
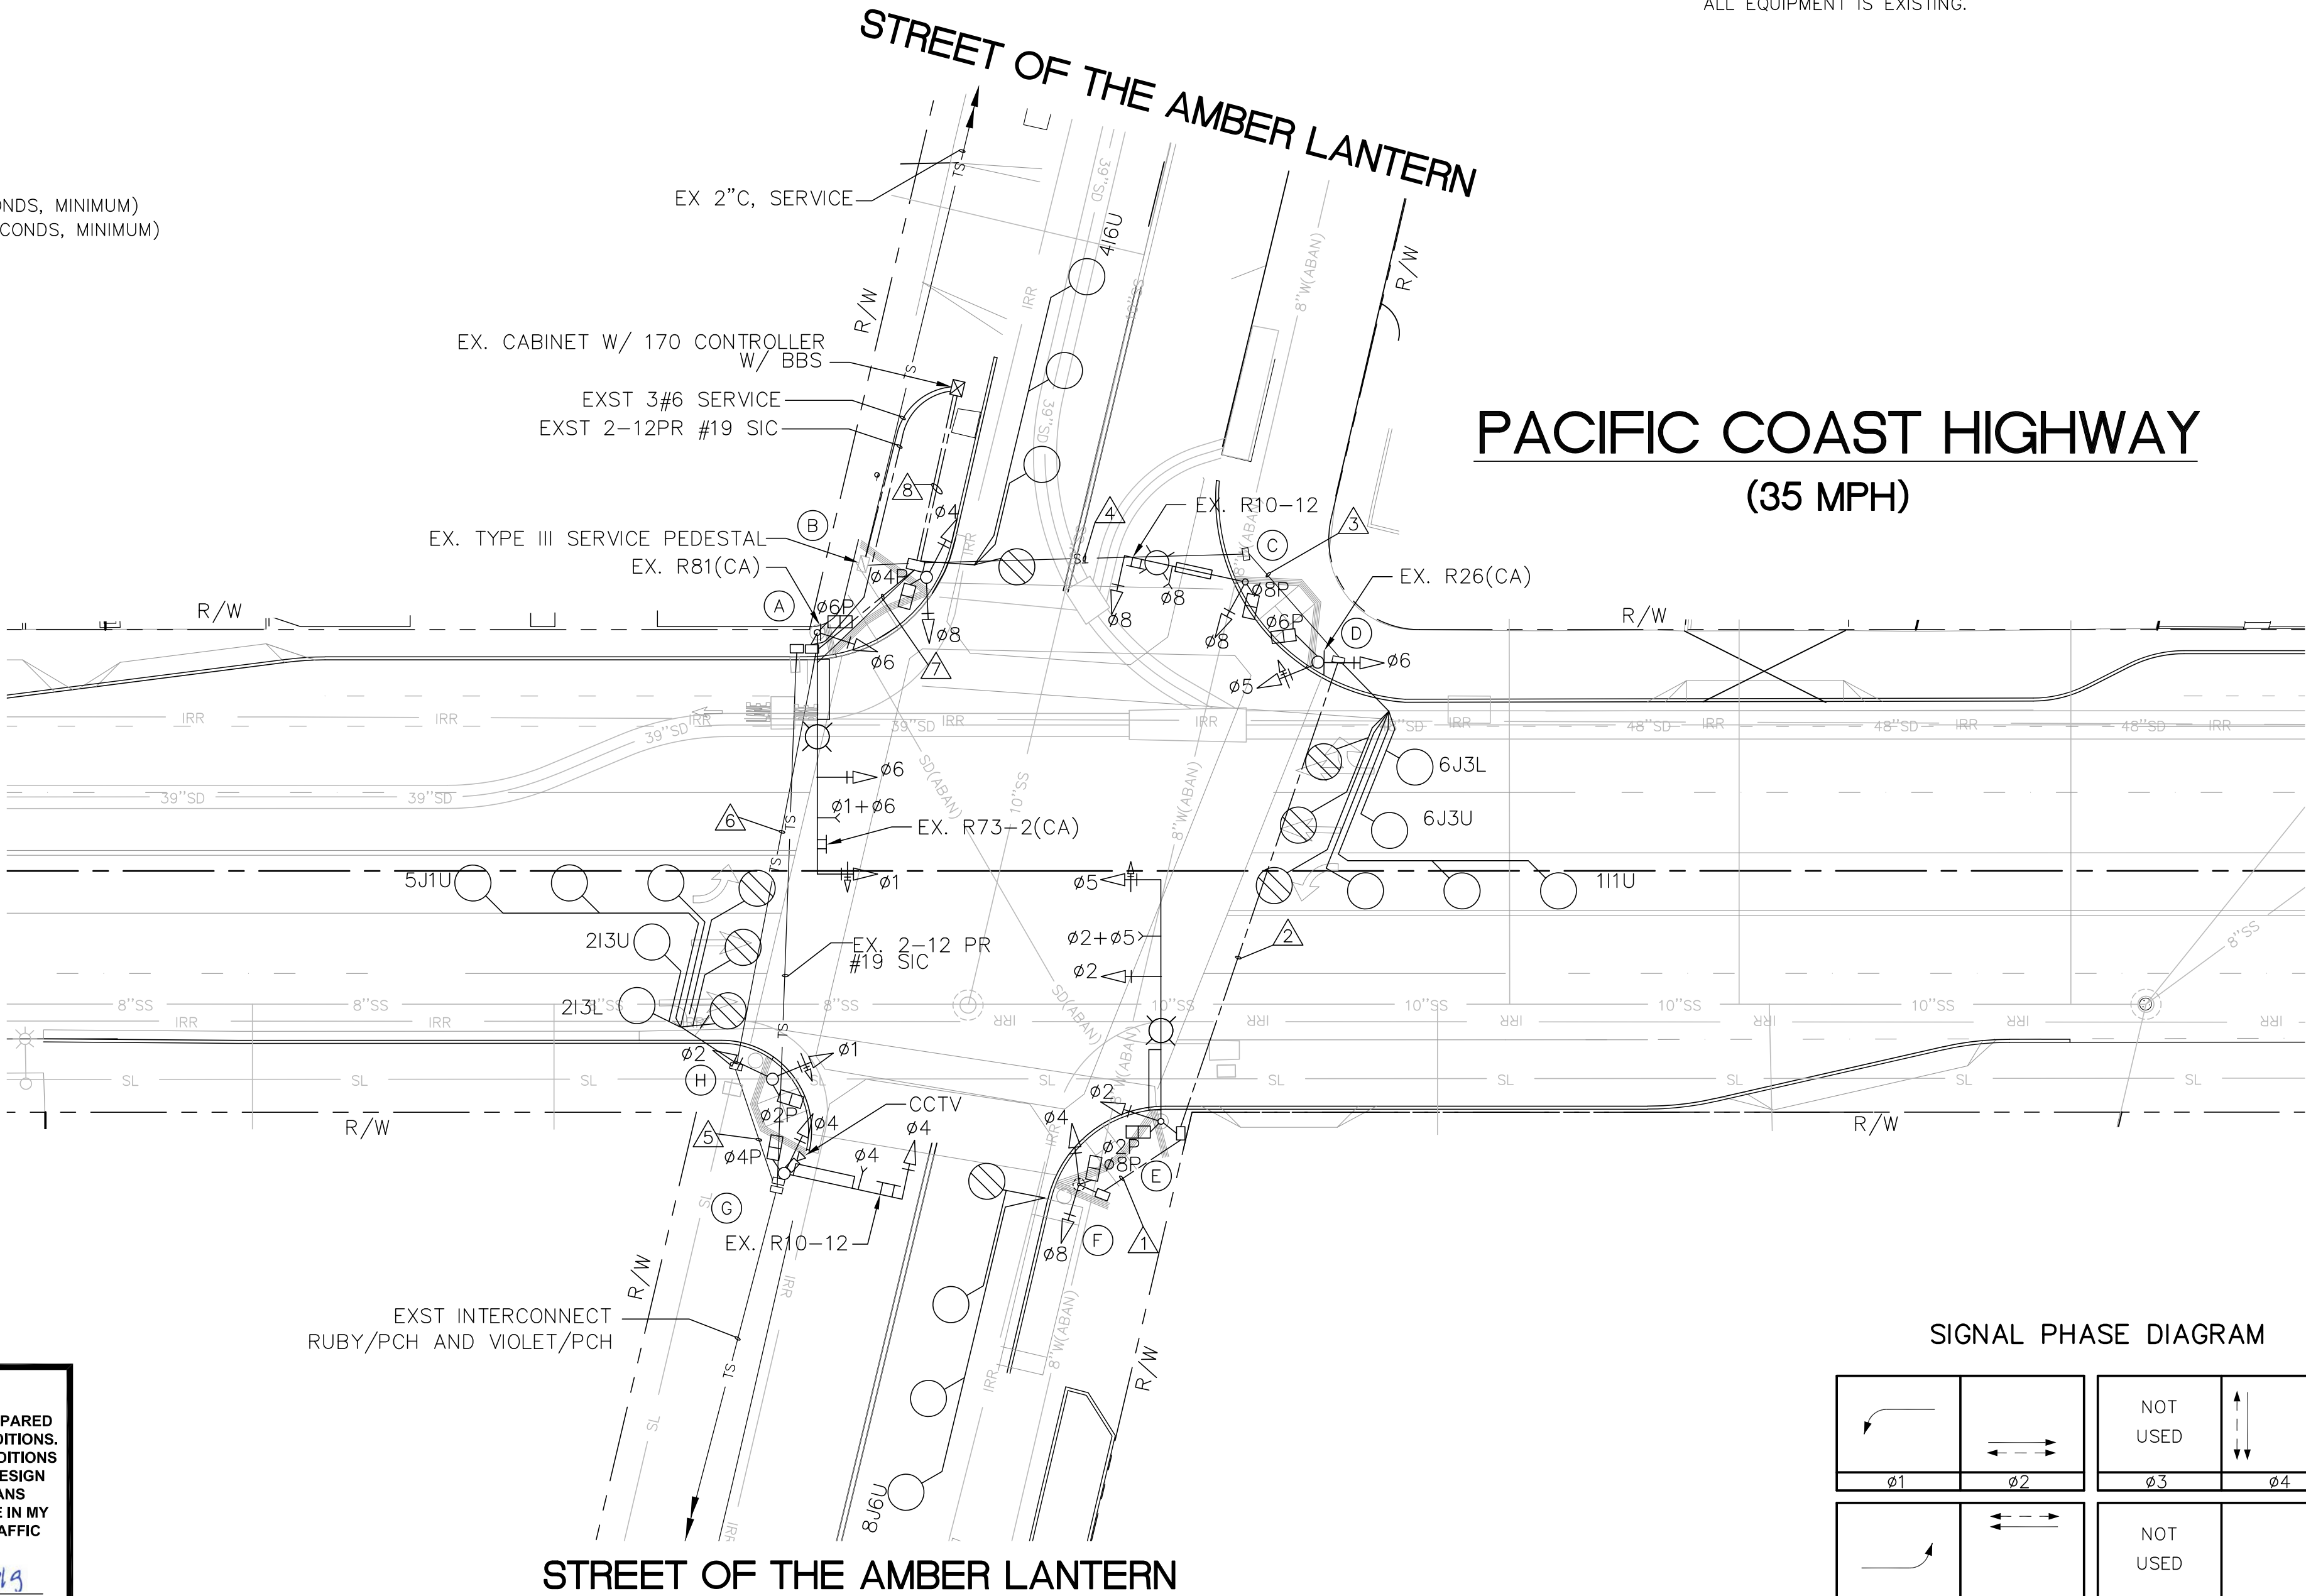


- GENERAL NOTES:
- A. THIS PLAN IS BEING GENERATED TO DOCUMENT AS-BUILT CONDITIONS, AND TO REVIEW THE IN PLACE TRAFFIC SIGNAL INSTALLATION TO VERIFY COMPLIANCE WITH CURRENT APPLICABLE REGULATIONS. UNDERGROUND UTILITY CONSTRUCTION IS NOT A PART OF THE ENGINEER'S REVIEW, BUT IS SHOWN FOR INFORMATIONAL PURPOSES ONLY PER PREVIOUS AS-BUILT PLANS.
- B. TRAFFIC SIGNAL AND HIGHWAY LIGHTING CONSTRUCTION SHOWN HEREON CONFORMED TO THE VERSION OF THE STATE OF CALIFORNIA DEPARTMENT OF TRANSPORTATION STANDARD PLANS AND SPECIFICATIONS AND THE CALIFORNIA MANUAL OF UNIFORM TRAFFIC CONTROL DEVICES THAT WAS CURRENT AT THE TIME THE TRAFFIC SIGNAL WAS INSTALLED.
- C. TRAFFIC SIGNAL PHASING AND SIGNAL TIMING IN PLACE AT THE INTERSECTION SHALL BE AS DIRECTED BY THE CITY ENGINEER OR HIS DESIGNATED REPRESENTATIVE.

SENSOR TABLE ■			
SENSOR UNIT	CHANNEL	DETECTOR	ASSIGNMENT
1	1	111U	NORMAL
	2	213L	NORMAL
2	1	213U	NORMAL
	2	416U	NORMAL
3	1	5J1U	NORMAL
	2	6J3L	NORMAL
4	1	6J3U	NORMAL
	2	8J6U	NORMAL

- ALL EQUIPMENT EXISTING.
- ▲ INTEGRAL CALL HOLD CAPABILITY (0-5 SECONDS, MINIMUM)
- ◆ INTEGRAL CALL DELAY CAPABILITY (0-30 SECONDS, MINIMUM)


SIGNS ON THIS SHEET

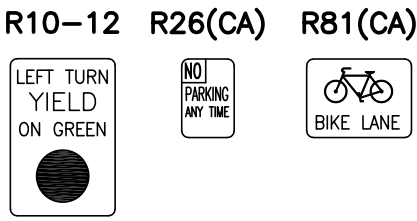



CONDUCTOR SCHEDULE														
AWG SIZE OR CABLE TYPE		P O L E	PHASE	CONDUIT SIZE AND RUN										
				1	2	3	4	5	6	7	8			
NO.14 CABLES 12 3	ROUNDED CONDUIT	(A)	Ø1,Ø6,Ø6P /Ø4PPB	-	-	-	-	-	-	1	1	1		
		(B)	Ø4,Ø8,Ø4P /Ø6PPB	-	-	-	-	-	-	-	-	1	1	
		(C)	Ø8,Ø8P /Ø6PPB	-	-	-	1	1	-	-	-	-	1	
		(D)	Ø5,Ø6,Ø6P /Ø8PPB	-	-	1	1	1	-	-	-	-	1	
		(E)	Ø2,Ø5,Ø2P /Ø8PPB	-	1	1	1	1	-	-	-	-	1	
		(F)	Ø4,Ø8,Ø8P /Ø2PPB	1	1	1	1	1	-	-	-	-	1	
		(G)	Ø4,Ø4P /Ø2PPB	-	-	-	-	1	1	1	1	1	1	
		(H)	Ø1,Ø2,Ø2P /Ø4PPB	-	-	-	-	-	-	1	1	1	1	
TOTAL CABLES		- 12 CON / 3 CON		1	2	2	3	4	4	1	2	3	3	8
#8	GROUND			1	1	1	1	1	1	1	1	1	1	
#10	LUMINAIRES			-	2	2	2	2	2	2	-	-		
	IISNS			-	2	2	2	2	2	2	-			
TYPE "B" DLC	Ø1			-	-	1	1	-	-	-	-	1		
	Ø2			-	-	-	-	-	2	2	2			
	Ø4			-	-	-	-	-	-	1	1			
	Ø5			-	-	-	-	-	1	1	1			
	Ø6			-	-	2	2	-	-	-	2			
	Ø8			1	1	1	1	-	-	-	1			
		TOTAL		1	1	4	3	-	3	4	8			
CCTV					-	-	-	1	1	1	1			
GTT MODEL 138 EVP					-	1	1	2	1	2	4			
12PR #19 SIC					-	-	-	1	1	1	2			
CONDUIT SIZES (INCHES)				3"	3"	3"	3"	3"	3"	3"	2-3"			

ALL CONDUCTORS AND CONDUITS ARE EXISTING.
PPB = PED PUSH BUTTON

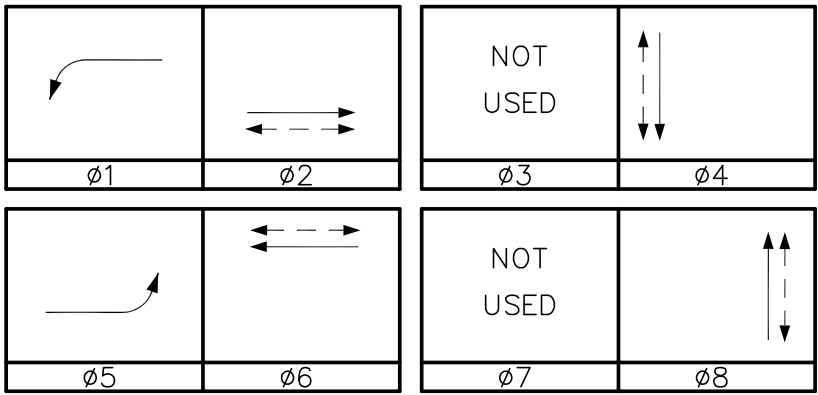SIGNAL PHASE DIAGRAM



SCALE 1"=20'

1	5/31/19	M.A. SIGN NOT NEEDED	CL	5/31/19	<div><div>LINSCOTT LAW & GREENSPAN</div><div>TRANSPORTATION PLANNING - TRAFFIC ENGINEERING - PARKING</div><div><div>600 South Lake Avenue, Suite 500, Pasadena, Ca 91106 (626) 796-2322</div><div>2 Executive Circle, Suite 250, Irvine, Ca 92614 (949) 825-8175</div><div>4542 Ruffner Street, Suite 100, San Diego, Ca 92111 (619) 300-8800</div></div></div> <div><div>REGISTERED PROFESSIONAL ENGINEER</div><div>RICHARD E. BARRETO</div><div>No. 2006</div><div>Exp. 6/30/19</div><div>TRAFFIC</div><div>STATE OF CALIFORNIA</div></div> <div><div>PLANS REVIEWED BY:</div><div>CITY OF DANA POINT, PUBLIC WORKS & ENGINEERING SERVICES</div><div>33282 GOLDEN LANTERN</div><div>DANA POINT, CA 92629</div><div></div><div>6/17/19</div><div>DATE</div><div>MATTHEW V. SINACORI</div><div>DIRECTOR OF PUBLIC WORKS/CITY ENGINEER</div><div>RCE #59239 EXP. 06/30/19</div><div>THIS PLAN IS SIGNED BY THE CITY ENGINEER FOR SCOPE AND ADHERENCE TO CITY STANDARDS AND REQUIREMENTS, CITY CODES, AND OTHER GENERAL ENGINEERING AND REGULATORY REQUIREMENTS ONLY. THE CITY ENGINEER IS NOT RESPONSIBLE FOR DESIGN, ASSUMPTIONS, OR ACCURACY.</div></div> <div></div> <div><div>TRAFFIC SIGNAL PLAN</div><div>AMBER LANTERN AT</div><div>PACIFIC COAST HIGHWAY</div><div>THE CITY OF DANA POINT</div><div>Public Works Department</div></div> <div>PROJECT NO. 2-16-3741</div>	
						SHEET 1
						OF 1
NO.	DATE	REVISIONS	APP.	DATE		