

CONDUCTOR SCHEDULE									
AWG SIZE OR CABLE TYPE	POLE	PHASE	CONDUIT SIZE AND RUN						
			1	2	3	4	5		
NO.14 CABLES	(A)	Ø5,Ø6,Ø8,Ø6P,Ø8P / Ø6PPB,Ø6PPB	-	-	-	-	-	2	2
12	(B)	Ø2,Ø5,Ø2P / Ø8PPB	-	-	1	1	-	1	1
	(C)	Ø4,Ø8,Ø8P / Ø2PPB	-	1	1	1	-	1	1
	(D)	Ø4,Ø2P / Ø2PPB	1	1	1	1	-	1	1
	(E)	Ø1,Ø2 / -	1	0	1	0	-	1	0
	(F)	Ø1,Ø6,Ø8,Ø6P / Ø6PPB	-	-	-	-	-	2	2
TOTAL CABLES	-	12 CON / 3 CON	2	1	3	2	4	3	2
#10	LUMINAIRES		2	2	2	2	-	-	-
	ISNS		2	2	2	2	-	-	-
TYPE "B" DLC	TOTAL		4	4	4	4	-	-	-
	Ø1		-	-	-	-	-	-	-
	Ø2		5	5	5	-	-	-	-
	Ø4		-	-	-	-	-	-	-
	Ø5		1	1	1	-	-	-	-
	Ø6		-	-	-	-	-	-	-
	Ø8		-	2	2	-	-	-	-
3M MODEL 138 EVP	TOTAL		6	8	8	1	9	-	-
	PERCENT FILL (%)		22%	32%	41%	21%	37%	-	-
CONDUIT SIZES (INCHES)			3"	3"	3"	3"	2-3"	-	-

ALL CONDUCTORS AND CONDUITS ARE EXISTING.
PPB = PED PUSH BUTTON


SENSOR TABLE			
SENSOR UNIT	CHANNEL	DETECTOR	ASSIGNMENT
1	1	11IU	NORMAL
2	2	212L	EXTENSION
	1	212U	EXTENSION
3	2	213L	DELAY
	1	214U	NORMAL
4	2	214L	NORMAL
	1	4J8U	NORMAL
5	2	5J1U	NORMAL
	1	6J2U	EXTENSION
6	2	6J2L	EXTENSION
	1	6J4U	NORMAL
7	2	6J4L	NORMAL
	1	8J8U	NORMAL
	2	8J8L	NORMAL

■ ALL EQUIPMENT EXISTING.
▲ INTEGRAL CALL HOLD CAPABILITY (0-5 SECONDS, MINIMUM)
♦ INTEGRAL CALL DELAY CAPABILITY (0-30 SECONDS, MINIMUM)

EQUIPMENT SCHEDULE														
LOCATION	POLE TYPE	SIGNAL STANDARD		LUMINAIRE SIZE/TYPE	MOUNTINGS			PEDESTRIAN PUSH BUTTON			POLE LOCATION		I.I.S.N.S.	REMARKS
		MAST ARM	LUM.		VEHICLE		PEDESTRIAN	PHASE	TYPE	QUAD	A	B		
					POLE	MAST ARM								
(A)	1-A	-	-	-	TV-3-T	-	**SP-2-T	Ø6 / Ø8	APS APS	S / E	EXISTING	EXISTING	-	-
(B)	29-5-80	50'	15'	200W	SV-1-T	2-MAS F=16'	**SP-1-T	Ø8	APS	E	EXISTING	EXISTING	Crystal Lantern	-
(C)	1-A	-	-	-	TV-2-T	-	**SP-1-T	Ø2	APS	S	EXISTING	EXISTING	-	-
(D)	15	-	15'	200W	SV-1-T	-	**SP-1-T	Ø2	APS	S	EXISTING	EXISTING	-	-
(E)	1-A	-	-	-	TV-2-T	-	-	-	-	-	EXISTING	EXISTING	-	-
(F)	29-5-80	55'	15'	-	SV-2-T	2-MAS F=12'	**SP-1-T	Ø6	APS	N	EXISTING	EXISTING	Crystal Lantern	-

ALL EQUIPMENT IS EXISTING UNLESS NOTED OTHERWISE.
APS = ASSESSABLE PEDESTRIAN PUSH BUTTON, MUTCD AND ITE COMPLIANT.
** = ALL PEDESTRIAN INDICATION HEADS SHALL BE DIALITE COUNTDOWN HEADS, MUTCD COMPLIANT


CRYSTAL LANTERN

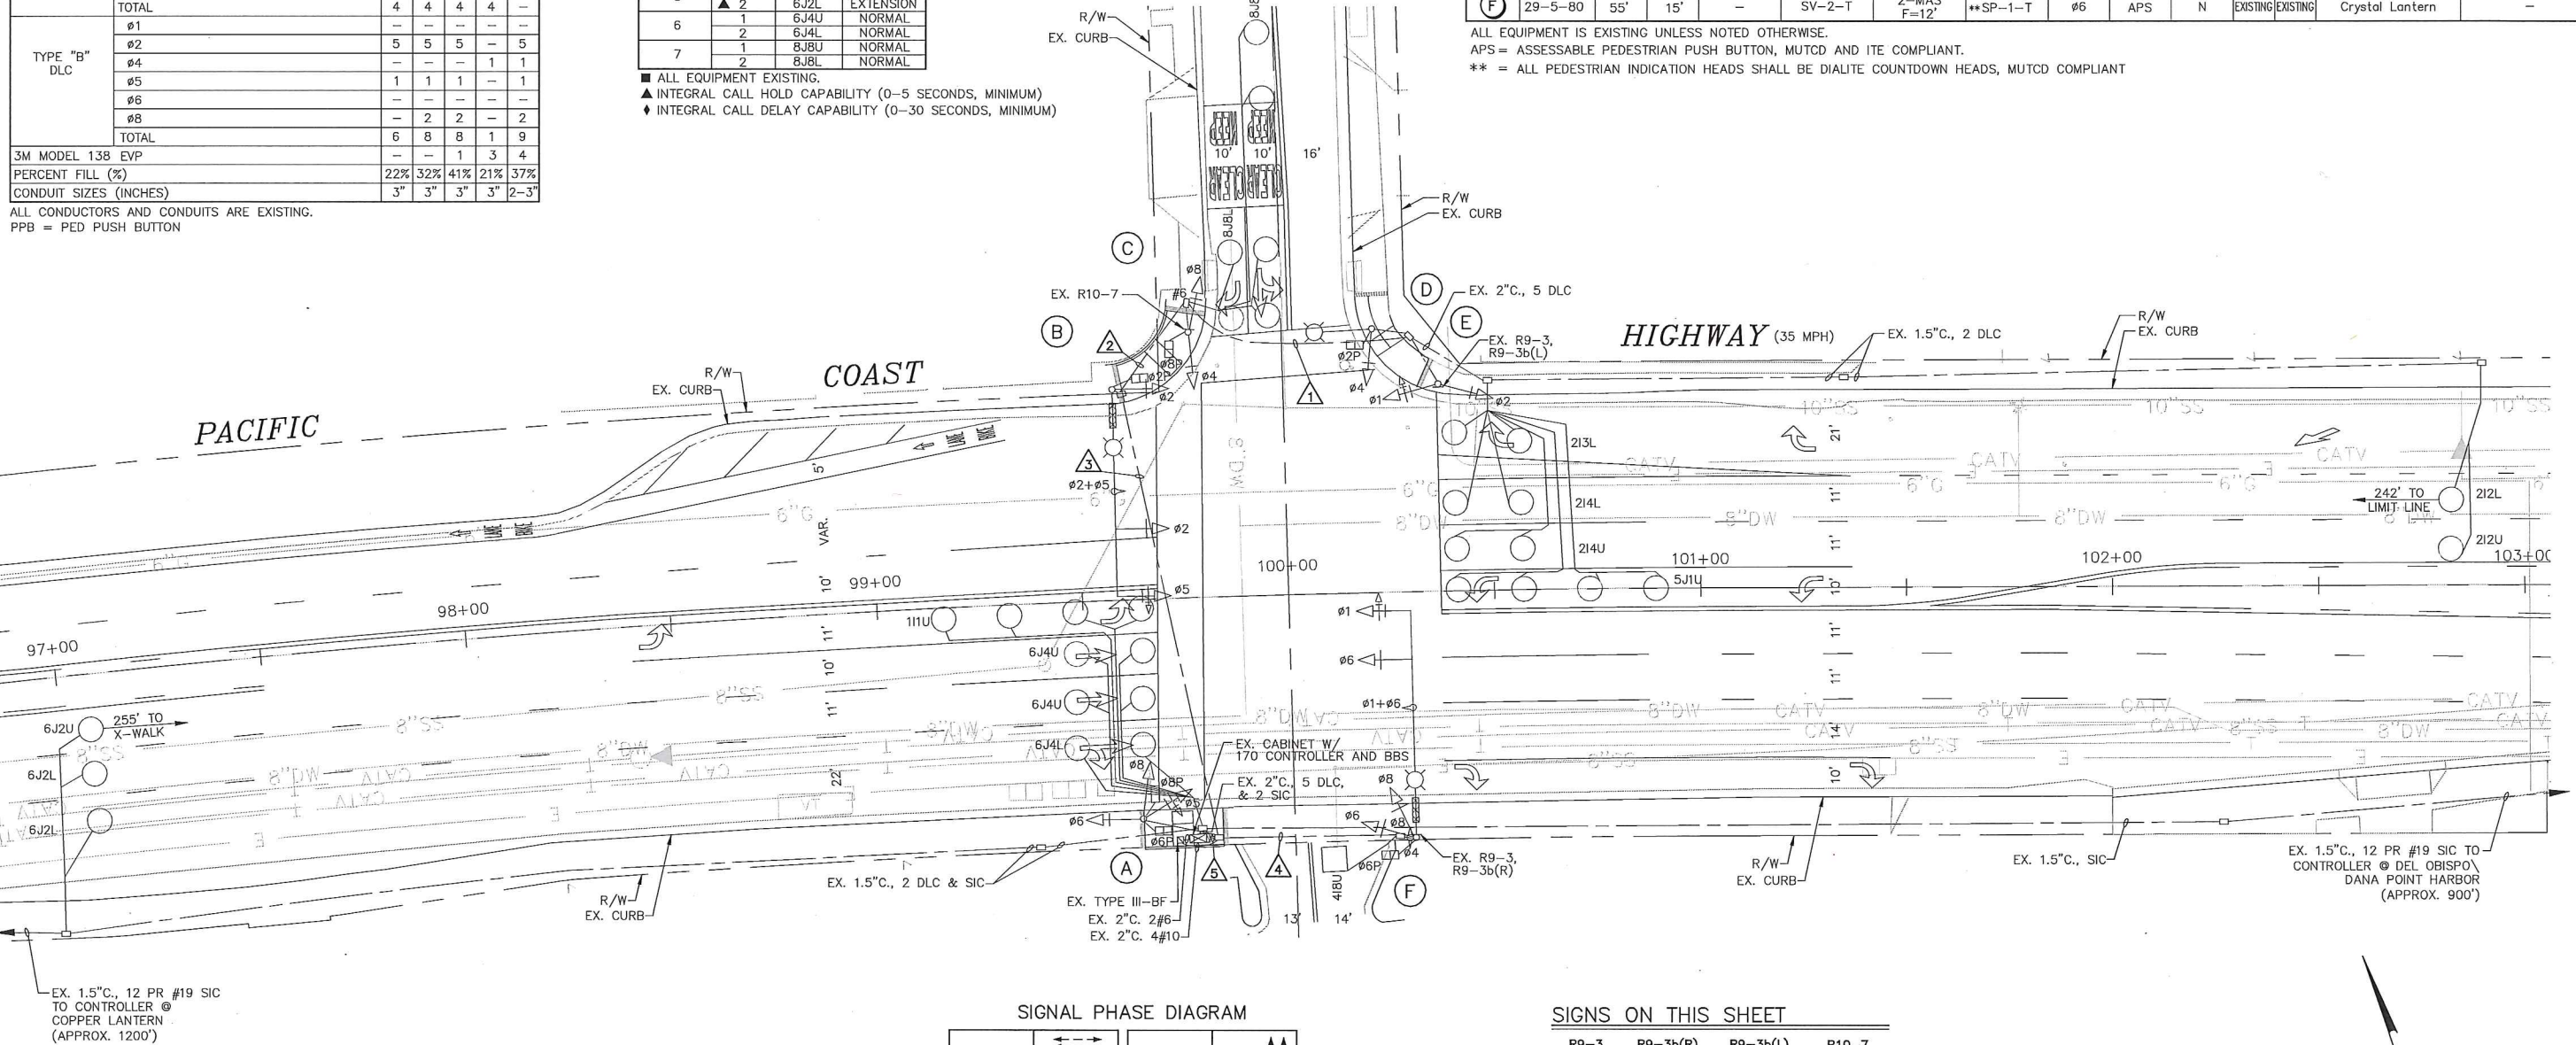


GENERAL NOTES:

- THIS PLAN IS BEING GENERATED TO DOCUMENT AS-BUILT CONDITIONS, AND TO REVIEW THE IN PLACE TRAFFIC SIGNAL INSTALLATION TO VERIFY COMPLIANCE WITH CURRENT APPLICABLE REGULATIONS. UNDERGROUND UTILITY CONSTRUCTION IS NOT A PART OF THE ENGINEER'S REVIEW, BUT IS SHOWN FOR INFORMATIONAL PURPOSES ONLY PER PREVIOUS AS-BUILT PLANS.
- TRAFFIC SIGNAL AND HIGHWAY LIGHTING CONSTRUCTION SHOWN HEREON CONFORMED TO THE VERSION OF THE STATE OF CALIFORNIA DEPARTMENT OF TRANSPORTATION STANDARD PLANS AND SPECIFICATIONS AND THE CALIFORNIA MANUAL OF UNIFORM TRAFFIC CONTROL DEVICES THAT WAS CURRENT AT THE TIME THE TRAFFIC SIGNAL WAS INSTALLED.
- TRAFFIC SIGNAL PHASING AND SIGNAL TIMING IN PLACE AT THE INTERSECTION SHALL BE AS DIRECTED BY THE CITY ENGINEER OR HIS DESIGNATED REPRESENTATIVE.

SIGNAL PHASE DIAGRAM

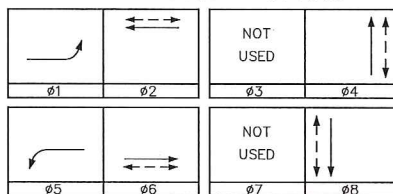

SIGNS ON THIS SHEET

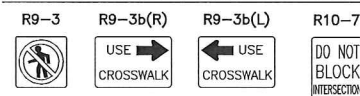

RECORD DRAWING

THIS SET OF RECORD DRAWINGS HAS BEEN PREPARED BASED ON VERIFICATION OF ACTUAL FIELD CONDITIONS. THE ENGINEER CERTIFIES THAT ON STREET CONDITIONS ARE ACCEPTABLE PER APPLICABLE TRAFFIC DESIGN GUIDELINES (I.E. CALIFORNIA MUTCD/CALTRANS STANDARD PLANS, ETC.) AND ARE ACCEPTABLE IN MY PROFESSIONAL OPINION AS A REGISTERED TRAFFIC ENGINEER IN THE STATE OF CALIFORNIA.

Name: *Matthew V. Sinacori* Date: *6/17/17*
CALIFORNIA REGISTRATION NO. *TR*

SCALE 1"=20'

NO.	DATE	REVISIONS	APP.	DATE

PLAN PREPARED BY:

LINSCOTT, LAW & GREENSPAN, ENGINEERS
TRANSPORTATION PLANNING - TRAFFIC ENGINEERING - PARKING
234 East Colorado Boulevard, Suite 400, Pasadena, CA 91101 (828) 798-2322
1580 Corporate Drive, Suite 122, Costa Mesa, CA 92626 (714) 441-5597
4542 Rutherford Street, Suite 100, San Diego, CA 92111 (619) 590-8800



PLANS REVIEWED BY:

CITY OF DANA POINT, PUBLIC WORKS & ENGINEERING SERVICES
33282 GOLDEN LANTERN
DANA POINT, CA 92629
MATTHEW V. SINACORI, CITY ENGINEER
RCE #59239 EXP. 06/30/17
DATE: *6/20/17*
THIS PLAN IS SIGNED BY THE CITY ENGINEER FOR SCOPE AND ADHERENCE TO CITY STANDARDS AND REQUIREMENTS, CITY CODES, AND OTHER GENERAL ENGINEERING AND REGULATORY REQUIREMENTS ONLY. THE CITY ENGINEER IS NOT RESPONSIBLE FOR DESIGN, ASSUMPTIONS, OR ACCURACY.



TRAFFIC SIGNAL PLAN
CRYSTAL LANTERN AT
PACIFIC COAST HIGHWAY
THE CITY OF DANA POINT
Public Works Department

PROJECT NO.
1111
SHEET *TS4*
OF *1*