


GENERAL NOTES:

- A. THIS PLAN IS BEING GENERATED TO DOCUMENT AS-BUILT CONDITIONS, AND TO REVIEW THE IN PLACE TRAFFIC SIGNAL INSTALLATION TO VERIFY COMPLIANCE WITH CURRENT APPLICABLE REGULATIONS. UNDERGROUND UTILITY CONSTRUCTION IS NOT A PART OF THE ENGINEER'S REVIEW, BUT IS SHOWN FOR INFORMATIONAL PURPOSES ONLY PER PREVIOUS AS-BUILT PLANS.
- B. TRAFFIC SIGNAL AND HIGHWAY LIGHTING CONSTRUCTION SHOWN HEREON CONFORMED TO THE VERSION OF THE STATE OF CALIFORNIA DEPARTMENT OF TRANSPORTATION STANDARD PLANS AND SPECIFICATIONS AND THE CALIFORNIA MANUAL OF UNIFORM TRAFFIC CONTROL DEVICES THAT WAS CURRENT AT THE TIME THE TRAFFIC SIGNAL WAS INSTALLED.
- C. TRAFFIC SIGNAL PHASING AND SIGNAL TIMING IN PLACE AT THE INTERSECTION SHALL BE AS DIRECTED BY THE CITY ENGINEER OR HIS DESIGNATED REPRESENTATIVE.

EXISTING SIGN ON THIS SHEET

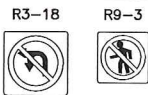

EQUIPMENT SCHEDULE

POLE LOCATION	SIGNAL STANDARD		LUMINAIRE SIZE/TYPE	MOUNTINGS			PEDESTRIAN PUSH BUTTON			POLE LOCATION		I.I.S.N.S.	
	TYPE	MAST ARM		VEHICLE		PEDESTRIAN	PHASE	TYPE	QUAD	A B			
		SIG.		LUM.	POLE					MAST ARM			
(A)	19A-4-100	25'	15'	310W	SV-1-T	2-MAS F=X',X'	* SP-1-T	6	APS	N	EXISTING	EXISTING	Del Prado
(B)	17-3-100	30'	15'	310W	SV-1-T	MAS	* SP-1-T	6	APS	N	EXISTING	EXISTING	Pacific Coast Hwy
(C)	19A-4-100	15'	15'	310W	SV-1-T	2-MAS F=X',X'	* SP-1-T	2	APS	S	EXISTING	EXISTING	Del Prado
(D)	15TS	-	15'	310W	SV-2-TA	-	* SP-1-T	2	APS	N	EXISTING	EXISTING	-

ALL EQUIPMENT IS EXISTING.

* = ALL PEDESTRIAN INDICATION HEADS SHALL BE DIALITE COUNTDOWN HEADS, MUTCD COMPLIANT
APS = ASSESSABLE PEDESTRIAN PUSH BUTTON, MUTCD AND ITE COMPLIANT.

PACIFIC COAST HIGHWAY
(35 MPH)



SENSOR TABLE ■			
SENSOR UNIT	CHANNEL	DETECTOR	ASSIGNMENT
1	1	2I2L	NORMAL
	2	2I2U	NORMAL
2	▲ 1	6J3L	NORMAL
	▲ 2	6J3U	NORMAL
3	1	8J6L	NORMAL

- ALL EQUIPMENT EXISTING.
▲ INTEGRAL CALL HOLD CAPABILITY (0-5 SECONDS, MINIMUM)
♦ INTEGRAL CALL DELAY CAPABILITY (0-30 SECONDS, MINIMUM)

AWG SIZE OR CABLE TYPE	P O L E	PHASE	CONDUIT SIZE AND RUN				
			1	2	3	4	5
NO.14 CABLES 12 3	(A)	Ø4,Ø6,Ø8,Ø6P /Ø6PPB	-	-	2	1	2
	(B)	Ø8,Ø6P /Ø6PPB	-	-	-	1	1
	(C)	Ø2,Ø4,Ø2P /Ø2PPB	-	1	-	-	1
	(D)	Ø4,Ø8,Ø2P /Ø2PPB	1	1	-	1	1
	(E)	- /-	-	-	-	-	-
	(F)	- /-	-	-	-	-	-
	(G)	- /-	-	-	-	-	-
	(H)	- /-	-	-	-	-	-
TOTAL CABLES - 12 CON / 3 CON			1	2	2	5	4
#8	GROUND		1	1	1	1	1
	LUMINAIRES		1	1	1	1	1
	IISNS		1	1	1	1	1
	Ø2		2	2	-	2	2
TYPE "B" DLC	Ø4		-	-	1	1	1
	Ø6		-	-	-	1	1
	Ø8		-	1	-	1	1
	TOTAL		2	3	1	5	5
GTT MODEL 138 EVP			1	2	1	3	3
CONDUIT SIZES (INCHES)			3"	3"	3"	3"	3"


ALL CONDUCTORS AND CONDUITS ARE EXISTING.
PPB = PED PUSH BUTTON

SIGNAL PHASE DIAGRAM

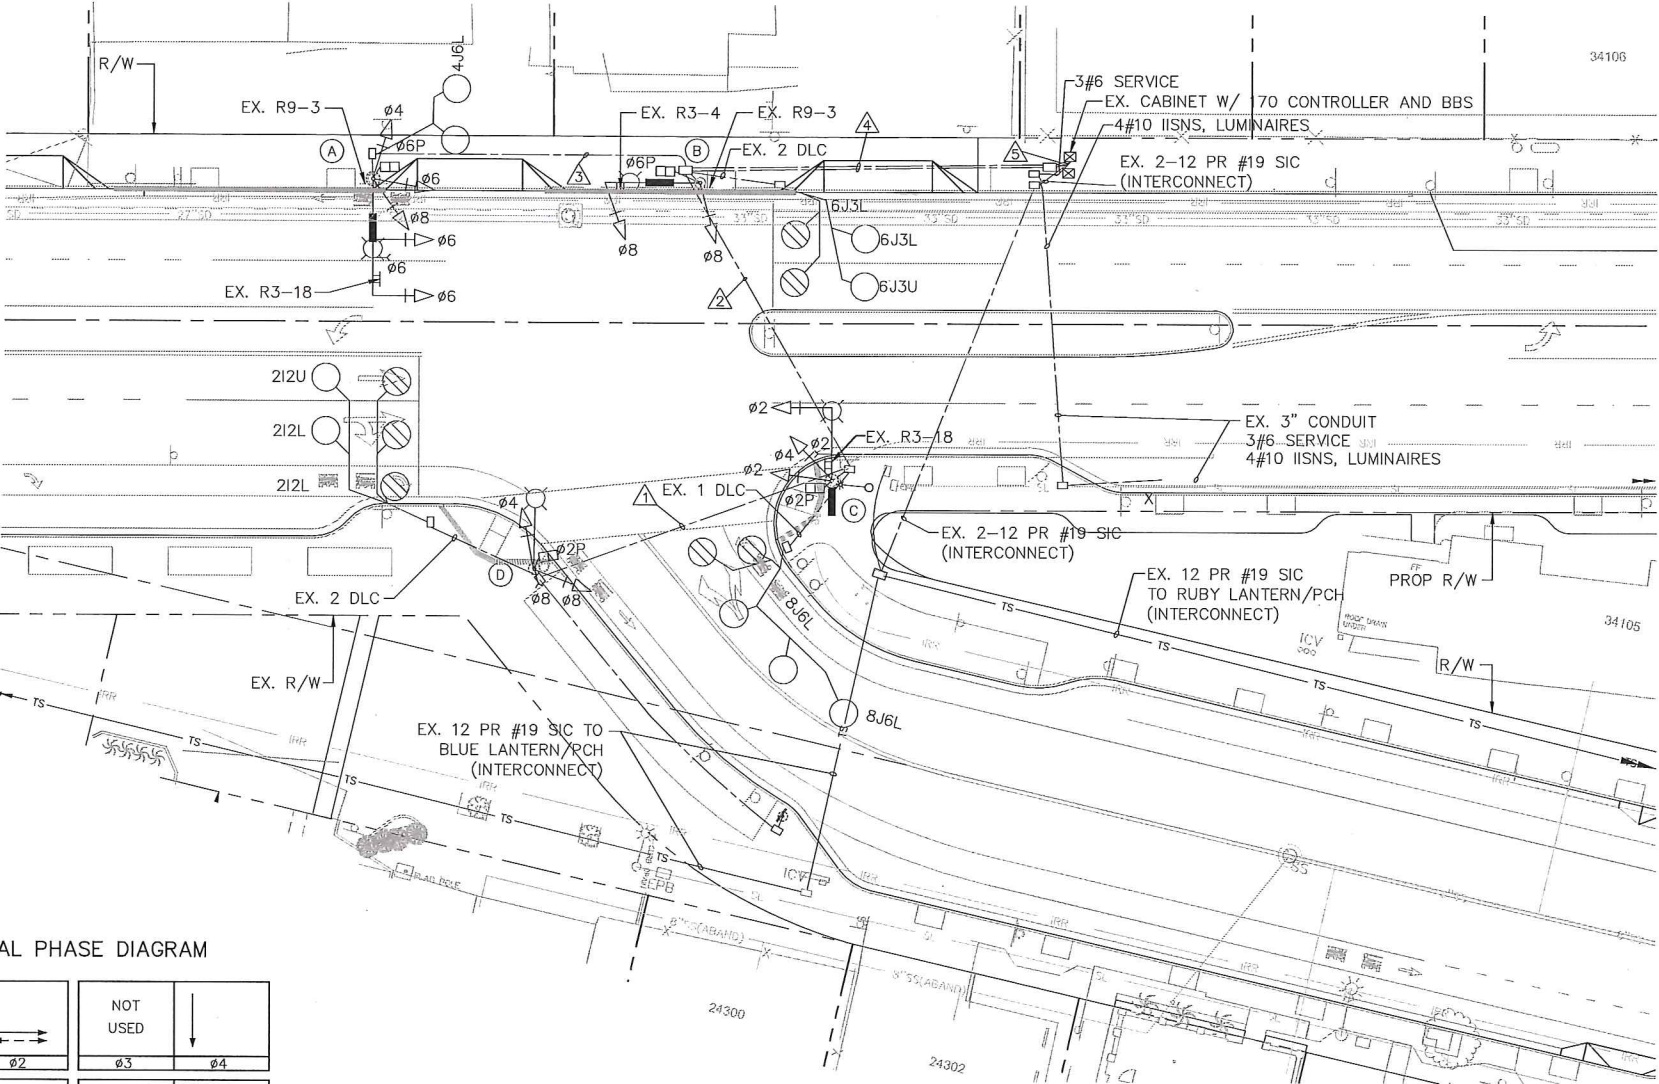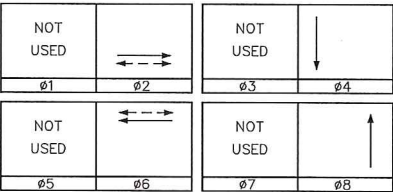

DEL PRADO
(30 MPH)

RECORD DRAWING
THIS SET OF RECORD DRAWINGS HAS BEEN PREPARED BASED ON VERIFICATION OF ACTUAL FIELD CONDITIONS. THE ENGINEER CERTIFIES THAT ON STREET CONDITIONS ARE ACCEPTABLE PER APPLICABLE TRAFFIC DESIGN GUIDELINES (I.E. CALIFORNIA MUTCD/CALTRANS STANDARD PLANS, ETC.) AND ARE ACCEPTABLE IN MY PROFESSIONAL OPINION AS A REGISTERED TRAFFIC ENGINEER IN THE STATE OF CALIFORNIA.
Name: [Signature] Date: 6/19/17
CALIFORNIA REGISTRATION TR

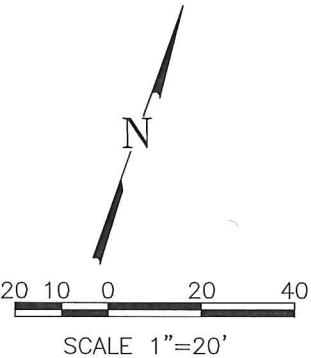

NO.		DATE	REVISIONS	APP.	DATE	PLAN PREPARED BY: LINSCOTT, LAW & GREENSPAN, ENGINEERS TRANSPORTATION PLANNING - TRAFFIC ENGINEERING - PARKING 600 South Lake Avenue, Suite 500, Pasadena, Ca 91106 (626) 796-2322 2 Descriptive Circle, Suite 250, Irvine, Ca 92614 (949) 825-6175 4542 Ruffner Street, Suite 100, San Diego, Ca 92111 (619) 500-8000			PLANS REVIEWED BY: CITY OF DANA POINT, PUBLIC WORKS & ENGINEERING SERVICES 33282 GOLDEN LANTERN DANA POINT, CA 92629 [Signature] 6/20/17 MATTHEW V. SINACORI, CITY ENGINEER RCE #59239 EXP. 06/30/17 DATE		TRAFFIC SIGNAL PLAN DEL PRADO AT PACIFIC COAST HIGHWAY		PROJECT NO. 2-16-3741
THE CITY OF DANA POINT Public Works Department											SHEET 1 OF 1		