


GENERAL NOTES:

- THIS PLAN IS BEING GENERATED TO DOCUMENT AS-BUILT CONDITIONS, AND TO REVIEW THE IN PLACE TRAFFIC SIGNAL INSTALLATION TO VERIFY COMPLIANCE WITH CURRENT APPLICABLE REGULATIONS. UNDERGROUND UTILITY CONSTRUCTION IS NOT A PART OF THE ENGINEER'S REVIEW, BUT IS SHOWN FOR INFORMATIONAL PURPOSES ONLY PER PREVIOUS AS-BUILT PLANS.
- TRAFFIC SIGNAL AND HIGHWAY LIGHTING CONSTRUCTION SHOWN HEREON CONFORMED TO THE VERSION OF THE STATE OF CALIFORNIA DEPARTMENT OF TRANSPORTATION STANDARD PLANS AND SPECIFICATIONS AND THE CALIFORNIA MANUAL OF UNIFORM TRAFFIC CONTROL DEVICES THAT WAS CURRENT AT THE TIME THE TRAFFIC SIGNAL WAS INSTALLED.
- TRAFFIC SIGNAL PHASING AND SIGNAL TIMING IN PLACE AT THE INTERSECTION SHALL BE AS DIRECTED BY THE CITY ENGINEER OR HIS DESIGNATED REPRESENTATIVE.

EXISTING SIGN ON THIS SHEET

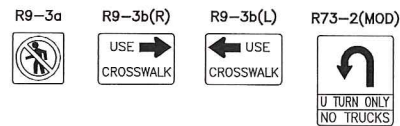


SENSOR TABLE			
SENSOR UNIT	CHANNEL	DETECTOR	ASSIGNMENT
1	1	111U	NORMAL
	2	212L	EXTENSION
2	1	212U	EXTENSION
	2	213U	NORMAL
3	1	213L	NORMAL
	2	214U	NORMAL
4	1	4J6U	NORMAL
	2	5J1U	NORMAL
5	1	6J2U	EXTENSION
	2	6J2L	EXTENSION
6	1	6J3U	EXTENSION
	2	6J3L	NORMAL
7	1	6J4U	NORMAL
	2	6J4L	NORMAL

- ALL EQUIPMENT IS EXISTING
- ▲ INTEGRAL CALL HOLD CAPABILITY (0-5 SECONDS, MINIMUM)
- ◆ INTEGRAL CALL DELAY CAPABILITY (0-30 SECONDS, MINIMUM)


CONDUCTOR SCHEDULE

AWG	CIRCUIT	1	2	3	4	5
#14	Ø1	3	3	3	6	6
	Ø2	-	-	-	3	3
	Ø4	3	3	-	3	3
	Ø5	-	3	-	3	3
	Ø6	3	3	-	3	3
	Ø2P	-	-	2	2	2
	Ø2 PPB	-	-	1	1	1
	PPB COMMON	-	-	1	1	1
	SPARES	3	3	3	6	6
	TOTAL	12	15	10	28	28
#10	SIGNAL COMMON	1	1	1	2	2
	IISNS	2	2	-	2	2
	LUMINAIRE	2	2	-	2	2
	TOTAL	5	5	1	6	6
TYPE "B" DLC	Ø1 DETECTOR	-	1	-	1	1
	Ø2 DETECTOR	-	-	5	5	5
	Ø4 DETECTOR	-	-	-	1	1
	Ø5 DETECTOR	-	-	1	1	1
	Ø6 DETECTOR	-	6	-	6	6
	TOTAL	-	7	6	14	14
OPTICOM		2	2	-	2	2
CCTV		-	-	-	1	1
12PR #19 SIC		-	1	-	1	1
CONDUIT SIZE		3"	2"	2"	3"	3"

ALL CONDUITS AND CONDUCTORS ARE EXISTING.
PPB = PED PUSH BUTTON

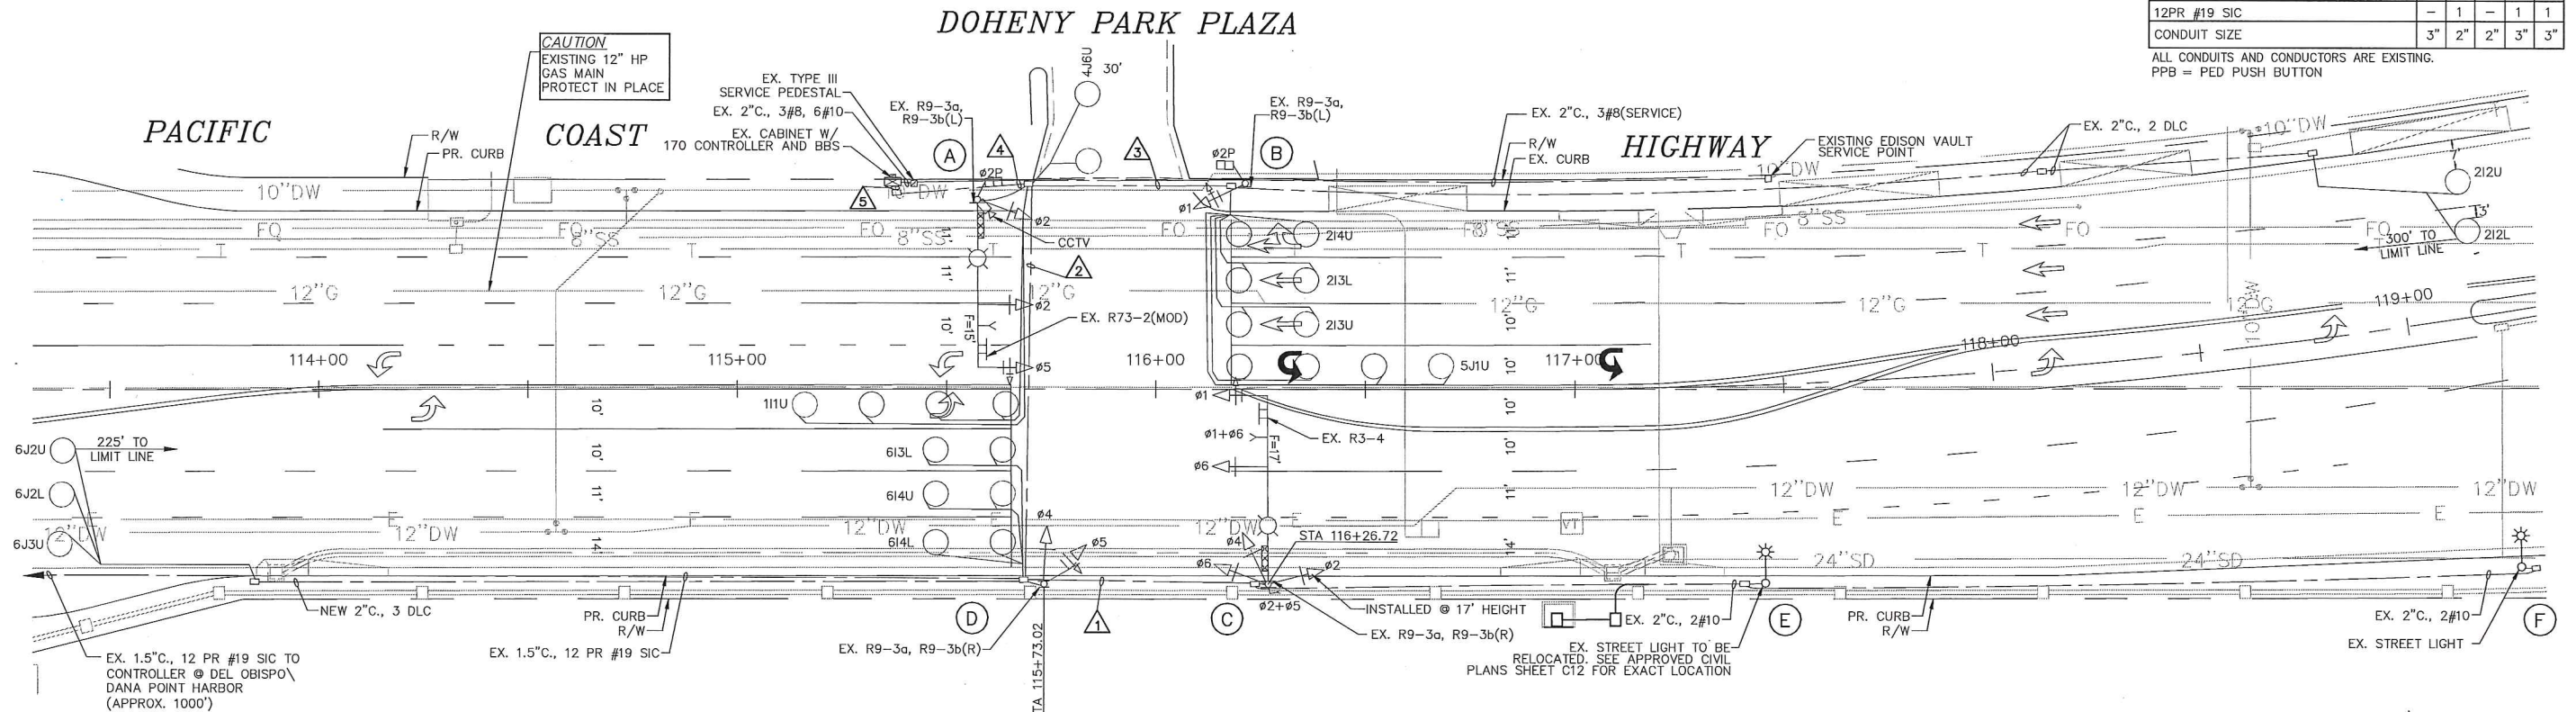

SIGNAL PHASE DIAGRAM

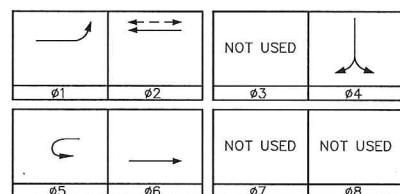

RECORD DRAWING


THIS SET OF RECORD DRAWINGS HAS BEEN PREPARED BASED ON VERIFICATION OF ACTUAL FIELD CONDITIONS. THE ENGINEER CERTIFIES THAT ON STREET CONDITIONS ARE ACCEPTABLE PER APPLICABLE TRAFFIC DESIGN GUIDELINES (I.E. CALIFORNIA MUTCD/CALTRANS STANDARD PLANS, ETC.) AND ARE ACCEPTABLE IN MY PROFESSIONAL OPINION AS A REGISTERED TRAFFIC ENGINEER IN THE STATE OF CALIFORNIA.

Name: *[Signature]* Date: 6/19/17
CALIFORNIA REGISTRATION TR

EQUIPMENT SCHEDULE

EQUIPMENT SCHEDULE													
POLE LOCATION	SIGNAL STANDARD		H.P.S. LUMINAIRE SIZE/TYPE	MOUNTINGS			PEDESTRIAN PUSH BUTTON			POLE LOCATION		I.I.S.N.S.	
	TYPE	MAST ARM		VEHICLE	MAST ARM	PEDESTRIAN	PHASE	TYPE	QUAD	A	B		
		SIG.											LUM.
(A)	26-4-100	40'	15'	250W	SV-1-T	2-MAS F=15'	* SP-1-T	Ø2	B	N	EXISTING	EXISTING	Doheny Park Plaza
(B)	1-A	-	-	-	TV-1-T	-	* SP-1-T	Ø2	A	S	EXISTING	EXISTING	-
(C)	26-4-100	45'	15'	250W	SV-1-T SV-2-T	2-MAS F=17'	-	-	-	-	AS SHOWN	EXISTING	Doheny Park Plaza
(D)	1-A	-	-	-	TV-2-T	-	-	-	-	-	AS SHOWN	EXISTING	-
(E)	EX. STREET LIGHT	-	15'	310W	-	-	-	-	-	-	SEE PLAN	SEE PLAN	-
(F)	EX. STREET LIGHT	-	15'	310W	-	-	-	-	-	-	EXISTING	EXISTING	-

- ALL EQUIPMENT IS EXISTING.
- = MOUNT AT 17' HEIGHT.
- * = PEDESTRIAN INDICATION HEADS SHALL BE DIALITE COUNTDOWN HEADS, MUTCD COMPLIANT.
- (A) = ANODOE PUSH BUTTON, (B) = BULL DOG PUSH BUTTON.

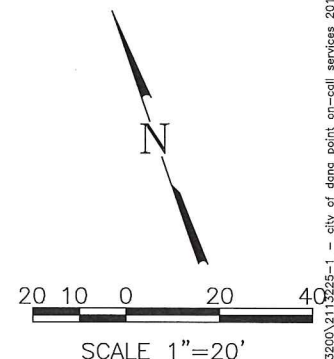

PLAN PREPARED BY: LINSCOTT, LAW & GREENSPAN, ENGINEERS TRANSPORTATION PLANNING - TRAFFIC ENGINEERING - PARKING 600 South Lake Avenue, Suite 500, Pasadena, CA 91106 (626) 796-2322 2 Executive Circle, Suite 250, Irvine, CA 92614 (949) 825-8175 4542 Ruffner Street, Suite 100, San Diego, CA 92111 (619) 300-8800				PLANS REVIEWED BY: CITY OF DANA POINT, PUBLIC WORKS & ENGINEERING SERVICES 33282 GOLDEN LANTERN DANA POINT, CA 92629 <i>[Signature]</i> 6/26/17 MATTHEW V. SINACORI, CITY ENGINEER RCE #59239 EXP. 06/30/17 DATE				TRAFFIC SIGNAL PLAN DOHENY PARK PLAZA AT PACIFIC COAST HIGHWAY THE CITY OF DANA POINT Public Works Department		PROJECT NO. 1111 SHEET <u>1</u> OF <u>1</u>	
NO.	DATE	REVISIONS	APP.	DATE							