


A. THIS PLAN IS BEING GENERATED TO DOCUMENT AS-BUILT CONDITIONS, AND TO REVIEW THE IN PLACE TRAFFIC SIGNAL INSTALLATION TO VERIFY COMPLIANCE WITH CURRENT APPLICABLE REGULATIONS. UNDERGROUND UTILITY CONSTRUCTION IS NOT A PART OF THE ENGINEER'S REVIEW, BUT IS SHOWN FOR INFORMATIONAL PURPOSES ONLY PER PREVIOUS AS-BUILT PLANS.

B. TRAFFIC SIGNAL AND HIGHWAY LIGHTING CONSTRUCTION SHOWN HEREON CONFORMED TO THE VERSION OF THE STATE OF CALIFORNIA DEPARTMENT OF TRANSPORTATION STANDARD PLANS AND SPECIFICATIONS AND THE CALIFORNIA MANUAL OF UNIFORM TRAFFIC CONTROL DEVICES THAT WAS CURRENT AT THE TIME THE TRAFFIC SIGNAL WAS INSTALLED.

C. TRAFFIC SIGNAL PHASING AND SIGNAL TIMING IN PLACE AT THE INTERSECTION SHALL BE AS DIRECTED BY THE CITY ENGINEER OR HIS DESIGNATED REPRESENTATIVE.

EQUIPMENT SCHEDULE													
LOCATION	SIGNAL STANDARD		LUMINAIRE SIZE/TYPE	MOUNTINGS			PEDESTRIAN PUSH BUTTON			POLE LOCATION		I.I.S.N.S.	
	POLE TYPE	MAST ARM SIG.		LUM.	VEHICLE		PEDESTRIAN	PHASE	TYPE	QUAD	A		B
					POLE	MAST ARM							
(A)	26-4-129	45'	15'	310W	SV-1-T	MAT(#1) MAS(#6)	**SP-1-T	Ø4	B	S	EXISTING	EXISTING	Selva Road
(B)	1-A	10'	—	—	TV-1-T	—	**SP-1-T	Ø6	B	W	EXISTING	EXISTING	—
(C)	26-4-100	30'	15'	310W	SV-1-T	MAS-4B	—	Ø6	B	W	EXISTING	EXISTING	Pacific Coast Hw
(D)	1-A	10'	—	—	TV-2-T	—	**SP-1-T	—	—	—	EXISTING	EXISTING	—
(E)	26-4-129	45'	15'	310W	SV-1-T	MAT(#5) MAS(#2)	**SP-1-T	—	—	—	EXISTING	EXISTING	Selva Road
(F)	1-A	10'	—	—	TV-1-T	—	—	Ø2	Ø3	B	E	N	—
(G)	17-2-129	20'	12'	310W	SV-2-TA	MAS-4B	**SP-1-T	Ø2	B	E	EXISTING	EXISTING	Pacific Coast Hw
(H)	1-A	10'	—	—	TV-2-T	—	**SP-1-T	Ø4	B	S	EXISTING	EXISTING	—



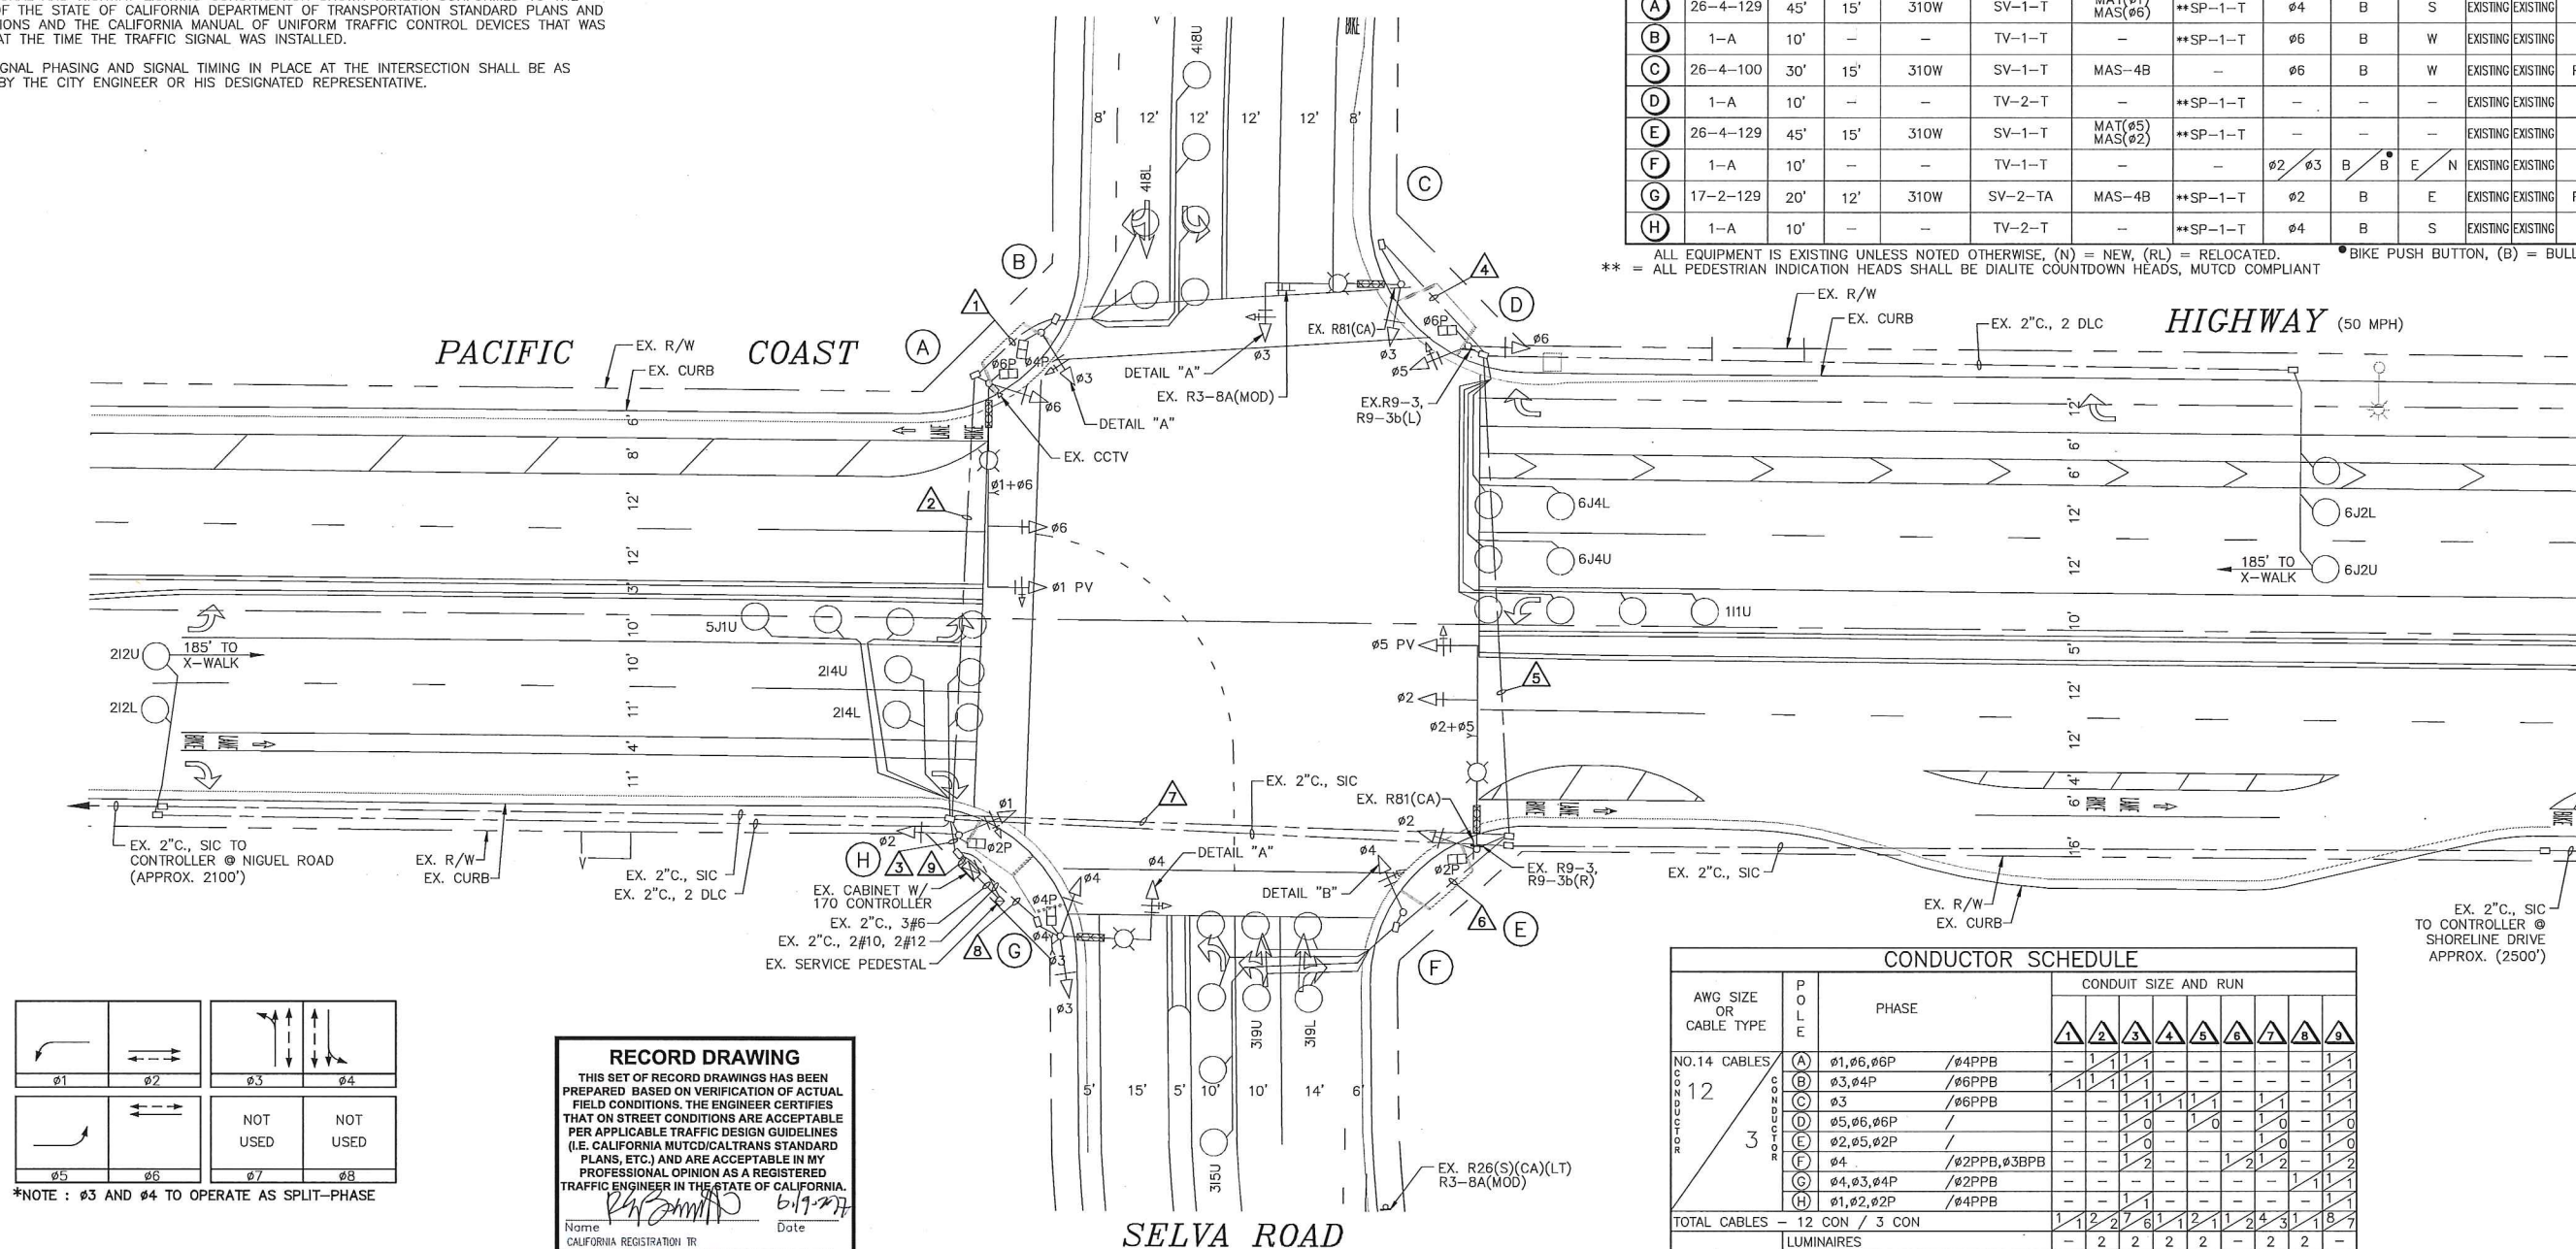


** = ALL PEDESTRIAN INDICATION HEADS SHALL BE DIALITE COUNTDOWN HEADS, MUTCD COMPLIANT



 
CONDUCTOR SCHEDULE																
AWG SIZE OR CABLE TYPE		P O L E	PHASE	CONDUIT SIZE AND RUN												
				1	2	3	4	5	6	7	8	9	10	11	12	13
NO.14 CABLES 12 3 CONDUCTOR	(A)	ø1,ø6,ø6P	/ø4PPB	—	1	1	1	—	—	—	—	—	—	—	—	1
	(B)	ø3,ø4P	/ø6PPB	1	1	1	1	—	—	—	—	—	—	—	—	1
	(C)	ø3	/ø6PPB	—	—	1	1	1	1	—	1	1	—	—	—	1
	(D)	ø5,ø6,ø6P	/	—	—	1	0	—	1	0	—	1	0	—	—	1
	(E)	ø2,ø5,ø2P	/	—	—	1	0	—	—	—	1	0	—	—	—	1
	(F)	ø4	/ø2PPB,ø3BPB	—	—	1	2	—	—	1	2	1	—	—	1	1
	(G)	ø4,ø3,ø4P	/ø2PPB	—	—	—	—	—	—	—	—	—	1	1	—	1
	(H)	ø1,ø2,ø2P	/ø4PPB	—	—	1	1	—	—	—	—	—	—	—	—	1
TOTAL CABLES — 12 CON / 3 CON				1	2	2	7	6	1	2	1	2	4	3	1	8
#10	LUMINAIRES			—	2	2	2	2	—	2	2	—	—	—	—	
	IISNS			—	2	2	2	2	—	2	2	—	—	—	—	
TYPE "B" DLC	TOTAL			—	4	4	4	4	—	4	4	—	—	—	—	
	ø1			—	—	1	—	1	—	1	—	—	—	—	1	
	ø2			—	—	4	—	—	—	—	—	—	—	—	4	
	ø3			—	—	3	—	—	3	3	—	—	—	—	3	
	ø4			2	2	2	—	—	—	—	—	—	—	—	2	
	ø5			—	—	1	—	—	—	—	—	—	—	—	1	
	ø6			—	—	4	—	4	—	4	—	—	—	—	4	
TOTAL				2	2	15	—	5	3	8	—	—	—	11		
SIC				—	—	2	—	—	—	—	—	—	—	—	2	
3M MODEL 138 EVP				—	1	2	—	—	—	1	1	3	—	—	—	
CCTV CABLE				—	1	1	—	—	—	—	—	—	—	—	1	
PERCENT FILL (%)				22%	21%	53%	10%	16%	11%	40%	7%	25%	—	—	—	
CONDUIT SIZES (INCHES)				2"	3"	4"	3"	3.5"	3"	3"	4"	2"	—	—	—	

ALL CONDUCTORS AND CONDUITS ARE EXISTING.
PPB = PED PUSH BUTTON. BPB = BIKE PUSH BUTTON

SCALE 1"=20'

R3-8A(MOD)	R9-3	R9-3b(R)	R9-3b(L)	R81(CA)
				

THIS SET OF RECORD DRAWINGS HAS BEEN
PREPARED BASED ON VERIFICATION OF ACTUAL
FIELD CONDITIONS. THE ENGINEER CERTIFIES
THAT ON STREET CONDITIONS ARE ACCEPTABLE
PER APPLICABLE TRAFFIC DESIGN GUIDELINES
(I.E. CALIFORNIA MUTCD/CALTRANS STANDARD
PLANS, ETC.) AND ARE ACCEPTABLE IN MY
PROFESSIONAL OPINION AS A REGISTERED
TRAFFIC ENGINEER IN THE STATE OF CALIFORNIA.

 6/17/2017

Name _____ Date _____

CALIFORNIA REGISTRATION TR _____

☐ R
☐ Y
☐ G
☒ GA

DETAIL "A"
12", 4-SECTION VEHICLE HEAD
NO SCALE

- ← RA
- ← YA
- ← GA

DETAIL "B"

12", 3-SECTION VEHICLE HEAD

NO SCALE

NO.	DATE	REVISIONS	APP. DATE

LINSCOTT, LAW & GREENSPAN, ENGINEERS
TRANSPORTATION PLANNING — TRAFFIC ENGINEERING — PARKING

■ 236 North Chester Avenue, Suite 200, Pasadena, CA 91106 (626) 796-2326
■ 1580 Corporate Drive, Suite 122, Costa Mesa, CA 92626 (714) 641-1580
■ 4542 Ruffner Street, Suite 100, San Diego, CA 92111 (606) 300-8000



THIS PLAN IS SIGNED BY THE CITY ENGINEER FOR SCOPE AND ADHERENCE TO CITY STANDARDS AND REQUIREMENTS, CITY CODES, AND OTHER GENERAL ENGINEERING AND REGULATORY REQUIREMENTS ONLY. THE CITY ENGINEER IS NOT RESPONSIBLE FOR DESIGN, ASSUMPTIONS, OR ACCURACY.



THE CITY OF DANA POINT
Public Works Department

SHEET 1
OF 1