


CONDUCTOR SCHEDULE										
AWG	CIRCUIT	1	2	3	4	5	6	7	8	9
#14	Ø1	-	-	-	-	-	-	3	3	3
	Ø2	-	-	-	3	3	3	3	3	3
	Ø4	-	-	-	-	-	3	3	3	3
	Ø5	3	3	3	3	3	3	3	6	6
	Ø6	-	-	-	-	-	-	3	3	3
	Ø8	-	3	3	-	-	-	-	3	3
	Ø2P	-	-	-	2	2	2	2	2	2
	Ø4P	-	-	2	-	-	2	2	4	4
	Ø6P	2	2	2	-	-	-	-	2	2
	Ø8P	-	2	2	-	2	2	2	4	4
	Ø2PPB	-	-	-	-	1	1	1	1	1
	Ø4PPB	-	-	-	-	-	1	1	1	1
#10	Ø6PPB	-	1	1	-	-	-	-	1	1
	Ø8PPB	1	1	1	1	1	1	1	2	2
	PPB COMMON	1	1	1	1	1	1	1	2	2
	SPARES	3	3	3	3	3	3	3	6	6
	TOTAL	10	16	18	13	19	21	25	47	47
TYPE "B" DLC	Ø1	1	1	1	-	-	-	-	1	1
	Ø2	-	-	-	-	-	-	3	3	3
	Ø4	-	-	1	-	-	-	-	1	1
	Ø5	-	-	-	-	-	-	1	1	1
	Ø6	3	3	3	-	-	-	-	3	3
SIC	Ø8	-	-	-	-	1	1	1	1	1
	TOTAL	4	4	5	-	1	1	5	10	10
CCTV	Ø1	1	1	1	-	-	-	-	1	2
	Ø2	-	-	-	-	-	-	-	1	1
	Ø4	-	-	-	-	-	-	-	1	1
	Ø5	-	-	-	-	-	-	-	1	1
	Ø6	3	3	3	-	-	-	-	3	3
EVP	Ø8	-	-	-	-	1	1	1	1	1
	TOTAL	4	4	5	-	1	1	5	10	10
CONDUIT SIZES (INCHES)	Ø1	2"	2"	2"	2"	2"	2"	2"	2-3"	2-3"
	Ø2	2"	2"	2"	2"	2"	2"	2"	2-3"	2-3"
	Ø4	2"	2"	2"	2"	2"	2"	2"	2-3"	2-3"
	Ø5	2"	2"	2"	2"	2"	2"	2"	2-3"	2-3"
	Ø6	2"	2"	2"	2"	2"	2"	2"	2-3"	2-3"


ALL CONDUCTORS AND CONDUITS ARE EXISTING.
PPB = PED PUSH BUTTON

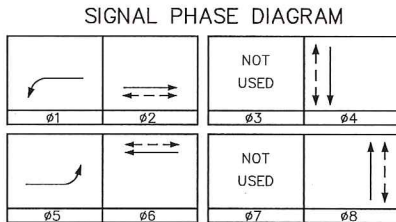


EQUIPMENT SCHEDULE													
SIGNAL STANDARD				H.P.S. LUMINAIRE SIZE/TYPE	MOUNTINGS			PEDESTRIAN PUSH BUTTON			POLE LOCATION		I.I.S.N.S.
LOCATION	POLE TYPE	MAST ARM			VEHICLE		PEDESTRIAN	PHASE	TYPE	QUAD	A	B	
		SIG.	LUM.		POLE	MAST ARM							
(A)	26-4-70	35'	15'	250W	SV-1-T SV-1-T	2-MAS F=17'	SP-1-T	Ø4	A	E	EXISTING	EXISTING	Palo Alto St
(B)	1-A	-	-	-	TV-1-T	-	SP-1-T	Ø6	A	S	EXISTING	EXISTING	-
(C)	17-2-70	20'	15'	250W	SV-1-T	MAS	SP-1-T	Ø6	A	S	EXISTING	EXISTING	Stonehill Dr
(D)	1-A	-	-	-	TV-1-T	-	SP-1-T	Ø8	A	W	EXISTING	EXISTING	-
(E)	24-4-70	35'	15'	250W	SV-1-T	2-MAS F=17'	SP-1-T	Ø8	A	W	EXISTING	EXISTING	Palo Alto St
(F)	1-A	-	-	-	TV-1-T	-	SP-1-T	Ø2	A	N	EXISTING	EXISTING	-
(G)	17-2-70	20'	15'	250W	SV-1-T	MAS	SP-1-T	Ø2	A	N	EXISTING	EXISTING	Stonehill Dr
(H)	1-A	-	-	-	TV-1-T	-	SP-1-T	Ø4	A	E	EXISTING	EXISTING	-

ALL EQUIPMENT IS EXISTING.
● = MOUNT AT 17' HEIGHT.

(A) = ANAODE PUSH BUTTON

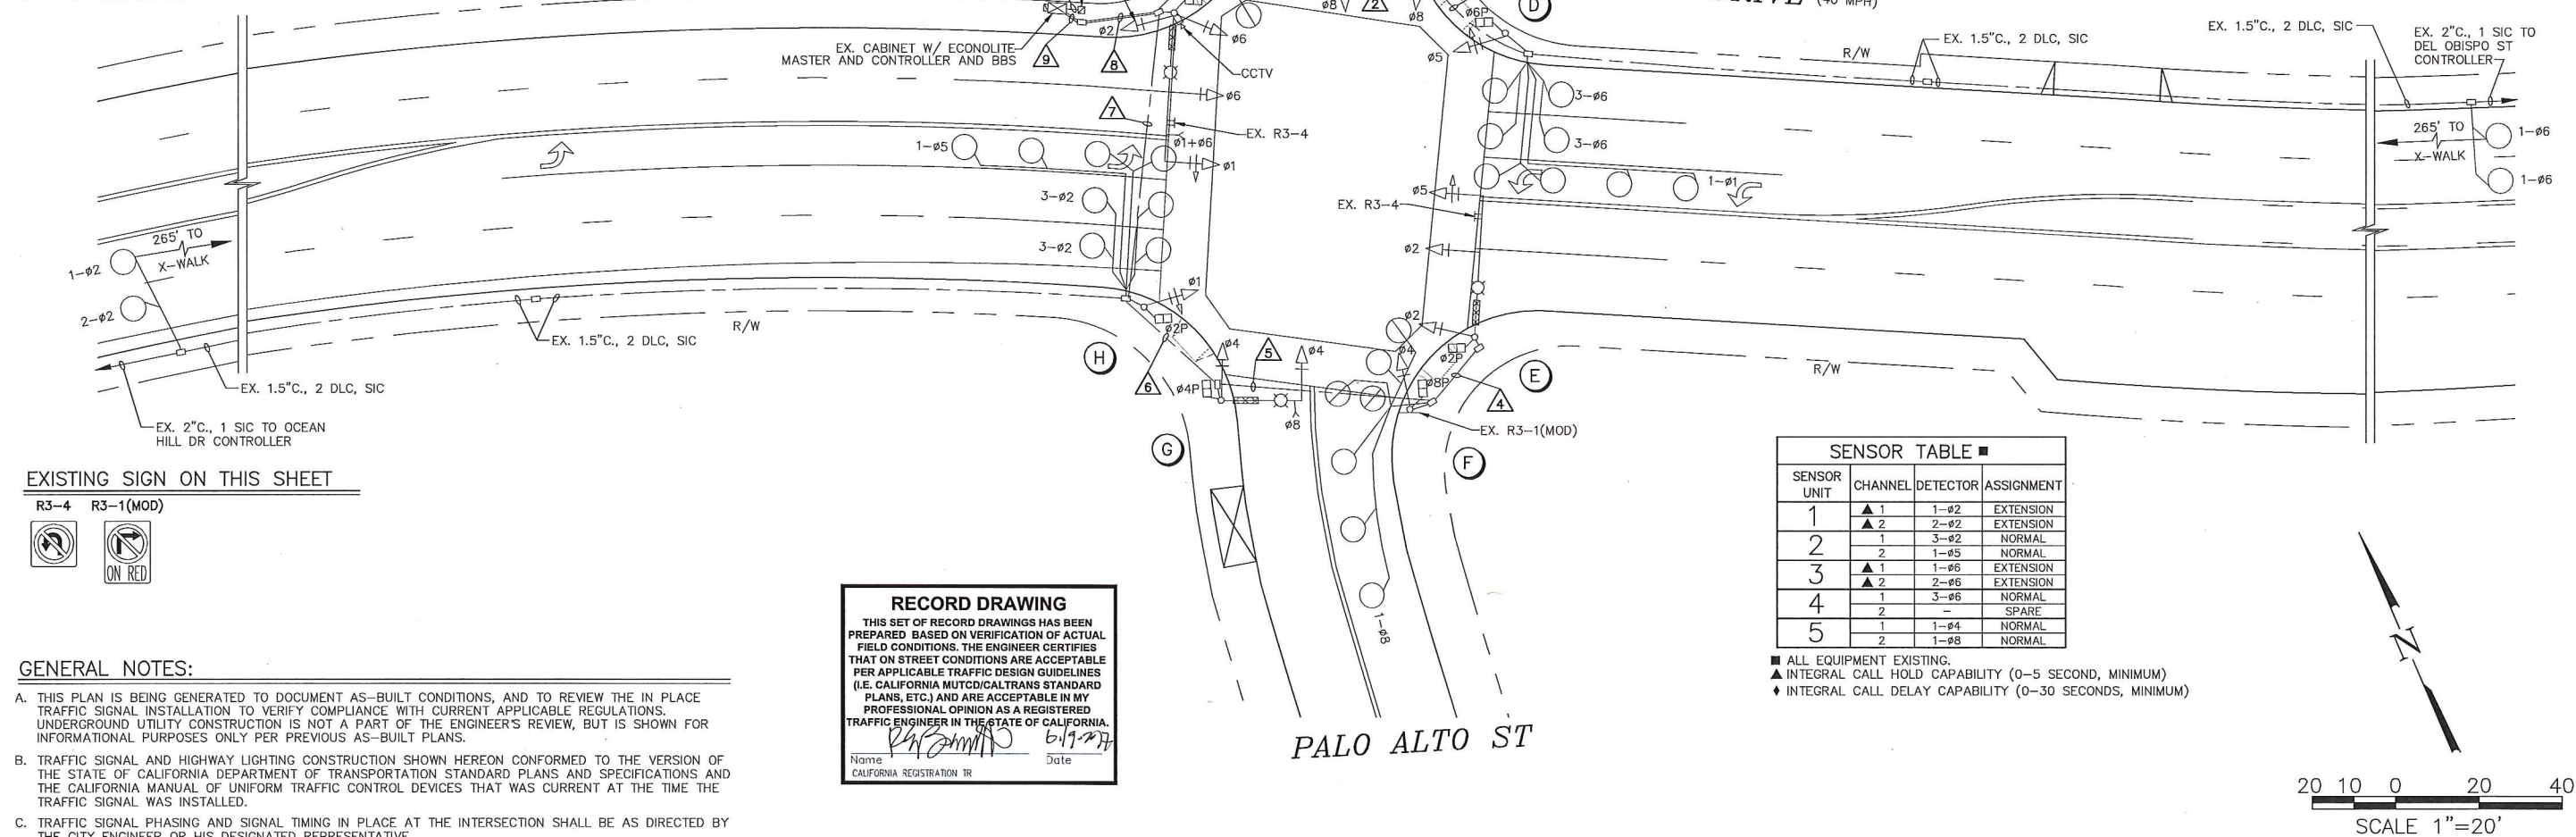

EXISTING SIGN ON THIS SHEET

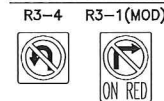

GENERAL NOTES:

- THIS PLAN IS BEING GENERATED TO DOCUMENT AS-BUILT CONDITIONS, AND TO REVIEW THE IN PLACE TRAFFIC SIGNAL INSTALLATION TO VERIFY COMPLIANCE WITH CURRENT APPLICABLE REGULATIONS. UNDERGROUND UTILITY CONSTRUCTION IS NOT A PART OF THE ENGINEER'S REVIEW, BUT IS SHOWN FOR INFORMATIONAL PURPOSES ONLY PER PREVIOUS AS-BUILT PLANS.
- TRAFFIC SIGNAL AND HIGHWAY LIGHTING CONSTRUCTION SHOWN HEREON CONFORMED TO THE VERSION OF THE STATE OF CALIFORNIA DEPARTMENT OF TRANSPORTATION STANDARD PLANS AND SPECIFICATIONS AND THE CALIFORNIA MANUAL OF UNIFORM TRAFFIC CONTROL DEVICES THAT WAS CURRENT AT THE TIME THE TRAFFIC SIGNAL WAS INSTALLED.
- TRAFFIC SIGNAL PHASING AND SIGNAL TIMING IN PLACE AT THE INTERSECTION SHALL BE AS DIRECTED BY THE CITY ENGINEER OR HIS DESIGNATED REPRESENTATIVE.

RECORD DRAWING

THIS SET OF RECORD DRAWINGS HAS BEEN PREPARED BASED ON VERIFICATION OF ACTUAL FIELD CONDITIONS. THE ENGINEER CERTIFIES THAT ON STREET CONDITIONS ARE ACCEPTABLE PER APPLICABLE TRAFFIC DESIGN GUIDELINES (I.E. CALIFORNIA MUTOCALTRANS STANDARD PLANS, ETC.) AND ARE ACCEPTABLE IN MY PROFESSIONAL OPINION AS A REGISTERED TRAFFIC ENGINEER IN THE STATE OF CALIFORNIA.

Name: *[Signature]* Date: *6/19/17*

CALIFORNIA REGISTRATION NO. *619239*

SENSOR TABLE			
SENSOR UNIT	CHANNEL	DETECTOR	ASSIGNMENT
1	▲ 1	1-Ø2	EXTENSION
2	▲ 2	2-Ø2	EXTENSION
3	1	3-Ø2	NORMAL
4	2	1-Ø5	NORMAL
5	▲ 1	1-Ø6	EXTENSION
	▲ 2	2-Ø6	EXTENSION
	1	3-Ø6	NORMAL
	2	1-Ø4	NORMAL
	1	1-Ø8	NORMAL
	2	1-Ø8	NORMAL

- ALL EQUIPMENT EXISTING.
▲ INTEGRAL CALL HOLD CAPABILITY (0-5 SECOND, MINIMUM)
◆ INTEGRAL CALL DELAY CAPABILITY (0-30 SECONDS, MINIMUM)

20 10 0 20 40
SCALE 1"=20'

NO.		DATE	REVISIONS	APP.	DATE
PLAN PREPARED BY:					
LINSCOTT, LAW & GREENSPAN, ENGINEERS TRANSPORTATION PLANNING - TRAFFIC ENGINEERING - PARKING 600 South Lake Avenue, Suite 500, Pasadena, Ca 91106 (626) 796-2322 2 Executive Circle, Suite 250, Irvine, Ca 92614 (949) 825-6175 4542 Ruffner Street, Suite 100, San Diego, Ca 92111 (619) 300-8800					
PLANS REVIEWED BY:					
CITY OF DANA POINT, PUBLIC WORKS & ENGINEERING SERVICES 33282 GOLDEN LANTERN DANA POINT, CA 92629 MATTHEW V. SINACORI, CITY ENGINEER RCE #59239 EXP. 06/30/17 DATE: <i>6/26/17</i>					
THIS PLAN IS SIGNED BY THE CITY ENGINEER FOR SCOPE AND ADHERENCE TO CITY STANDARDS AND REQUIREMENTS, CITY CODES, AND OTHER GENERAL ENGINEERING AND REGULATORY REQUIREMENTS ONLY. THE CITY ENGINEER IS NOT RESPONSIBLE FOR DESIGN, ASSUMPTIONS, OR ACCURACY.					
TRAFFIC SIGNAL PLAN STONEHILL DRIVE AT PALO ALTO STREET					
THE CITY OF DANA POINT Public Works Department					
PROJECT NO. 2-16-3741					
SHEET <i>1</i> OF <i>1</i>					