



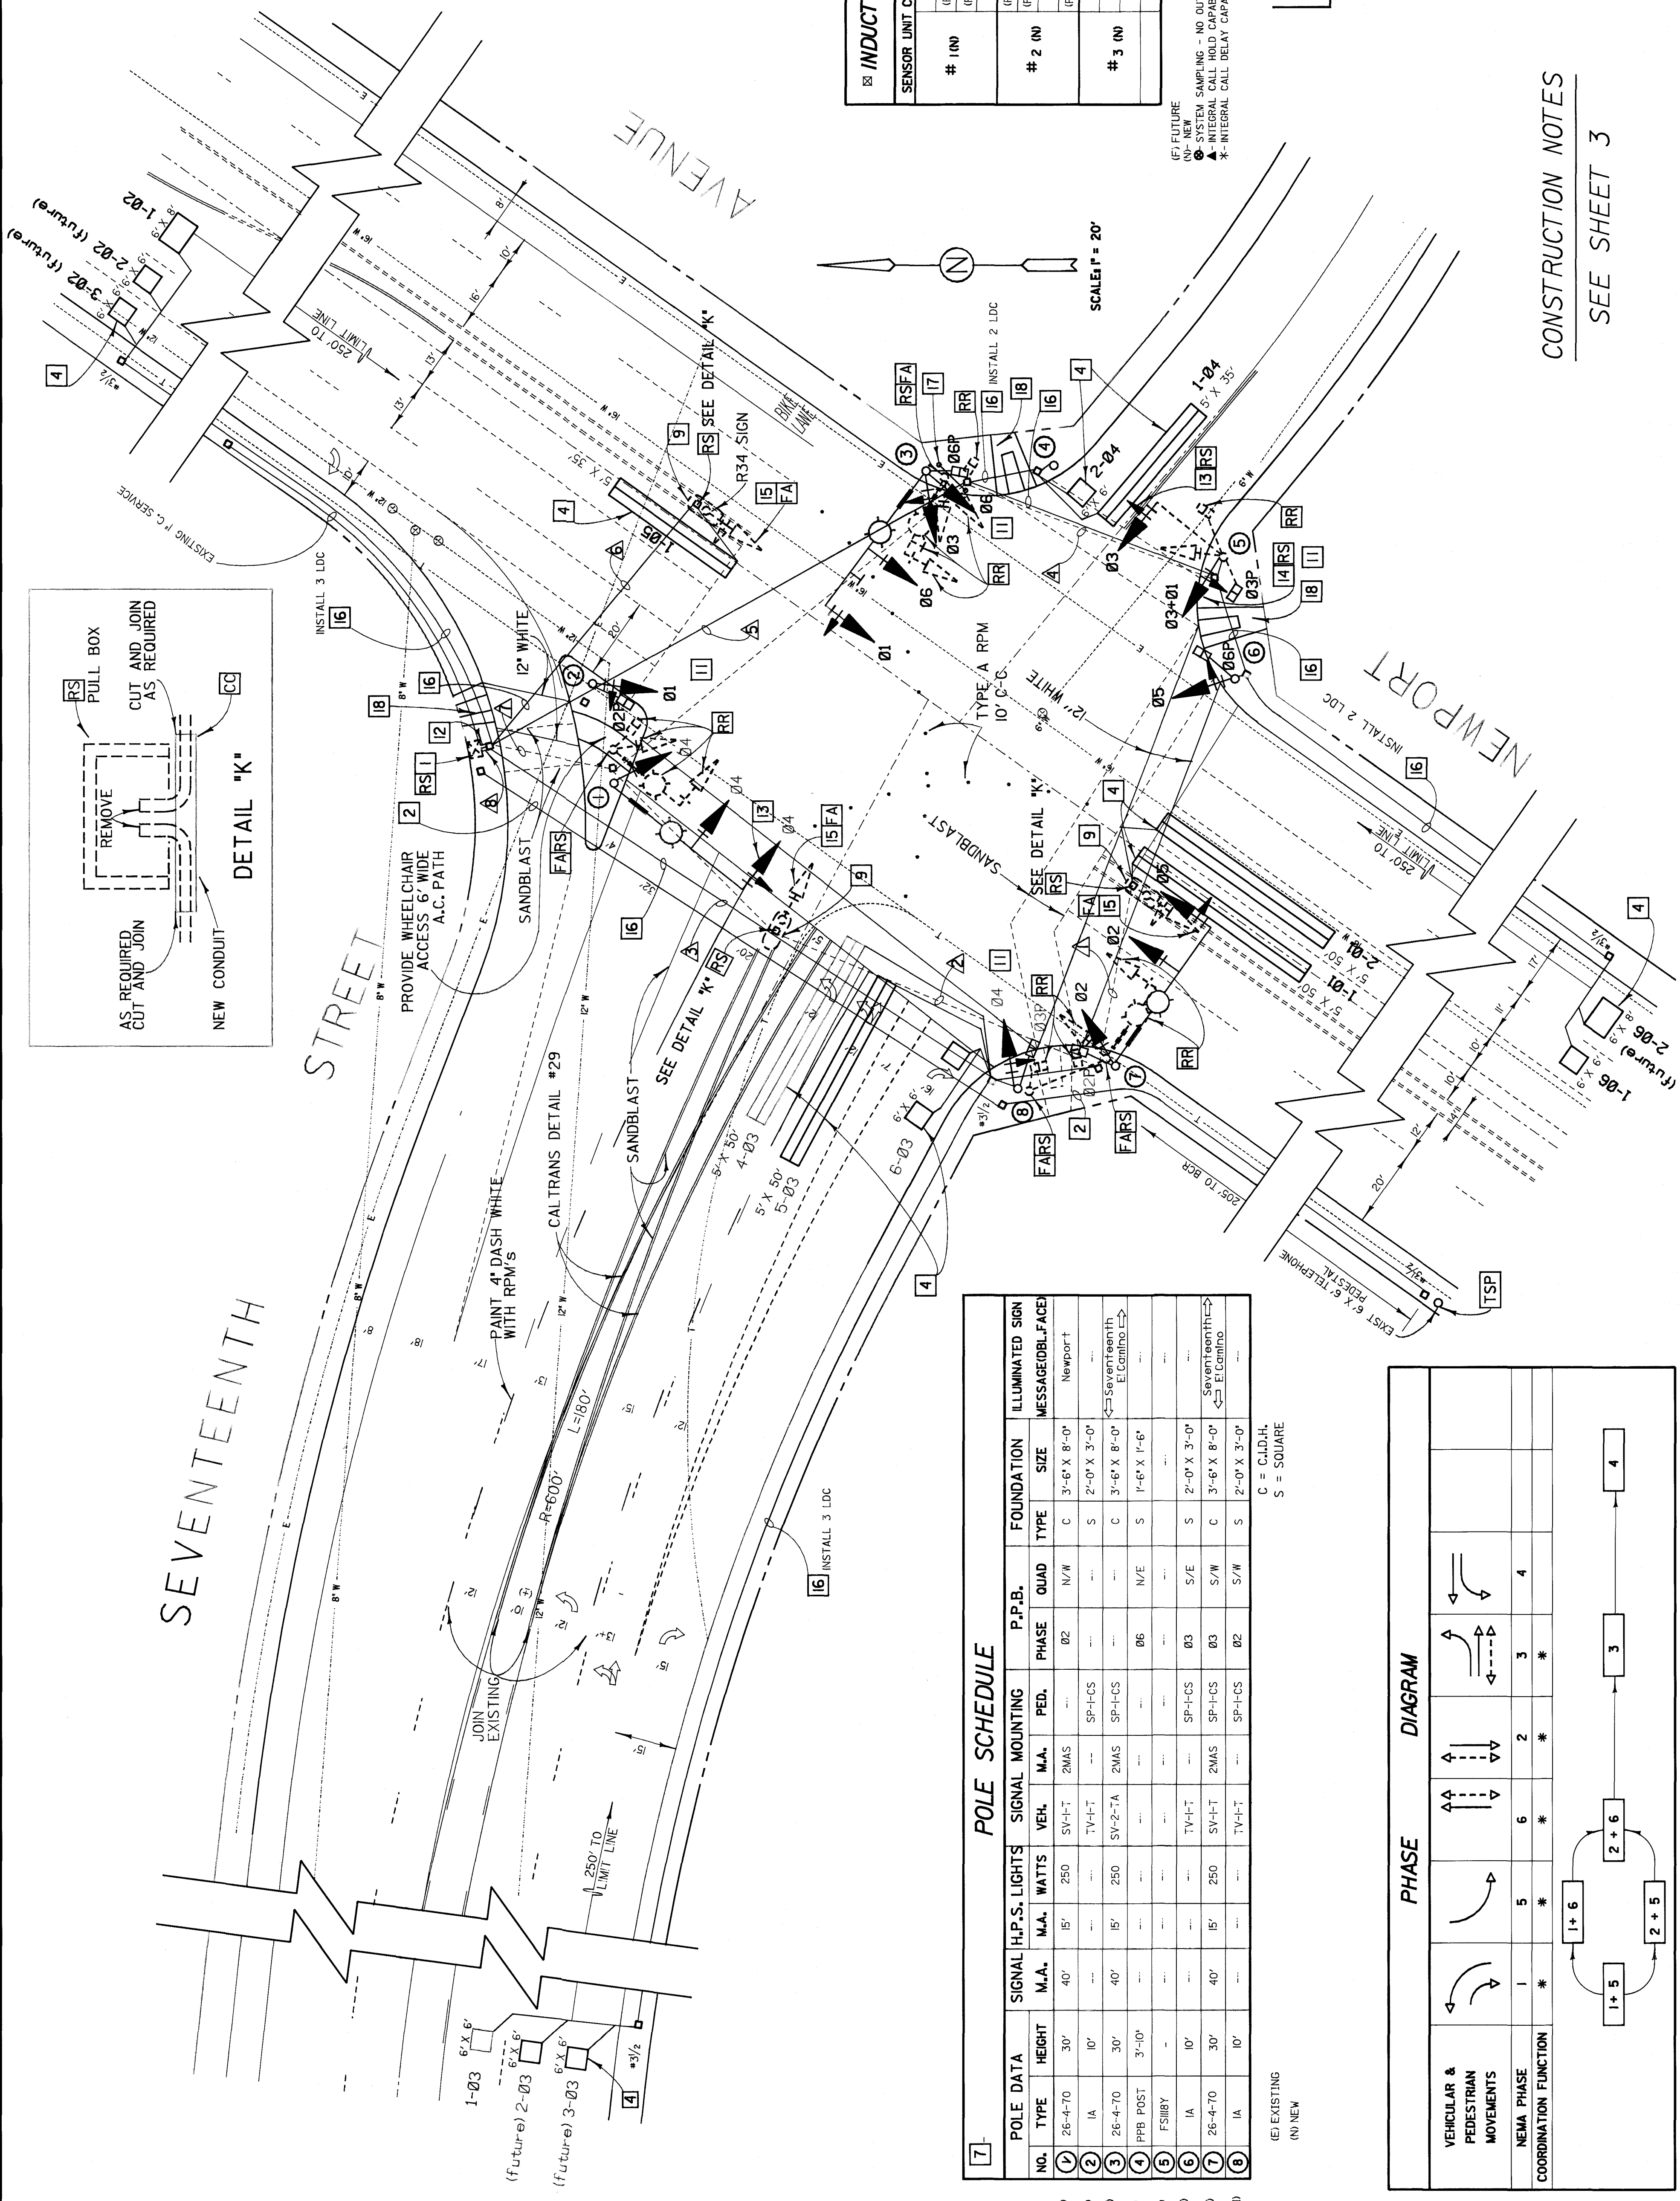

7

POLE SCHEDULE														
POLE DATA			SIGNAL		H.P.S. LIGHTS		SIGNAL MOUNTING			P.P.B.		FOUNDATION		ILLUMINATED SIGN MESSAGE/OBL.FACE
NO.	TYPE	HEIGHT	M.A.	M.A.	WATTS	VEH.	M.A.	PED.	PHASE	QUAD	TYPE	SIZE		
1	26-4-70	30'	40'	15'	250	SV-I-T	2MAS		02	N/W	C	3'-6" X 8'-0"	Newport	
2	1A	10'				TV-I-T		SP-I-CS			S	2'-0" X 3'-0"		
3	26-4-70	30'	40'	15'	250	SV-2-TA	2MAS	SP-I-CS			C	3'-6" X 8'-0"	Seventeenth ← E Camino →	
4	PRB POST	3'-10"							06	N/E	S	1'-6" X 1'-6"		
5	F Sility													
6	1A	10'				TV-I-T		SP-I-CS	03	S/E	S	2'-0" X 3'-0"	Seventeenth ← E Camino →	
7	26-4-70	30'	40'	15'	250	SV-I-T	2MAS	SP-I-CS	03	S/W	C	3'-6" X 8'-0"		
8	1A	10'				TV-I-T		SP-I-CS	02	S/W	S	2'-0" X 3'-0"		

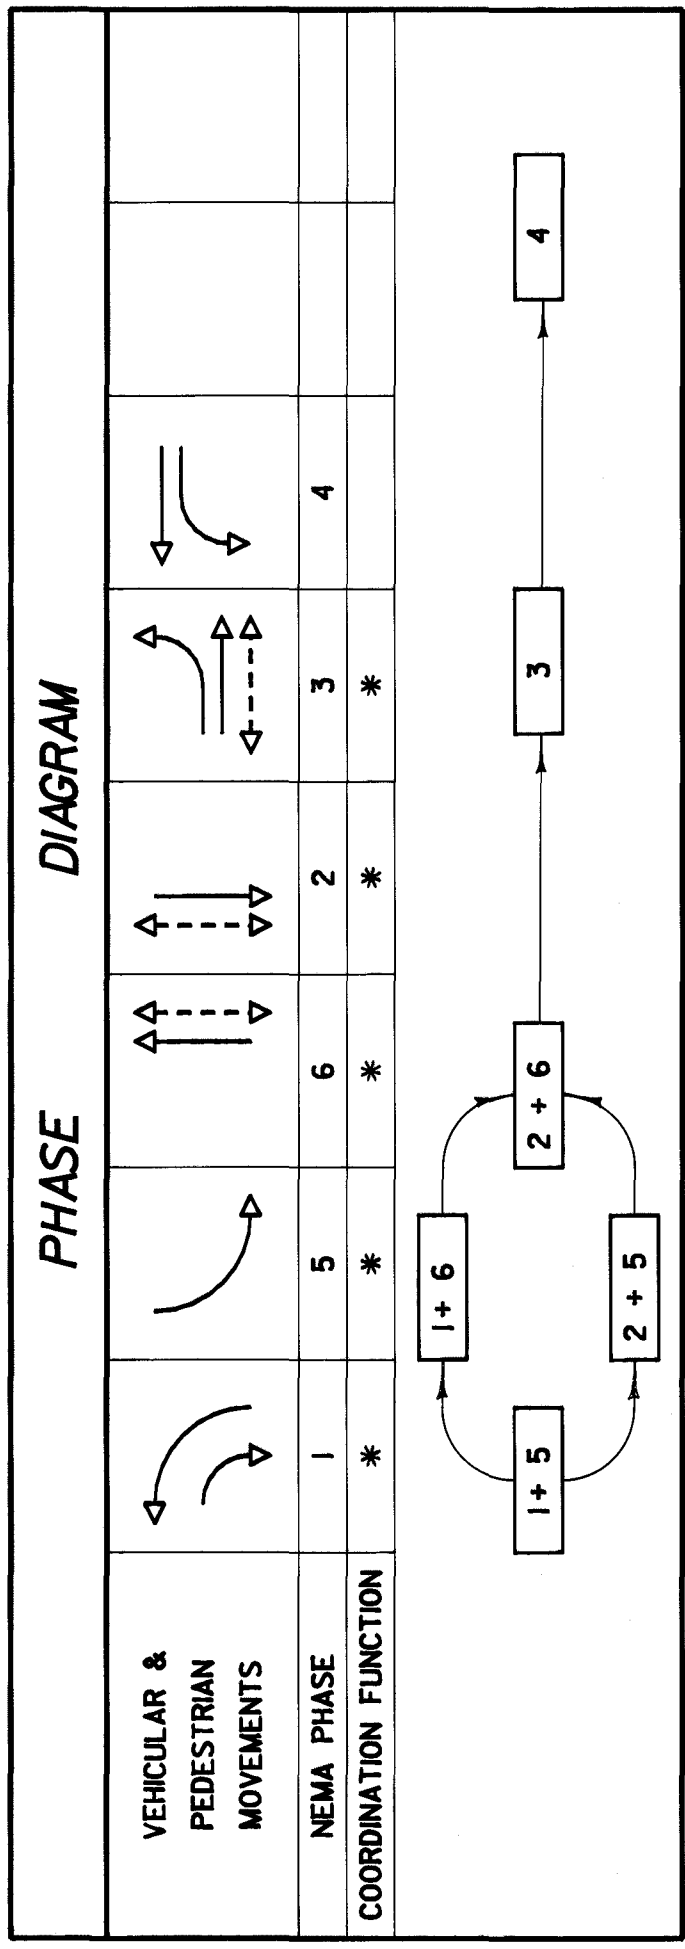

☒ INDUCTIVE LOOP DETECTOR SCHEDULE									
SENSOR UNIT CHANNEL DETECTOR				SENSOR UNIT CHANNEL DETECTOR				SENSOR UNIT CHANNEL DETECTOR	
# 1 (N)	1	①	1-02	# 4 (N)	1	4-03	# 5 (N)	1	▲ 1-02
	(F) 2	②	2-02		2	SPARE		(F) 2	▲ 2-02
	(F) 3	③	3-02		3	2-01		(F) 1	▲ 3-02
	4	④	1-03		4	1-05		2	1-03
# 2 (N)	(F) 1	①	2-03	# 6 (N)	1	▲ 1-02	# 7 (N)	1	▲ 2-03
	(F) 2	②	3-03		(F) 2	▲ 2-02		(F) 2	▲ 3-03
	3	③	1-06		(F) 1	▲ 3-03		2	1-03
	(F) 4	④	2-06		(F) 1	▲ 2-03		2	▲ 3-03
# 3 (N)	1	1-04	# 8 (N)	# 9 (N)	(F) 1	▲ 1-06	2	▲ 2-06	
	2	5-03			(F) 2	▲ 3-03			
	3	6-03			(F) 2	▲ 2-06			
	4	1-01			1	※			
								2	SPARE

E SAMPING INC. - NO. OUTPUT TO PHASE

[illegible]

(F) FUTURE
(N) NEW
⊗ - SYSTEM SAMPLING - NO OUTPUT TO PHASE.
▲ - INTEGRAL CALL HOLD CAPABILITY (0-5 SEC. MIN.)
✱ - INTEGRAL CALL DELAY CAPABILITY (0-30 SEC. MIN.)

LOCATION "F"

3 inches on original drawing

CONSTRUCTION NOTES
SEE SHEET 3

		ORANGE COUNTY ENVIRONMENTAL MANAGEMENT AGENCY	
		SEVENTEENTH STREET AND NEWPORT AVENUE	
		SIGNAL MODIFICATION PLAN	
DATE	DATE	PREPARED UNDER SUPERVISION OF	SHEET 1 / 8 OF 8
		DATE	DATE
		SCALE AS SHOWN	N. G. NO. N. G. P. 25 (E3)
		12/10/86 25317 11/1/86	
		R. SCHROEDER MANSFIELD/BLANCHARD DESIGNED CHECKED M. YAMADA	
		R E V I S I O N S	