


```

graph LR
    A[A] --> B[B]
    B[B] --> C[C]
    C[C] --> B[B]
  
```

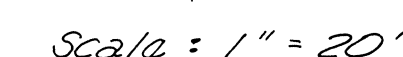

● = New conductors shall be used throughout. Salvage existing conductors & deliver to County Yard.

SENSOR UNIT	CHANNEL	DETECTOR
#1	1	1-B
	2	2-B
	3	1-C

(E) - Existing
(M) - Modify
(N) - New
(R) - Relocate

* See Detail #4,
Sheet 6 of 6

**6' SIGN PER DETAIL NO. 1 SHEET 6 OF 6

1. FOR GENERAL NOTES SEE SHEET 6 OF 6 .
2. INSTALL COUNTY FURNISHED TYPE 26 CONTROLLER & CABINET OR EQUIVALENT. MODIFY CABINET & CONTROLLER TO PROVIDE ACTUATED PHASES AS SHOWN.
RELOCATE EXISTING RADIO EQUIPMENT TO NEW CABINET. (SEE SPECIAL PROVISIONS).
3. INSTALL PEDESTRIAN FENCE PER DETAIL # 6, SHEET 6 OF 6.
4. CONSTRUCT SIDEWALK ACCESS RAMP PER ORANGE COUNTY STANDARD PLAN # III AND ACCESS RAMP DETAIL ON SHEET 4.
5. PAINT TRAFFIC STRIPE
6. REMOVE TRAFFIC STRIPE - 1/2" CROSSWALK (135' L.F.)

TRAFFIC SIGNAL MODIFICATION PLAN
SEVENTEENTH ST. @ HOLT AVE.

PREPARED UNDER THE SUPERVISION OF
Hilbert William Dickson DATE 1-4-77
HILBERT WILLIAM DICKSON R.C.E. No. 19417

TRAFFIC ENGINEERING
CONSULTANTS

 **Herman
Kimmel and Associates, Inc.**
4242 CAMPUS DRIVE, SUITE 104, HUNTING BEACH, CALIF. 92656
(714) 546-0915

8/8/78	N.S.J.	REVISED PAGE 3 FROM A TYPE 19 WITH 6'26" M.A. TO 5 TYPE 19 WITH 6'30" M.A.	5/11/78	APPROVED	TRAFFIC SIGNAL MODIFICATION PLAN SEVENTEENTH ST. @ HOLT AVE.
				Robert W. Voien	
				RCE 12169	
				DATE 1-24-77	
DATE	BY	DESCRIPTION	APP'D.	DESIGNED J.P. Grimm	DRAWN E & G
		REVISIONS		CHECKED J.P. Grimm	DATE MAR 76
					ORANGE COUNTY E.M.A.
					SHEET 3 OF 6