


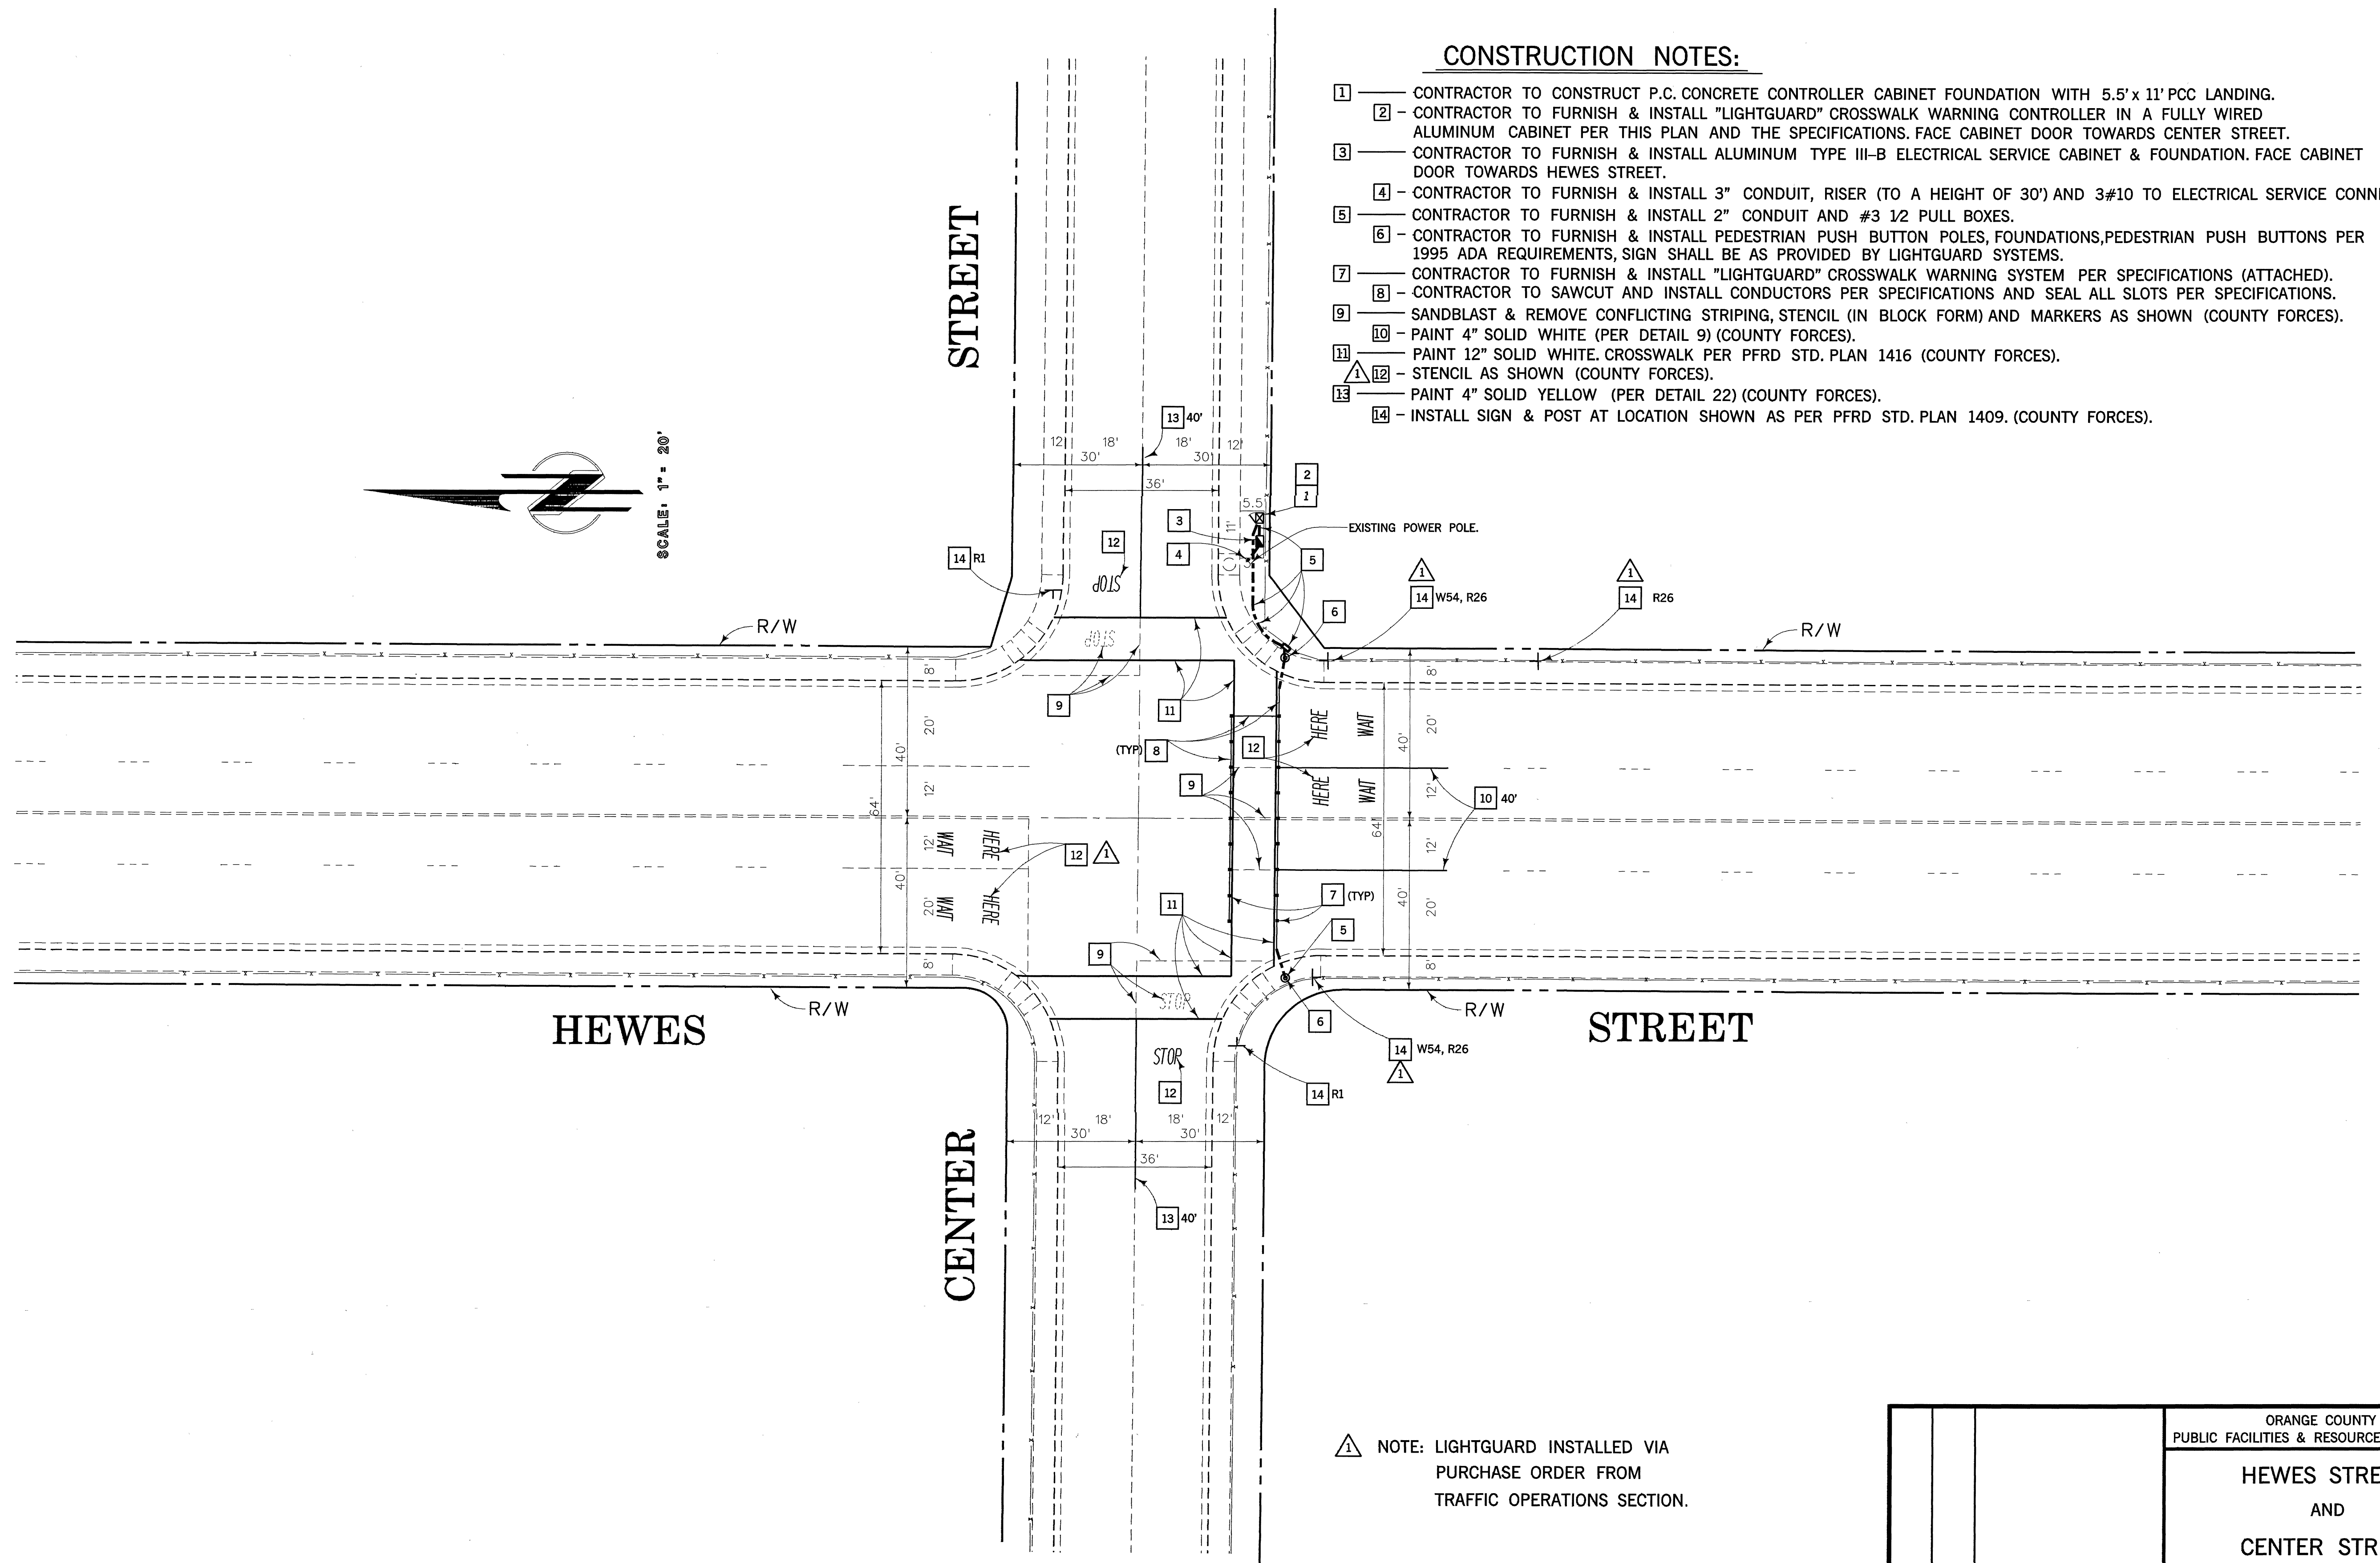

1 1/2 0 1 2
3 inches on original drawing

ORANGE COUNTY PUBLIC FACILITIES & RESOURCES DEPARTMENT			
HEWES STREET AND CENTER STREET			
INSTALLATION OF LIGHTGUARD CROSSWALK WARNING SYSTEM			
1/1/00	AS-BUILT	PREPARED UNDER	SHEET
MARK	DATE	DESCRIPTION	1
REVISIONS			
DESIGNED	T. PHAM	SCALE	DATE
DRAWN	T. PHAM	CHECKED	L. ABAD/M. DIAZ
AS SHOWN	JUNE 99	W. O. NO.	OF 1