
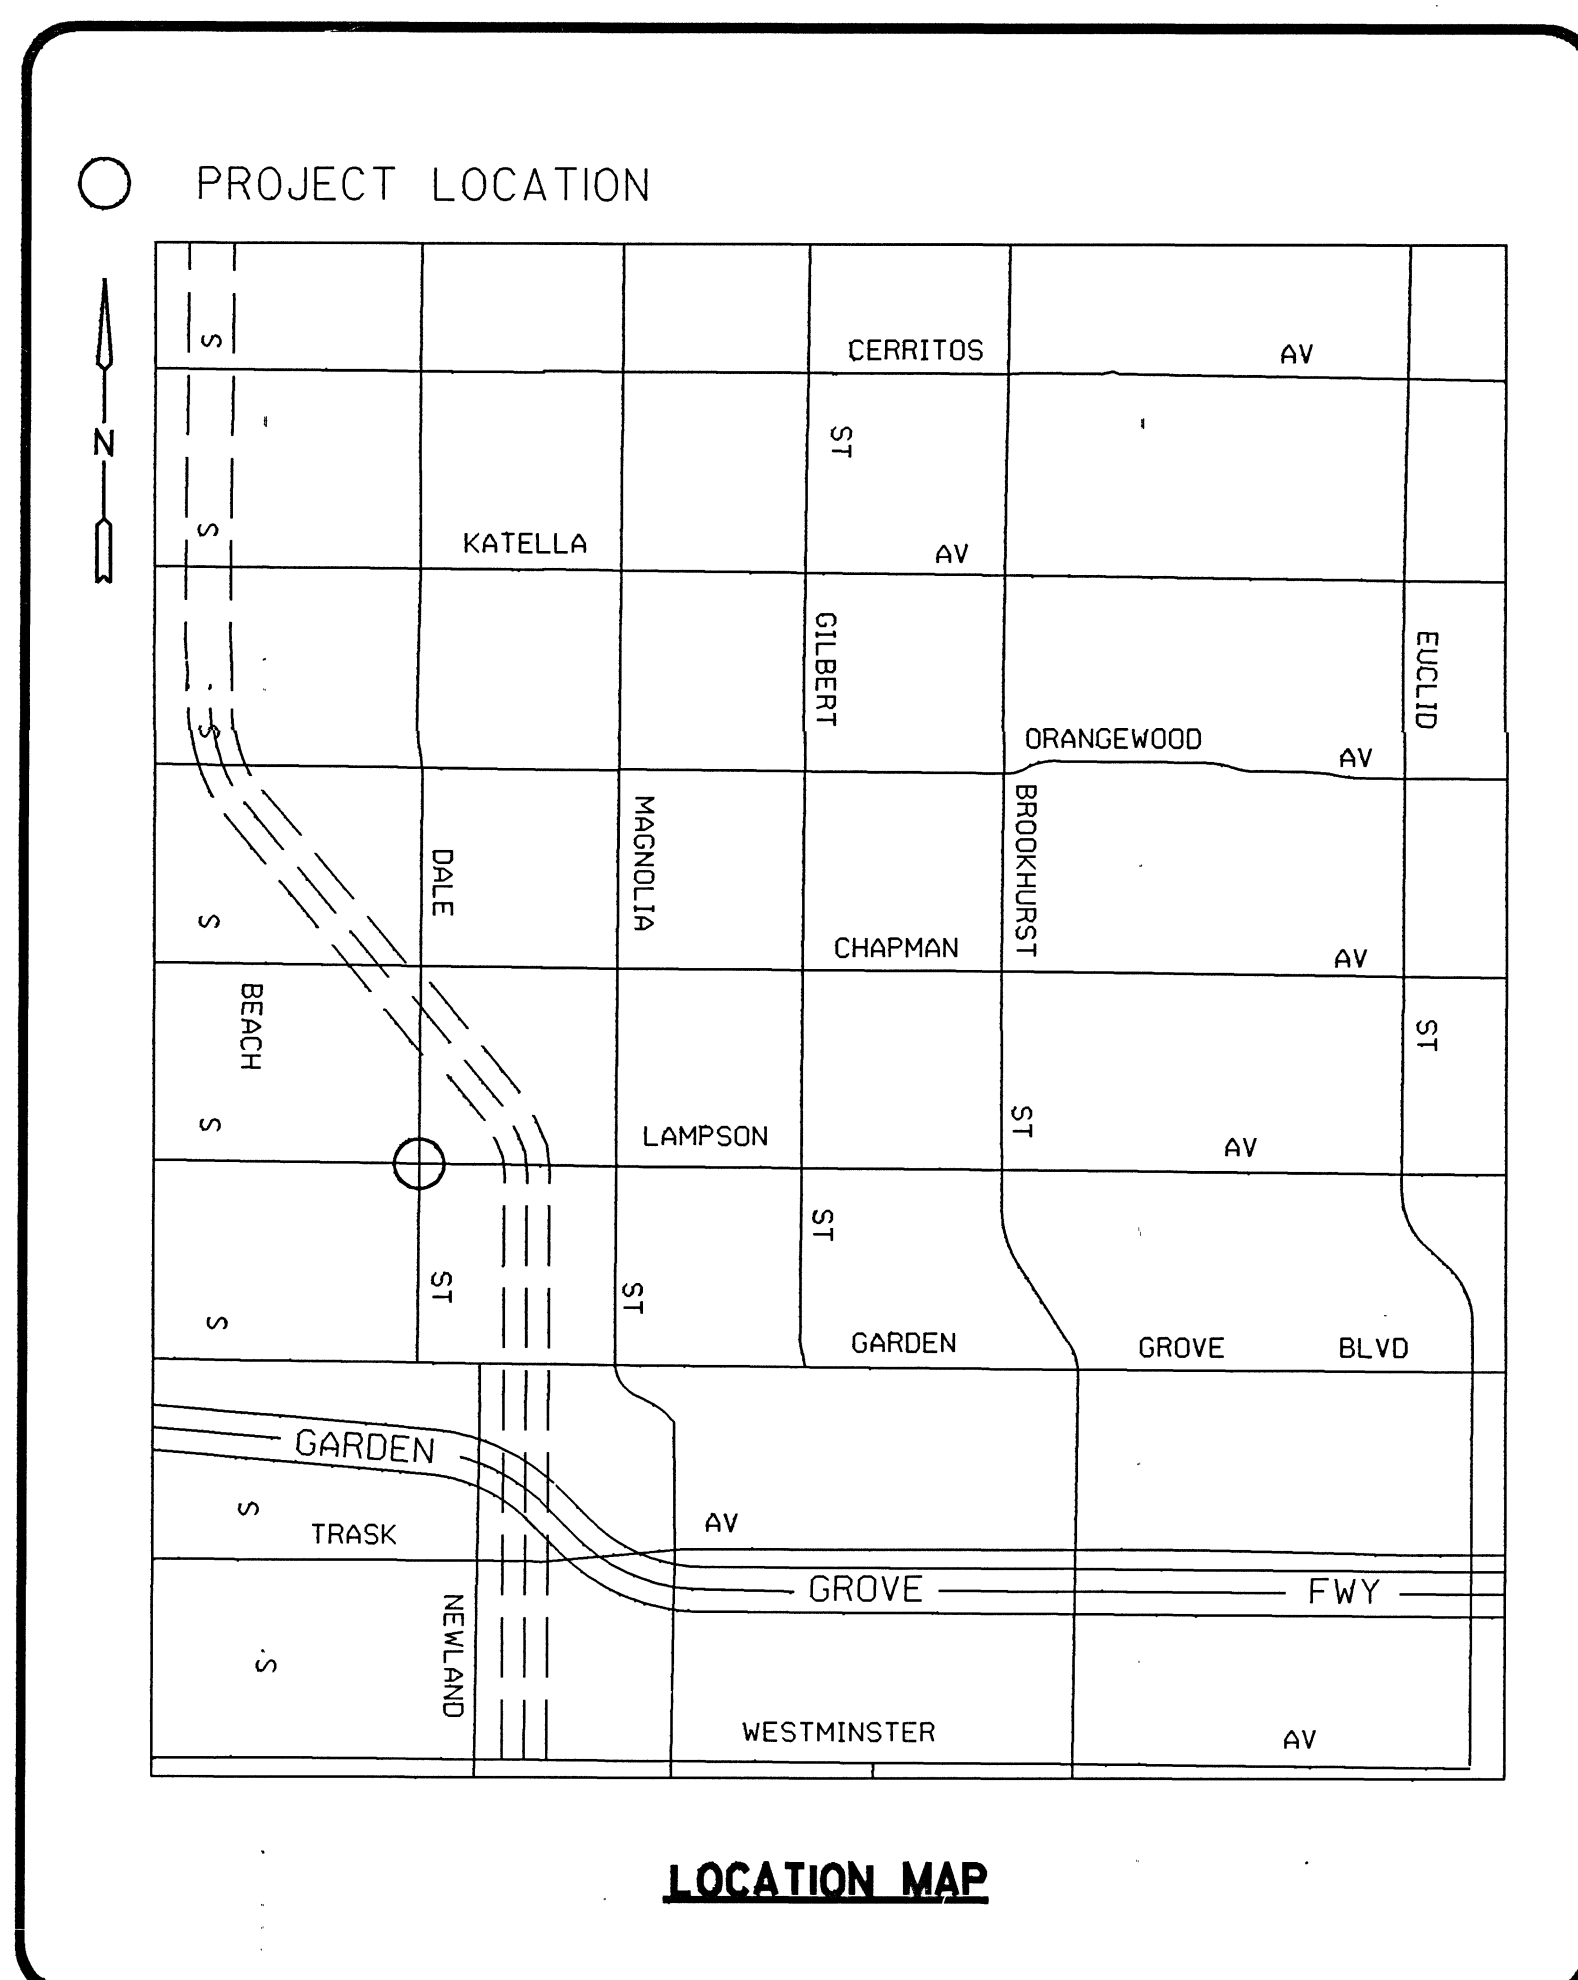


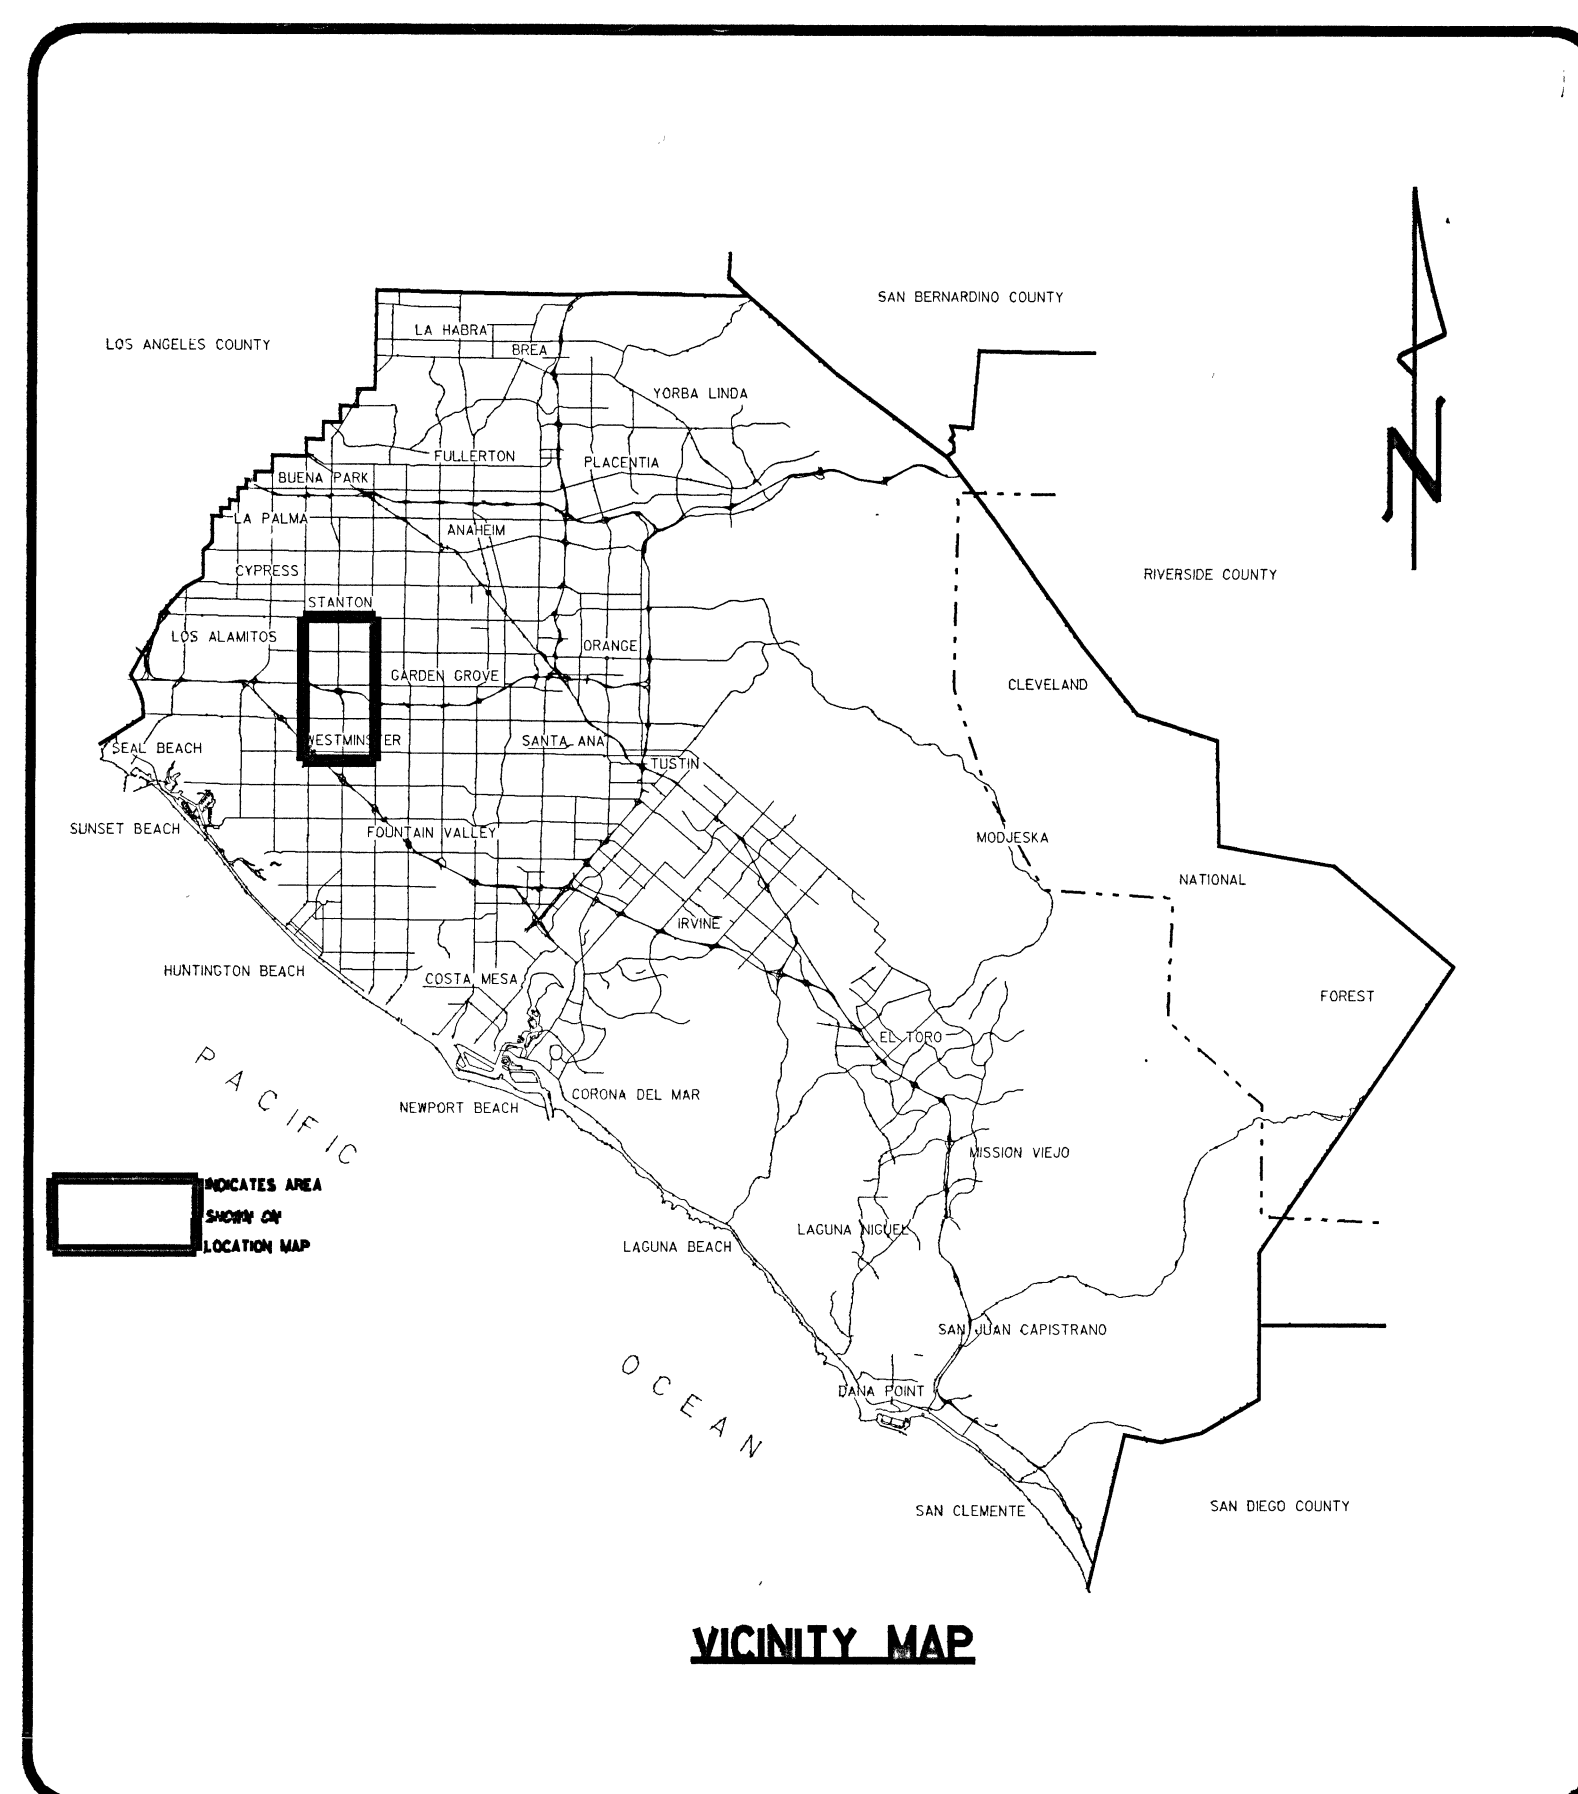

ORANGE COUNTY
ENVIRONMENTAL MANAGEMENT AGENCY

SANTA ANA, CALIFORNIA
M. RUANE, DIRECTOR

PLANS FOR CONSTRUCTION OF TRAFFIC SIGNAL AT

LAMPSON AVENUE @ DALE STREET

JUNE, 1990

FUNDED BY: O.C.D.A.

CITY OF GARDEN GROVE

APPROVED: Frank E. Ballard 6-14-90
CE 21265 DATE

E M A - T R A N S P O R T A T I O N

REGISTERED PROFESSIONAL ENGINEER
 ILLINOIS ENGINEERING BOARD
 No. 35217
 CIVIL
 STATE OF ILLINOIS (91)
 R.T. (91-91)

SUBMITTED: *[Signature]*
 TRAFFIC ENGINEER
 I. G. OCHOA

6/14/90
 DATE

RECOMMENDED: *[Signature]*
 PROGRAM MANAGER
 STEVE M. HOGAN

6/14/90
 DATE

APPROVED: *[Signature]*
 DIRECTOR OF TRANSPORTATION
 KEN R. SMITH

6/20/90
 DATE

<u>INDEX OF SHEETS</u>	
SHEET	DESCRIPTION
1.	TITLE SHEET.
2.	LAMPSON AVENUE @ DALE STREET SIGNAL PLAN.
3.	DETAIL SHEET.

UTILITY OWNER	PHONE NO.	CONTACT
SO CALIFORNIA GAS COMPANY	JOE MORENO	(714) 634-3115
SO CALIFORNIA EDISON CO	PLANNING MGR	(714) 973-5628
PACIFIC BELL	JACK STEWART	(714) 666-5657
SO CA GAS CO - TRANSMISSION	BARRIE OLSEN	(213) 689-7263
GARDEN GROVE WATER DEPT	MIKE MARTIN	(714) 638-6871
GARDEN GROVE SANITARY DIST.	RON CATES	(714) 534-3943
WEST ORANGE CO WATER BOARD	RAY WOODSIDE	(714) 979-5240
USA		1-800-422-4133

BENCH MARK:


BASIS OF BEARINGS:

[illegible]

W. O. NO. D89240

SHEET 1 OF 3

**ALAMITOS
INTERMEDIATE
SCHOOL**

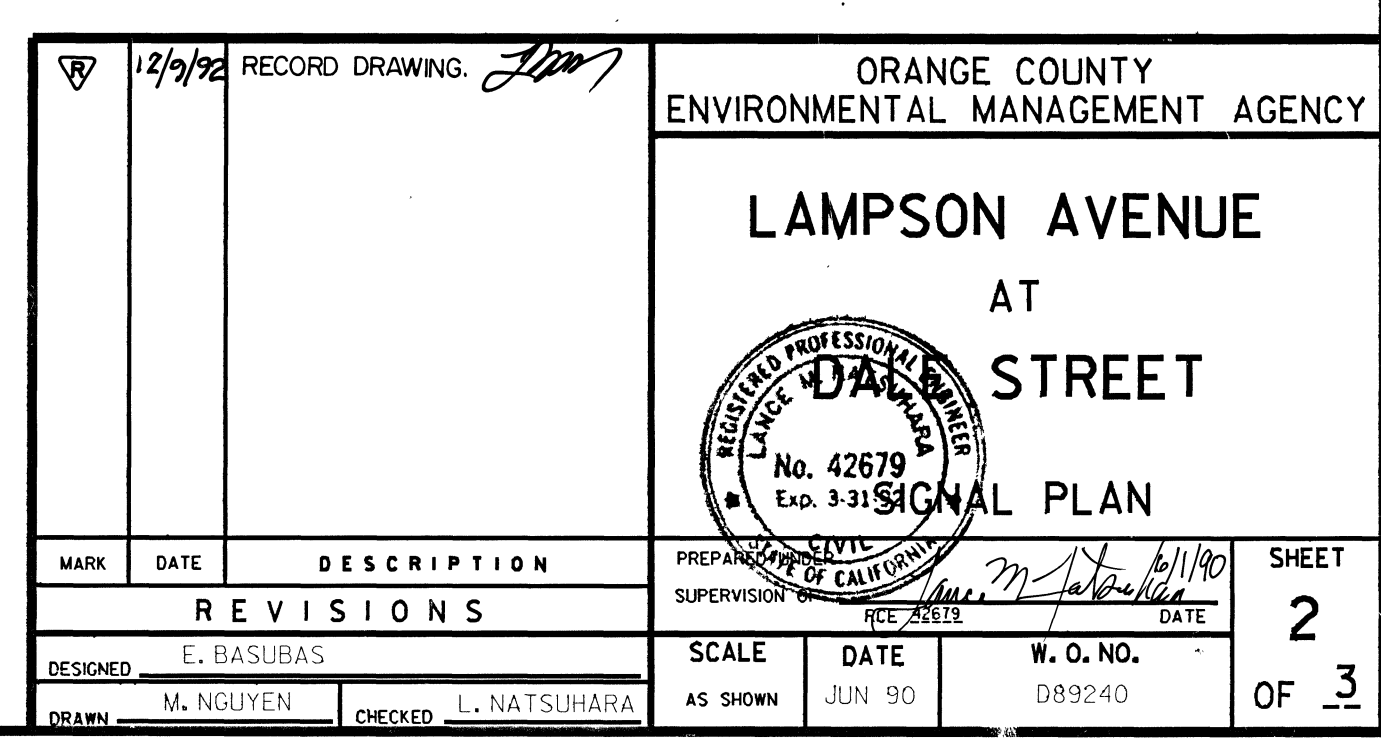

  	3-29-88	ADDED NOTE 17.	ORANGE COUNTY ENVIRONMENTAL MANAGEMENT AGENCY
	4-4-88	DELETED TYPE 11 SERVICE.	
	12-8-88	ADDED INTERCONNECT SPLICE CABINET. MODIFIED INTERCONNECT SPLICE CABINET.	
			DETAIL SHEET
MARK	DATE	DESCRIPTION	
REVISIONS			
DESIGNED	E. BASUBAS		PREPARED BY: J. L. HARRIS SUPERVISOR: J. L. HARRIS DATE: 12/1/90 SCALE: AS SHOWN DATE: JUNE 90 W. O. NO. D89240
DRAWN	M. NGUYEN		
CHECKED	L. NATSUHARA		
SHEET 3 OF 3			