


**CRAWFORD CANYON
ROAD**


NEWPORT

- 1 — CONSTRUCT P.C. CONCRETE TYPE "B" CONTROLLER CABINET FOUNDATION.
- 2 — FURNISH & INSTALL TRAFFIC CONTROLLER IN TYPE "B" ALUMINUM CABINET, PER THIS PLAN AND THE SPECIAL PROVISIONS.
- 3 — FURNISH & INSTALL TYPE III SERVICE & FOUNDATION.
- 4 — FURNISH & INSTALL 2" CONDUIT, NO. 5 PULL BOXES, AND CONDUCTOR FOR ELECTRICAL SERVICE CONNECTION.
- 5 — FURNISH & INSTALL PEDESTRIAN BARRICADE WITH R96 & R96A PER CALIF. STD. PLAN ES-6A.
- 6 — FURNISH & INSTALL TYPE 9 FLASHER SYSTEM & W41 SIGN AT 500' ADVANCE OF INTERSECTION.
- 7 — CONTRACTOR SHALL MAINTAIN & OPERATE EXISTING SIGNAL & FLASHER SYSTEMS UNTIL NEW SYSTEMS ARE ENERGIZED. CONTRACTOR SHALL REMOVE & SALVAGE EXISTING SYSTEM COMPLETE & DELIVER TO FRUIT STREET YARD.
- 8 — FURNISH & INSTALL 2" C. #5 PULLBOX ON 200' C-C, AND 6 PAIR #22 REA-PE 22 CABLE TO POLE 2211513E FOR TELEPHONE SERVICE APPROXIMATELY 850' N/O C. INTERSECTION.
- 9 — FURNISH & INSTALL TELEPHONE DROP.
- 10 — PAINT 8" SOLID WHITE.
- 11 — PAINT 12" SOLID WHITE.
- 12 — FURNISH & INSTALL R61 SIGN & POST.
- 13 — FURNISH & INSTALL R34-2 SIGN ON THE MAST ARM.
- 14 — FURNISH & INSTALL R73-3 SIGN ON THE MAST ARM.

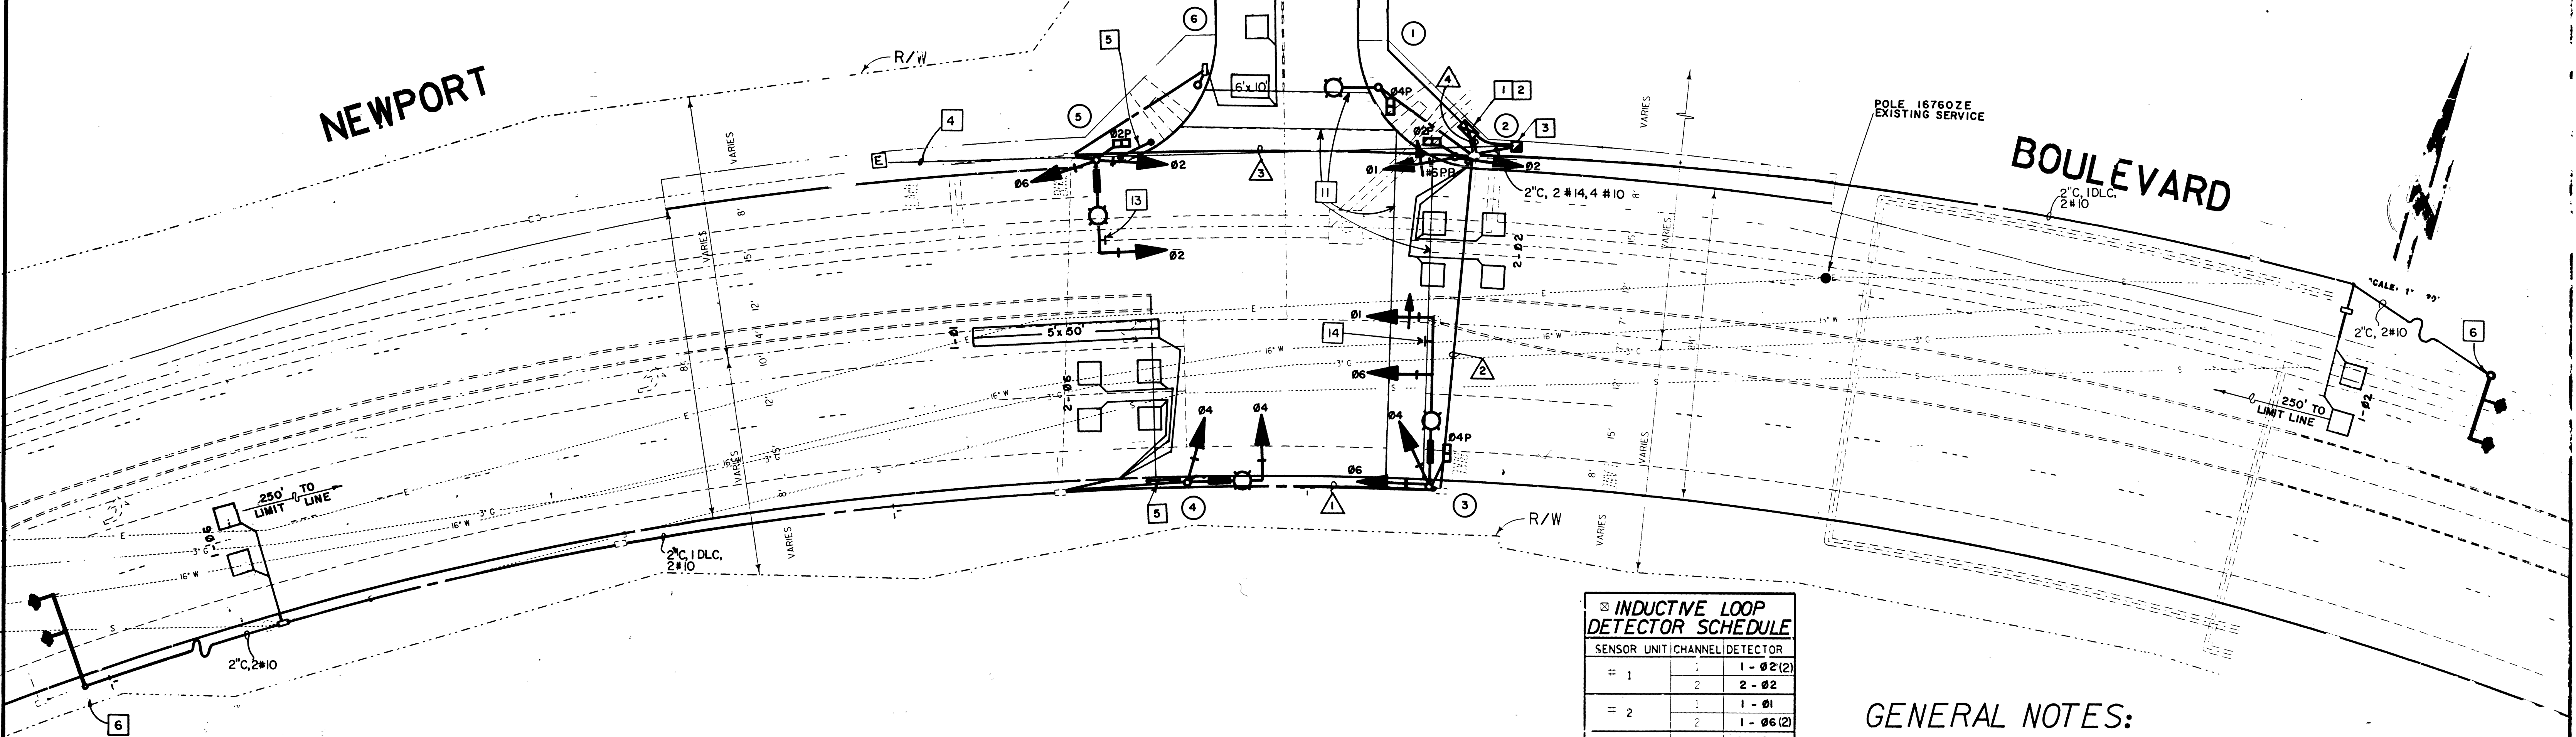


GENERAL NOTES:

SEE DETAIL SHEET--

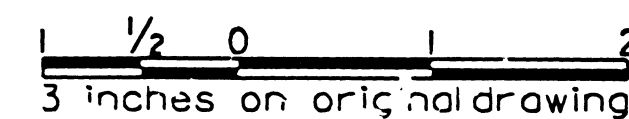


* - WITH GLARE SHEILDS

C = C.I.D.H. ☒ SINGLE FACE
S = SQUARE

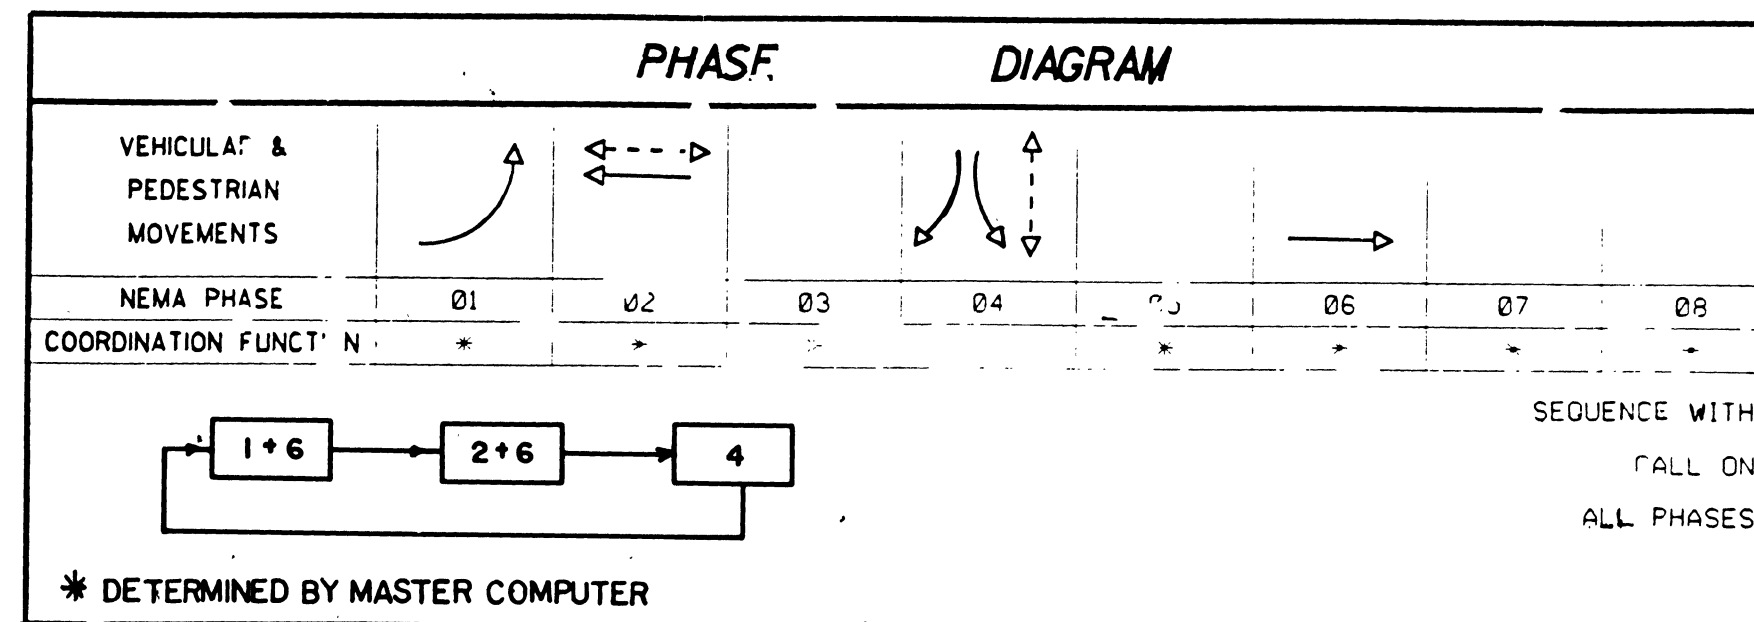

DUPLICATE

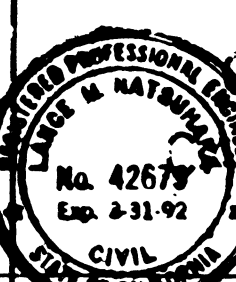		GRANGE COUNTY ENVIRONMENTAL MANAGEMENT AGENCY NEWPORT BOULEVARD AT CRAWFORD YON ROAD SIGNAL PLAN		SHEET SI OF 44
				
MARK	DATE	DESCRIPTION		
REVISIONS				
DESIGNED	BY		SCALE	
DRAWN	CHECKED		DATE	
M. NGUYEN		C. N. NUYEN	AUG 89	W. O. NO.
			SHOWN	ROBEY

☒ DETECTOR LOOP LOCATIONS SHALL BE APPROVED BY ENGINEER IN FIELD PRIOR TO INSTALLATION.