


\\\\reserver2\\home\\PhamT\\Microstation\\cad fiber\\cable\\17-21-FO-Hewes & Foothill.dgn 5/6/2014 9:45 AM

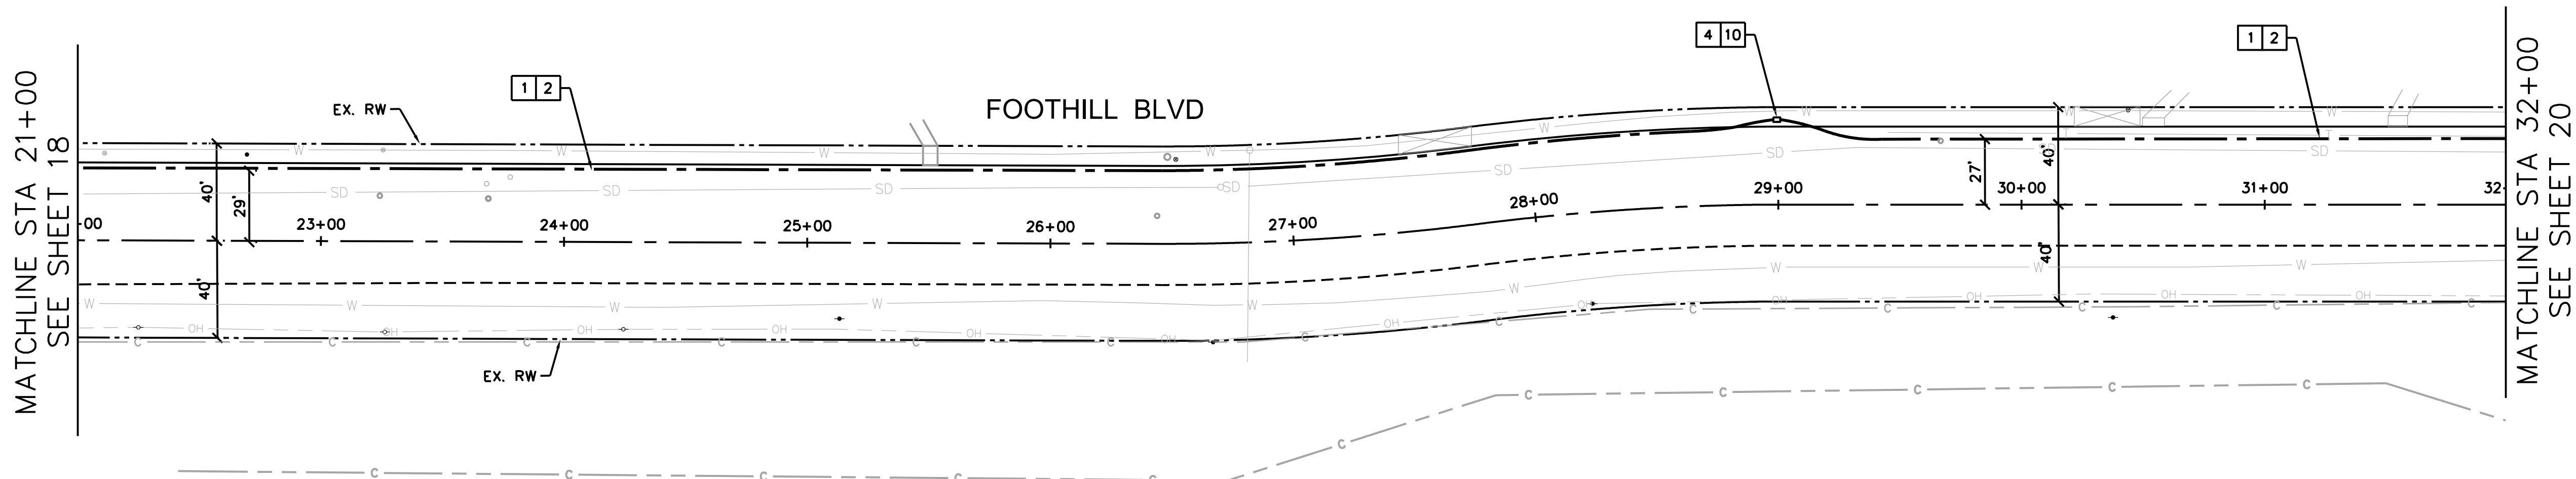


CONSTRUCTION NOTES

- 1 FURNISH AND INSTALL NEW 3" PVC SCHEDULE 80 CONDUIT BY BORING METHOD.
- 2 FURNISH AND INSTALL 24 SMFO CABLE IN CONDUIT.
- 4 FURNISH AND INSTALL NEW #6E PULL BOX UNLESS OTHERWISE NOTED.
- 10 COIL 50' OF FIBER OPTIC CABLE SLACK IN PULL BOX.

LEGEND

PROPOSED CONDUIT	---
EXISTING CONDUIT	---
EXISTING PULLBOX	□
PROPOSED PULLBOX	□
EXISTING CONTROLLER	□
PROPOSED CCTV CAMERA	□

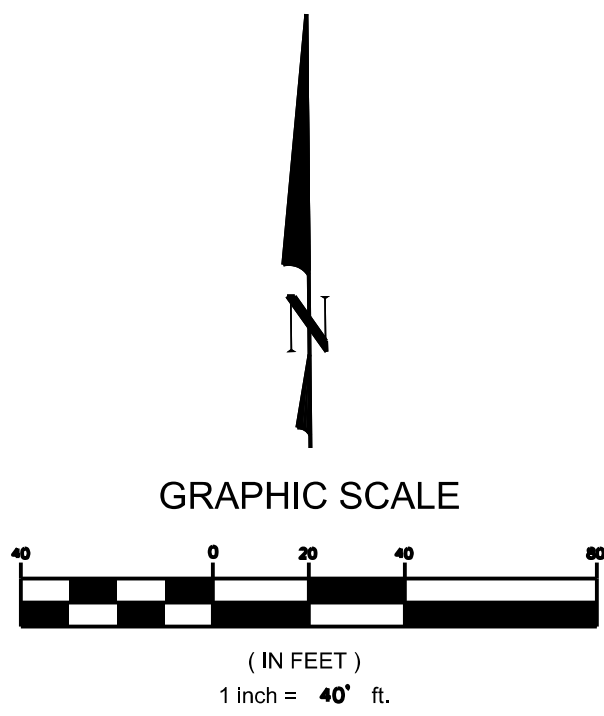

COUNTY OF ORANGE
CCTV CAMERA AND FIBER OPTIC
COMMUNICATIONS DESIGN PLANS

FOOTHILL BLVD

DATE: 04/18/2017	SUBMITTED: _____ NAME/SIGNATURE	SHEET NO. 19 OF 25
SCALE: 1" = 40'	DATE: _____	PROJECT NO. 099598001
DESIGN: JL	APPROVED: _____ NAME/SIGNATURE	
DRAWN: RP/RC	DATE: _____	
CHECKED: MSW		



Kimley»Horn

© 2017 KIMLEY-HORN AND ASSOCIATES, INC.
660 South Figueroa Street, Suite 2050, Los Angeles, CA 90017
Tel (213) 261-4040

