


\\reserver2\home\PhamT\Microstation\cad fiber\optic\17-21-FO-Hewes & Foothill.dgn 5/6/2014 9:45 AM

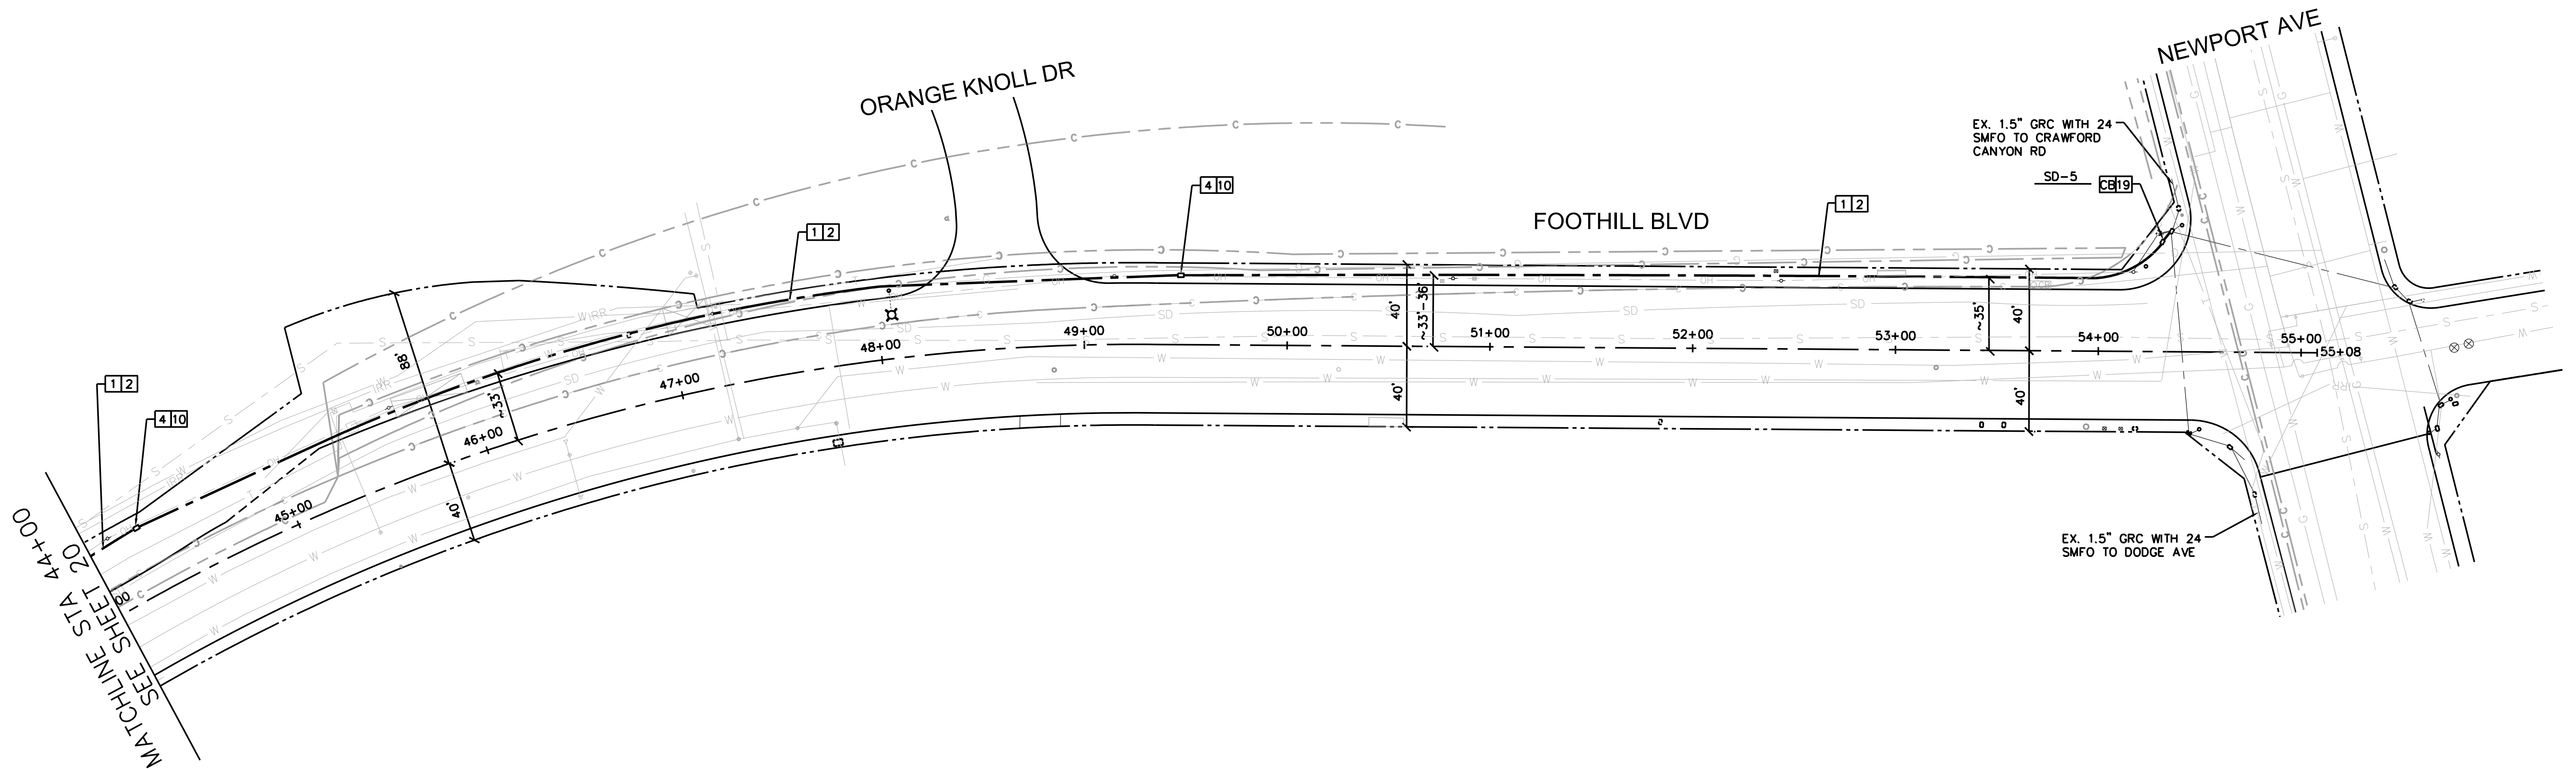


CONSTRUCTION NOTES

- 1 FURNISH AND INSTALL NEW 3" PVC SCHEDULE 80 CONDUIT BY BORING METHOD.
- 2 FURNISH AND INSTALL 24 SMFO CABLE IN CONDUIT.
- 4 FURNISH AND INSTALL NEW #6E PULL BOX UNLESS OTHERWISE NOTED.
- 10 COIL 50' OF FIBER OPTIC CABLE SLACK IN PULL BOX.
- 19 FUSION SPLICE 24-STRAND SMFO CABLE TO EXISTING SMFO CABLES IN EXISTING SPLICE ENCLOSURE PER SPLICE DETAIL AS IDENTIFIED ON THE PLANS. CONTRACTOR SHALL RE-SEAL EXISTING SPLICE ENCLOSURE PER MANUFACTURER REQUIREMENTS.
- CB INSTALL CONDUIT INTO EXISTING PULL BOX.

LEGEND

PROPOSED CONDUIT	---
EXISTING CONDUIT	---
EXISTING PULLBOX	[Symbol]
PROPOSED PULLBOX	[Symbol]
EXISTING CONTROLLER	[Symbol]
PROPOSED CCTV CAMERA	[Symbol]

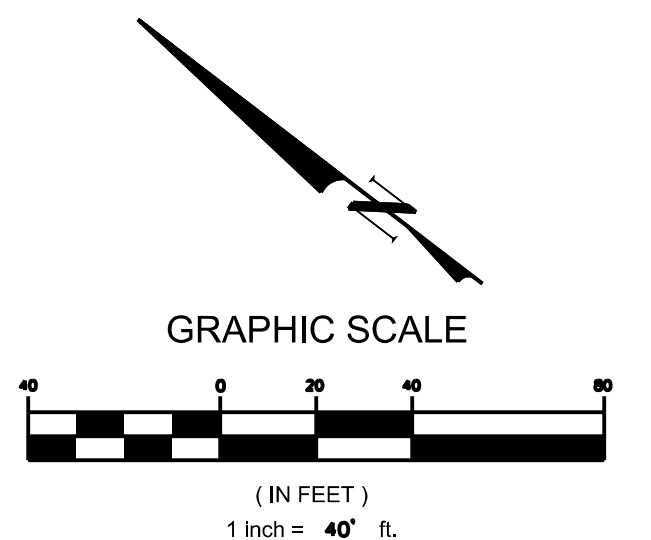

COUNTY OF ORANGE CCTV CAMERA AND FIBER OPTIC COMMUNICATIONS DESIGN PLANS

FOOTHILL BLVD

DATE: 04/18/2017	SUBMITTED: _____ NAME/SIGNATURE	SHEET NO. 21 OF 25
SCALE: 1" = 40'	DATE: _____	PROJECT NO. 099598001
DESIGN: JL	APPROVED: _____ NAME/SIGNATURE	
DRAWN: RP/RC	DATE: _____	
CHECKED: MSW		



Kimley»Horn

© 2017 KIMLEY-HORN AND ASSOCIATES, INC.
660 South Figueroa Street, Suite 2050, Los Angeles, CA 90017
Tel (213) 261-4040



DIAL TOLL FREE
811

Know what's below.
Call before you dig.

AT LEAST TWO DAYS
BEFORE YOU DIG

UNDERGROUND SERVICE ALERT OF SOUTHERN CALIFORNIA