


\\filer2\home\PhamT\Microstation\cad fiber\c22-23-FO-Newport.dgn 5/6/2014 9:45 AM

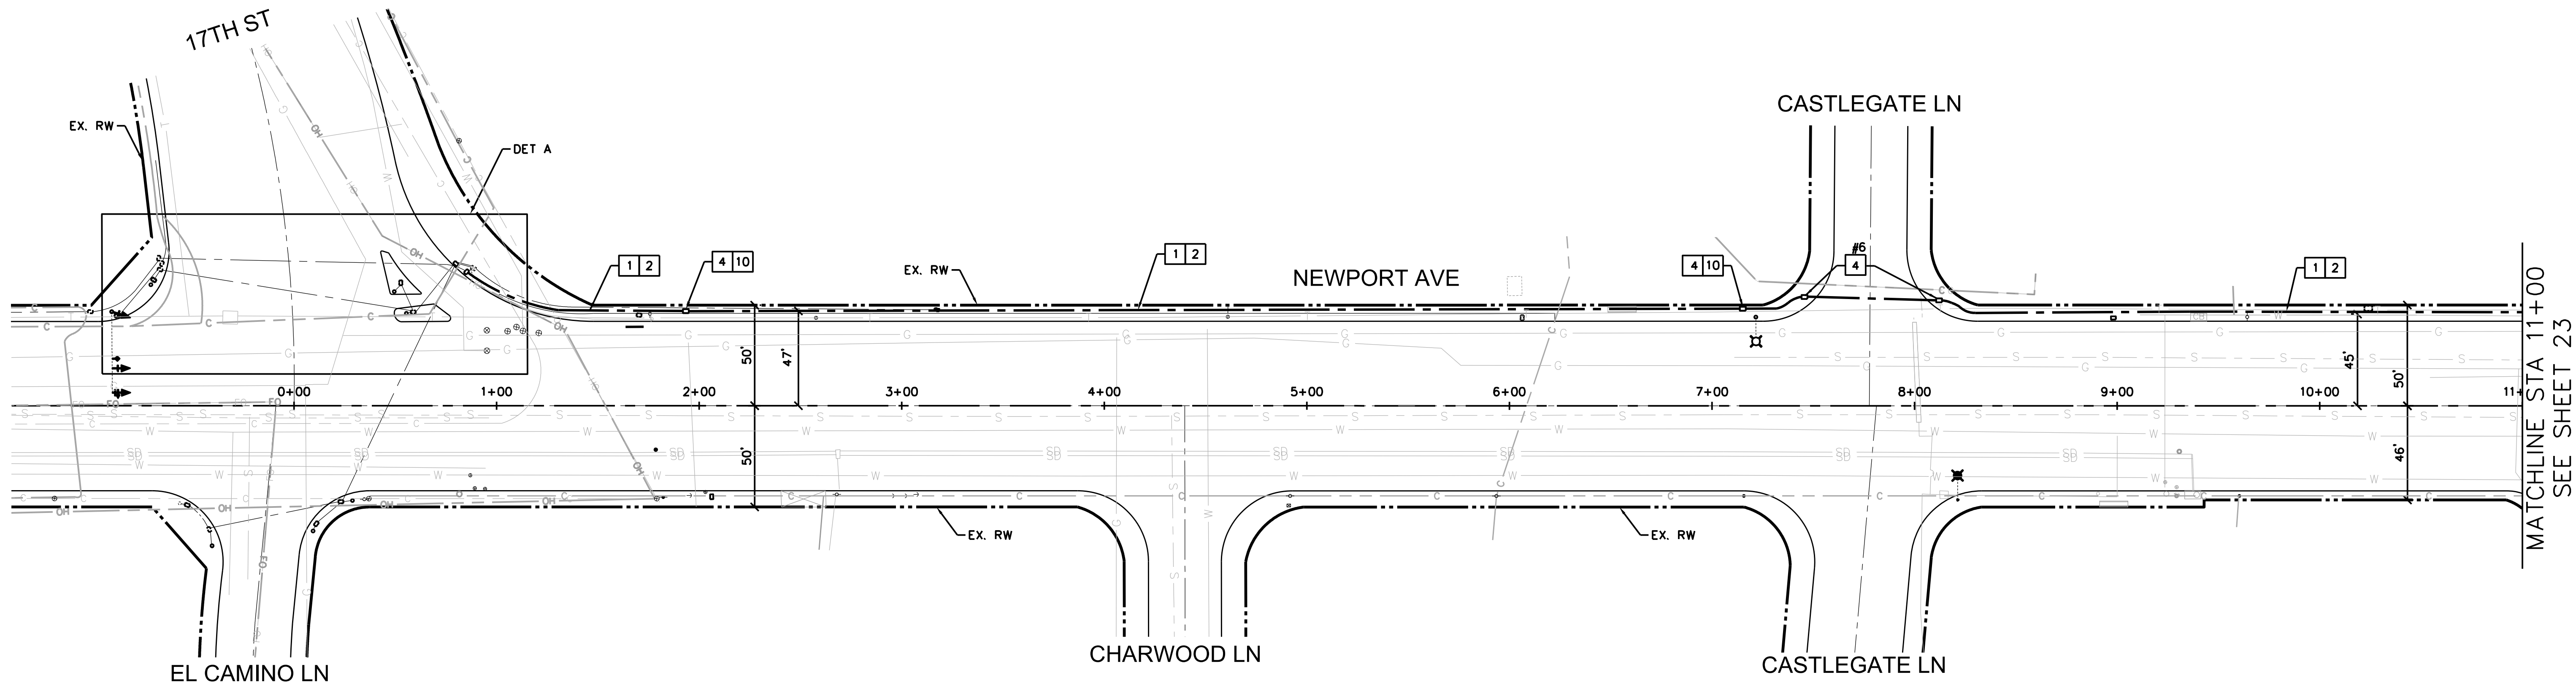


DETAIL A
1"=10'

CONSTRUCTION NOTES

- [1] FURNISH AND INSTALL NEW 3" PVC SCHEDULE 80 CONDUIT BY BORING METHOD.
- [2] FURNISH AND INSTALL 24 SMFO CABLE IN CONDUIT.
- [4] FURNISH AND INSTALL NEW #6E PULL BOX UNLESS OTHERWISE NOTED.
- [10] COIL 50' OF FIBER OPTIC CABLE SLACK IN PULL BOX.
- [16] REMOVE AND SALVAGE EXISTING WIRELESS RADIO EQUIPMENT INCLUDING RADIO, ANTENNA, AND EXISTING CATSE CABLING.
- [19] FUSION SPLICE 24-STRAND SMFO CABLE TO EXISTING SMFO CABLES IN EXISTING SPLICE ENCLOSURE PER SPLICE DETAIL AS IDENTIFIED ON THE PLANS. CONTRACTOR SHALL RE-SEAL EXISTING SPLICE ENCLOSURE PER MANUFACTURER REQUIREMENTS.
- [CB] INSTALL CONDUIT INTO EXISTING PULL BOX.

LEGEND

PROPOSED CONDUIT	
EXISTING CONDUIT	
EXISTING PULLBOX	
PROPOSED PULLBOX	
EXISTING CONTROLLER	
PROPOSED CCTV CAMERA	

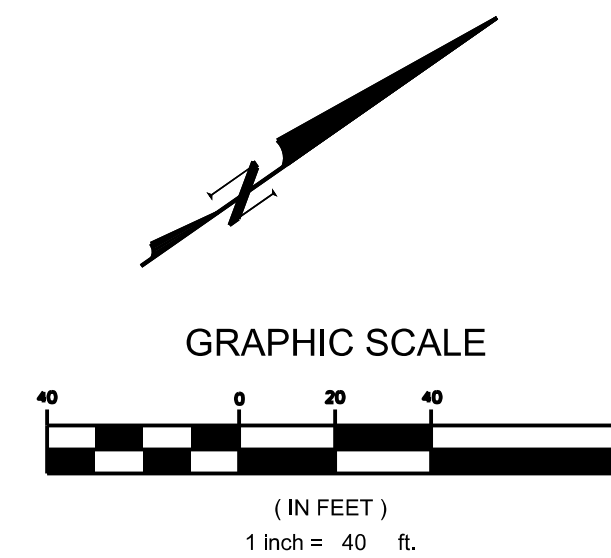

COUNTY OF ORANGE CCTV CAMERA AND FIBER OPTIC COMMUNICATIONS DESIGN PLANS

NEWPORT AVE

DATE: 04/18/2017	SUBMITTED _____ NAME/SIGNATURE	SHEET NO. 22 OF 25
SCALE: 1" = 40'	DATE _____	PROJECT NO. 099598001
DESIGN: JL	APPROVED _____ NAME/SIGNATURE	
DRAWN: RP/RC	DATE _____	
CHECKED: MSW		



Kimley»Horn

© 2017 KIMLEY-HORN AND ASSOCIATES, INC.
660 South Figueroa Street, Suite 2050, Los Angeles, CA 90017
Tel (213) 261-4040

