


LEGEND

PROPOSED CONDUIT	
EXISTING CONDUIT	
EXISTING PULLBOX	
PROPOSED PULLBOX	
EXISTING CONTROLLER	
PROPOSED CCTV CAMERA	

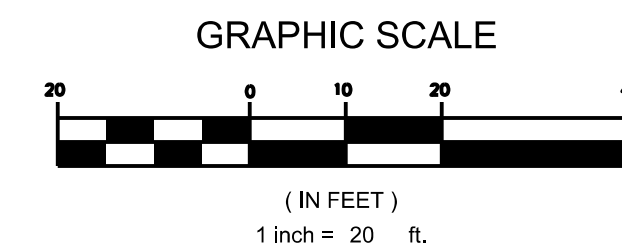

CONSTRUCTION NOTES

- [12] FURNISH AND INSTALL CA280S CABLE FOR CCTV POWER, VIDEO, AND CONTROL.
- [13] FURNISH AND INSTALL COHU RISE 4222HD (OR APPROVED EQUAL)CCTV CAMERA.
- [14] FURNISH AND INSTALL POE INJECTOR AND SURGE PROTECTOR PER CCTV CAMERA MANUFACTURER REQUIREMENTS.
- [17] EXISTING TRAFFIC SIGNAL CONDUCTORS TO REMAIN.

Kimley»Horn

© 2017 KIMLEY-HORN AND ASSOCIATES, INC.  
660 South Figueroa Street, Suite 2050, Los Angeles, CA 90017  
Tel (213) 261-4040

COUNTY OF ORANGE  
CCTV CAMERA AND FIBER OPTIC  
COMMUNICATIONS DESIGN PLANS

NEWPORT BLVD AT CRAWFORD CANYON ROAD AND  
ROCKHURST AVENUE/COWAN HEIGHTS

DATE: 04/18/2017	SUBMITTED _____ NAME/SIGNATURE	SHEET NO. 25 OF 25
SCALE: 1" = 20'	DATE _____	PROJECT NO. 099598001
DESIGN: JL	APPROVED _____ NAME/SIGNATURE	
DRAWN: RP/RC	DATE _____	
CHECKED: MSW		