


\\LD7P01\Project\LD7_P70\099598001 - orange county fiber optic design\CADD\Working\4. 99598001-Splice Details.dwg 5/6/2014 9:45 AM



LEGEND

EXISTING FIBER	---
NEW FIBER	---
EXISTING SPLICE	o
NEW SPLICE	•
UNSPLICED	x
FULL TUBE SPLICE	⊙

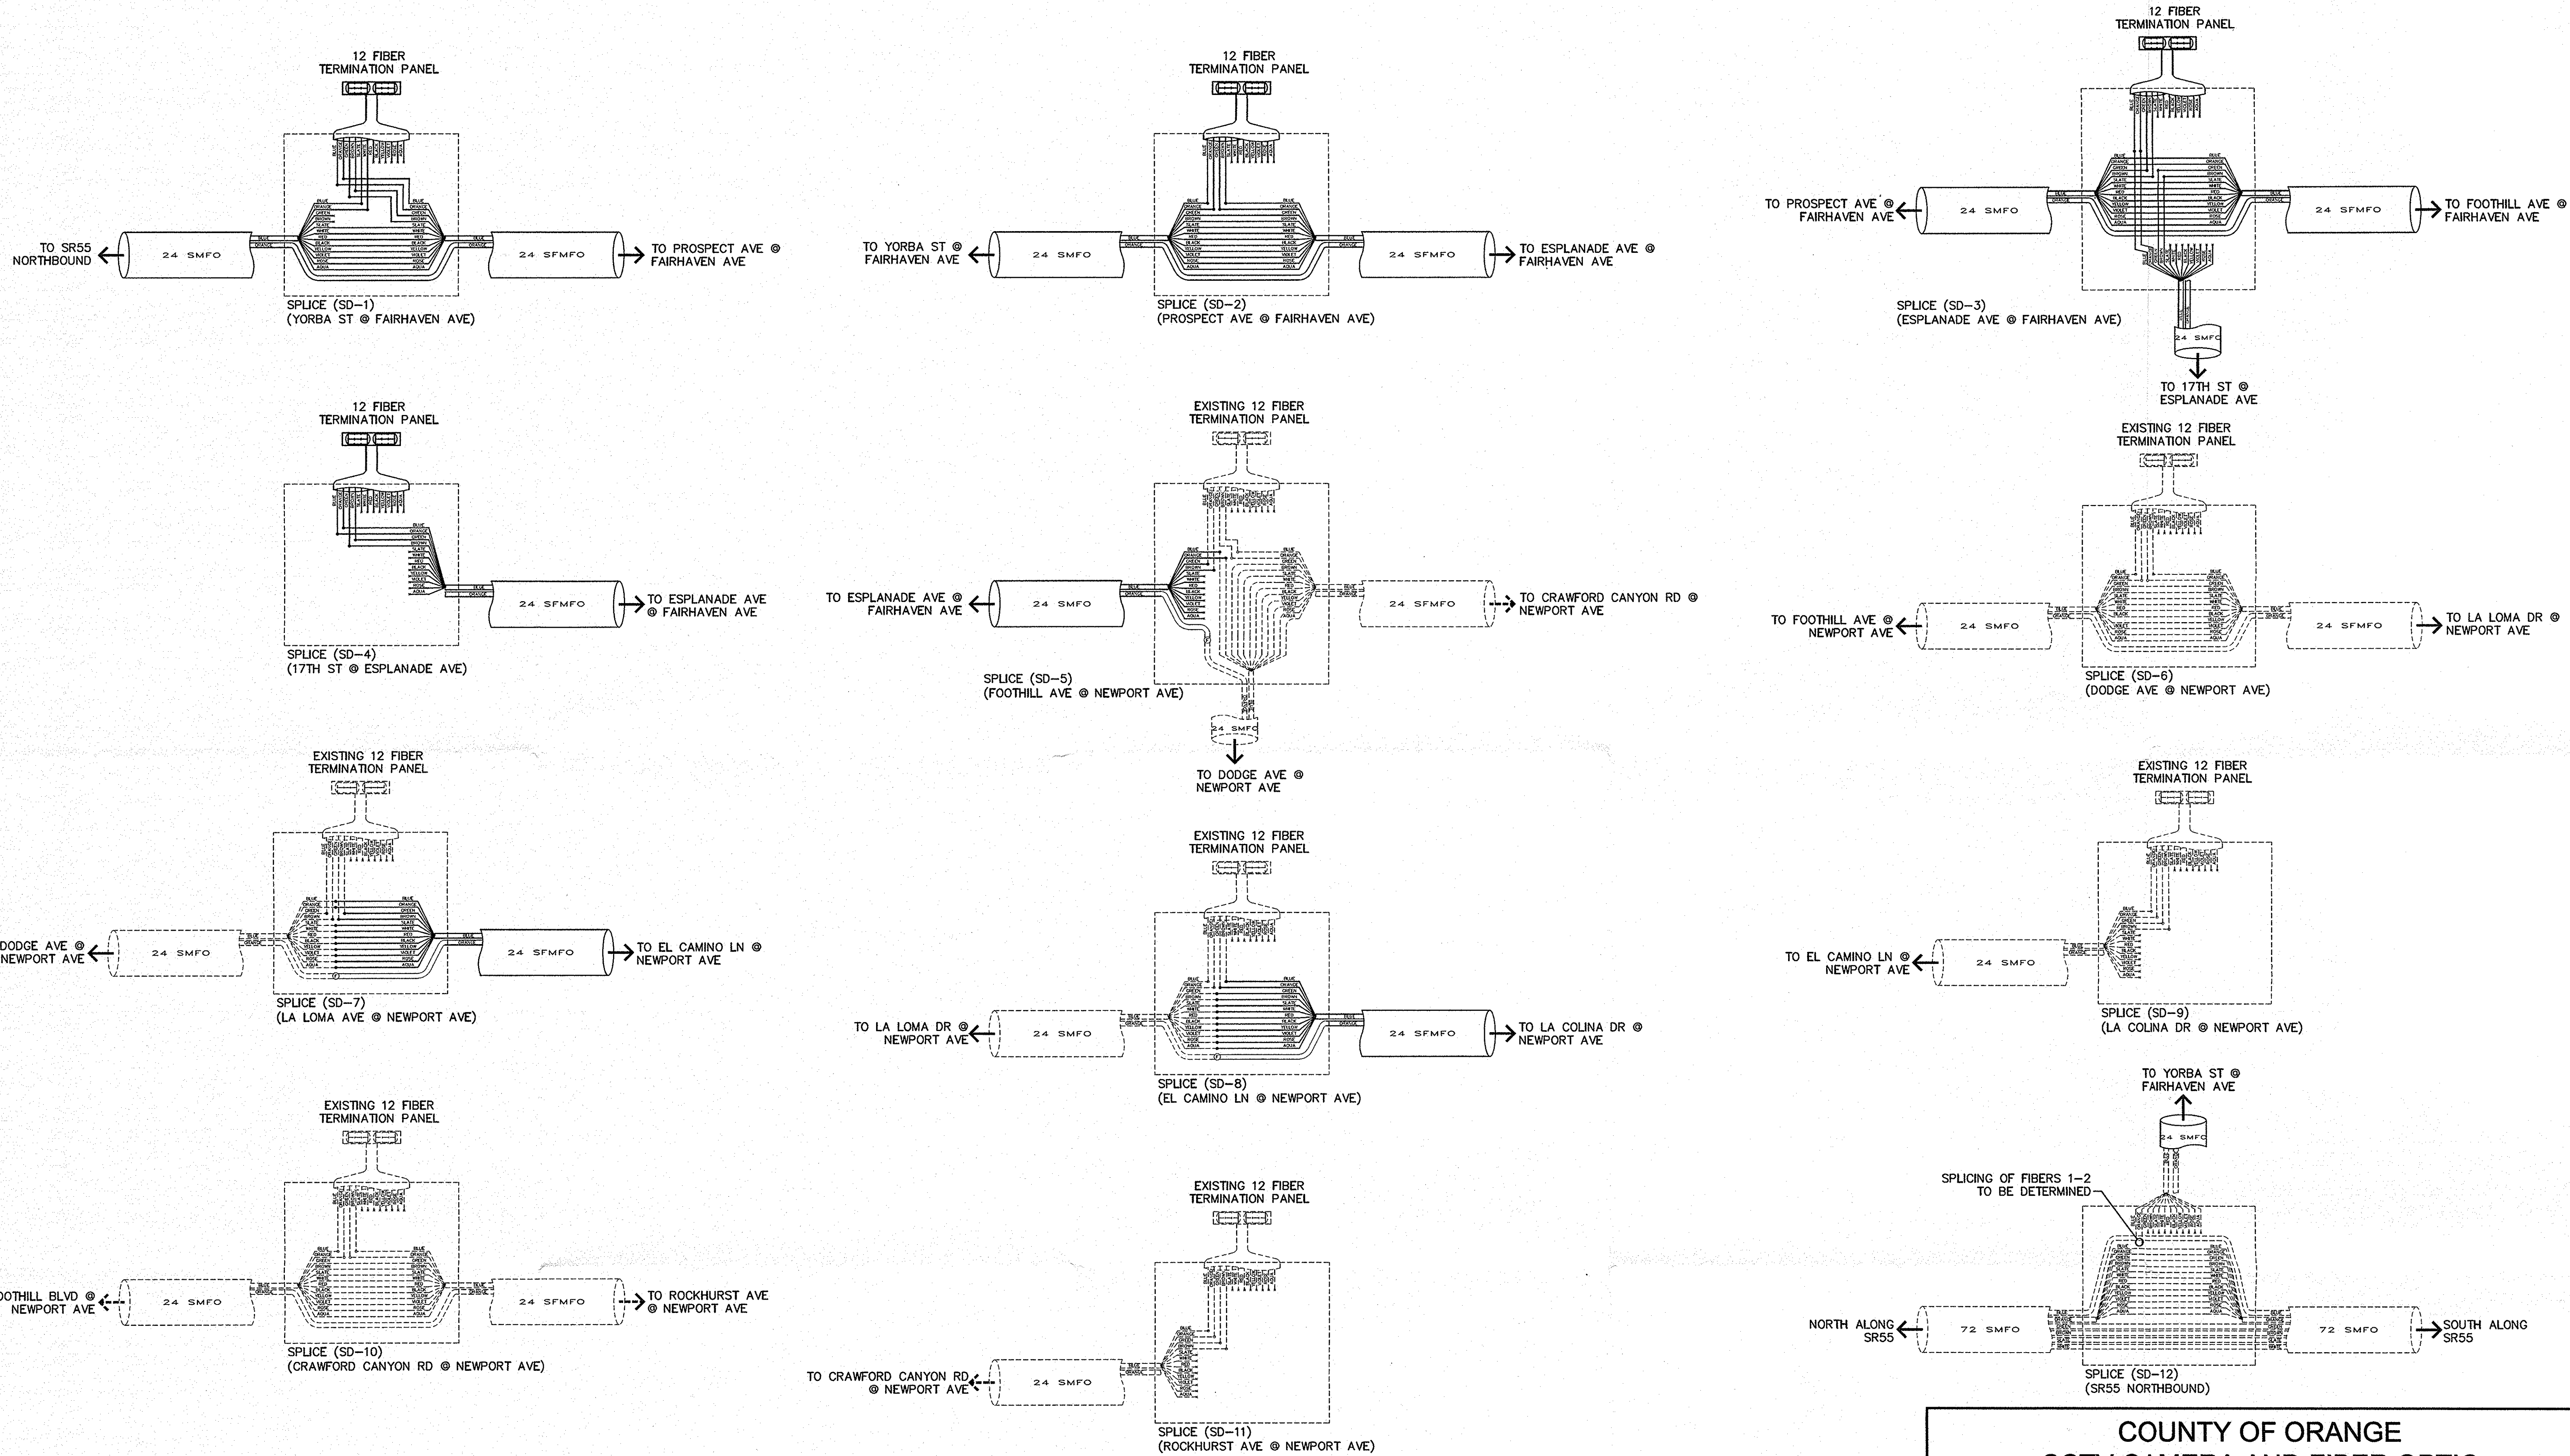


Kimley»Horn

© 2017 KIMLEY-HORN AND ASSOCIATES, INC.
680 South Figueroa Street, Suite 2050, Los Angeles, CA 90017
Tel (213) 261-4040



Know what's below.
Call before you dig.
AT LEAST TWO DAYS
BEFORE YOU DIG
UNDERGROUND SERVICE ALERT OF SOUTHERN CALIFORNIA

DIAL TOLL FREE
811

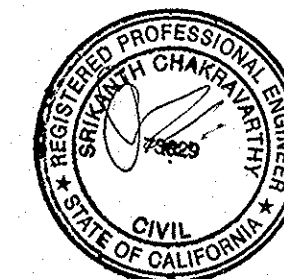

COUNTY OF ORANGE CCTV CAMERA AND FIBER OPTIC COMMUNICATIONS DESIGN PLANS

SPLICE DETAILS

DATE: 04/18/2017	SUBMITTED _____ NAME/SIGNATURE	SHEET NO. 4 OF 25
SCALE: N/A	DATE _____	PROJECT NO. 099598001
DESIGN: JL	APPROVED _____ NAME/SIGNATURE	
DRAWN: RP/RC	DATE _____	
CHECKED: MSW		