




OC PUBLIC WORKS DEPARTMENT

JAMES TREADAWAY, DIRECTOR OF PUBLIC WORKS

KEVIN HILLS, COUNTY SURVEYOR

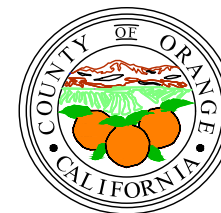


ATWOOD CHANNEL

REHABILITATION

SECTIONS WERE DERIVED FROM RECORD AS-BUILT PLANS E04-101-1A & E04-101-2A
BETWEEN STATIONS 0+00 TO 30+74 / 32+75 TO 39+99 / 42+14 TO 47+90
AND O.C.S TOPOGRAPHIC SURVEY DATED JUNE, 2021.


THIS DOCUMENT IS SUPPLEMENTAL TO THE TOPOGRAPHIC SURVEY MAP DATED JUNE, 2021.

PROJECT CROSS SECTIONS

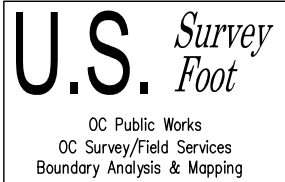

ATWOOD CHANNEL (E04)


0+00
CL

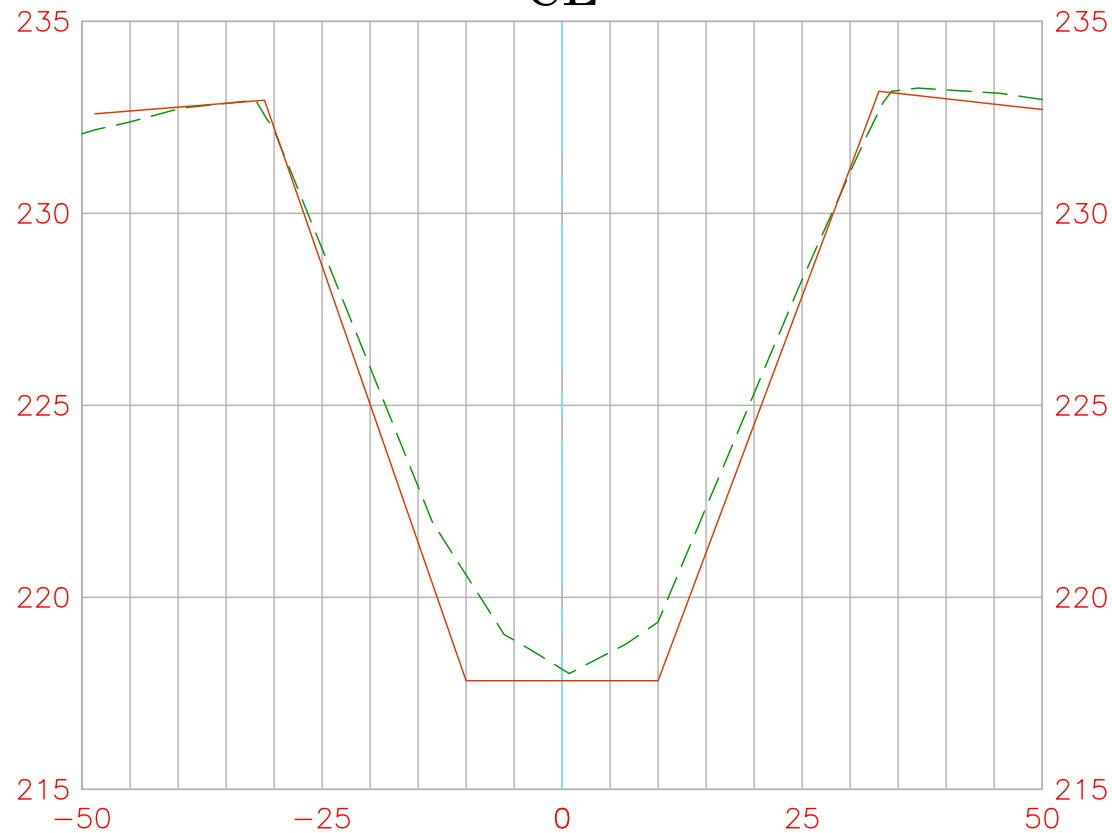

EXISTING CONDITION 2021
RECORD DRAWINGS:
DATE PREPARED: 3/31/2023




Vert. Scale: 1"=5'
Hor. Scale: 1"=20'

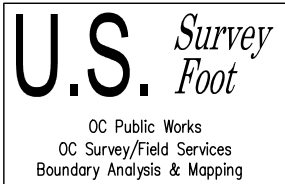

ATWOOD CHANNEL (E04)


0+50
CL

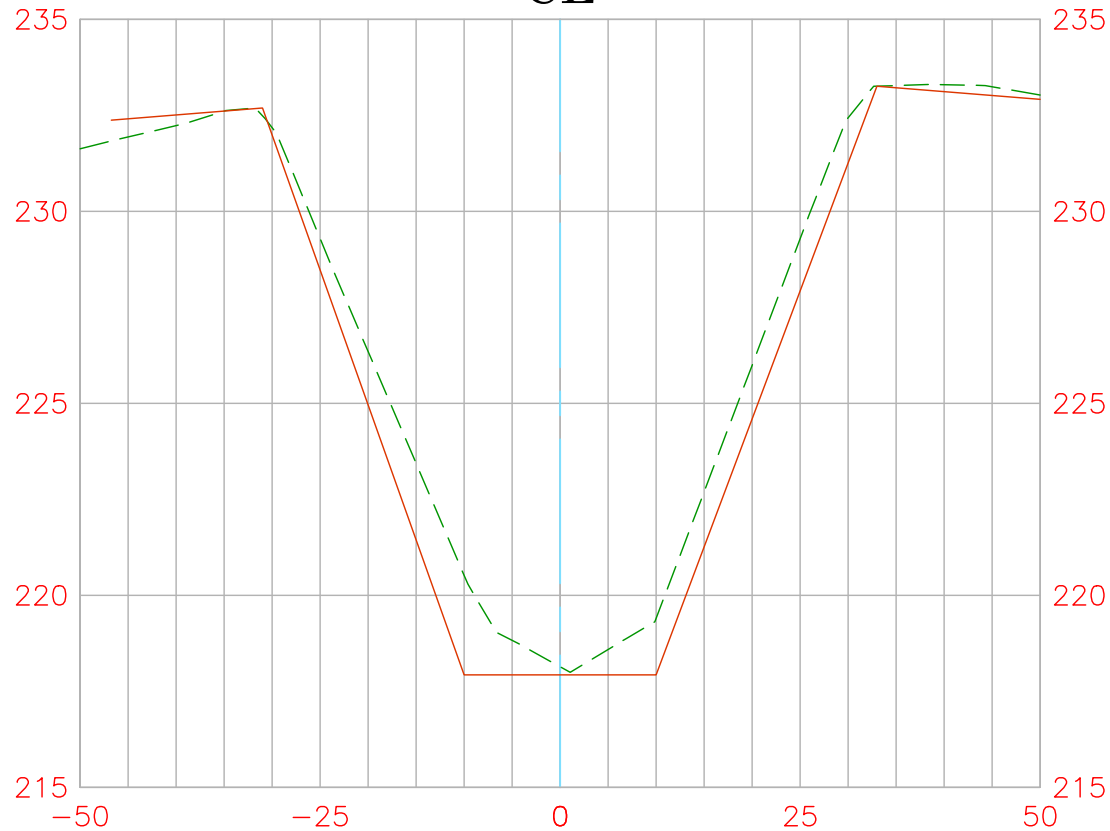

EXISTING CONDITION 2021
RECORD DRAWINGS:
DATE PREPARED: 3/31/2023




Vert. Scale: 1"=5'
Hor. Scale: 1"=20'

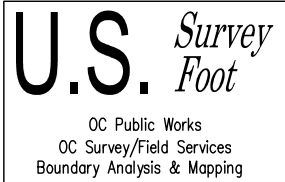

ATWOOD CHANNEL (E04)

1+00
CL

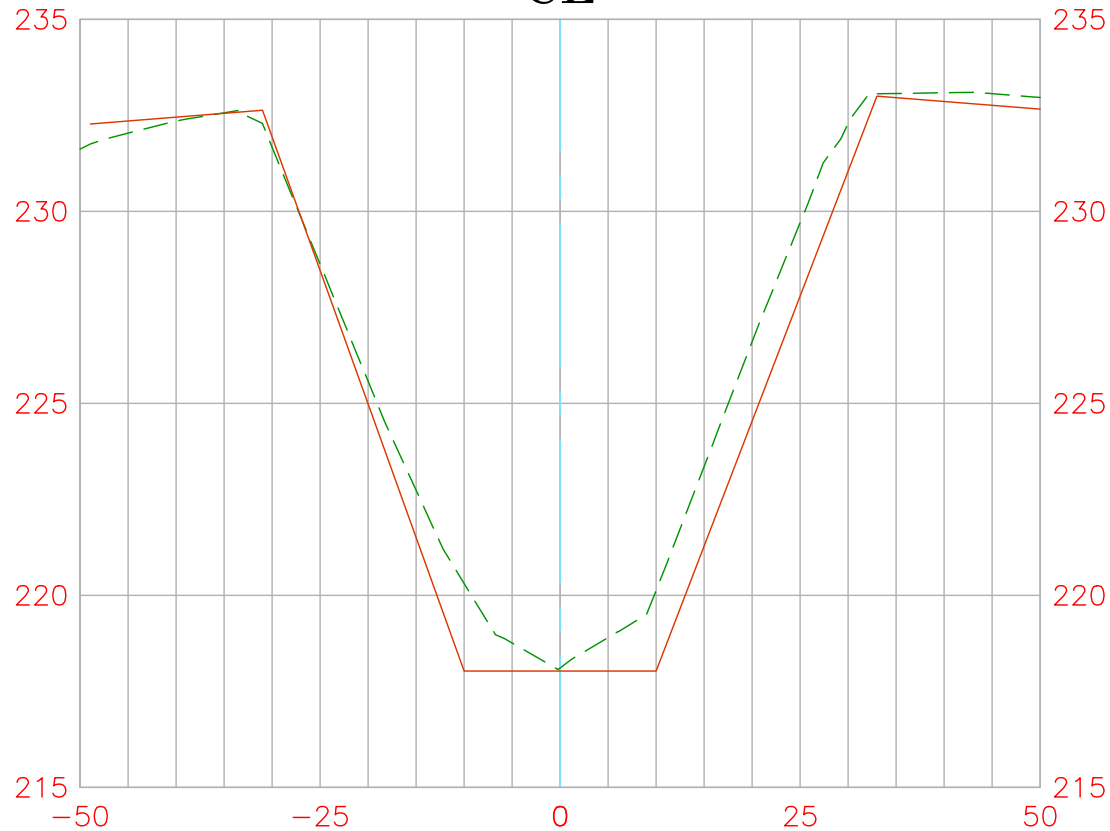

EXISTING CONDITION 2021
RECORD DRAWINGS:
DATE PREPARED: 3/31/2023



Vert. Scale: 1"=5'
Hor. Scale: 1"=20'


U.S. *Survey
Foot*

OC Public Works
OC Survey/Field Services
Boundary Analysis & Mapping

ATWOOD CHANNEL (E04)

1+50

CL

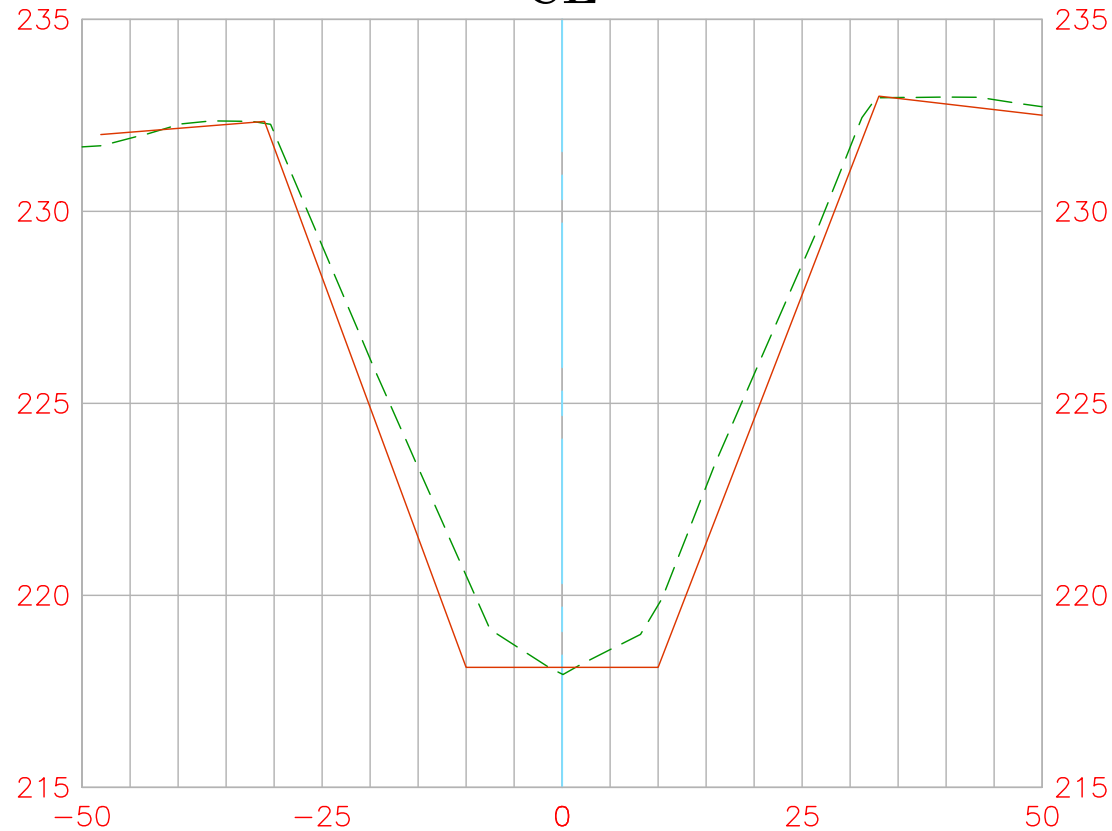


EXISTING CONDITION 2021

RECORD DRAWINGS:

DATE PREPARED: 3/31/2023




Vert. Scale: 1"=5'
Hor. Scale: 1"=20'

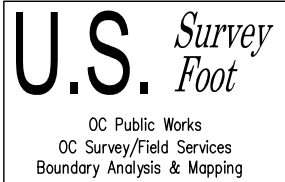

ATWOOD CHANNEL (E04)

2+00


CL

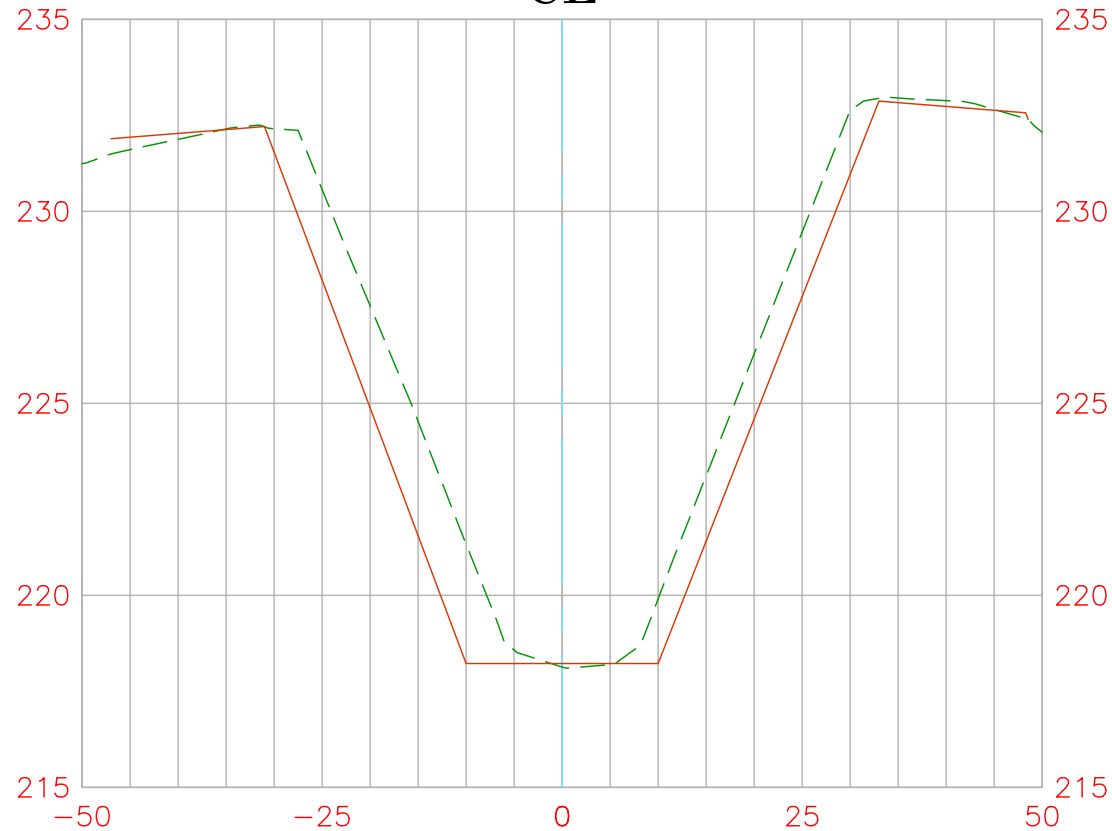

EXISTING CONDITION 2021
RECORD DRAWINGS:
DATE PREPARED: 3/31/2023




Vert. Scale: 1"=5'
Hor. Scale: 1"=20'

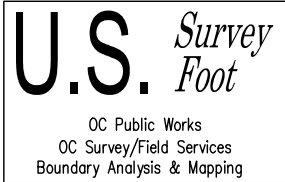

ATWOOD CHANNEL (E04)

2+50


CL

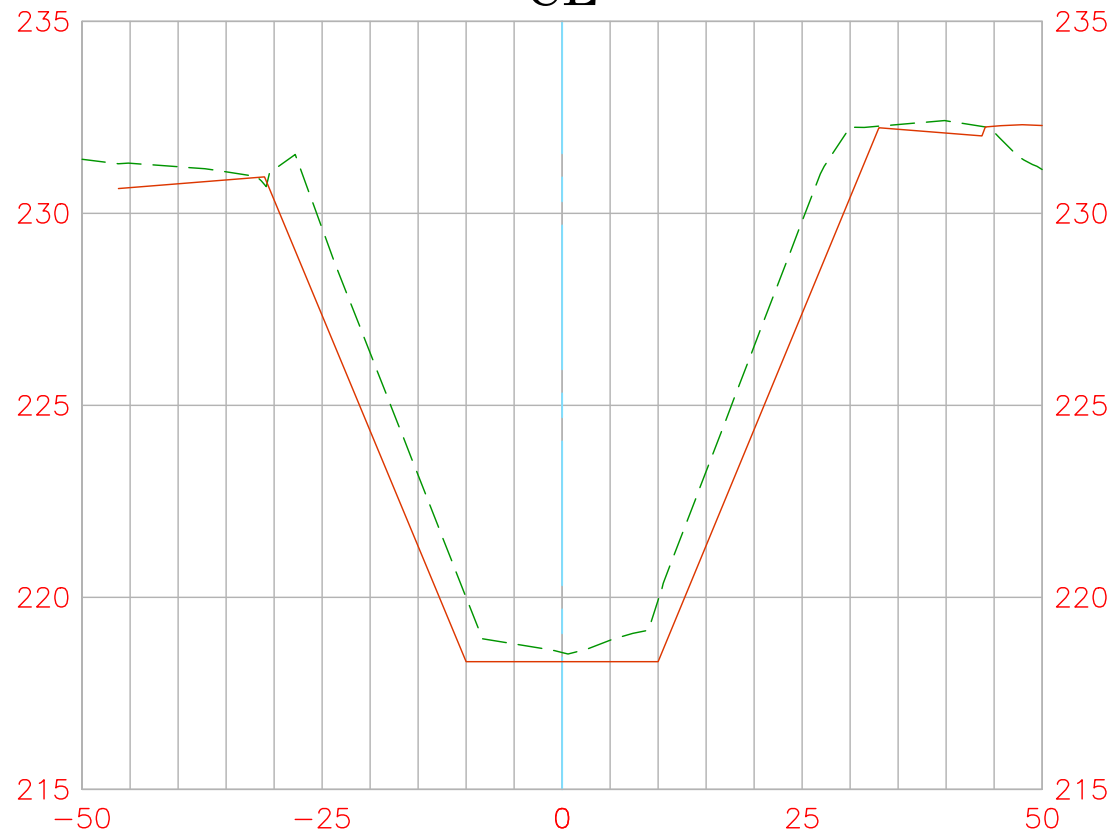

EXISTING CONDITION 2021
RECORD DRAWINGS:
DATE PREPARED: 3/31/2023




Vert. Scale: 1"=5'
Hor. Scale: 1"=20'

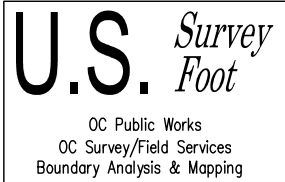

ATWOOD CHANNEL (E04)


3+00
CL

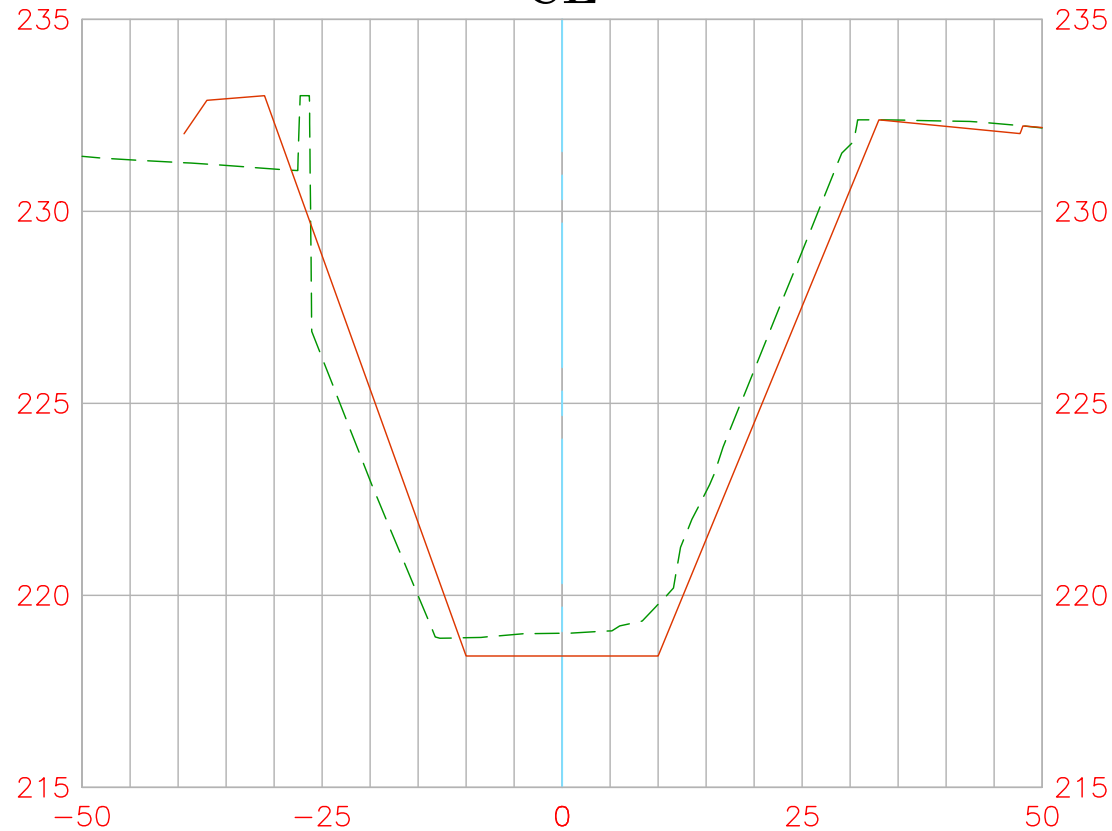

EXISTING CONDITION 2021
RECORD DRAWINGS:
DATE PREPARED: 3/31/2023




Vert. Scale: 1"=5'
Hor. Scale: 1"=20'

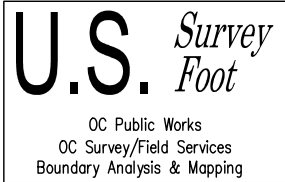

ATWOOD CHANNEL (E04)

3+50

CL

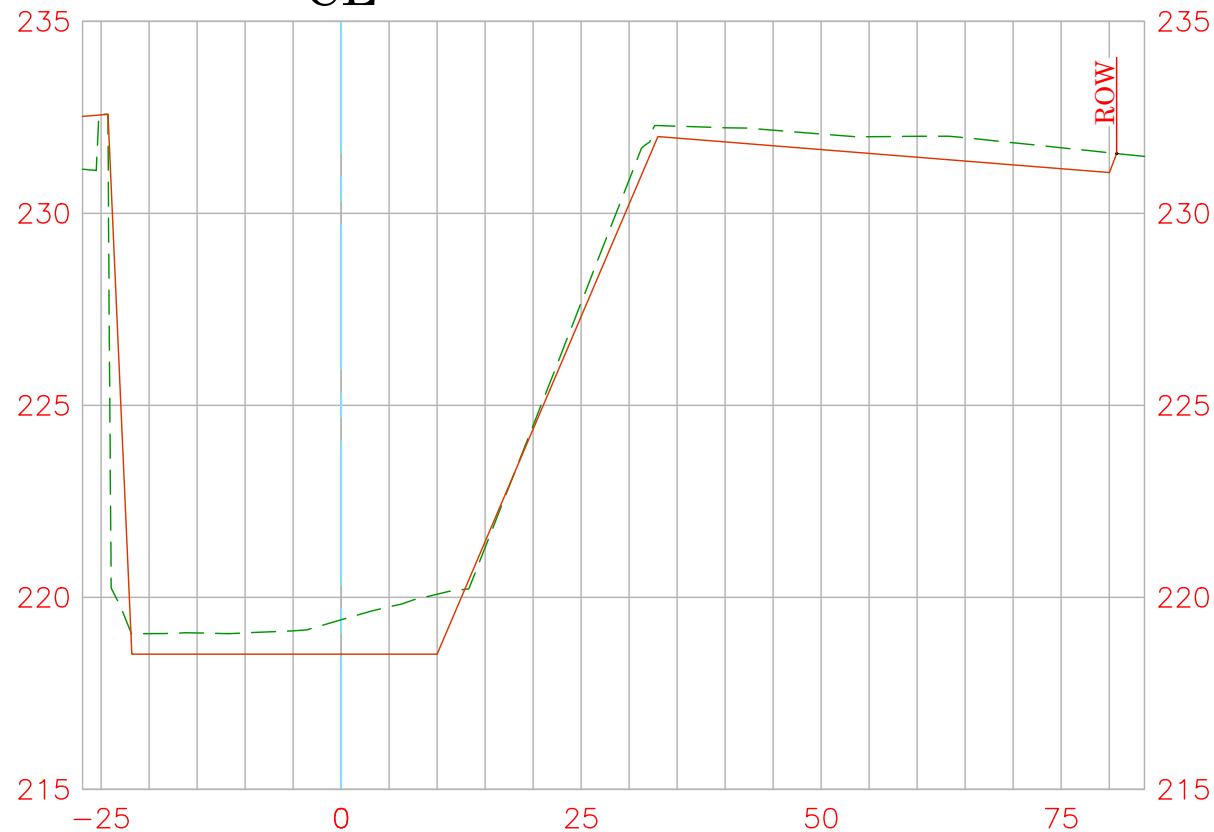

EXISTING CONDITION 2021
RECORD DRAWINGS:
DATE PREPARED: 3/31/2023



Vert. Scale: 1"=5'
Hor. Scale: 1"=20'


U.S. *Survey*
Foot

OC Public Works
OC Survey/Field Services
Boundary Analysis & Mapping

ATWOOD CHANNEL (E04)

4+00

CL

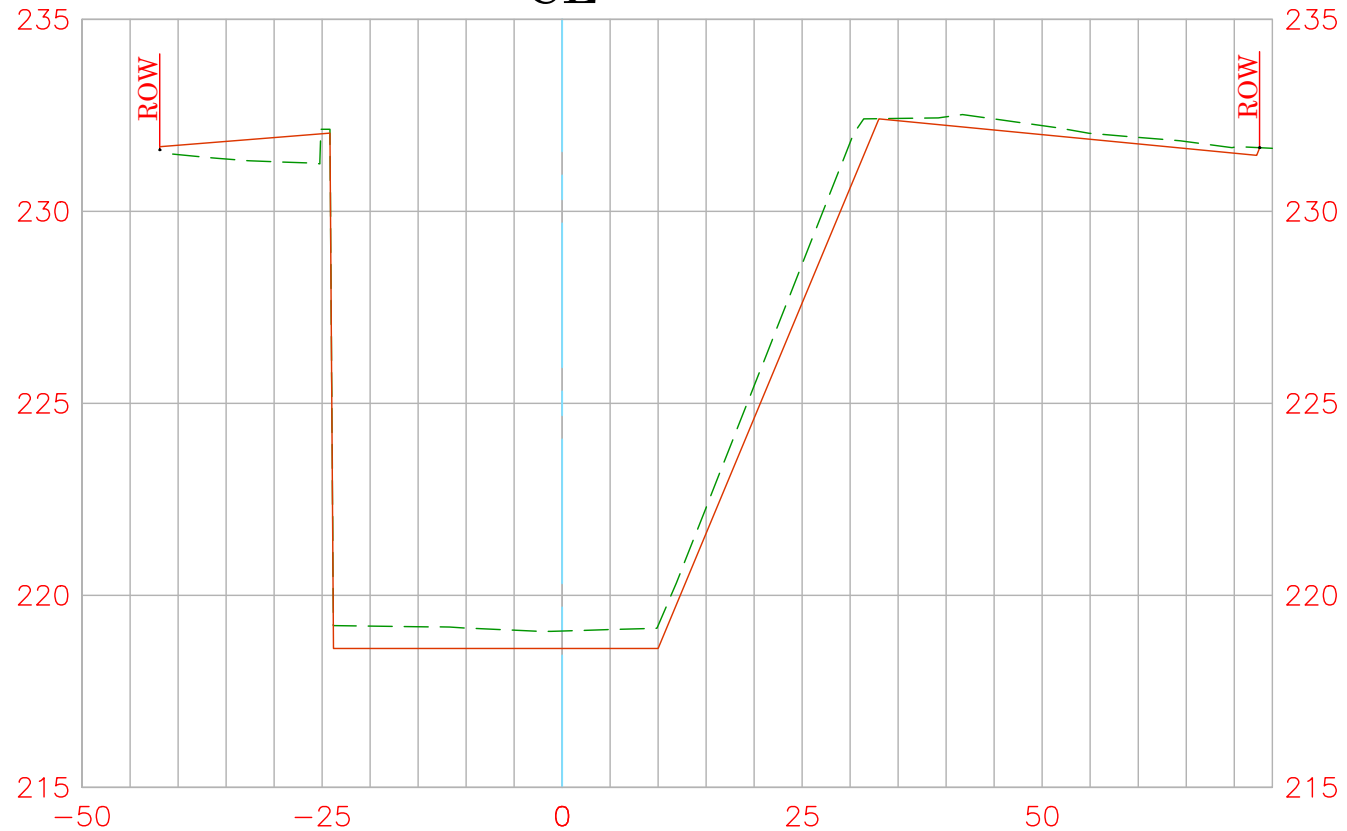


EXISTING CONDITION 2021

RECORD DRAWINGS:

DATE PREPARED: 3/31/2023





Vert. Scale: 1"=5'
Hor. Scale: 1"=20'

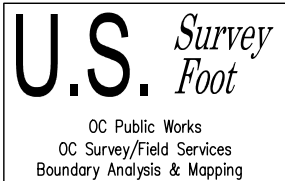


ATWOOD CHANNEL (E04)

4+50


CL

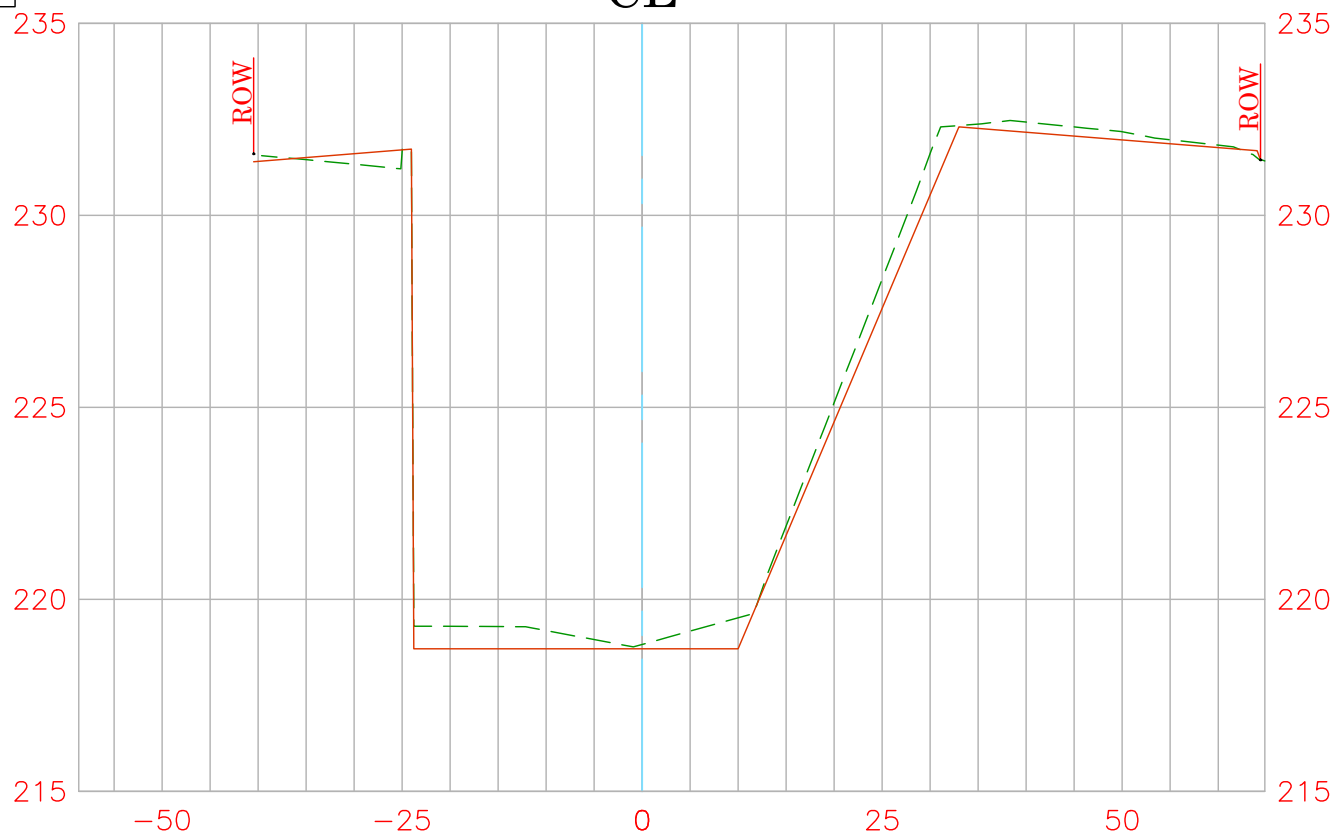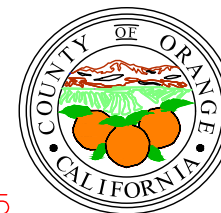

EXISTING CONDITION 2021
RECORD DRAWINGS:
DATE PREPARED: 3/31/2023


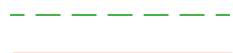


Vert. Scale: 1"=5'
Hor. Scale: 1"=20'

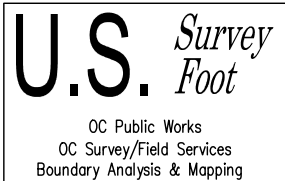


ATWOOD CHANNEL (E04)

5+00
CL

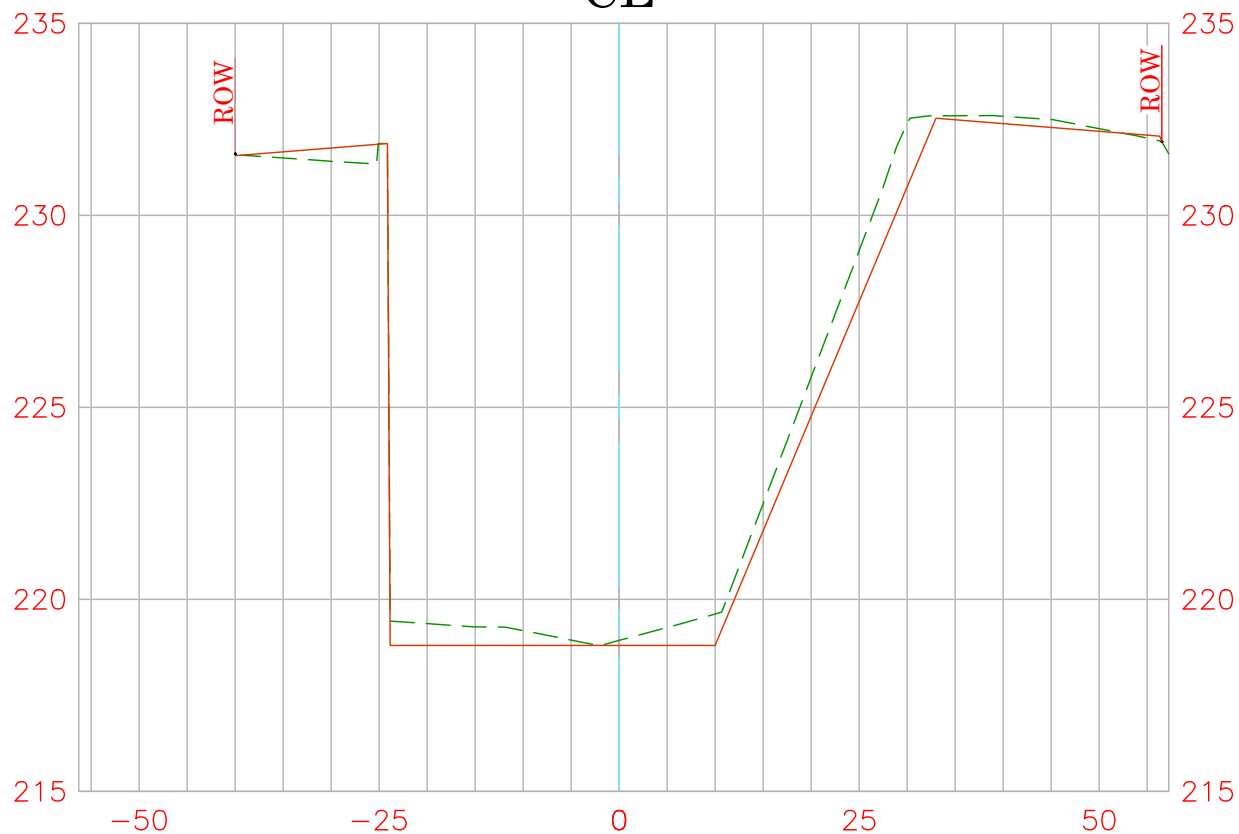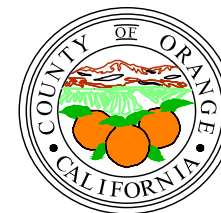

EXISTING CONDITION 2021
RECORD DRAWINGS:
DATE PREPARED: 3/31/2023

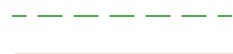

Vert. Scale: 1"=5'
Hor. Scale: 1"=20'


U.S. *Survey*
Foot

OC Public Works
OC Survey/Field Services
Boundary Analysis & Mapping

ATWOOD CHANNEL (E04)

5+50

CL

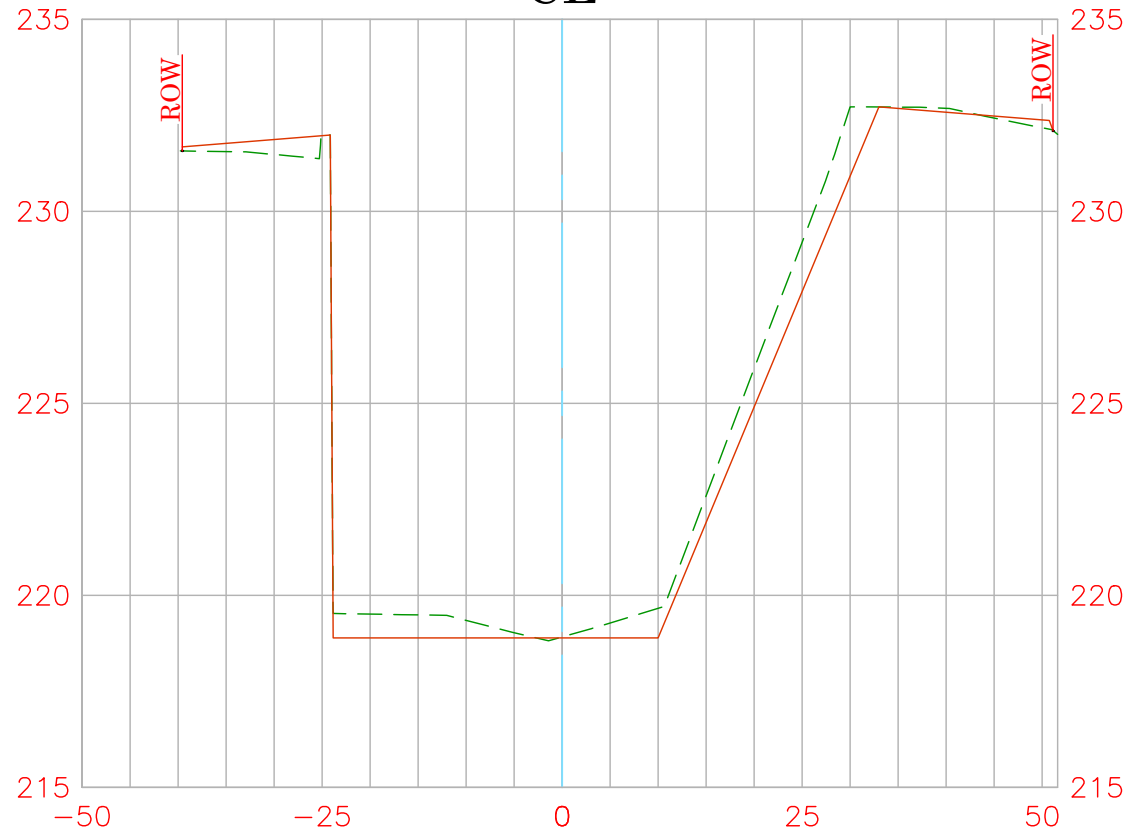


EXISTING CONDITION 2021

RECORD DRAWINGS:

DATE PREPARED: 3/31/2023




Vert. Scale: 1"=5'
Hor. Scale: 1"=20'

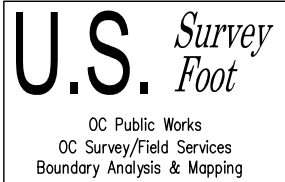

ATWOOD CHANNEL (E04)

6+00
CL

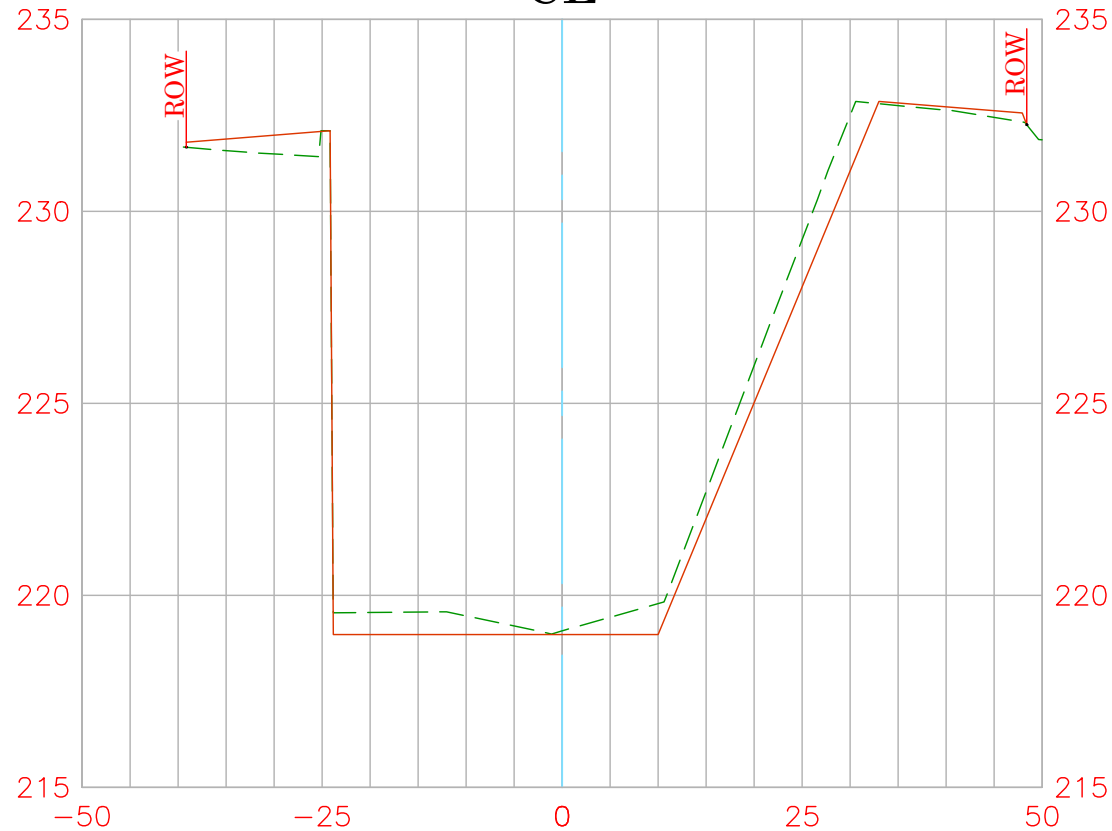

EXISTING CONDITION 2021
RECORD DRAWINGS:
DATE PREPARED: 3/31/2023



Vert. Scale: 1"=5'
Hor. Scale: 1"=20'


U.S. *Survey
Foot*

OC Public Works
OC Survey/Field Services
Boundary Analysis & Mapping

ATWOOD CHANNEL (E04)

6+50

CL

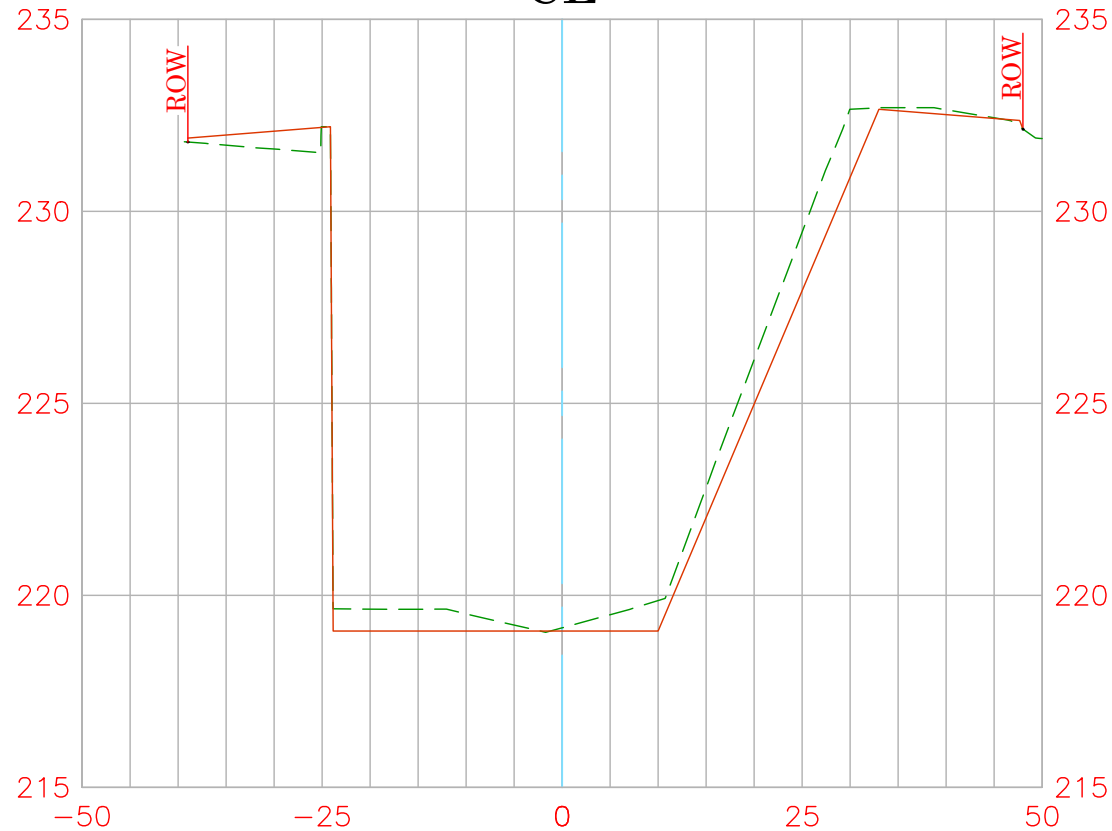

EXISTING CONDITION 2021

RECORD DRAWINGS:


DATE PREPARED: 3/31/2023



Vert. Scale: 1"=5'
Hor. Scale: 1"=20'

ATWOOD CHANNEL (E04)


7+00
CL

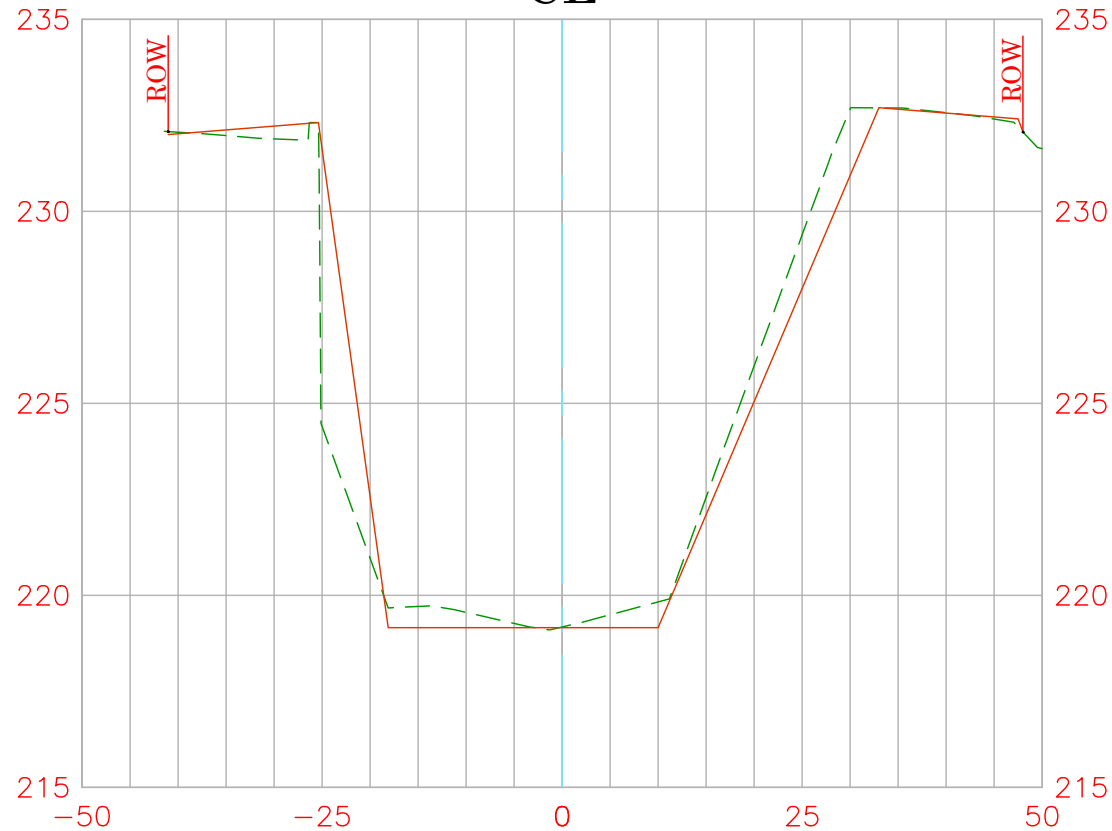

EXISTING CONDITION 2021
RECORD DRAWINGS:
DATE PREPARED: 3/31/2023




Vert. Scale: 1"=5'
Hor. Scale: 1"=20'

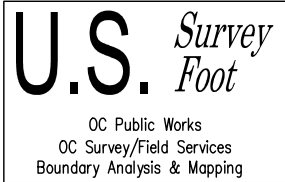

ATWOOD CHANNEL (E04)

7+50
CL

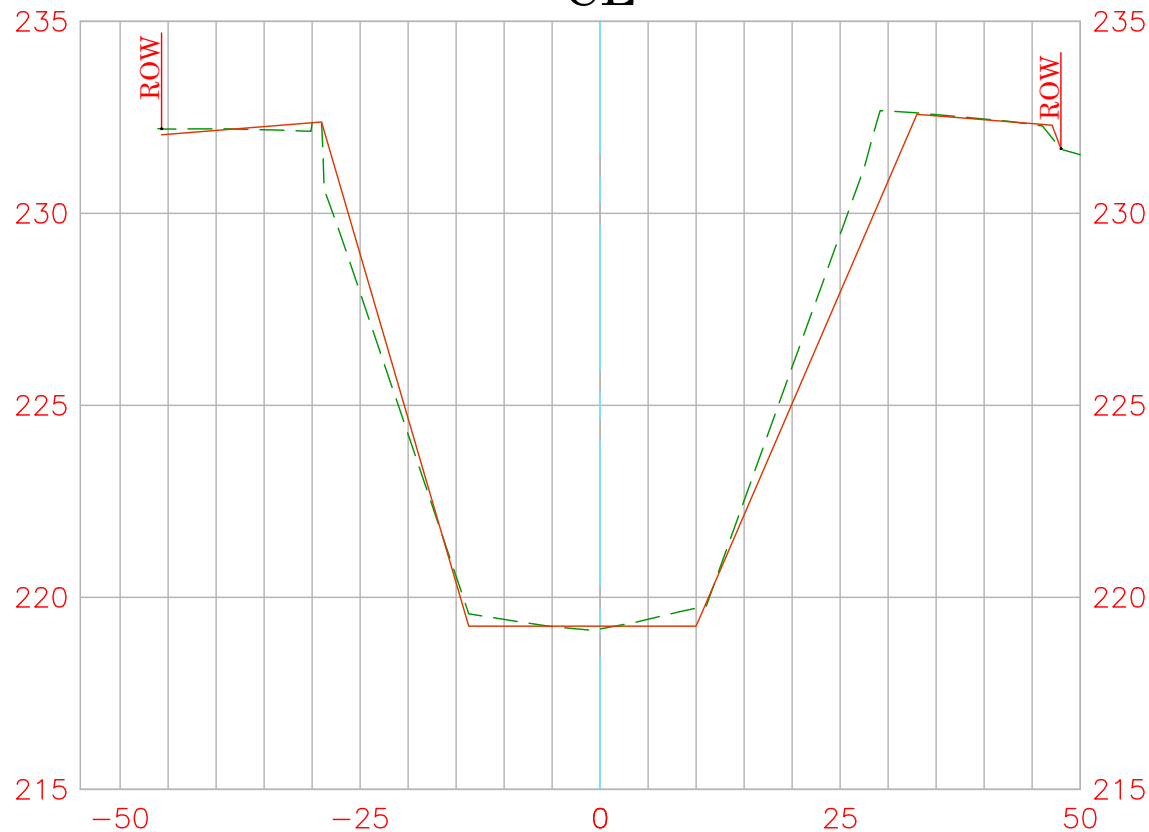

EXISTING CONDITION 2021
RECORD DRAWINGS:
DATE PREPARED: 3/31/2023



Vert. Scale: 1"=5'
Hor. Scale: 1"=20'


U.S. *Survey
Foot*

OC Public Works
OC Survey/Field Services
Boundary Analysis & Mapping

ATWOOD CHANNEL (E04)

8+00

CL

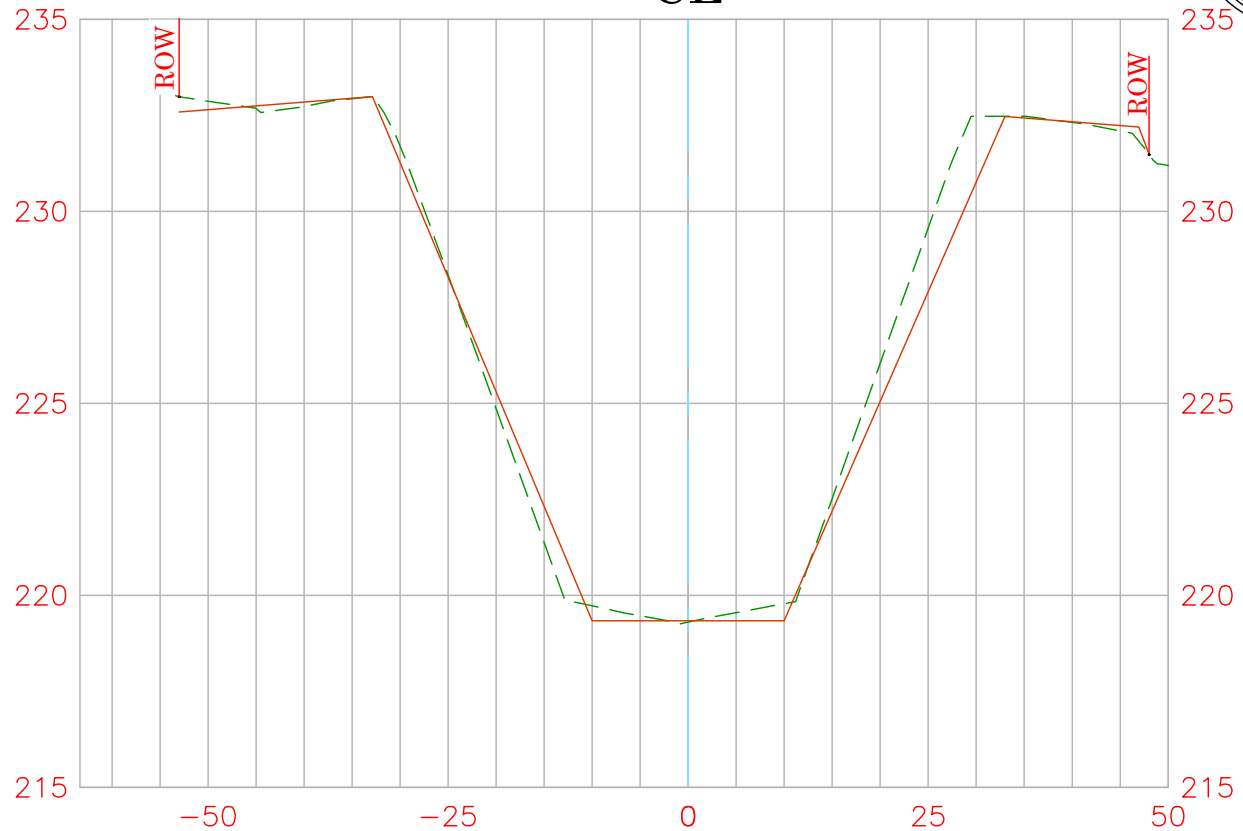

EXISTING CONDITION 2021

RECORD DRAWINGS:

DATE PREPARED: 3/31/2023



Vert. Scale: 1"=5'
Hor. Scale: 1"=20'


U.S. *Survey Foot*

OC Public Works
OC Survey/Field Services
Boundary Analysis & Mapping

ATWOOD CHANNEL (E04)

8+50

CL

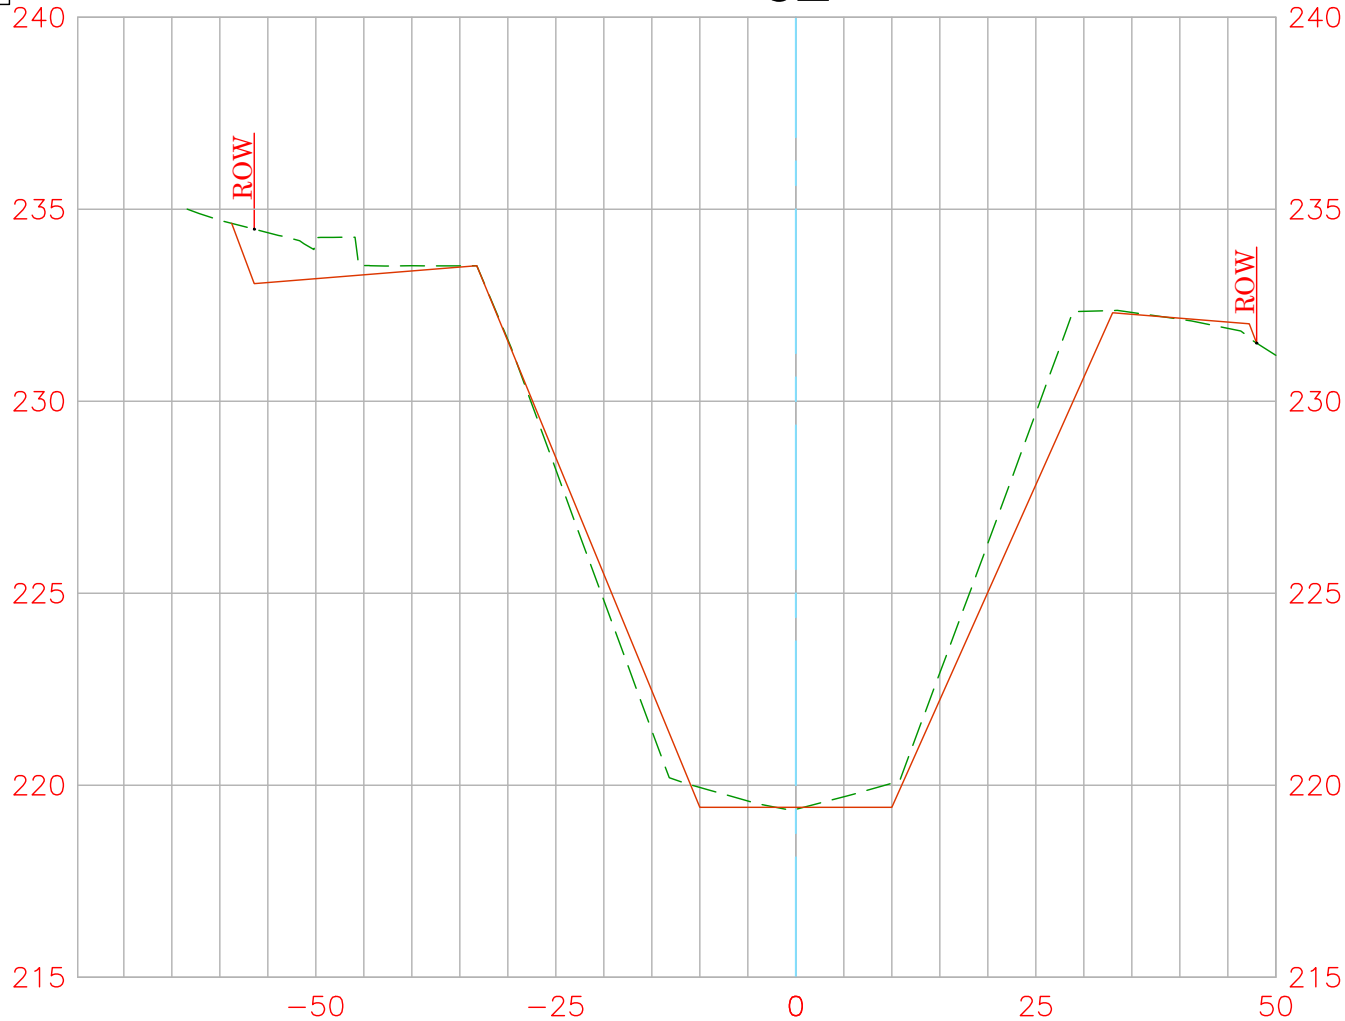

EXISTING CONDITION 2021

RECORD DRAWINGS:

DATE PREPARED: 3/31/2023

Vert. Scale: 1"=5'
Hor. Scale: 1"=20'


U.S. Survey Foot

OC Public Works
OC Survey/Field Services
Boundary Analysis & Mapping

ATWOOD CHANNEL (E04)

9+00

CL

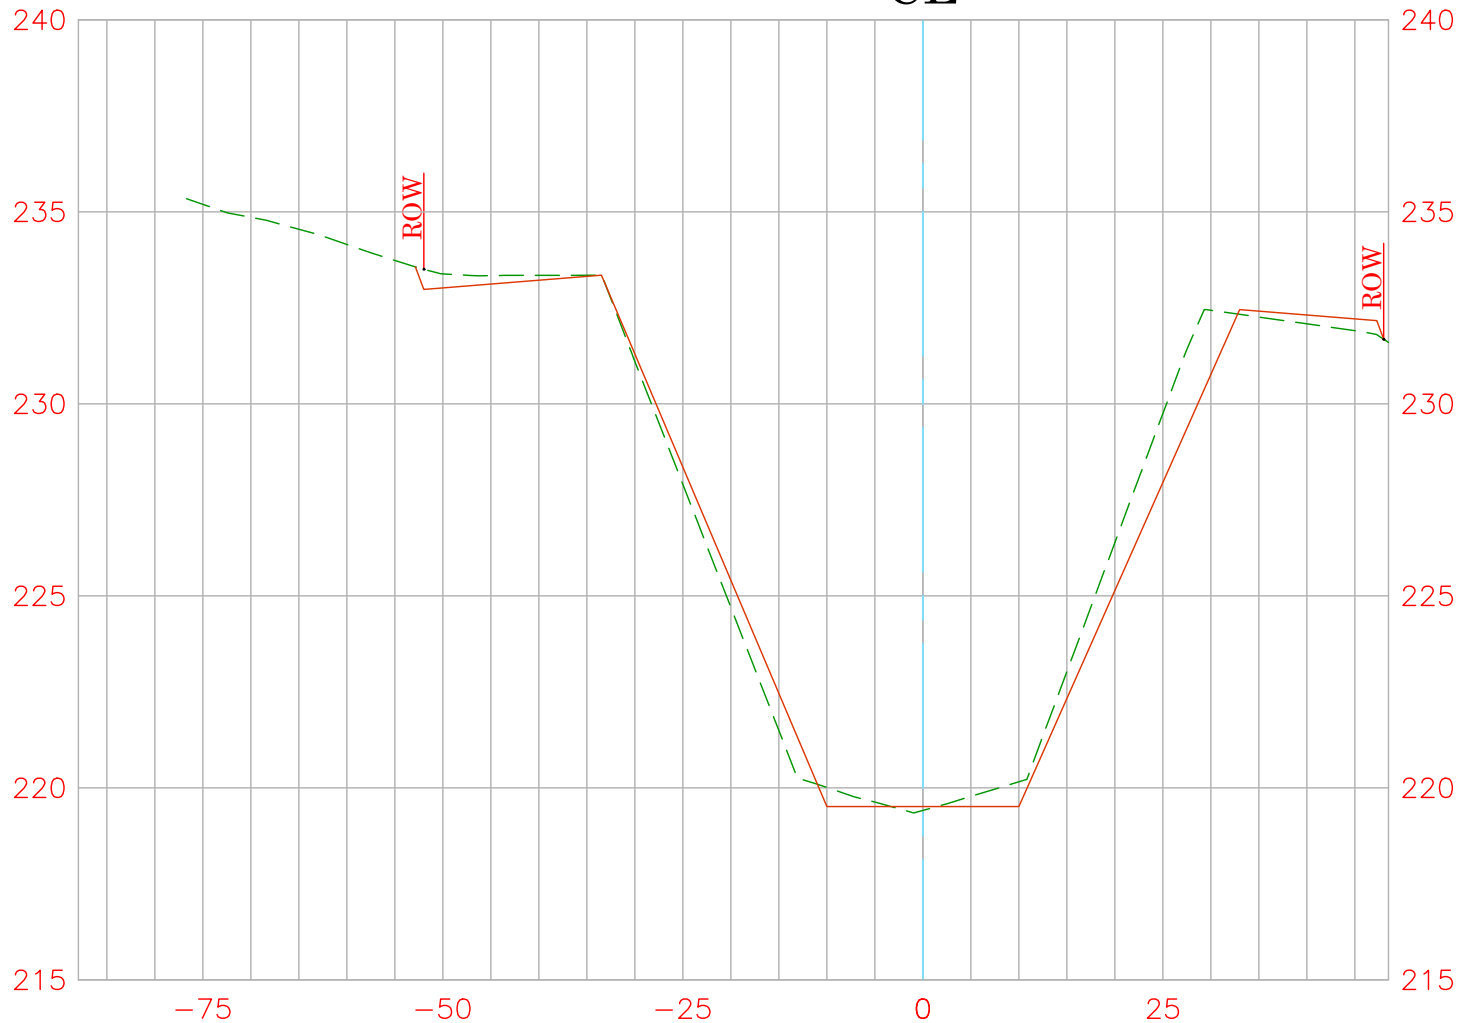

EXISTING CONDITION 2021

RECORD DRAWINGS:

DATE PREPARED: 3/31/2023

Vert. Scale: 1"=5'
Hor. Scale: 1"=20'


U.S. *Survey Foot*

OC Public Works
OC Survey/Field Services
Boundary Analysis & Mapping

ATWOOD CHANNEL (E04)

9+50

CL

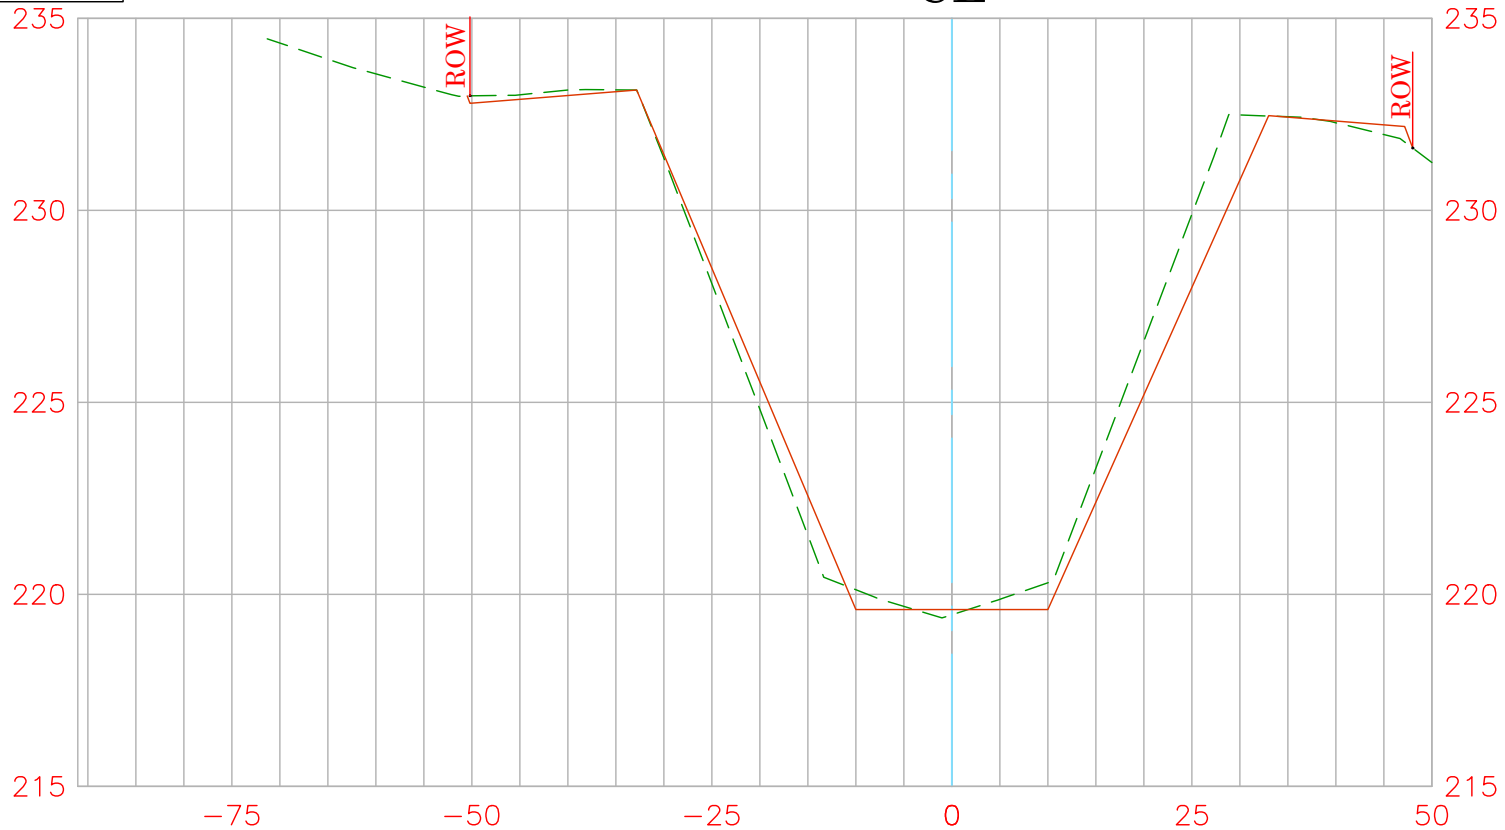

EXISTING CONDITION 2021

RECORD DRAWINGS:

DATE PREPARED: 3/31/2023


Vert. Scale: 1"=5'

Hor. Scale: 1"=20'

ATWOOD CHANNEL (E04)

10+00

CL

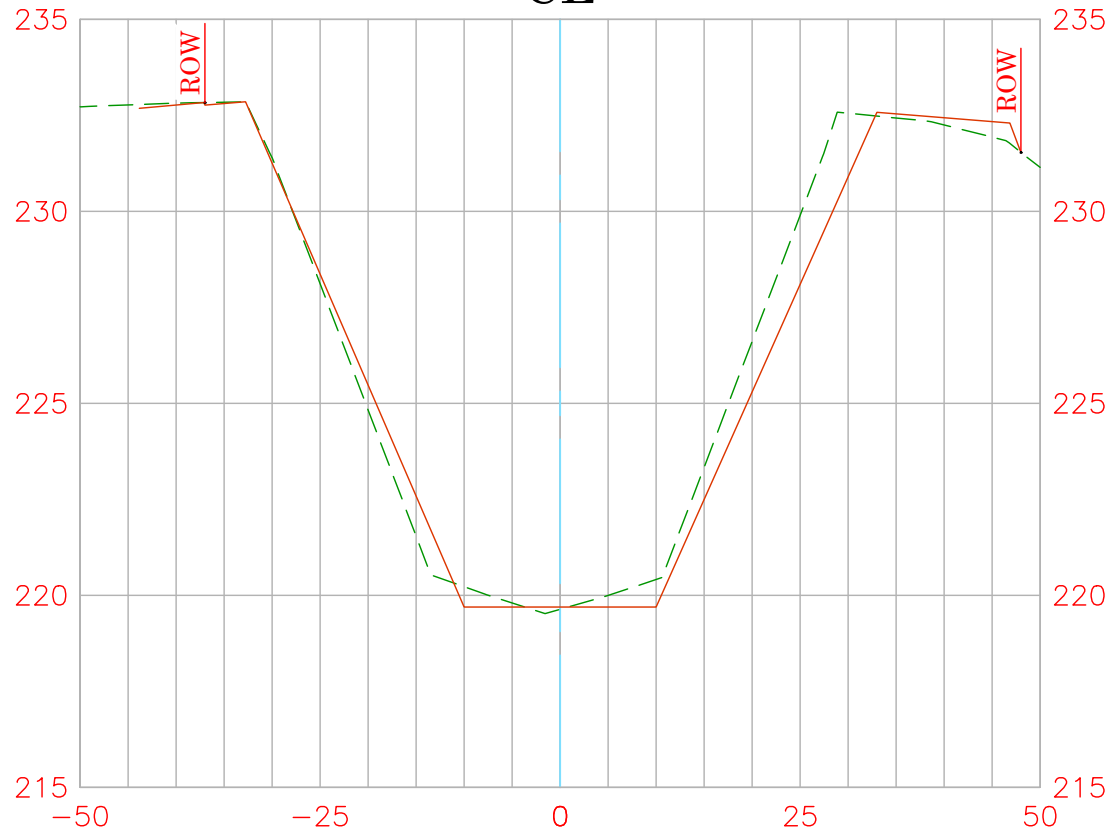

EXISTING CONDITION 2021
 RECORD DRAWINGS:
 DATE PREPARED: 3/31/2023



Vert. Scale: 1"=5'
 Hor. Scale: 1"=20'


U.S. *Survey
Foot*

OC Public Works
OC Survey/Field Services
Boundary Analysis & Mapping

ATWOOD CHANNEL (E04)

10+50

CL

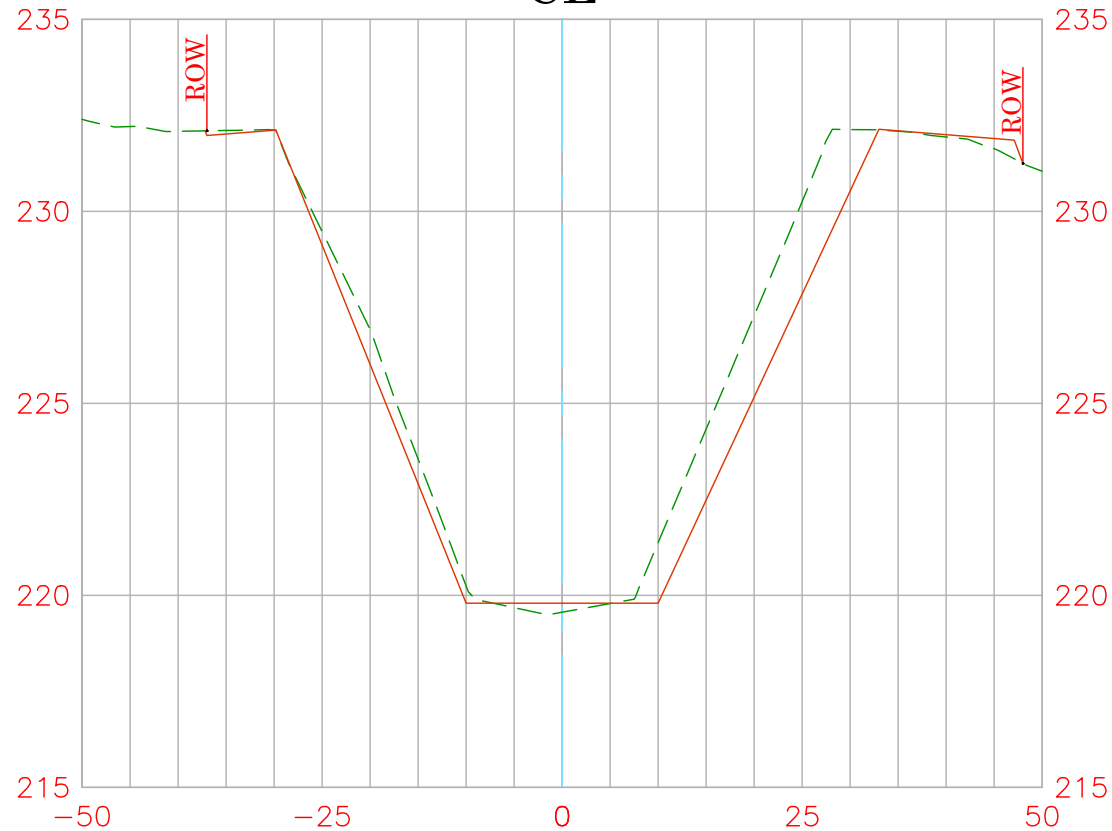

EXISTING CONDITION 2021

RECORD DRAWINGS:

DATE PREPARED: 3/31/2023




Vert. Scale: 1"=5'
Hor. Scale: 1"=20'

ATWOOD CHANNEL (E04)

11+00


CL

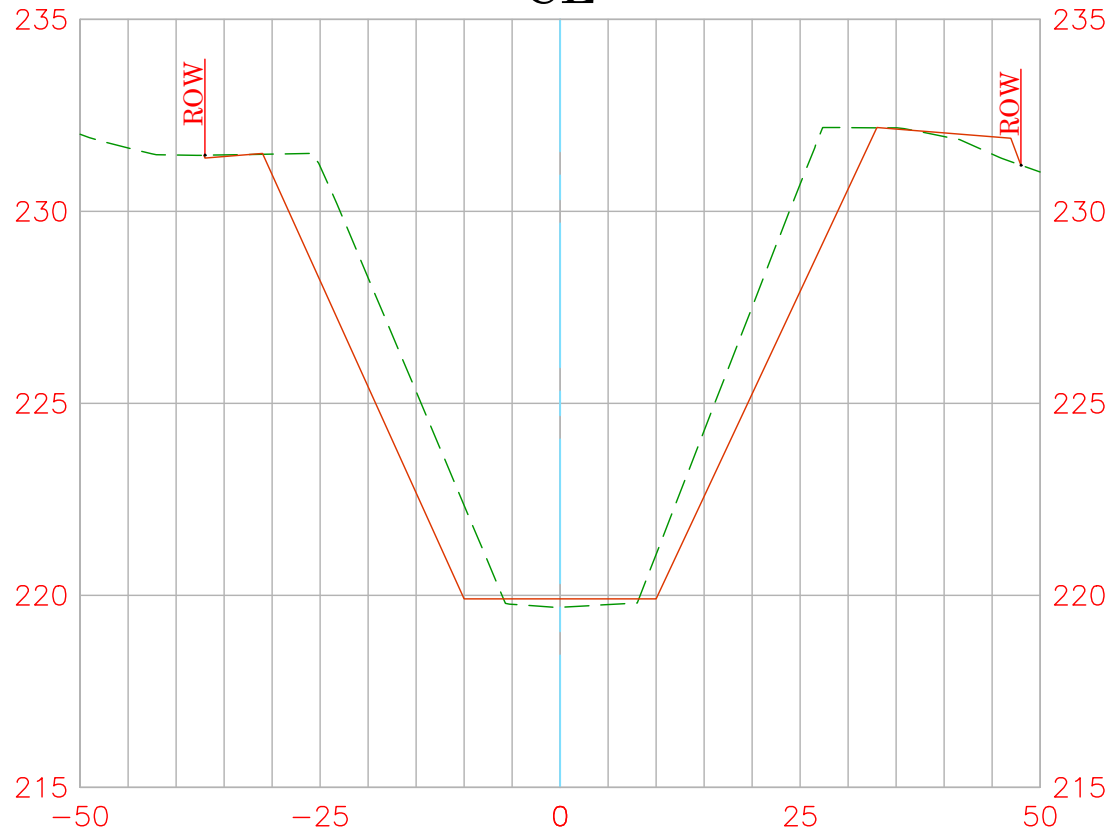

EXISTING CONDITION 2021
 RECORD DRAWINGS:
 DATE PREPARED: 3/31/2023





Vert. Scale: 1"=5'
 Hor. Scale: 1"=20'

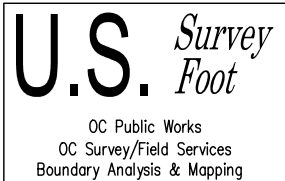


ATWOOD CHANNEL (E04)

11+50

CL

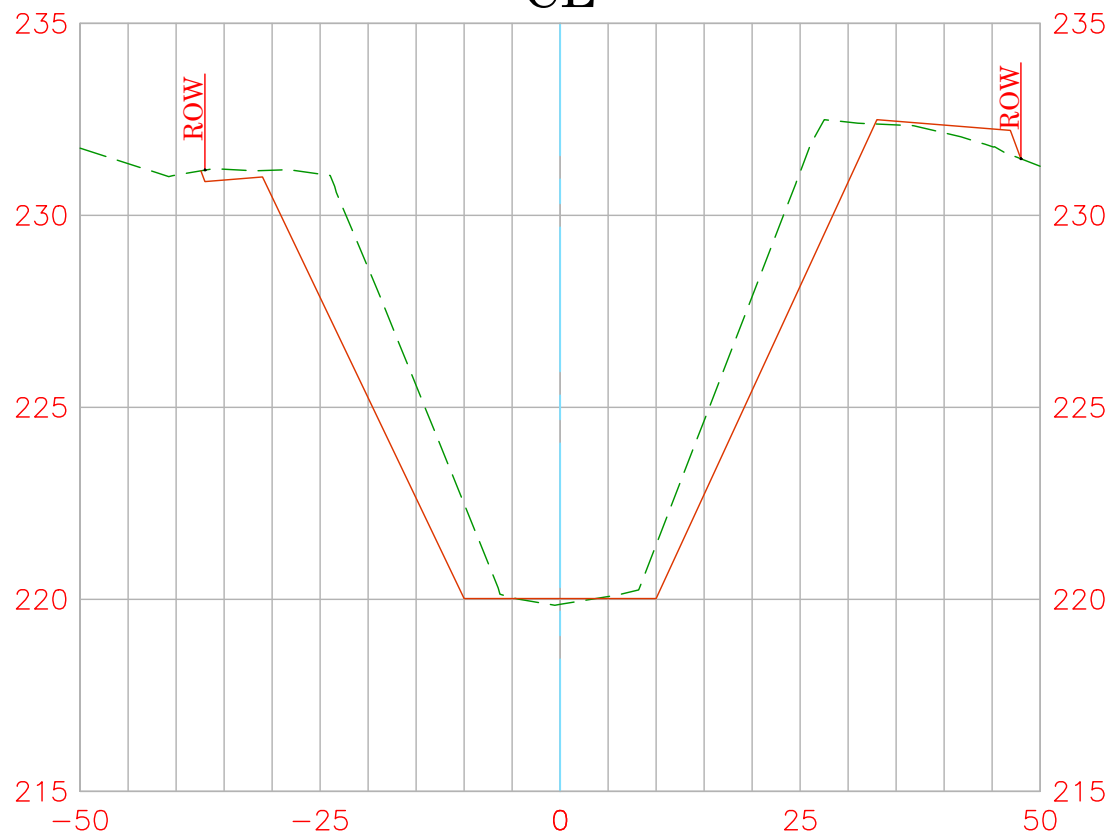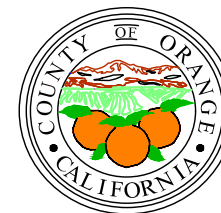

EXISTING CONDITION 2021
RECORD DRAWINGS:
DATE PREPARED: 3/31/2023

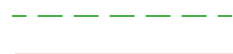


Vert. Scale: 1"=5'
Hor. Scale: 1"=20'

U.S. *Survey
Foot*

OC Public Works
OC Survey/Field Services
Boundary Analysis & Mapping

ATWOOD CHANNEL (E04)


12+00
CL

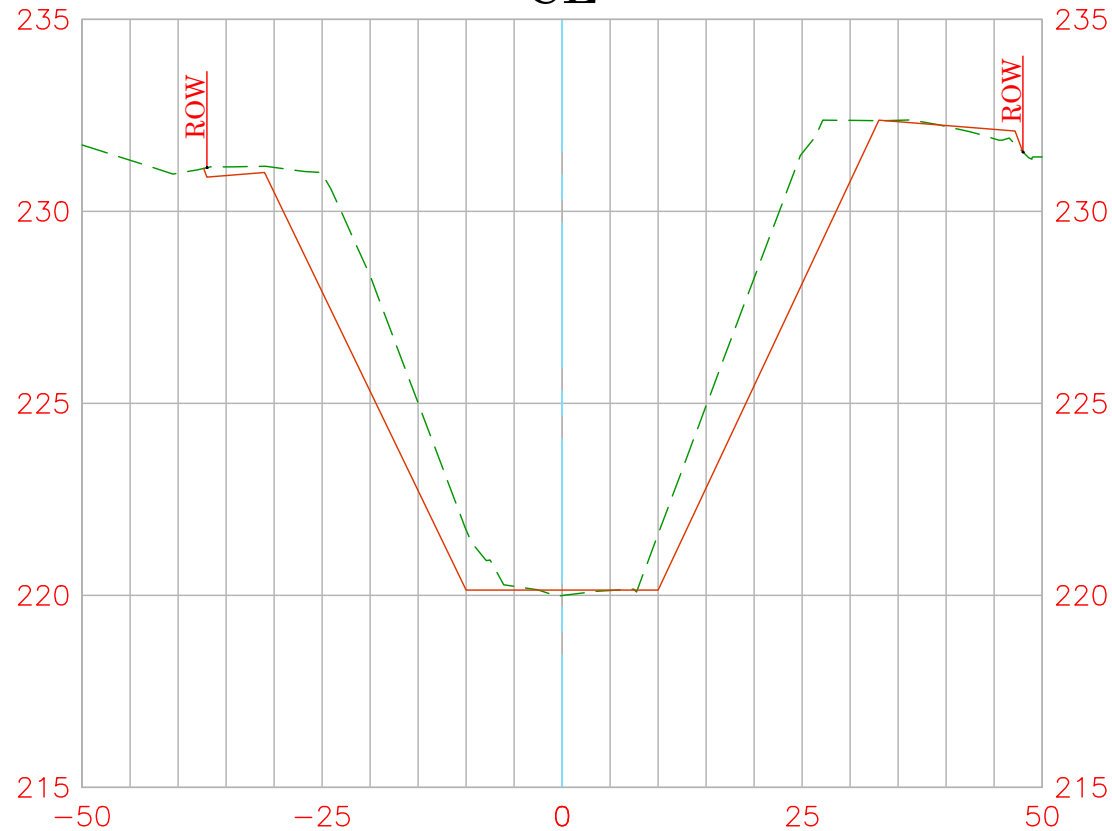



EXISTING CONDITION 2021
RECORD DRAWINGS:
DATE PREPARED: 3/31/2023



Vert. Scale: 1"=5'
Hor. Scale: 1"=20'

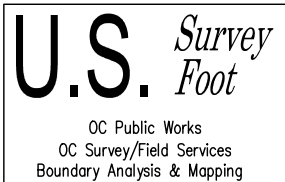

ATWOOD CHANNEL (E04)
12+50
CL

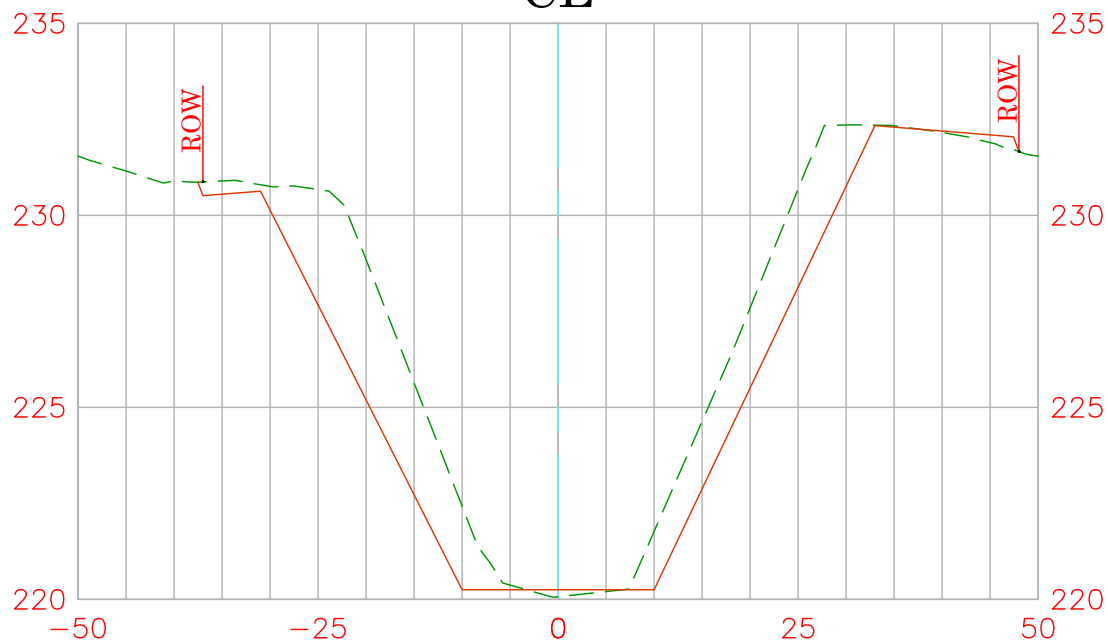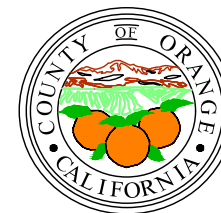

EXISTING CONDITION 2021
RECORD DRAWINGS:
DATE PREPARED: 3/31/2023

Vert. Scale: 1"=5'
Hor. Scale: 1"=20'


U.S. *Survey
Foot*

OC Public Works
OC Survey/Field Services
Boundary Analysis & Mapping

ATWOOD CHANNEL (E04)

13+00

CL

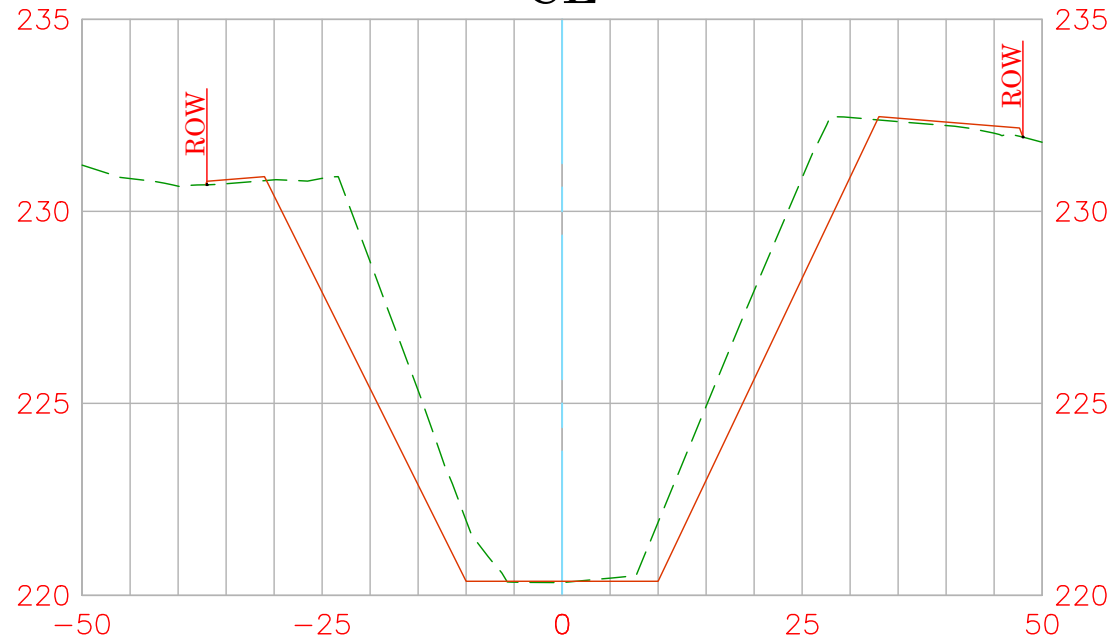

EXISTING CONDITION 2021

RECORD DRAWINGS:

DATE PREPARED: 3/31/2023




Vert. Scale: 1"=5'
Hor. Scale: 1"=20'

U.S. *Survey
Foot*

OC Public Works
OC Survey/Field Services
Boundary Analysis & Mapping

ATWOOD CHANNEL (E04) 13+50 CL

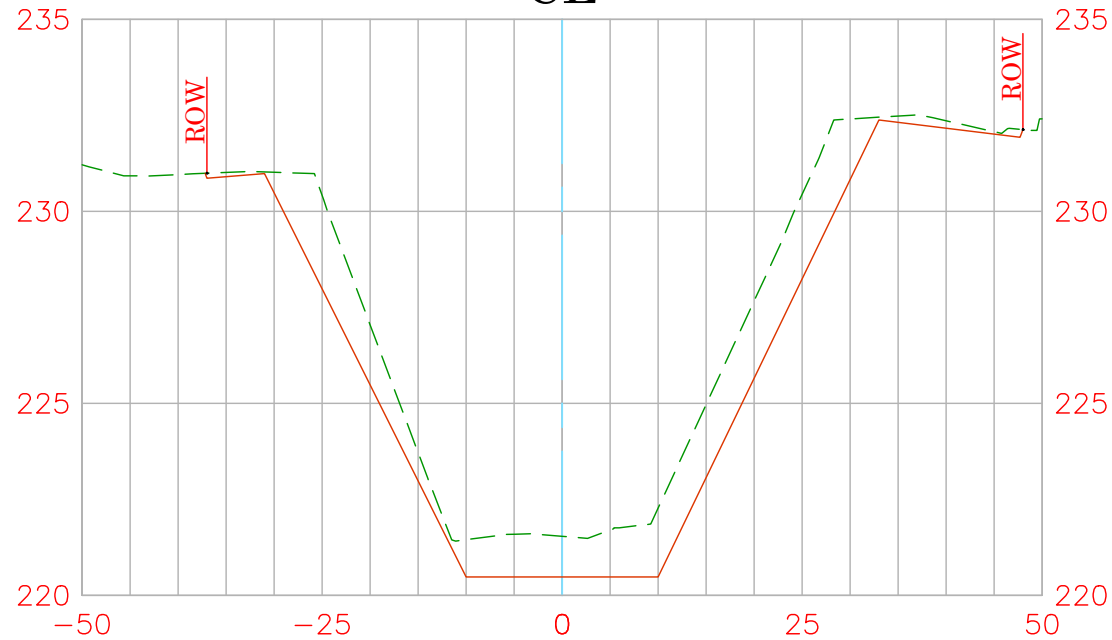

EXISTING CONDITION 2021

RECORD DRAWINGS:

DATE PREPARED: 3/31/2023



Vert. Scale: 1"=5'
Hor. Scale: 1"=20'


U.S. *Survey
Foot*

OC Public Works
OC Survey/Field Services
Boundary Analysis & Mapping

ATWOOD CHANNEL (E04)

14+00

CL

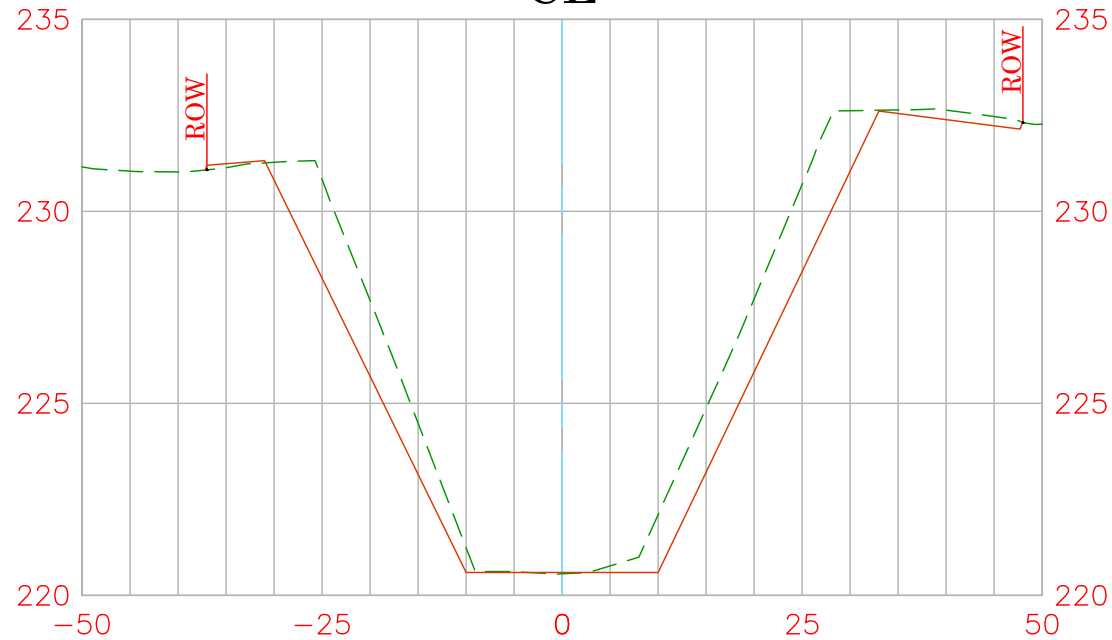

EXISTING CONDITION 2021

RECORD DRAWINGS:

DATE PREPARED: 3/31/2023




Vert. Scale: 1"=5'
Hor. Scale: 1"=20'

U.S. *Survey
Foot*

OC Public Works
OC Survey/Field Services
Boundary Analysis & Mapping

ATWOOD CHANNEL (E04) 14+50 CL

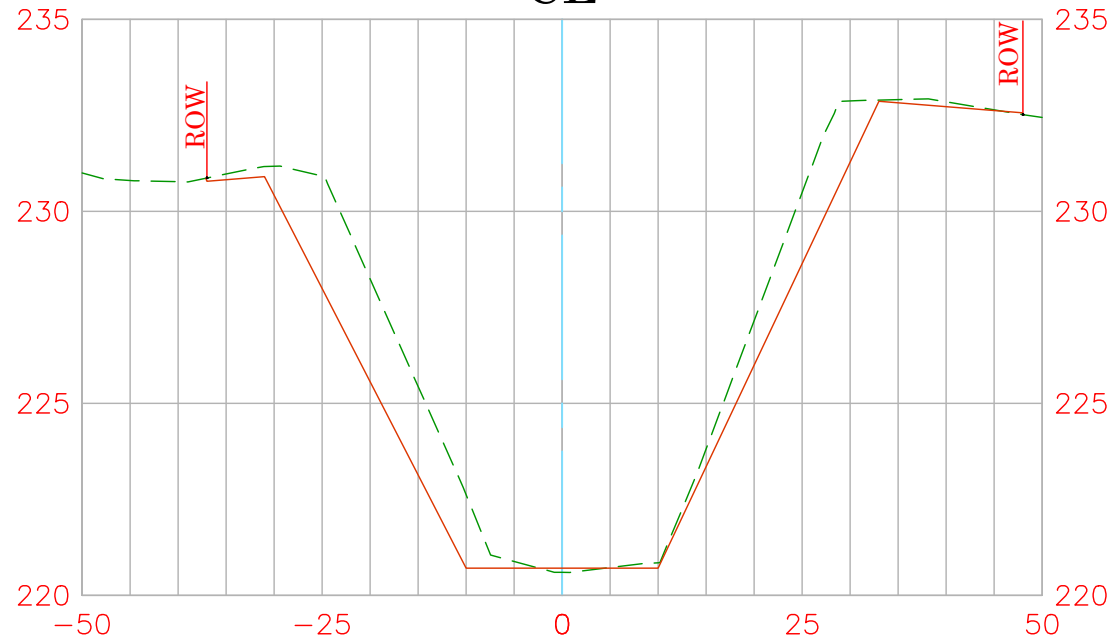

EXISTING CONDITION 2021

RECORD DRAWINGS:

DATE PREPARED: 3/31/2023




Vert. Scale: 1"=5'
Hor. Scale: 1"=20'

U.S. *Survey
Foot*

OC Public Works
OC Survey/Field Services
Boundary Analysis & Mapping

ATWOOD CHANNEL (E04) 15+00 CL

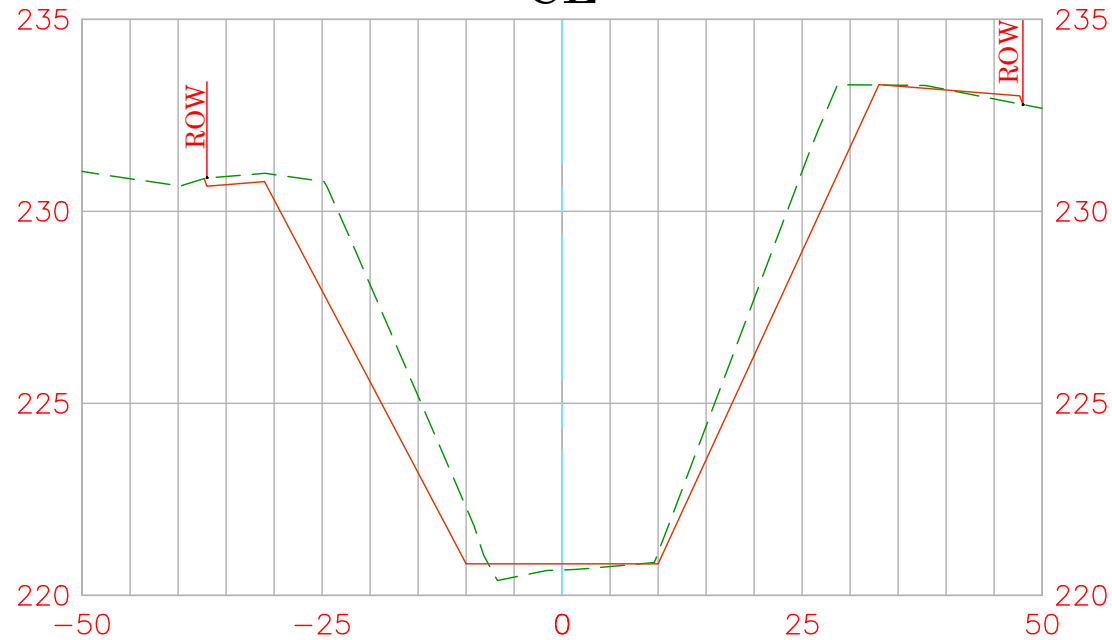

EXISTING CONDITION 2021

RECORD DRAWINGS:

DATE PREPARED: 3/31/2023




Vert. Scale: 1"=5'
Hor. Scale: 1"=20'

U.S. *Survey
Foot*

OC Public Works
OC Survey/Field Services
Boundary Analysis & Mapping

ATWOOD CHANNEL (E04) 15+50 CL

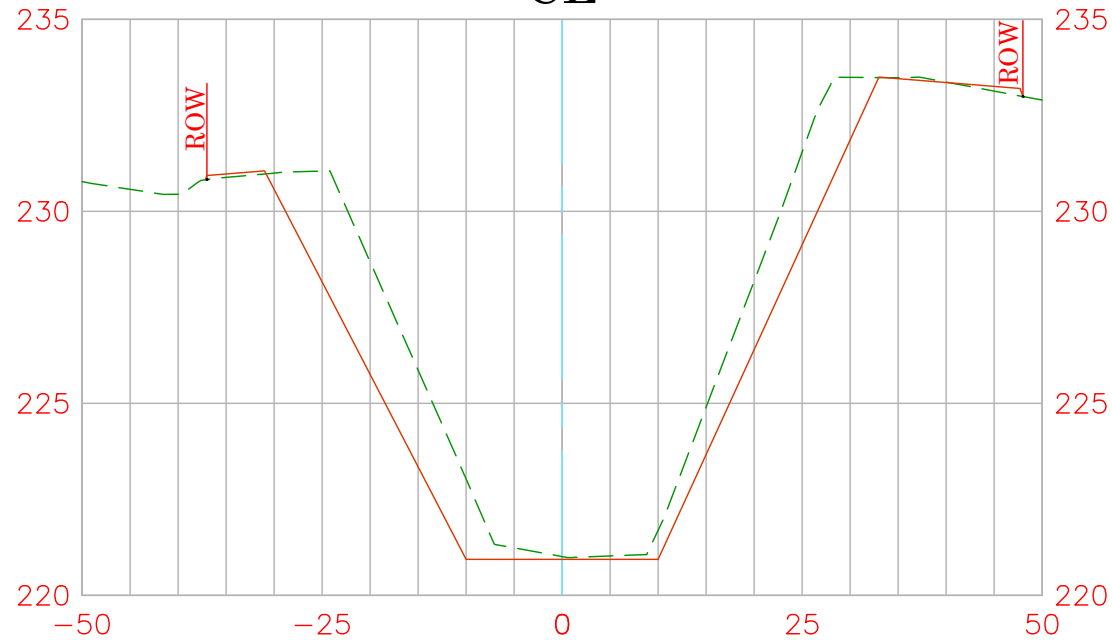

EXISTING CONDITION 2021

RECORD DRAWINGS:

DATE PREPARED: 3/31/2023




Vert. Scale: 1"=5'
Hor. Scale: 1"=20'

U.S. *Survey
Foot*

OC Public Works
OC Survey/Field Services
Boundary Analysis & Mapping

ATWOOD CHANNEL (E04) 16+00 CL

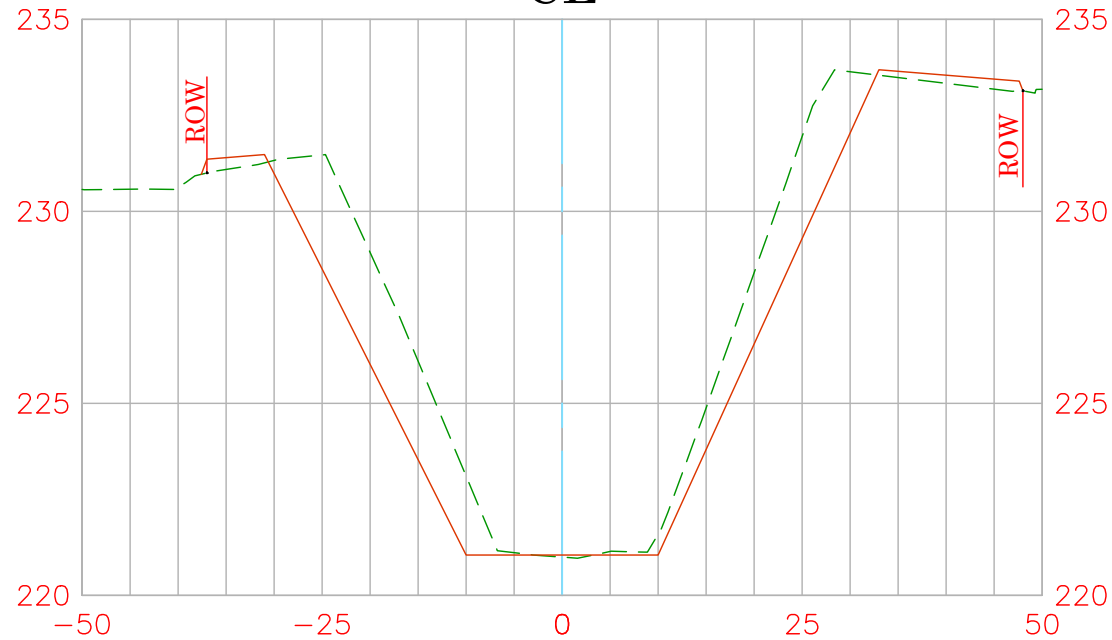

EXISTING CONDITION 2021
RECORD DRAWINGS:
DATE PREPARED: 3/31/2023




Vert. Scale: 1"=5'
Hor. Scale: 1"=20'

U.S. *Survey
Foot*

OC Public Works
OC Survey/Field Services
Boundary Analysis & Mapping

ATWOOD CHANNEL (E04) 16+50 CL

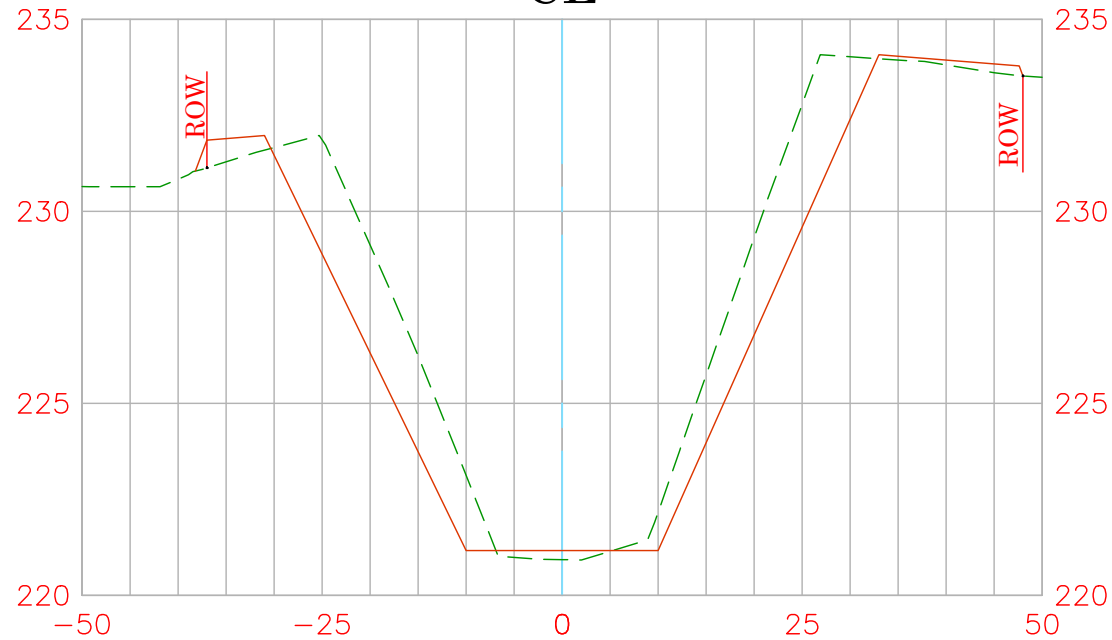

EXISTING CONDITION 2021

RECORD DRAWINGS:

DATE PREPARED: 3/31/2023





Vert. Scale: 1"=5'
Hor. Scale: 1"=20'


ATWOOD CHANNEL (E04)

17+00

CL

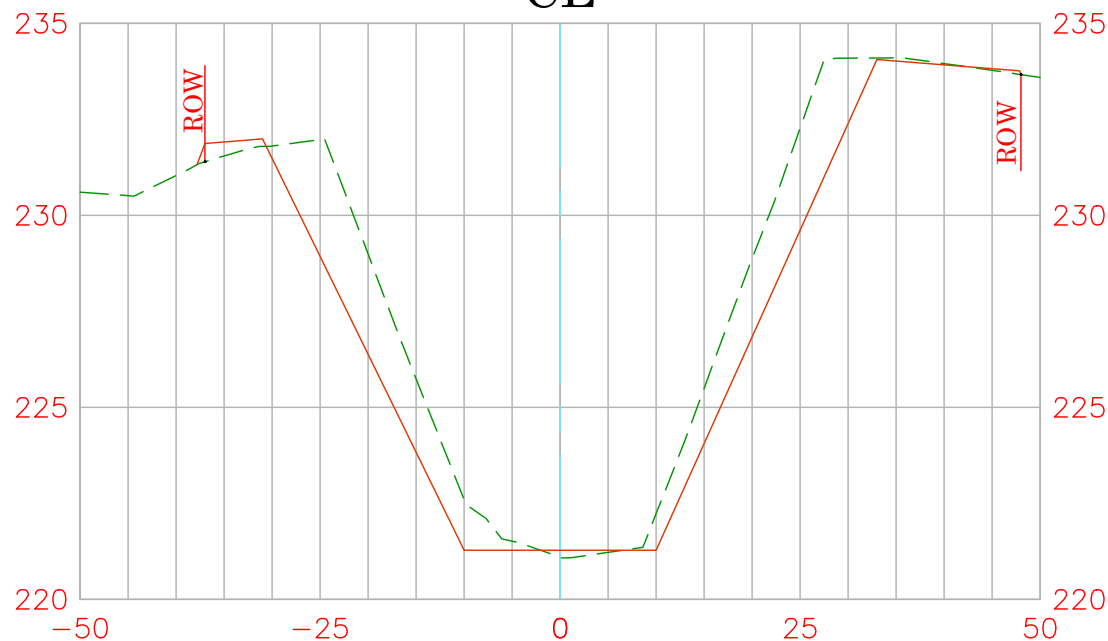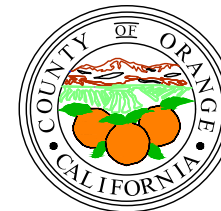

EXISTING CONDITION 2021
RECORD DRAWINGS:
DATE PREPARED: 3/31/2023

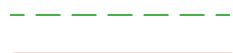


Vert. Scale: 1"=5'
Hor. Scale: 1"=20'

U.S. *Survey
Foot*

OC Public Works
OC Survey/Field Services
Boundary Analysis & Mapping

ATWOOD CHANNEL (E04) 17+50 CL

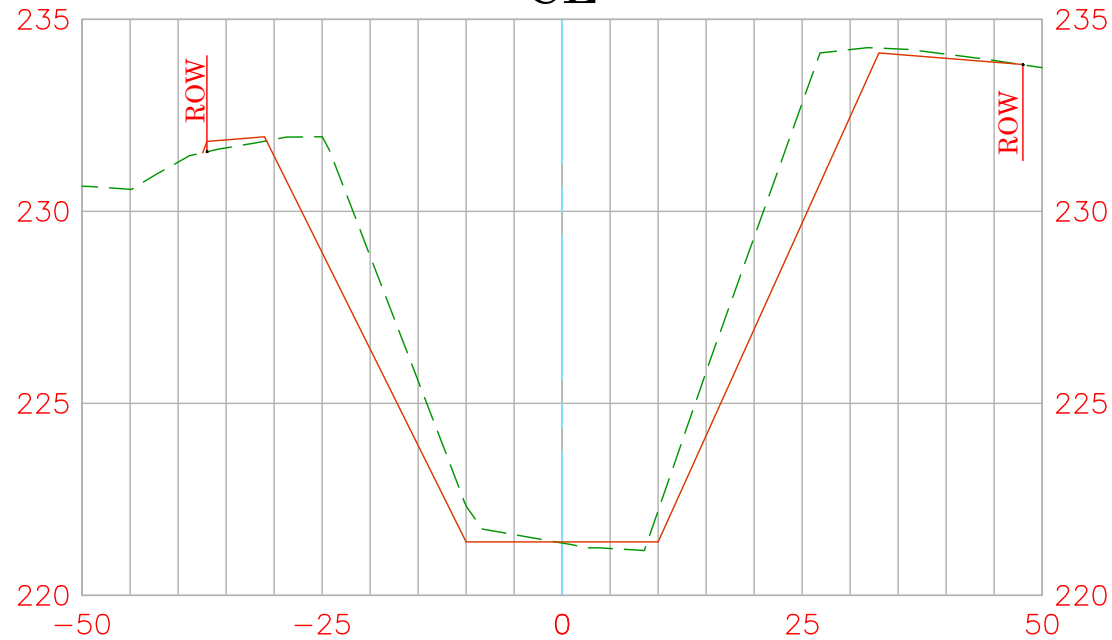

EXISTING CONDITION 2021

RECORD DRAWINGS:

DATE PREPARED: 3/31/2023




Vert. Scale: 1"=5'
Hor. Scale: 1"=20'

ATWOOD CHANNEL (E04)

18+00

CL

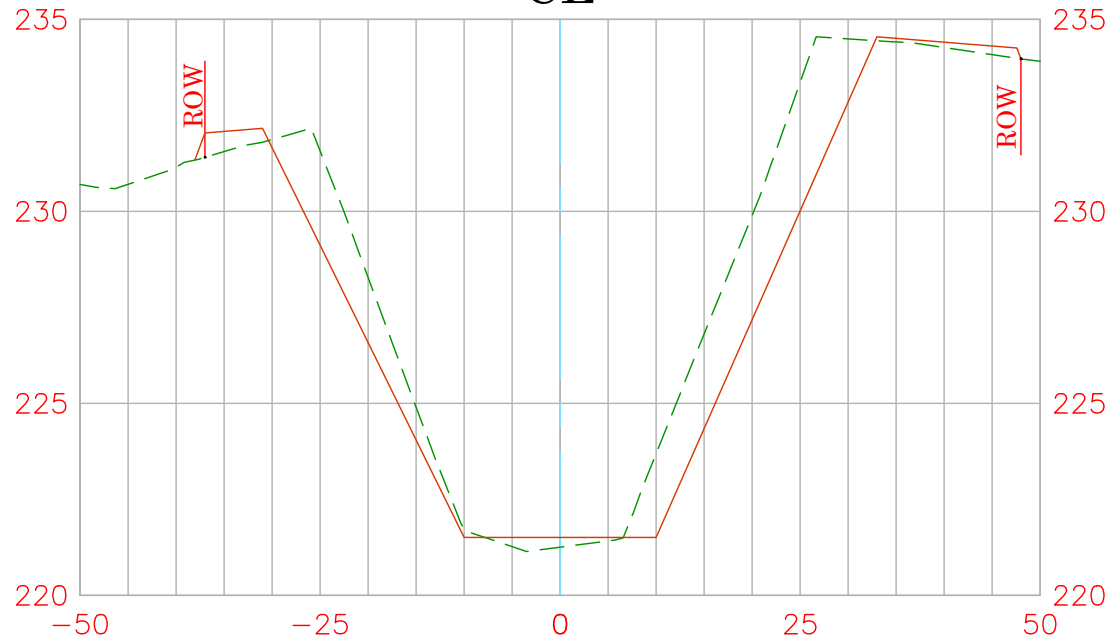

EXISTING CONDITION 2021
 RECORD DRAWINGS:
 DATE PREPARED: 3/31/2023




Vert. Scale: 1"=5'
 Hor. Scale: 1"=20'

ATWOOD CHANNEL (E04)

18+50


CL

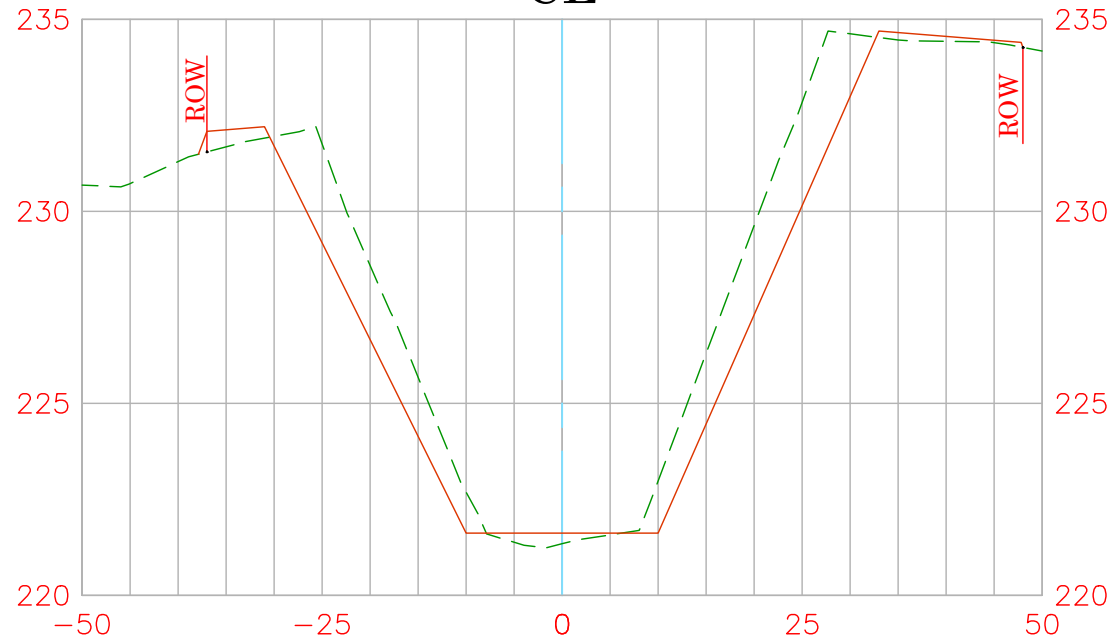

EXISTING CONDITION 2021
 RECORD DRAWINGS:
 DATE PREPARED: 3/31/2023




Vert. Scale: 1"=5'
 Hor. Scale: 1"=20'

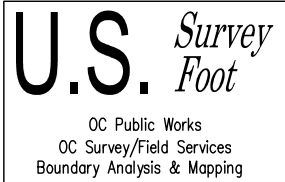

ATWOOD CHANNEL (E04)

19+00


CL

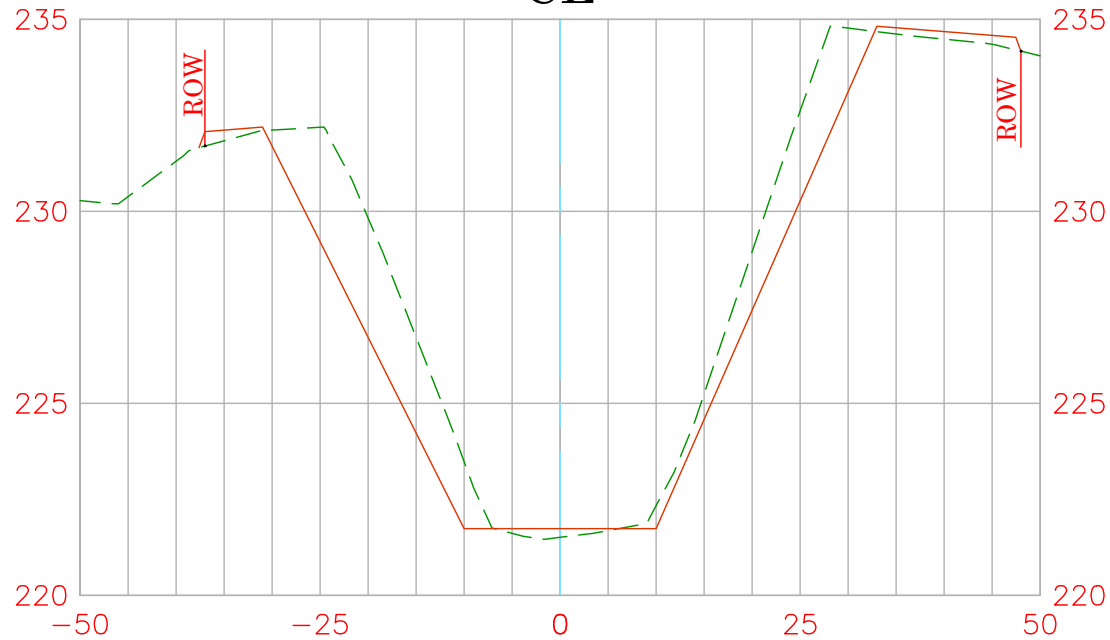

EXISTING CONDITION 2021
RECORD DRAWINGS:
DATE PREPARED: 3/31/2023





Vert. Scale: 1"=5'
Hor. Scale: 1"=20'

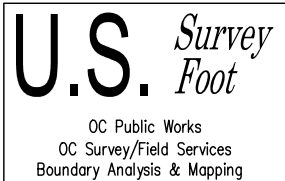


ATWOOD CHANNEL (E04)

19+50


CL

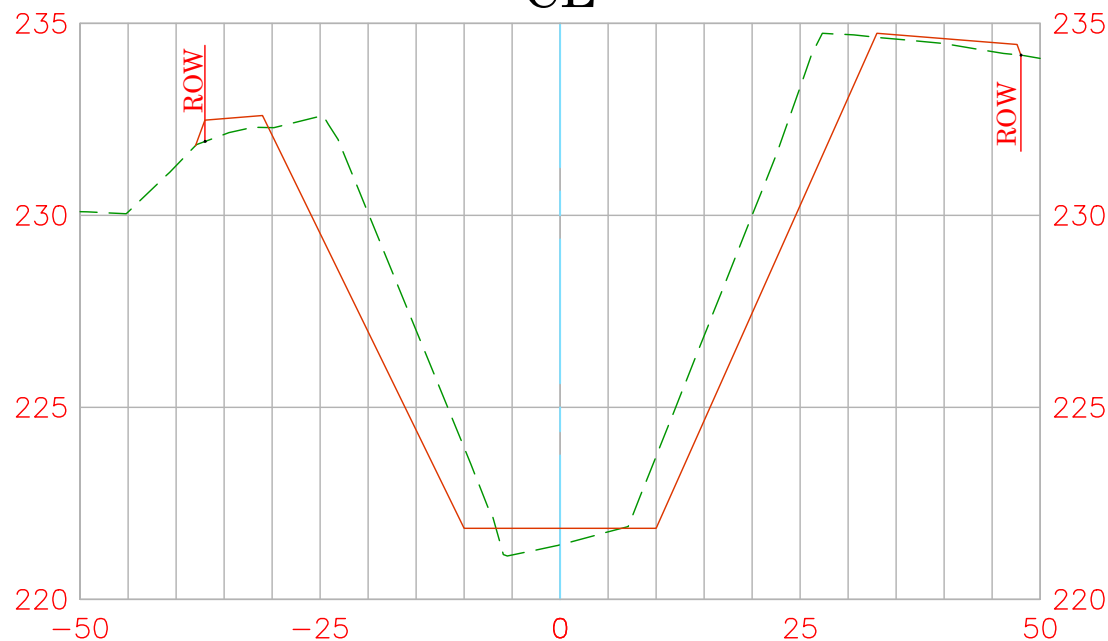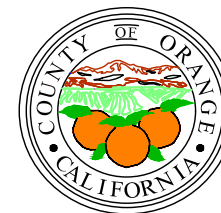

EXISTING CONDITION 2021
RECORD DRAWINGS:
DATE PREPARED: 3/31/2023

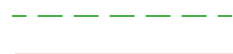


Vert. Scale: 1"=5'
Hor. Scale: 1"=20'

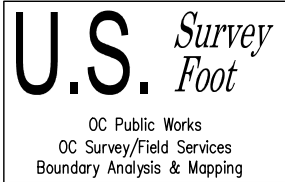

ATWOOD CHANNEL (E04)

20+00

CL

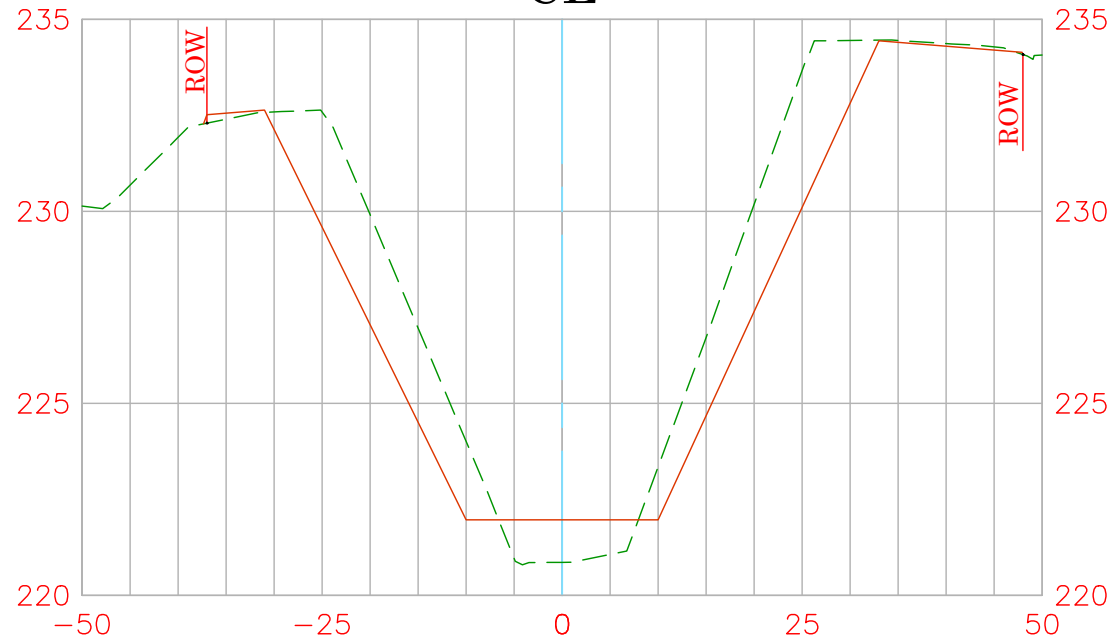

EXISTING CONDITION 2021
RECORD DRAWINGS:
DATE PREPARED: 3/31/2023




Vert. Scale: 1"=5'
Hor. Scale: 1"=20'

U.S. *Survey
Foot*

OC Public Works
OC Survey/Field Services
Boundary Analysis & Mapping

ATWOOD CHANNEL (E04) 20+50 CL

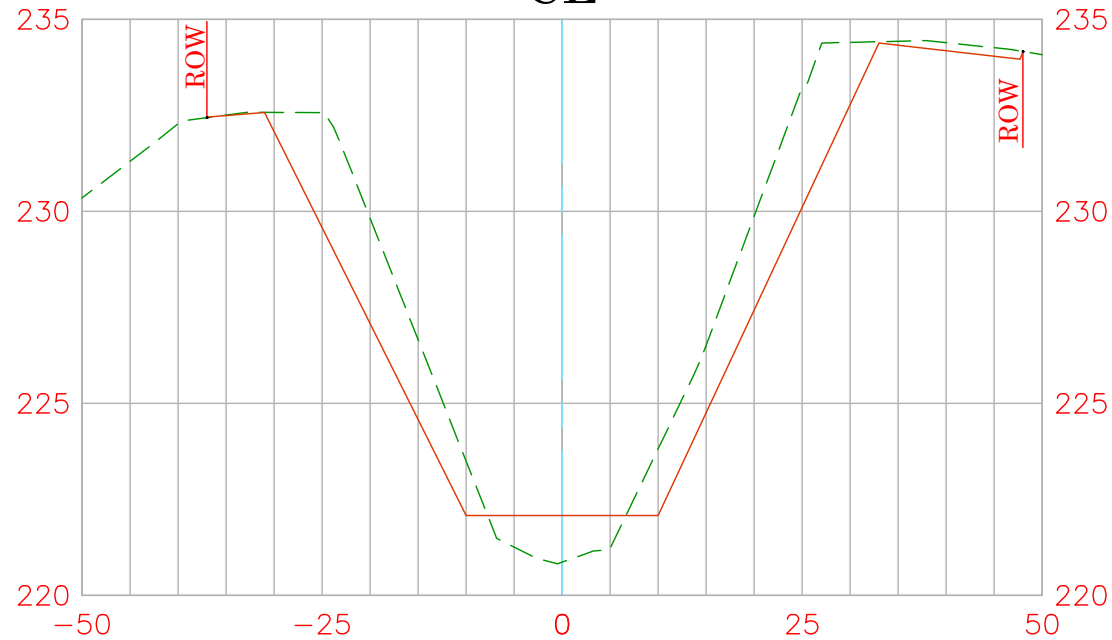


EXISTING CONDITION 2021

RECORD DRAWINGS:

DATE PREPARED: 3/31/2023





Vert. Scale: 1"=5'
Hor. Scale: 1"=20'

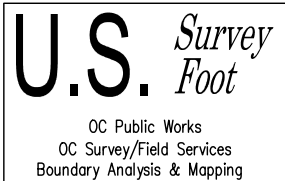


ATWOOD CHANNEL (E04)

21+00


CL

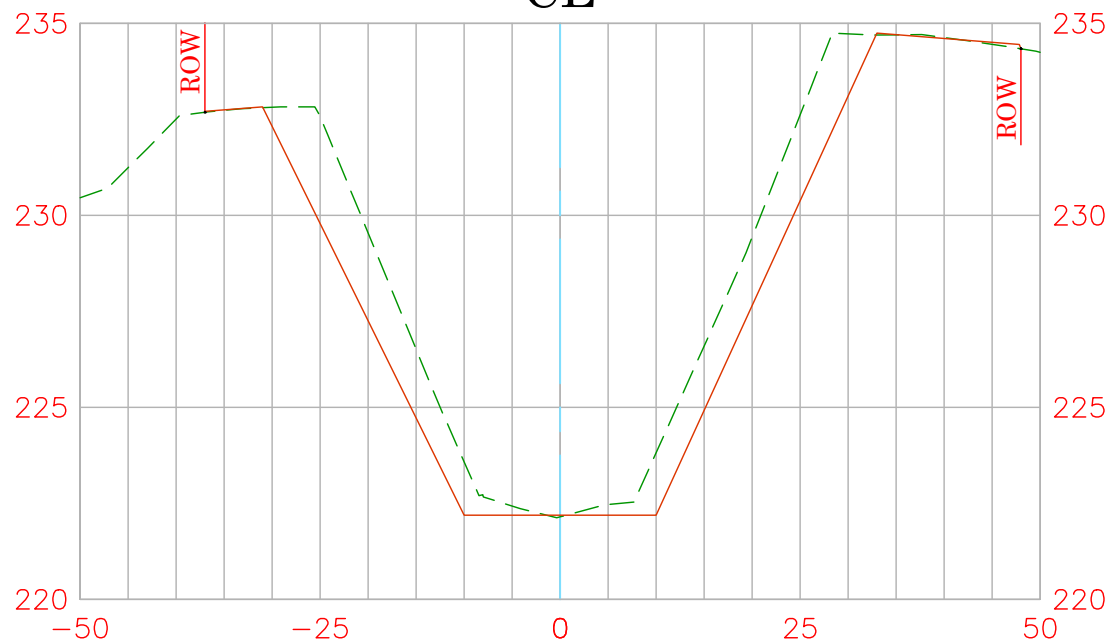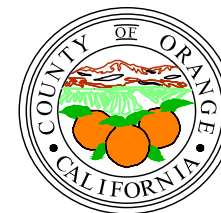

EXISTING CONDITION 2021
RECORD DRAWINGS:
DATE PREPARED: 3/31/2023

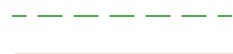


Vert. Scale: 1"=5'
Hor. Scale: 1"=20'

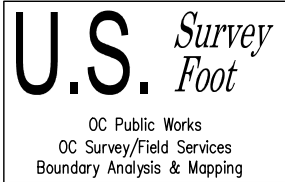

ATWOOD CHANNEL (E04)

21+50


CL

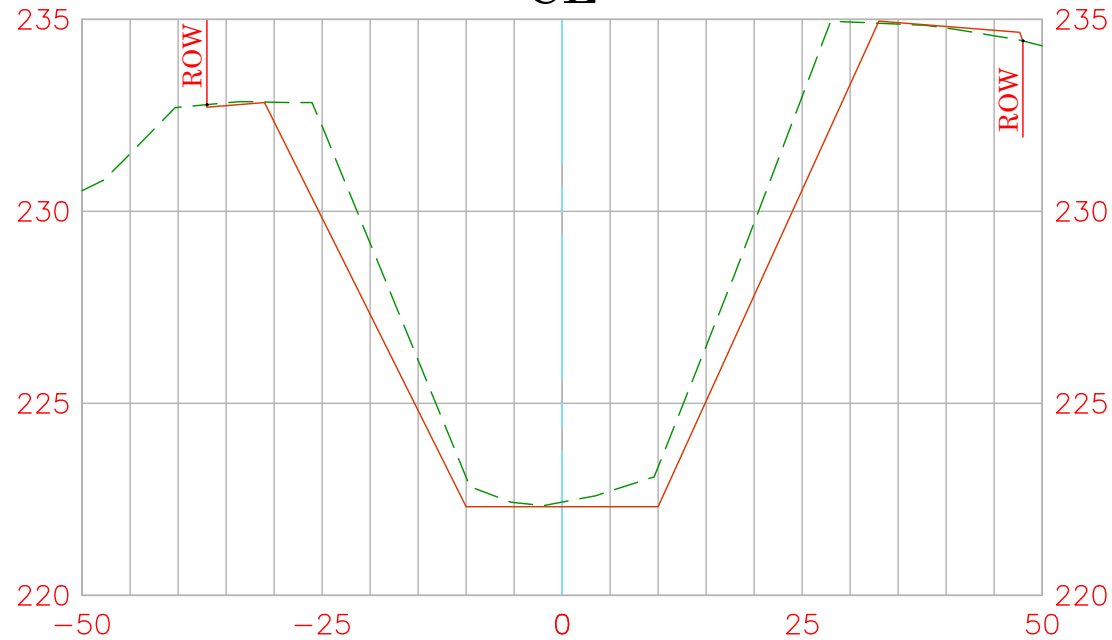

EXISTING CONDITION 2021
RECORD DRAWINGS:
DATE PREPARED: 3/31/2023




Vert. Scale: 1"=5'
Hor. Scale: 1"=20'

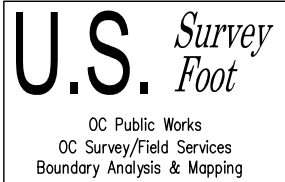

ATWOOD CHANNEL (E04)

22+00


CL

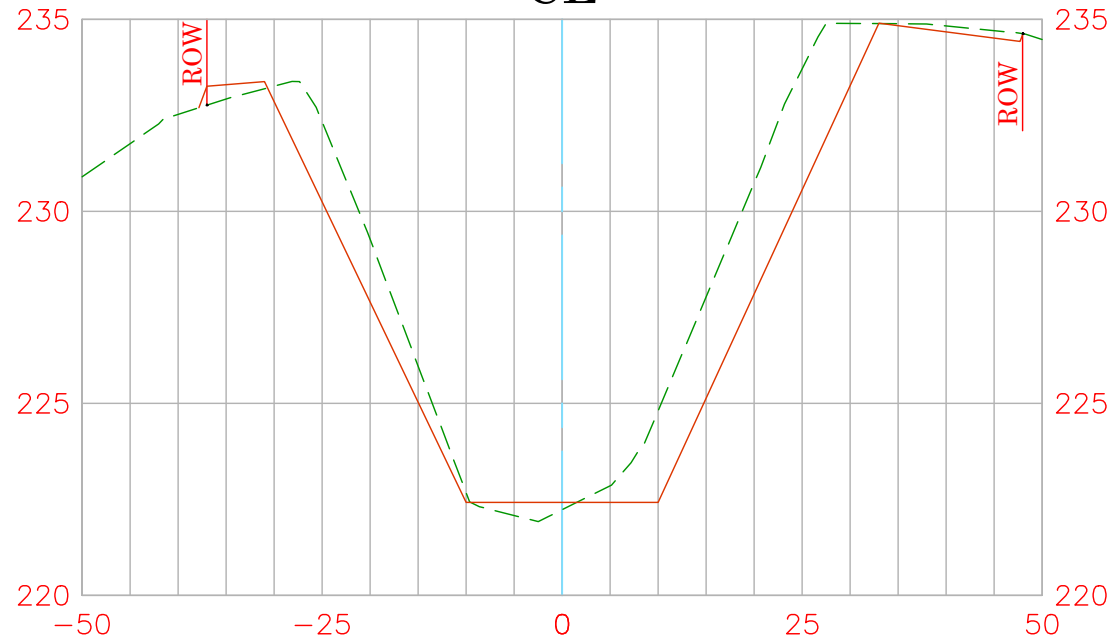

EXISTING CONDITION 2021
RECORD DRAWINGS:
DATE PREPARED: 3/31/2023




Vert. Scale: 1"=5'
Hor. Scale: 1"=20'

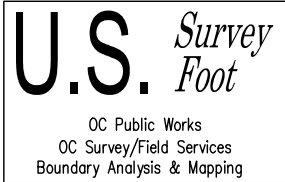

ATWOOD CHANNEL (E04)

22+50

CL

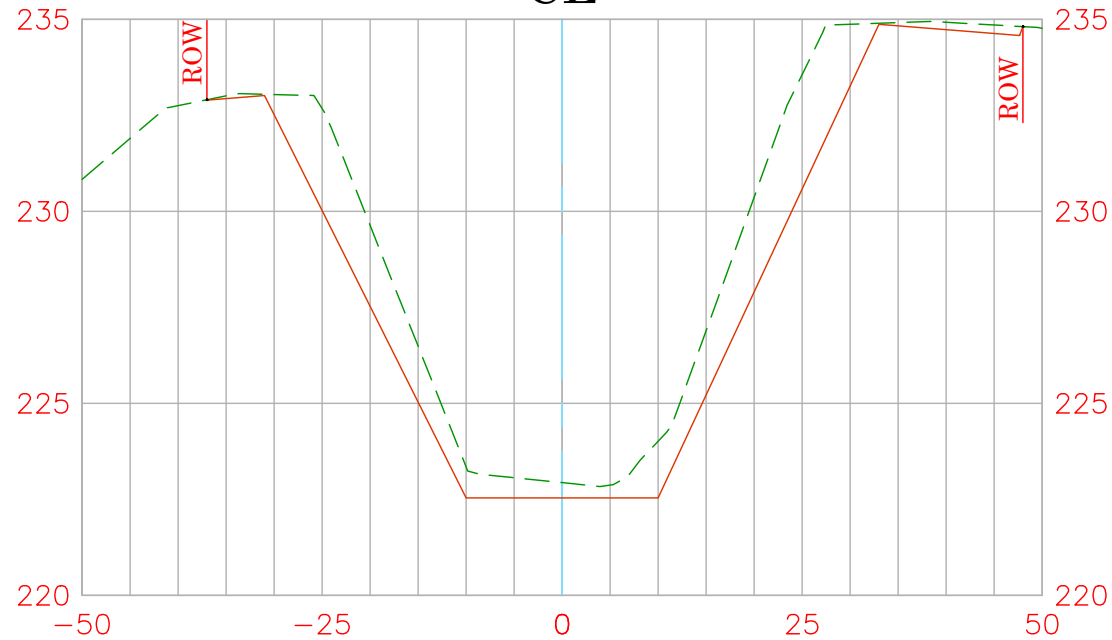

EXISTING CONDITION 2021
RECORD DRAWINGS:
DATE PREPARED: 3/31/2023



Vert. Scale: 1"=5'
Hor. Scale: 1"=20'


U.S. *Survey
Foot*

OC Public Works
OC Survey/Field Services
Boundary Analysis & Mapping

ATWOOD CHANNEL (E04)

23+00

CL

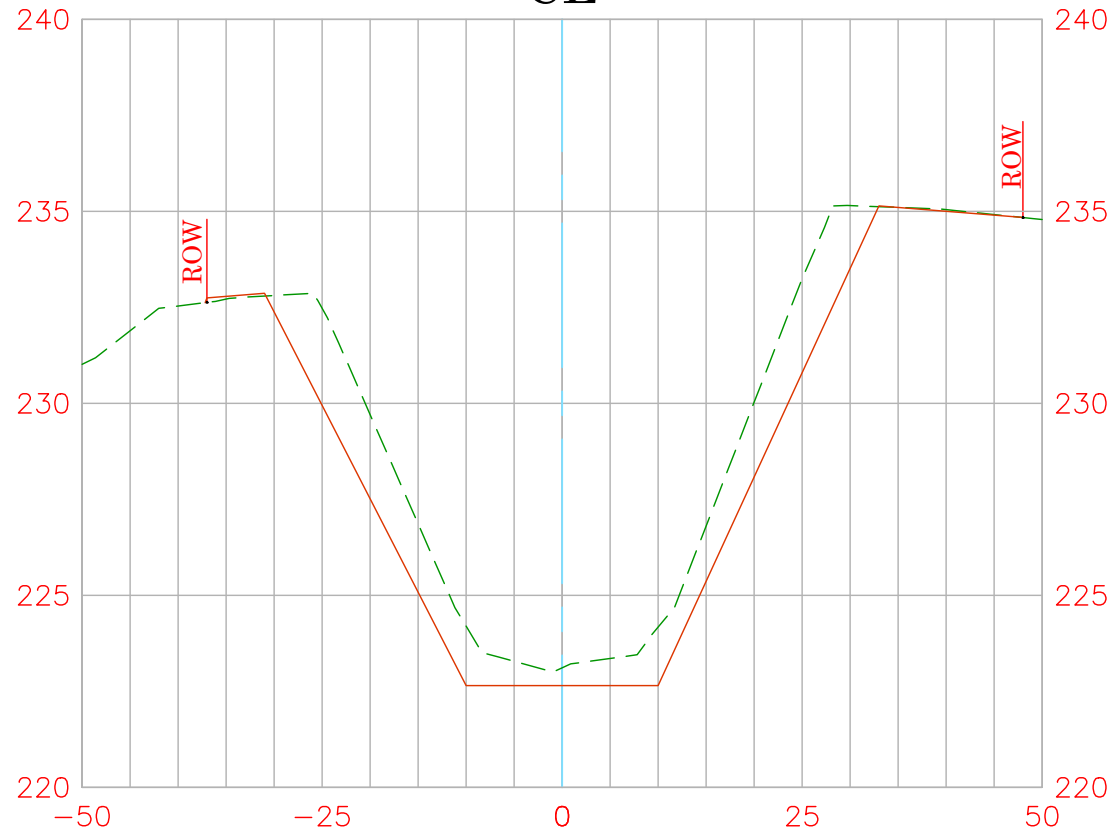


EXISTING CONDITION 2021

RECORD DRAWINGS:

DATE PREPARED: 3/31/2023




Vert. Scale: 1"=5'
Hor. Scale: 1"=20'

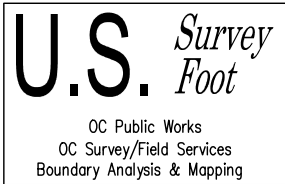

ATWOOD CHANNEL (E04)

23+50

CL

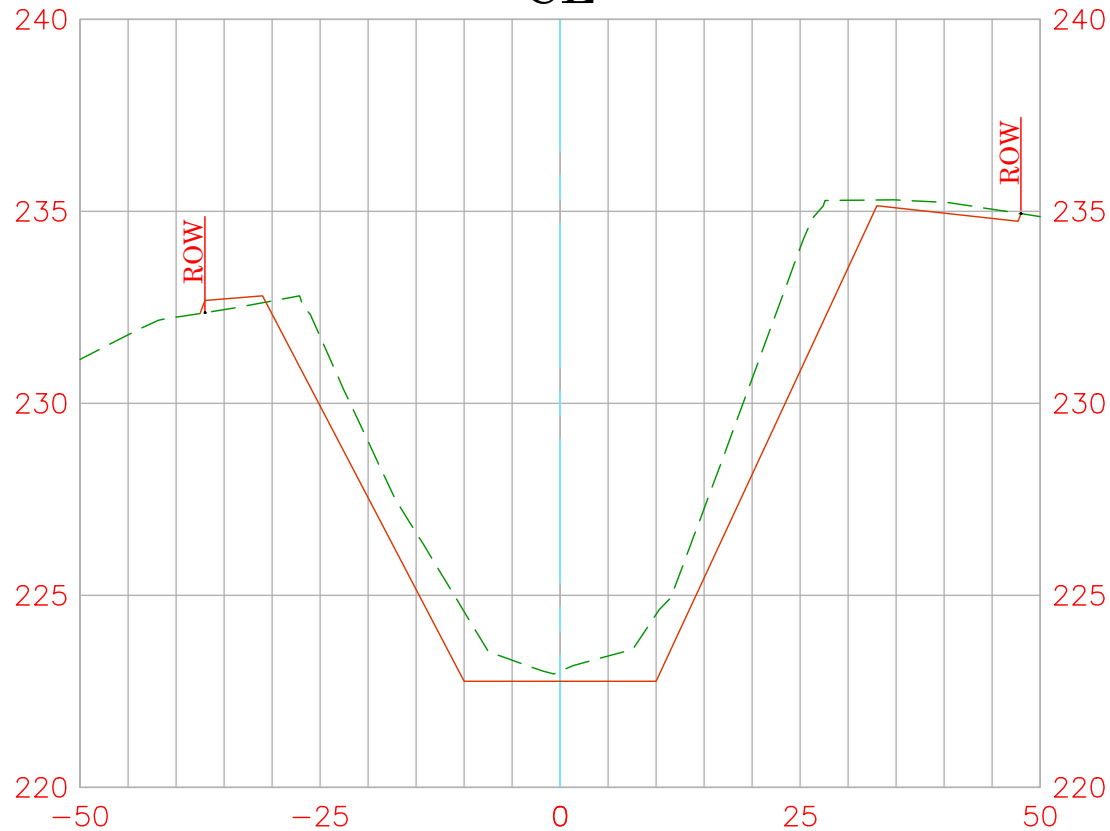

EXISTING CONDITION 2021
RECORD DRAWINGS:
DATE PREPARED: 3/31/2023



Vert. Scale: 1"=5'
Hor. Scale: 1"=20'


U.S. *Survey*
Foot

OC Public Works
OC Survey/Field Services
Boundary Analysis & Mapping

ATWOOD CHANNEL (E04)

24+00

CL

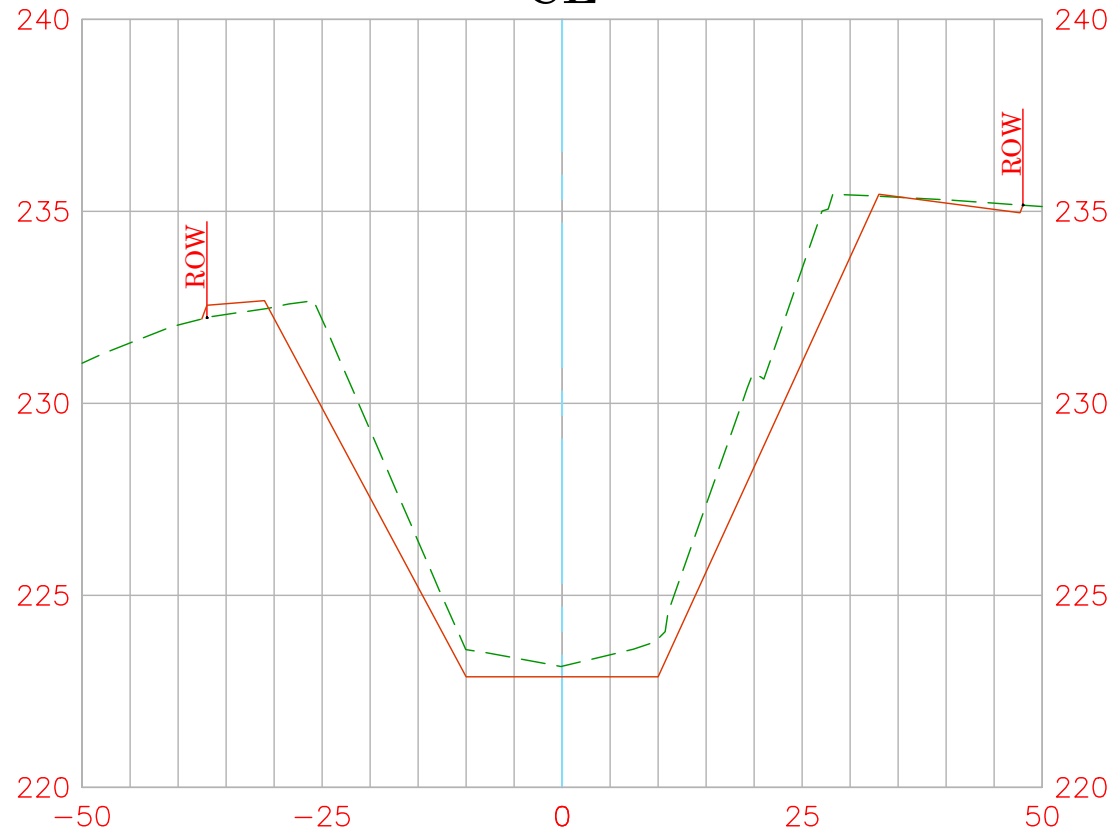


EXISTING CONDITION 2021

RECORD DRAWINGS:

DATE PREPARED: 3/31/2023





Vert. Scale: 1"=5'
Hor. Scale: 1"=20'

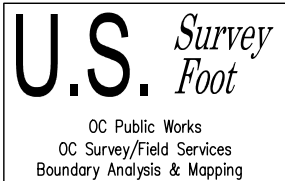


ATWOOD CHANNEL (E04)

24+50

CL

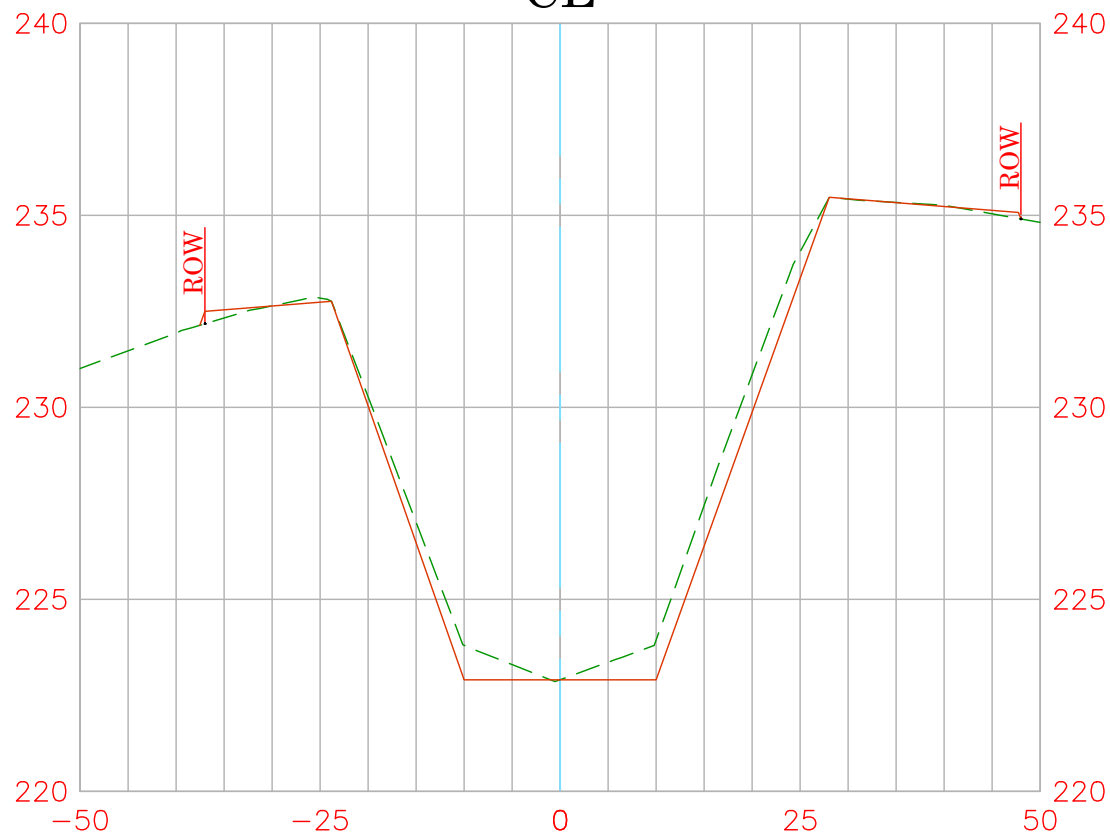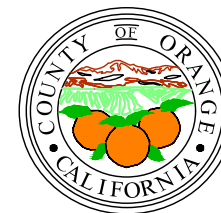

EXISTING CONDITION 2021
RECORD DRAWINGS:
DATE PREPARED: 3/31/2023

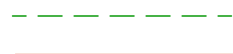


Vert. Scale: 1"=5'
Hor. Scale: 1"=20'

ATWOOD CHANNEL (E04)

25+00

CL

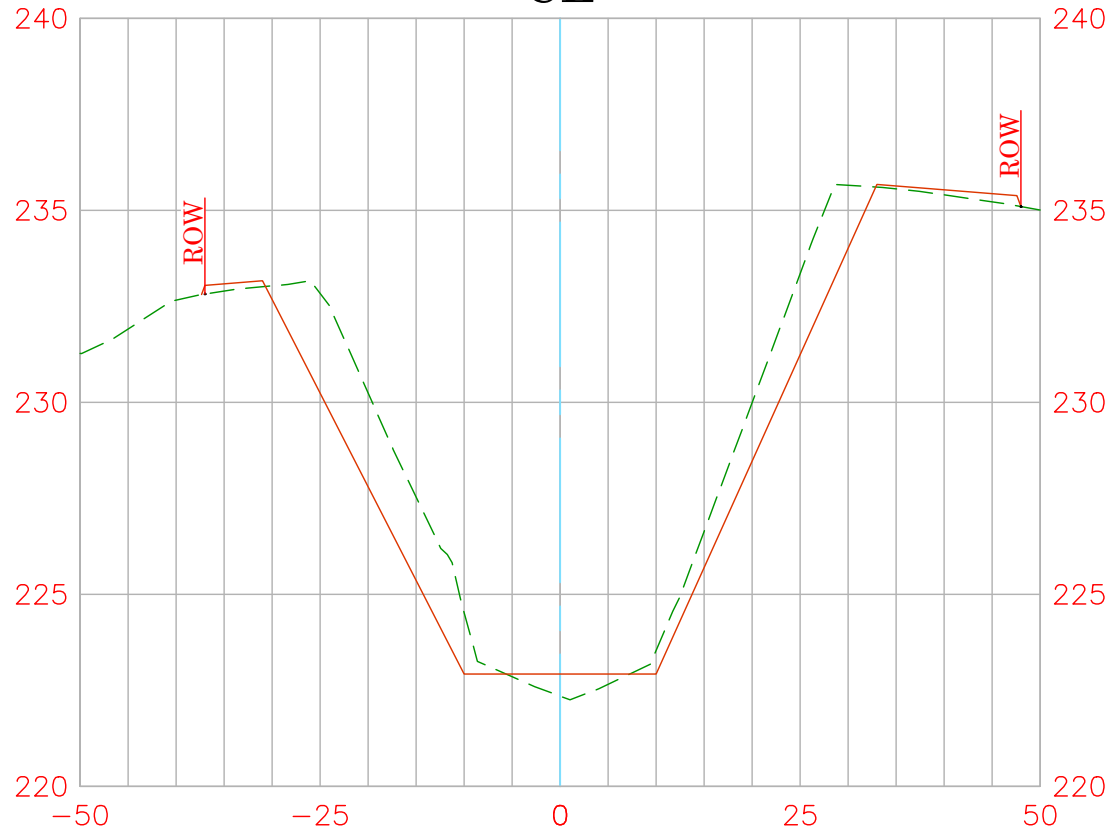

EXISTING CONDITION 2021
 RECORD DRAWINGS:
 DATE PREPARED: 3/31/2023




Vert. Scale: 1"=5'
 Hor. Scale: 1"=20'

ATWOOD CHANNEL (E04)

25+50

CL

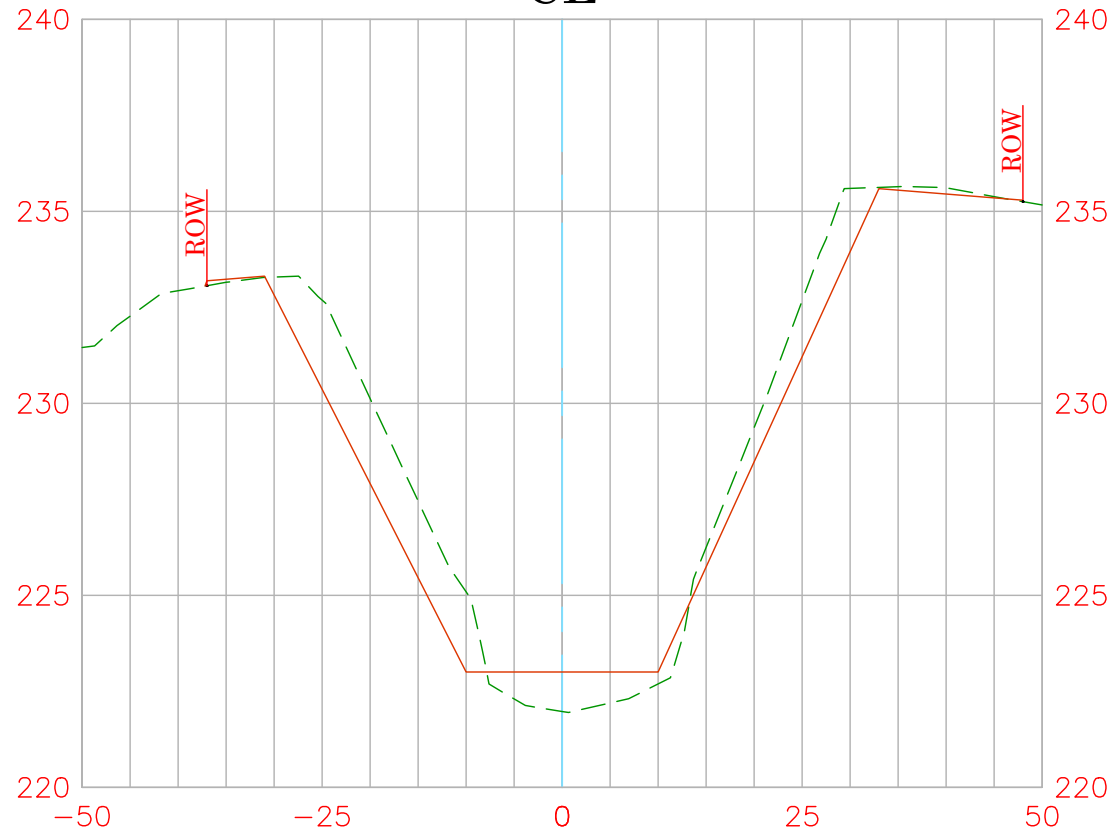

EXISTING CONDITION 2021
RECORD DRAWINGS:
DATE PREPARED: 3/31/2023





Vert. Scale: 1"=5'
Hor. Scale: 1"=20'


ATWOOD CHANNEL (E04)

26+00


CL

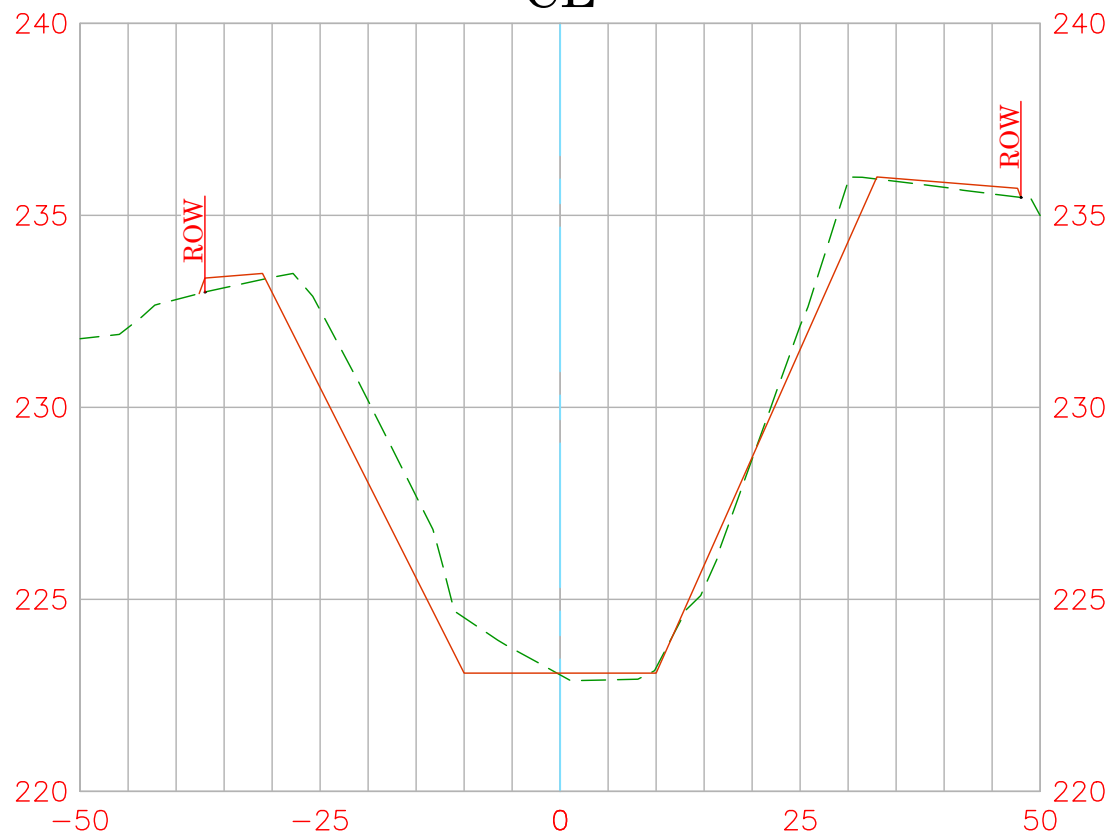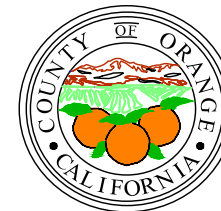

EXISTING CONDITION 2021
 RECORD DRAWINGS:
 DATE PREPARED: 3/31/2023

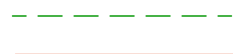


Vert. Scale: 1"=5'
 Hor. Scale: 1"=20'

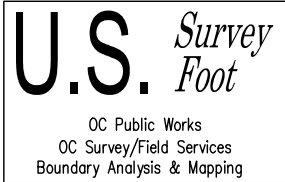

ATWOOD CHANNEL (E04)

26+50


CL

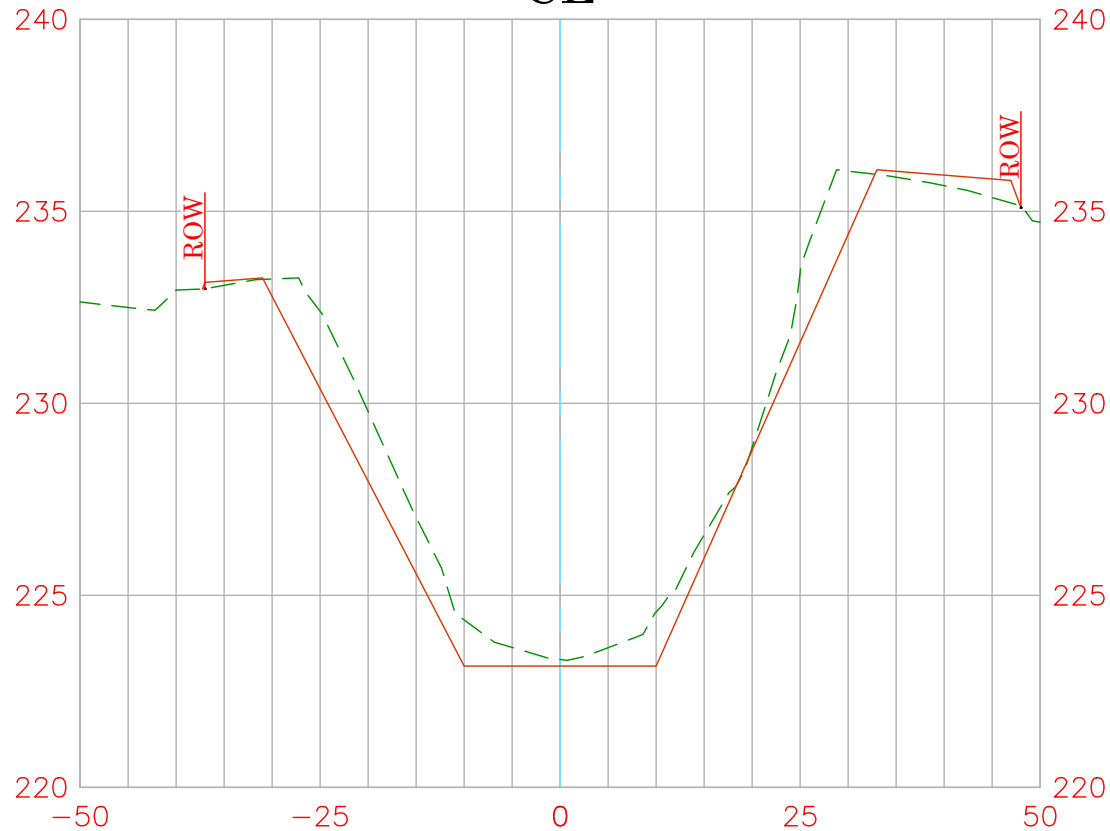

EXISTING CONDITION 2021
RECORD DRAWINGS:
DATE PREPARED: 3/31/2023





Vert. Scale: 1"=5'
Hor. Scale: 1"=20'

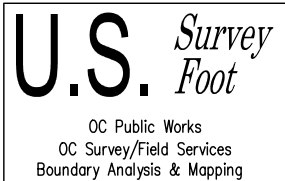


ATWOOD CHANNEL (E04)

27+00

CL

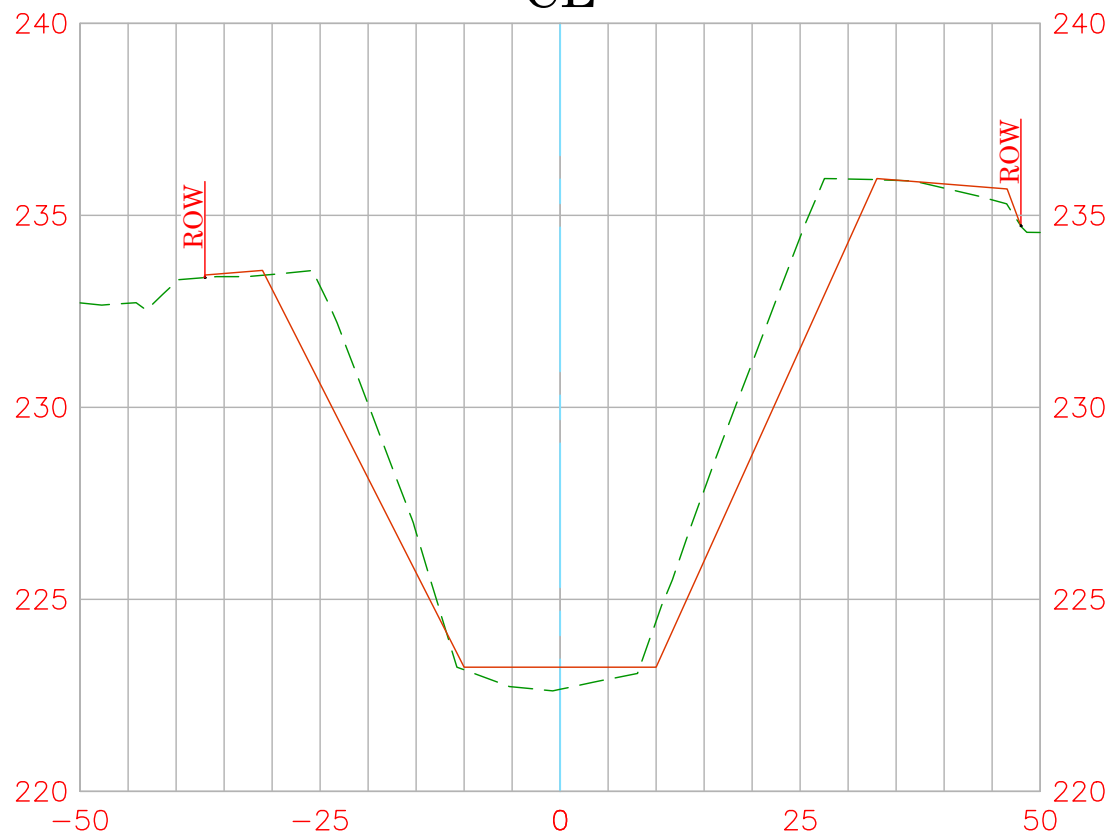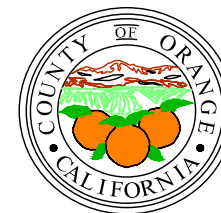

EXISTING CONDITION 2021
RECORD DRAWINGS:
DATE PREPARED: 3/31/2023

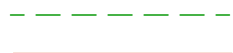


Vert. Scale: 1"=5'
Hor. Scale: 1"=20'

U.S. *Survey
Foot*

OC Public Works
OC Survey/Field Services
Boundary Analysis & Mapping

ATWOOD CHANNEL (E04) 27+50 CL

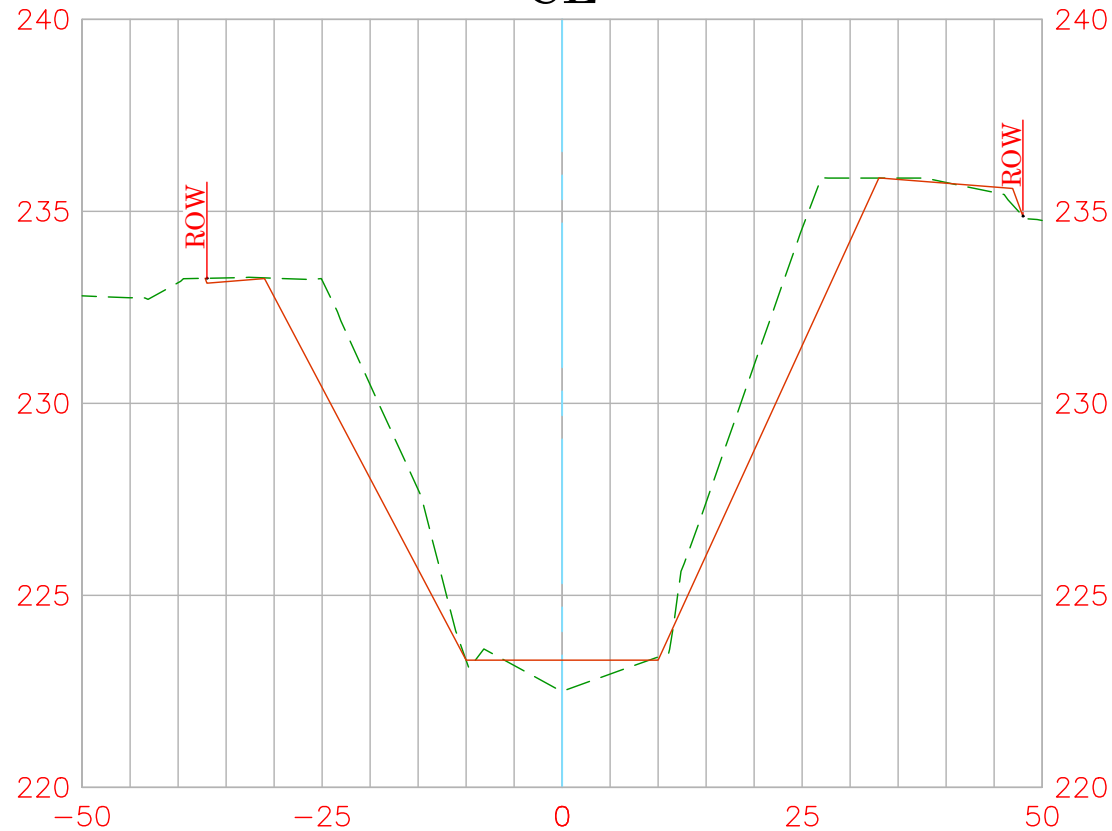


EXISTING CONDITION 2021

RECORD DRAWINGS:

DATE PREPARED: 3/31/2023




Vert. Scale: 1"=5'
Hor. Scale: 1"=20'

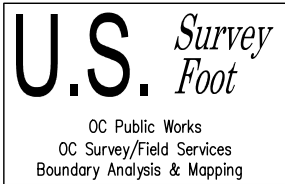

ATWOOD CHANNEL (E04)

28+00


CL

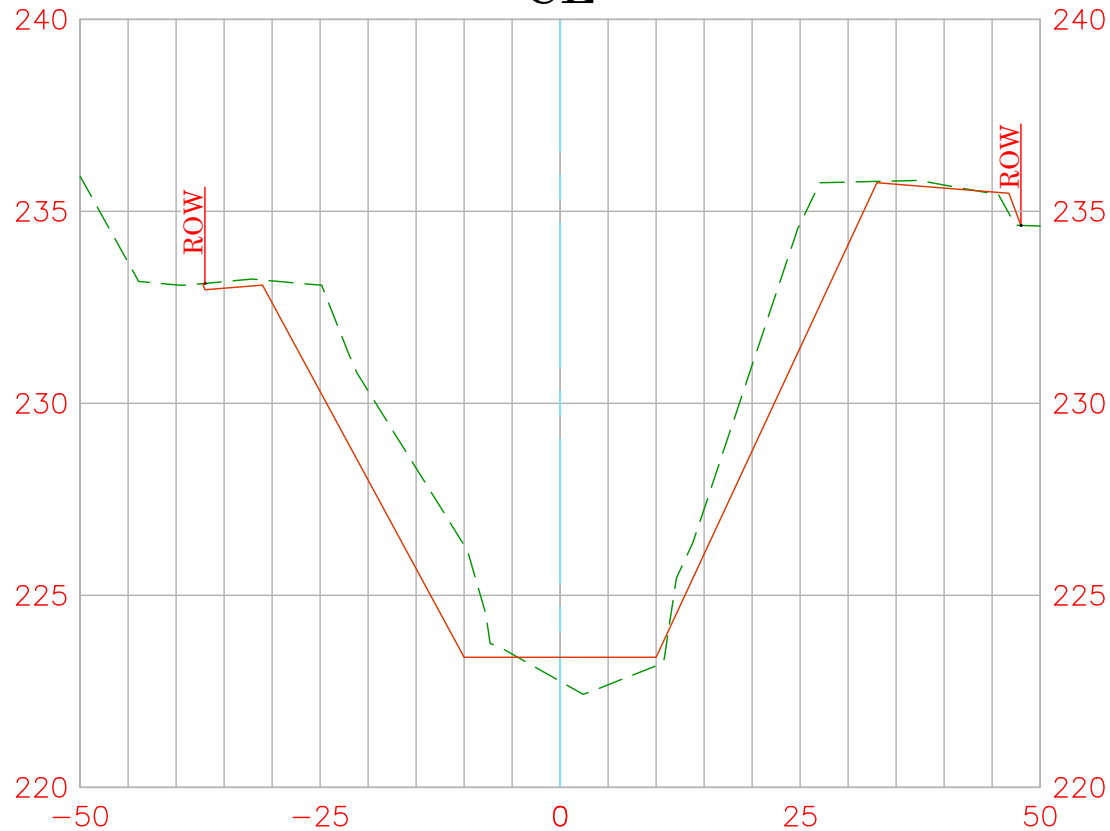

EXISTING CONDITION 2021
RECORD DRAWINGS:
DATE PREPARED: 3/31/2023





Vert. Scale: 1"=5'
Hor. Scale: 1"=20'

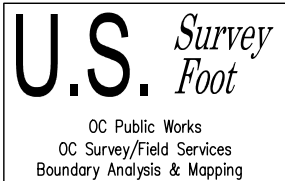


ATWOOD CHANNEL (E04)

28+50


CL

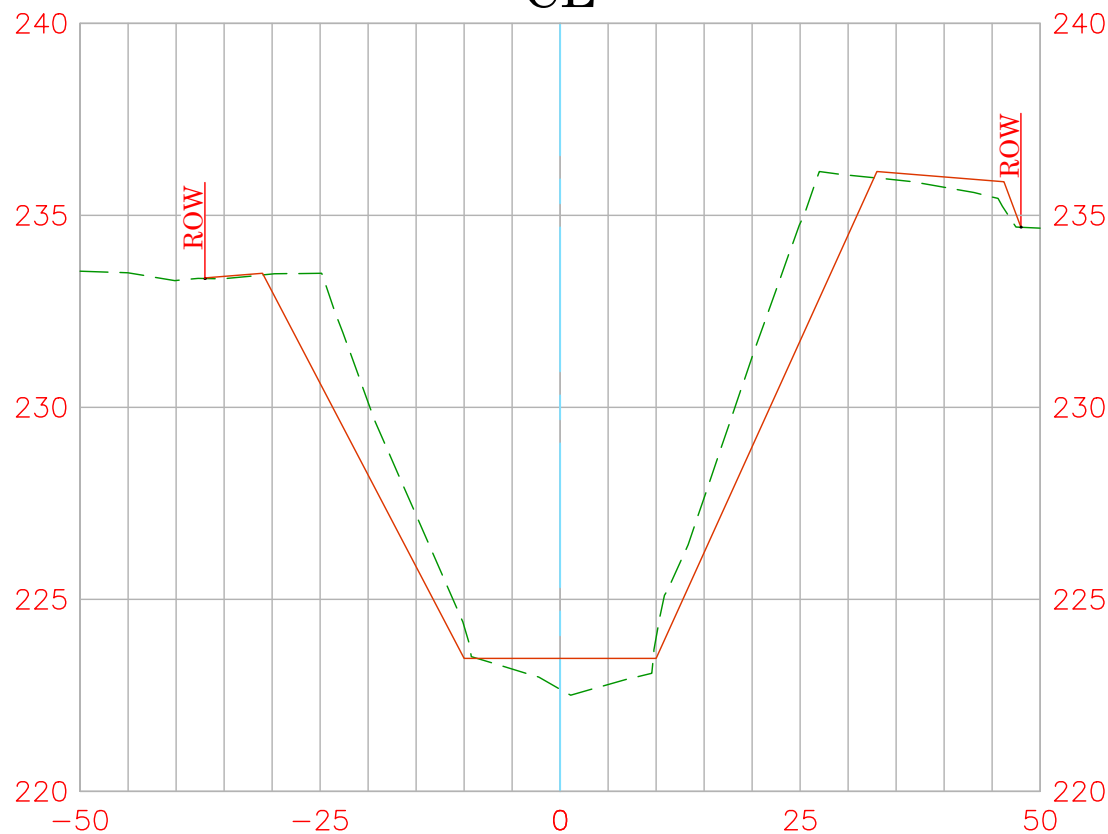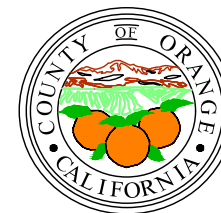

EXISTING CONDITION 2021
RECORD DRAWINGS:
DATE PREPARED: 3/31/2023

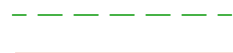



Vert. Scale: 1"=5'
Hor. Scale: 1"=20'

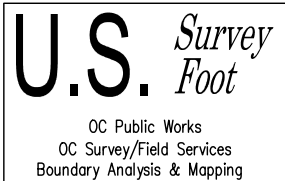


ATWOOD CHANNEL (E04)

29+00

CL

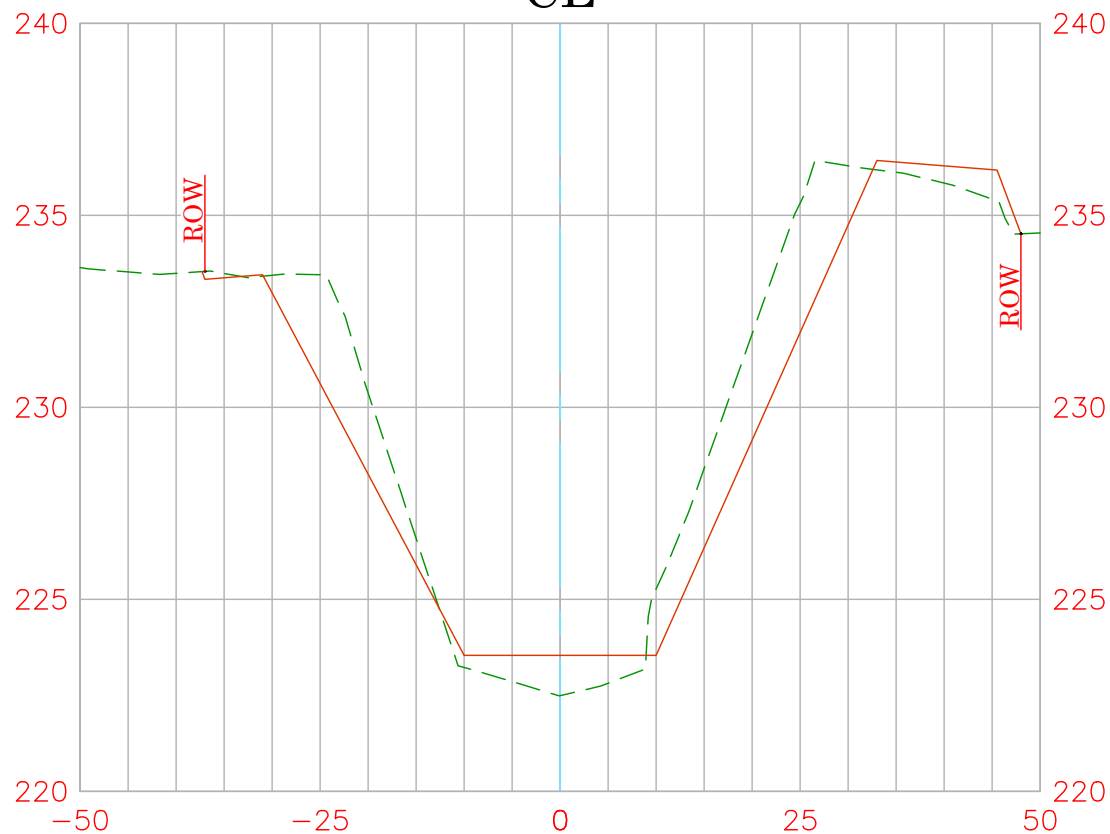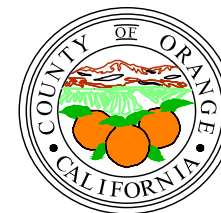

EXISTING CONDITION 2021
RECORD DRAWINGS:
DATE PREPARED: 3/31/2023


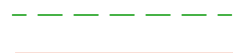


Vert. Scale: 1"=5'
Hor. Scale: 1"=20'


ATWOOD CHANNEL (E04)

29+50


CL

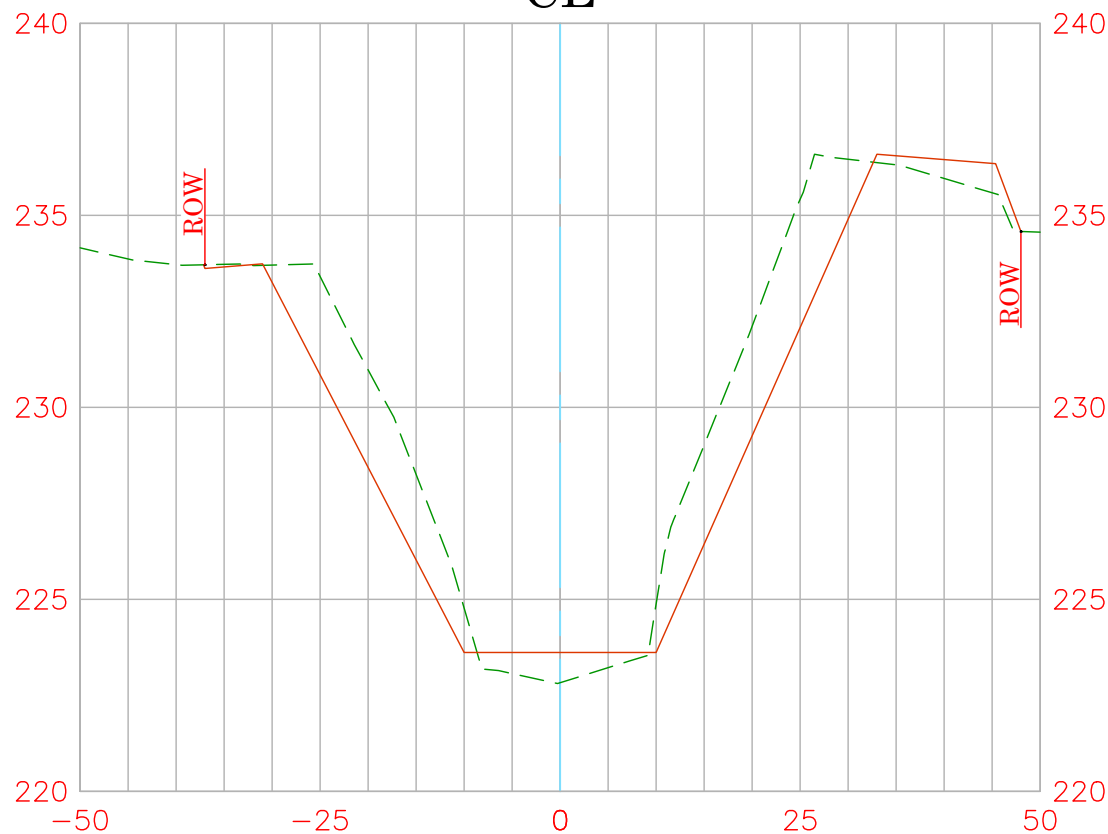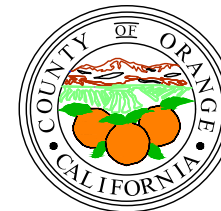

EXISTING CONDITION 2021
 RECORD DRAWINGS:
 DATE PREPARED: 3/31/2023

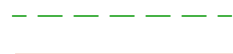


Vert. Scale: 1"=5'
 Hor. Scale: 1"=20'

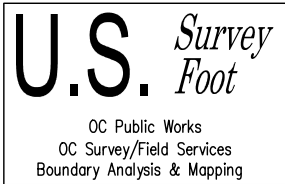

ATWOOD CHANNEL (E04)

30+00

CL

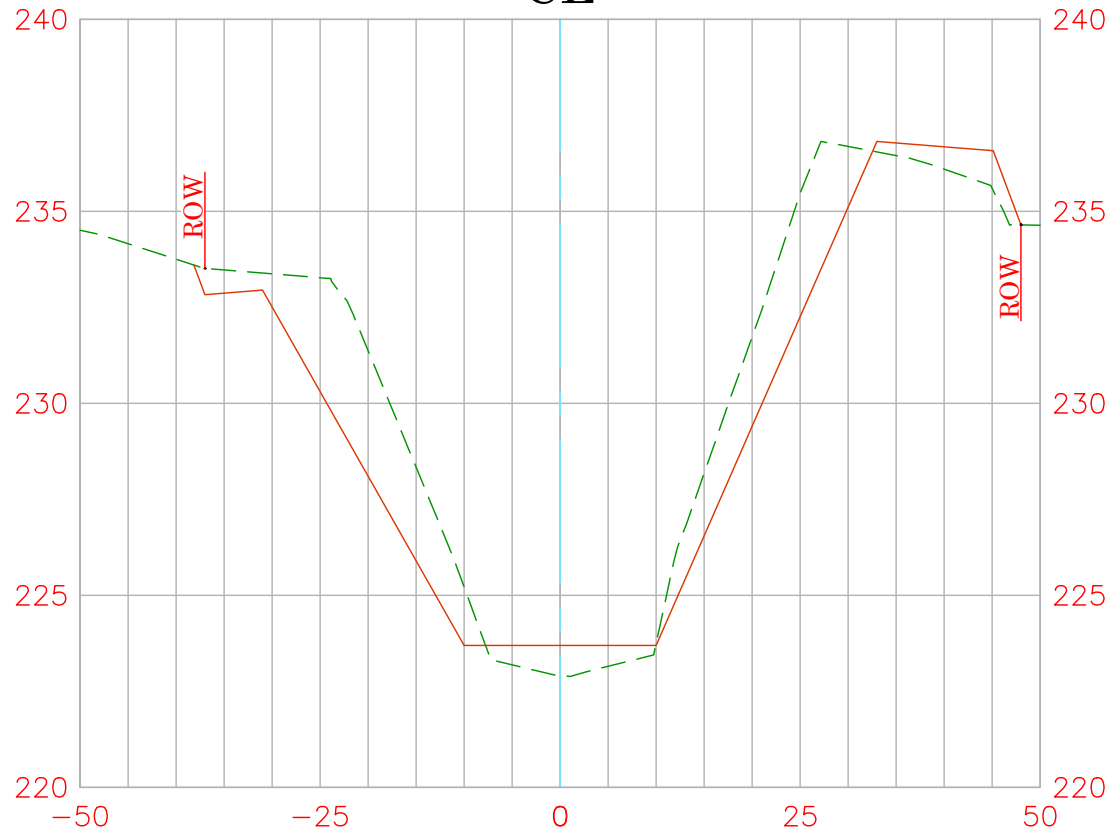

EXISTING CONDITION 2021
RECORD DRAWINGS:
DATE PREPARED: 3/31/2023




Vert. Scale: 1"=5'
Hor. Scale: 1"=20'

ATWOOD CHANNEL (E04)

30+50

CL

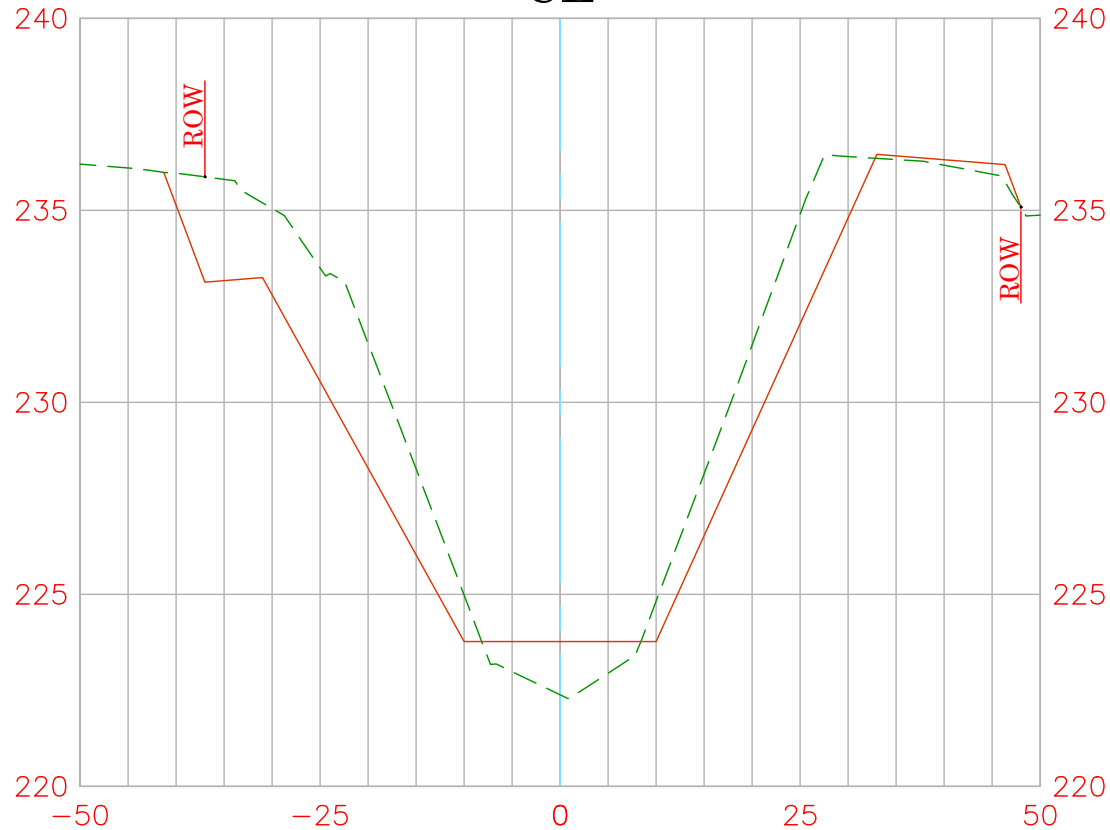

EXISTING CONDITION 2021
 RECORD DRAWINGS:
 DATE PREPARED: 3/31/2023




Vert. Scale: 1"=5'
 Hor. Scale: 1"=20'

ATWOOD CHANNEL (E04)

33+00


CL

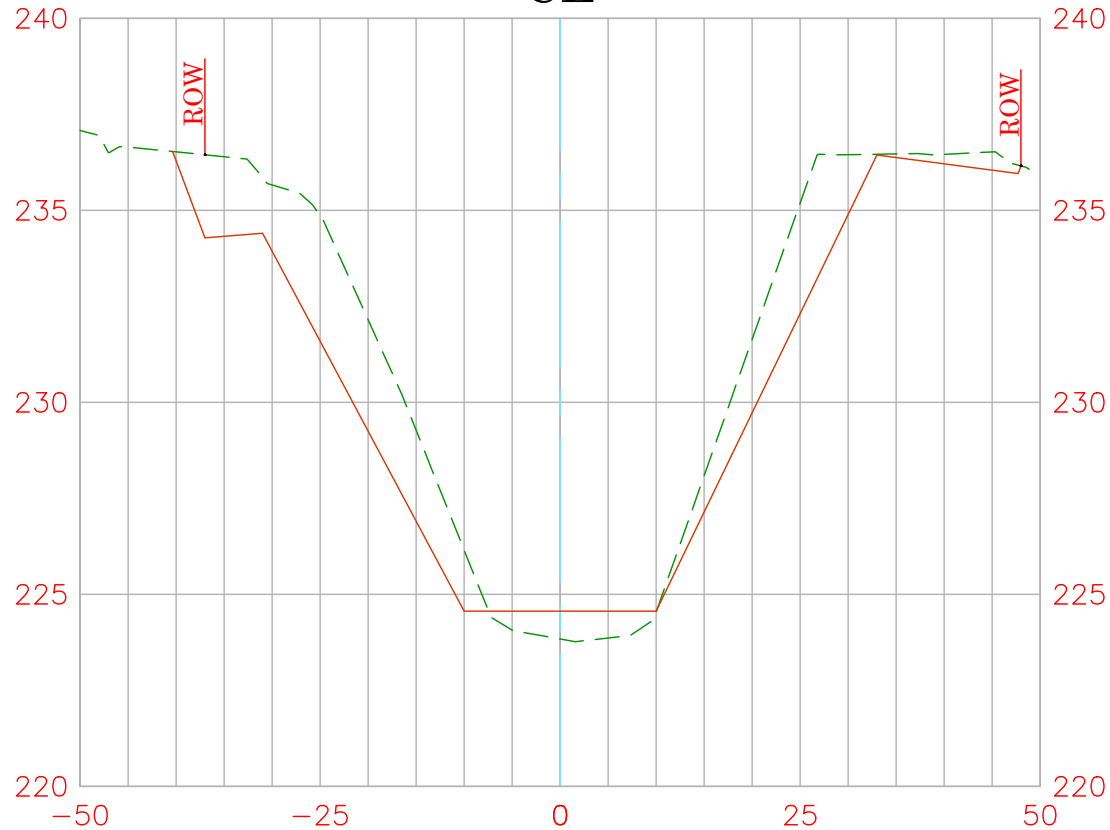

EXISTING CONDITION 2021
 RECORD DRAWINGS:
 DATE PREPARED: 3/31/2023




Vert. Scale: 1"=5'
 Hor. Scale: 1"=20'

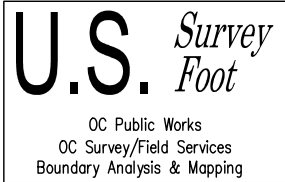

ATWOOD CHANNEL (E04)

33+50


CL

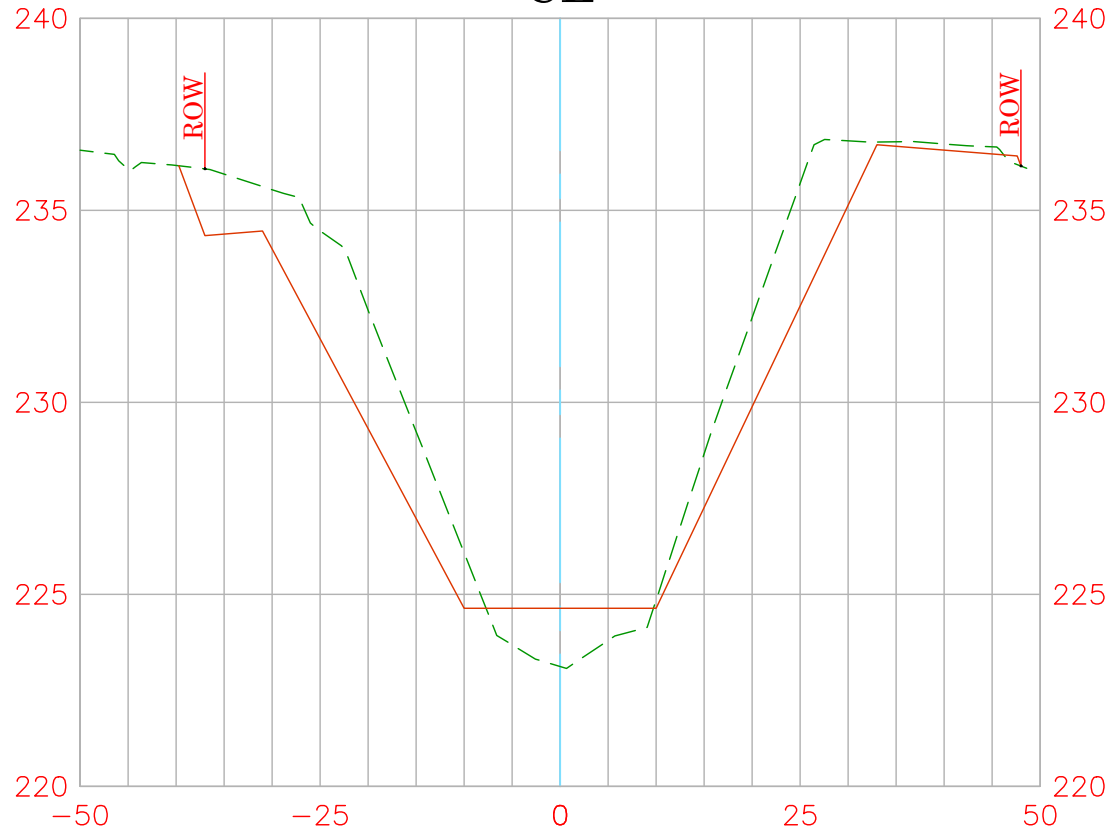

EXISTING CONDITION 2021
RECORD DRAWINGS:
DATE PREPARED: 3/31/2023





Vert. Scale: 1"=5'
Hor. Scale: 1"=20'

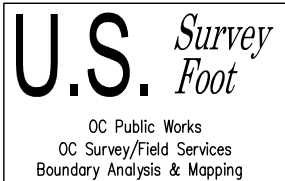


ATWOOD CHANNEL (E04)

34+00


CL

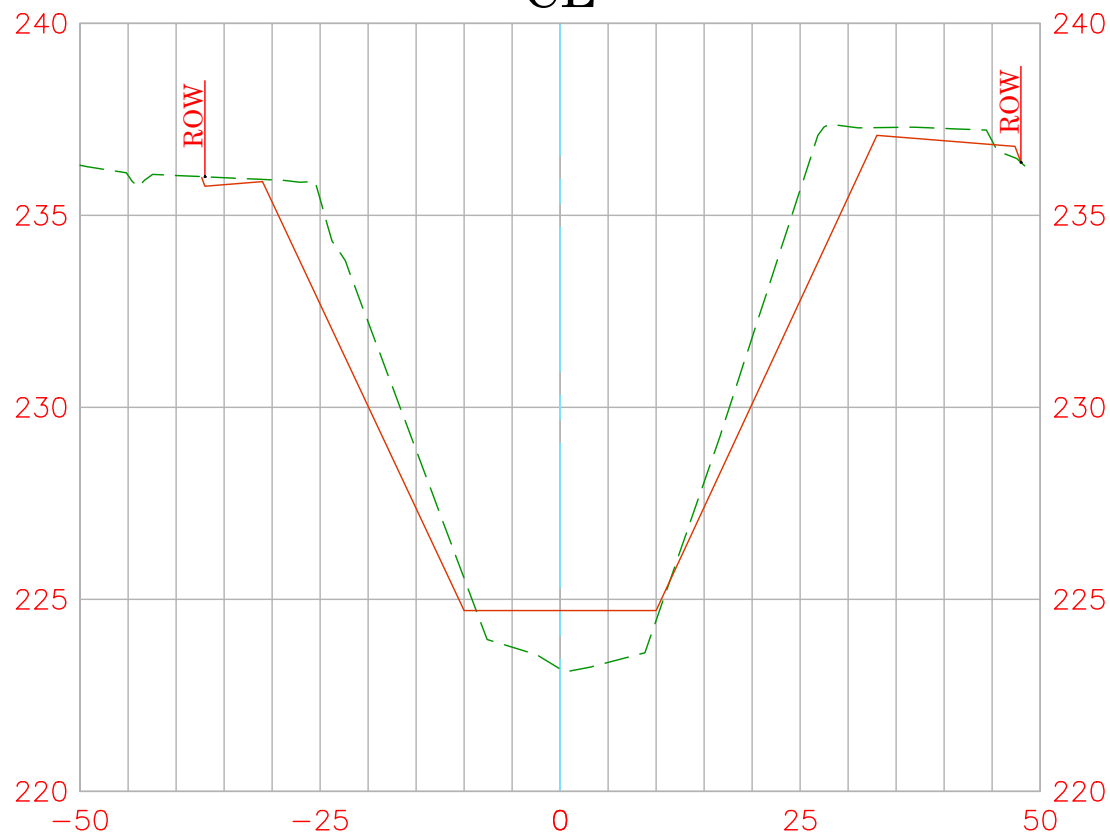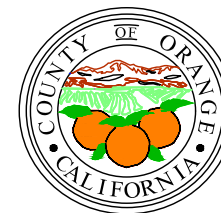

EXISTING CONDITION 2021
RECORD DRAWINGS:
DATE PREPARED: 3/31/2023

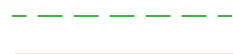


Vert. Scale: 1"=5'
Hor. Scale: 1"=20'

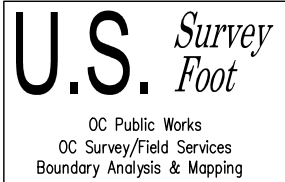

ATWOOD CHANNEL (E04)

34+50

CL

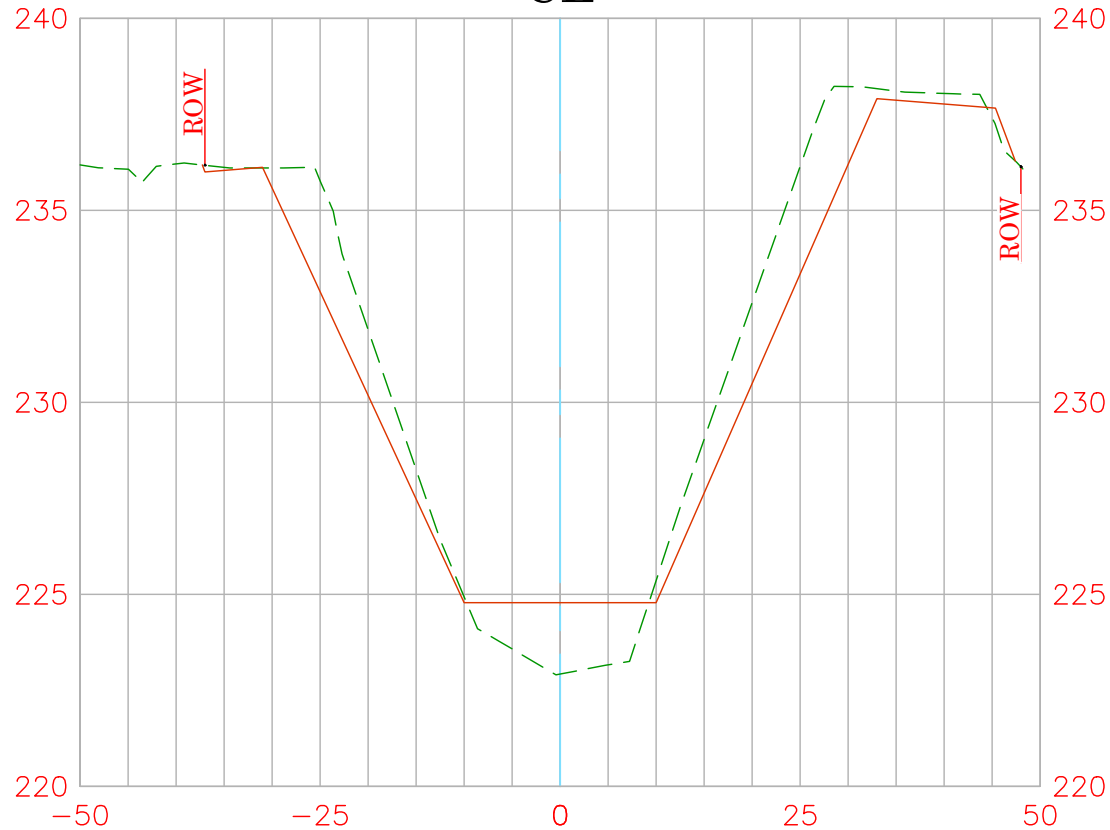

EXISTING CONDITION 2021
RECORD DRAWINGS:
DATE PREPARED: 3/31/2023



Vert. Scale: 1"=5'
Hor. Scale: 1"=20'


U.S. *Survey
Foot*

OC Public Works
OC Survey/Field Services
Boundary Analysis & Mapping

ATWOOD CHANNEL (E04)

35+00

CL

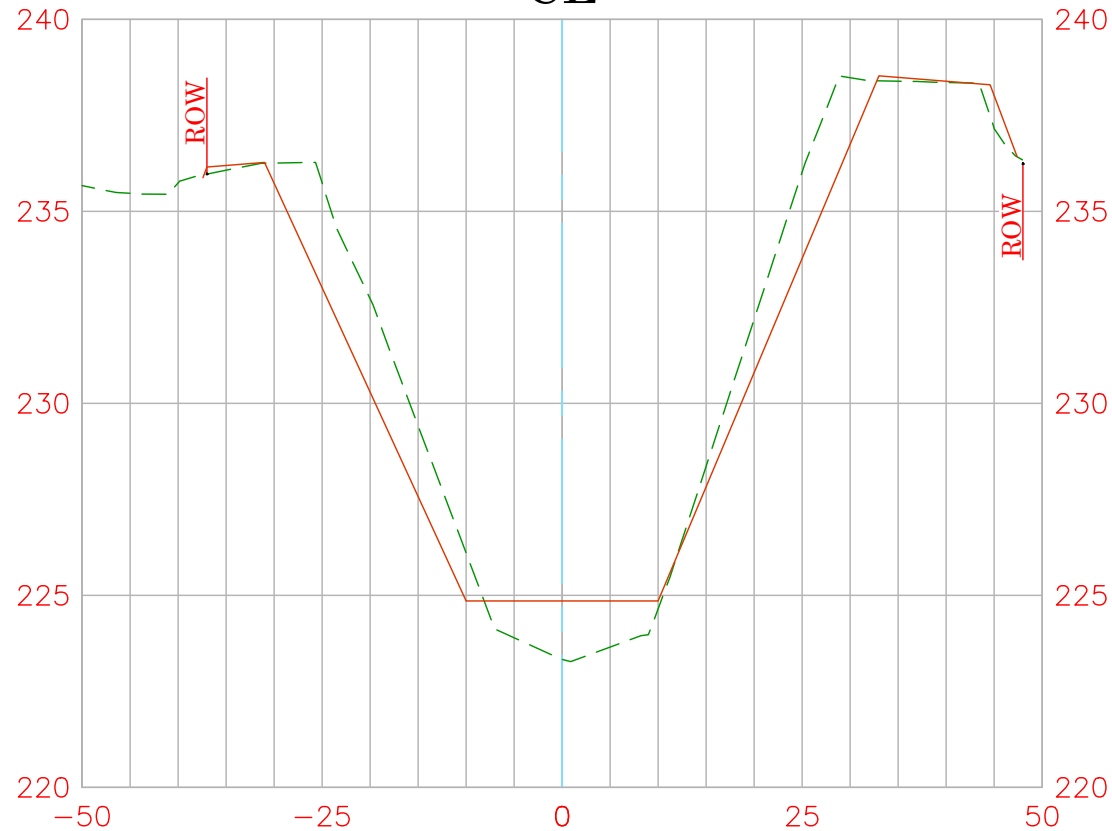

EXISTING CONDITION 2021

RECORD DRAWINGS:

DATE PREPARED: 3/31/2023





Vert. Scale: 1"=5'
Hor. Scale: 1"=20'


ATWOOD CHANNEL (E04)

35+50


CL

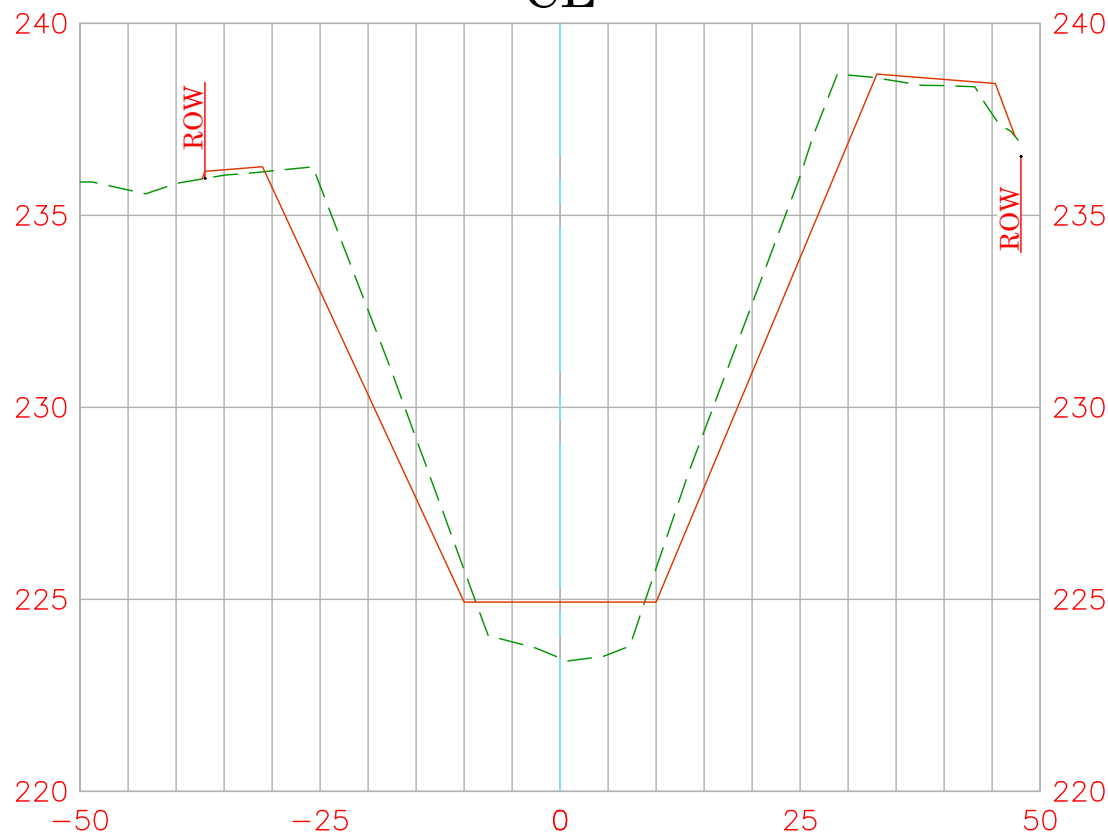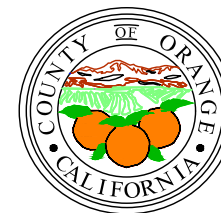

EXISTING CONDITION 2021
 RECORD DRAWINGS:
 DATE PREPARED: 3/31/2023

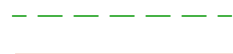



Vert. Scale: 1"=5'
 Hor. Scale: 1"=20'

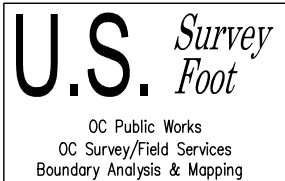


ATWOOD CHANNEL (E04)

36+00

CL

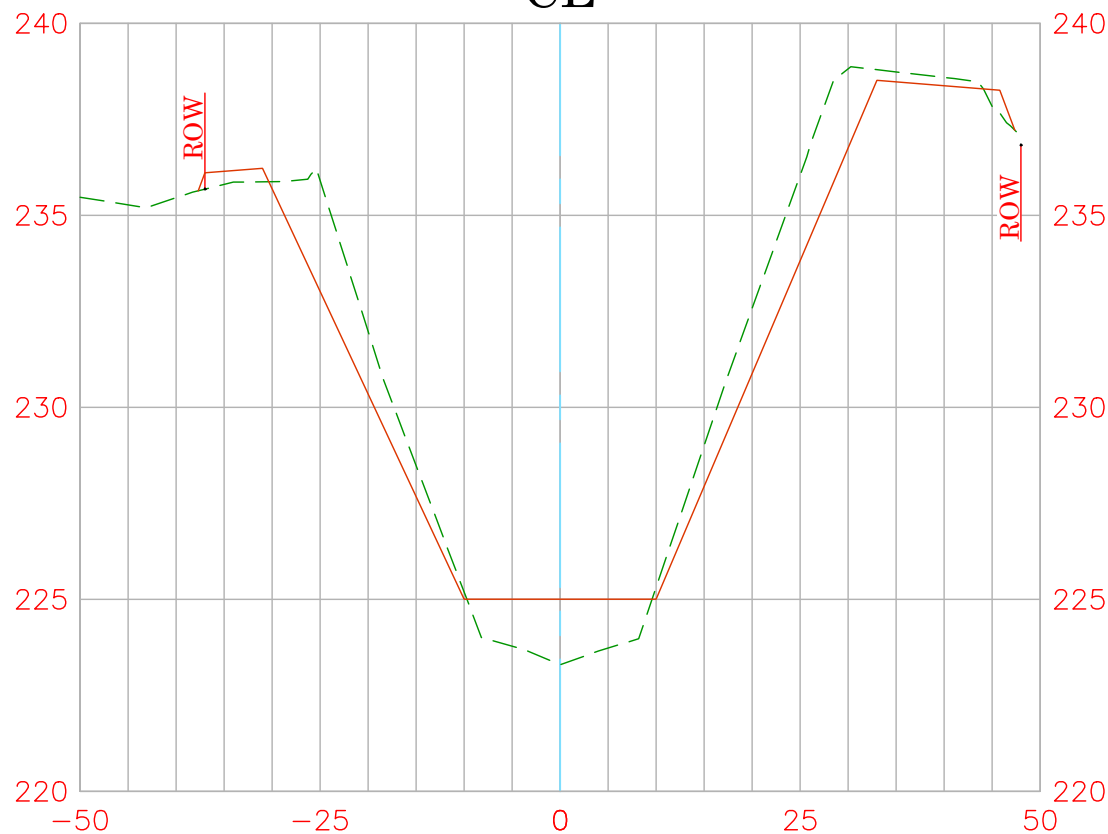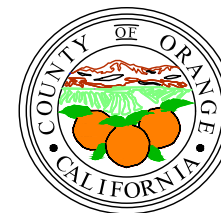

EXISTING CONDITION 2021
RECORD DRAWINGS:
DATE PREPARED: 3/31/2023

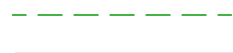


Vert. Scale: 1"=5'
Hor. Scale: 1"=20'

ATWOOD CHANNEL (E04)

36+50

CL

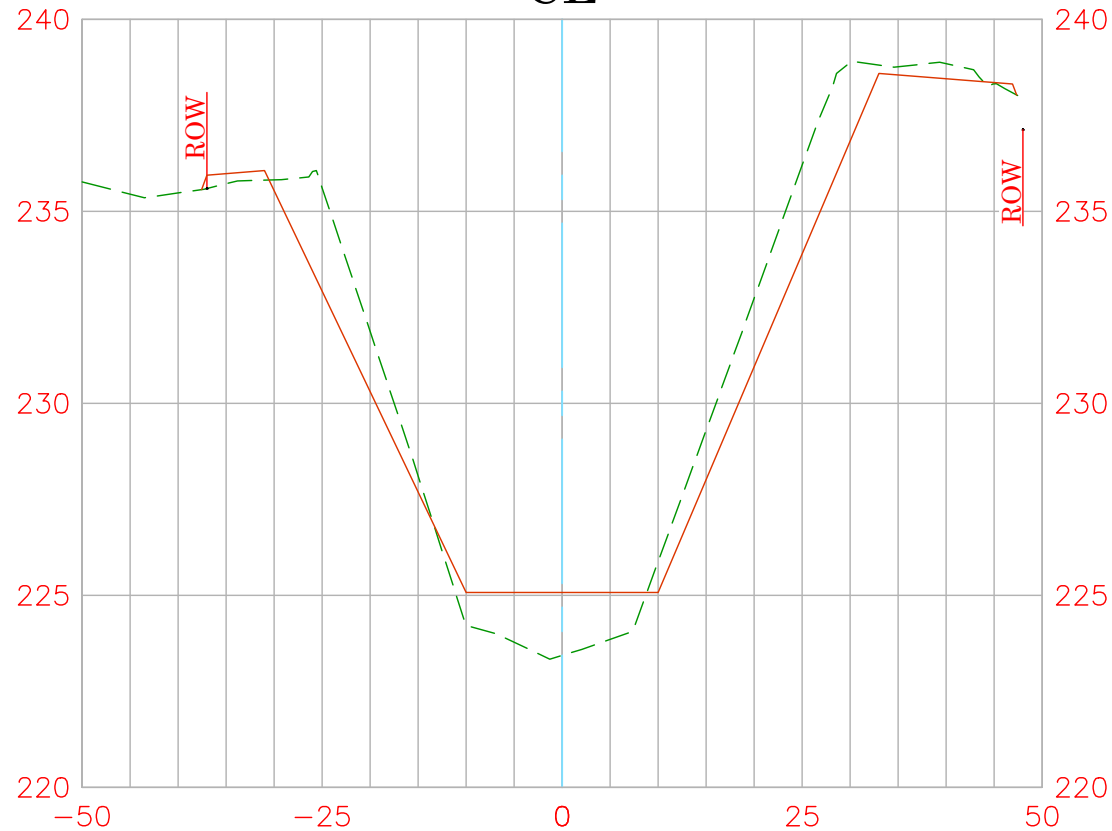

EXISTING CONDITION 2021
 RECORD DRAWINGS:
 DATE PREPARED: 3/31/2023





Vert. Scale: 1"=5'
 Hor. Scale: 1"=20'


ATWOOD CHANNEL (E04)

37+00

CL

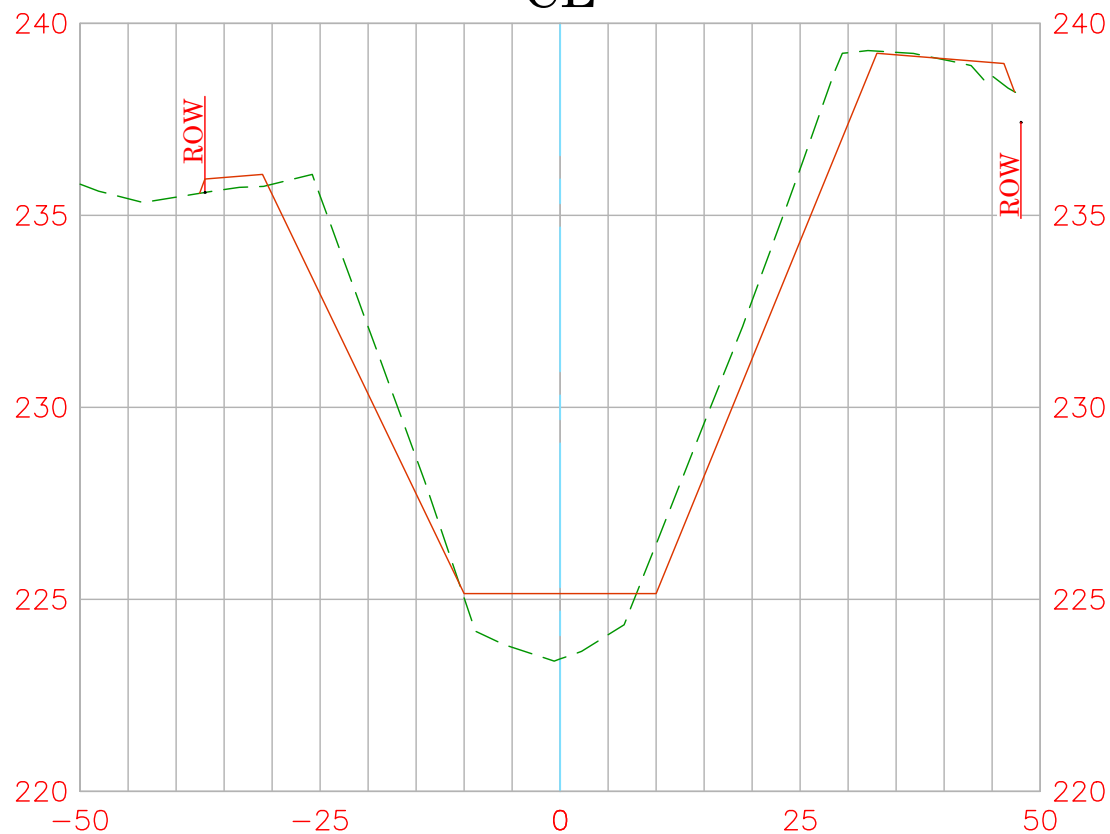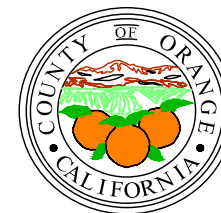

EXISTING CONDITION 2021
 RECORD DRAWINGS:
 DATE PREPARED: 3/31/2023

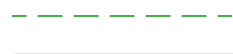

Vert. Scale: 1"=5'
 Hor. Scale: 1"=20'


U.S. *Survey
Foot*

OC Public Works
OC Survey/Field Services
Boundary Analysis & Mapping

ATWOOD CHANNEL (E04)

37+50

CL

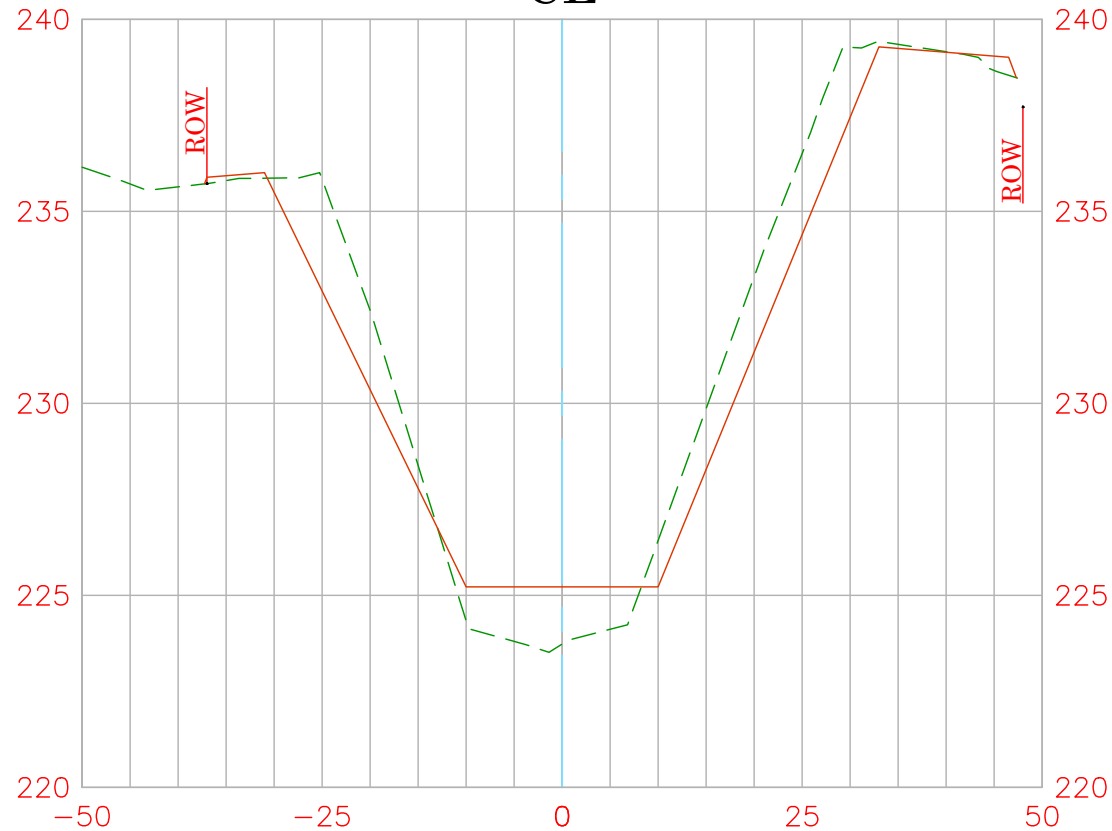

EXISTING CONDITION 2021
RECORD DRAWINGS:
DATE PREPARED: 3/31/2023




Vert. Scale: 1"=5'
Hor. Scale: 1"=20'

U.S. Survey Foot

OC Public Works
OC Survey/Field Services
Boundary Analysis & Mapping

ATWOOD CHANNEL (E04)


38+00
CL

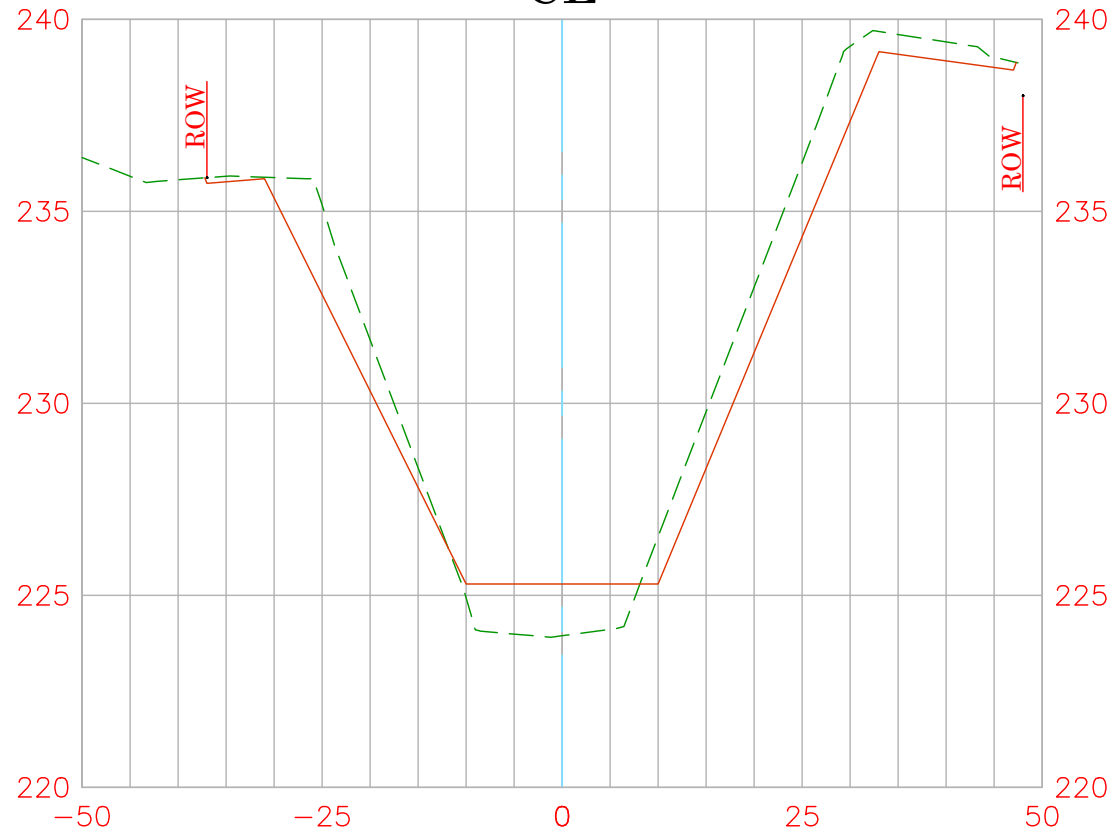

EXISTING CONDITION 2021
RECORD DRAWINGS:
DATE PREPARED: 3/31/2023




Vert. Scale: 1"=5'
Hor. Scale: 1"=20'

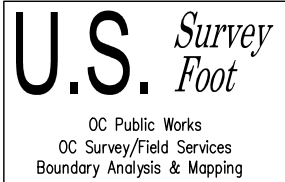

ATWOOD CHANNEL (E04)

38+50


CL

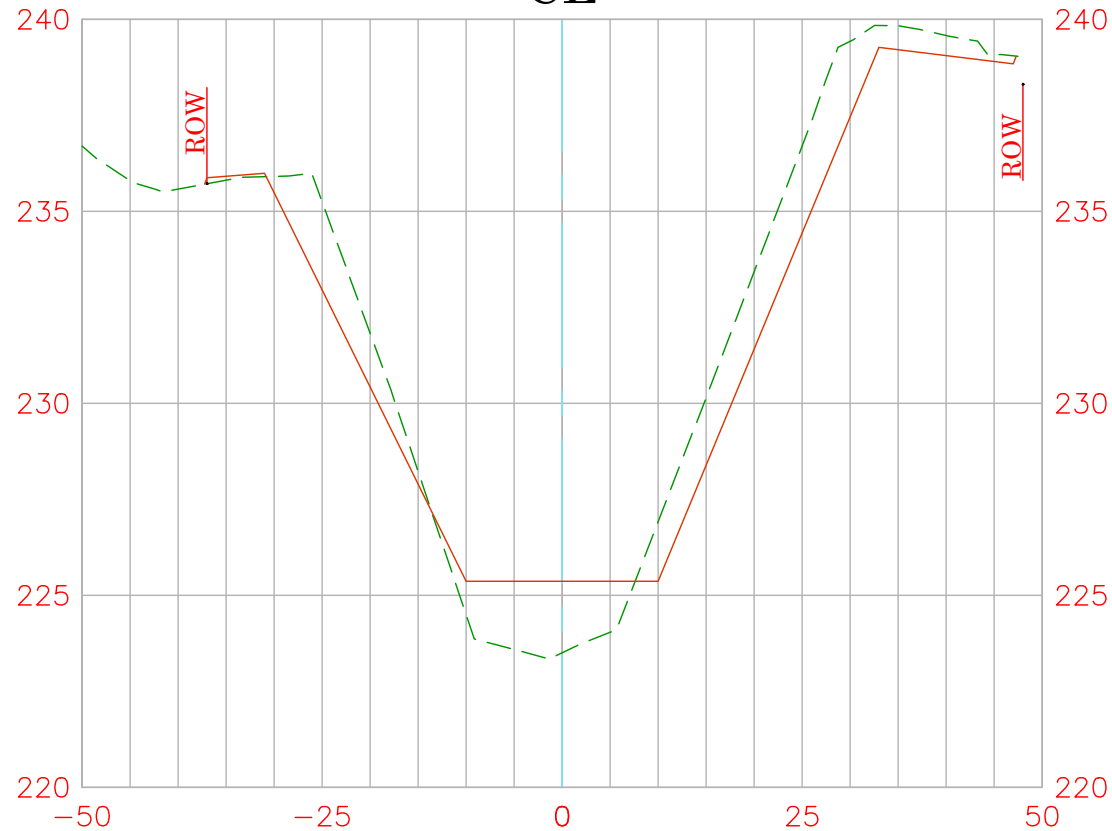

EXISTING CONDITION 2021
RECORD DRAWINGS:
DATE PREPARED: 3/31/2023




Vert. Scale: 1"=5'
Hor. Scale: 1"=20'

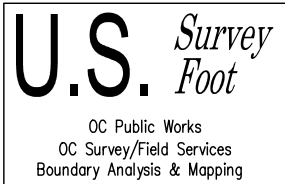

ATWOOD CHANNEL (E04)

39+00

CL

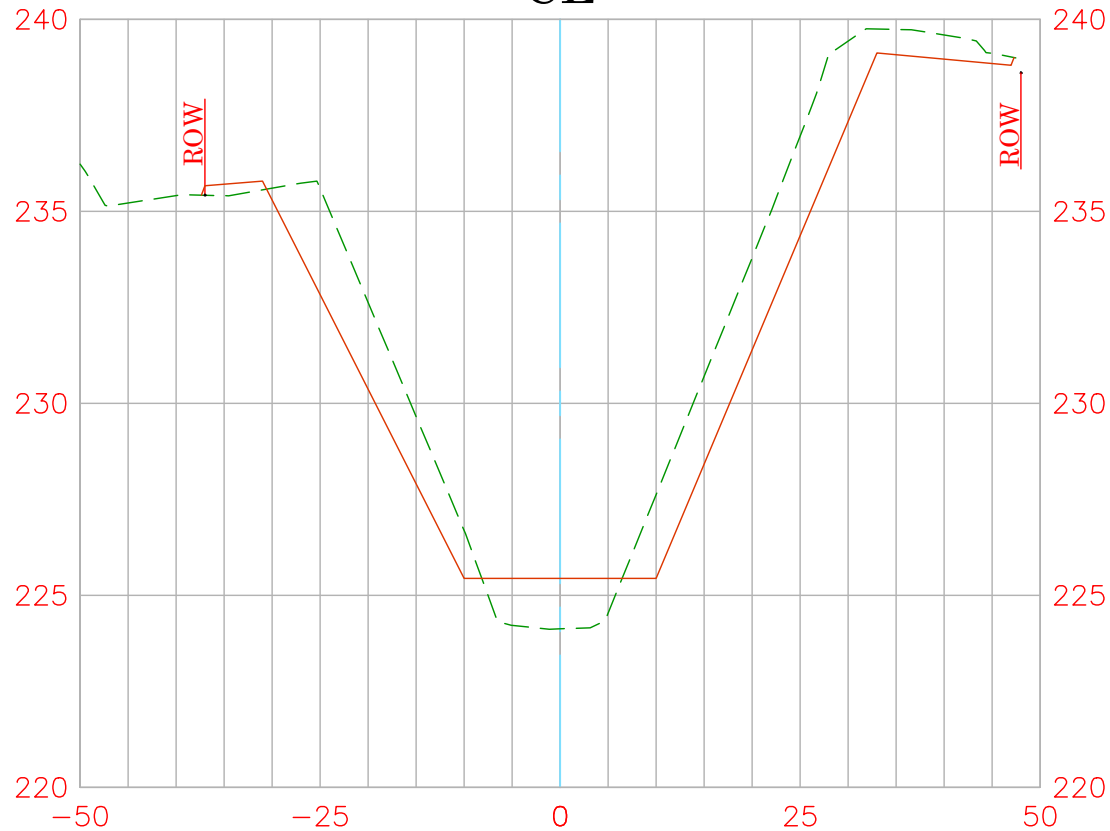

EXISTING CONDITION 2021
RECORD DRAWINGS:
DATE PREPARED: 3/31/2023




Vert. Scale: 1"=5'
Hor. Scale: 1"=20'

ATWOOD CHANNEL (E04)

39+50


CL

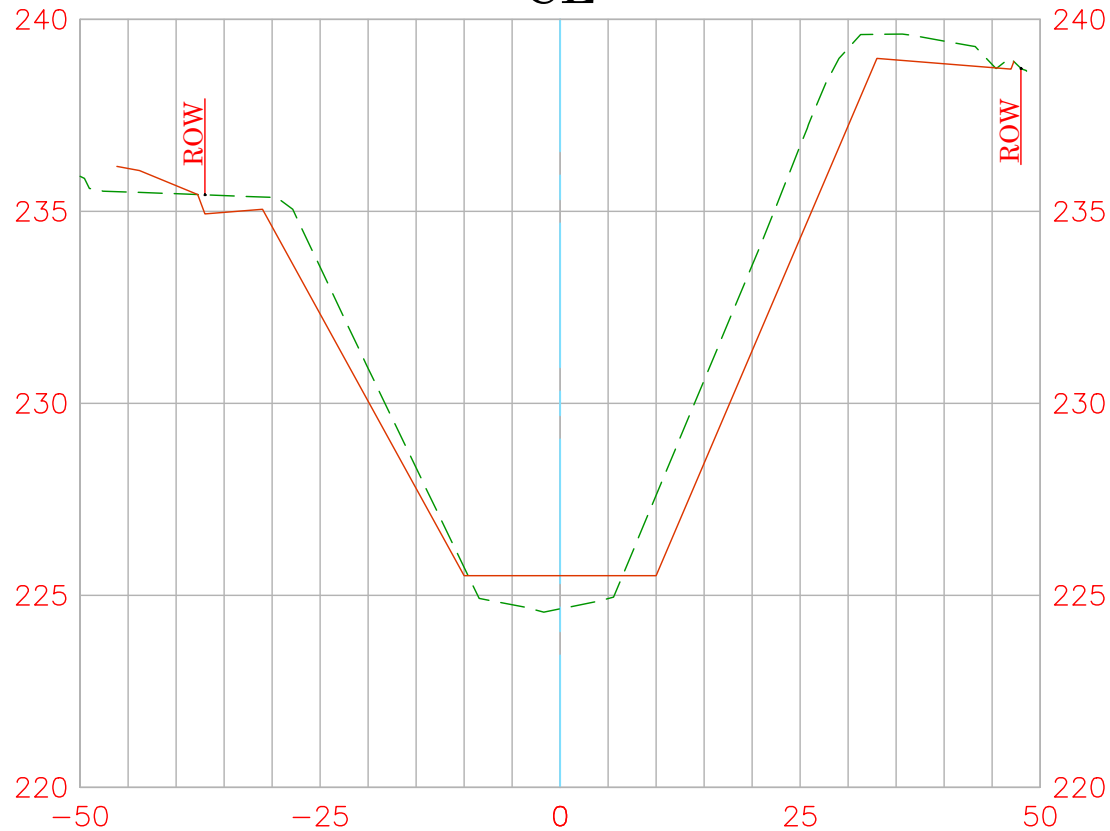


EXISTING CONDITION 2021
 RECORD DRAWINGS:
 DATE PREPARED: 3/31/2023




Vert. Scale: 1"=5'
 Hor. Scale: 1"=20'

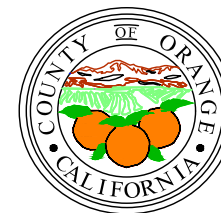


ATWOOD CHANNEL (E04) 42+50 CL

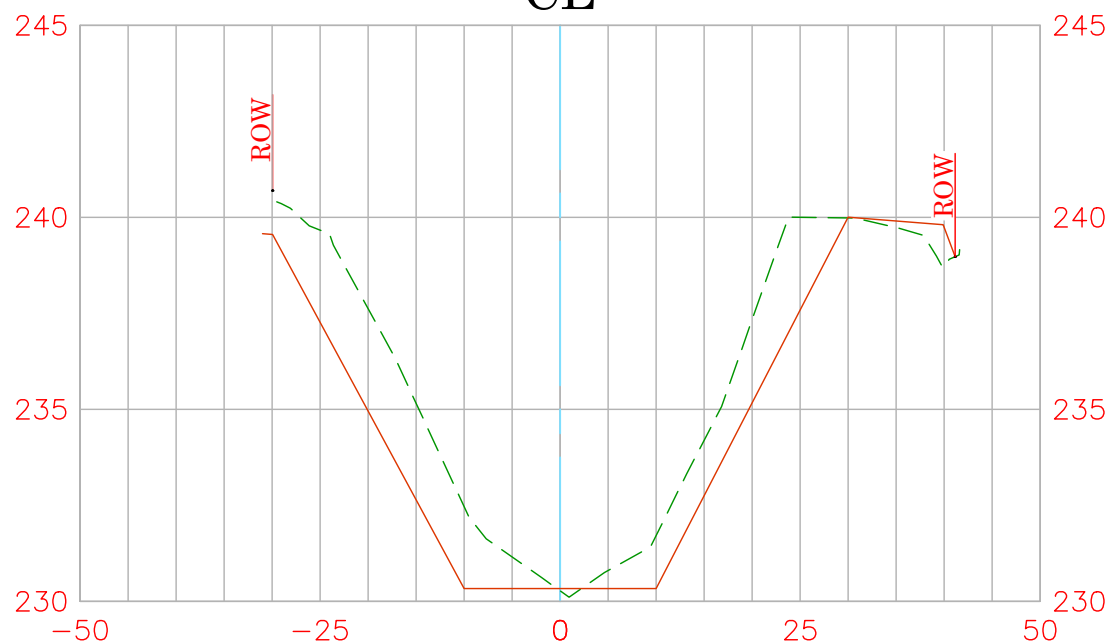

EXISTING CONDITION 2021
RECORD DRAWINGS:
DATE PREPARED: 3/31/2023

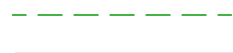



Vert. Scale: 1"=5'
Hor. Scale: 1"=20'

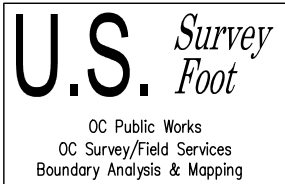


ATWOOD CHANNEL (E04)

43+00


CL

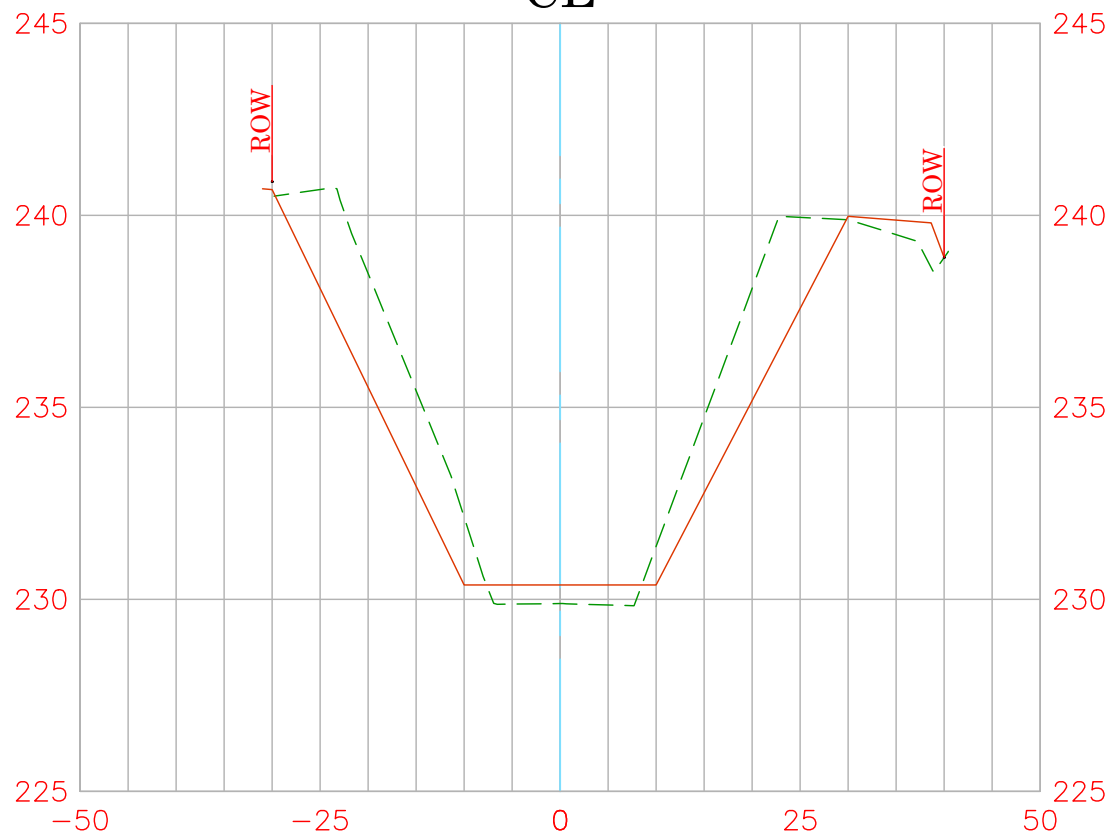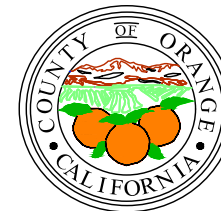


EXISTING CONDITION 2021
RECORD DRAWINGS:
DATE PREPARED: 3/31/2023

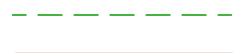

Vert. Scale: 1"=5'
Hor. Scale: 1"=20'

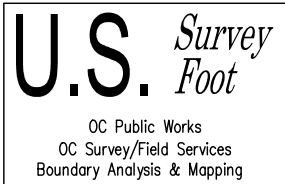


ATWOOD CHANNEL (E04) 43+50 CL

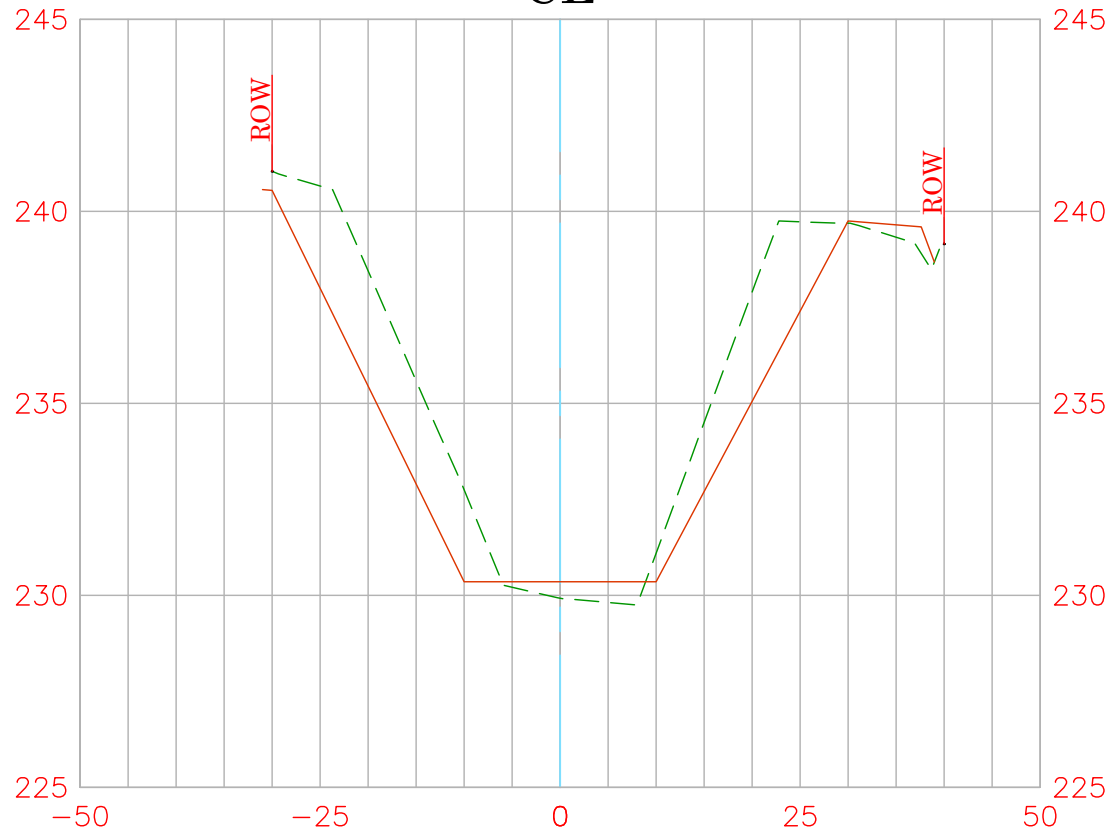

EXISTING CONDITION 2021
RECORD DRAWINGS:
DATE PREPARED: 3/31/2023





Vert. Scale: 1"=5'
Hor. Scale: 1"=20'

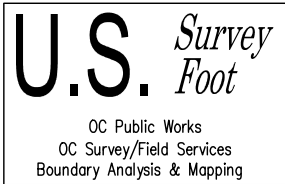


ATWOOD CHANNEL (E04)

44+00


CL

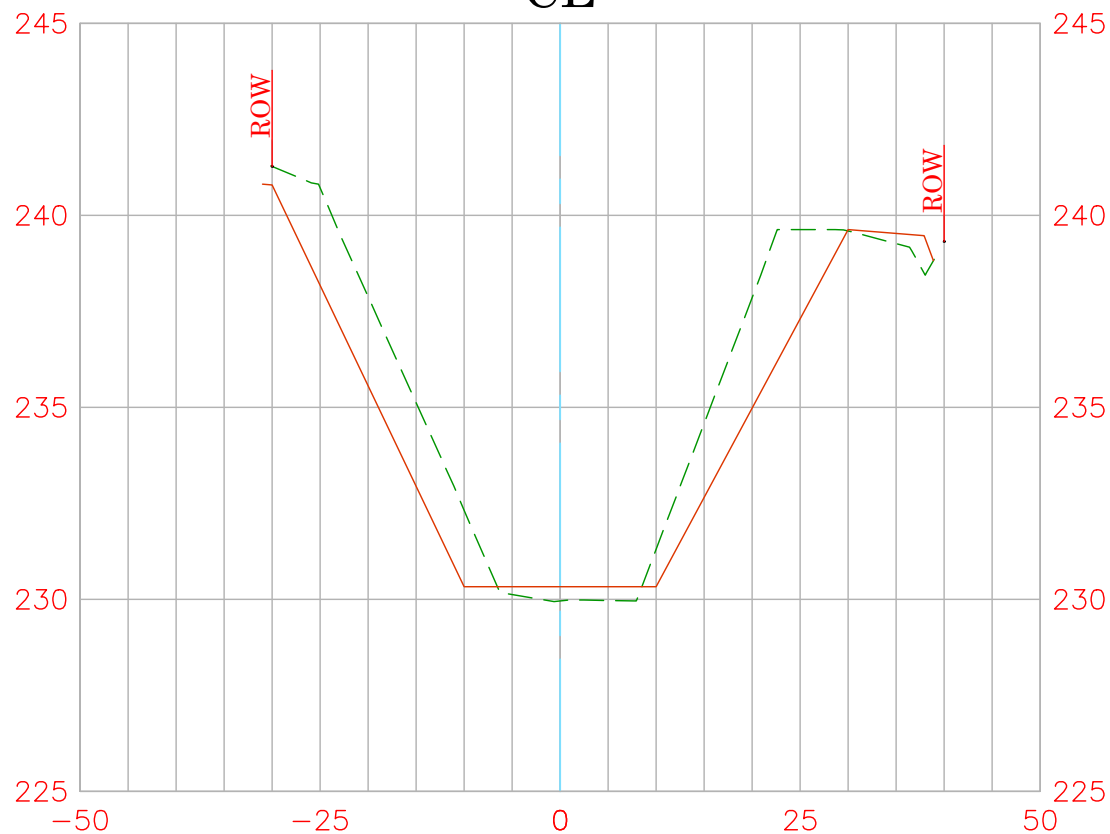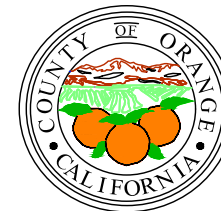


EXISTING CONDITION 2021
RECORD DRAWINGS:
DATE PREPARED: 3/31/2023

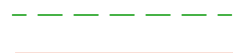

Vert. Scale: 1"=5'
Hor. Scale: 1"=20'

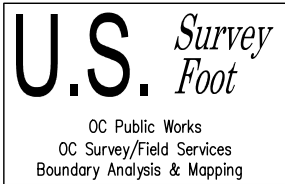


ATWOOD CHANNEL (E04) 44+50 CL

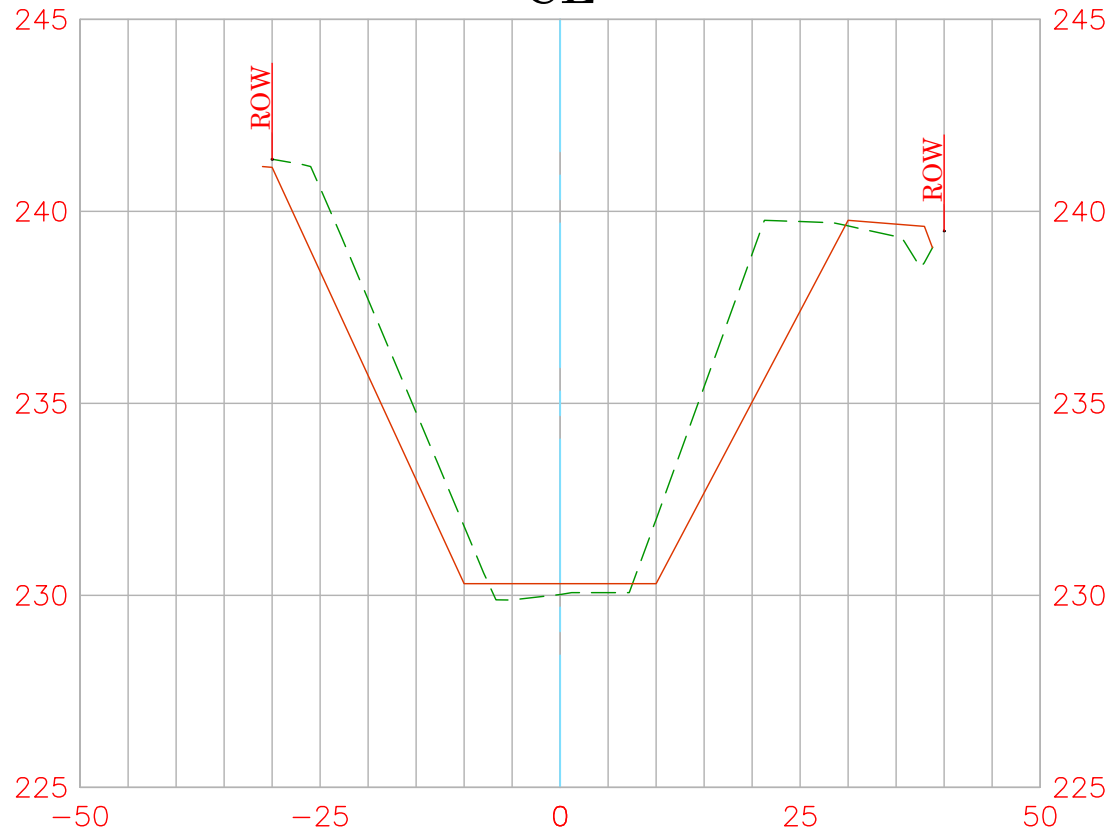

EXISTING CONDITION 2021
RECORD DRAWINGS:
DATE PREPARED: 3/31/2023




Vert. Scale: 1"=5'
Hor. Scale: 1"=20'

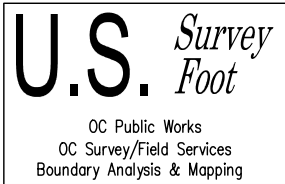

ATWOOD CHANNEL (E04)

45+00

CL


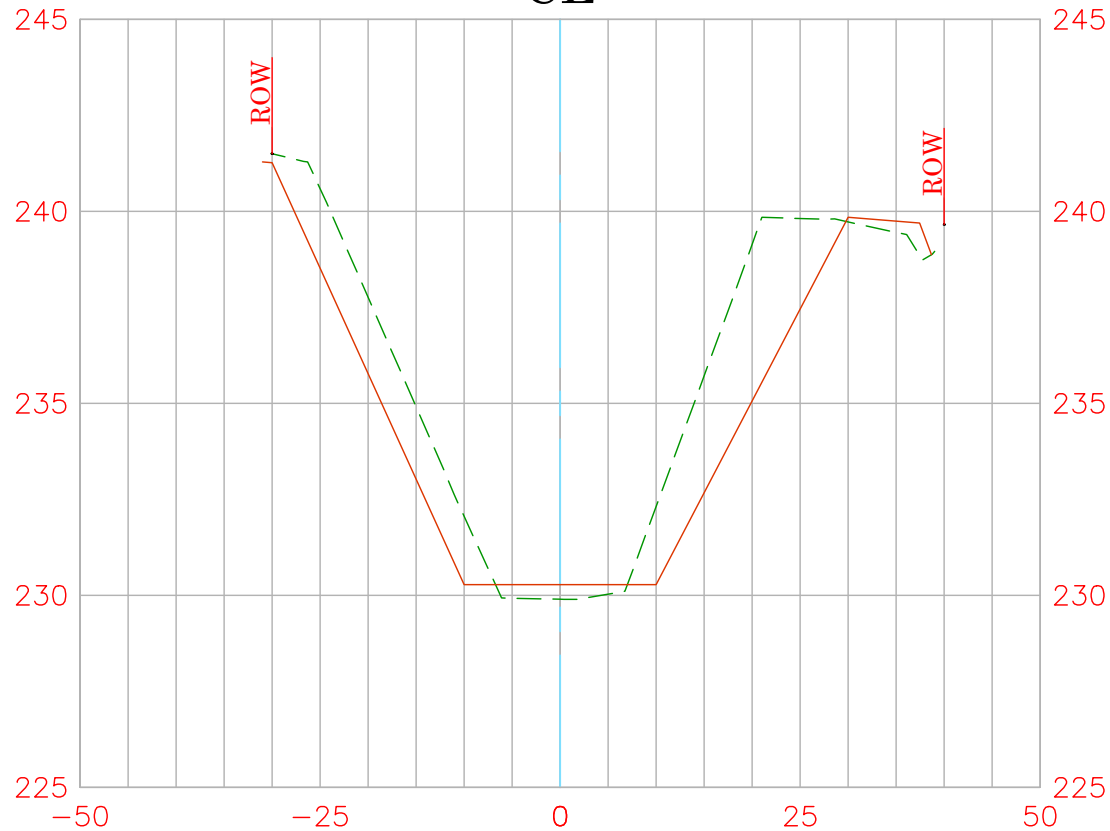


EXISTING CONDITION 2021
RECORD DRAWINGS:
DATE PREPARED: 3/31/2023




Vert. Scale: 1"=5'
Hor. Scale: 1"=20'


ATWOOD CHANNEL (E04) 45+50 CL

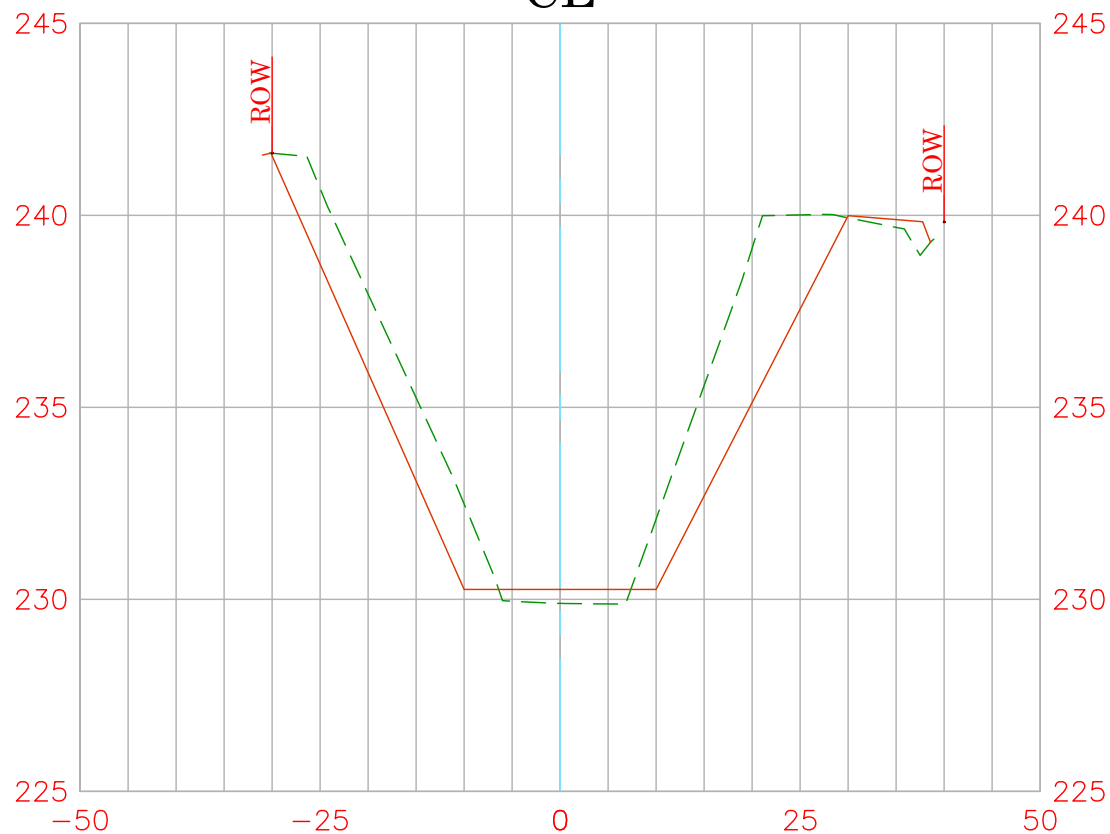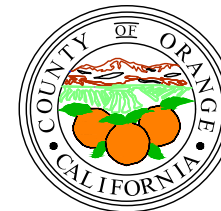

EXISTING CONDITION 2021
 RECORD DRAWINGS:
 DATE PREPARED: 3/31/2023

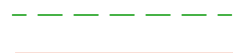


Vert. Scale: 1"=5'
 Hor. Scale: 1"=20'

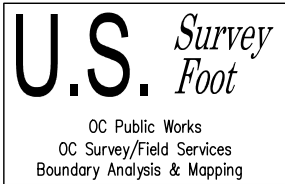

ATWOOD CHANNEL (E04)

46+00

CL

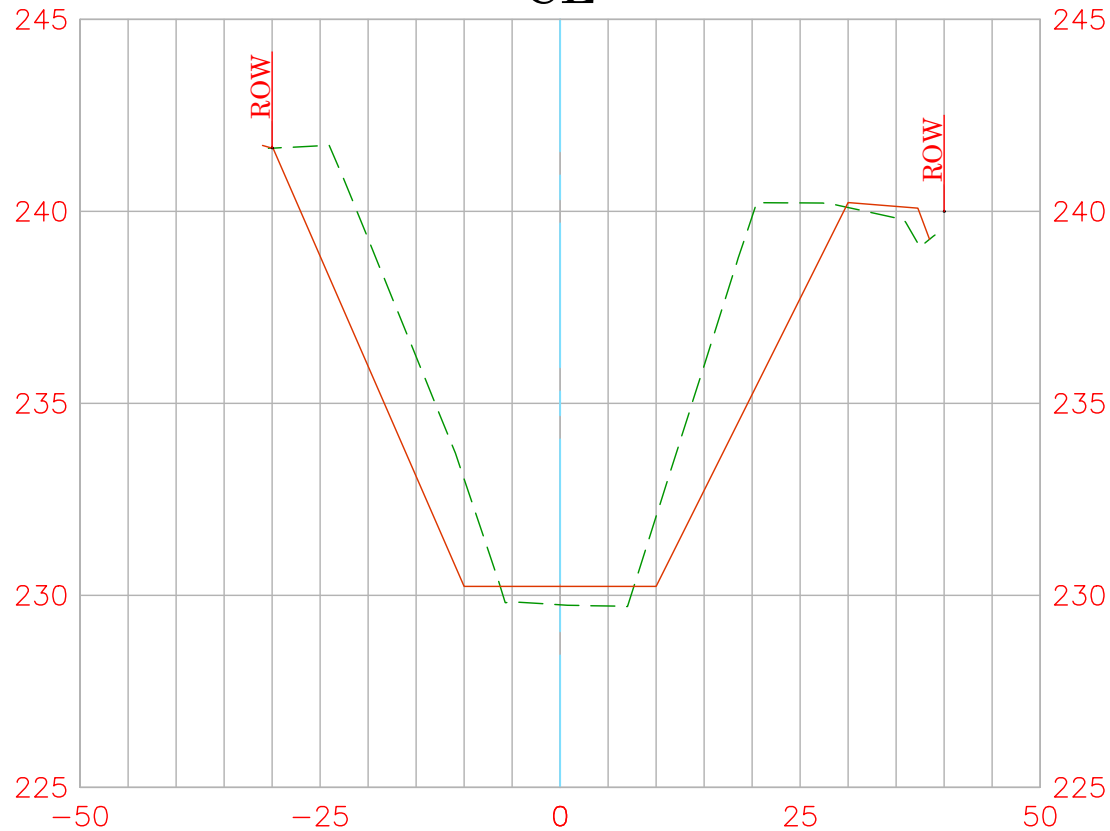

EXISTING CONDITION 2021
RECORD DRAWINGS:
DATE PREPARED: 3/31/2023





Vert. Scale: 1"=5'
Hor. Scale: 1"=20'


ATWOOD CHANNEL (E04)

46+50

CL

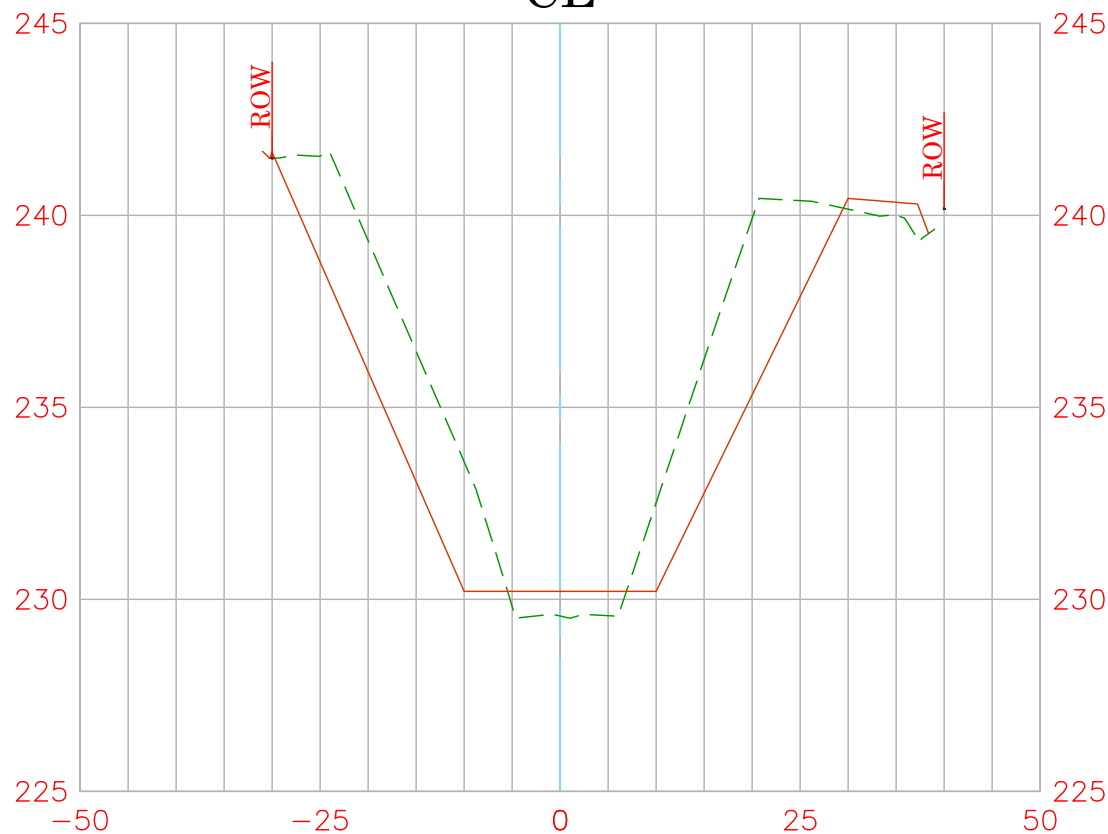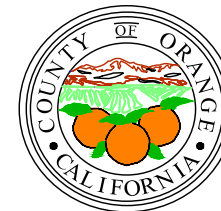

EXISTING CONDITION 2021
 RECORD DRAWINGS:
 DATE PREPARED: 3/31/2023

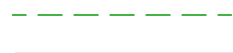


Vert. Scale: 1"=5'
 Hor. Scale: 1"=20'

ATWOOD CHANNEL (E04)

47+00


CL

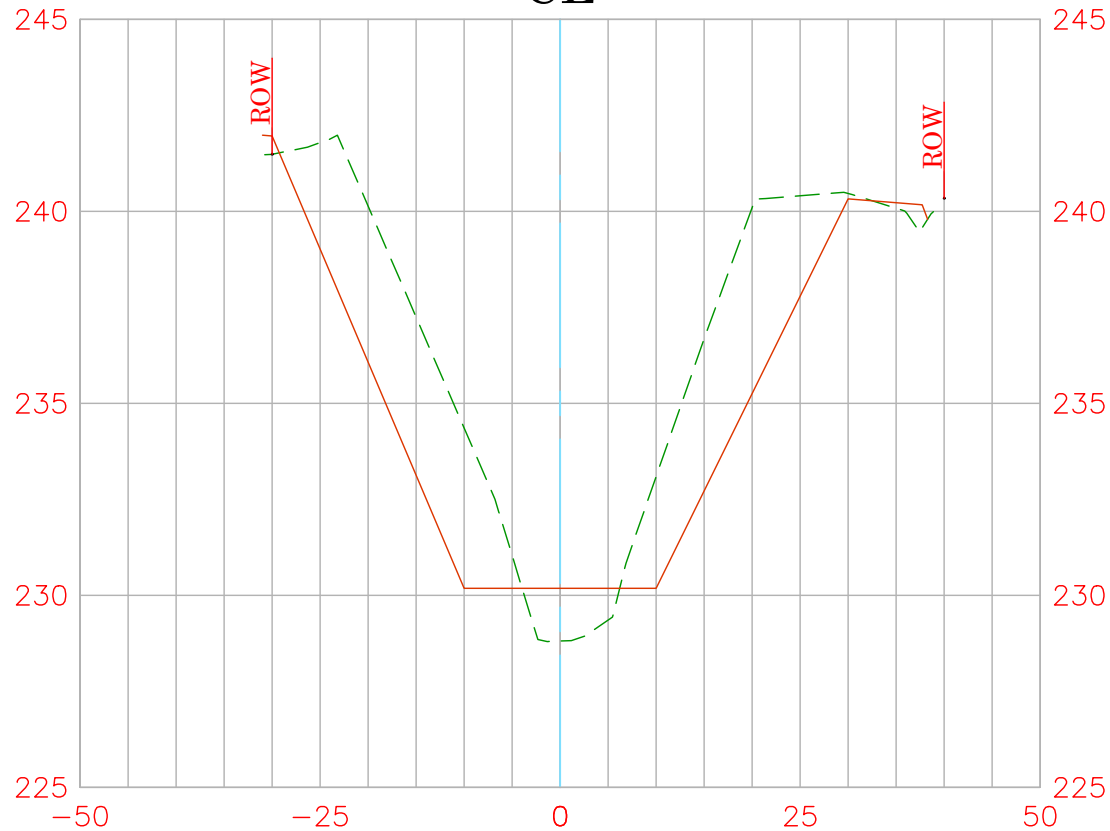

EXISTING CONDITION 2021
 RECORD DRAWINGS:
 DATE PREPARED: 3/31/2023




Vert. Scale: 1"=5'
 Hor. Scale: 1"=20'

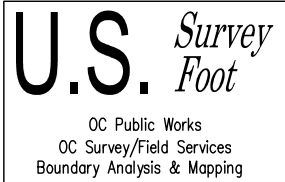

ATWOOD CHANNEL (E04)

47+50

CL

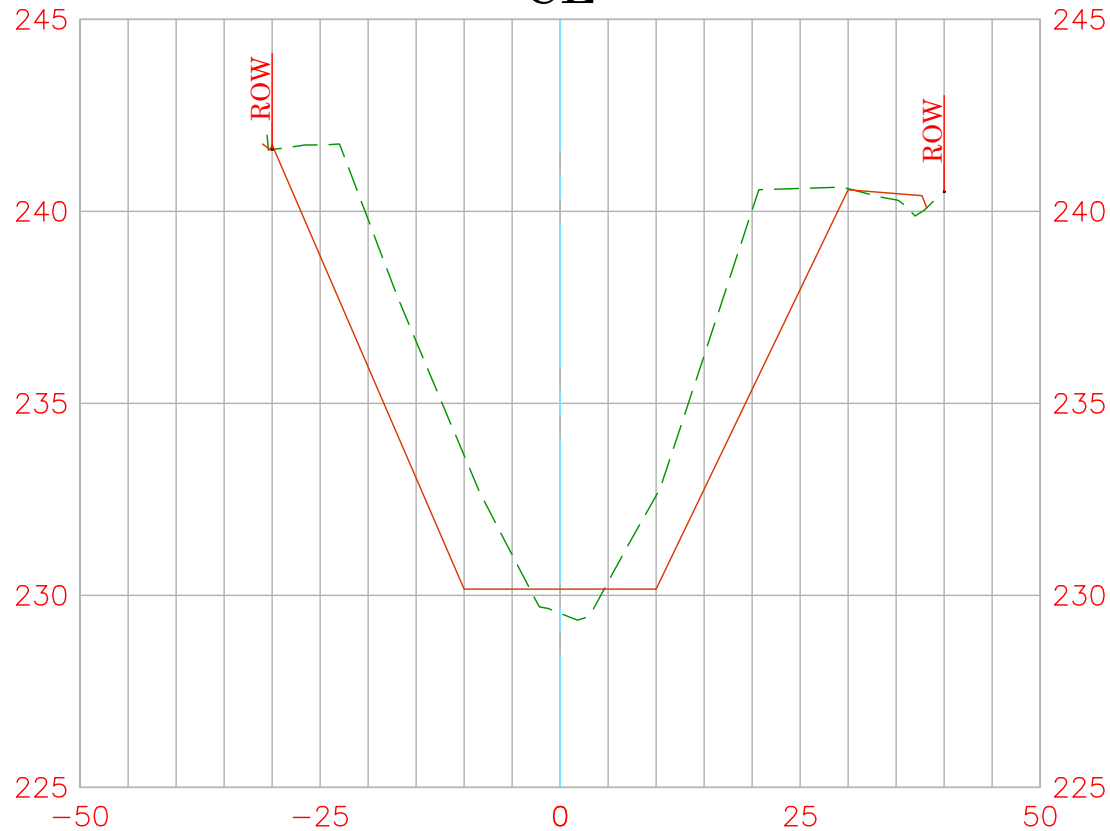

EXISTING CONDITION 2021
RECORD DRAWINGS:
DATE PREPARED: 3/31/2023



Vert. Scale: 1"=5'
Hor. Scale: 1"=20'