


FAIRVIEW CHANNEL (D04)

CL



2019 Channel Survey
As-Built Plan

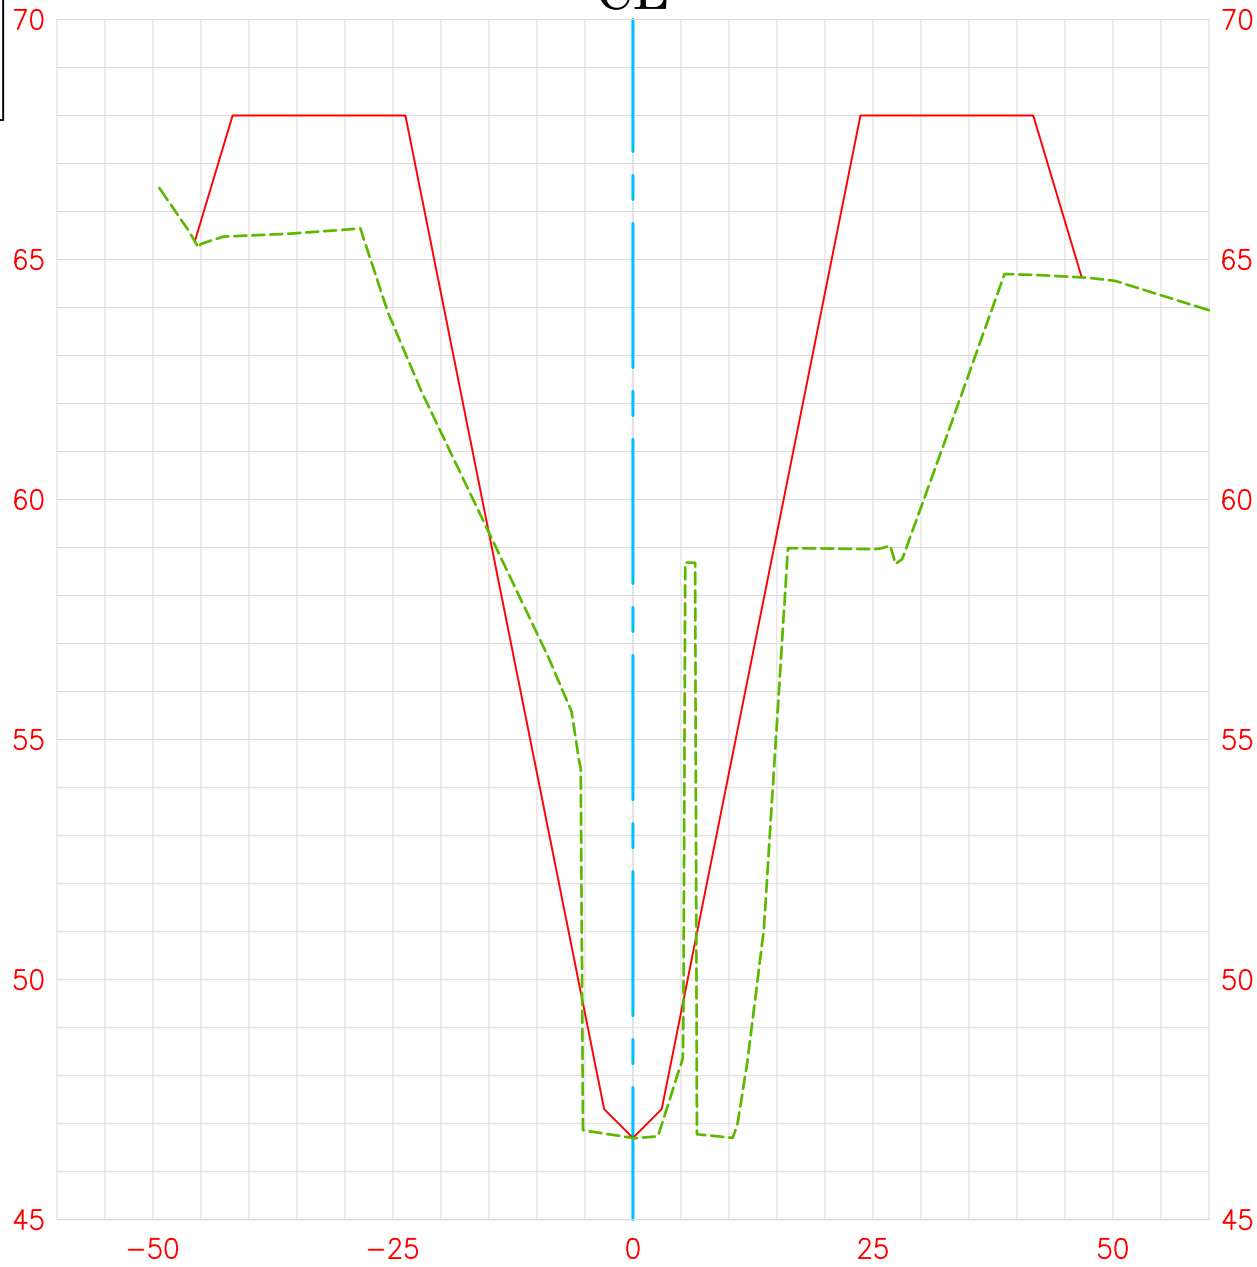

61+51.36


Vert. Scale: 1"=5'
Hor. Scale: 1"=20'

FAIRVIEW CHANNEL (D04)

CL



2019 Channel Survey
As-Built Plan

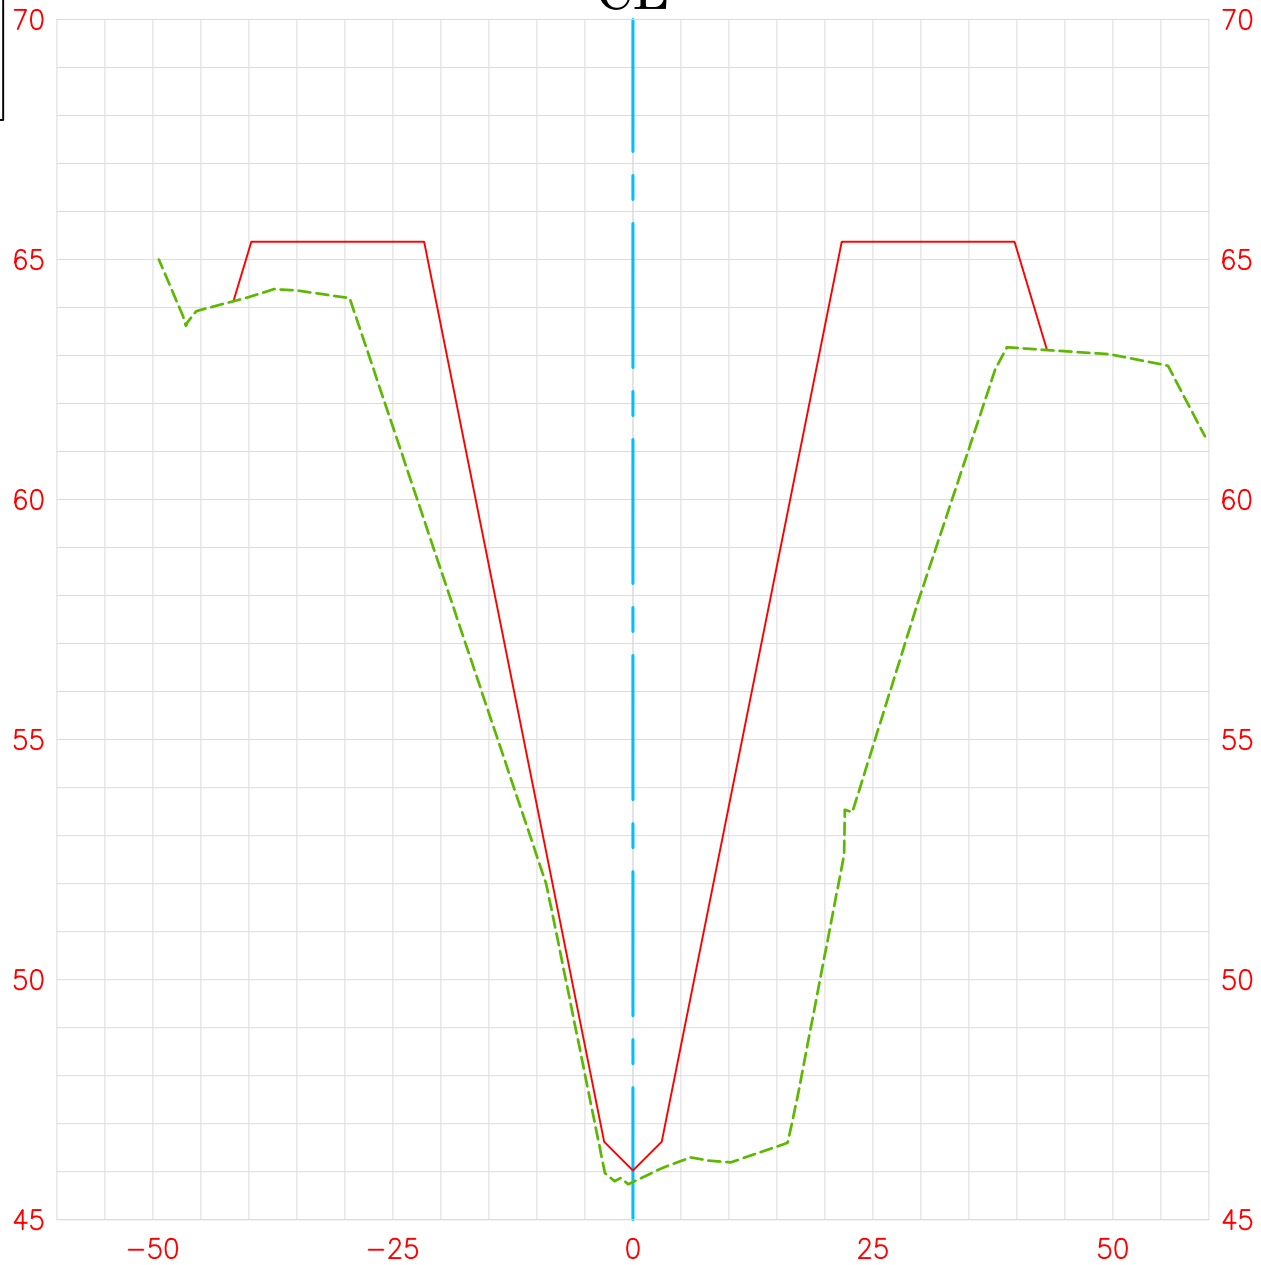



62+00.00


Vert. Scale: 1"=5'
Hor. Scale: 1"=20'

FAIRVIEW CHANNEL (D04) CL



2019 Channel Survey 
As-Built Plan 

Vert. Scale: 1"=5'
Hor. Scale: 1"=20'

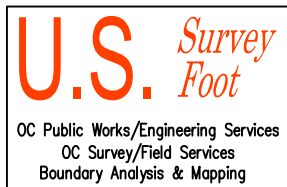


FAIRVIEW CHANNEL (D04) CL



2019 Channel Survey
As-Built Plan

Vert. Scale: 1"=5'
Hor. Scale: 1"=20'

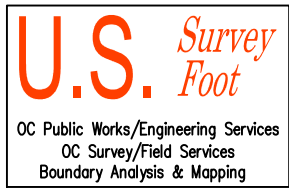


FAIRVIEW CHANNEL (D04) CL




2019 Channel Survey
As-Built Plan

Vert. Scale: 1"=5'
Hor. Scale: 1"=20'

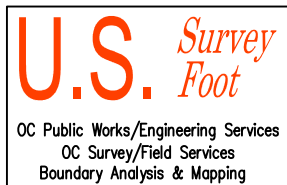


FAIRVIEW CHANNEL (D04) CL

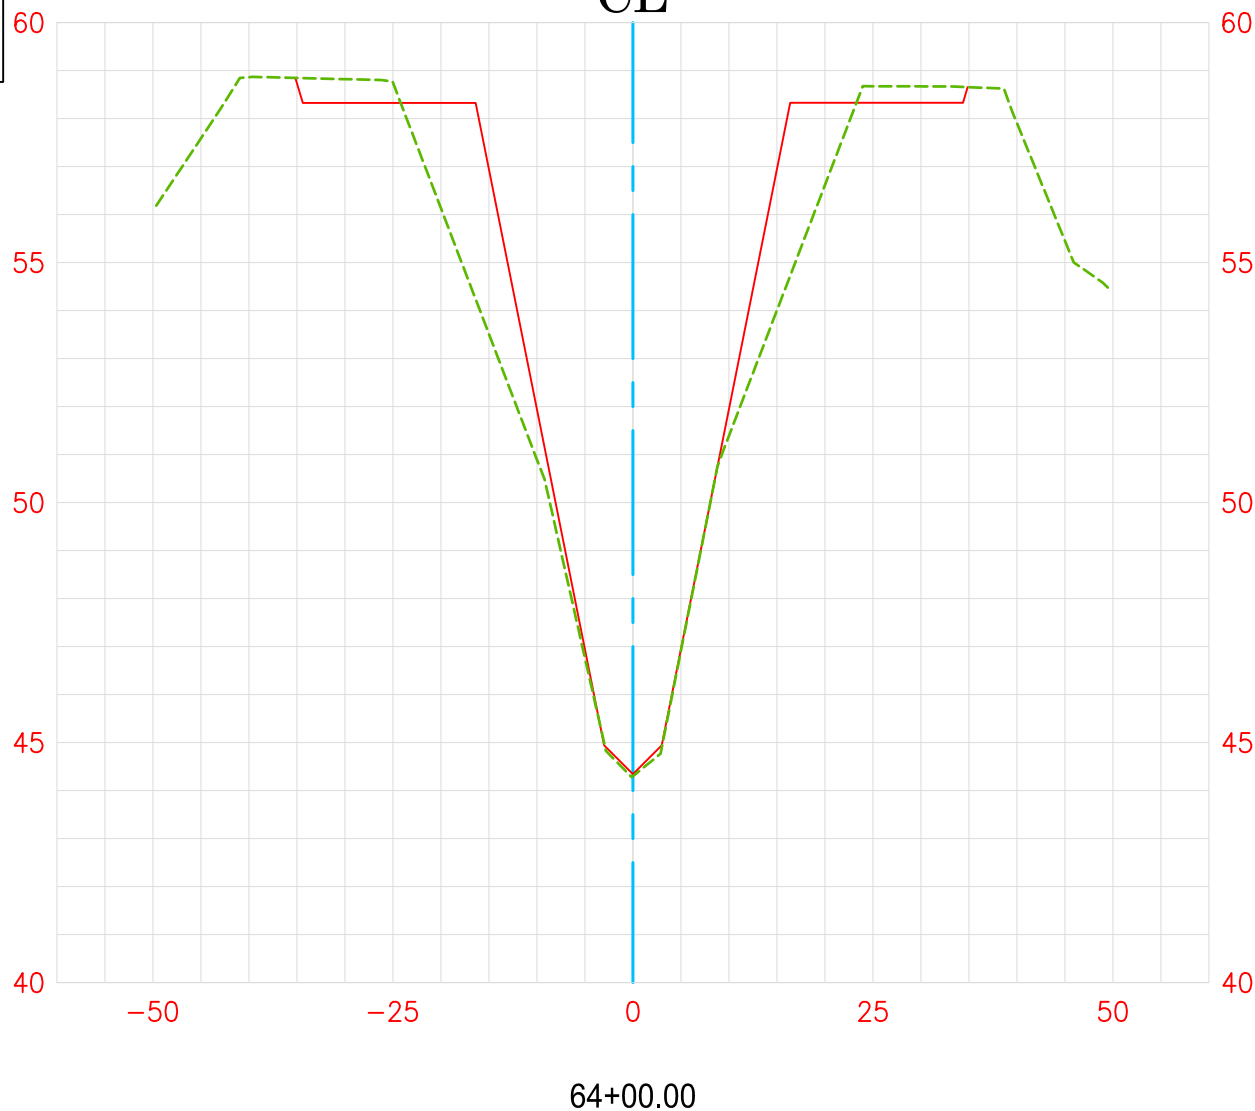




2019 Channel Survey 
As-Built Plan 

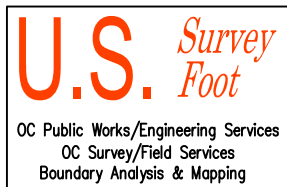Vert. Scale: 1"=5'
Hor. Scale: 1"=20'

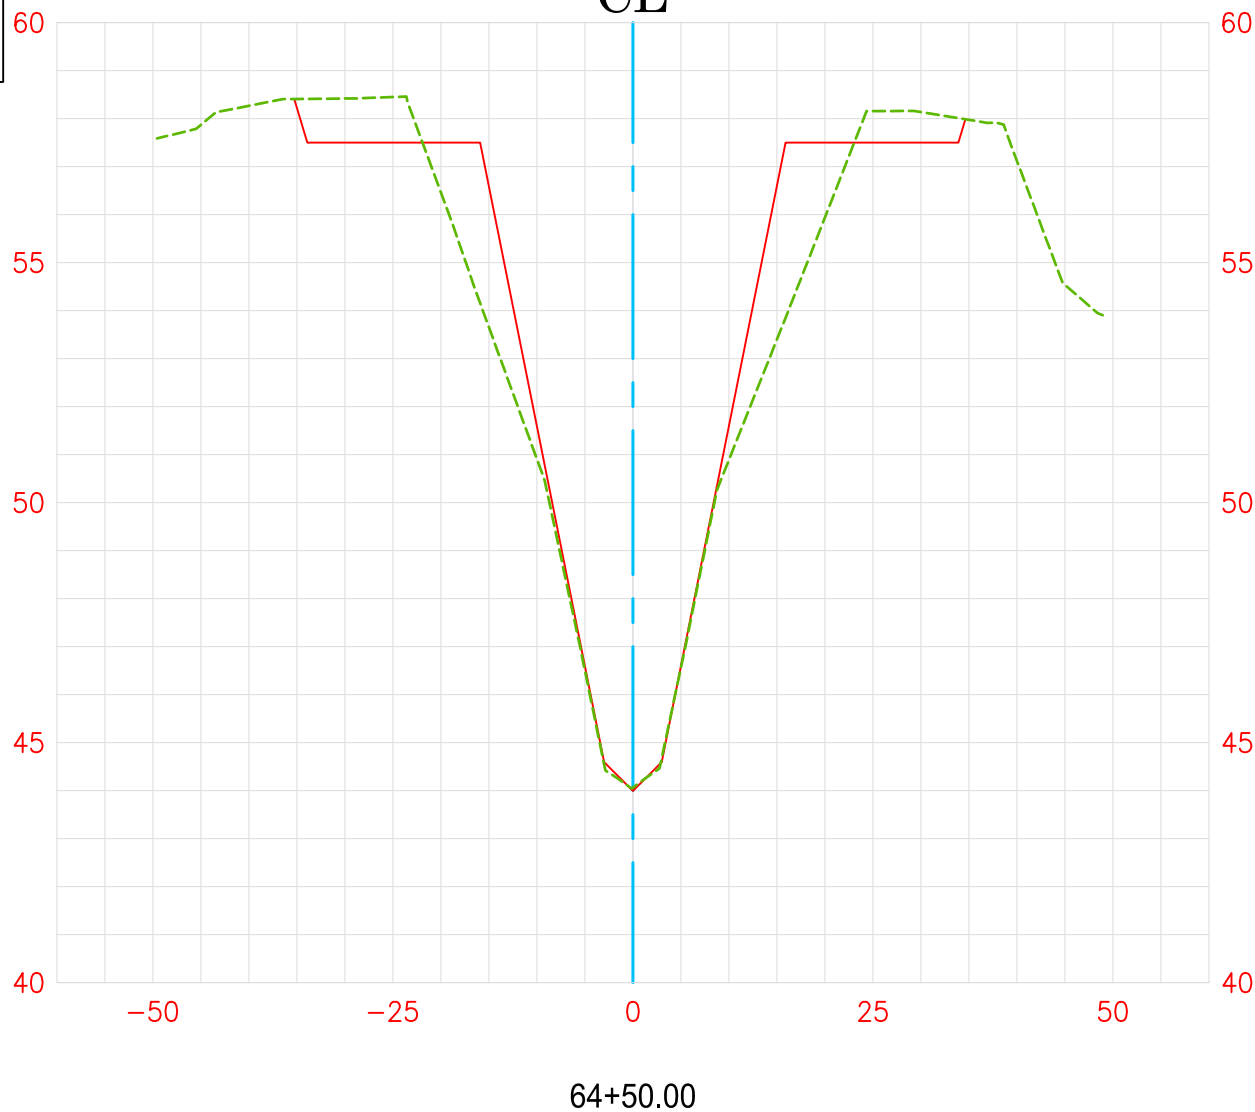


FAIRVIEW CHANNEL (D04) CL





2019 Channel Survey 
As-Built Plan 


Vert. Scale: 1"=5'
Hor. Scale: 1"=20'

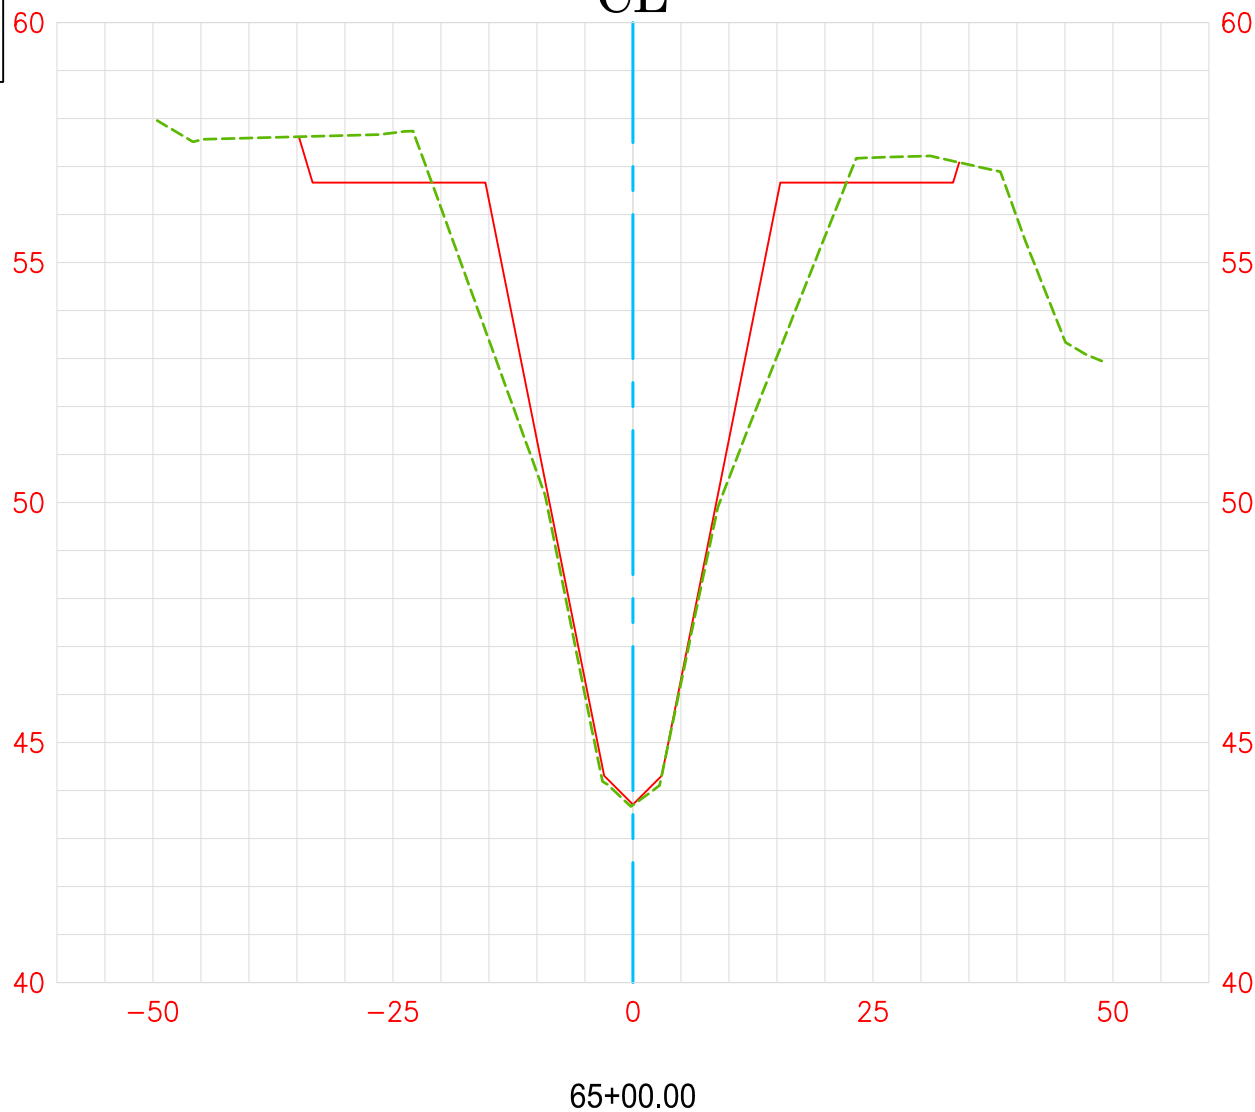FAIRVIEW CHANNEL (D04) CL





2019 Channel Survey 
As-Built Plan 

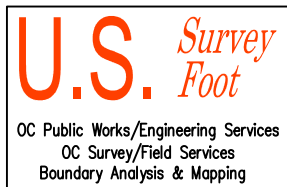Vert. Scale: 1"=5'
Hor. Scale: 1"=20'



FAIRVIEW CHANNEL (D04) CL





2019 Channel Survey 
As-Built Plan 


Vert. Scale: 1"=5'
Hor. Scale: 1"=20'

FAIRVIEW CHANNEL (D04) CL





2019 Channel Survey 
As-Built Plan 

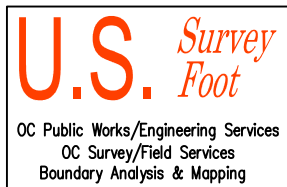Vert. Scale: 1"=5'
Hor. Scale: 1"=20'




FAIRVIEW CHANNEL (D04) CL





2019 Channel Survey 
As-Built Plan 

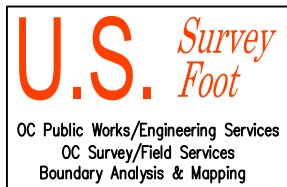Vert. Scale: 1"=5'
Hor. Scale: 1"=20'




FAIRVIEW CHANNEL (D04) CL



2019 Channel Survey 
As-Built Plan 

Vert. Scale: 1"=5'
Hor. Scale: 1"=20'


FAIRVIEW CHANNEL (D04) CL

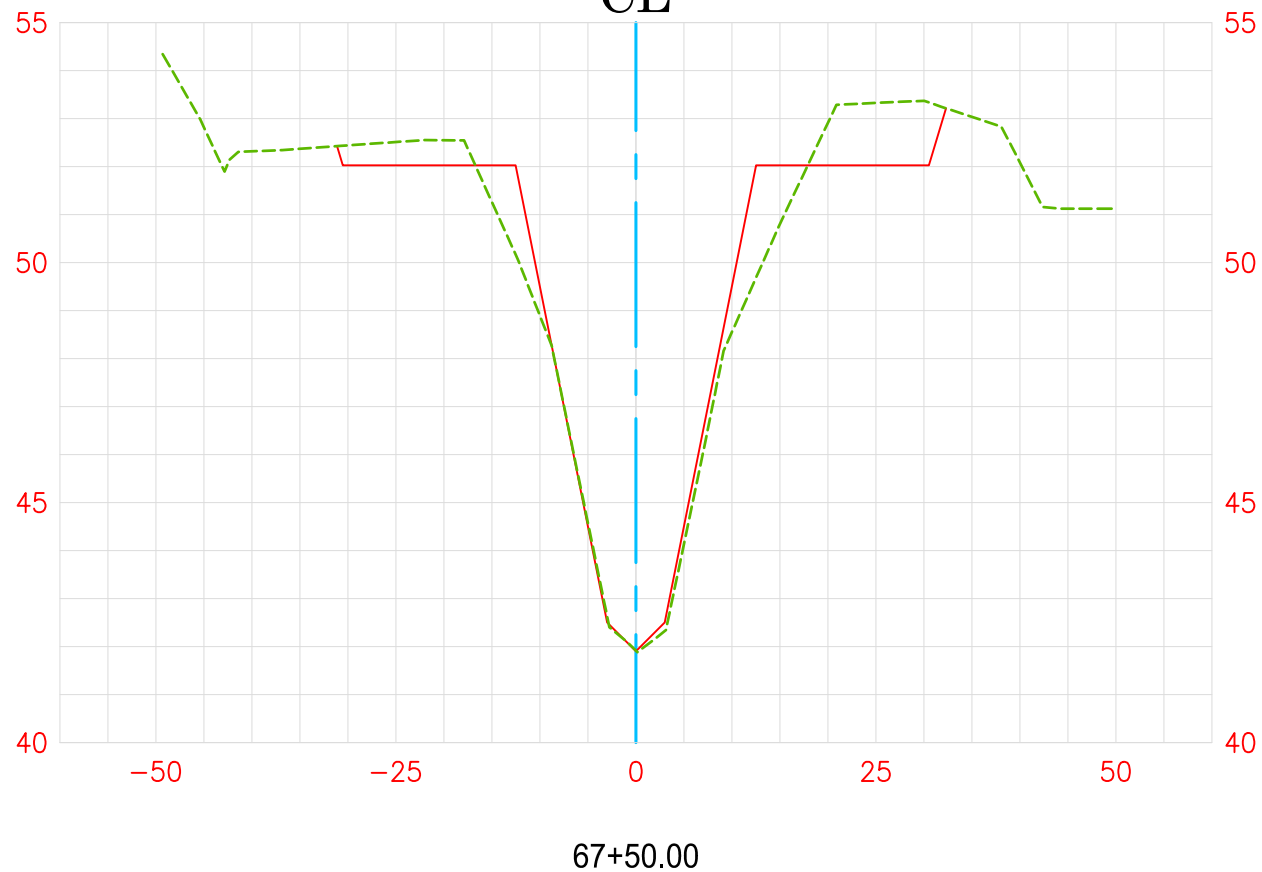

2019 Channel Survey
As-Built Plan

Vert. Scale: 1"=5'
Hor. Scale: 1"=20'


FAIRVIEW CHANNEL (D04) CL

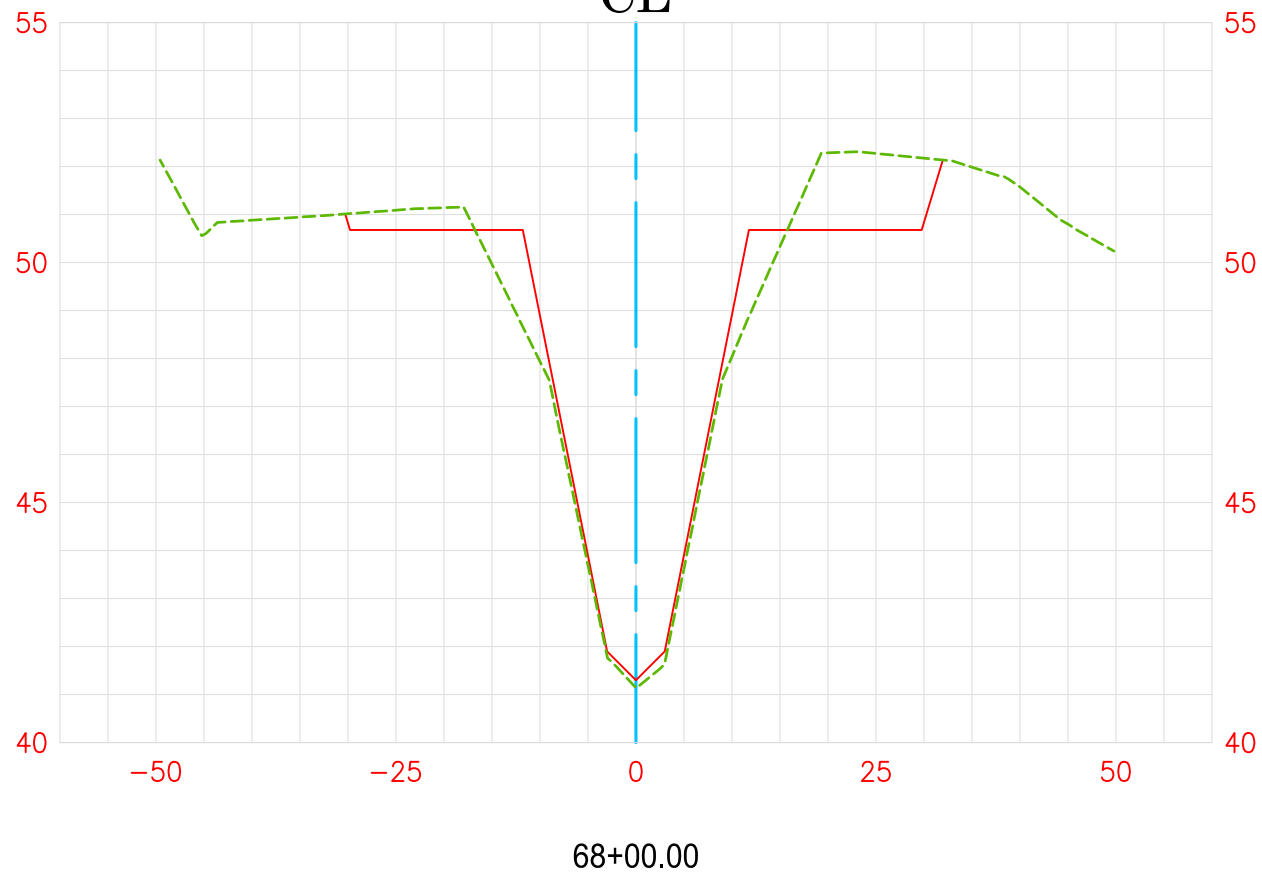

2019 Channel Survey 
As-Built Plan 

Vert. Scale: 1"=5'
Hor. Scale: 1"=20'


FAIRVIEW CHANNEL (D04) CL

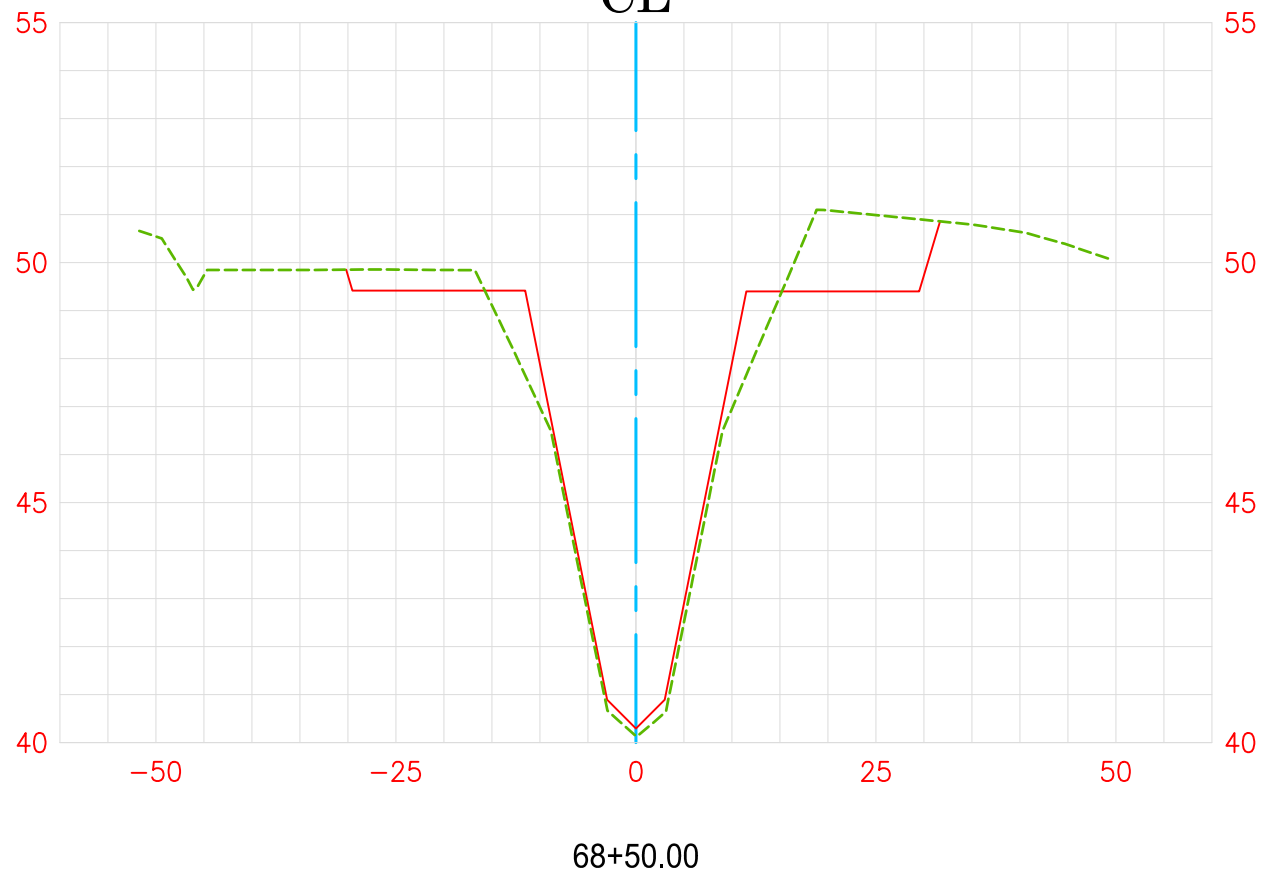



2019 Channel Survey 
As-Built Plan 

Vert. Scale: 1"=5'
Hor. Scale: 1"=20'

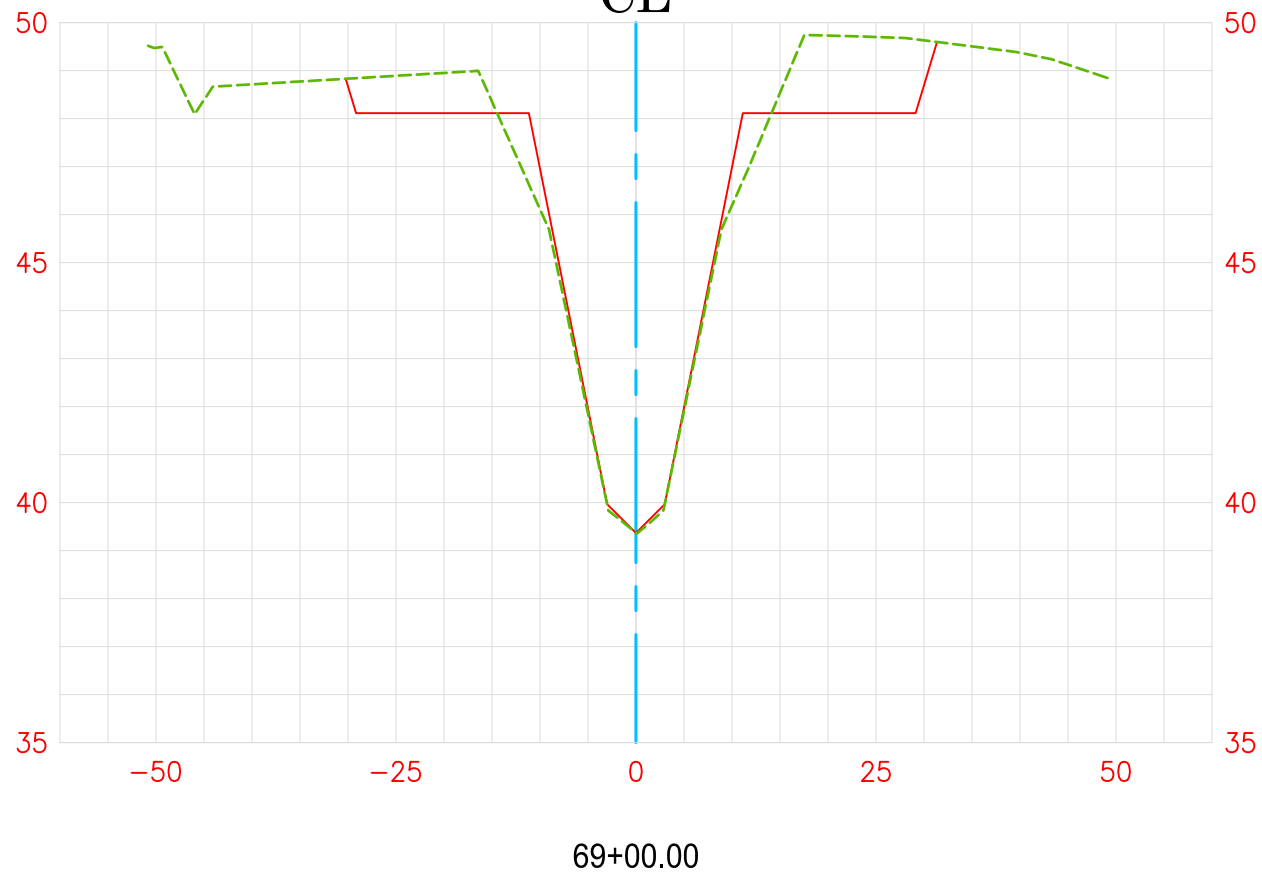
FAIRVIEW CHANNEL (D04) CL



2019 Channel Survey 
As-Built Plan 

Vert. Scale: 1"=5'
Hor. Scale: 1"=20'


FAIRVIEW CHANNEL (D04) CL

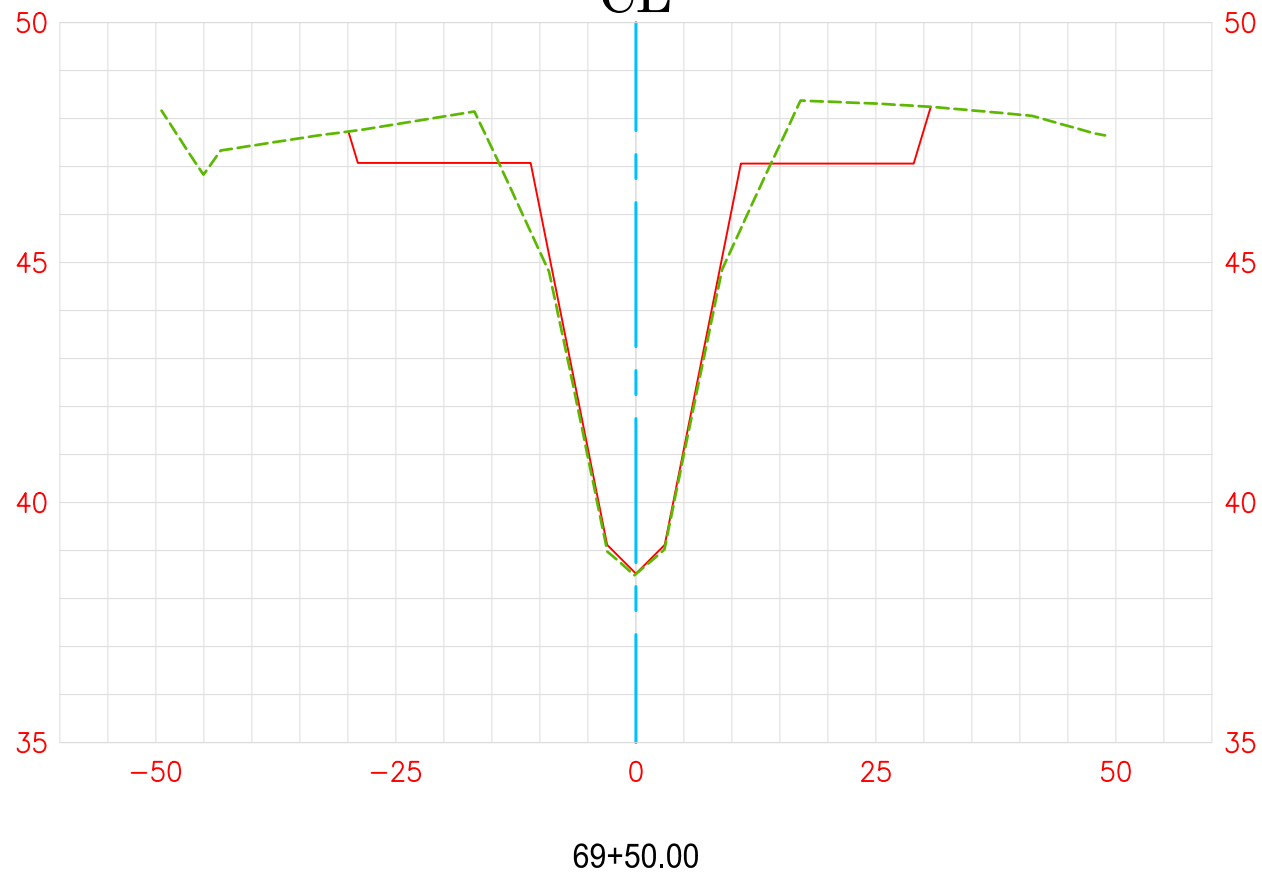



2019 Channel Survey 
As-Built Plan 

Vert. Scale: 1"=5'
Hor. Scale: 1"=20'

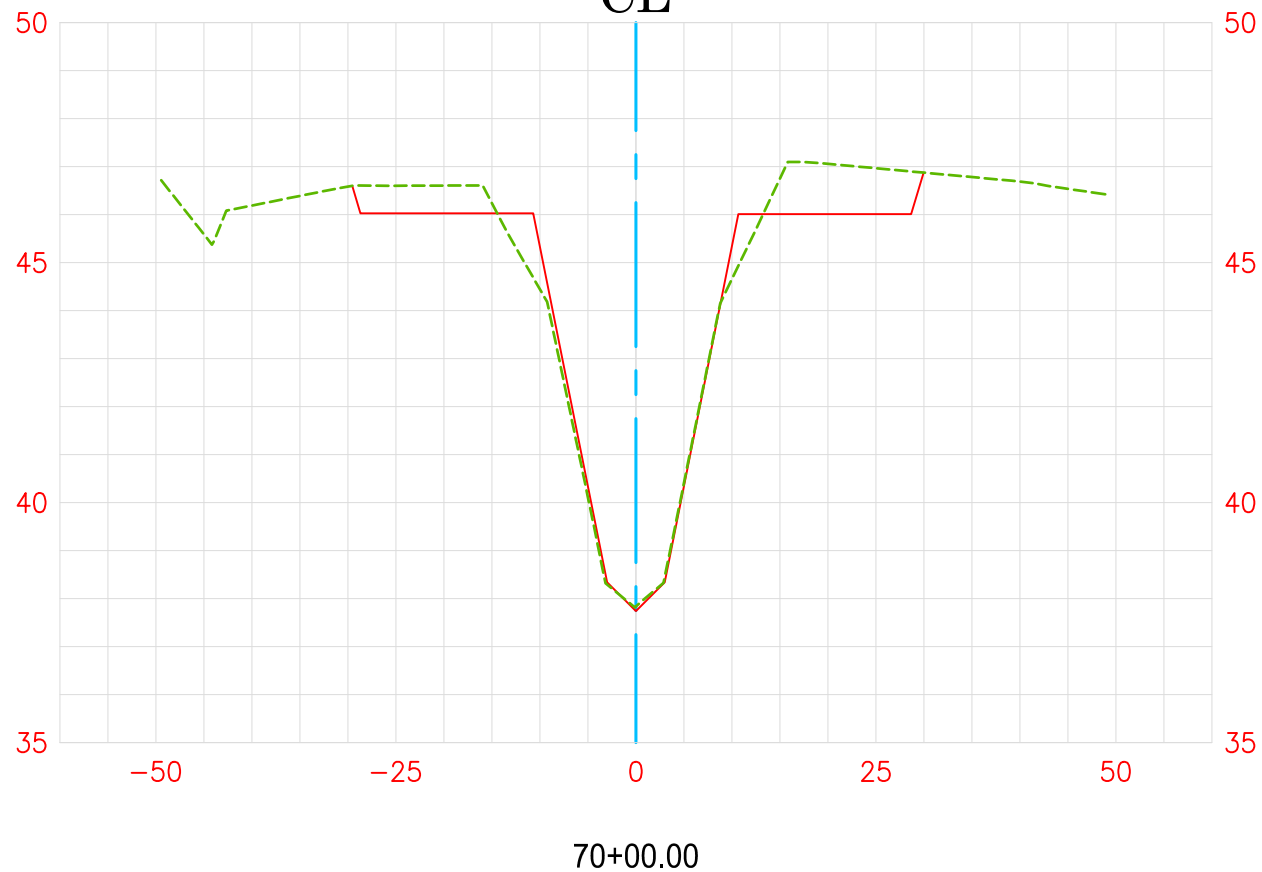
FAIRVIEW CHANNEL (D04) CL



2019 Channel Survey 
As-Built Plan 

Vert. Scale: 1"=5'
Hor. Scale: 1"=20'


FAIRVIEW CHANNEL (D04) CL

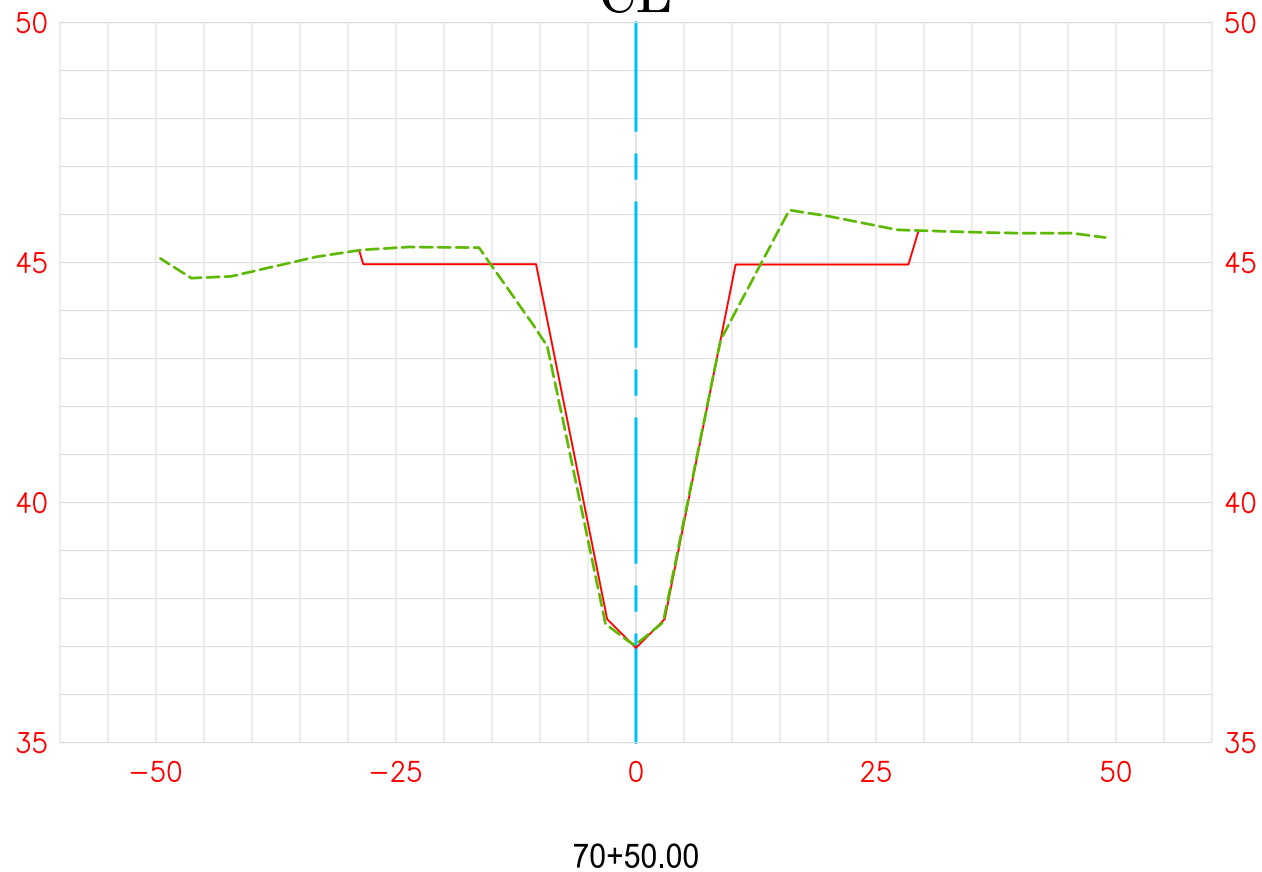

2019 Channel Survey 
As-Built Plan 

Vert. Scale: 1"=5'
Hor. Scale: 1"=20'


FAIRVIEW CHANNEL (D04) CL

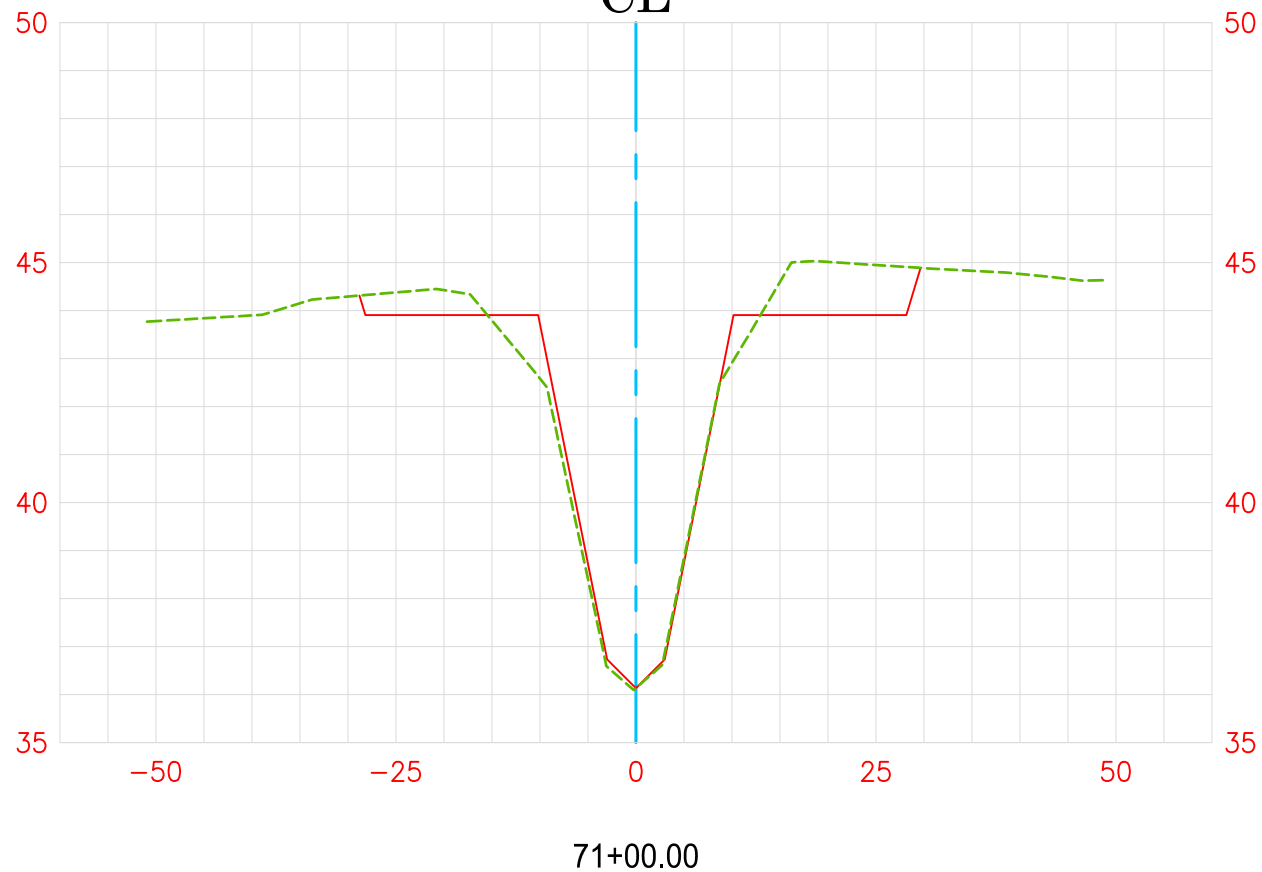



2019 Channel Survey 
As-Built Plan 

Vert. Scale: 1"=5'
Hor. Scale: 1"=20'

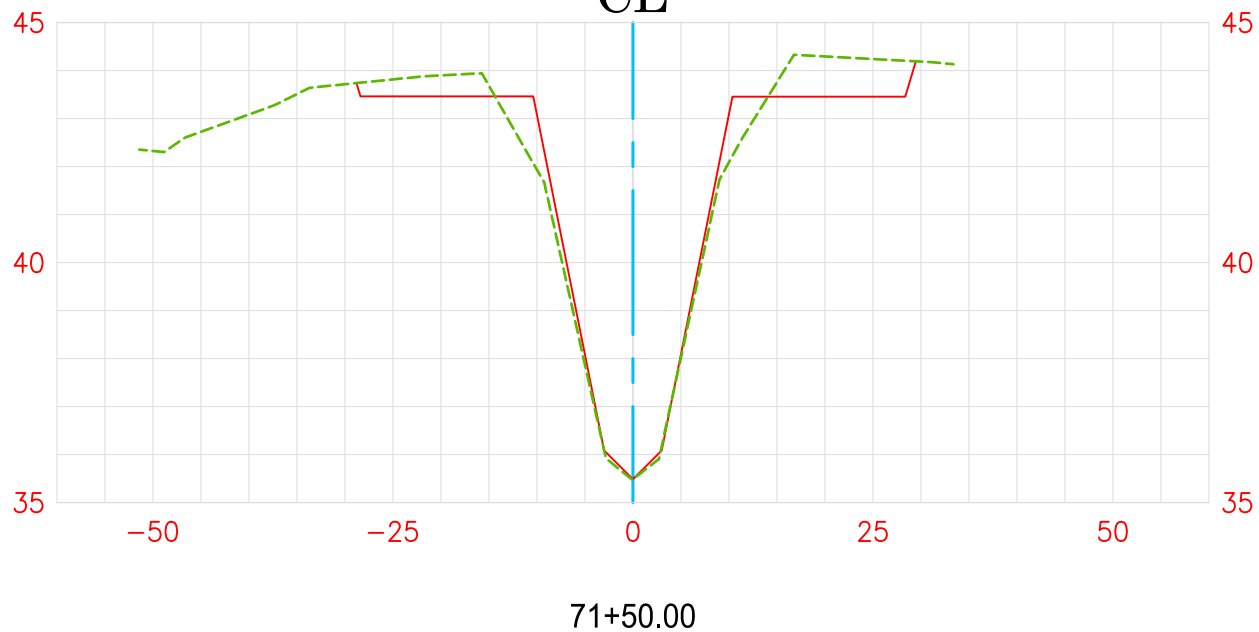
FAIRVIEW CHANNEL (D04) CL



2019 Channel Survey 
As-Built Plan 

Vert. Scale: 1"=5'
Hor. Scale: 1"=20'


FAIRVIEW CHANNEL (D04) CL

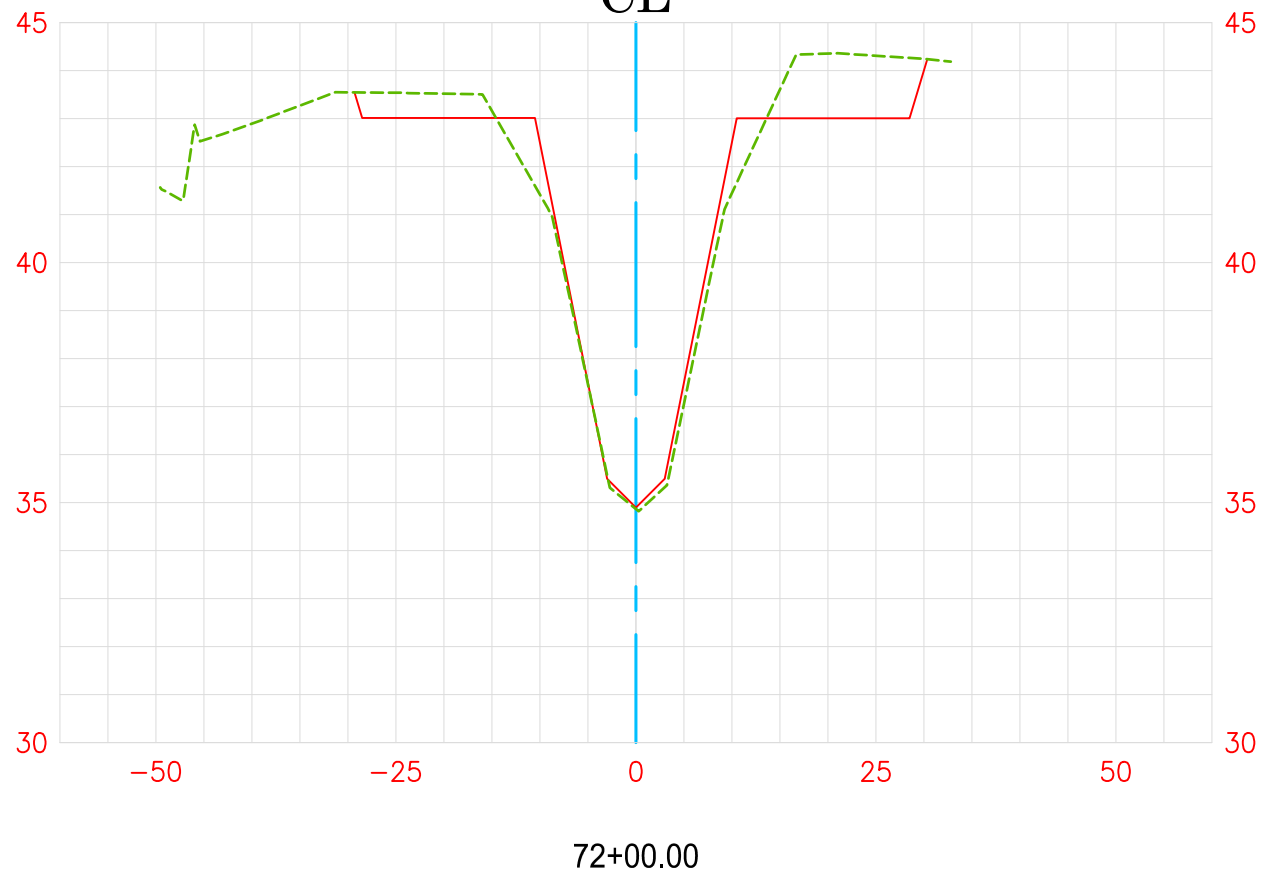



2019 Channel Survey 
As-Built Plan 

Vert. Scale: 1"=5'
Hor. Scale: 1"=20'

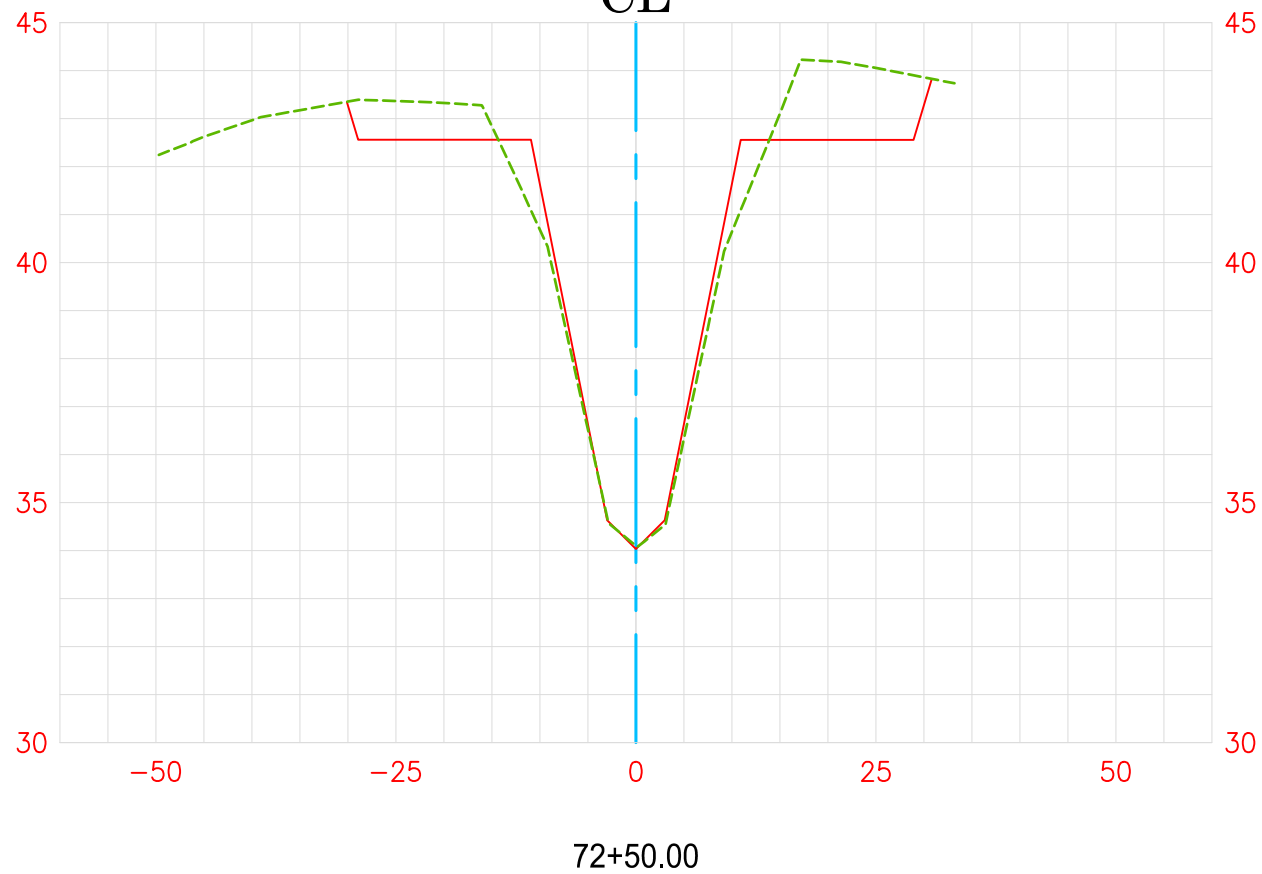
FAIRVIEW CHANNEL (D04) CL





2019 Channel Survey 
As-Built Plan 

Vert. Scale: 1"=5'
Hor. Scale: 1"=20'

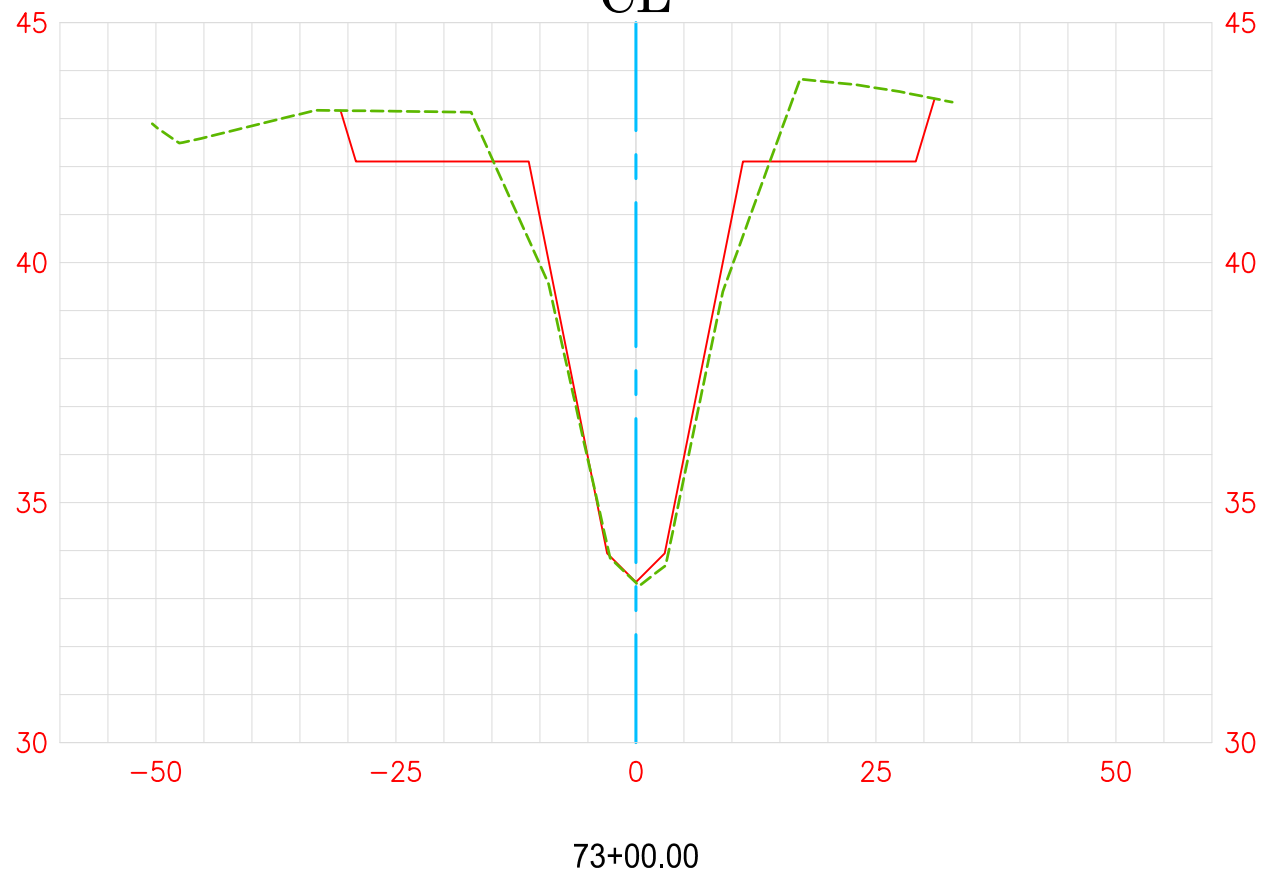
FAIRVIEW CHANNEL (D04) CL



2019 Channel Survey 
As-Built Plan 

Vert. Scale: 1"=5'
Hor. Scale: 1"=20'


FAIRVIEW CHANNEL (D04) CL

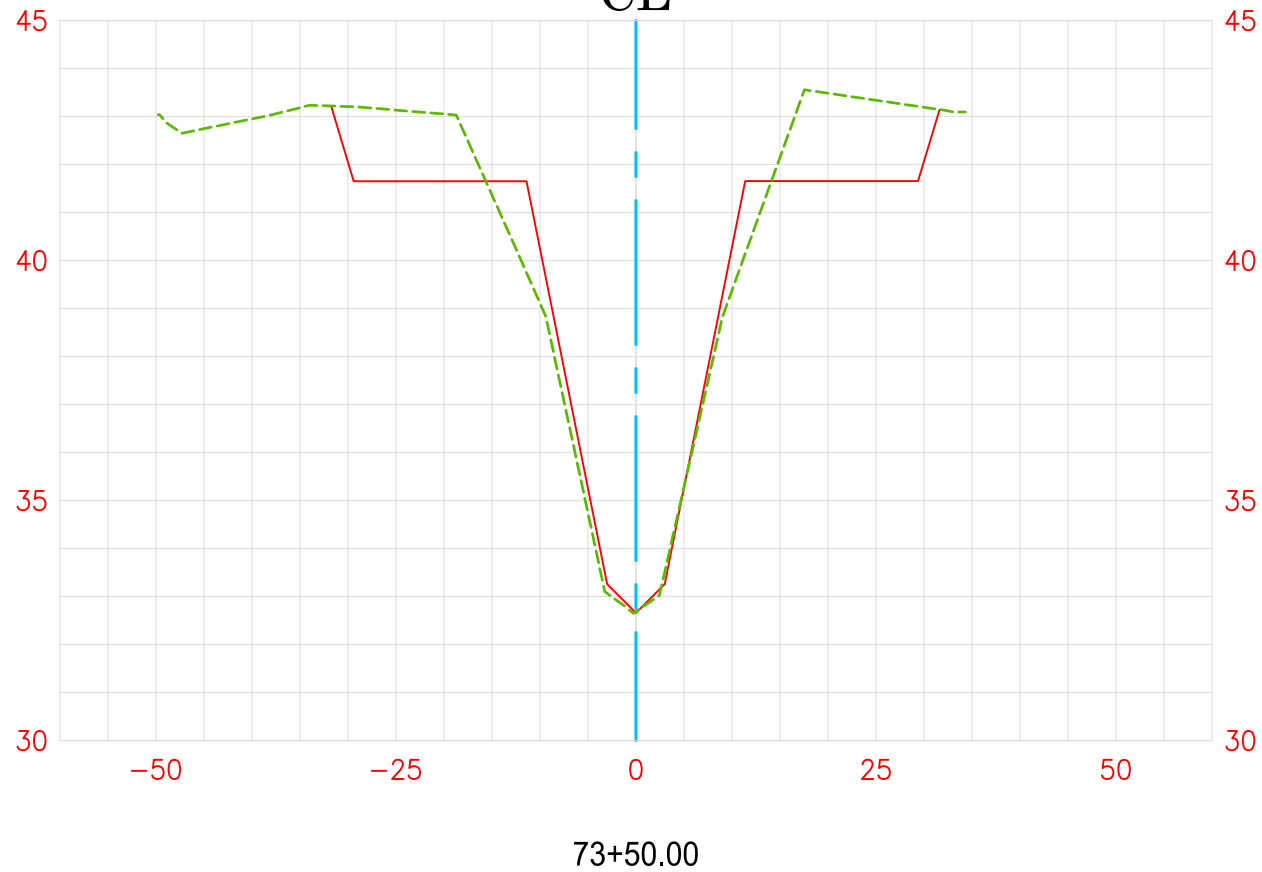

2019 Channel Survey 
As-Built Plan 

Vert. Scale: 1"=5'
Hor. Scale: 1"=20'


FAIRVIEW CHANNEL (D04) CL

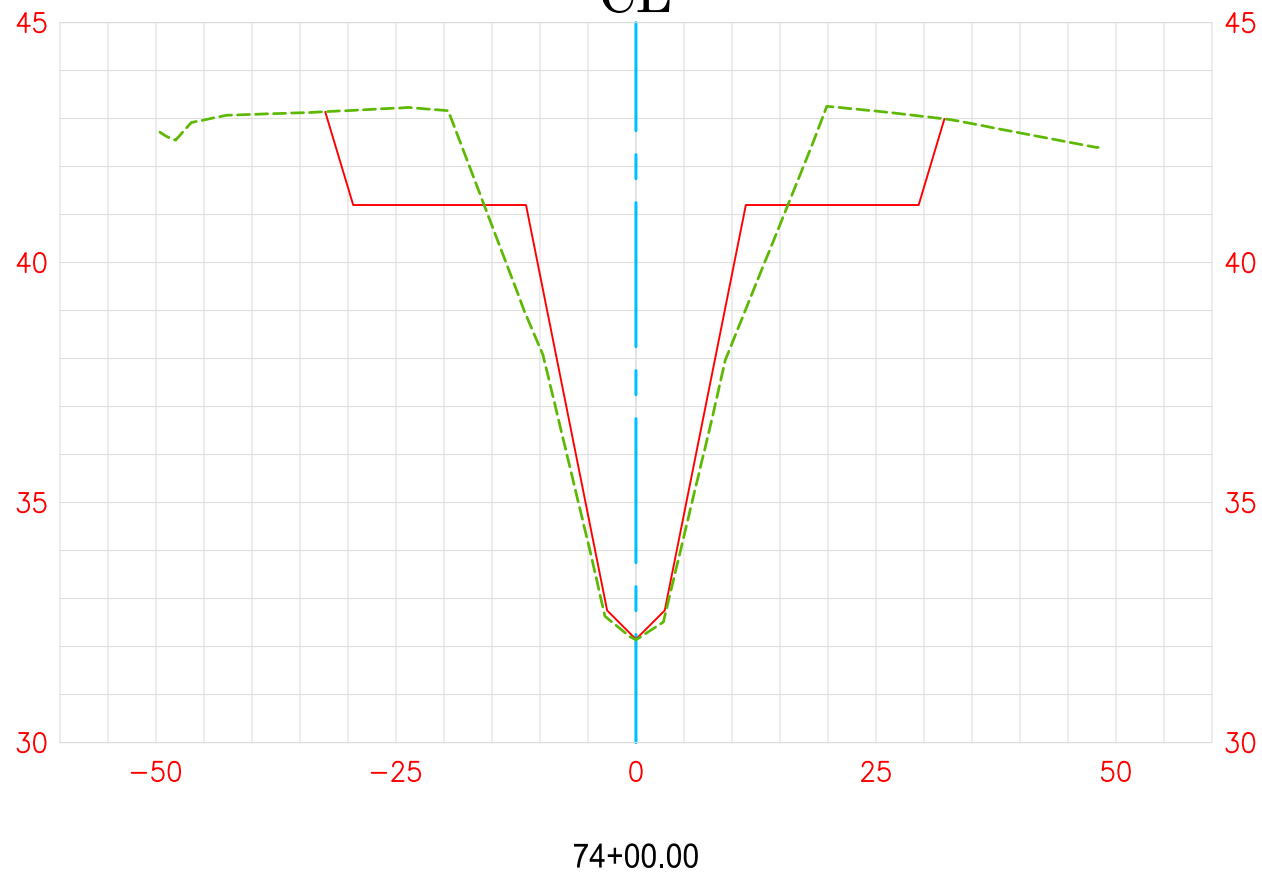



2019 Channel Survey 
As-Built Plan 

Vert. Scale: 1"=5'
Hor. Scale: 1"=20'

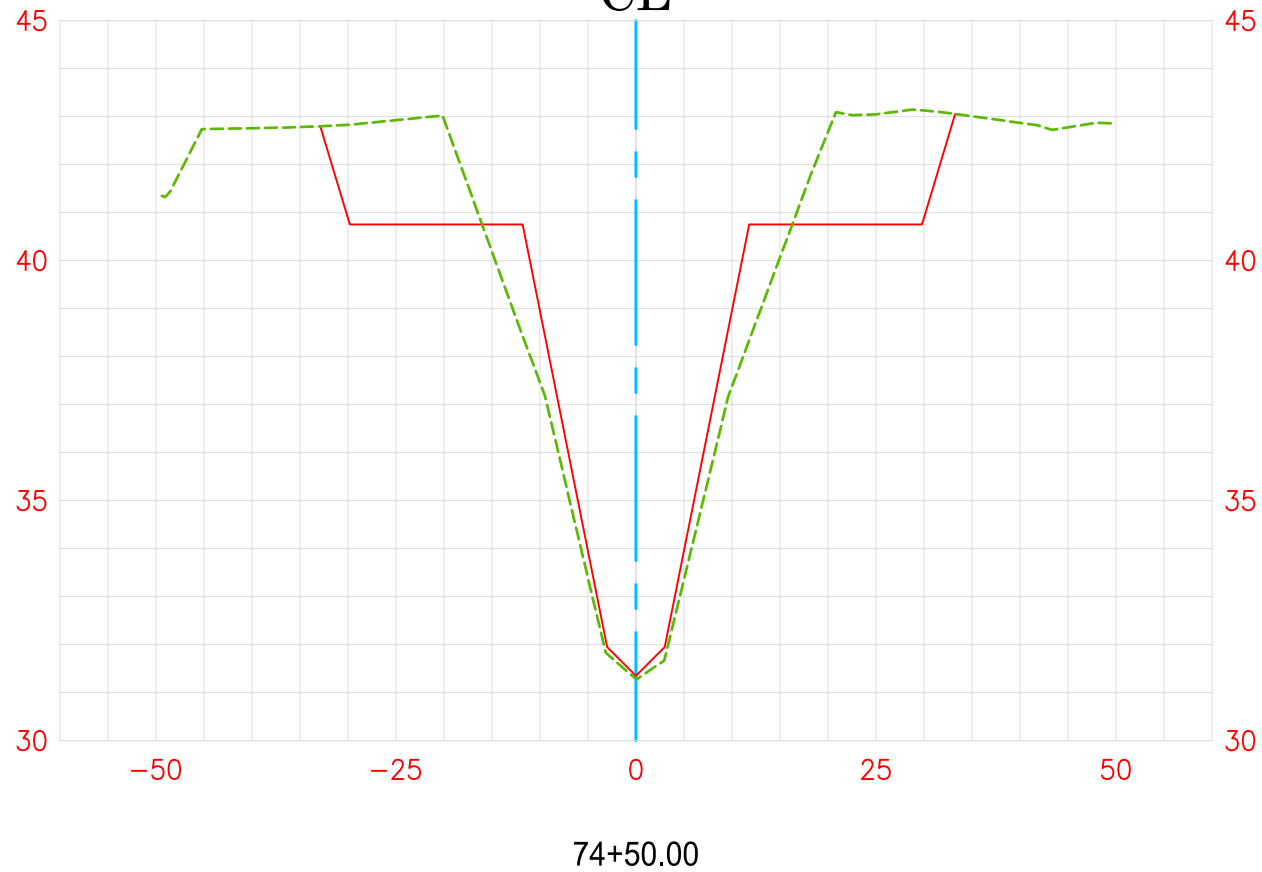
FAIRVIEW CHANNEL (D04) CL





2019 Channel Survey 
As-Built Plan 

Vert. Scale: 1"=5'
Hor. Scale: 1"=20'

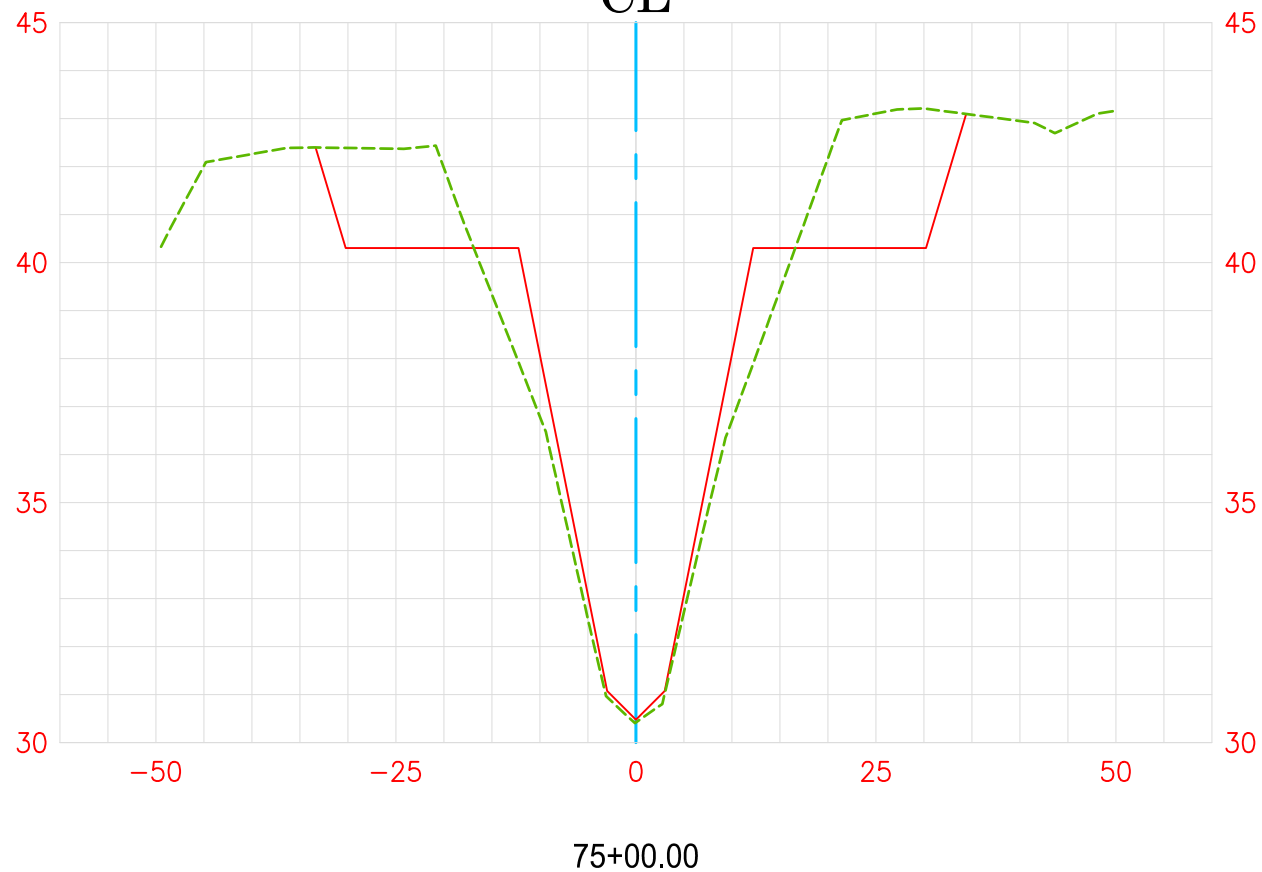
FAIRVIEW CHANNEL (D04) CL



2019 Channel Survey 
As-Built Plan 


Vert. Scale: 1"=5'
Hor. Scale: 1"=20'

FAIRVIEW CHANNEL (D04) CL

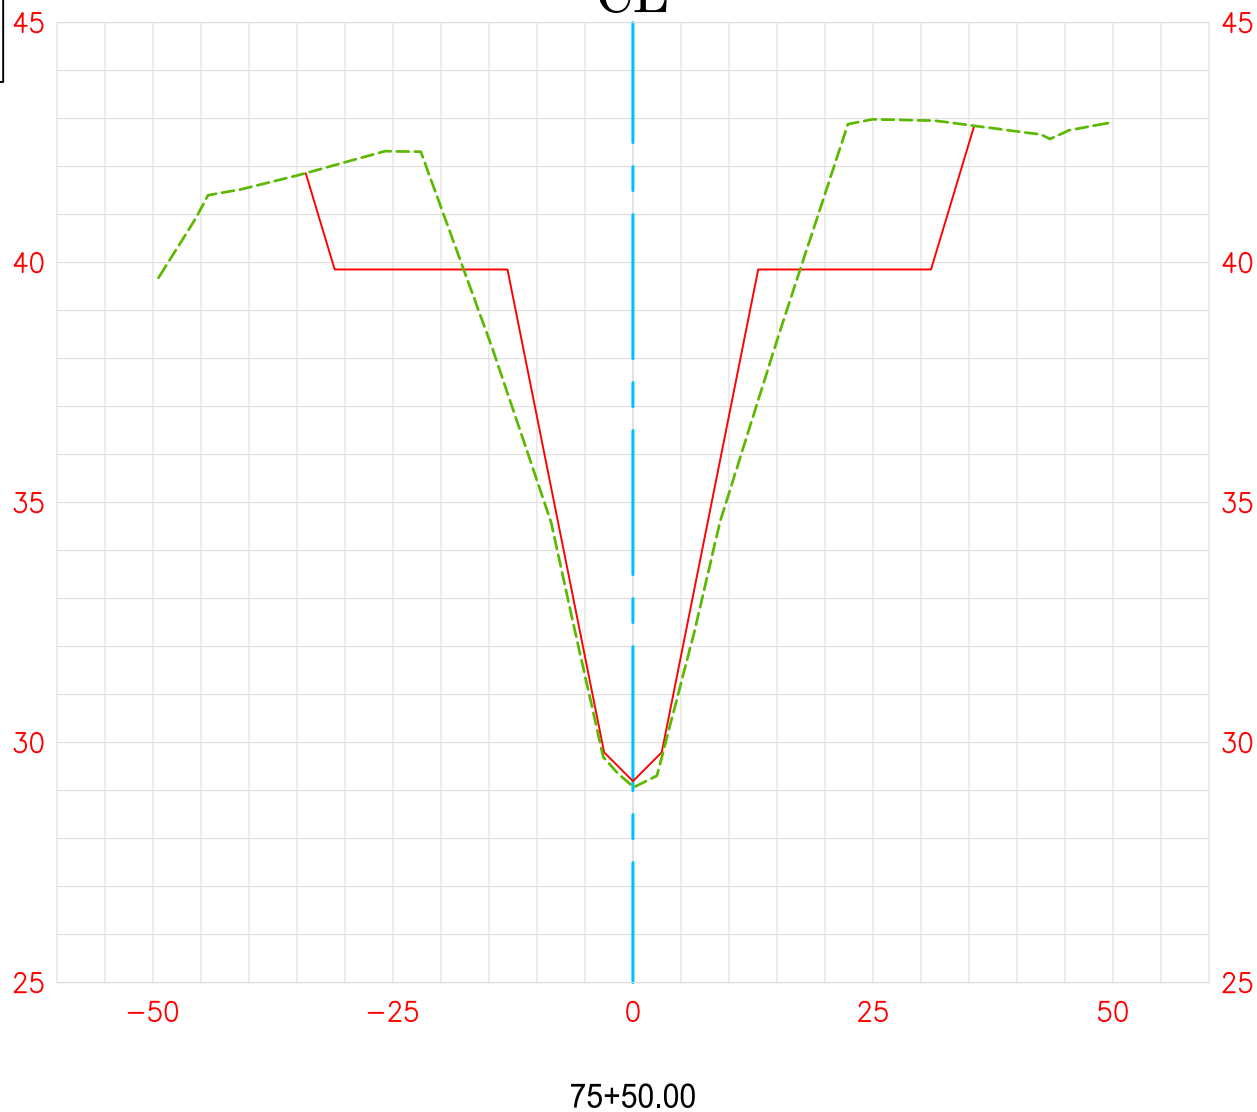

2019 Channel Survey 
As-Built Plan 

Vert. Scale: 1"=5'
Hor. Scale: 1"=20'

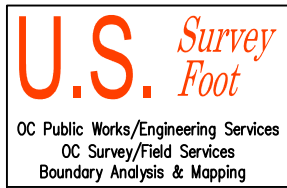


FAIRVIEW CHANNEL (D04) CL



2019 Channel Survey 
As-Built Plan 

Vert. Scale: 1"=5'
Hor. Scale: 1"=20'

FAIRVIEW CHANNEL (D04) CL

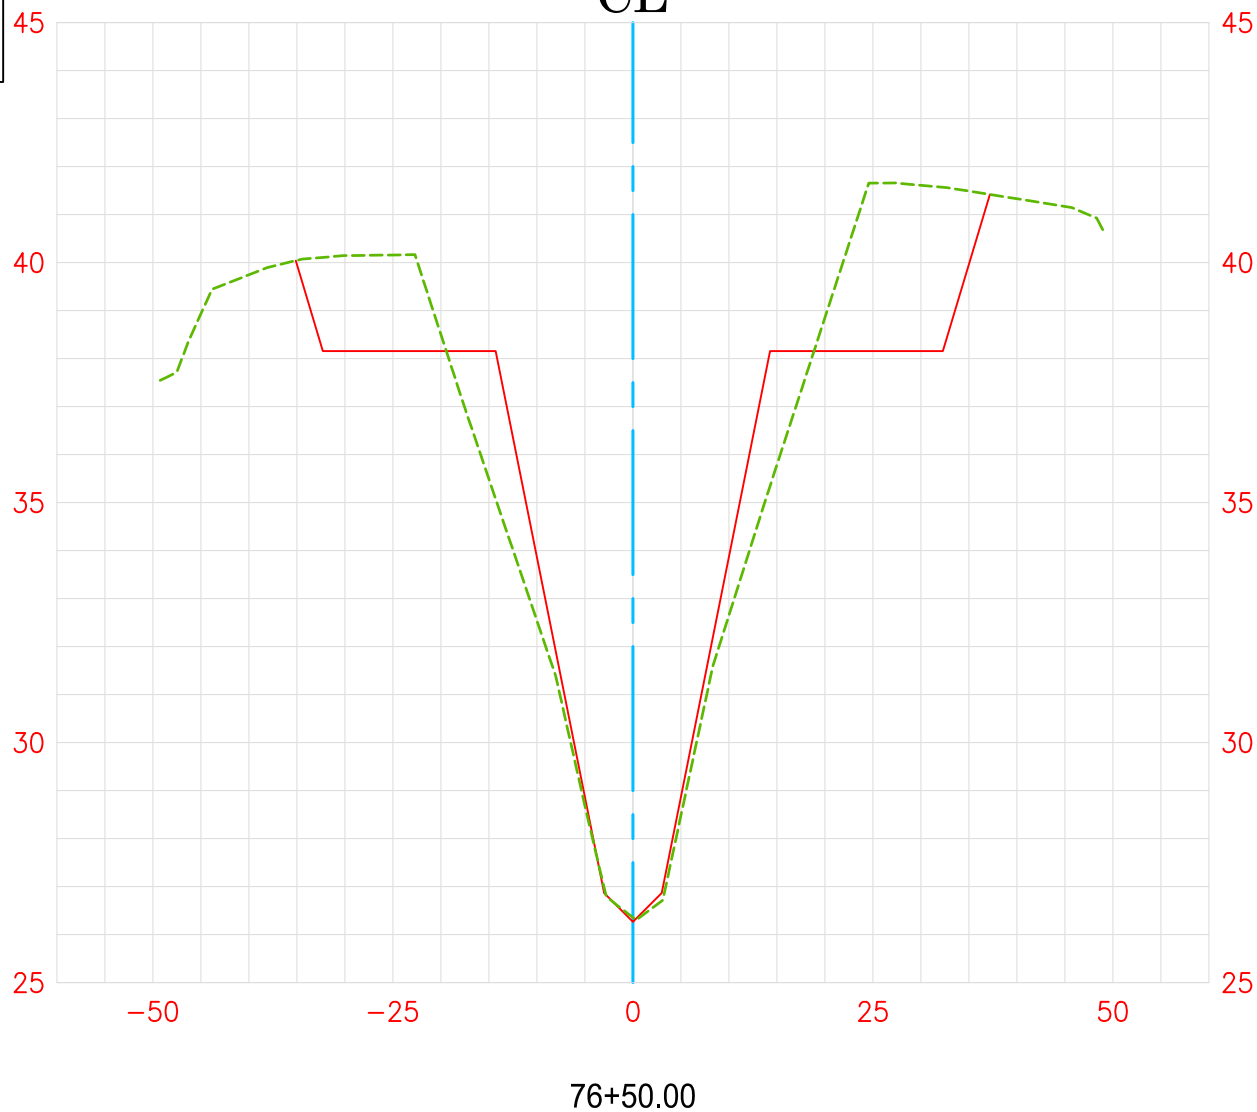

2019 Channel Survey
As-Built Plan


Vert. Scale: 1"=5'
Hor. Scale: 1"=20'



FAIRVIEW CHANNEL (D04) CL



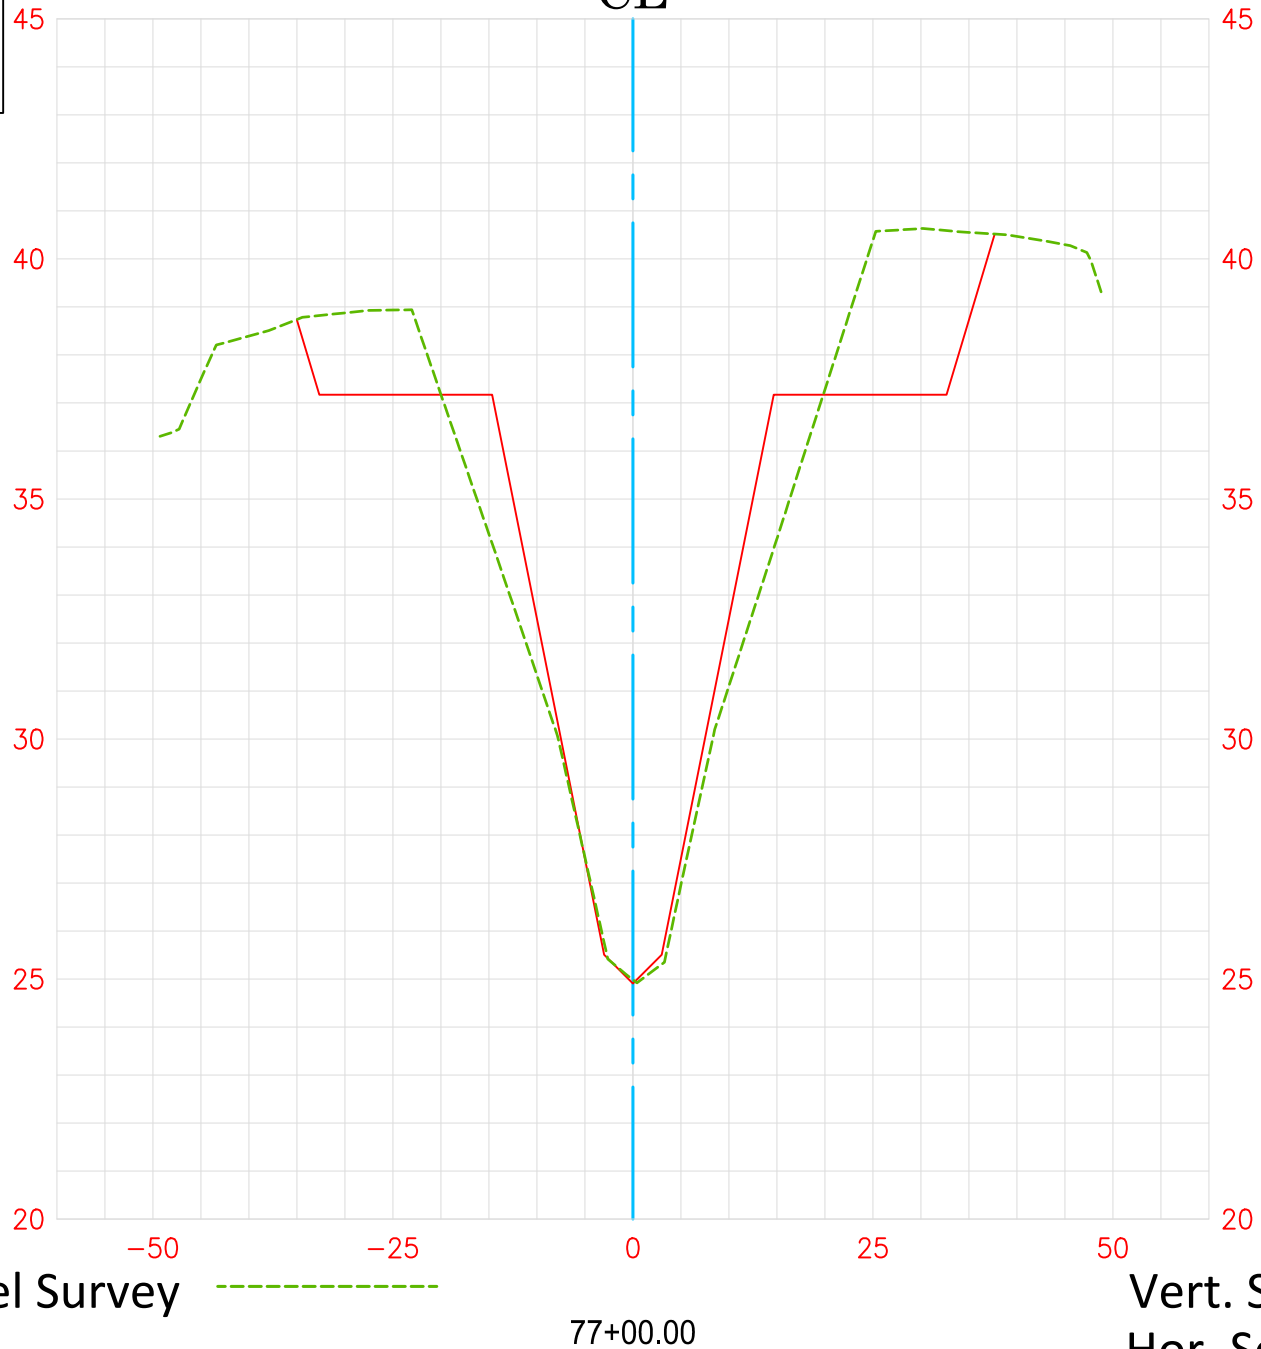

2019 Channel Survey
As-Built Plan



Vert. Scale: 1"=5'
Hor. Scale: 1"=20'


FAIRVIEW CHANNEL (D04) CL



2019 Channel Survey 
As-Built Plan 

Vert. Scale: 1"=5'
Hor. Scale: 1"=20'

FAIRVIEW CHANNEL (D04) CL

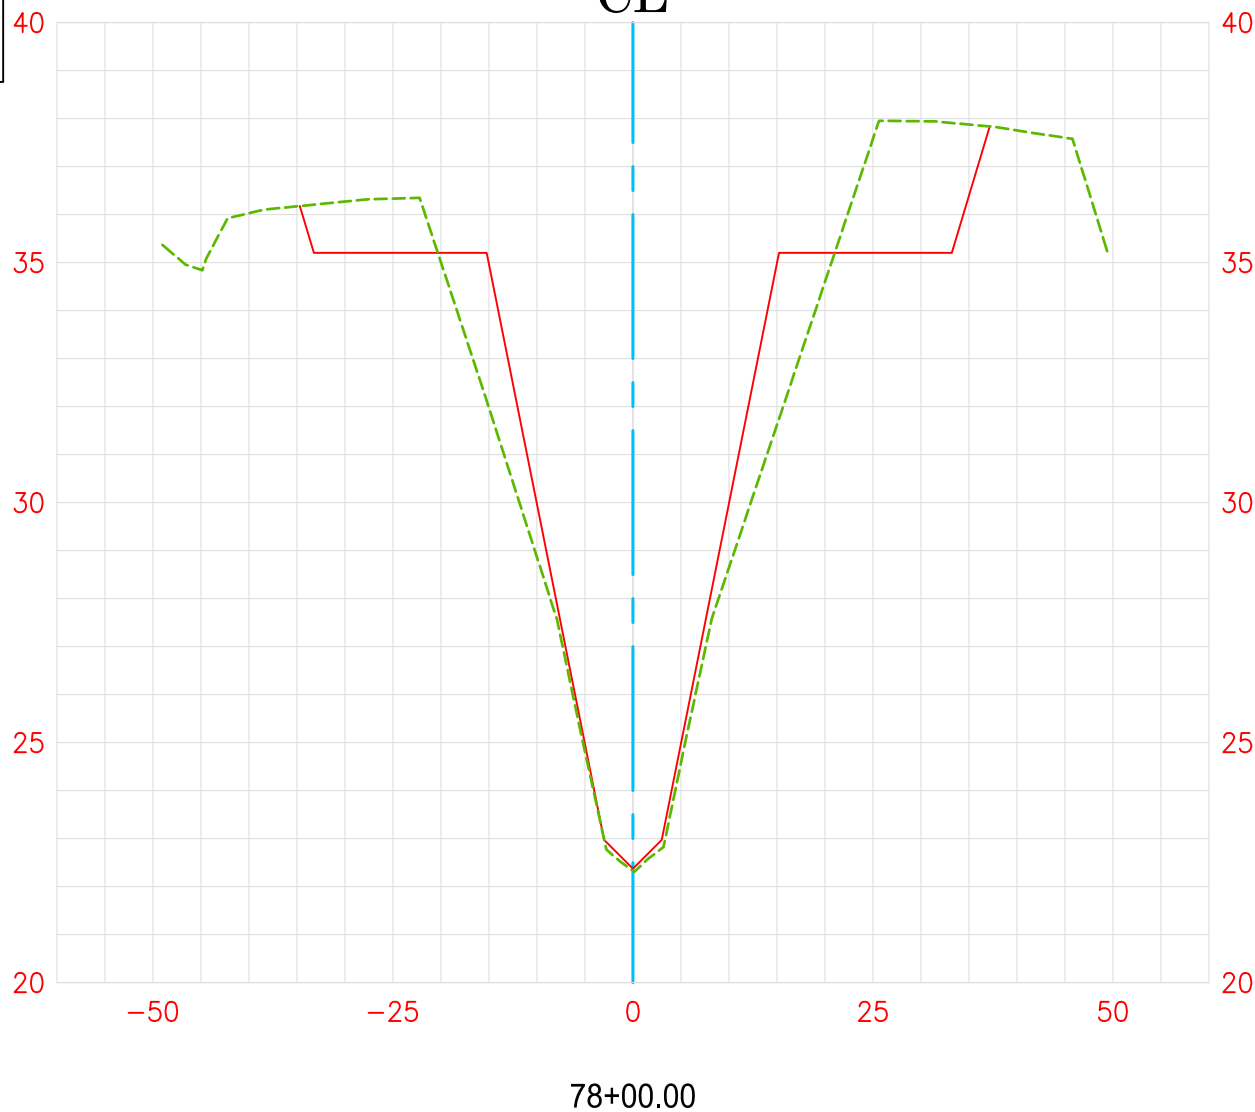



2019 Channel Survey -----
 As-Built Plan —————

Vert. Scale: 1"=5'
 Hor. Scale: 1"=20'

FAIRVIEW CHANNEL (D04) CL




2019 Channel Survey 
As-Built Plan 

Vert. Scale: 1"=5'
Hor. Scale: 1"=20'

FAIRVIEW CHANNEL (D04)

CL

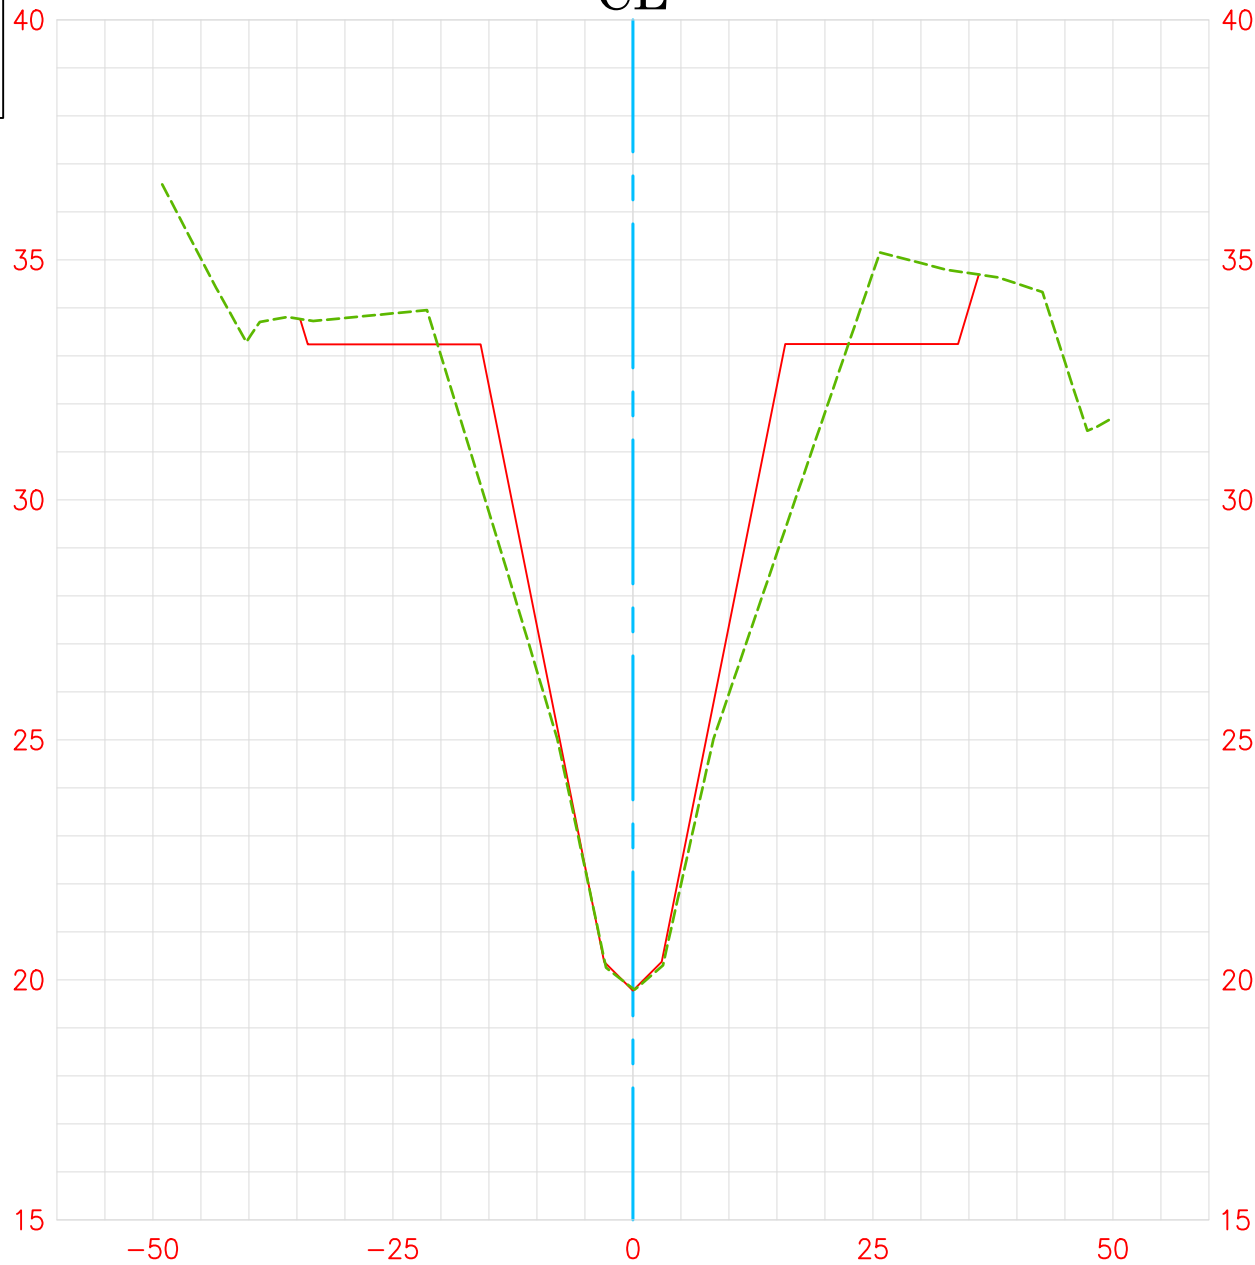


2019 Channel Survey
As-Built Plan



79+00.00

Vert. Scale: 1"=5'
Hor. Scale: 1"=20'

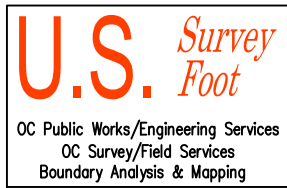


FAIRVIEW CHANNEL (D04) CL



2019 Channel Survey
As-Built Plan

Vert. Scale: 1"=5'
Hor. Scale: 1"=20'

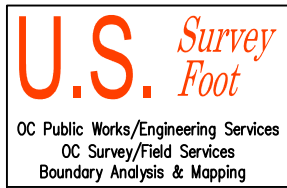


FAIRVIEW CHANNEL (D04) CL



2019 Channel Survey
As-Built Plan

Vert. Scale: 1"=5'
Hor. Scale: 1"=20'


FAIRVIEW CHANNEL (D04) CL

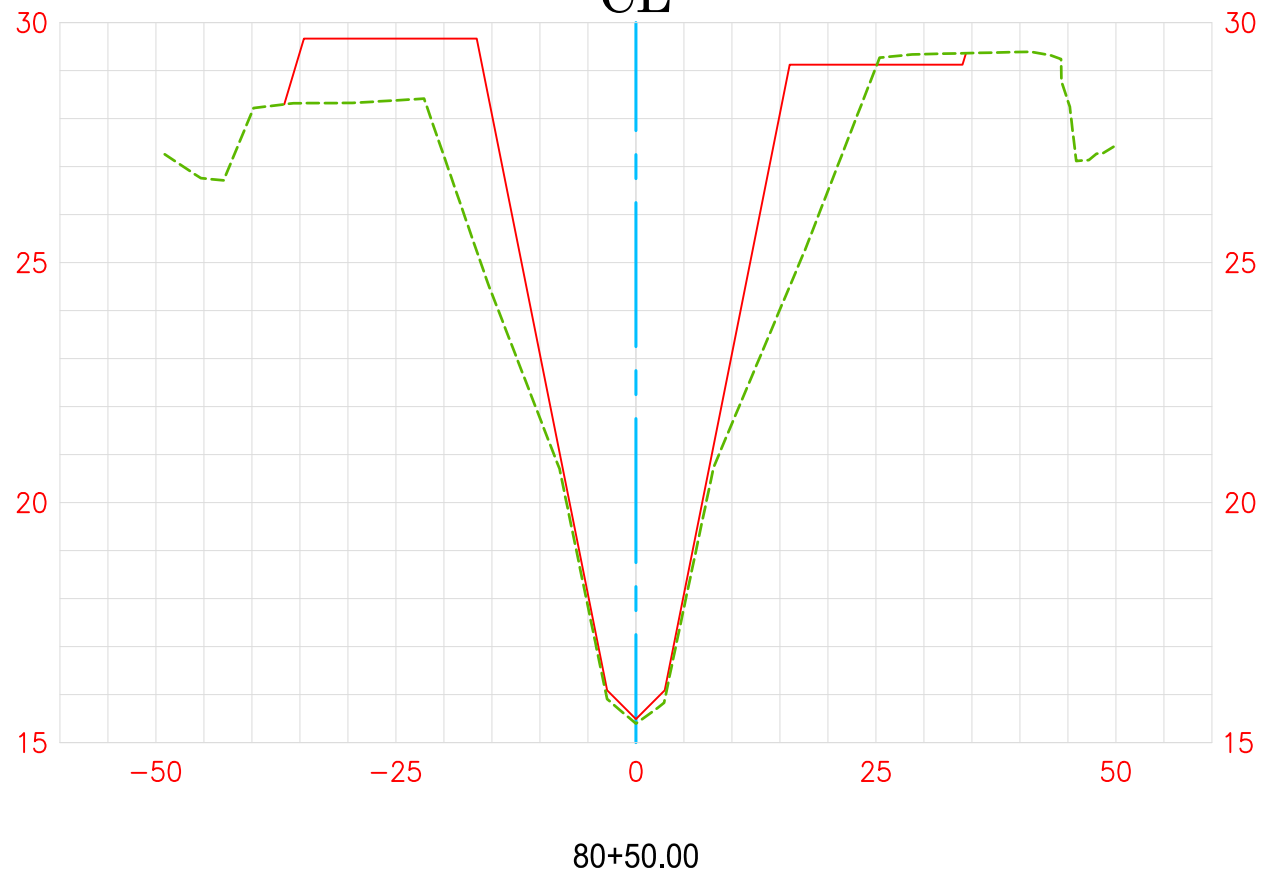

2019 Channel Survey 
As-Built Plan 

Vert. Scale: 1"=5'
Hor. Scale: 1"=20'

FAIRVIEW CHANNEL (D04) CL

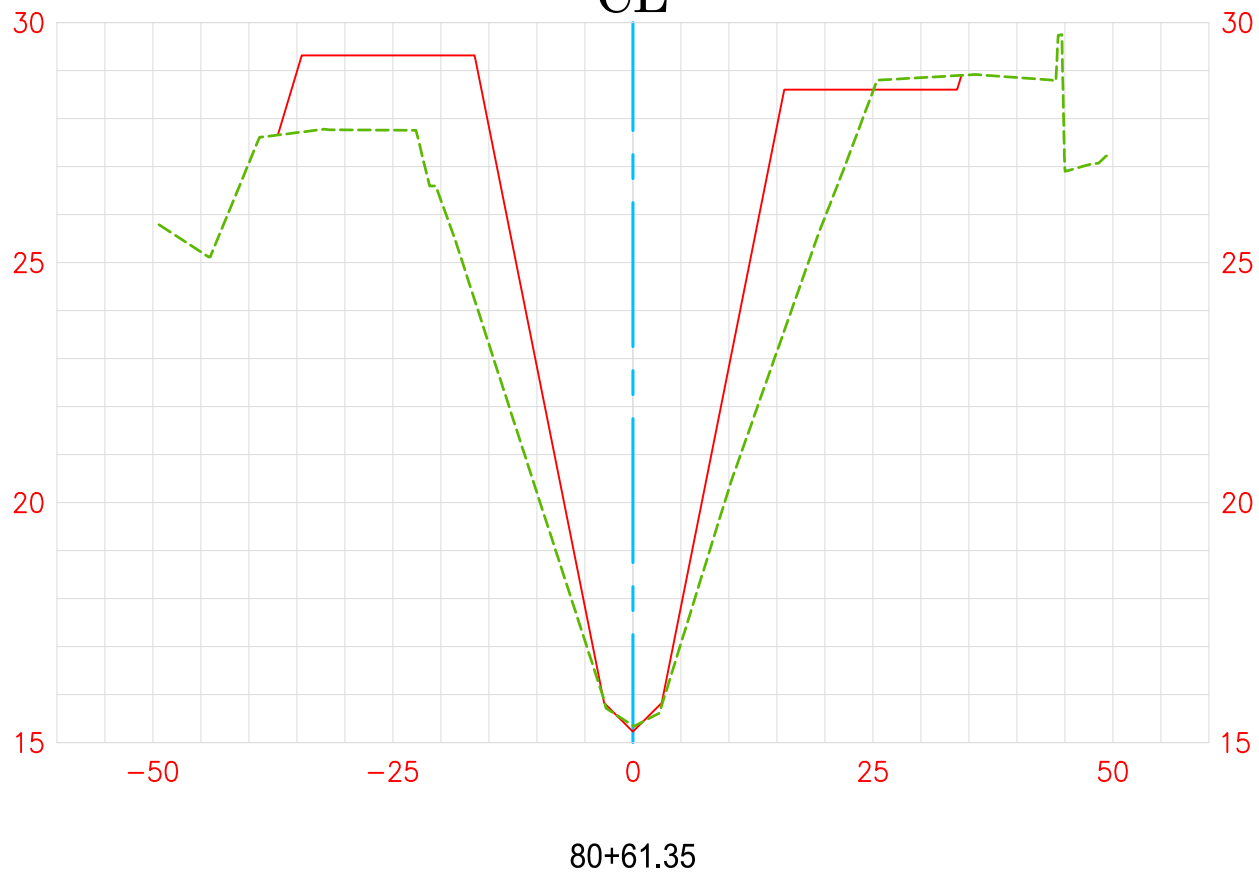


2019 Channel Survey 
As-Built Plan 

Vert. Scale: 1"=5'
Hor. Scale: 1"=20'

FAIRVIEW CHANNEL (D04)

CL

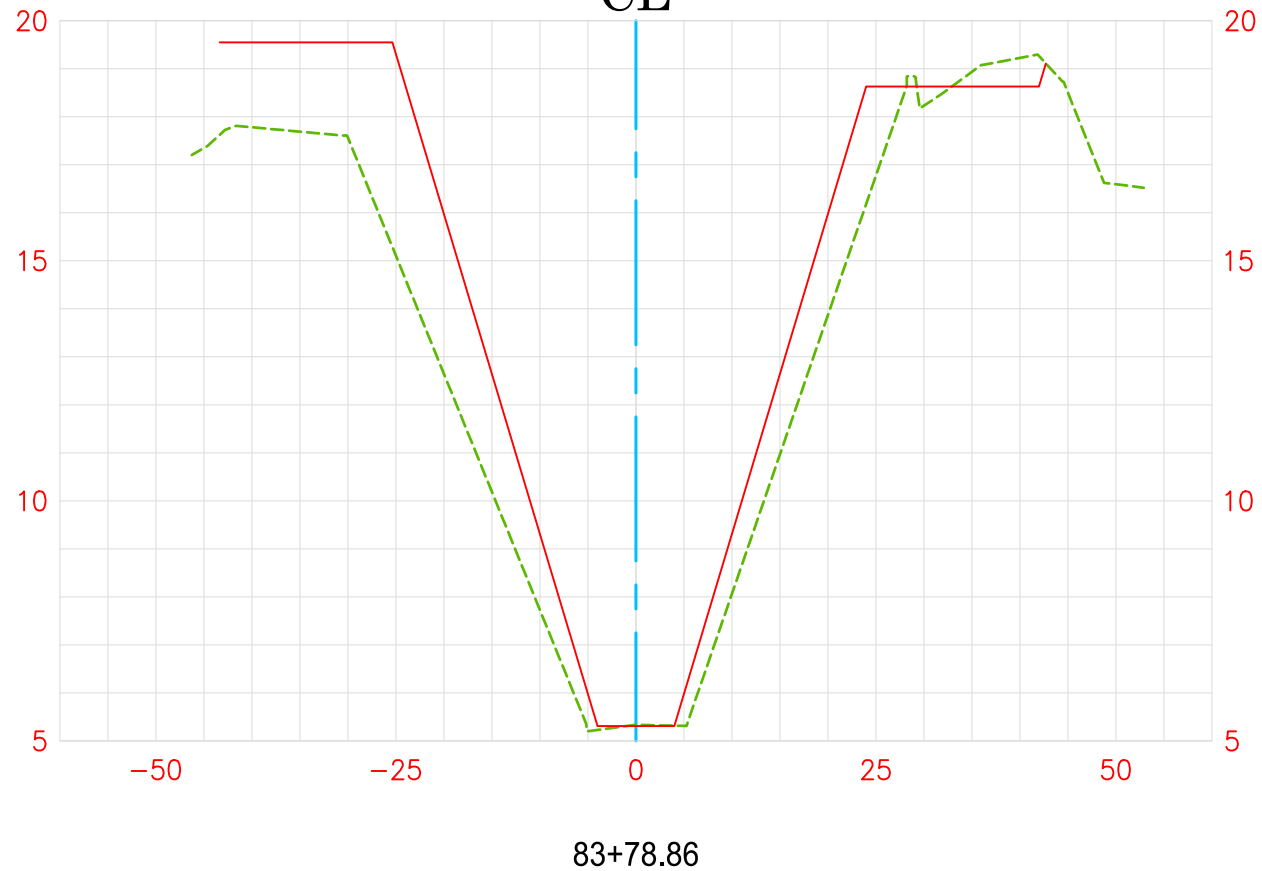


2019 Channel Survey -----
 As-Built Plan —————

Vert. Scale: 1"=5'
 Hor. Scale: 1"=20'

FAIRVIEW CHANNEL (D04)

CL

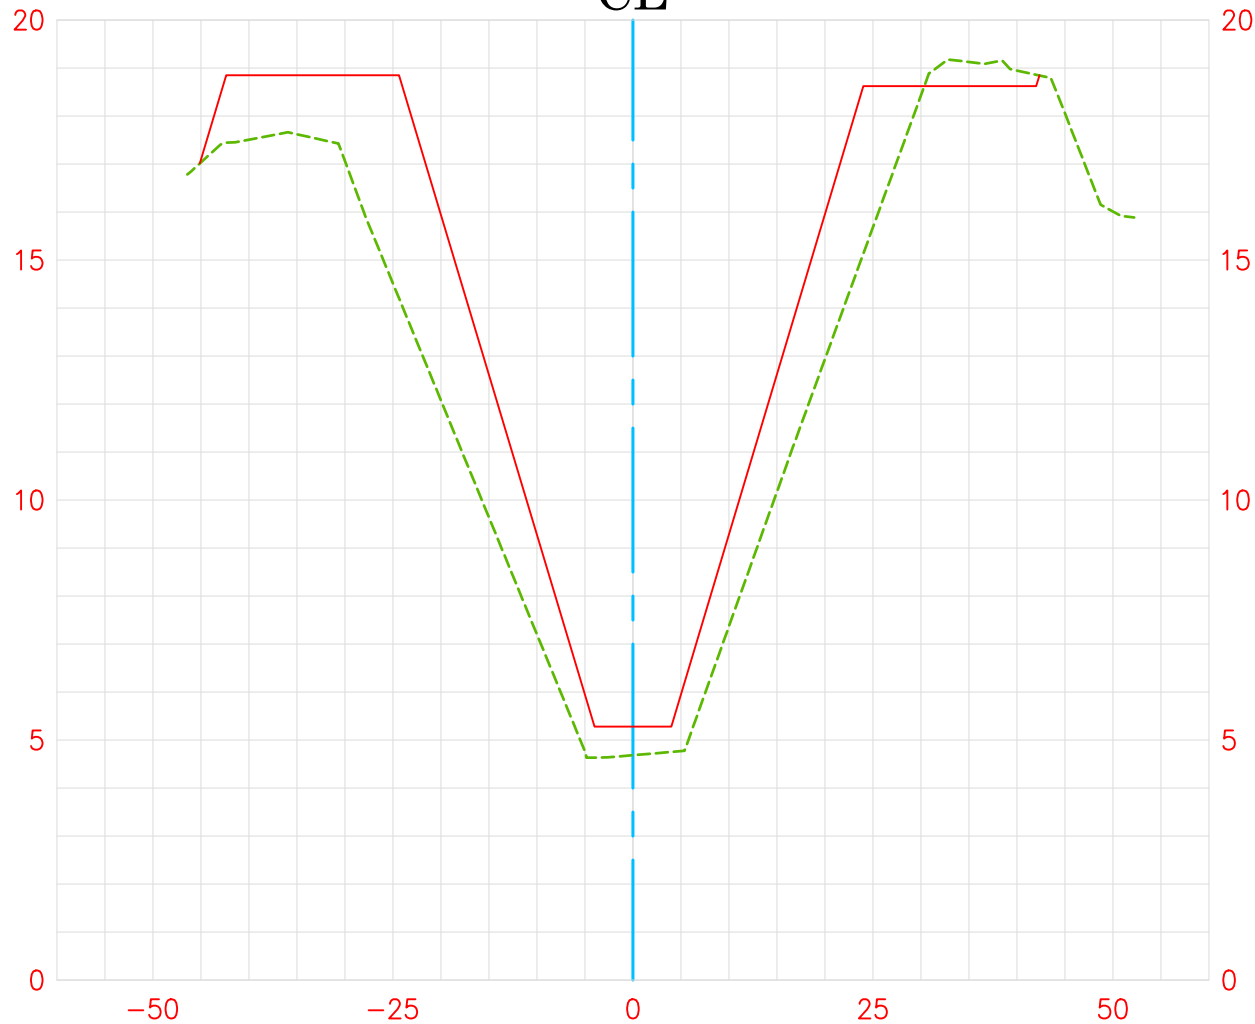

2019 Channel Survey
 As-Built Plan




84+00.00

Vert. Scale: 1"=5'
 Hor. Scale: 1"=20'

FAIRVIEW CHANNEL (D04)

CL

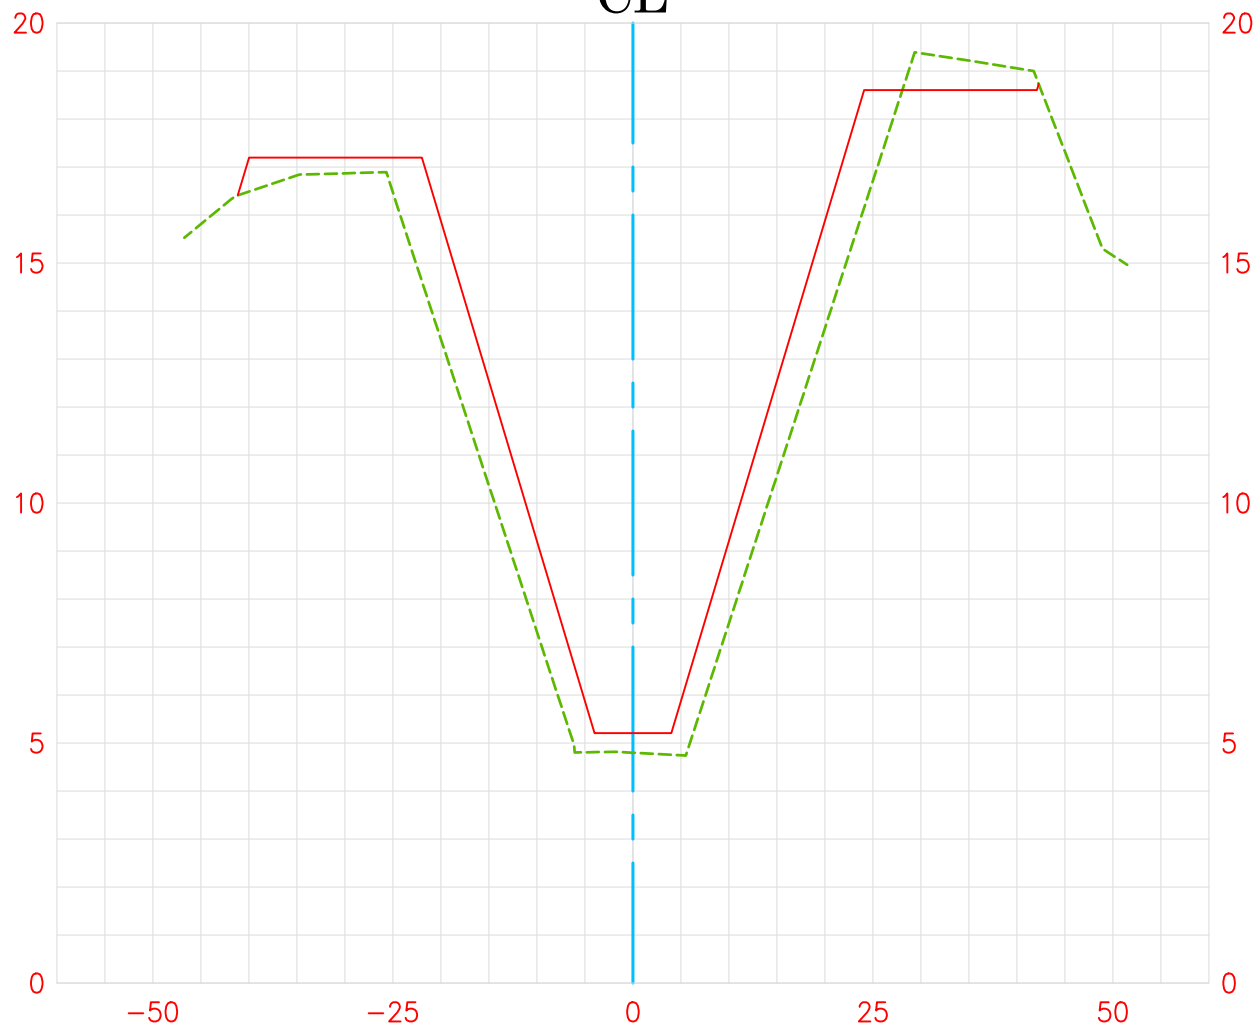

2019 Channel Survey
 As-Built Plan




84+50.00

Vert. Scale: 1"=5'
 Hor. Scale: 1"=20'

FAIRVIEW CHANNEL (D04)

CL

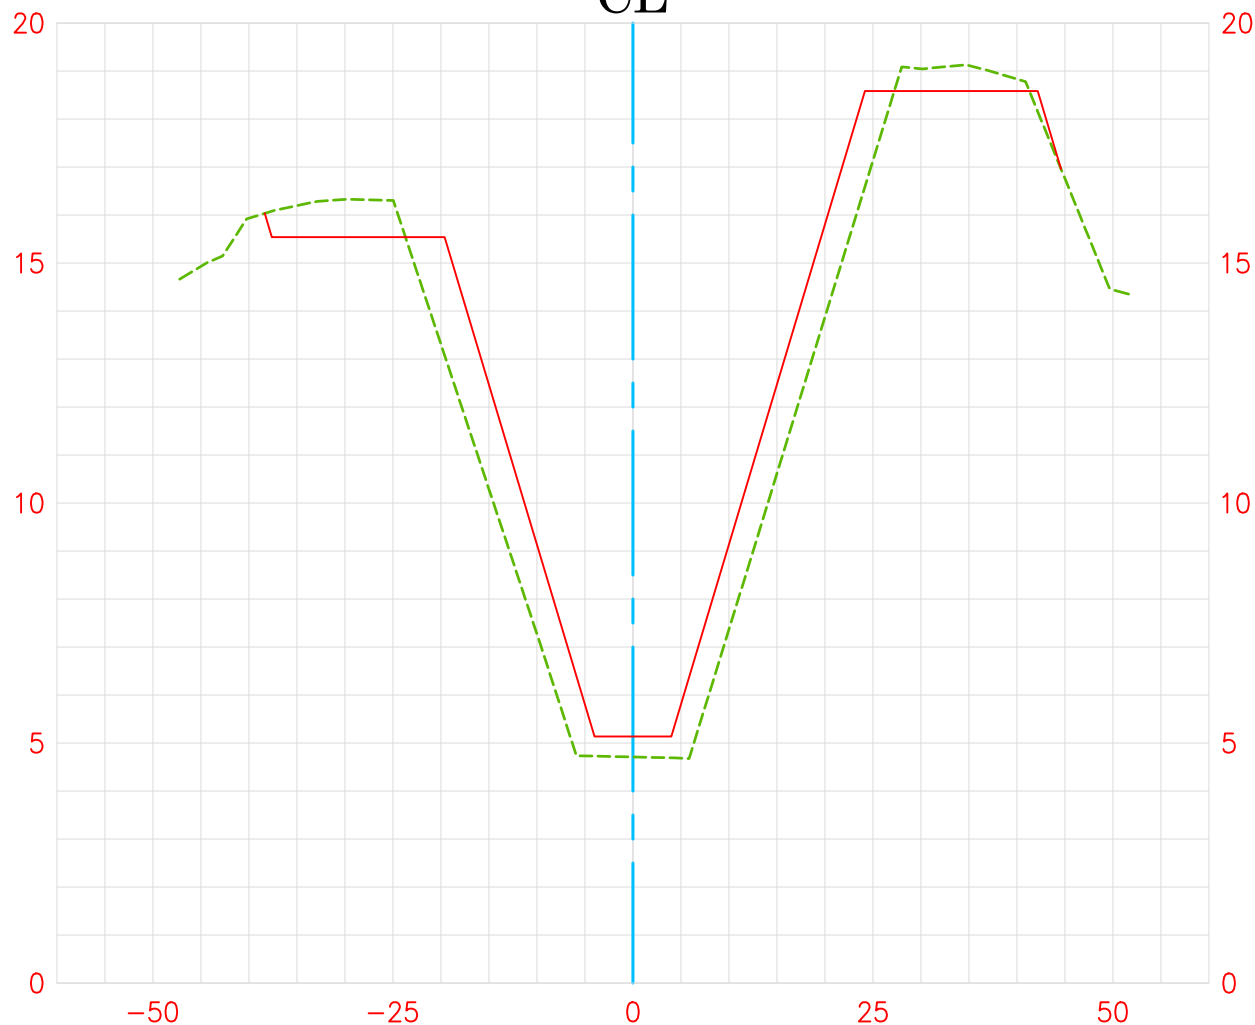

2019 Channel Survey
As-Built Plan




85+00.00

Vert. Scale: 1"=5'
Hor. Scale: 1"=20'

FAIRVIEW CHANNEL (D04)

CL

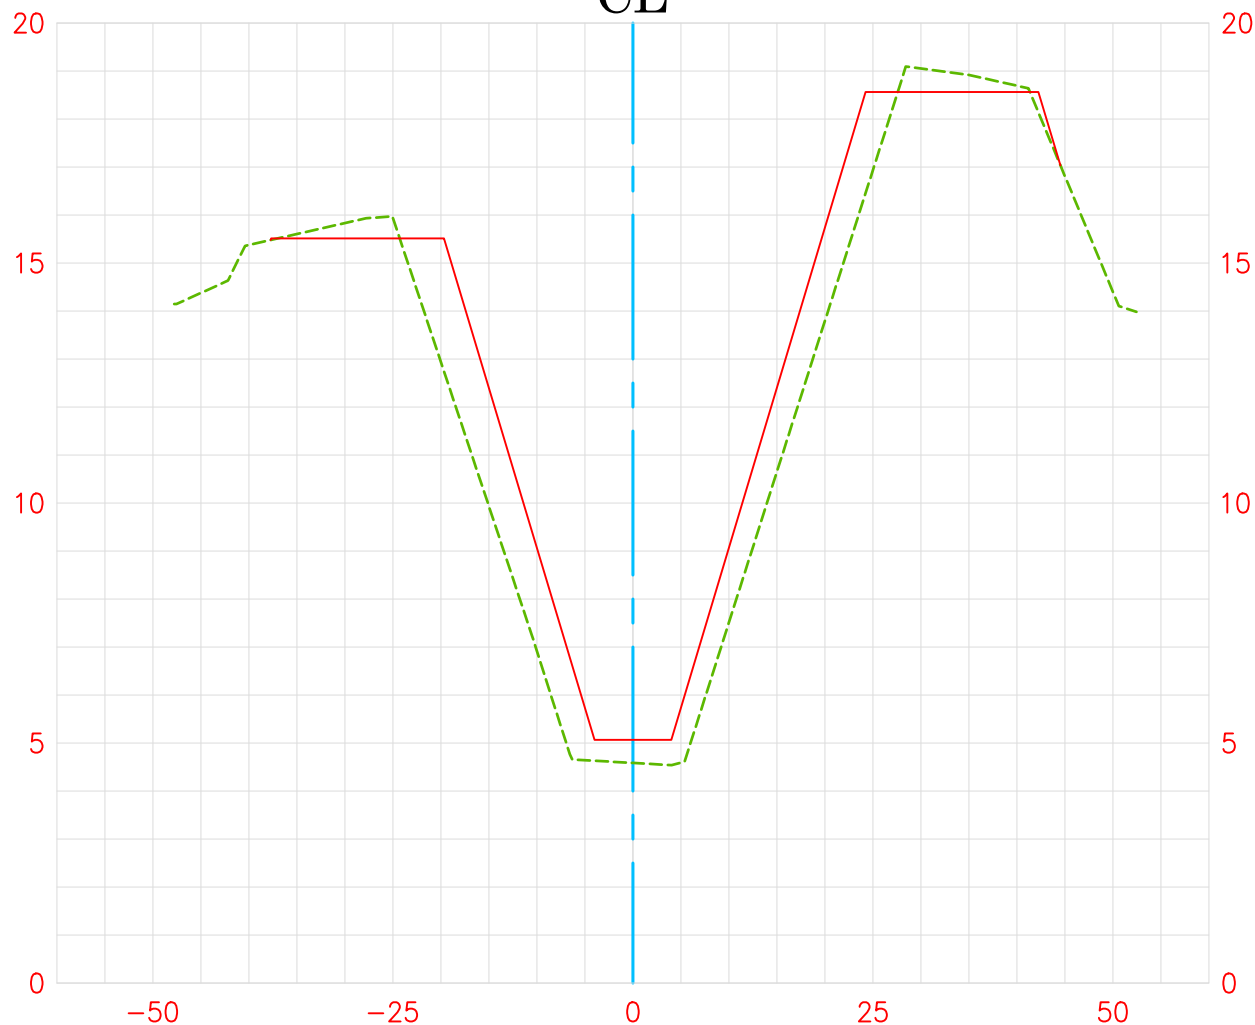

2019 Channel Survey
As-Built Plan




85+50.00

Vert. Scale: 1"=5'
Hor. Scale: 1"=20'

FAIRVIEW CHANNEL (D04)

CL

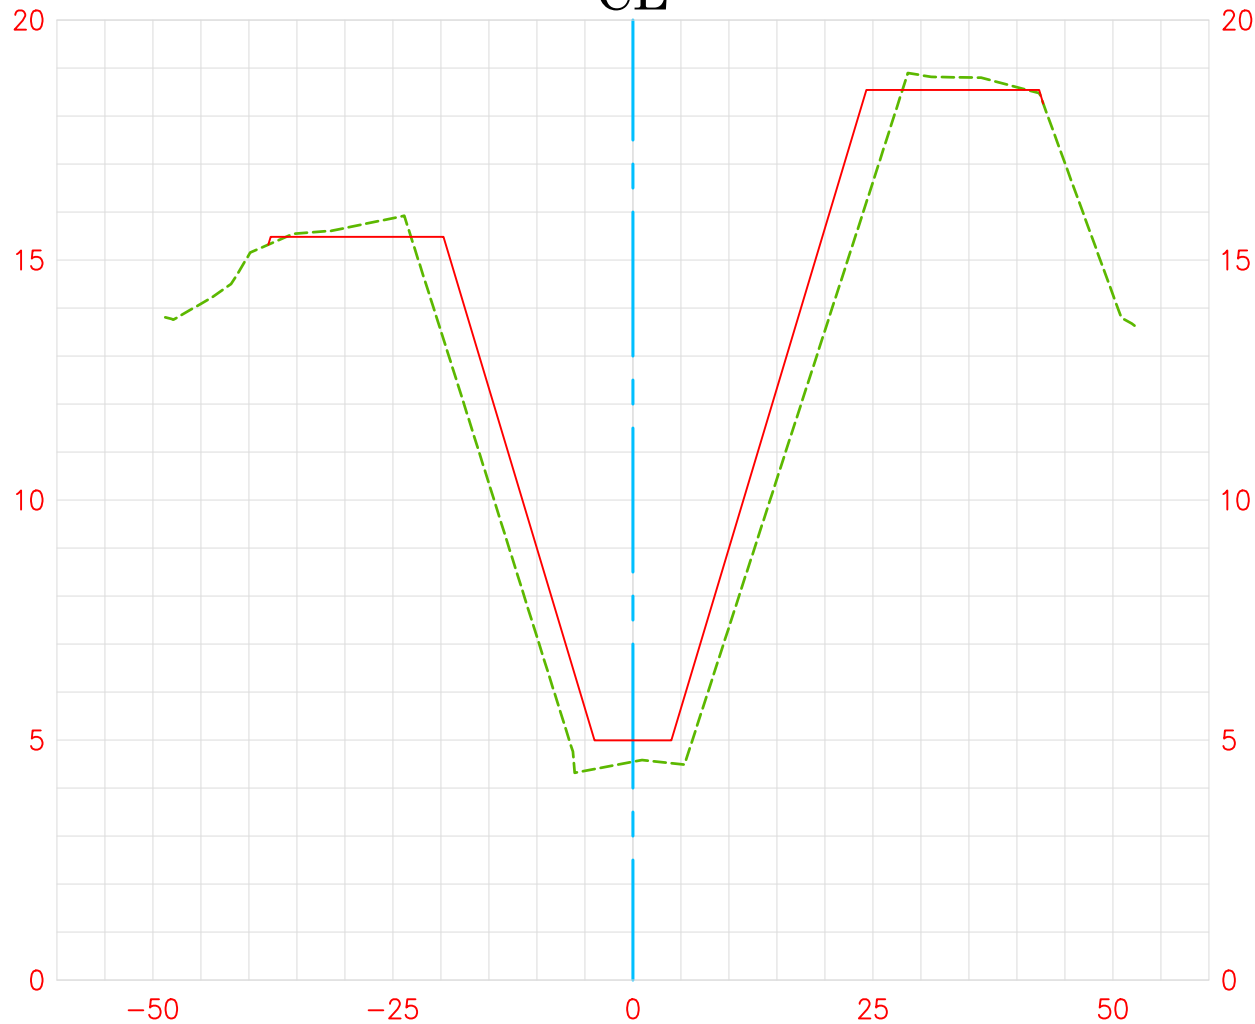

2019 Channel Survey
As-Built Plan




86+00.00

Vert. Scale: 1"=5'
Hor. Scale: 1"=20'

FAIRVIEW CHANNEL (D04)

CL

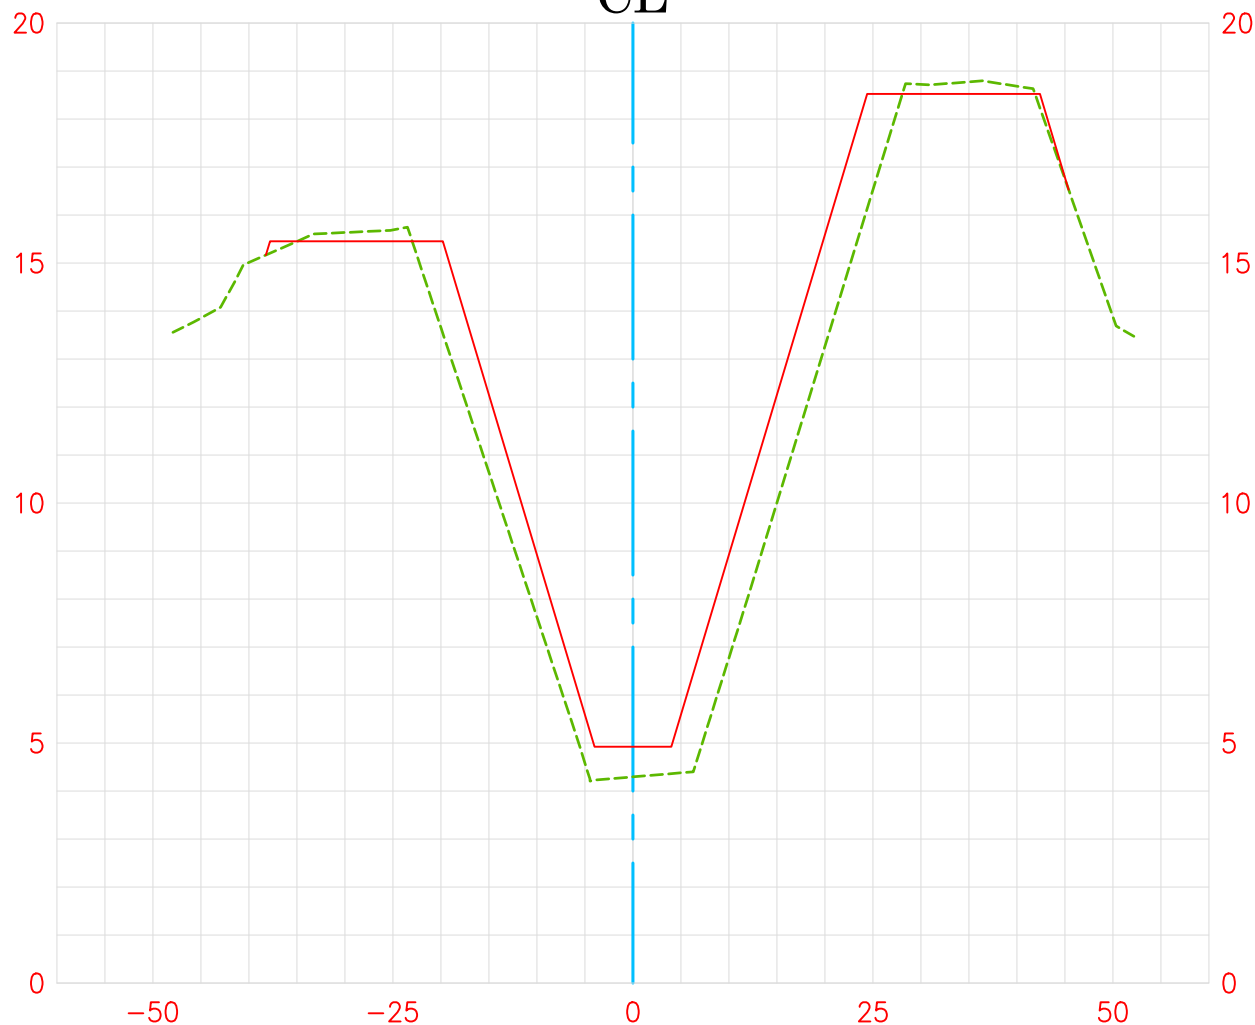

2019 Channel Survey
As-Built Plan




86+50.00

Vert. Scale: 1"=5'
Hor. Scale: 1"=20'

FAIRVIEW CHANNEL (D04)

CL

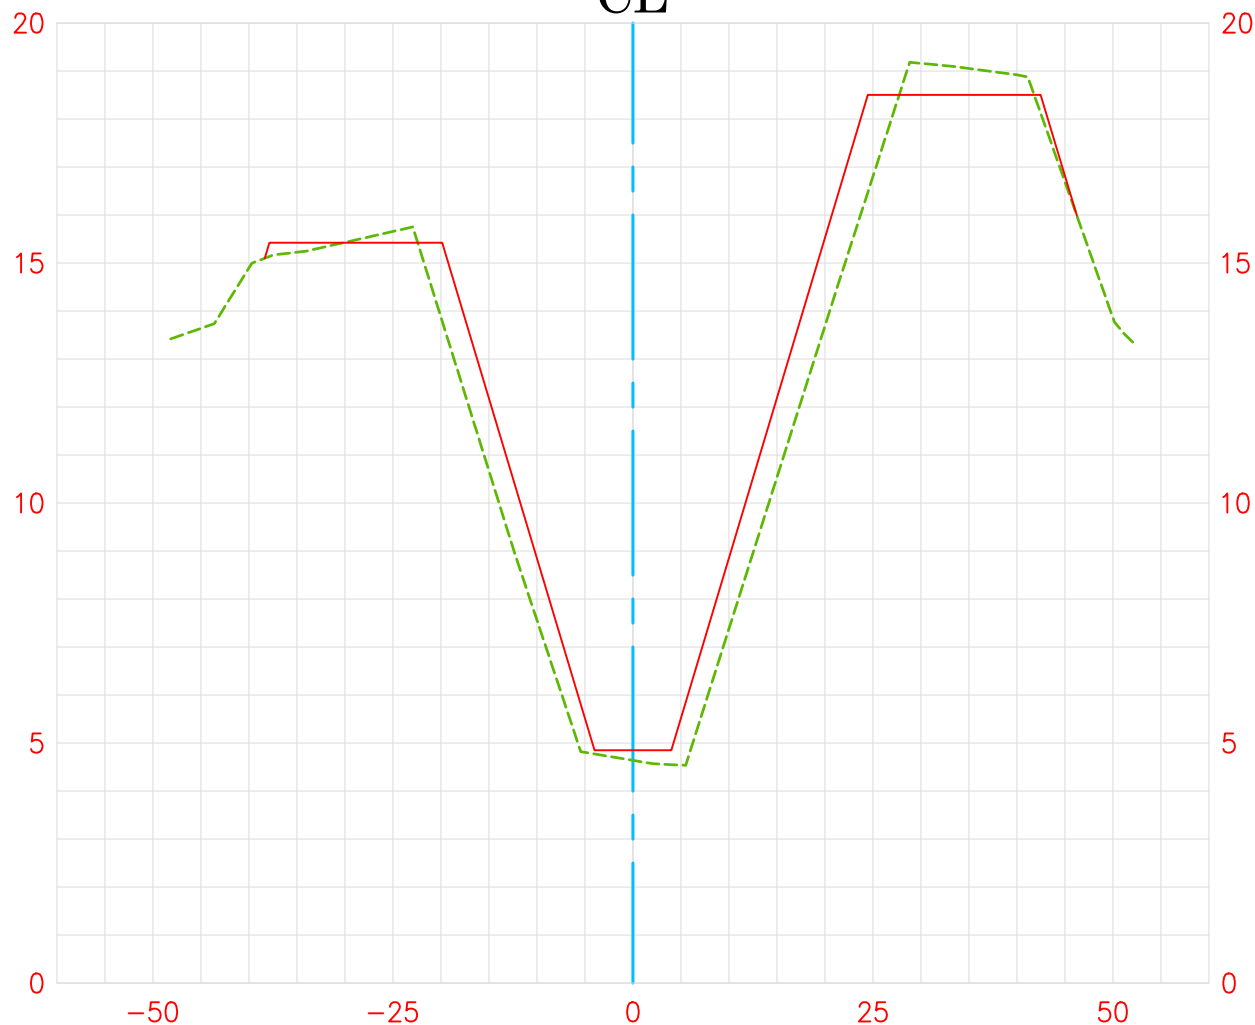

2019 Channel Survey
As-Built Plan



87+00.00

Vert. Scale: 1"=5'
Hor. Scale: 1"=20'

FAIRVIEW CHANNEL (D04)

CL



2019 Channel Survey
As-Built Plan




87+50.00

Vert. Scale: 1"=5'
Hor. Scale: 1"=20'

FAIRVIEW CHANNEL (D04)

CL

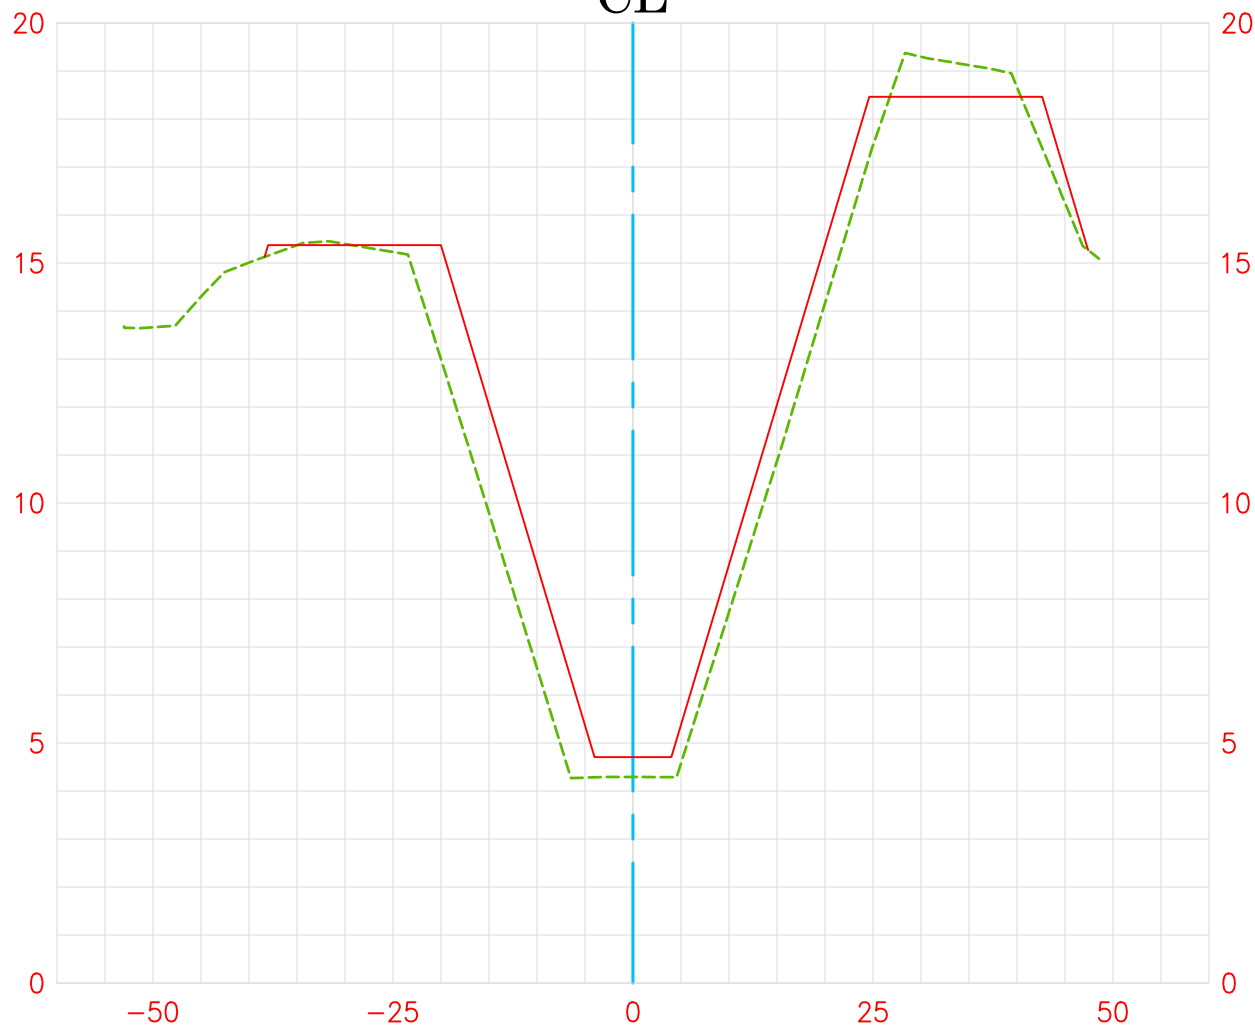

2019 Channel Survey
As-Built Plan




88+00.00

Vert. Scale: 1"=5'
Hor. Scale: 1"=20'

FAIRVIEW CHANNEL (D04)

CL

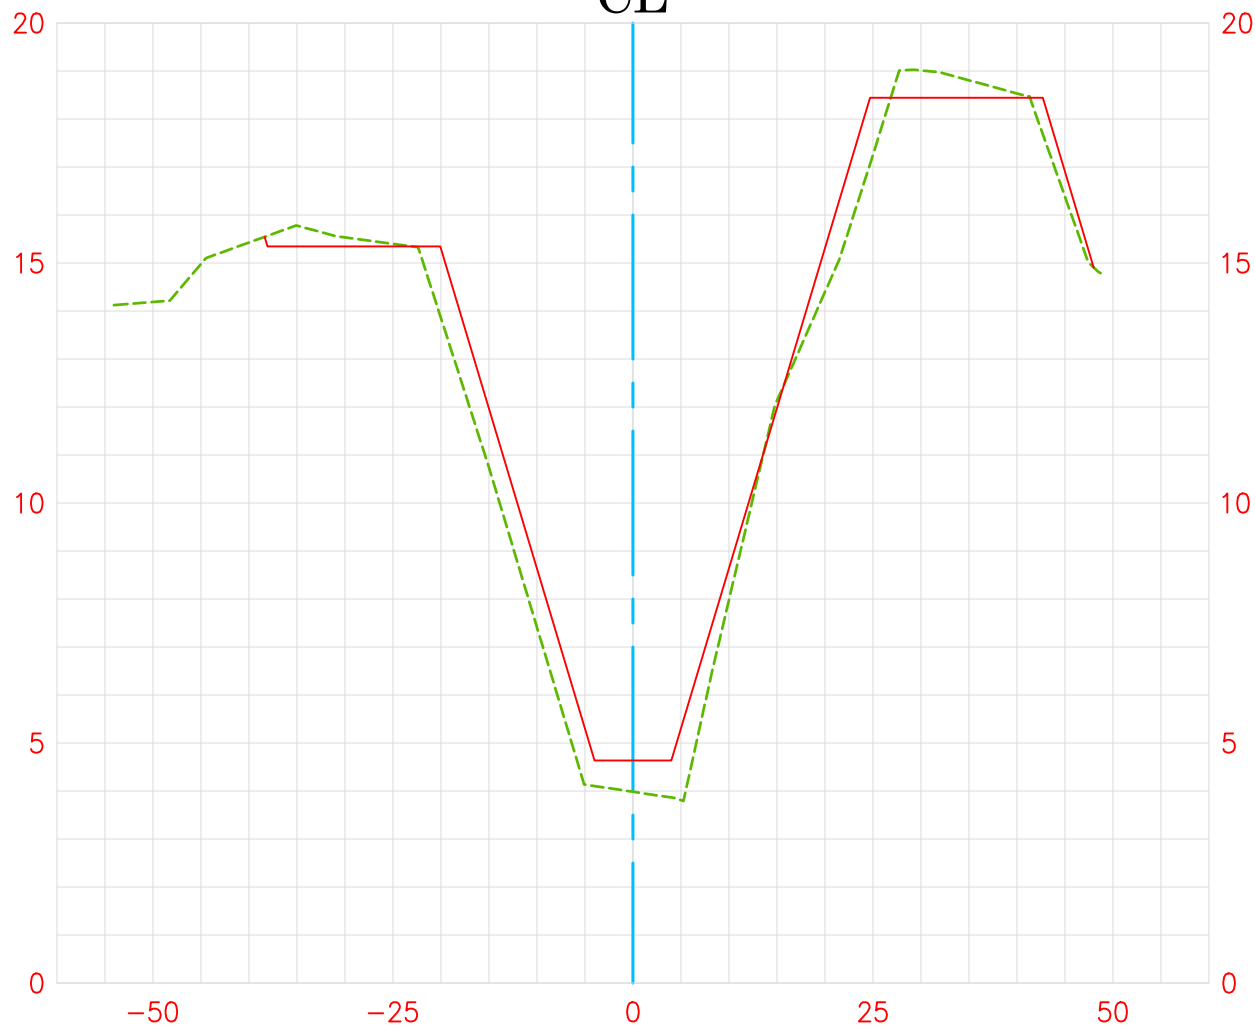

2019 Channel Survey
As-Built Plan




88+50.00

Vert. Scale: 1"=5'
Hor. Scale: 1"=20'

FAIRVIEW CHANNEL (D04)

CL

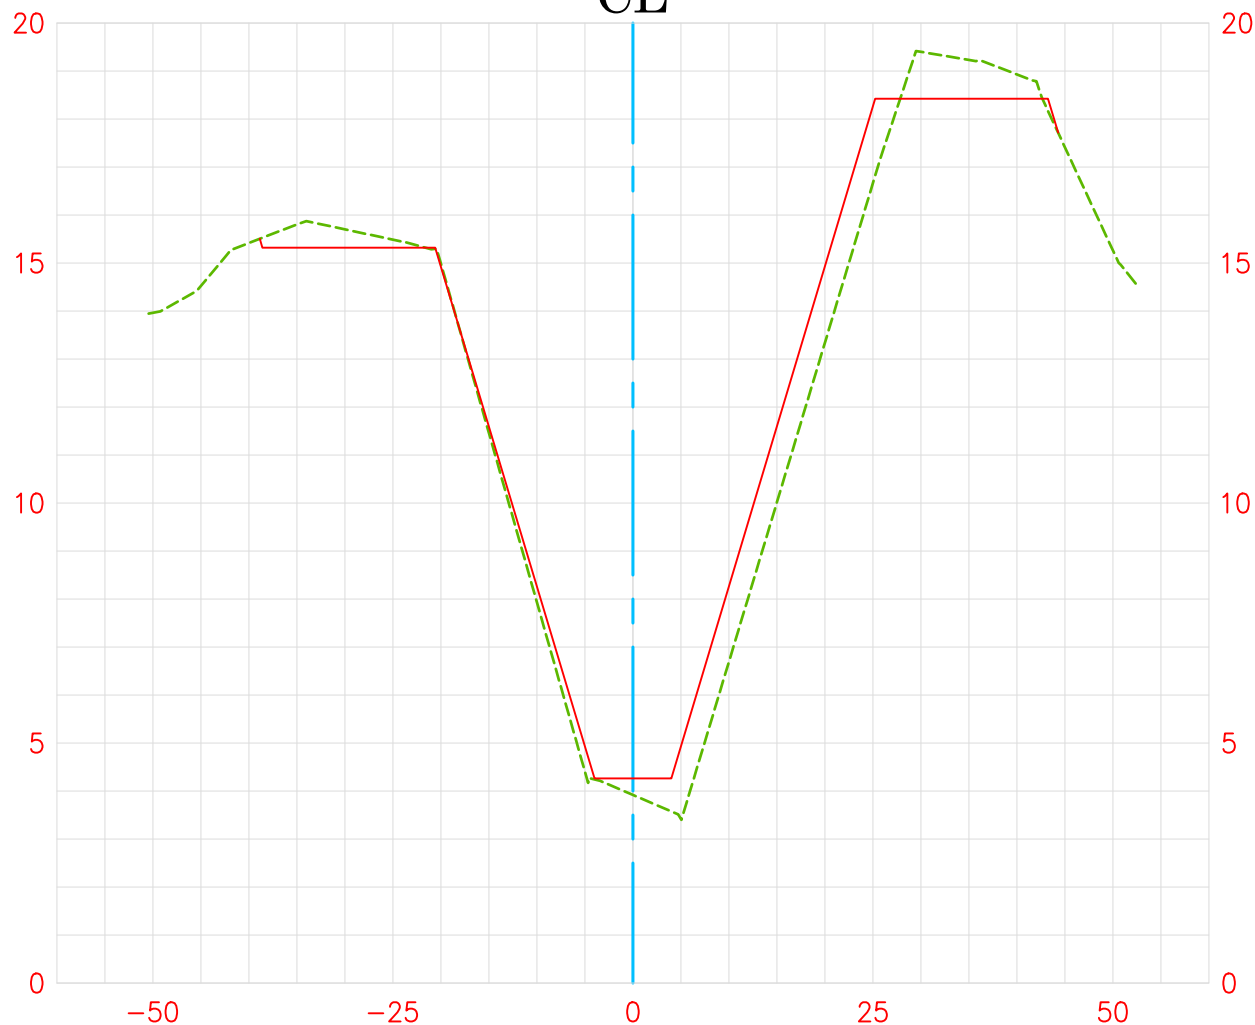

2019 Channel Survey
As-Built Plan




89+00.00

Vert. Scale: 1"=5'
Hor. Scale: 1"=20'

FAIRVIEW CHANNEL (D04)

CL

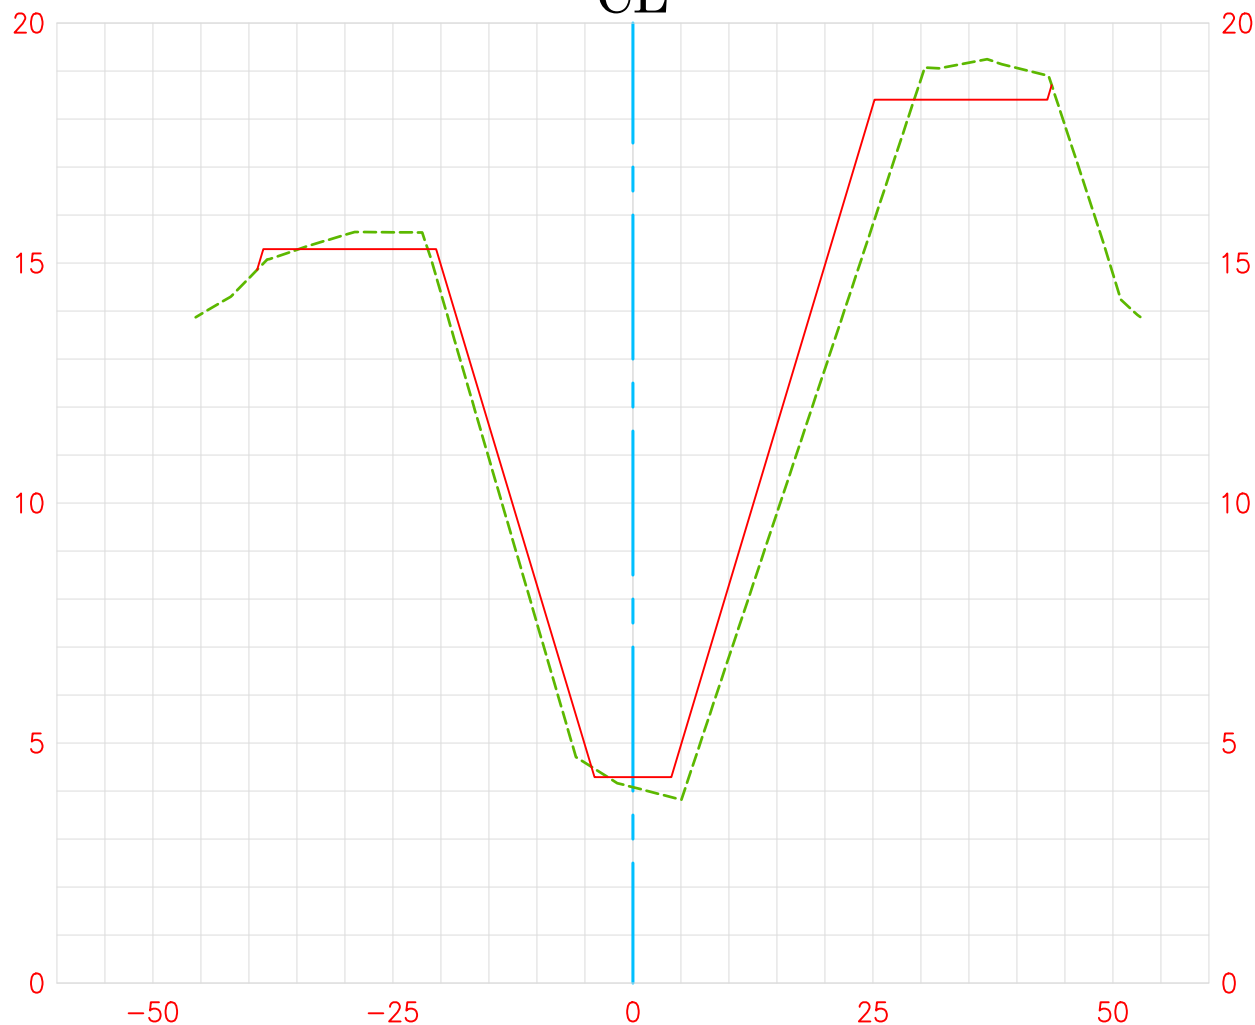

2019 Channel Survey
As-Built Plan



89+50.00

Vert. Scale: 1"=5'
Hor. Scale: 1"=20'

FAIRVIEW CHANNEL (D04)

CL



2019 Channel Survey
As-Built Plan



90+00.00

Vert. Scale: 1"=5'
Hor. Scale: 1"=20'

FAIRVIEW CHANNEL (D04)

CL



2019 Channel Survey
As-Built Plan




90+50.00

Vert. Scale: 1"=5'
Hor. Scale: 1"=20'

FAIRVIEW CHANNEL (D04)

CL

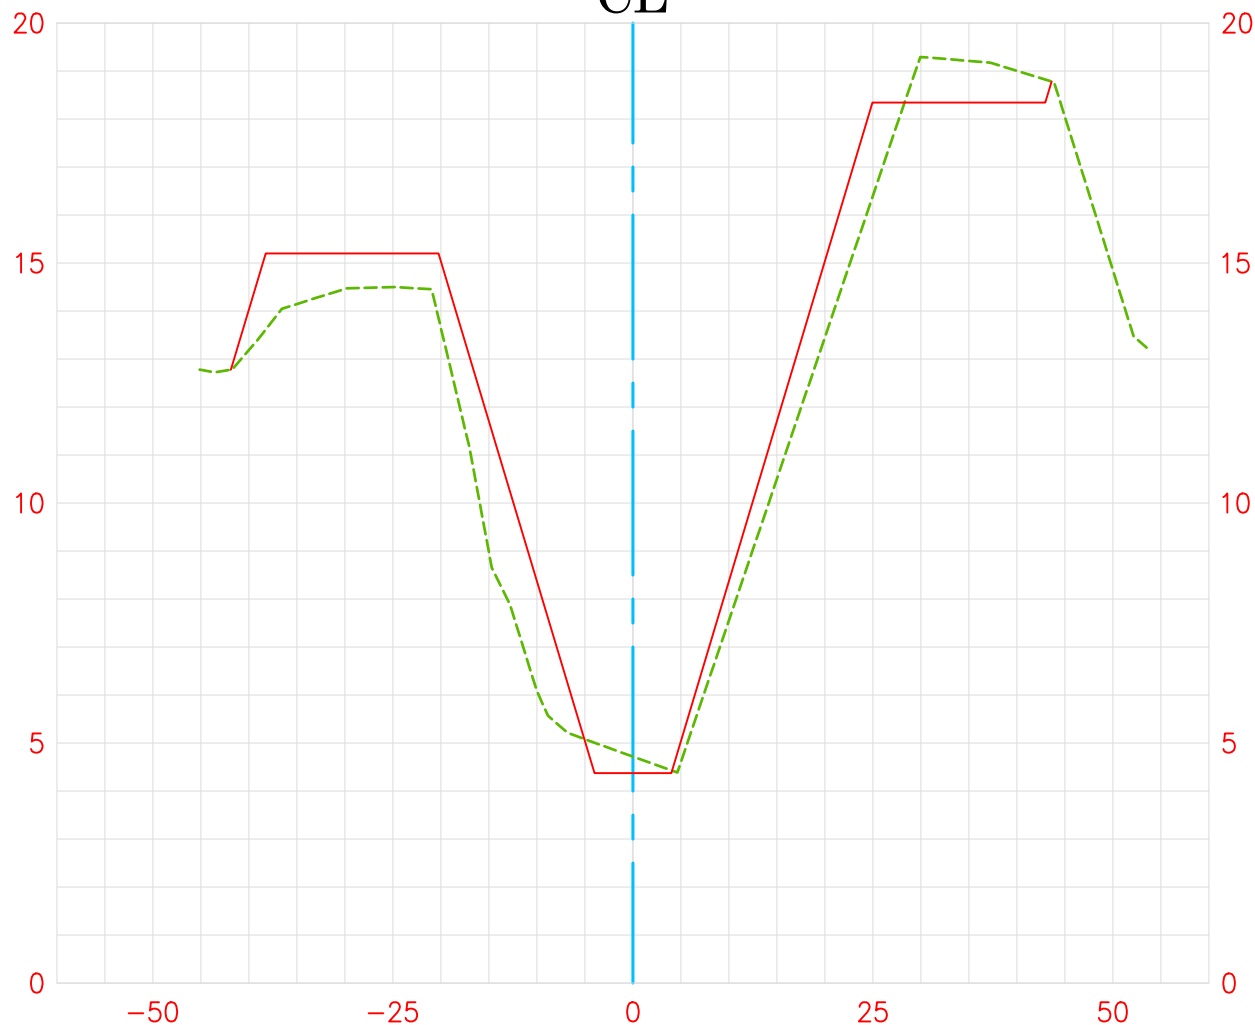

2019 Channel Survey
As-Built Plan




91+00.00

Vert. Scale: 1"=5'
Hor. Scale: 1"=20'

FAIRVIEW CHANNEL (D04)

CL

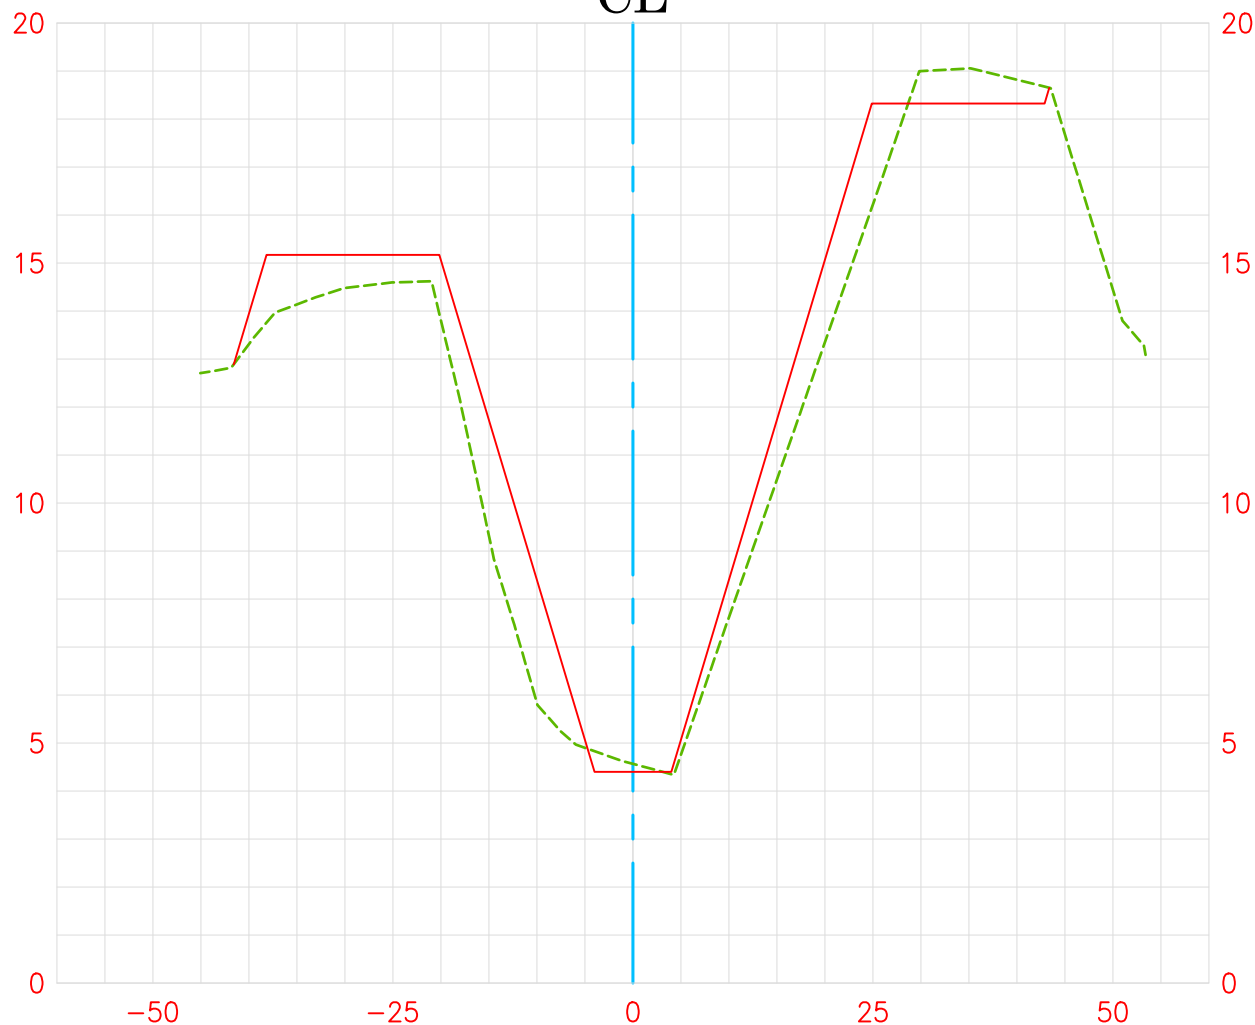

2019 Channel Survey
 As-Built Plan




91+50.00

Vert. Scale: 1"=5'
 Hor. Scale: 1"=20'

FAIRVIEW CHANNEL (D04)

CL

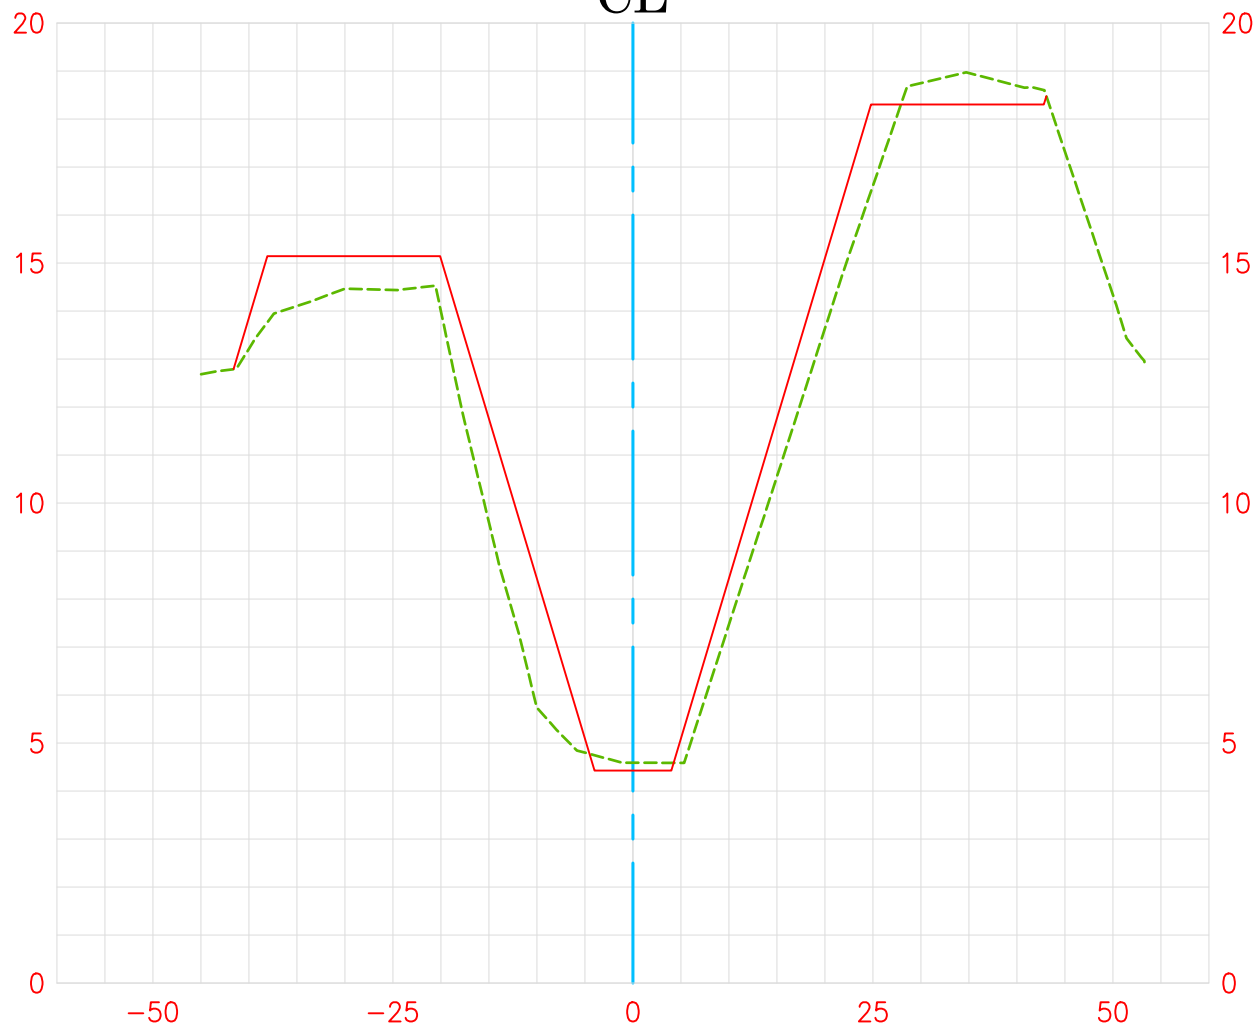

2019 Channel Survey
As-Built Plan




92+00.00

Vert. Scale: 1"=5'
Hor. Scale: 1"=20'

FAIRVIEW CHANNEL (D04)

CL

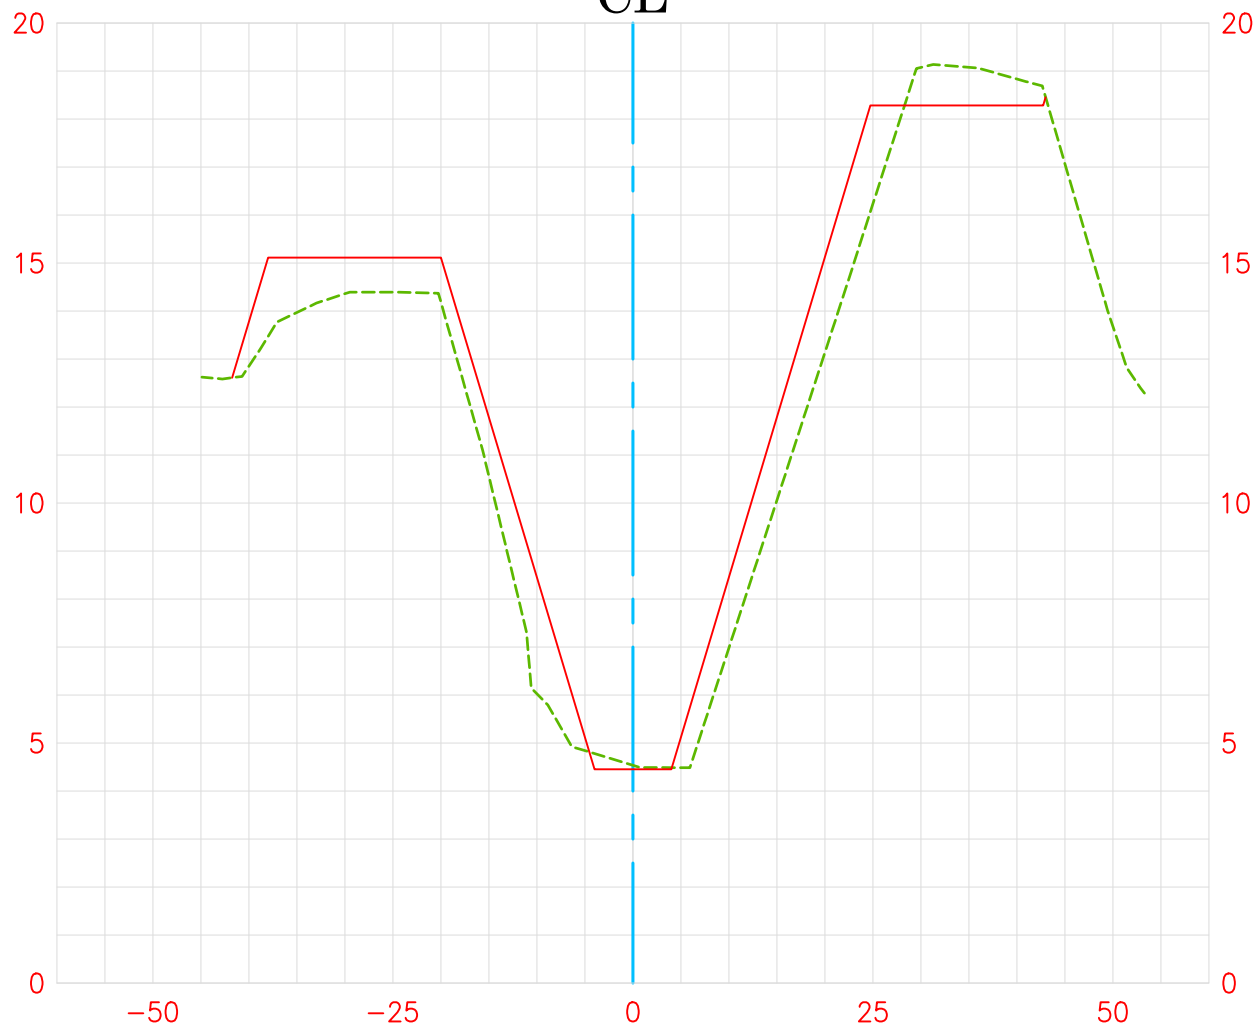

2019 Channel Survey
As-Built Plan




92+50.00

Vert. Scale: 1"=5'
Hor. Scale: 1"=20'

FAIRVIEW CHANNEL (D04)

CL

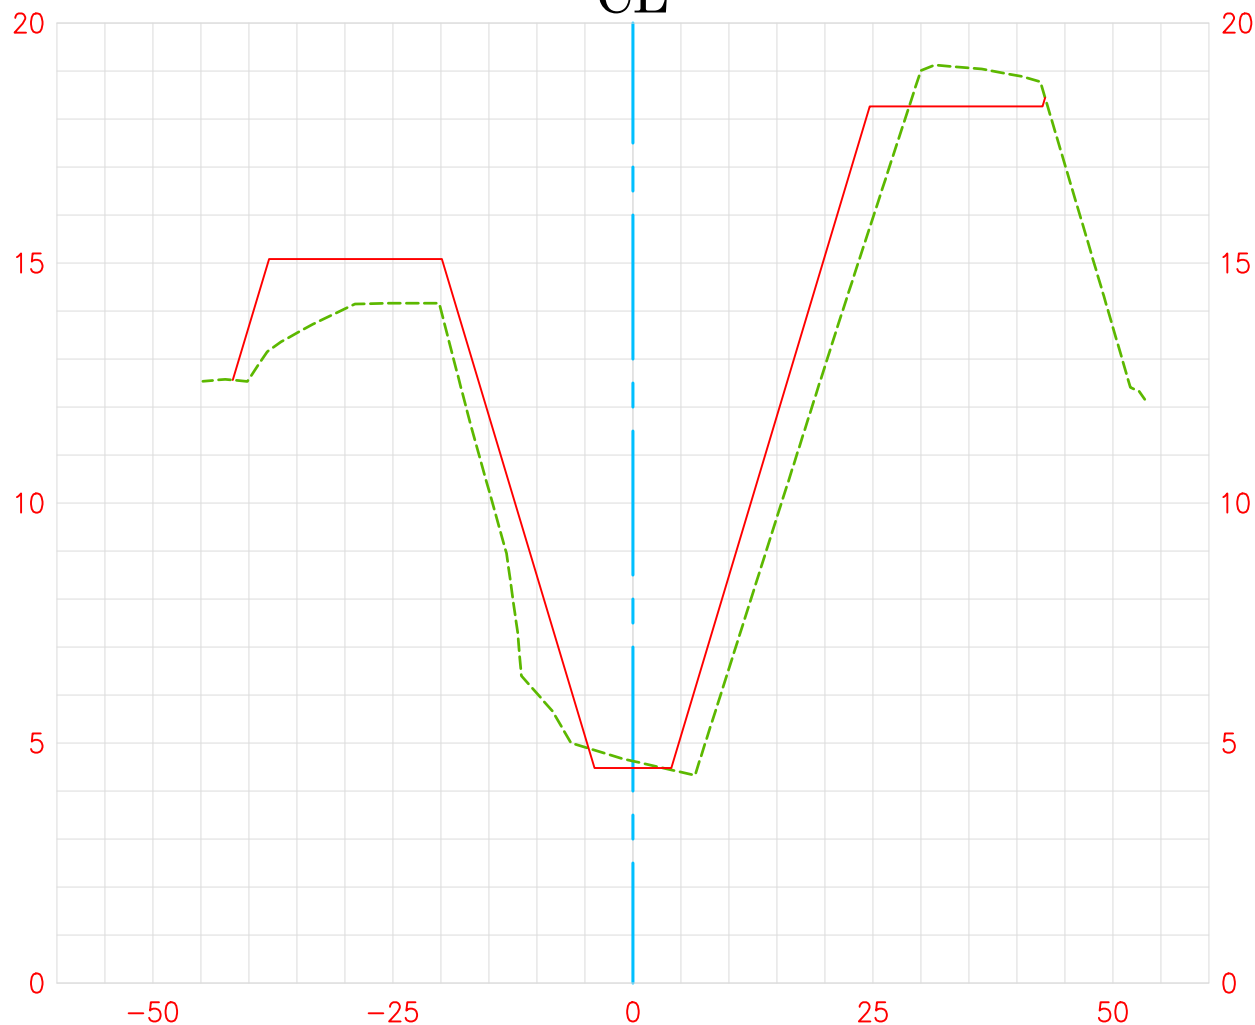

2019 Channel Survey
 As-Built Plan




93+00.00

Vert. Scale: 1"=5'
 Hor. Scale: 1"=20'

FAIRVIEW CHANNEL (D04)

CL

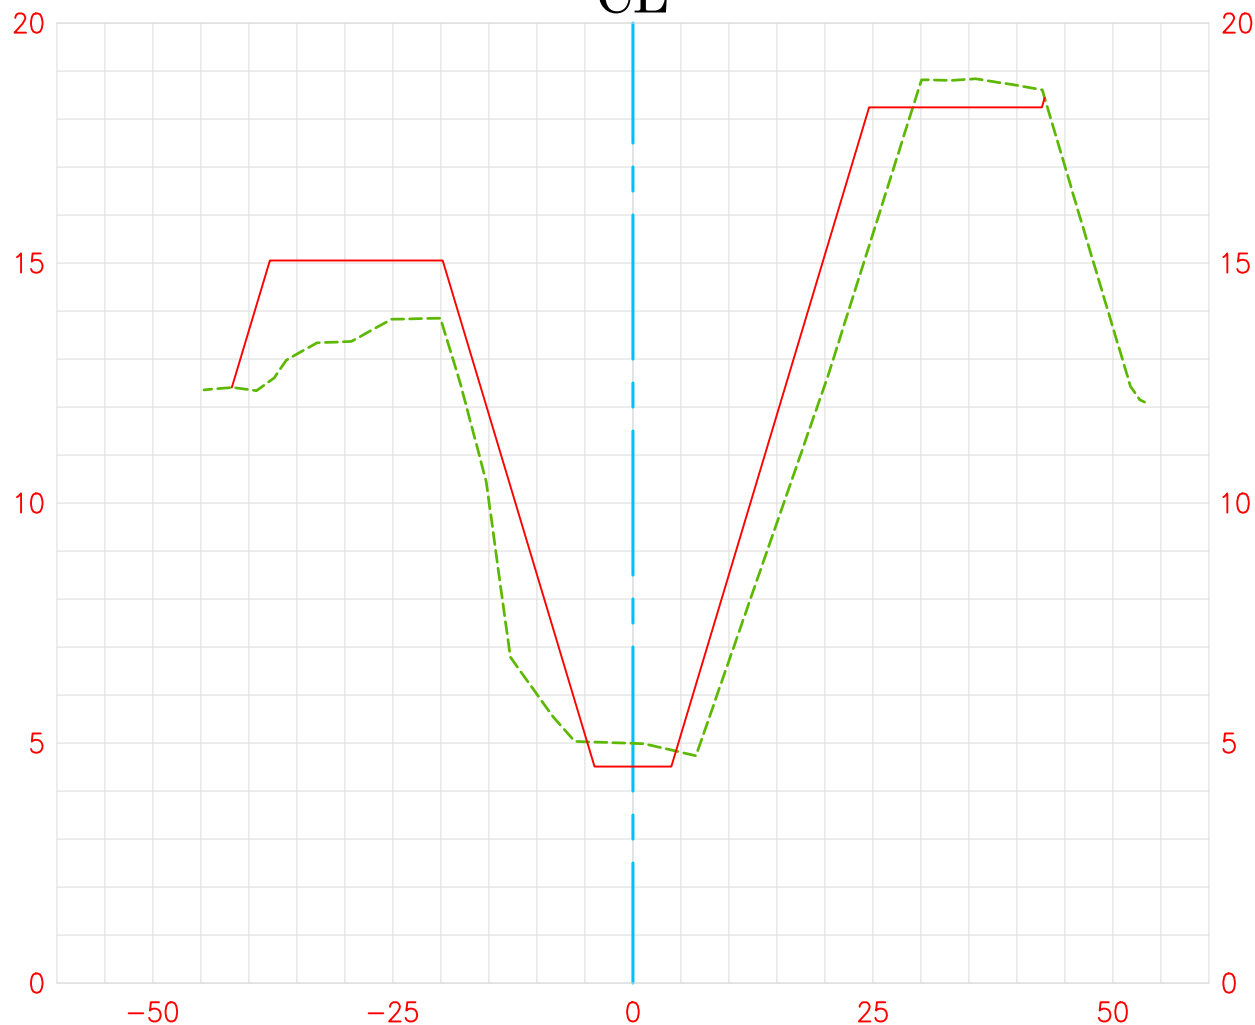

2019 Channel Survey
As-Built Plan




93+50.00

Vert. Scale: 1"=5'
Hor. Scale: 1"=20'

FAIRVIEW CHANNEL (D04)

CL

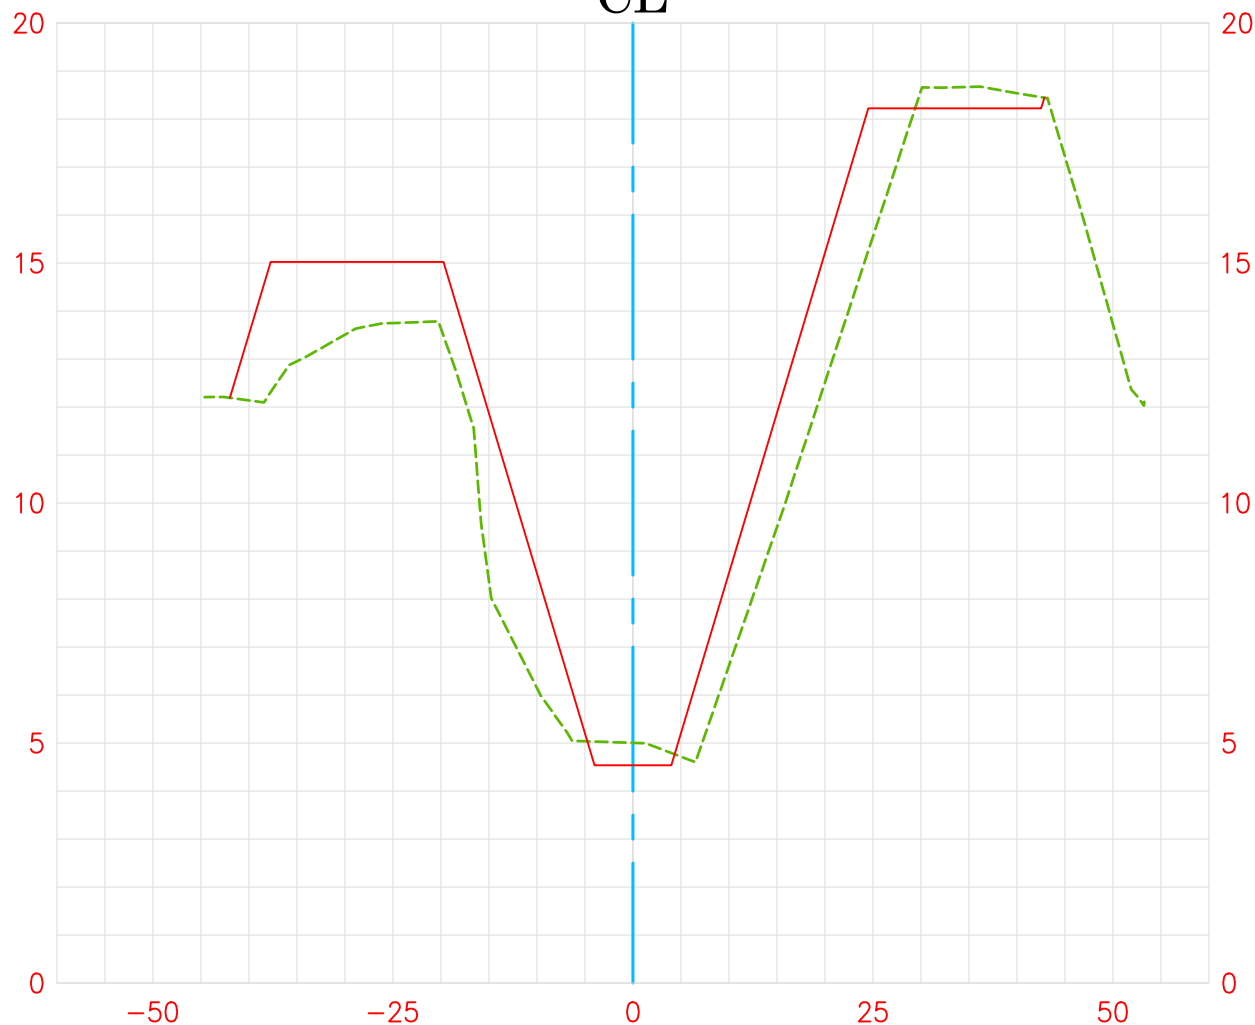

2019 Channel Survey
 As-Built Plan




94+00.00

Vert. Scale: 1"=5'
 Hor. Scale: 1"=20'

FAIRVIEW CHANNEL (D04)

CL

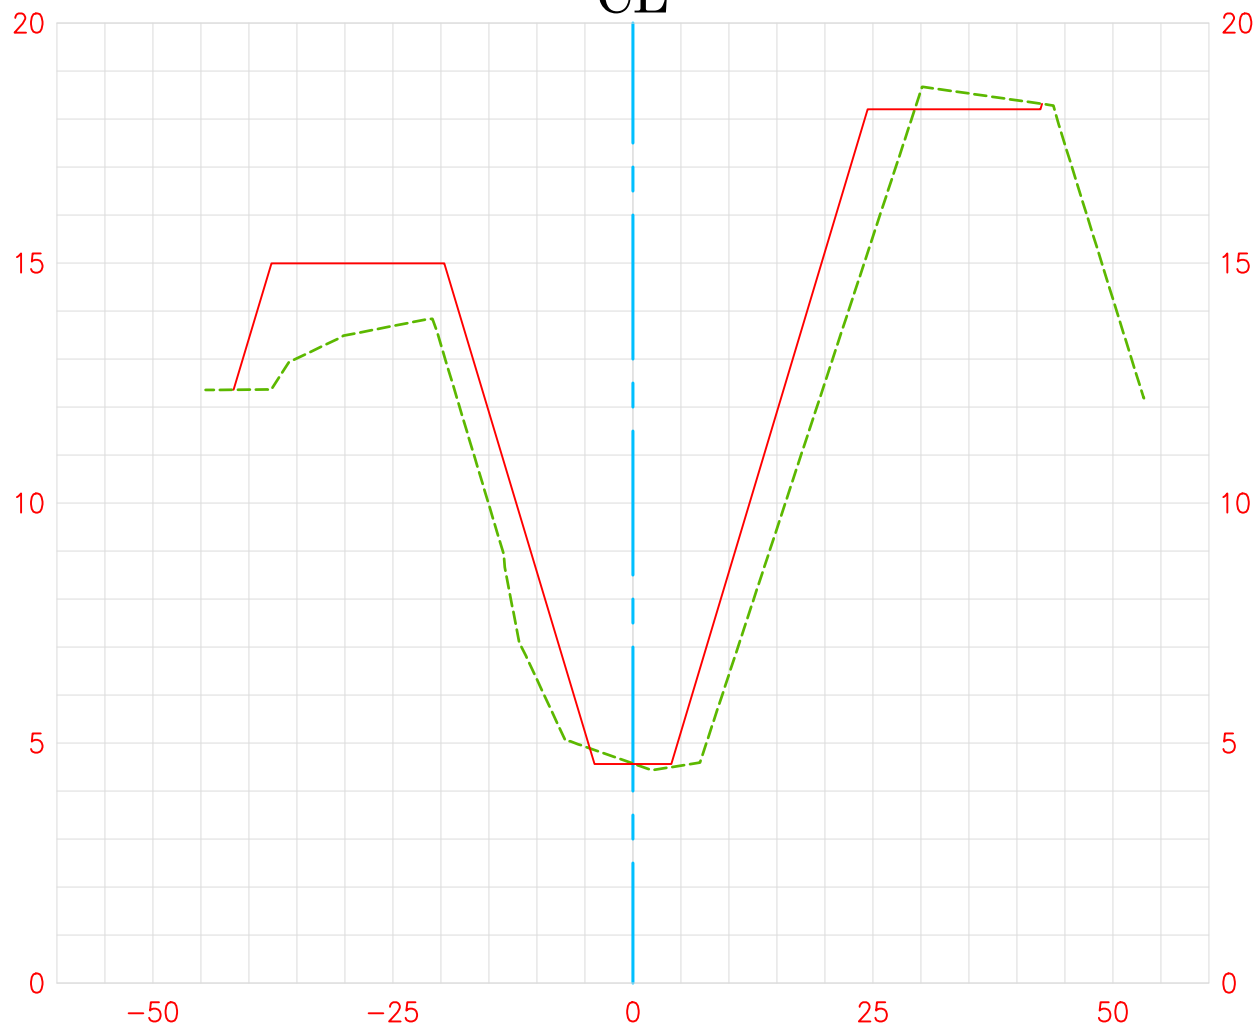

2019 Channel Survey
 As-Built Plan




94+50.00

Vert. Scale: 1"=5'
 Hor. Scale: 1"=20'

FAIRVIEW CHANNEL (D04)

CL

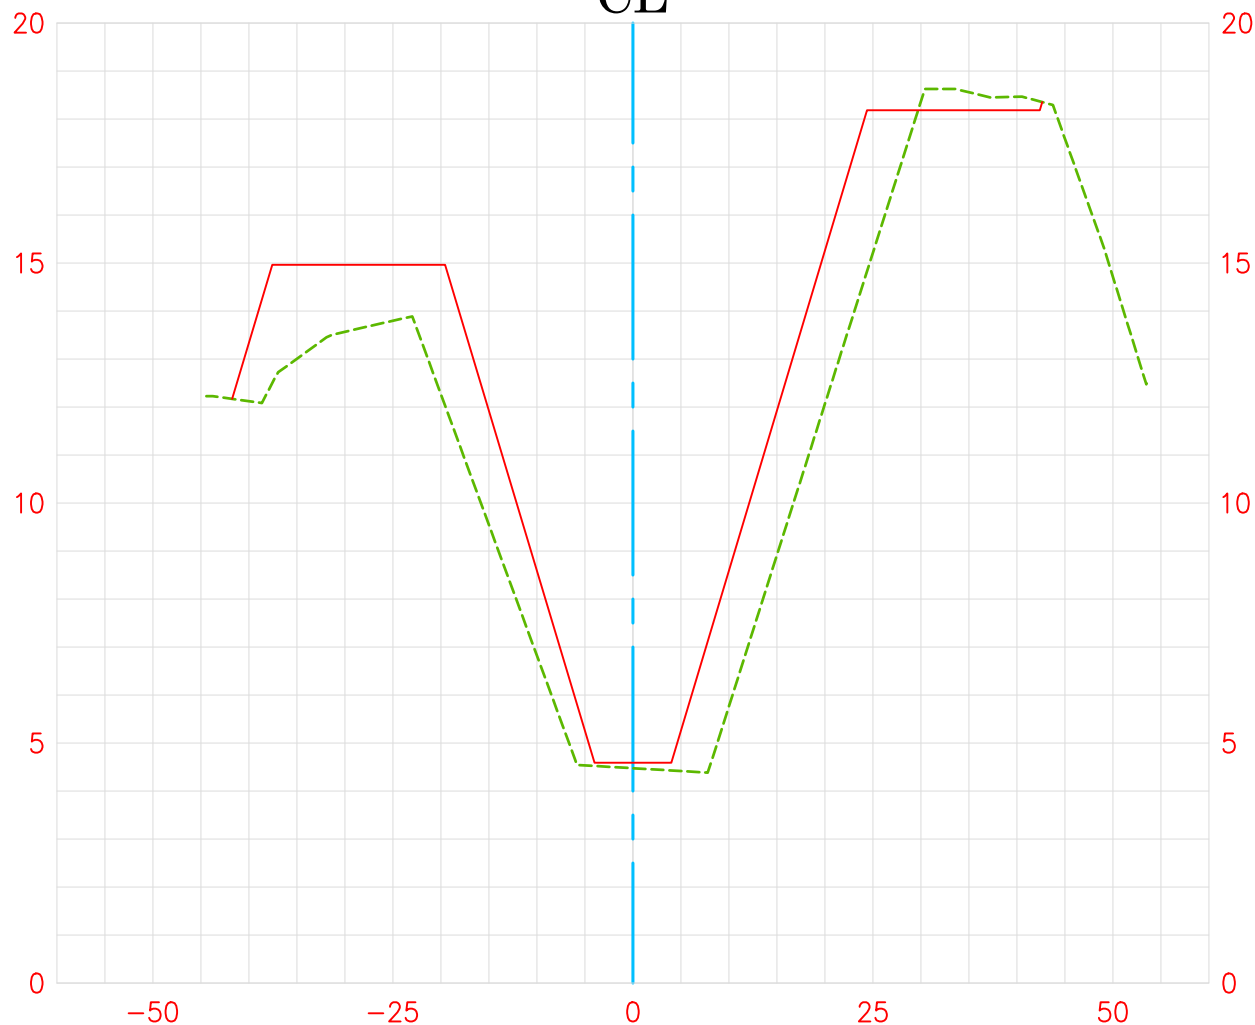

2019 Channel Survey
 As-Built Plan




95+00.00

Vert. Scale: 1"=5'
 Hor. Scale: 1"=20'

FAIRVIEW CHANNEL (D04)

CL

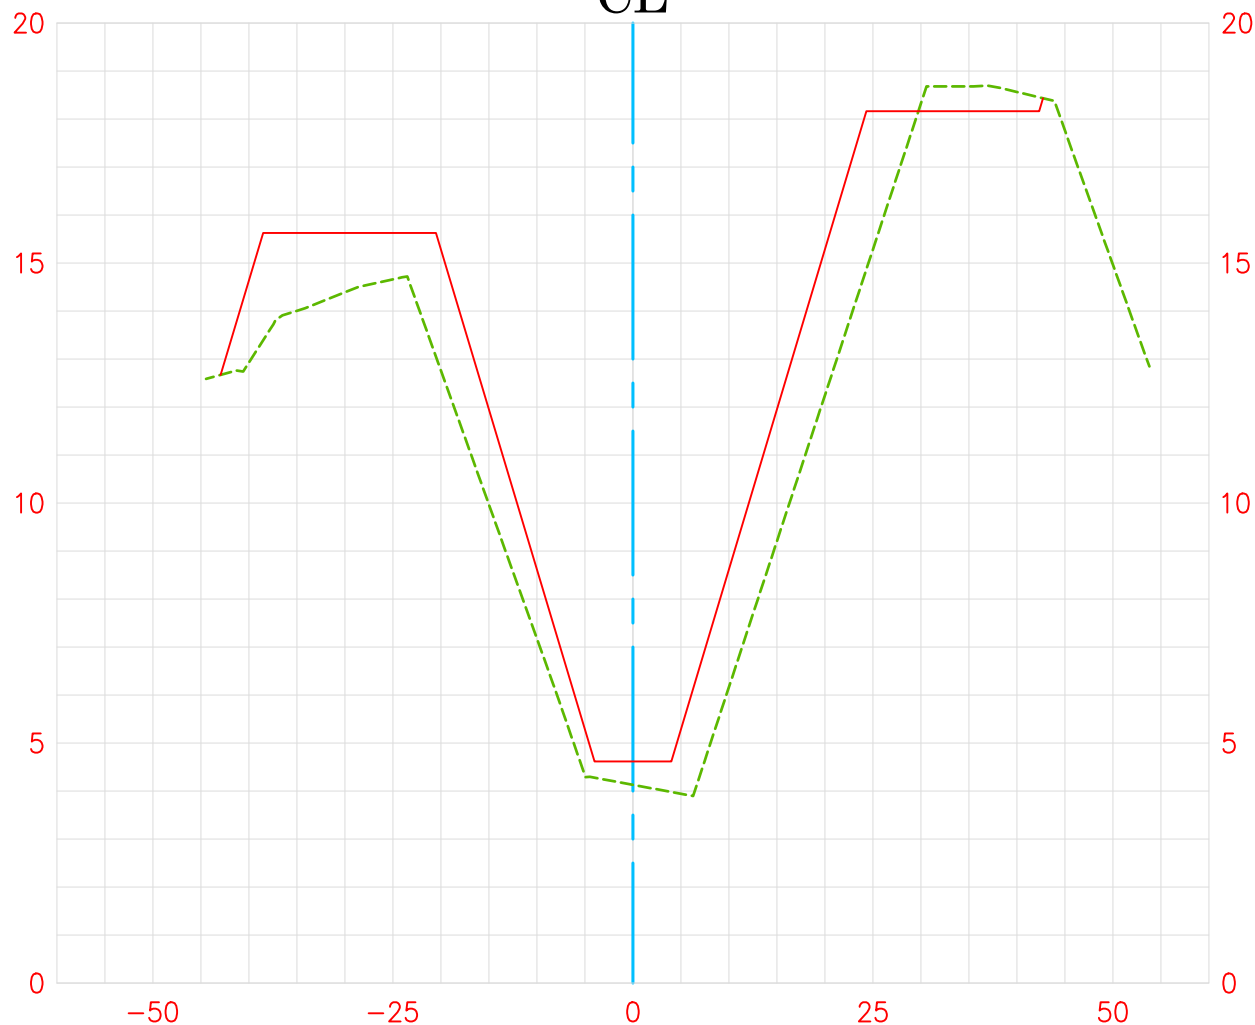

2019 Channel Survey
As-Built Plan




95+50.00

Vert. Scale: 1"=5'
Hor. Scale: 1"=20'

FAIRVIEW CHANNEL (D04)

CL

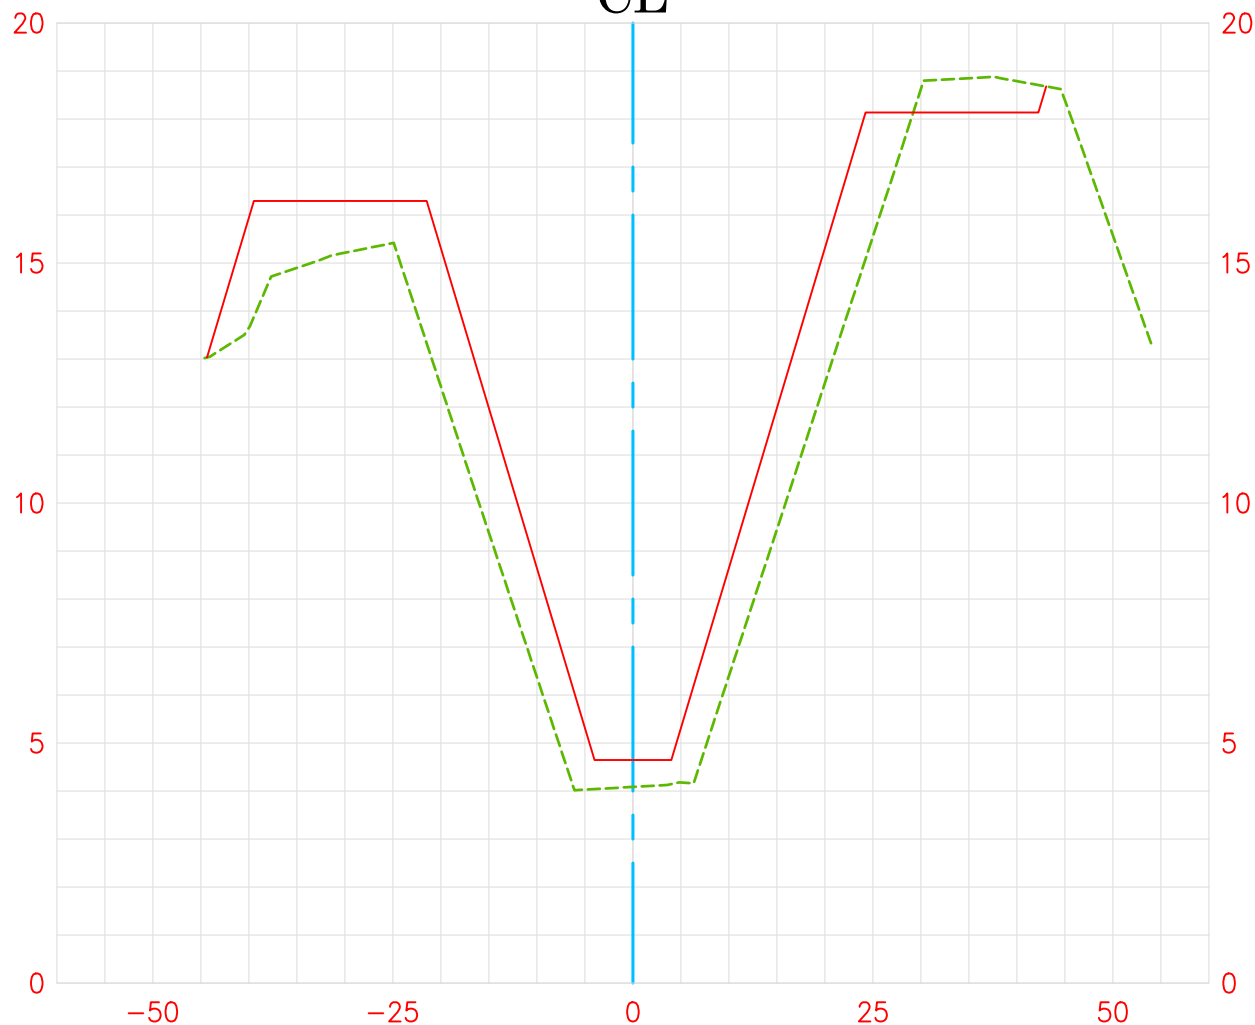

2019 Channel Survey
As-Built Plan




96+00.00

Vert. Scale: 1"=5'
Hor. Scale: 1"=20'

FAIRVIEW CHANNEL (D04)

CL

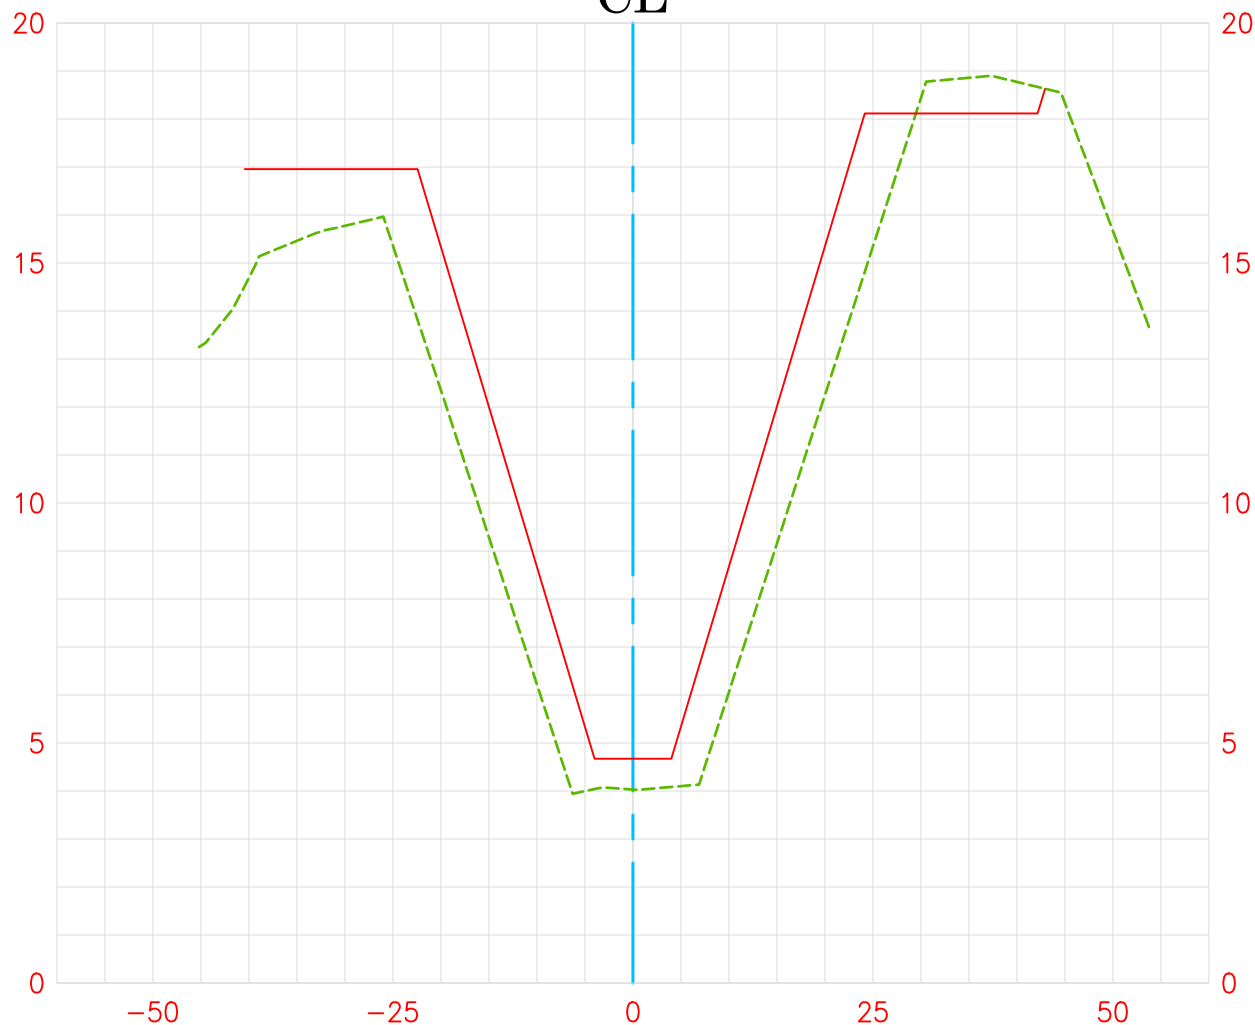

2019 Channel Survey
As-Built Plan




96+50.00

Vert. Scale: 1"=5'
Hor. Scale: 1"=20'

FAIRVIEW CHANNEL (D04)

CL

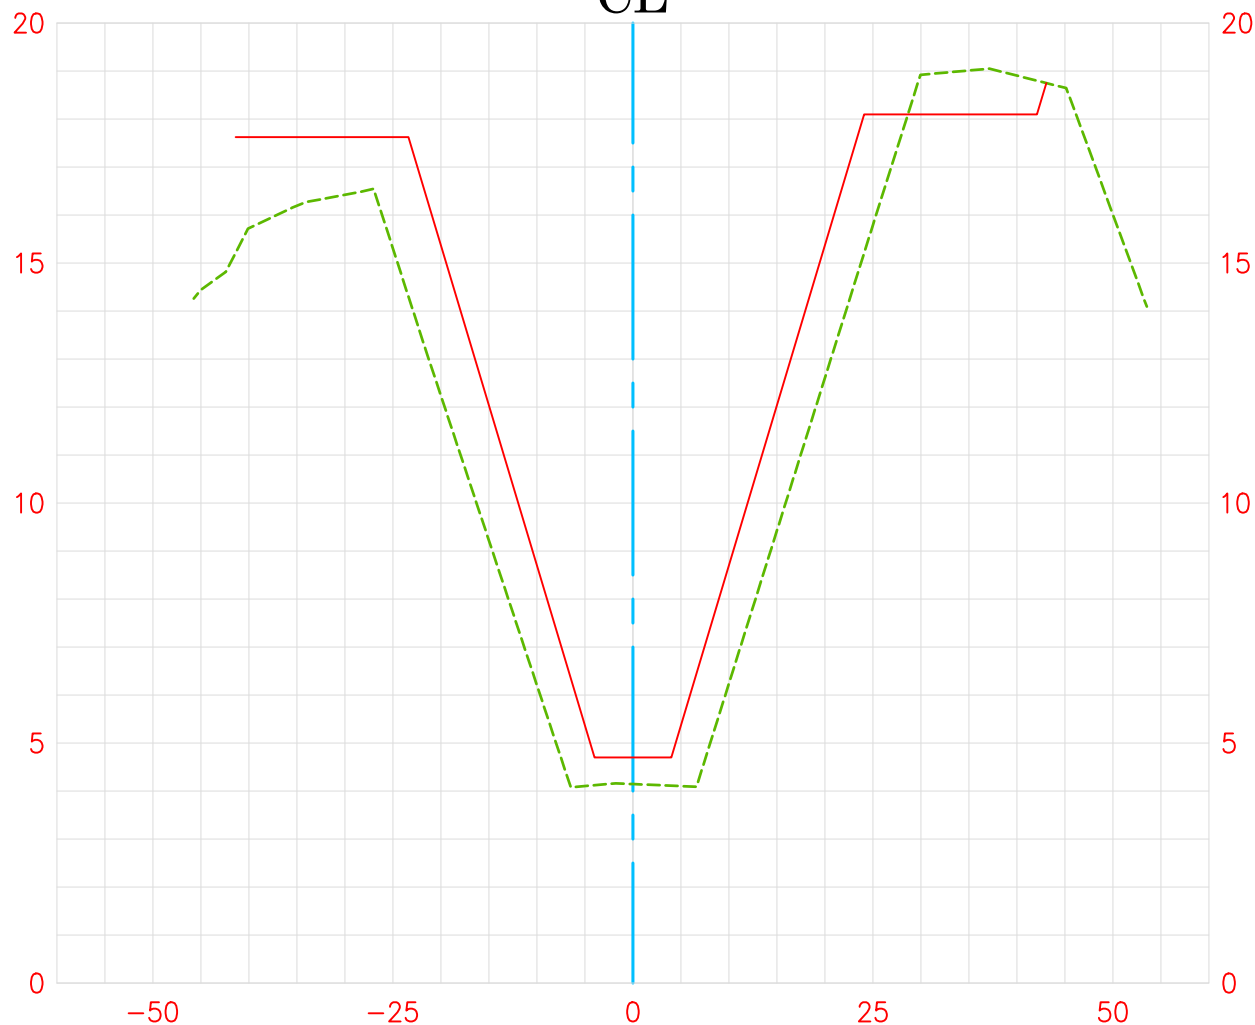

2019 Channel Survey
As-Built Plan




97+00.00

Vert. Scale: 1"=5'
Hor. Scale: 1"=20'

FAIRVIEW CHANNEL (D04)

CL

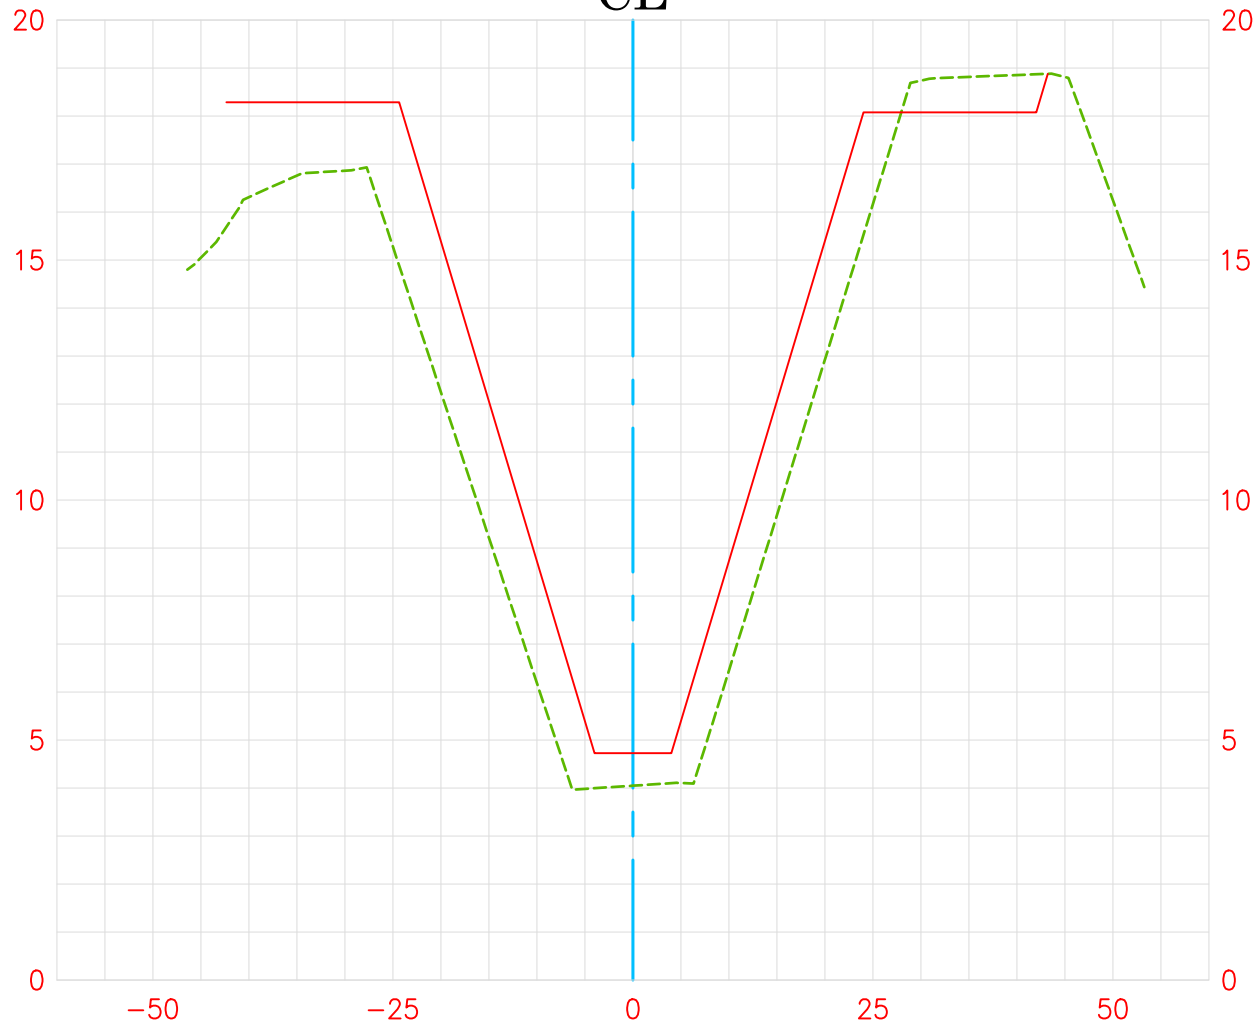

2019 Channel Survey
As-Built Plan




97+50.00

Vert. Scale: 1"=5'
Hor. Scale: 1"=20'

FAIRVIEW CHANNEL (D04)

CL

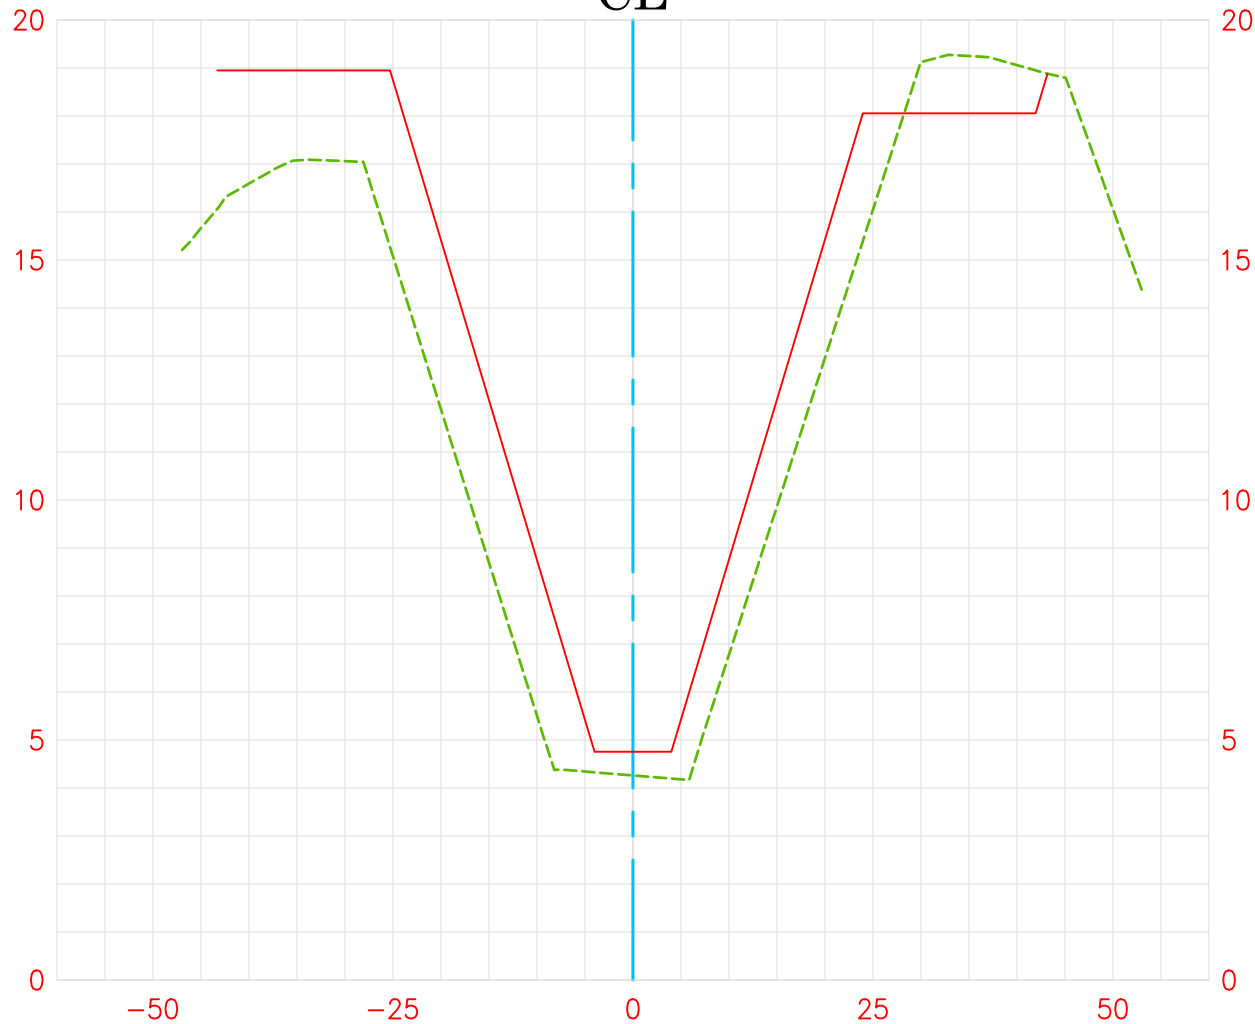

2019 Channel Survey
As-Built Plan




98+00.00

Vert. Scale: 1"=5'
Hor. Scale: 1"=20'

FAIRVIEW CHANNEL (D04)

CL

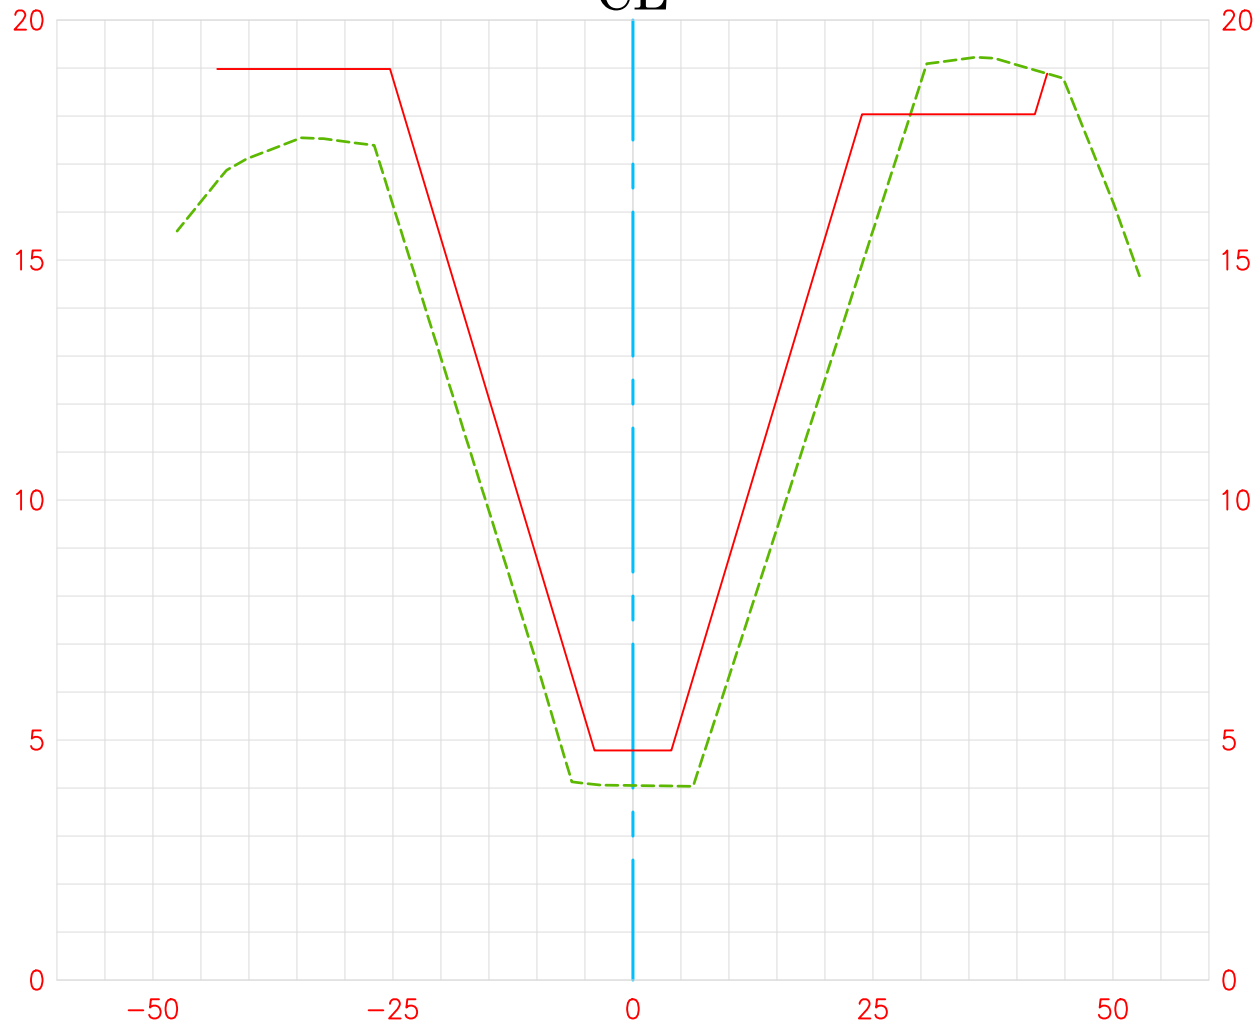

2019 Channel Survey
As-Built Plan




98+50.00

Vert. Scale: 1"=5'
Hor. Scale: 1"=20'

FAIRVIEW CHANNEL (D04)

CL

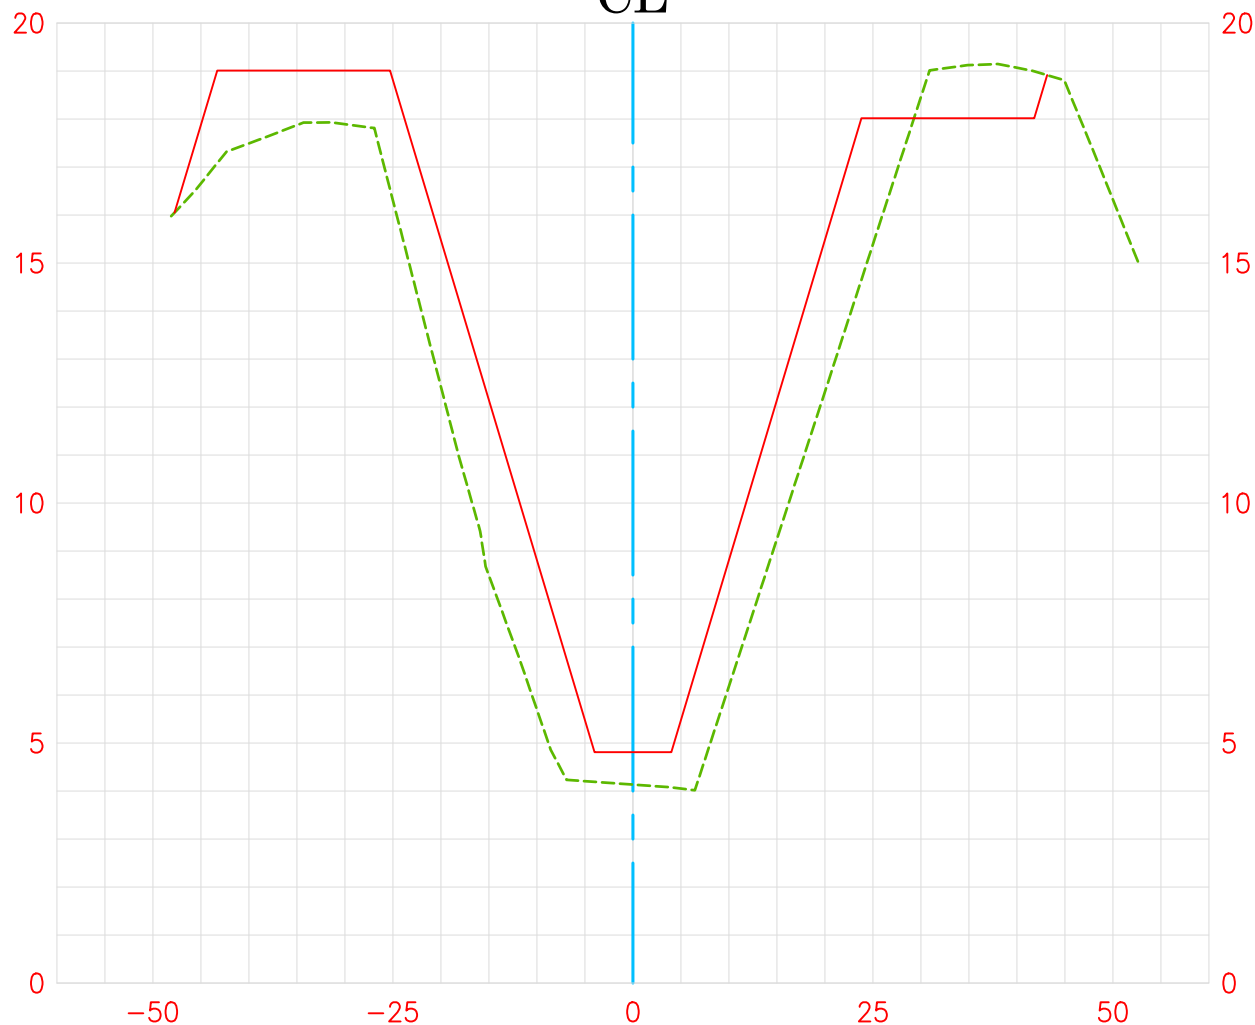

2019 Channel Survey
As-Built Plan




99+00.00

Vert. Scale: 1"=5'
Hor. Scale: 1"=20'

FAIRVIEW CHANNEL (D04)

CL

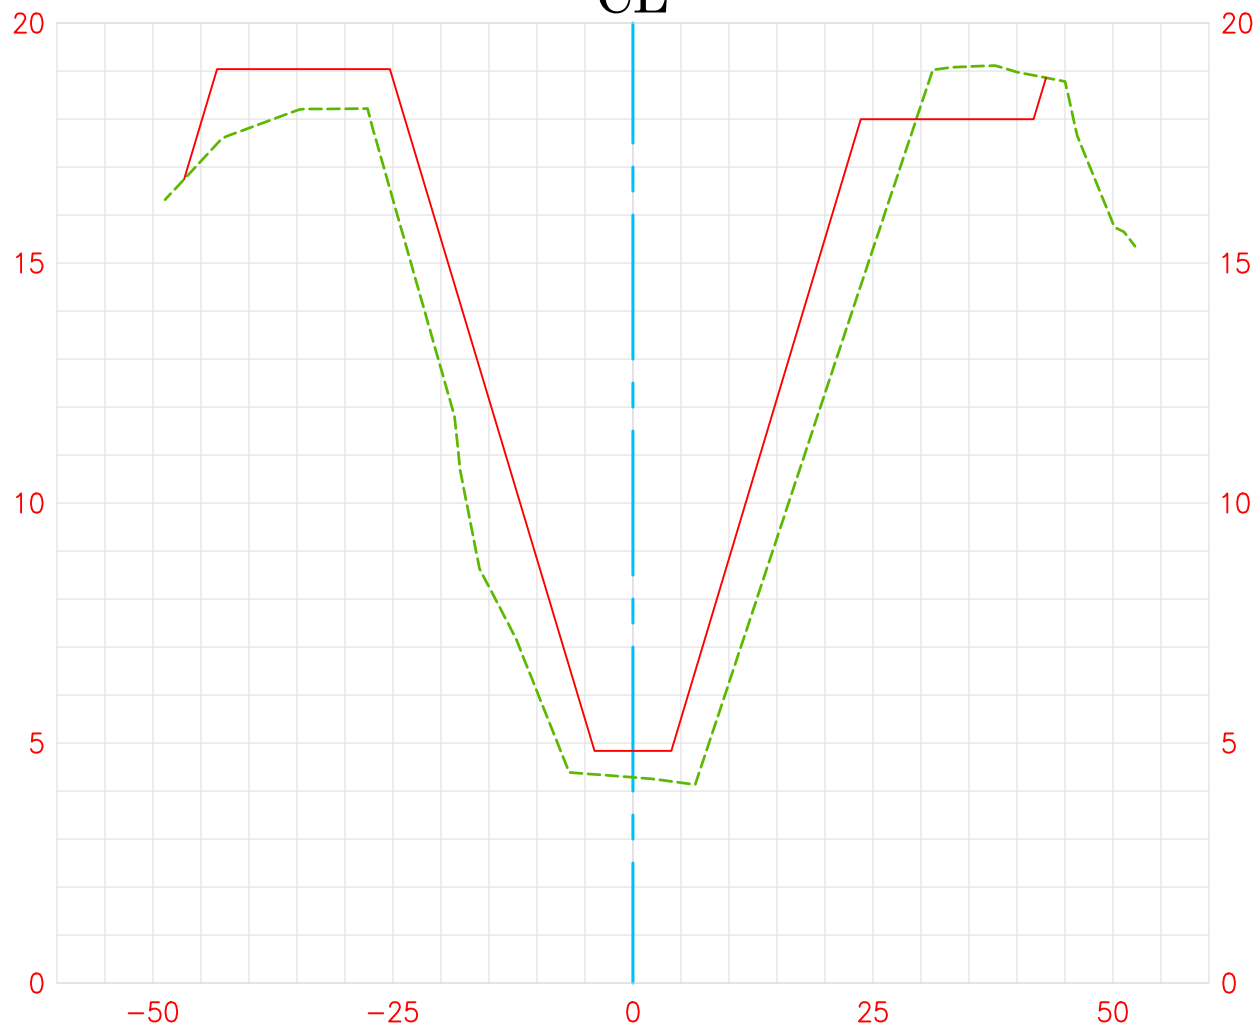

2019 Channel Survey
 As-Built Plan




99+50.00

Vert. Scale: 1"=5'
 Hor. Scale: 1"=20'

FAIRVIEW CHANNEL (D04)

CL

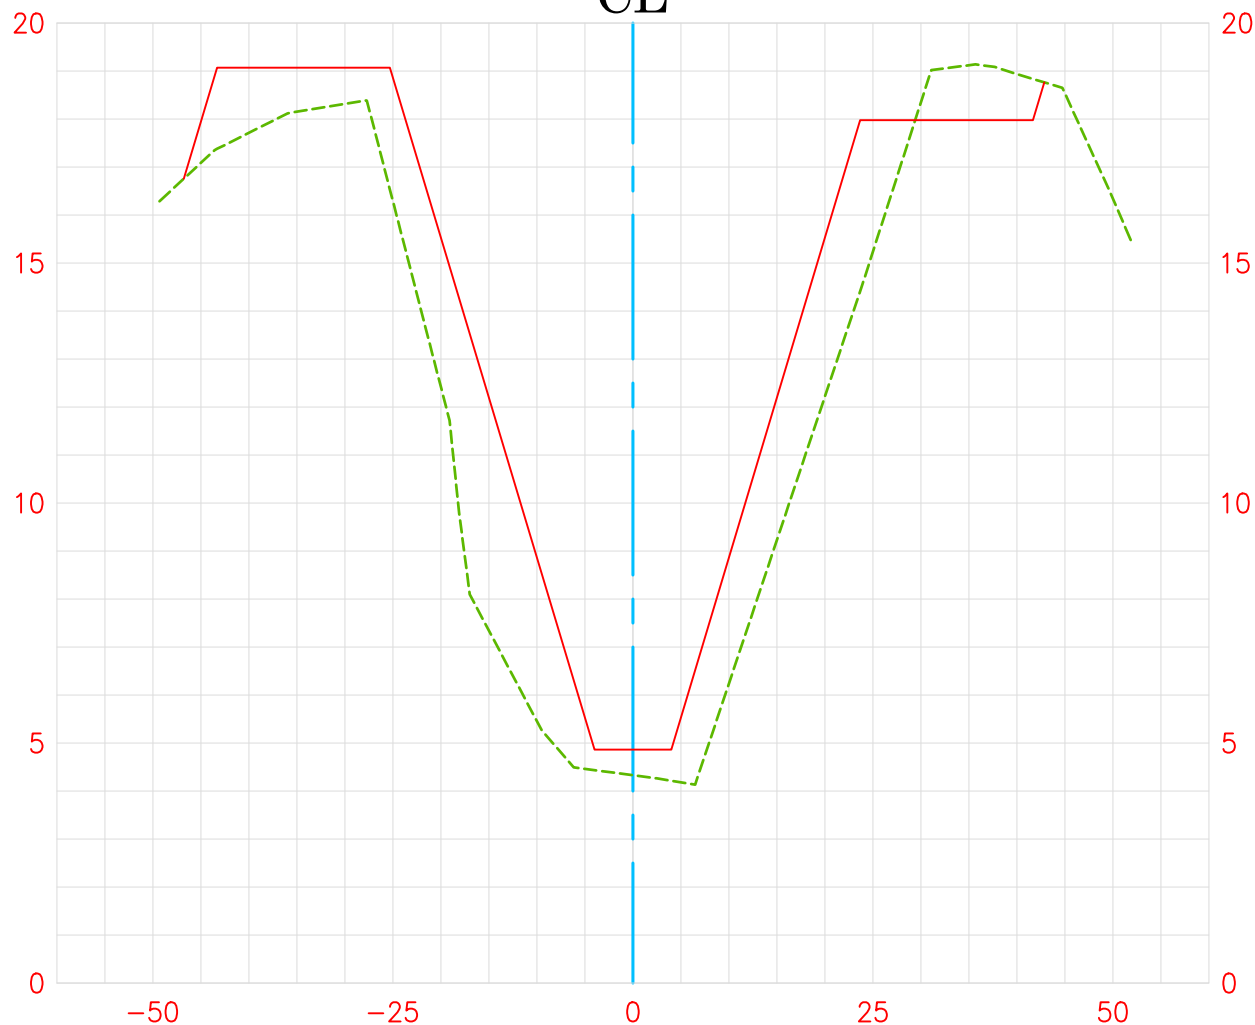

2019 Channel Survey
 As-Built Plan




100+00.00

Vert. Scale: 1"=5'
 Hor. Scale: 1"=20'

FAIRVIEW CHANNEL (D04)

CL

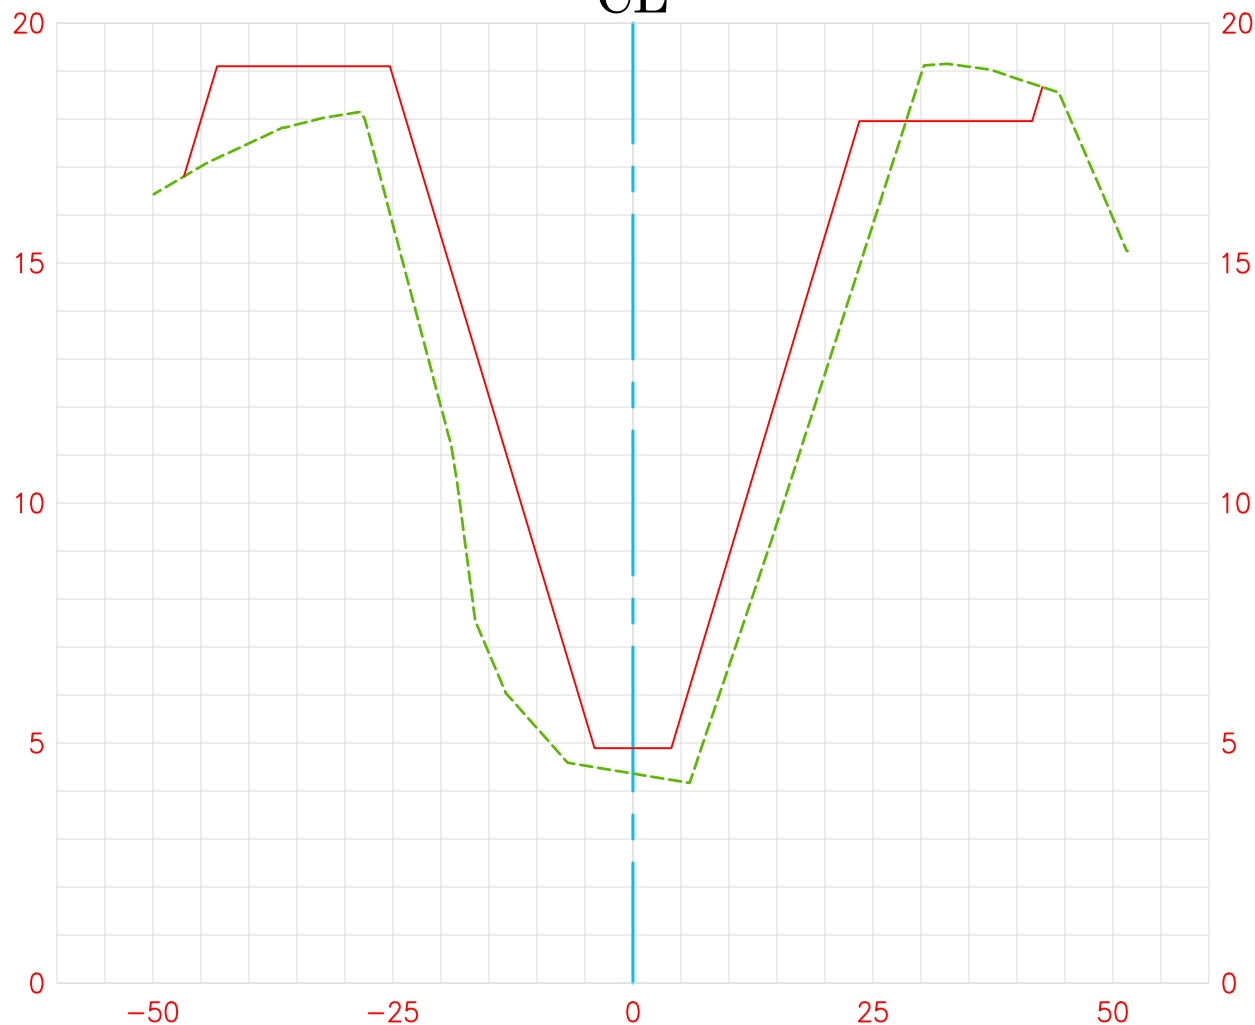

2019 Channel Survey
As-Built Plan




100+50.00


Vert. Scale: 1"=5'
Hor. Scale: 1"=20'

FAIRVIEW CHANNEL (D04)

CL

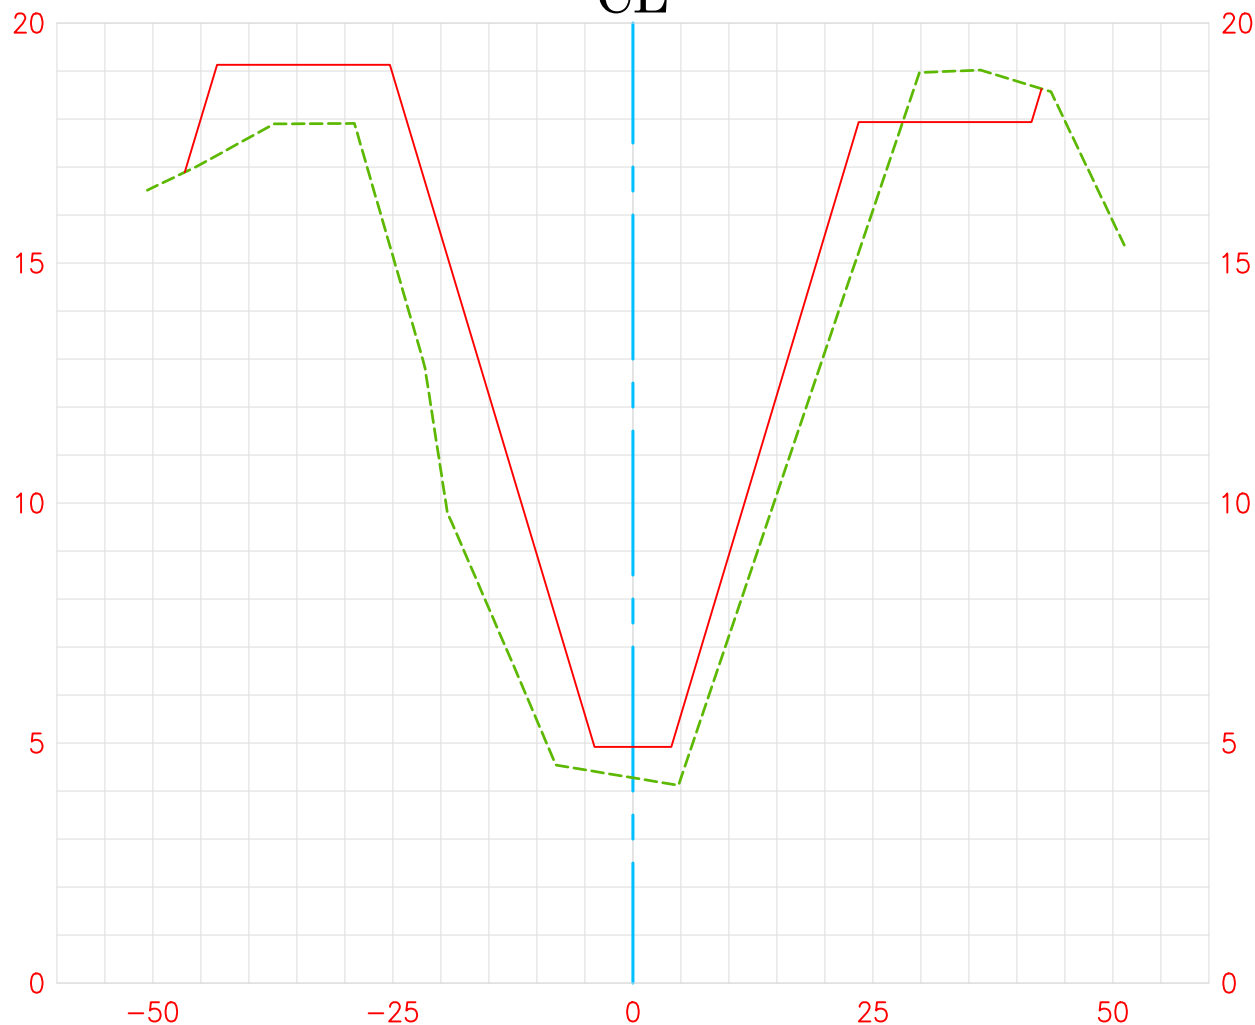

2019 Channel Survey
 As-Built Plan

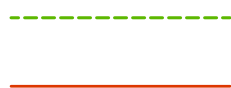


101+00.00

Vert. Scale: 1"=5'
 Hor. Scale: 1"=20'

FAIRVIEW CHANNEL (D04)

CL

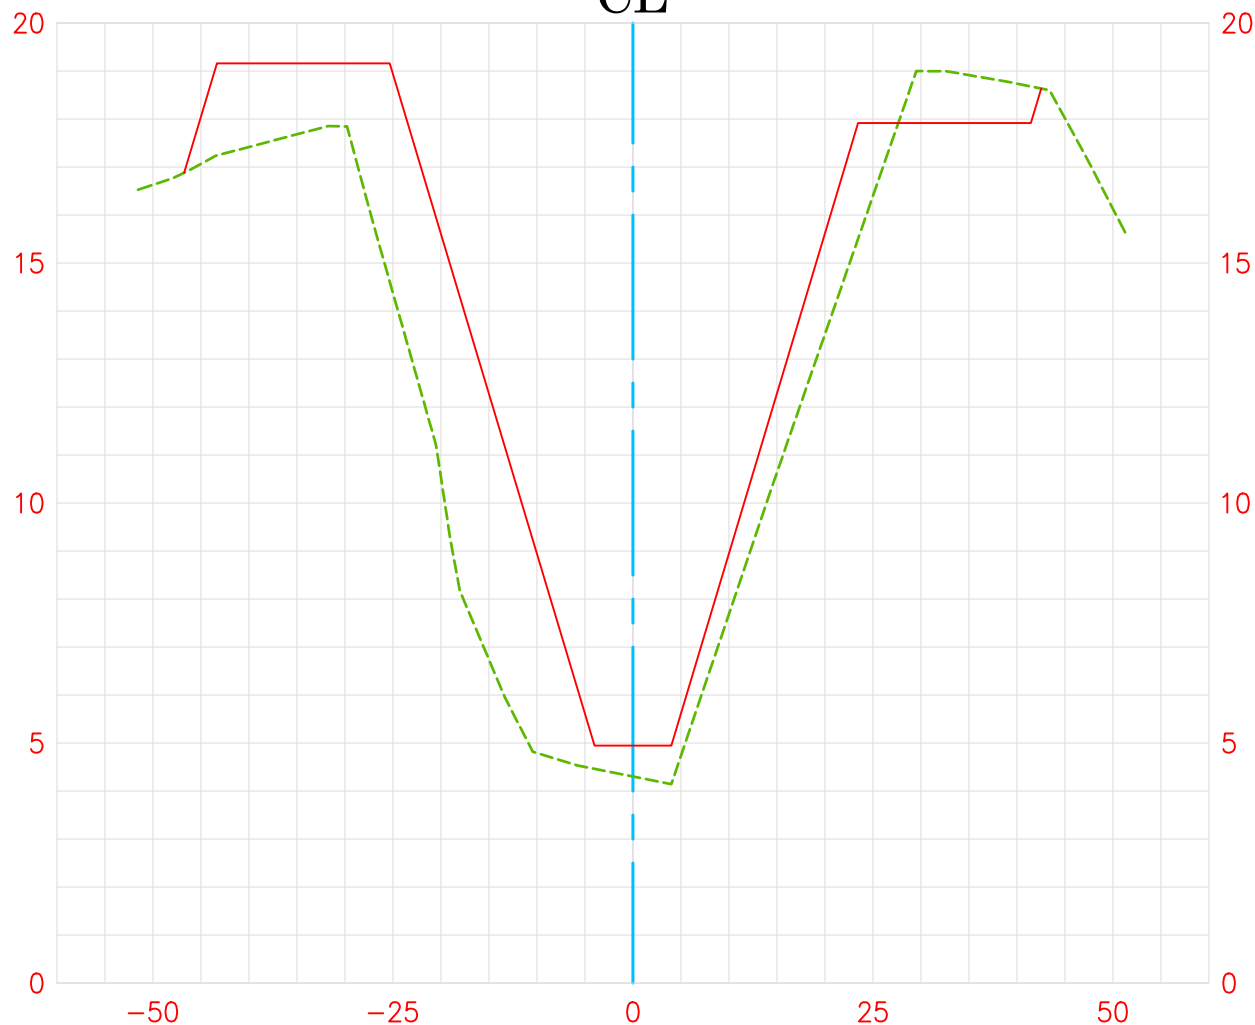

2019 Channel Survey
 As-Built Plan




101+50.00

Vert. Scale: 1"=5'
 Hor. Scale: 1"=20'

FAIRVIEW CHANNEL (D04)

CL

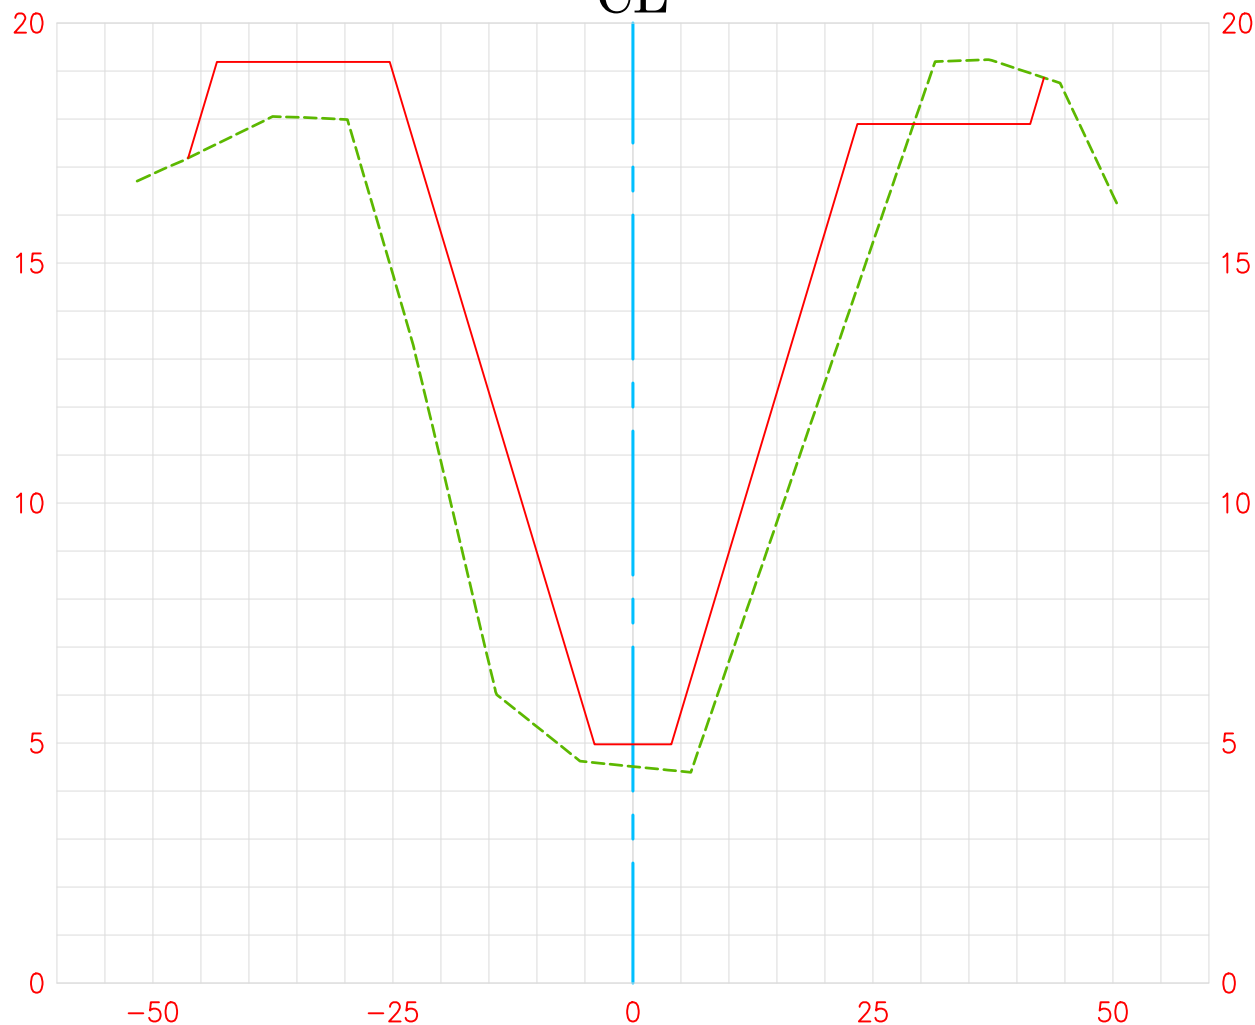

2019 Channel Survey
 As-Built Plan




102+00.00

Vert. Scale: 1"=5'
 Hor. Scale: 1"=20'

FAIRVIEW CHANNEL (D04)

CL

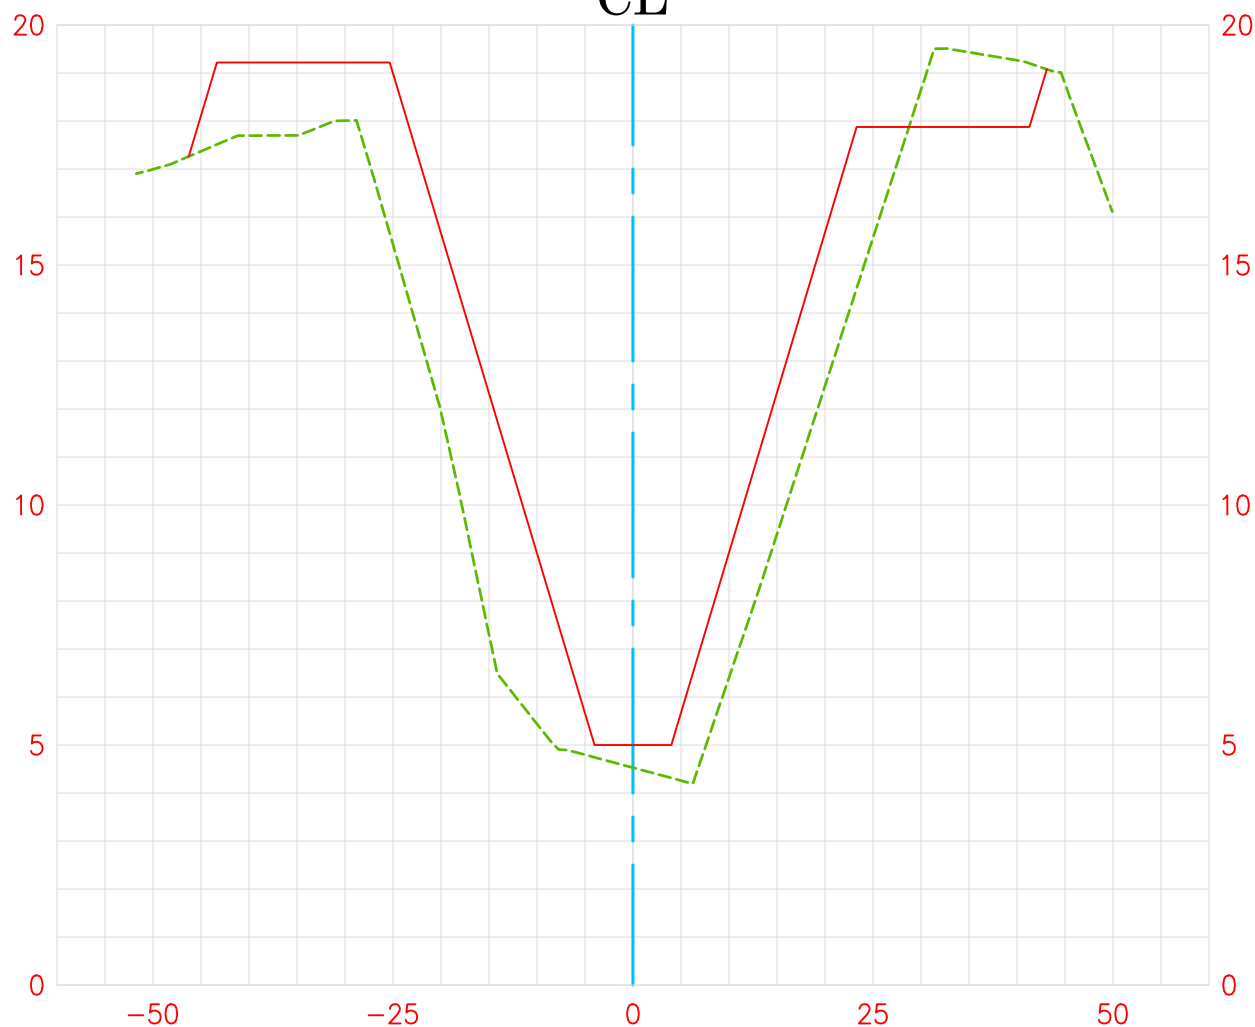

2019 Channel Survey
As-Built Plan




102+50.00

Vert. Scale: 1"=5'
Hor. Scale: 1"=20'

FAIRVIEW CHANNEL (D04)

CL

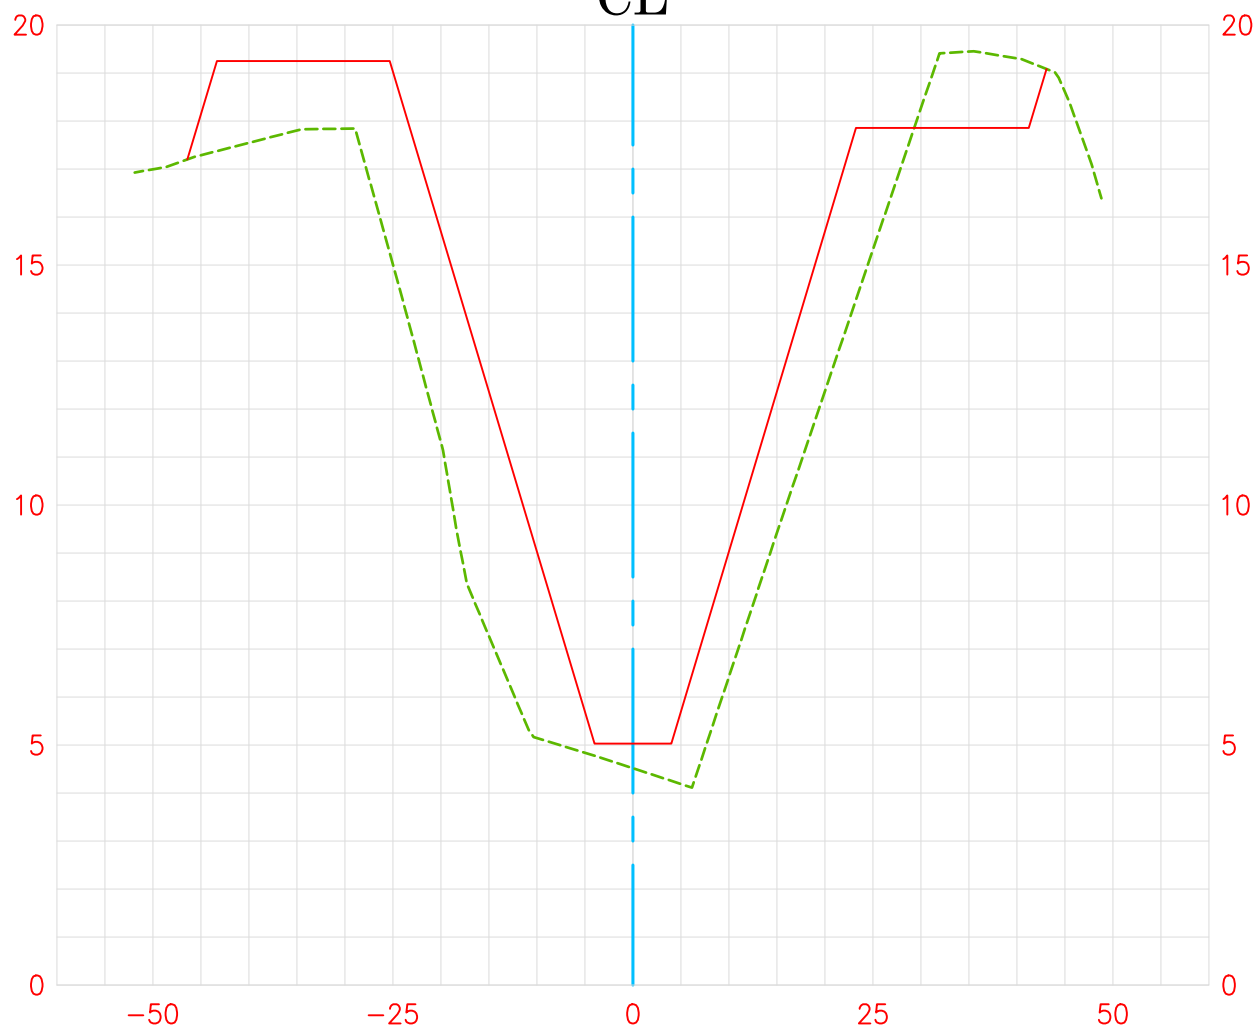

2019 Channel Survey
As-Built Plan




103+00.00

Vert. Scale: 1"=5'
Hor. Scale: 1"=20'

FAIRVIEW CHANNEL (D04)

CL

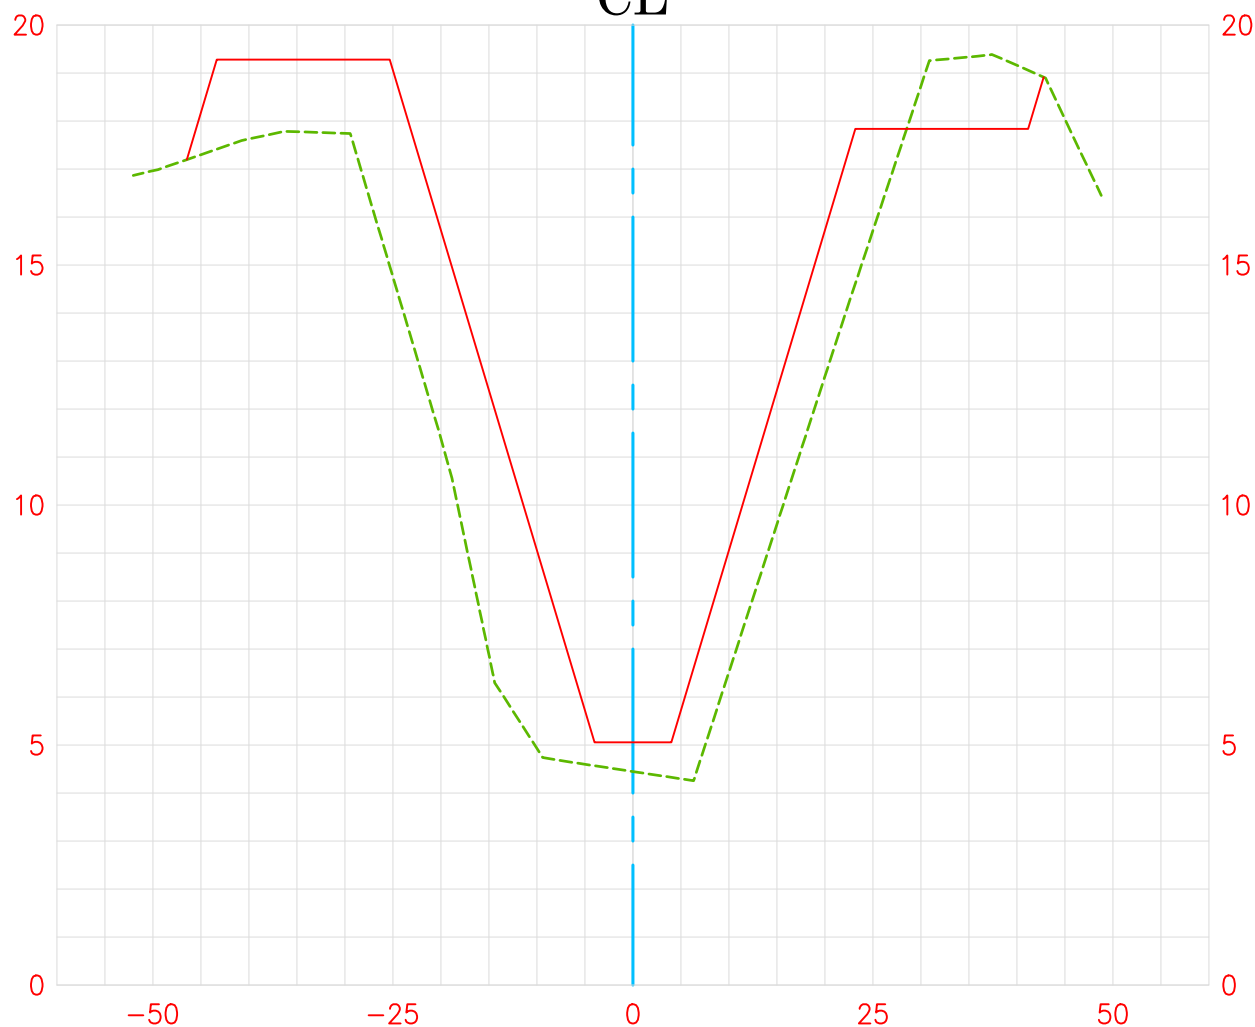

2019 Channel Survey
As-Built Plan




103+50.00

Vert. Scale: 1"=5'
Hor. Scale: 1"=20'

FAIRVIEW CHANNEL (D04)

CL

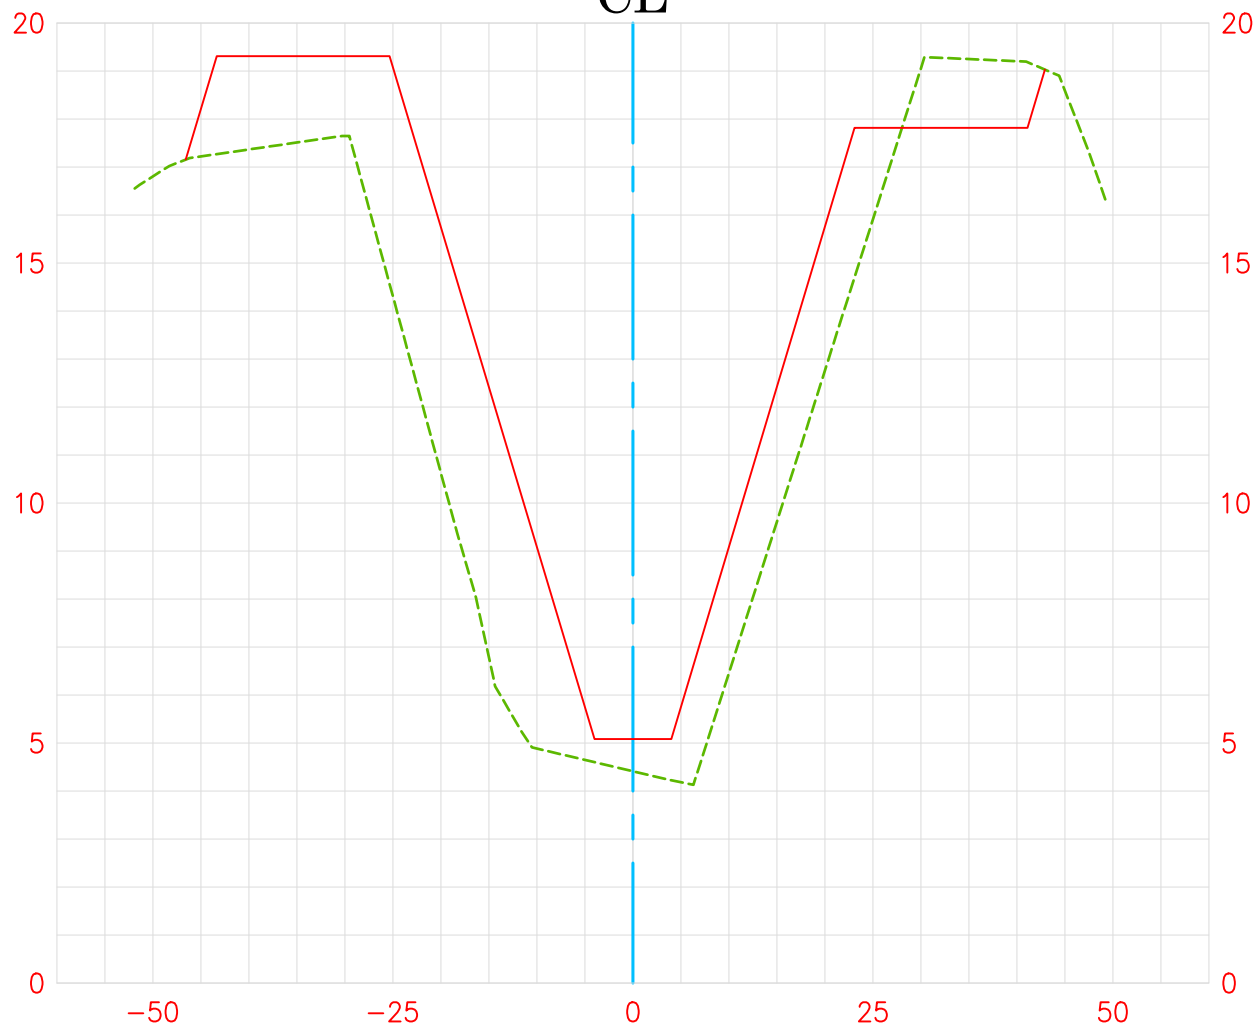

2019 Channel Survey
 As-Built Plan




104+00.00

Vert. Scale: 1"=5'
 Hor. Scale: 1"=20'

FAIRVIEW CHANNEL (D04)

CL

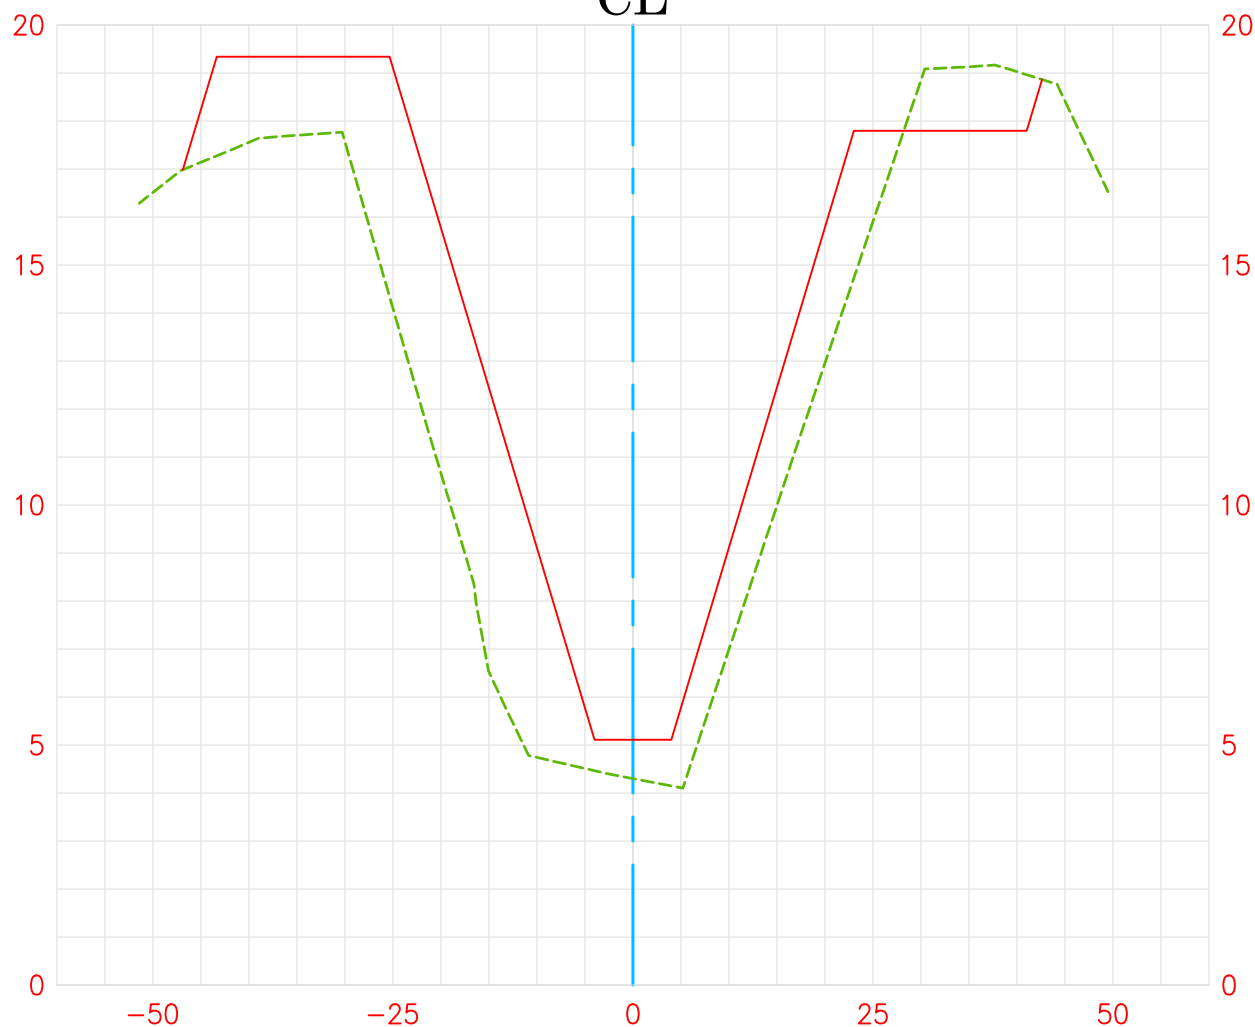

2019 Channel Survey
As-Built Plan




104+50.00


Vert. Scale: 1"=5'
Hor. Scale: 1"=20'

FAIRVIEW CHANNEL (D04)

CL

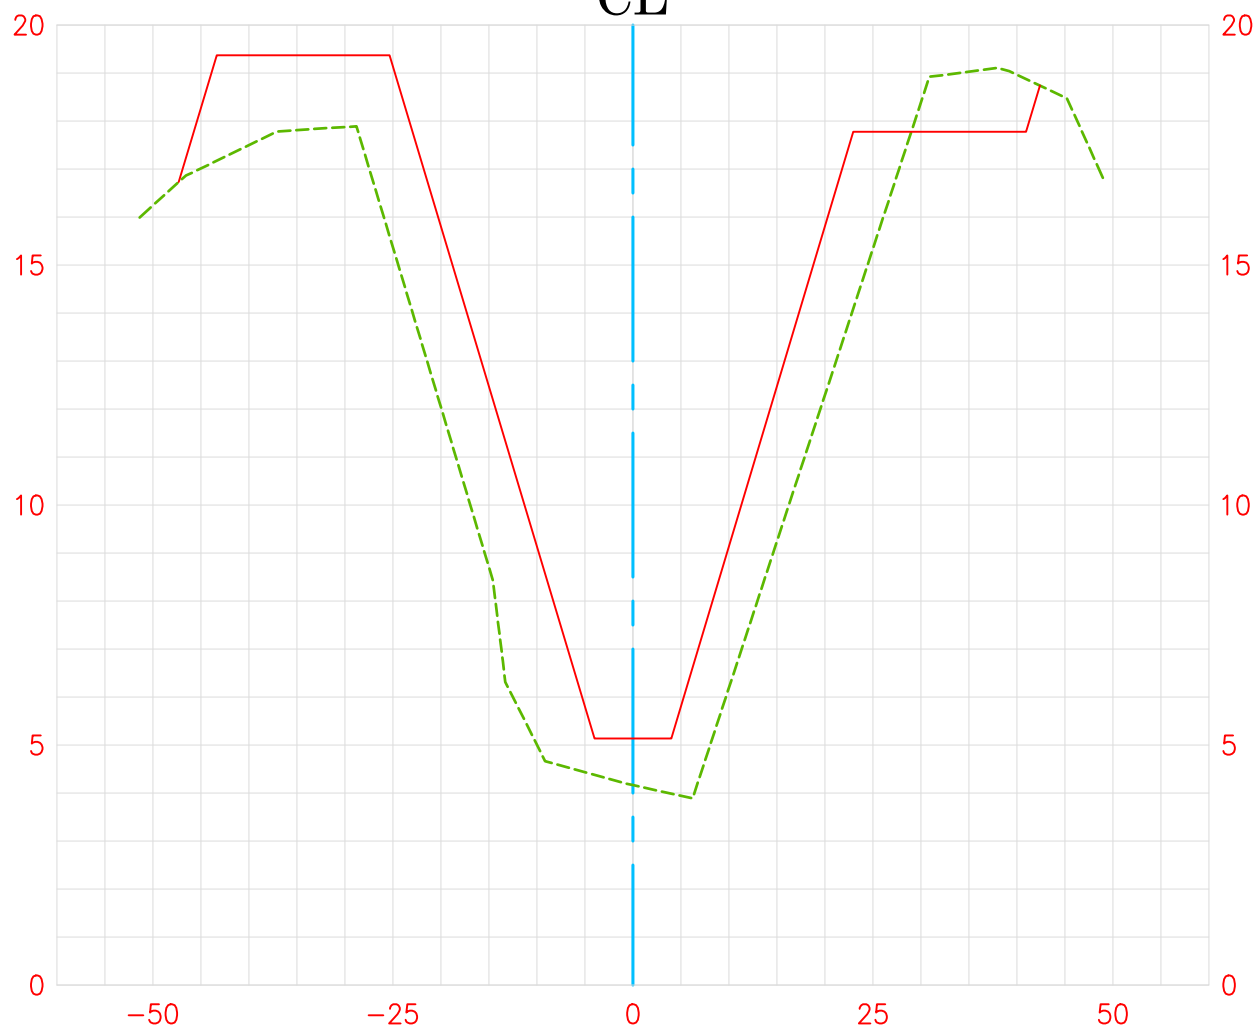

2019 Channel Survey
As-Built Plan

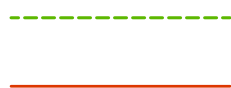


105+00.00

Vert. Scale: 1"=5'
Hor. Scale: 1"=20'

FAIRVIEW CHANNEL (D04)

CL

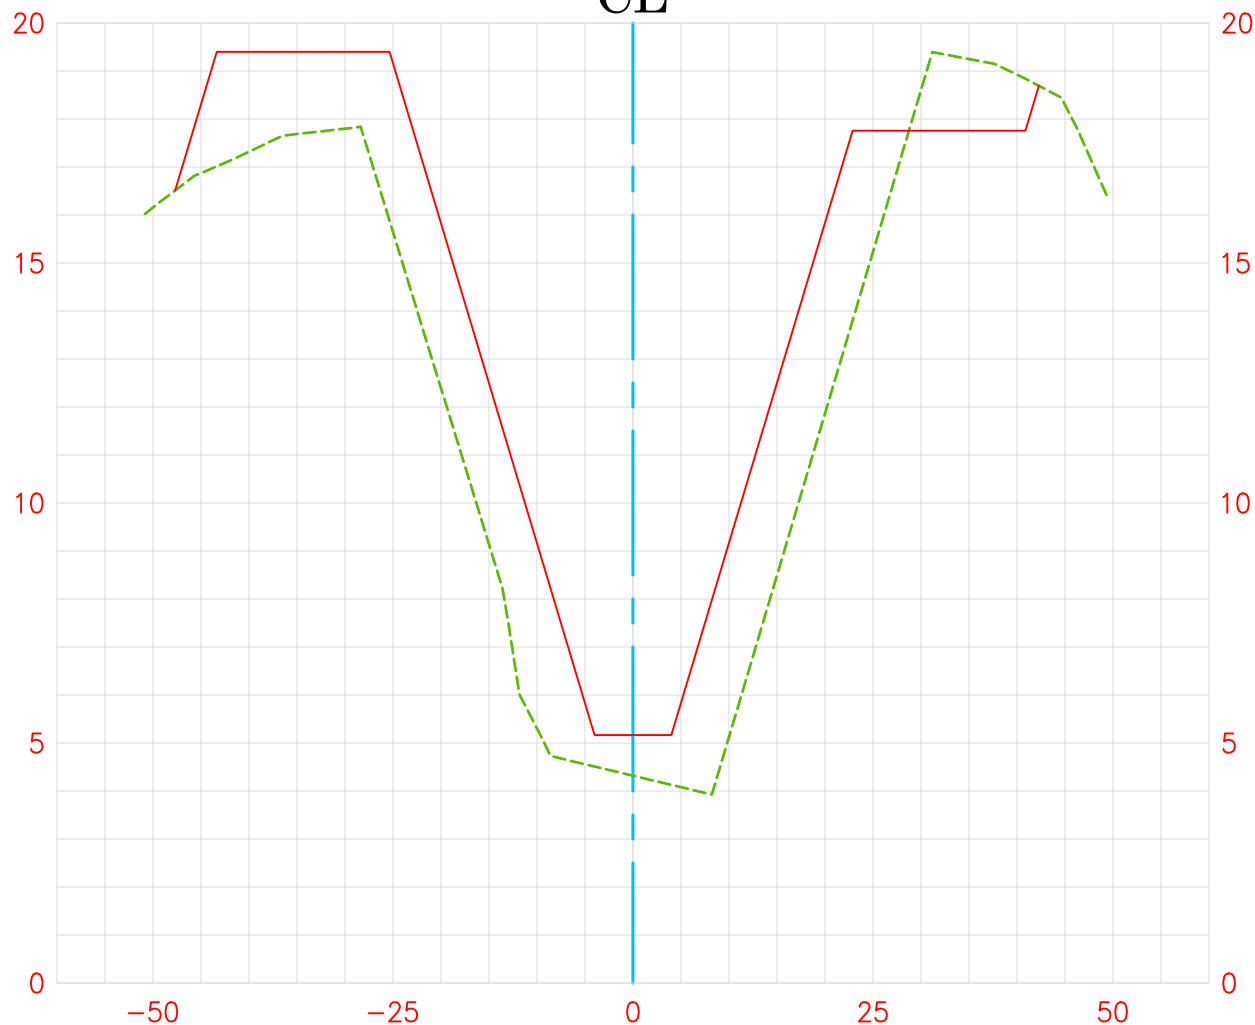

2019 Channel Survey
As-Built Plan




105+50.00

Vert. Scale: 1"=5'
Hor. Scale: 1"=20'

FAIRVIEW CHANNEL (D04)

CL

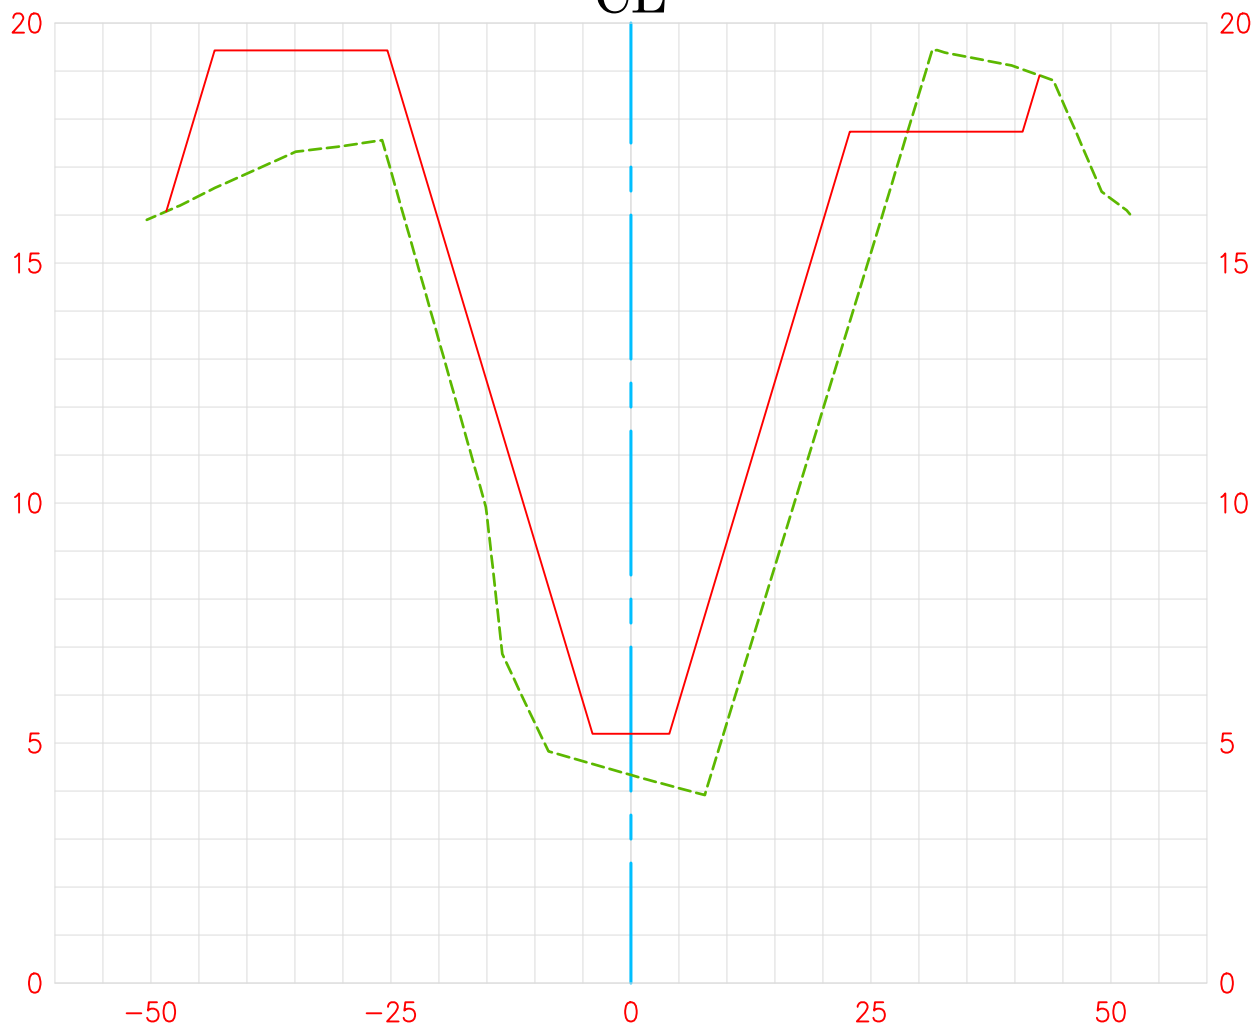

2019 Channel Survey
As-Built Plan




106+00.00

Vert. Scale: 1"=5'
Hor. Scale: 1"=20'

FAIRVIEW CHANNEL (D04)

CL

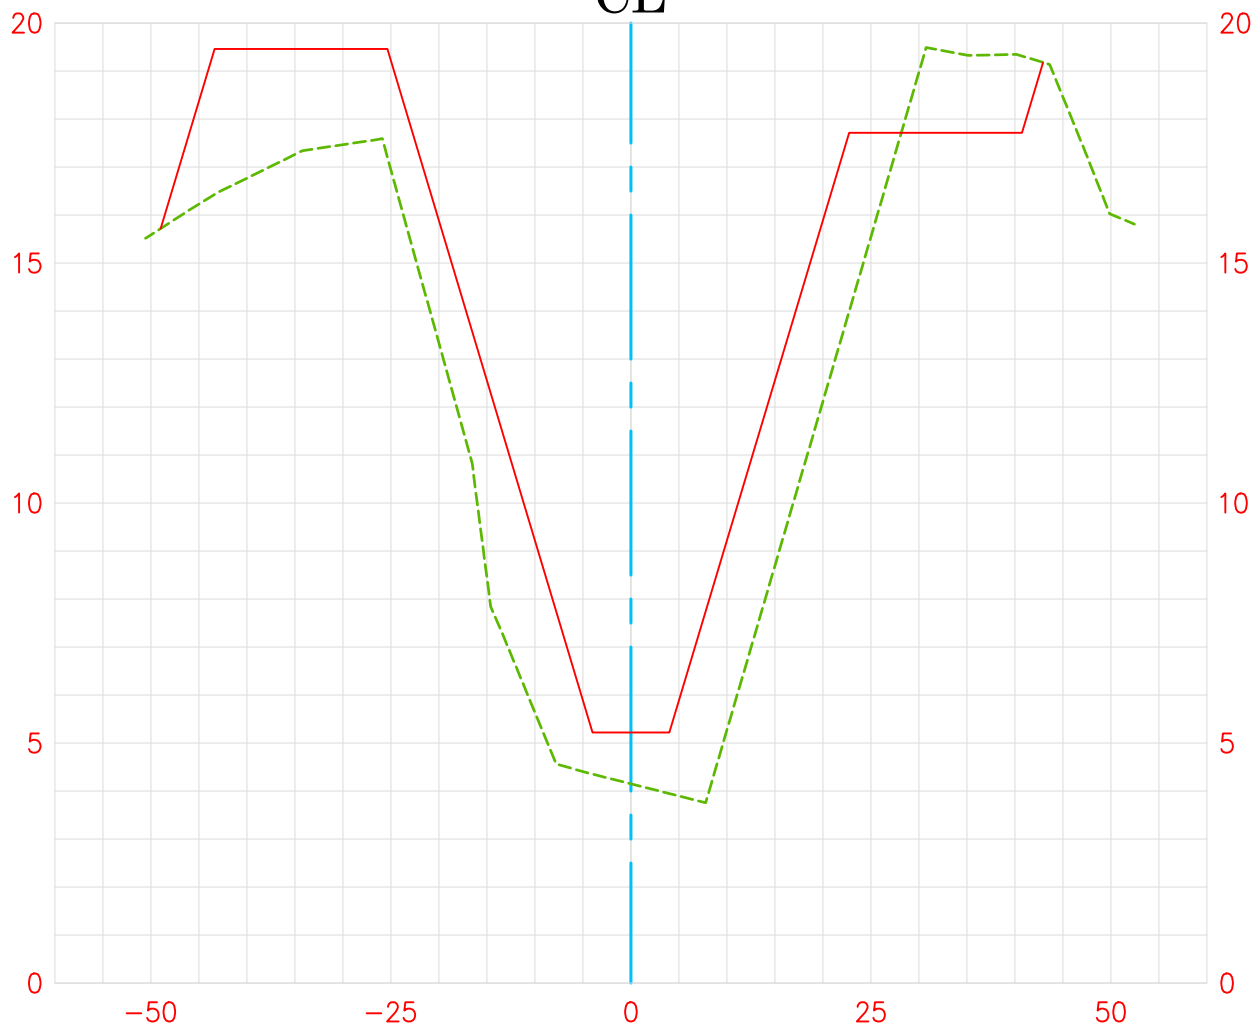

2019 Channel Survey
 As-Built Plan




106+50.00

Vert. Scale: 1"=5'
 Hor. Scale: 1"=20'

FAIRVIEW CHANNEL (D04)

CL

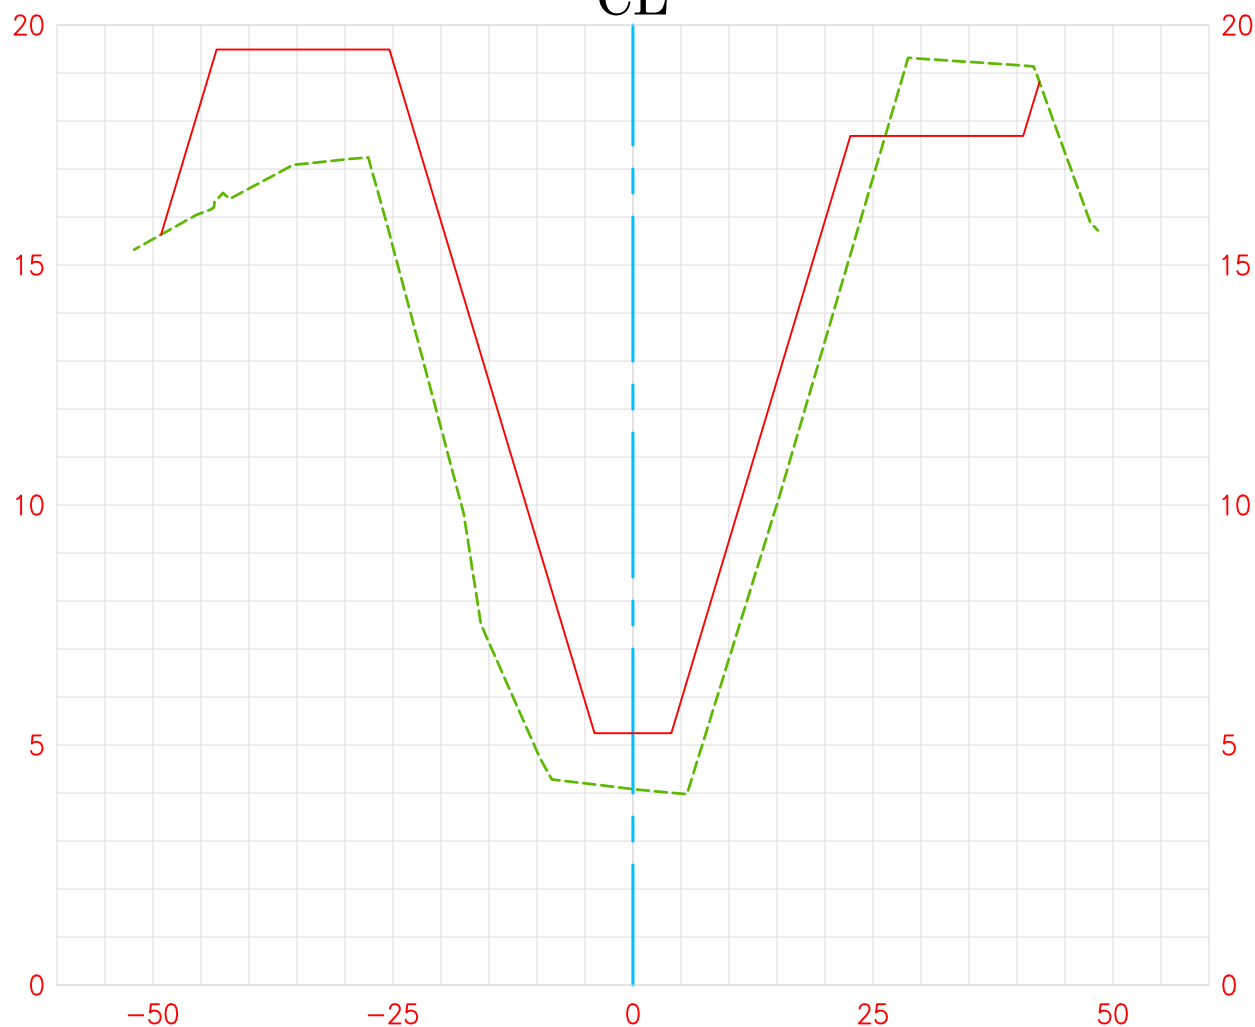

2019 Channel Survey
As-Built Plan




107+00.00

Vert. Scale: 1"=5'
Hor. Scale: 1"=20'

FAIRVIEW CHANNEL (D04)

CL

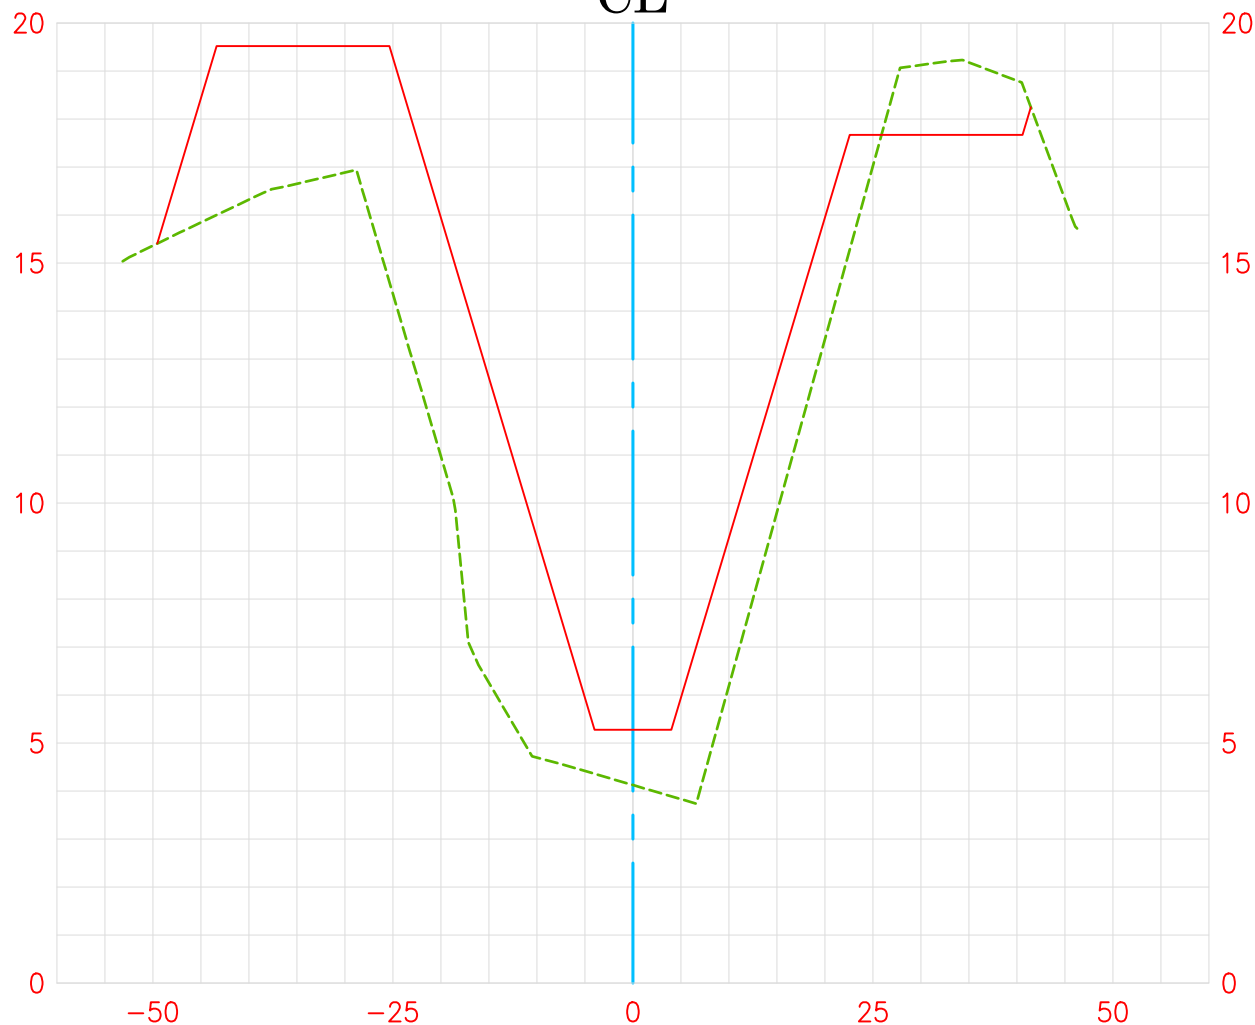

2019 Channel Survey
As-Built Plan




107+50.00

Vert. Scale: 1"=5'
Hor. Scale: 1"=20'

FAIRVIEW CHANNEL (D04)

CL

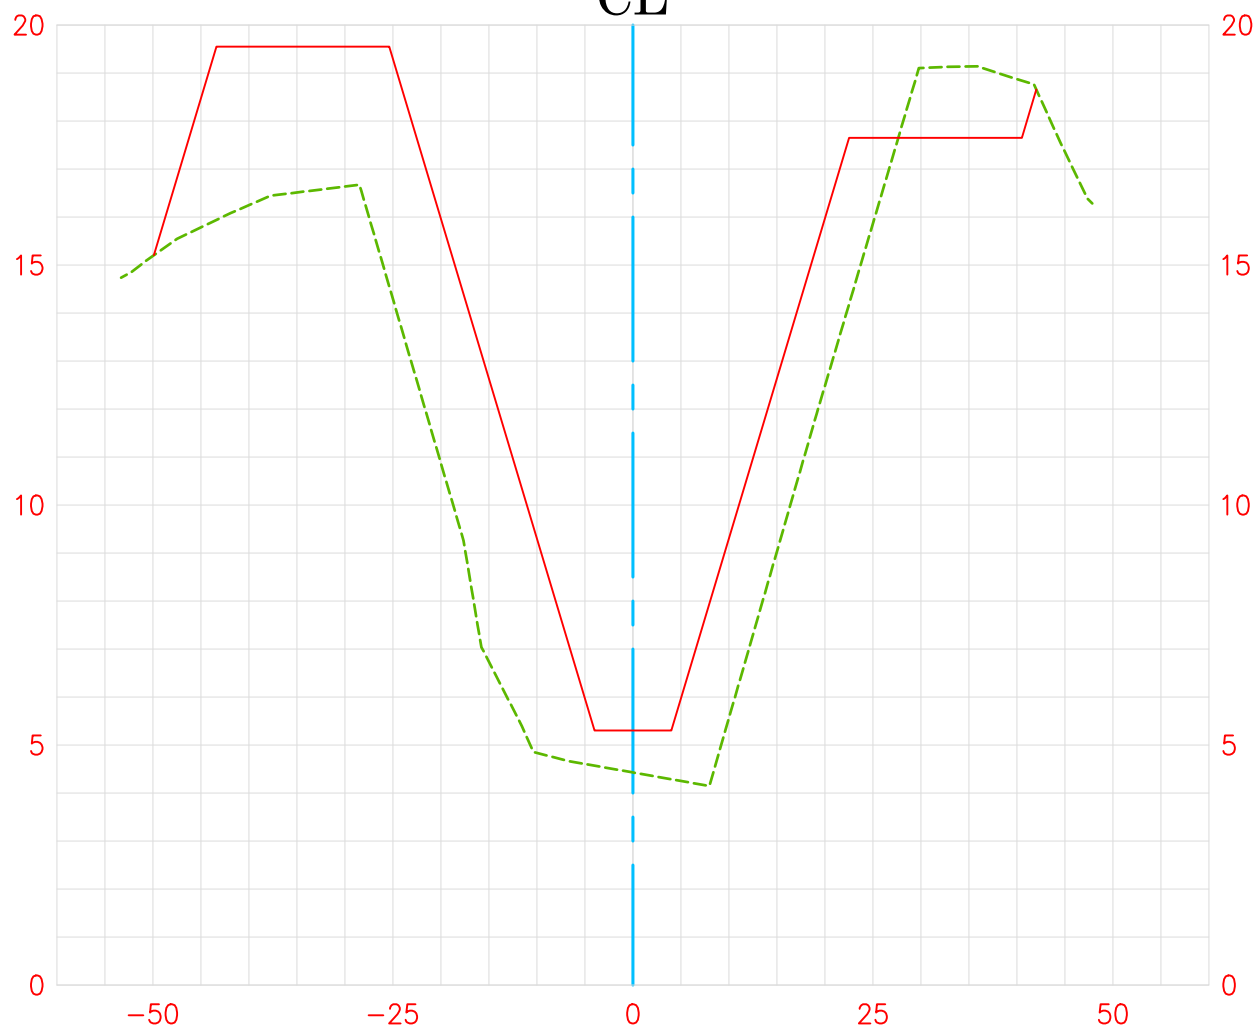

2019 Channel Survey
As-Built Plan




108+00.00

Vert. Scale: 1"=5'
Hor. Scale: 1"=20'

FAIRVIEW CHANNEL (D04)

CL

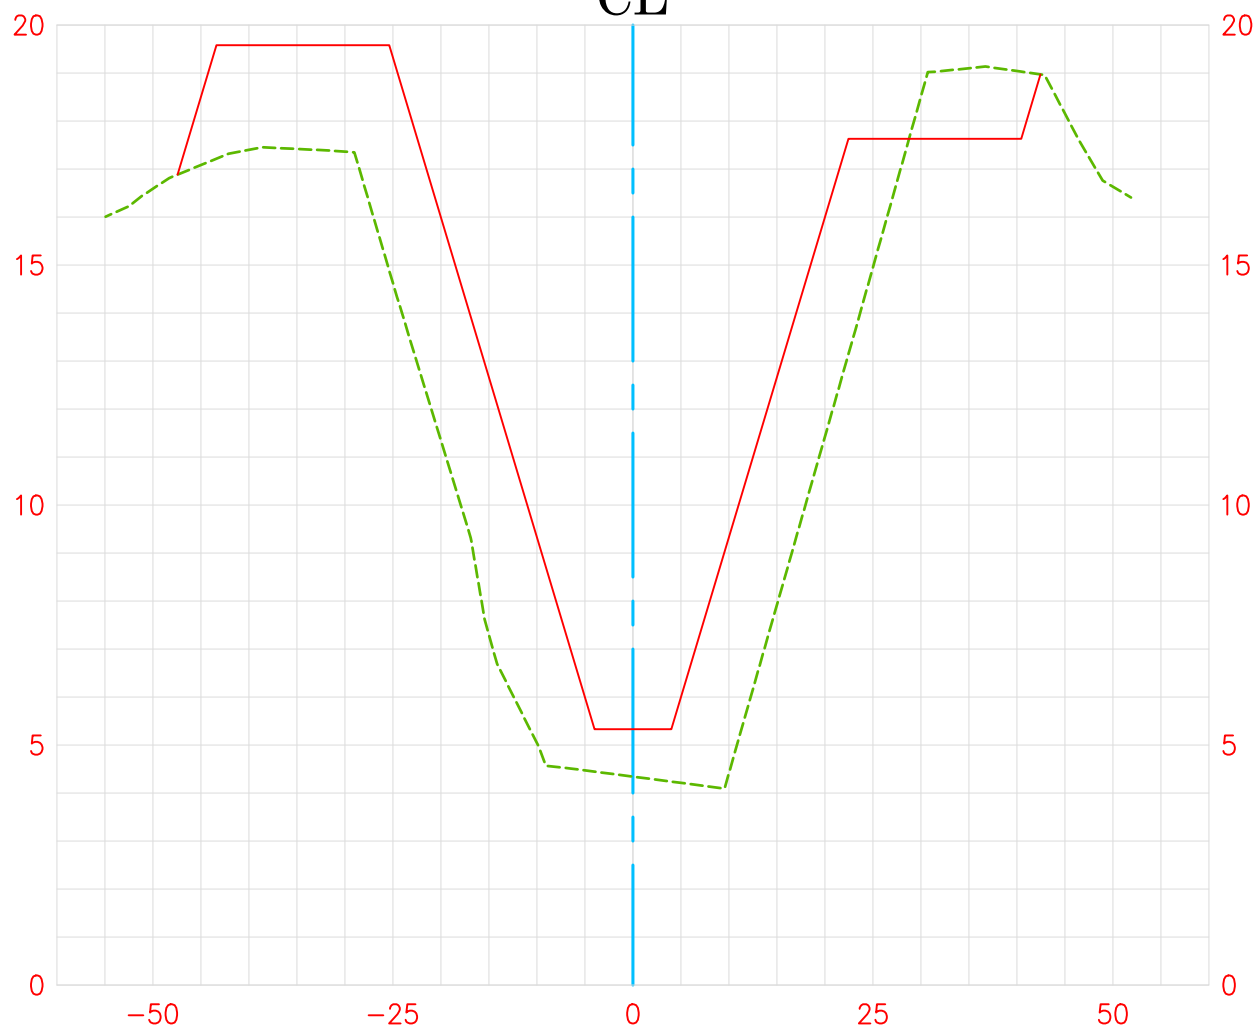

2019 Channel Survey
As-Built Plan




108+50.00

Vert. Scale: 1"=5'
Hor. Scale: 1"=20'



FAIRVIEW CHANNEL (D04) CL

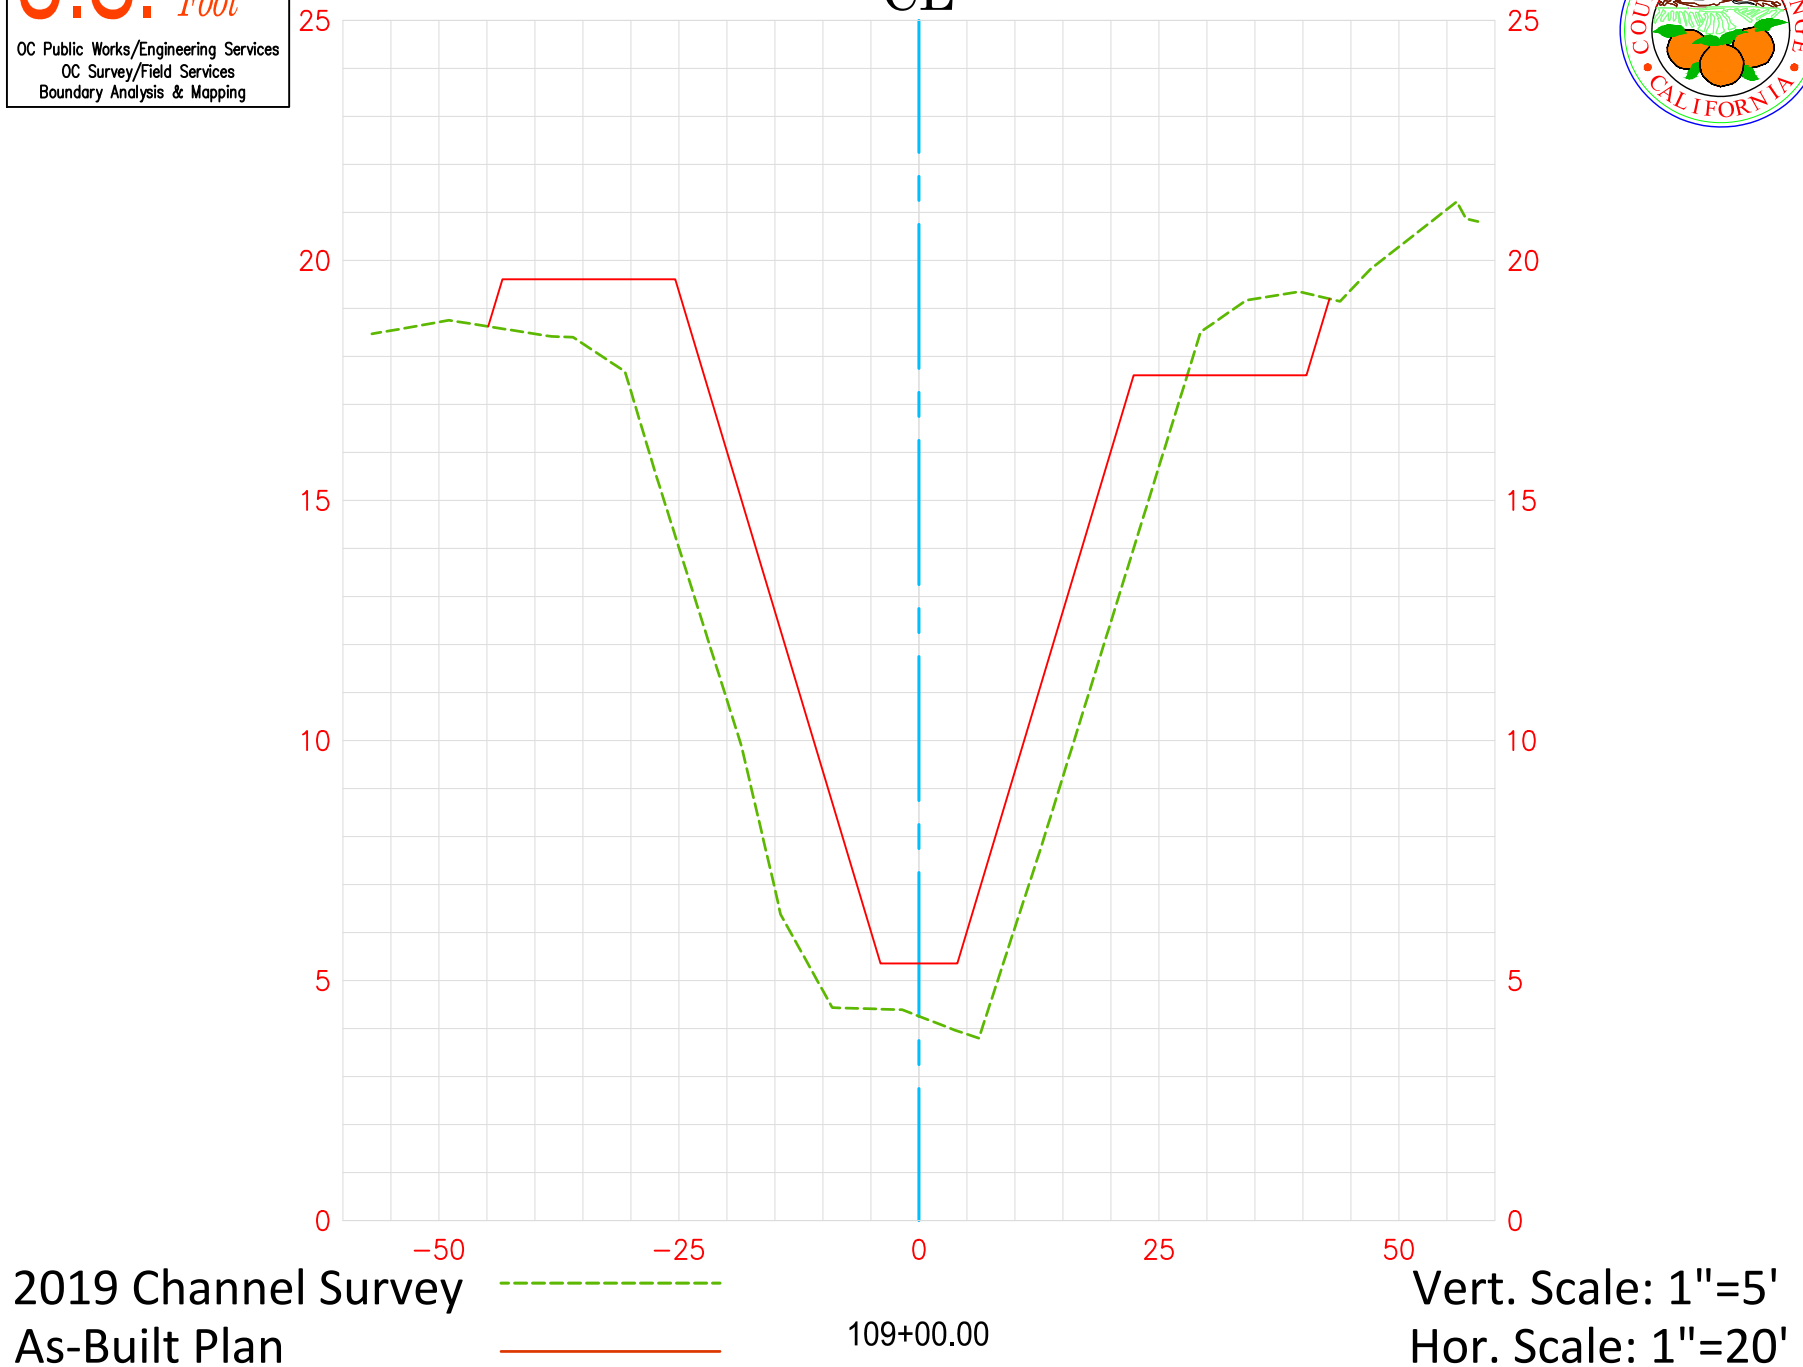




FAIRVIEW CHANNEL (D04) CL



2019 Channel Survey
As-Built Plan

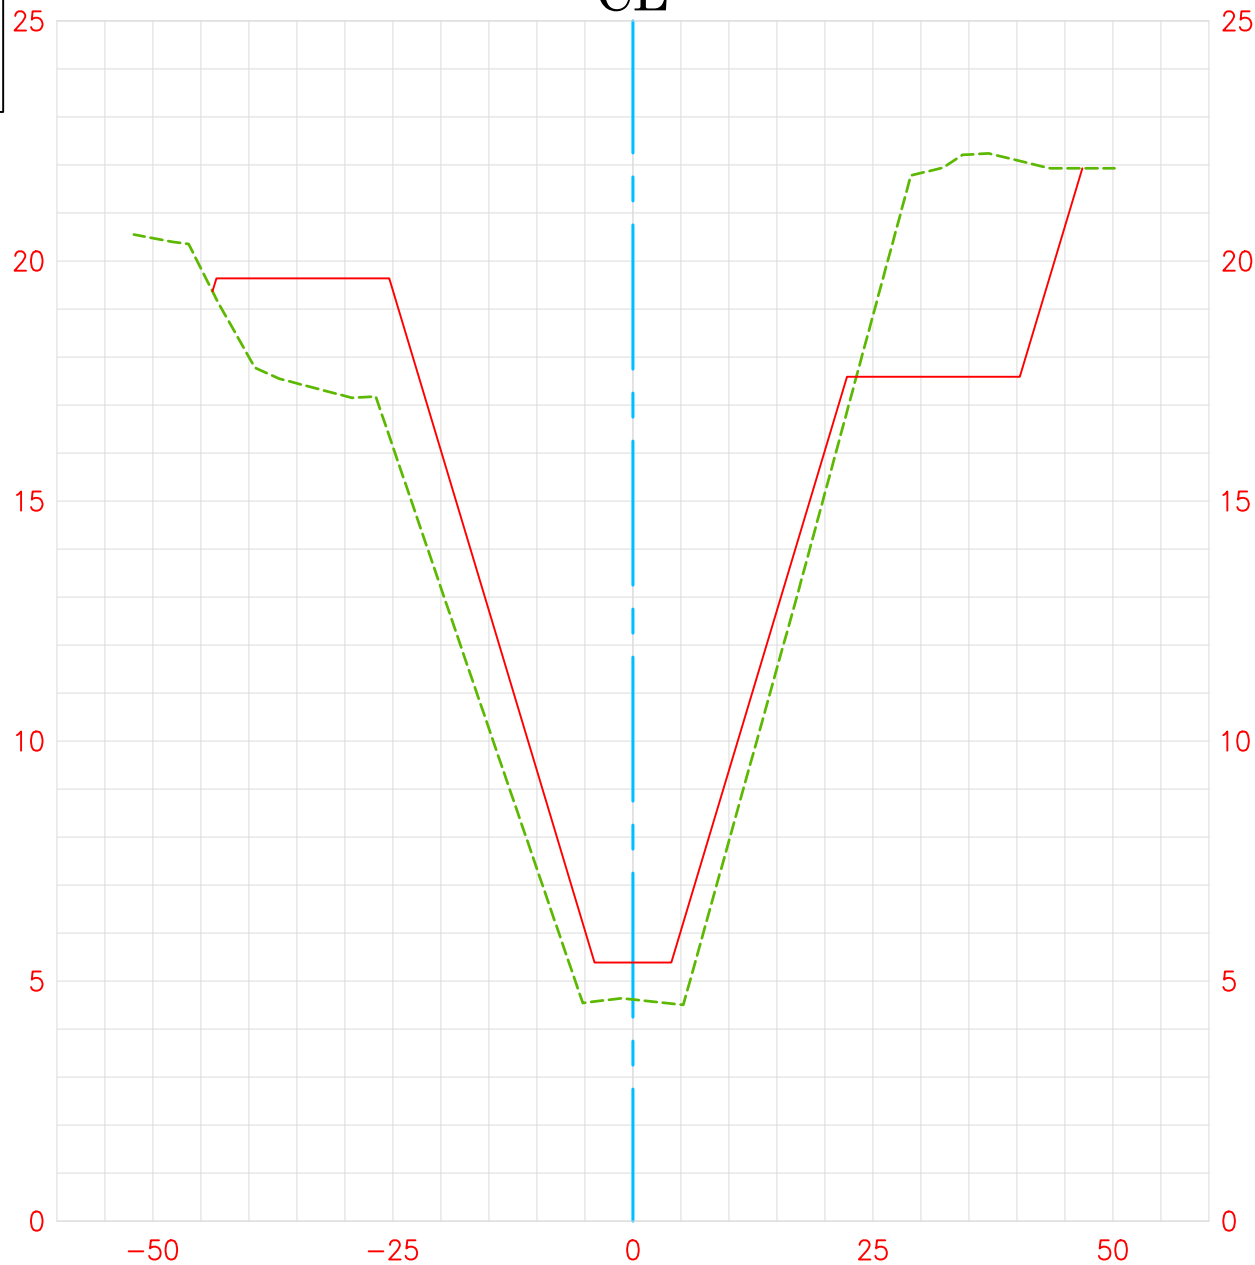


109+50.00

Vert. Scale: 1"=5'
Hor. Scale: 1"=20'



FAIRVIEW CHANNEL (D04) CL

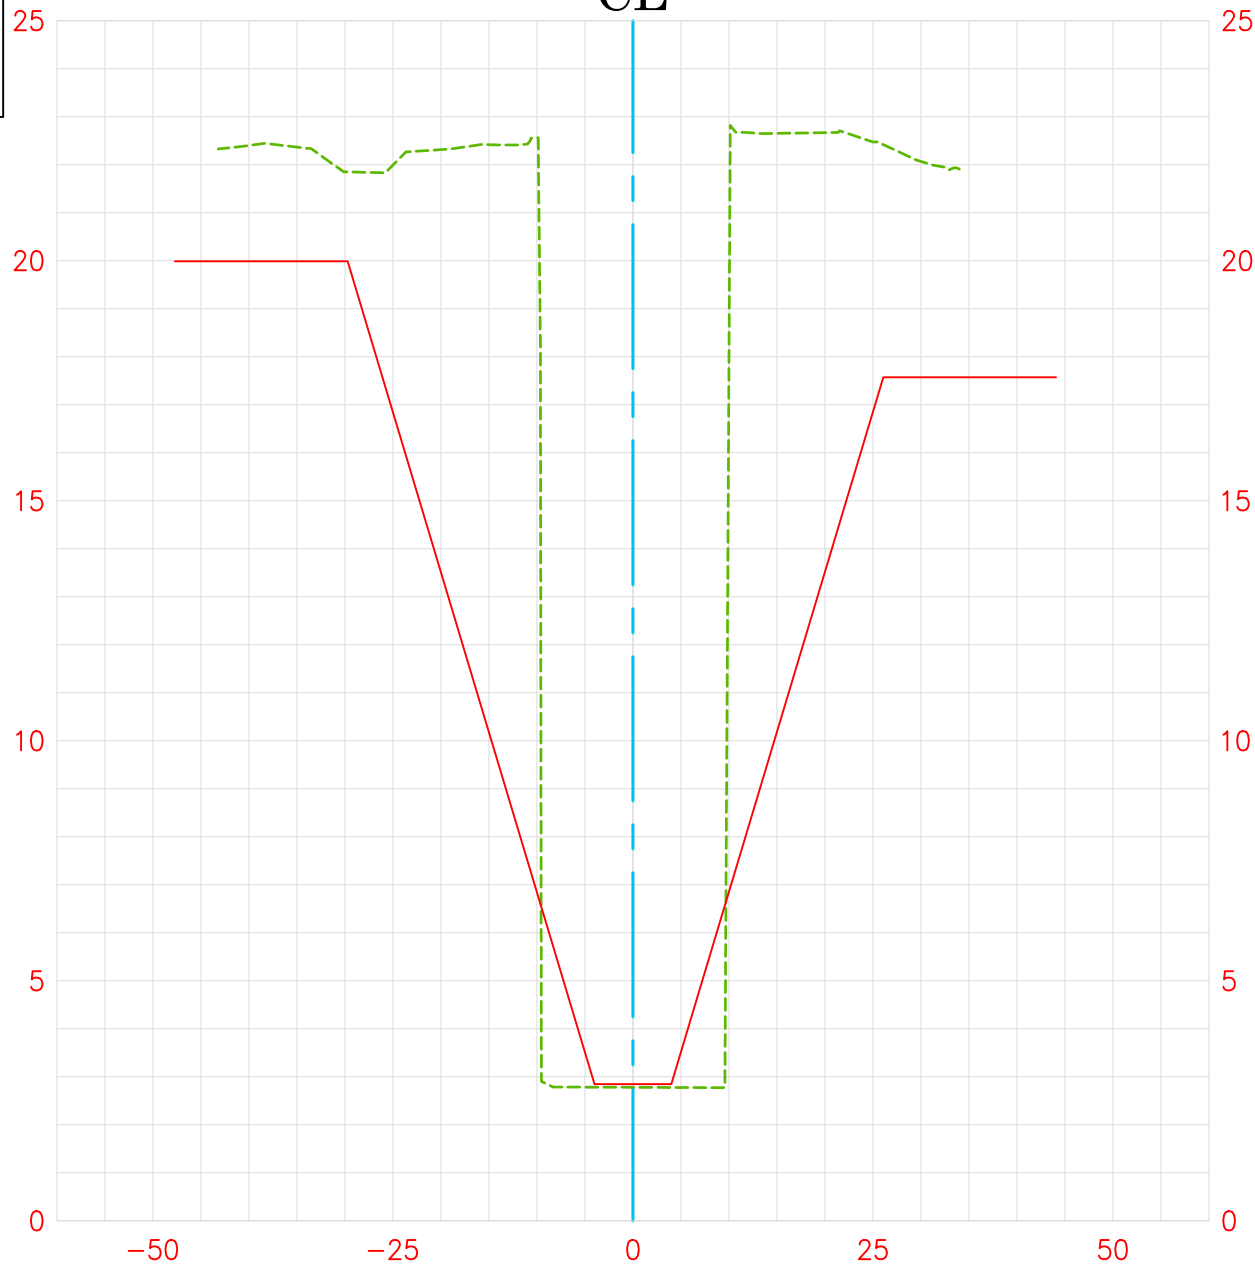

2019 Channel Survey
As-Built Plan



109+87.00

Vert. Scale: 1"=5'
Hor. Scale: 1"=20'