



OC PUBLIC WORKS DEPARTMENT

JAMES TREADAWAY, DIRECTOR OF PUBLIC WORKS

KEVIN HILLS, COUNTY SURVEYOR



FOUNTAIN VALLEY CHANNEL REHABILITATION

SECTIONS WERE DERIVED FROM RECORD AS-BUILT PLAN D05-101-7R MAY, 2020
BETWEEN STATIONS 38+01.30 TO 61+91.24 / 63+92.92 TO 81+00.40
AND O.C.S TOPOGRAPHIC SURVEY DATED SEPTEMBER, 2020.

THIS DOCUMENT IS SUPPLEMENTAL TO THE TOPOGRAPHIC SURVEY MAP DATED SEPTEMBER, 2020.

PROJECT CROSS SECTIONS

**U.S. Survey
Foot**


OC Public Works
OC Survey/Field Services
Boundary Analysis & Mapping



FOUNTAIN VALLEY CHANNEL (D05)

38+01.30

CL

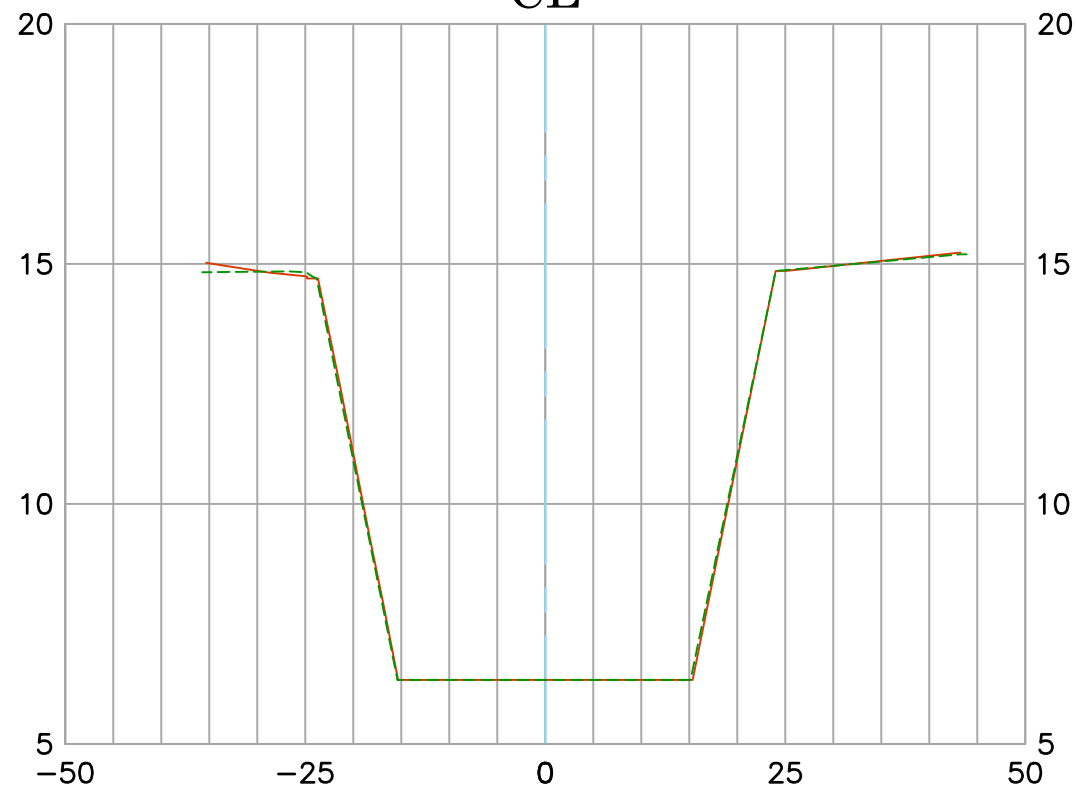

Existing Condition 2020
Record Drawing D05-101-7R

Date Prepared: 09/16/2020

Vert. Scale: 1"=4'
Hor. Scale: 1"=20'

U.S. Survey Foot


OC Public Works
OC Survey/Field Services
Boundary Analysis & Mapping



FOUNTAIN VALLEY CHANNEL (D05)

38+50.00

CL

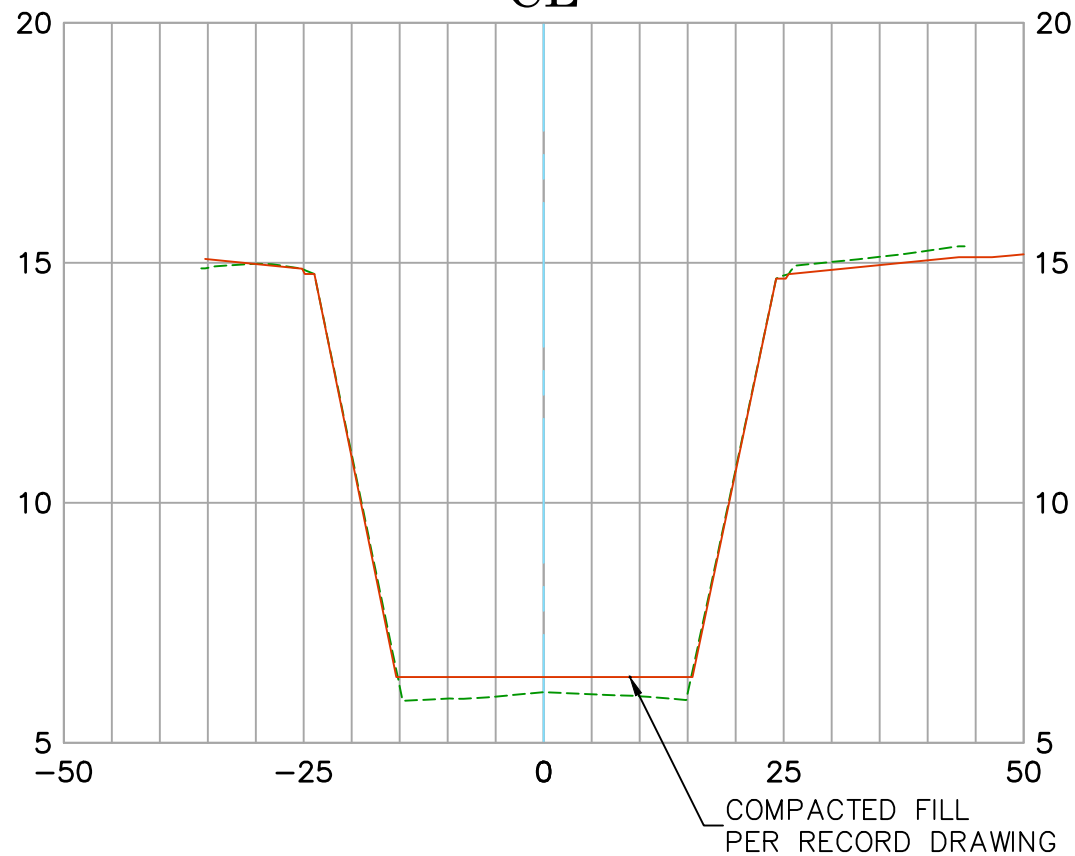

Existing Condition 2020
Record Drawing D05-101-7R

Date Prepared: 09/16/2020

Vert. Scale: 1"=4'
Hor. Scale: 1"=20'

**U.S. Survey
Foot**


OC Public Works
OC Survey/Field Services
Boundary Analysis & Mapping



FOUNTAIN VALLEY CHANNEL (D05)

39+00.00

CL

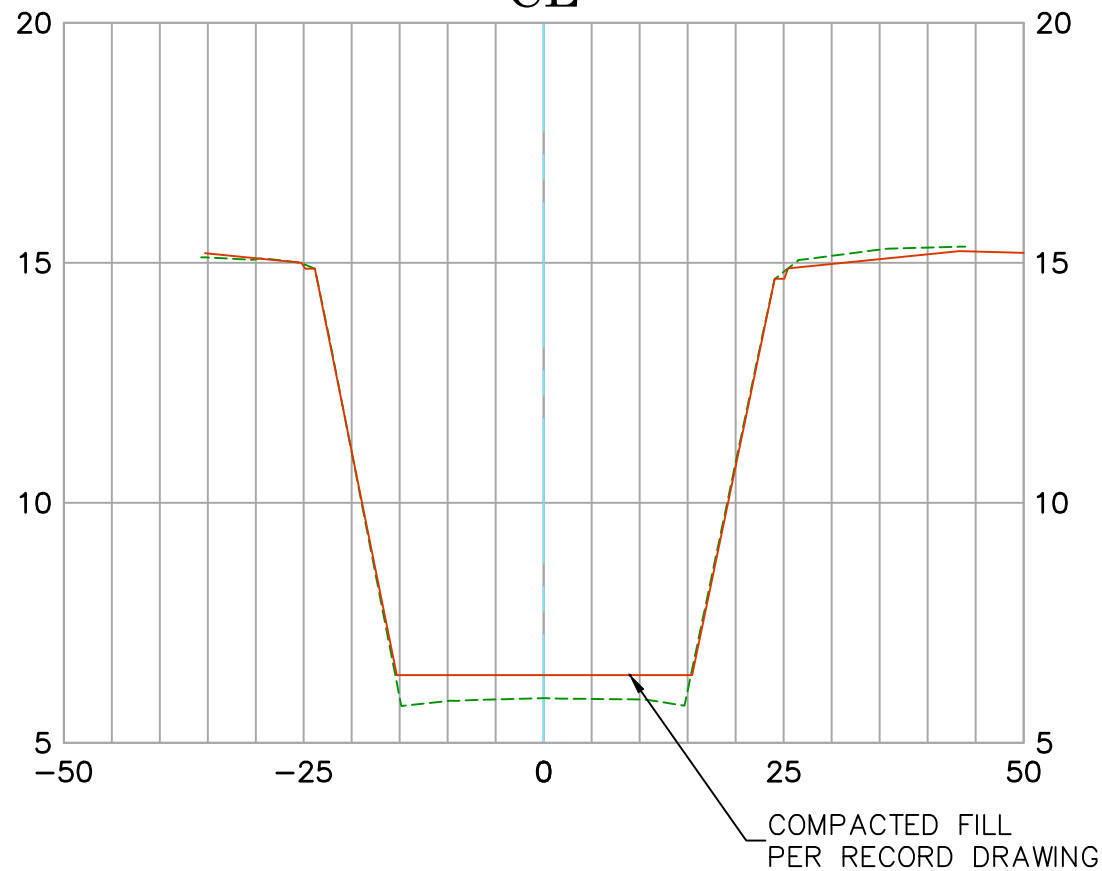

Existing Condition 2020
Record Drawing D05-101-7R

Date Prepared: 09/16/2020

Vert. Scale: 1"=4'
Hor. Scale: 1"=20'

**U.S. Survey
Foot**


OC Public Works
OC Survey/Field Services
Boundary Analysis & Mapping



FOUNTAIN VALLEY CHANNEL (D05)

39+50.00

CL

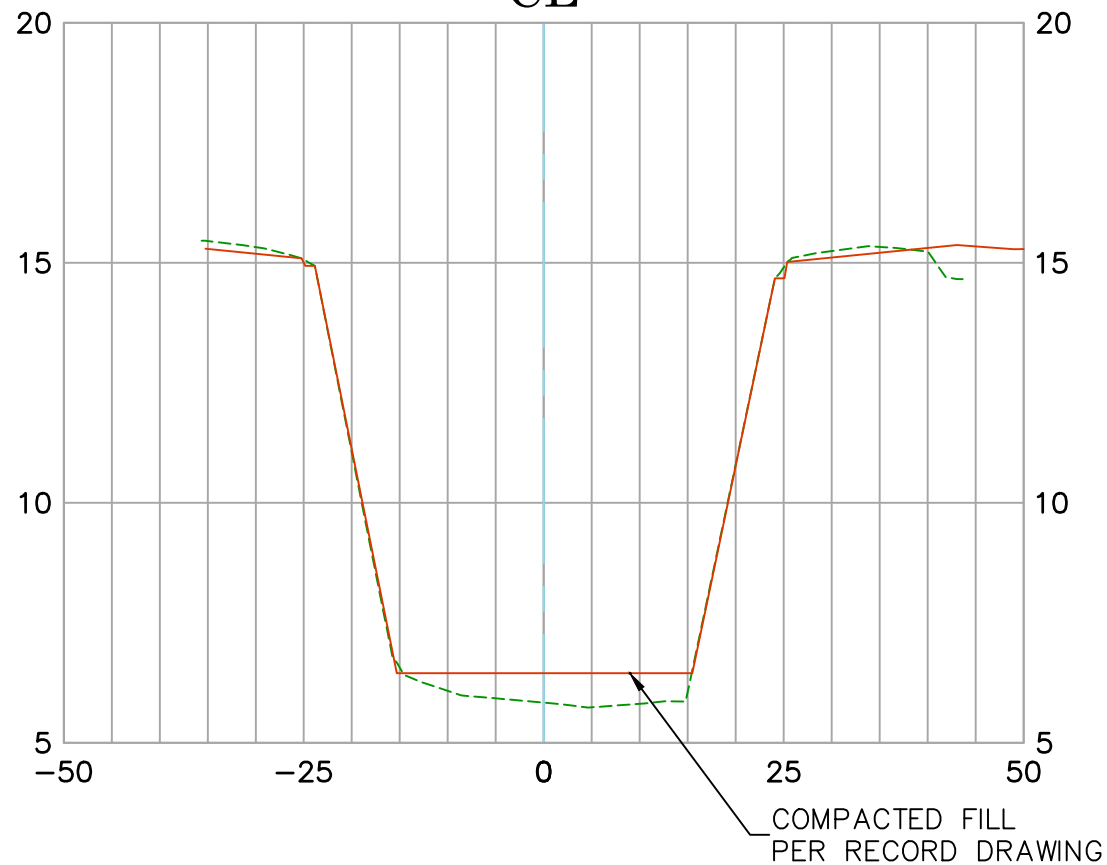

Existing Condition 2020
Record Drawing D05-101-7R

Date Prepared: 09/16/2020

Vert. Scale: 1"=4'
Hor. Scale: 1"=20'

U.S. Survey Foot


OC Public Works
OC Survey/Field Services
Boundary Analysis & Mapping



FOUNTAIN VALLEY CHANNEL (D05)

40+00.00

CL

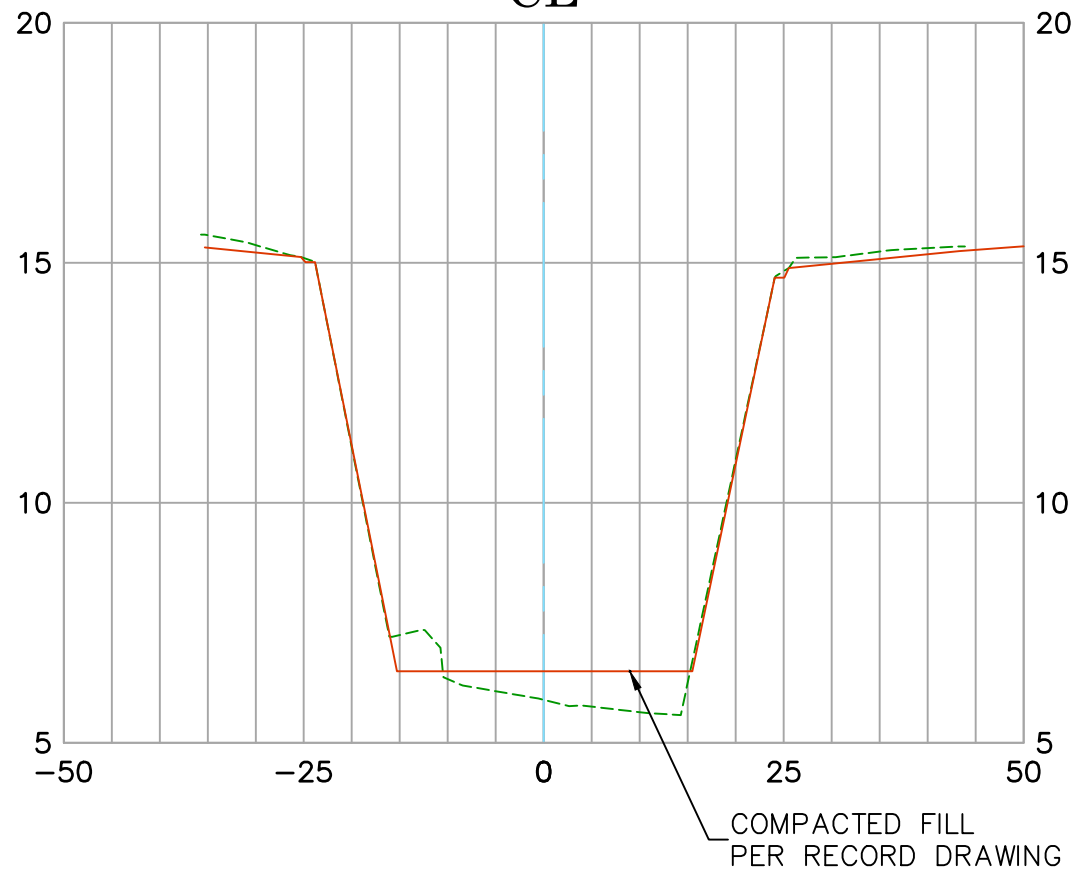

Existing Condition 2020
Record Drawing D05-101-7R

Date Prepared: 09/16/2020


Vert. Scale: 1"=4'
Hor. Scale: 1"=20'



FOUNTAIN VALLEY CHANNEL (D05)

40+50.00

CL

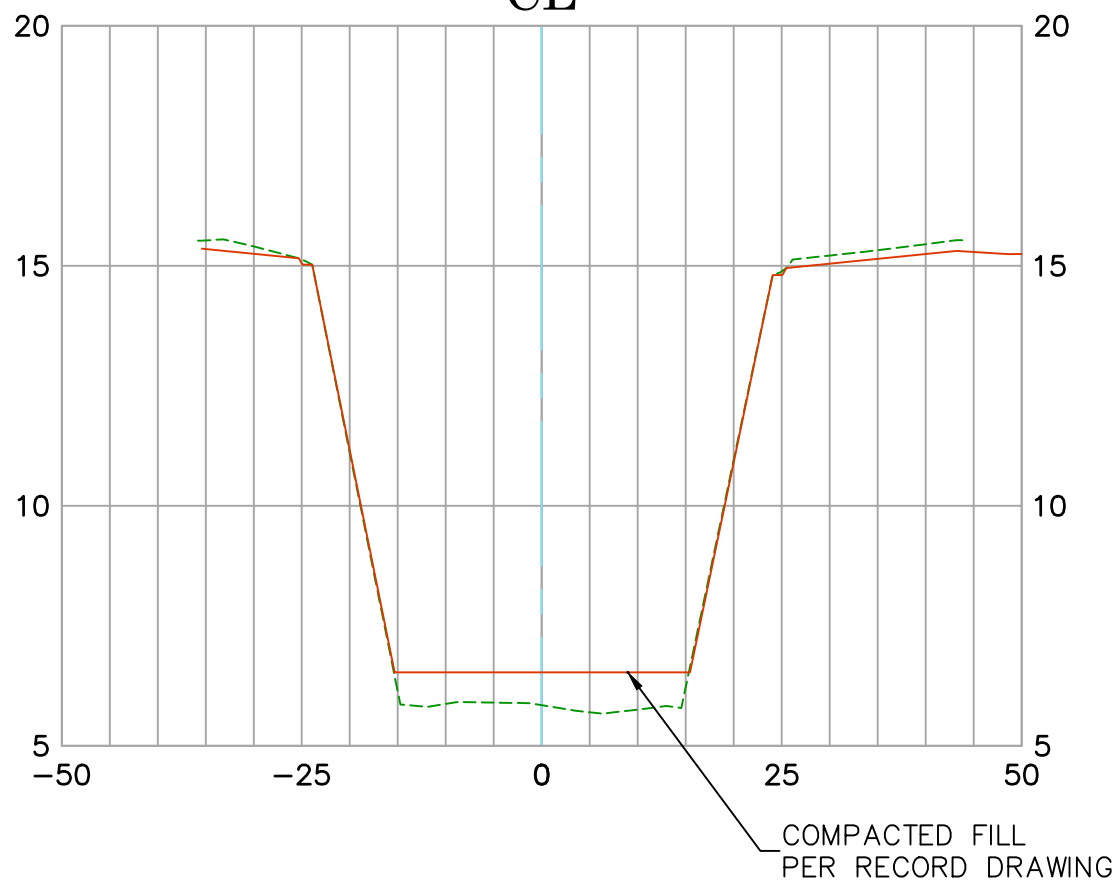

Existing Condition 2020
 Record Drawing D05-101-7R

Date Prepared: 09/16/2020

Vert. Scale: 1"=4'
 Hor. Scale: 1"=20'

**U.S. Survey
Foot**


OC Public Works
OC Survey/Field Services
Boundary Analysis & Mapping



FOUNTAIN VALLEY CHANNEL (D05)

41+00.00

CL

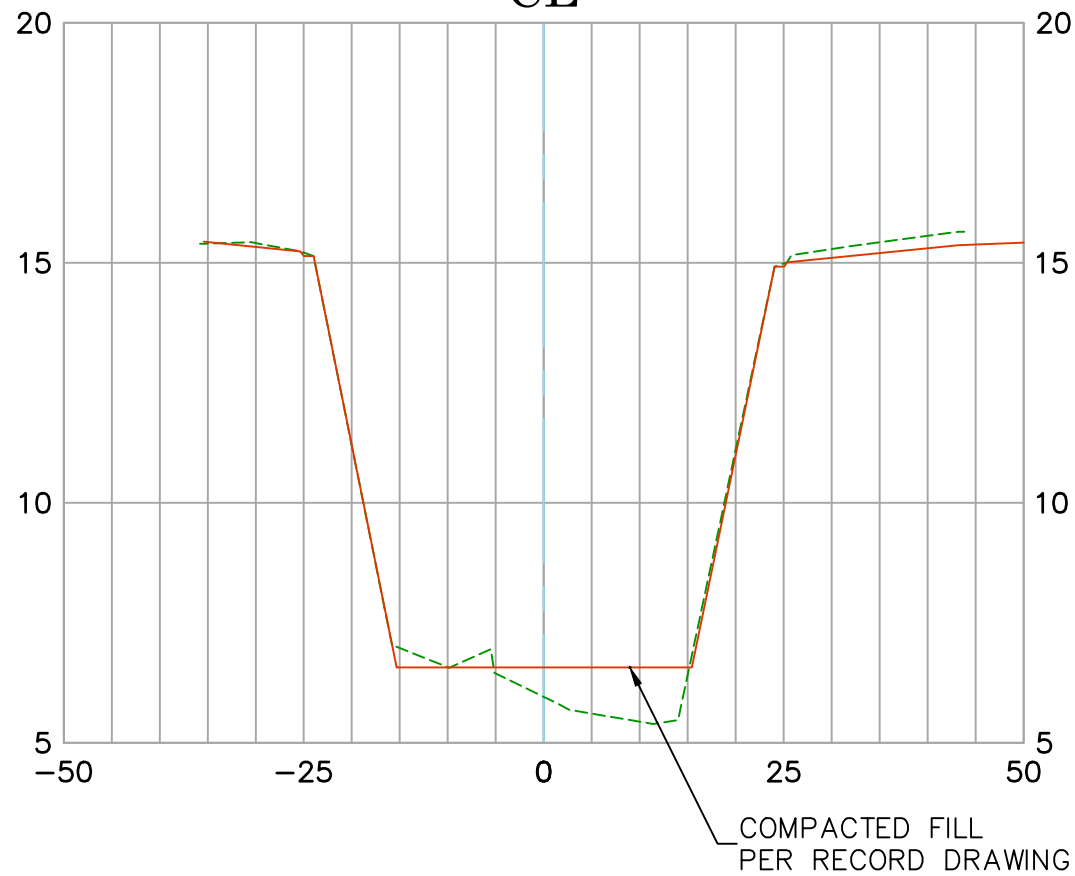

Existing Condition 2020
Record Drawing D05-101-7R

Date Prepared: 09/16/2020

Vert. Scale: 1"=4'
Hor. Scale: 1"=20'


U.S. Survey Foot

OC Public Works
OC Survey/Field Services
Boundary Analysis & Mapping

FOUNTAIN VALLEY CHANNEL (D05)

41+50.00

CL

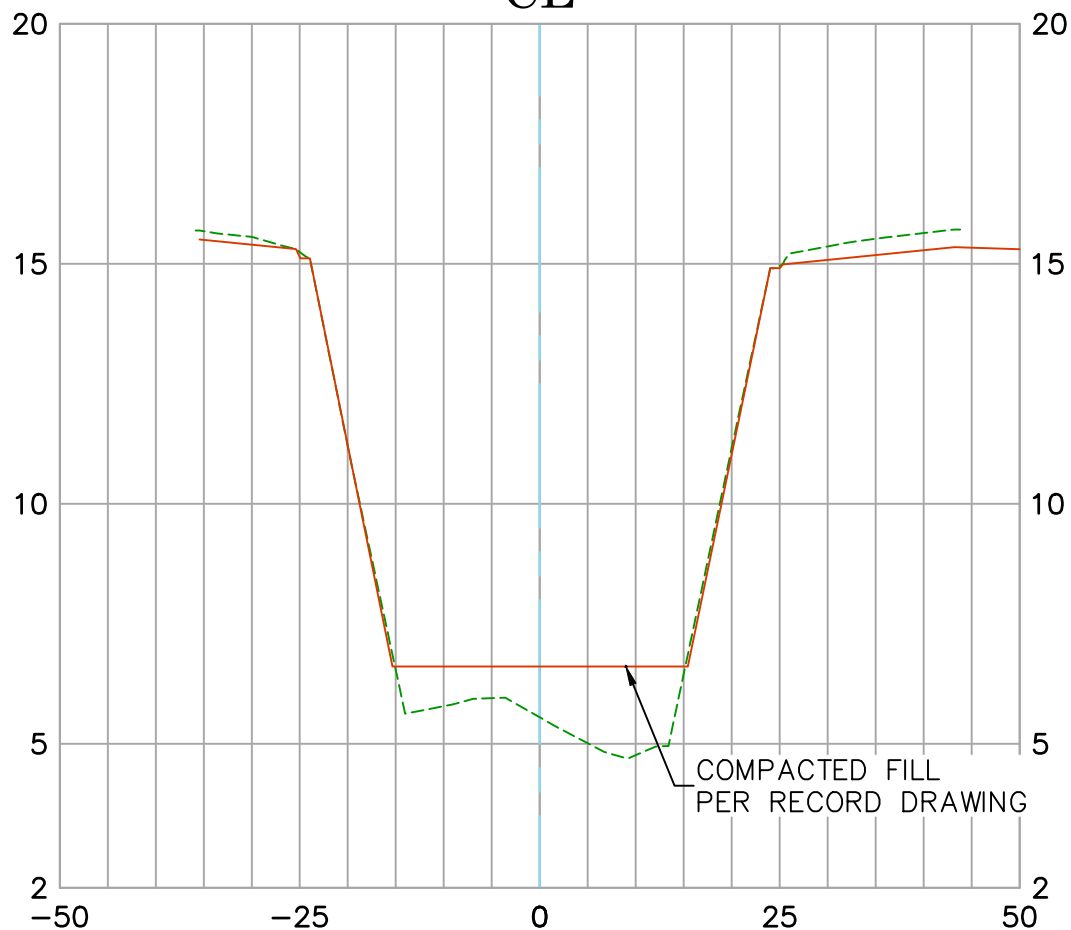

Existing Condition 2020
Record Drawing D05-101-7R

Date Prepared: 09/16/2020

Vert. Scale: 1"=4'
Hor. Scale: 1"=20'

U.S. Survey Foot


OC Public Works
OC Survey/Field Services
Boundary Analysis & Mapping



FOUNTAIN VALLEY CHANNEL (D05)

42+00.00

CL

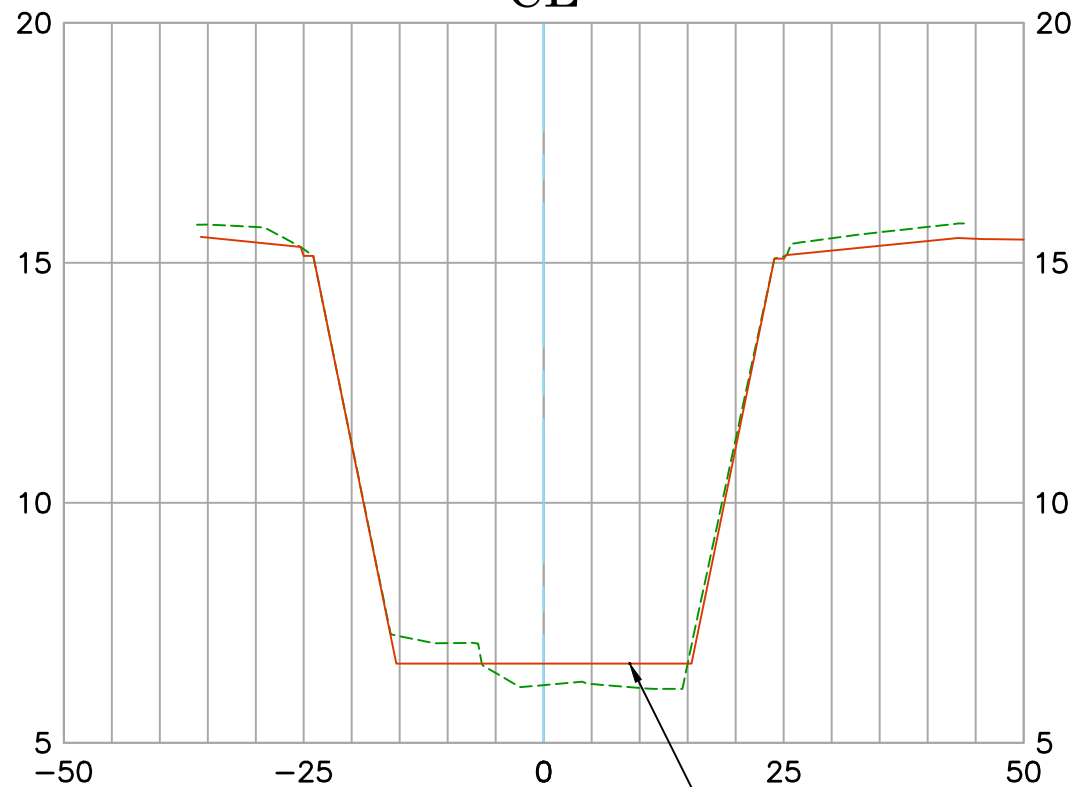

Existing Condition 2020
Record Drawing D05-101-7R

Date Prepared: 09/16/2020

COMPACTED FILL
PER RECORD DRAWING


Vert. Scale: 1"=4'
Hor. Scale: 1"=20'



FOUNTAIN VALLEY CHANNEL (D05)

42+50.00

CL

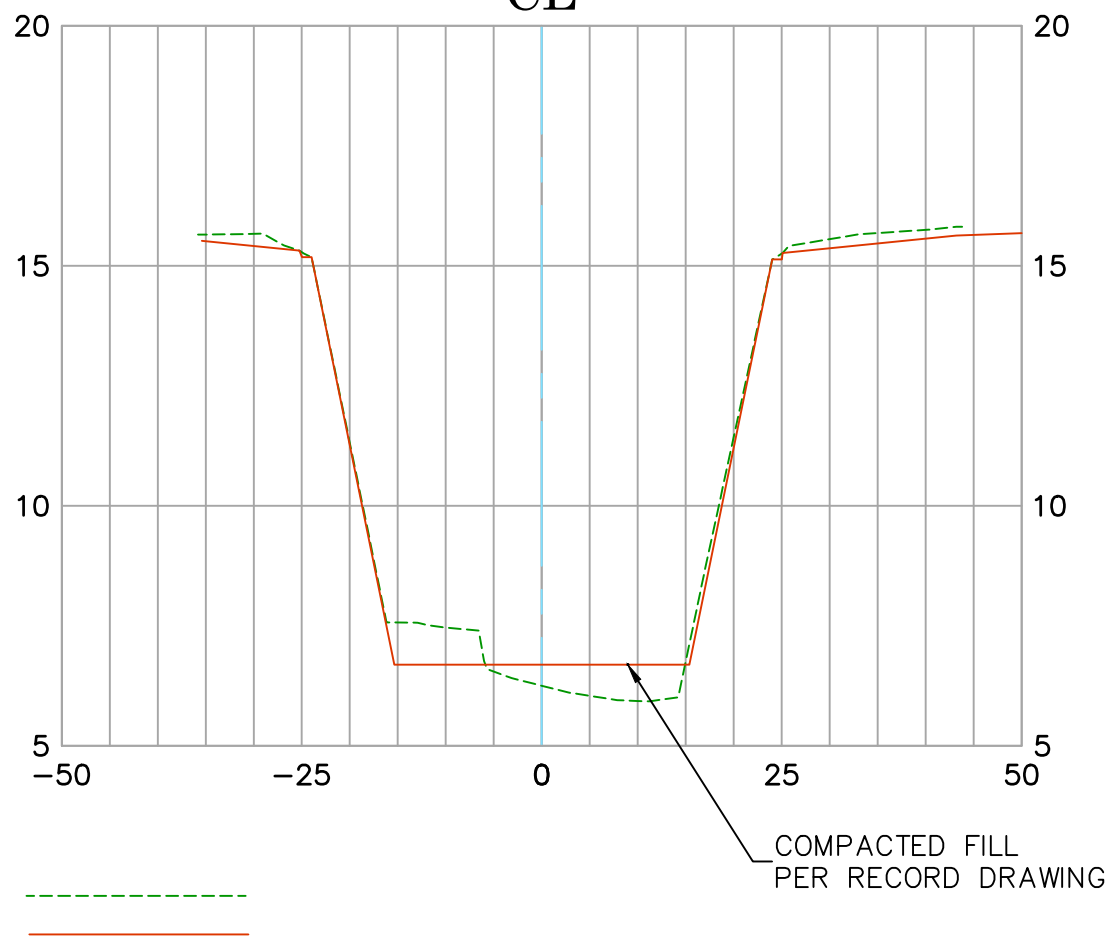

Existing Condition 2020
 Record Drawing D05-101-7R

Date Prepared: 09/16/2020

Vert. Scale: 1"=4'
 Hor. Scale: 1"=20'

U.S. Survey Foot


OC Public Works
OC Survey/Field Services
Boundary Analysis & Mapping



FOUNTAIN VALLEY CHANNEL (D05)

43+00.00

CL

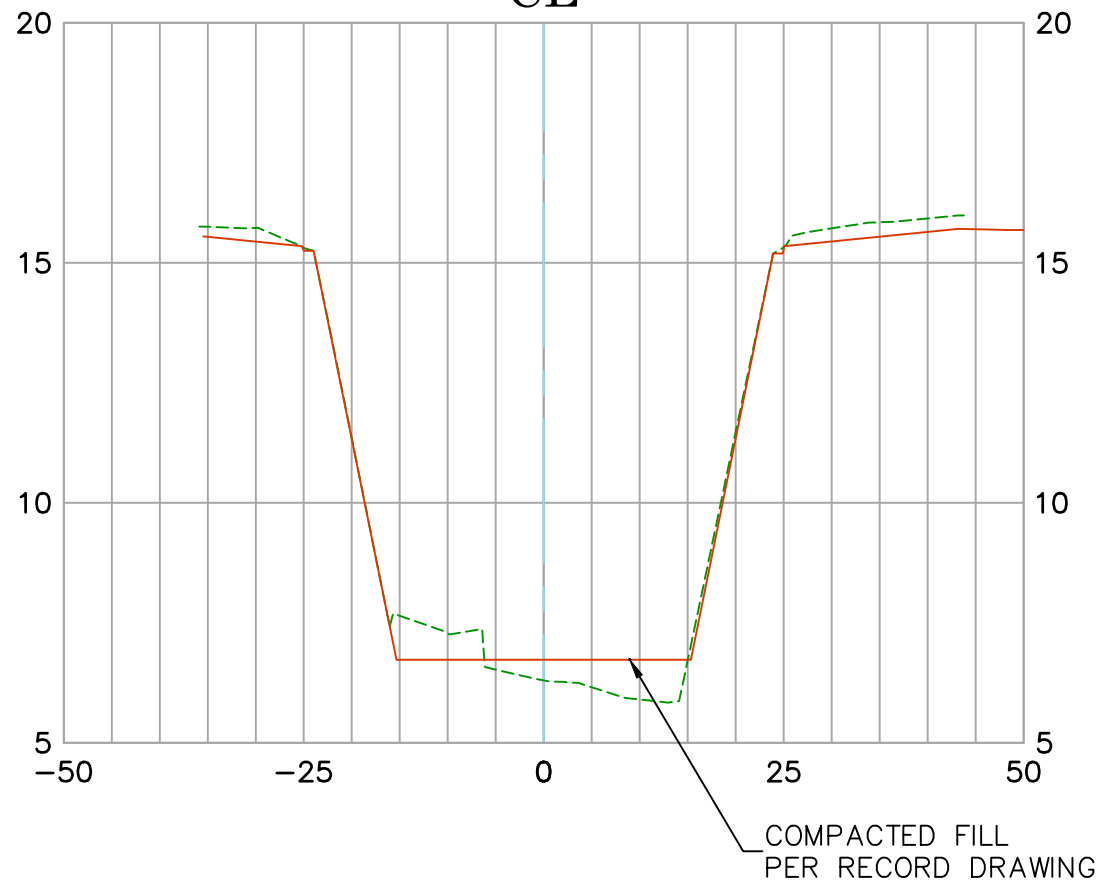

Existing Condition 2020
Record Drawing D05-101-7R

Date Prepared: 09/16/2020


Vert. Scale: 1"=4'
Hor. Scale: 1"=20'



FOUNTAIN VALLEY CHANNEL (D05)

43+50.00

CL

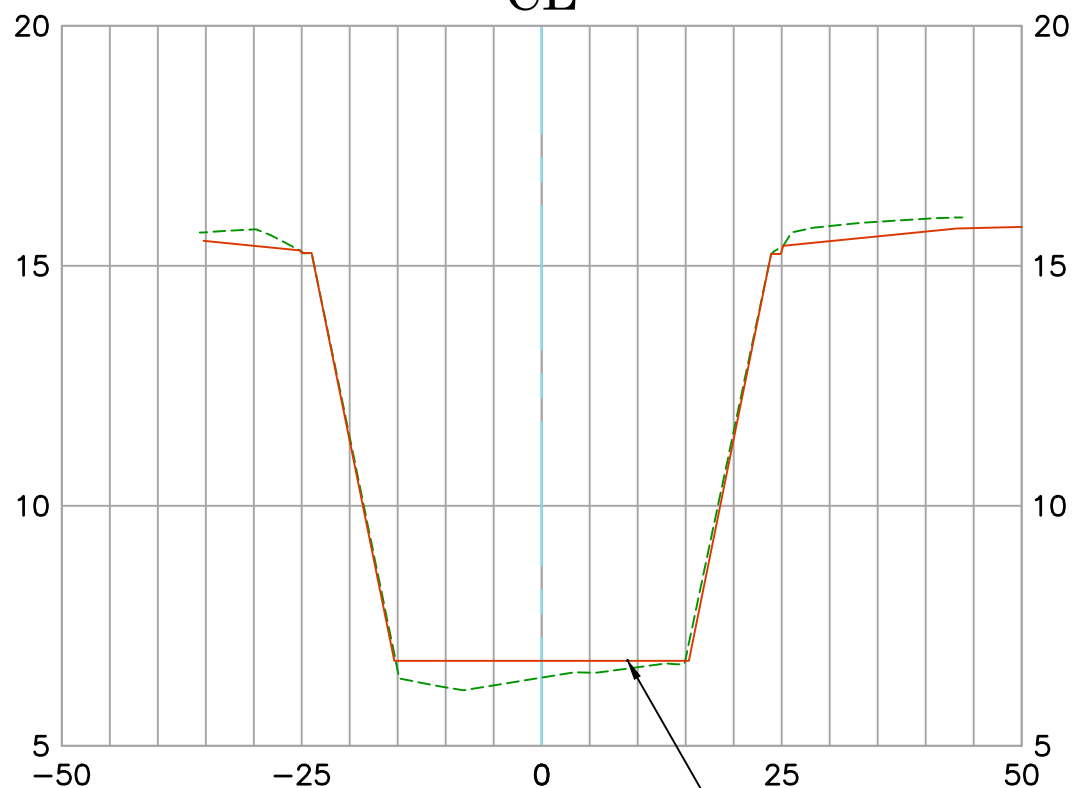

Existing Condition 2020
 Record Drawing D05-101-7R

Date Prepared: 09/16/2020

COMPACTED FILL
 PER RECORD DRAWING

Vert. Scale: 1"=4'
 Hor. Scale: 1"=20'

**U.S. Survey
Foot**


OC Public Works
OC Survey/Field Services
Boundary Analysis & Mapping



FOUNTAIN VALLEY CHANNEL (D05)

44+00.00

CL

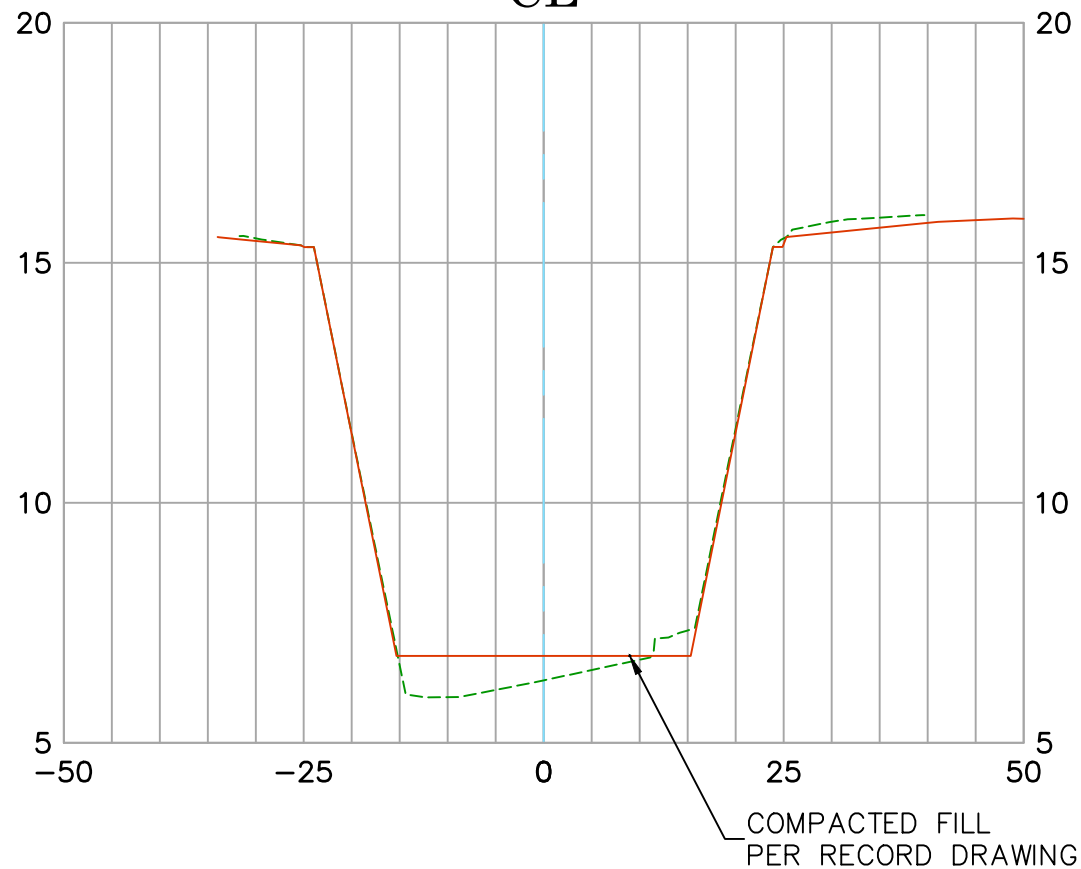

Existing Condition 2020
Record Drawing D05-101-7R

Date Prepared: 09/16/2020

Vert. Scale: 1"=4'
Hor. Scale: 1"=20'

U.S. Survey Foot


OC Public Works
OC Survey/Field Services
Boundary Analysis & Mapping



FOUNTAIN VALLEY CHANNEL (D05)


44+50.00

CL

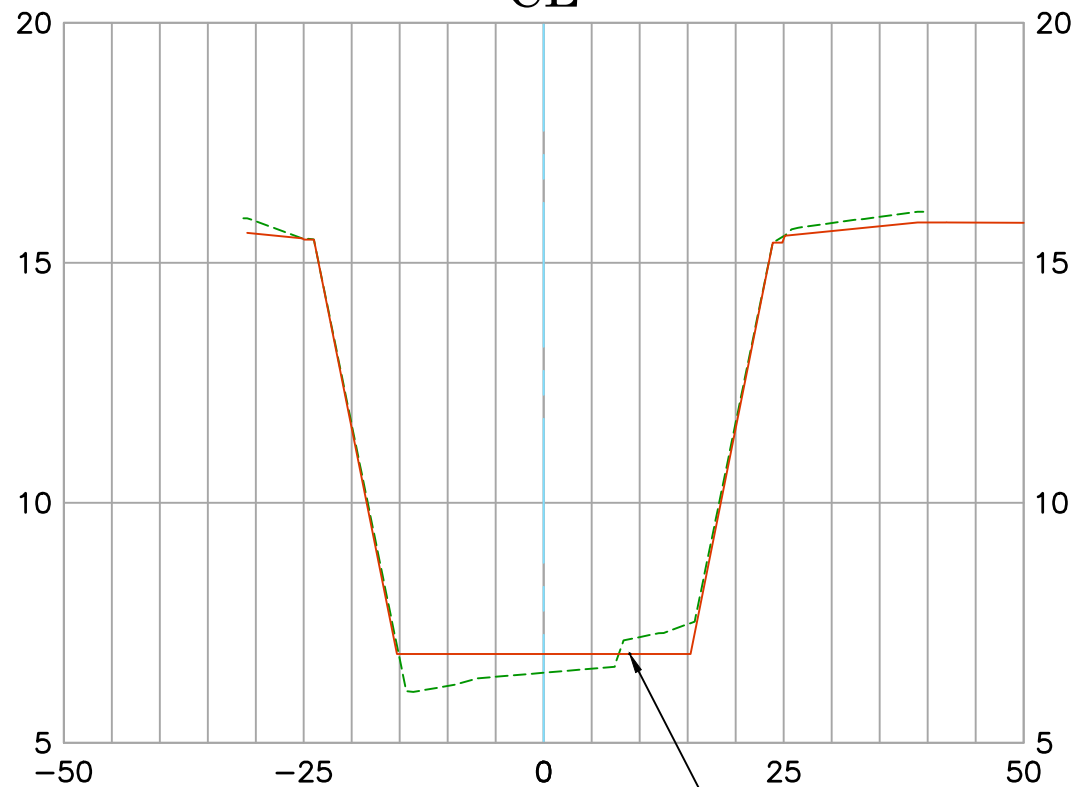

Existing Condition 2020
Record Drawing D05-101-7R

Date Prepared: 09/16/2020

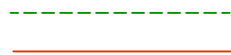

COMPACTED FILL
PER RECORD DRAWING

Vert. Scale: 1"=4'
Hor. Scale: 1"=20'

U.S. Survey Foot


OC Public Works
OC Survey/Field Services
Boundary Analysis & Mapping



FOUNTAIN VALLEY CHANNEL (D05)

45+00.00

CL

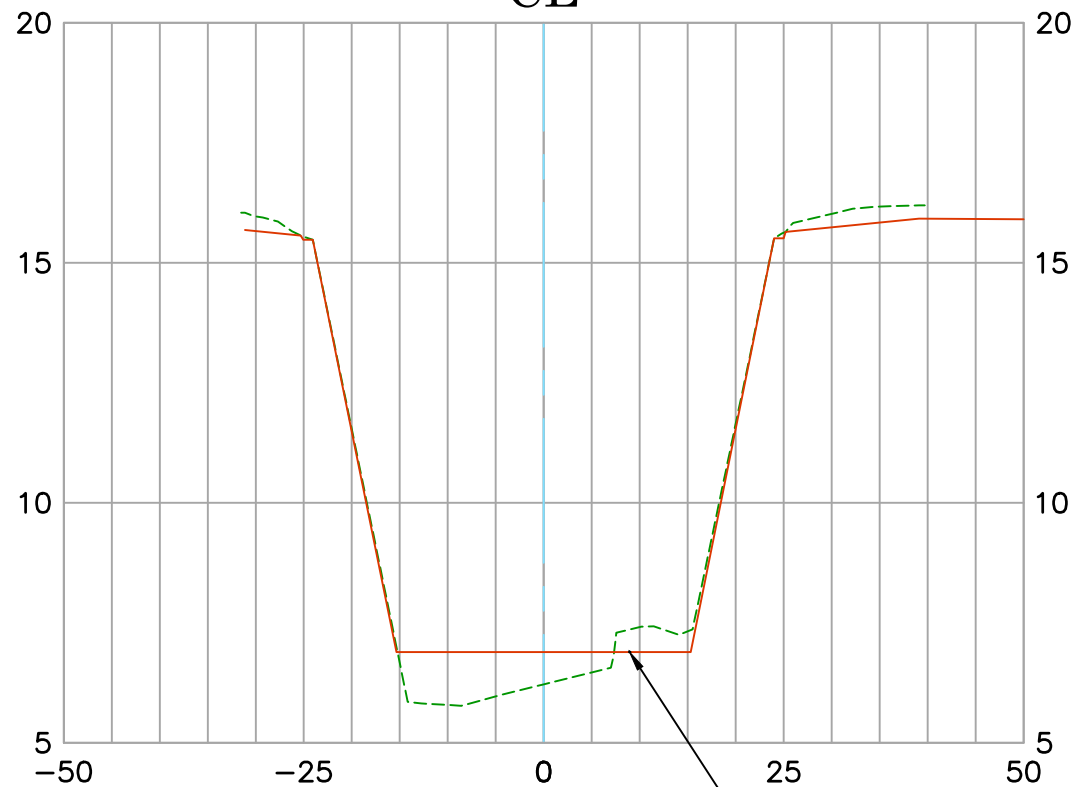

Existing Condition 2020
Record Drawing D05-101-7R

Date Prepared: 09/16/2020

--- Existing Condition 2020
— Channel Bed

COMPACTED FILL
PER RECORD DRAWING

Vert. Scale: 1"=4'
Hor. Scale: 1"=20'

U.S. Survey Foot


OC Public Works
OC Survey/Field Services
Boundary Analysis & Mapping



FOUNTAIN VALLEY CHANNEL (D05)

45+50.00

CL

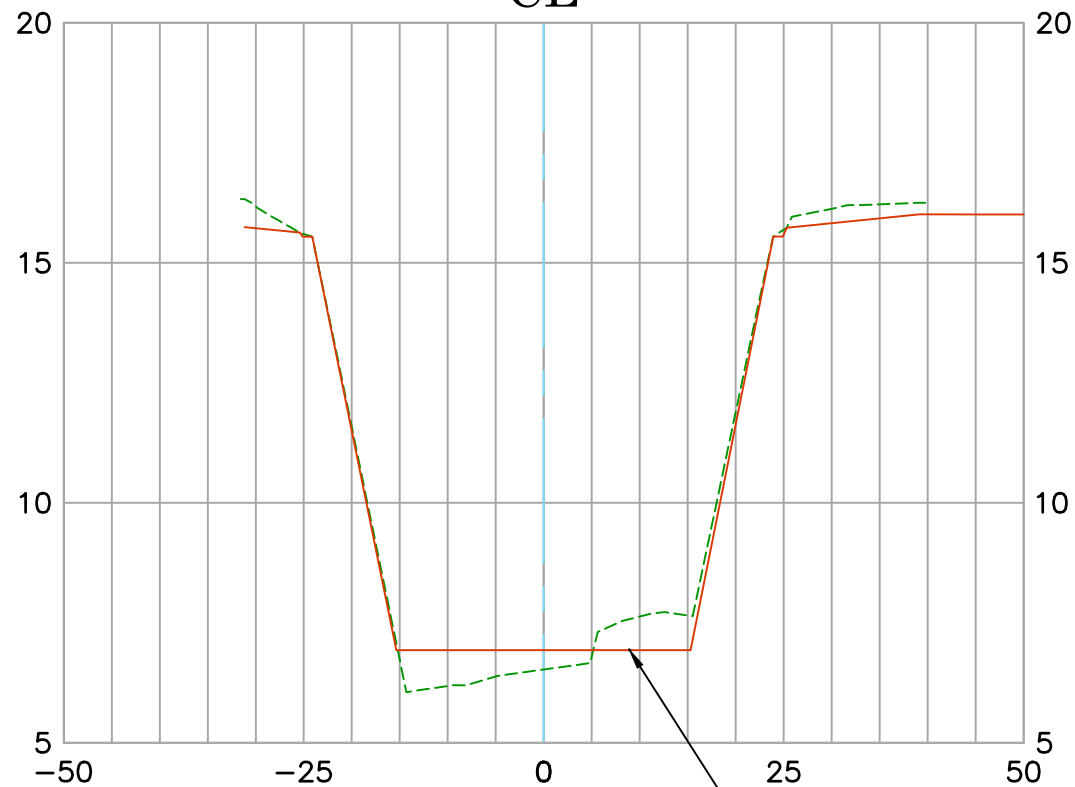

Existing Condition 2020
Record Drawing D05-101-7R

Date Prepared: 09/16/2020

COMPACTED FILL
PER RECORD DRAWING

Vert. Scale: 1"=4'
Hor. Scale: 1"=20'

U.S. Survey Foot


OC Public Works
OC Survey/Field Services
Boundary Analysis & Mapping



FOUNTAIN VALLEY CHANNEL (D05)

46+00.00

CL

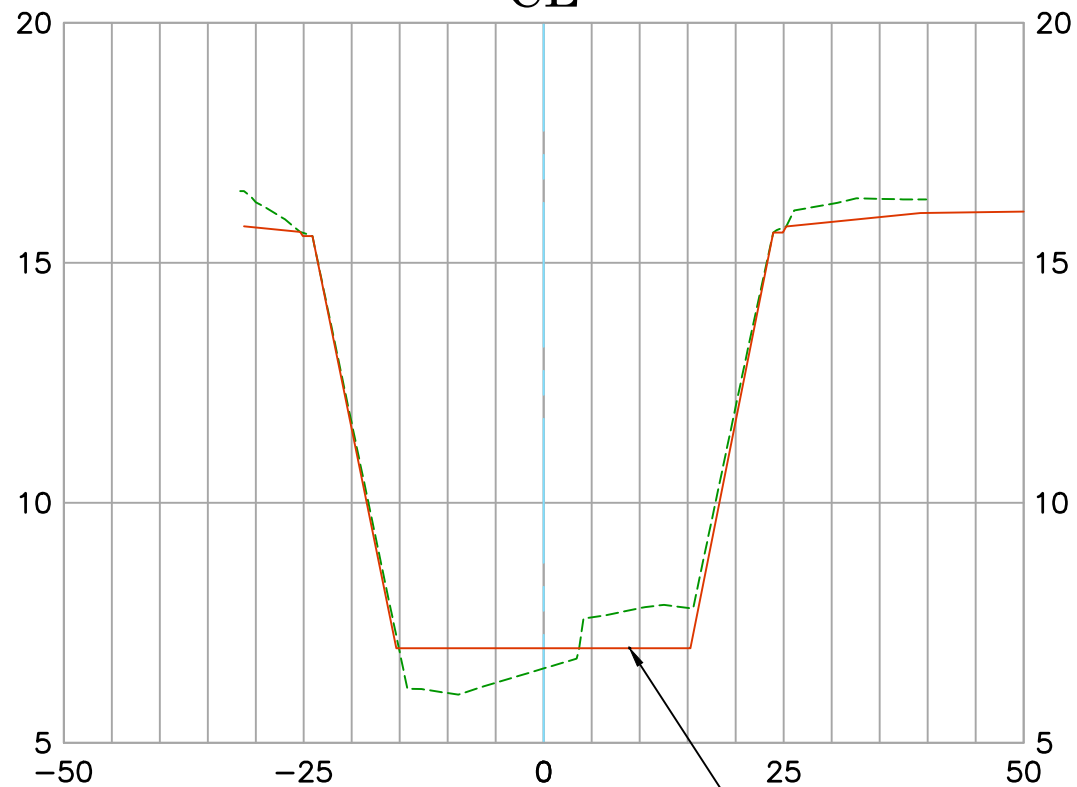

Existing Condition 2020
Record Drawing D05-101-7R

Date Prepared: 09/16/2020

COMPACTED FILL
PER RECORD DRAWING


Vert. Scale: 1"=4'
Hor. Scale: 1"=20'



FOUNTAIN VALLEY CHANNEL (D05)

46+50.00

CL

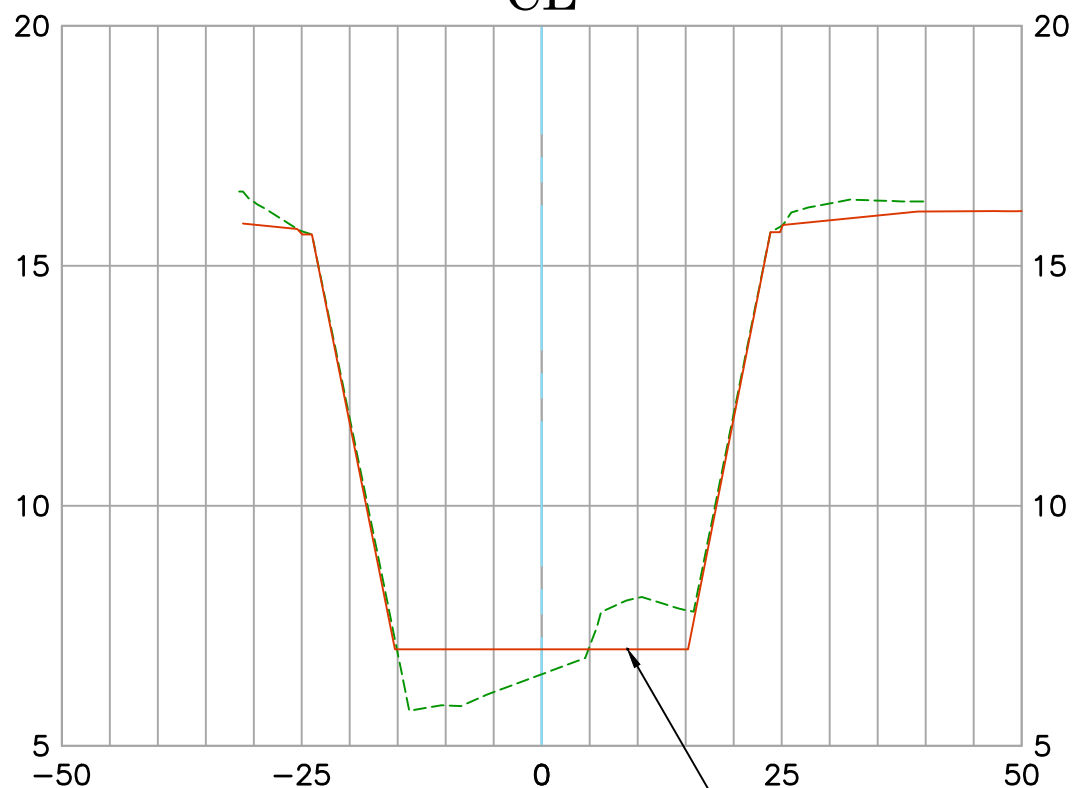

Existing Condition 2020
 Record Drawing D05-101-7R

Date Prepared: 09/16/2020

COMPACTED FILL
 PER RECORD DRAWING

Vert. Scale: 1"=4'
 Hor. Scale: 1"=20'

U.S. Survey Foot


OC Public Works
OC Survey/Field Services
Boundary Analysis & Mapping



FOUNTAIN VALLEY CHANNEL (D05)

47+00.00

CL

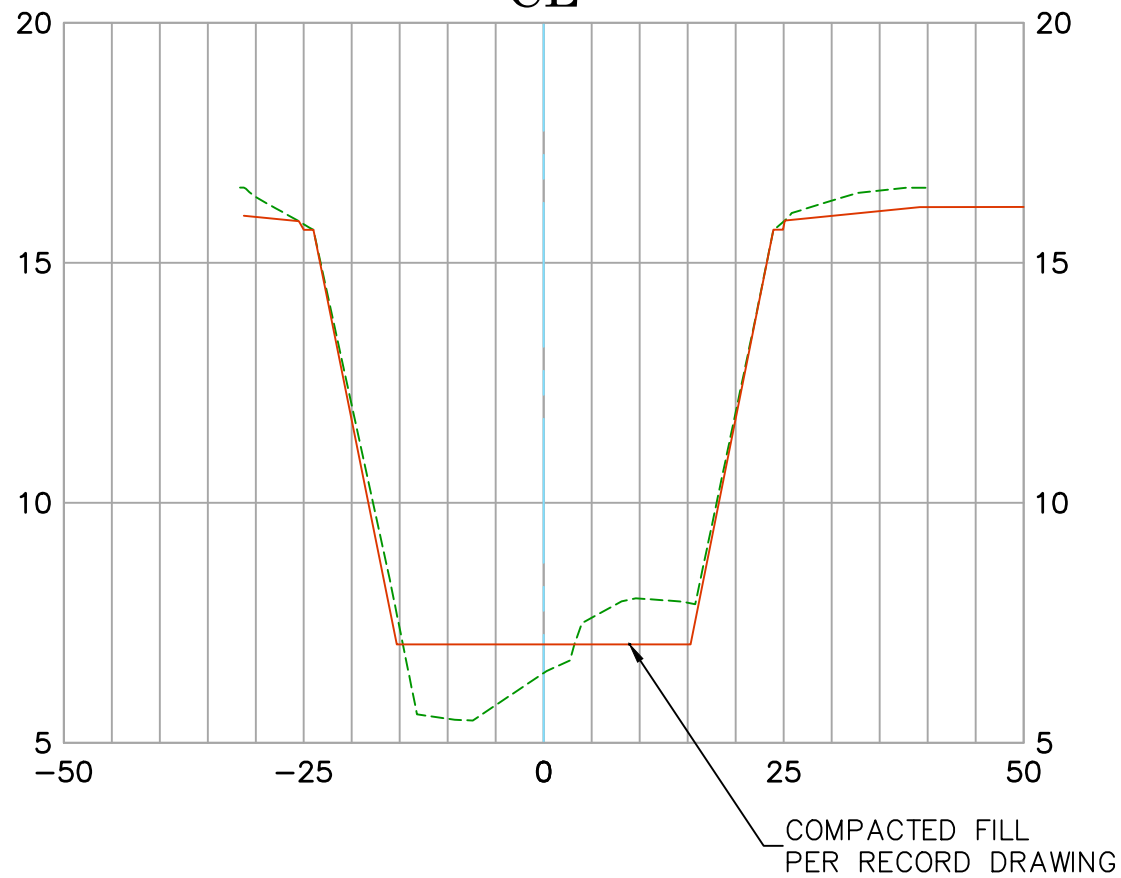

Existing Condition 2020
Record Drawing D05-101-7R

Date Prepared: 09/16/2020


Vert. Scale: 1"=4'
Hor. Scale: 1"=20'



FOUNTAIN VALLEY CHANNEL (D05)

47+50.00


CL

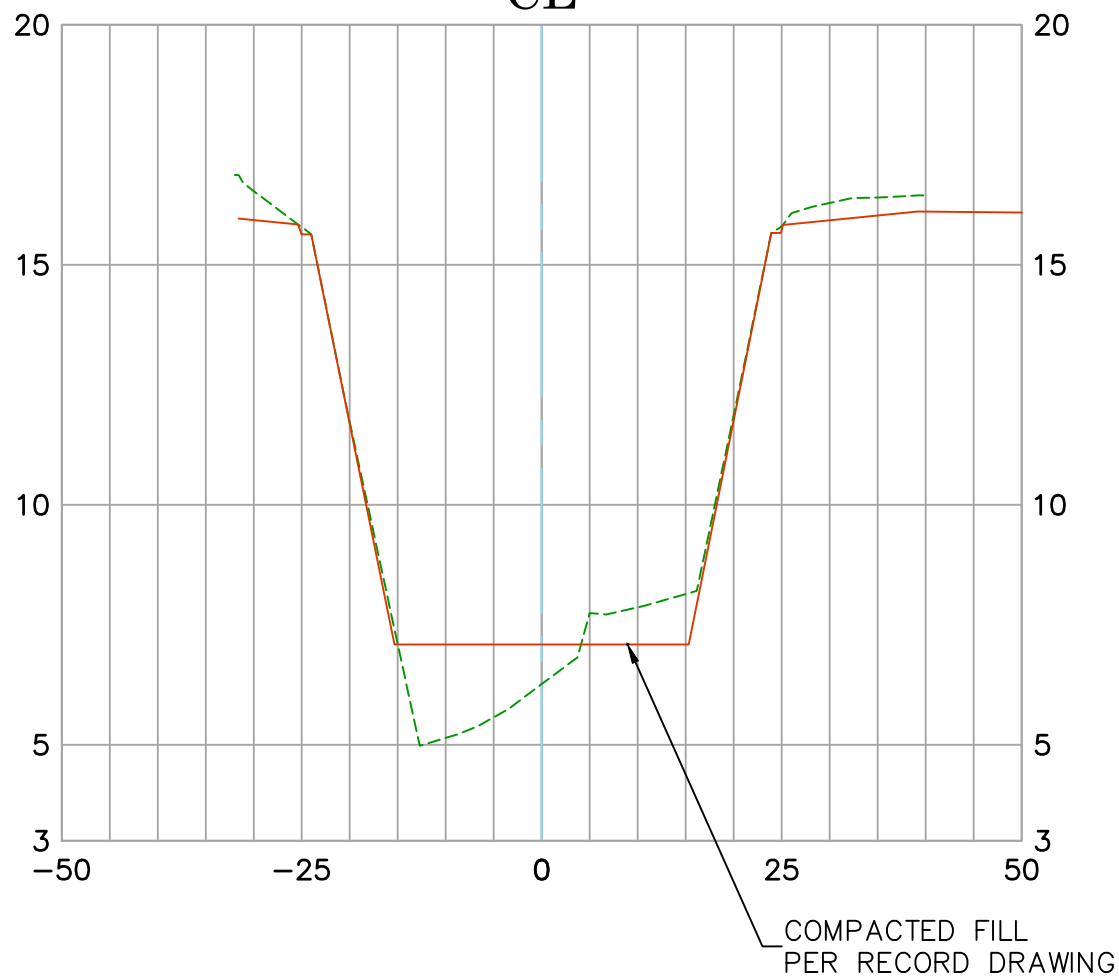

Existing Condition 2020
 Record Drawing D05-101-7R

Date Prepared: 09/16/2020


Vert. Scale: 1"=4'
 Hor. Scale: 1"=20'

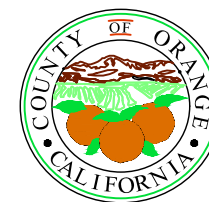

FOUNTAIN VALLEY CHANNEL (D05)

48+00.00

CL

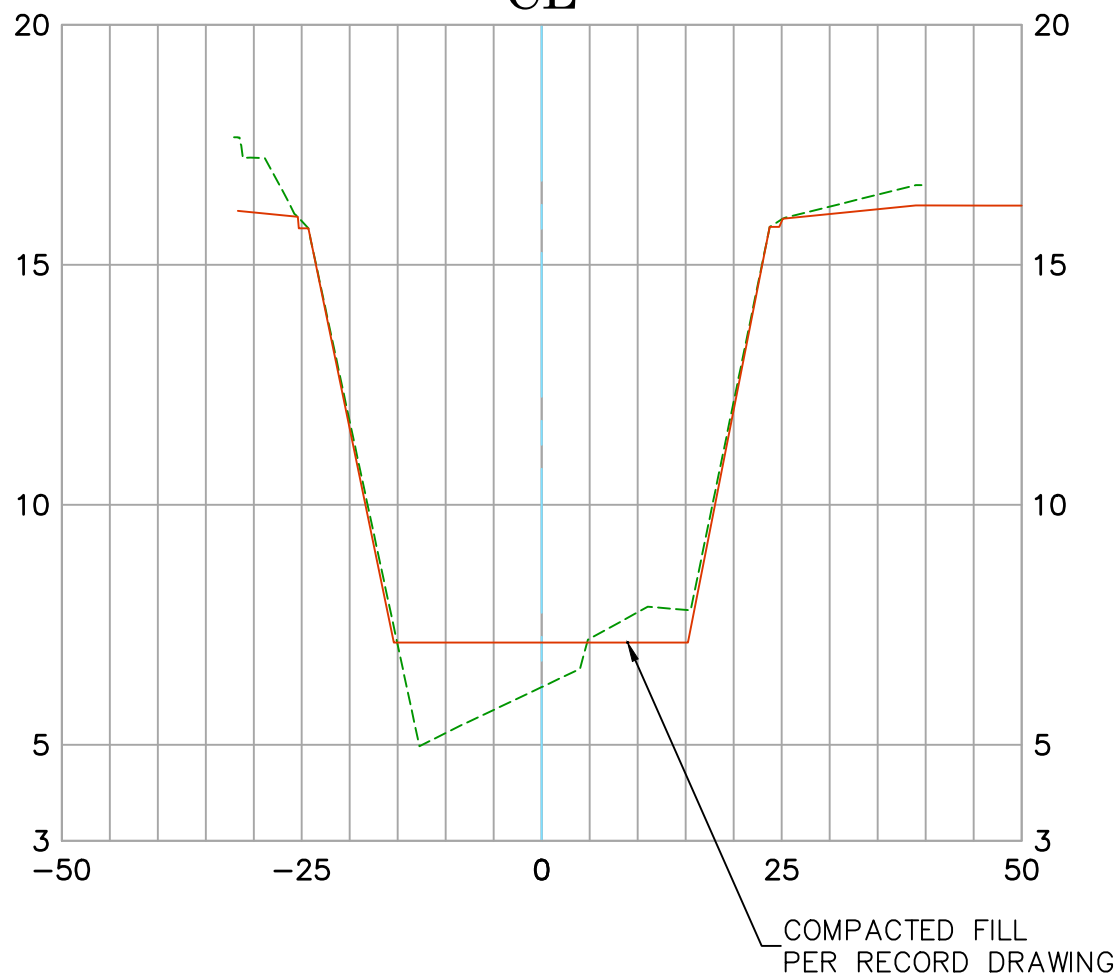

Existing Condition 2020
 Record Drawing D05-101-7R

Date Prepared: 09/16/2020


Vert. Scale: 1"=4'
 Hor. Scale: 1"=20'



FOUNTAIN VALLEY CHANNEL (D05)


48+50.00

CL

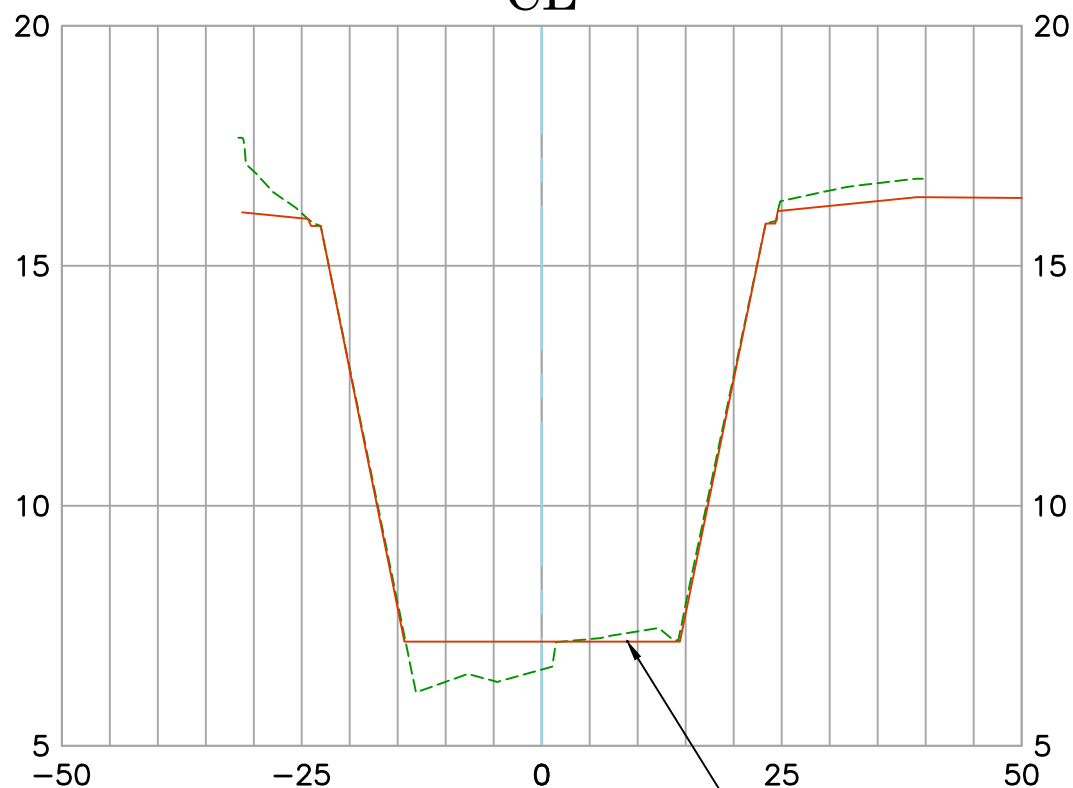

Existing Condition 2020
 Record Drawing D05-101-7R

Date Prepared: 09/16/2020

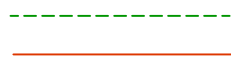

COMPACTED FILL
 PER RECORD DRAWING

Vert. Scale: 1"=4'
 Hor. Scale: 1"=20'

U.S. Survey Foot


OC Public Works
OC Survey/Field Services
Boundary Analysis & Mapping



FOUNTAIN VALLEY CHANNEL (D05)

49+00.00

CL

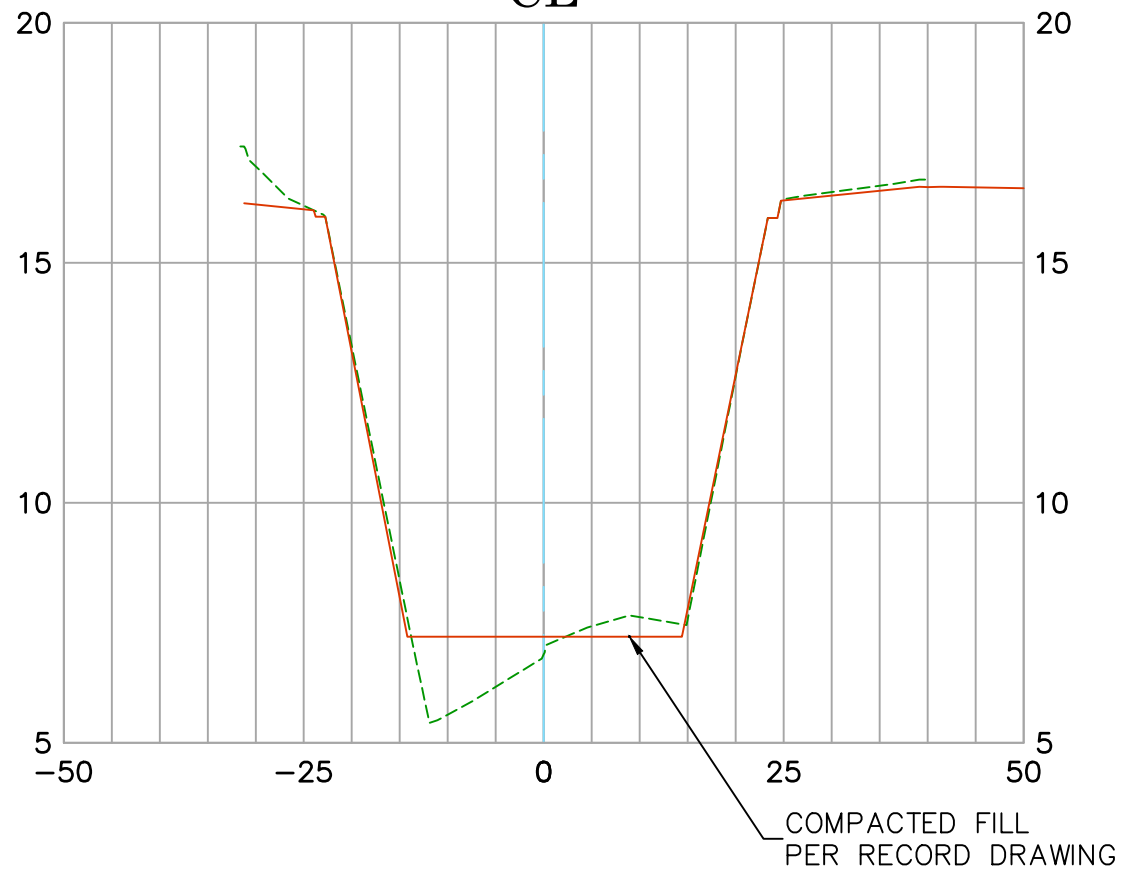

Existing Condition 2020
Record Drawing D05-101-7R

Date Prepared: 09/16/2020

Vert. Scale: 1"=4'
Hor. Scale: 1"=20'

U.S. Survey Foot


OC Public Works
OC Survey/Field Services
Boundary Analysis & Mapping



FOUNTAIN VALLEY CHANNEL (D05)

49+50.00

CL

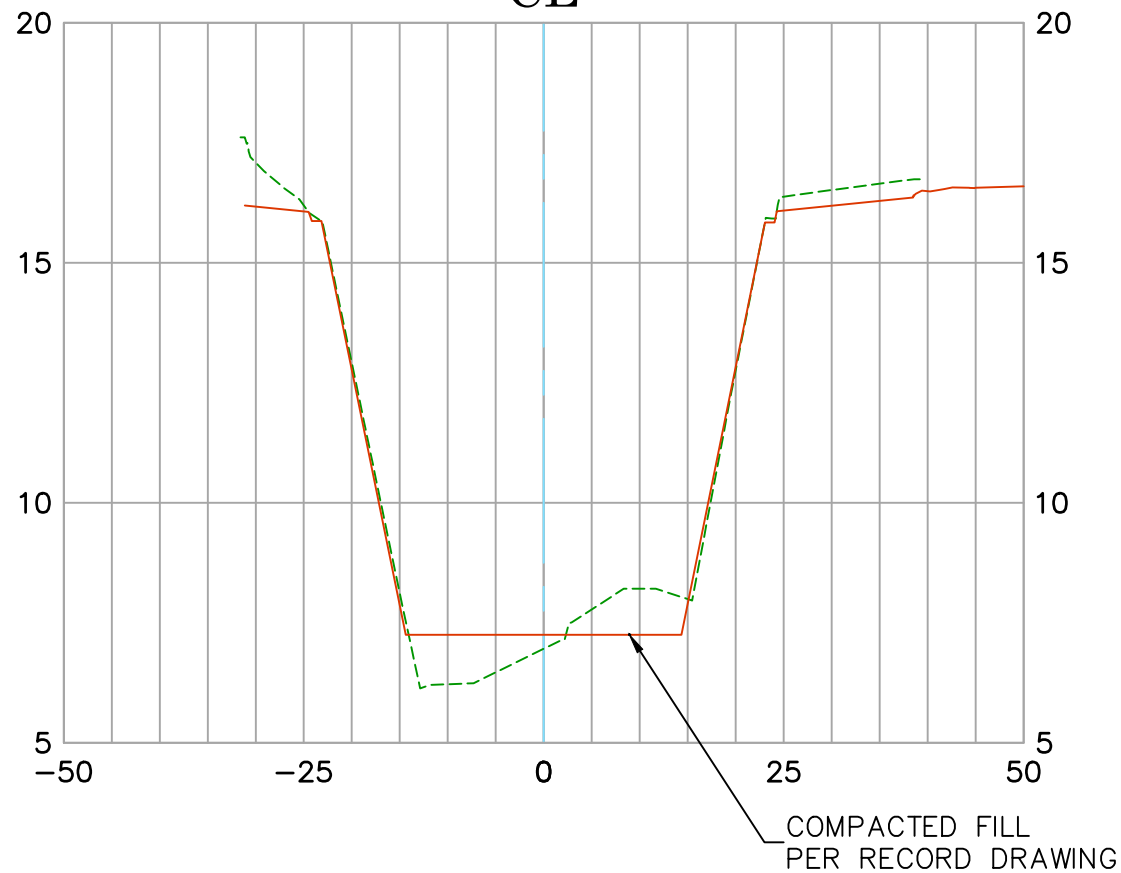

Existing Condition 2020
Record Drawing D05-101-7R

Date Prepared: 09/16/2020

Vert. Scale: 1"=4'
Hor. Scale: 1"=20'


U.S. Survey Foot

OC Public Works
OC Survey/Field Services
Boundary Analysis & Mapping

FOUNTAIN VALLEY CHANNEL (D05)

50+00.00

CL

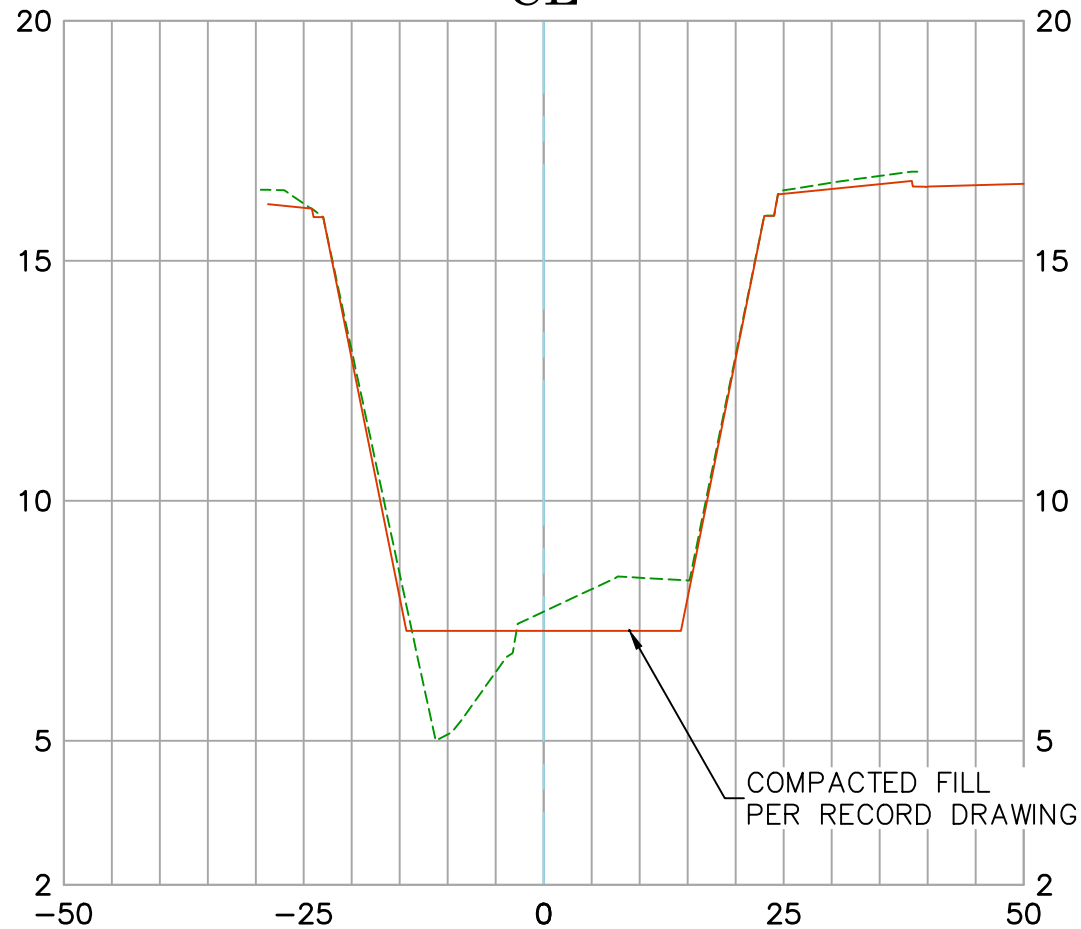

Existing Condition 2020
Record Drawing D05-101-7R

Date Prepared: 09/16/2020

Vert. Scale: 1"=4'
Hor. Scale: 1"=20'

U.S. Survey Foot


OC Public Works
OC Survey/Field Services
Boundary Analysis & Mapping



FOUNTAIN VALLEY CHANNEL (D05)

50+50.00

CL

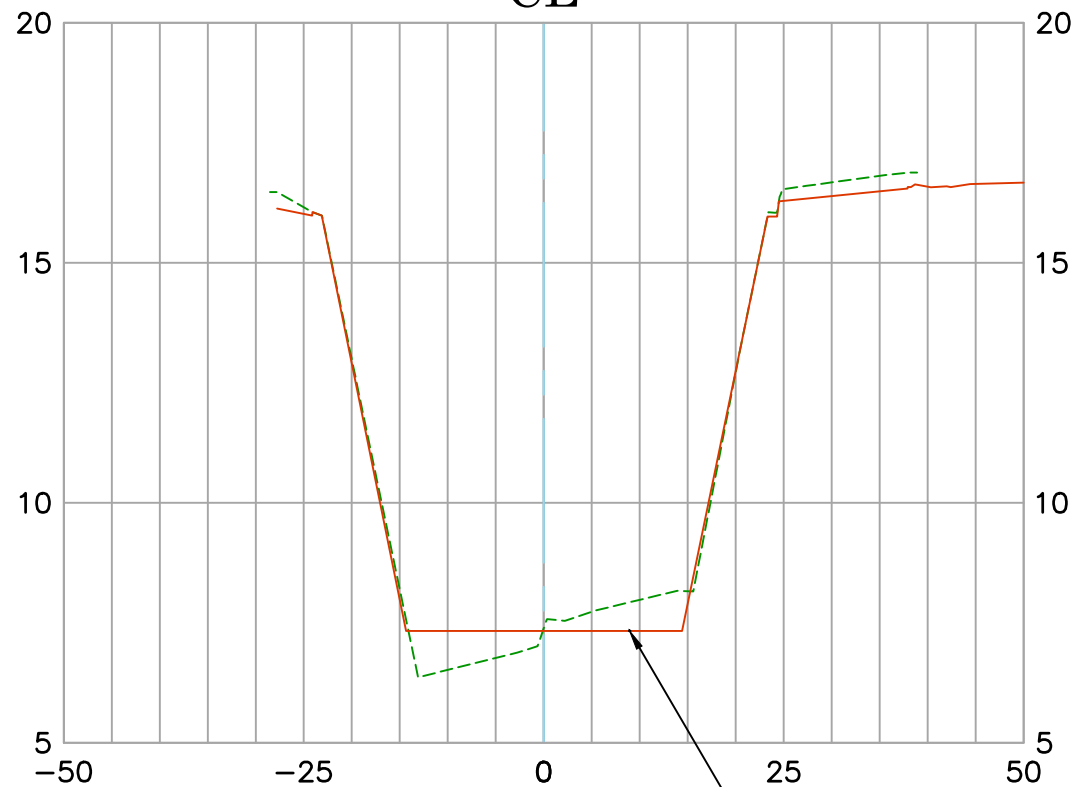

Existing Condition 2020
Record Drawing D05-101-7R

Date Prepared: 09/16/2020

COMPACTED FILL
PER RECORD DRAWING

Vert. Scale: 1"=4'
Hor. Scale: 1"=20'

U.S. Survey Foot


OC Public Works
OC Survey/Field Services
Boundary Analysis & Mapping



FOUNTAIN VALLEY CHANNEL (D05)

51+00.00

CL

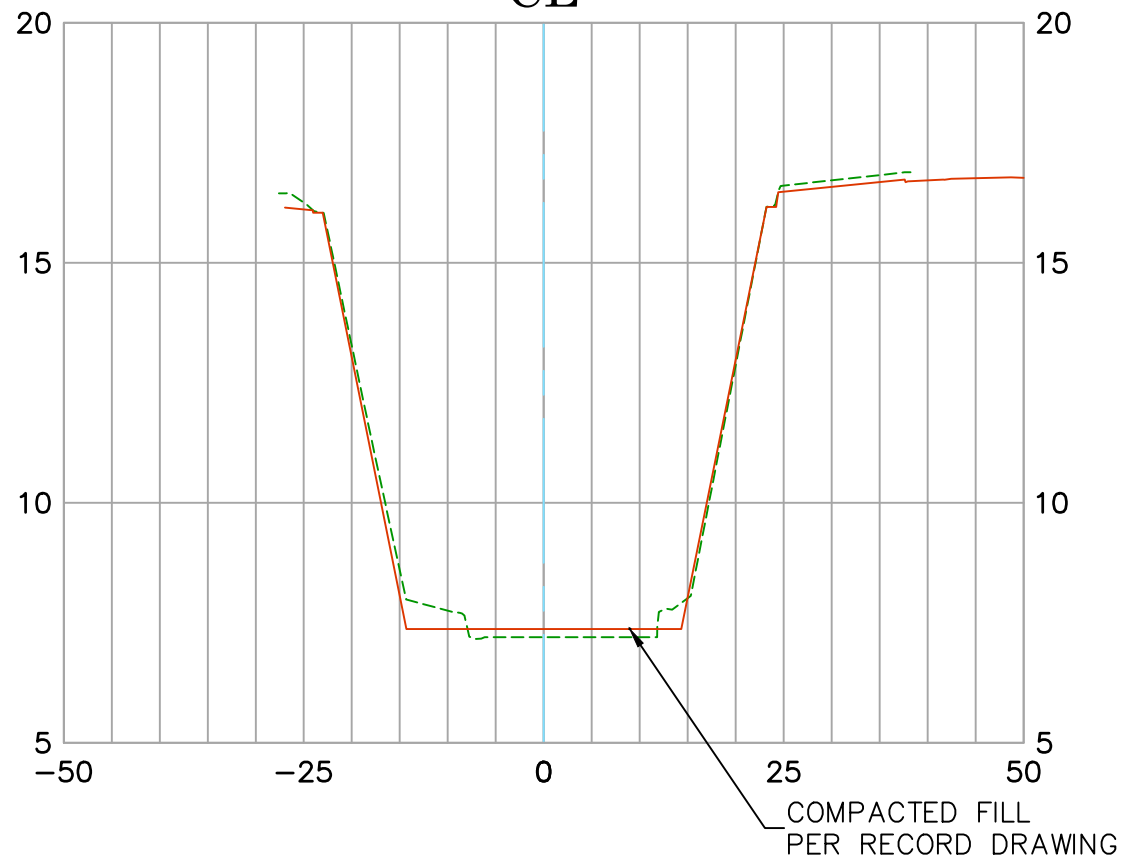

Existing Condition 2020
Record Drawing D05-101-7R

Date Prepared: 09/16/2020

Vert. Scale: 1"=4'
Hor. Scale: 1"=20'

U.S. Survey Foot


OC Public Works
OC Survey/Field Services
Boundary Analysis & Mapping



FOUNTAIN VALLEY CHANNEL (D05)

51+50.00

CL

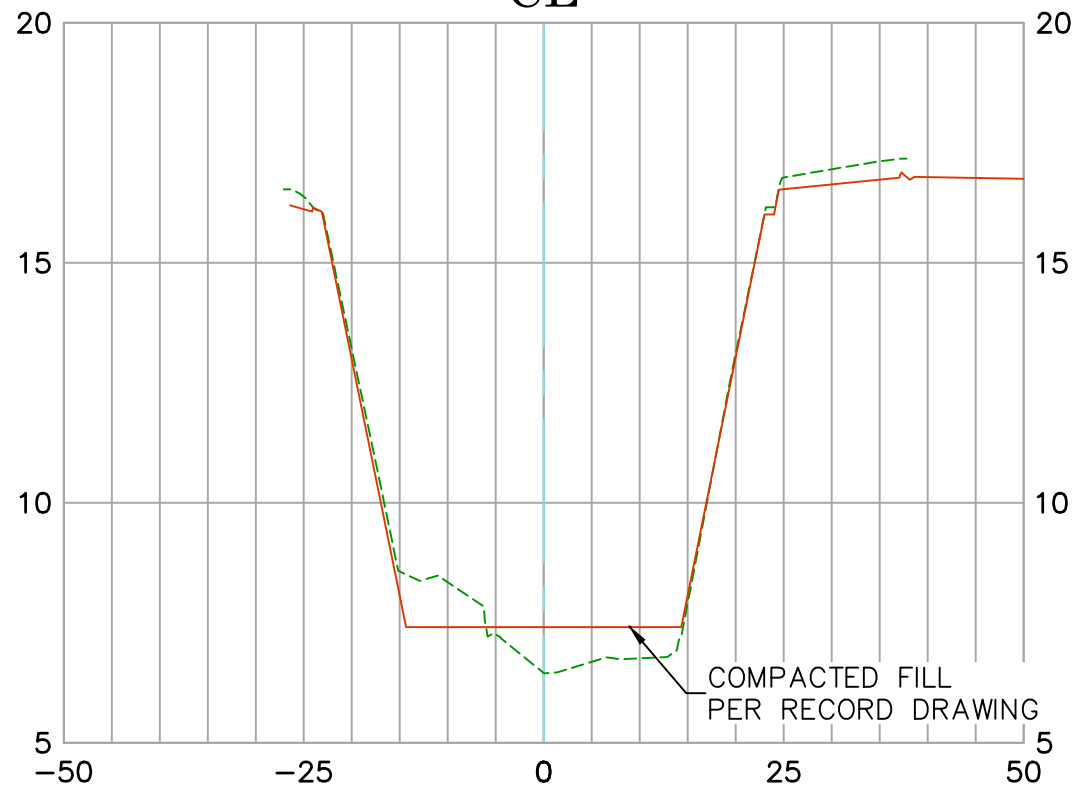

Existing Condition 2020
Record Drawing D05-101-7R

Date Prepared: 09/16/2020


Vert. Scale: 1"=4'
Hor. Scale: 1"=20'



FOUNTAIN VALLEY CHANNEL (D05)

52+00.00

CL

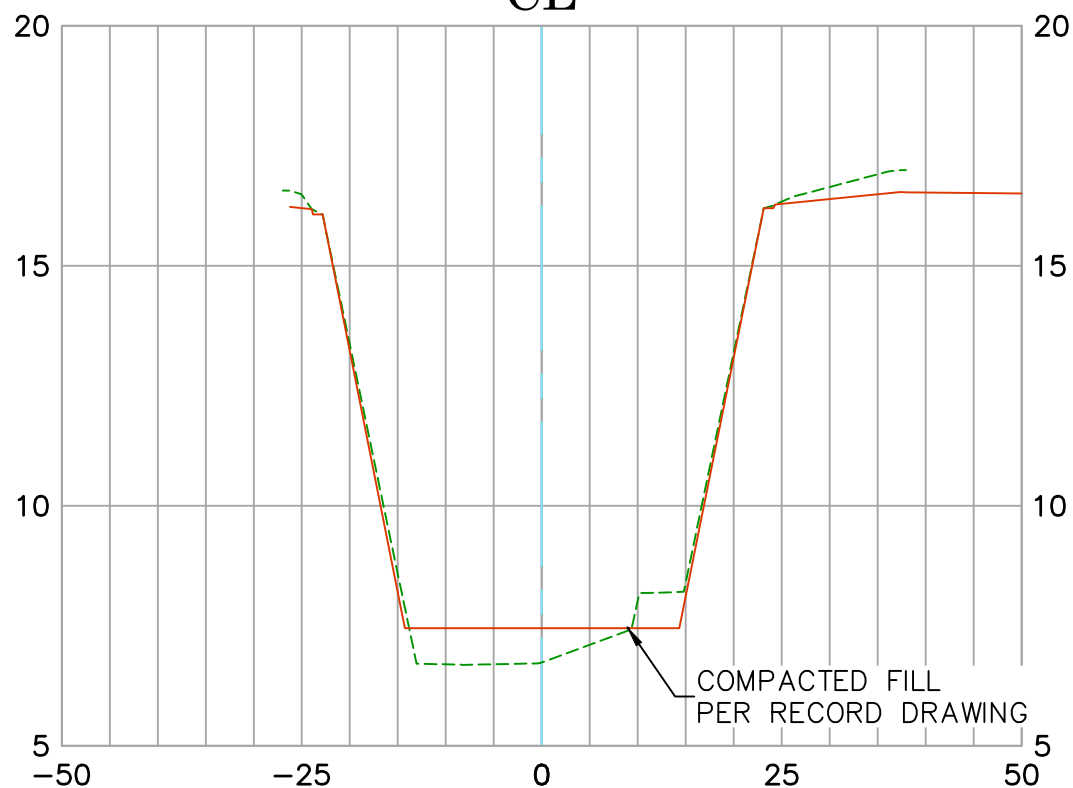

Existing Condition 2020
 Record Drawing D05-101-7R

Date Prepared: 09/16/2020

Vert. Scale: 1"=4'
 Hor. Scale: 1"=20'

U.S. Survey Foot


OC Public Works
OC Survey/Field Services
Boundary Analysis & Mapping



FOUNTAIN VALLEY CHANNEL (D05)

52+50.00

CL

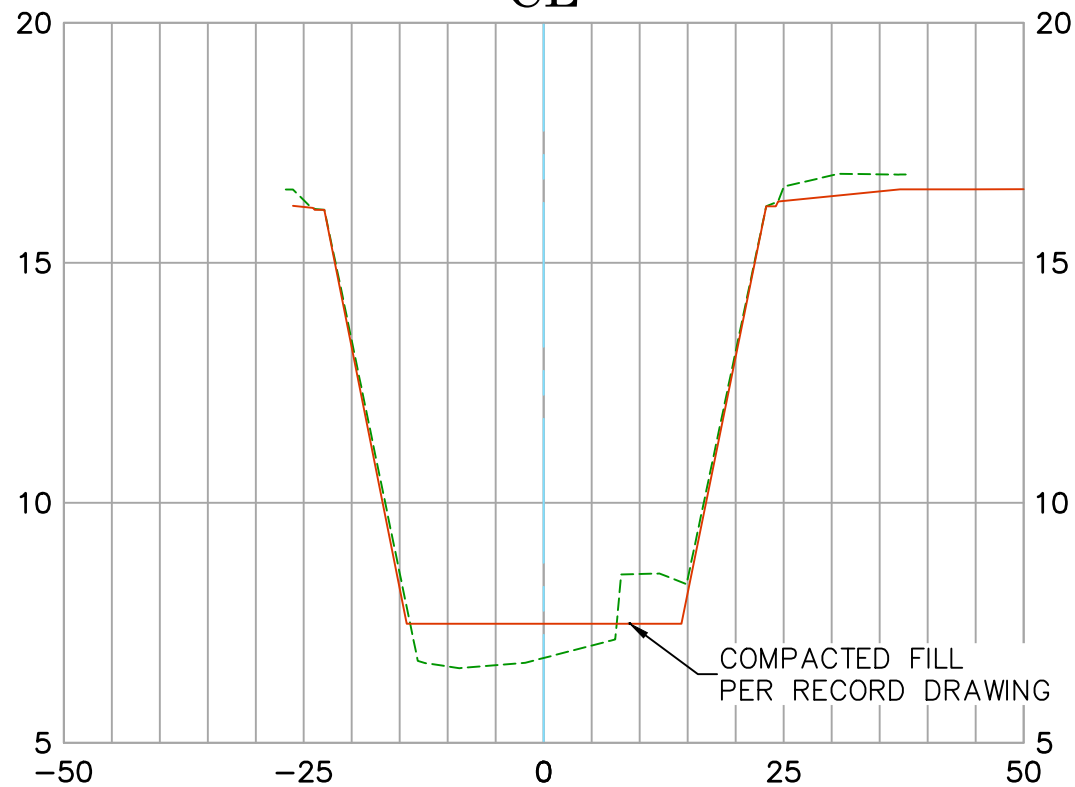

Existing Condition 2020
Record Drawing D05-101-7R

Date Prepared: 09/16/2020

Vert. Scale: 1"=4'
Hor. Scale: 1"=20'

U.S. Survey Foot


OC Public Works
OC Survey/Field Services
Boundary Analysis & Mapping



FOUNTAIN VALLEY CHANNEL (D05)

53+00.00

CL

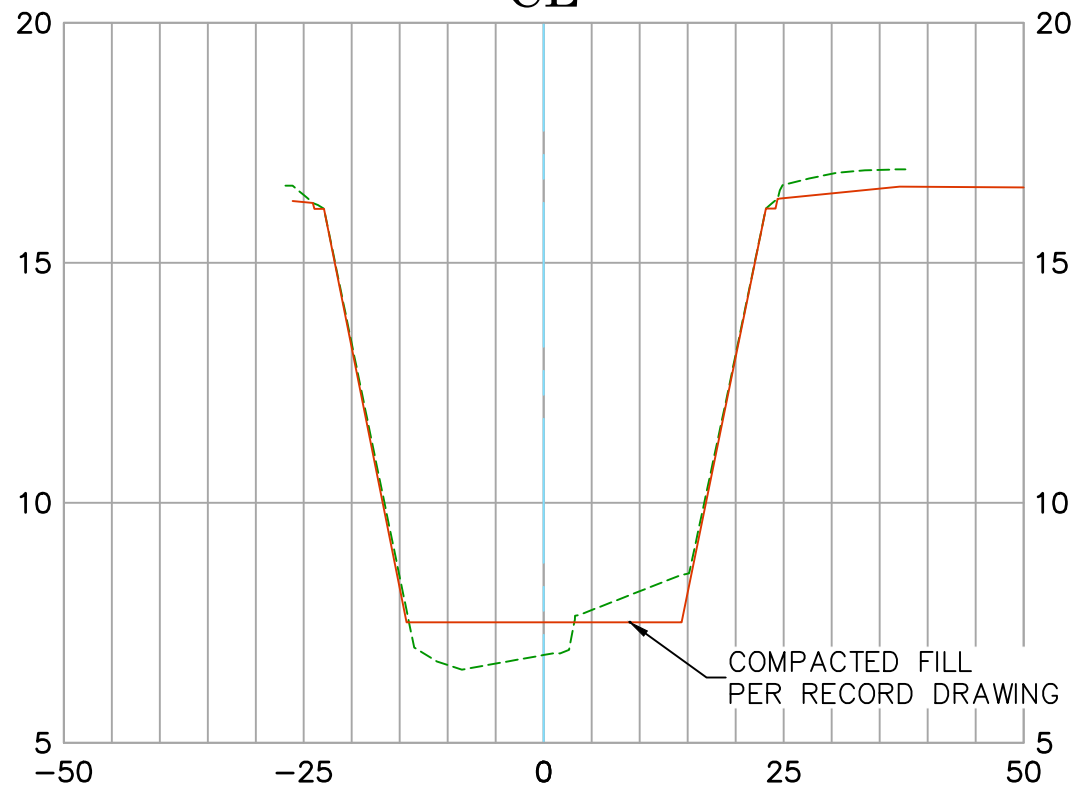

Existing Condition 2020
Record Drawing D05-101-7R

Date Prepared: 09/16/2020


Vert. Scale: 1"=4'
Hor. Scale: 1"=20'



FOUNTAIN VALLEY CHANNEL (D05)

53+50.00

CL

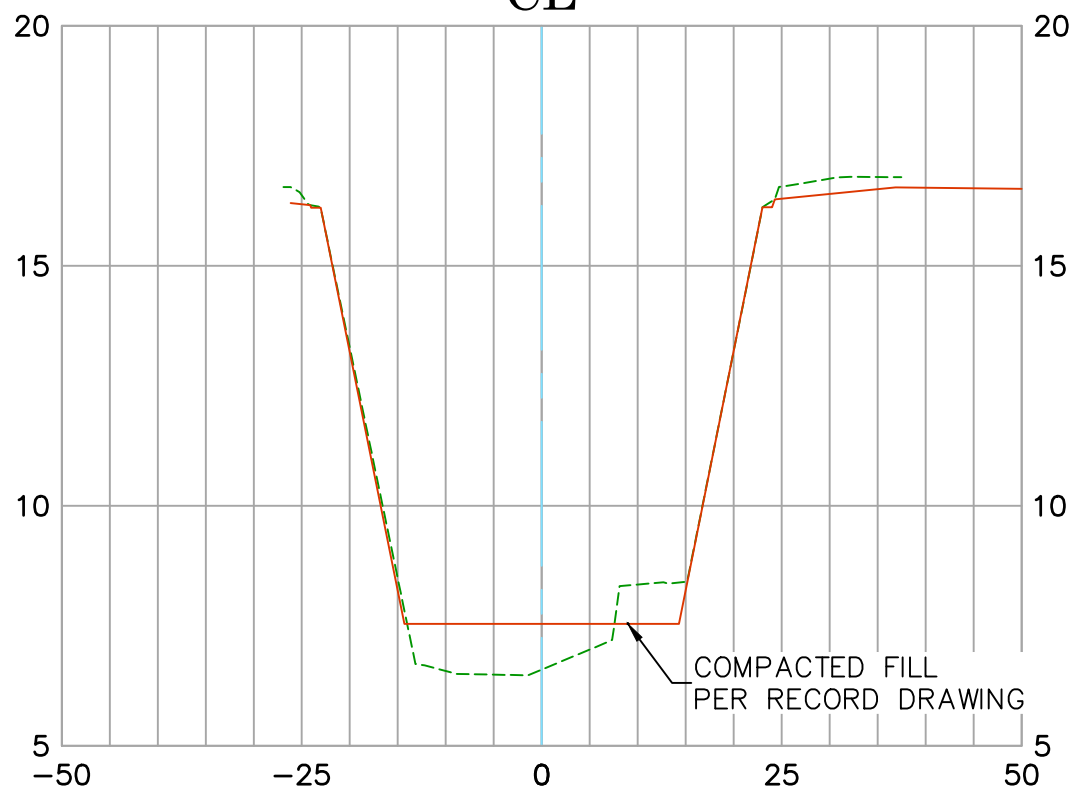

Existing Condition 2020
 Record Drawing D05-101-7R

Date Prepared: 09/16/2020


Vert. Scale: 1"=4'
 Hor. Scale: 1"=20'



FOUNTAIN VALLEY CHANNEL (D05)

54+00.00

CL

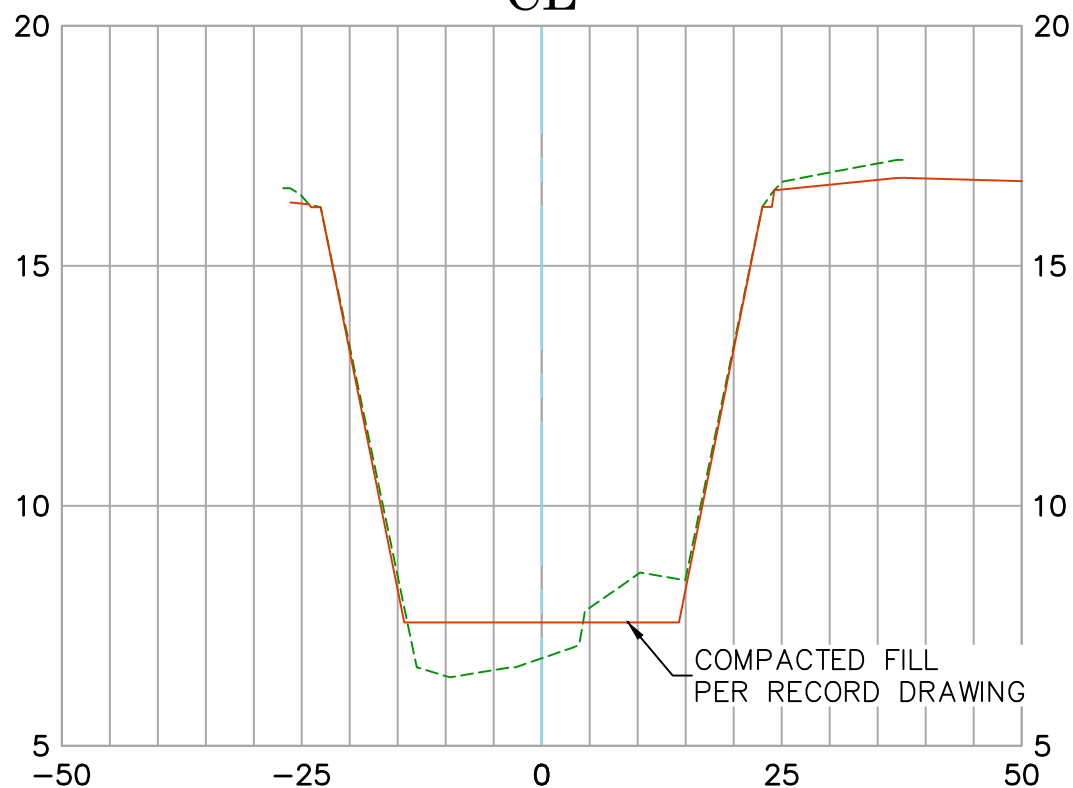

Existing Condition 2020
 Record Drawing D05-101-7R

Date Prepared: 09/16/2020

Vert. Scale: 1"=4'
 Hor. Scale: 1"=20'

U.S. Survey Foot


OC Public Works
OC Survey/Field Services
Boundary Analysis & Mapping



FOUNTAIN VALLEY CHANNEL (D05)

54+50.00

CL

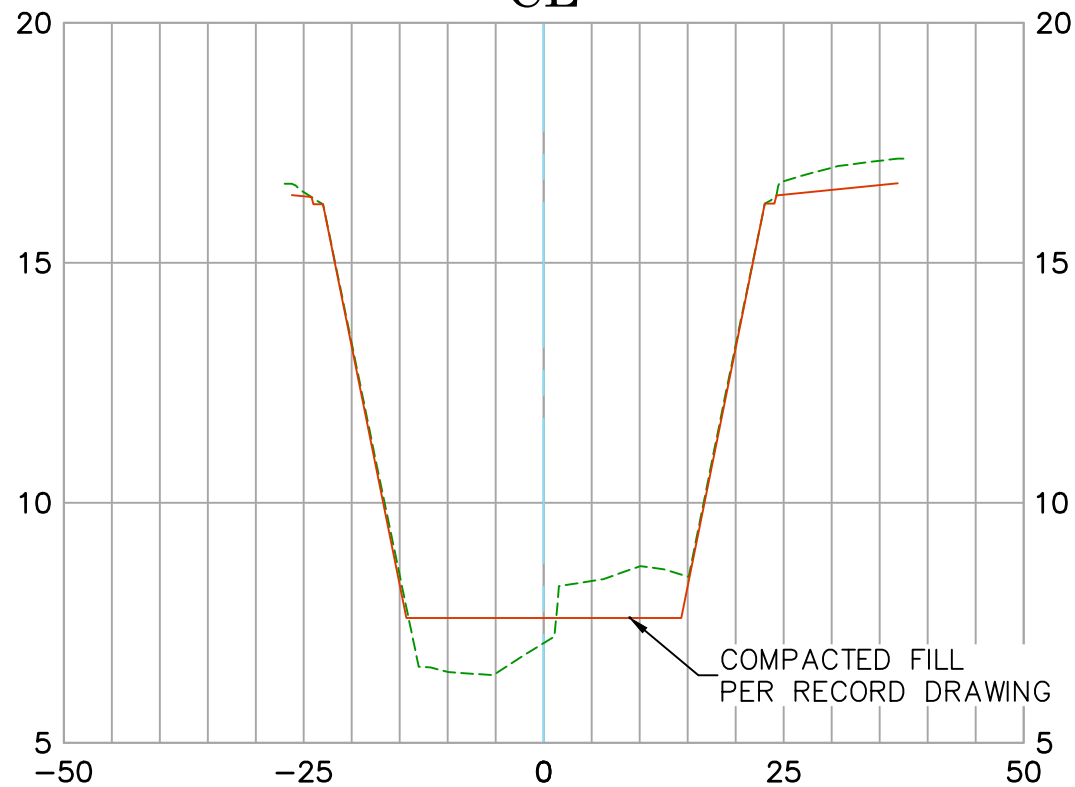

Existing Condition 2020
Record Drawing D05-101-7R

Date Prepared: 09/16/2020

Vert. Scale: 1"=4'
Hor. Scale: 1"=20'

U.S. Survey Foot


OC Public Works
OC Survey/Field Services
Boundary Analysis & Mapping



FOUNTAIN VALLEY CHANNEL (D05)

55+00.00

CL

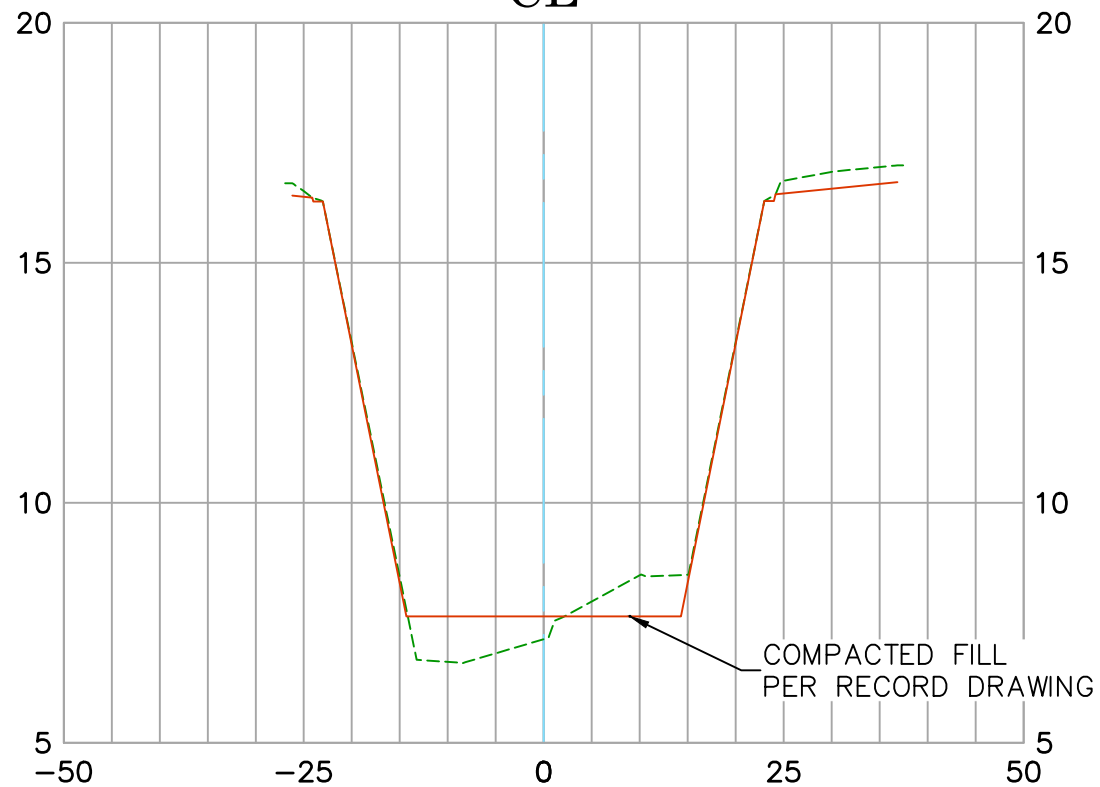

Existing Condition 2020
Record Drawing D05-101-7R

Date Prepared: 09/16/2020


Vert. Scale: 1"=4'
Hor. Scale: 1"=20'



FOUNTAIN VALLEY CHANNEL (D05)

55+50.00

CL

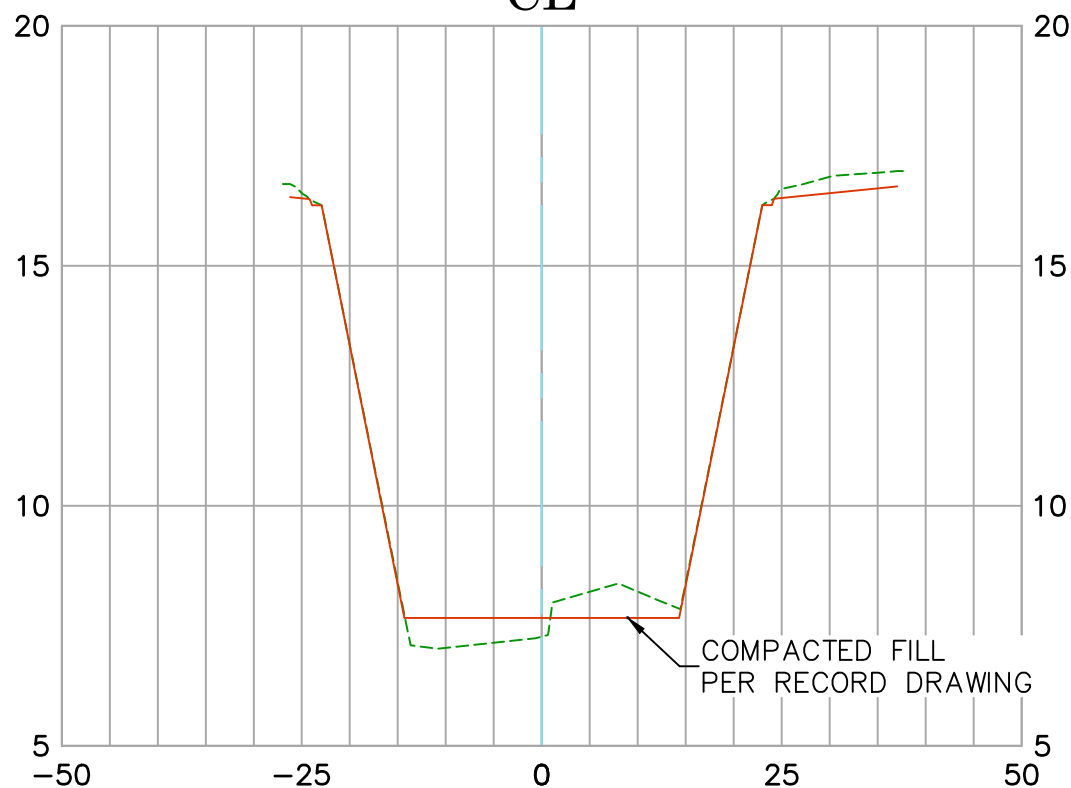

Existing Condition 2020
 Record Drawing D05-101-7R

Date Prepared: 09/16/2020

Vert. Scale: 1"=4'
 Hor. Scale: 1"=20'

U.S. Survey Foot


OC Public Works
OC Survey/Field Services
Boundary Analysis & Mapping



FOUNTAIN VALLEY CHANNEL (D05)

56+00.00

CL

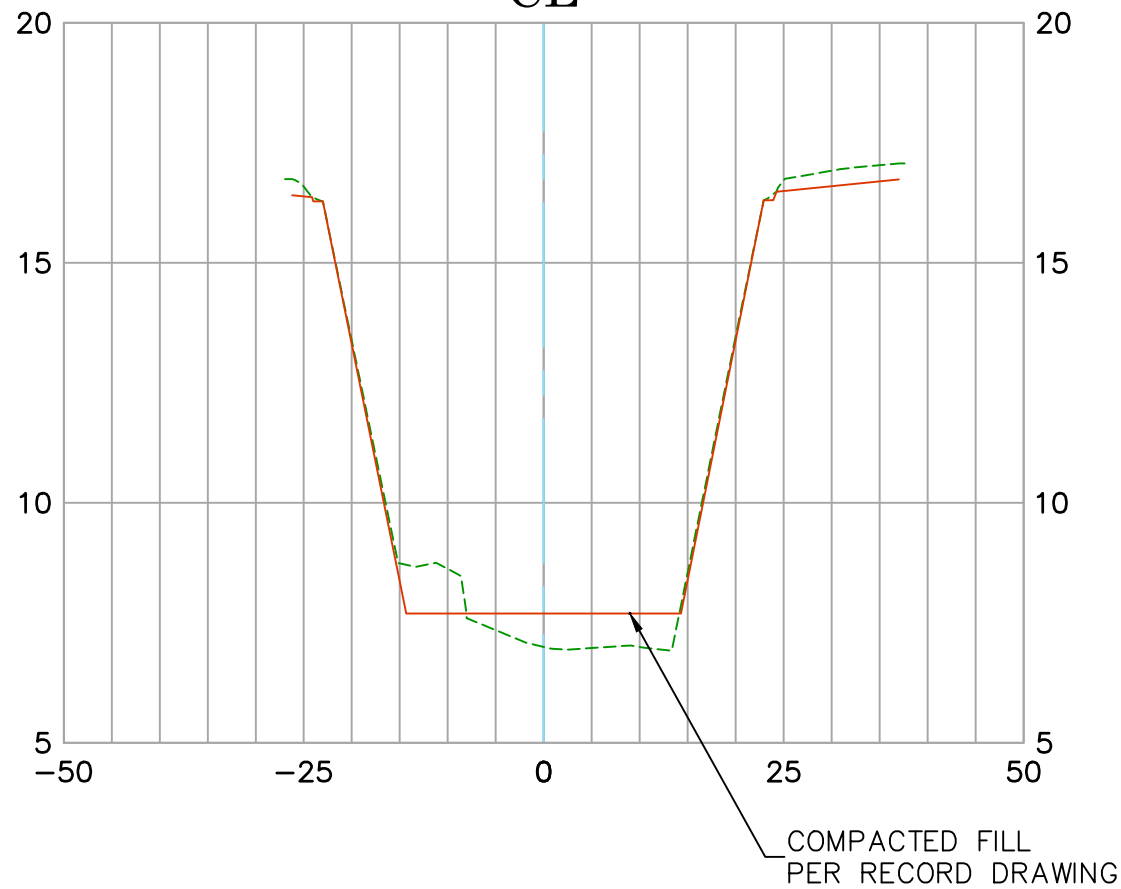

Existing Condition 2020
Record Drawing D05-101-7R

Date Prepared: 09/16/2020

Vert. Scale: 1"=4'
Hor. Scale: 1"=20'

U.S. Survey Foot


OC Public Works
OC Survey/Field Services
Boundary Analysis & Mapping



FOUNTAIN VALLEY CHANNEL (D05)

56+50.00

CL

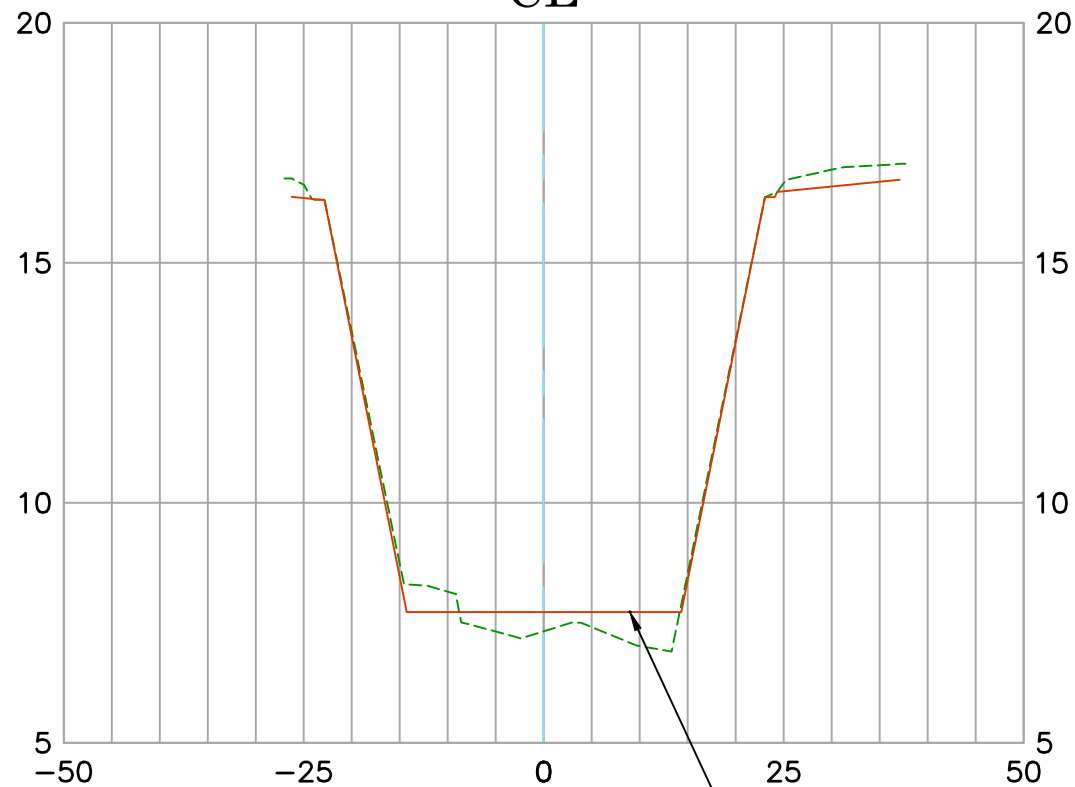

Existing Condition 2020
Record Drawing D05-101-7R

Date Prepared: 09/16/2020



COMPACTED FILL
PER RECORD DRAWING

Vert. Scale: 1"=4'
Hor. Scale: 1"=20'

U.S. *Survey Foot*


OC Public Works
OC Survey/Field Services
Boundary Analysis & Mapping



FOUNTAIN VALLEY CHANNEL (D05)

57+00.00

CL

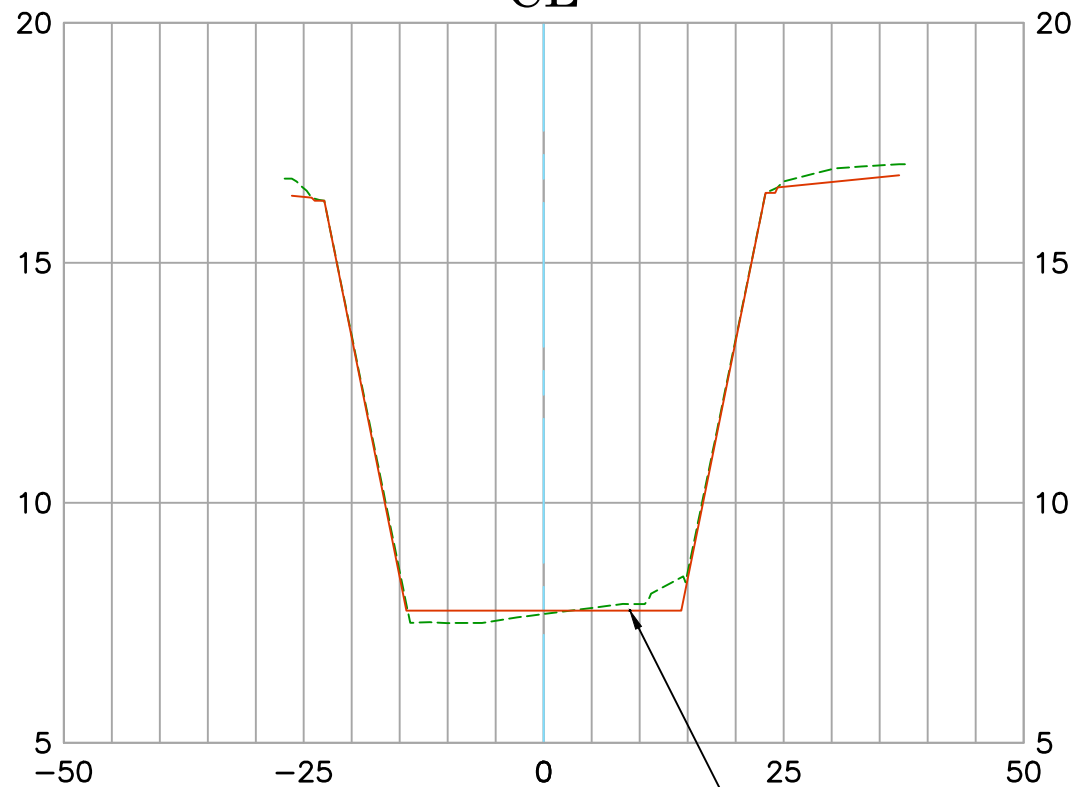

Existing Condition 2020
Record Drawing D05-101-7R

Date Prepared: 09/16/2020

COMPACTED FILL
PER RECORD DRAWING

Vert. Scale: 1"=4'
Hor. Scale: 1"=20'

U.S. Survey Foot


OC Public Works
OC Survey/Field Services
Boundary Analysis & Mapping



FOUNTAIN VALLEY CHANNEL (D05)

57+50.00

CL

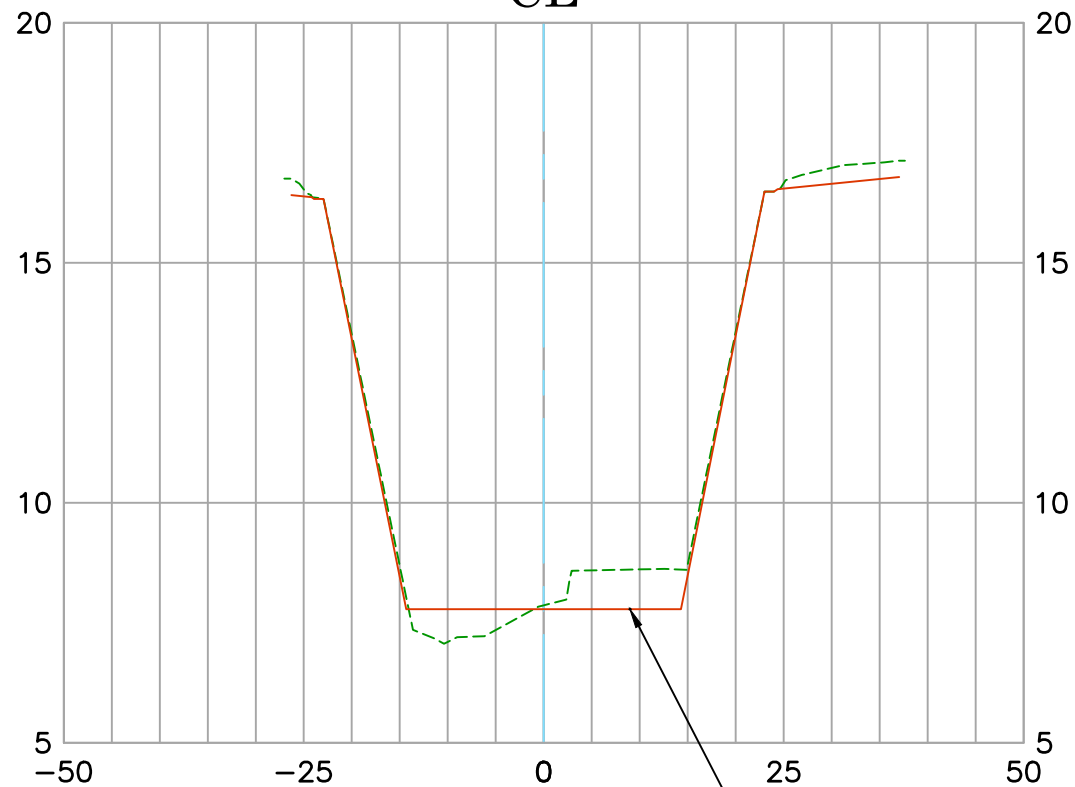

Existing Condition 2020
Record Drawing D05-101-7R

Date Prepared: 09/16/2020

COMPACTED FILL
PER RECORD DRAWING

Vert. Scale: 1"=4'
Hor. Scale: 1"=20'

U.S. Survey Foot


OC Public Works
OC Survey/Field Services
Boundary Analysis & Mapping



FOUNTAIN VALLEY CHANNEL (D05)

58+00.00

CL

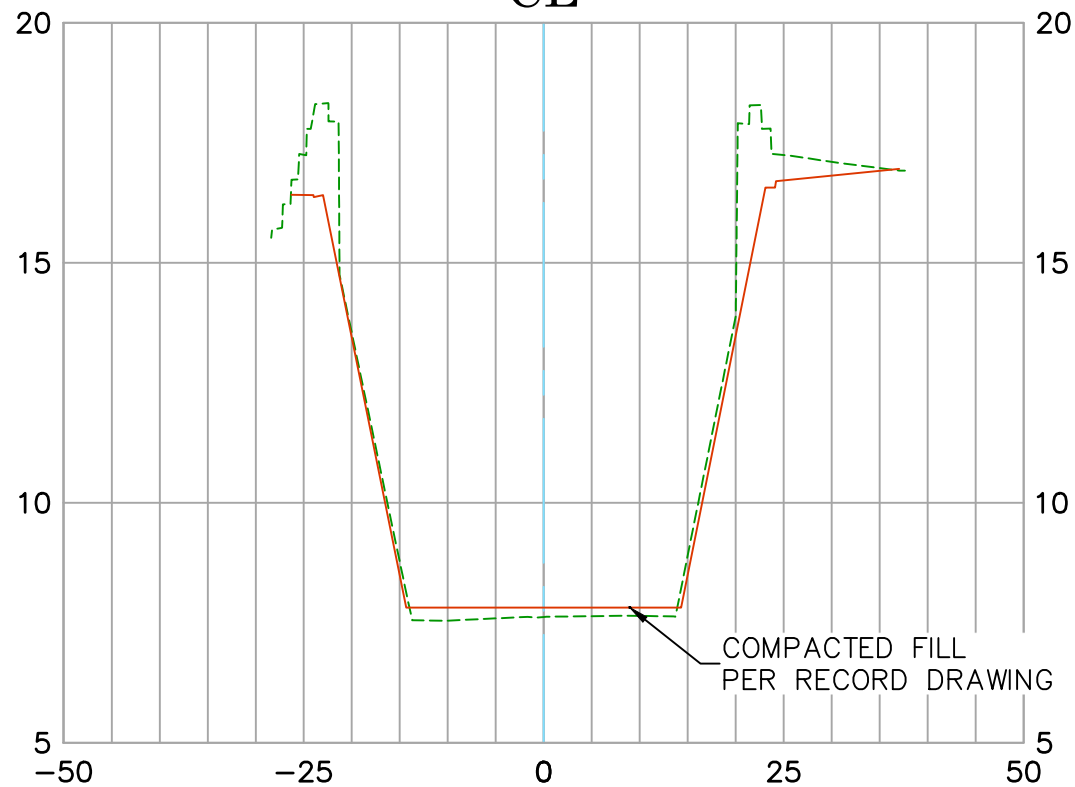

Existing Condition 2020
Record Drawing D05-101-7R

Date Prepared: 09/16/2020

Vert. Scale: 1"=4'
Hor. Scale: 1"=20'

U.S. Survey Foot


OC Public Works
OC Survey/Field Services
Boundary Analysis & Mapping



FOUNTAIN VALLEY CHANNEL (D05)

58+50.00

CL

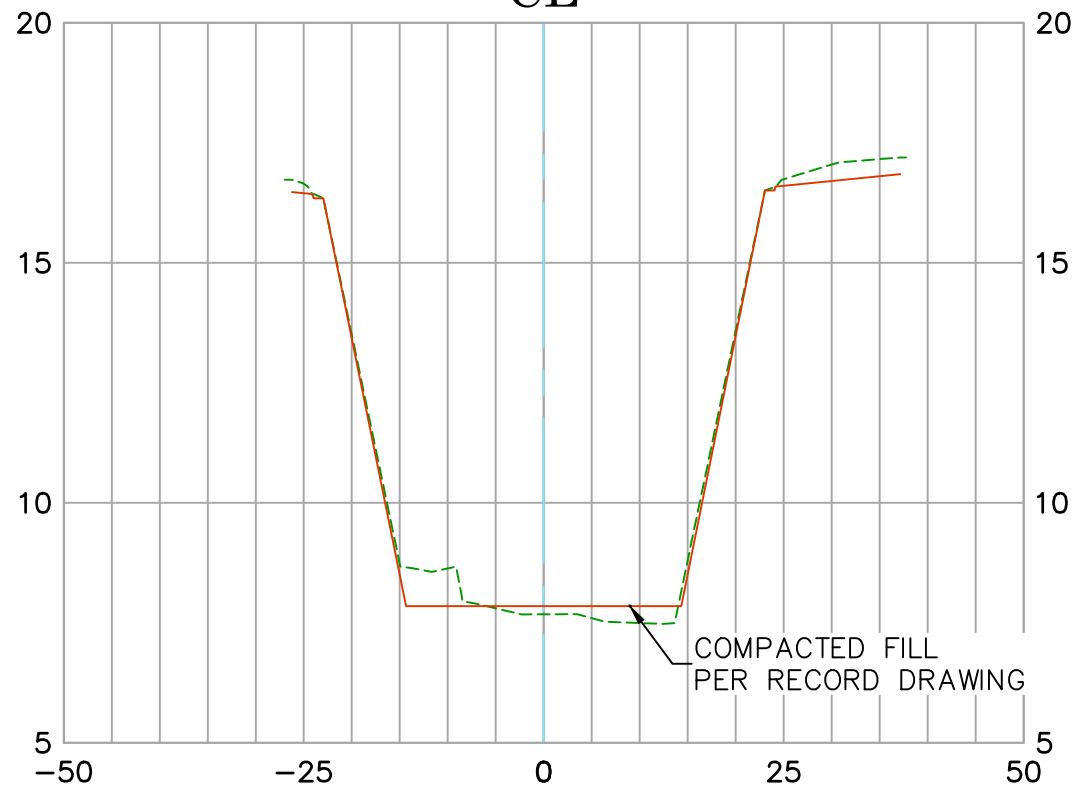

Existing Condition 2020
Record Drawing D05-101-7R

Date Prepared: 09/16/2020

Vert. Scale: 1"=4'
Hor. Scale: 1"=20'

U.S. Survey Foot


OC Public Works
OC Survey/Field Services
Boundary Analysis & Mapping



FOUNTAIN VALLEY CHANNEL (D05)

59+00.00

CL

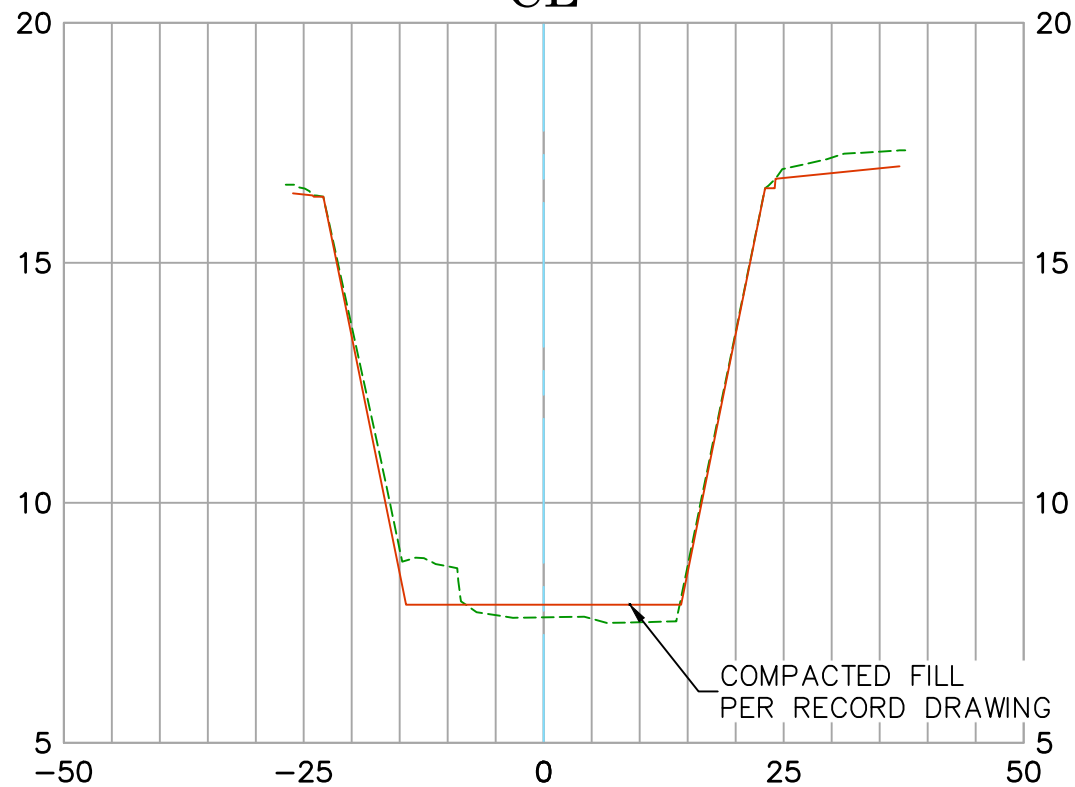

Existing Condition 2020
Record Drawing D05-101-7R

Date Prepared: 09/16/2020

Vert. Scale: 1"=4'
Hor. Scale: 1"=20'

U.S. Survey Foot


OC Public Works
OC Survey/Field Services
Boundary Analysis & Mapping



FOUNTAIN VALLEY CHANNEL (D05)

59+50.00

CL

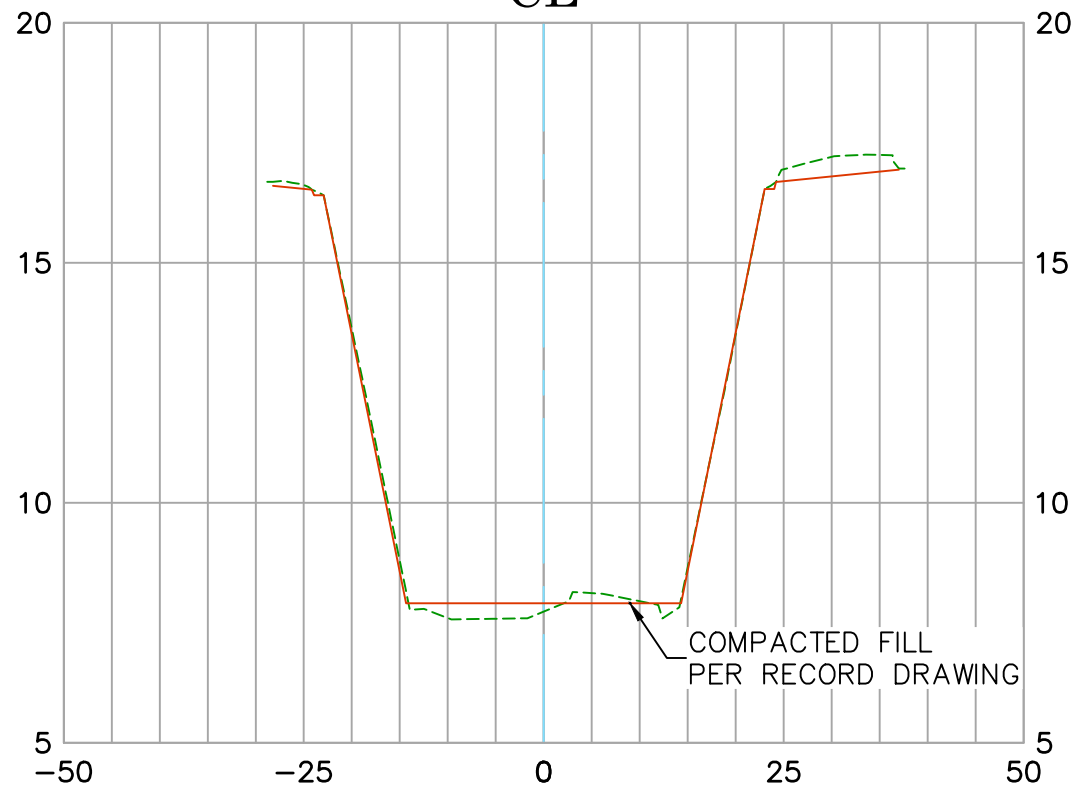

Existing Condition 2020
Record Drawing D05-101-7R

Date Prepared: 09/16/2020

Vert. Scale: 1"=4'
Hor. Scale: 1"=20'

U.S. Survey Foot


OC Public Works
OC Survey/Field Services
Boundary Analysis & Mapping



FOUNTAIN VALLEY CHANNEL (D05)

60+00.00

CL

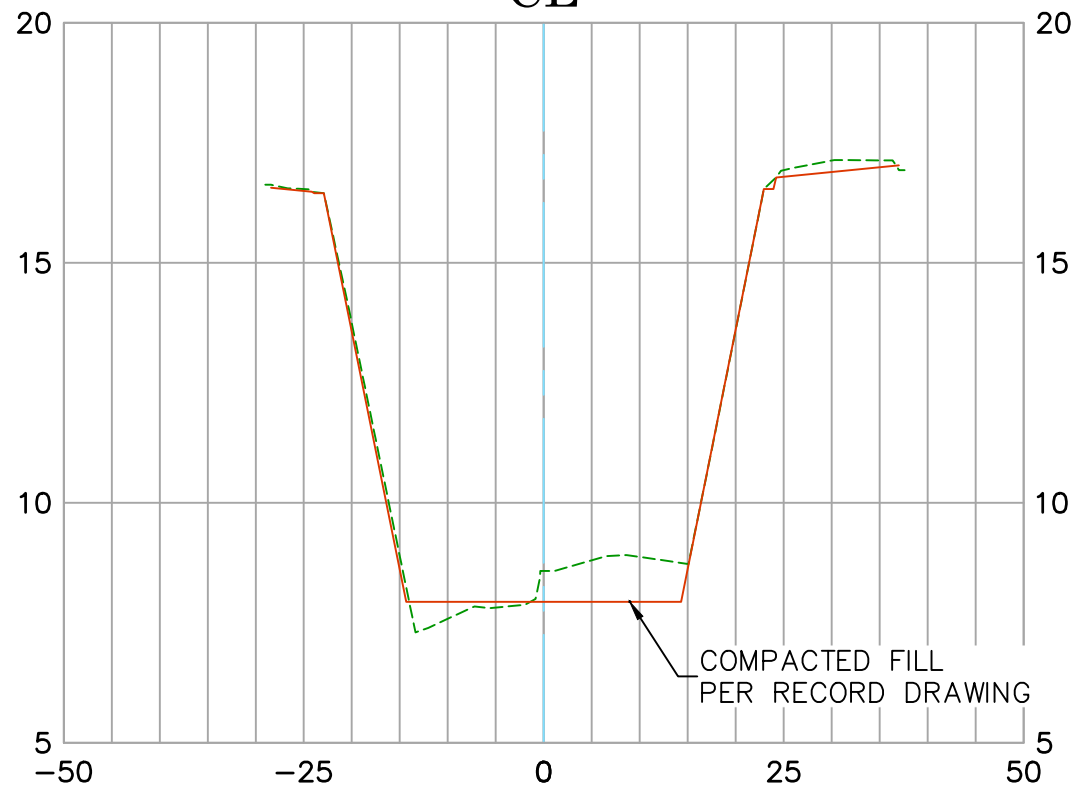

Existing Condition 2020
Record Drawing D05-101-7R

Date Prepared: 09/16/2020

Vert. Scale: 1"=4'
Hor. Scale: 1"=20'

U.S. Survey Foot


OC Public Works
OC Survey/Field Services
Boundary Analysis & Mapping



FOUNTAIN VALLEY CHANNEL (D05)

60+50.00

CL

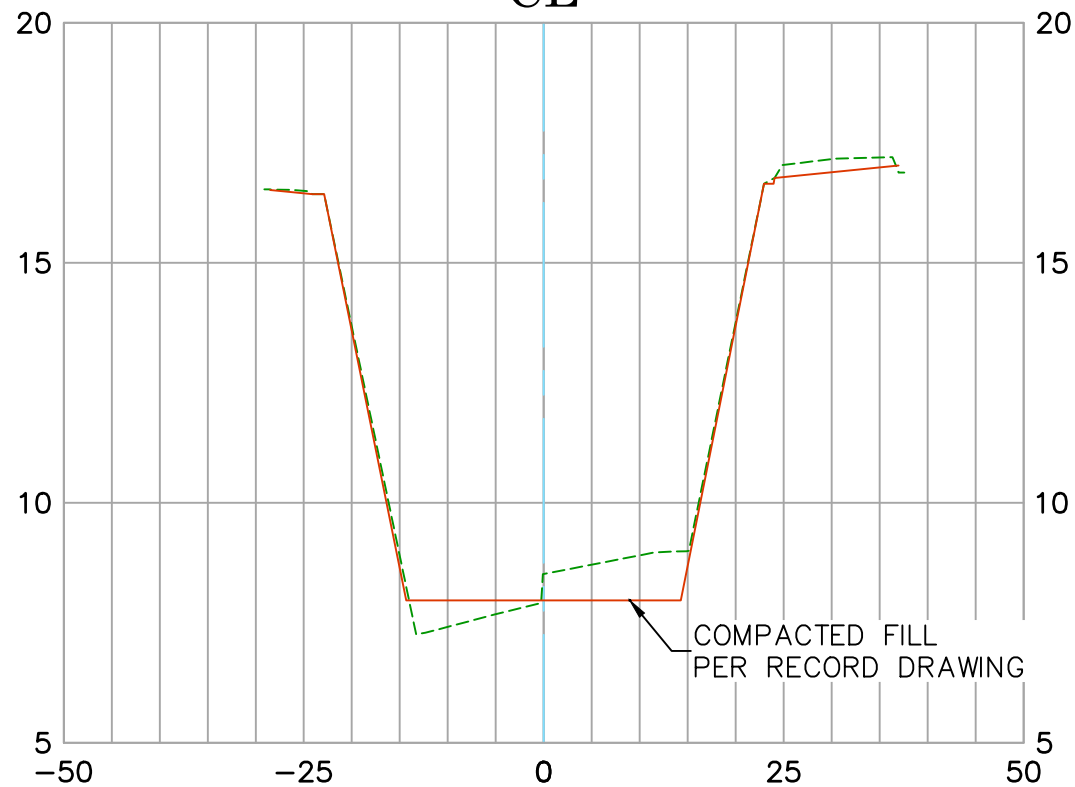

Existing Condition 2020
Record Drawing D05-101-7R

Date Prepared: 09/16/2020


Vert. Scale: 1"=4'
Hor. Scale: 1"=20'



FOUNTAIN VALLEY CHANNEL (D05)

61+00.00

CL

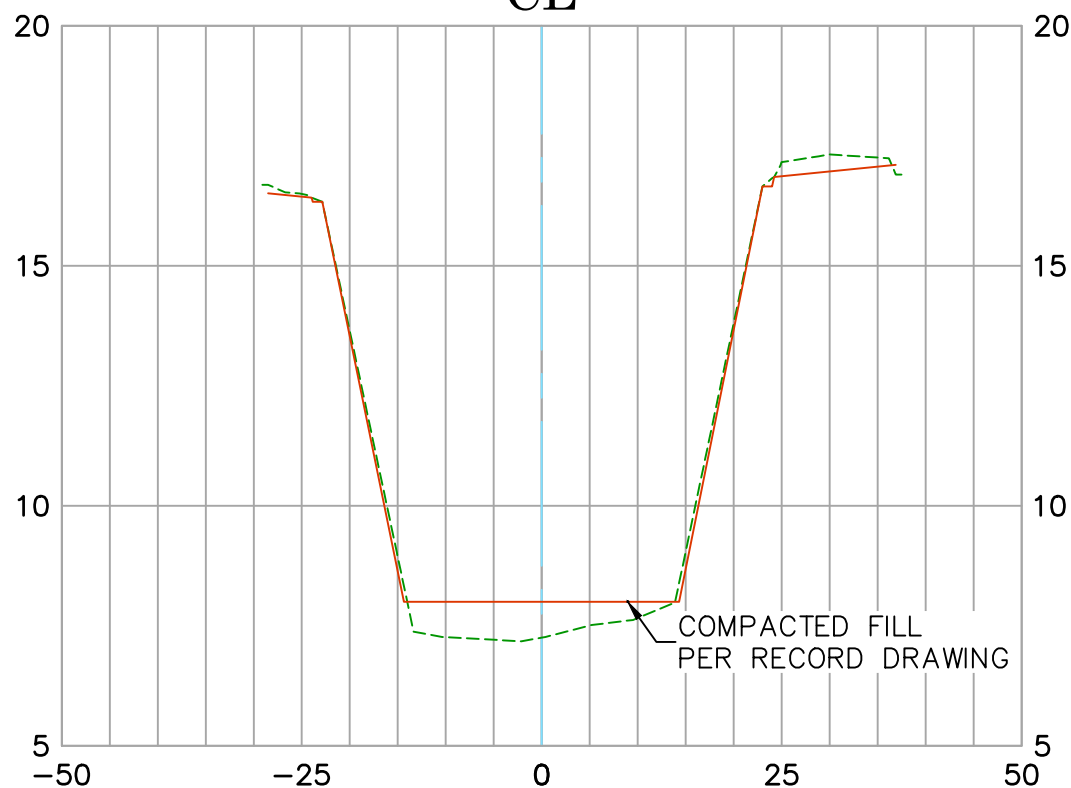

Existing Condition 2020
 Record Drawing D05-101-7R

Date Prepared: 09/16/2020

Vert. Scale: 1"=4'
 Hor. Scale: 1"=20'

U.S. Survey Foot


OC Public Works
OC Survey/Field Services
Boundary Analysis & Mapping



FOUNTAIN VALLEY CHANNEL (D05)

61+50.00

CL

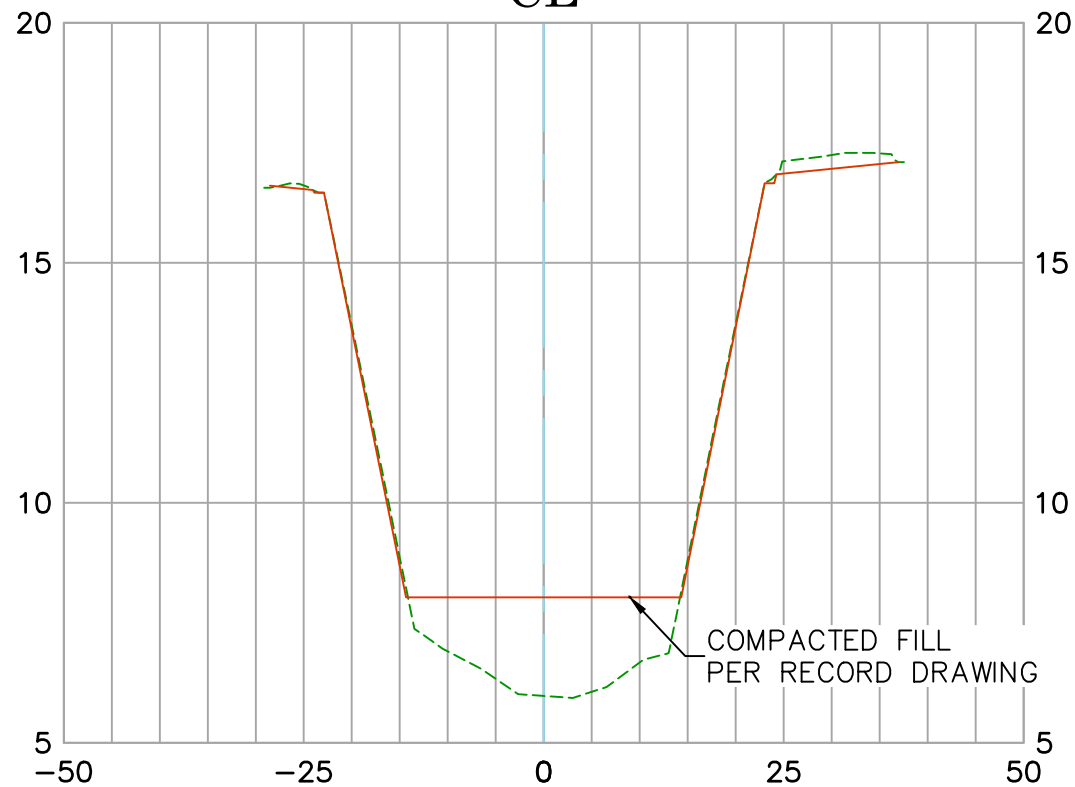

Existing Condition 2020
Record Drawing D05-101-7R



Date Prepared: 09/16/2020

Vert. Scale: 1"=4'
Hor. Scale: 1"=20'




FOUNTAIN VALLEY CHANNEL (D05)

61+91.24
CL

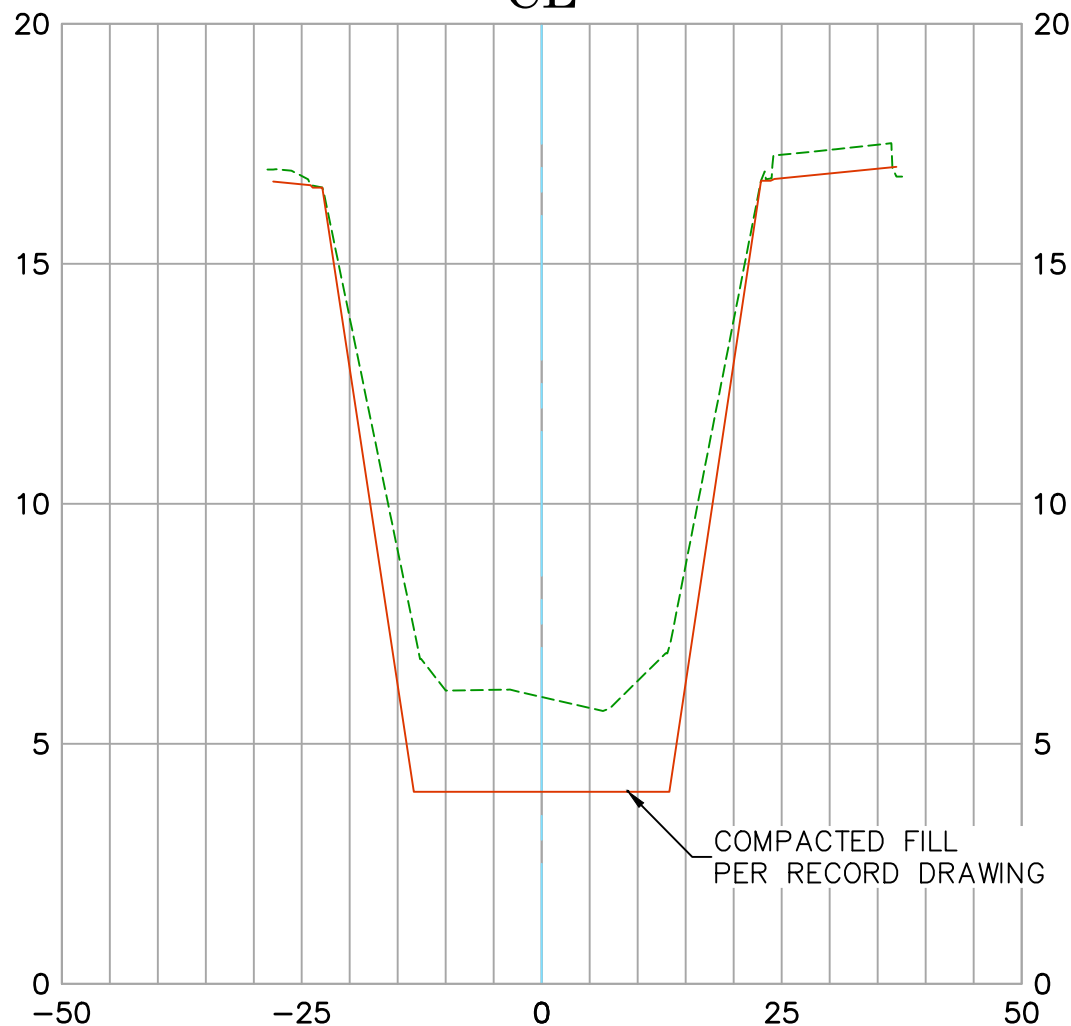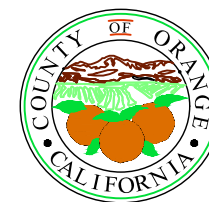

Existing Condition 2020
Record Drawing D05-101-7R

Date Prepared: 09/16/2020

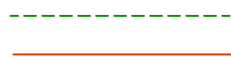

Vert. Scale: 1"=4'
Hor. Scale: 1"=20'

U.S. Survey Foot


OC Public Works
OC Survey/Field Services
Boundary Analysis & Mapping



FOUNTAIN VALLEY CHANNEL (D05)

63+92.92

CL

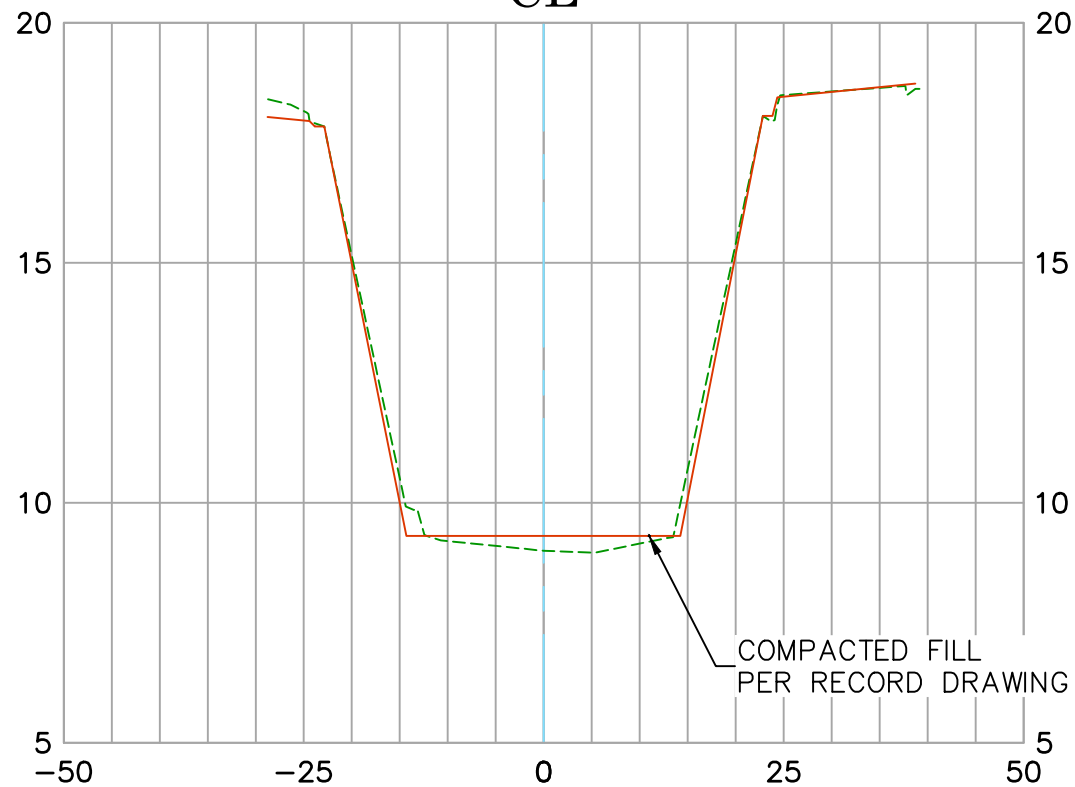

Existing Condition 2020
Record Drawing D05-101-7R

Date Prepared: 09/16/2020


Vert. Scale: 1"=4'
Hor. Scale: 1"=20'



FOUNTAIN VALLEY CHANNEL (D05)

64+00.00

CL

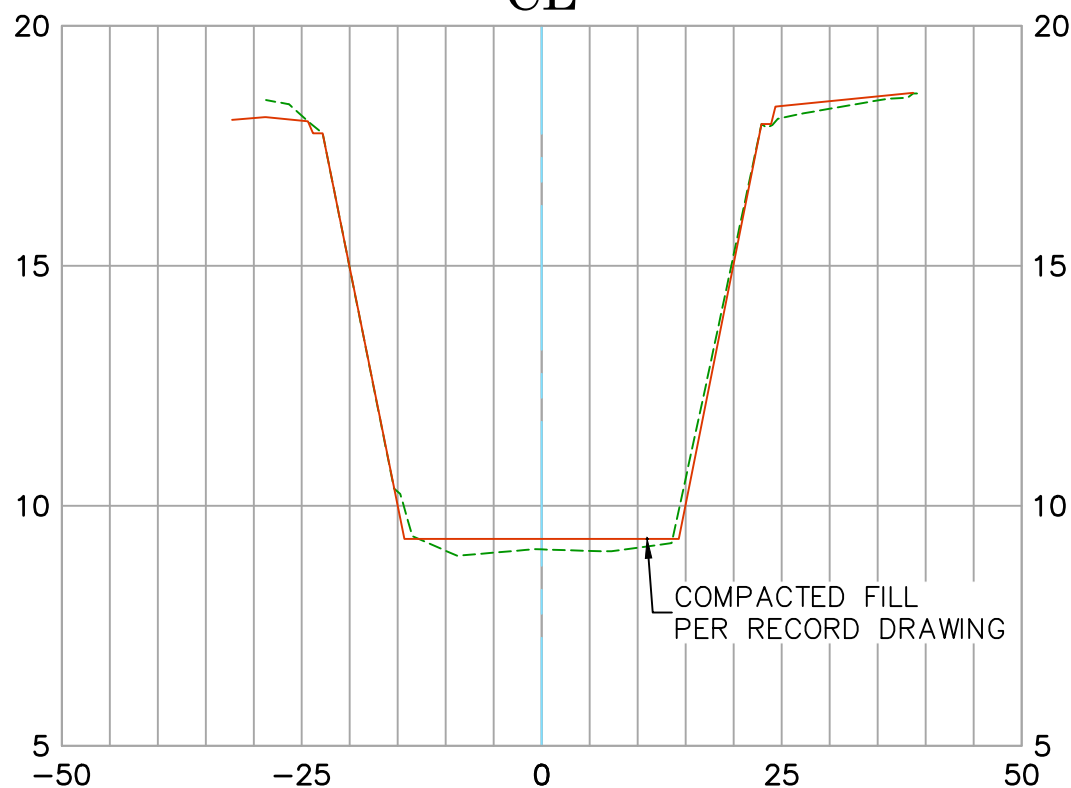

Existing Condition 2020
 Record Drawing D05-101-7R

Date Prepared: 09/16/2020


Vert. Scale: 1"=4'
 Hor. Scale: 1"=20'



FOUNTAIN VALLEY CHANNEL (D05)

64+50.00

CL

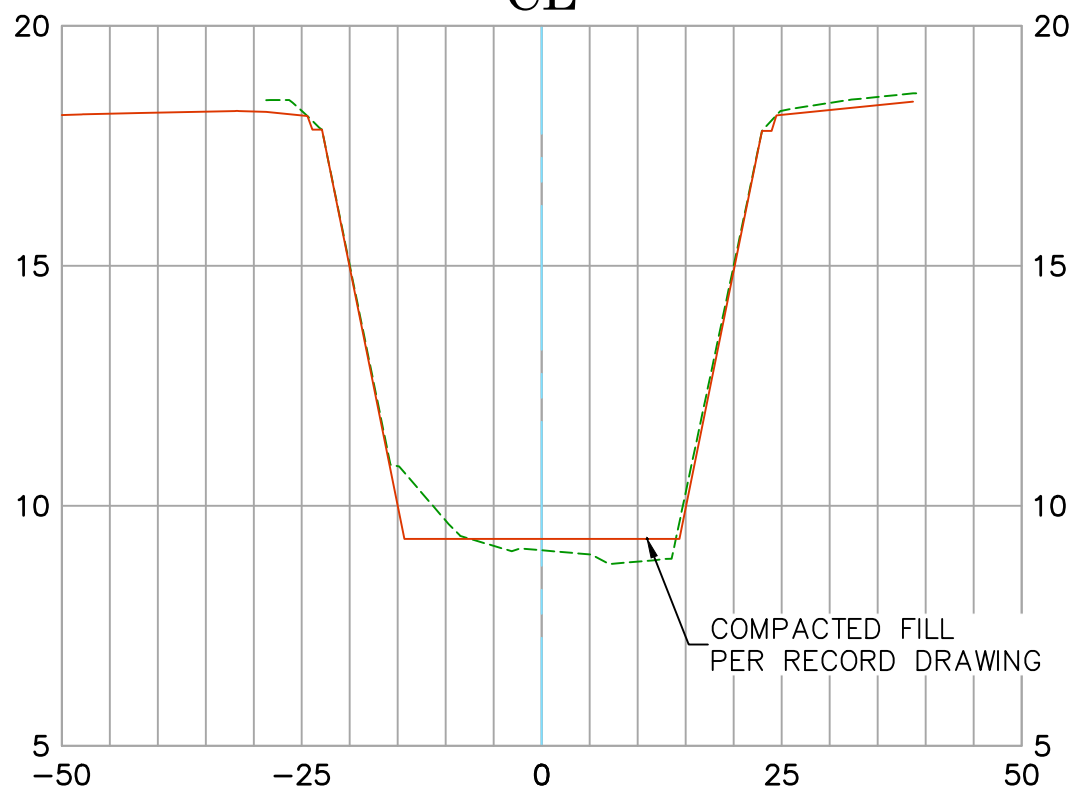

Existing Condition 2020
 Record Drawing D05-101-7R

Date Prepared: 09/16/2020


Vert. Scale: 1"=4'
 Hor. Scale: 1"=20'



FOUNTAIN VALLEY CHANNEL (D05)

65+00.00

CL

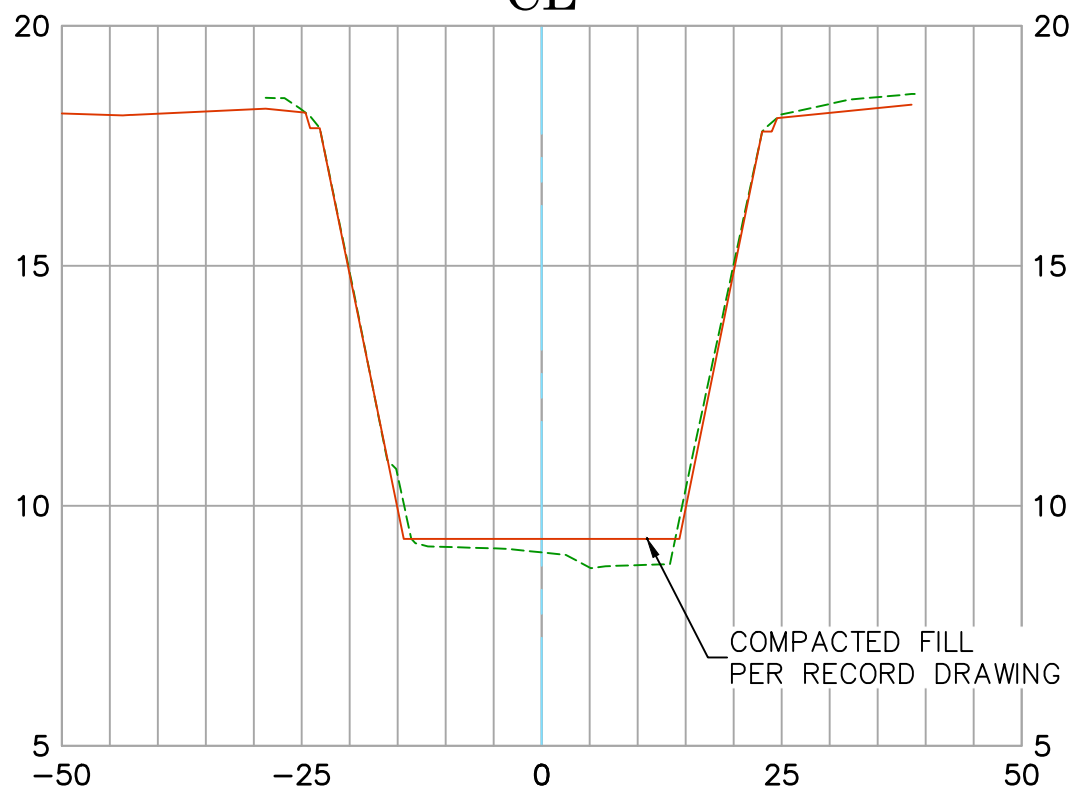

Existing Condition 2020
 Record Drawing D05-101-7R

Date Prepared: 09/16/2020


Vert. Scale: 1"=4'
 Hor. Scale: 1"=20'



FOUNTAIN VALLEY CHANNEL (D05)

65+50.00

CL

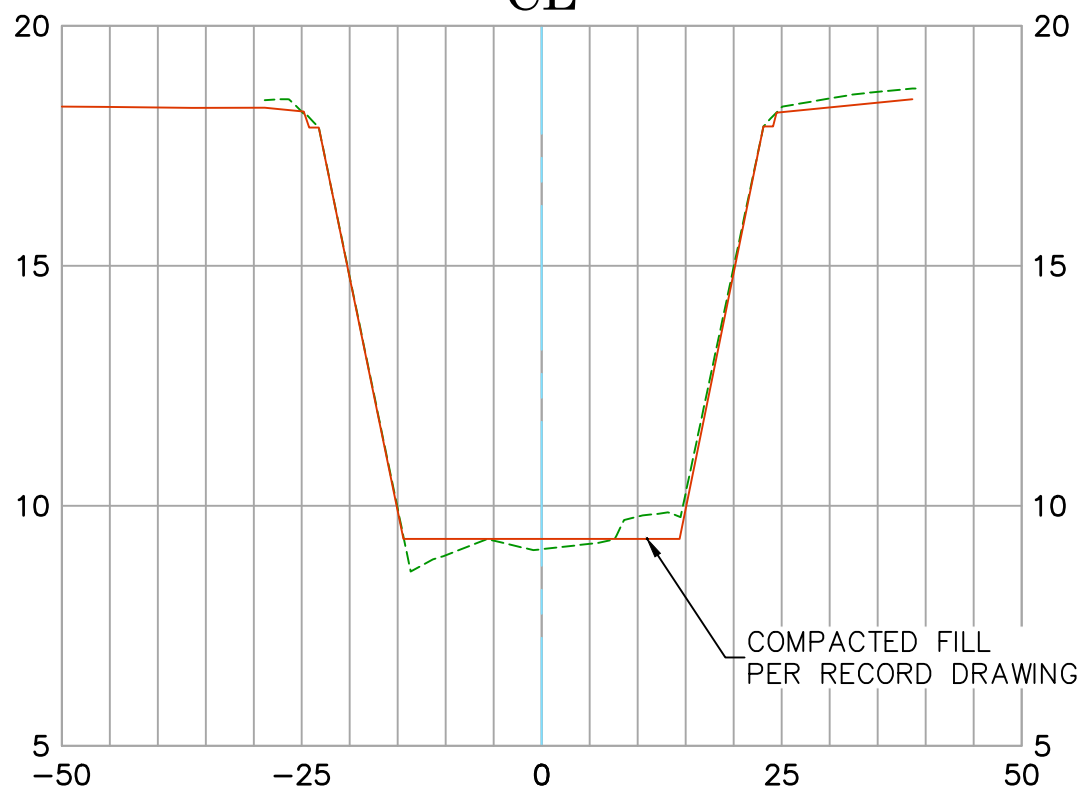

Existing Condition 2020
 Record Drawing D05-101-7R

Date Prepared: 09/16/2020

Vert. Scale: 1"=4'
 Hor. Scale: 1"=20'

U.S. Survey Foot


OC Public Works
OC Survey/Field Services
Boundary Analysis & Mapping



FOUNTAIN VALLEY CHANNEL (D05)

66+00.00

CL

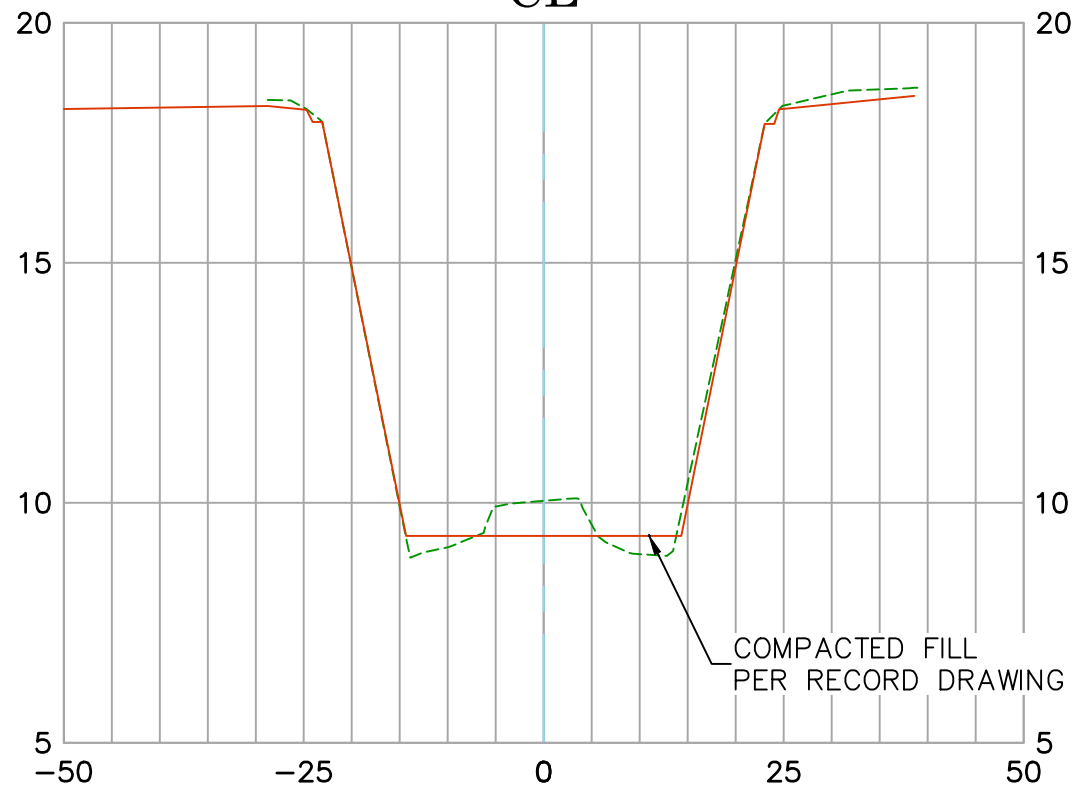

Existing Condition 2020
Record Drawing D05-101-7R

Date Prepared: 09/16/2020

Vert. Scale: 1"=4'
Hor. Scale: 1"=20'

U.S. Survey Foot


OC Public Works
OC Survey/Field Services
Boundary Analysis & Mapping



FOUNTAIN VALLEY CHANNEL (D05)

66+50.00

CL

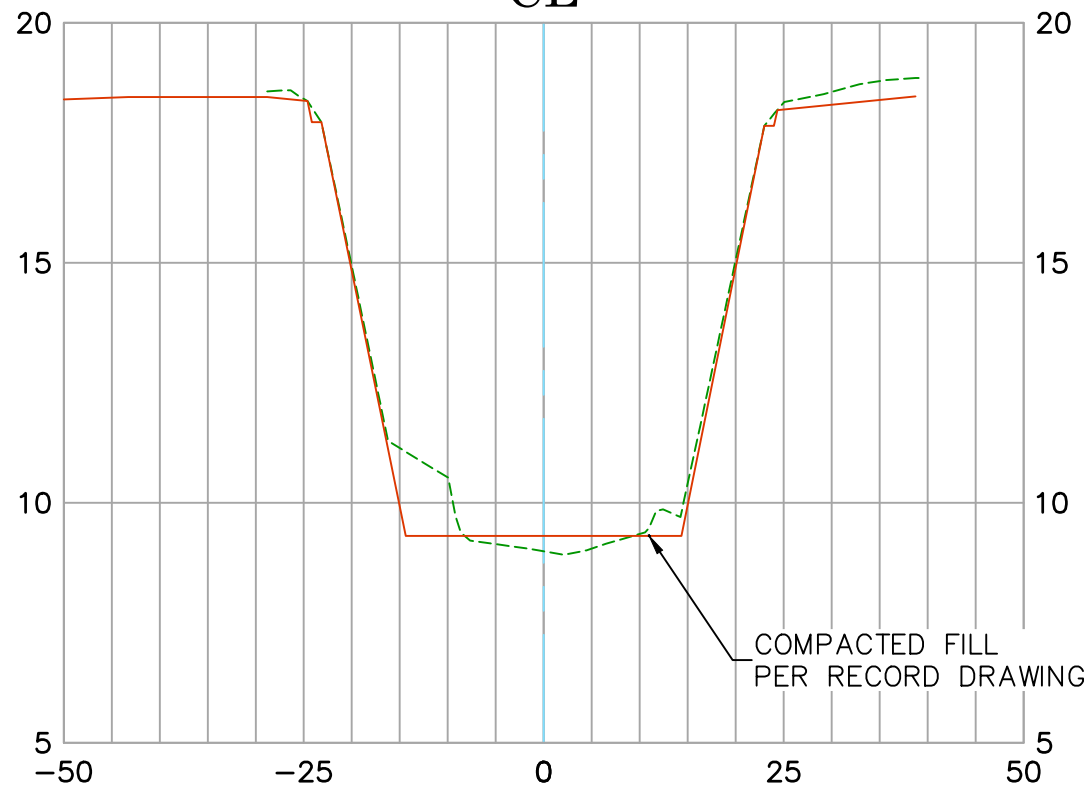

Existing Condition 2020
Record Drawing D05-101-7R

Date Prepared: 09/16/2020

Vert. Scale: 1"=4'
Hor. Scale: 1"=20'

U.S. Survey Foot


OC Public Works
OC Survey/Field Services
Boundary Analysis & Mapping



FOUNTAIN VALLEY CHANNEL (D05)

67+00.00

CL

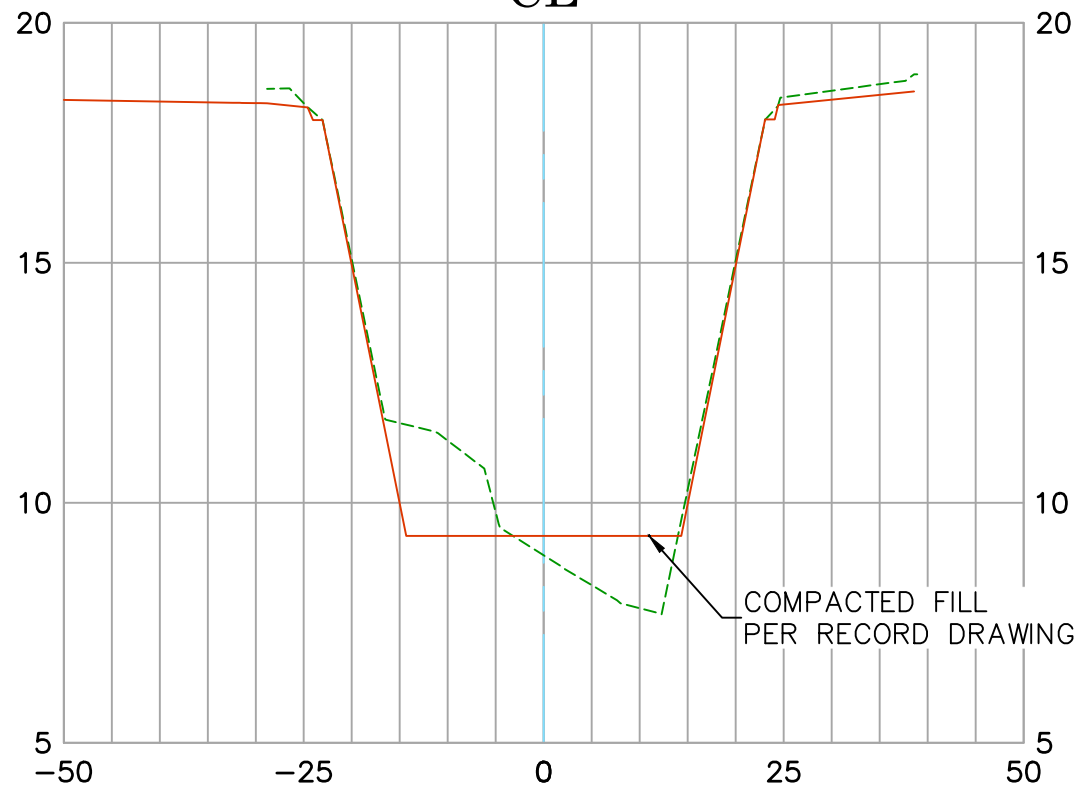

Existing Condition 2020
Record Drawing D05-101-7R

Date Prepared: 09/16/2020


Vert. Scale: 1"=4'
Hor. Scale: 1"=20'



FOUNTAIN VALLEY CHANNEL (D05)

67+50.00

CL

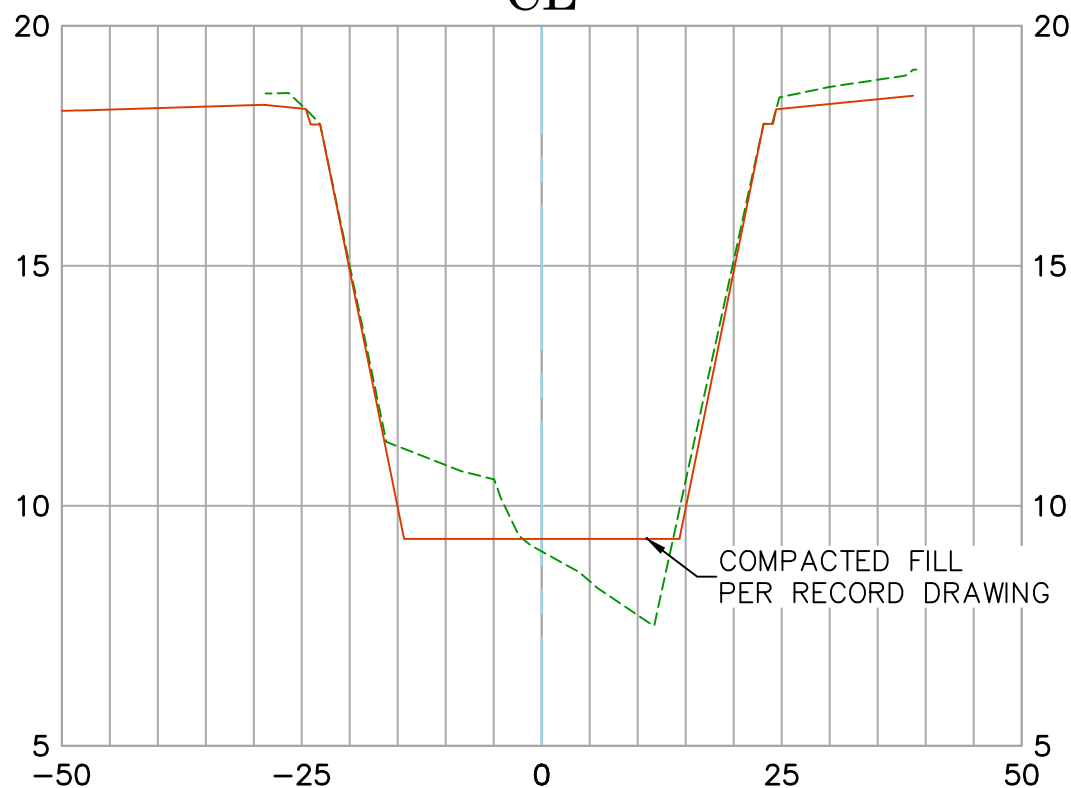

Existing Condition 2020
 Record Drawing D05-101-7R

Date Prepared: 09/16/2020

Vert. Scale: 1"=4'
 Hor. Scale: 1"=20'

U.S. Survey Foot


OC Public Works
OC Survey/Field Services
Boundary Analysis & Mapping



FOUNTAIN VALLEY CHANNEL (D05)

68+00.00

CL

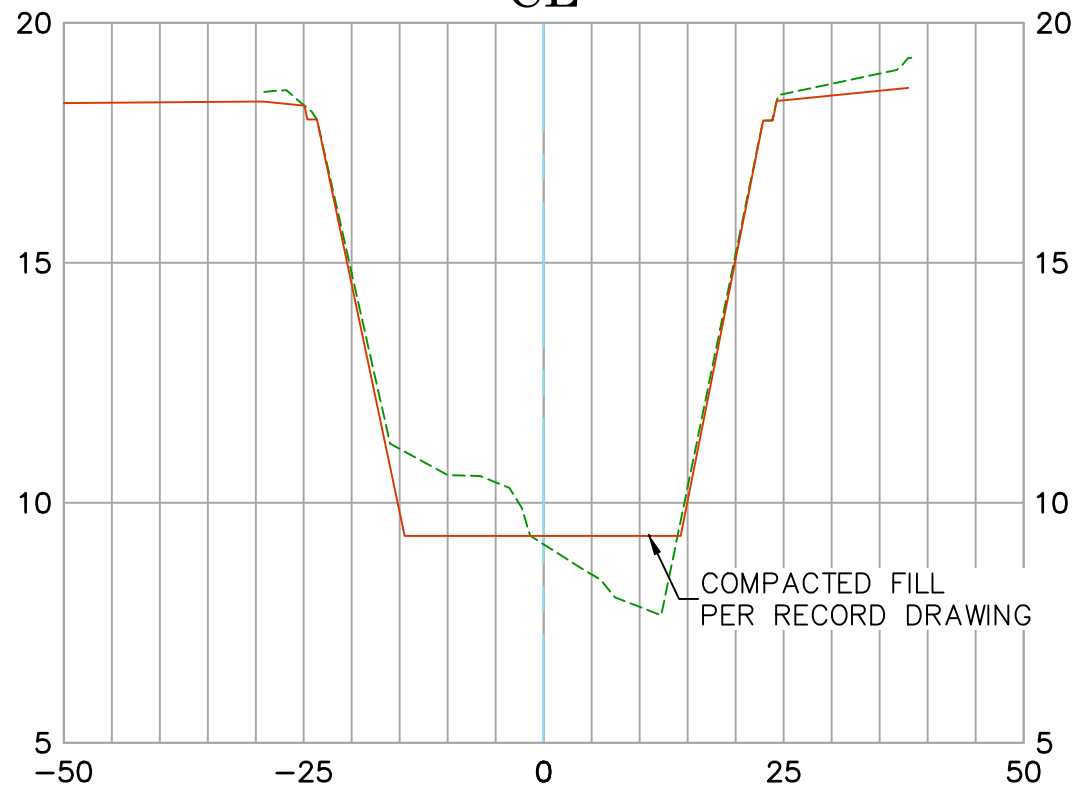

Existing Condition 2020
Record Drawing D05-101-7R

Date Prepared: 09/16/2020


Vert. Scale: 1"=4'
Hor. Scale: 1"=20'



FOUNTAIN VALLEY CHANNEL (D05)

68+50.00

CL

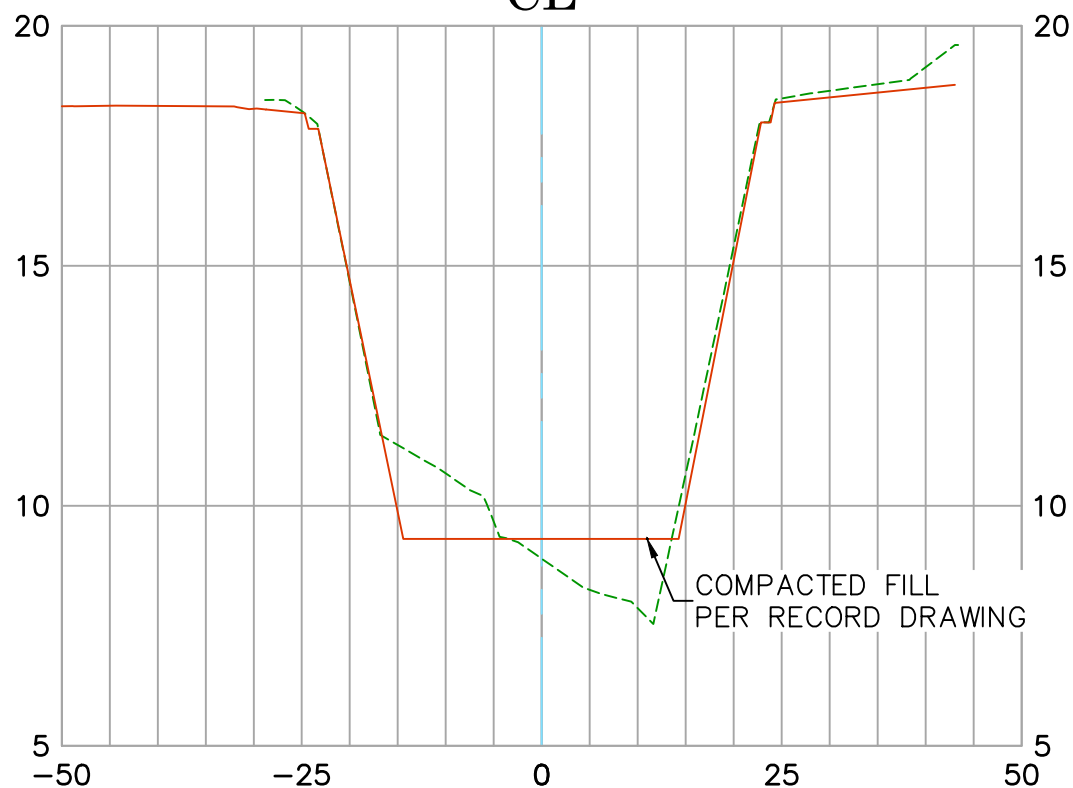

Existing Condition 2020
Record Drawing D05-101-7R

Date Prepared: 09/16/2020

Vert. Scale: 1"=4'
Hor. Scale: 1"=20'

U.S. Survey Foot


OC Public Works
OC Survey/Field Services
Boundary Analysis & Mapping



FOUNTAIN VALLEY CHANNEL (D05)

69+00.00

CL

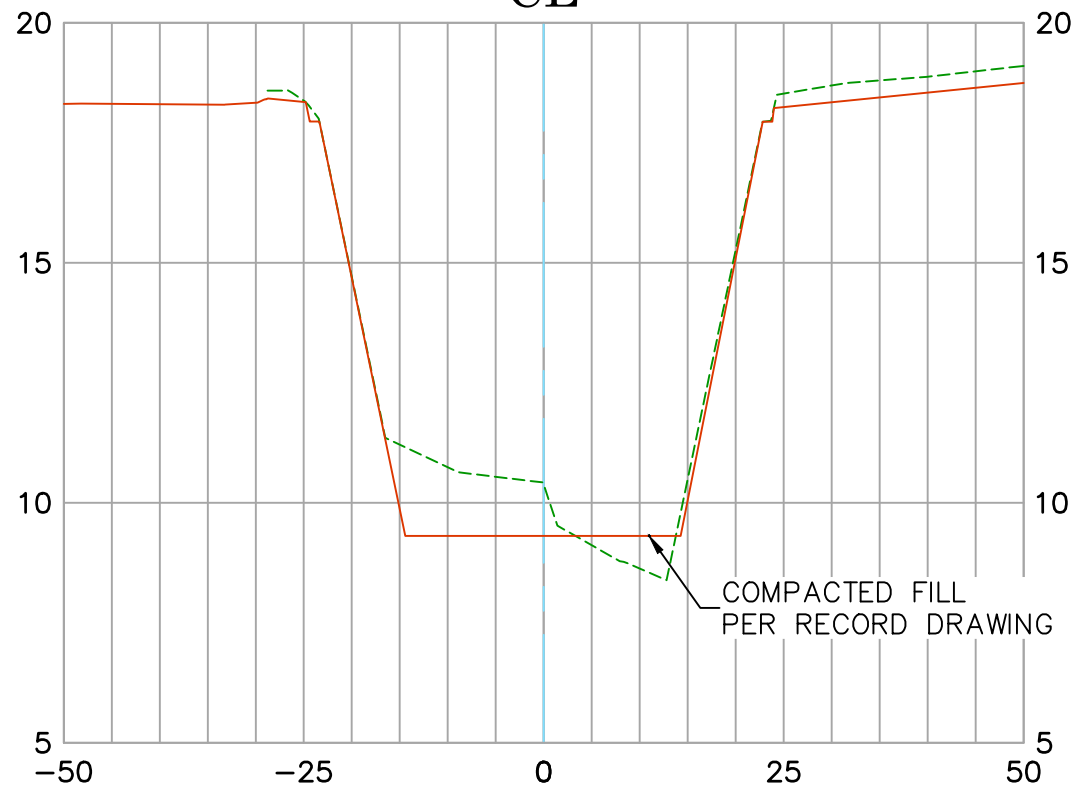

Existing Condition 2020
Record Drawing D05-101-7R

Date Prepared: 09/16/2020


Vert. Scale: 1"=4'
Hor. Scale: 1"=20'



FOUNTAIN VALLEY CHANNEL (D05)

69+50.00

CL

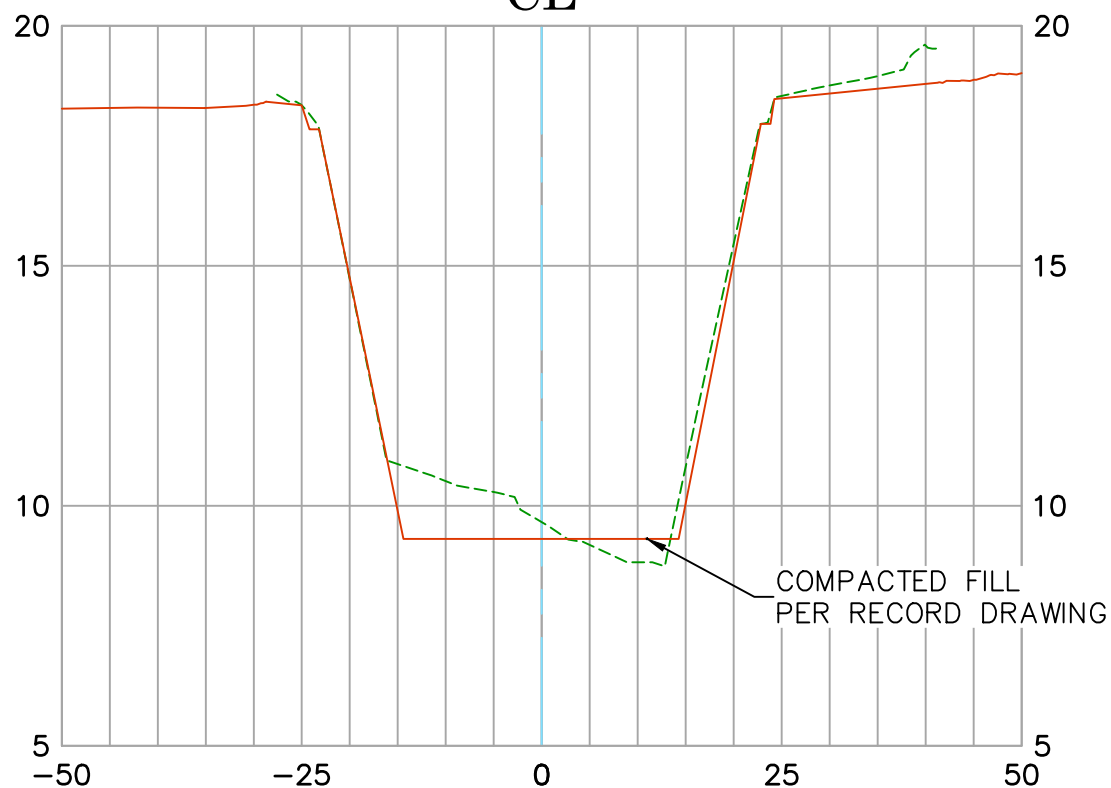

Existing Condition 2020
 Record Drawing D05-101-7R

Date Prepared: 09/16/2020

Vert. Scale: 1"=4'
 Hor. Scale: 1"=20'

U.S. Survey Foot


OC Public Works
OC Survey/Field Services
Boundary Analysis & Mapping



FOUNTAIN VALLEY CHANNEL (D05)

70+00.00

CL

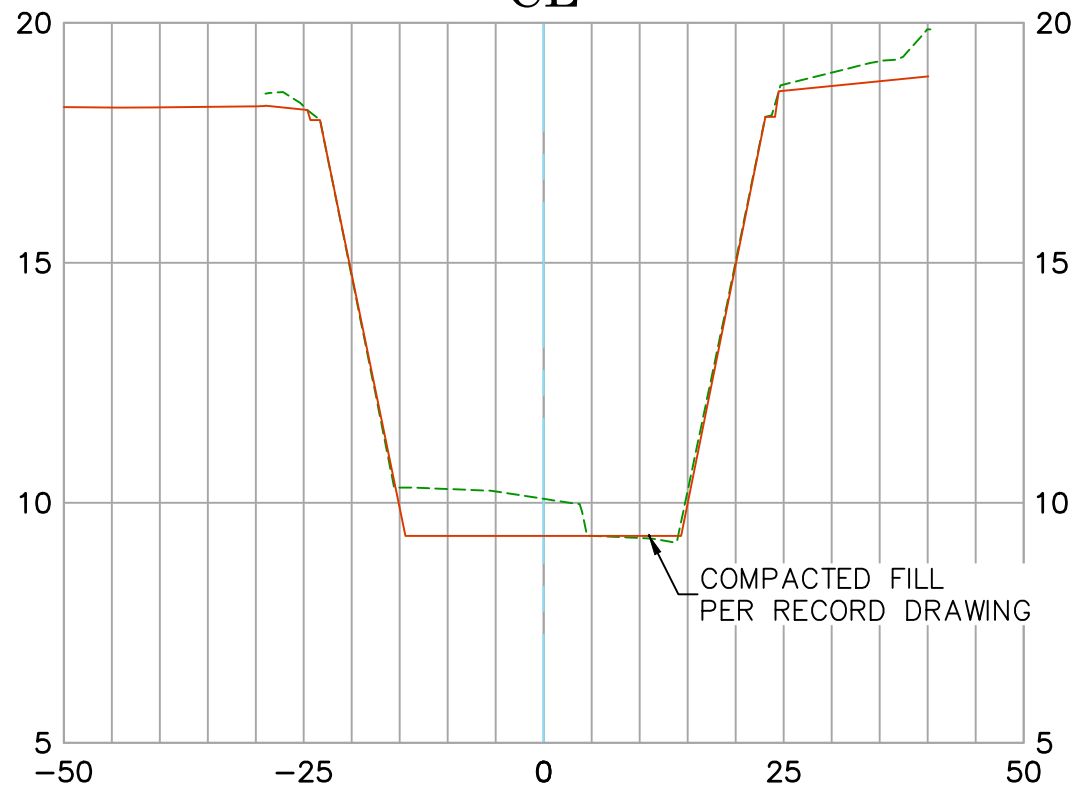

Existing Condition 2020
Record Drawing D05-101-7R

Date Prepared: 09/16/2020

Vert. Scale: 1"=4'
Hor. Scale: 1"=20'

U.S. Survey Foot


OC Public Works
OC Survey/Field Services
Boundary Analysis & Mapping



FOUNTAIN VALLEY CHANNEL (D05)

70+50.00

CL

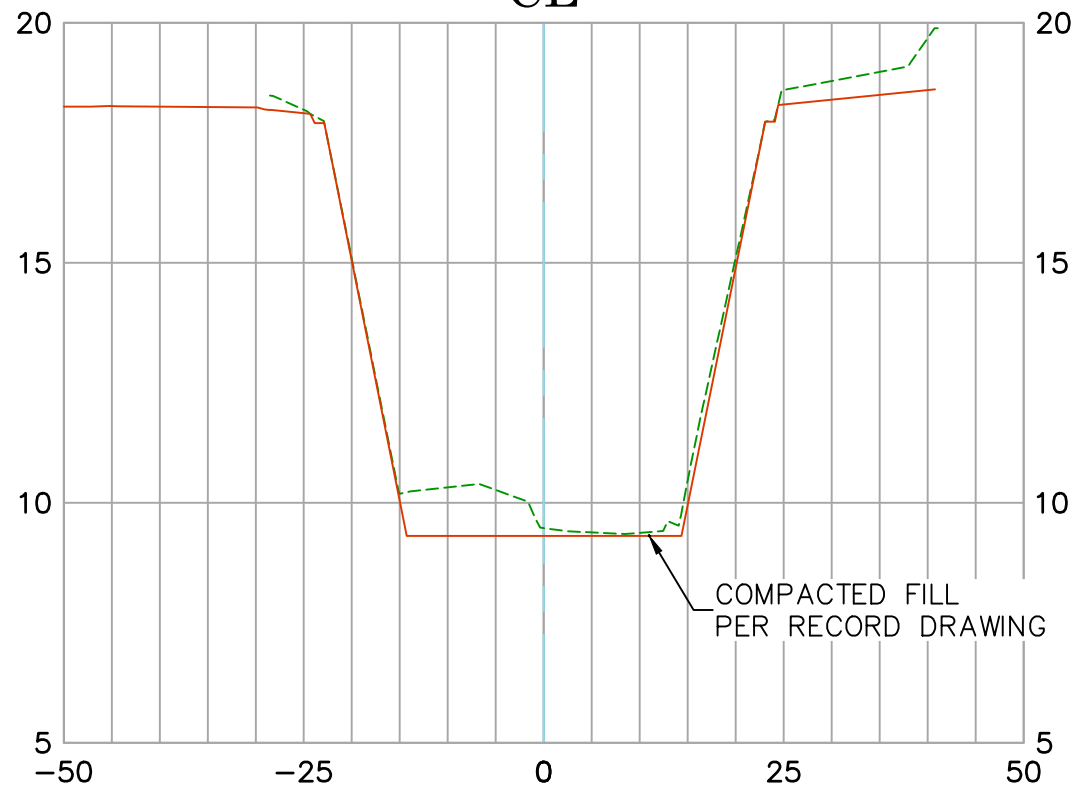

Existing Condition 2020
Record Drawing D05-101-7R

Date Prepared: 09/16/2020

Vert. Scale: 1"=4'
Hor. Scale: 1"=20'

U.S. Survey Foot


OC Public Works
OC Survey/Field Services
Boundary Analysis & Mapping



FOUNTAIN VALLEY CHANNEL (D05)

71+00.00

CL

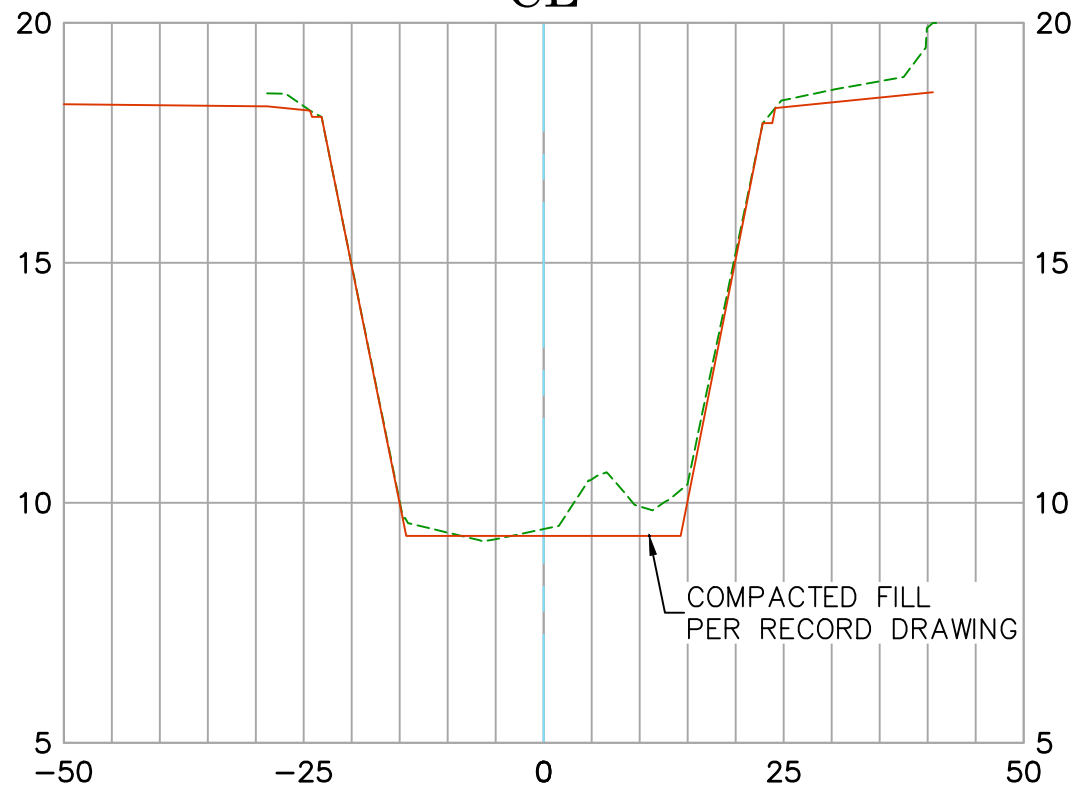

Existing Condition 2020
Record Drawing D05-101-7R

Date Prepared: 09/16/2020


Vert. Scale: 1"=4'
Hor. Scale: 1"=20'



FOUNTAIN VALLEY CHANNEL (D05)


71+50.00

CL

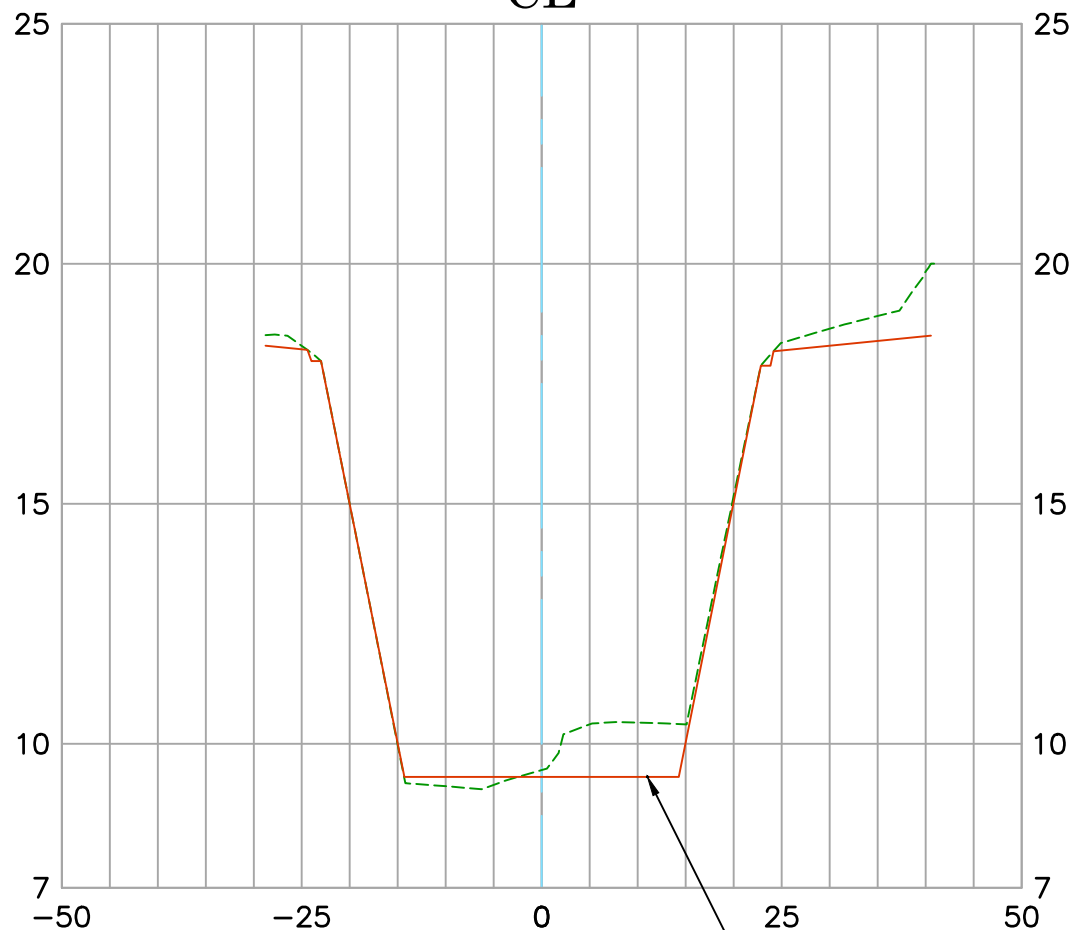

Existing Condition 2020
 Record Drawing D05-101-7R

Date Prepared: 09/16/2020

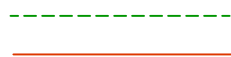

COMPACTED FILL
 PER RECORD DRAWING

Vert. Scale: 1"=4'
 Hor. Scale: 1"=20'

U.S. Survey Foot


OC Public Works
OC Survey/Field Services
Boundary Analysis & Mapping



FOUNTAIN VALLEY CHANNEL (D05)

72+00.00

CL

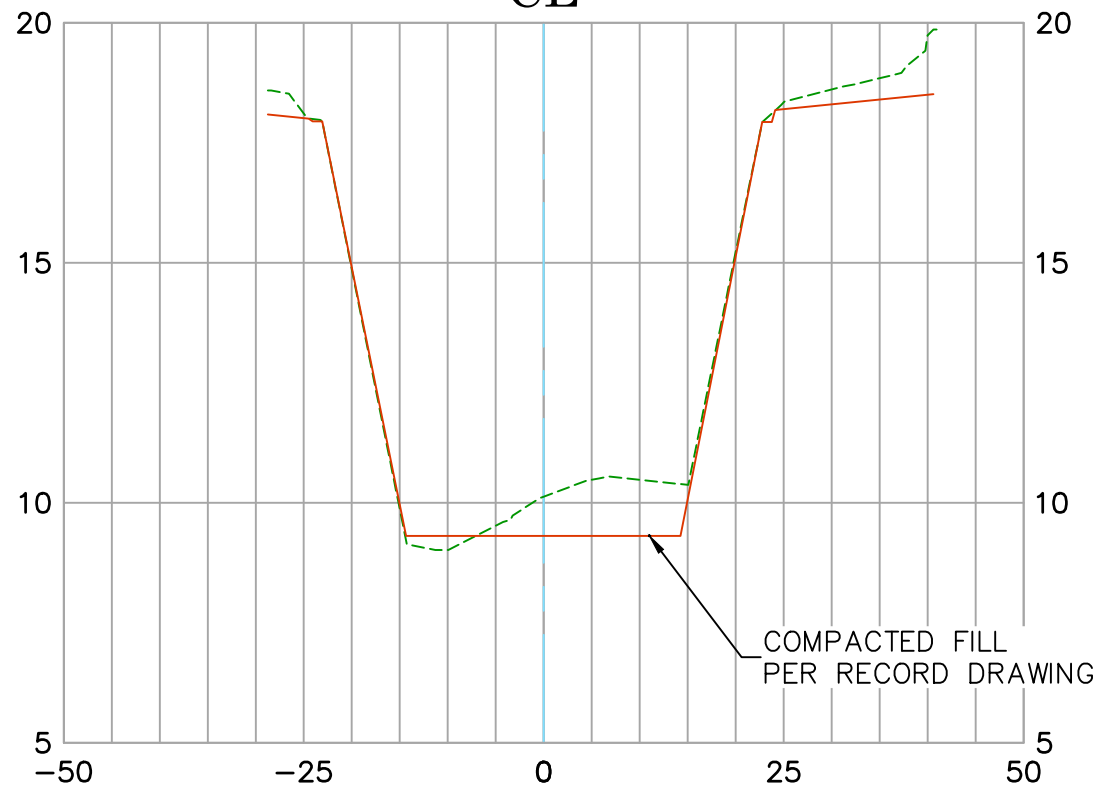

Existing Condition 2020
Record Drawing D05-101-7R

Date Prepared: 09/16/2020

Vert. Scale: 1"=4'
Hor. Scale: 1"=20'

U.S. Survey Foot


OC Public Works
OC Survey/Field Services
Boundary Analysis & Mapping



FOUNTAIN VALLEY CHANNEL (D05)

72+50.00

CL

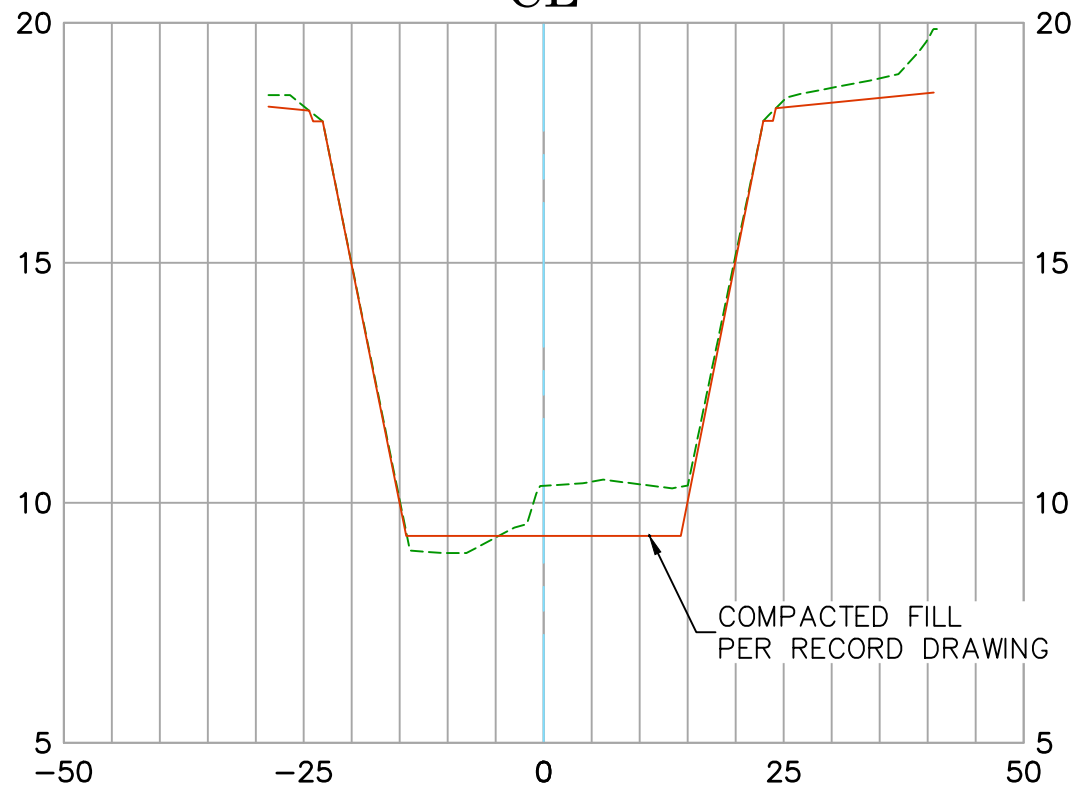

Existing Condition 2020
Record Drawing D05-101-7R



Date Prepared: 09/16/2020

Vert. Scale: 1"=4'
Hor. Scale: 1"=20'

FOUNTAIN VALLEY CHANNEL (D05)

73+00.00

CL

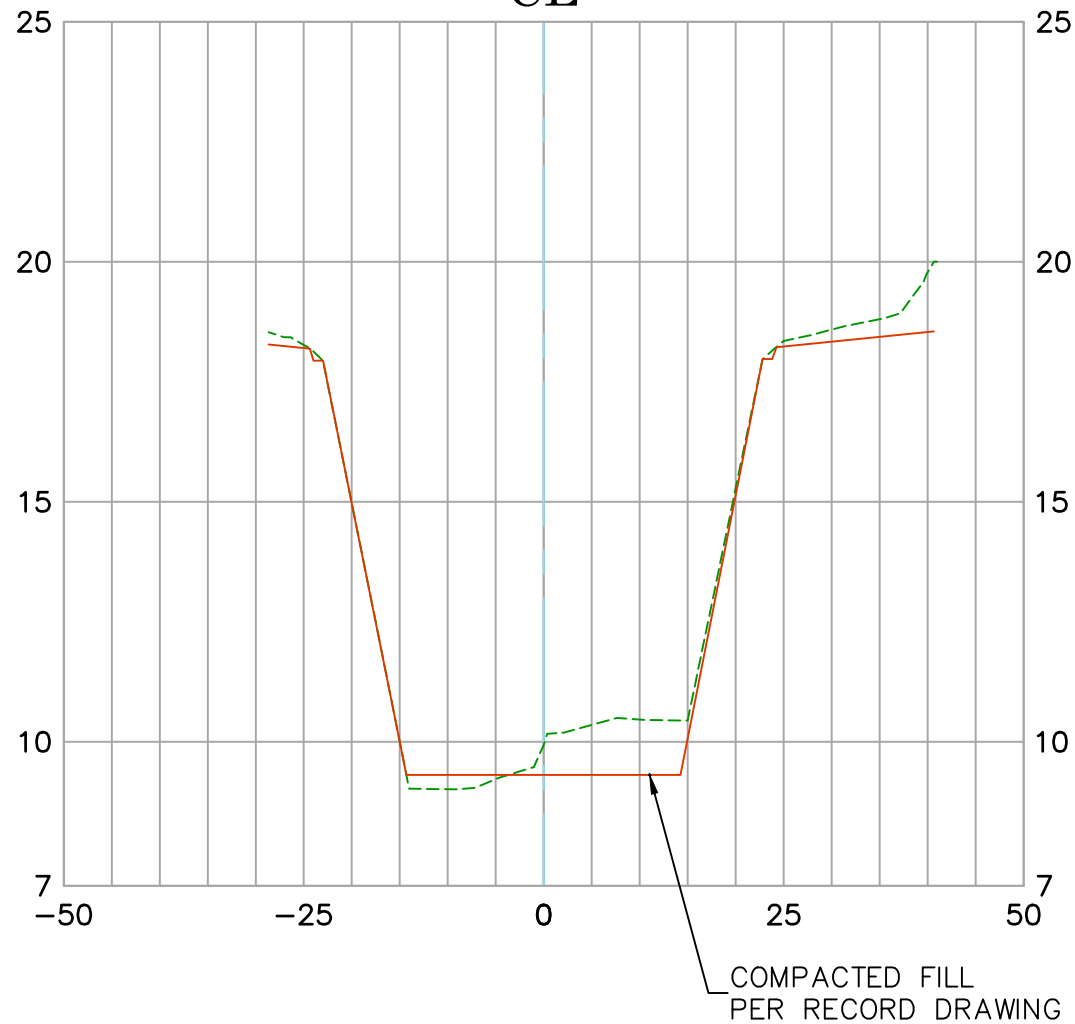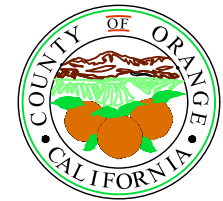

Existing Condition 2020
 Record Drawing D05-101-7R

Date Prepared: 09/16/2020

Vert. Scale: 1"=4'
 Hor. Scale: 1"=20'

U.S. Survey Foot


OC Public Works
OC Survey/Field Services
Boundary Analysis & Mapping



FOUNTAIN VALLEY CHANNEL (D05)

73+50.00

CL

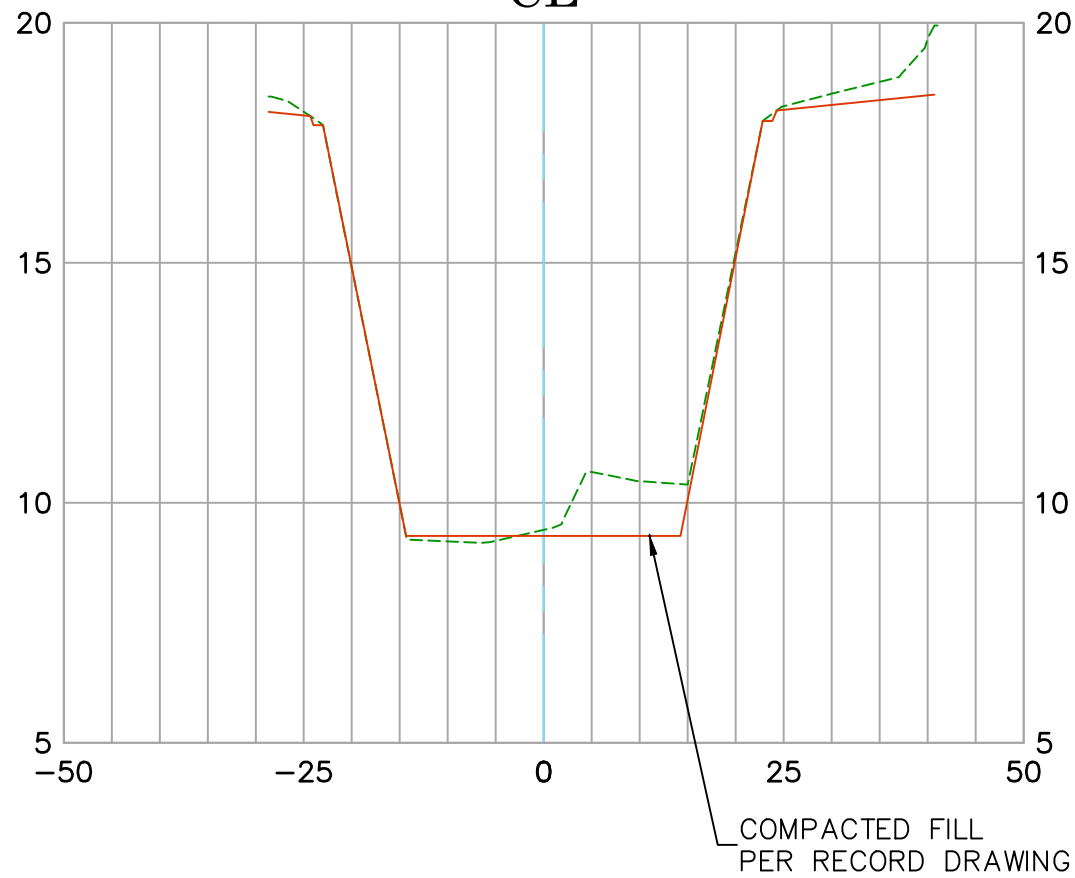

Existing Condition 2020
Record Drawing D05-101-7R


Date Prepared: 09/16/2020

Vert. Scale: 1"=4'
Hor. Scale: 1"=20'

FOUNTAIN VALLEY CHANNEL (D05)

74+00.00

CL

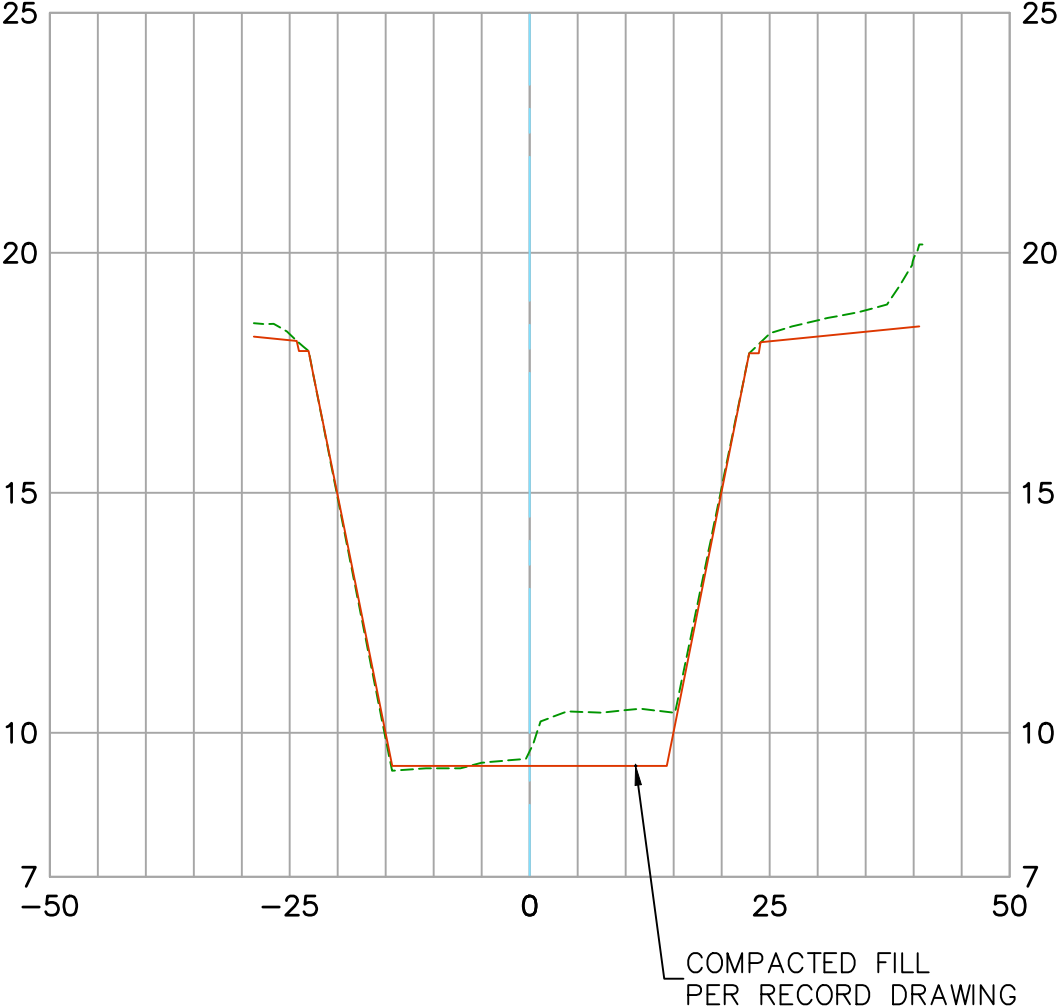

Existing Condition 2020
 Record Drawing D05-101-7R
 Date Prepared: 09/16/2020


Vert. Scale: 1"=4'
 Hor. Scale: 1"=20'



FOUNTAIN VALLEY CHANNEL (D05)

74+50.00

CL

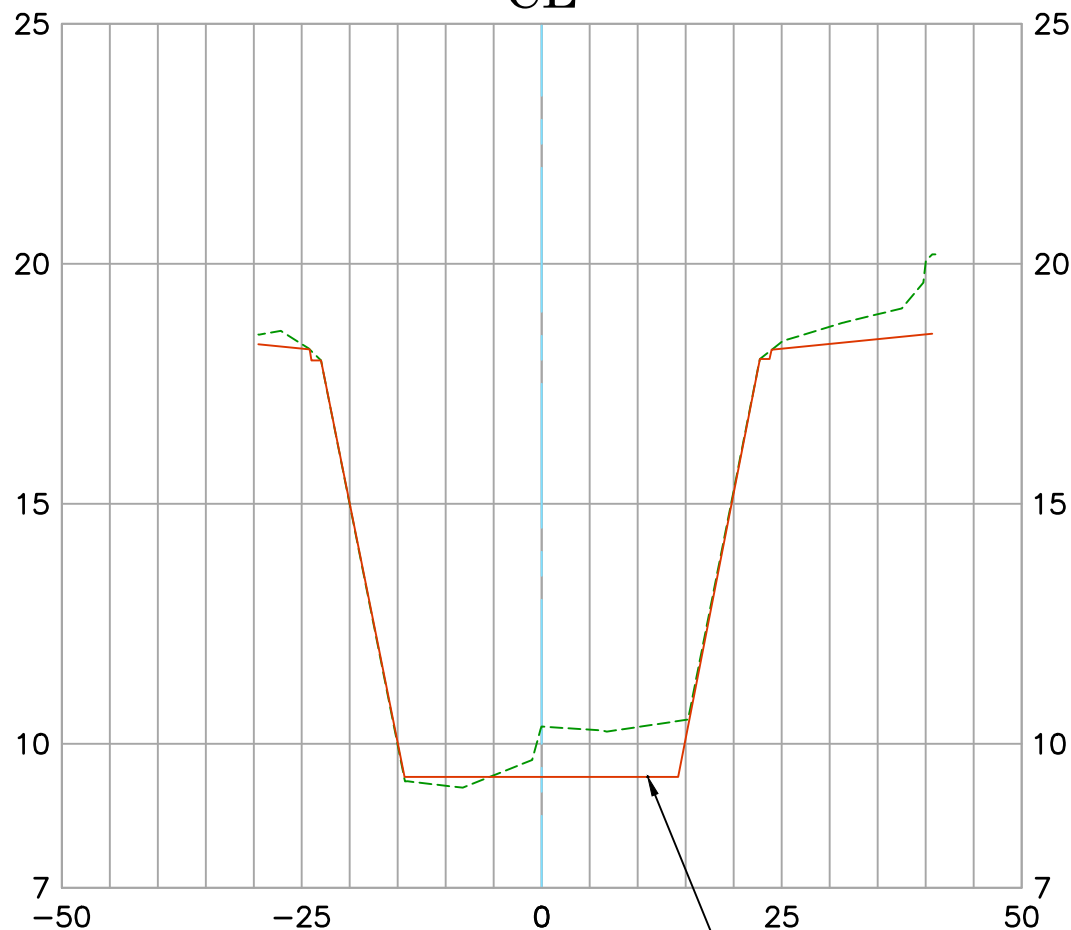

Existing Condition 2020
 Record Drawing D05-101-7R

Date Prepared: 09/16/2020



COMPACTED FILL
 PER RECORD DRAWING

Vert. Scale: 1"=4'
 Hor. Scale: 1"=20'

FOUNTAIN VALLEY CHANNEL (D05)

75+00.00

CL

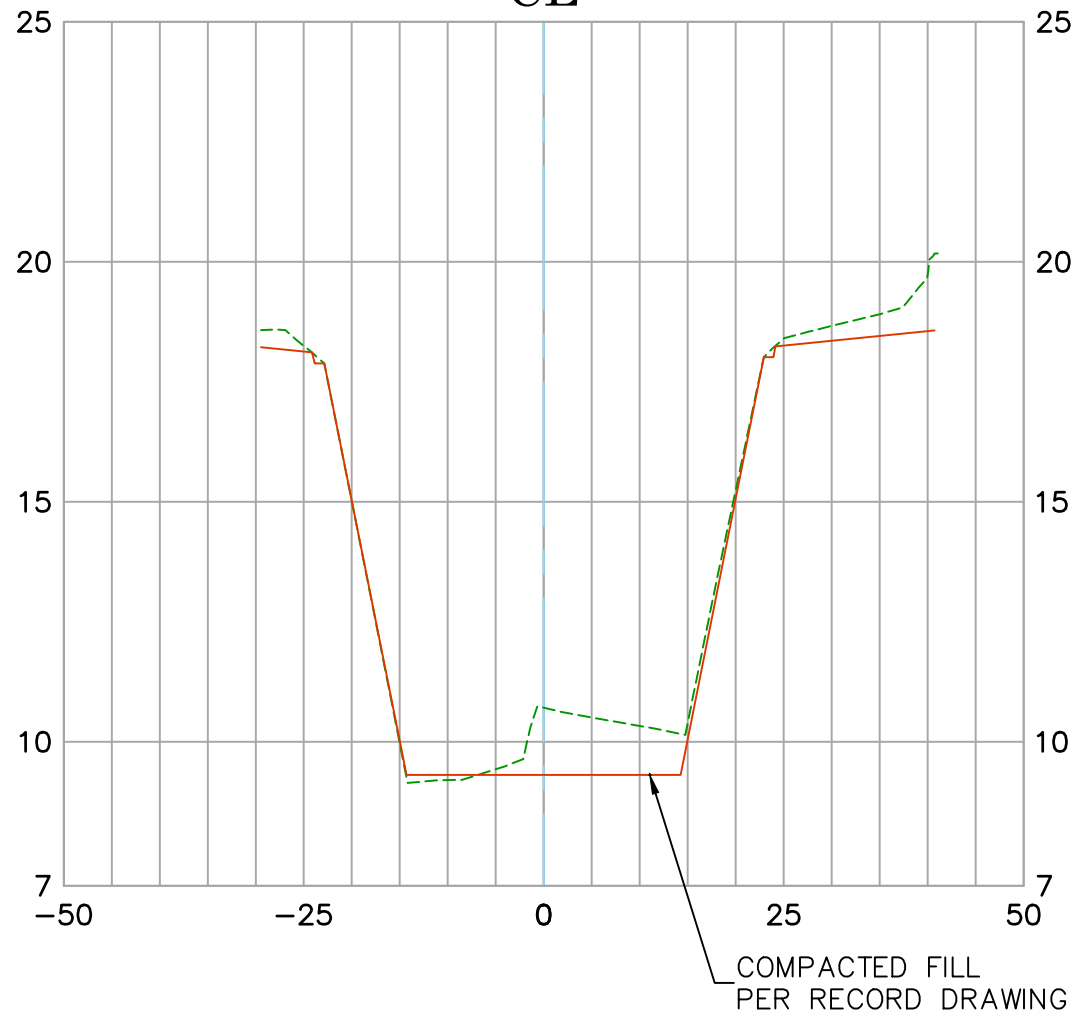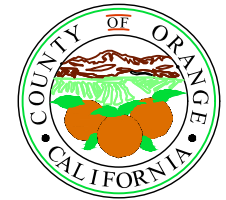

Existing Condition 2020
 Record Drawing D05-101-7R

Date Prepared: 09/16/2020

Vert. Scale: 1"=4'
 Hor. Scale: 1"=20'


**U.S. Survey
Foot**

OC Public Works
OC Survey/Field Services
Boundary Analysis & Mapping

FOUNTAIN VALLEY CHANNEL (D05)

75+50.00

CL

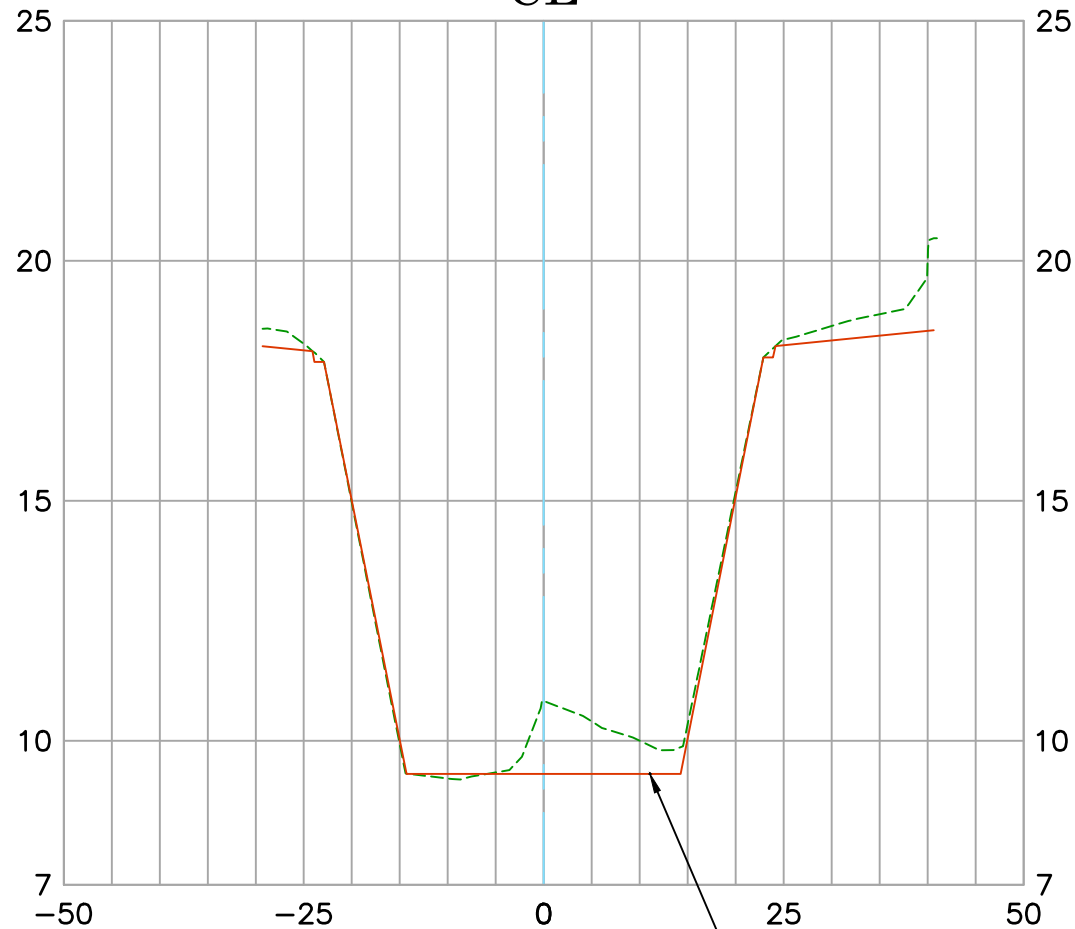

Existing Condition 2020
Record Drawing D05-101-7R

Date Prepared: 09/16/2020


COMPACTED FILL
PER RECORD DRAWING

Vert. Scale: 1"=4'
Hor. Scale: 1"=20'

FOUNTAIN VALLEY CHANNEL (D05)

76+00.00

CL

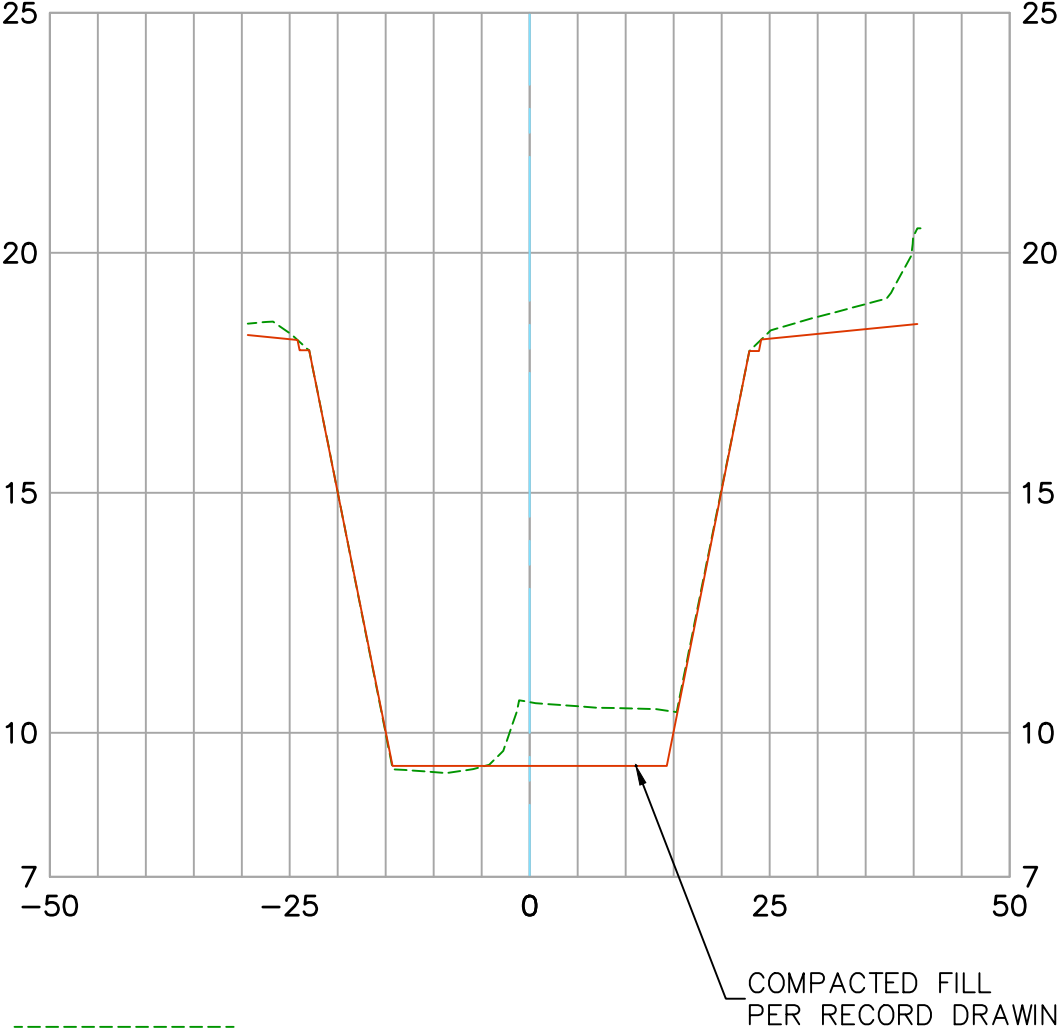


Existing Condition 2020
 Record Drawing D05-101-7R
 Date Prepared: 09/16/2020

Vert. Scale: 1"=4'
 Hor. Scale: 1"=20'

FOUNTAIN VALLEY CHANNEL (D05)

76+50.00

CL


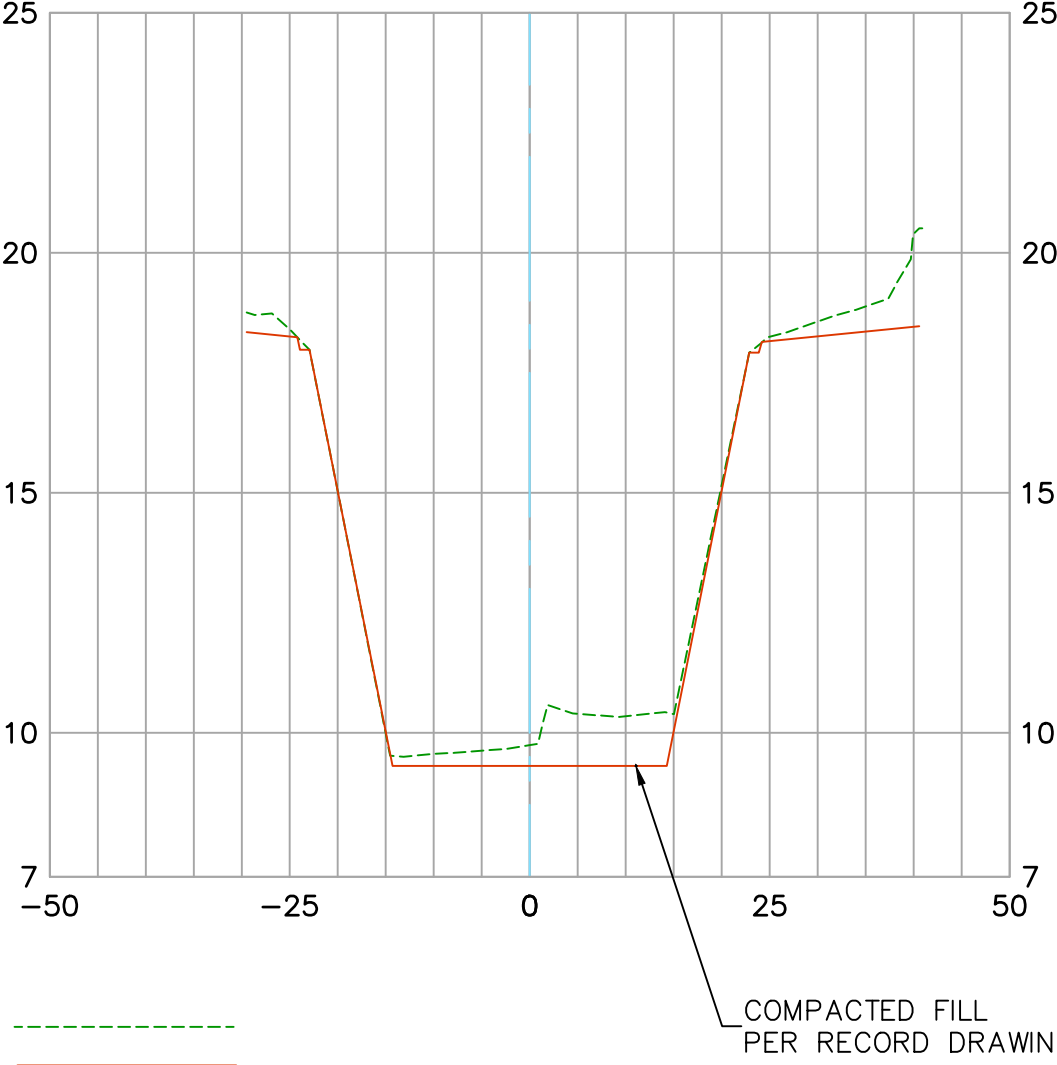


Existing Condition 2020
 Record Drawing D05-101-7R
 Date Prepared: 09/16/2020

Vert. Scale: 1"=4'
 Hor. Scale: 1"=20'

FOUNTAIN VALLEY CHANNEL (D05)

77+00.00
 CL

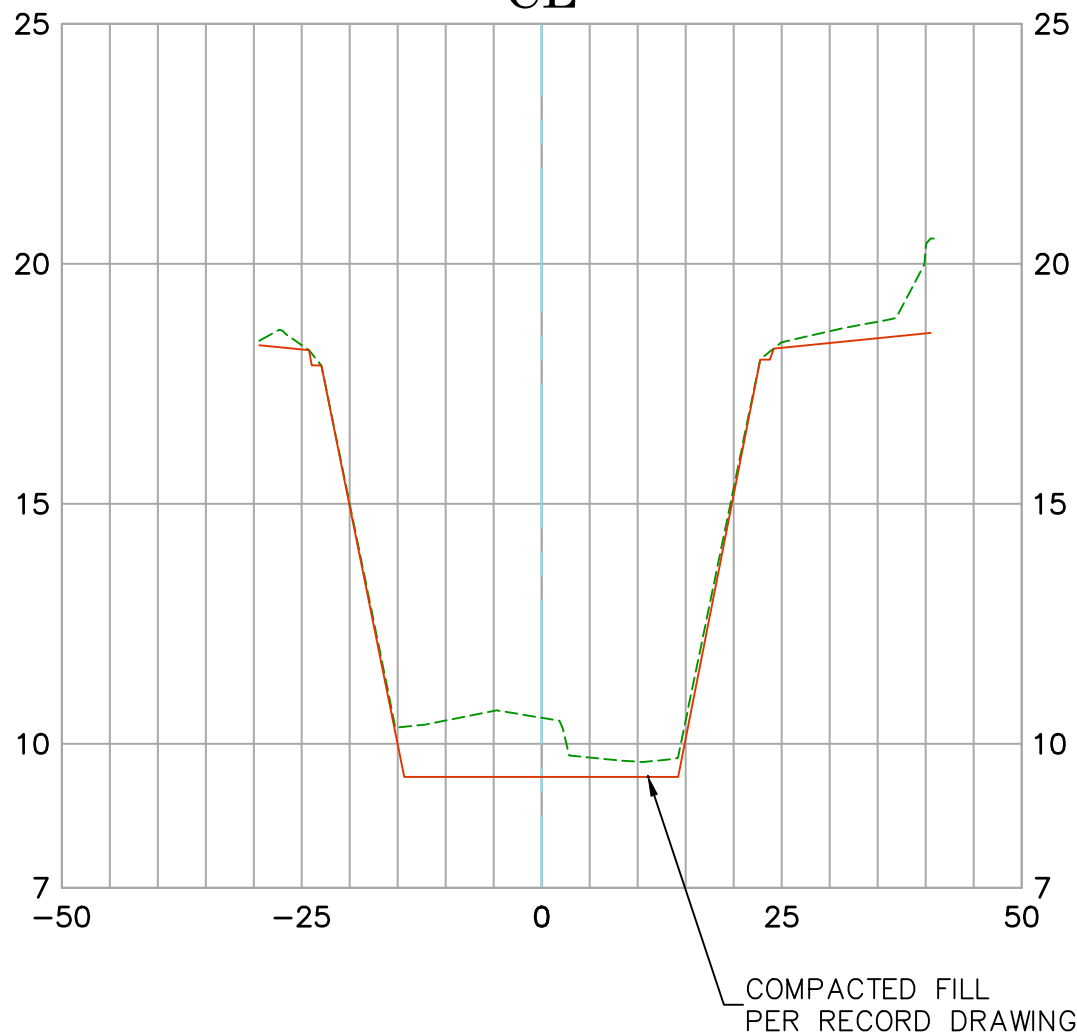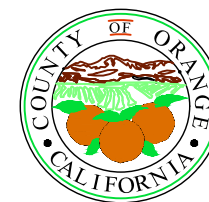

Existing Condition 2020
 Record Drawing D05-101-7R

Date Prepared: 09/16/2020

Vert. Scale: 1"=4'
 Hor. Scale: 1"=20'


**U.S. Survey
Foot**

OC Public Works
OC Survey/Field Services
Boundary Analysis & Mapping

FOUNTAIN VALLEY CHANNEL (D05)

77+50.00

CL

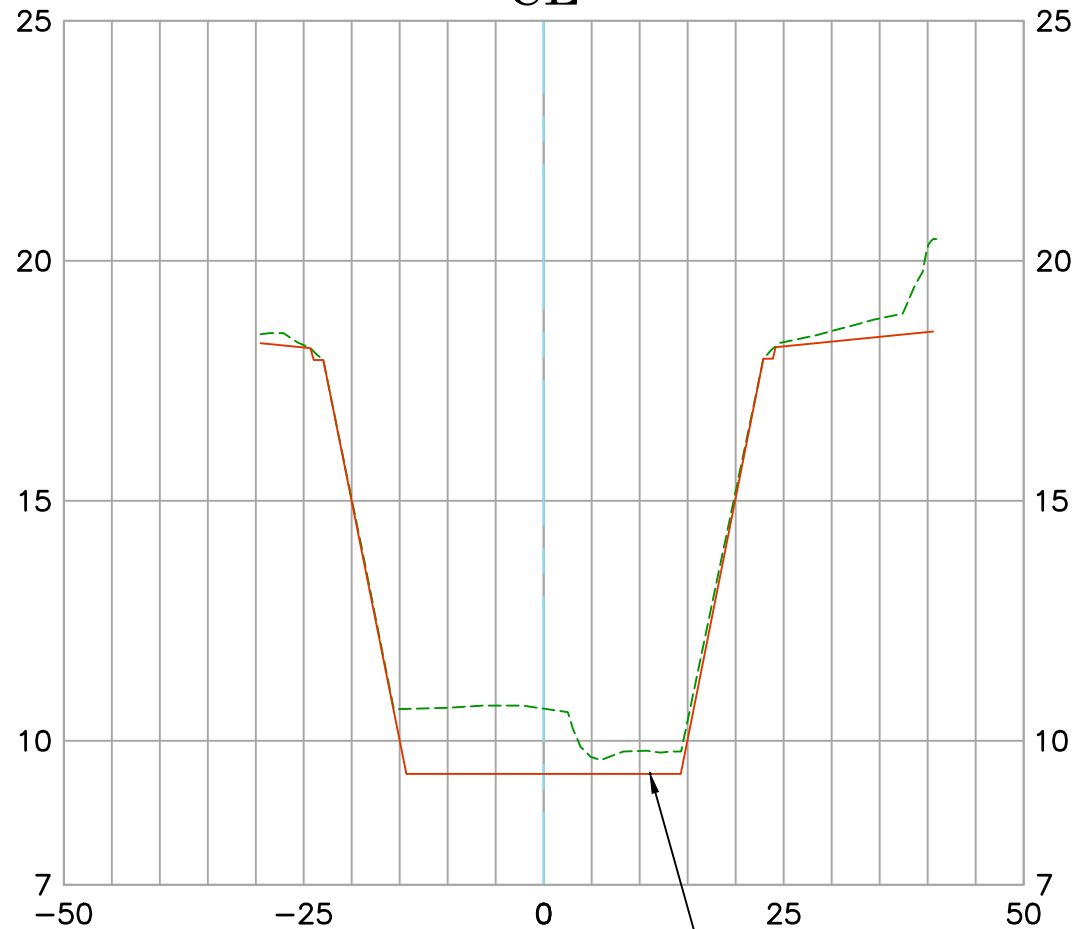

Existing Condition 2020
Record Drawing D05-101-7R

Date Prepared: 09/16/2020

--- Existing Condition 2020
— Compacted Fill

COMPACTED FILL
PER RECORD DRAWING


Vert. Scale: 1"=4'
Hor. Scale: 1"=20'



FOUNTAIN VALLEY CHANNEL (D05)

78+00.00

CL

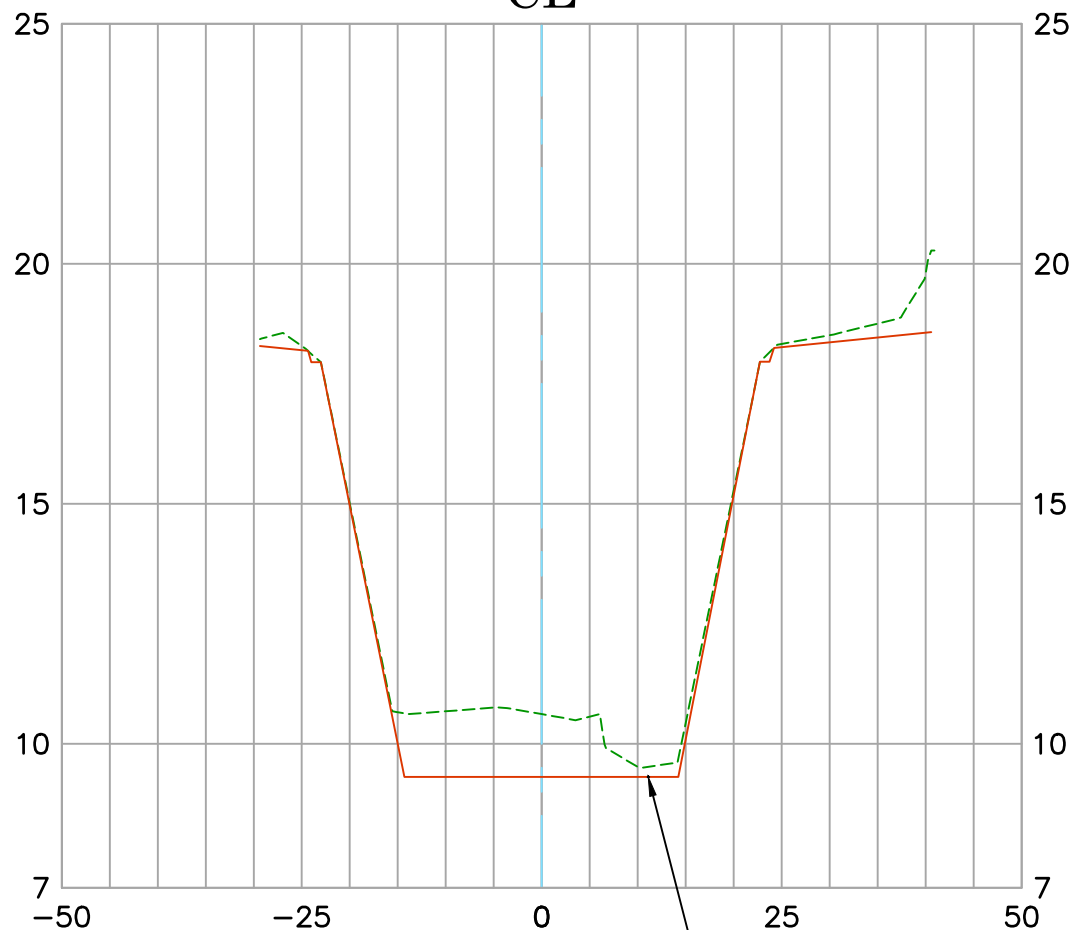

Existing Condition 2020
 Record Drawing D05-101-7R

Date Prepared: 09/16/2020

COMPACTED FILL
 PER RECORD DRAWING


Vert. Scale: 1"=4'
 Hor. Scale: 1"=20'



FOUNTAIN VALLEY CHANNEL (D05)

78+50.00

CL

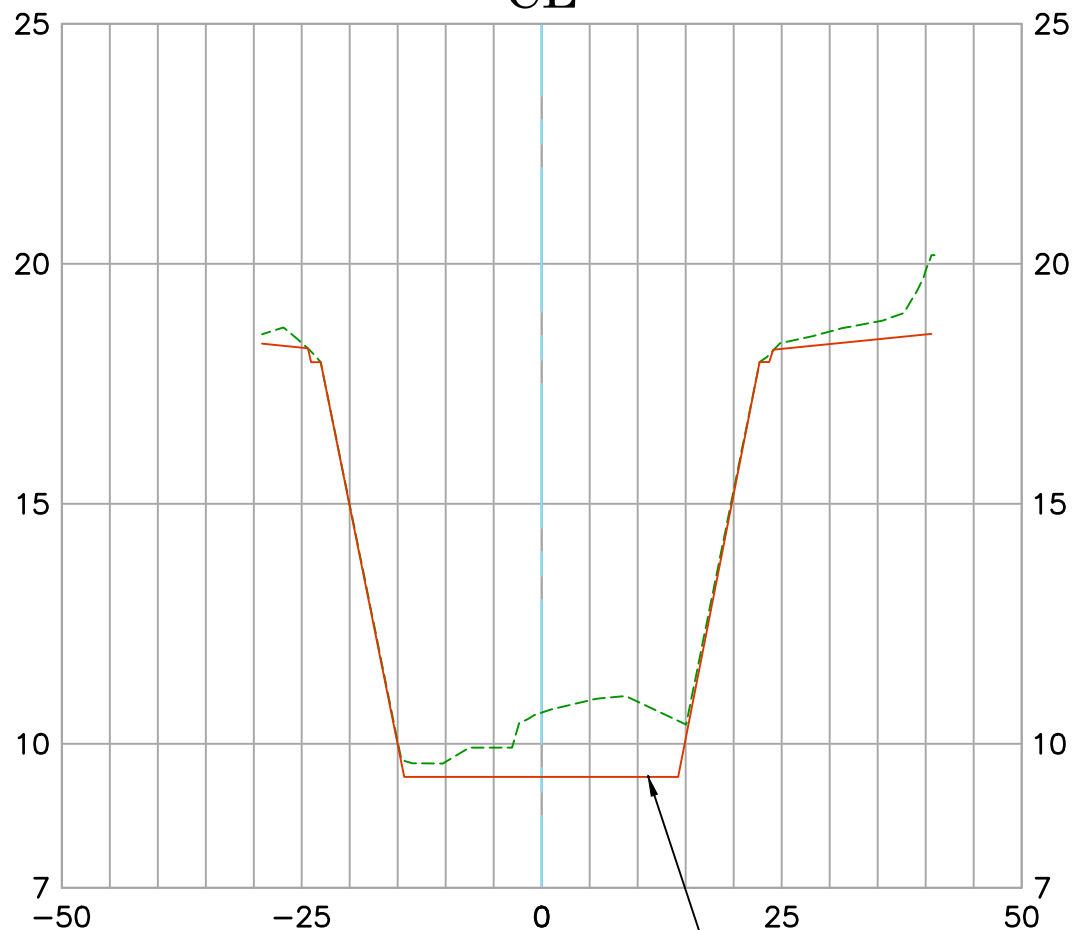

Existing Condition 2020
 Record Drawing D05-101-7R

Date Prepared: 09/16/2020

COMPACTED FILL
 PER RECORD DRAWING


Vert. Scale: 1"=4'
 Hor. Scale: 1"=20'



FOUNTAIN VALLEY CHANNEL (D05)

79+00.00

CL

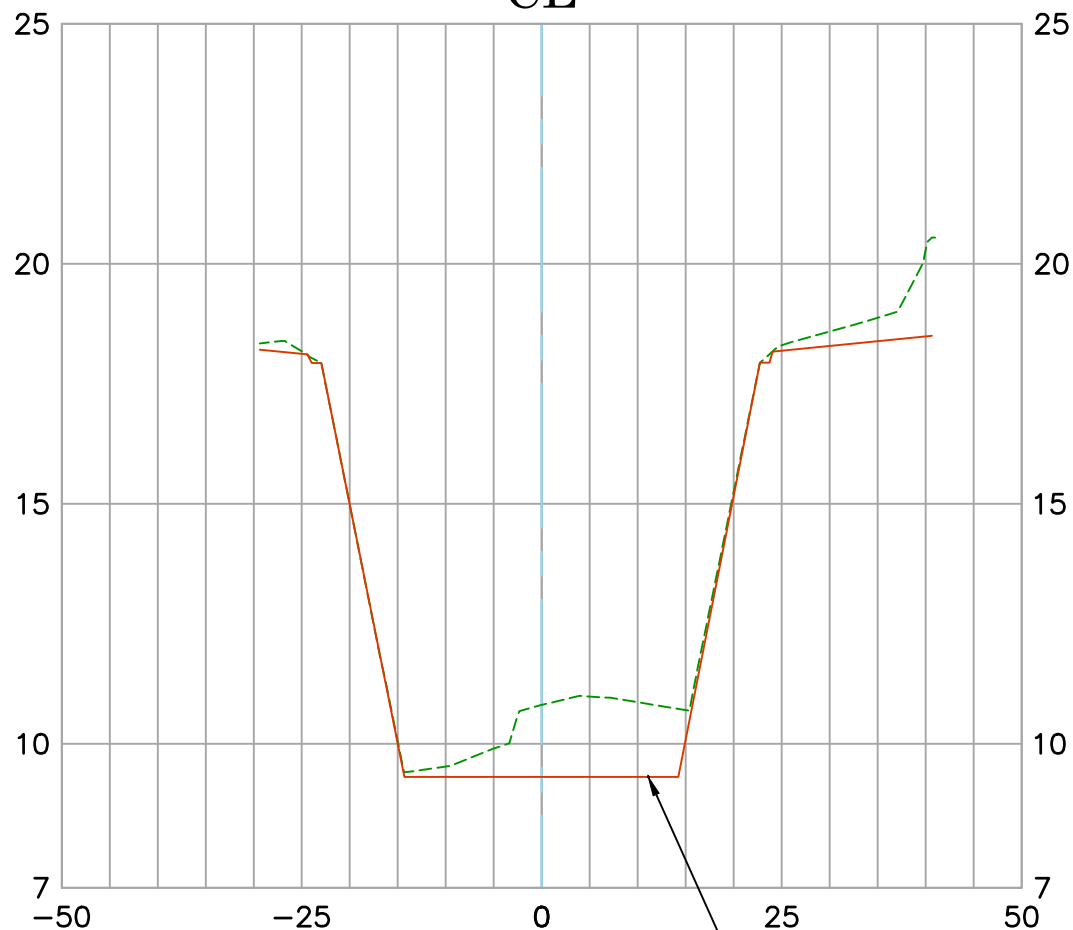

Existing Condition 2020
 Record Drawing D05-101-7R

Date Prepared: 09/16/2020

--- Existing Condition 2020
 --- Record Drawing D05-101-7R

COMPACTED FILL
 PER RECORD DRAWING


Vert. Scale: 1"=4'
 Hor. Scale: 1"=20'



FOUNTAIN VALLEY CHANNEL (D05)

79+50.00

CL

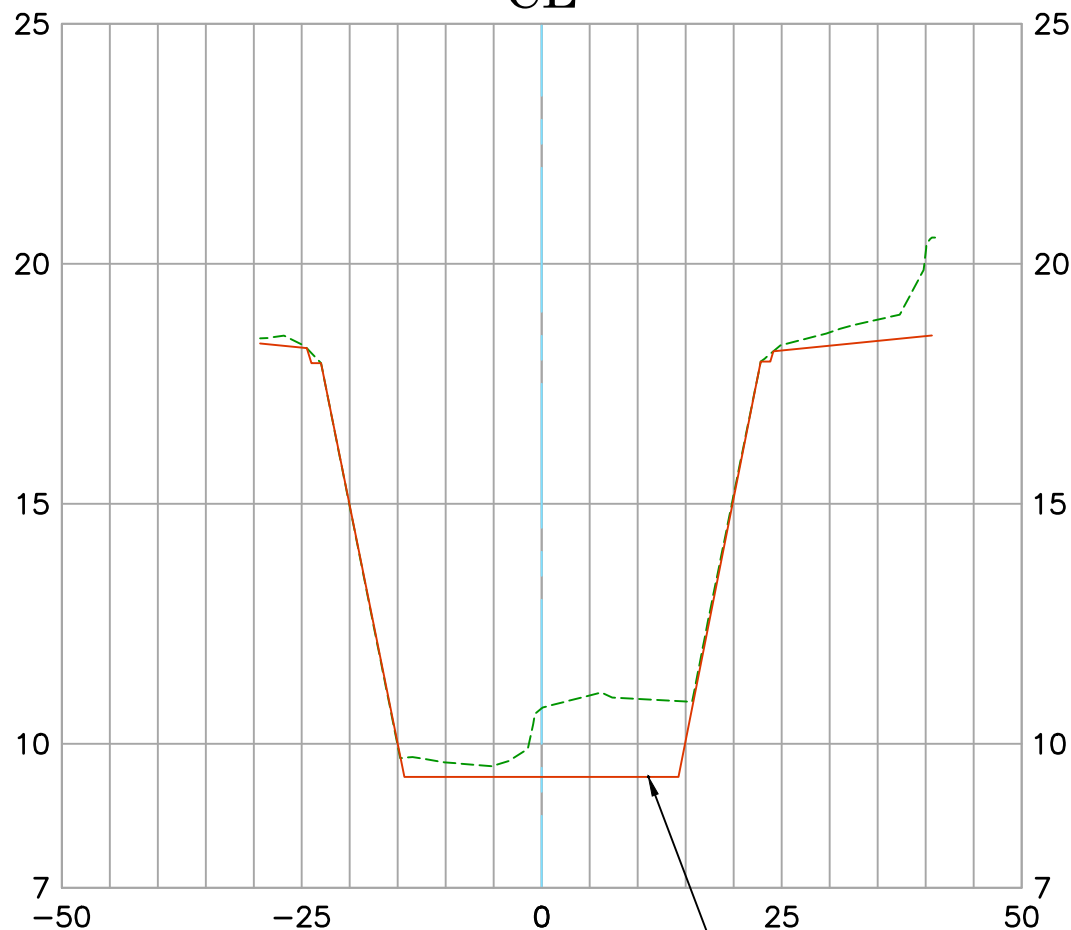

Existing Condition 2020
 Record Drawing D05-101-7R

Date Prepared: 09/16/2020

--- Existing Condition 2020
 --- Compacted Fill



COMPACTED FILL
 PER RECORD DRAWING

Vert. Scale: 1"=4'
 Hor. Scale: 1"=20'

FOUNTAIN VALLEY CHANNEL (D05)

80+00.00

CL

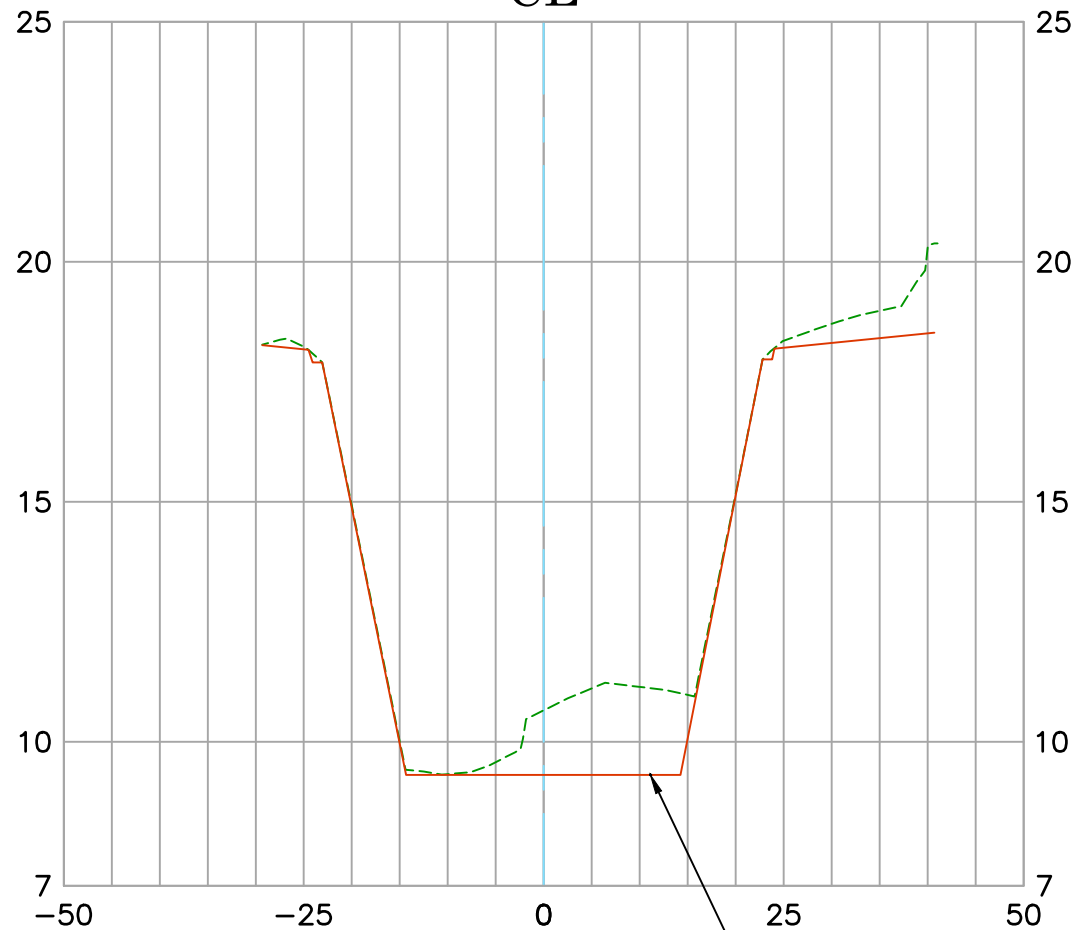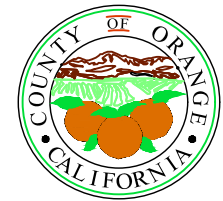

Existing Condition 2020
 Record Drawing D05-101-7R

Date Prepared: 09/16/2020





COMPACTED FILL
 PER RECORD DRAWING

Vert. Scale: 1"=4'
 Hor. Scale: 1"=20'

FOUNTAIN VALLEY CHANNEL (D05)

80+50.00
 CL

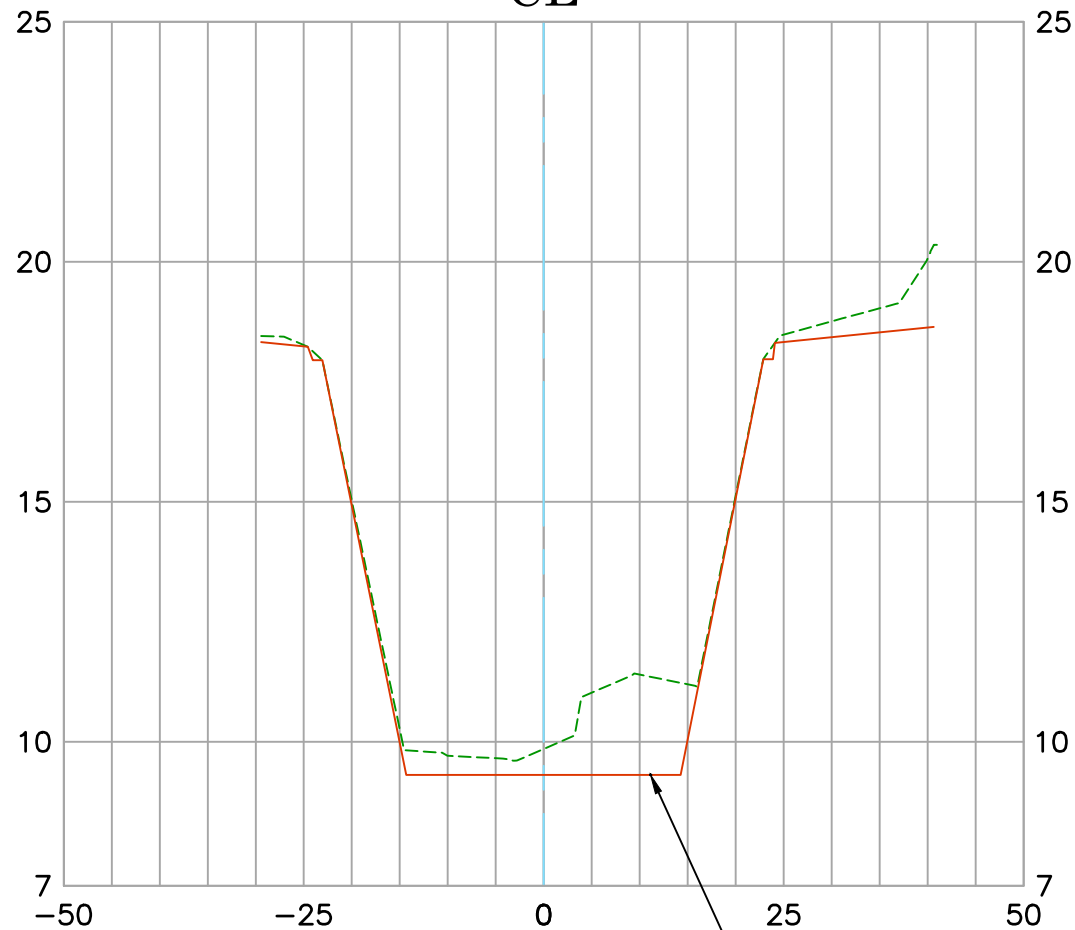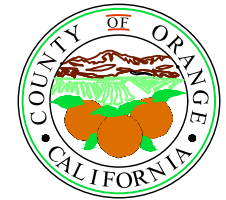

Existing Condition 2020
 Record Drawing D05-101-7R

Date Prepared: 09/16/2020

--- Existing Condition 2020
 --- Record Drawing

COMPACTED FILL
 PER RECORD DRAWING

Vert. Scale: 1"=4'
 Hor. Scale: 1"=20'


**U.S. Survey
Foot**

OC Public Works
OC Survey/Field Services
Boundary Analysis & Mapping

FOUNTAIN VALLEY CHANNEL (D05)

81+00.00

CL

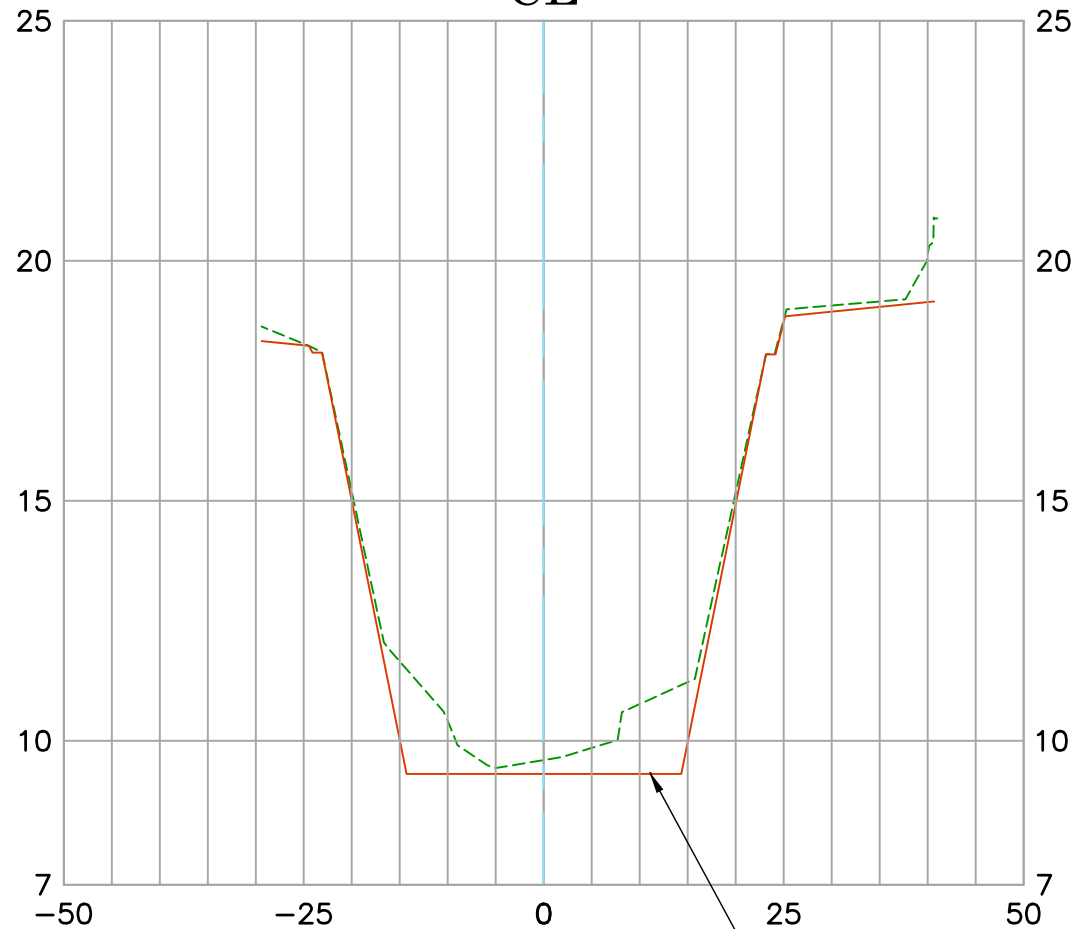

COMPACTED FILL
PER RECORD DRAWING

Existing Condition 2020
Record Drawing D05-101-7R



Date Prepared: 09/16/2020

Vert. Scale: 1"=4'
Hor. Scale: 1"=20'

FOUNTAIN VALLEY CHANNEL (D05)

81+00.40

CL

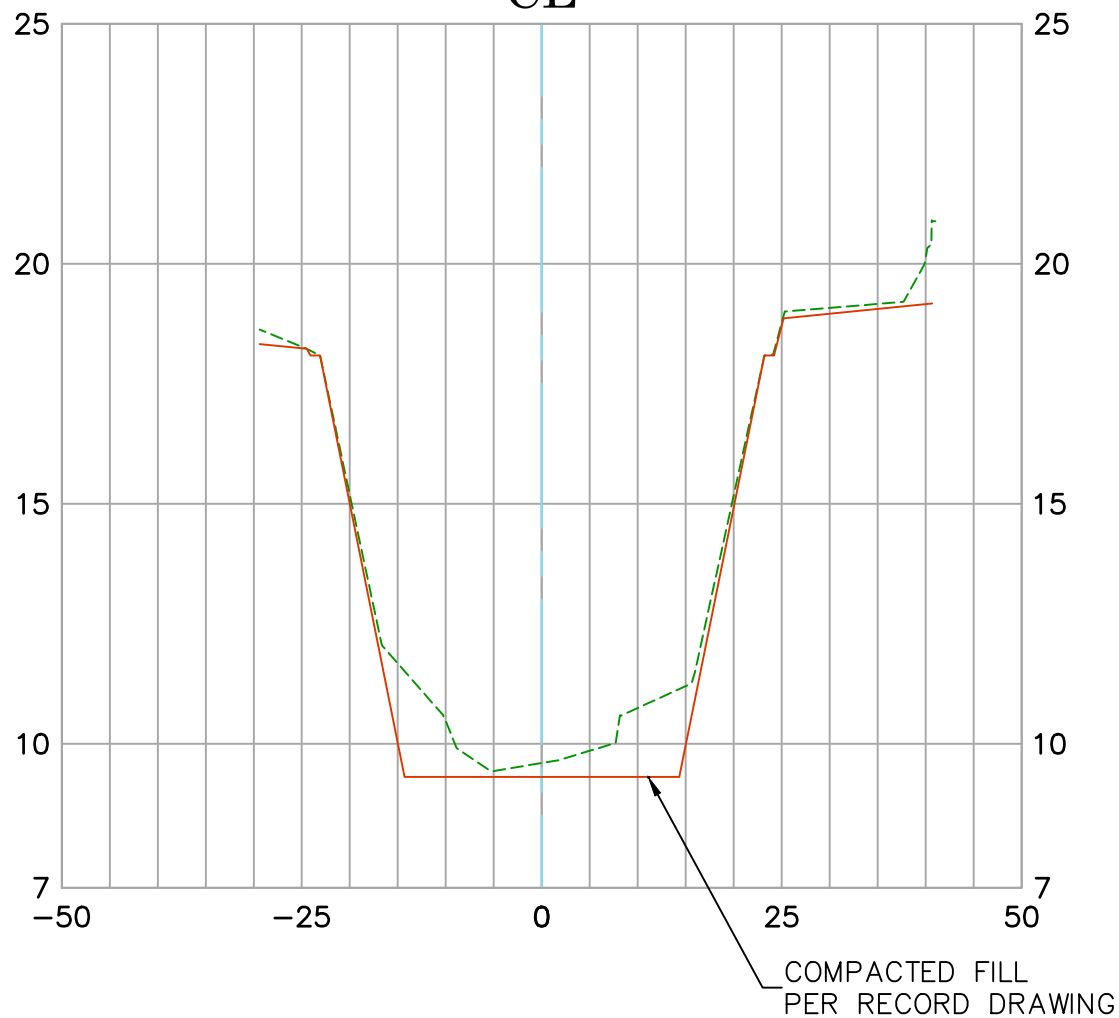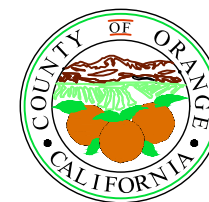

Existing Condition 2020
Record Drawing D05-101-7R

Date Prepared: 09/16/2020

Vert. Scale: 1"=4'
Hor. Scale: 1"=20'