




OC PUBLIC WORKS DEPARTMENT

JAMES TREADAWAY, DIRECTOR OF PUBLIC WORKS

KEVIN HILLS, COUNTY SURVEYOR

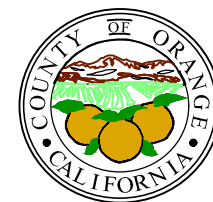

GREENVILLE BANNING CHANNEL REHABILITATION


SECTIONS WERE DERIVED FROM RECORD AS-BUILT PLANS D03-101-2A, D03-101-3A, AND D03-101-7R BETWEEN STATIONS 334+89 TO 349+15, 350+83 TO 362+25, 363+78 TO 381+03, 382+46 TO 404+32, 405+76 TO 424+03, 424+93 TO 436+46, 437+24 TO 450.72, AND O.C.S TOPOGRAPHIC SURVEY DATED JULY, 2020.

THIS DOCUMENT IS SUPPLEMENTAL TO THE TOPOGRAPHIC SURVEY MAP DATED JULY, 2020.

PROJECT CROSS SECTIONS



GREENVILLE BANNING CHANNEL (D03) CL

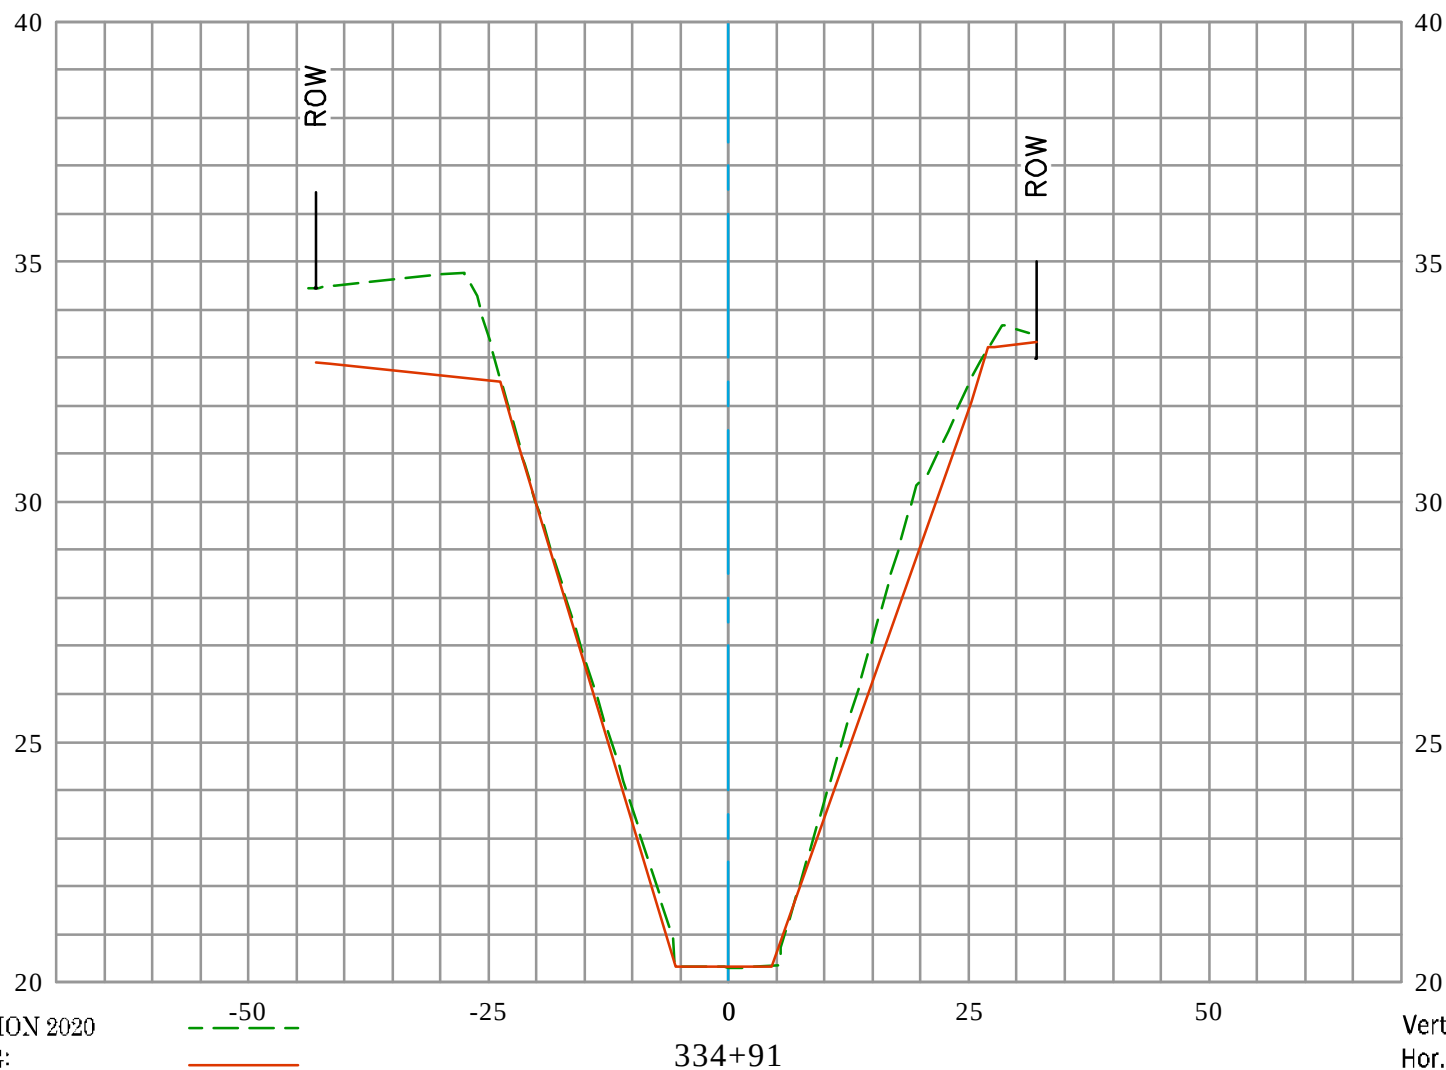


EXISTING CONDITION 2020
 RECORD DRAWING:
 D03-101-2A, D03-101-3A, & D03-101-7R
 DATE PREPARED: 01/24/2022

U.S. *Survey
Foot*

OC Public Works
OC Survey/Field Services
Boundary Analysis & Mapping

GREENVILLE BANNING CHANNEL (D03) CL

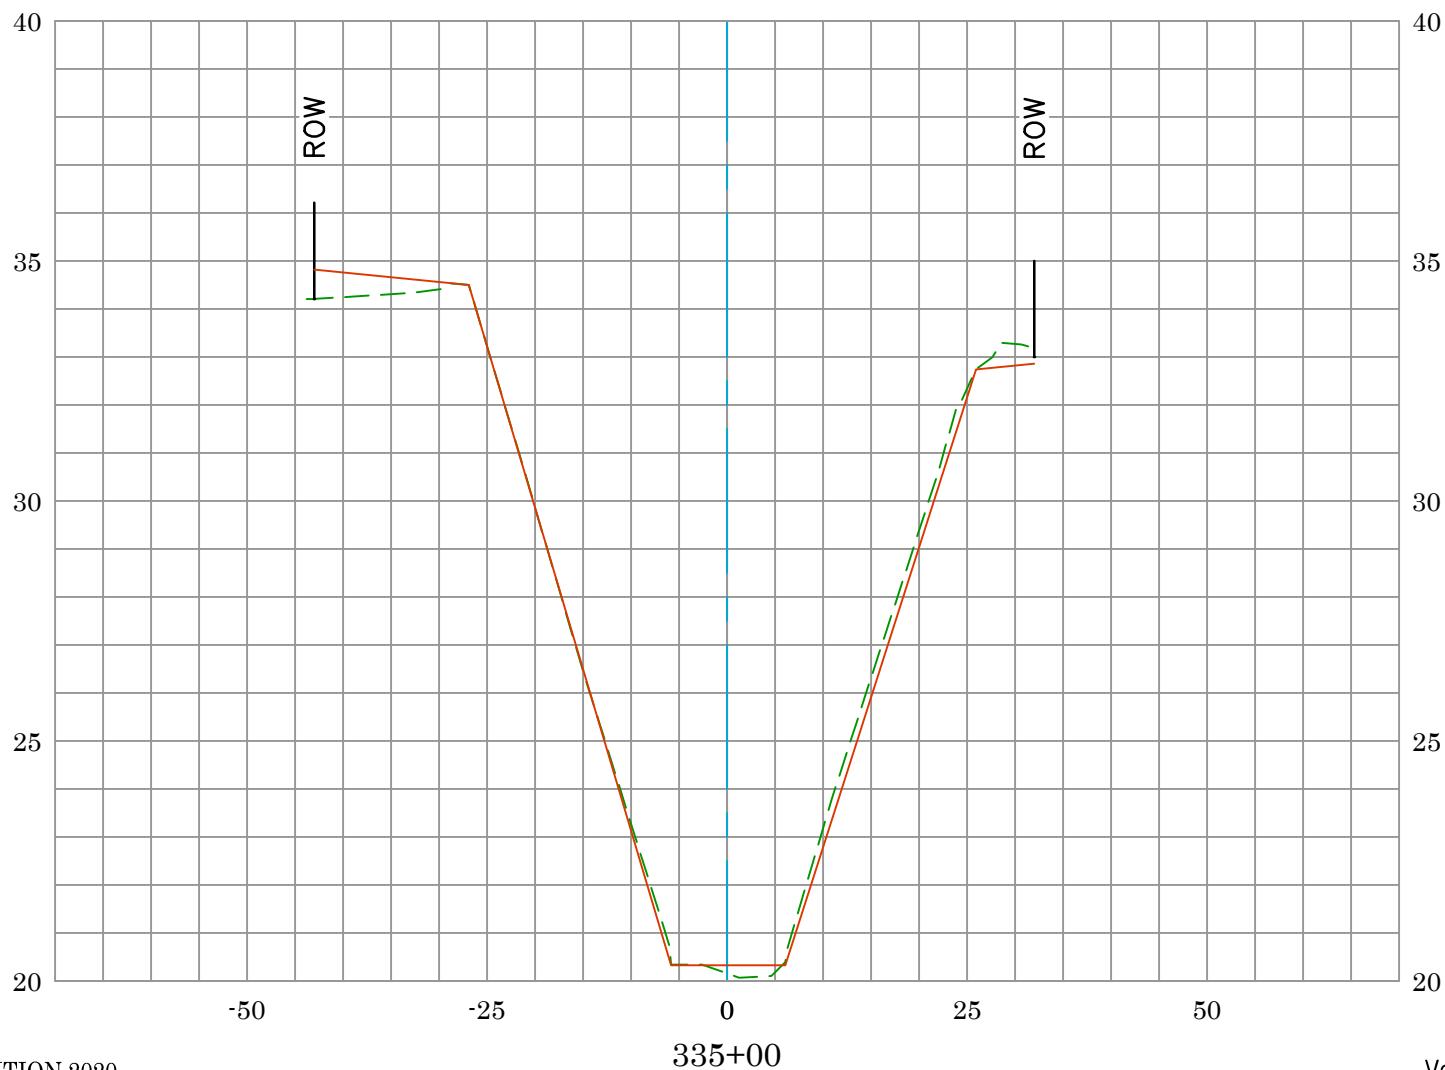


EXISTING CONDITION 2020
RECORD DRAWING:
D03-101-2A, D03-101-3A, & D03-101-7R
DATE PREPARED: 01/24/2022

Vert. Scale: 1" = 4'
Hor. Scale: 1" = 20'

U.S. *Survey Foot*

OC Public Works
OC Survey/Field Services
Boundary Analysis & Mapping

GREENVILLE BANNING CHANNEL (D03) CL

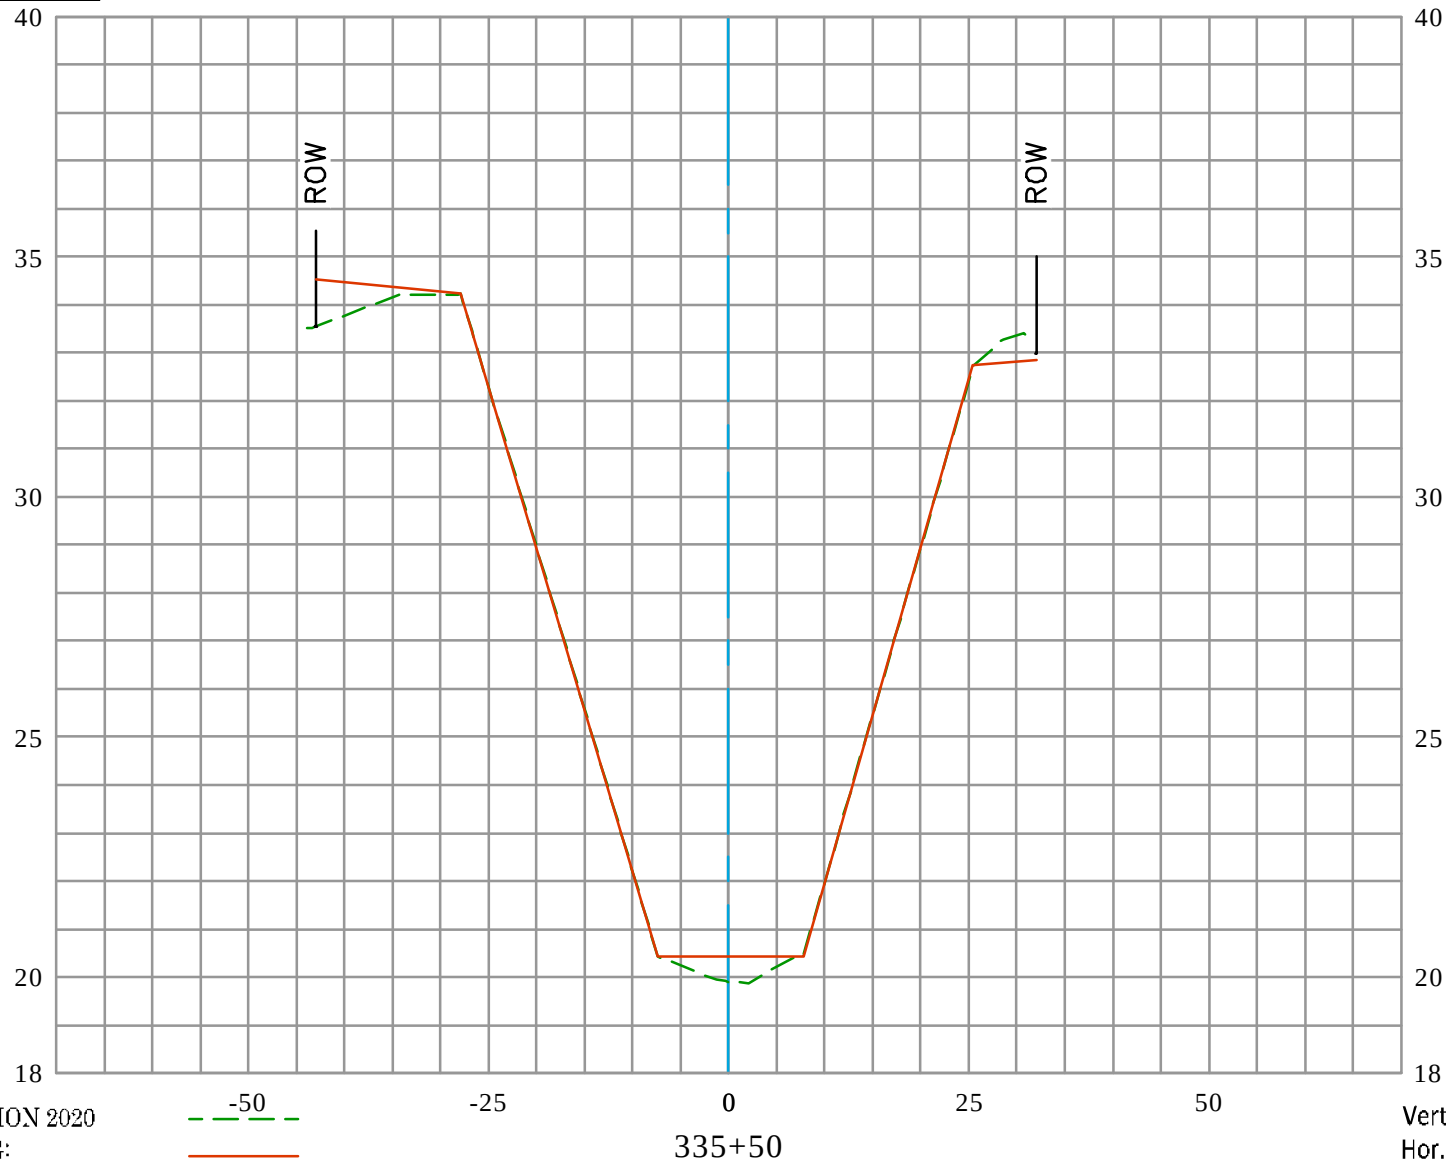


EXISTING CONDITION 2020
RECORD DRAWING:
D03-101-2A, D03-101-3A, & D03-101-7R
DATE PREPARED: 01/24/2022

Vert. Scale: 1" = 4'
Hor. Scale: 1" = 20'




GREENVILLE BANNING CHANNEL (D03) CL

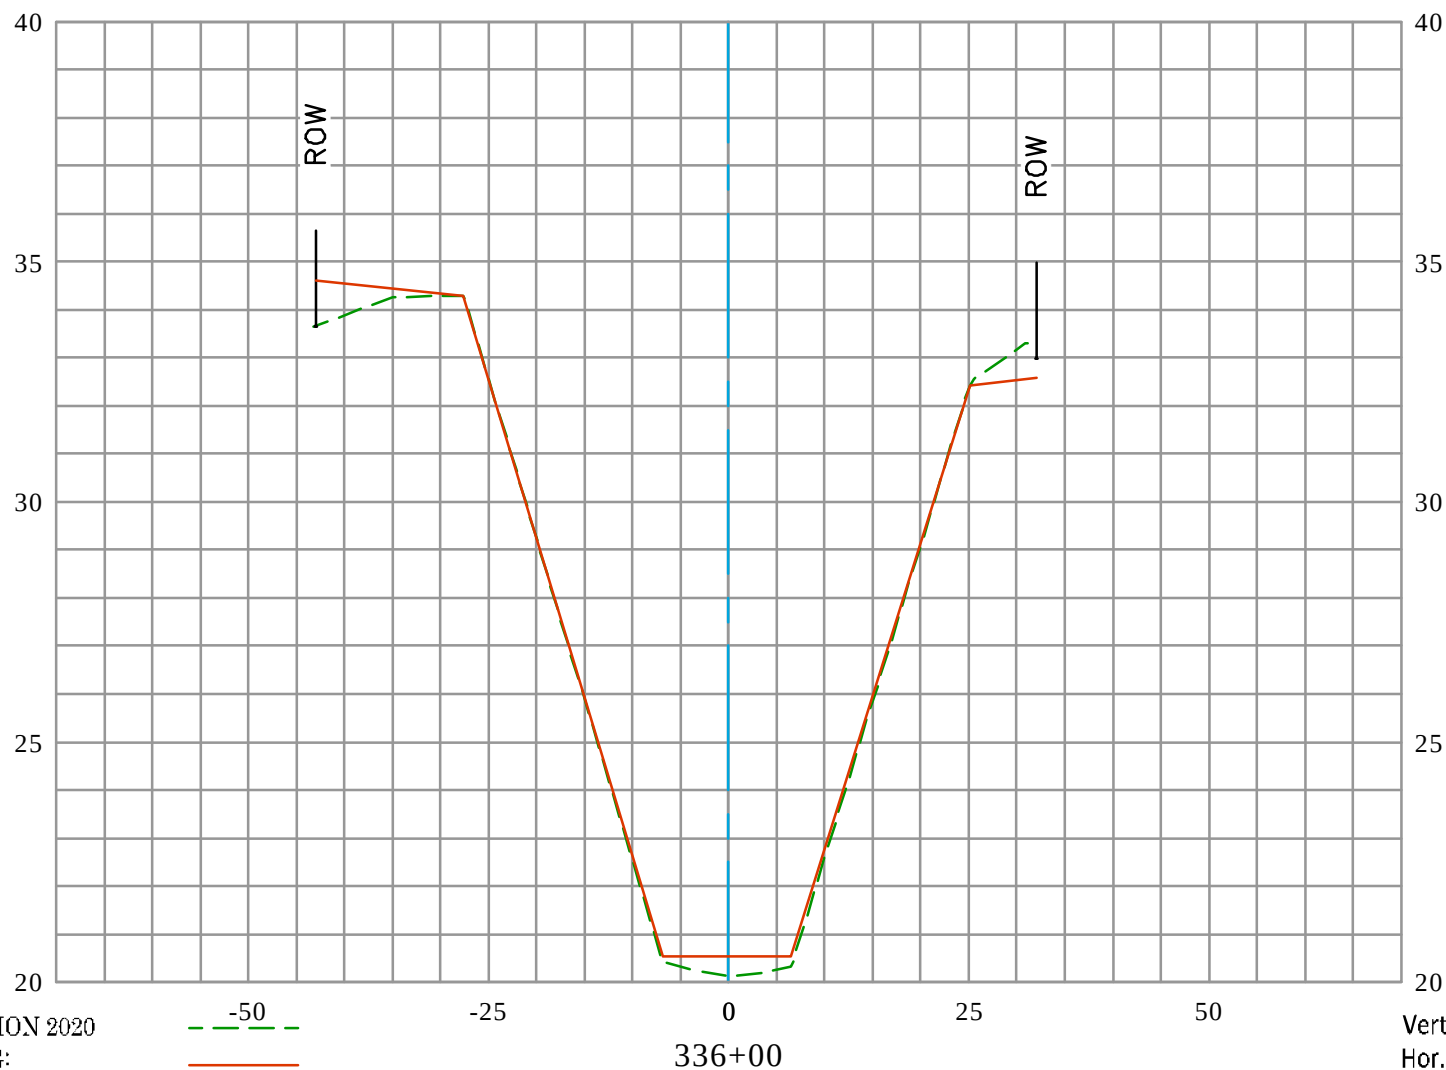

EXISTING CONDITION 2020
 RECORD DRAWING:
 D03-101-2A, D03-101-3A, & D03-101-7R
 DATE PREPARED: 01/24/2022



GREENVILLE BANNING CHANNEL (D03) CL

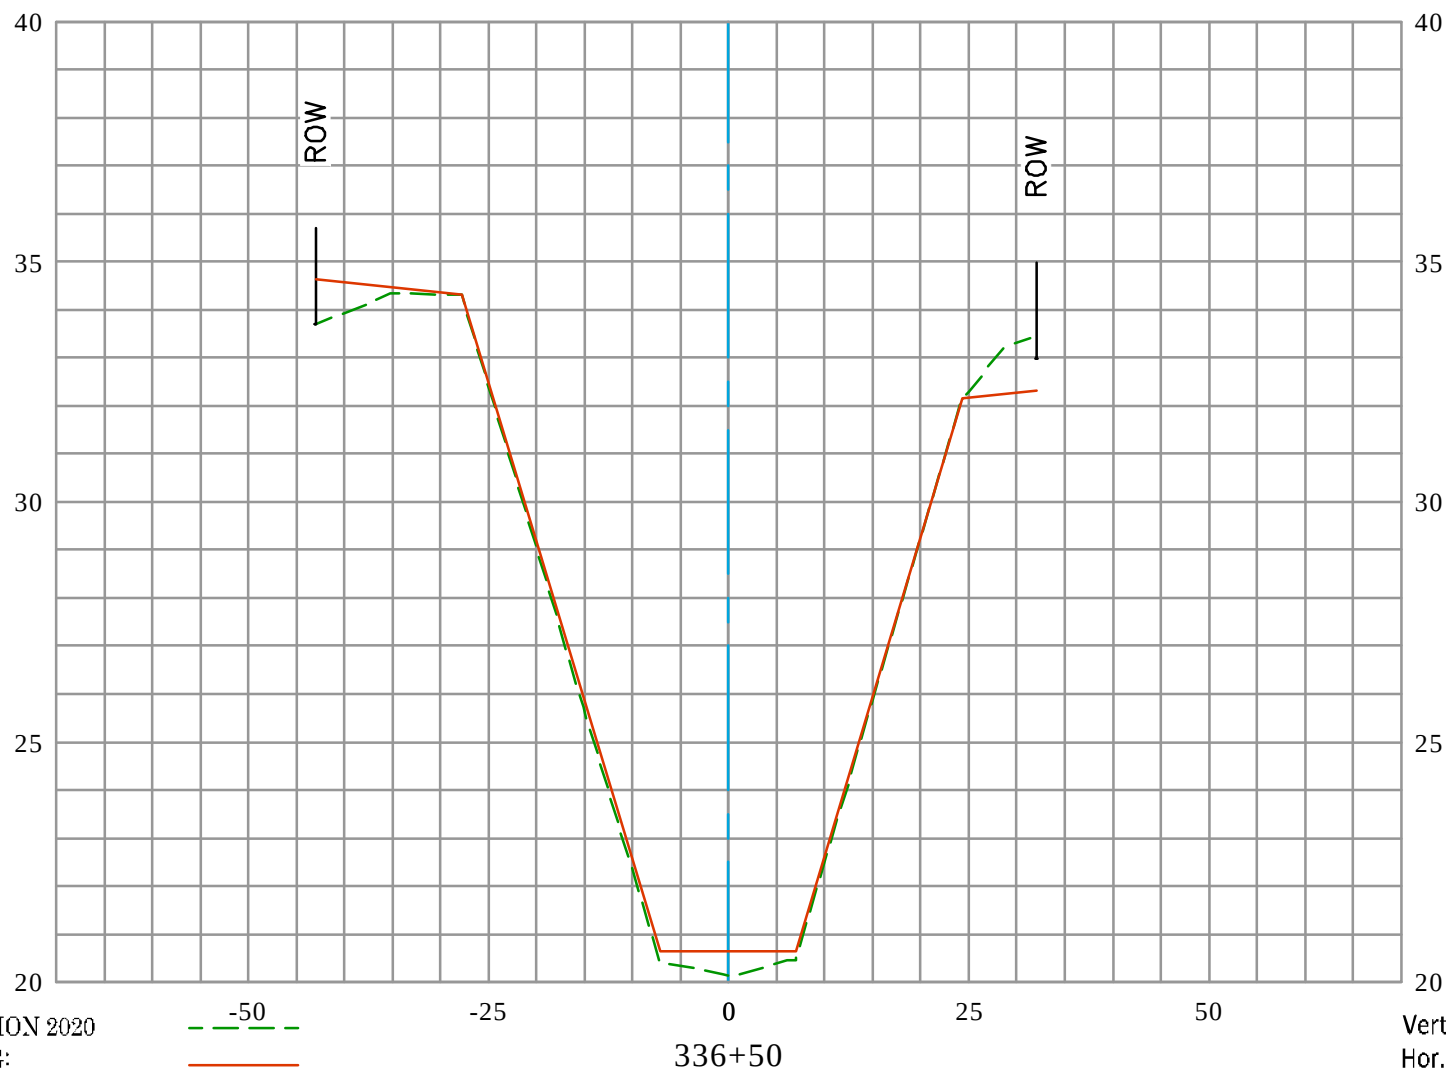



EXISTING CONDITION 2020
 RECORD DRAWING:
 D03-101-2A, D03-101-3A, & D03-101-7R
 DATE PREPARED: 01/24/2022

Vert. Scale: 1" = 4'
 Hor. Scale: 1" = 20'

U.S. *Survey Foot*

OC Public Works
OC Survey/Field Services
Boundary Analysis & Mapping


GREENVILLE BANNING CHANNEL (D03) CL

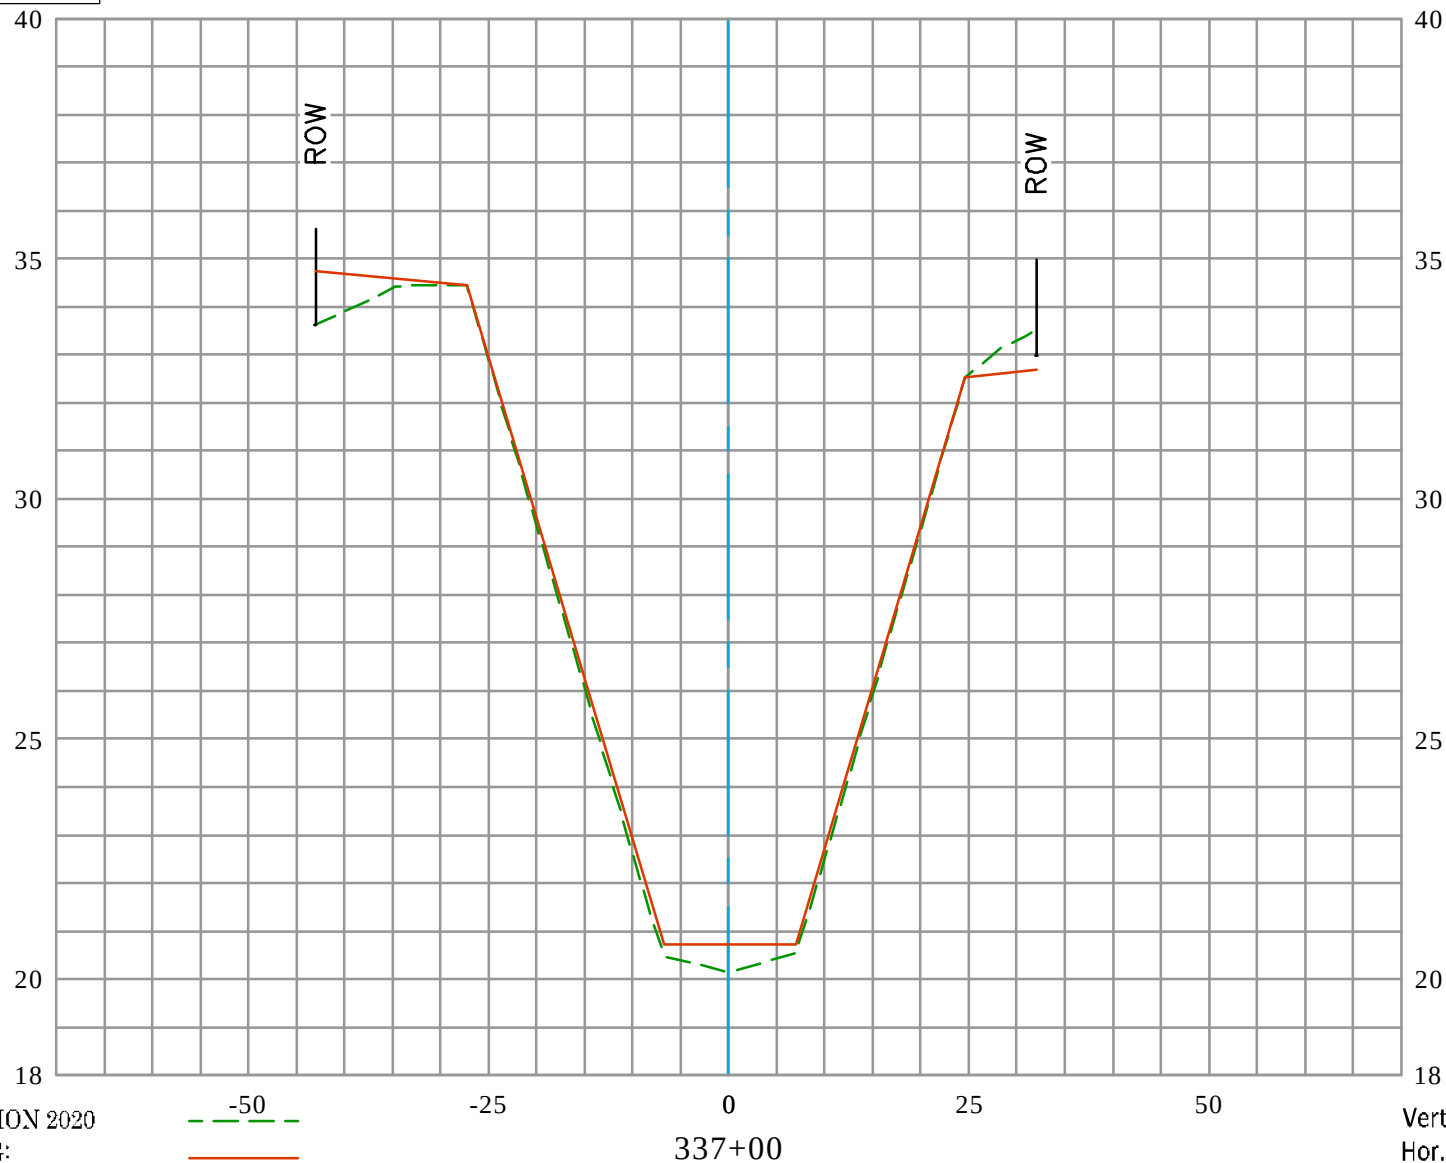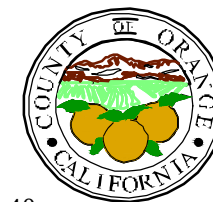

EXISTING CONDITION 2020
RECORD DRAWING:
D03-101-2A, D03-101-3A, & D03-101-7R
DATE PREPARED: 01/24/2022



GREENVILLE BANNING CHANNEL (D03) CL

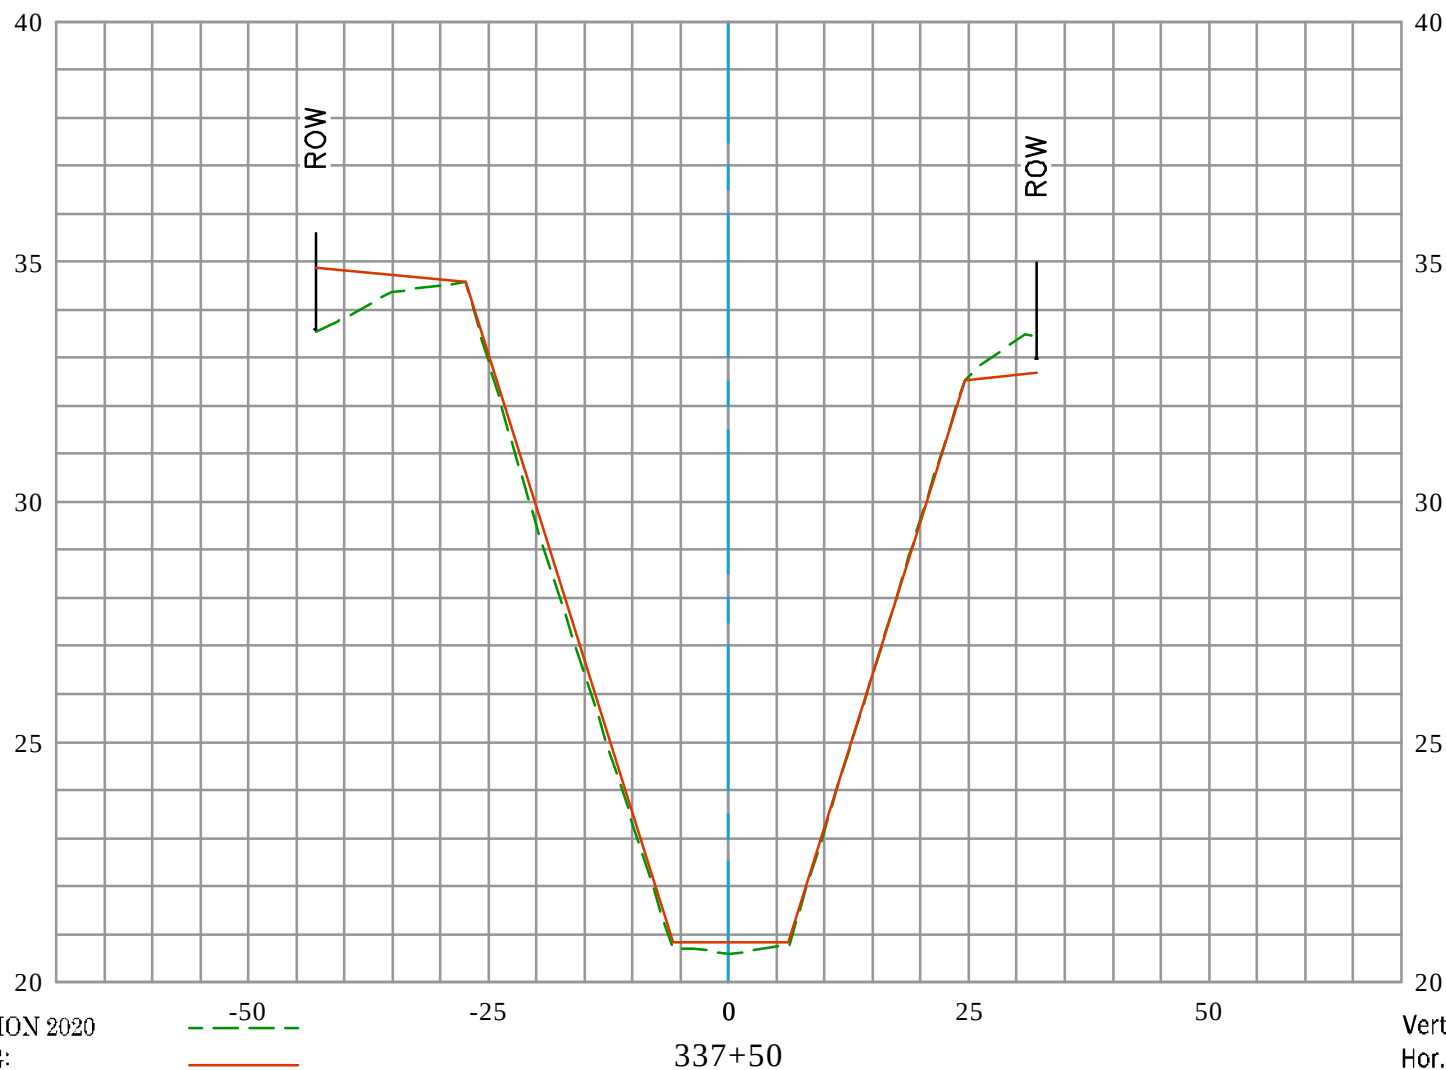


EXISTING CONDITION 2020
 RECORD DRAWING:
 D03-101-2A, D03-101-3A, & D03-101-7R
 DATE PREPARED: 01/24/2022

Vert. Scale: 1" = 4'
 Hor. Scale: 1" = 20'




GREENVILLE BANNING CHANNEL (D03) CL

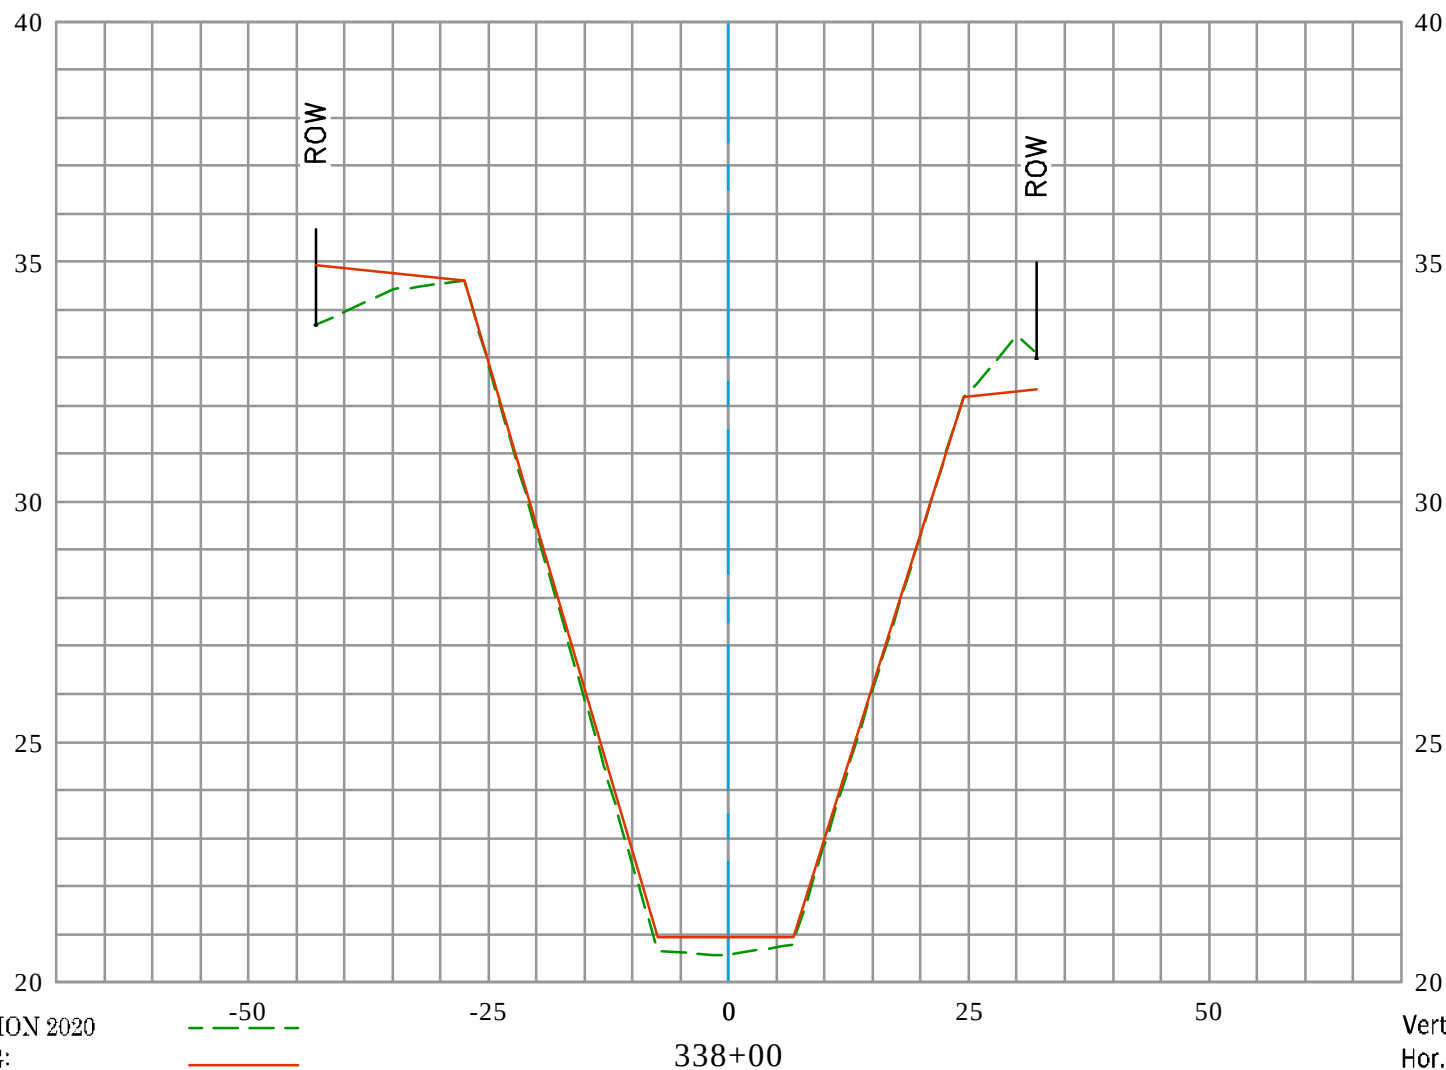

EXISTING CONDITION 2020
 RECORD DRAWING:
 D03-101-2A, D03-101-3A, & D03-101-7R
 DATE PREPARED: 01/24/2022



GREENVILLE BANNING CHANNEL (D03) CL

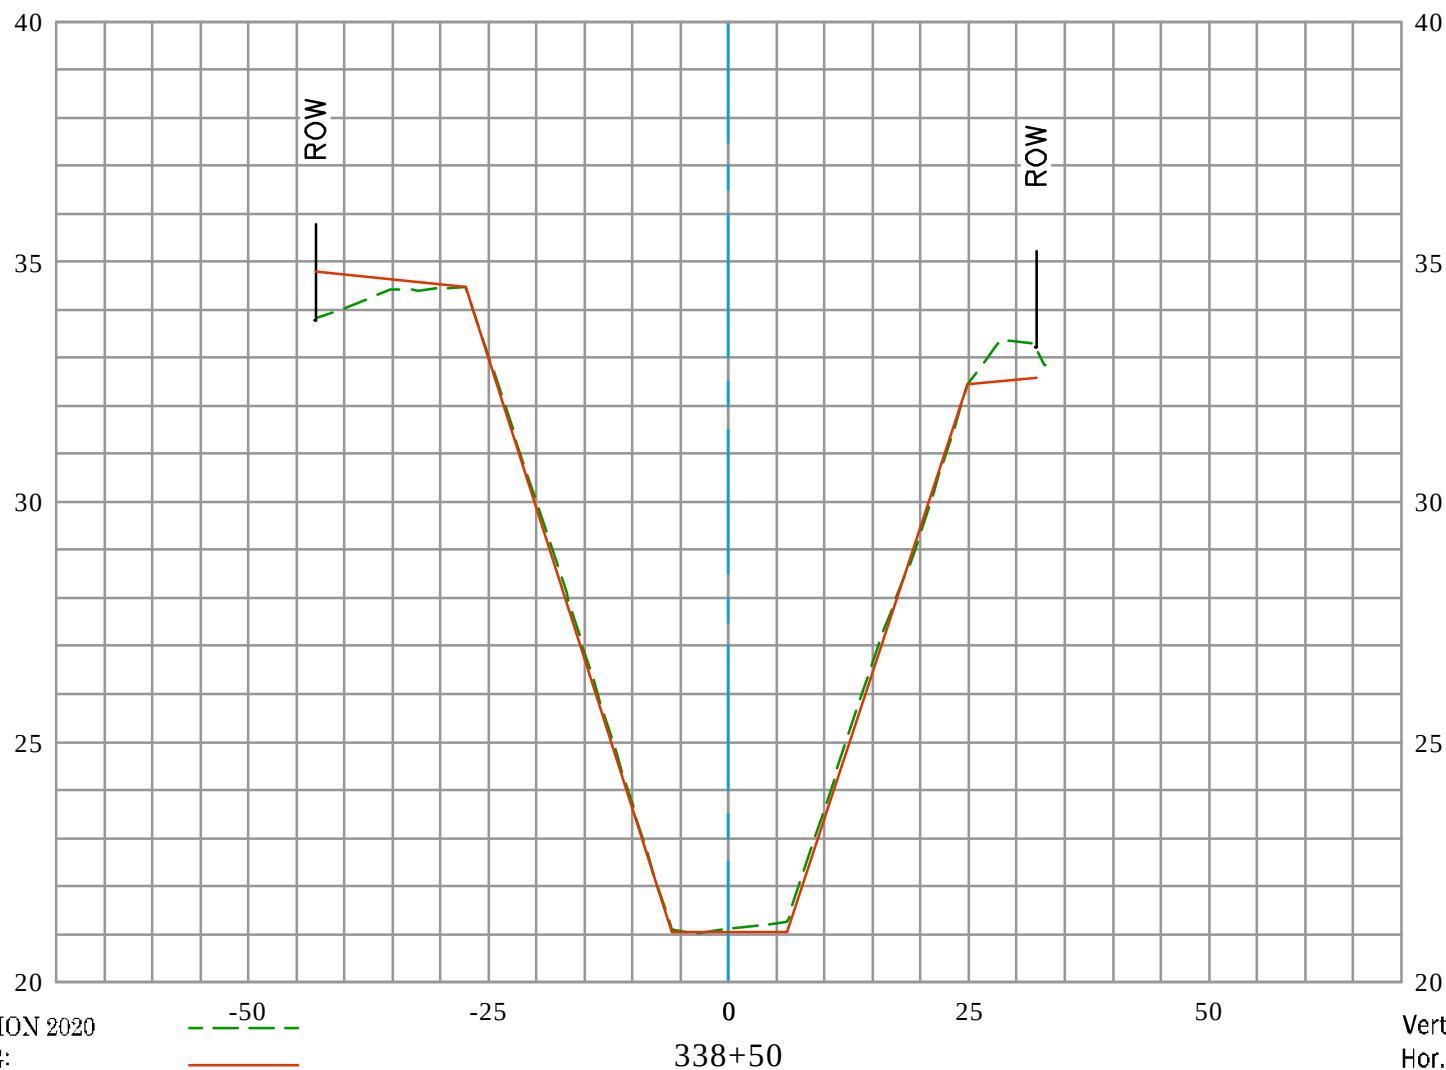


EXISTING CONDITION 2020
 RECORD DRAWING:
 D03-101-2A, D03-101-3A, & D03-101-7R
 DATE PREPARED: 01/24/2022

Vert. Scale: 1" = 4'
 Hor. Scale: 1" = 20'



GREENVILLE BANNING CHANNEL (D03) CL

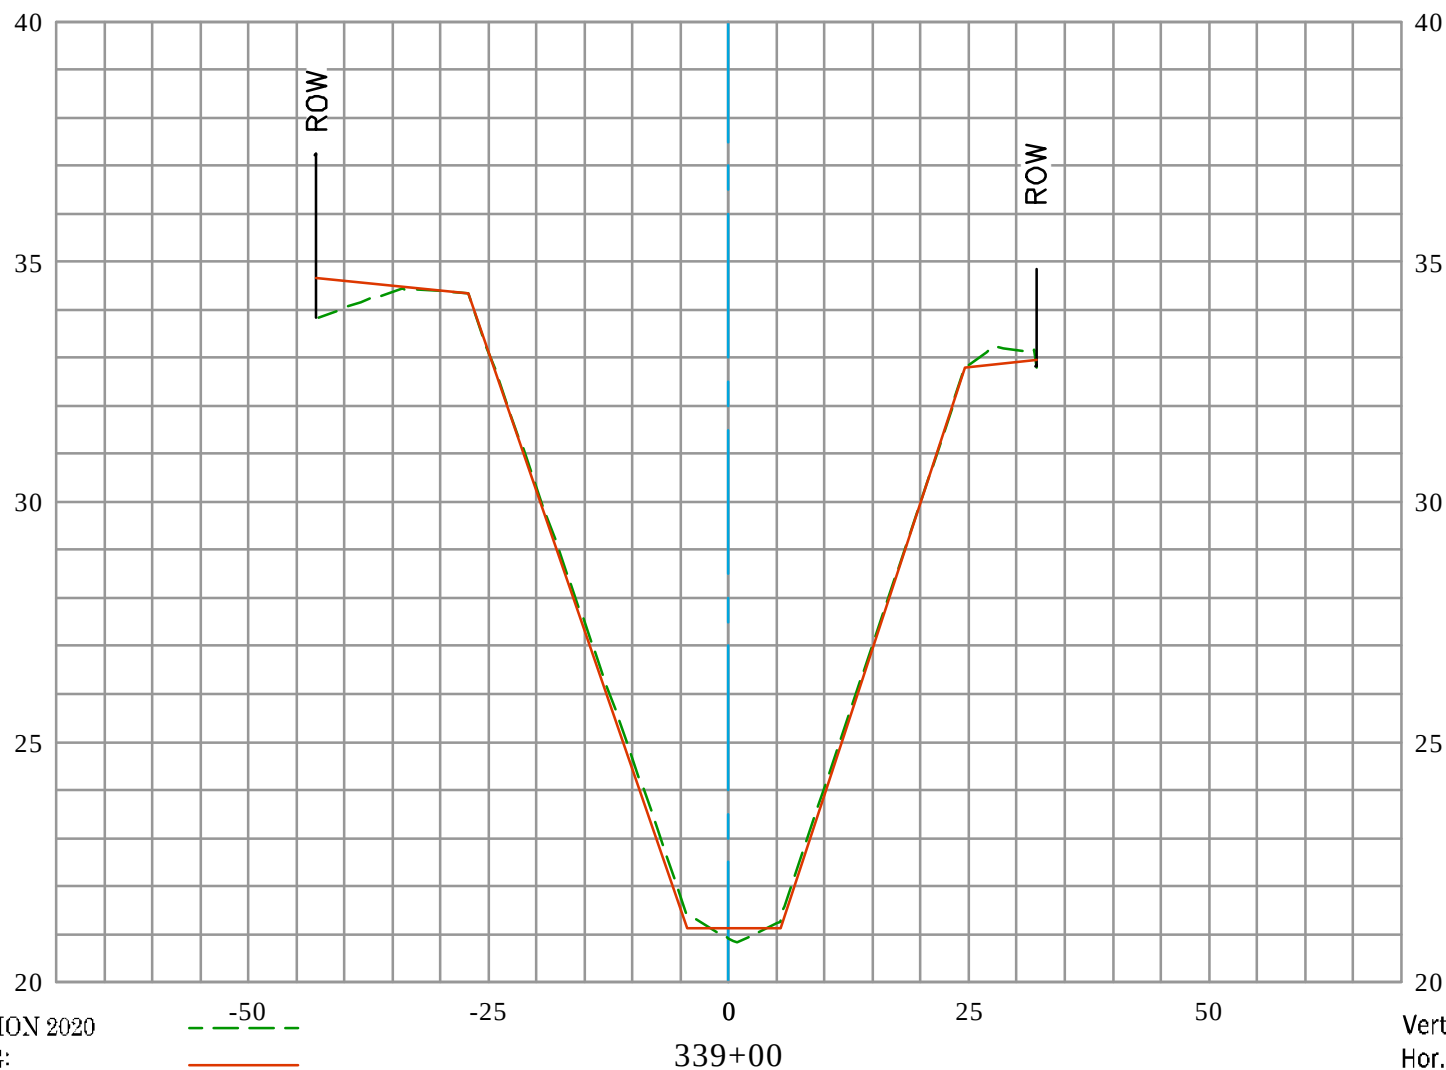


EXISTING CONDITION 2020
 RECORD DRAWING:
 D03-101-2A, D03-101-3A, & D03-101-7R
 DATE PREPARED: 01/24/2022

Vert. Scale: 1" = 4'
 Hor. Scale: 1" = 20'



GREENVILLE BANNING CHANNEL (D03) CL

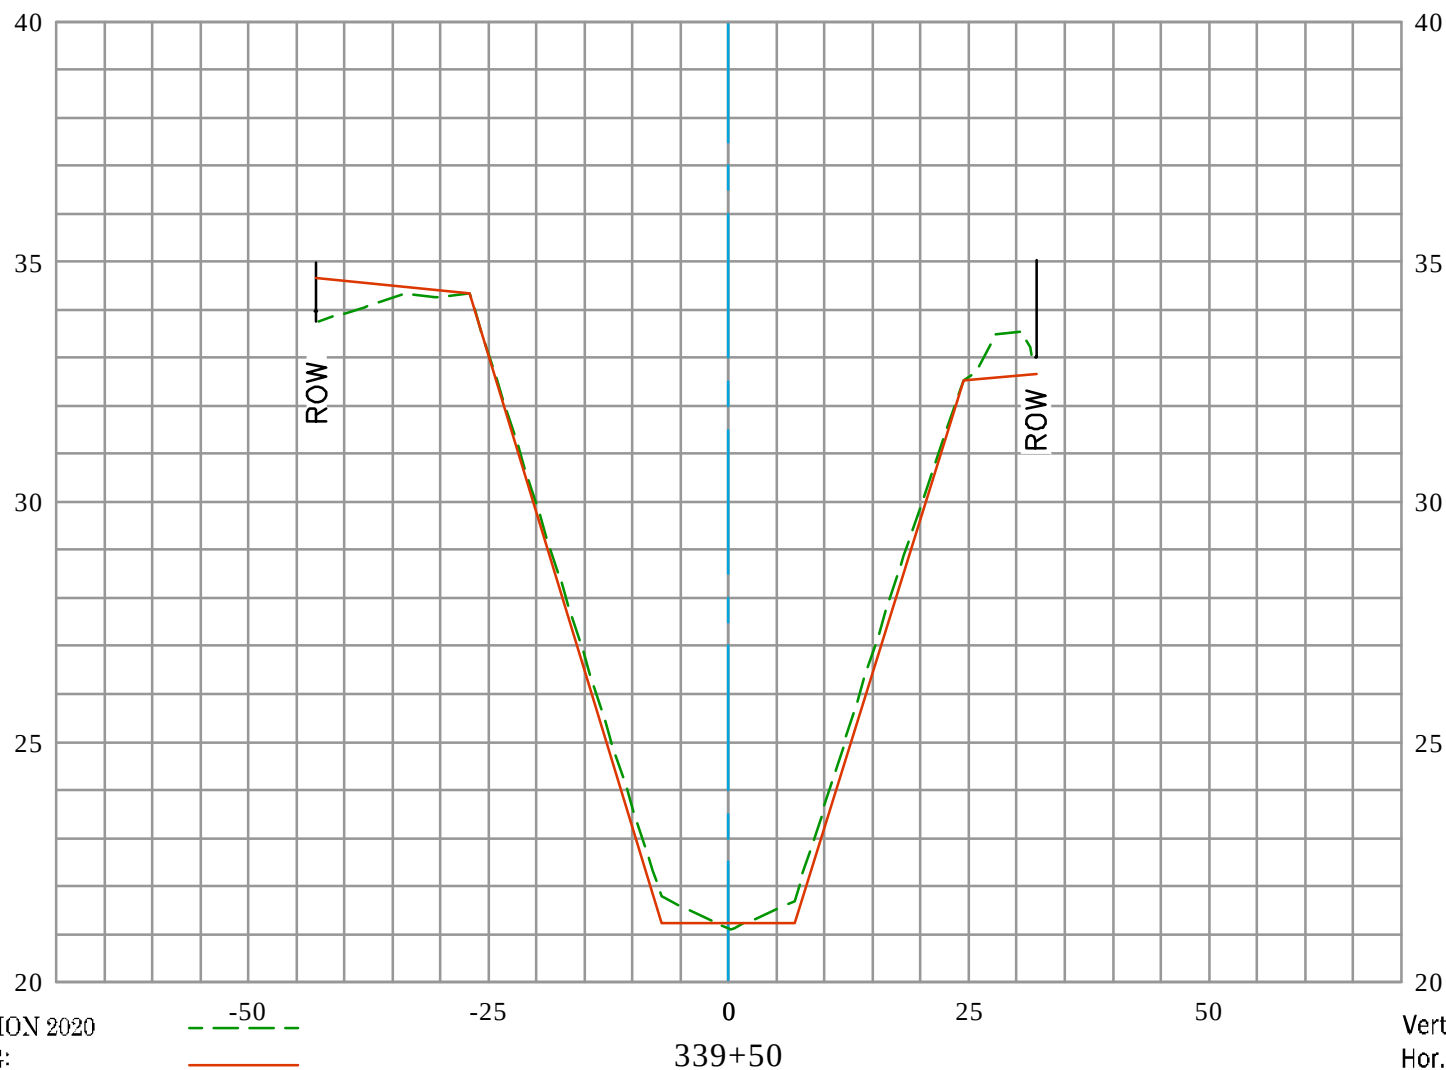


EXISTING CONDITION 2020
 RECORD DRAWING:
 D03-101-2A, D03-101-3A, & D03-101-7R
 DATE PREPARED: 01/24/2022

Vert. Scale: 1" = 4'
 Hor. Scale: 1" = 20'



GREENVILLE BANNING CHANNEL (D03) CL

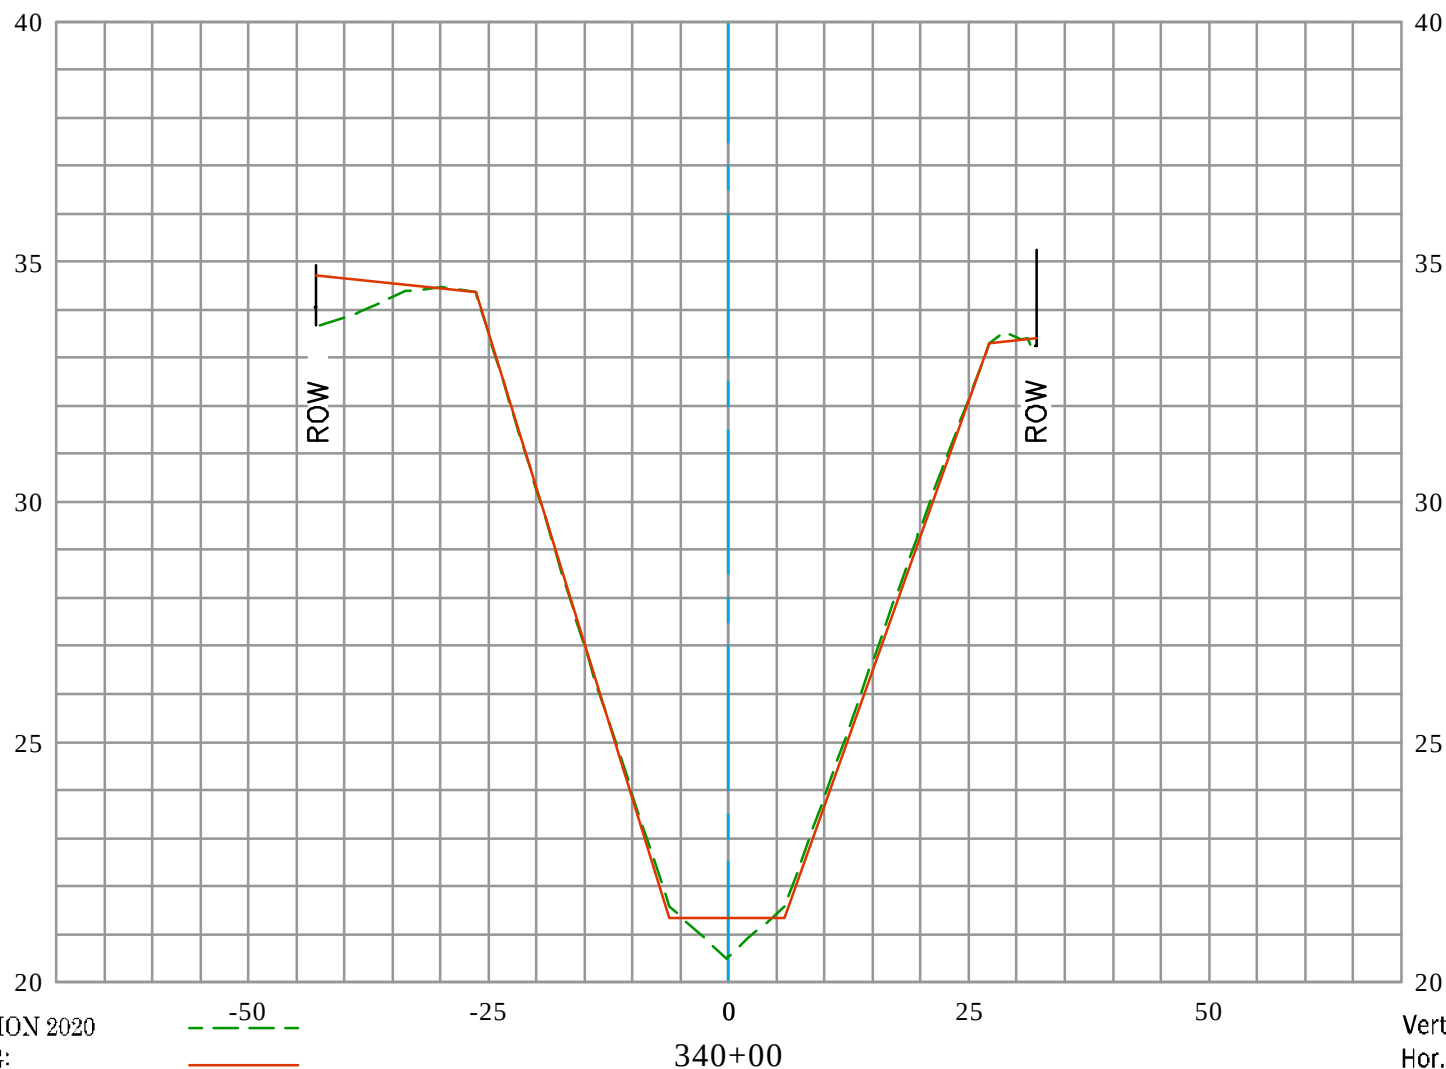


EXISTING CONDITION 2020
 RECORD DRAWING:
 D03-101-2A, D03-101-3A, & D03-101-7R
 DATE PREPARED: 01/24/2022

Vert. Scale: 1" = 4'
 Hor. Scale: 1" = 20'



GREENVILLE BANNING CHANNEL (D03) CL

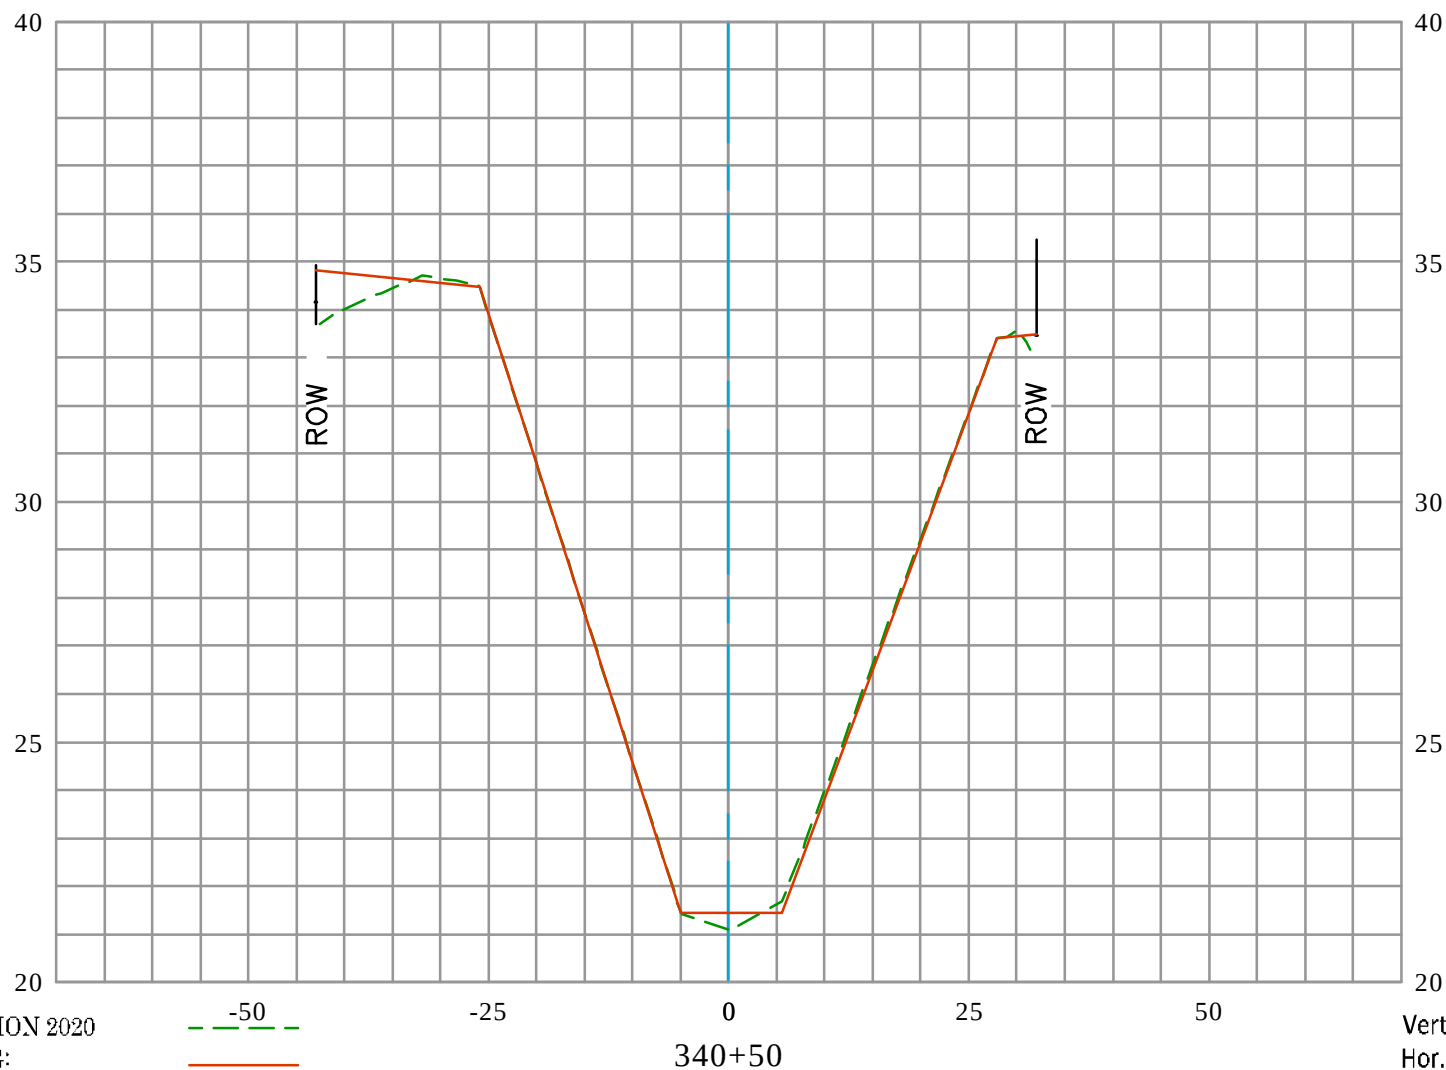

EXISTING CONDITION 2020
 RECORD DRAWING:
 D03-101-2A, D03-101-3A, & D03-101-7R
 DATE PREPARED: 01/24/2022


Vert. Scale: 1" = 4'
 Hor. Scale: 1" = 20'

**U.S. Survey
Foot**

OC Public Works
OC Survey/Field Services
Boundary Analysis & Mapping



GREENVILLE BANNING CHANNEL (D03) CL

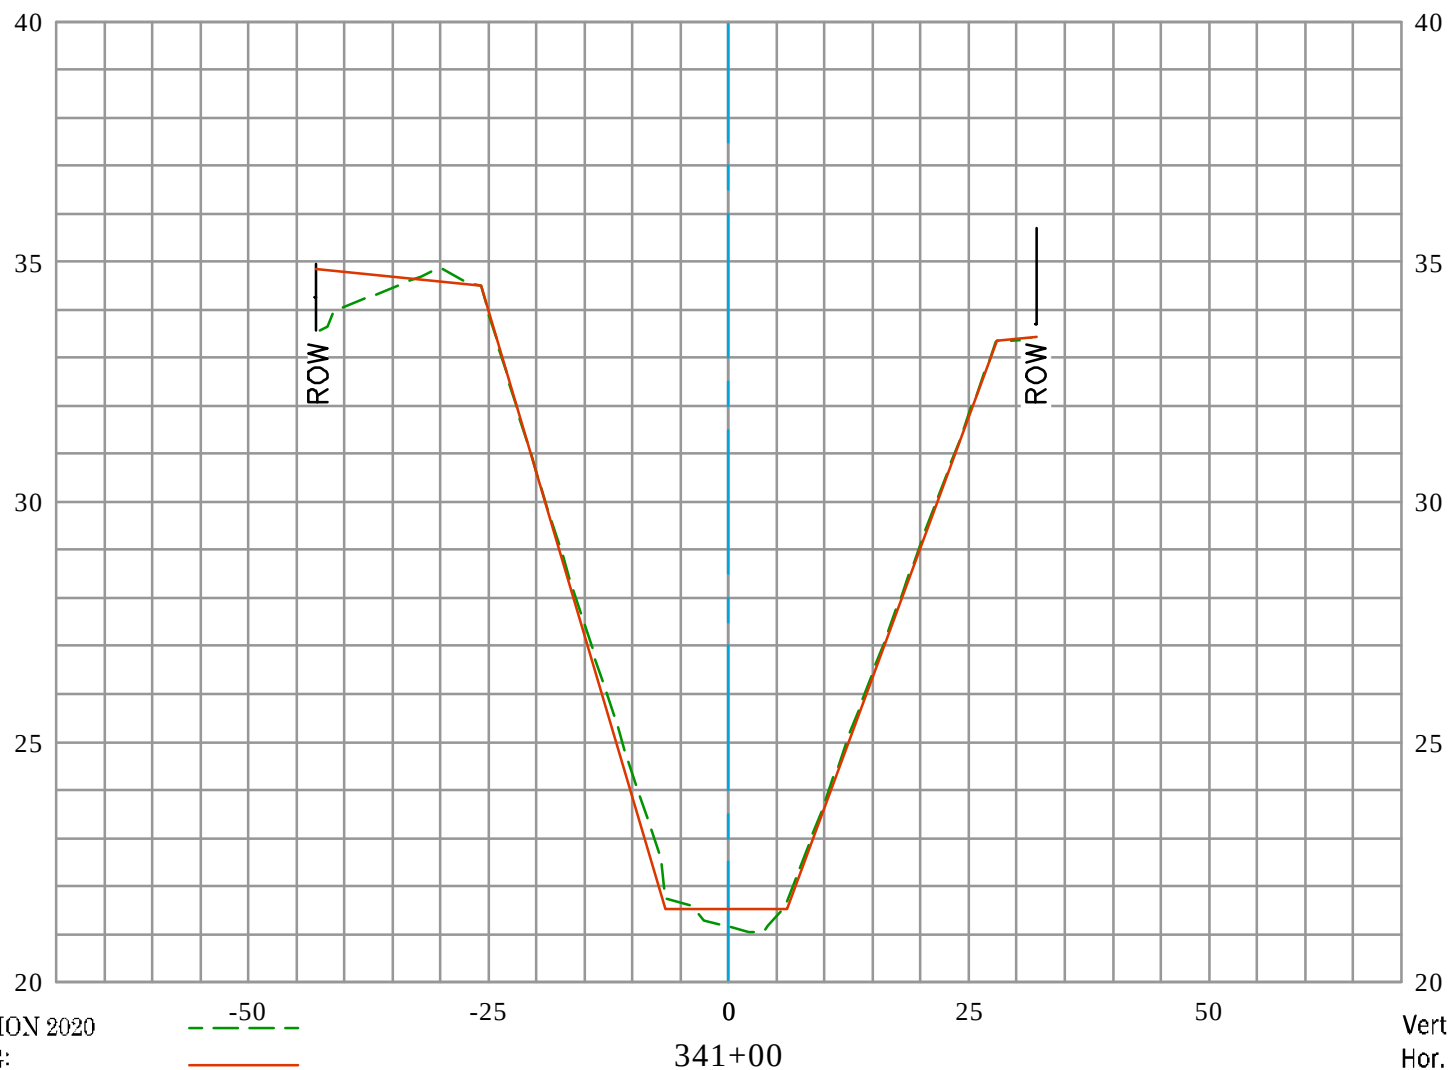


EXISTING CONDITION 2020
RECORD DRAWING:
D03-101-2A, D03-101-3A, & D03-101-7R
DATE PREPARED: 01/24/2022

Vert. Scale: 1" = 4'
Hor. Scale: 1" = 20'



GREENVILLE BANNING CHANNEL (D03) CL

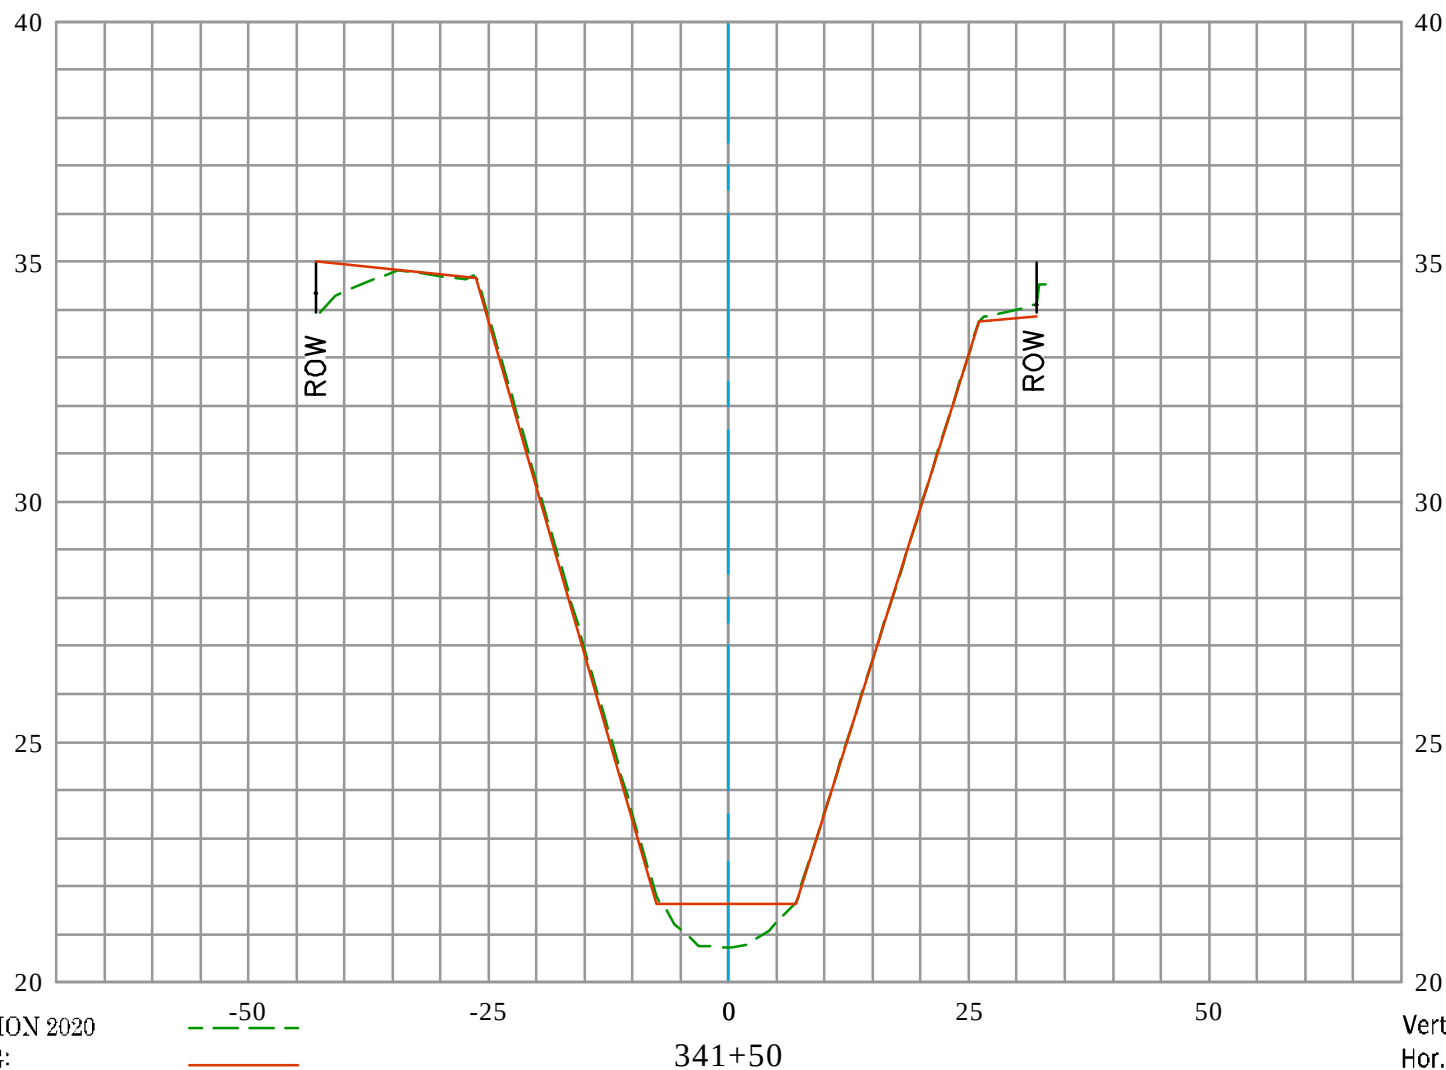


EXISTING CONDITION 2020
 RECORD DRAWING:
 D03-101-2A, D03-101-3A, & D03-101-7R
 DATE PREPARED: 01/24/2022

Vert. Scale: 1" = 4'
 Hor. Scale: 1" = 20'




GREENVILLE BANNING CHANNEL (D03) CL

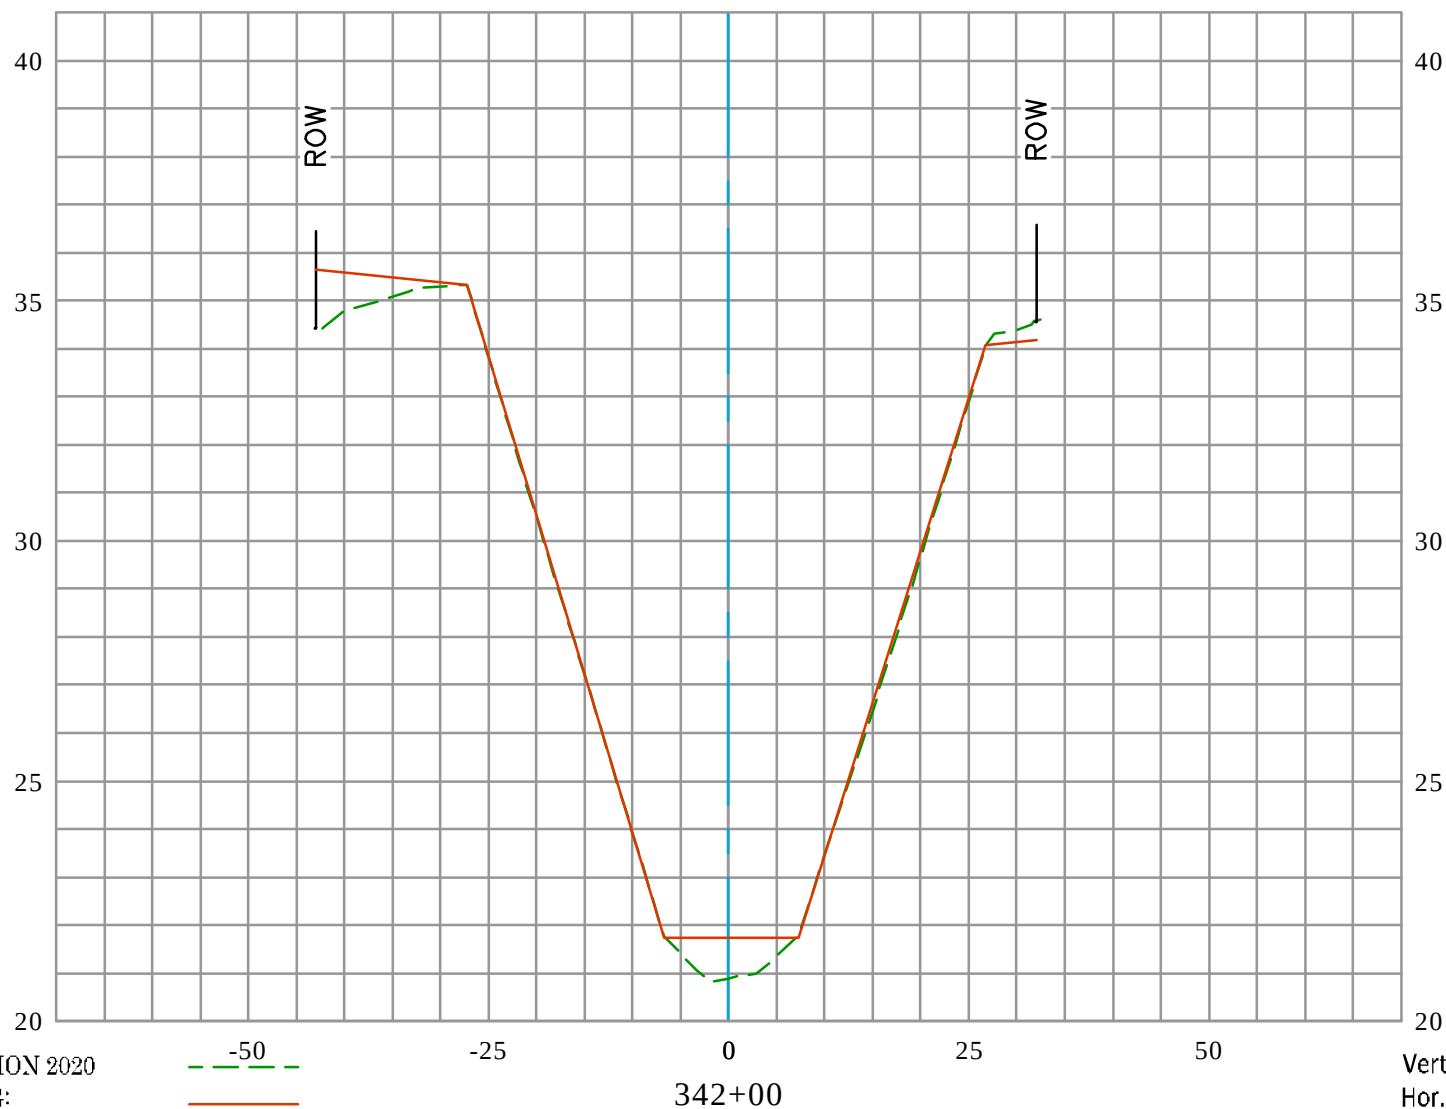


EXISTING CONDITION 2020
RECORD DRAWING:
D03-101-2A, D03-101-3A, & D03-101-7R
DATE PREPARED: 01/24/2022

GREENVILLE BANNING CHANNEL (D03) CL

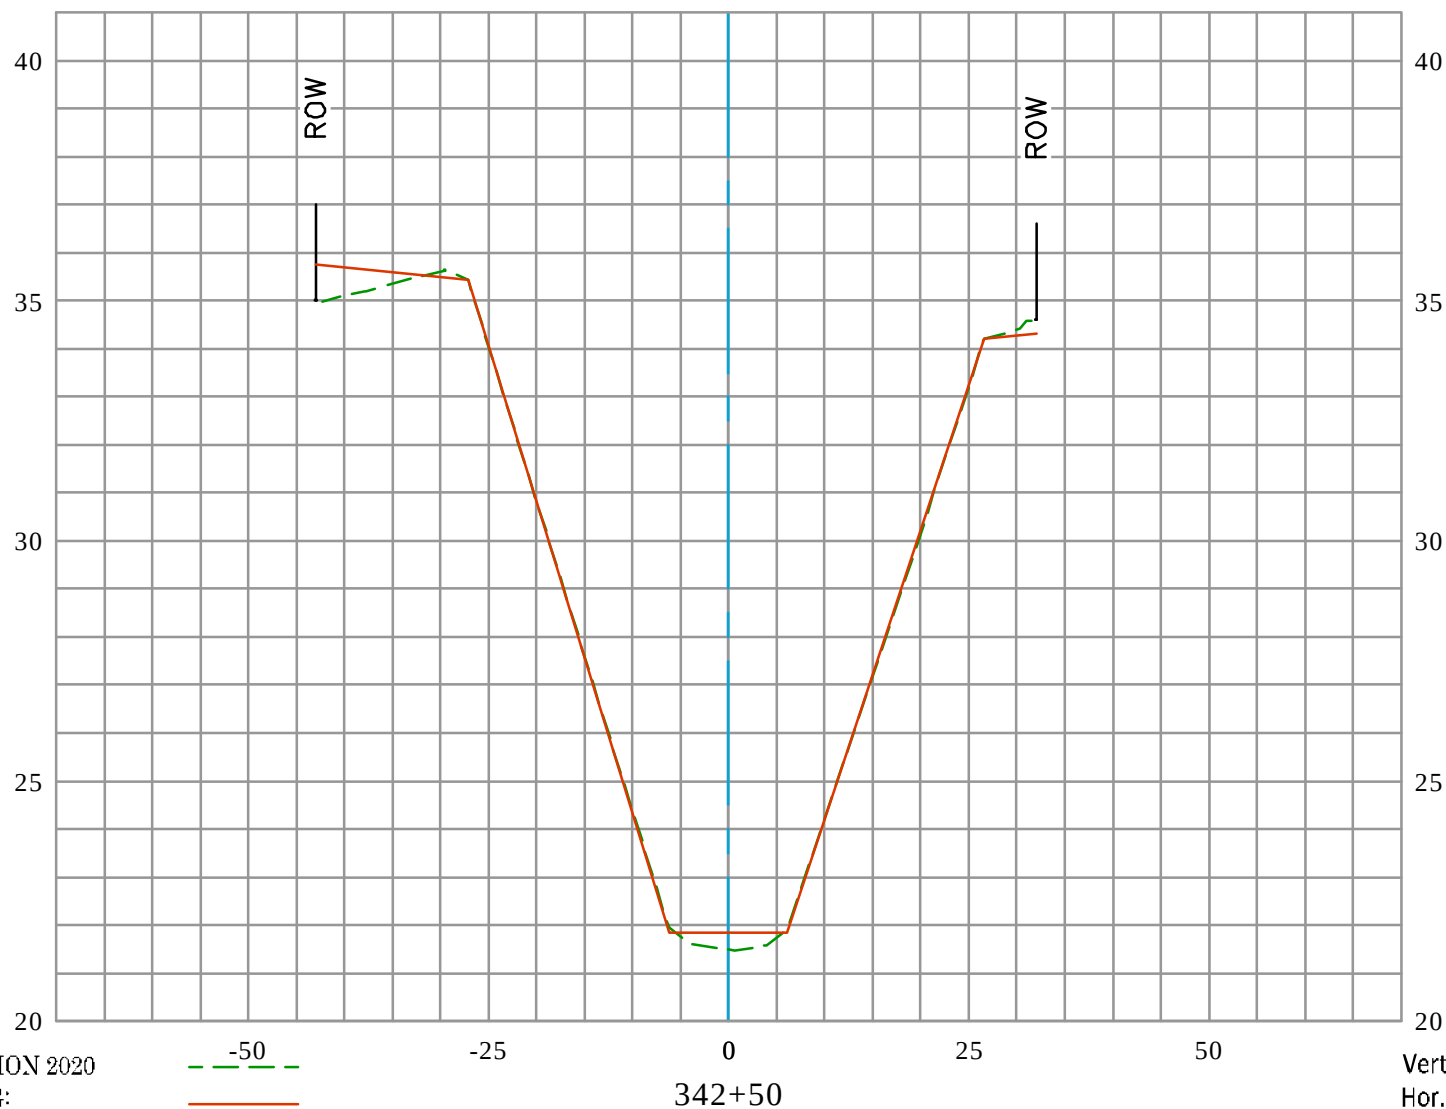

EXISTING CONDITION 2020
 RECORD DRAWING:
 D03-101-2A, D03-101-3A, & D03-101-7R
 DATE PREPARED: 01/24/2022

GREENVILLE BANNING CHANNEL (D03) CL

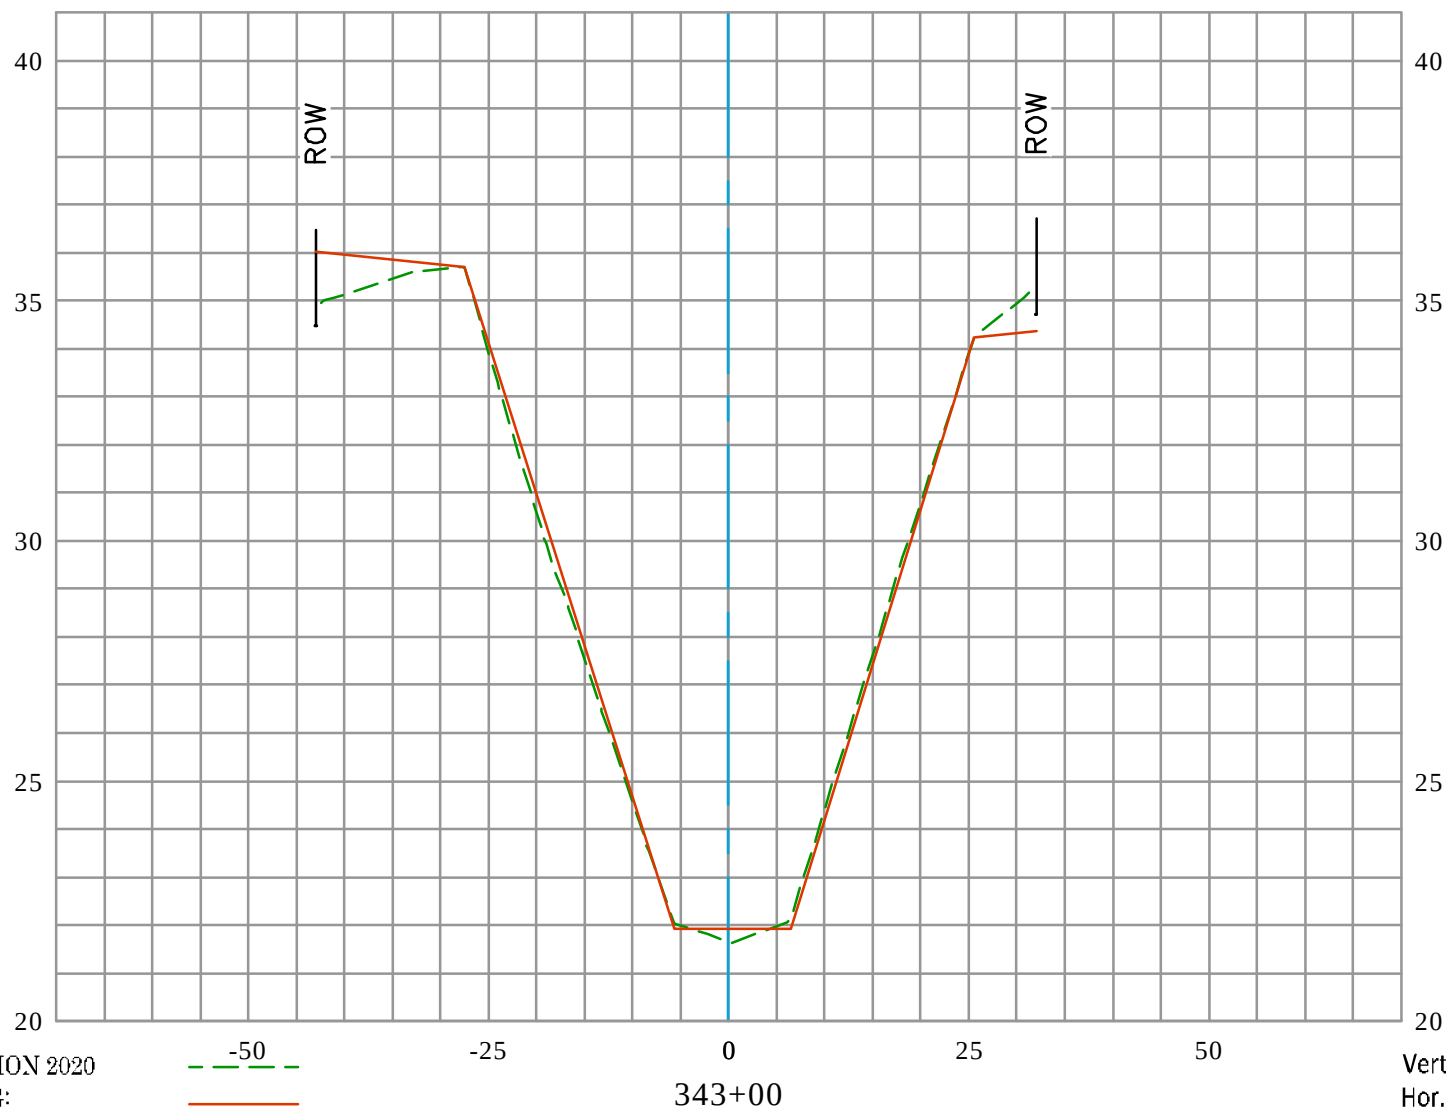


EXISTING CONDITION 2020
 RECORD DRAWING:
 D03-101-2A, D03-101-3A, & D03-101-7R
 DATE PREPARED: 01/24/2022

**U.S. Survey
Foot**


OC Public Works
OC Survey/Field Services
Boundary Analysis & Mapping

GREENVILLE BANNING CHANNEL (D03) CL

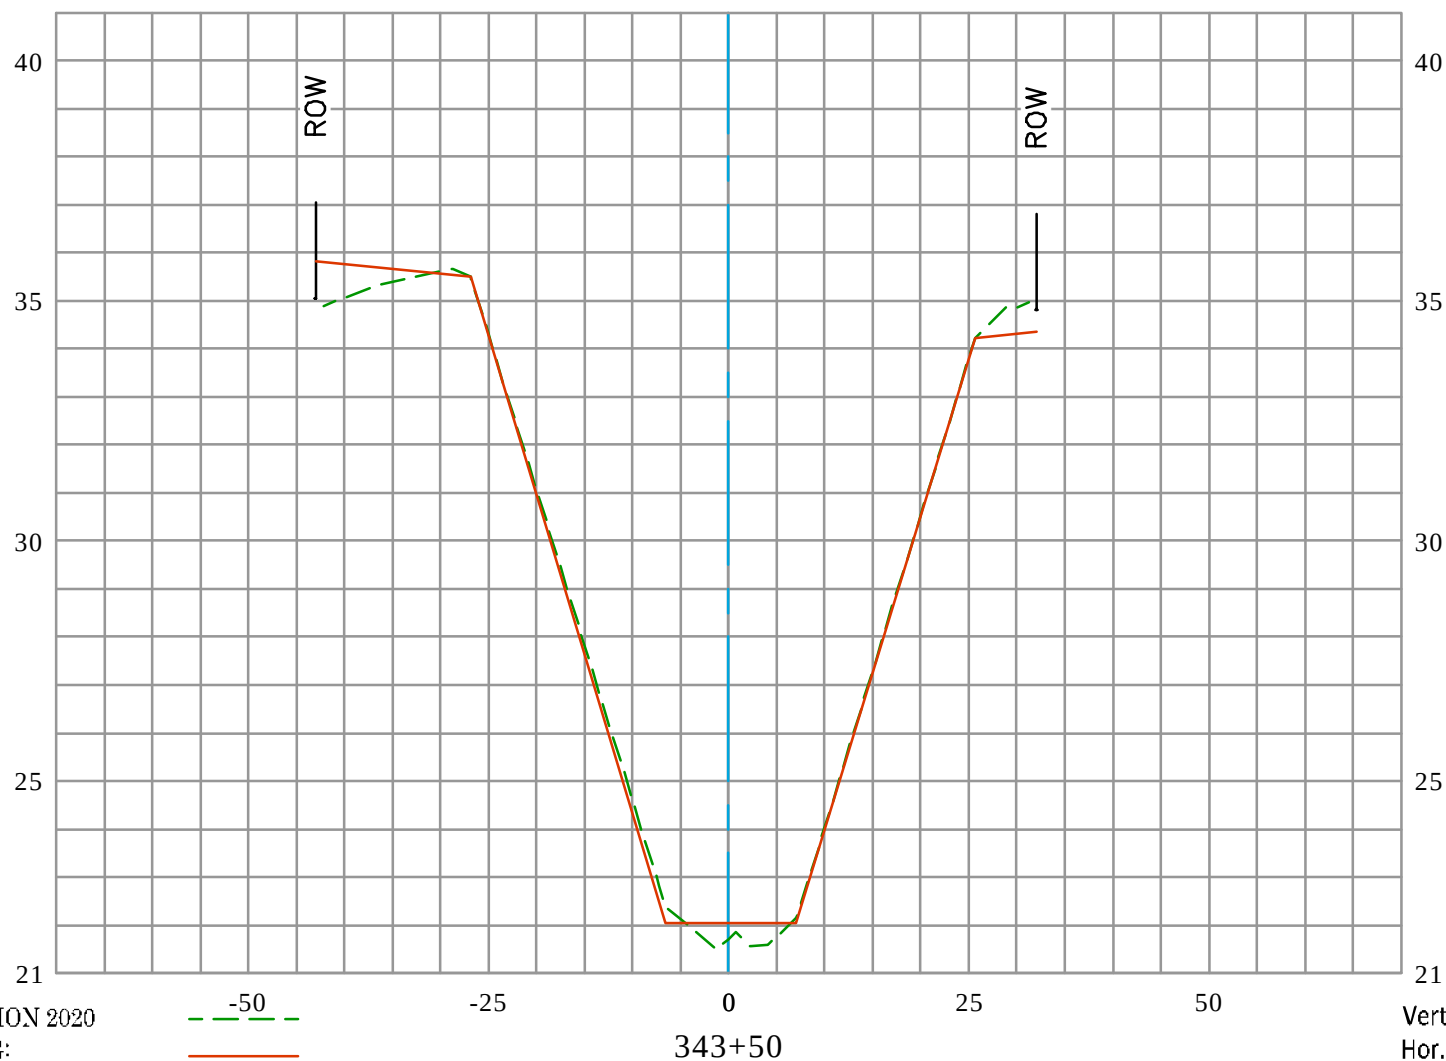



GREENVILLE BANNING CHANNEL (D03) CL

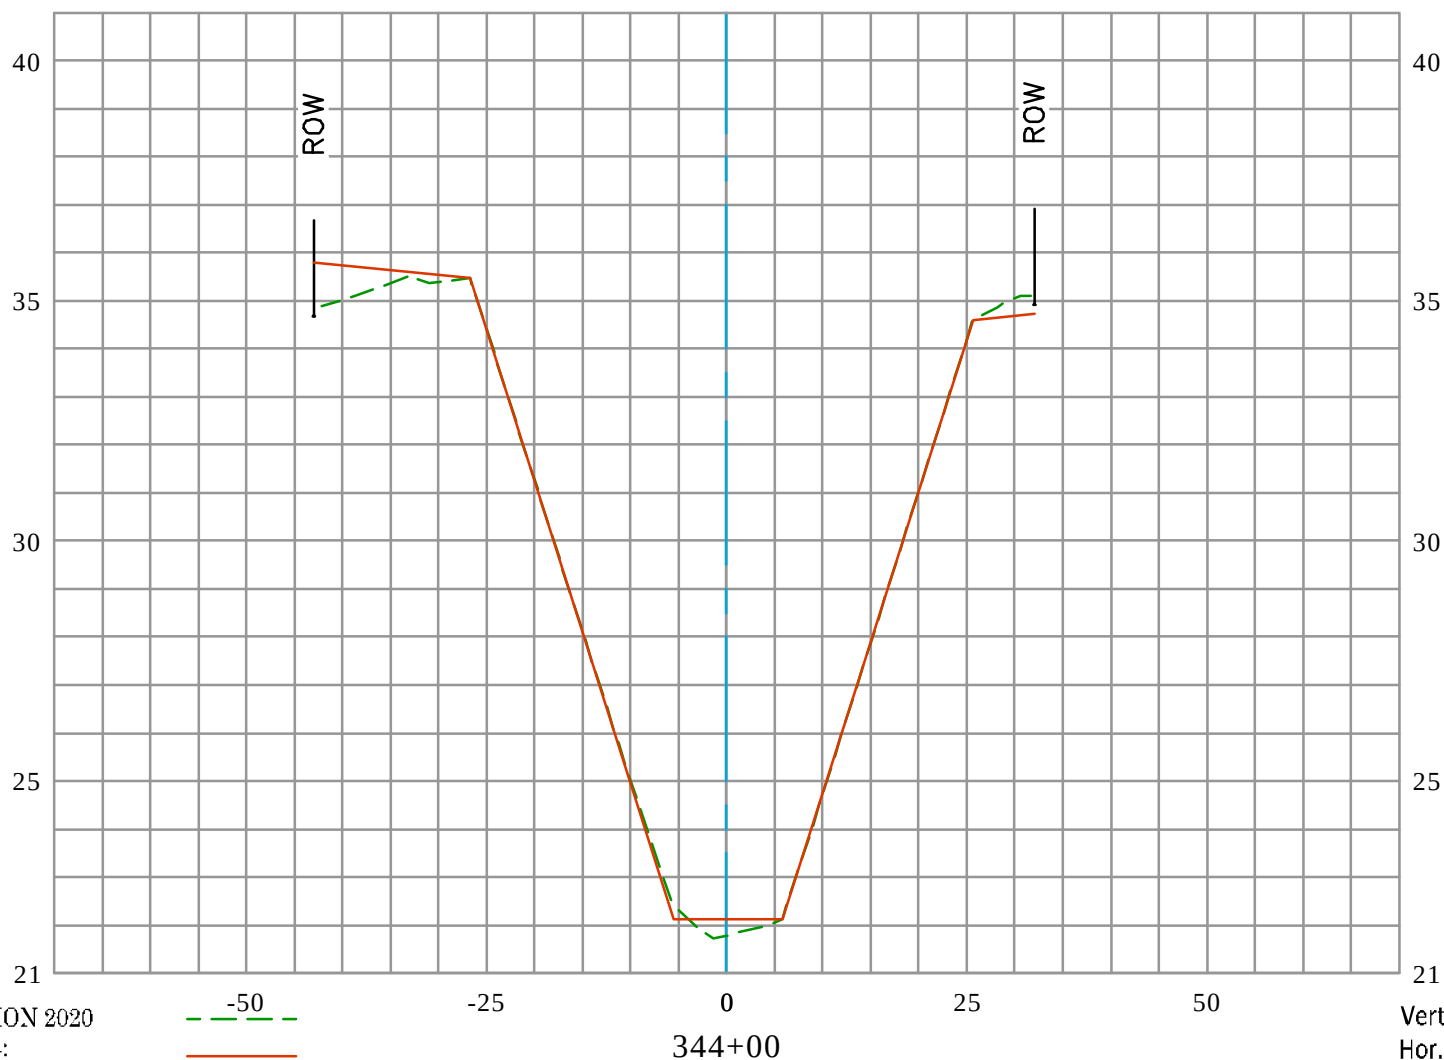


EXISTING CONDITION 2020
 RECORD DRAWING:
 D03-101-2A, D03-101-3A, & D03-101-7R
 DATE PREPARED: 01/24/2022

Vert. Scale: 1" = 4'
 Hor. Scale: 1" = 20'




GREENVILLE BANNING CHANNEL (D03) CL

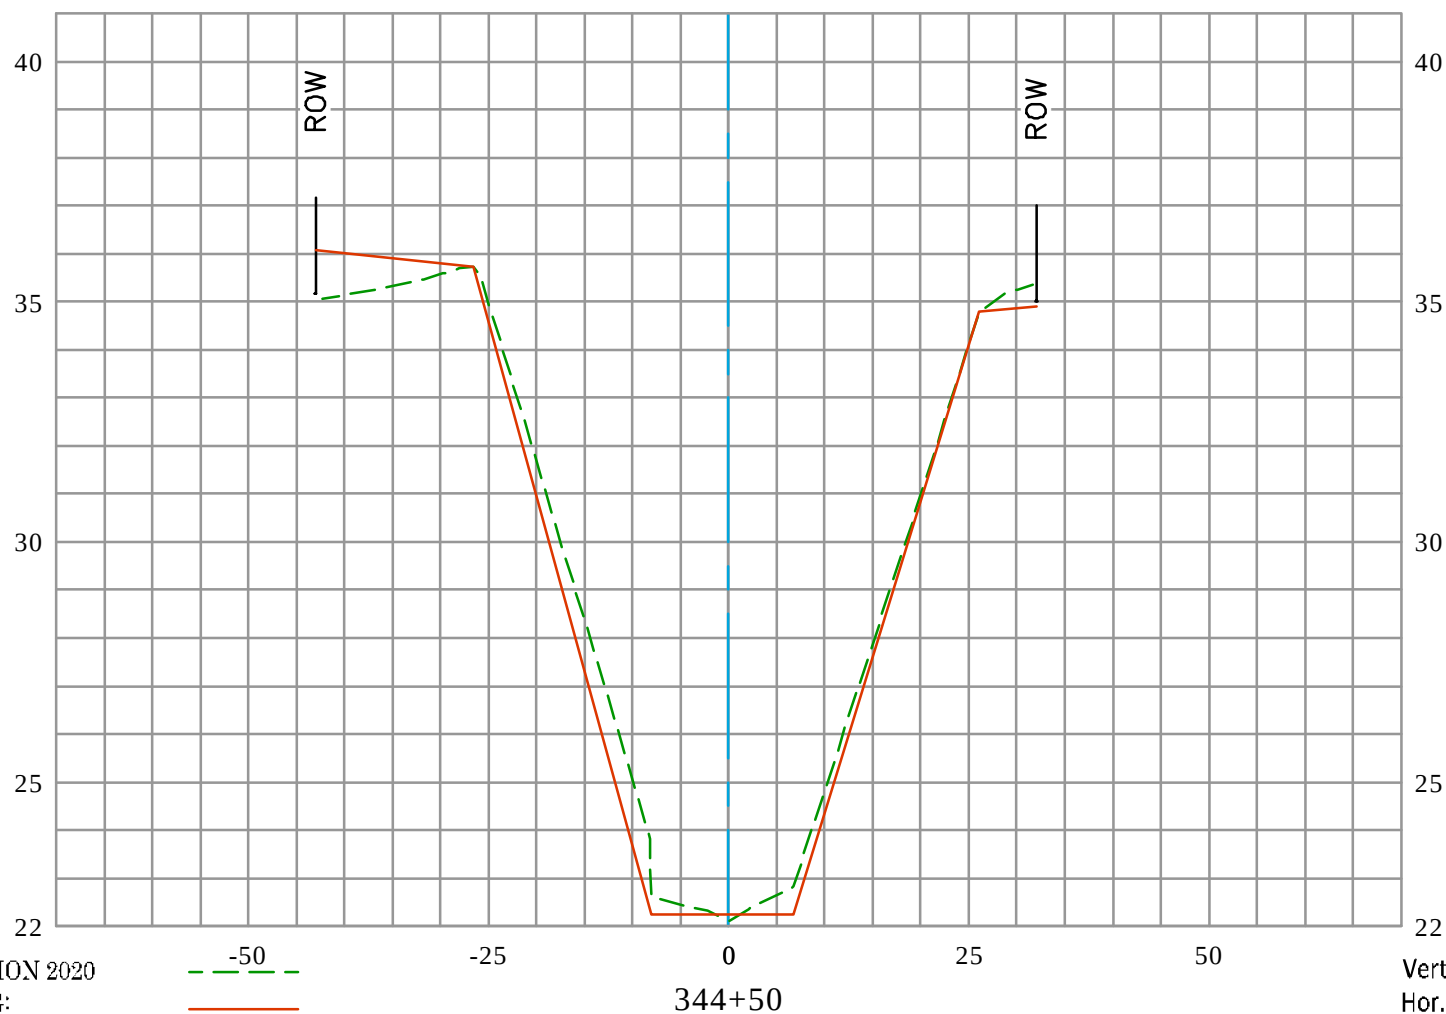

EXISTING CONDITION 2020
RECORD DRAWING:
D03-101-2A, D03-101-3A, & D03-101-7R
DATE PREPARED: 01/24/2022



GREENVILLE BANNING CHANNEL (D03) CL

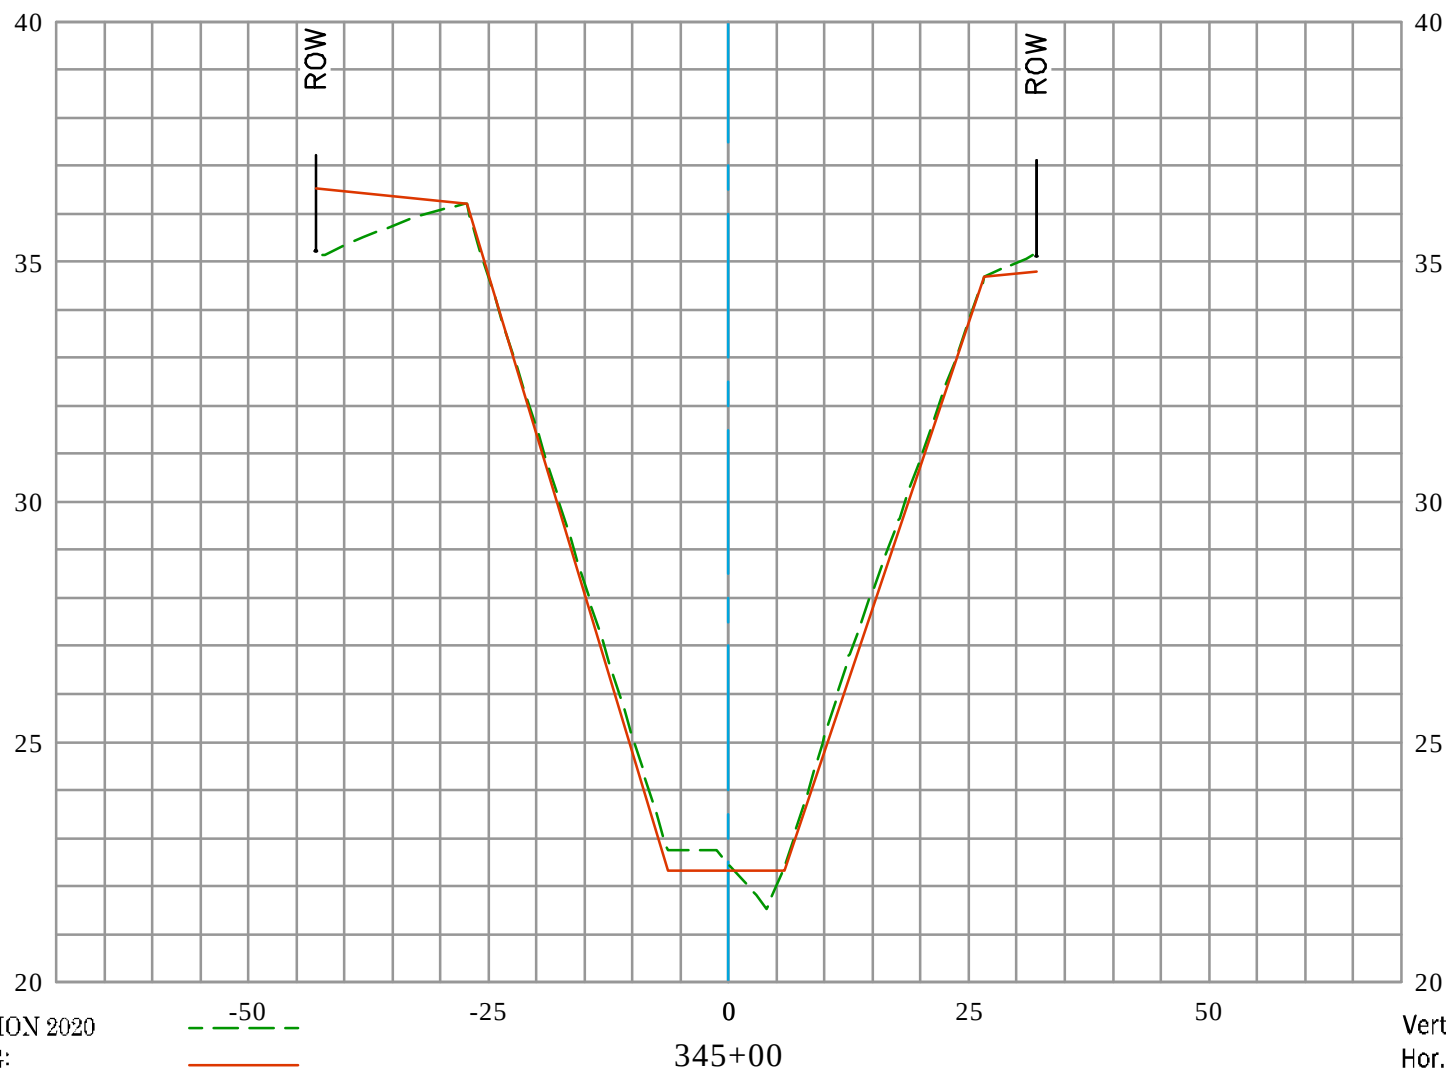


EXISTING CONDITION 2020
 RECORD DRAWING:
 D03-101-2A, D03-101-3A, & D03-101-7R
 DATE PREPARED: 01/24/2022

Vert. Scale: 1" = 4'
 Hor. Scale: 1" = 20'




GREENVILLE BANNING CHANNEL (D03) CL

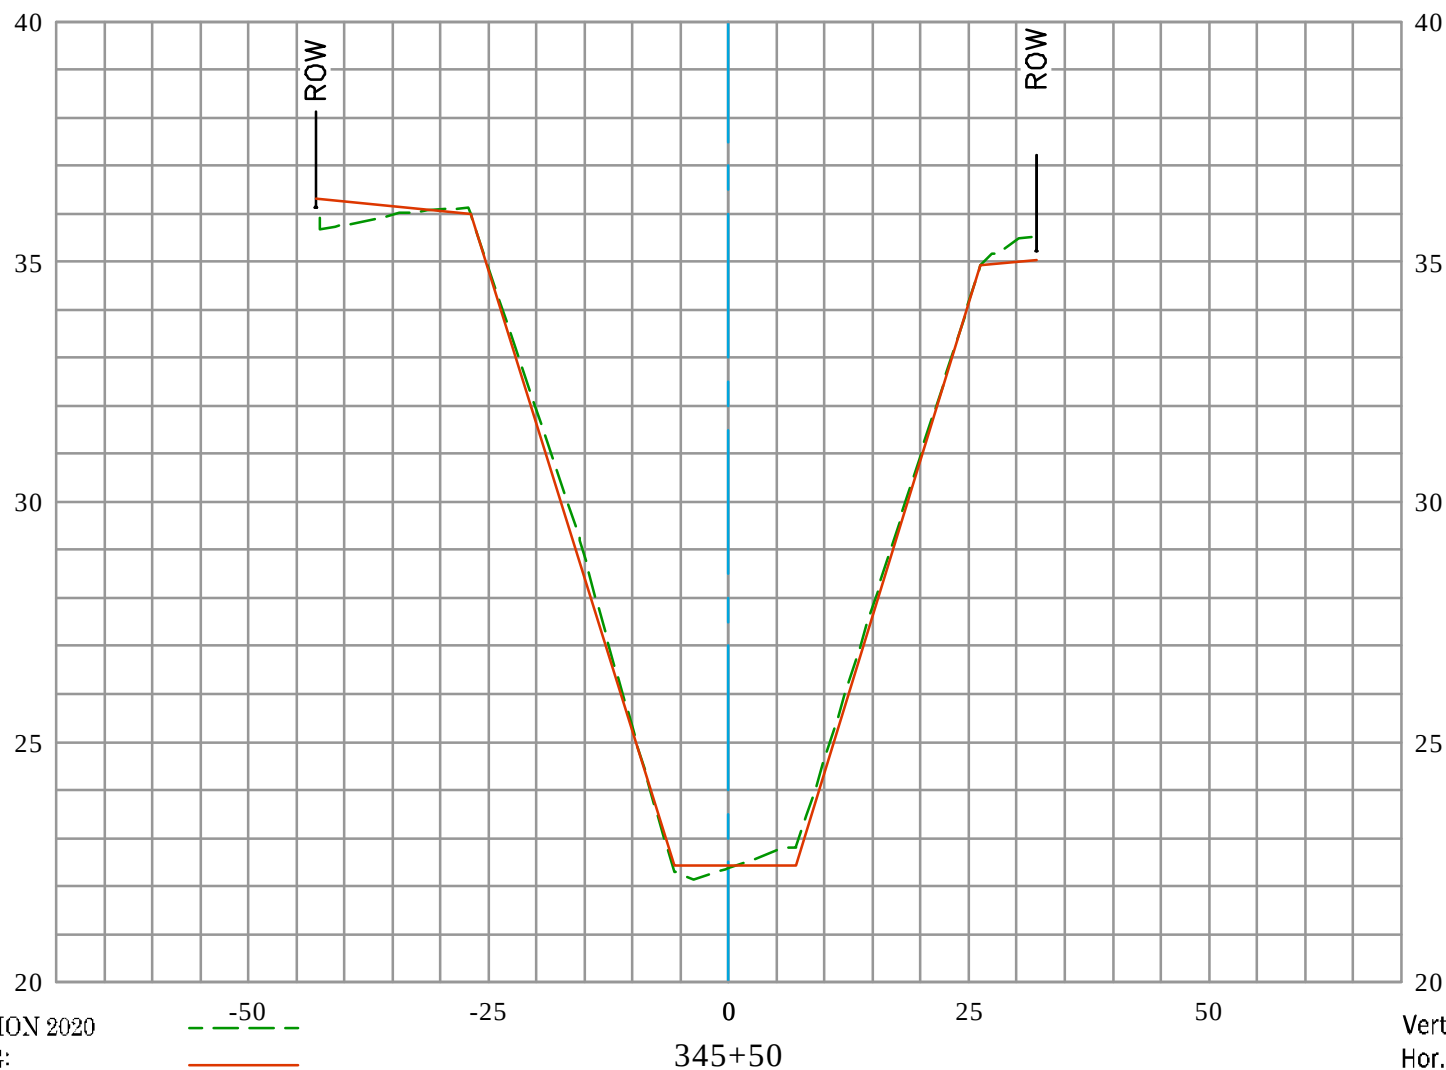

EXISTING CONDITION 2020
 RECORD DRAWING:
 D03-101-2A, D03-101-3A, & D03-101-7R
 DATE PREPARED: 01/24/2022

Vert. Scale: 1" = 4'
 Hor. Scale: 1" = 20'



GREENVILLE BANNING CHANNEL (D03) CL

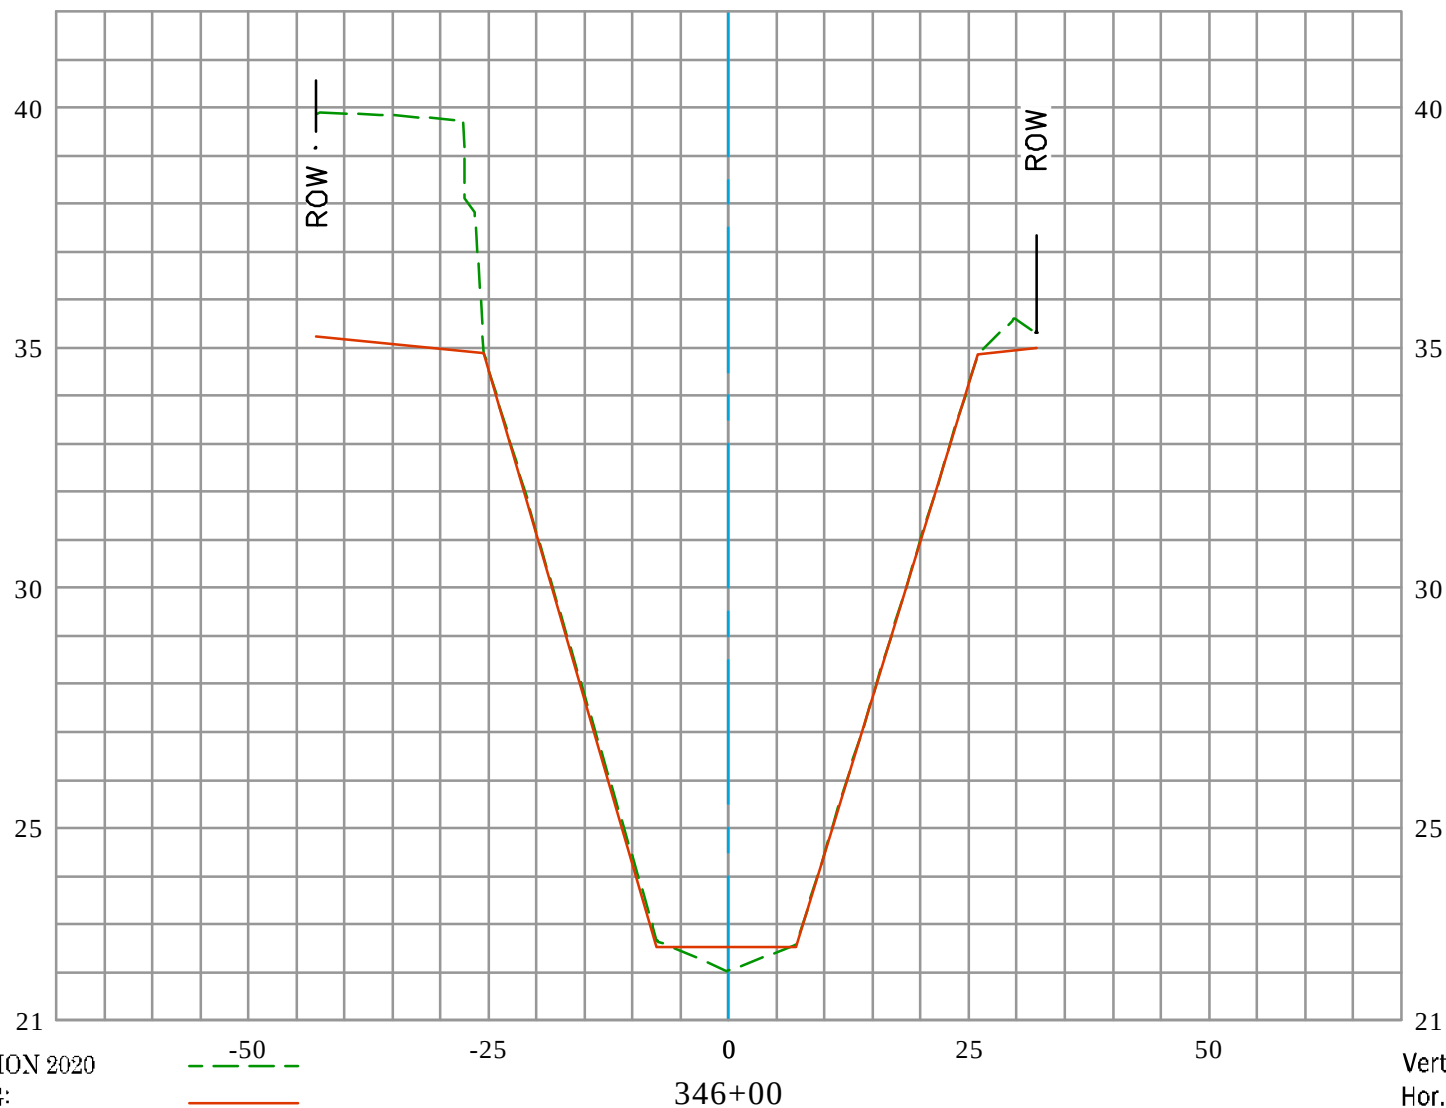

U.S. Survey Foot

OC Public Works
OC Survey/Field Services
Boundary Analysis & Mapping

GREENVILLE BANNING CHANNEL (D03) CL

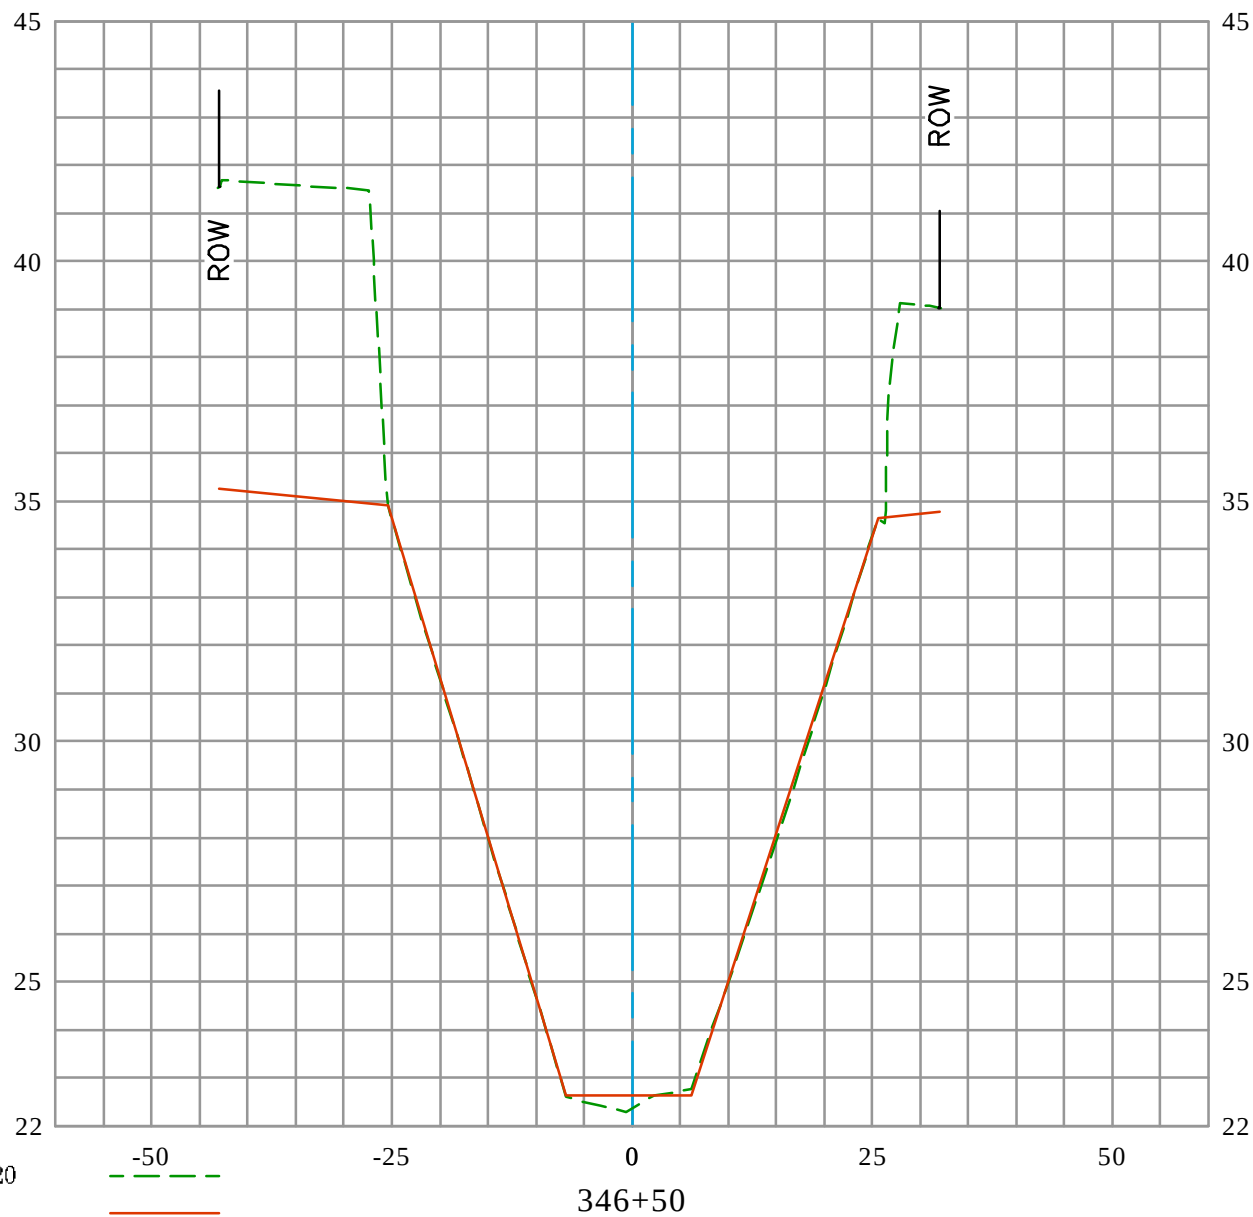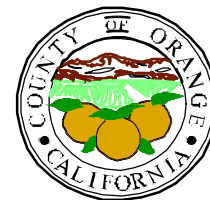



EXISTING CONDITION 2020
RECORD DRAWING:
D03-101-2A, D03-101-3A, & D03-101-7R
DATE PREPARED: 01/24/2022

Vert. Scale: 1" = 4'
Hor. Scale: 1" = 20'


U.S. *Survey*
Foot

OC Public Works
OC Survey/Field Services
Boundary Analysis & Mapping

GREENVILLE BANNING CHANNEL (D03) CL

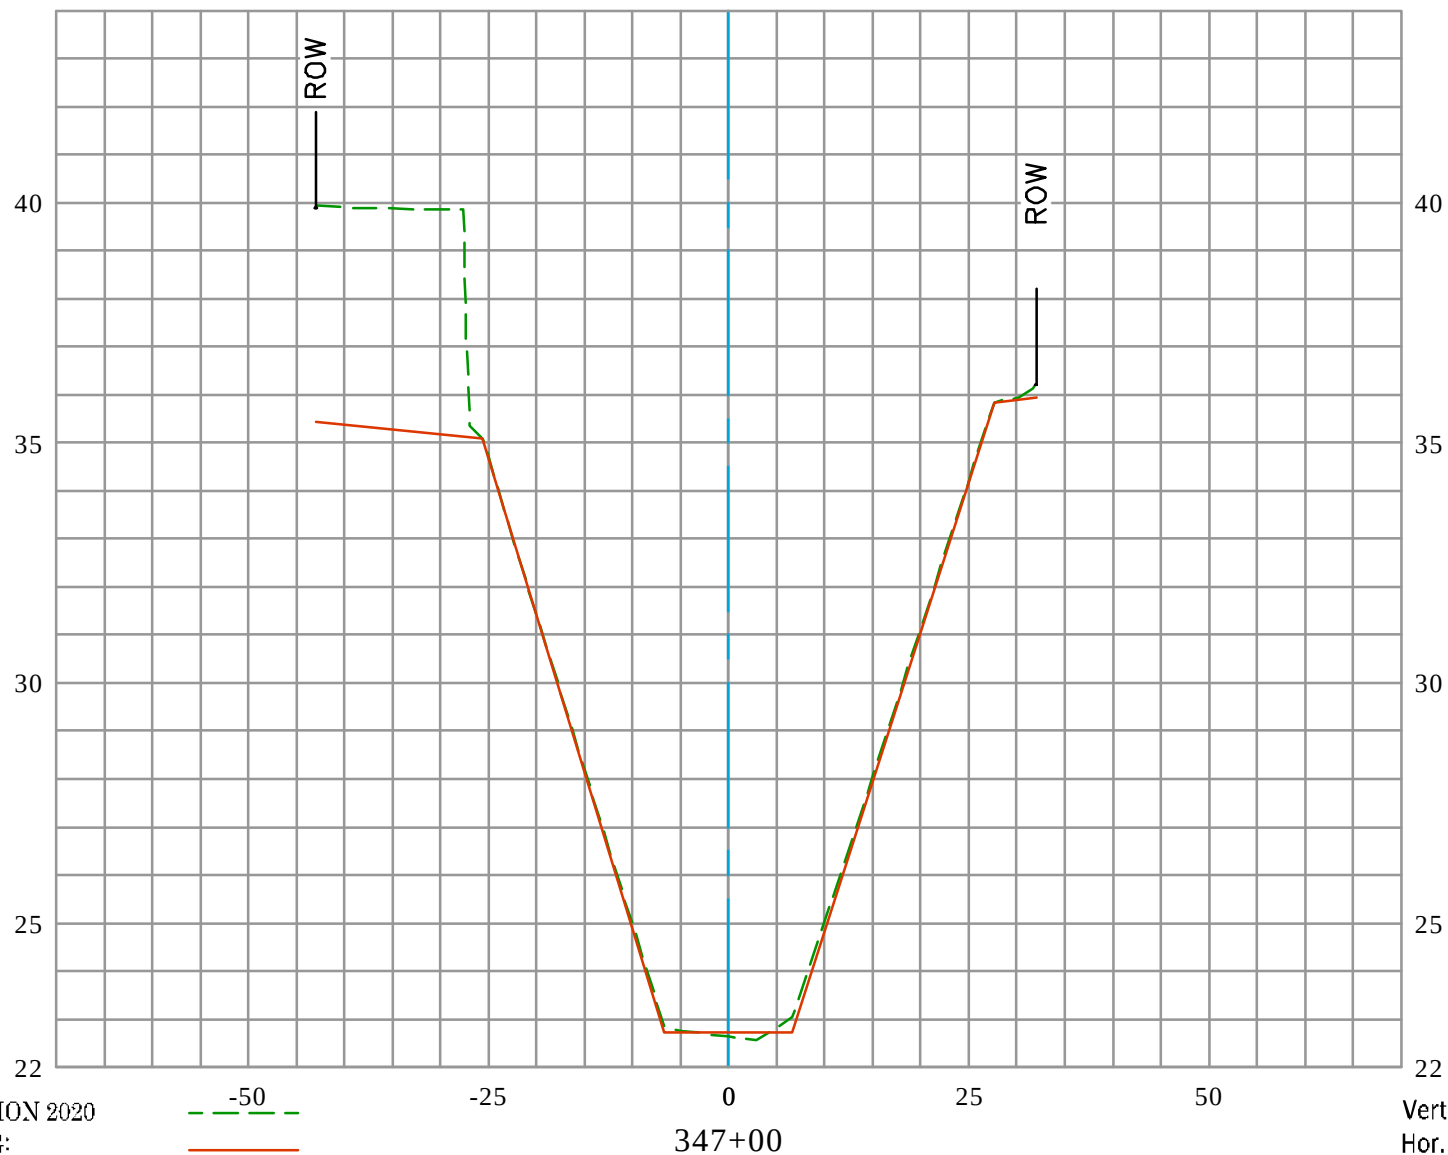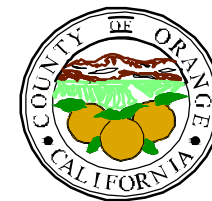

GREENVILLE BANNING CHANNEL (D03) CL

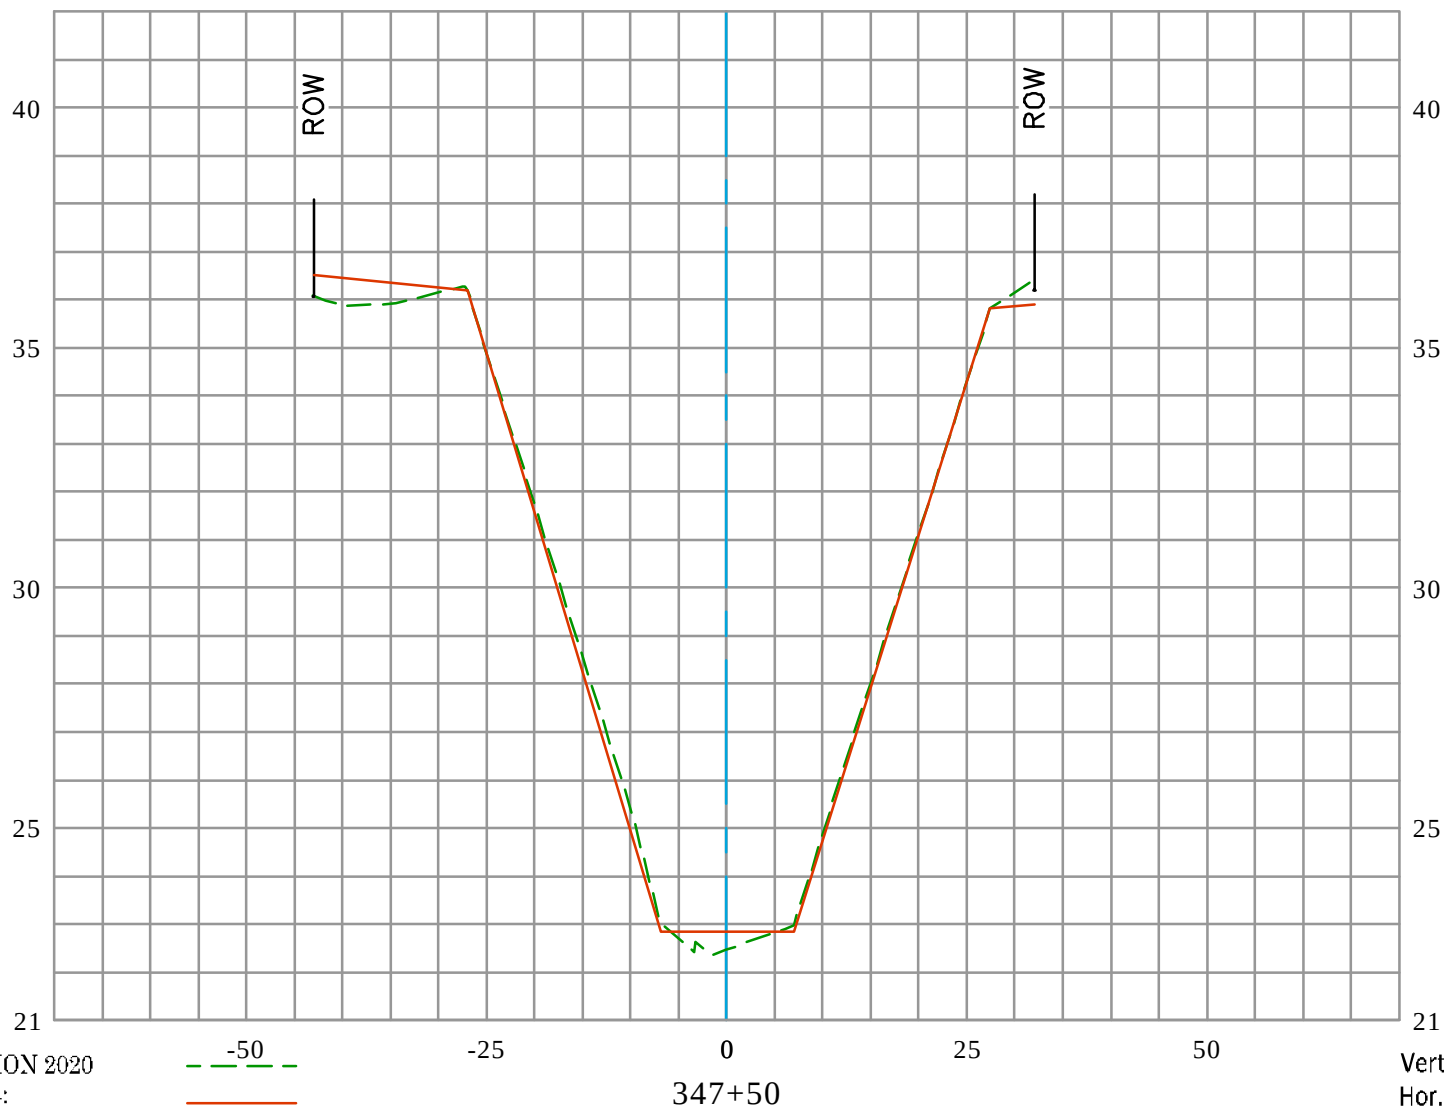



EXISTING CONDITION 2020
 RECORD DRAWING:
 D03-101-2A, D03-101-3A, & D03-101-7R
 DATE PREPARED: 01/24/2022

Vert. Scale: 1" = 4'
 Hor. Scale: 1" = 20'


U.S. *Survey*
Foot

OC Public Works
OC Survey/Field Services
Boundary Analysis & Mapping

GREENVILLE BANNING CHANNEL (D03) CL

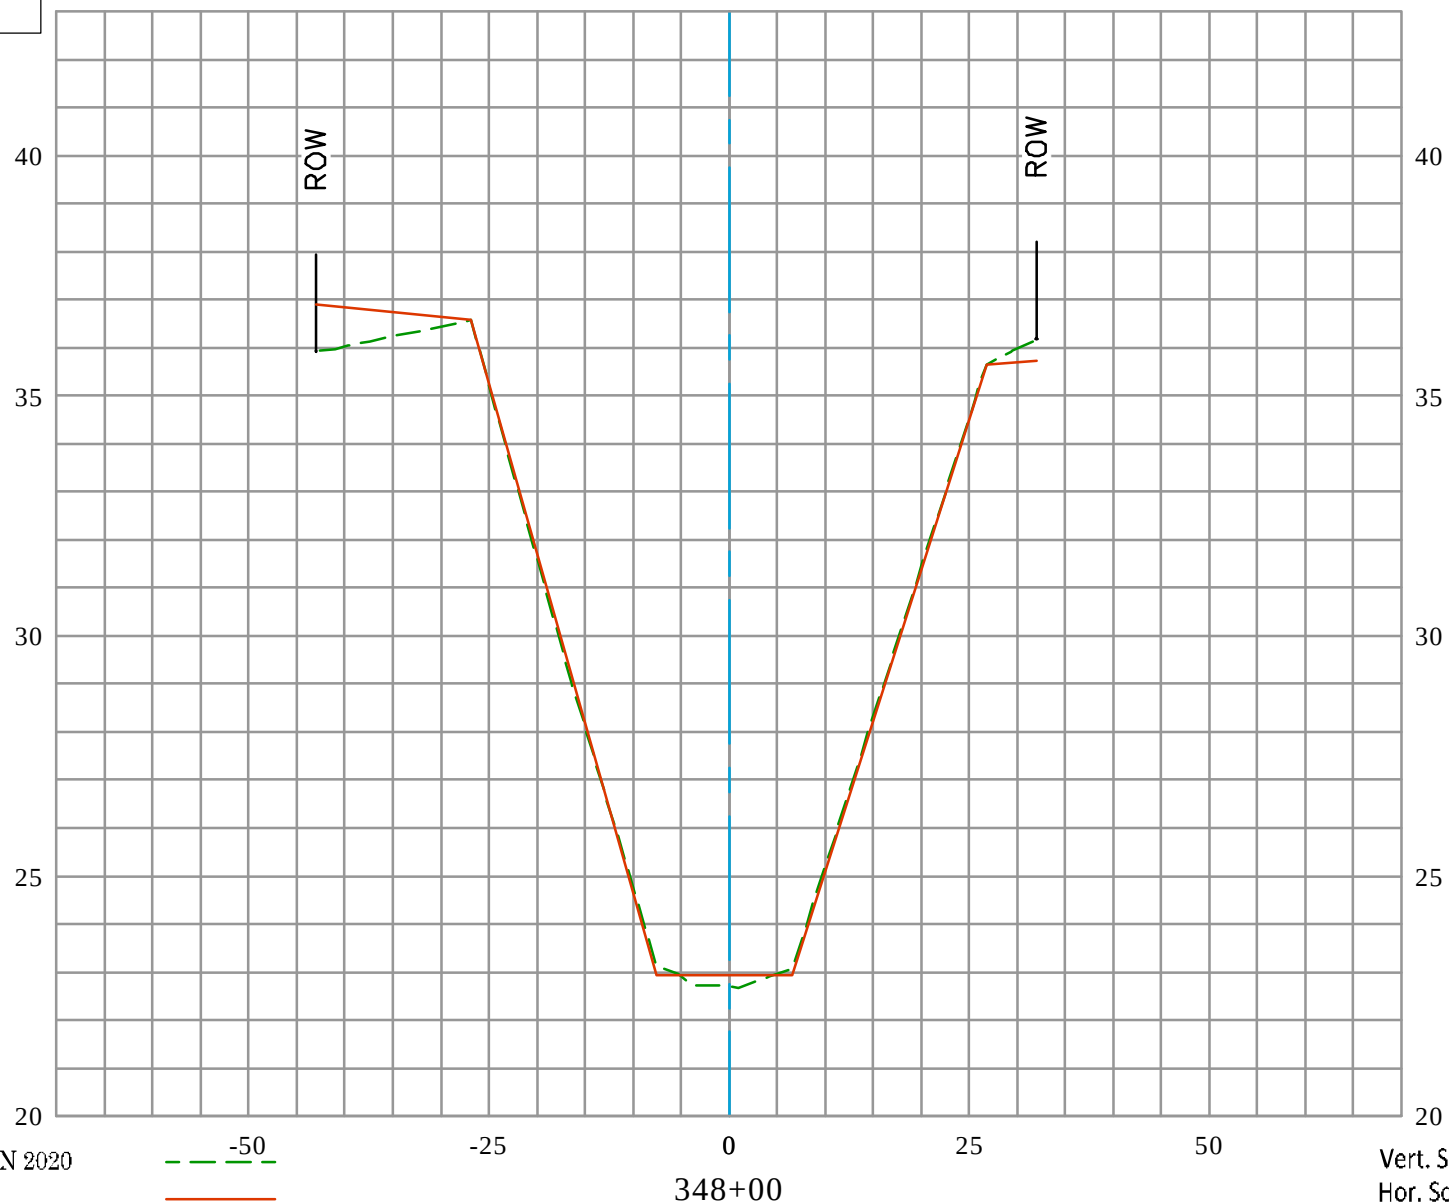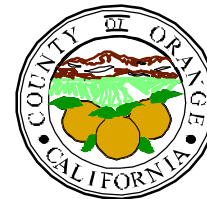

GREENVILLE BANNING CHANNEL (D03) CL

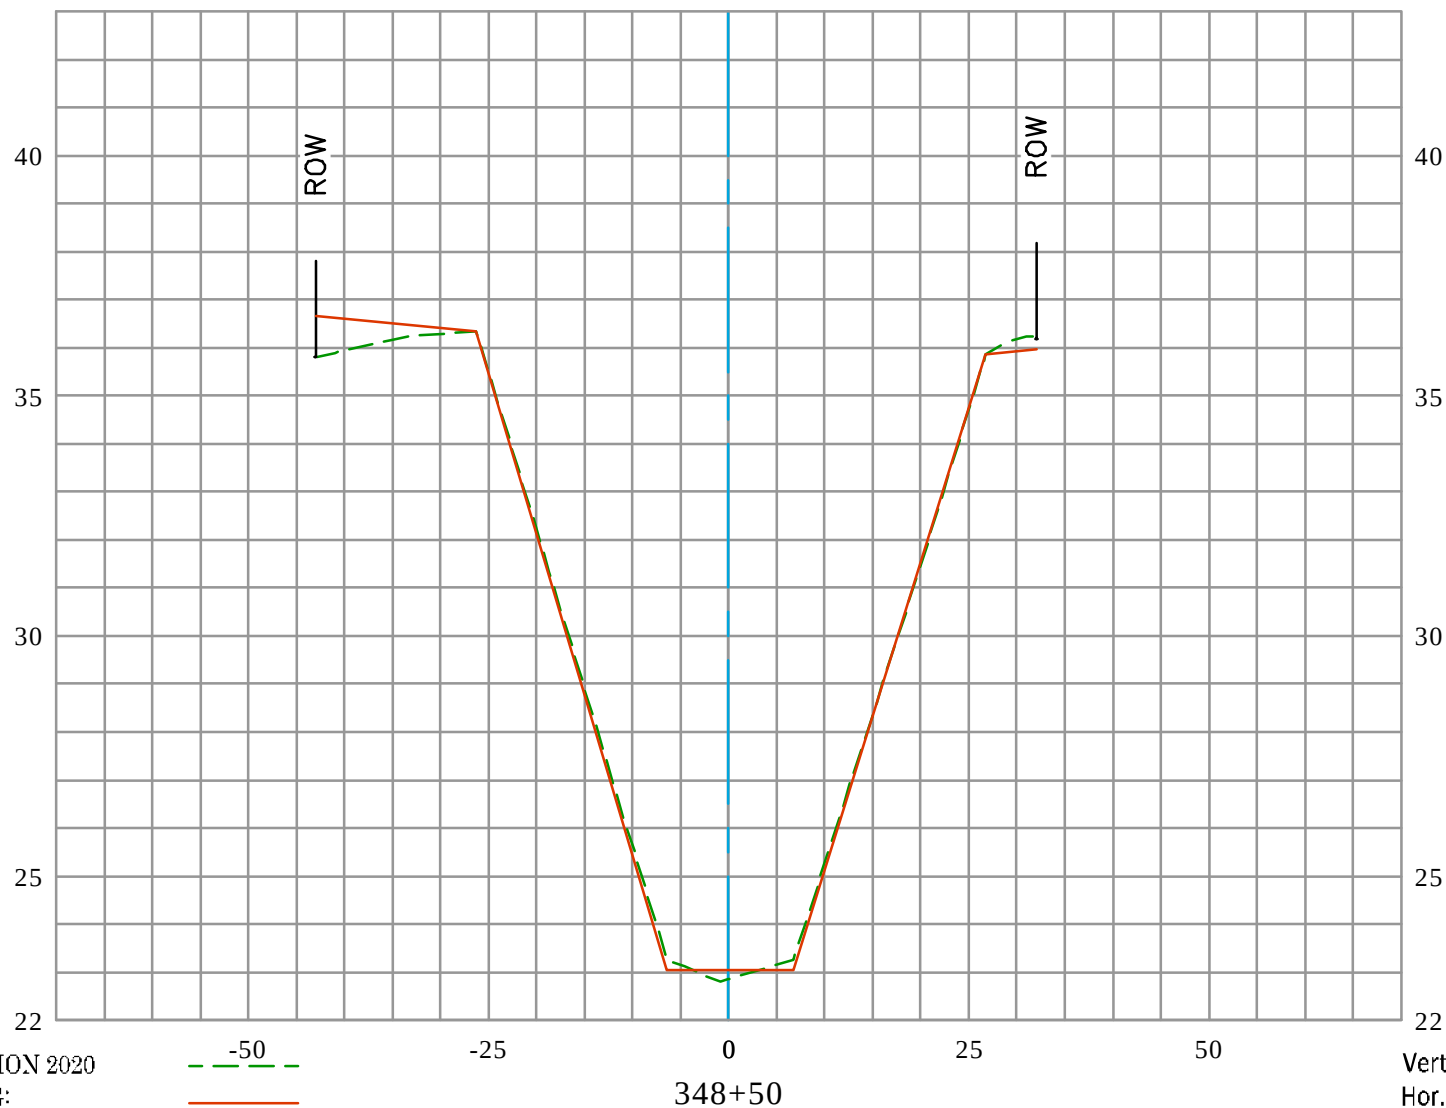



EXISTING CONDITION 2020
 RECORD DRAWING:
 D03-101-2A, D03-101-3A, & D03-101-7R
 DATE PREPARED: 01/24/2022

Vert. Scale: 1" = 4'
 Hor. Scale: 1" = 20'

U.S. Survey
Foot

OC Public Works
OC Survey/Field Services
Boundary Analysis & Mapping

GREENVILLE BANNING CHANNEL (D03) CL

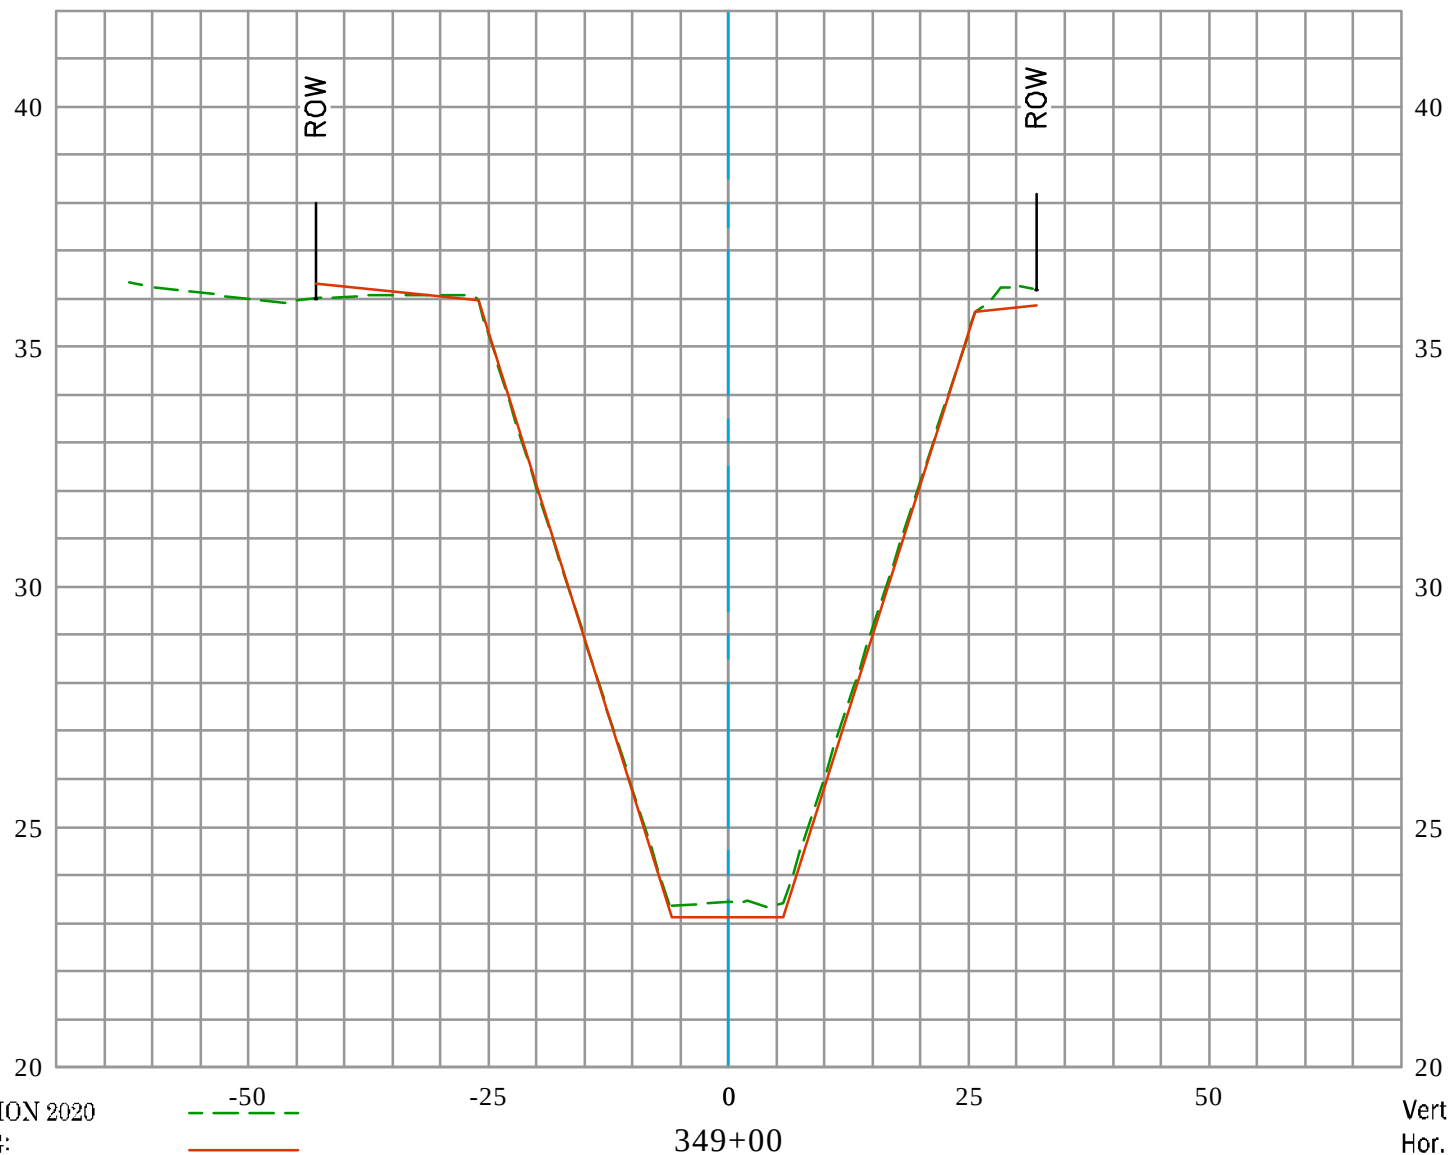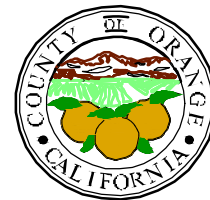



EXISTING CONDITION 2020
RECORD DRAWING:
D03-101-2A, D03-101-3A, & D03-101-7R
DATE PREPARED: 01/24/2022

Vert. Scale: 1" = 4'
Hor. Scale: 1" = 20'

U.S. *Survey Foot*


OC Public Works
OC Survey/Field Services
Boundary Analysis & Mapping

GREENVILLE BANNING CHANNEL (D03) CL

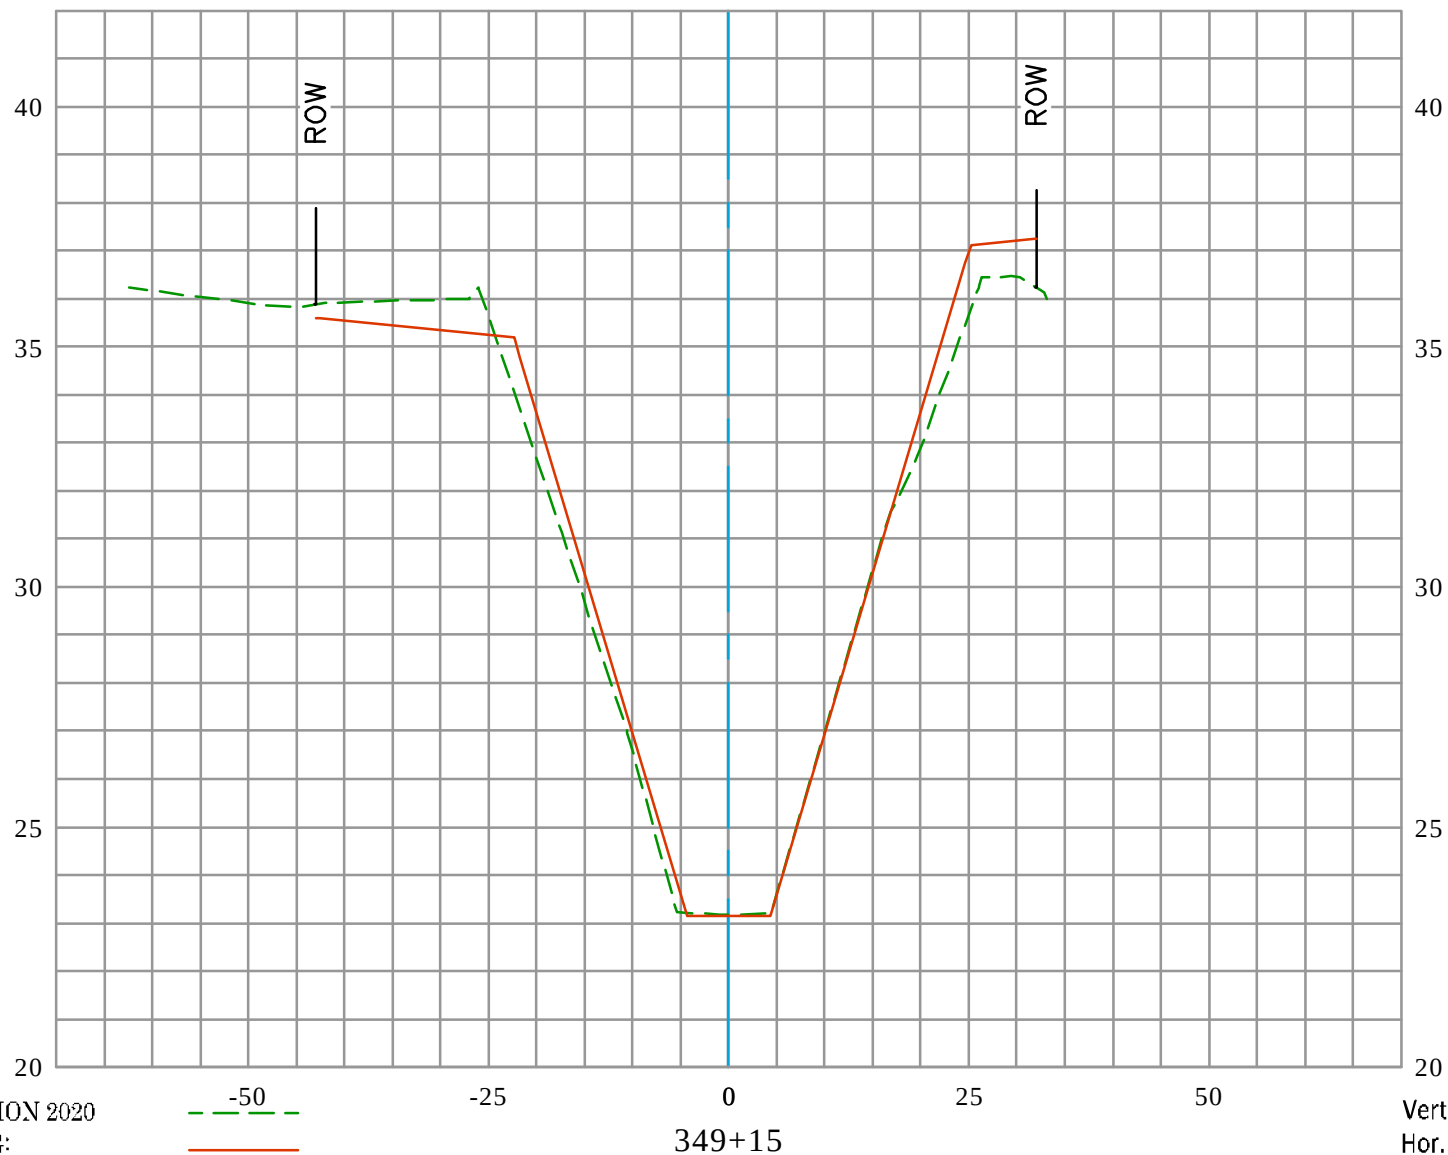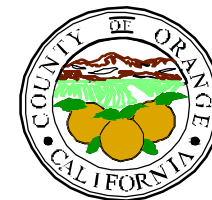

EXISTING CONDITION 2020
RECORD DRAWING:
D03-101-2A, D03-101-3A, & D03-101-7R
DATE PREPARED: 01/24/2022

GREENVILLE BANNING CHANNEL (D03) CL

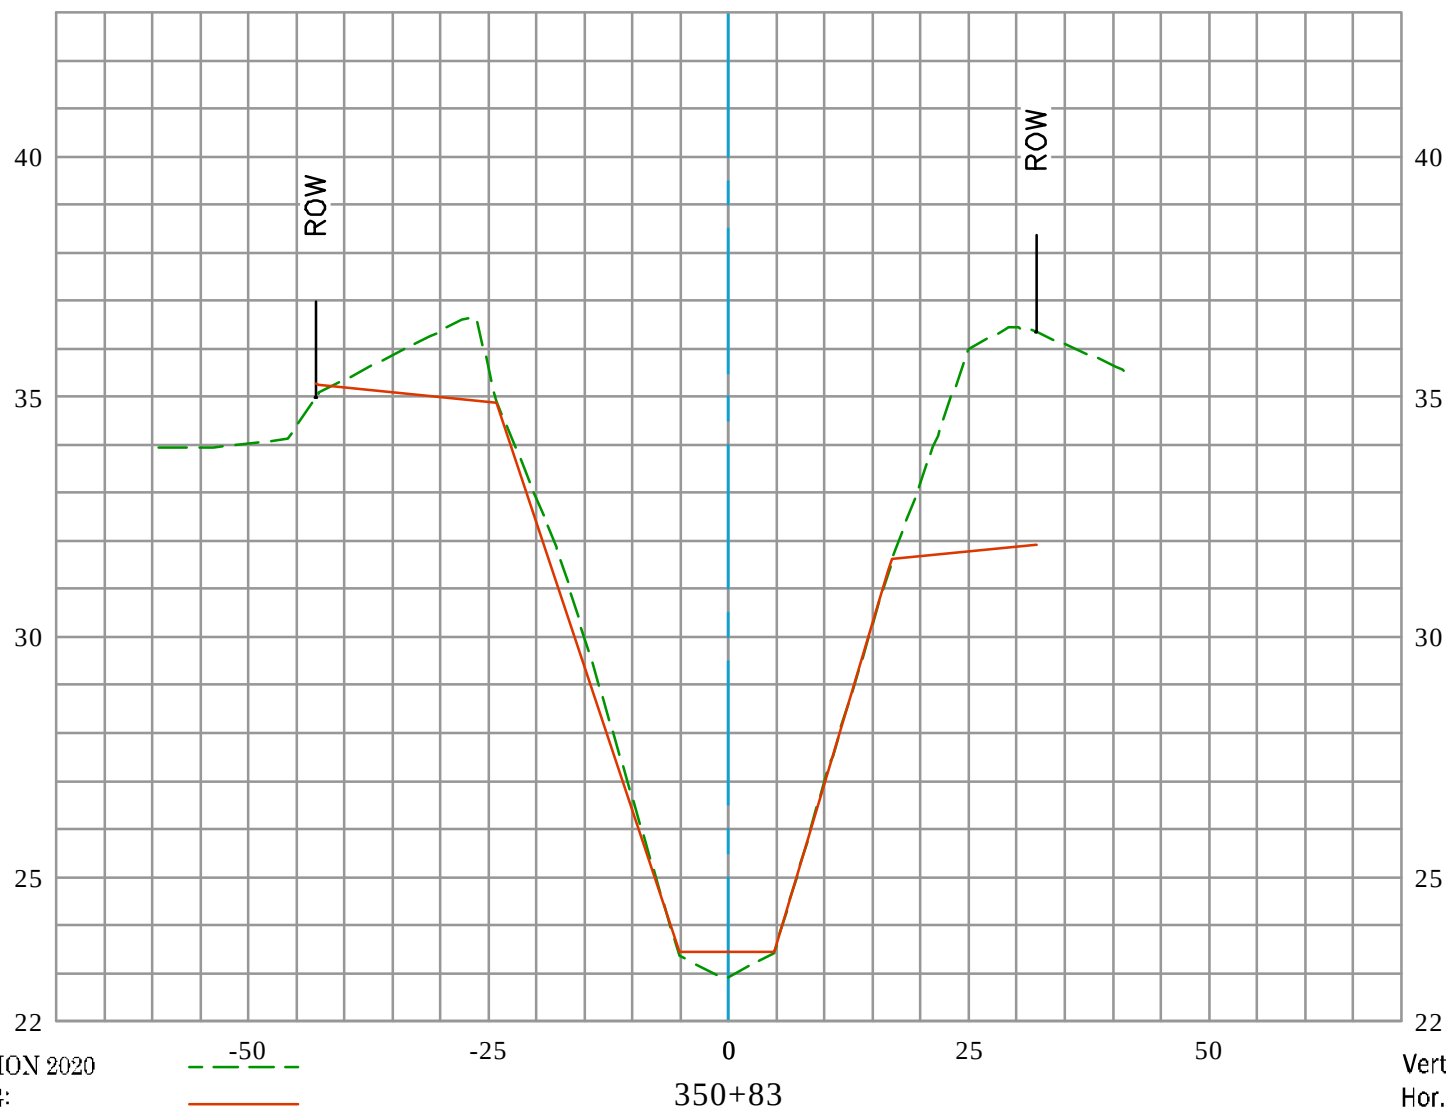



EXISTING CONDITION 2020
 RECORD DRAWING:
 D03-101-2A, D03-101-3A, & D03-101-7R
 DATE PREPARED: 01/24/2022

Vert. Scale: 1" = 4'
 Hor. Scale: 1" = 20'

U.S. Survey
Foot

OC Public Works
OC Survey/Field Services
Boundary Analysis & Mapping

GREENVILLE BANNING CHANNEL (D03) CL

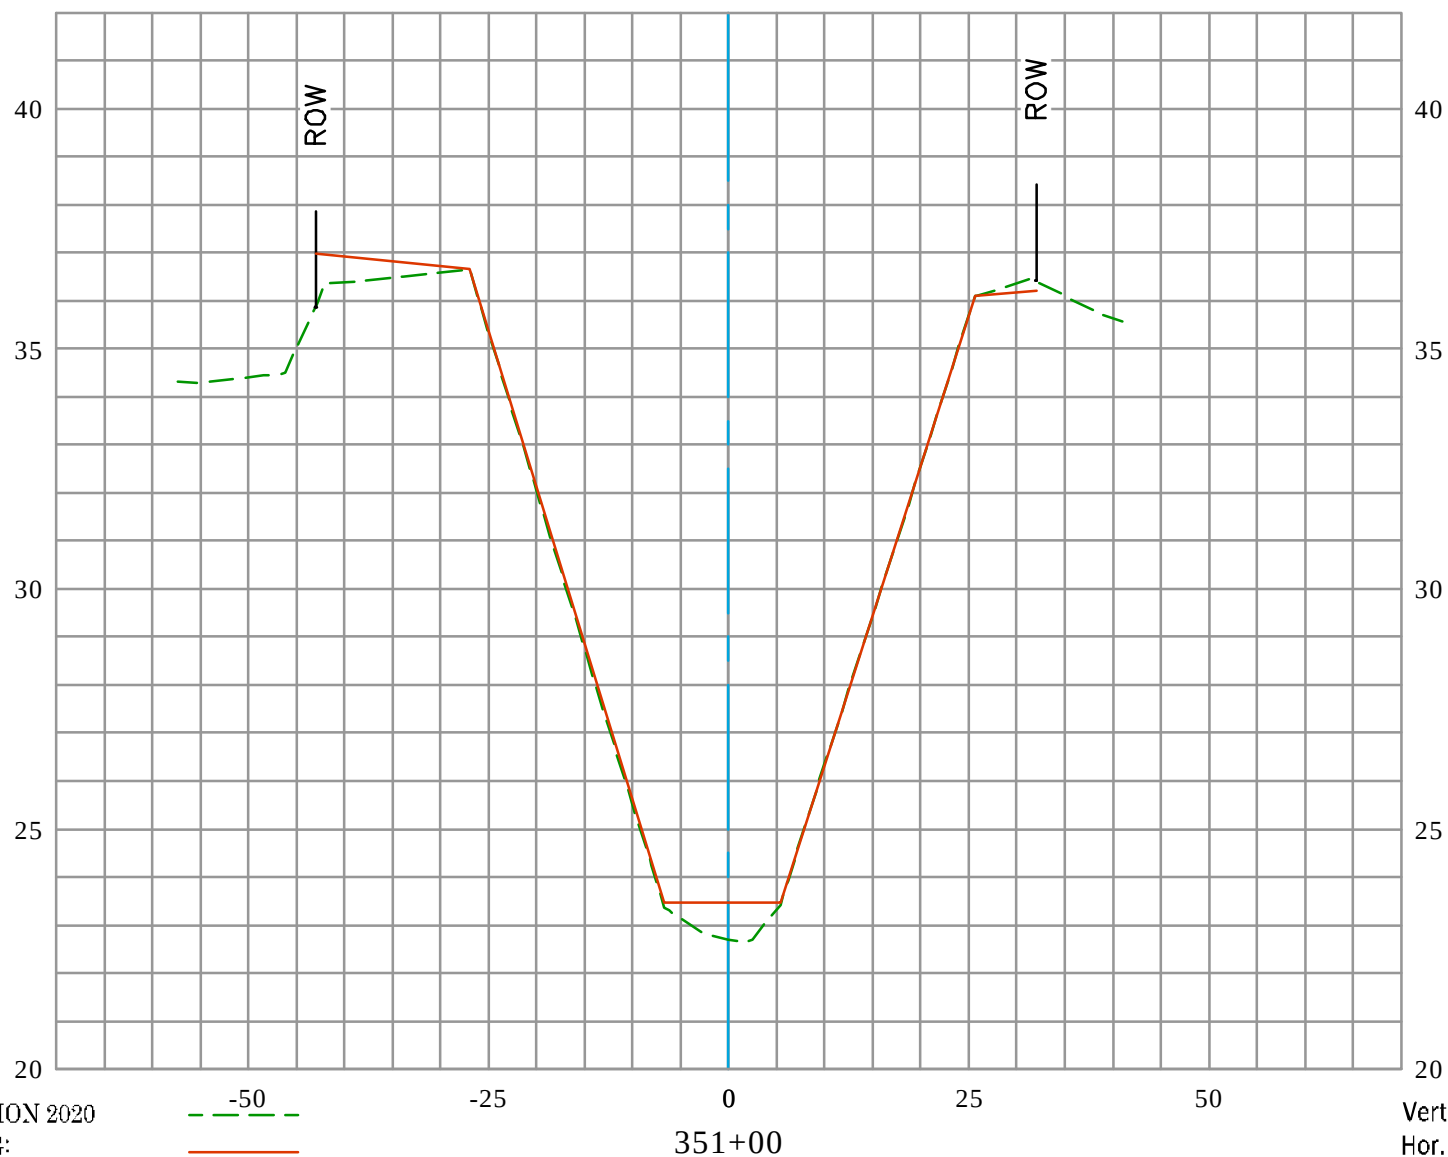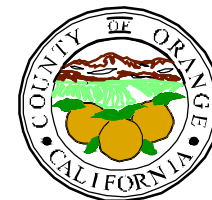


EXISTING CONDITION 2020
RECORD DRAWING:
D03-101-2A, D03-101-3A, & D03-101-7R
DATE PREPARED: 01/24/2022

Vert. Scale: 1" = 4'
Hor. Scale: 1" = 20'

U.S. *Survey
Foot*

OC Public Works
OC Survey/Field Services
Boundary Analysis & Mapping



GREENVILLE BANNING CHANNEL (D03) CL

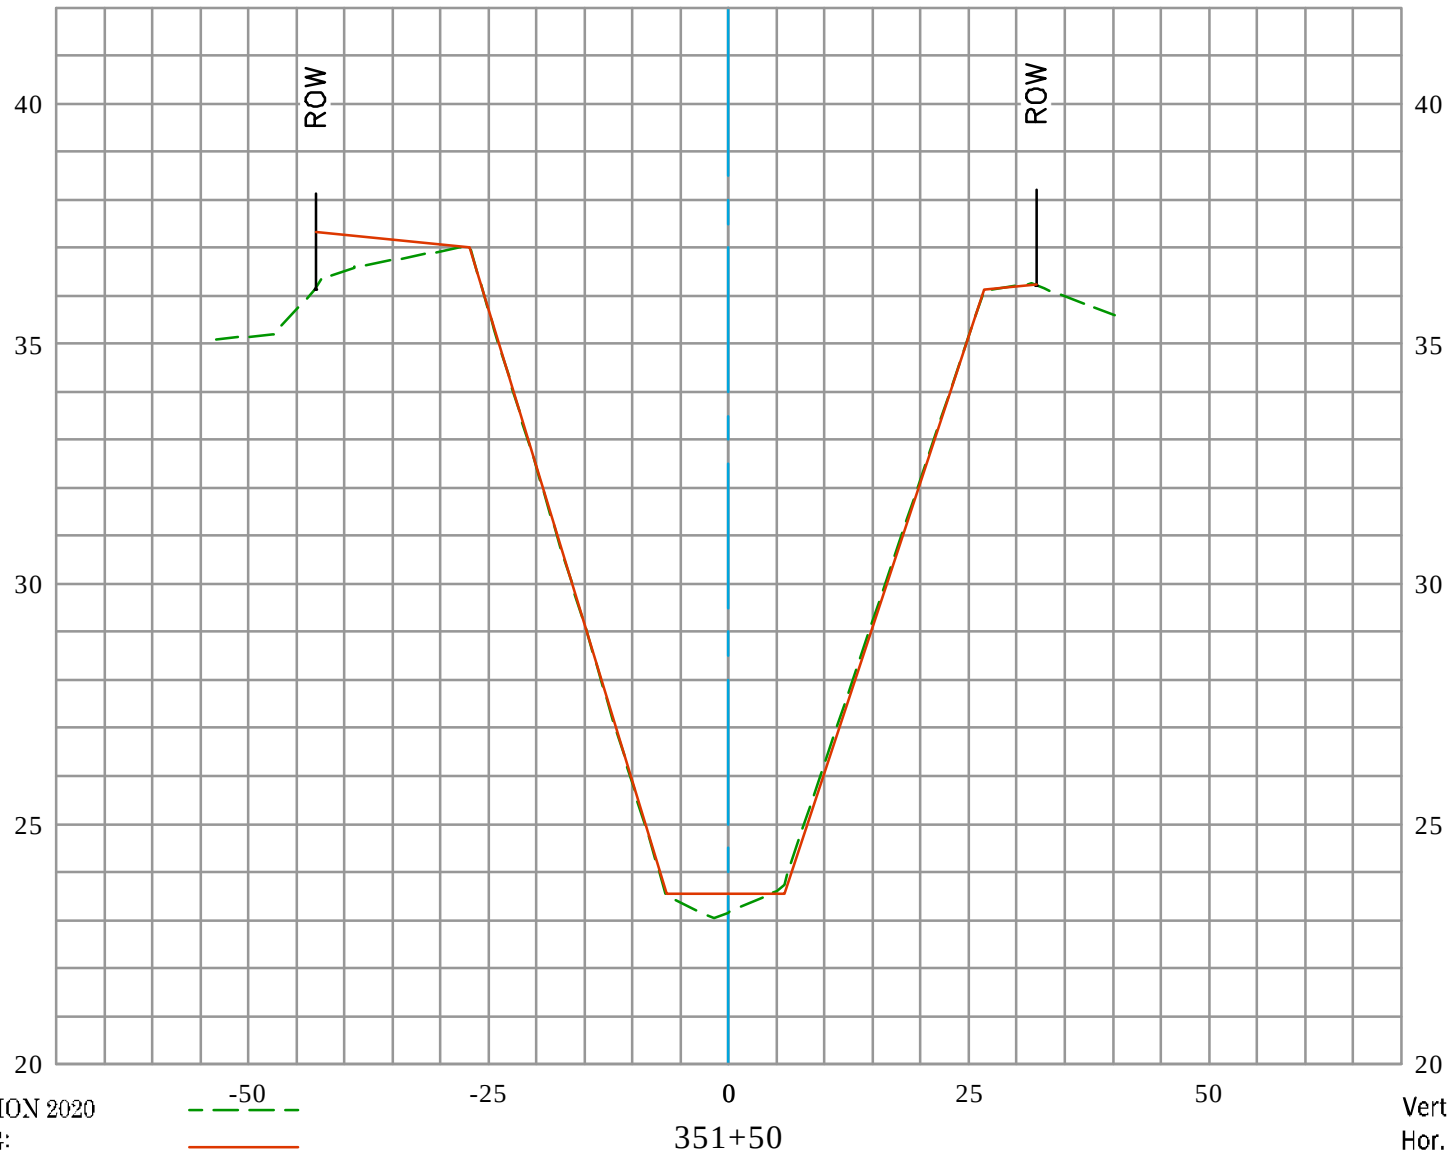

U.S. *Survey Foot*

OC Public Works
OC Survey/Field Services
Boundary Analysis & Mapping

GREENVILLE BANNING CHANNEL (D03) CL

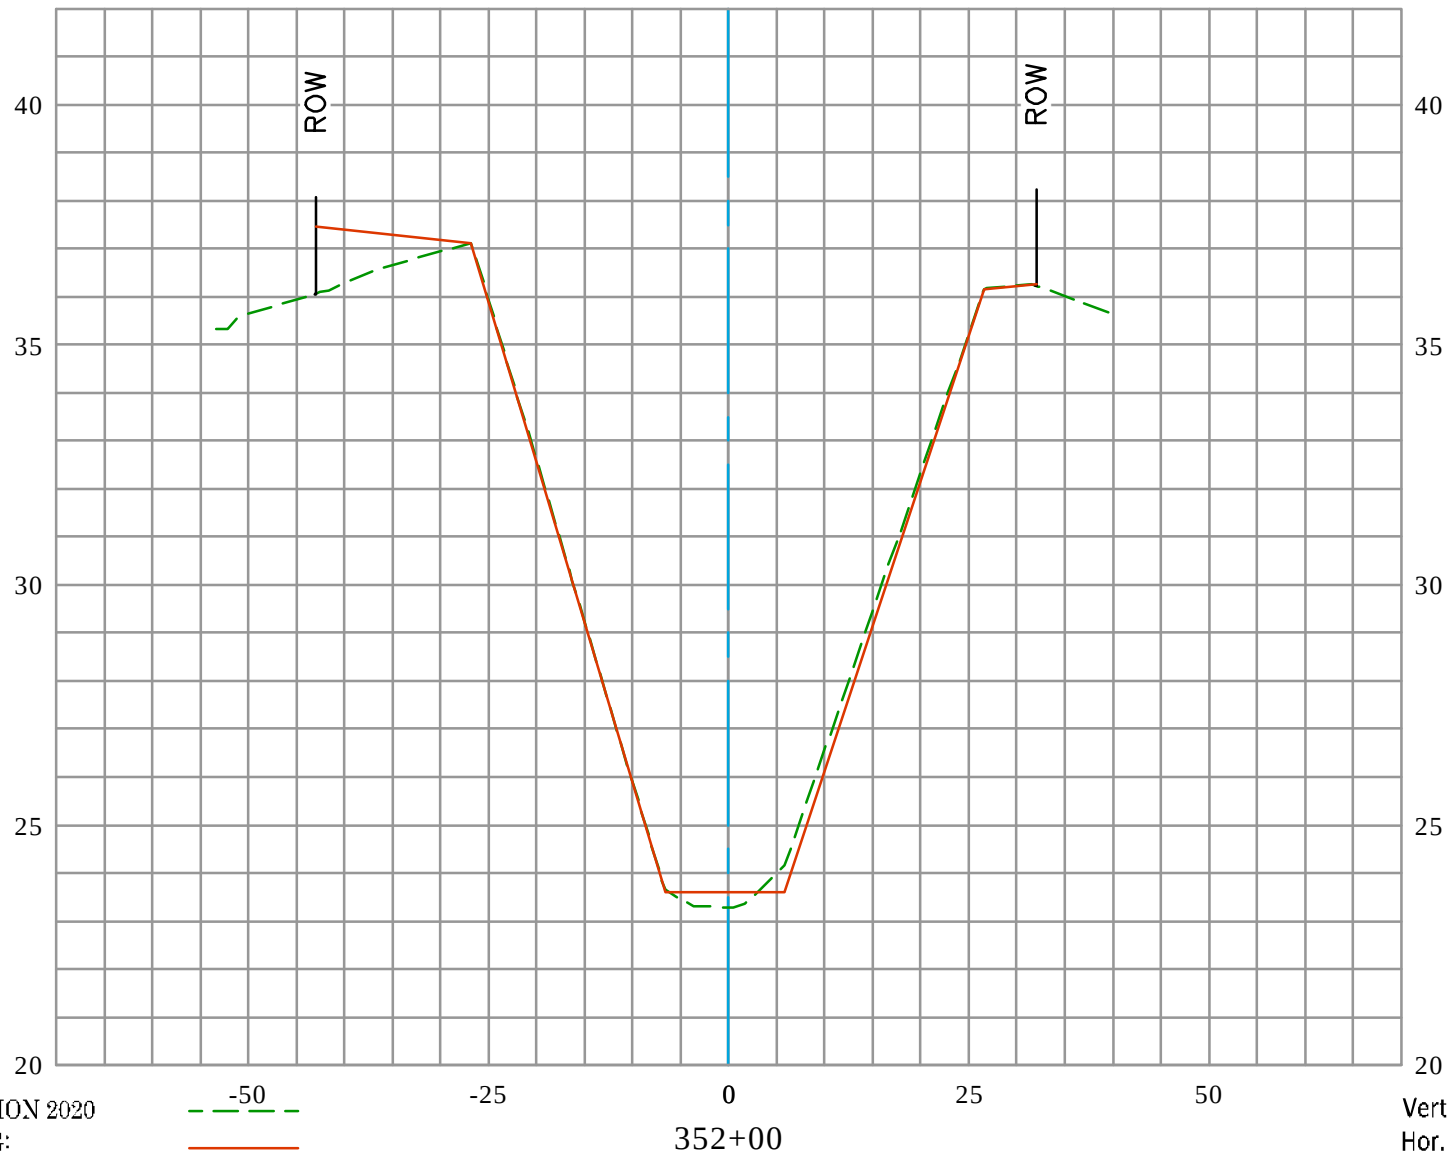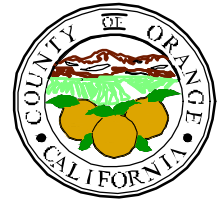



EXISTING CONDITION 2020
RECORD DRAWING:
D03-101-2A, D03-101-3A, & D03-101-7R
DATE PREPARED: 01/24/2022

Vert. Scale: 1" = 4'
Hor. Scale: 1" = 20'

U.S. Survey Foot

OC Public Works
OC Survey/Field Services
Boundary Analysis & Mapping

GREENVILLE BANNING CHANNEL (D03) CL

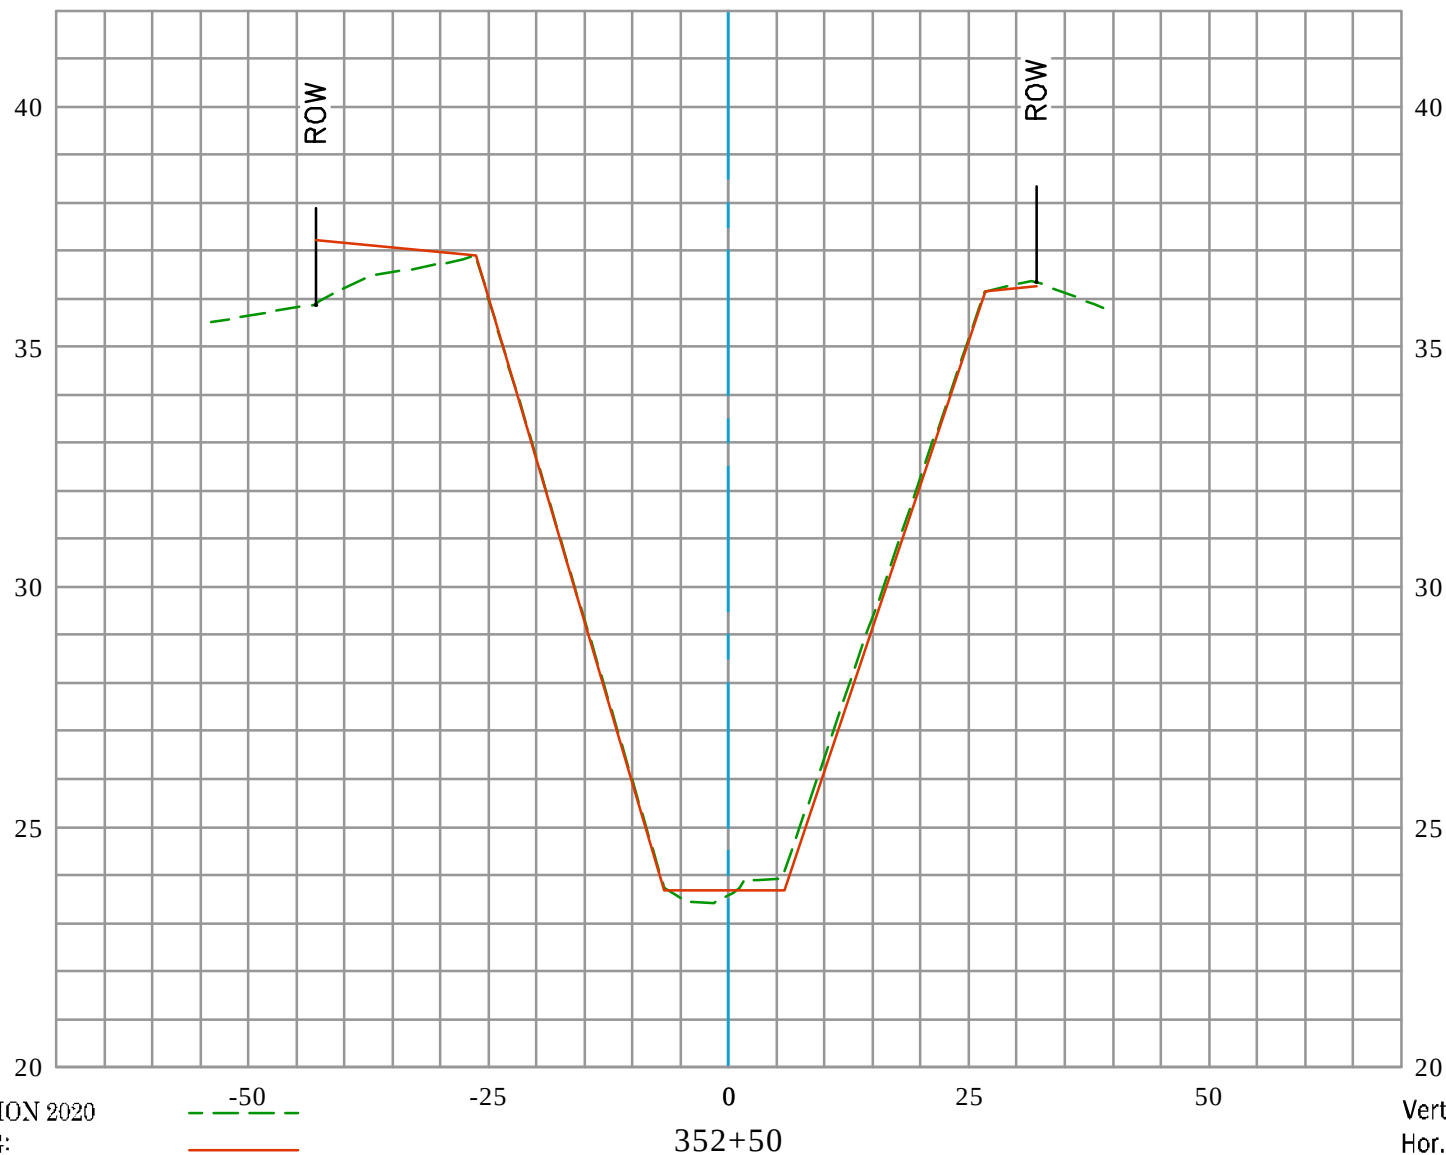
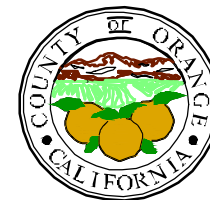


EXISTING CONDITION 2020
RECORD DRAWING:
D03-101-2A, D03-101-3A, & D03-101-7R
DATE PREPARED: 01/24/2022

U.S. Survey Foot

OC Public Works
OC Survey/Field Services
Boundary Analysis & Mapping

GREENVILLE BANNING CHANNEL (D03) CL

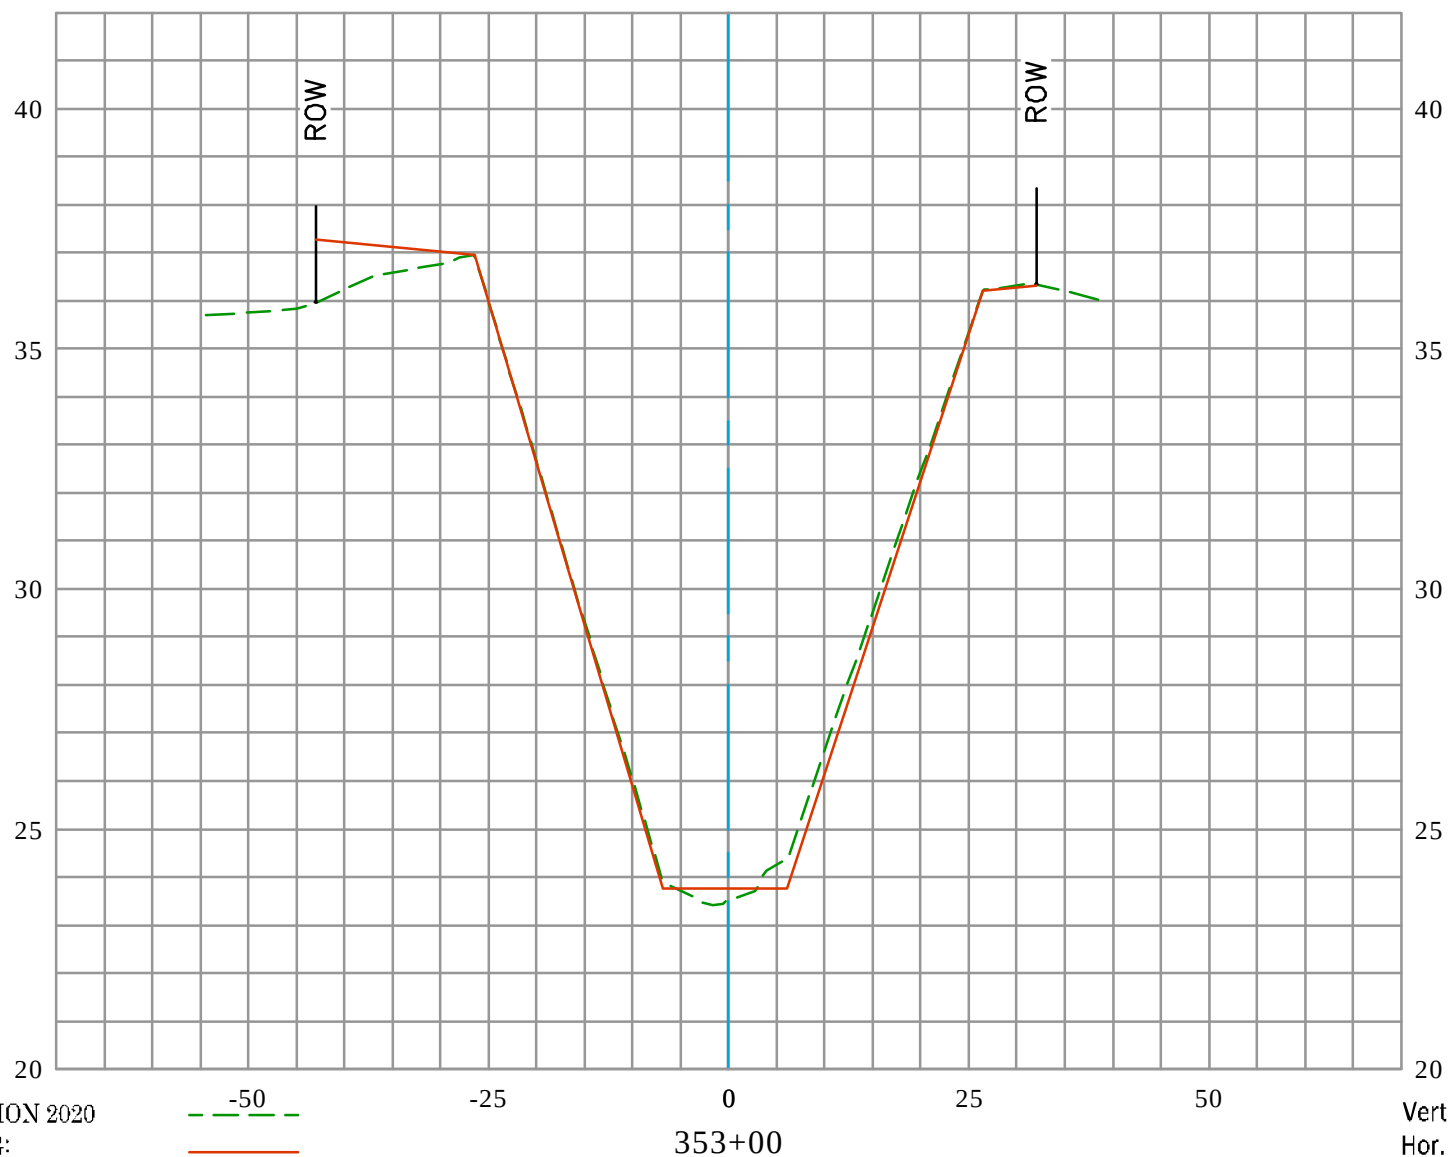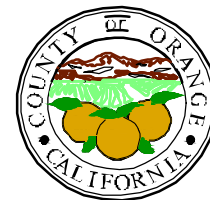


EXISTING CONDITION 2020
RECORD DRAWING:
D03-101-2A, D03-101-3A, & D03-101-7R
DATE PREPARED: 01/24/2022

U.S. Survey
Foot

OC Public Works
OC Survey/Field Services
Boundary Analysis & Mapping

GREENVILLE BANNING CHANNEL (D03) CL

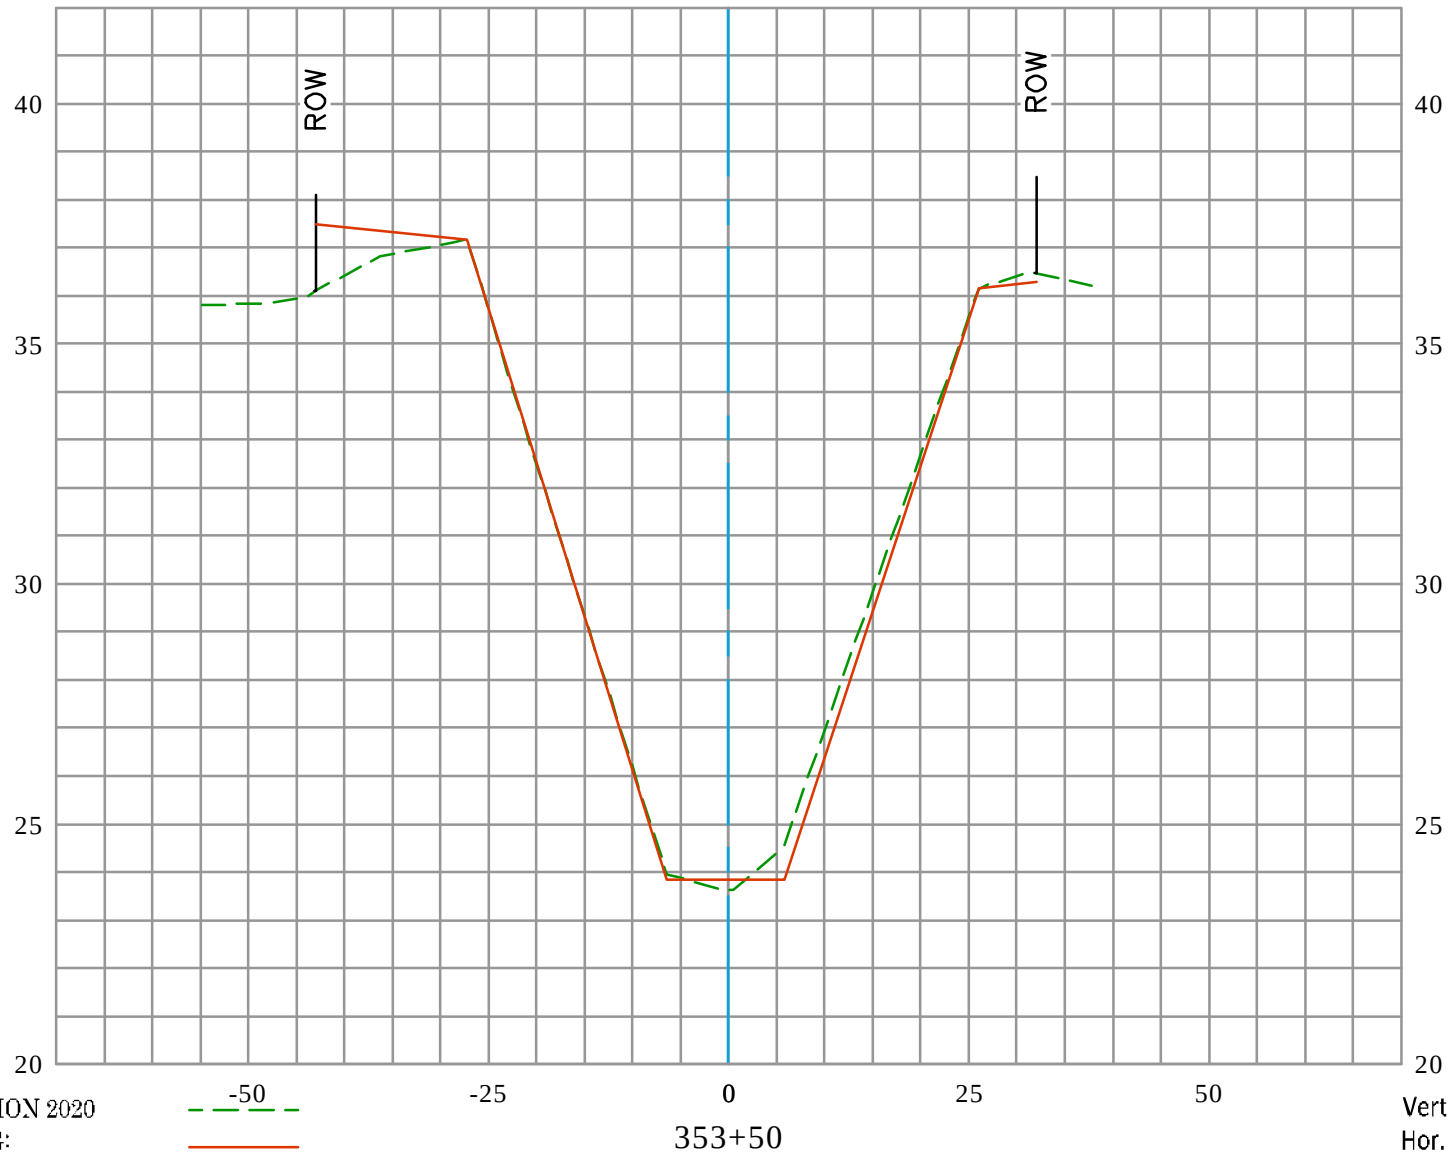



EXISTING CONDITION 2020
RECORD DRAWING:
D03-101-2A, D03-101-3A, & D03-101-7R
DATE PREPARED: 01/24/2022

Vert. Scale: 1" = 4'
Hor. Scale: 1" = 20'



U.S. *Survey*
Foot

OC Public Works
OC Survey/Field Services
Boundary Analysis & Mapping

GREENVILLE BANNING CHANNEL (D03) CL

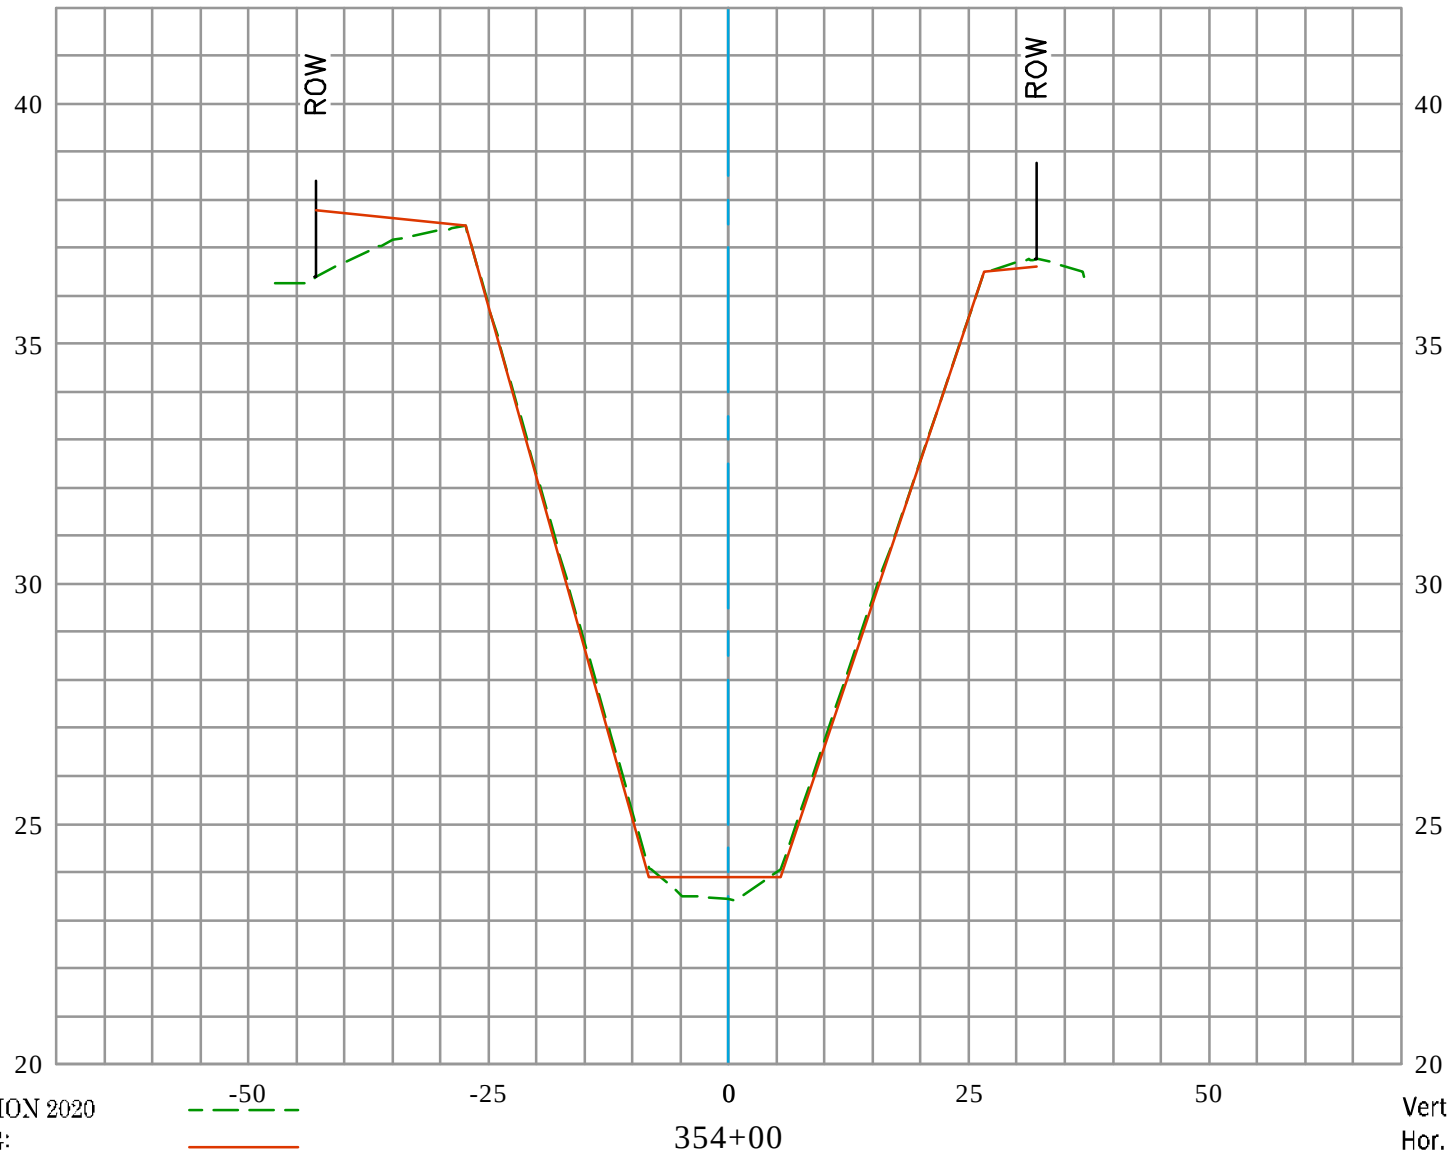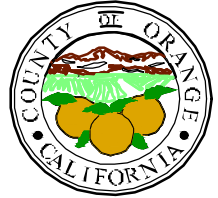

GREENVILLE BANNING CHANNEL (D03) CL

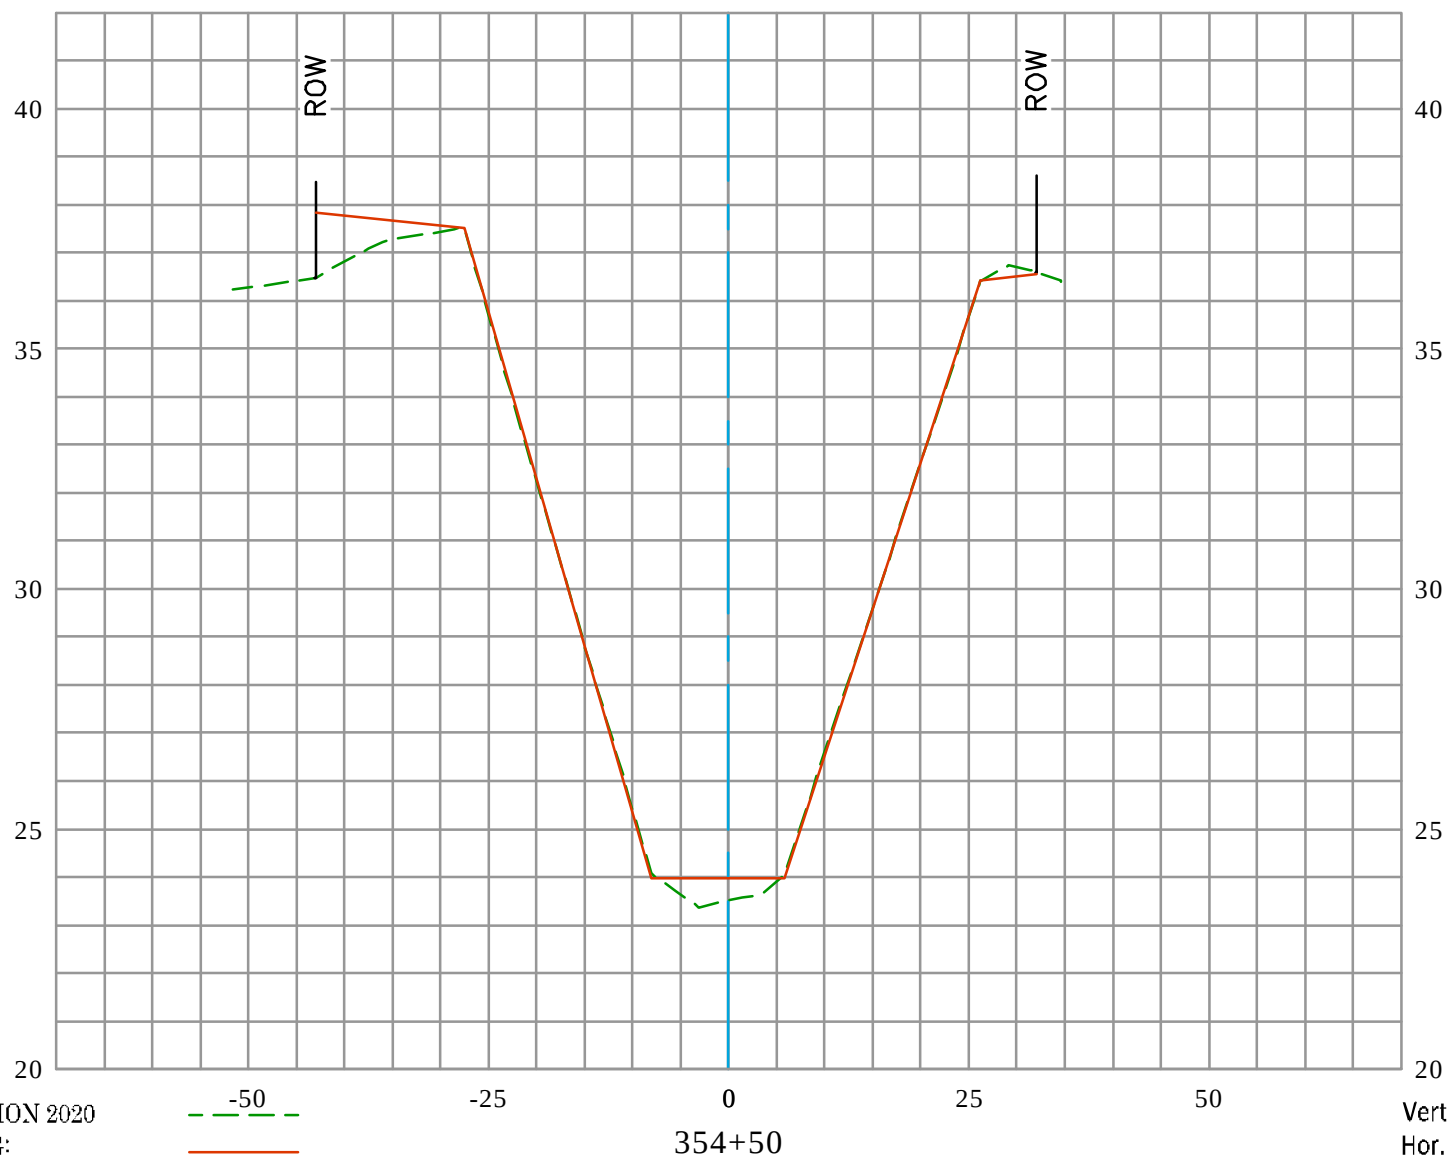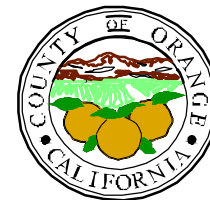


EXISTING CONDITION 2020
 RECORD DRAWING:
 D03-101-2A, D03-101-3A, & D03-101-7R
 DATE PREPARED: 01/24/2022

U.S. Survey
Foot

OC Public Works
OC Survey/Field Services
Boundary Analysis & Mapping

GREENVILLE BANNING CHANNEL (D03) CL

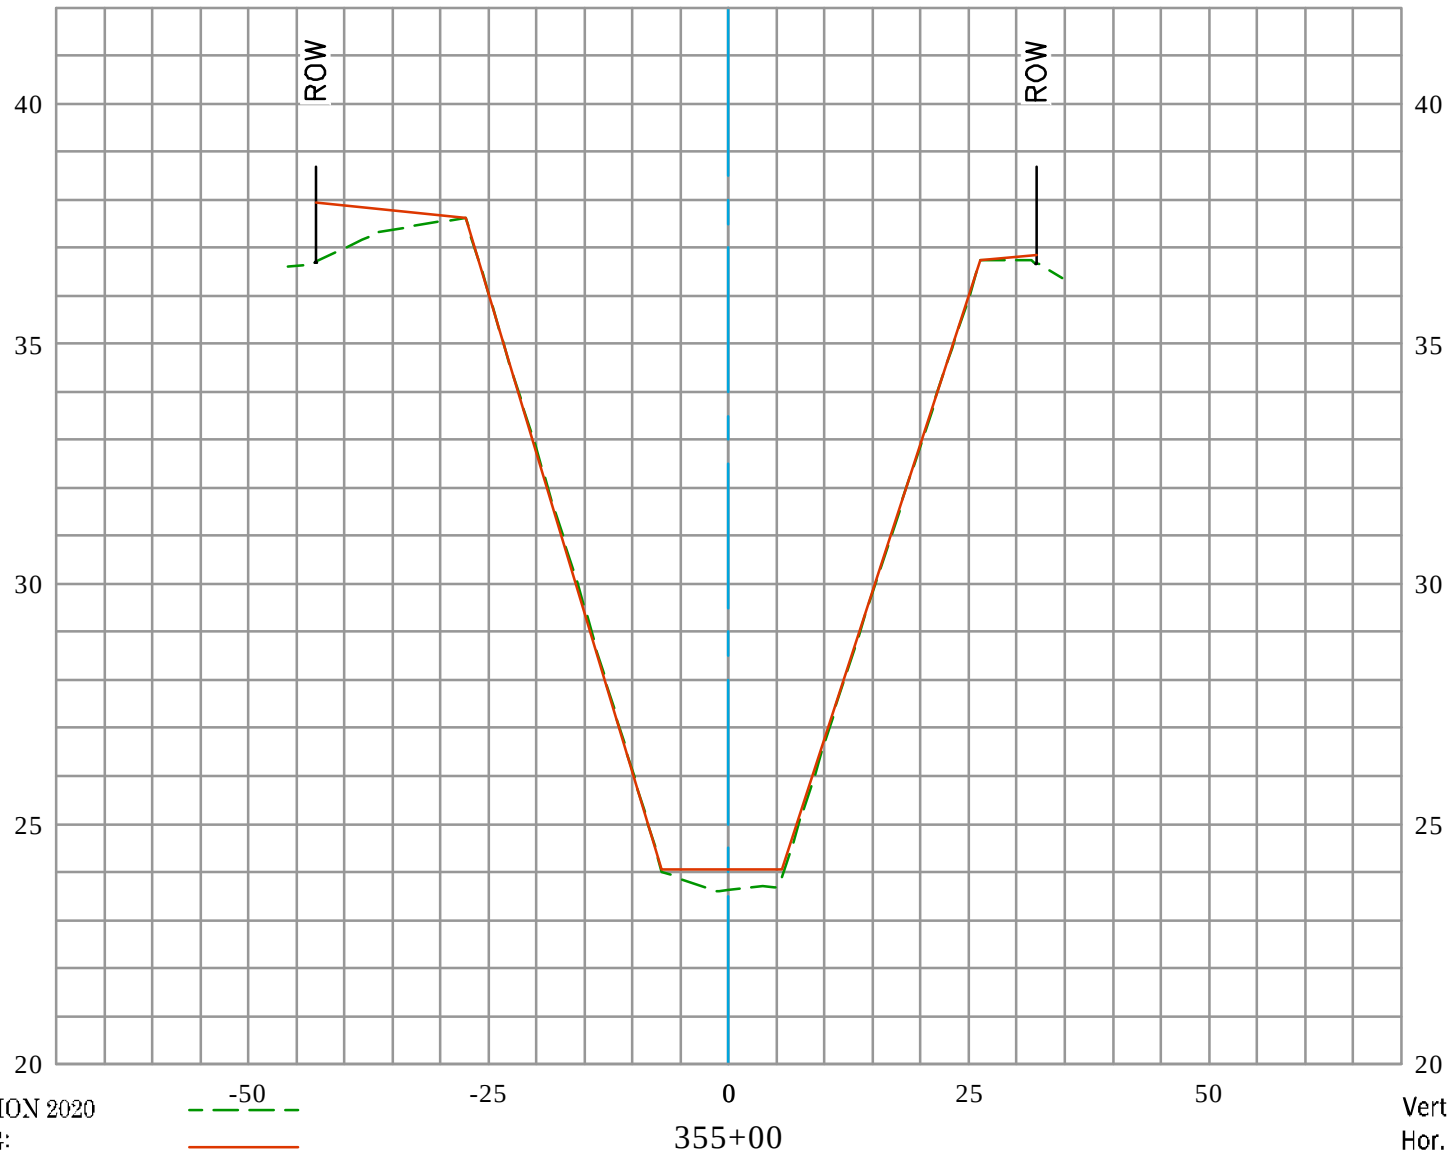


EXISTING CONDITION 2020
RECORD DRAWING:
D03-101-2A, D03-101-3A, & D03-101-7R
DATE PREPARED: 01/24/2022

Vert. Scale: 1" = 4'
Hor. Scale: 1" = 20'



GREENVILLE BANNING CHANNEL (D03) CL

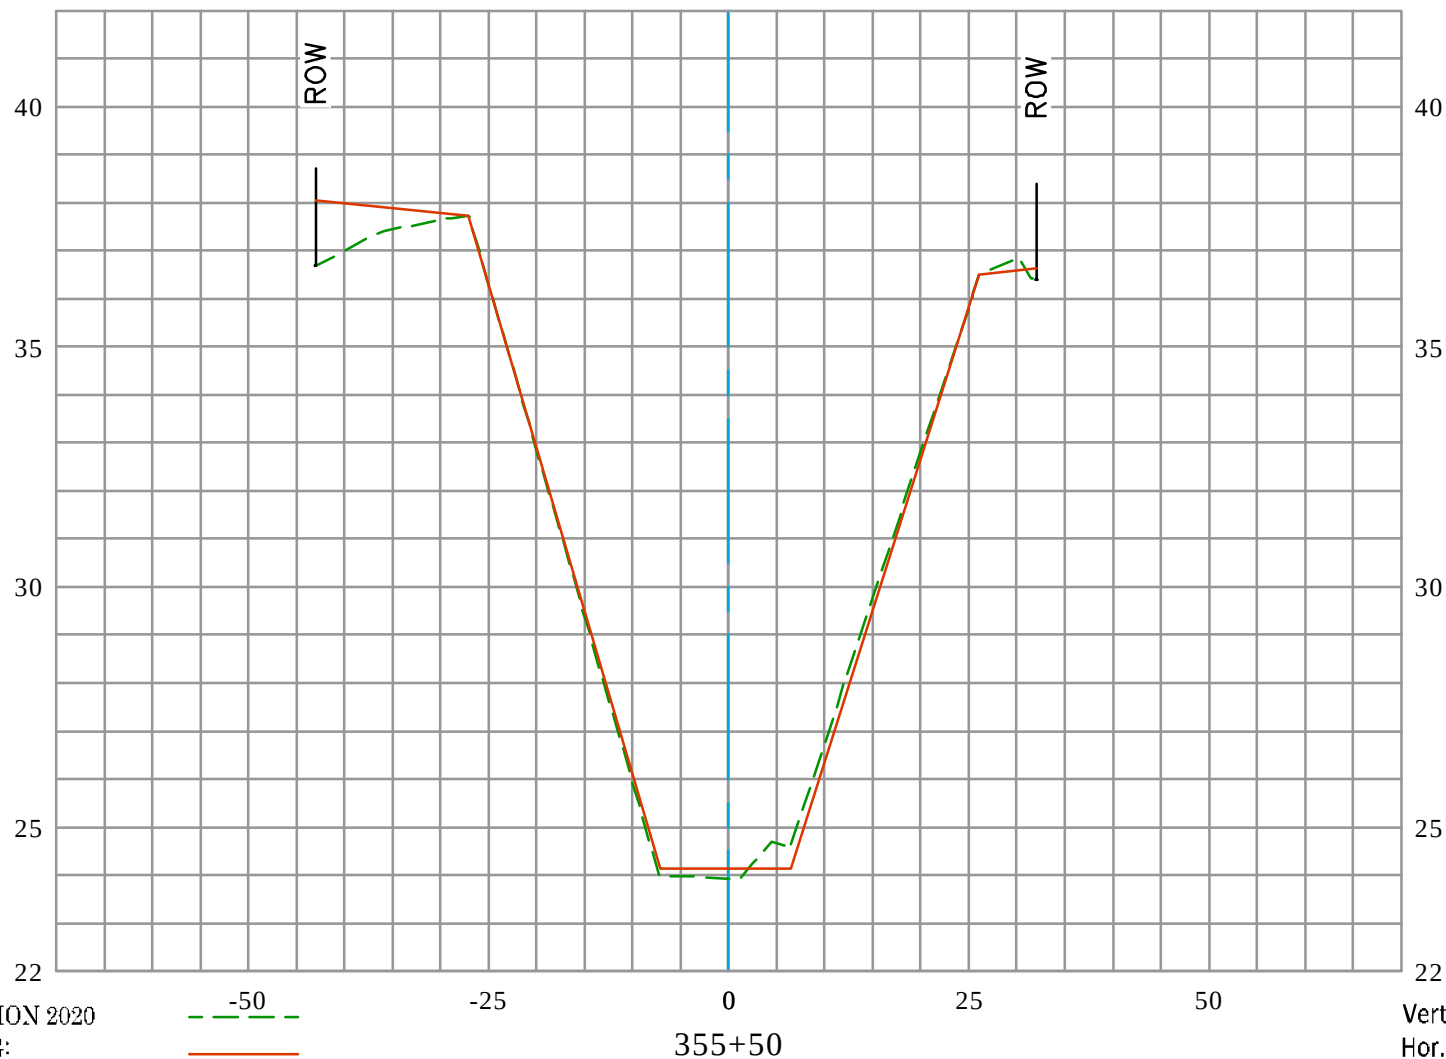


EXISTING CONDITION 2020
 RECORD DRAWING:
 D03-101-2A, D03-101-3A, & D03-101-7R
 DATE PREPARED: 01/24/2022

Vert. Scale: 1" = 4'
 Hor. Scale: 1" = 20'



GREENVILLE BANNING CHANNEL (D03) CL

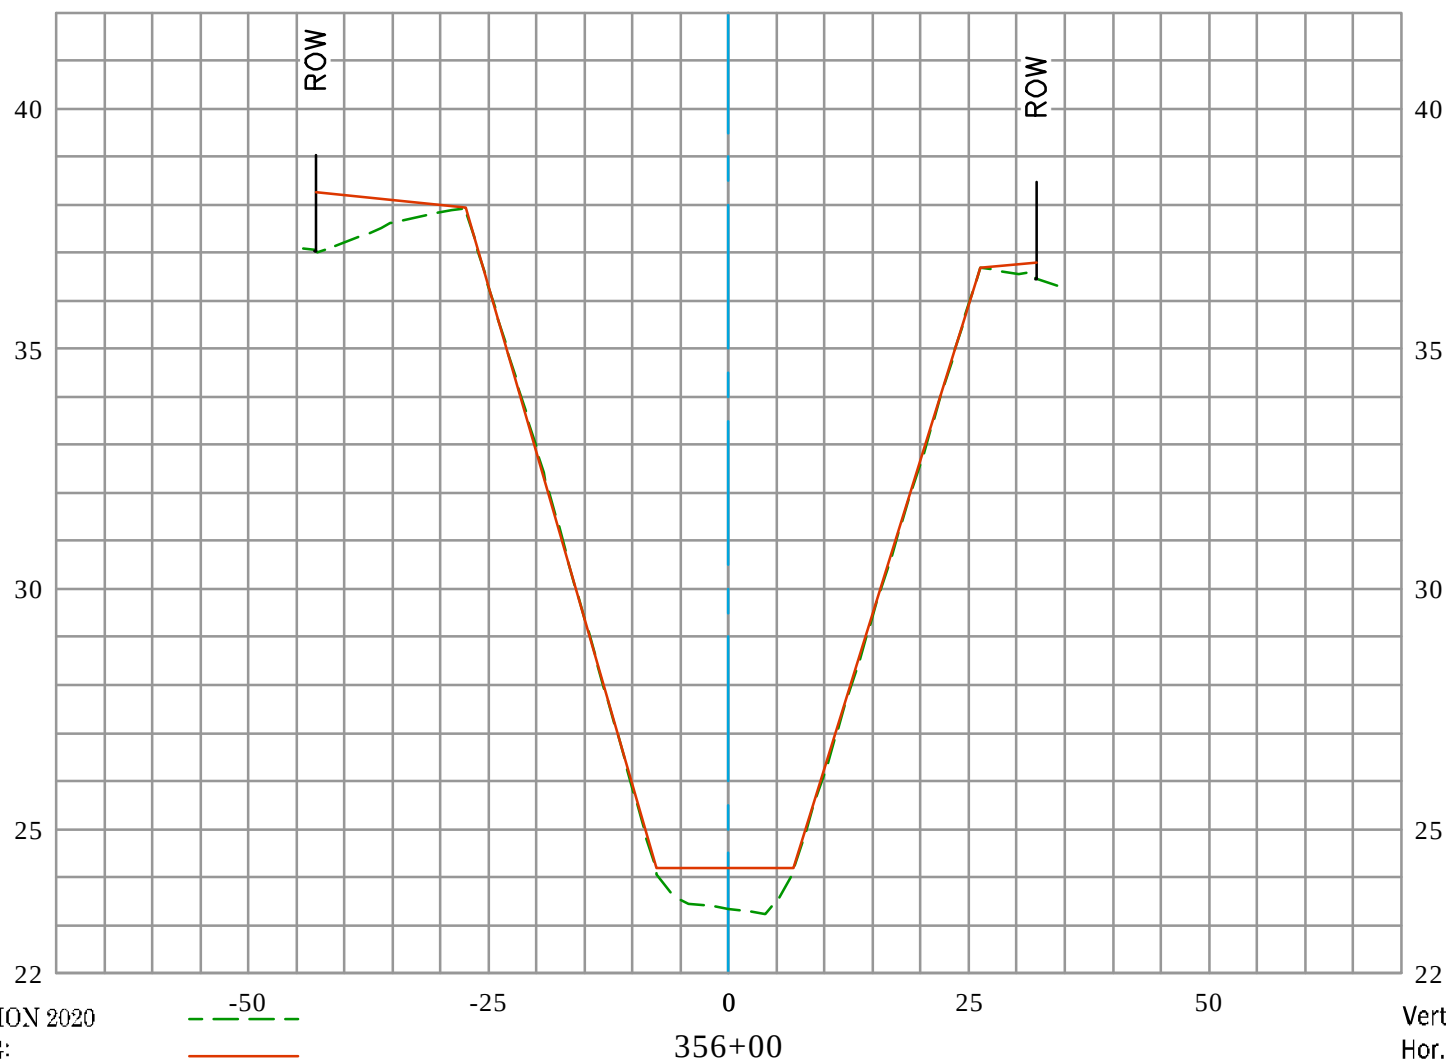


EXISTING CONDITION 2020
 RECORD DRAWING:
 D03-101-2A, D03-101-3A, & D03-101-7R
 DATE PREPARED: 01/24/2022

Vert. Scale: 1" = 4'
 Hor. Scale: 1" = 20'



GREENVILLE BANNING CHANNEL (D03) CL

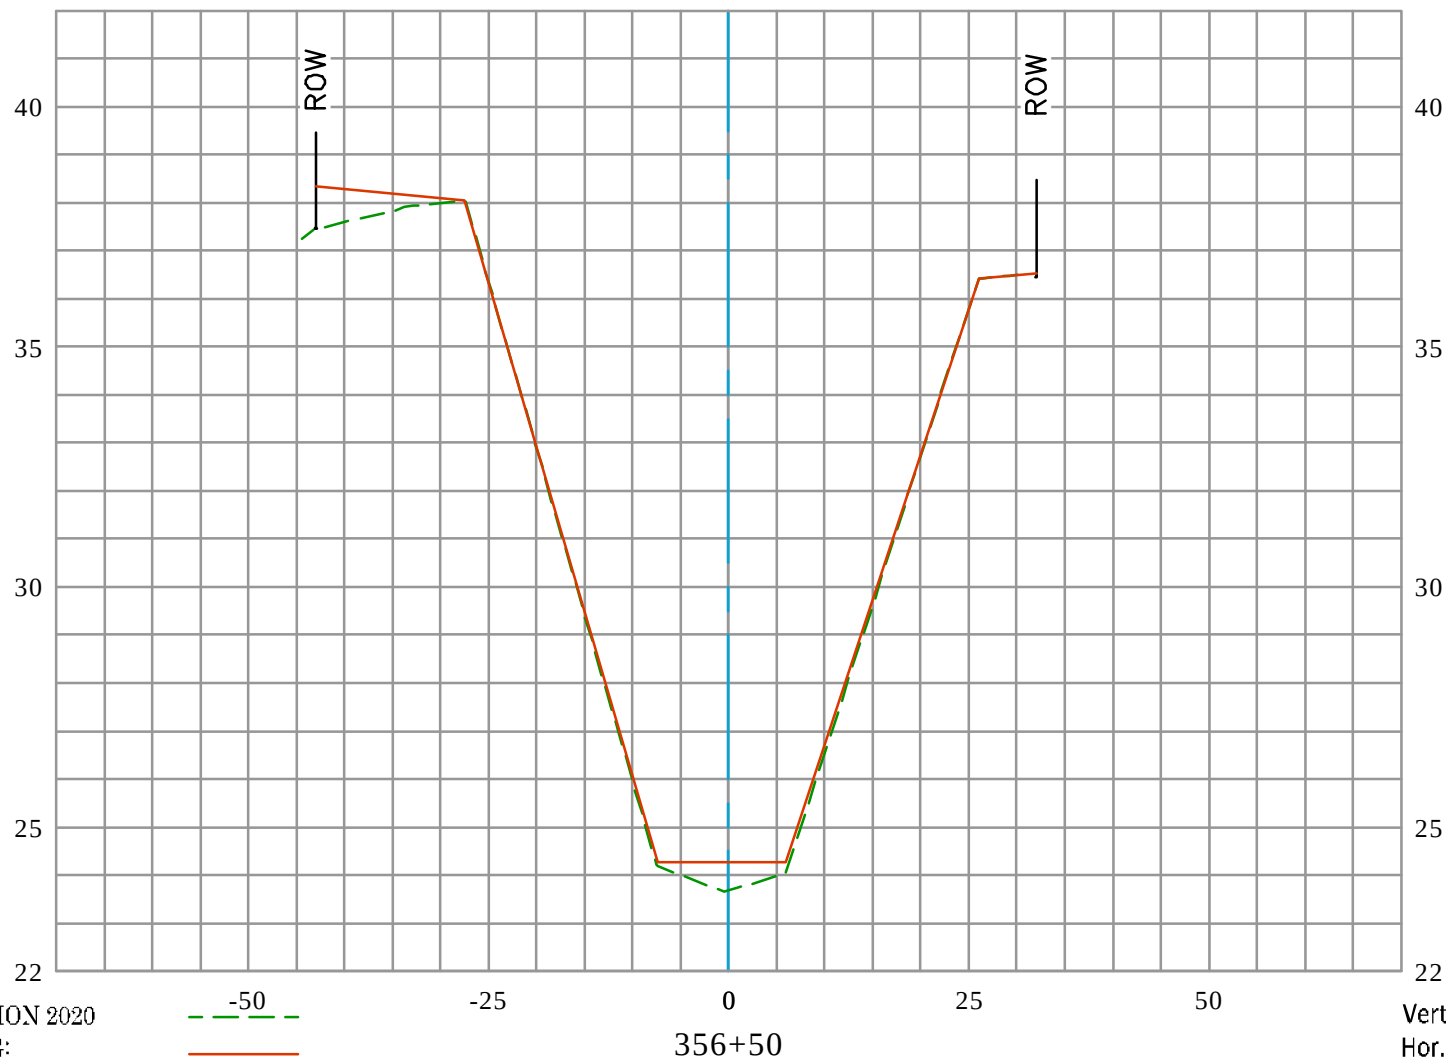


EXISTING CONDITION 2020
 RECORD DRAWING:
 D03-101-2A, D03-101-3A, & D03-101-7R
 DATE PREPARED: 01/24/2022

Vert. Scale: 1" = 4'
 Hor. Scale: 1" = 20'

U.S. Survey
Foot

OC Public Works
OC Survey/Field Services
Boundary Analysis & Mapping

GREENVILLE BANNING CHANNEL (D03) CL

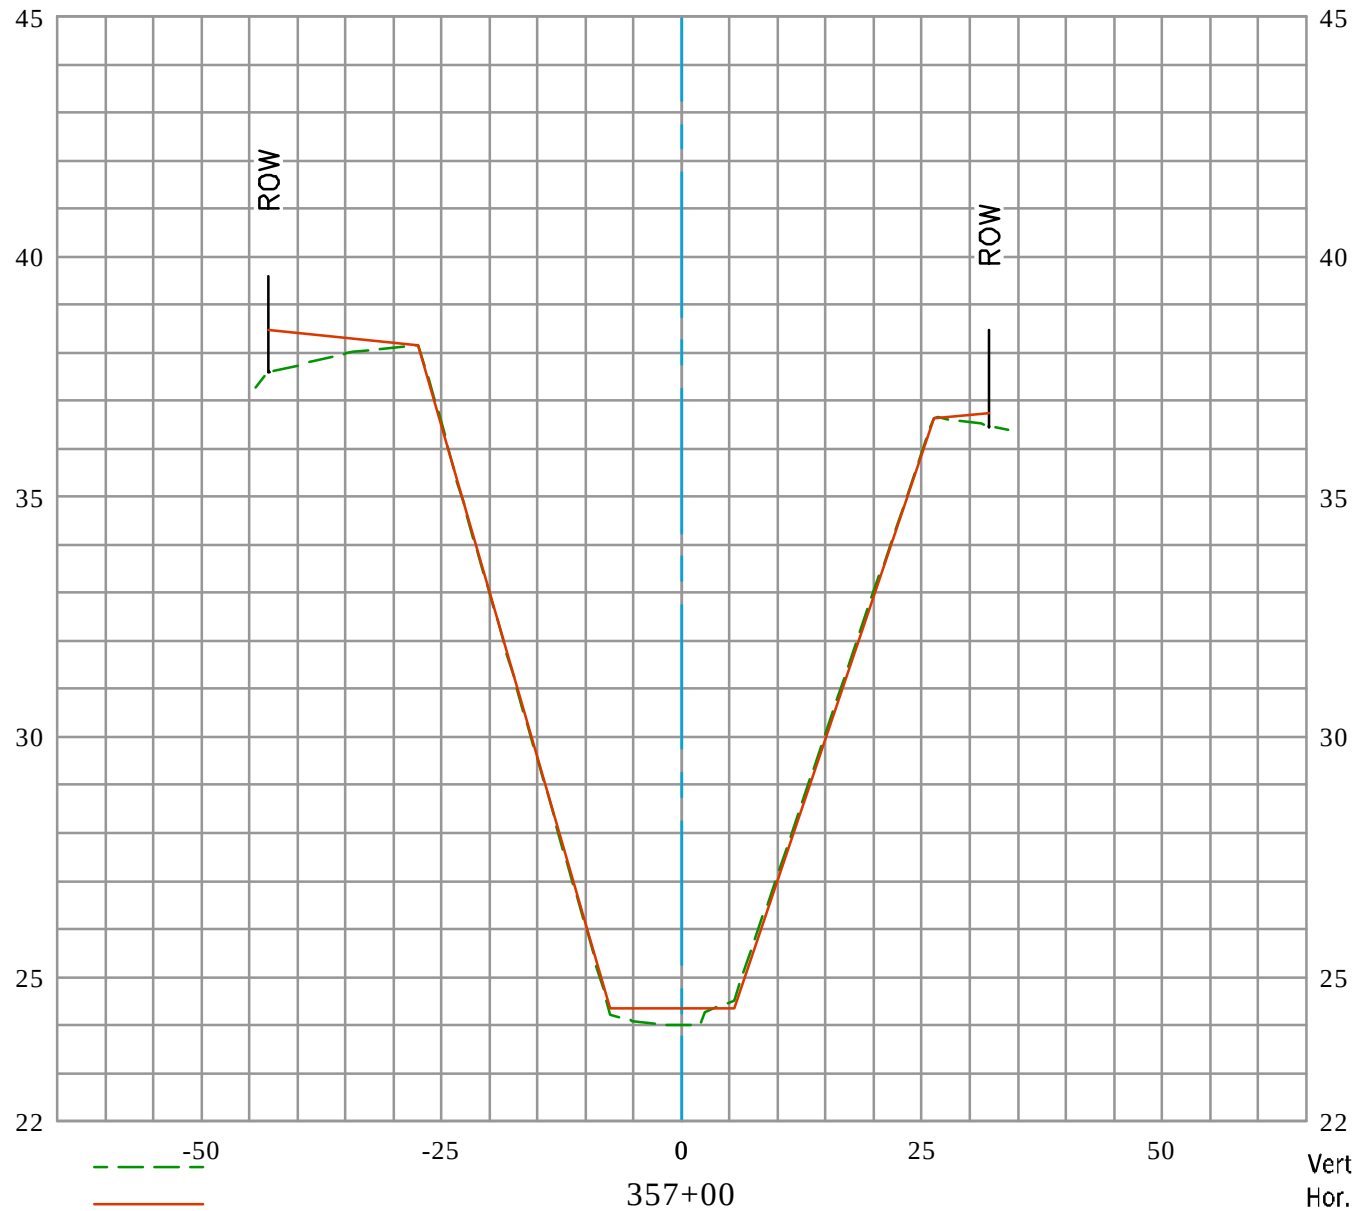


EXISTING CONDITION 2020
RECORD DRAWING:
D03-101-2A, D03-101-3A, & D03-101-7R
DATE PREPARED: 01/24/2022

Vert. Scale: 1" = 4'
Hor. Scale: 1" = 20'

U.S. Survey Foot

OC Public Works
OC Survey/Field Services
Boundary Analysis & Mapping

GREENVILLE BANNING CHANNEL (D03) CL

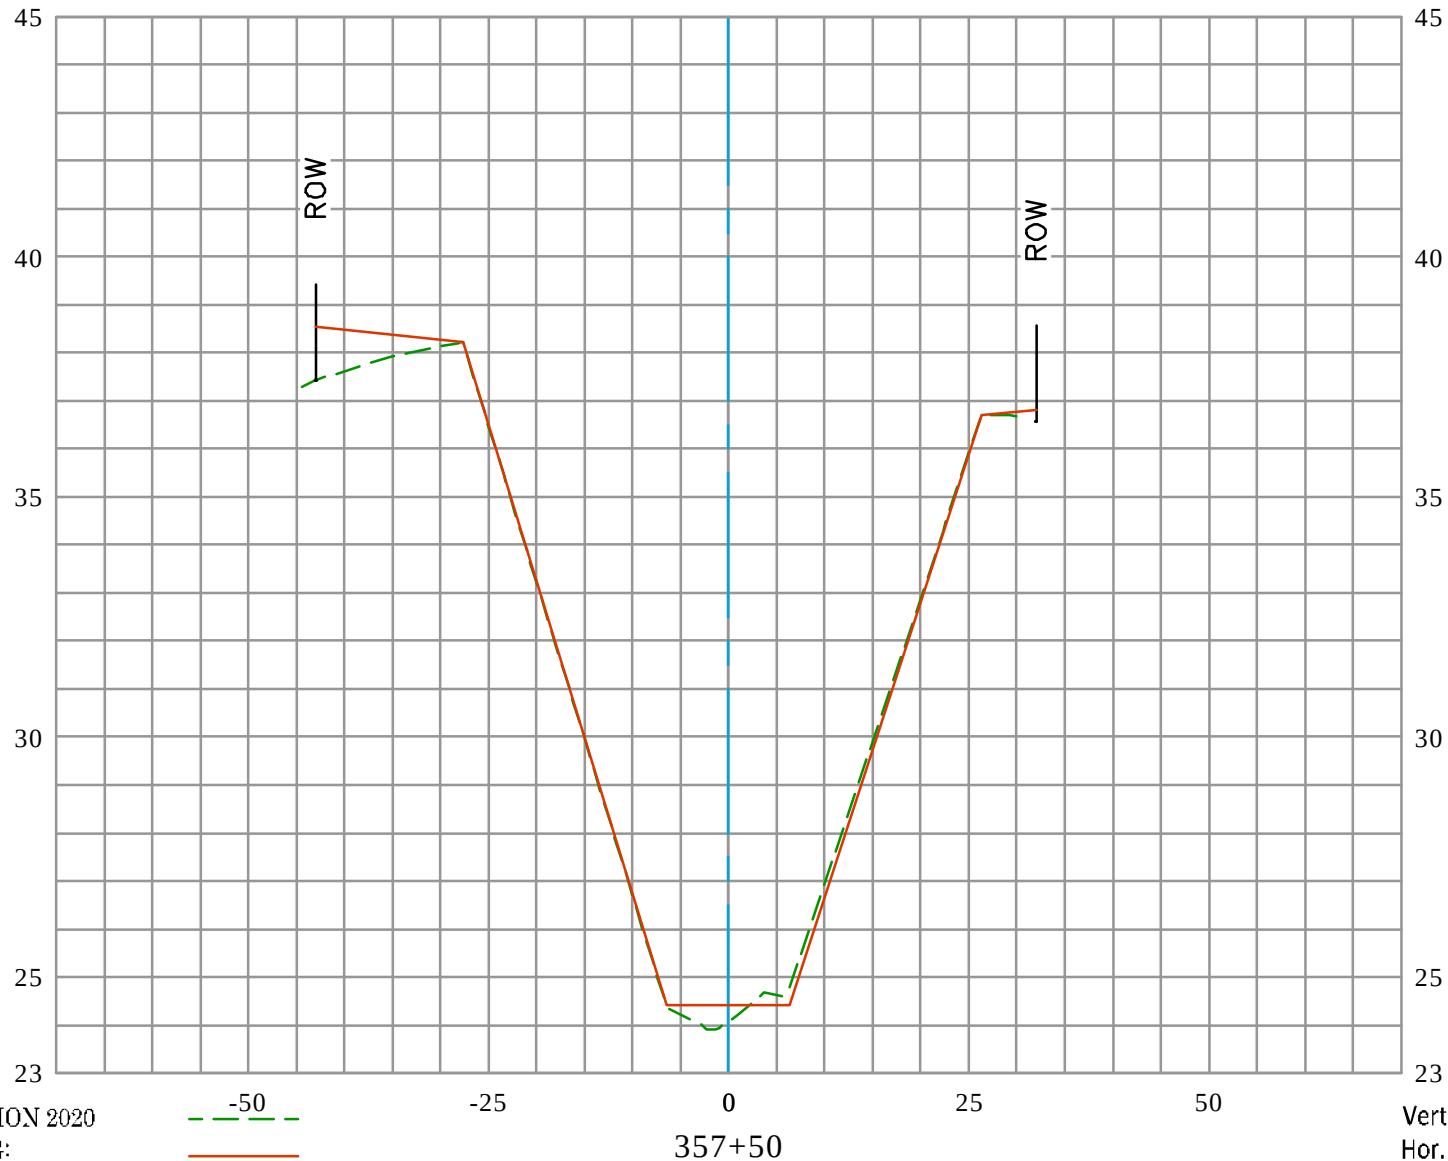



EXISTING CONDITION 2020
RECORD DRAWING:
D03-101-2A, D03-101-3A, & D03-101-7R
DATE PREPARED: 01/24/2022

Vert. Scale: 1" = 4'
Hor. Scale: 1" = 20'

U.S. *Survey*
Foot

OC Public Works
OC Survey/Field Services
Boundary Analysis & Mapping

GREENVILLE BANNING CHANNEL (D03) CL

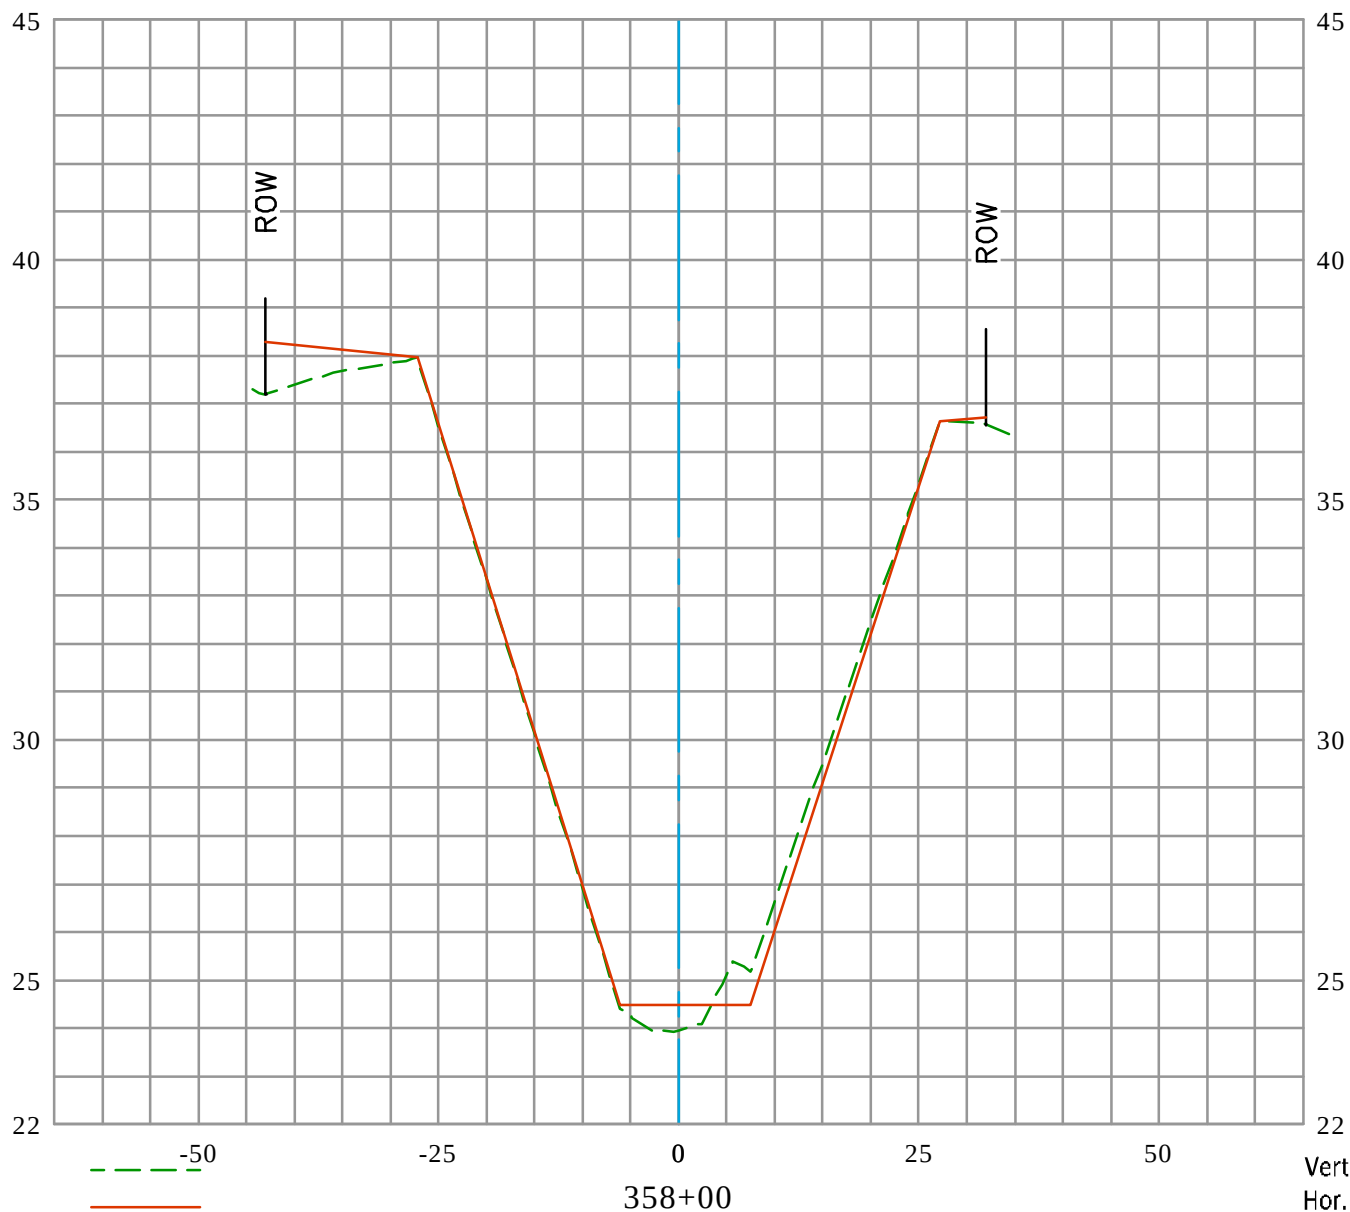
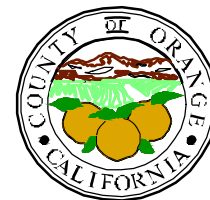


EXISTING CONDITION 2020
RECORD DRAWING:
D03-101-2A, D03-101-3A, & D03-101-7R
DATE PREPARED: 01/24/2022



U.S. *Survey Foot*

OC Public Works
OC Survey/Field Services
Boundary Analysis & Mapping

GREENVILLE BANNING CHANNEL (D03) CL

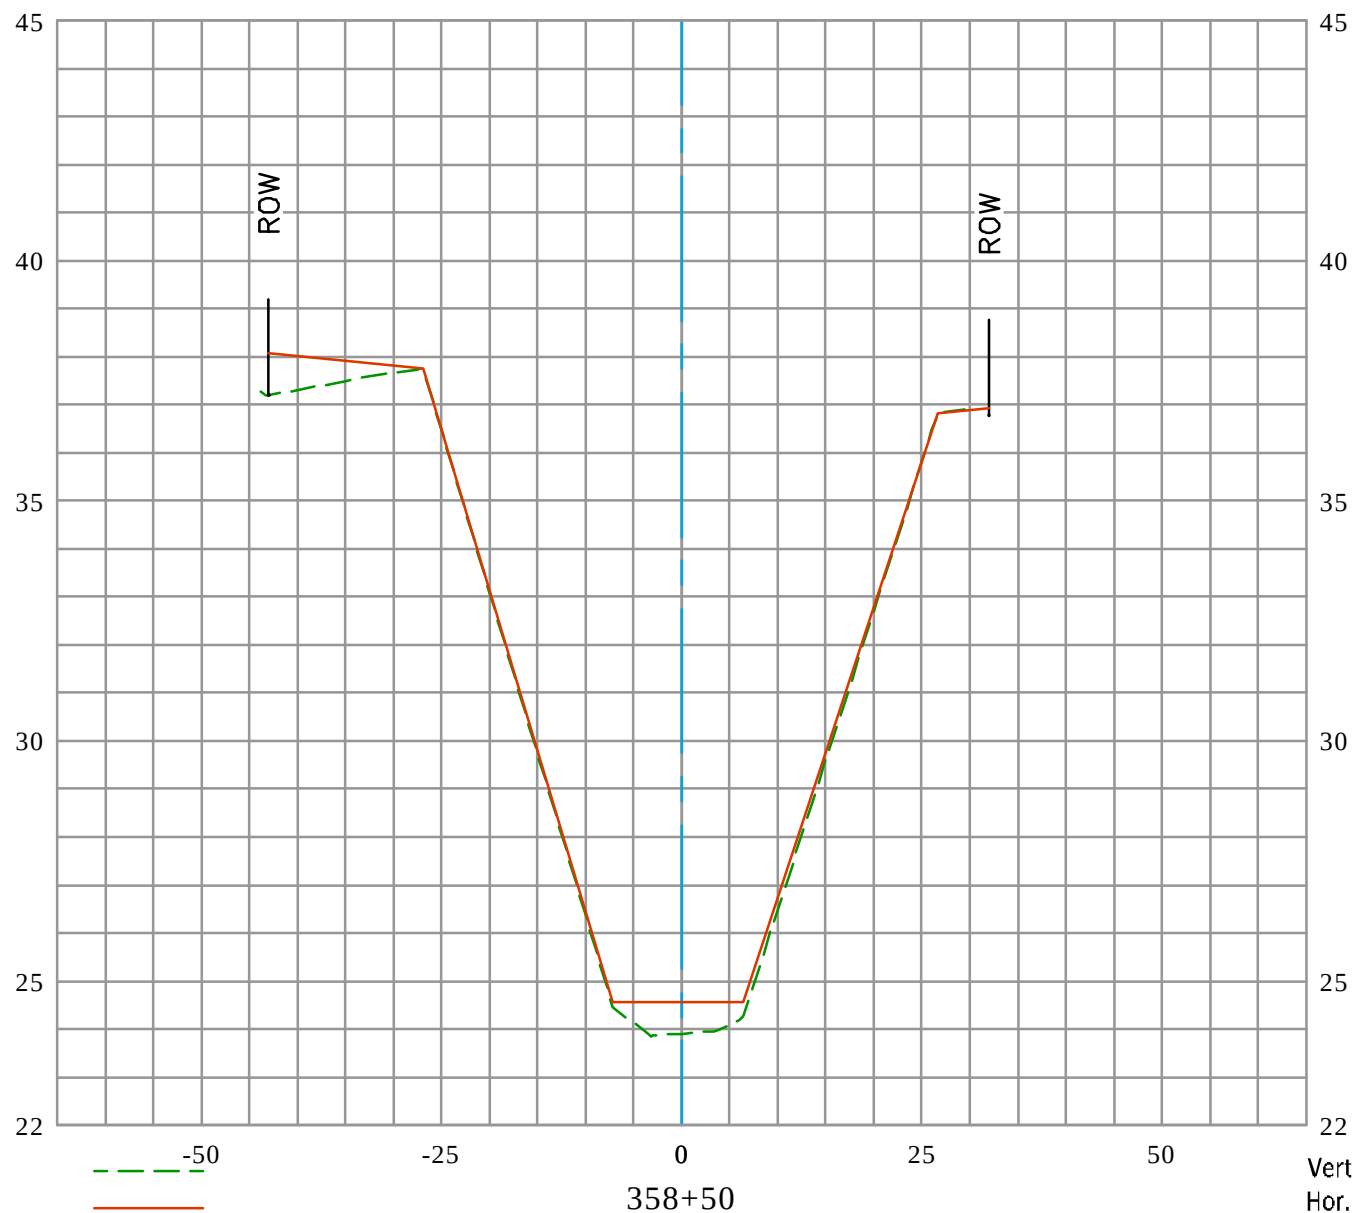
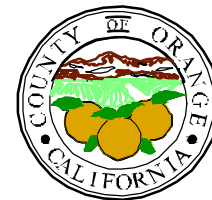


EXISTING CONDITION 2020
RECORD DRAWING:
D03-101-2A, D03-101-3A, & D03-101-7R
DATE PREPARED: 01/24/2022

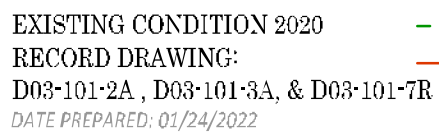
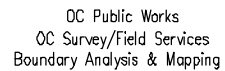


Vert. Scale: 1" = 4'
Hor. Scale: 1" = 20'

GREENVILLE BANNING CHANNEL (D03) CL

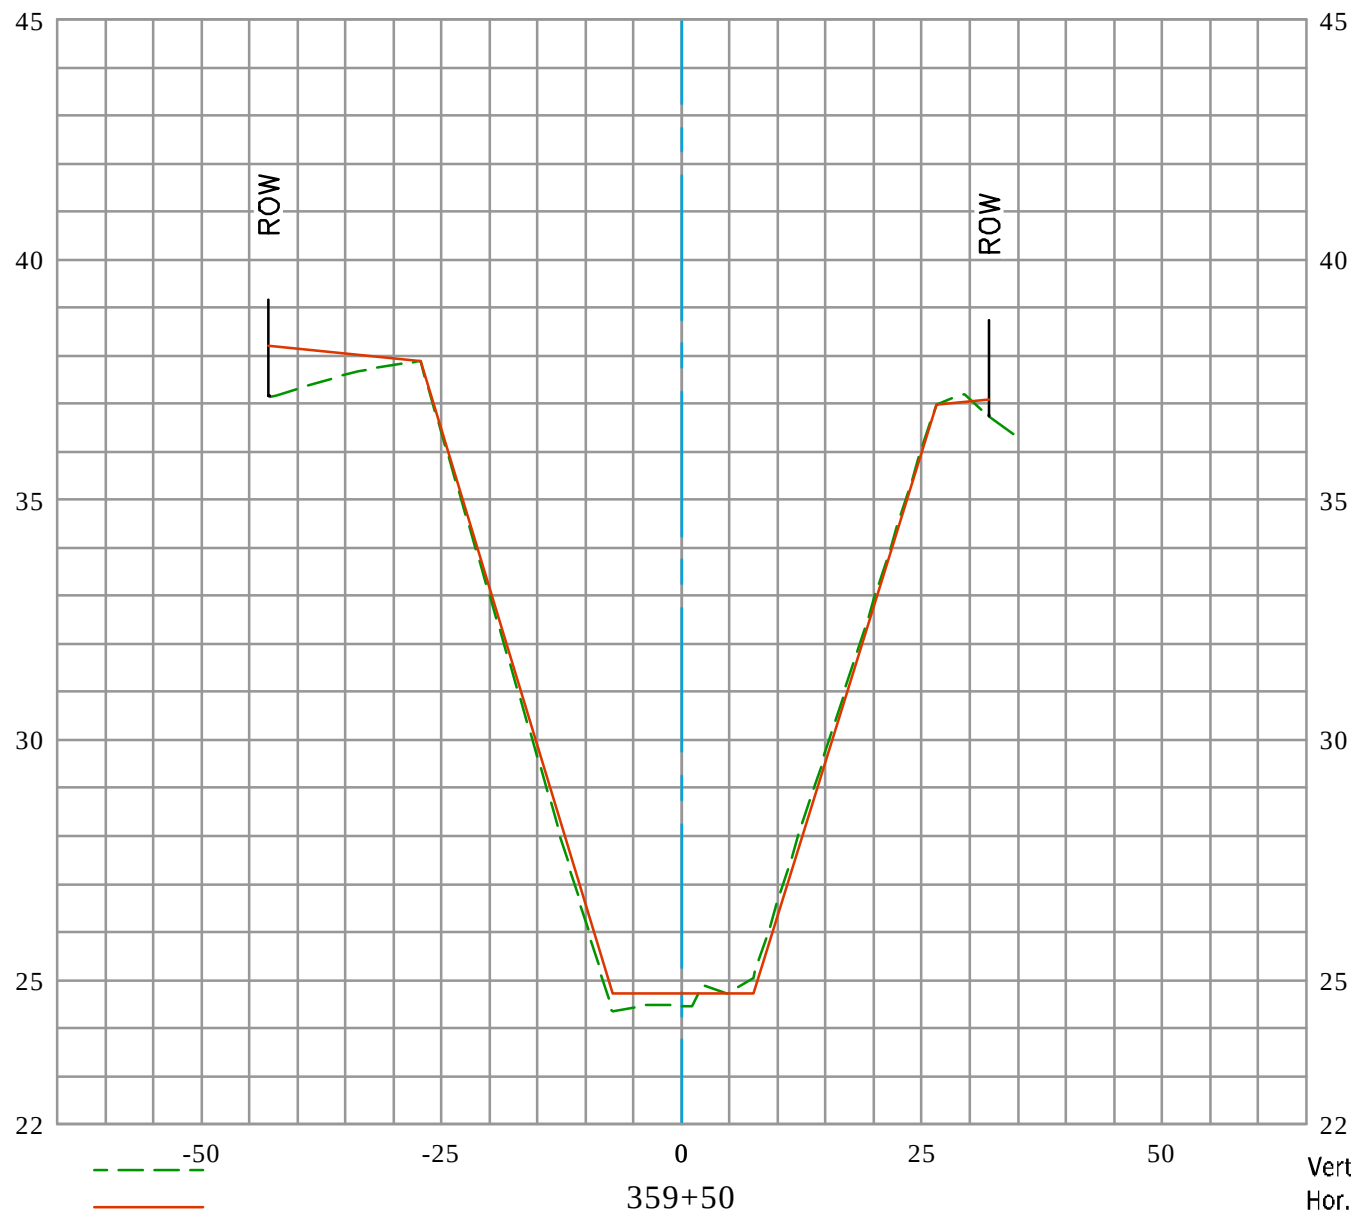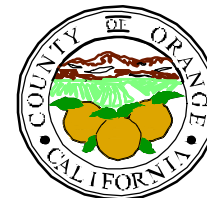

EXISTING CONDITION 2020
 RECORD DRAWING:
 D03-101-2A, D03-101-3A, & D03-101-7R
 DATE PREPARED: 01/24/2022

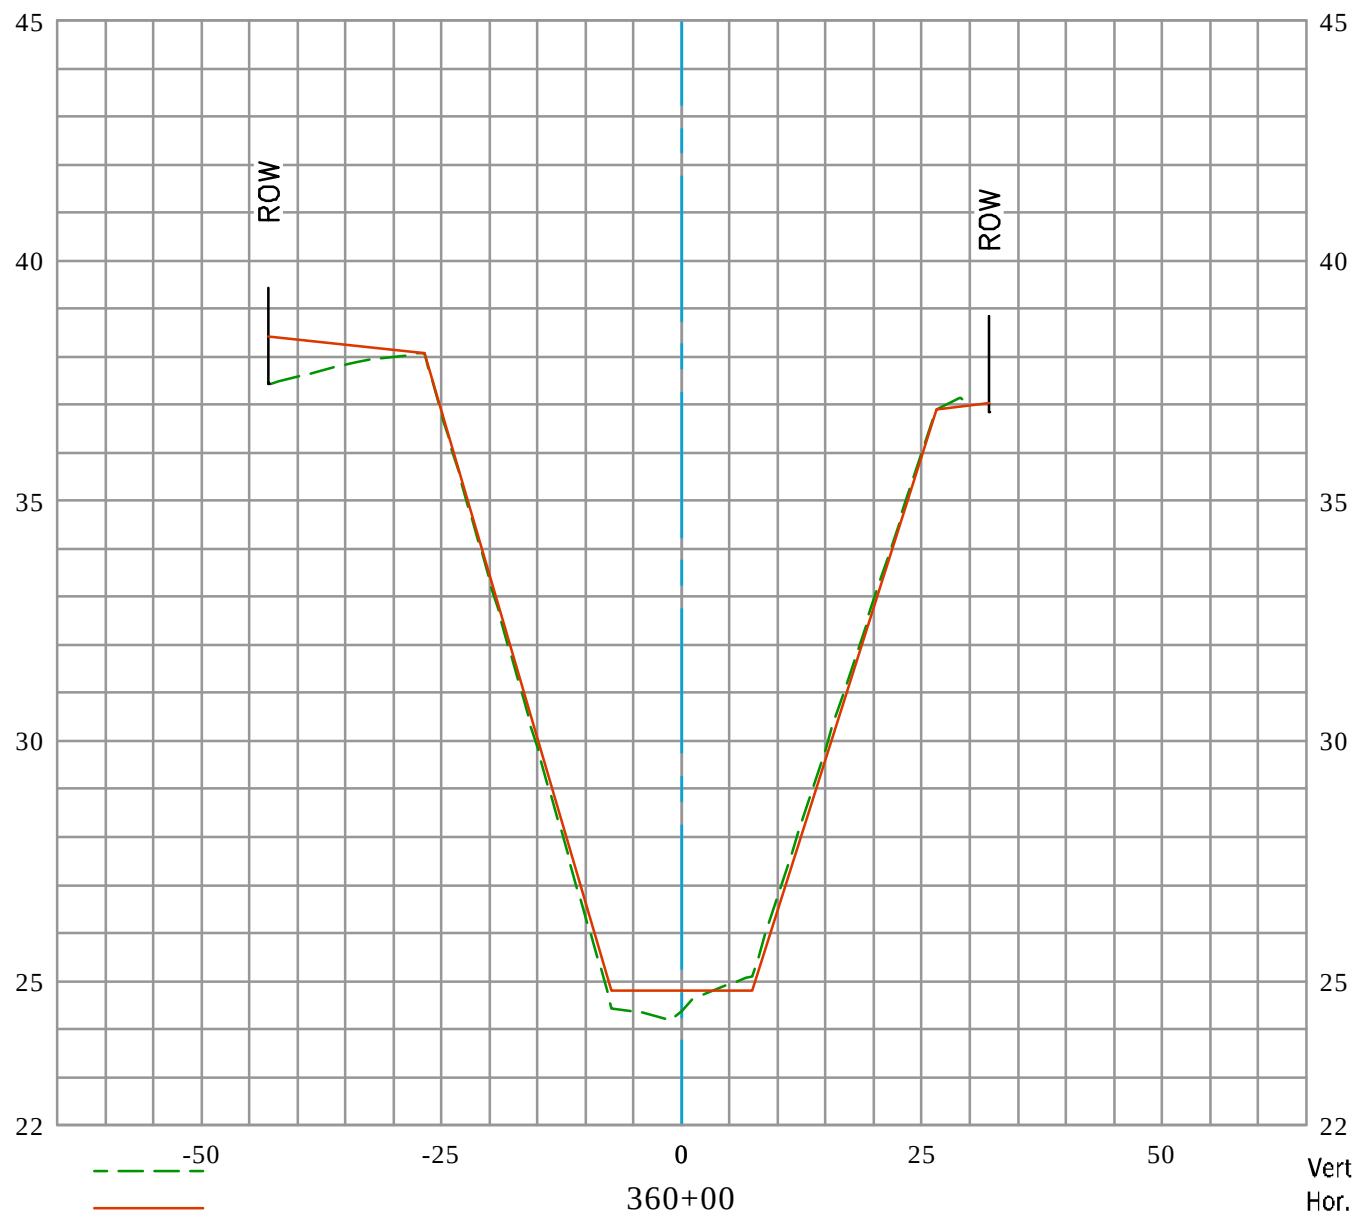
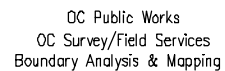


EXISTING CONDITION 2020 —
RECORD DRAWING: —
D03-101-2A, D03-101-3A, & D03-101-7R
DATE PREPARED: 01/24/2022

U.S. *Survey*
Foot

OC Public Works
OC Survey/Field Services
Boundary Analysis & Mapping

GREENVILLE BANNING CHANNEL (D03) CL

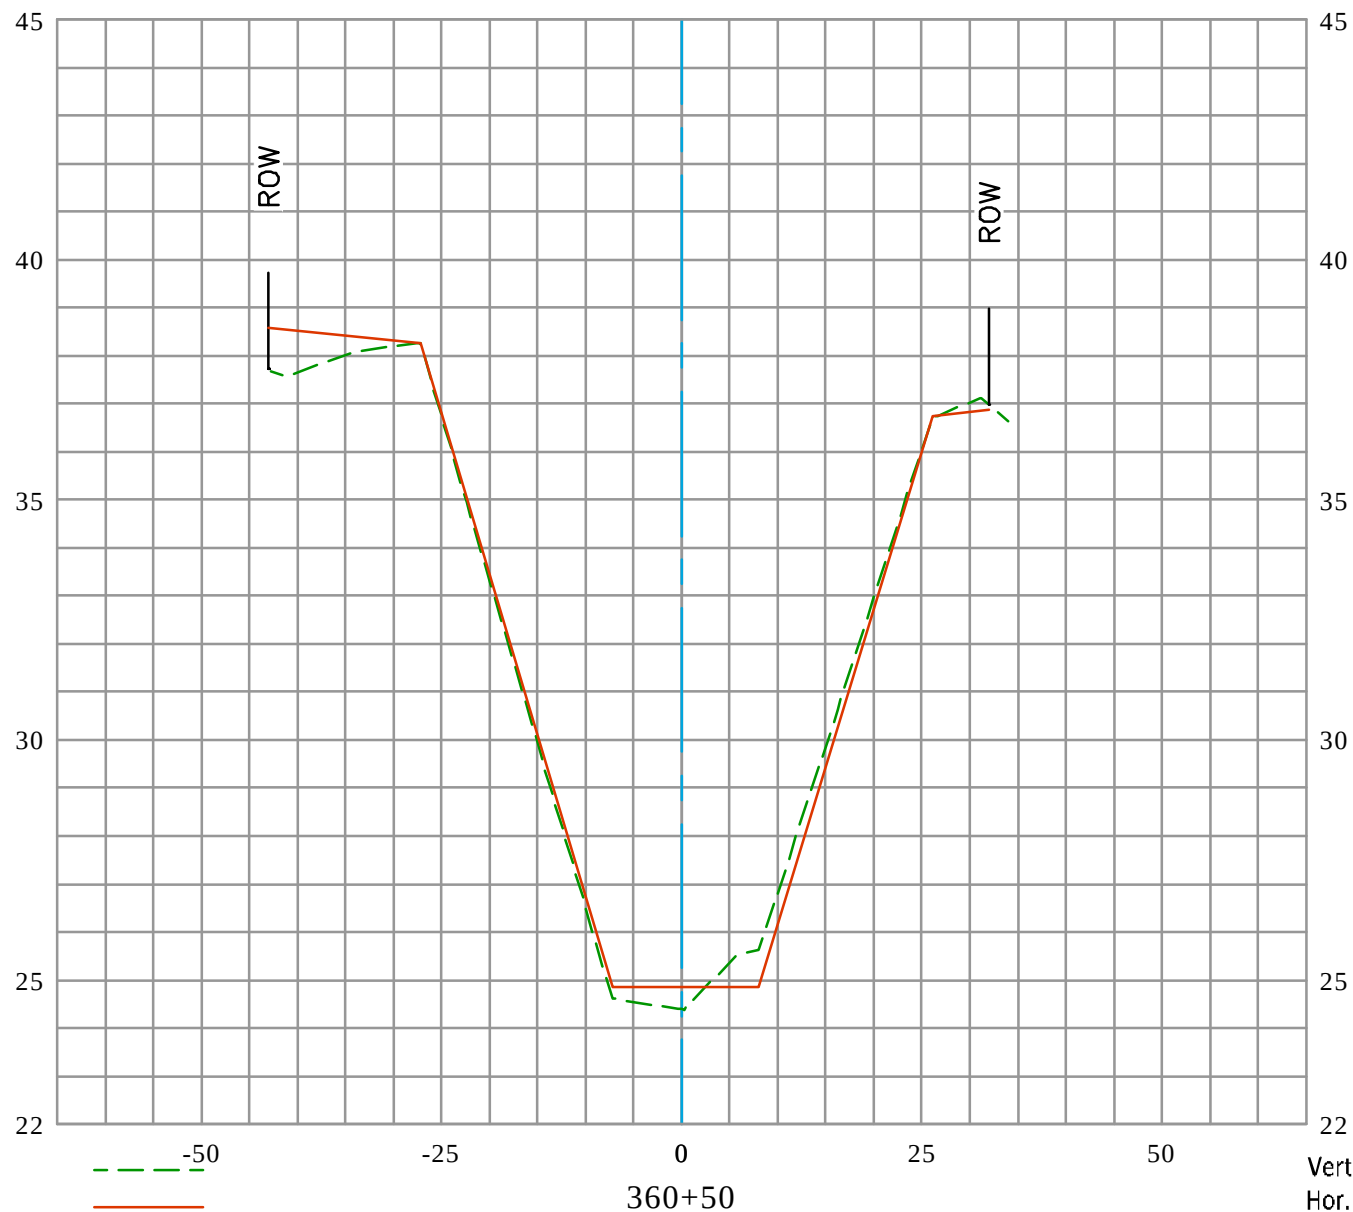
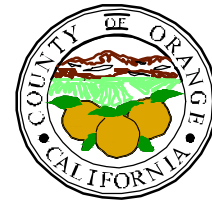


EXISTING CONDITION 2020
RECORD DRAWING:
D03-101-2A, D03-101-3A, & D03-101-7R
DATE PREPARED: 01/24/2022

U.S. *Survey*
Foot

OC Public Works
OC Survey/Field Services
Boundary Analysis & Mapping

GREENVILLE BANNING CHANNEL (D03) CL

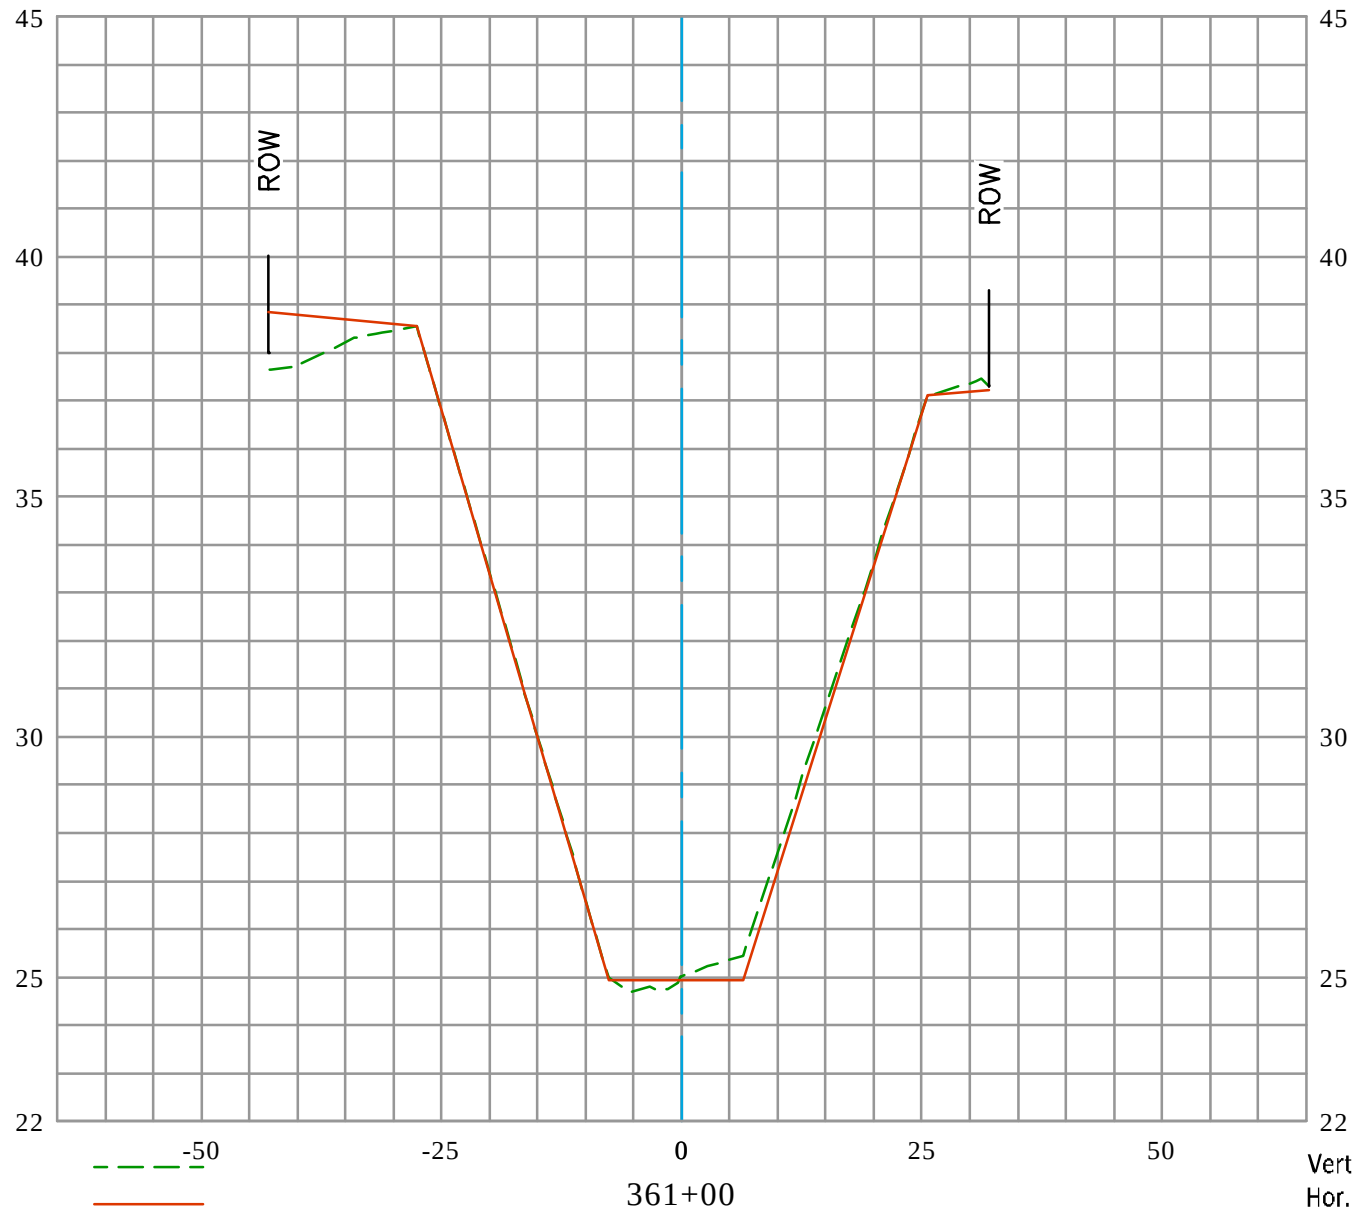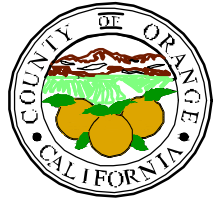


EXISTING CONDITION 2020
RECORD DRAWING:
D03-101-2A, D03-101-3A, & D03-101-7R
DATE PREPARED: 01/24/2022

Vert. Scale: 1" = 4'
Hor. Scale: 1" = 20'

U.S. Survey
Foot

OC Public Works
OC Survey/Field Services
Boundary Analysis & Mapping


GREENVILLE BANNING CHANNEL (D03) CL

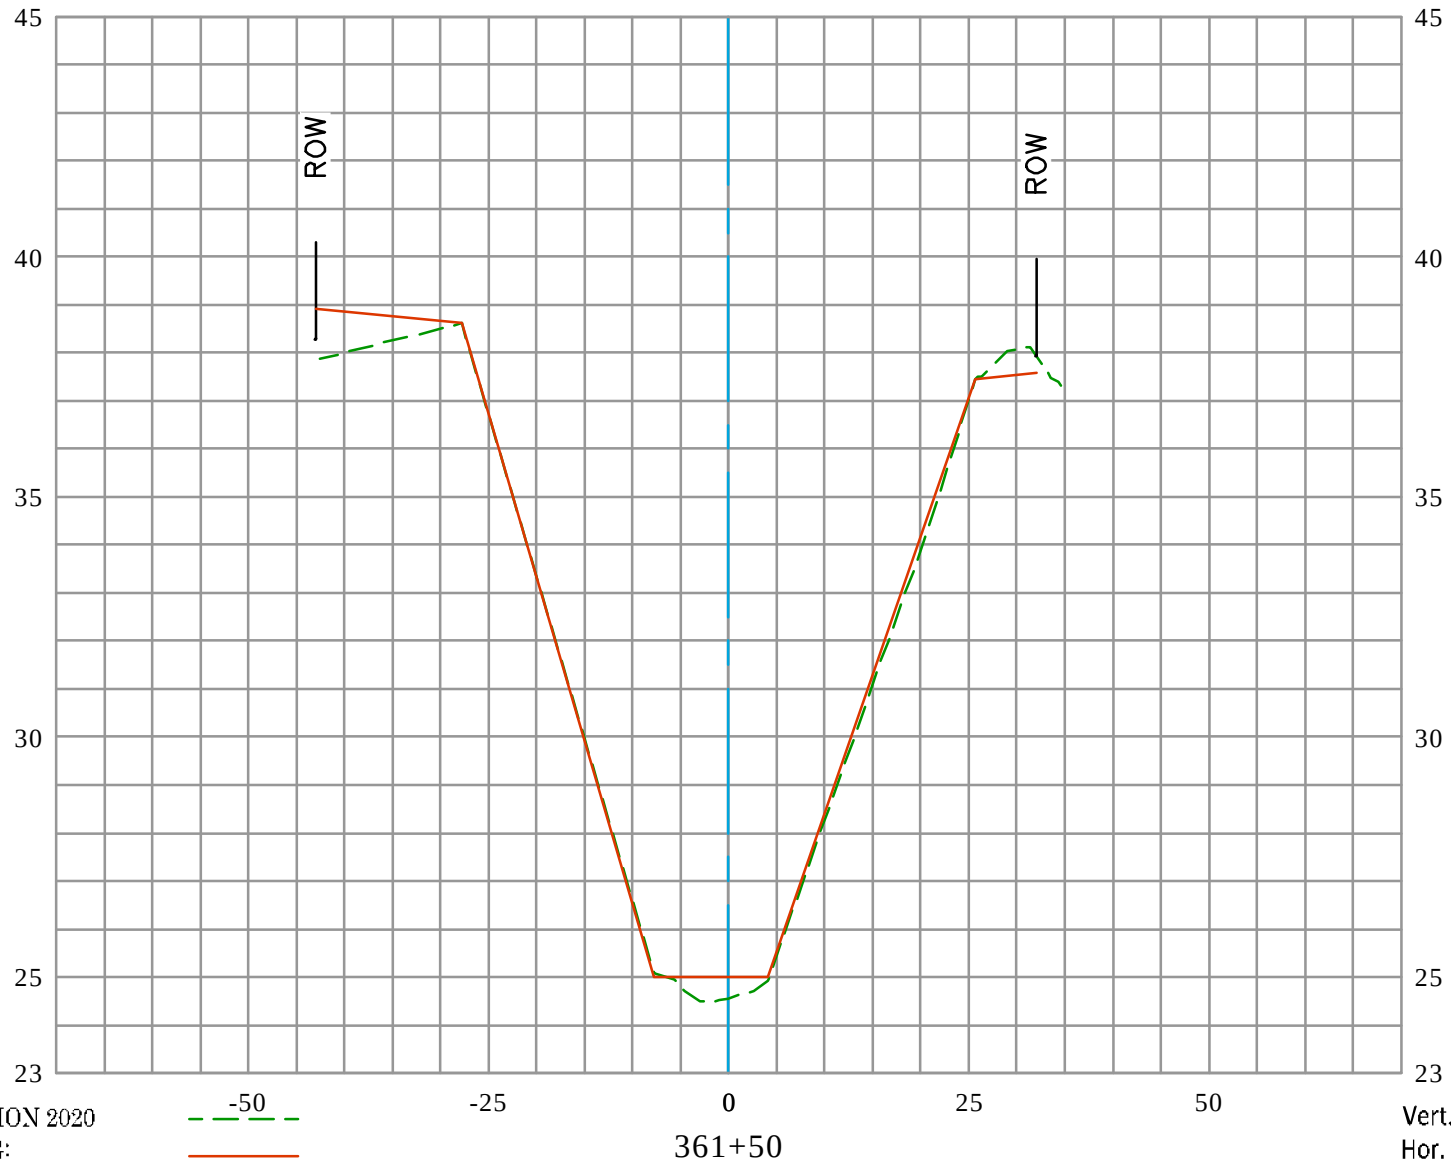

EXISTING CONDITION 2020
RECORD DRAWING:
D03-101-2A, D03-101-3A, & D03-101-7R
DATE PREPARED: 01/24/2022

Vert. Scale: 1" = 4'
Hor. Scale: 1" = 20'

GREENVILLE BANNING CHANNEL (D03) CL

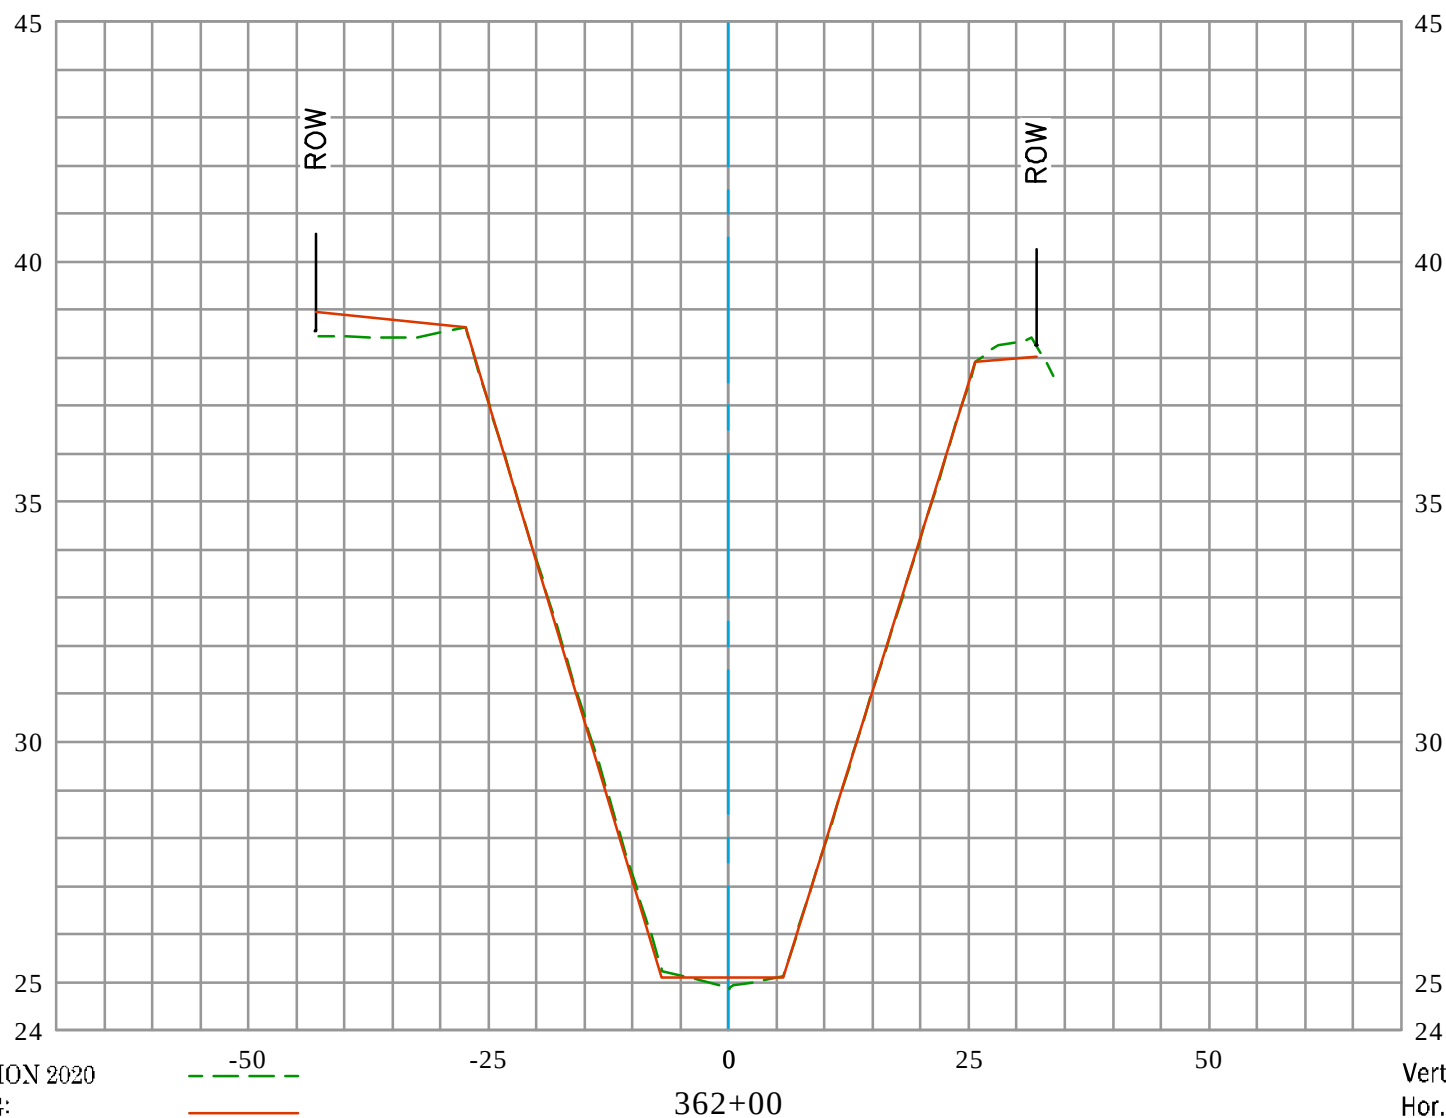


EXISTING CONDITION 2020
 RECORD DRAWING:
 D03-101-2A, D03-101-3A, & D03-101-7R
 DATE PREPARED: 01/24/2022

Vert. Scale: 1" = 4'
 Hor. Scale: 1" = 20'

U.S. *Survey Foot*

OC Public Works
OC Survey/Field Services
Boundary Analysis & Mapping

GREENVILLE BANNING CHANNEL (D03) CL

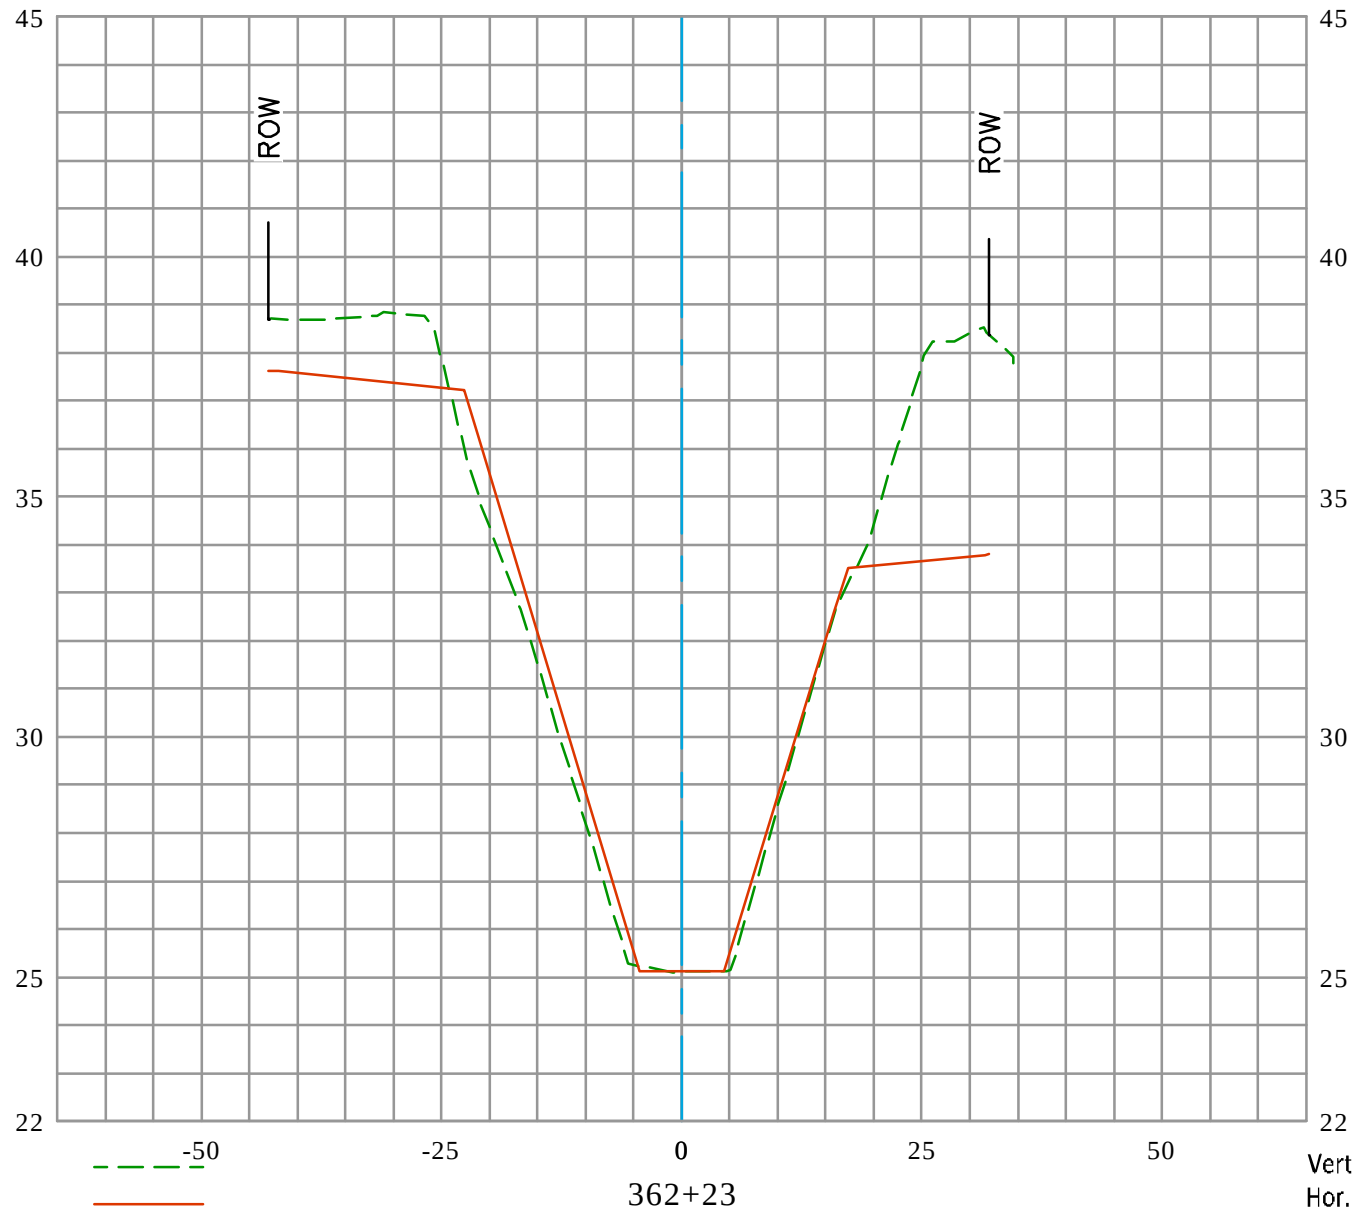


EXISTING CONDITION 2020
RECORD DRAWING:
D03-101-2A, D03-101-3A, & D03-101-7R
DATE PREPARED: 01/24/2022

Vert. Scale: 1" = 4'
Hor. Scale: 1" = 20'



GREENVILLE BANNING CHANNEL (D03) CL

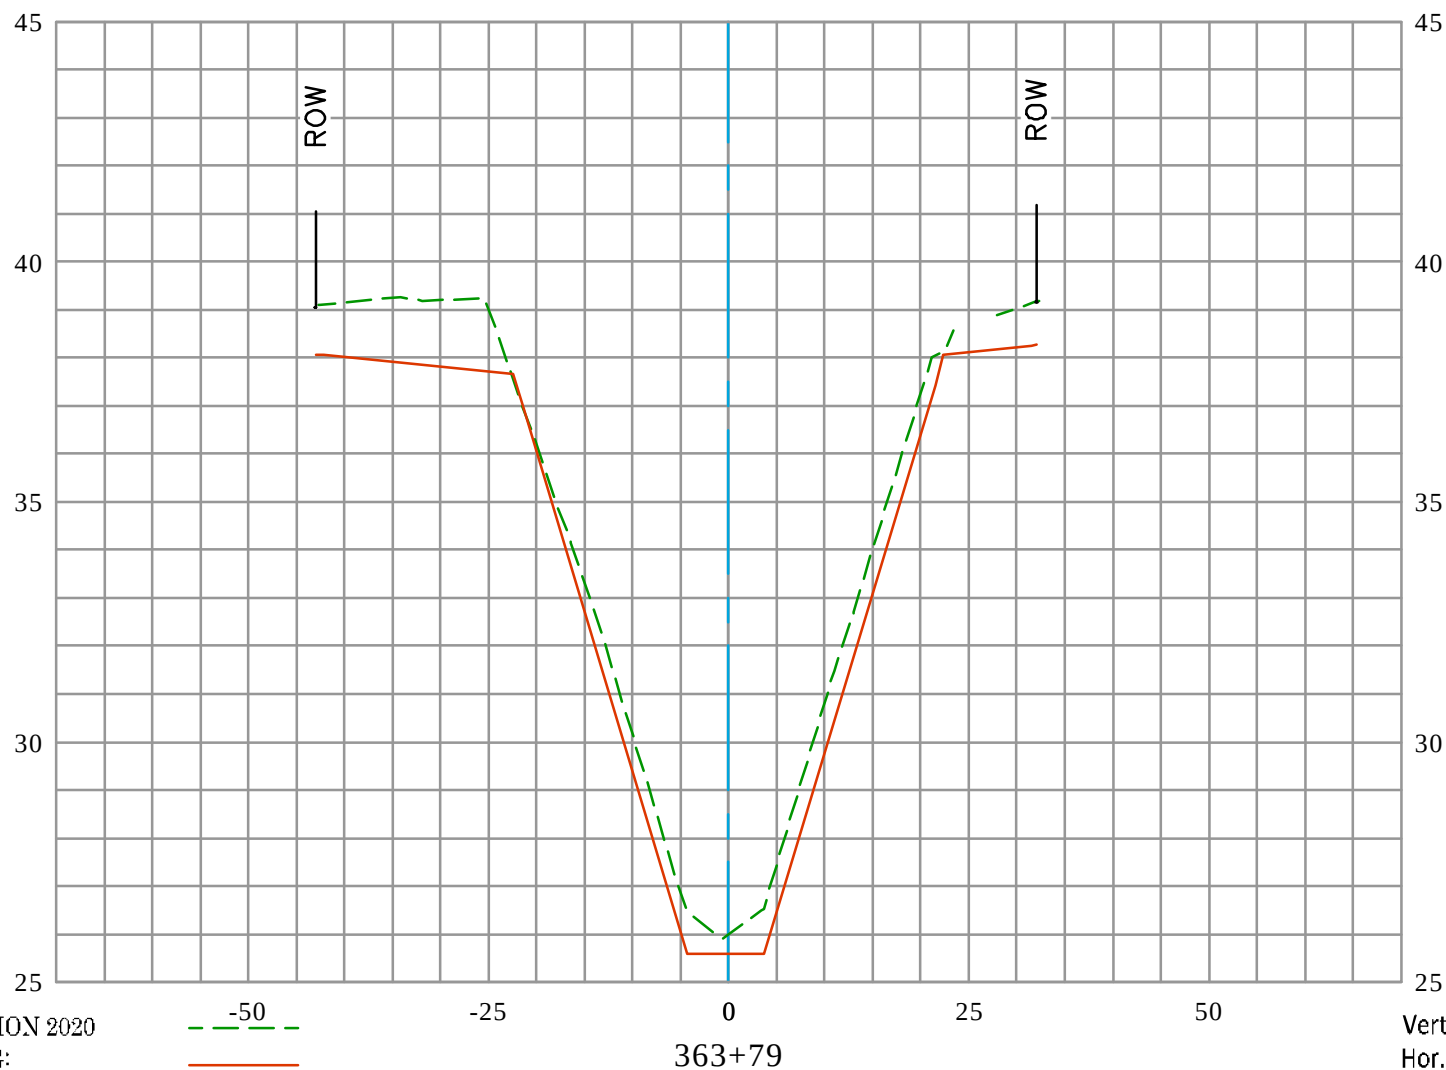


EXISTING CONDITION 2020
 RECORD DRAWING:
 D03-101-2A, D03-101-3A, & D03-101-7R
 DATE PREPARED: 01/24/2022

Vert. Scale: 1" = 4'
 Hor. Scale: 1" = 20'



GREENVILLE BANNING CHANNEL (D03) CL

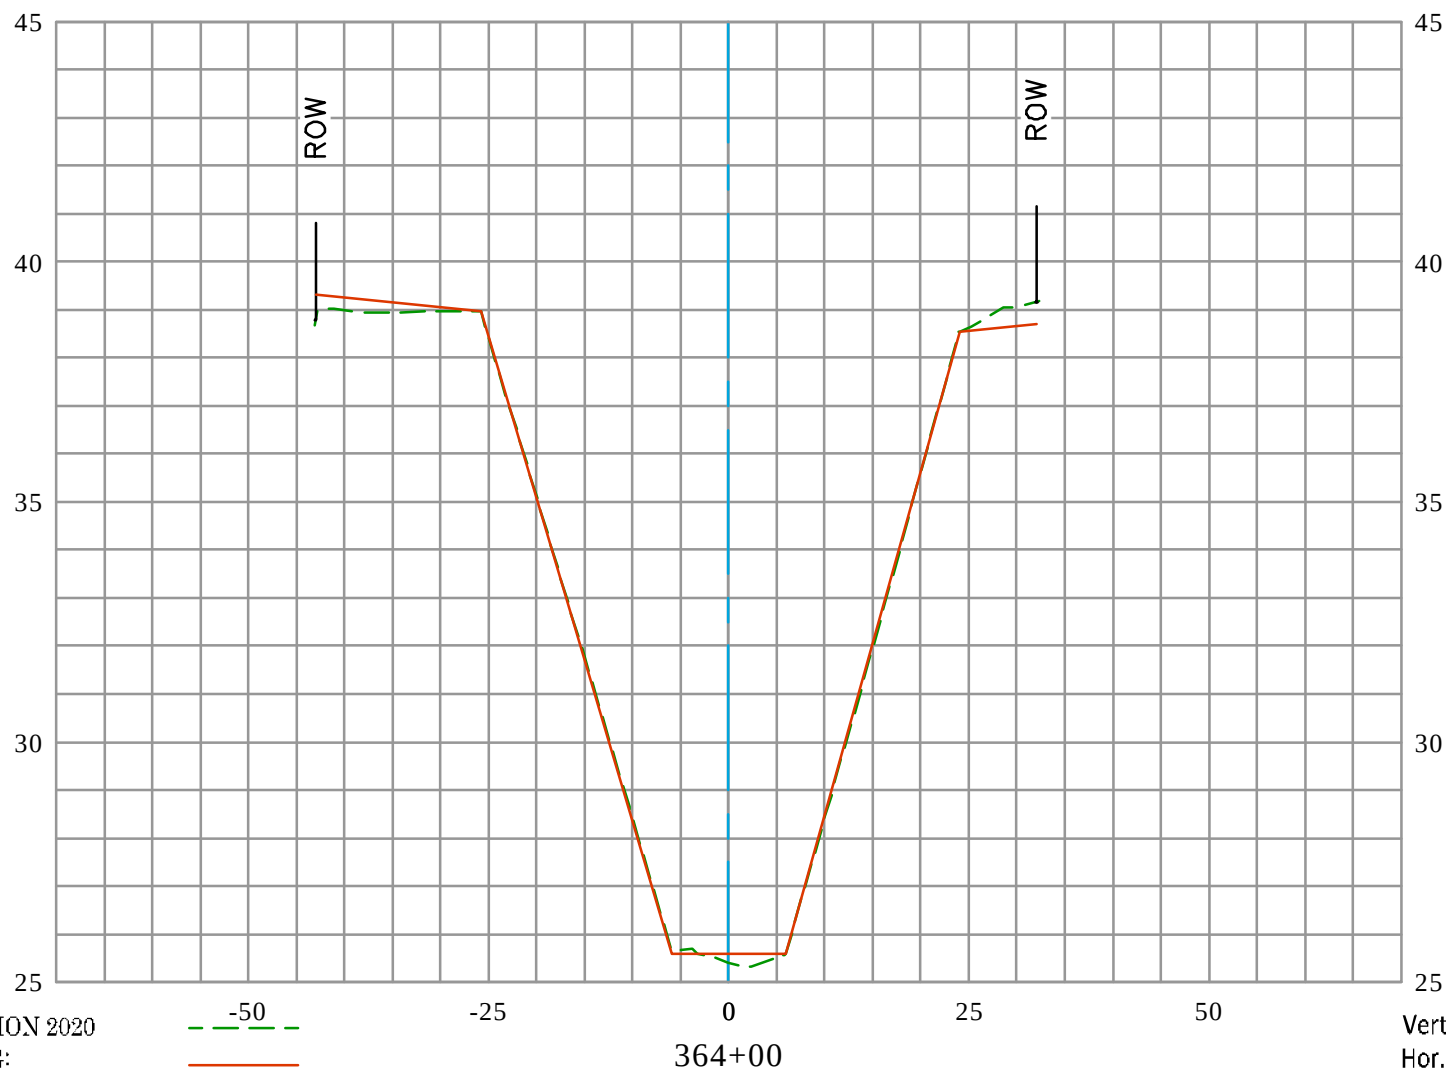


EXISTING CONDITION 2020
 RECORD DRAWING:
 D03-101-2A, D03-101-3A, & D03-101-7R
 DATE PREPARED: 01/24/2022

Vert. Scale: 1" = 4'
 Hor. Scale: 1" = 20'



GREENVILLE BANNING CHANNEL (D03) CL

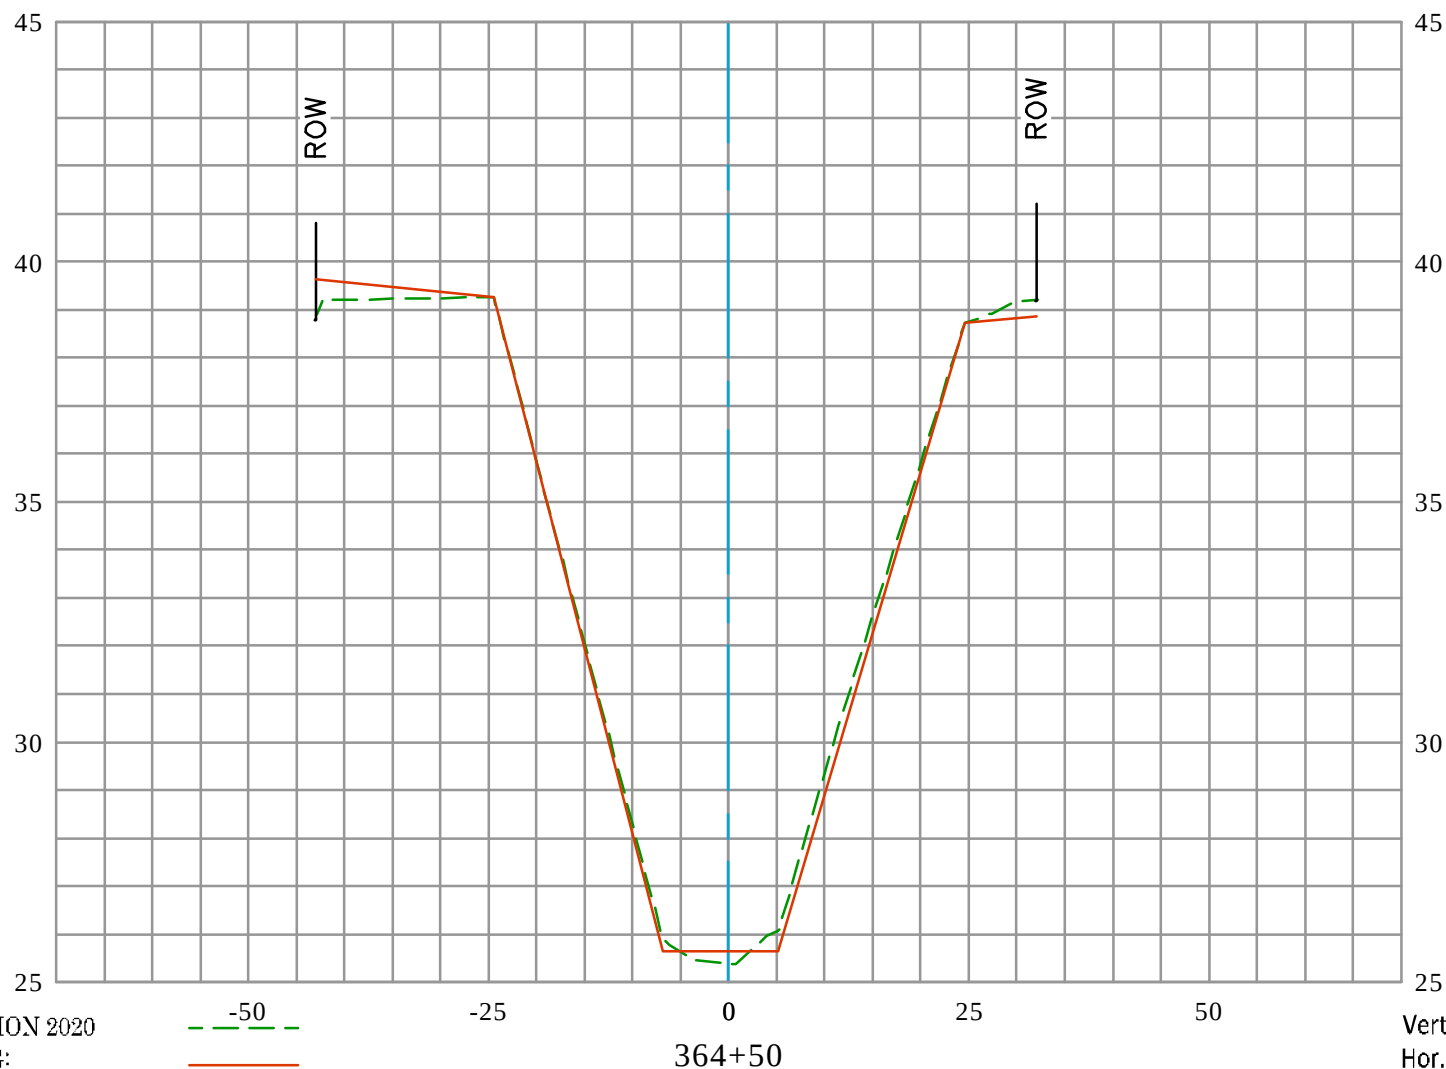


EXISTING CONDITION 2020
 RECORD DRAWING:
 D03-101-2A, D03-101-3A, & D03-101-7R
 DATE PREPARED: 01/24/2022

Vert. Scale: 1" = 4'
 Hor. Scale: 1" = 20'




GREENVILLE BANNING CHANNEL (D03) CL

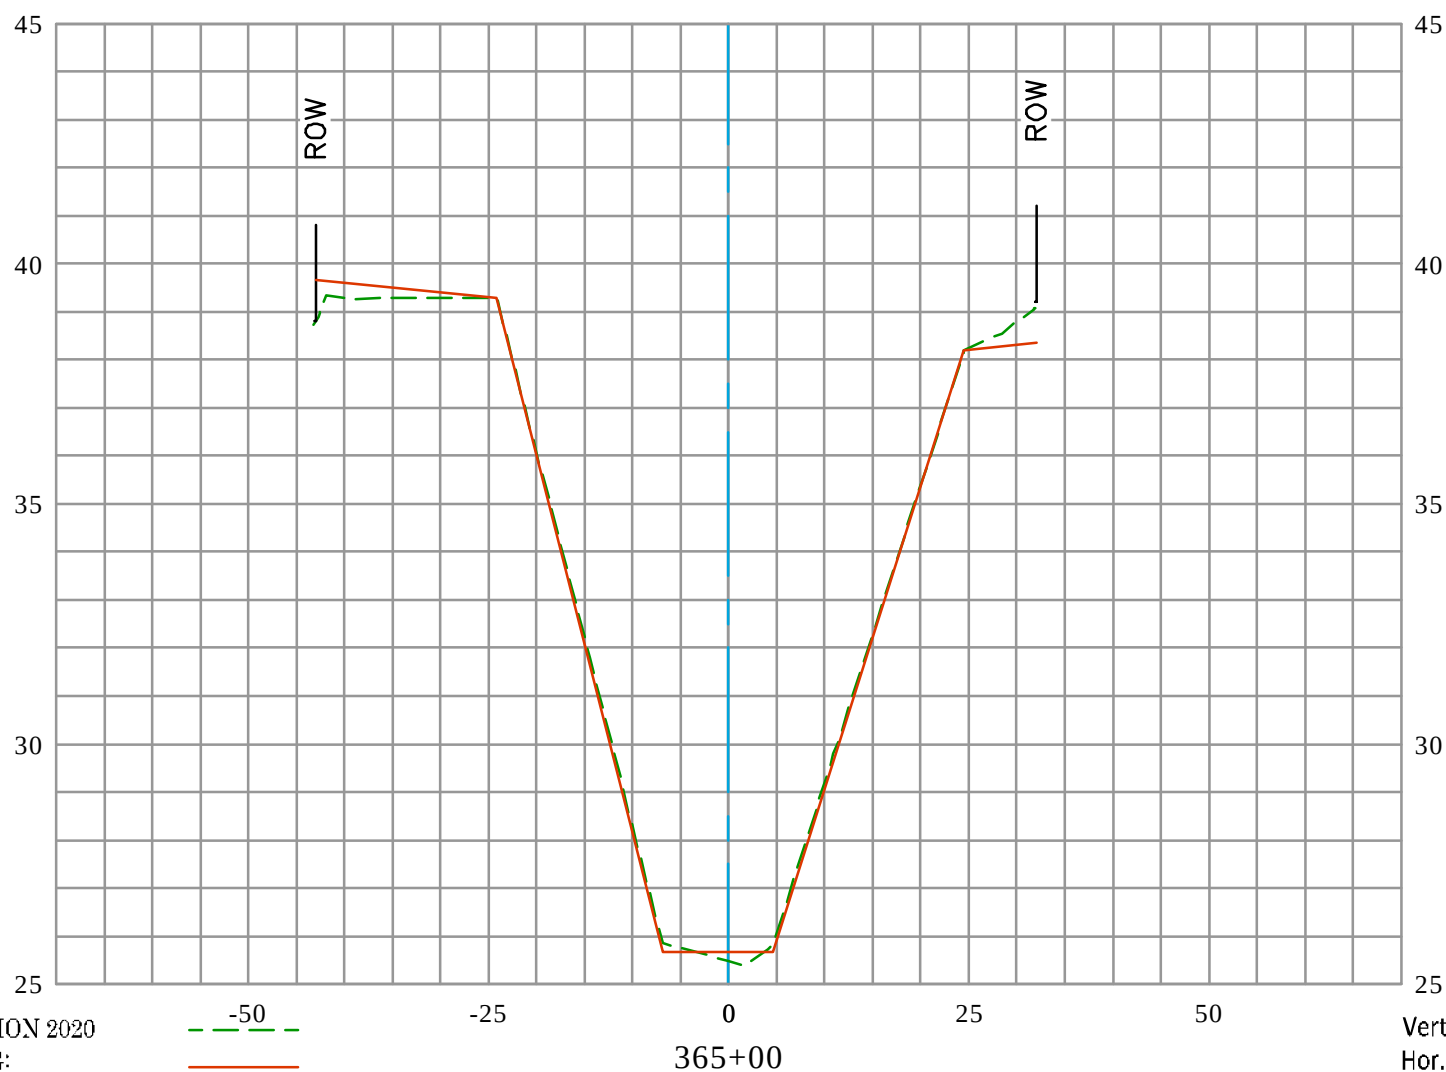

EXISTING CONDITION 2020
 RECORD DRAWING:
 D03-101-2A, D03-101-3A, & D03-101-7R
 DATE PREPARED: 01/24/2022




GREENVILLE BANNING CHANNEL (D03) CL

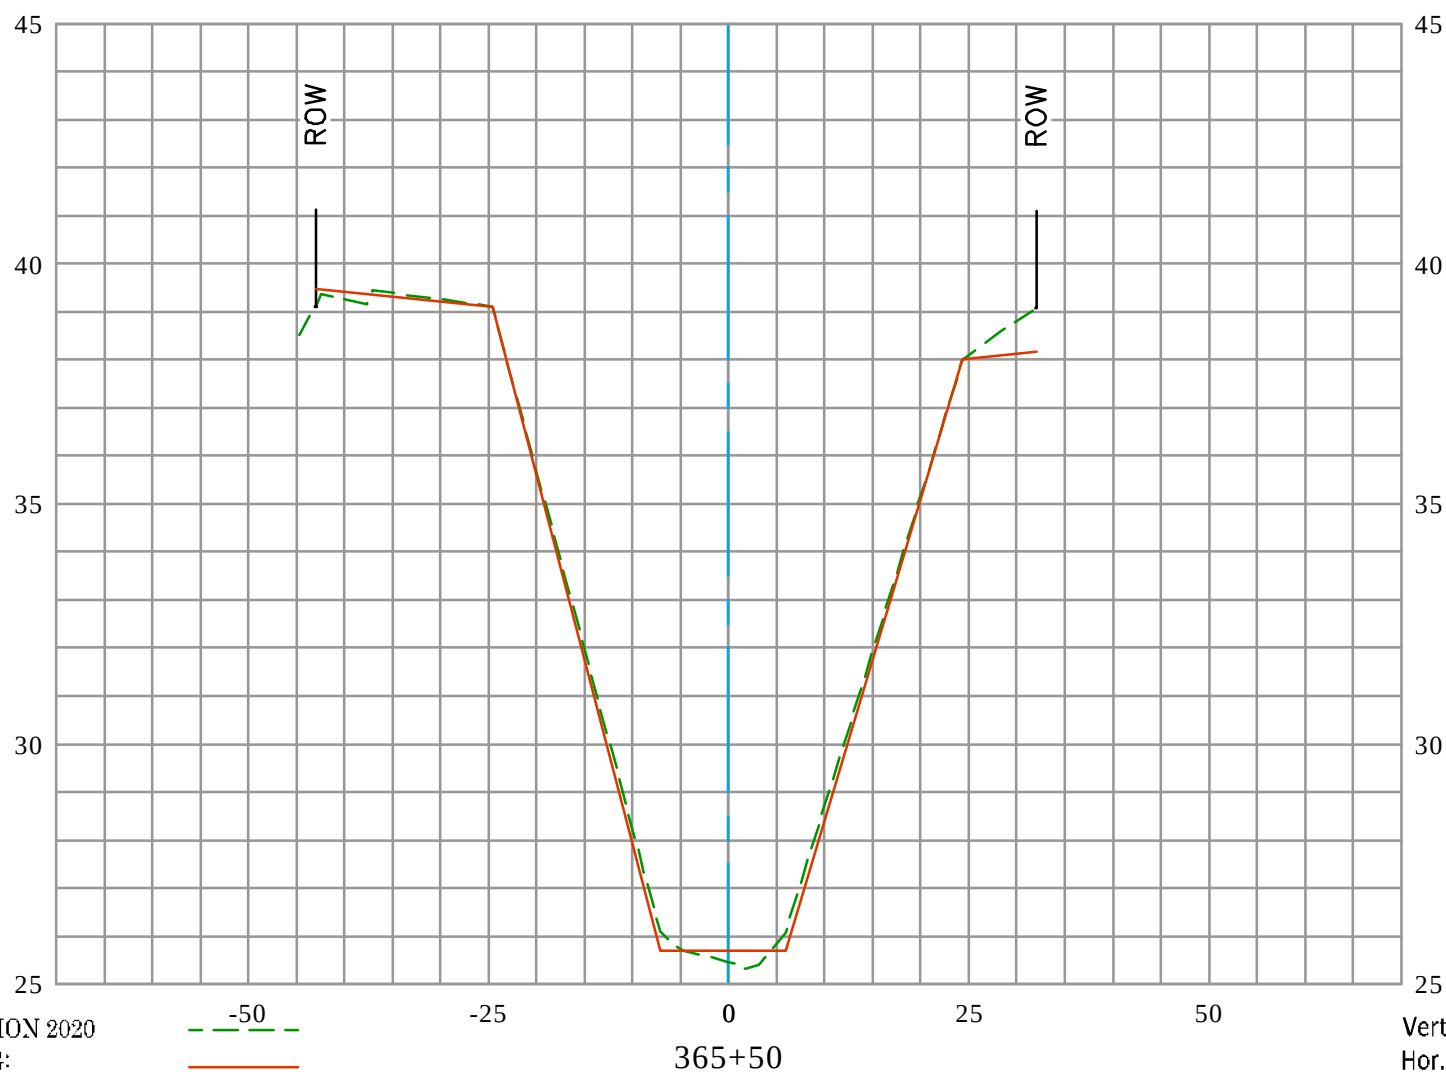

EXISTING CONDITION 2020
 RECORD DRAWING:
 D03-101-2A, D03-101-3A, & D03-101-7R
 DATE PREPARED: 01/24/2022



GREENVILLE BANNING CHANNEL (D03) CL

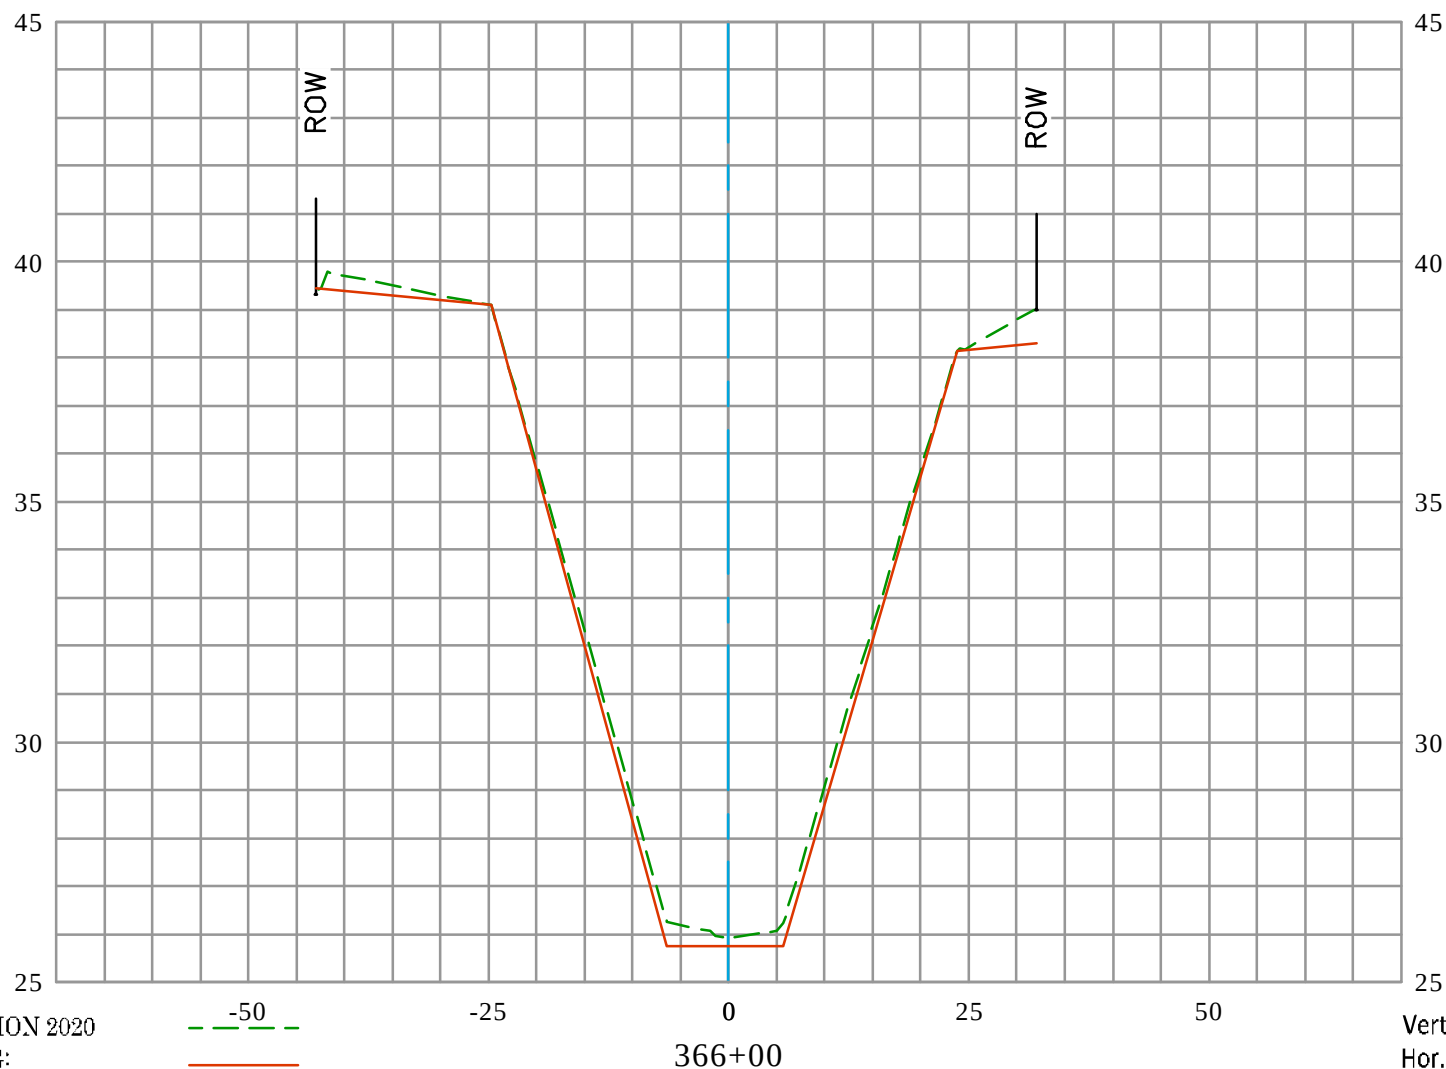


EXISTING CONDITION 2020
 RECORD DRAWING:
 D03-101-2A, D03-101-3A, & D03-101-7R
 DATE PREPARED: 01/24/2022

Vert. Scale: 1" = 4'
 Hor. Scale: 1" = 20'




GREENVILLE BANNING CHANNEL (D03) CL

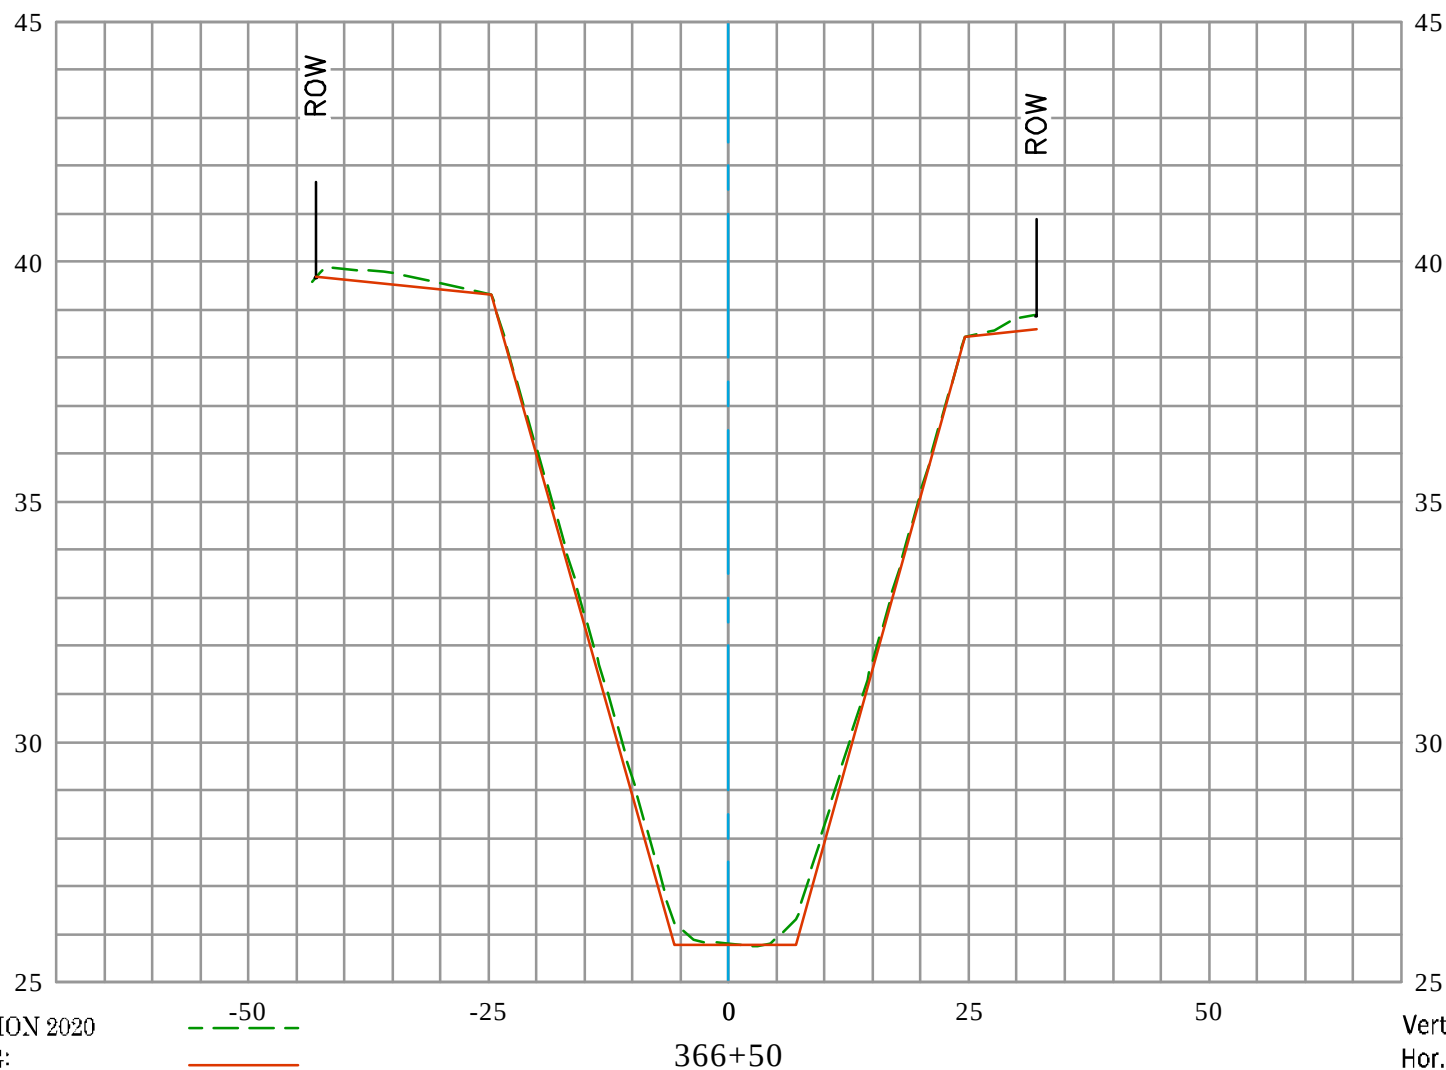

EXISTING CONDITION 2020
 RECORD DRAWING:
 D03-101-2A, D03-101-3A, & D03-101-7R
 DATE PREPARED: 01/24/2022




GREENVILLE BANNING CHANNEL (D03) CL

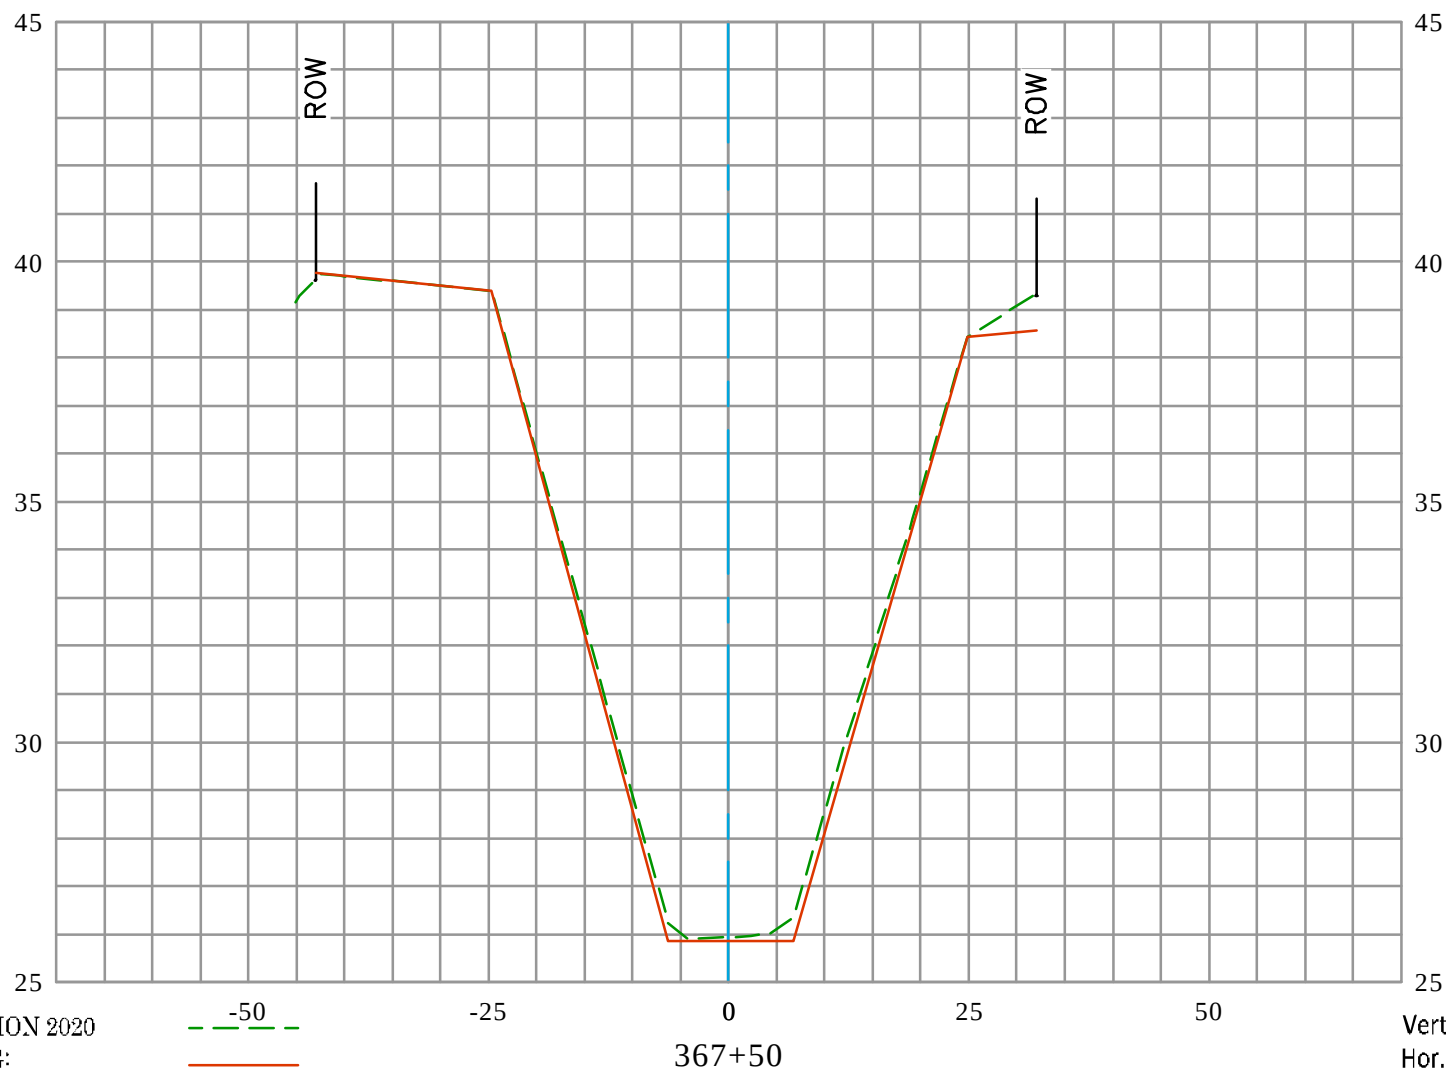

EXISTING CONDITION 2020
 RECORD DRAWING:
 D03-101-2A, D03-101-3A, & D03-101-7R
 DATE PREPARED: 01/24/2022



GREENVILLE BANNING CHANNEL (D03) CL

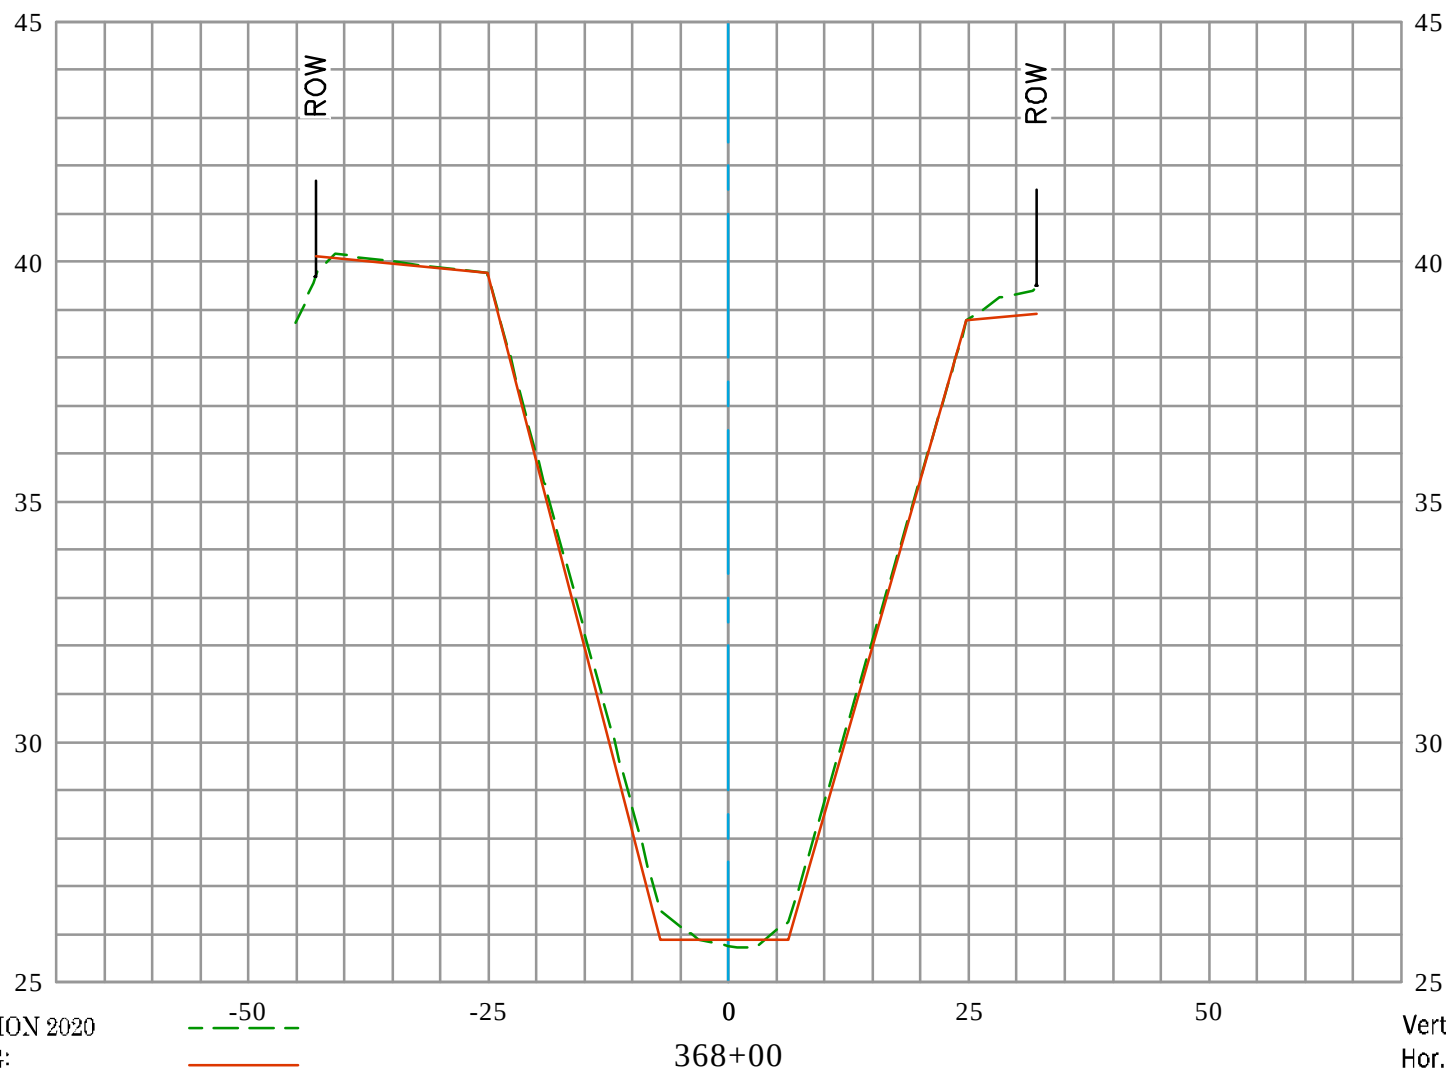


EXISTING CONDITION 2020
 RECORD DRAWING:
 D03-101-2A, D03-101-3A, & D03-101-7R
 DATE PREPARED: 01/24/2022

Vert. Scale: 1" = 4'
 Hor. Scale: 1" = 20'



GREENVILLE BANNING CHANNEL (D03) CL

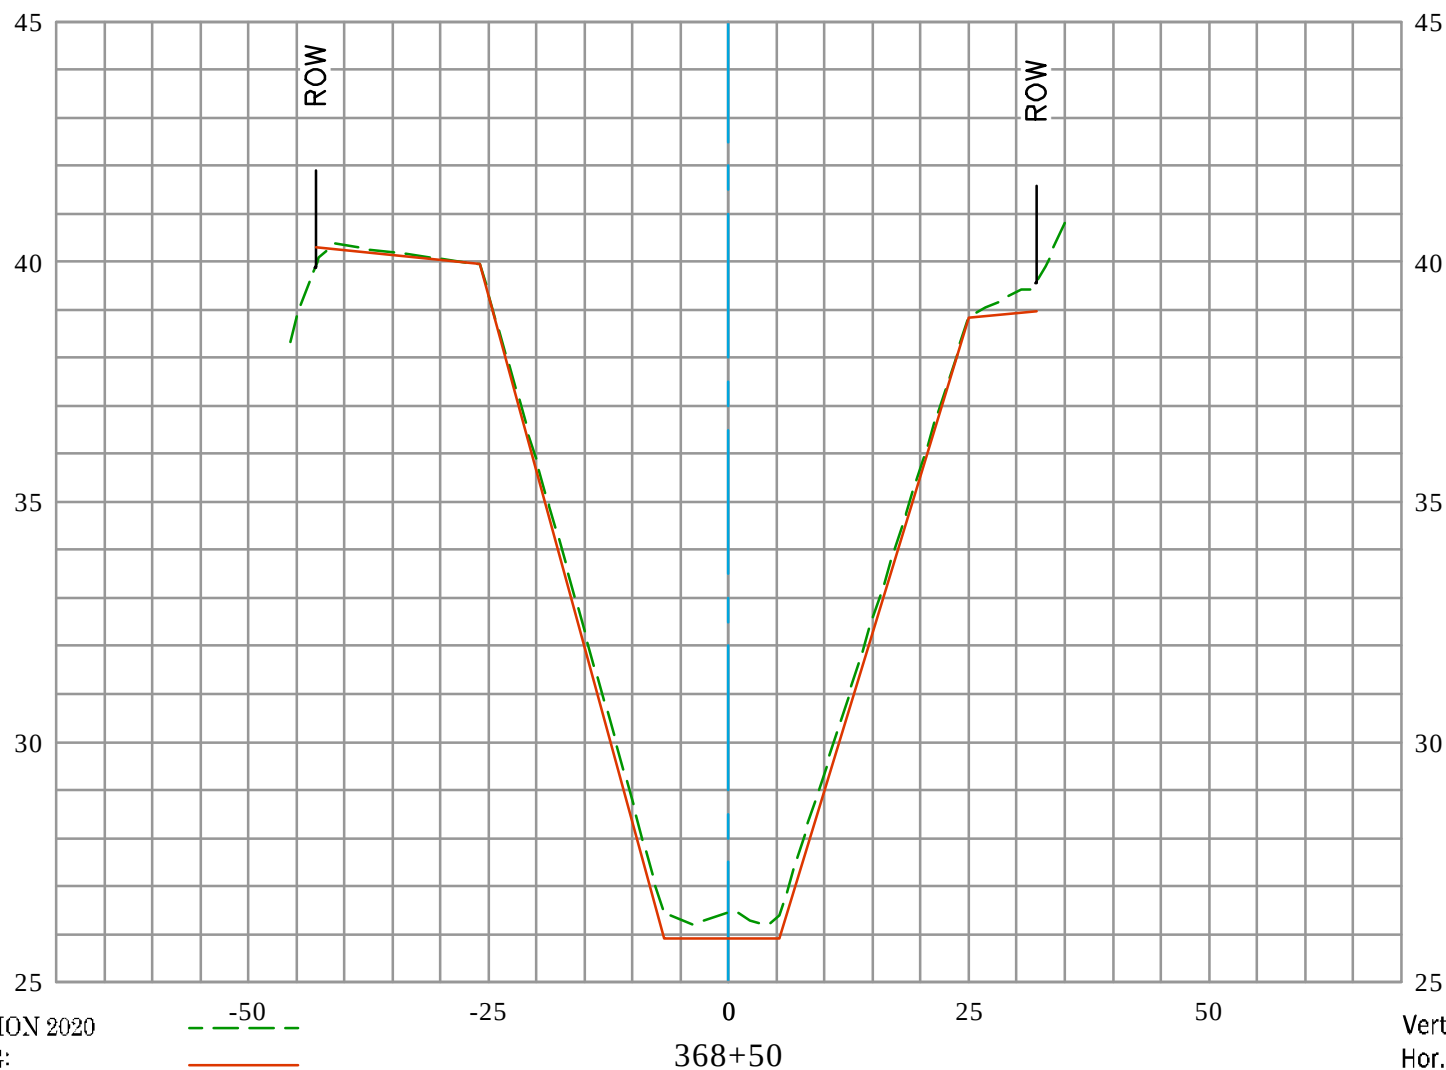


EXISTING CONDITION 2020
 RECORD DRAWING:
 D03-101-2A, D03-101-3A, & D03-101-7R
 DATE PREPARED: 01/24/2022

Vert. Scale: 1" = 4'
 Hor. Scale: 1" = 20'



GREENVILLE BANNING CHANNEL (D03) CL

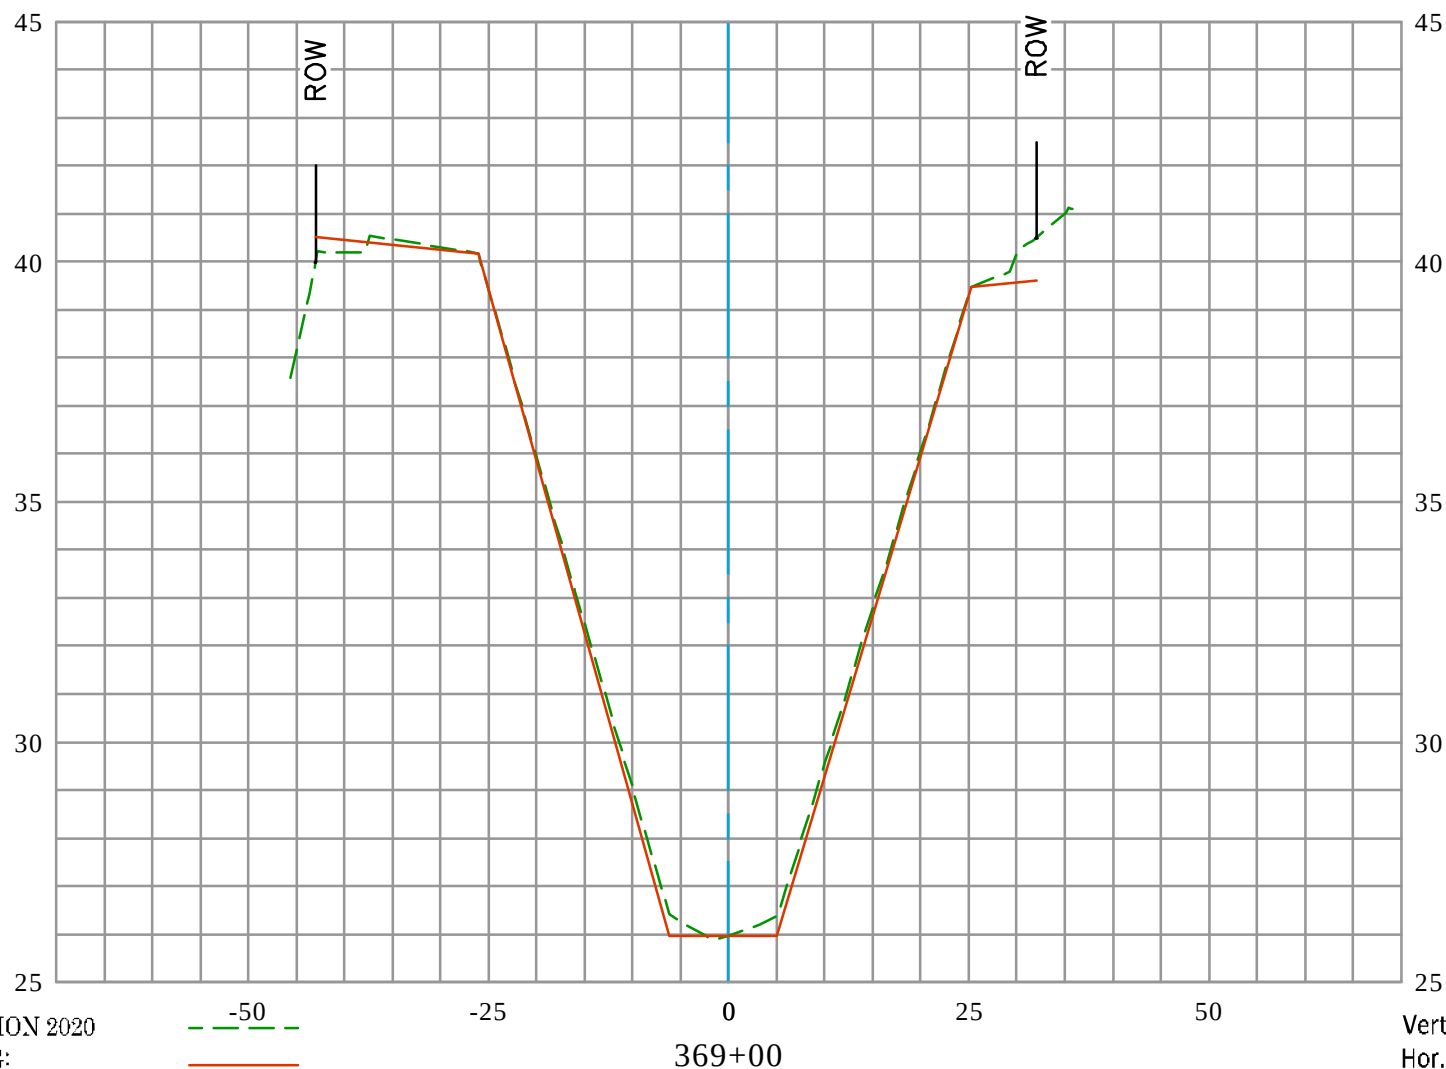


EXISTING CONDITION 2020
 RECORD DRAWING:
 D03-101-2A, D03-101-3A, & D03-101-7R
 DATE PREPARED: 01/24/2022

Vert. Scale: 1" = 4'
 Hor. Scale: 1" = 20'



GREENVILLE BANNING CHANNEL (D03) CL

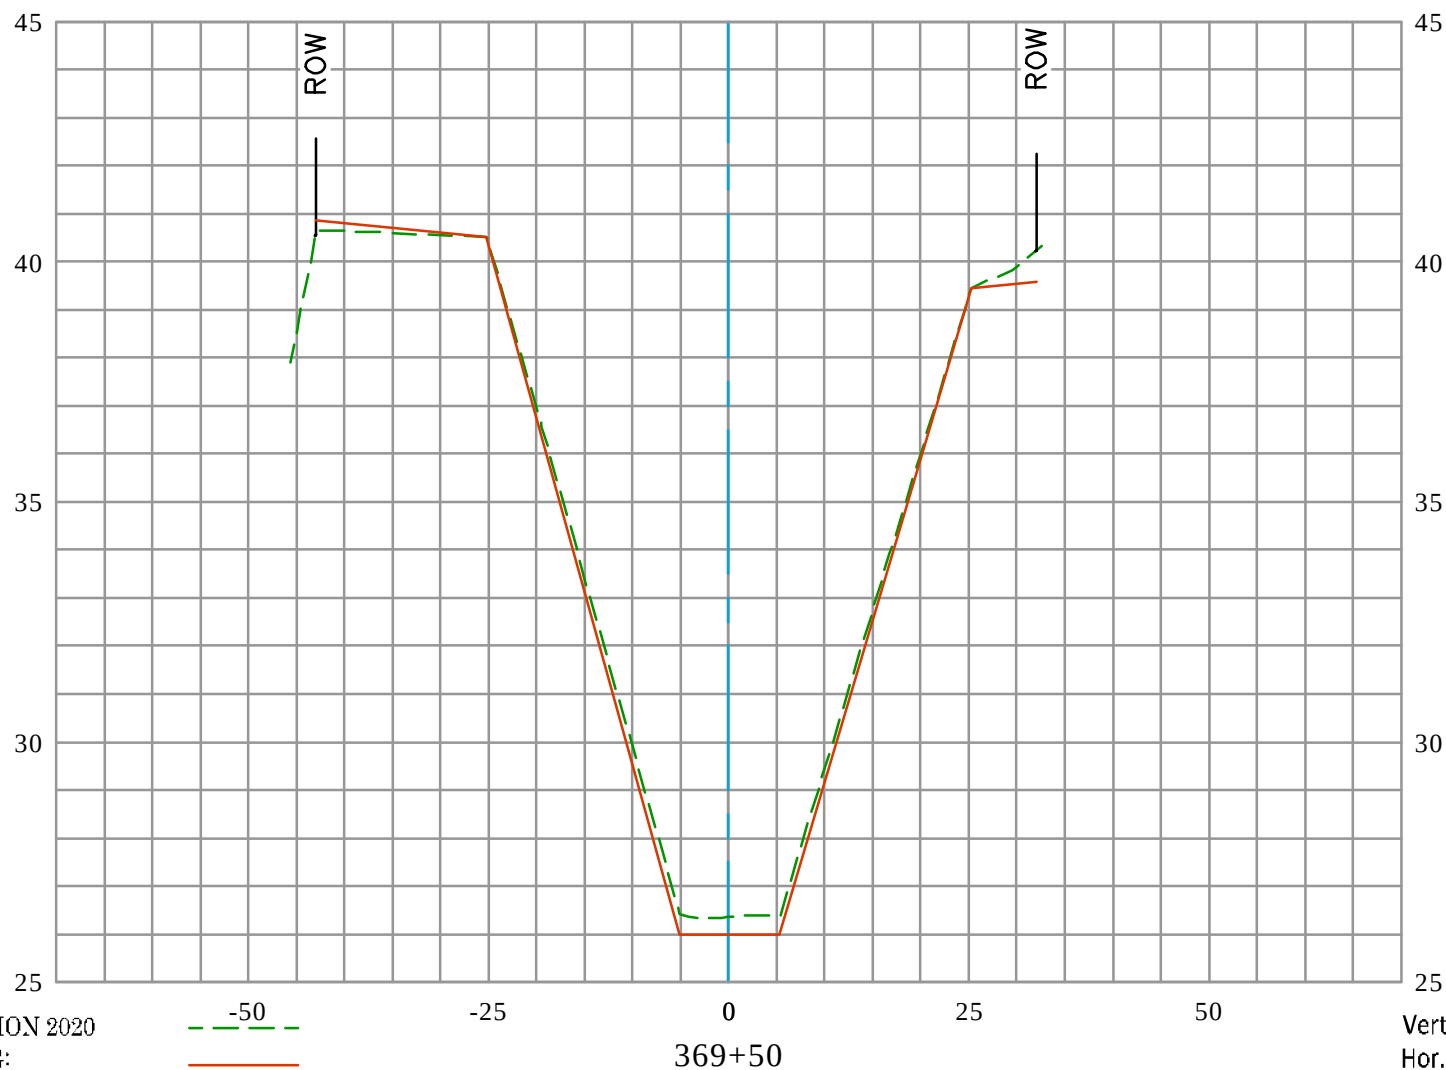

EXISTING CONDITION 2020
 RECORD DRAWING:
 D03-101-2A, D03-101-3A, & D03-101-7R
 DATE PREPARED: 01/24/2022



Vert. Scale: 1" = 4'
 Hor. Scale: 1" = 20'

U.S. *Survey Foot*

OC Public Works
OC Survey/Field Services
Boundary Analysis & Mapping

GREENVILLE BANNING CHANNEL (D03)


CL

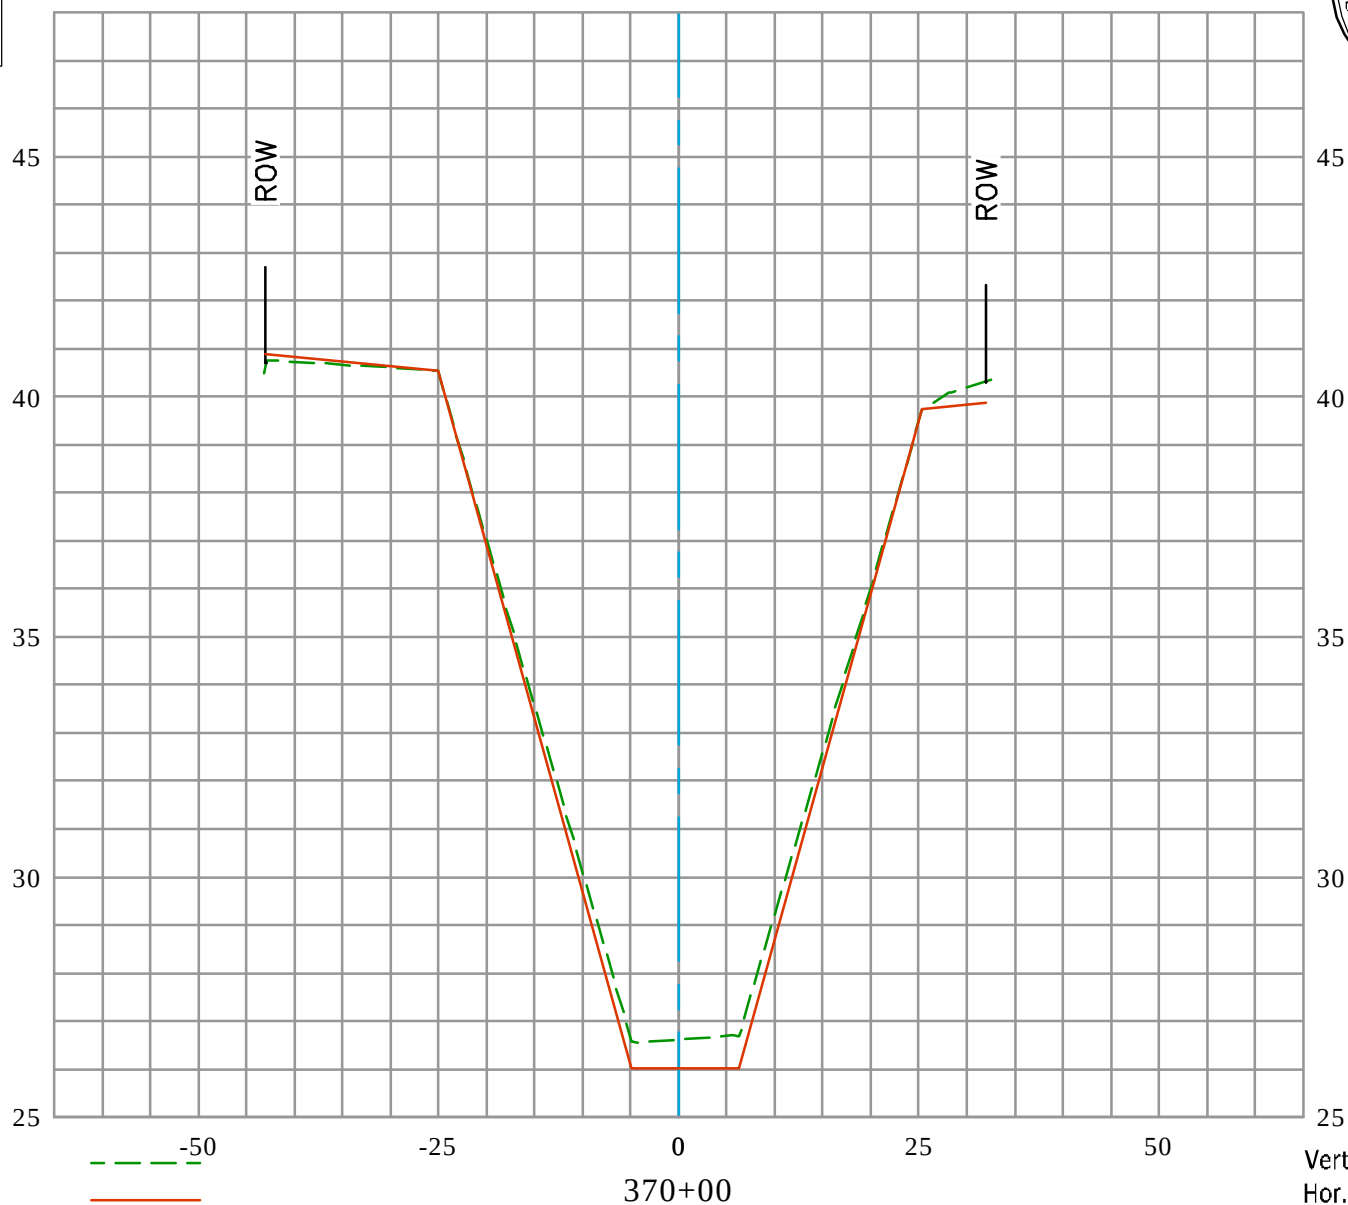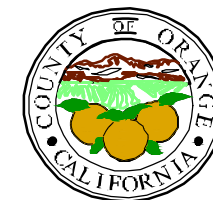

EXISTING CONDITION 2020
RECORD DRAWING:
D03-101-2A, D03-101-3A, & D03-101-7R
DATE PREPARED: 01/24/2022




GREENVILLE BANNING CHANNEL (D03) CL

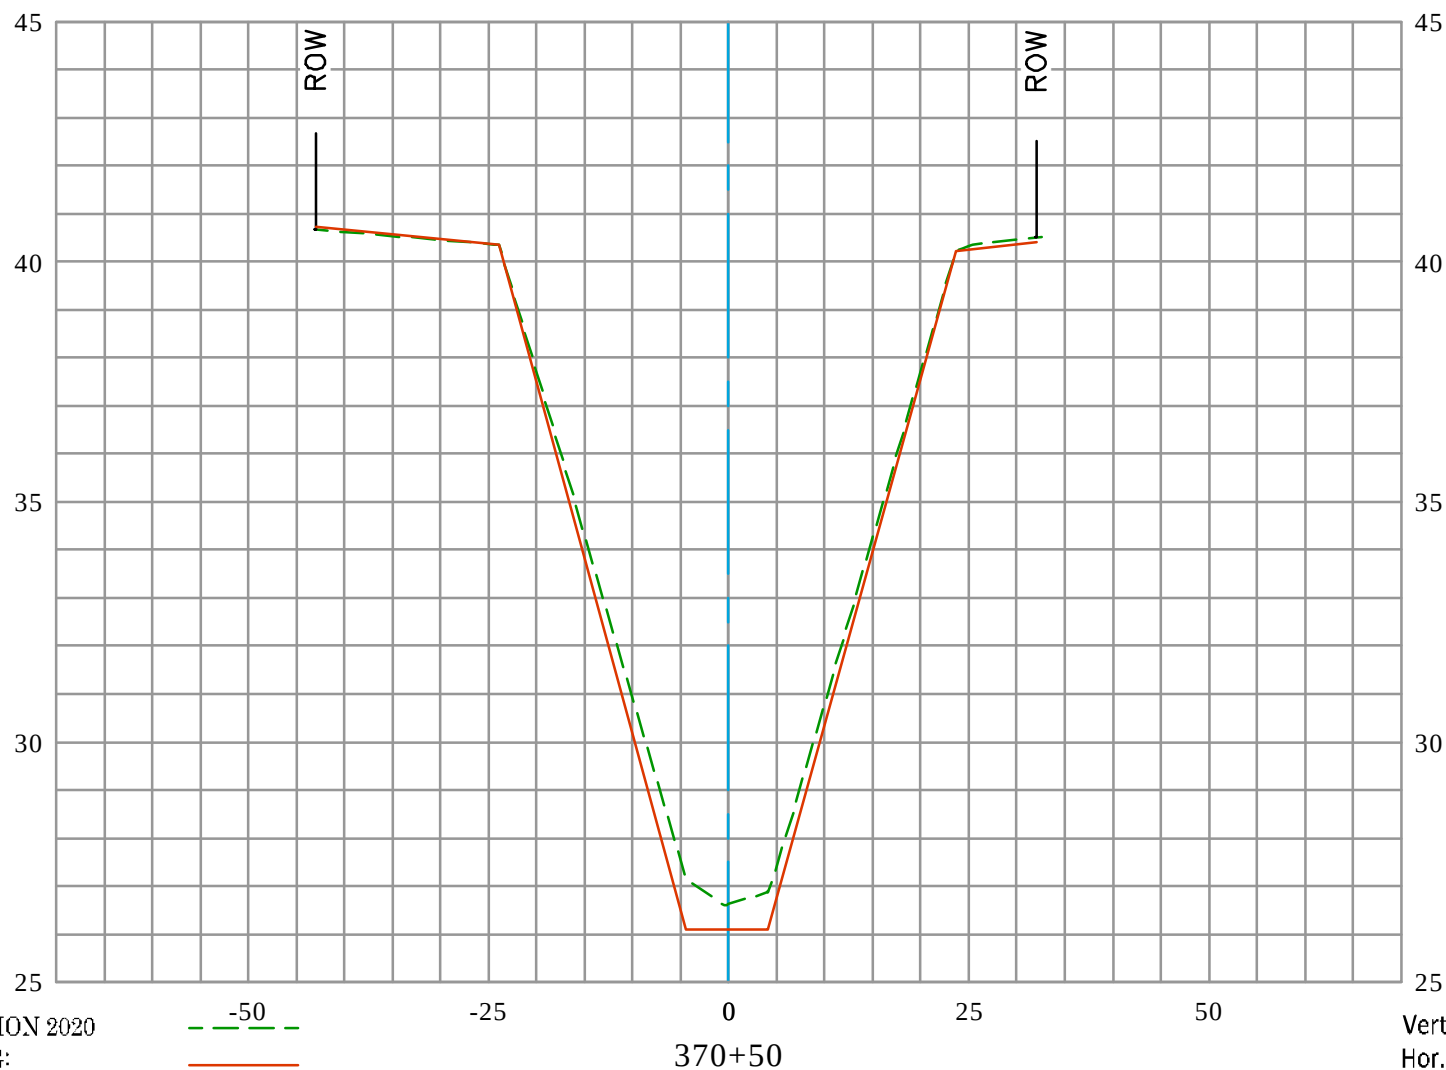

EXISTING CONDITION 2020
 RECORD DRAWING:
 D03-101-2A, D03-101-3A, & D03-101-7R
 DATE PREPARED: 01/24/2022



GREENVILLE BANNING CHANNEL (D03) CL

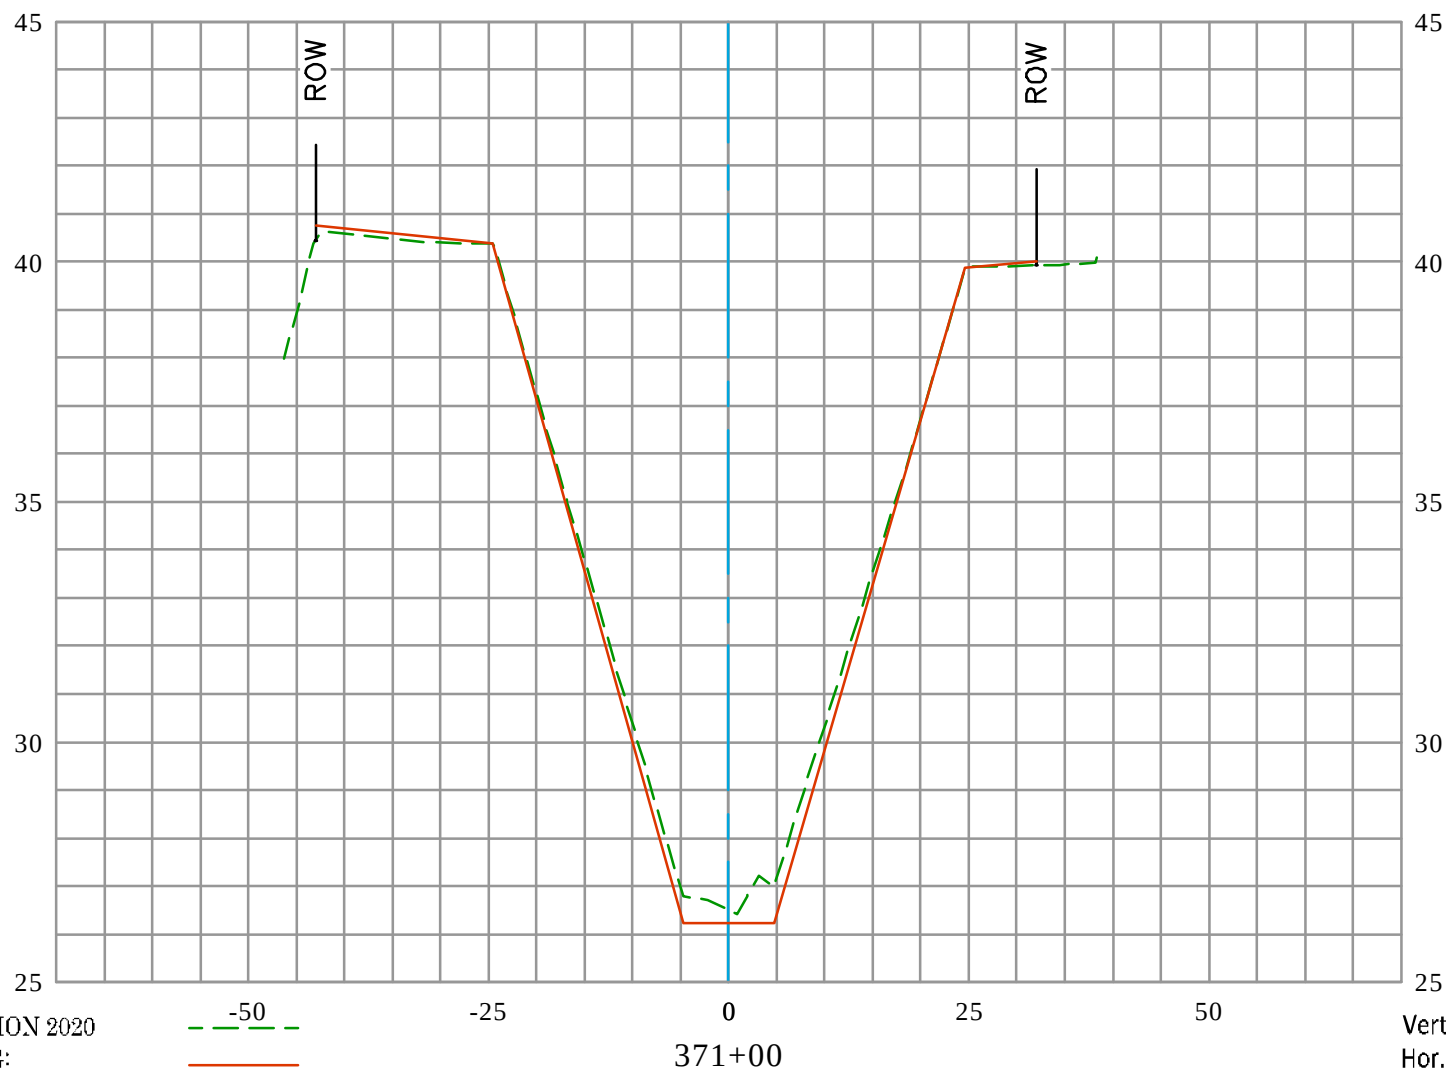


EXISTING CONDITION 2020
 RECORD DRAWING:
 D03-101-2A, D03-101-3A, & D03-101-7R
 DATE PREPARED: 01/24/2022

Vert. Scale: 1" = 4'
 Hor. Scale: 1" = 20'



GREENVILLE BANNING CHANNEL (D03) CL

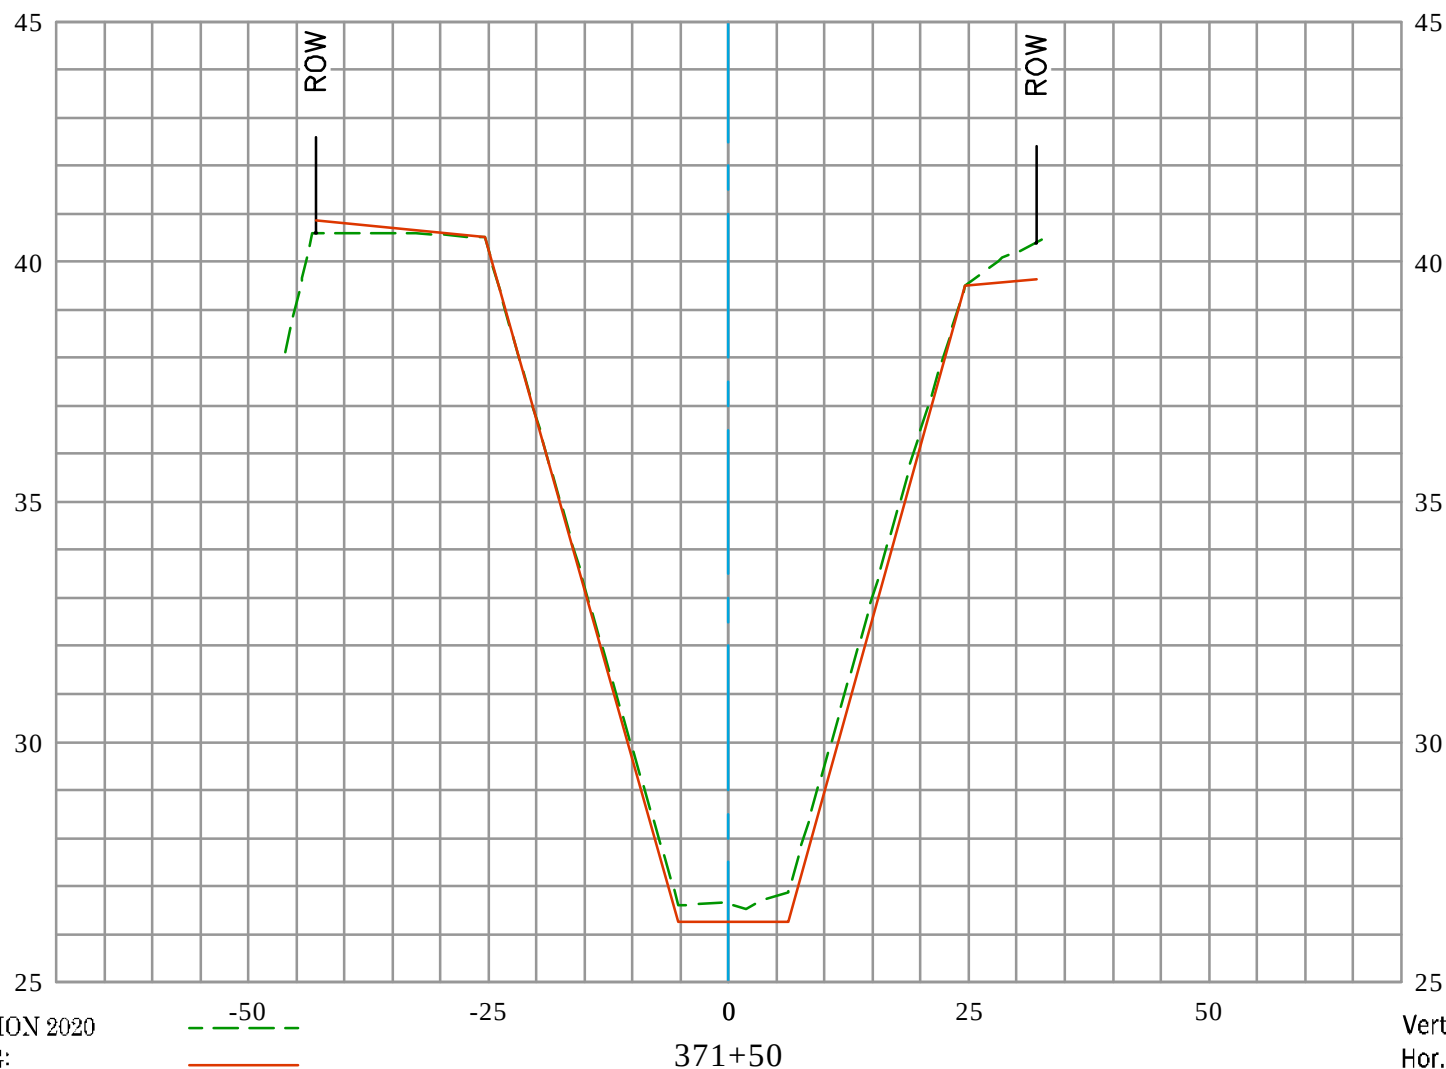


EXISTING CONDITION 2020
 RECORD DRAWING:
 D03-101-2A, D03-101-3A, & D03-101-7R
 DATE PREPARED: 01/24/2022

Vert. Scale: 1" = 4'
 Hor. Scale: 1" = 20'




GREENVILLE BANNING CHANNEL (D03) CL

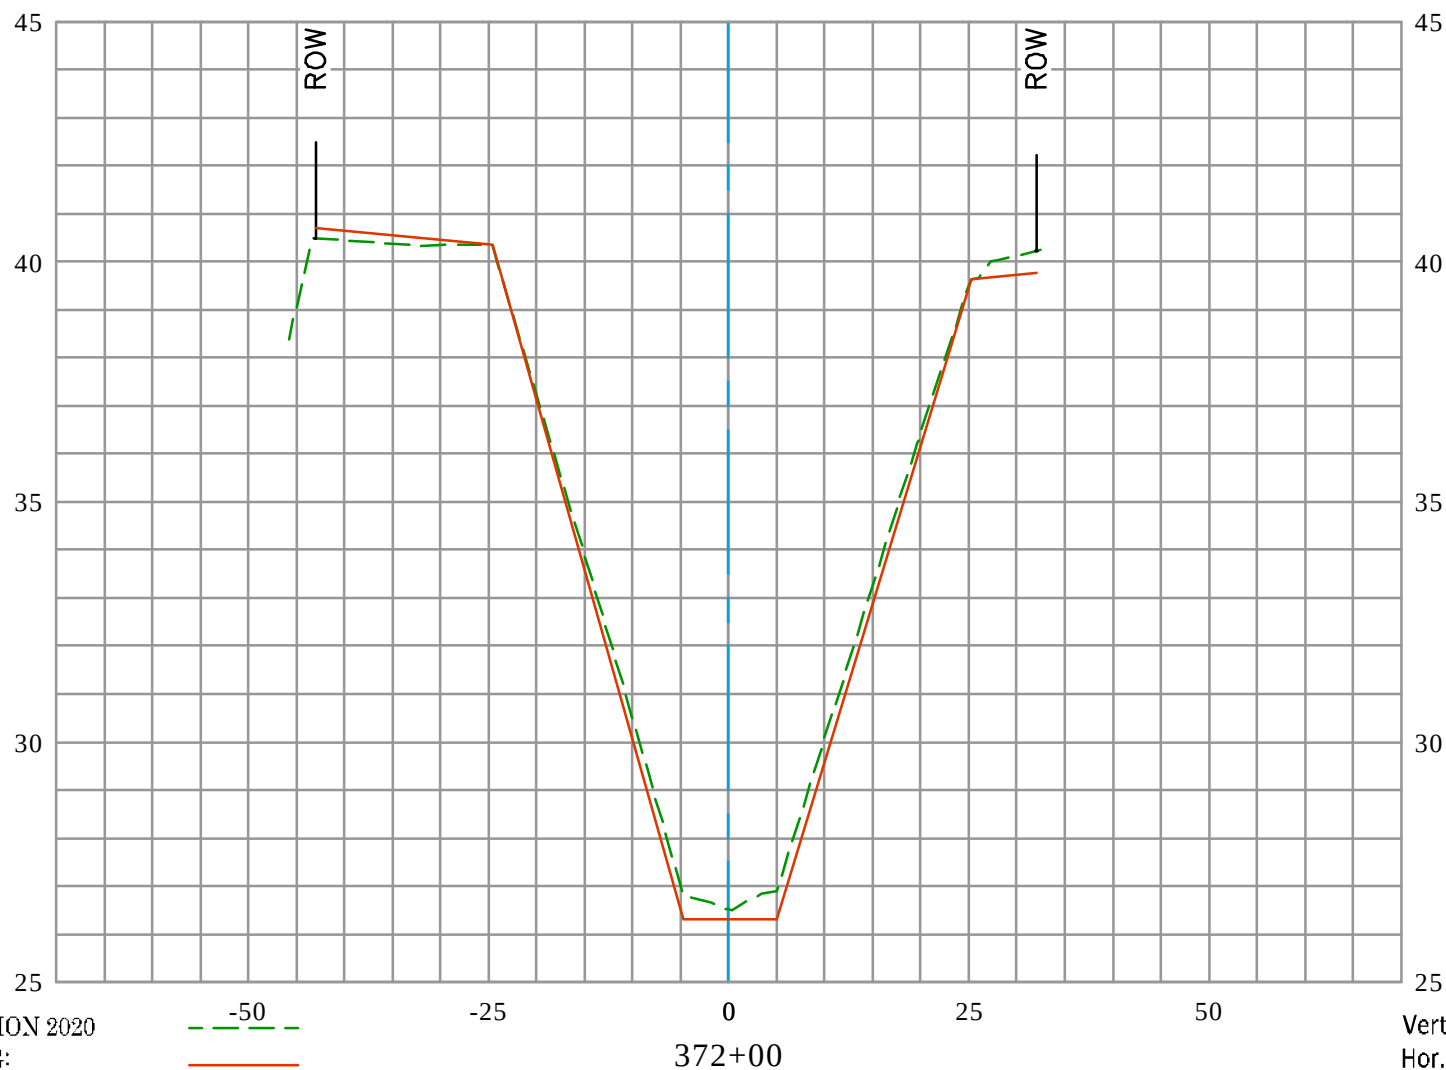

EXISTING CONDITION 2020
 RECORD DRAWING:
 D03-101-2A, D03-101-3A, & D03-101-7R
 DATE PREPARED: 01/24/2022




GREENVILLE BANNING CHANNEL (D03) CL

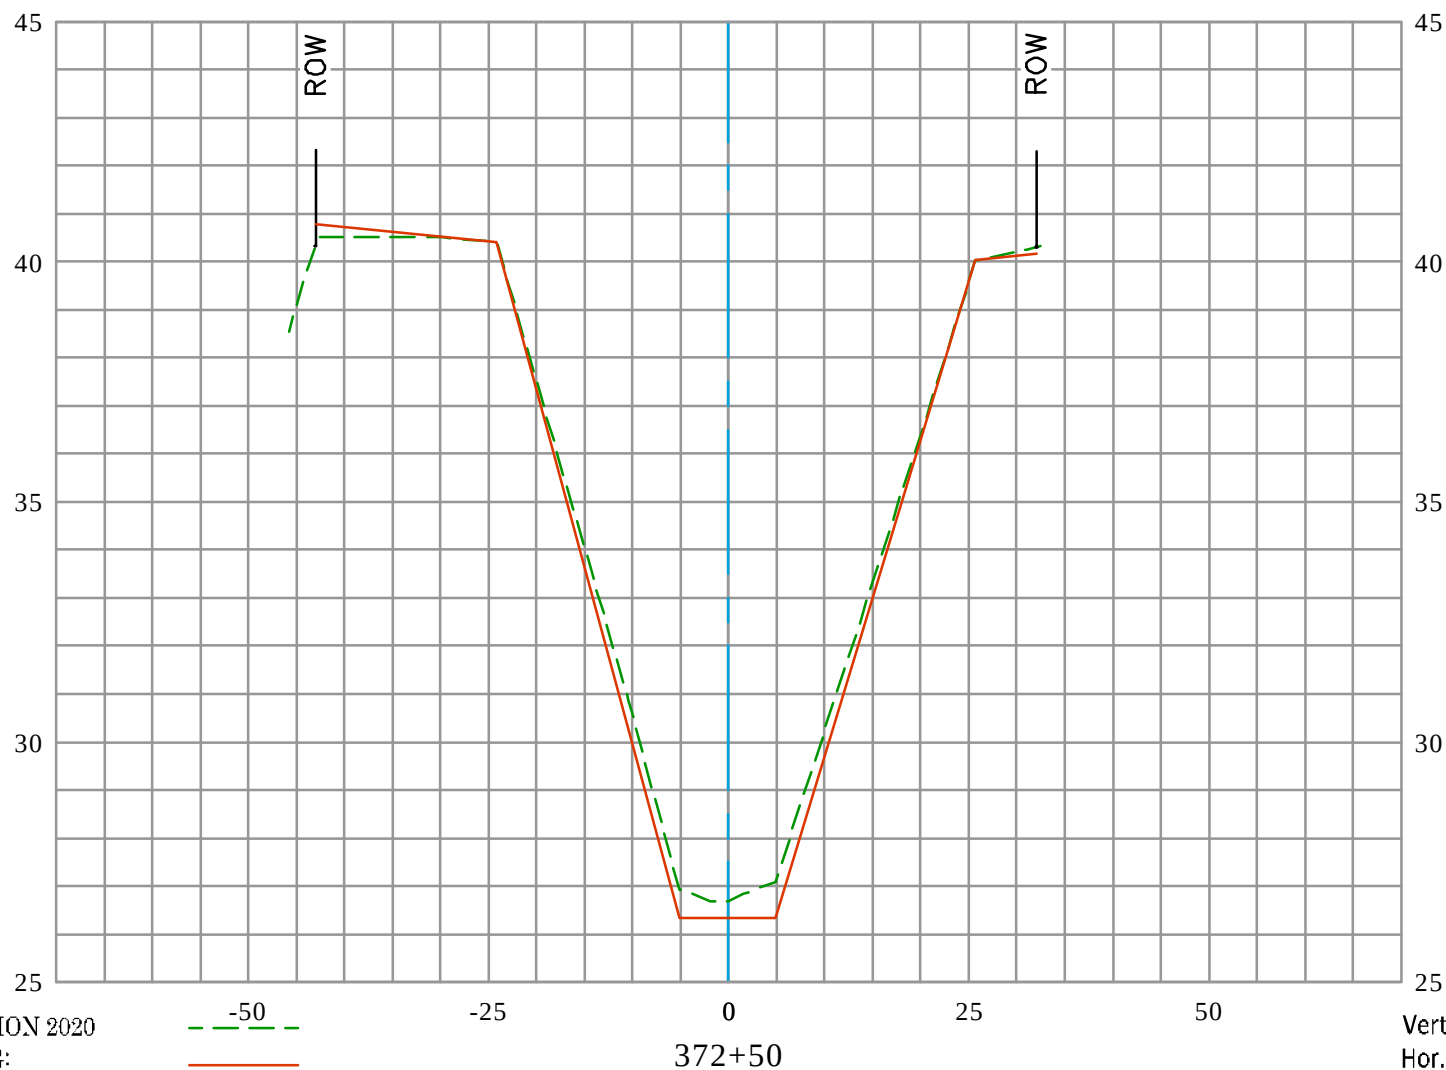

EXISTING CONDITION 2020
 RECORD DRAWING:
 D03-101-2A, D03-101-3A, & D03-101-7R
 DATE PREPARED: 01/24/2022



GREENVILLE BANNING CHANNEL (D03) CL

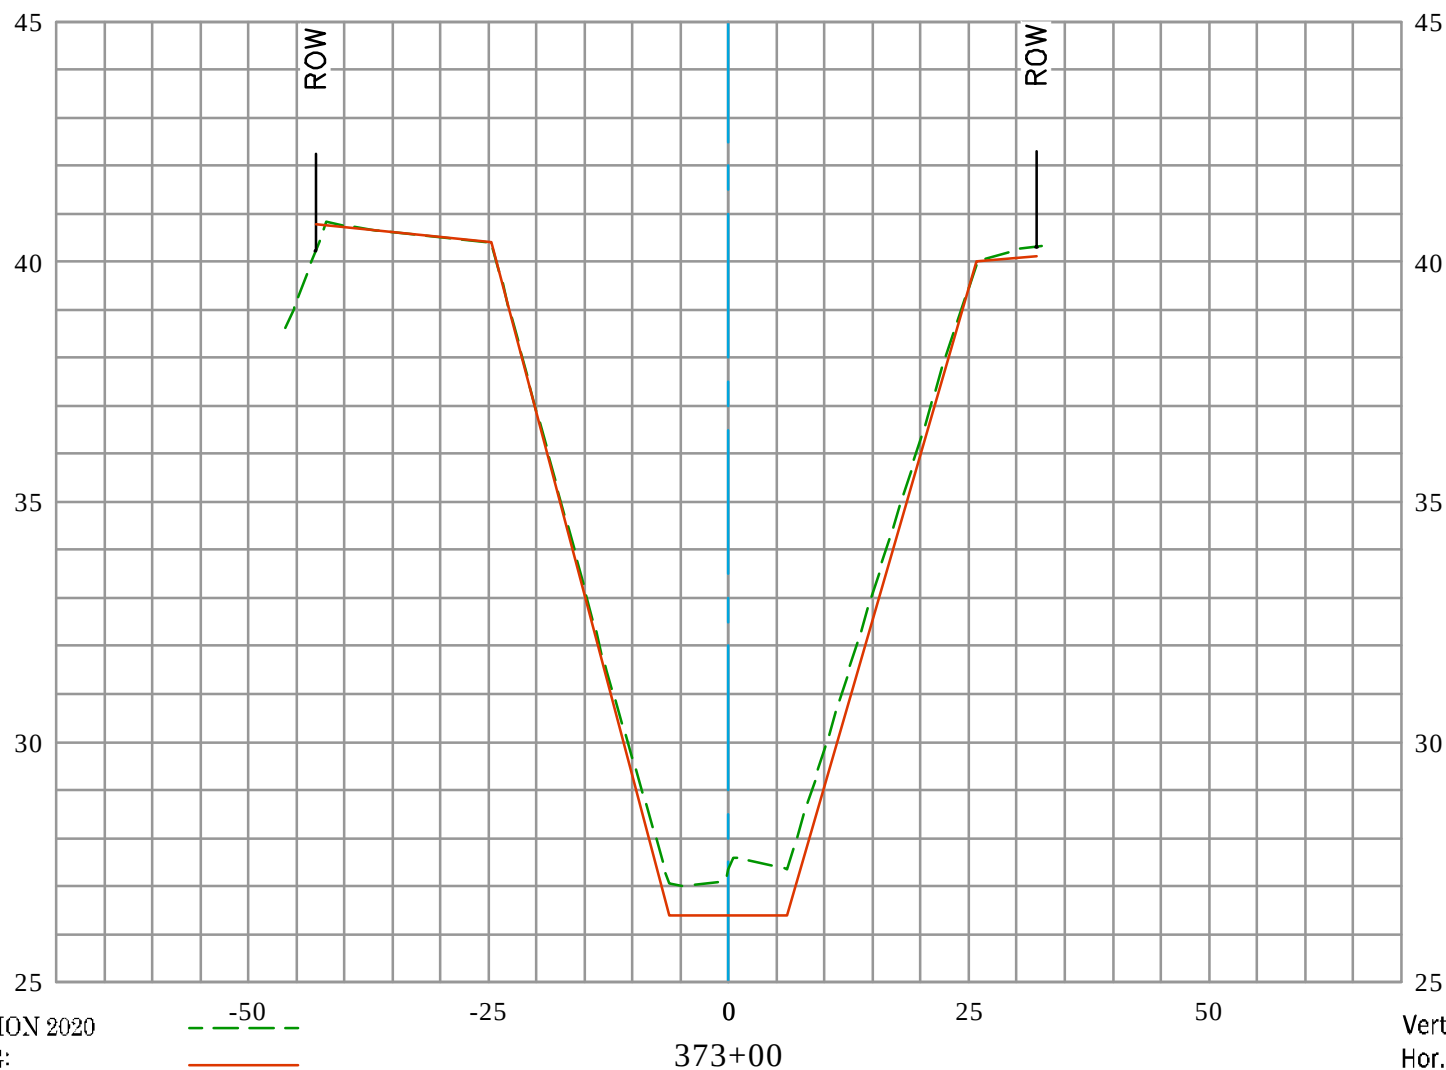


EXISTING CONDITION 2020
 RECORD DRAWING:
 D03-101-2A, D03-101-3A, & D03-101-7R
 DATE PREPARED: 01/24/2022

Vert. Scale: 1" = 4'
 Hor. Scale: 1" = 20'




GREENVILLE BANNING CHANNEL (D03) CL

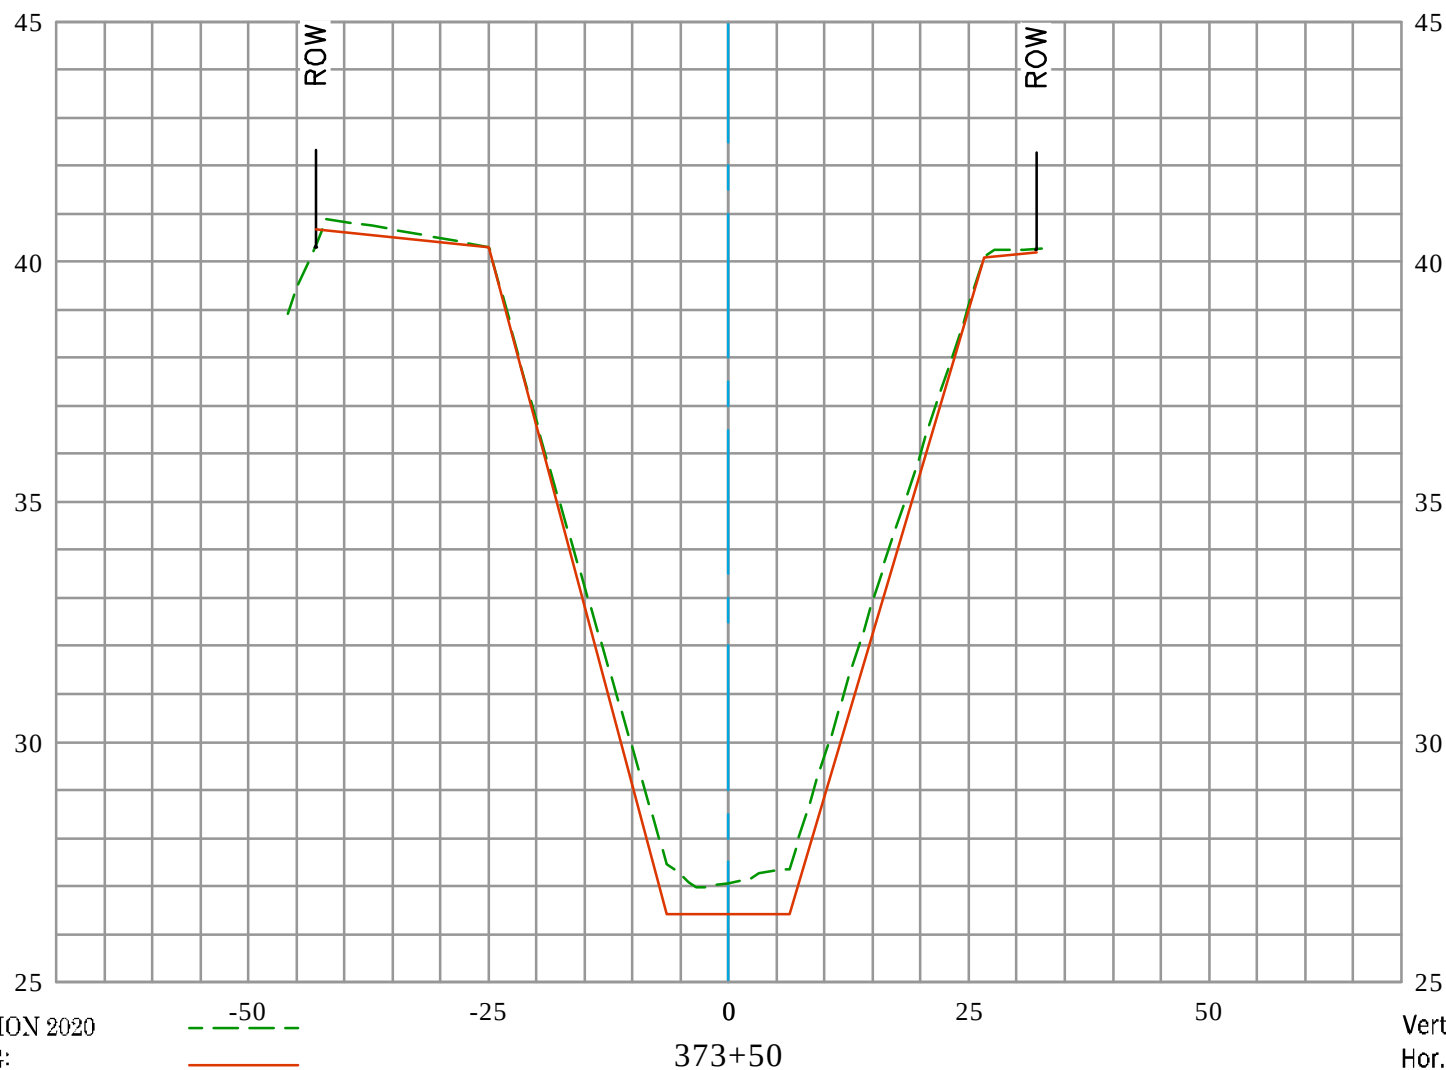

EXISTING CONDITION 2020
 RECORD DRAWING:
 D03-101-2A, D03-101-3A, & D03-101-7R
 DATE PREPARED: 01/24/2022




GREENVILLE BANNING CHANNEL (D03) CL

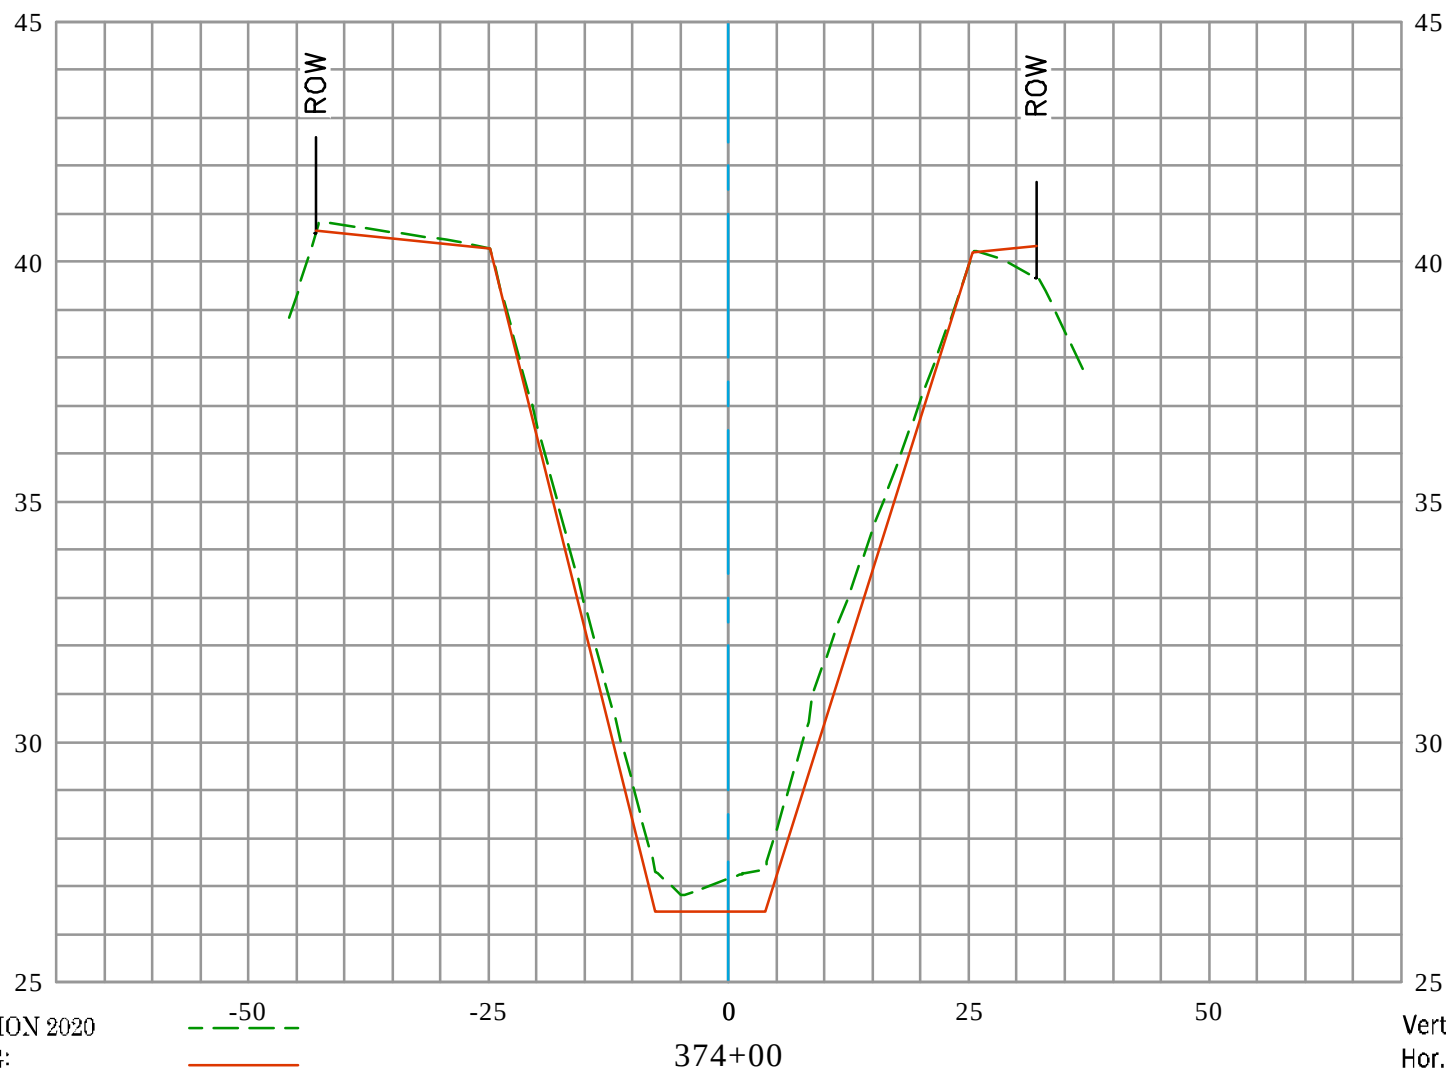


EXISTING CONDITION 2020
 RECORD DRAWING:
 D03-101-2A, D03-101-3A, & D03-101-7R
 DATE PREPARED: 01/24/2022

**U.S. Survey
Foot**

OC Public Works
OC Survey/Field Services
Boundary Analysis & Mapping

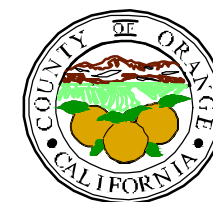

GREENVILLE BANNING CHANNEL (D03) CL

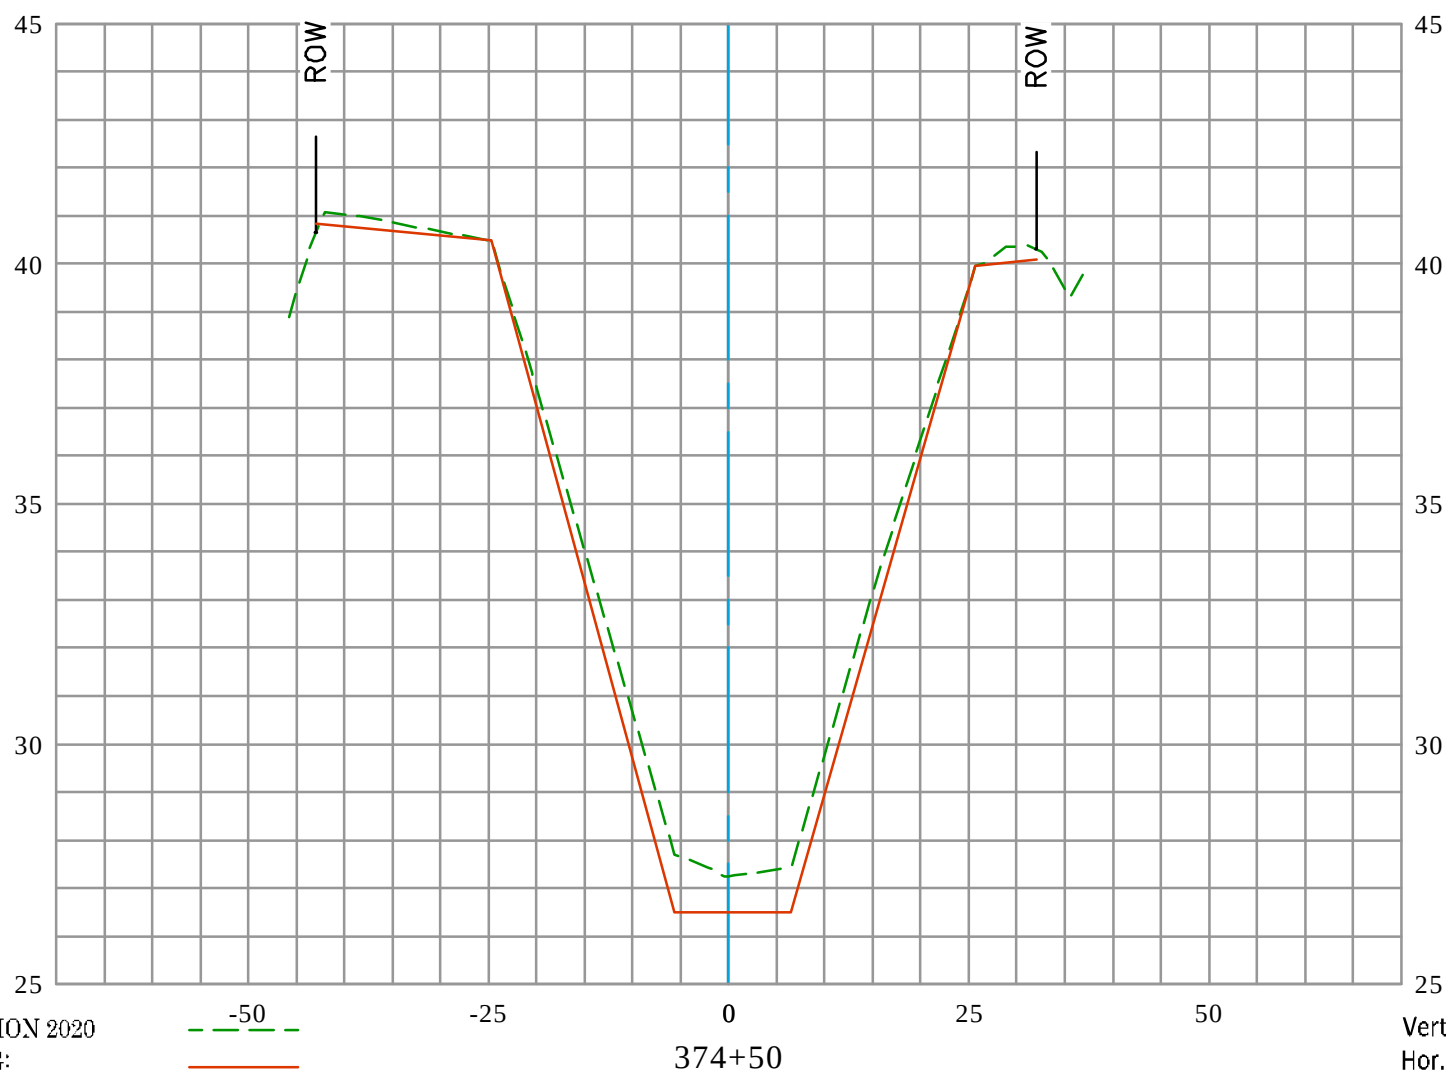


EXISTING CONDITION 2020
RECORD DRAWING:
D03-101-2A, D03-101-3A, & D03-101-7R
DATE PREPARED: 01/24/2022

Vert. Scale: 1" = 4'
Hor. Scale: 1" = 20'




GREENVILLE BANNING CHANNEL (D03) CL

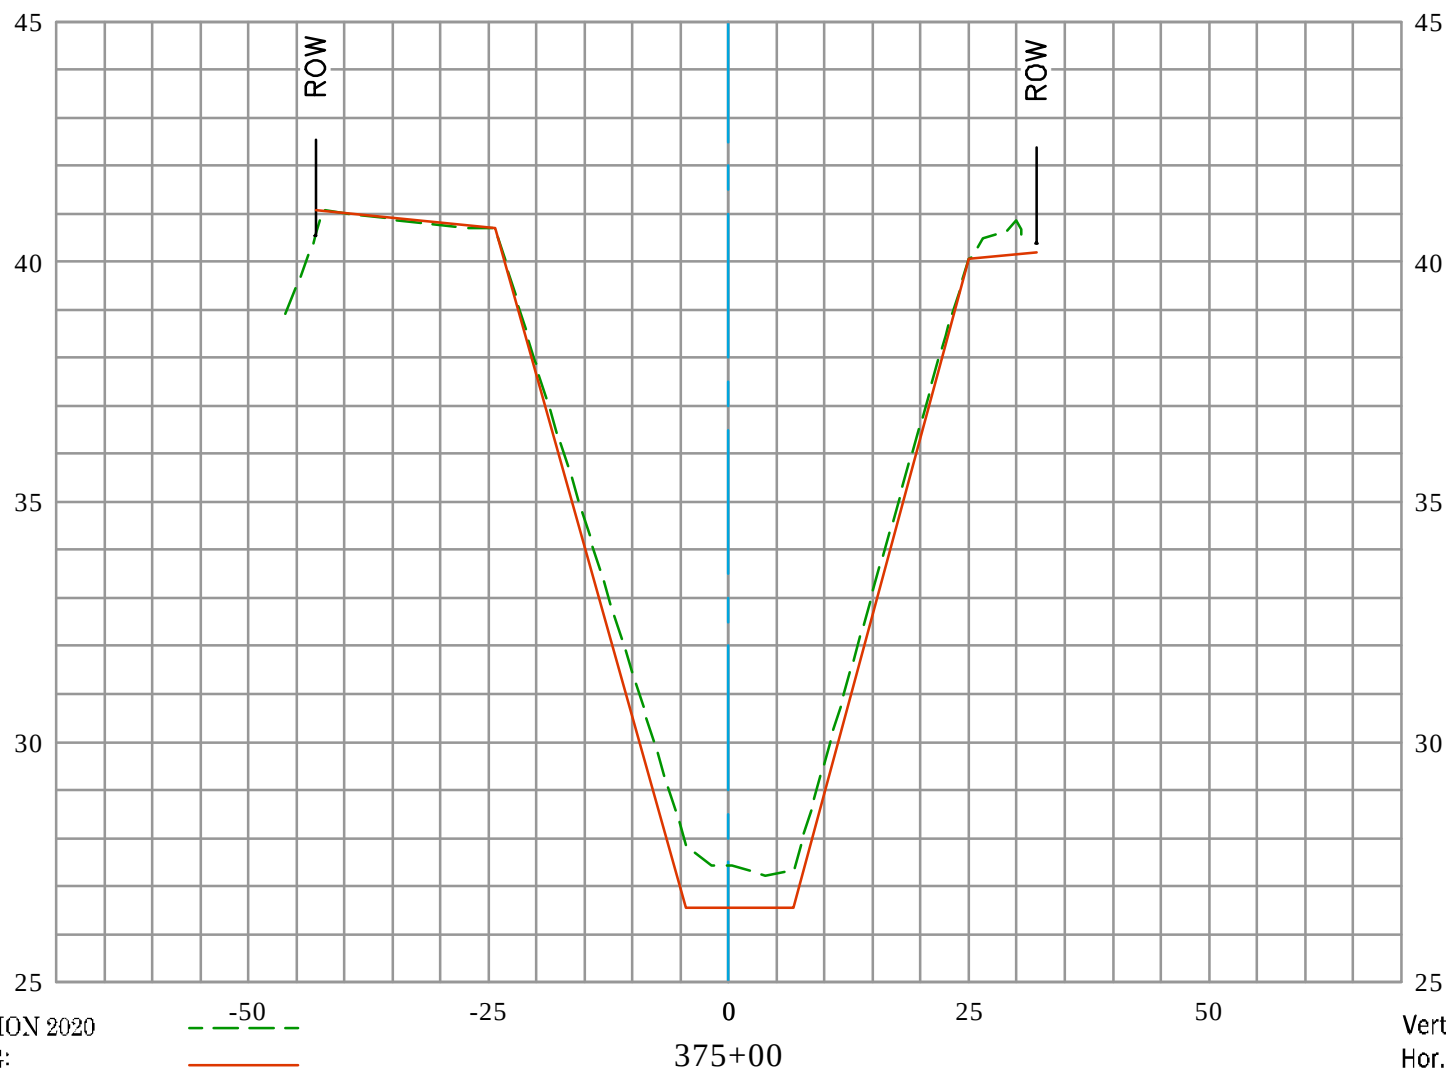

EXISTING CONDITION 2020
 RECORD DRAWING:
 D03-101-2A, D03-101-3A, & D03-101-7R
 DATE PREPARED: 01/24/2022




GREENVILLE BANNING CHANNEL (D03) CL

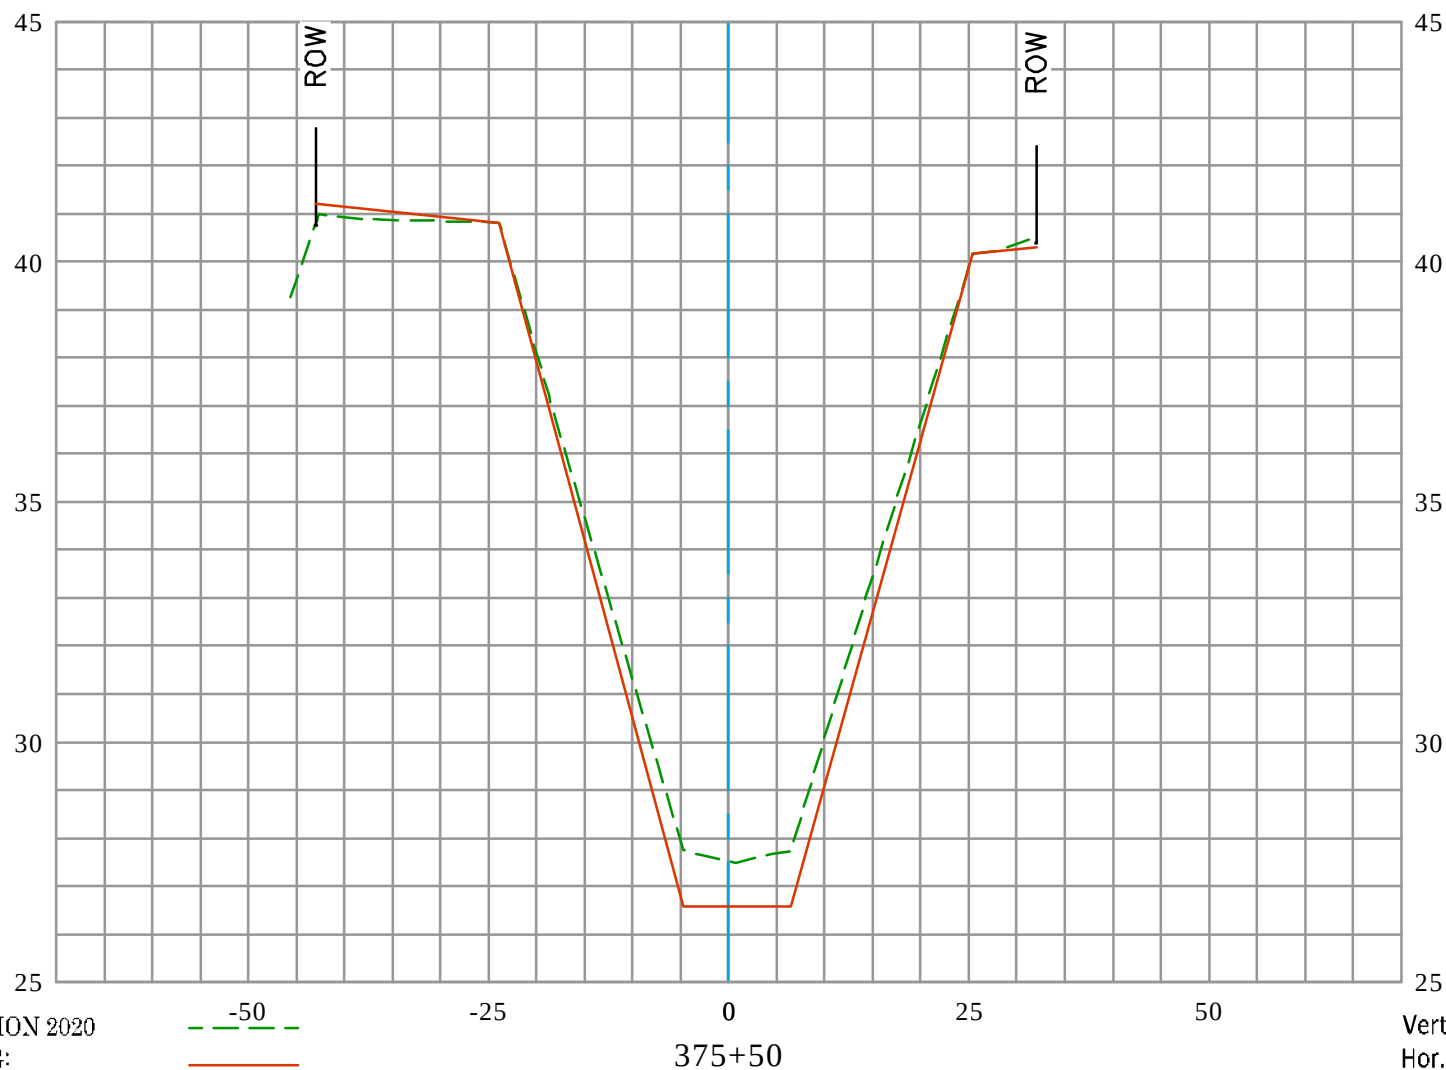

EXISTING CONDITION 2020
 RECORD DRAWING:
 D03-101-2A, D03-101-3A, & D03-101-7R
 DATE PREPARED: 01/24/2022




GREENVILLE BANNING CHANNEL (D03) CL

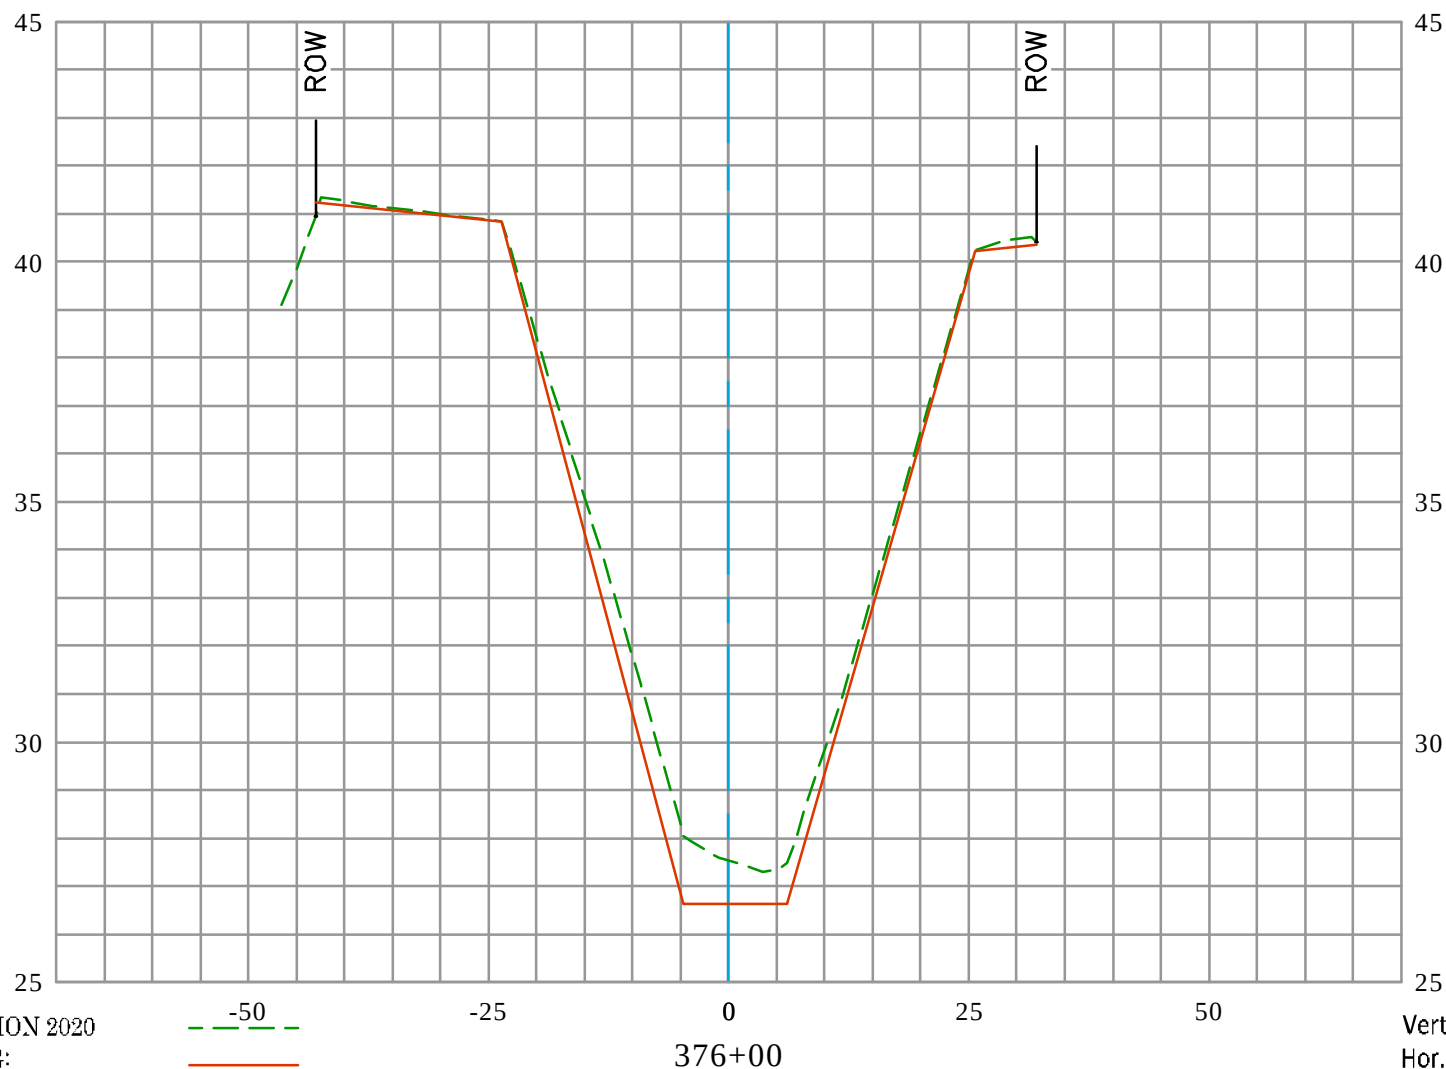




GREENVILLE BANNING CHANNEL (D03) CL

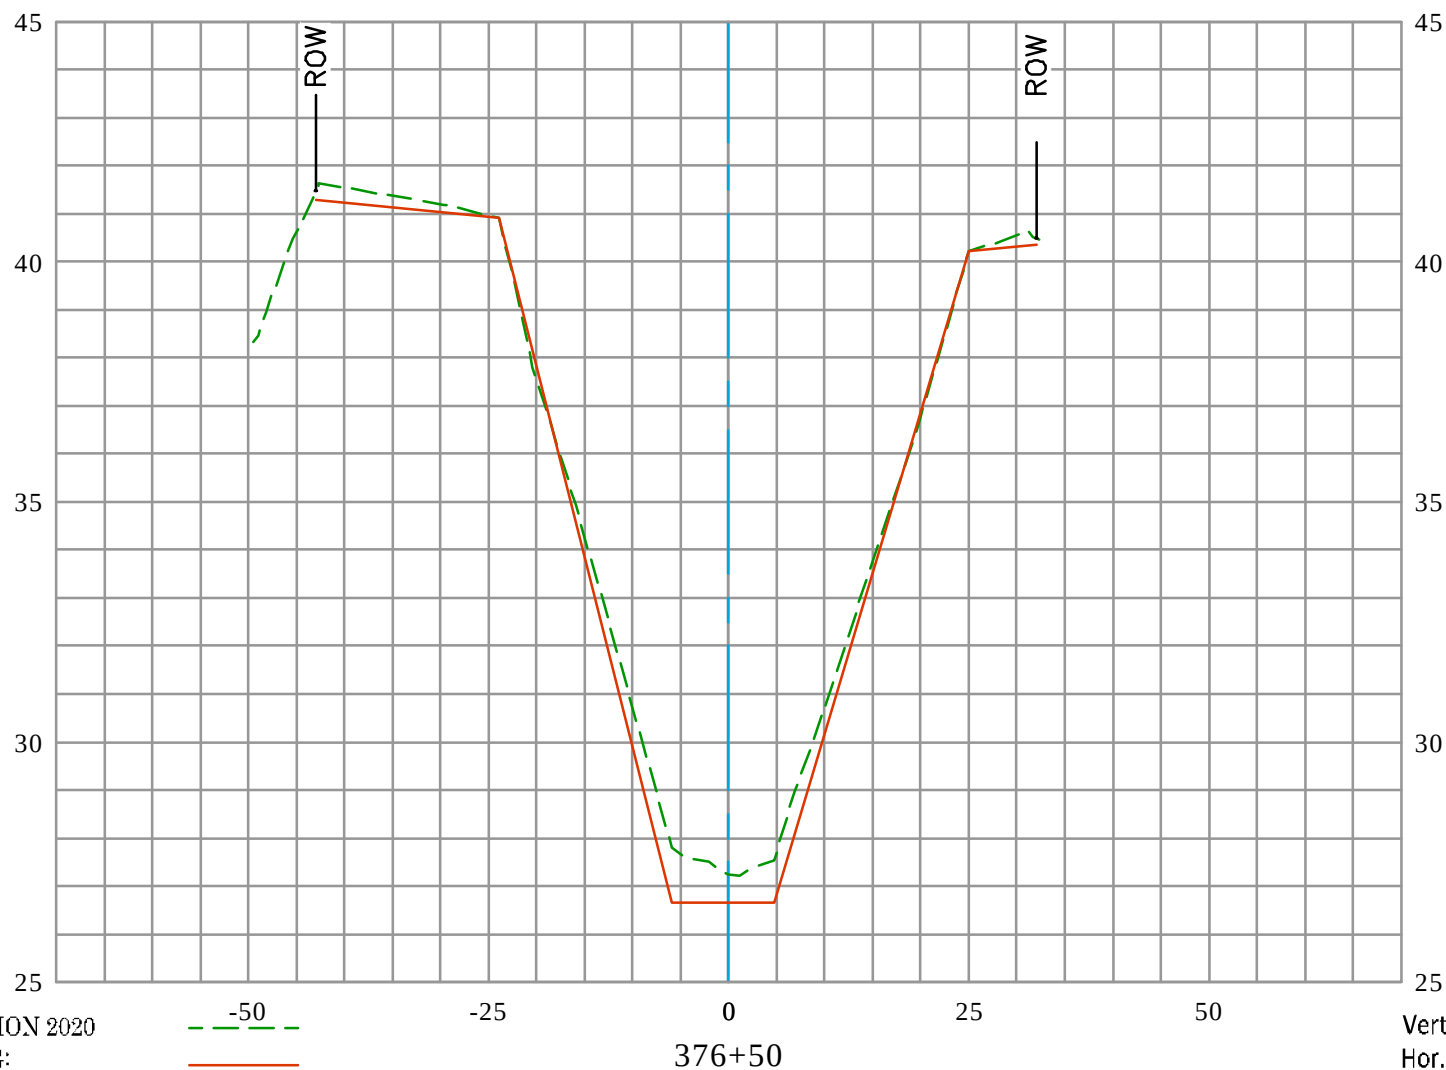



GREENVILLE BANNING CHANNEL (D03) CL

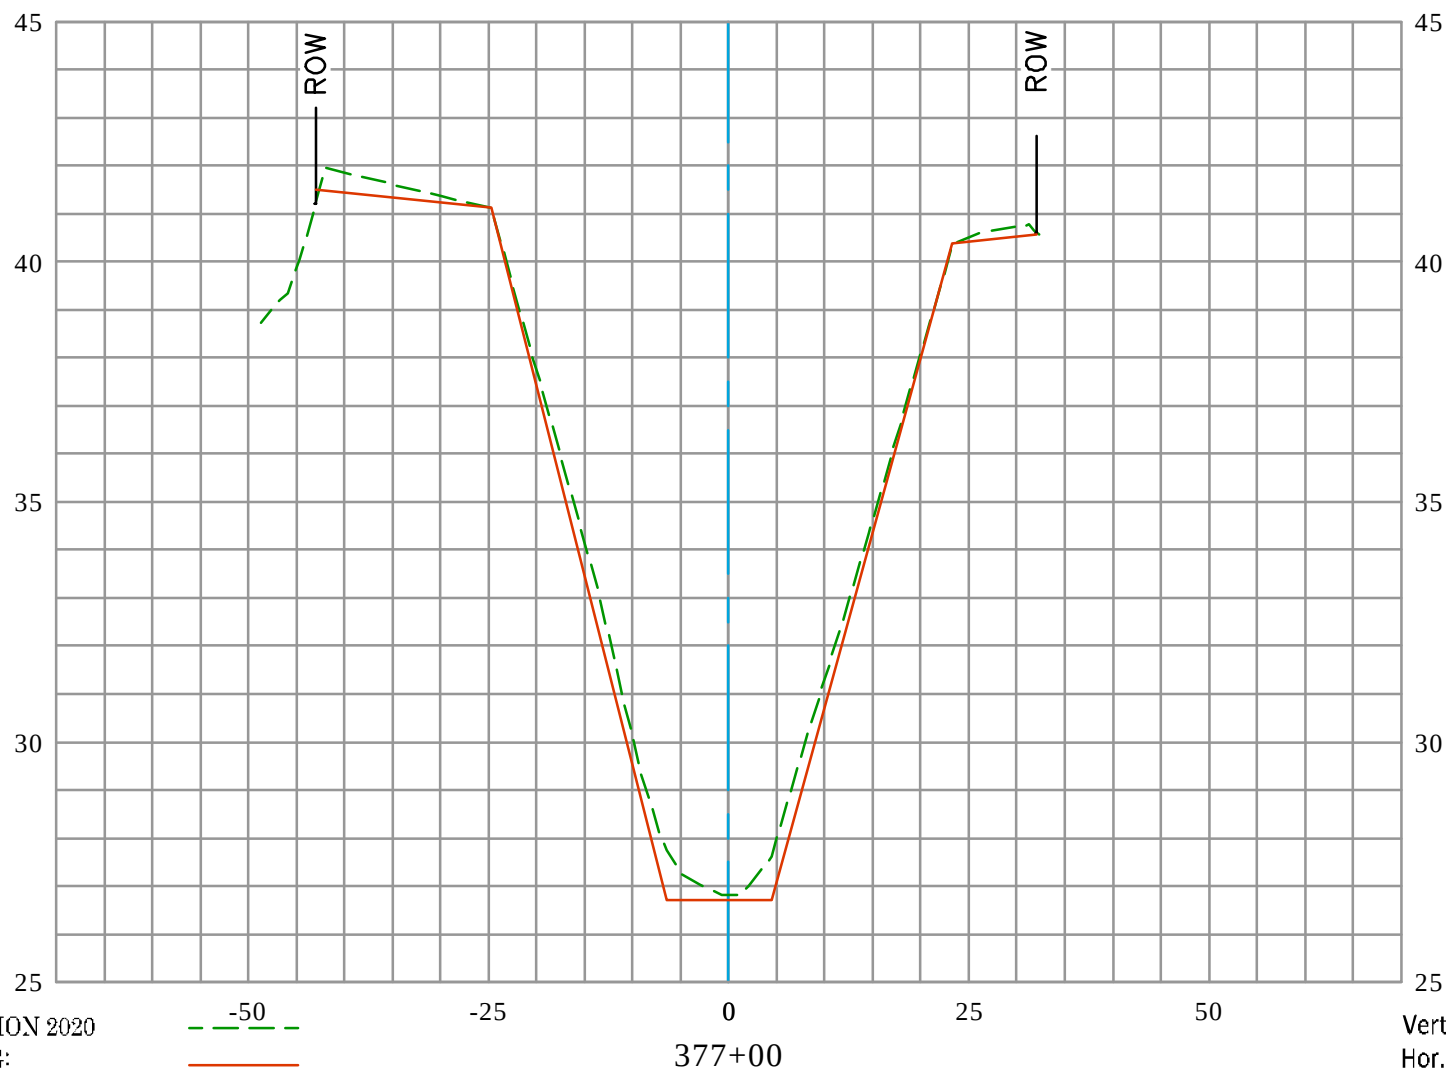


EXISTING CONDITION 2020
 RECORD DRAWING:
 D03-101-2A, D03-101-3A, & D03-101-7R
 DATE PREPARED: 01/24/2022

Vert. Scale: 1" = 4'
 Hor. Scale: 1" = 20'




GREENVILLE BANNING CHANNEL (D03) CL

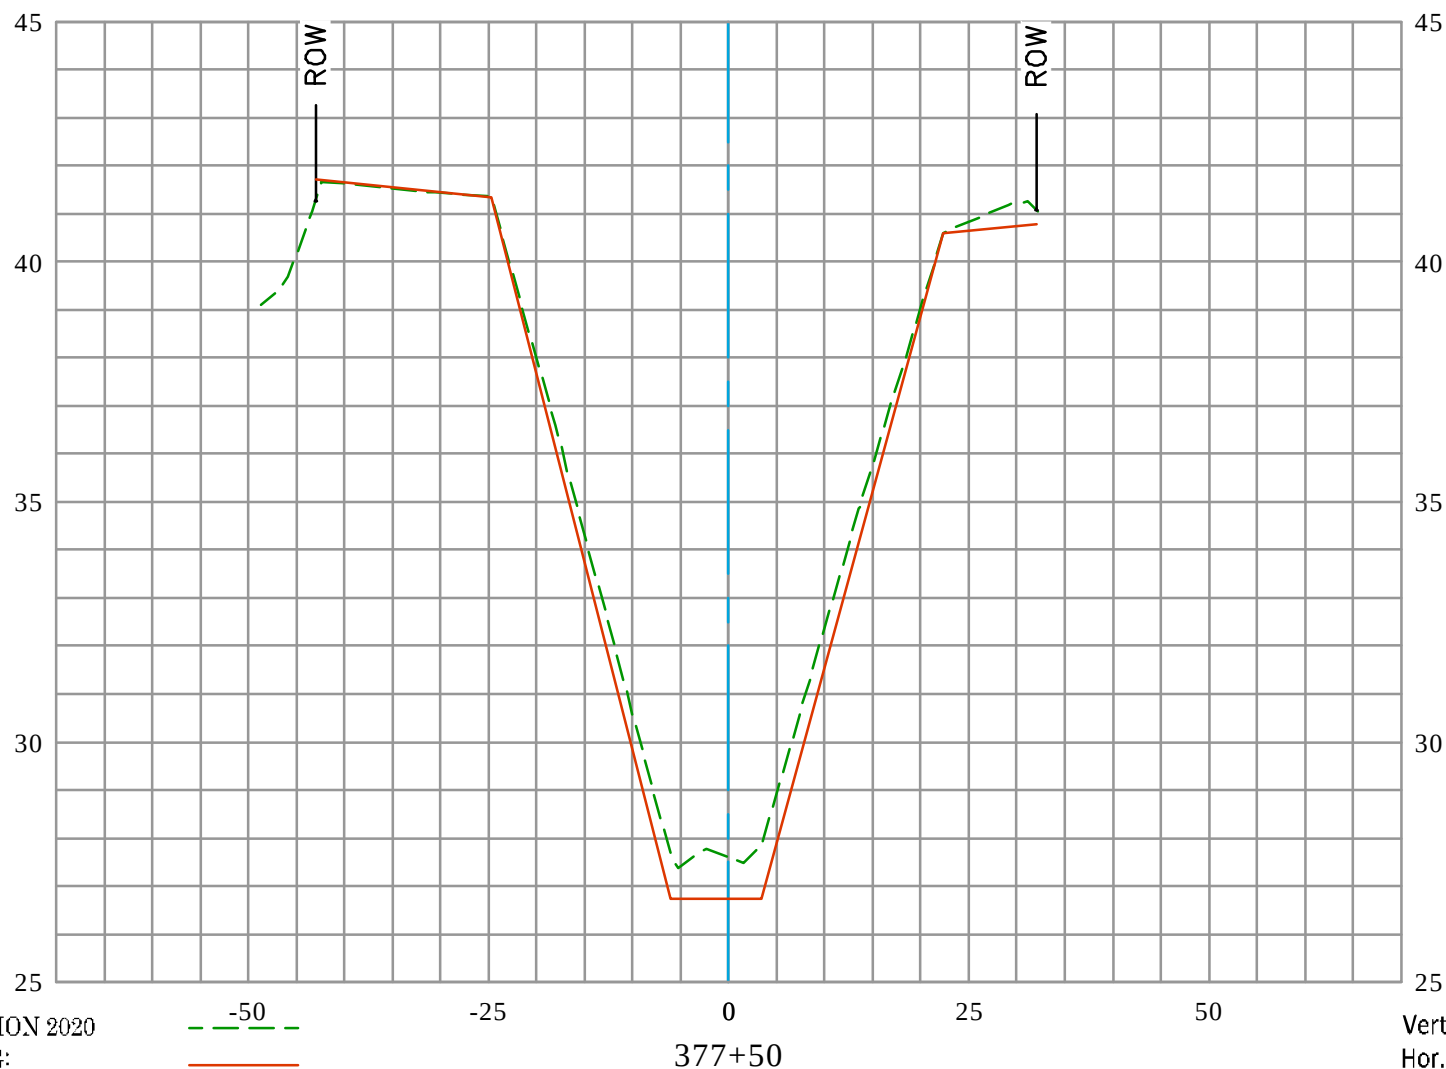

EXISTING CONDITION 2020
 RECORD DRAWING:
 D03-101-2A, D03-101-3A, & D03-101-7R
 DATE PREPARED: 01/24/2022



GREENVILLE BANNING CHANNEL (D03) CL

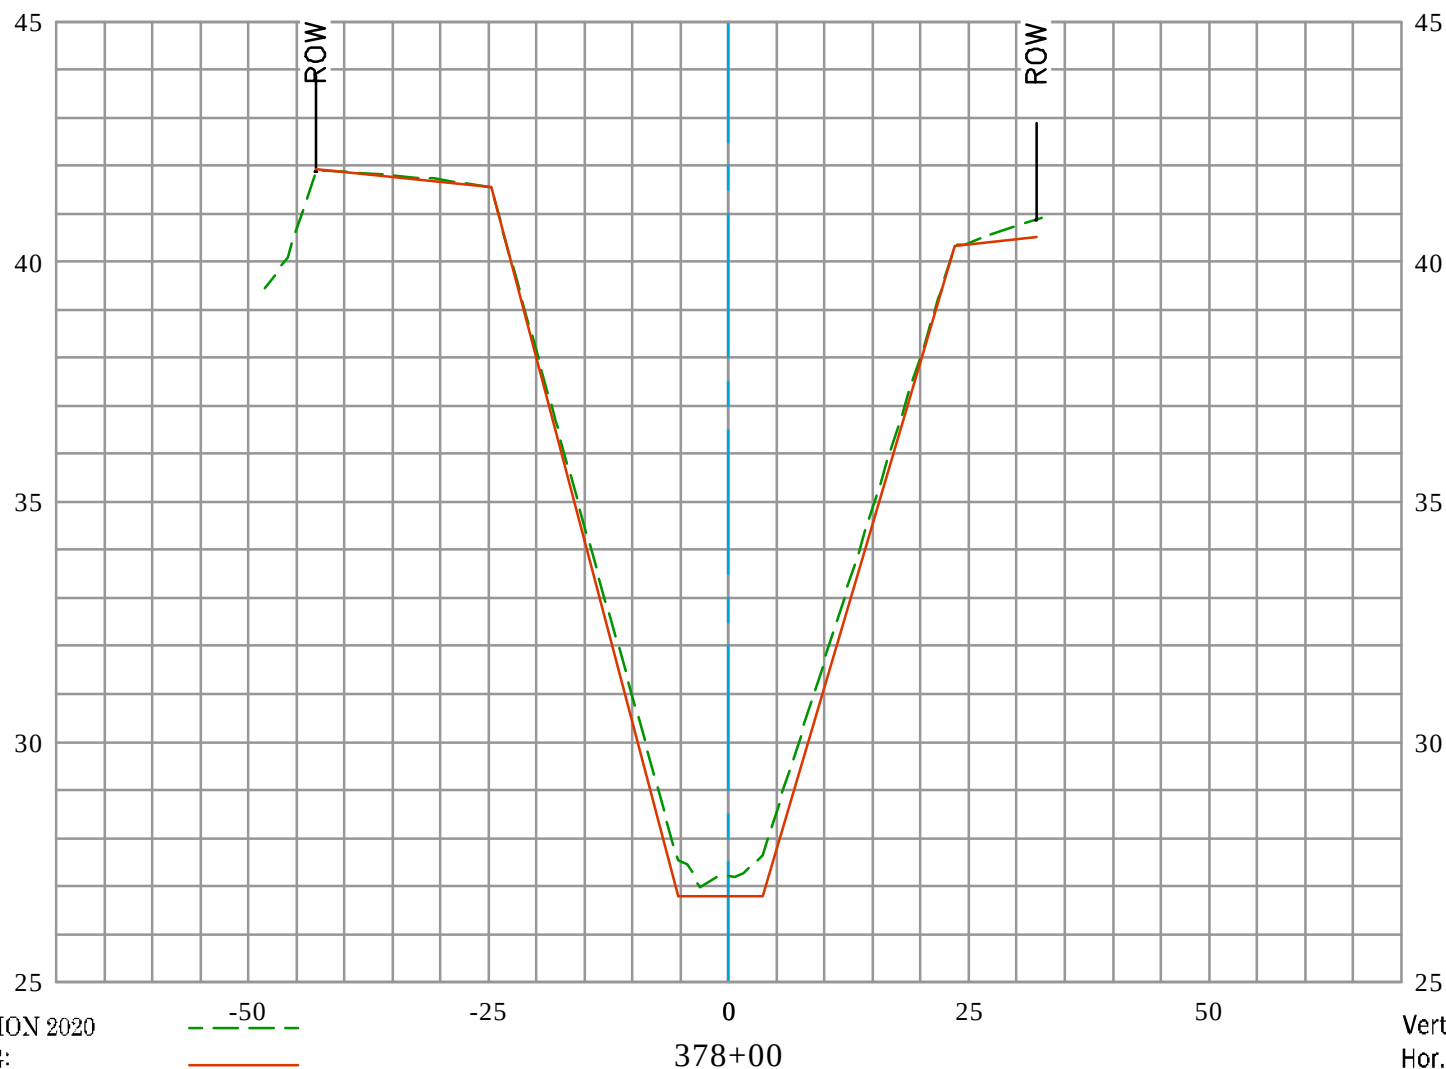



EXISTING CONDITION 2020
 RECORD DRAWING:
 D03-101-2A, D03-101-3A, & D03-101-7R
 DATE PREPARED: 01/24/2022

Vert. Scale: 1" = 4'
 Hor. Scale: 1" = 20'

U.S. Survey Foot

OC Public Works
OC Survey/Field Services
Boundary Analysis & Mapping


GREENVILLE BANNING CHANNEL (D03) CL

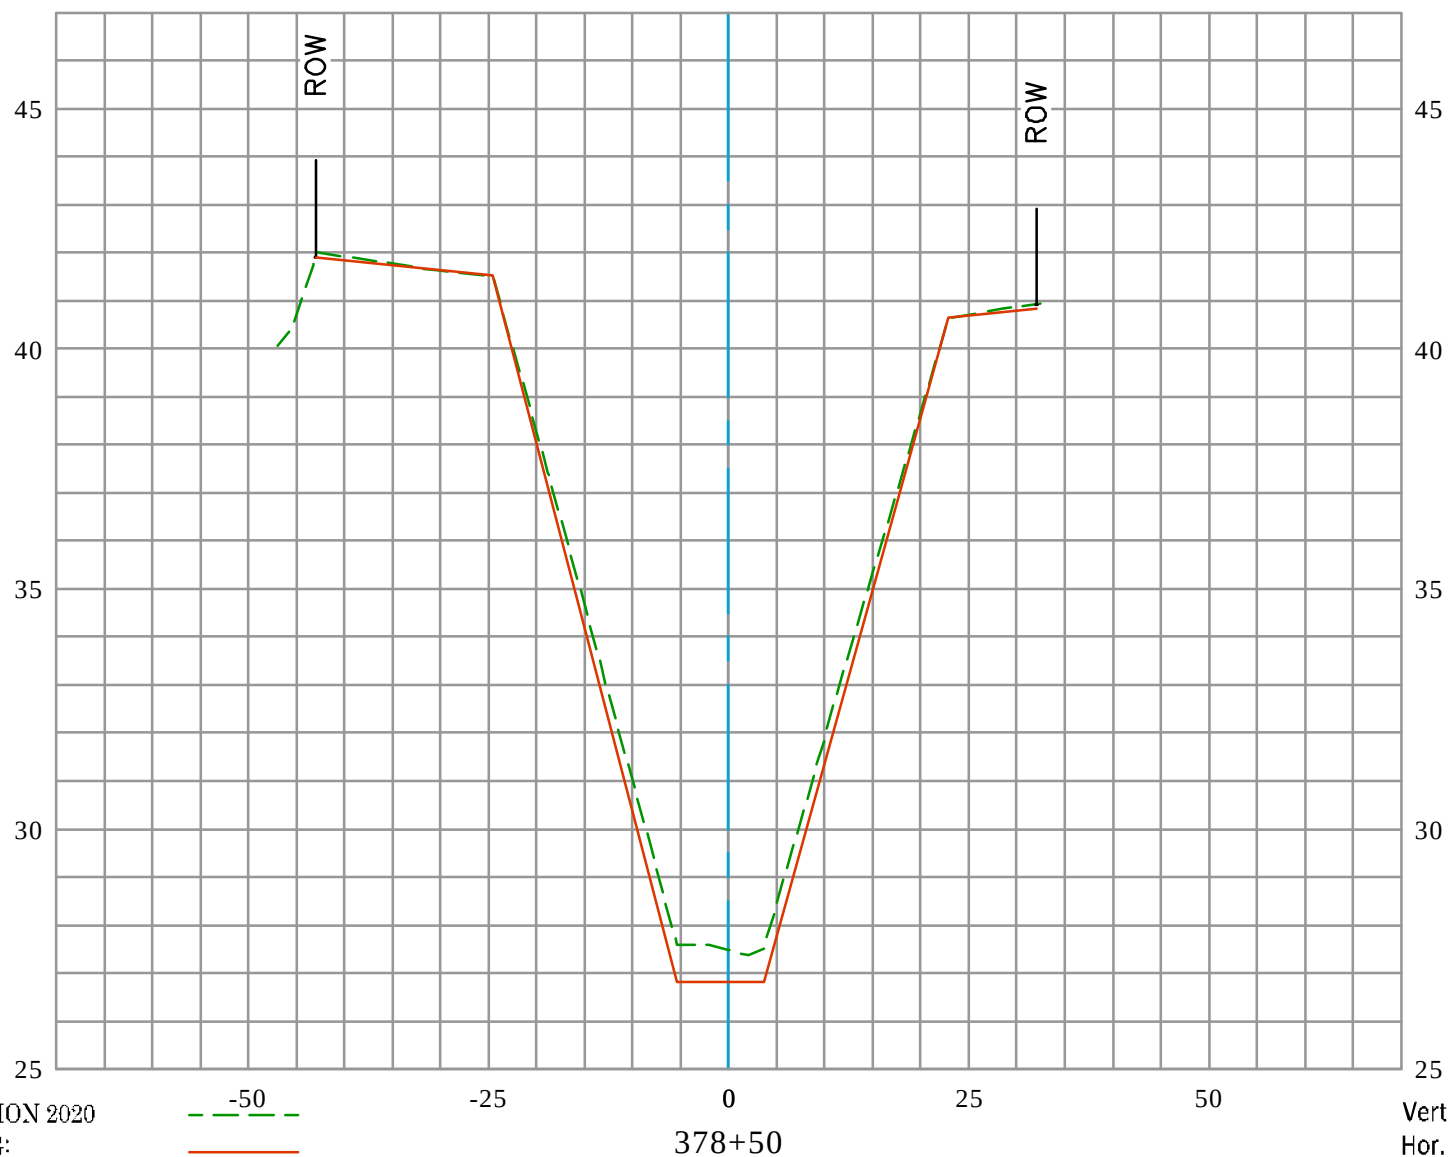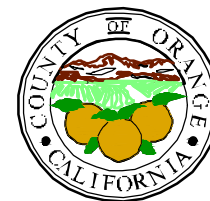

U.S. Survey Foot

OC Public Works
OC Survey/Field Services
Boundary Analysis & Mapping


GREENVILLE BANNING CHANNEL (D03) CL

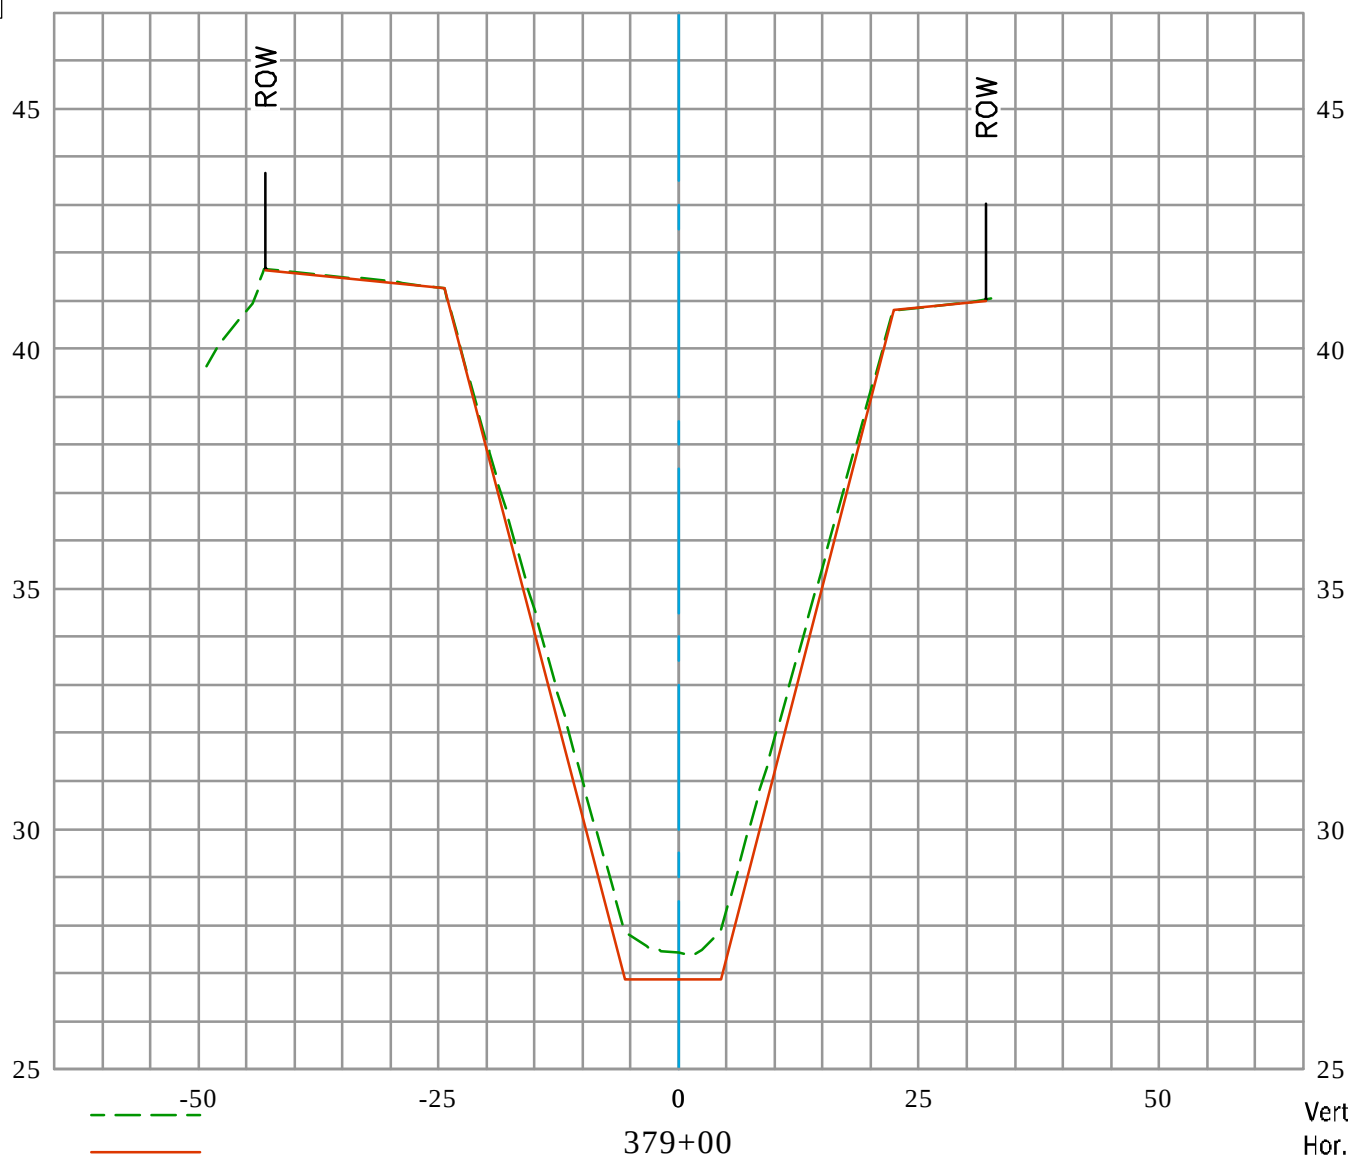

EXISTING CONDITION 2020
RECORD DRAWING:
D03-101-2A, D03-101-3A, & D03-101-7R
DATE PREPARED: 01/24/2022

Vert. Scale: 1" = 4'
Hor. Scale: 1" = 20'


GREENVILLE BANNING CHANNEL (D03) CL

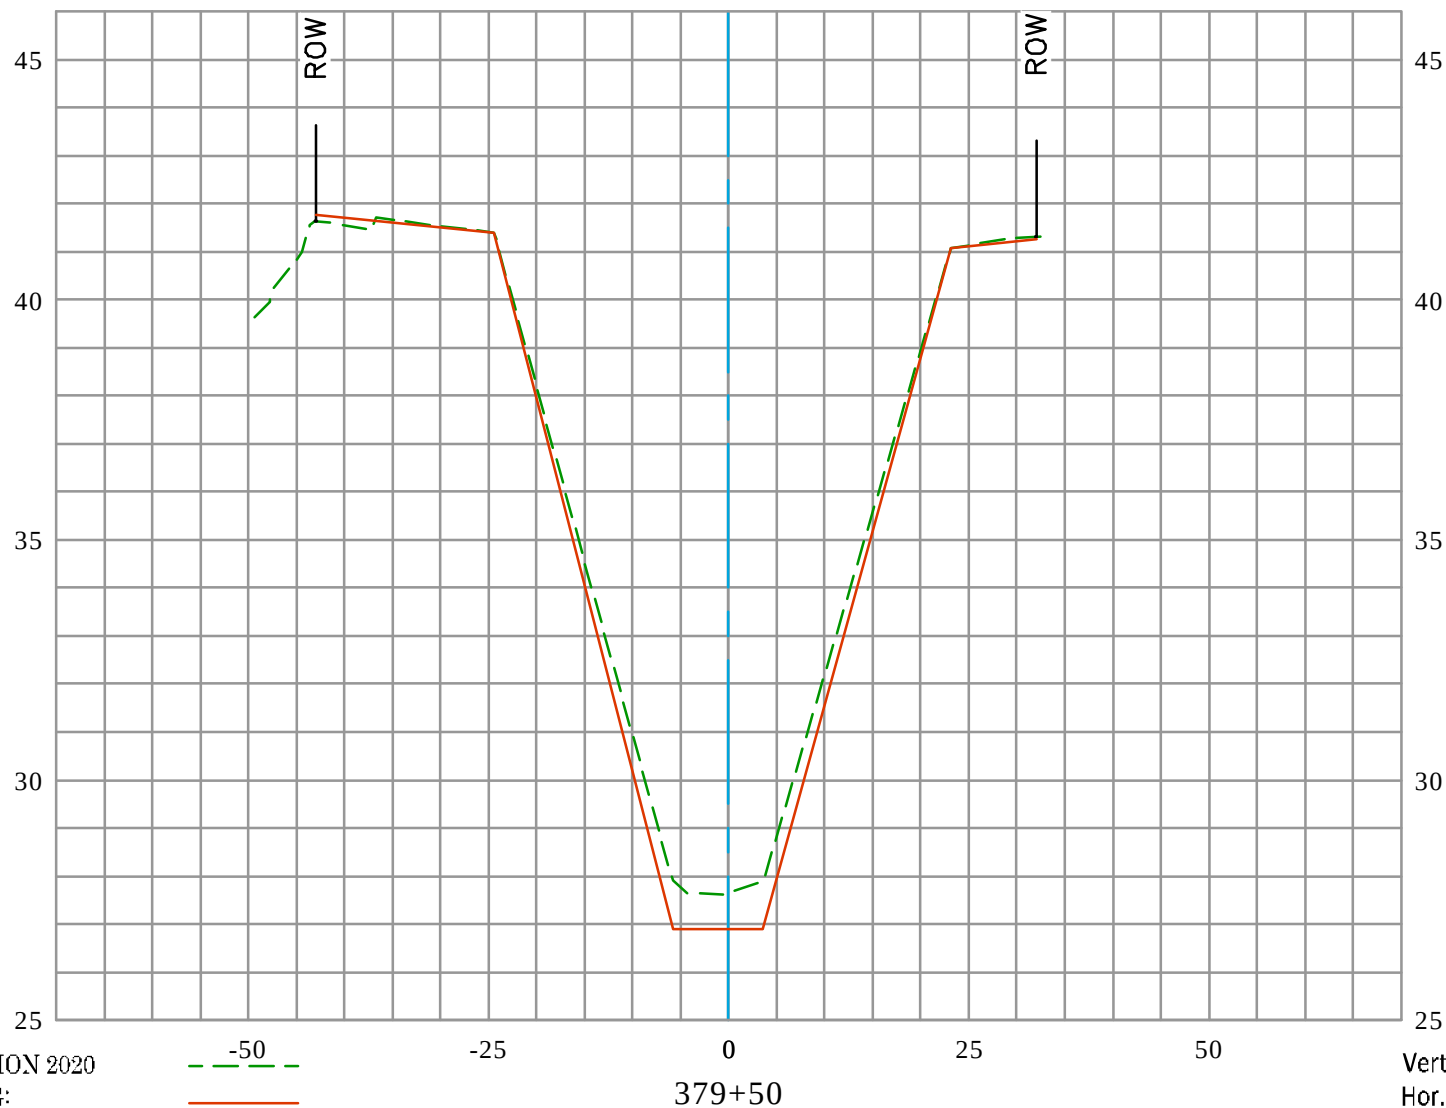

EXISTING CONDITION 2020
 RECORD DRAWING:
 D03-101-2A, D03-101-3A, & D03-101-7R
 DATE PREPARED: 01/24/2022

Vert. Scale: 1" = 4'
 Hor. Scale: 1" = 20'


GREENVILLE BANNING CHANNEL (D03) CL

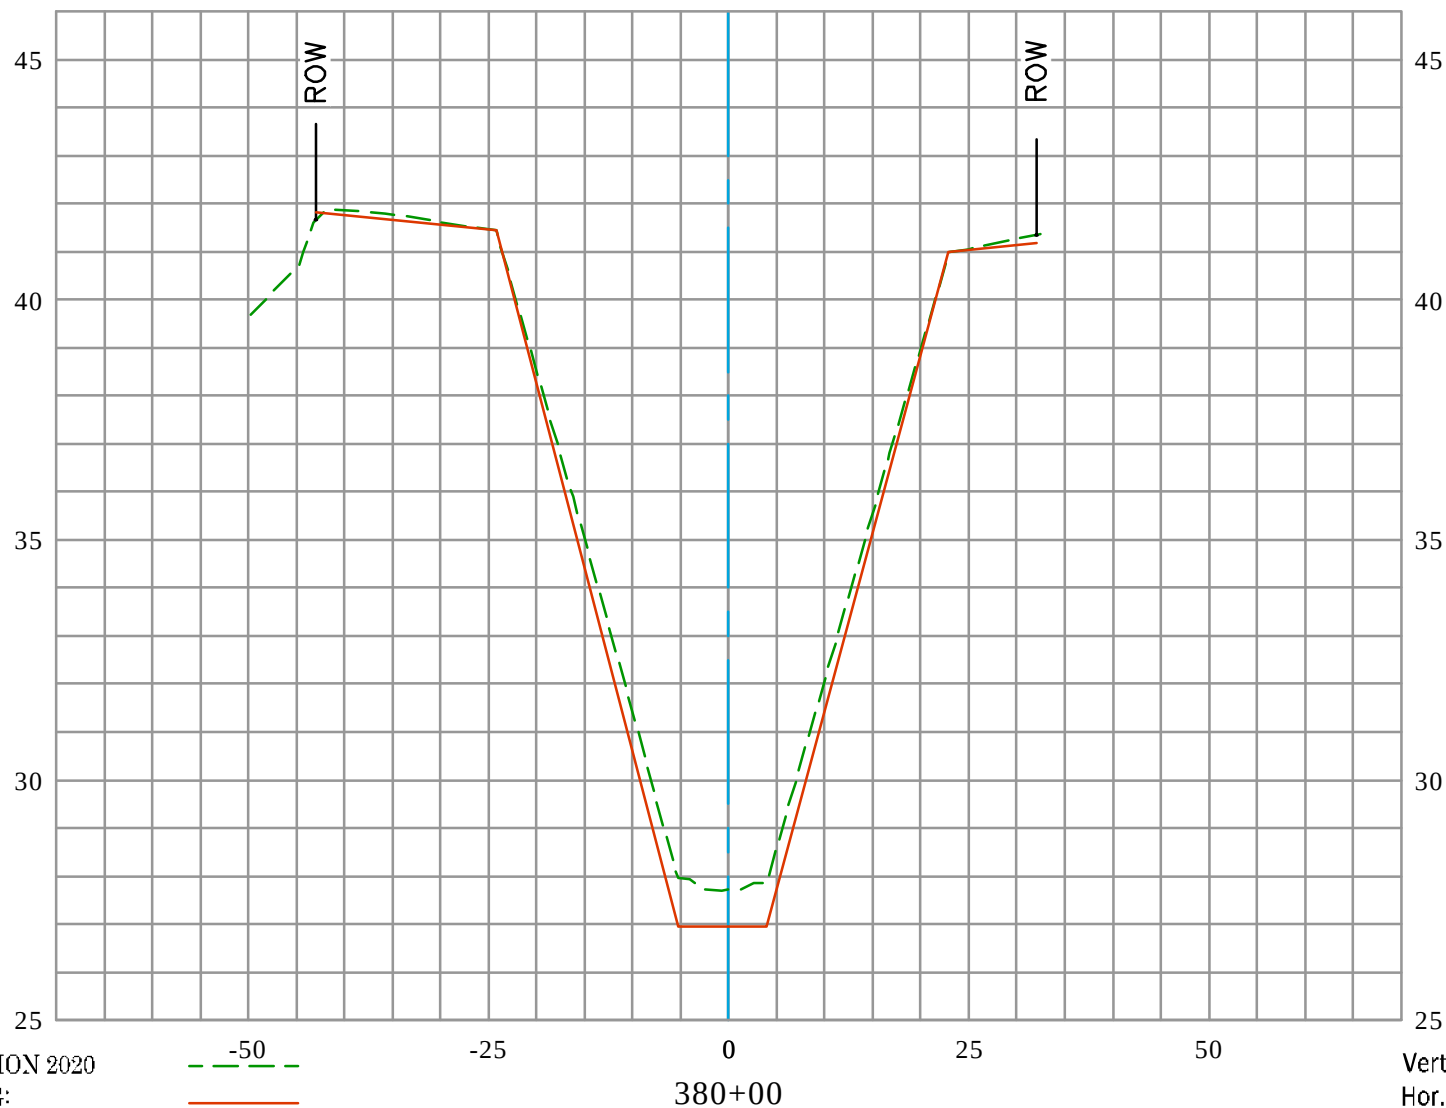

EXISTING CONDITION 2020
 RECORD DRAWING:
 D03-101-2A, D03-101-3A, & D03-101-7R
 DATE PREPARED: 01/24/2022



GREENVILLE BANNING CHANNEL (D03) CL

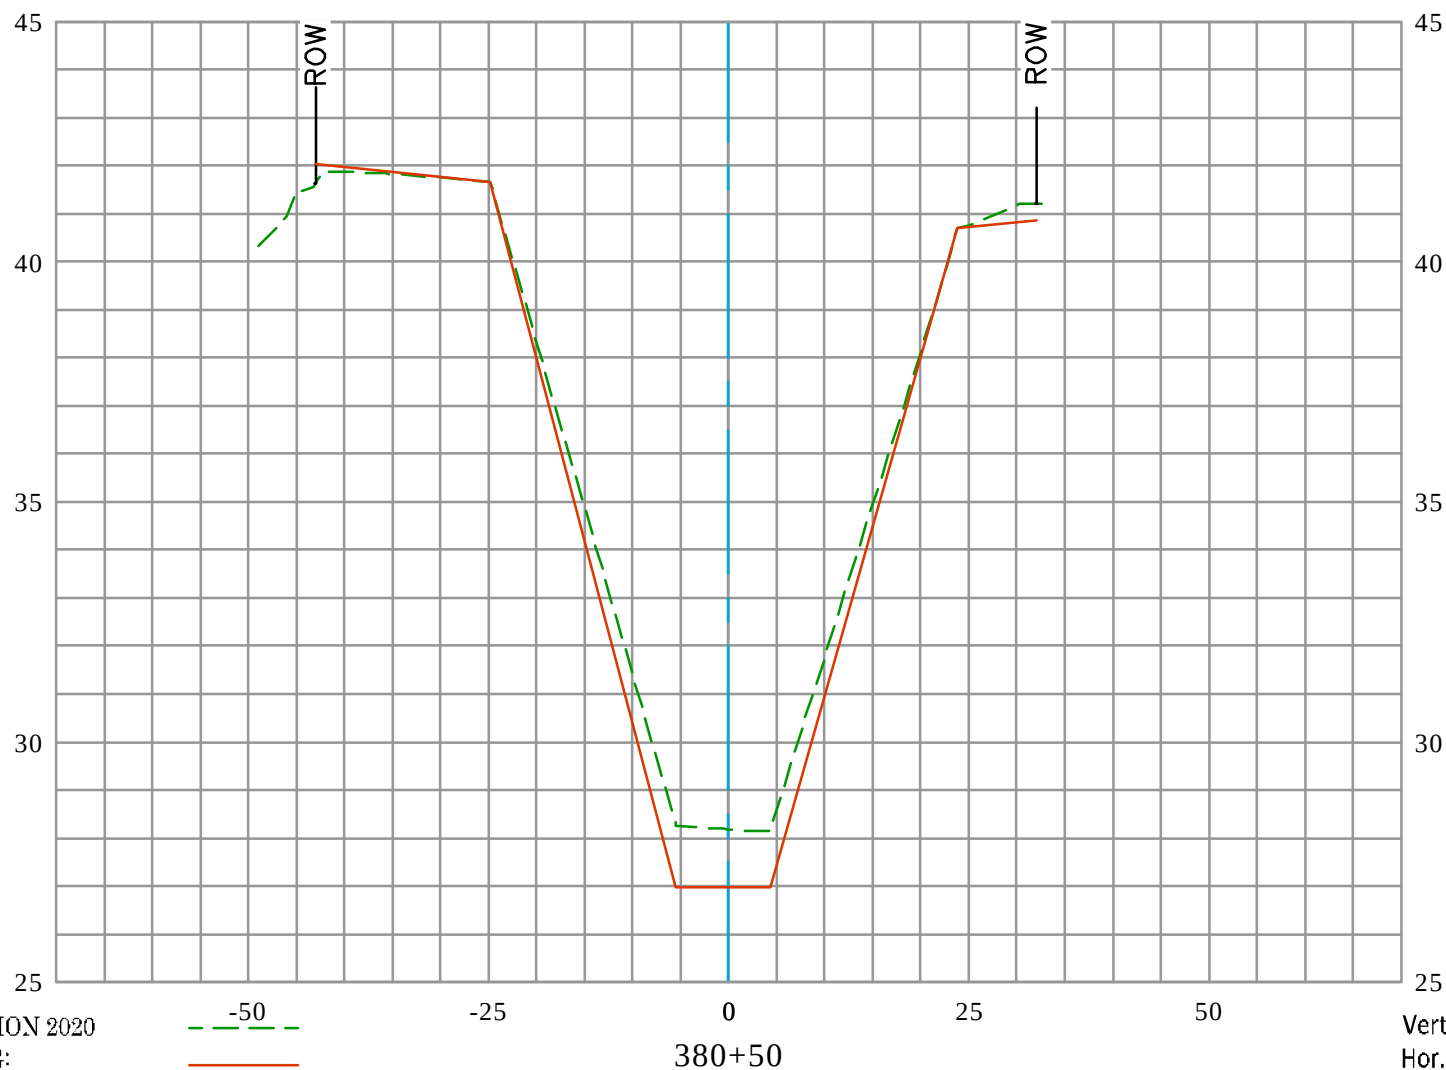


EXISTING CONDITION 2020
 RECORD DRAWING:
 D03-101-2A, D03-101-3A, & D03-101-7R
 DATE PREPARED: 01/24/2022

Vert. Scale: 1" = 4'
 Hor. Scale: 1" = 20'




GREENVILLE BANNING CHANNEL (D03) CL

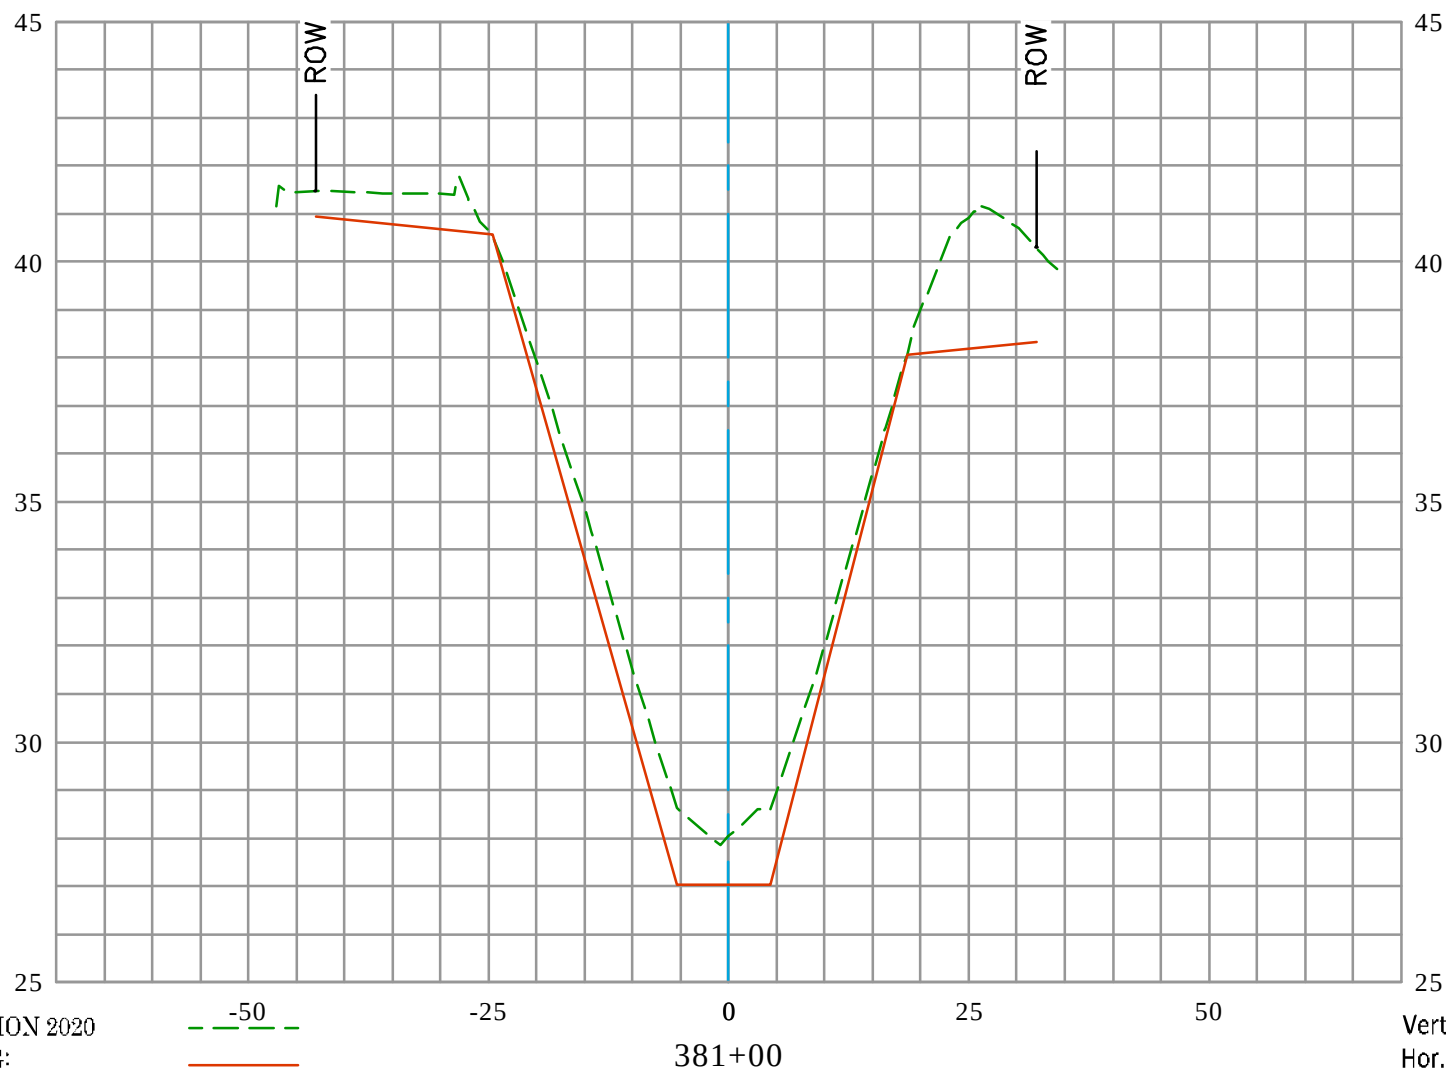

EXISTING CONDITION 2020
 RECORD DRAWING:
 D03-101-2A, D03-101-3A, & D03-101-7R
 DATE PREPARED: 01/24/2022



GREENVILLE BANNING CHANNEL (D03) CL

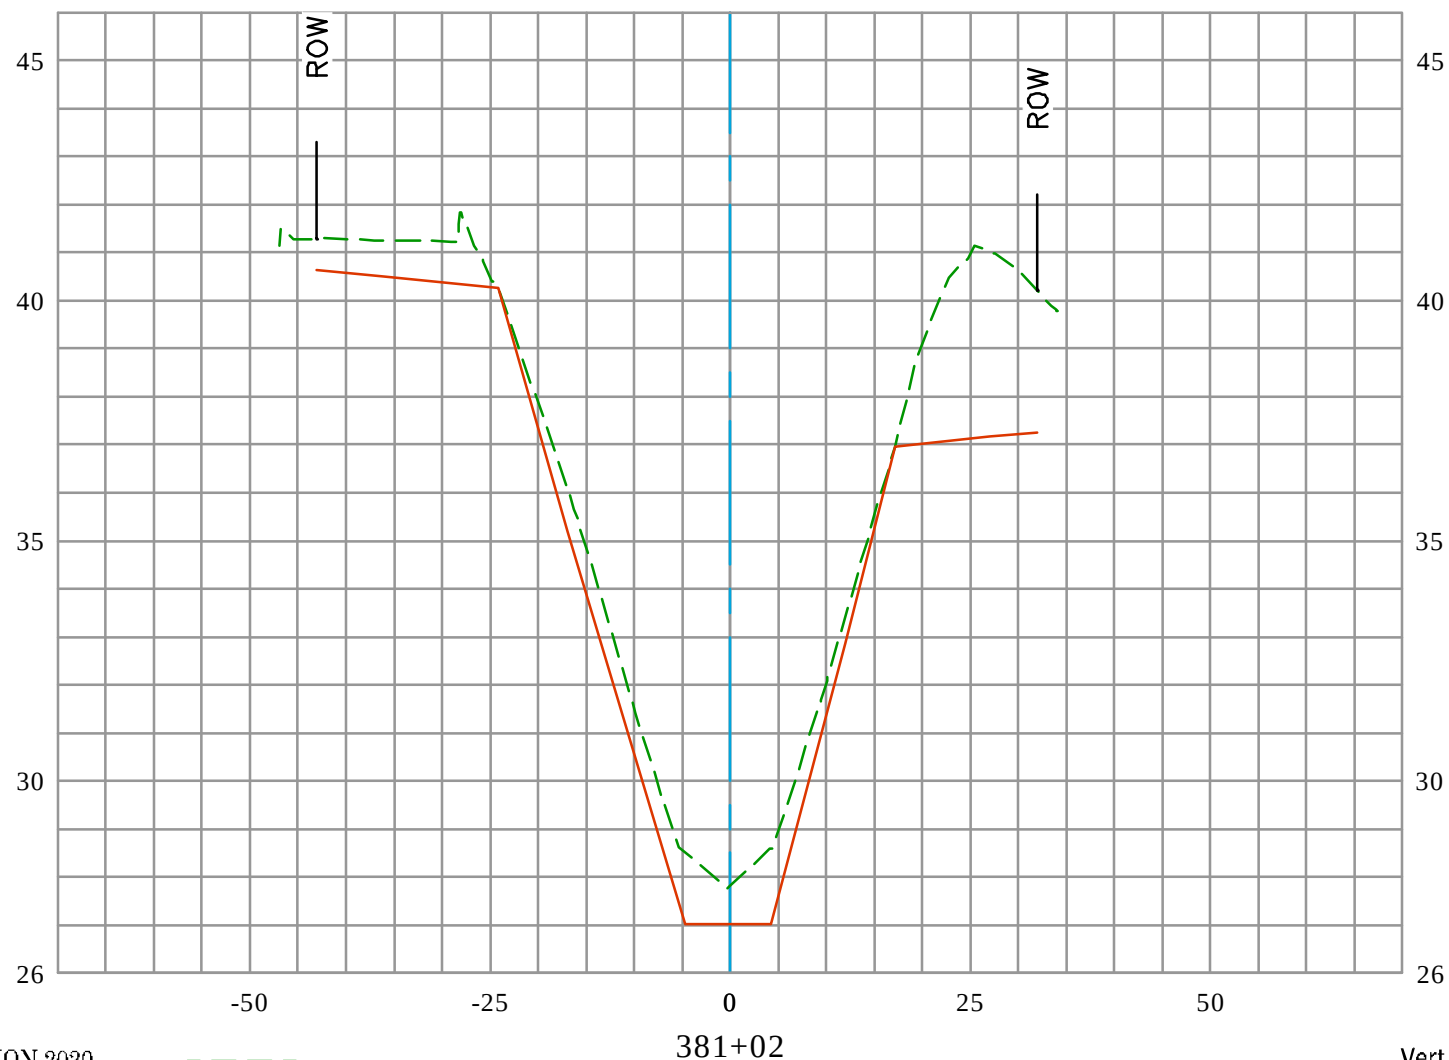

EXISTING CONDITION 2020
 RECORD DRAWING:
 D03-101-2A, D03-101-3A, & D03-101-7R
 DATE PREPARED: 01/24/2022

Vert. Scale: 1" = 4'
 Hor. Scale: 1" = 20'

GREENVILLE BANNING CHANNEL (D03) CL

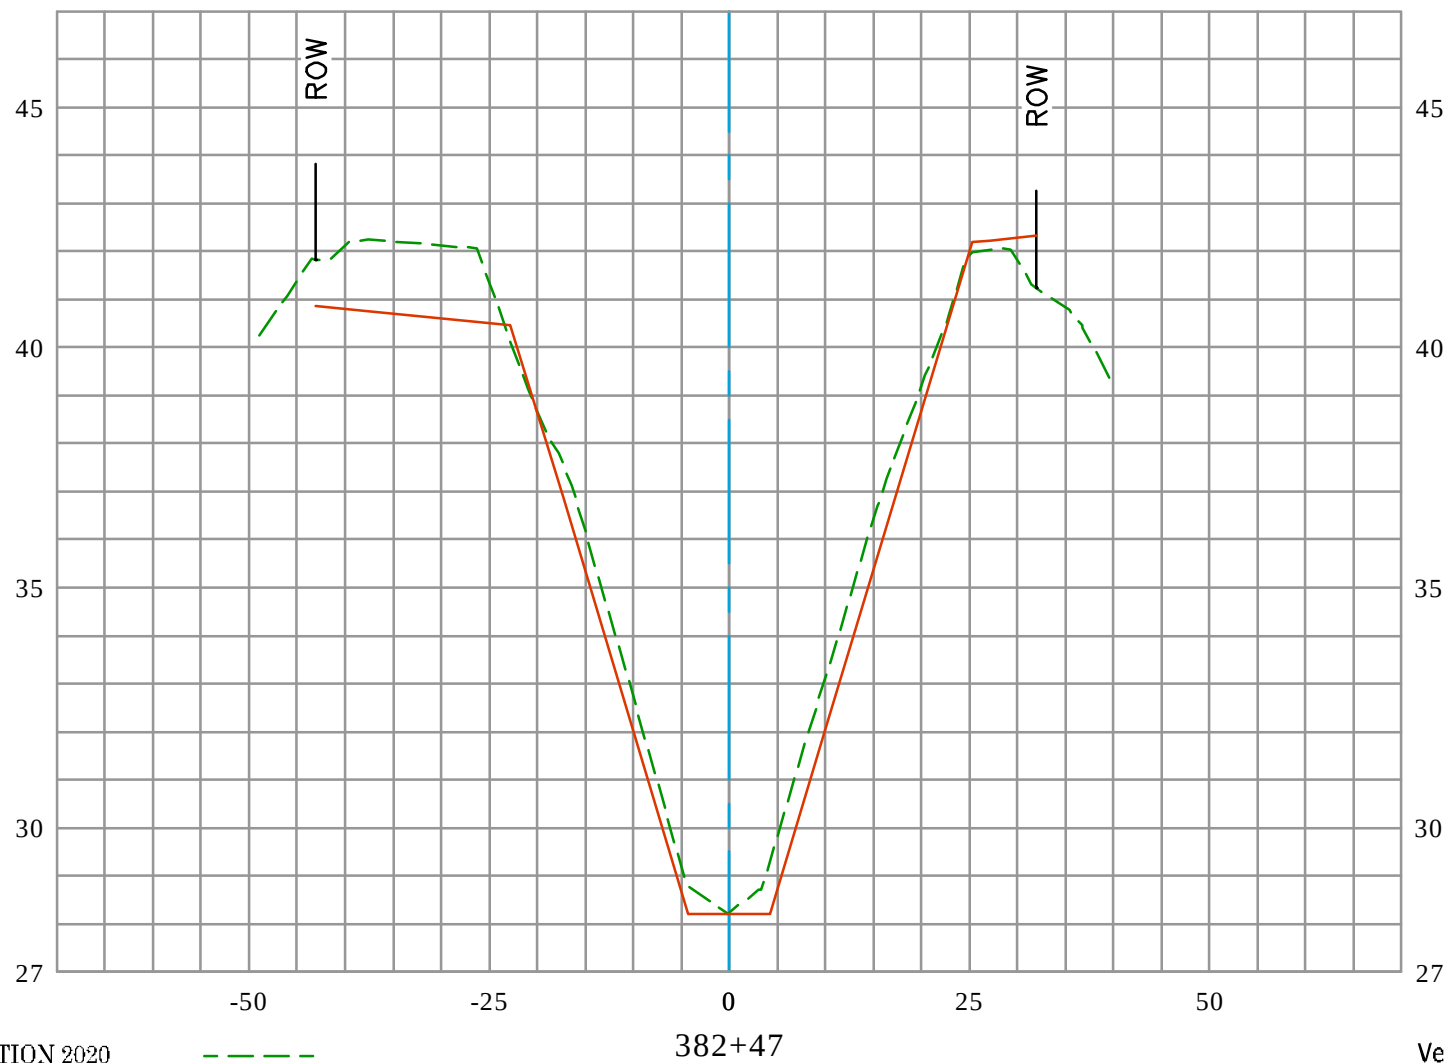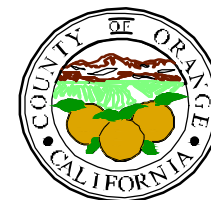


EXISTING CONDITION 2020
 RECORD DRAWING:
 D03-101-2A, D03-101-3A, & D03-101-7R
 DATE PREPARED: 01/24/2022

Vert. Scale: 1" = 4'
 Hor. Scale: 1" = 20'



GREENVILLE BANNING CHANNEL (D03) CL

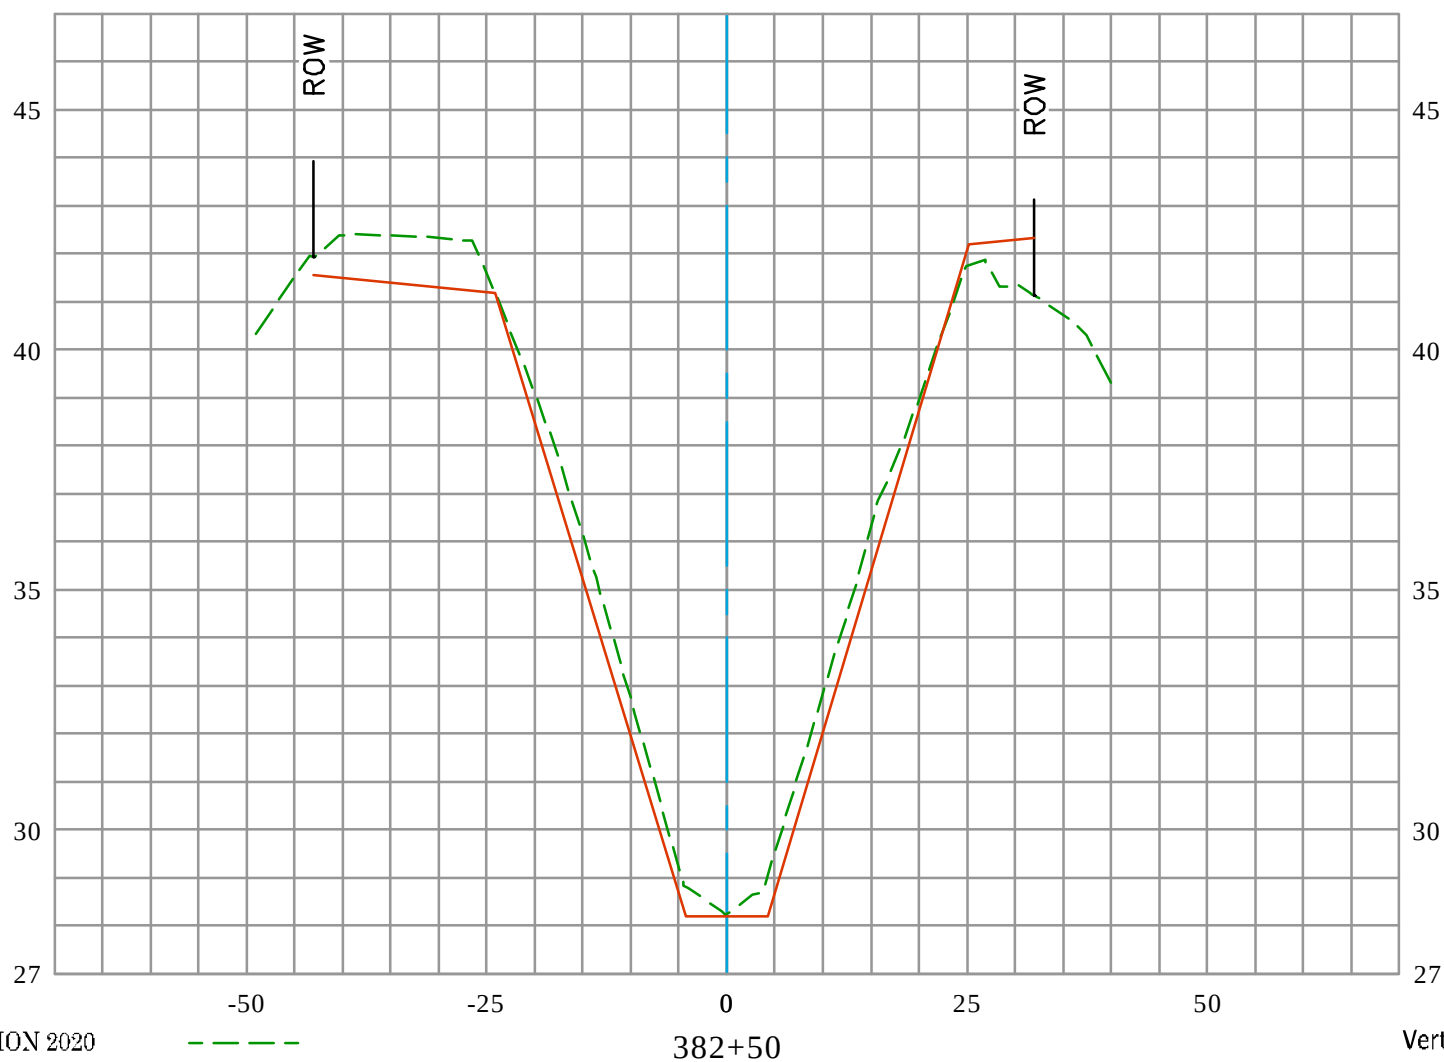


EXISTING CONDITION 2020
 RECORD DRAWING:
 D03-101-2A, D03-101-3A, & D03-101-7R
 DATE PREPARED: 01/24/2022


Vert. Scale: 1" = 4'
 Hor. Scale: 1" = 20'

**U.S. Survey
Foot**

OC Public Works
OC Survey/Field Services
Boundary Analysis & Mapping

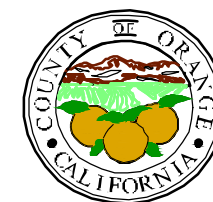

GREENVILLE BANNING CHANNEL (D03) CL

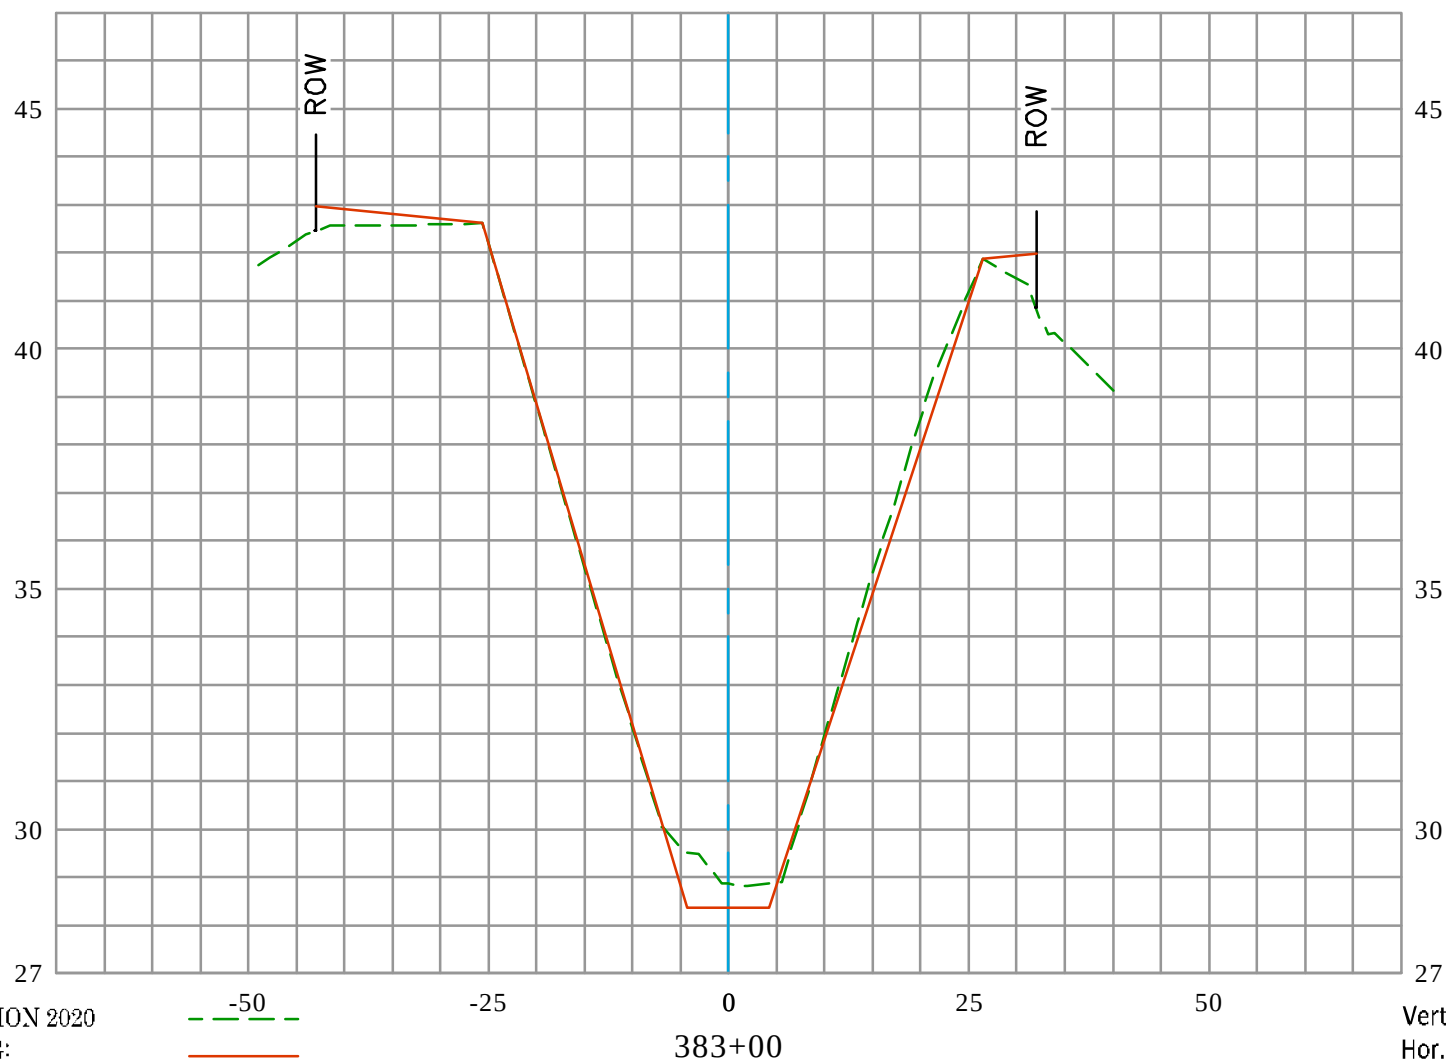



EXISTING CONDITION 2020
RECORD DRAWING:
D03-101-2A, D03-101-3A, & D03-101-7R
DATE PREPARED: 01/24/2022

Vert. Scale: 1" = 4'
Hor. Scale: 1" = 20'

U.S. Survey
Foot

OC Public Works
OC Survey/Field Services
Boundary Analysis & Mapping

GREENVILLE BANNING CHANNEL (D03) CL

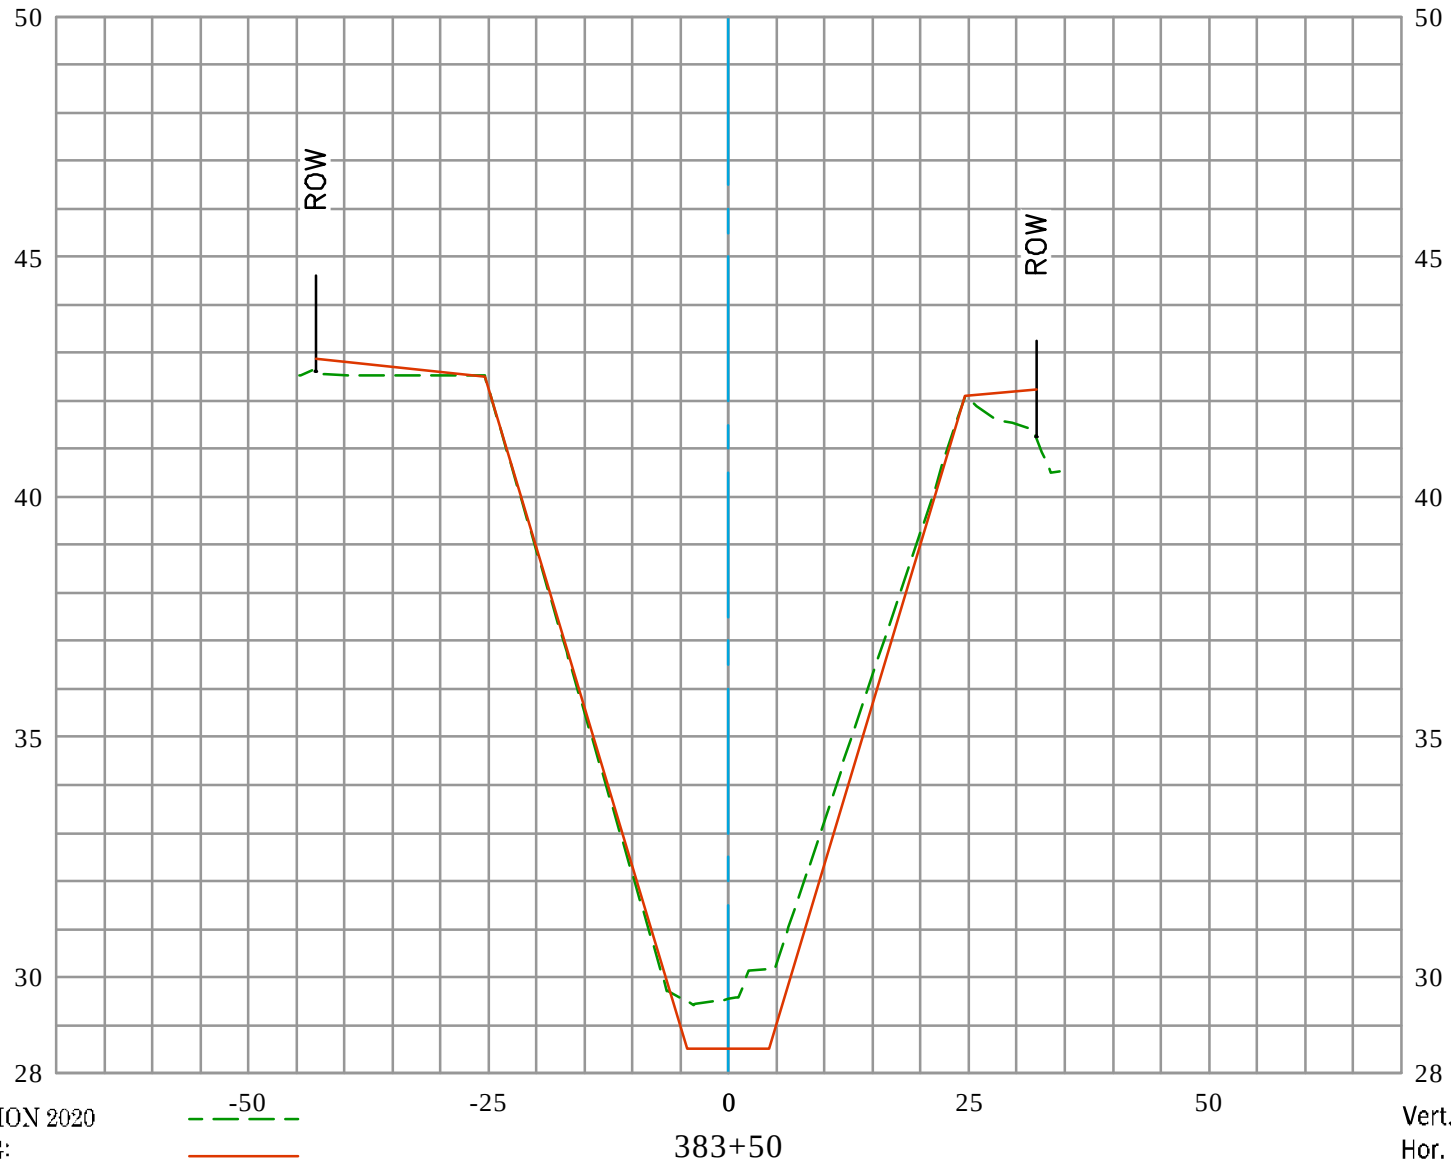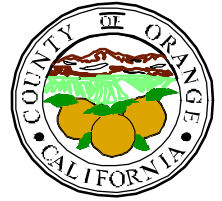



EXISTING CONDITION 2020
RECORD DRAWING:
D03-101-2A, D03-101-3A, & D03-101-7R
DATE PREPARED: 01/24/2022

Vert. Scale: 1" = 4'
Hor. Scale: 1" = 20'

U.S. *Survey Foot*

OC Public Works
OC Survey/Field Services
Boundary Analysis & Mapping

GREENVILLE BANNING CHANNEL (D03) CL

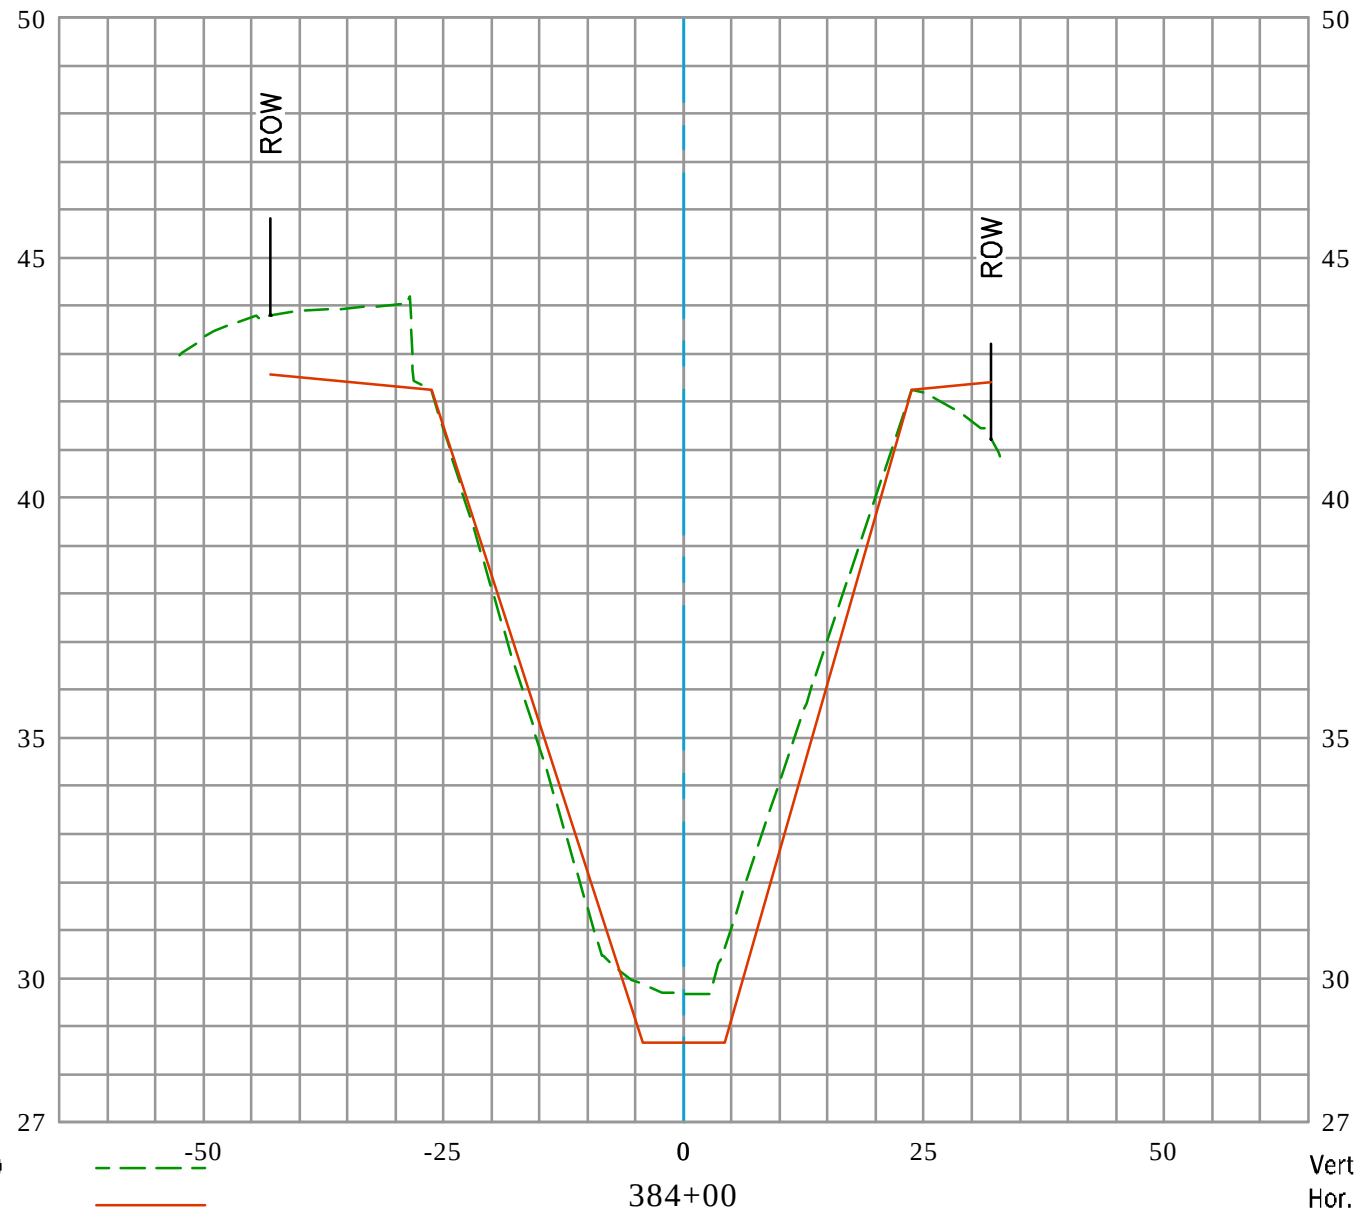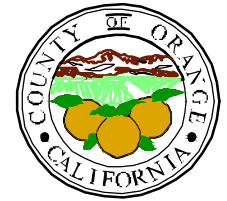


EXISTING CONDITION 2020
RECORD DRAWING:
D03-101-2A, D03-101-3A, & D03-101-7R
DATE PREPARED: 01/24/2022

Vert. Scale: 1" = 4'
Hor. Scale: 1" = 20'

U.S. *Survey
Foot*



OC Public Works
OC Survey/Field Services
Boundary Analysis & Mapping

GREENVILLE BANNING CHANNEL (D03) CL

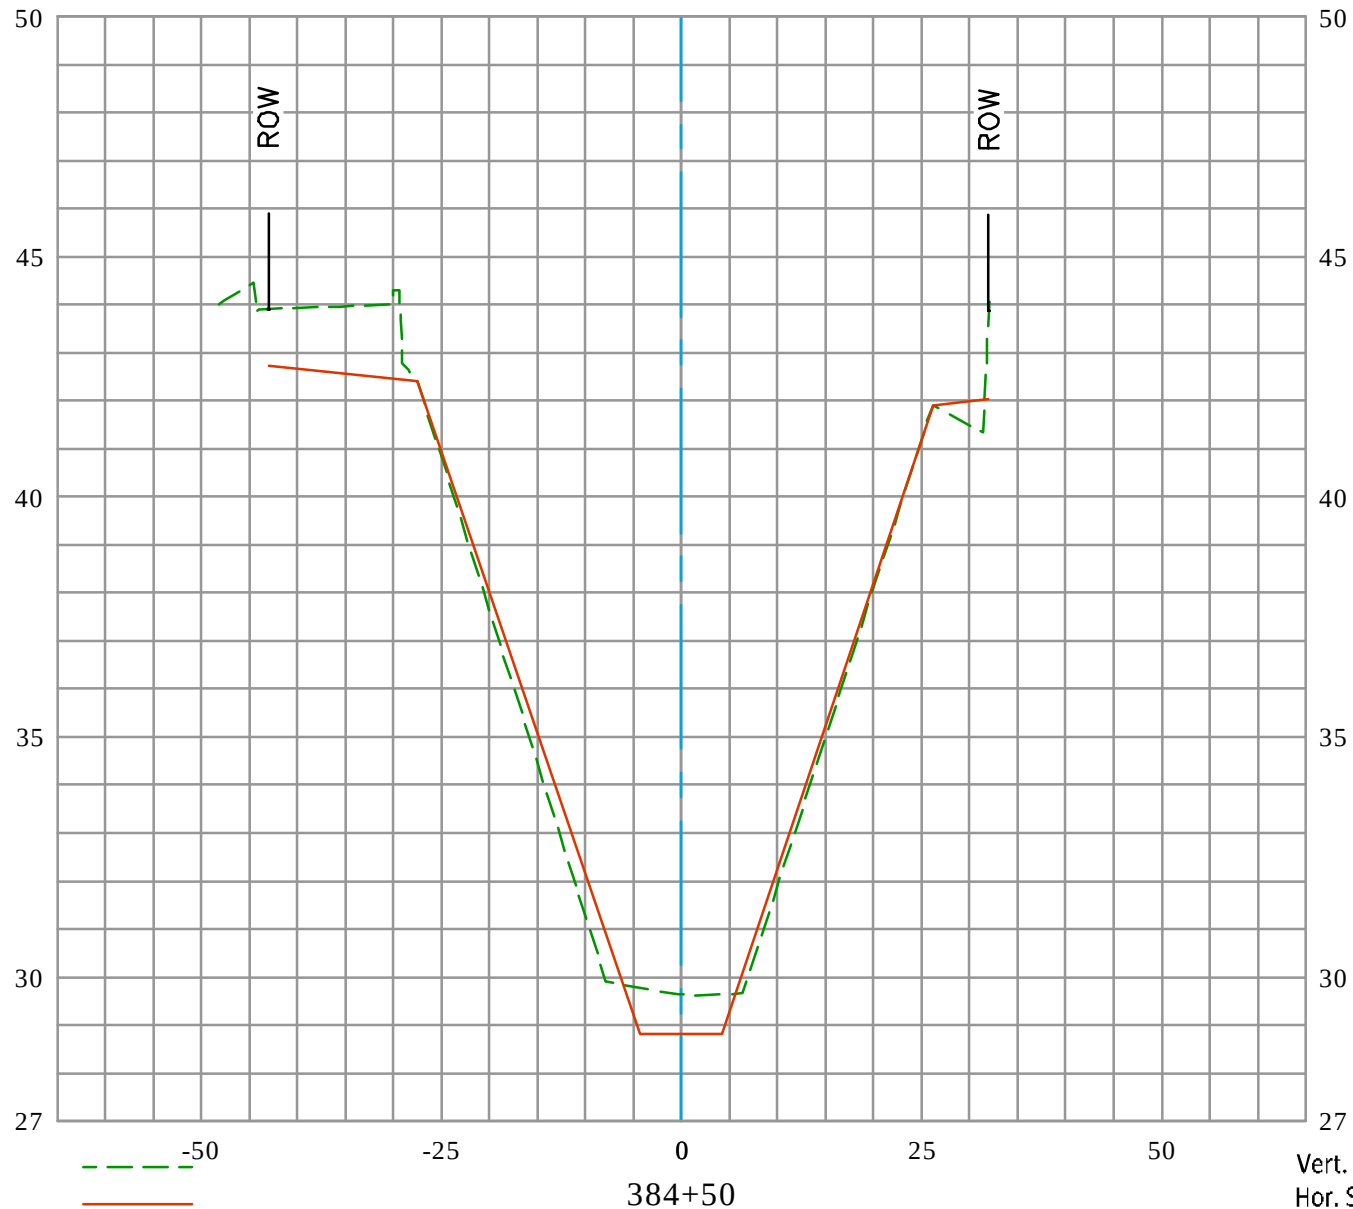



GREENVILLE BANNING CHANNEL (D03) CL

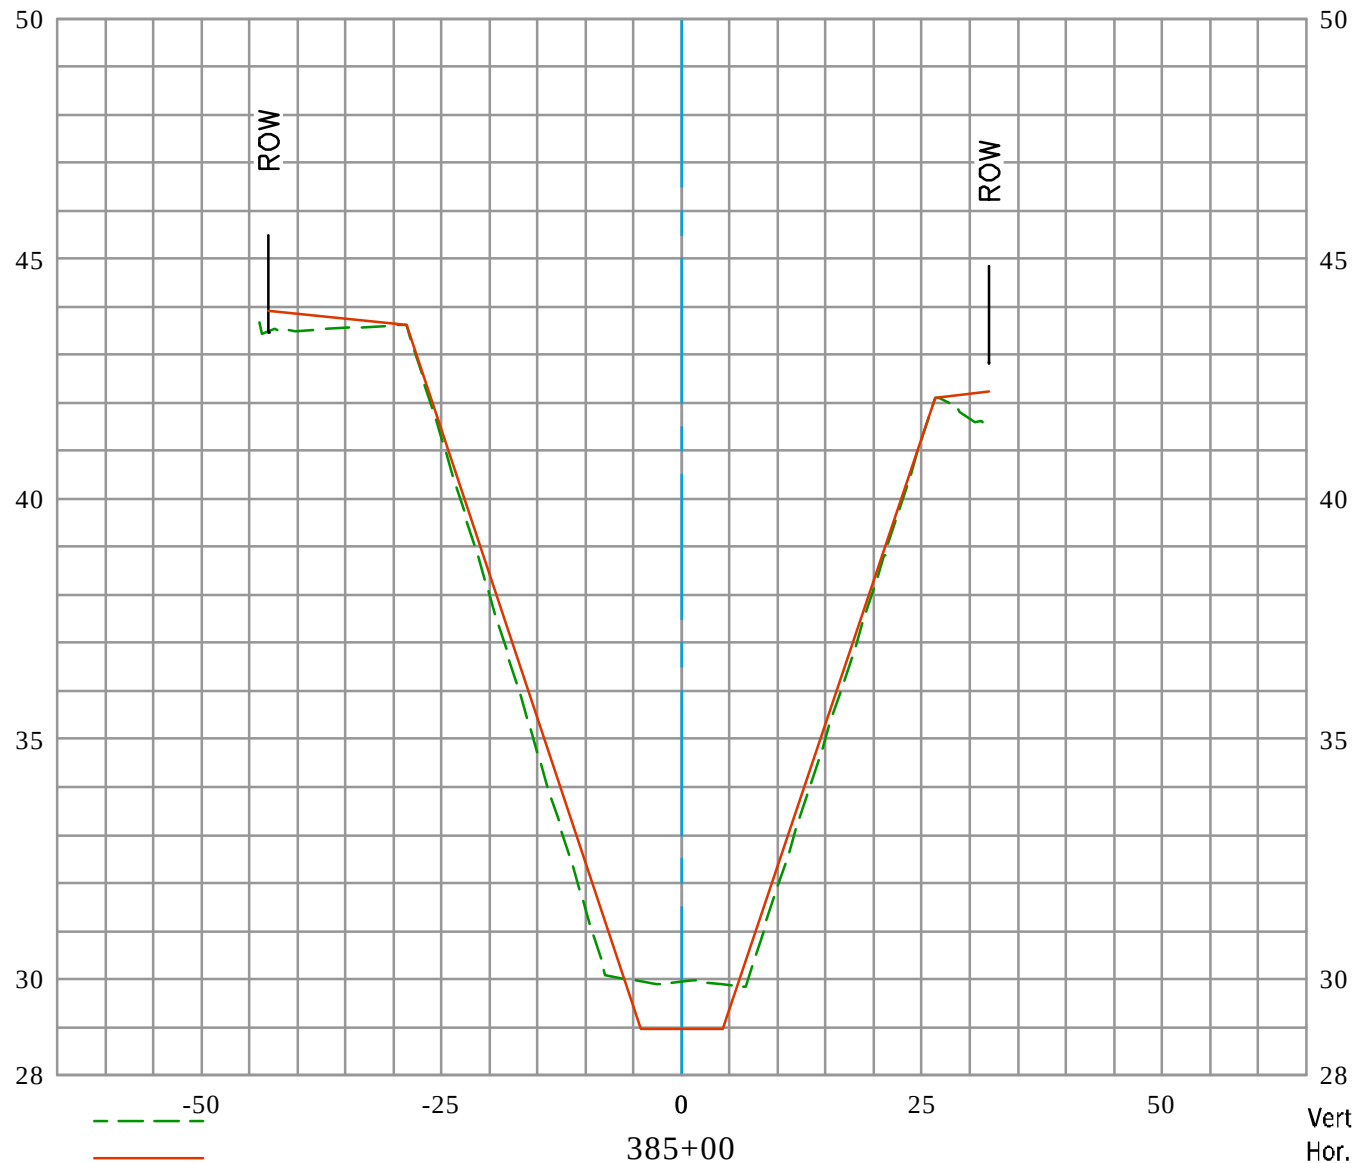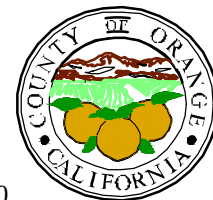


EXISTING CONDITION 2020
RECORD DRAWING:
D03-101-2A, D03-101-3A, & D03-101-7R
DATE PREPARED: 01/24/2022


Vert. Scale: 1" = 4'
Hor. Scale: 1" = 20'

U.S. Survey Foot

OC Public Works
OC Survey/Field Services
Boundary Analysis & Mapping

GREENVILLE BANNING CHANNEL (D03) CL

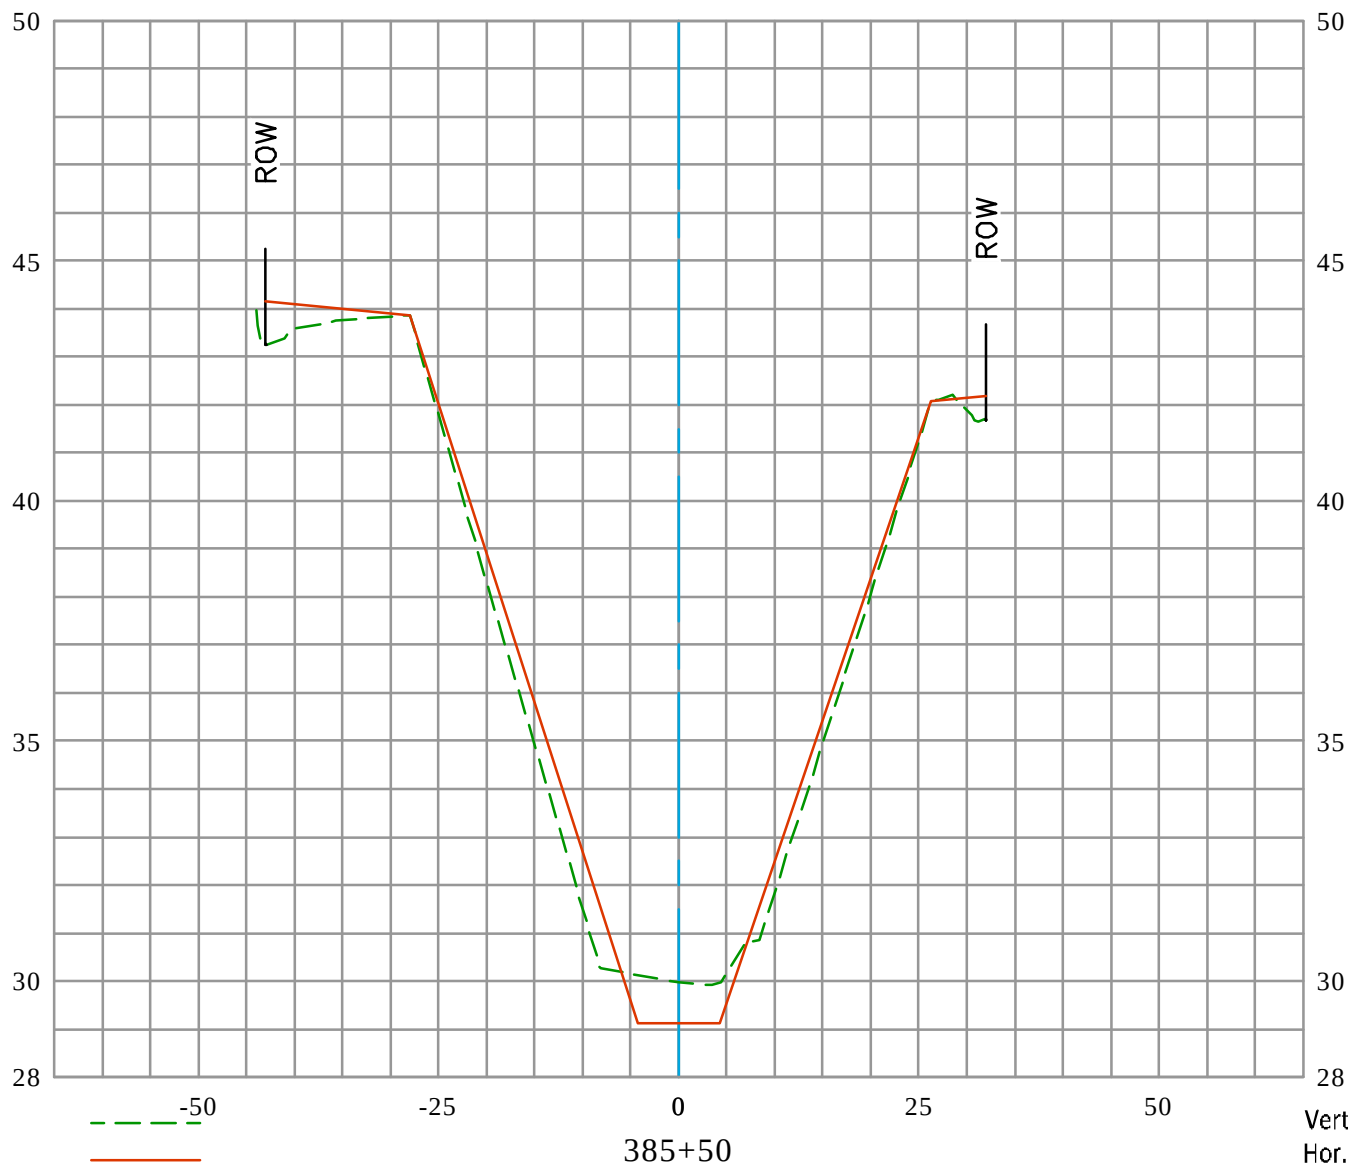


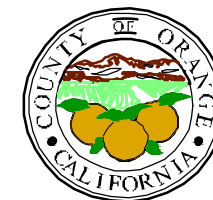

Vert. Scale: 1" = 4'
Hor. Scale: 1" = 20'



GREENVILLE BANNING CHANNEL (D03) CL

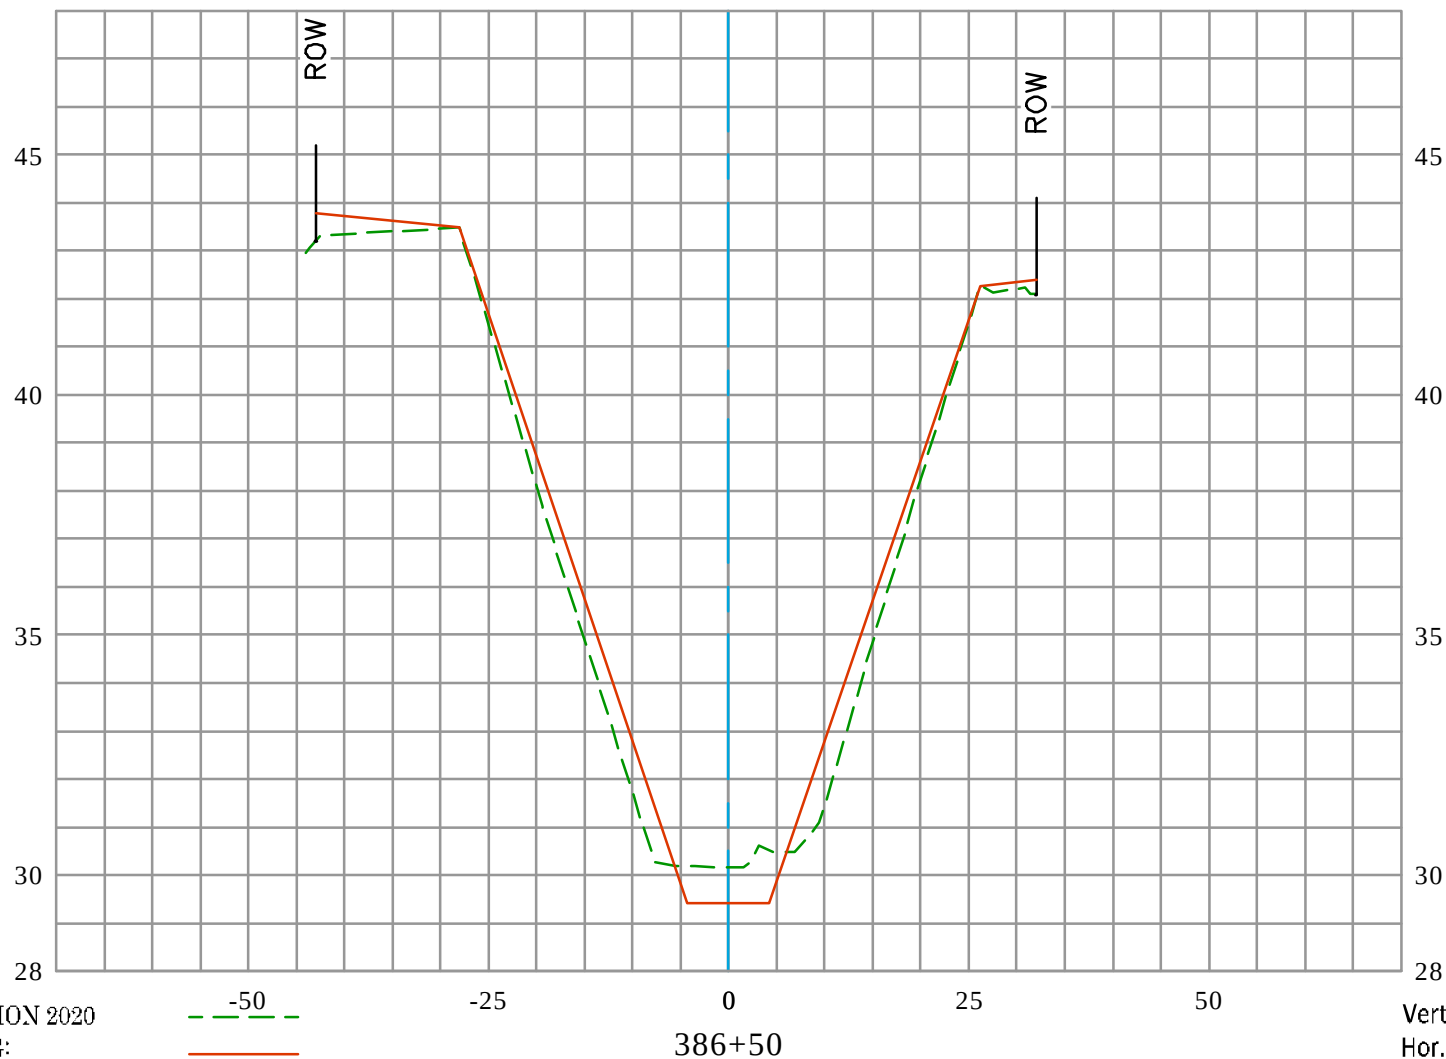


EXISTING CONDITION 2020
 RECORD DRAWING:
 D03-101-2A, D03-101-3A, & D03-101-7R
 DATE PREPARED: 01/24/2022

Vert. Scale: 1" = 4'
 Hor. Scale: 1" = 20'



GREENVILLE BANNING CHANNEL (D03) CL

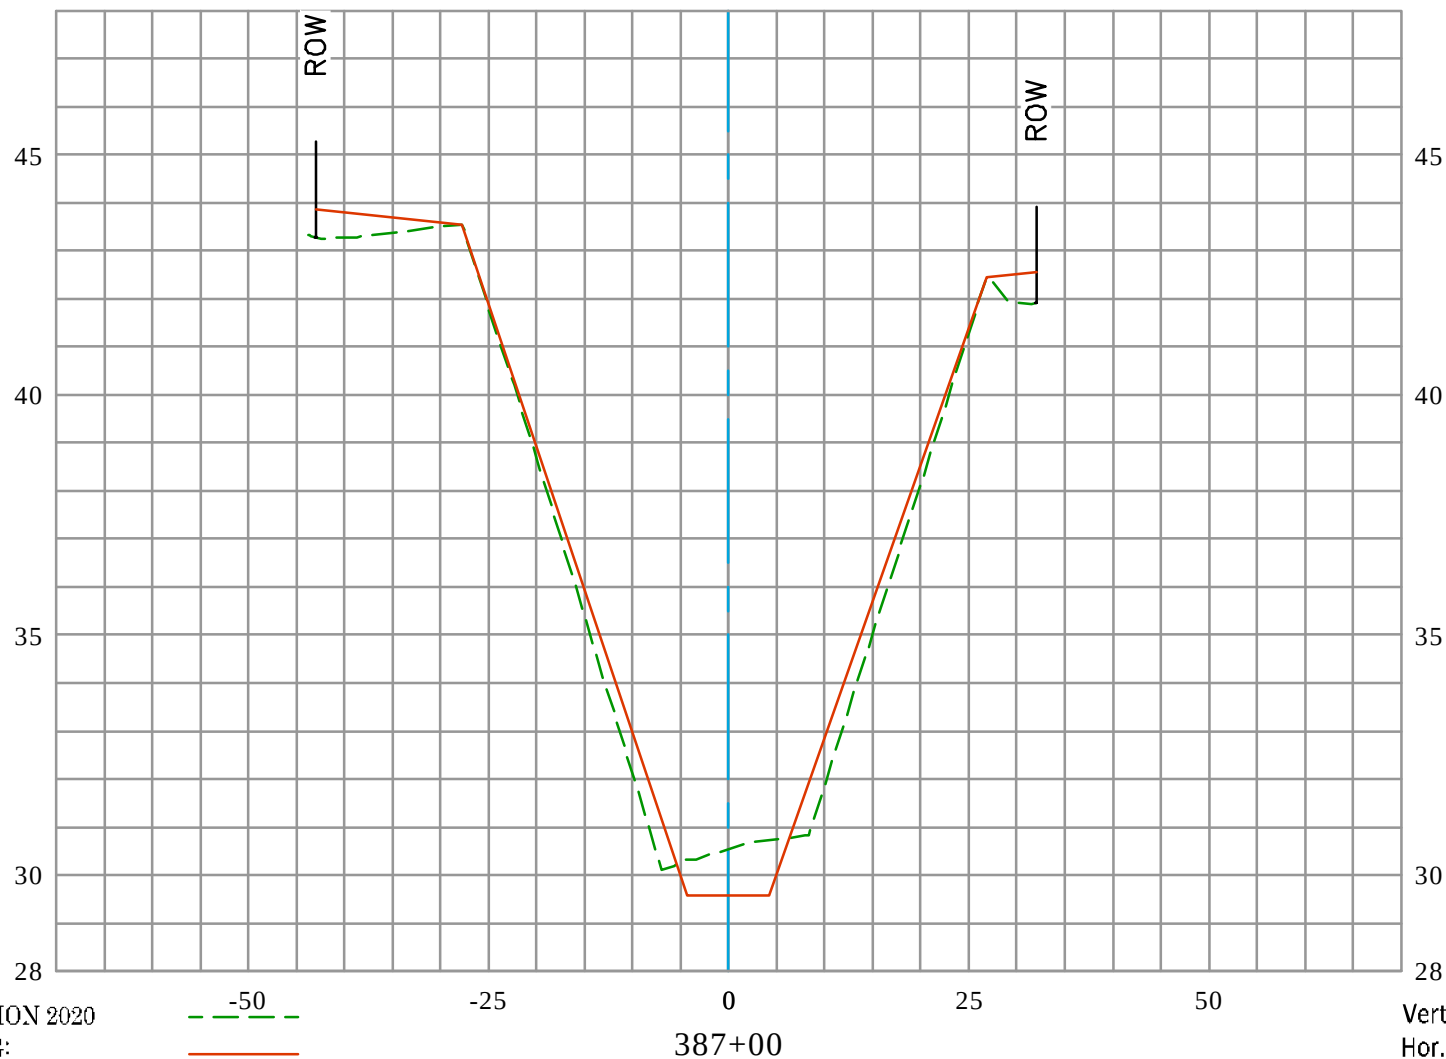


EXISTING CONDITION 2020
 RECORD DRAWING:
 D03-101-2A, D03-101-3A, & D03-101-7R
 DATE PREPARED: 01/24/2022

Vert. Scale: 1" = 4'
 Hor. Scale: 1" = 20'



GREENVILLE BANNING CHANNEL (D03) CL

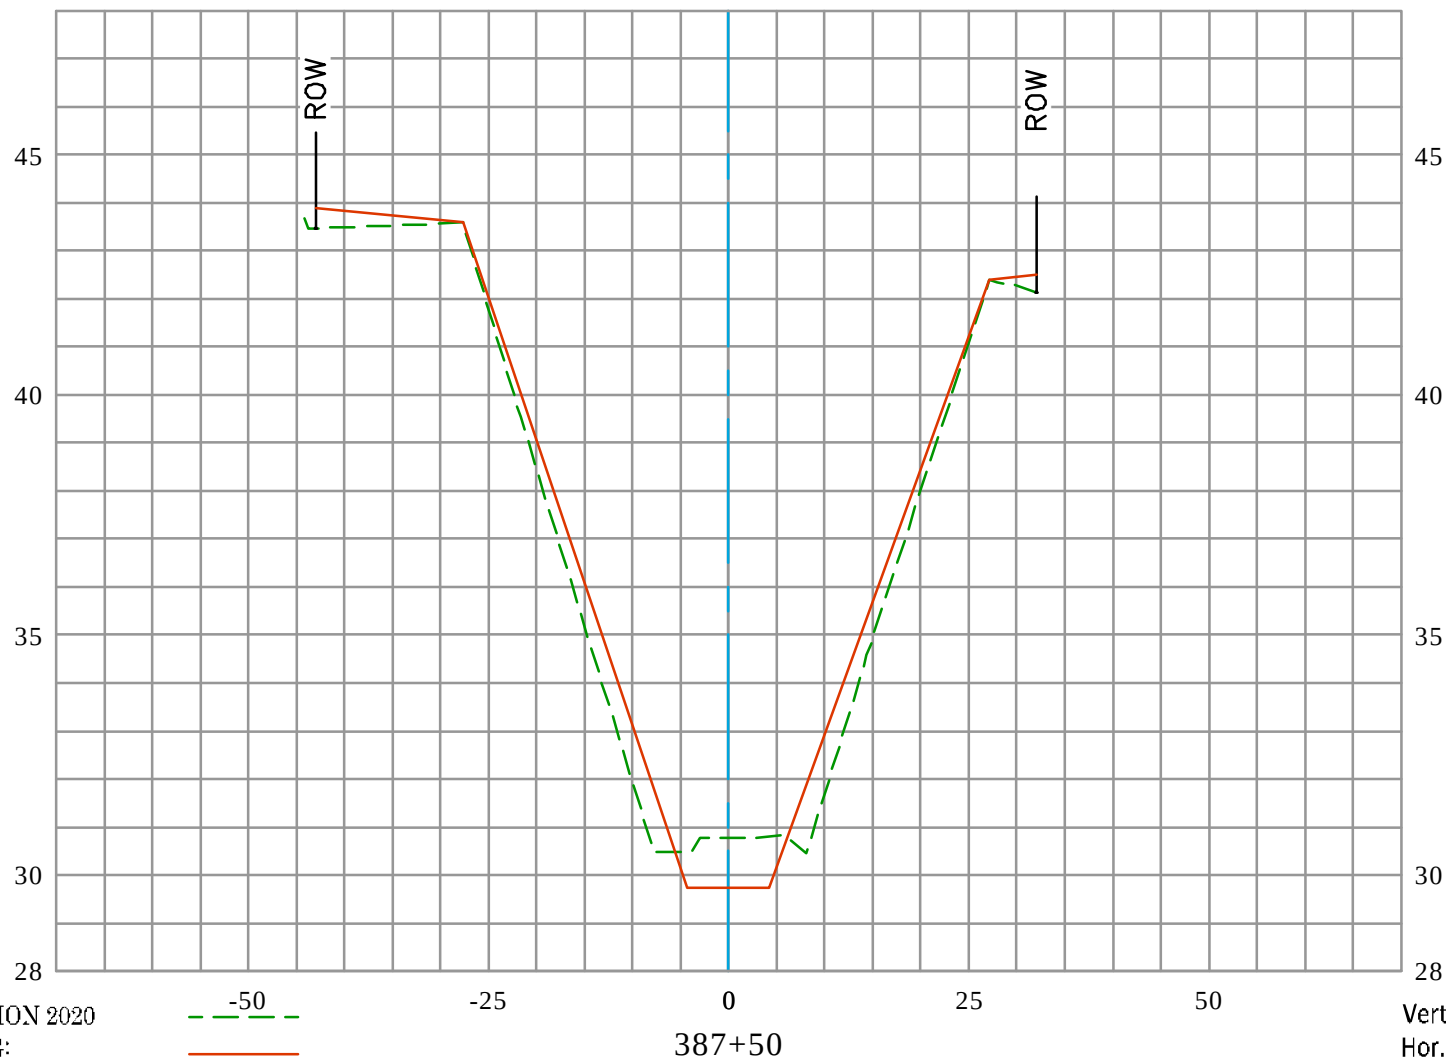


EXISTING CONDITION 2020
 RECORD DRAWING:
 D03-101-2A, D03-101-3A, & D03-101-7R
 DATE PREPARED: 01/24/2022

Vert. Scale: 1" = 4'
 Hor. Scale: 1" = 20'



GREENVILLE BANNING CHANNEL (D03) CL

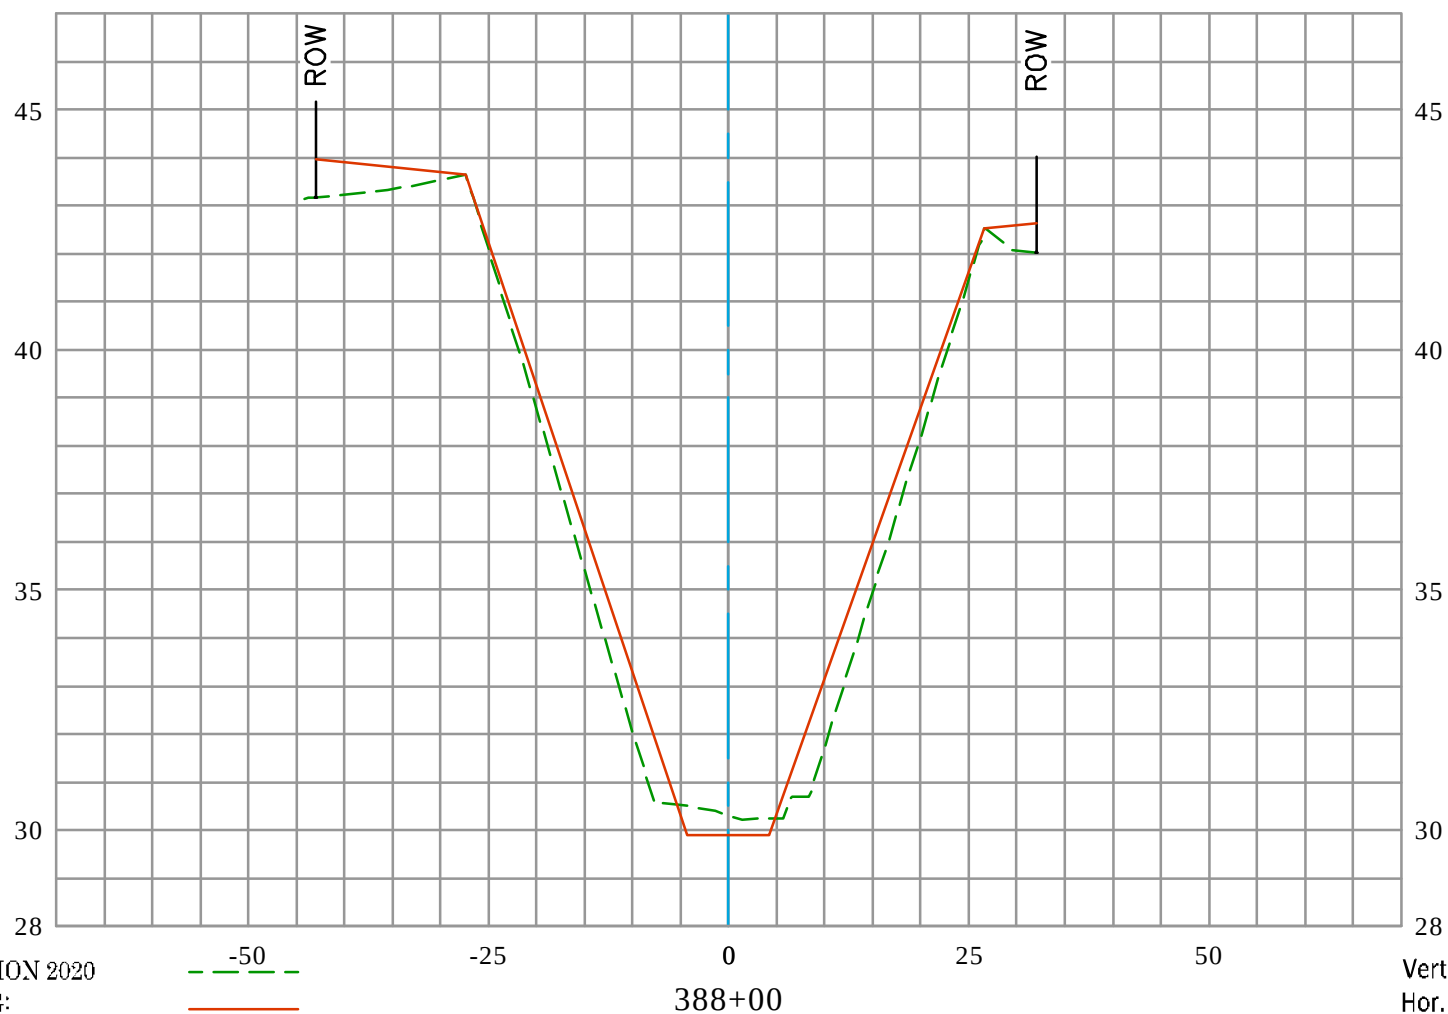


EXISTING CONDITION 2020
RECORD DRAWING:
D03-101-2A, D03-101-3A, & D03-101-7R
DATE PREPARED: 01/24/2022

Vert. Scale: 1" = 4'
Hor. Scale: 1" = 20'



GREENVILLE BANNING CHANNEL (D03) CL

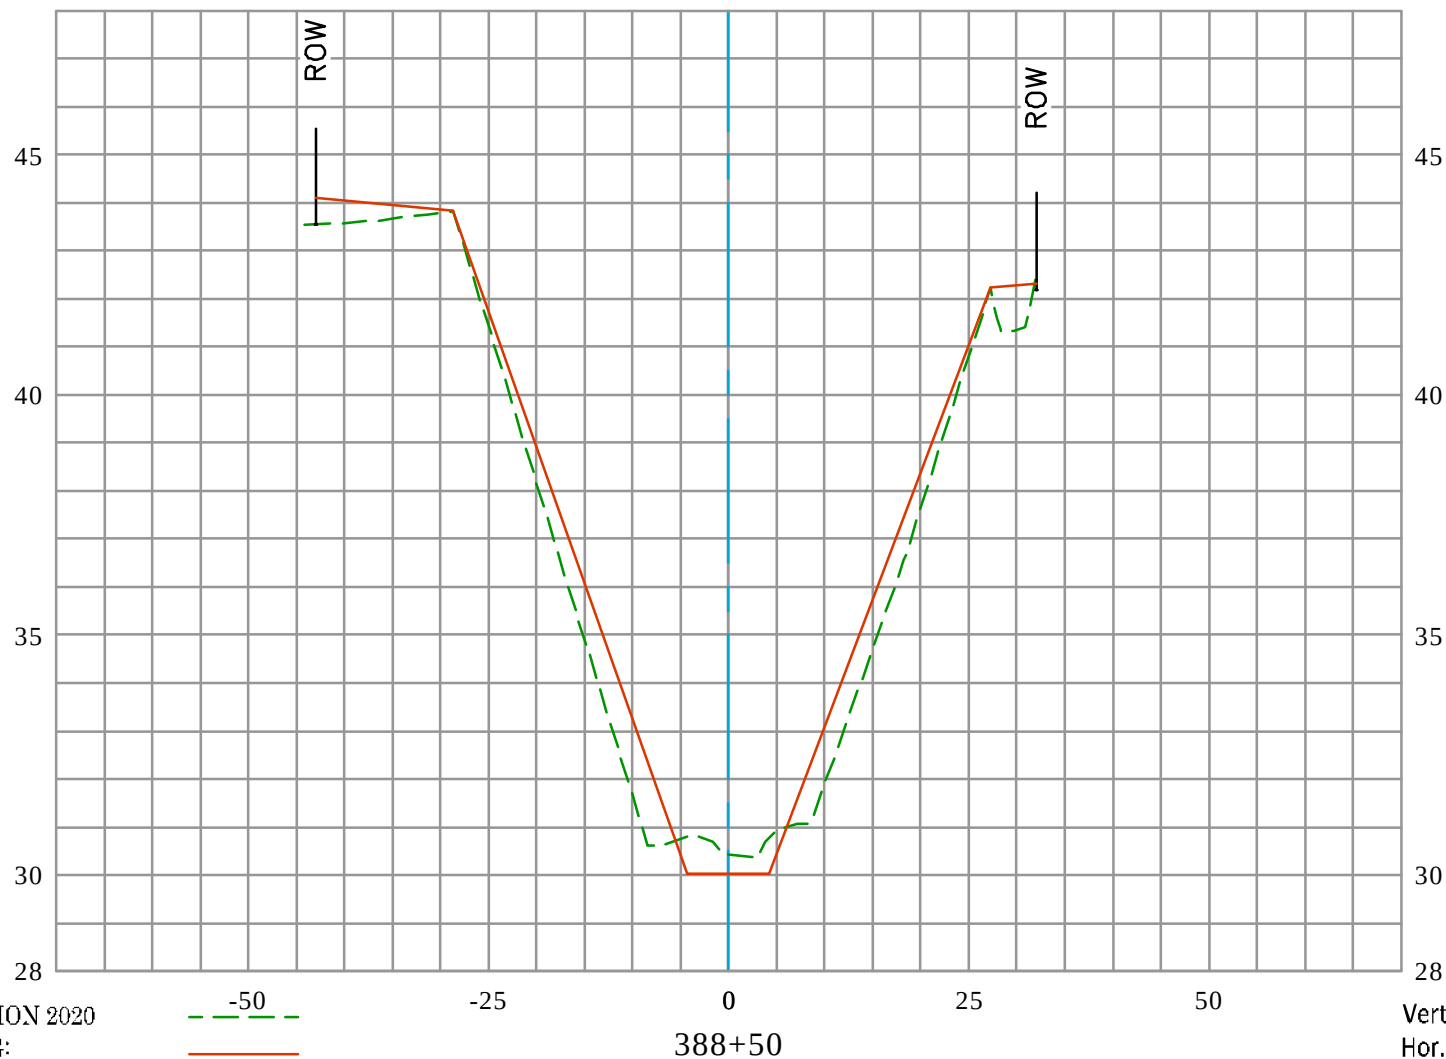


EXISTING CONDITION 2020
 RECORD DRAWING:
 D03-101-2A, D03-101-3A, & D03-101-7R
 DATE PREPARED: 01/24/2022

Vert. Scale: 1" = 4'
 Hor. Scale: 1" = 20'



GREENVILLE BANNING CHANNEL (D03) CL

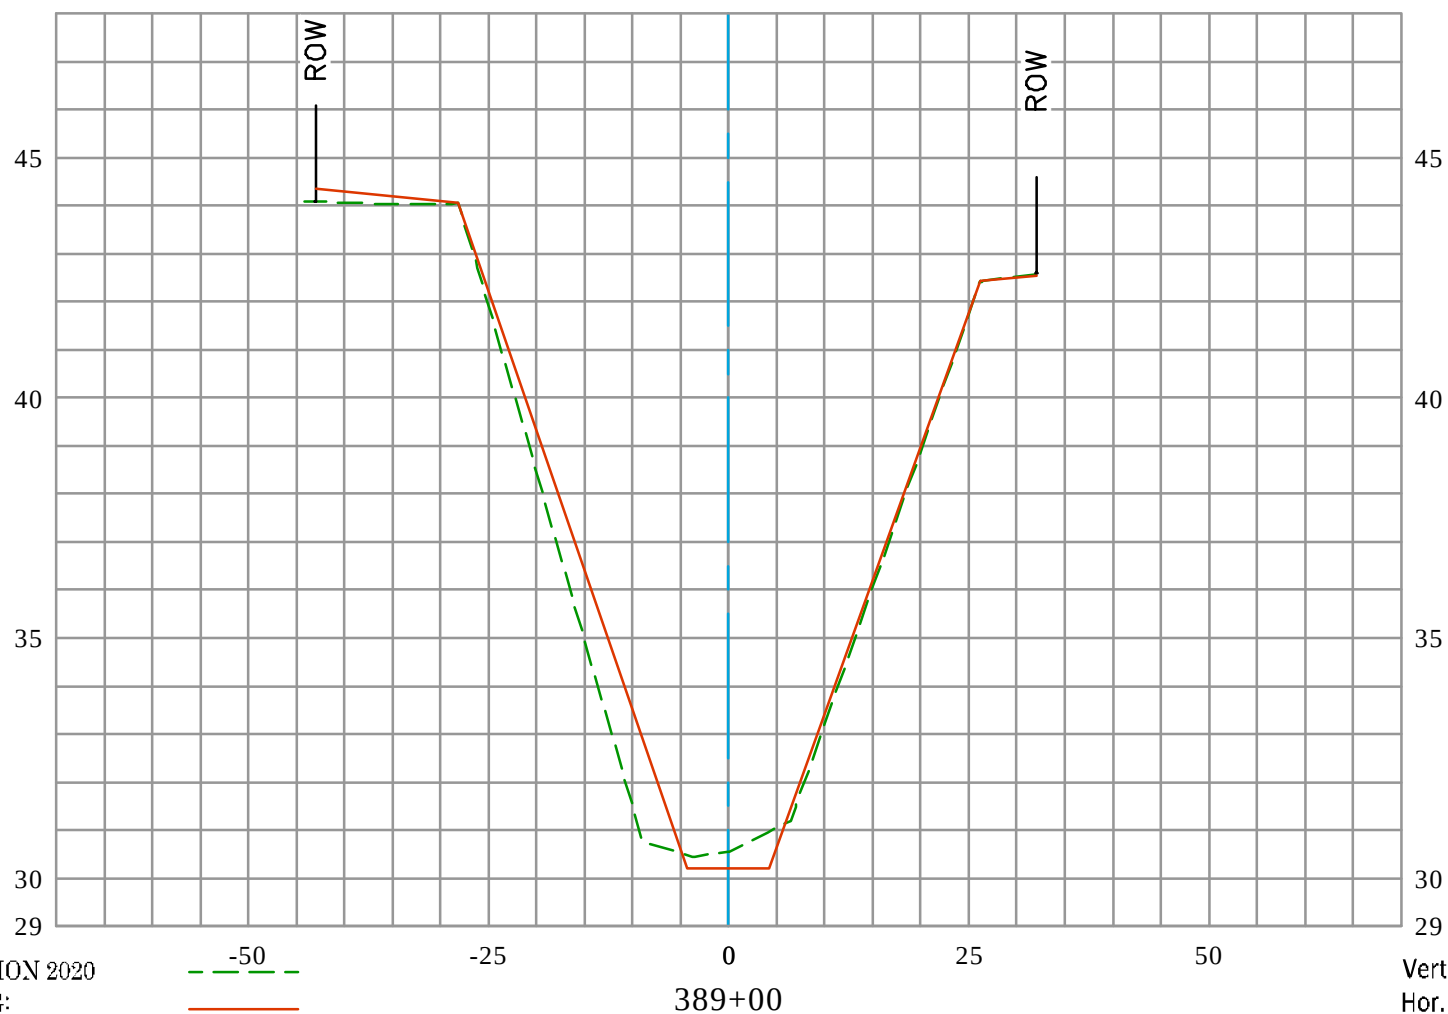


EXISTING CONDITION 2020
RECORD DRAWING:
D03-101-2A, D03-101-3A, & D03-101-7R
DATE PREPARED: 01/24/2022

Vert. Scale: 1" = 4'
Hor. Scale: 1" = 20'



GREENVILLE BANNING CHANNEL (D03) CL

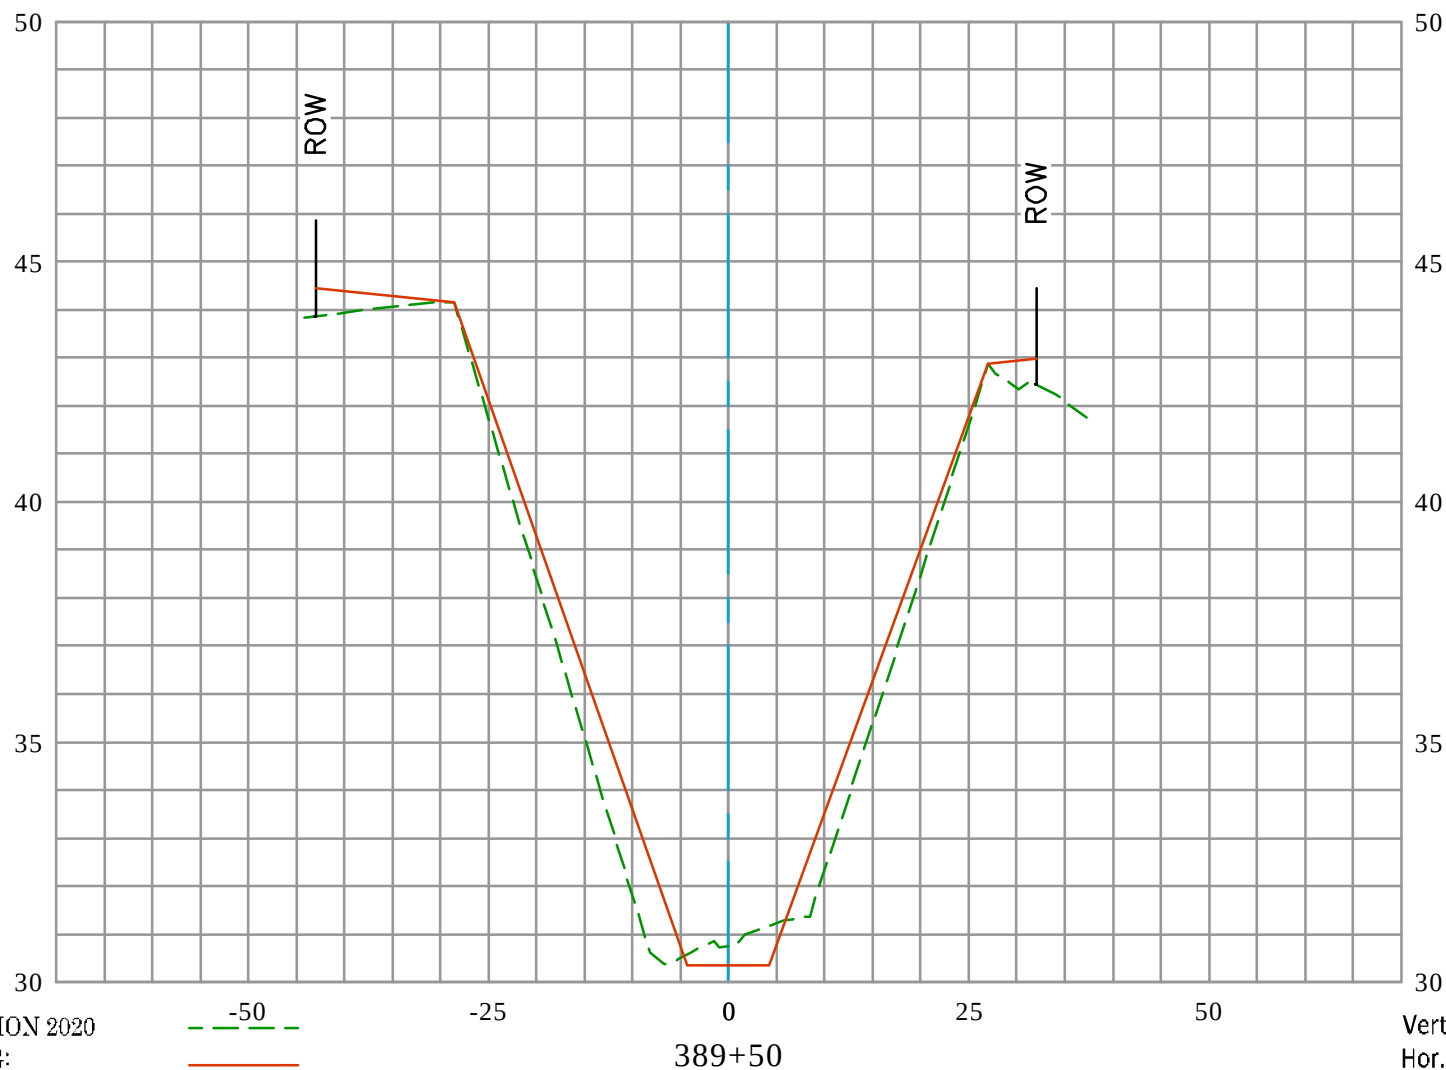


EXISTING CONDITION 2020
 RECORD DRAWING:
 D03-101-2A, D03-101-3A, & D03-101-7R
 DATE PREPARED: 01/24/2022

Vert. Scale: 1" = 4'
 Hor. Scale: 1" = 20'



GREENVILLE BANNING CHANNEL (D03) CL

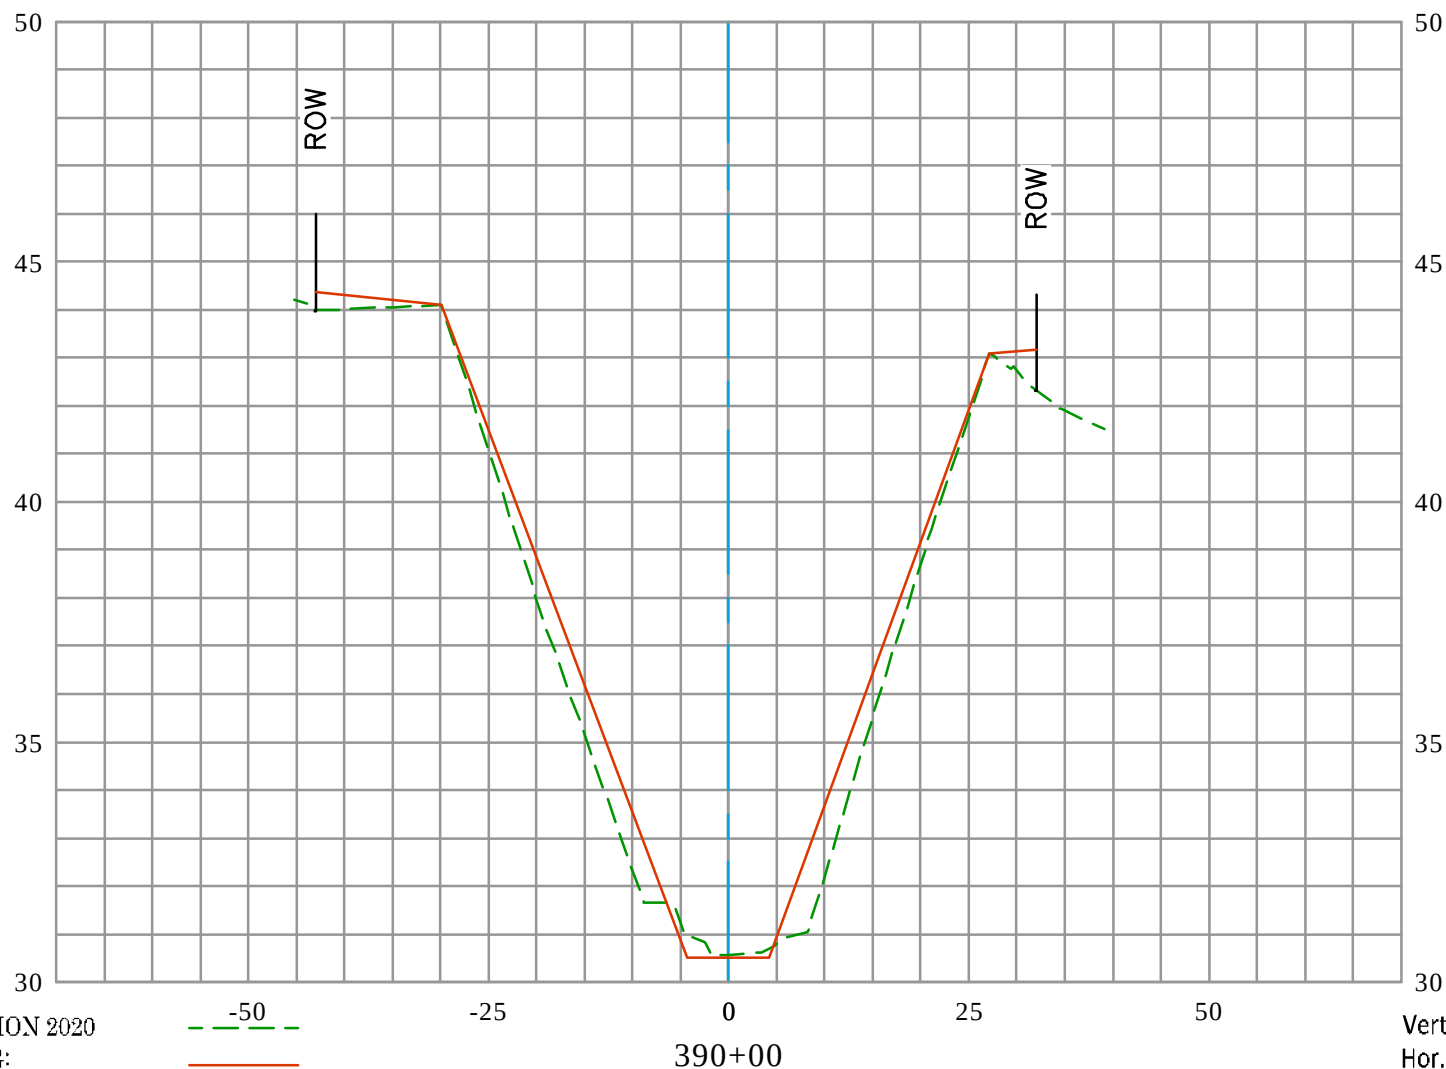


EXISTING CONDITION 2020
 RECORD DRAWING:
 D03-101-2A, D03-101-3A, & D03-101-7R
 DATE PREPARED: 01/24/2022

Vert. Scale: 1" = 4'
 Hor. Scale: 1" = 20'



GREENVILLE BANNING CHANNEL (D03) CL

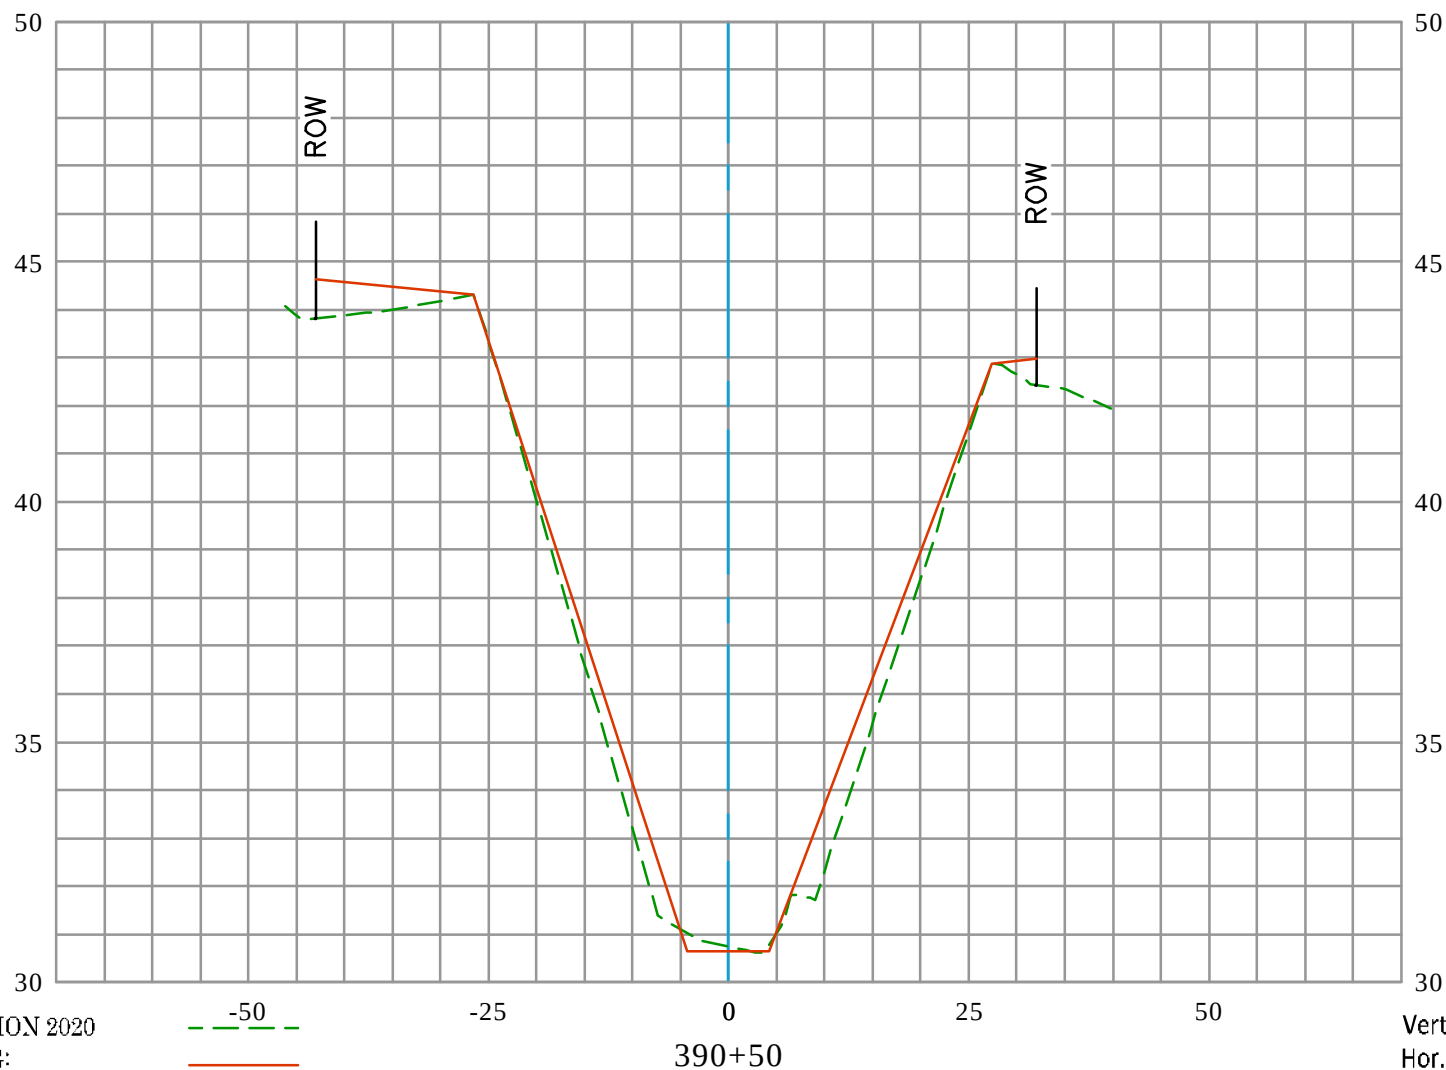


EXISTING CONDITION 2020
 RECORD DRAWING:
 D03-101-2A, D03-101-3A, & D03-101-7R
 DATE PREPARED: 01/24/2022

Vert. Scale: 1" = 4'
 Hor. Scale: 1" = 20'



GREENVILLE BANNING CHANNEL (D03) CL

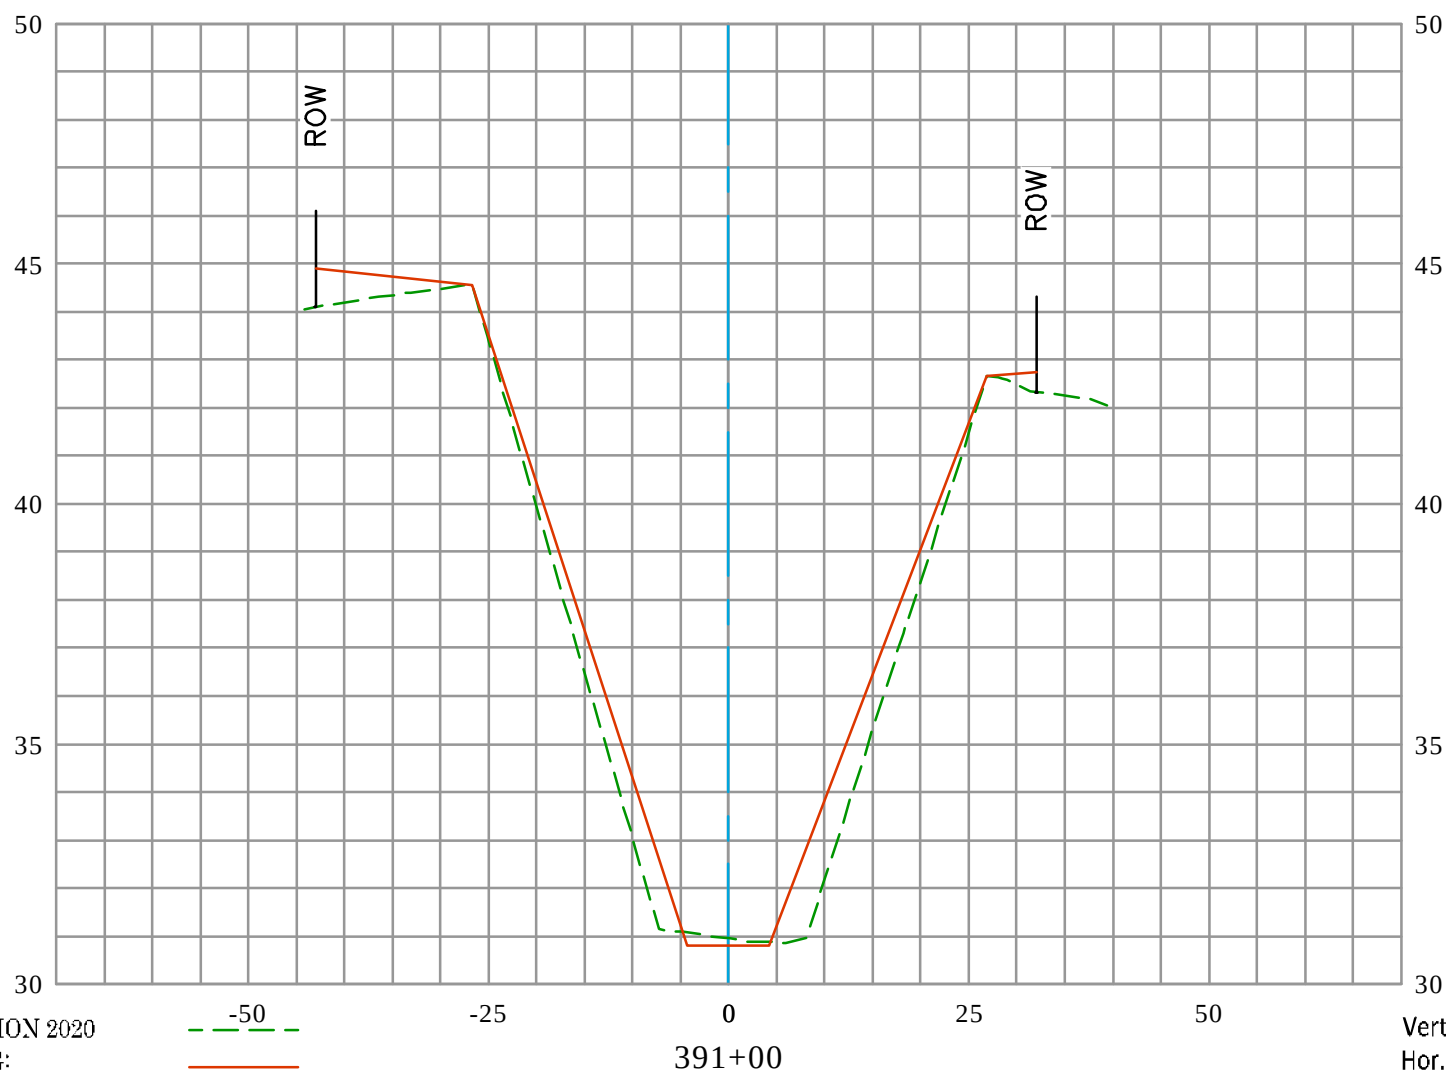


EXISTING CONDITION 2020
 RECORD DRAWING:
 D03-101-2A, D03-101-3A, & D03-101-7R
 DATE PREPARED: 01/24/2022

Vert. Scale: 1" = 4'
 Hor. Scale: 1" = 20'



GREENVILLE BANNING CHANNEL (D03) CL

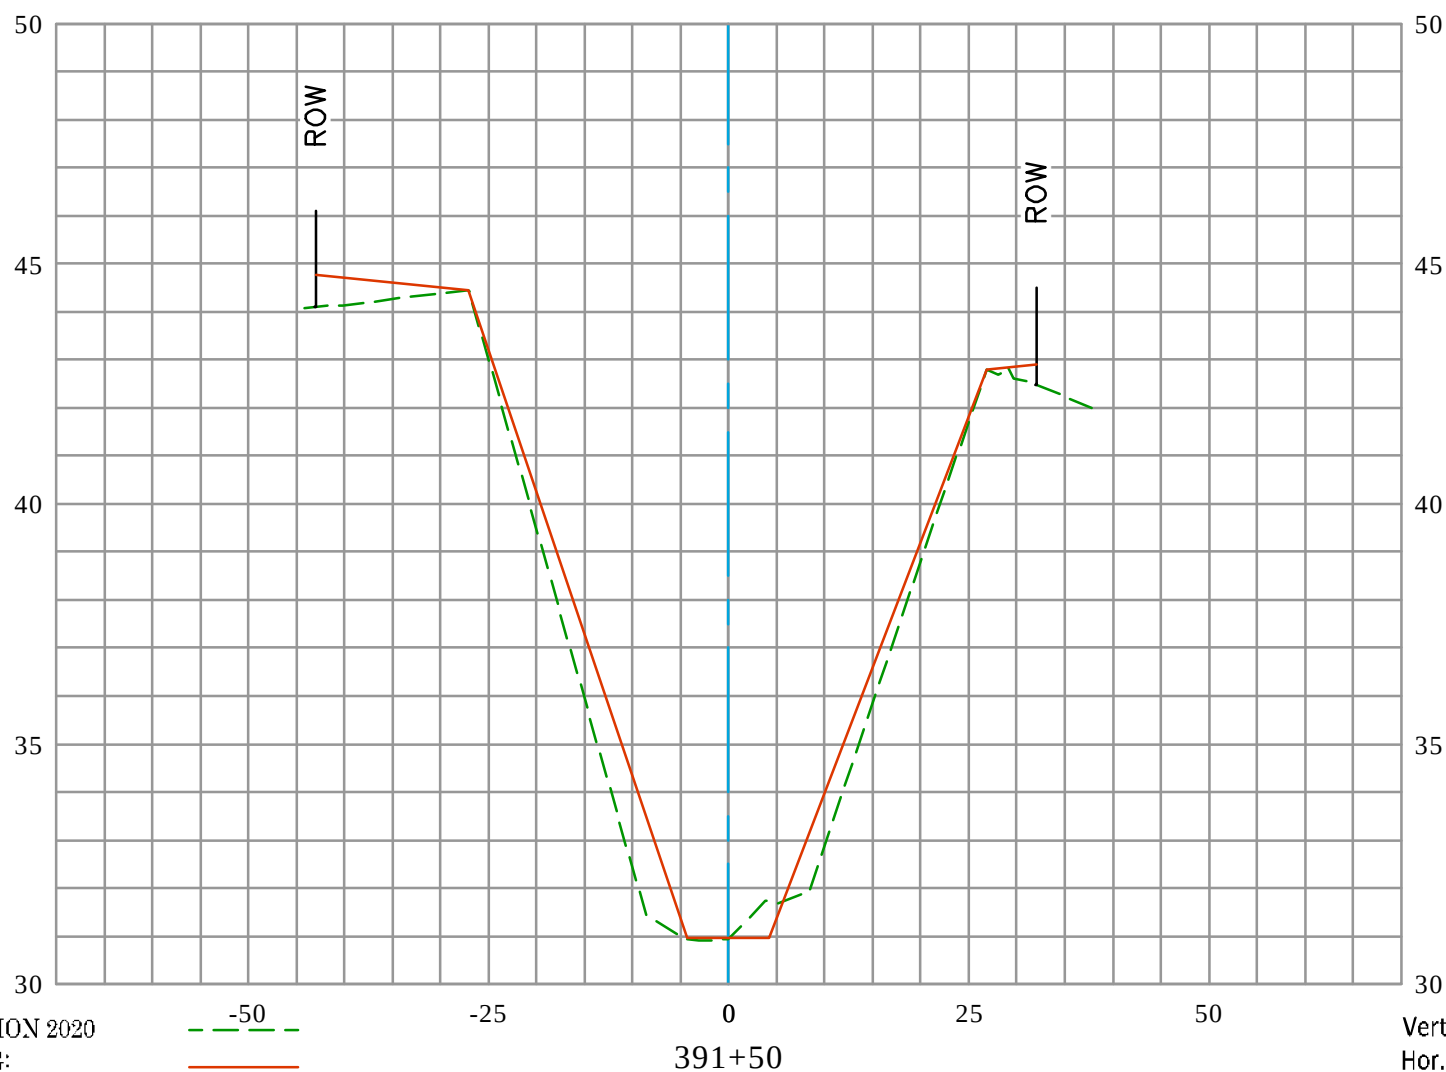


EXISTING CONDITION 2020
 RECORD DRAWING:
 D03-101-2A, D03-101-3A, & D03-101-7R
 DATE PREPARED: 01/24/2022

Vert. Scale: 1" = 4'
 Hor. Scale: 1" = 20'



GREENVILLE BANNING CHANNEL (D03) CL

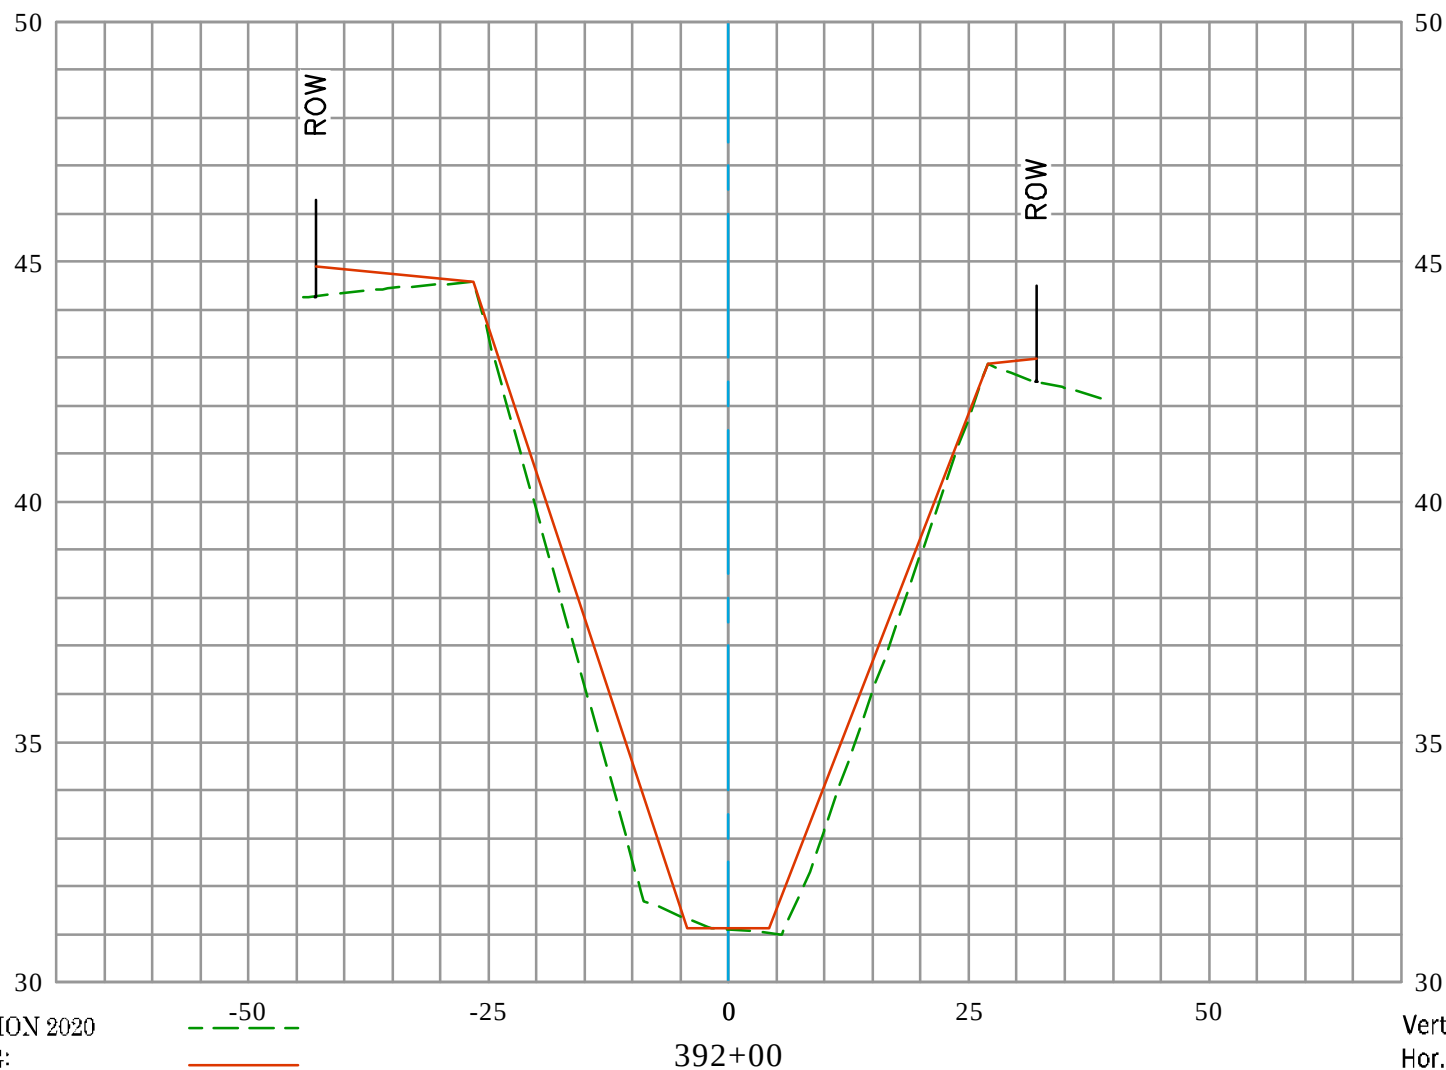


EXISTING CONDITION 2020
 RECORD DRAWING:
 D03-101-2A, D03-101-3A, & D03-101-7R
 DATE PREPARED: 01/24/2022

Vert. Scale: 1" = 4'
 Hor. Scale: 1" = 20'




GREENVILLE BANNING CHANNEL (D03) CL

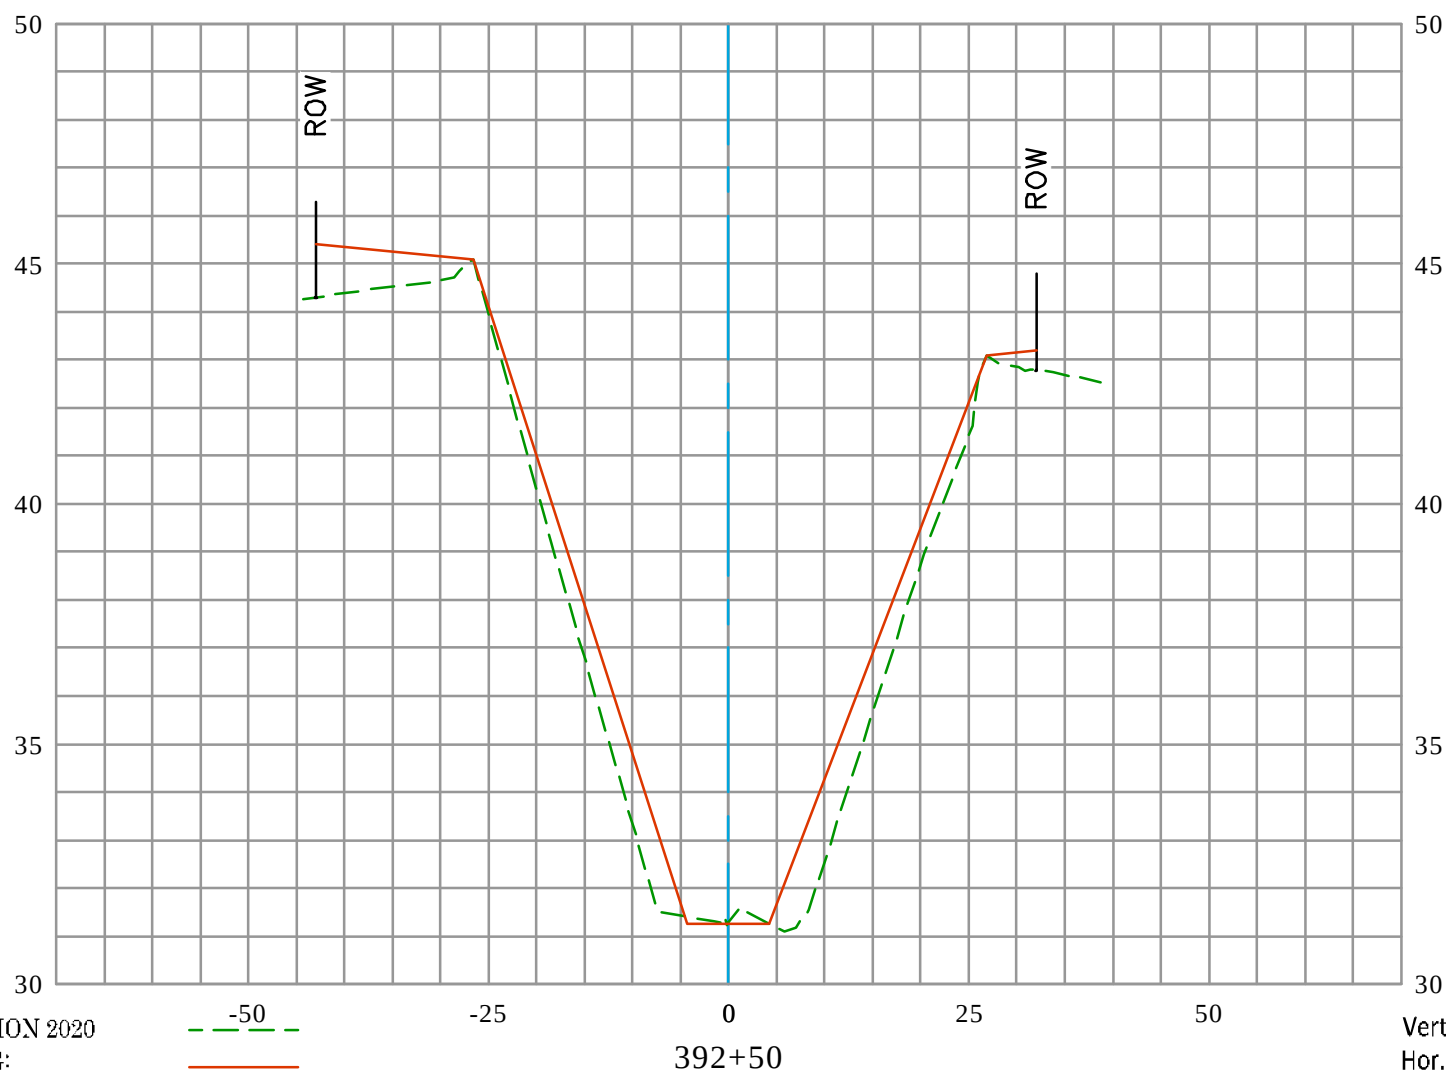

EXISTING CONDITION 2020
 RECORD DRAWING:
 D03-101-2A, D03-101-3A, & D03-101-7R
 DATE PREPARED: 01/24/2022



GREENVILLE BANNING CHANNEL (D03) CL

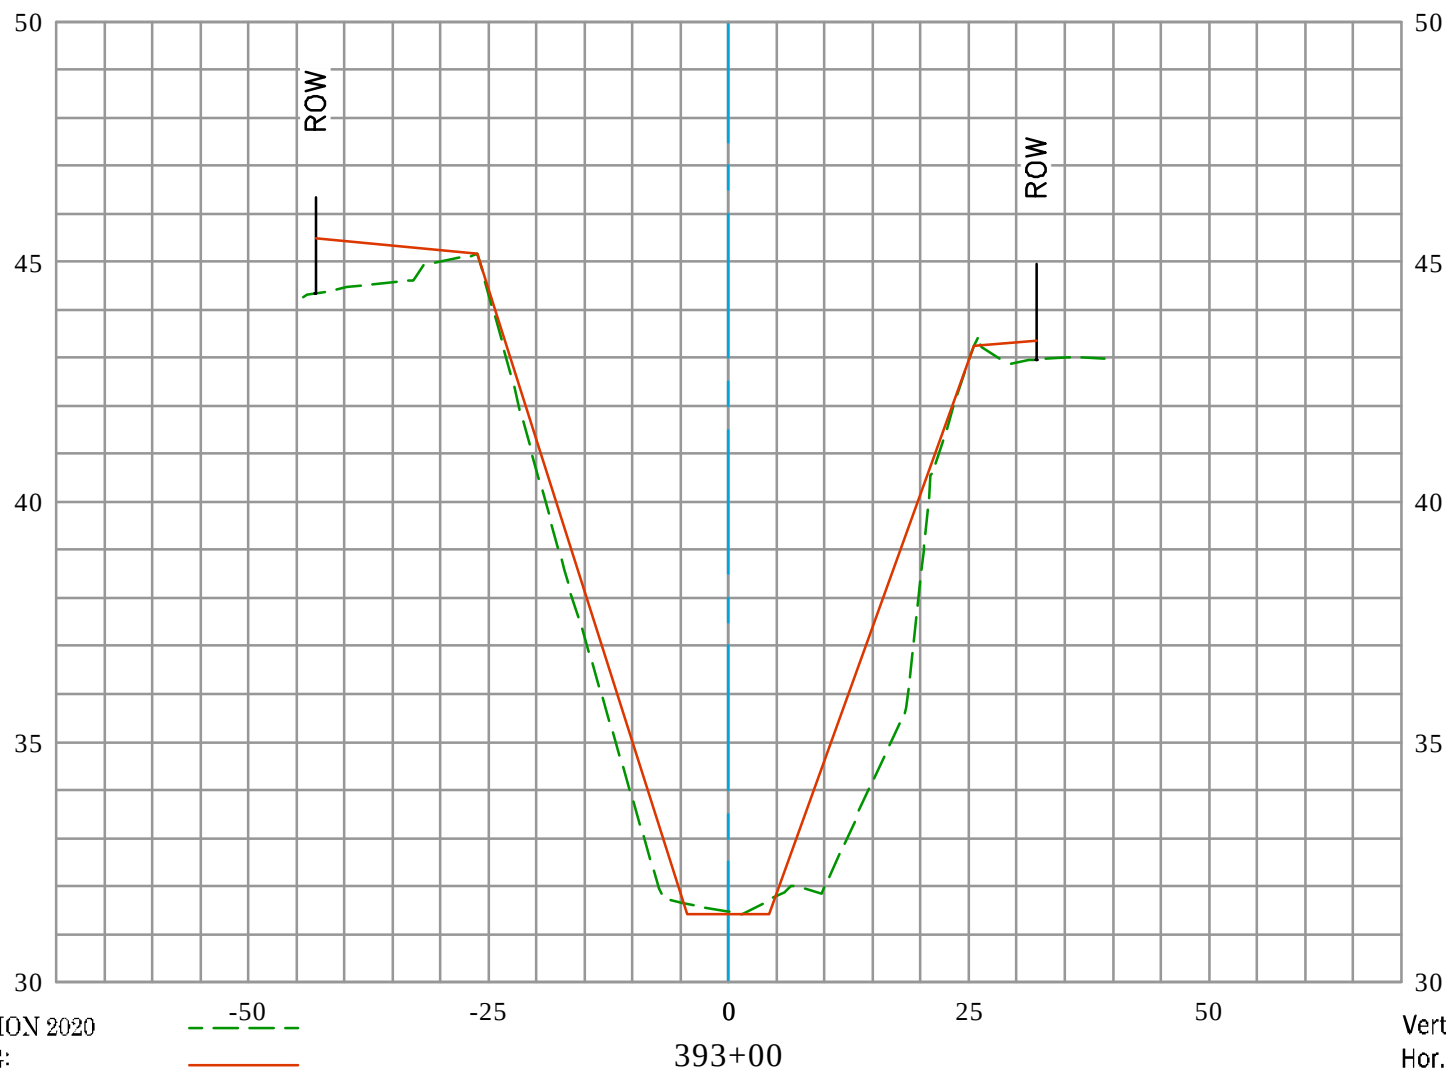


EXISTING CONDITION 2020
 RECORD DRAWING:
 D03-101-2A, D03-101-3A, & D03-101-7R
 DATE PREPARED: 01/24/2022

Vert. Scale: 1" = 4'
 Hor. Scale: 1" = 20'



GREENVILLE BANNING CHANNEL (D03) CL

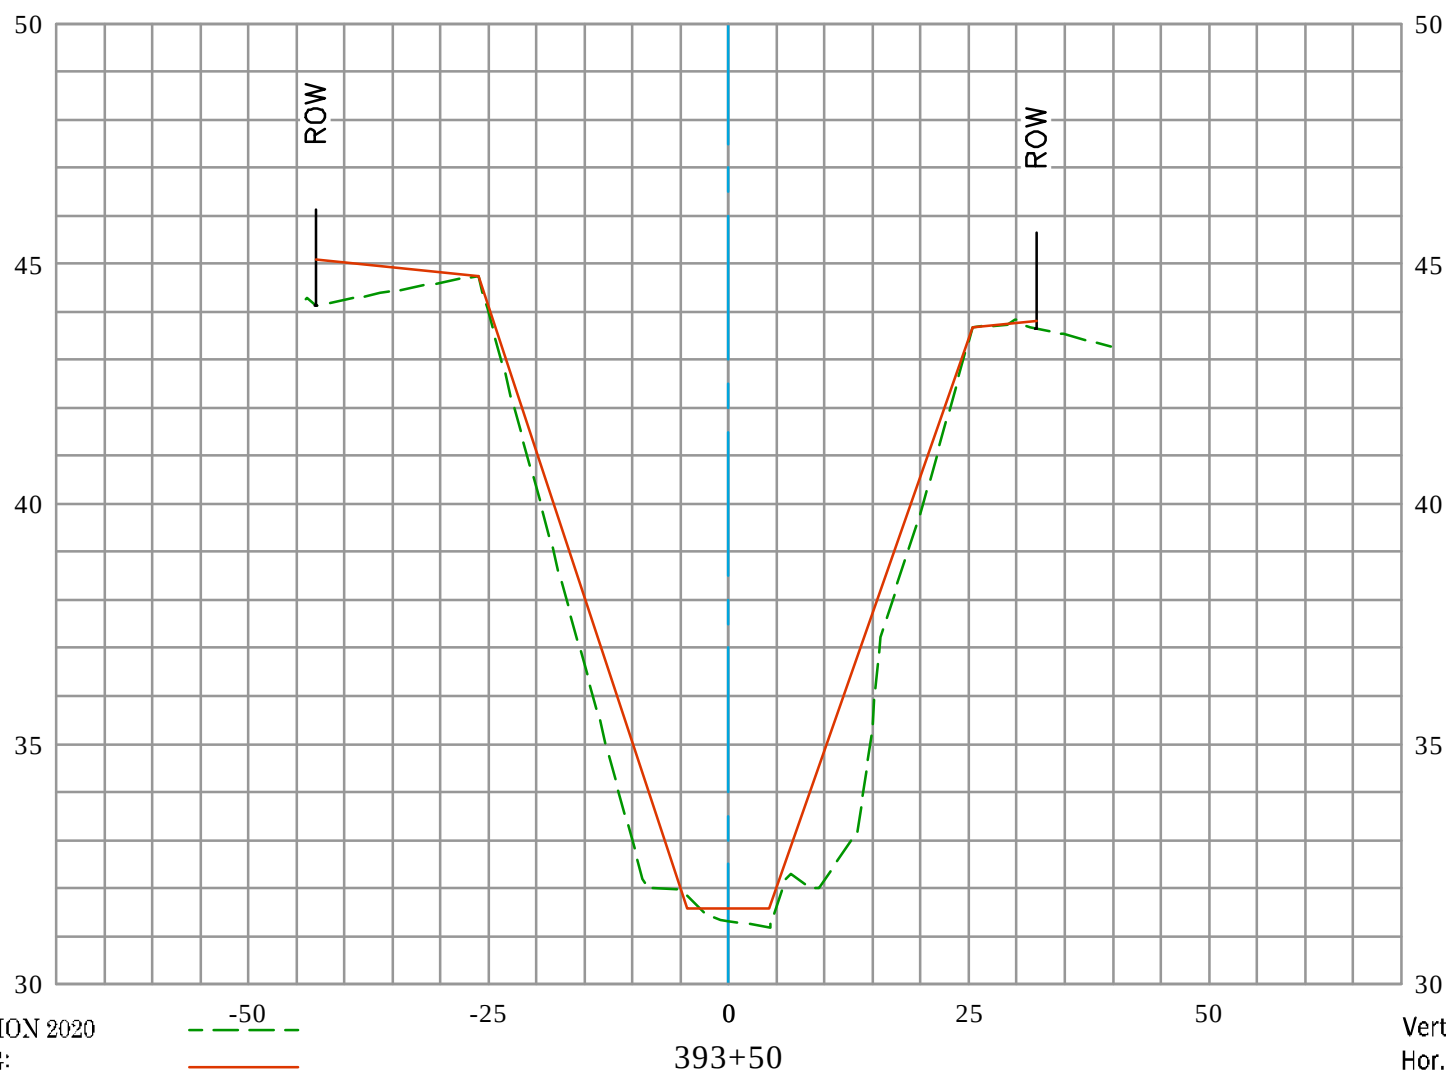


EXISTING CONDITION 2020
 RECORD DRAWING:
 D03-101-2A, D03-101-3A, & D03-101-7R
 DATE PREPARED: 01/24/2022

Vert. Scale: 1" = 4'
 Hor. Scale: 1" = 20'



GREENVILLE BANNING CHANNEL (D03) CL

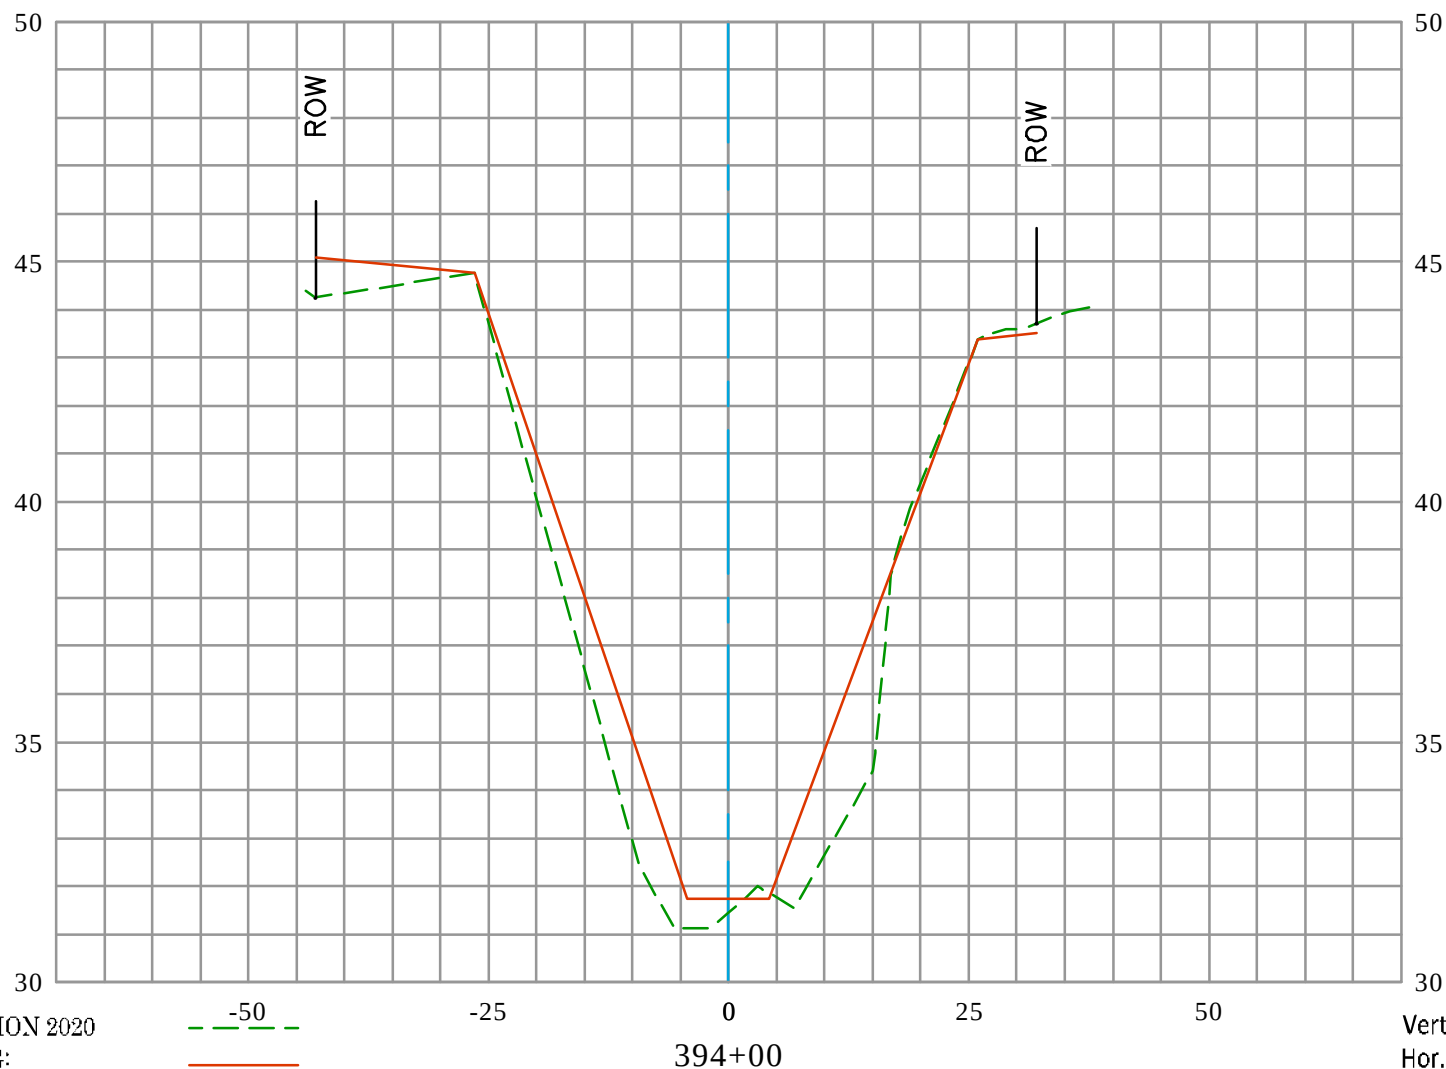


EXISTING CONDITION 2020
 RECORD DRAWING:
 D03-101-2A, D03-101-3A, & D03-101-7R
 DATE PREPARED: 01/24/2022

Vert. Scale: 1" = 4'
 Hor. Scale: 1" = 20'




GREENVILLE BANNING CHANNEL (D03) CL

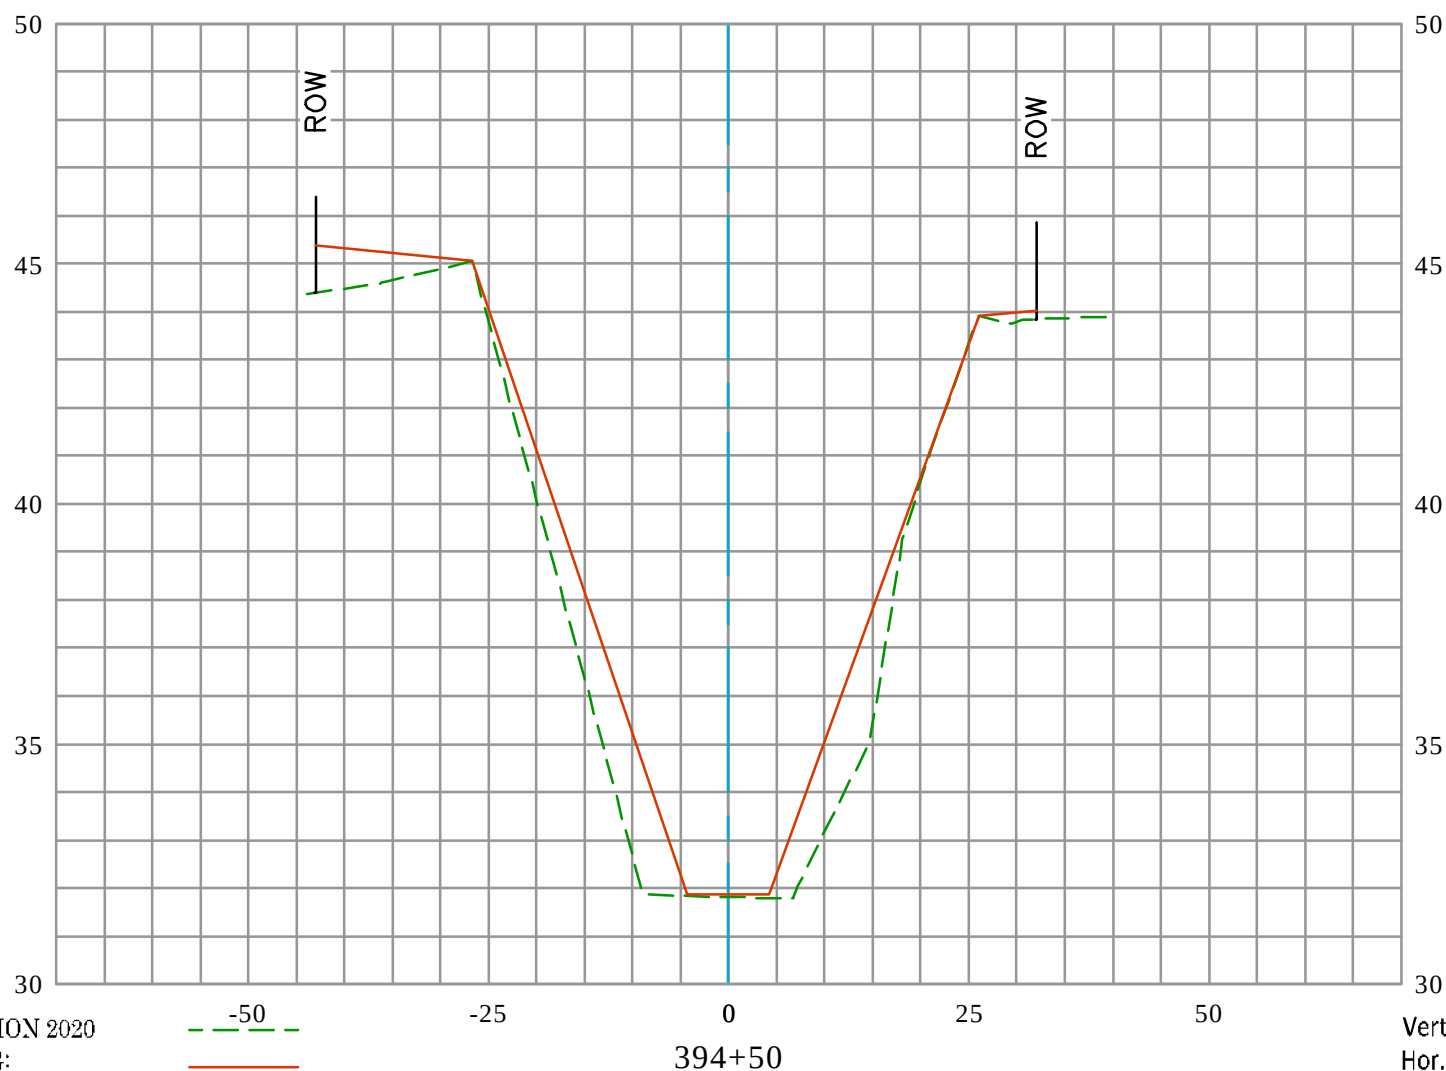

EXISTING CONDITION 2020
 RECORD DRAWING:
 D03-101-2A, D03-101-3A, & D03-101-7R
 DATE PREPARED: 01/24/2022




GREENVILLE BANNING CHANNEL (D03) CL

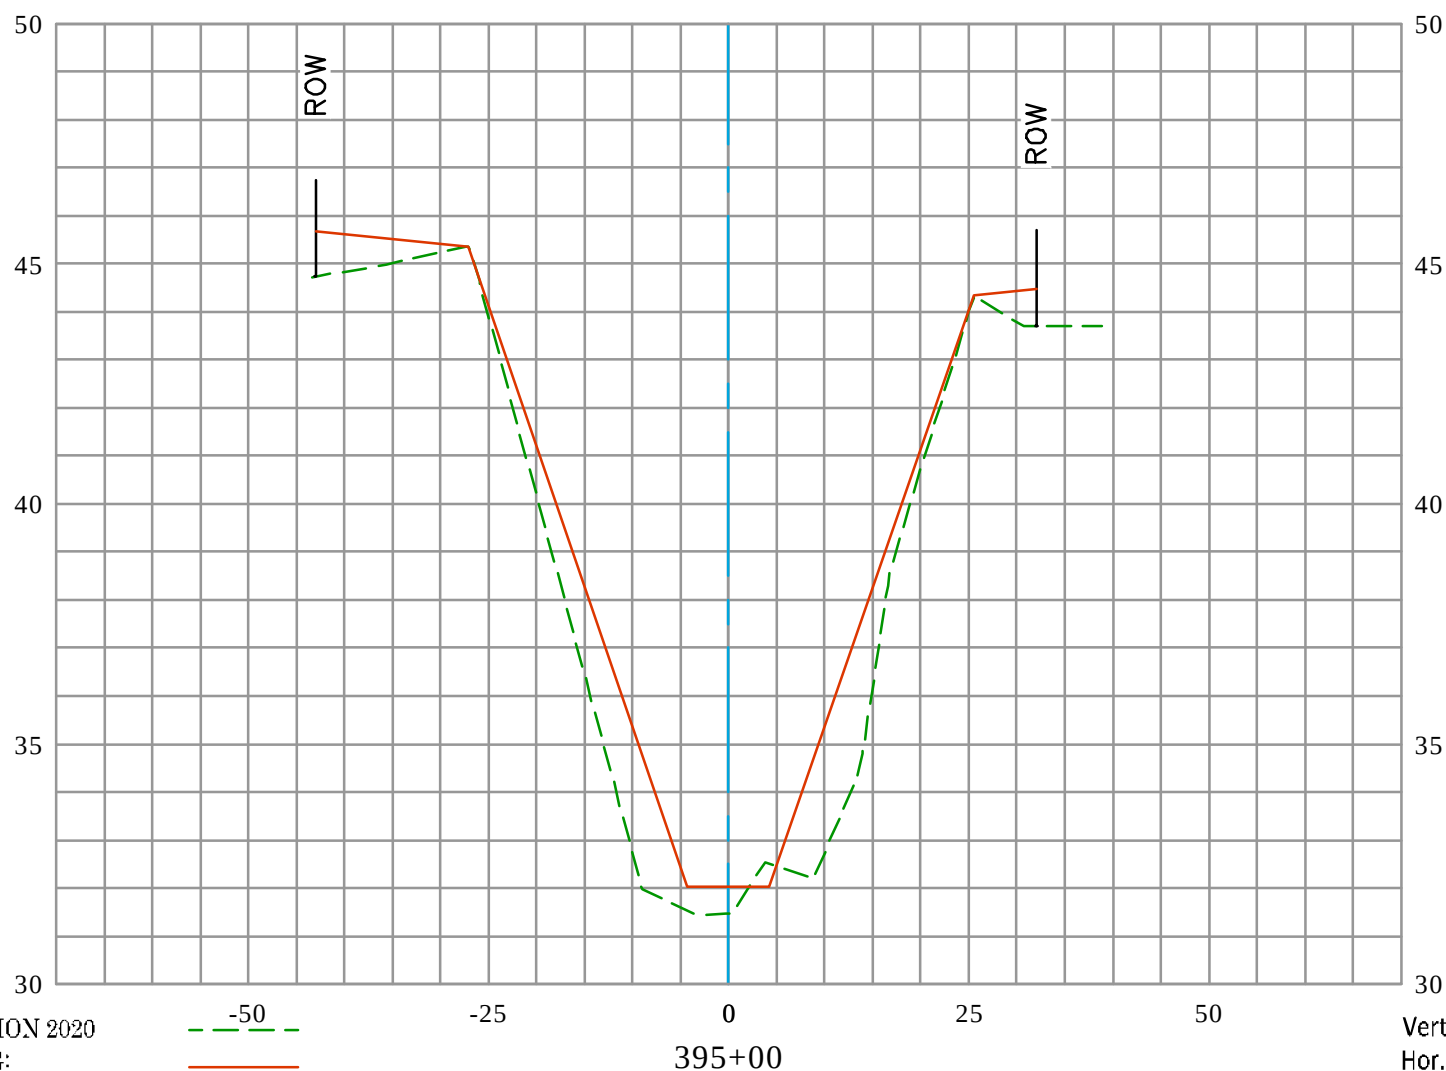

EXISTING CONDITION 2020
 RECORD DRAWING:
 D03-101-2A, D03-101-3A, & D03-101-7R
 DATE PREPARED: 01/24/2022




GREENVILLE BANNING CHANNEL (D03) CL

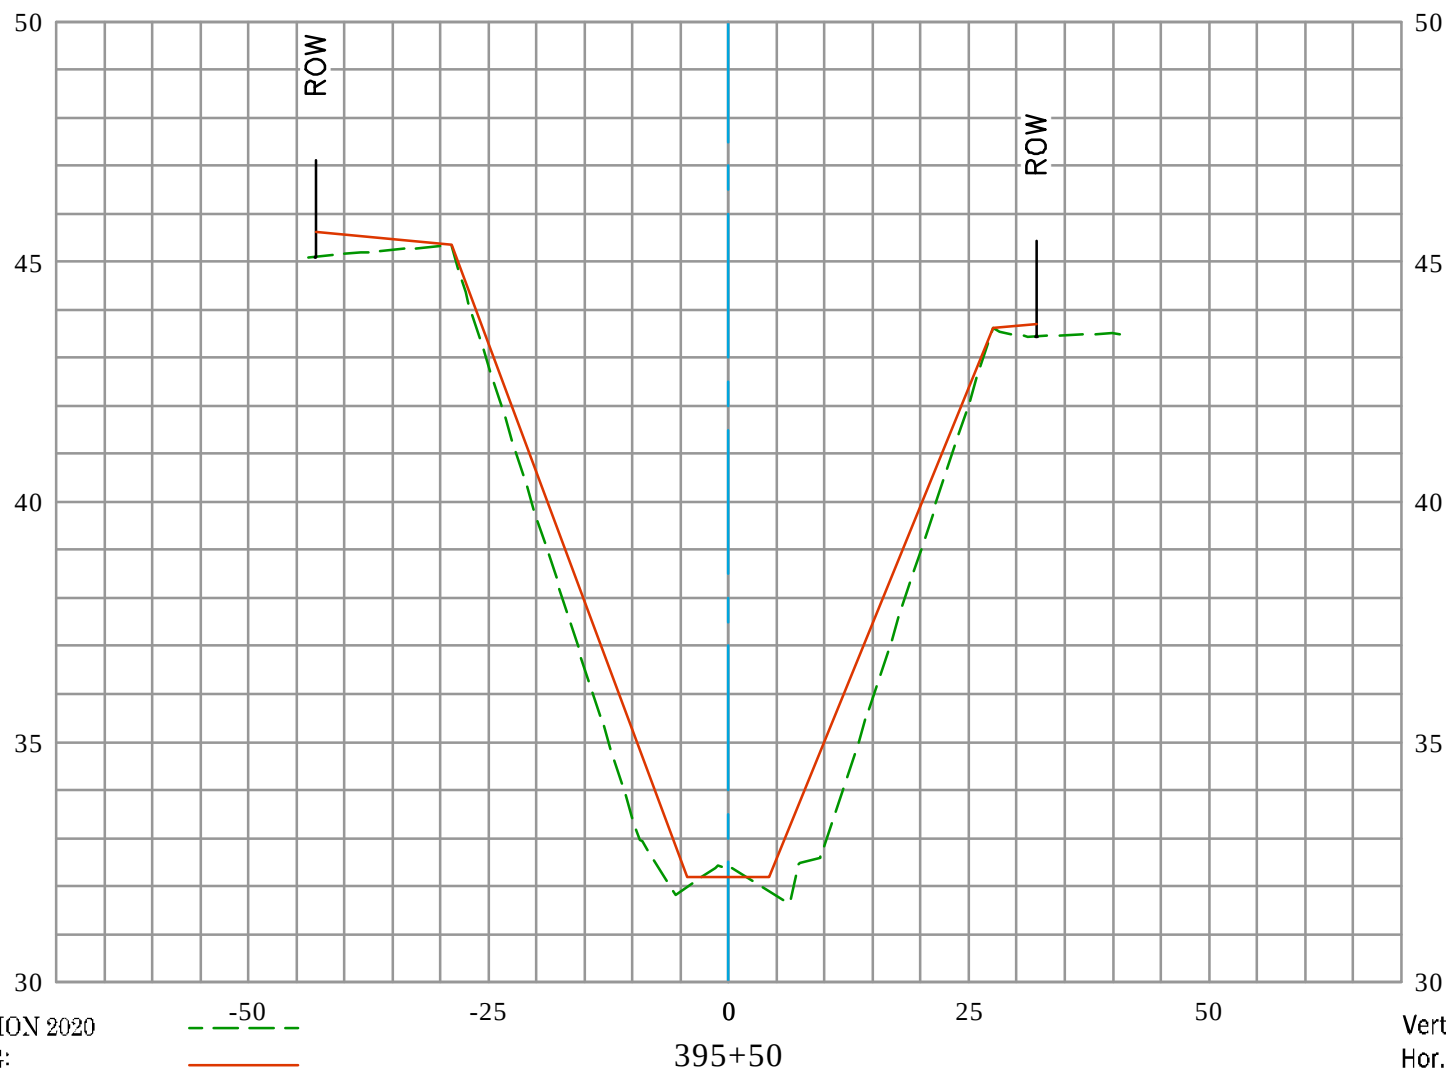



GREENVILLE BANNING CHANNEL (D03) CL

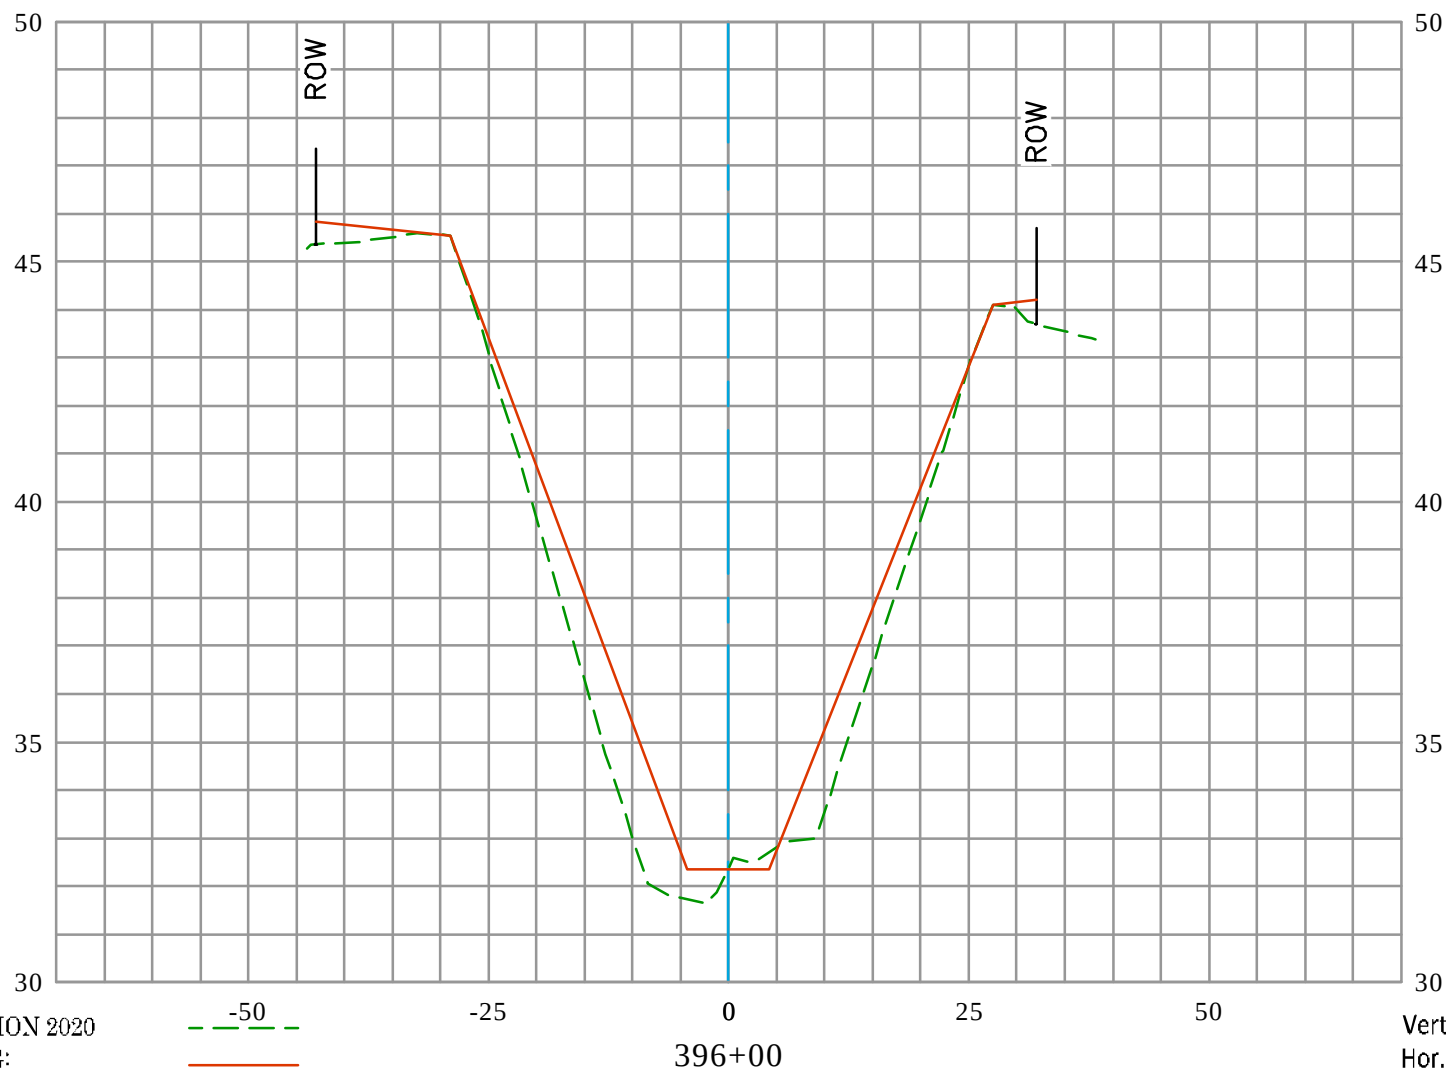


EXISTING CONDITION 2020
 RECORD DRAWING:
 D03-101-2A, D03-101-3A, & D03-101-7R
 DATE PREPARED: 01/24/2022

Vert. Scale: 1" = 4'
 Hor. Scale: 1" = 20'



GREENVILLE BANNING CHANNEL (D03) CL

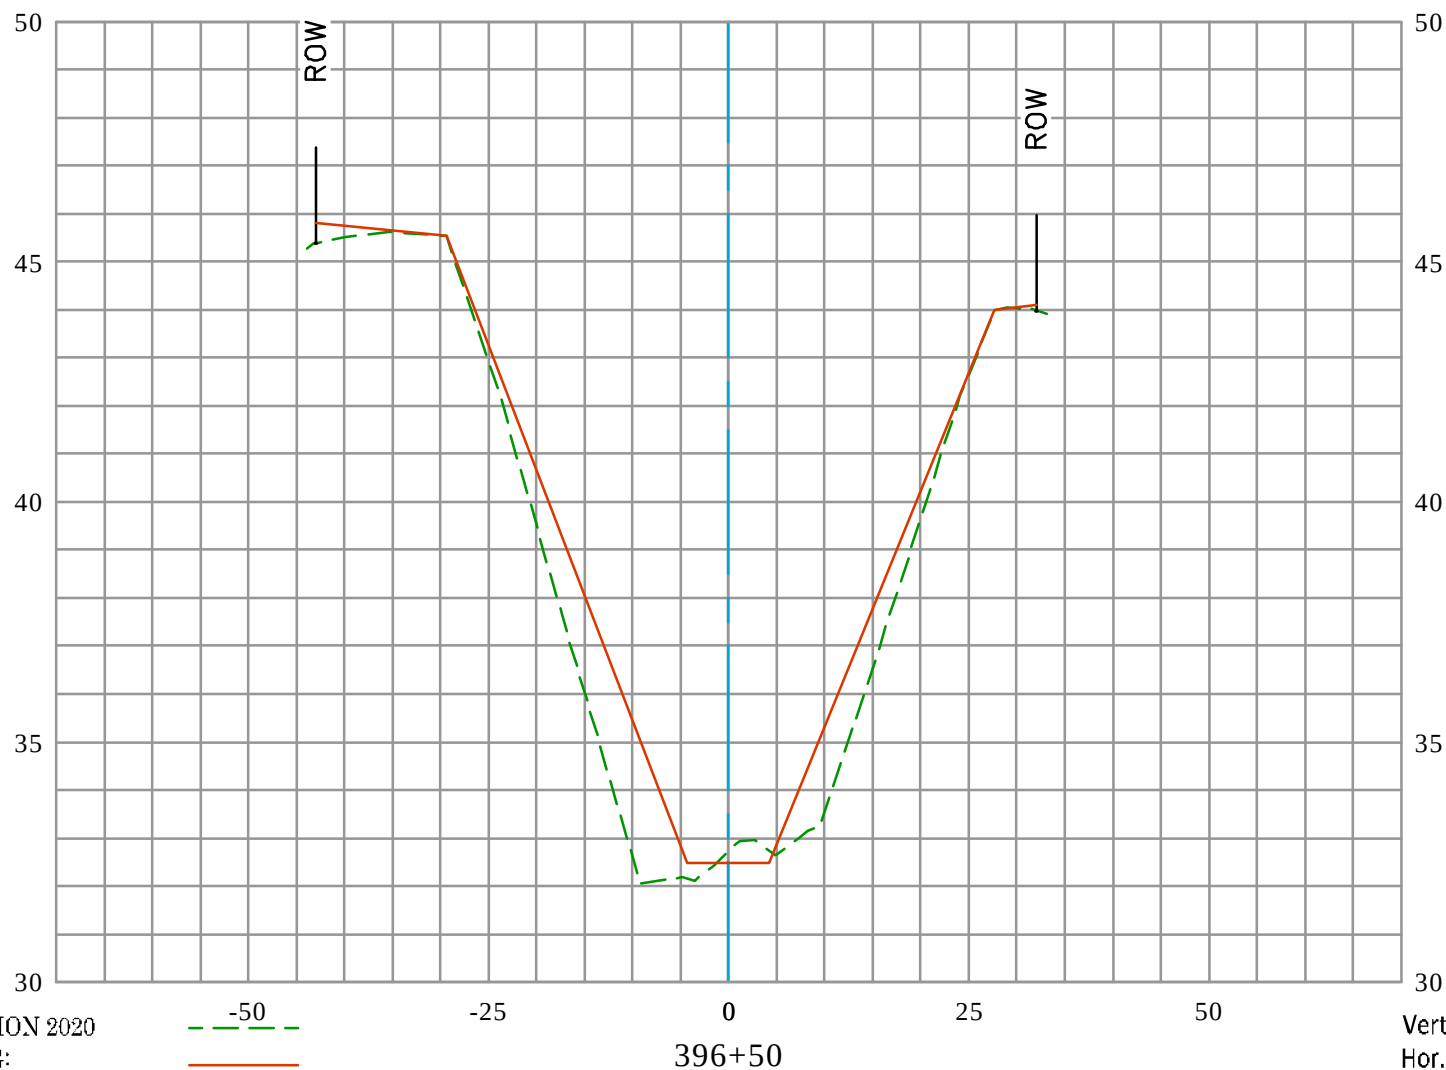


EXISTING CONDITION 2020
 RECORD DRAWING:
 D03-101-2A, D03-101-3A, & D03-101-7R
 DATE PREPARED: 01/24/2022

Vert. Scale: 1" = 4'
 Hor. Scale: 1" = 20'



GREENVILLE BANNING CHANNEL (D03) CL

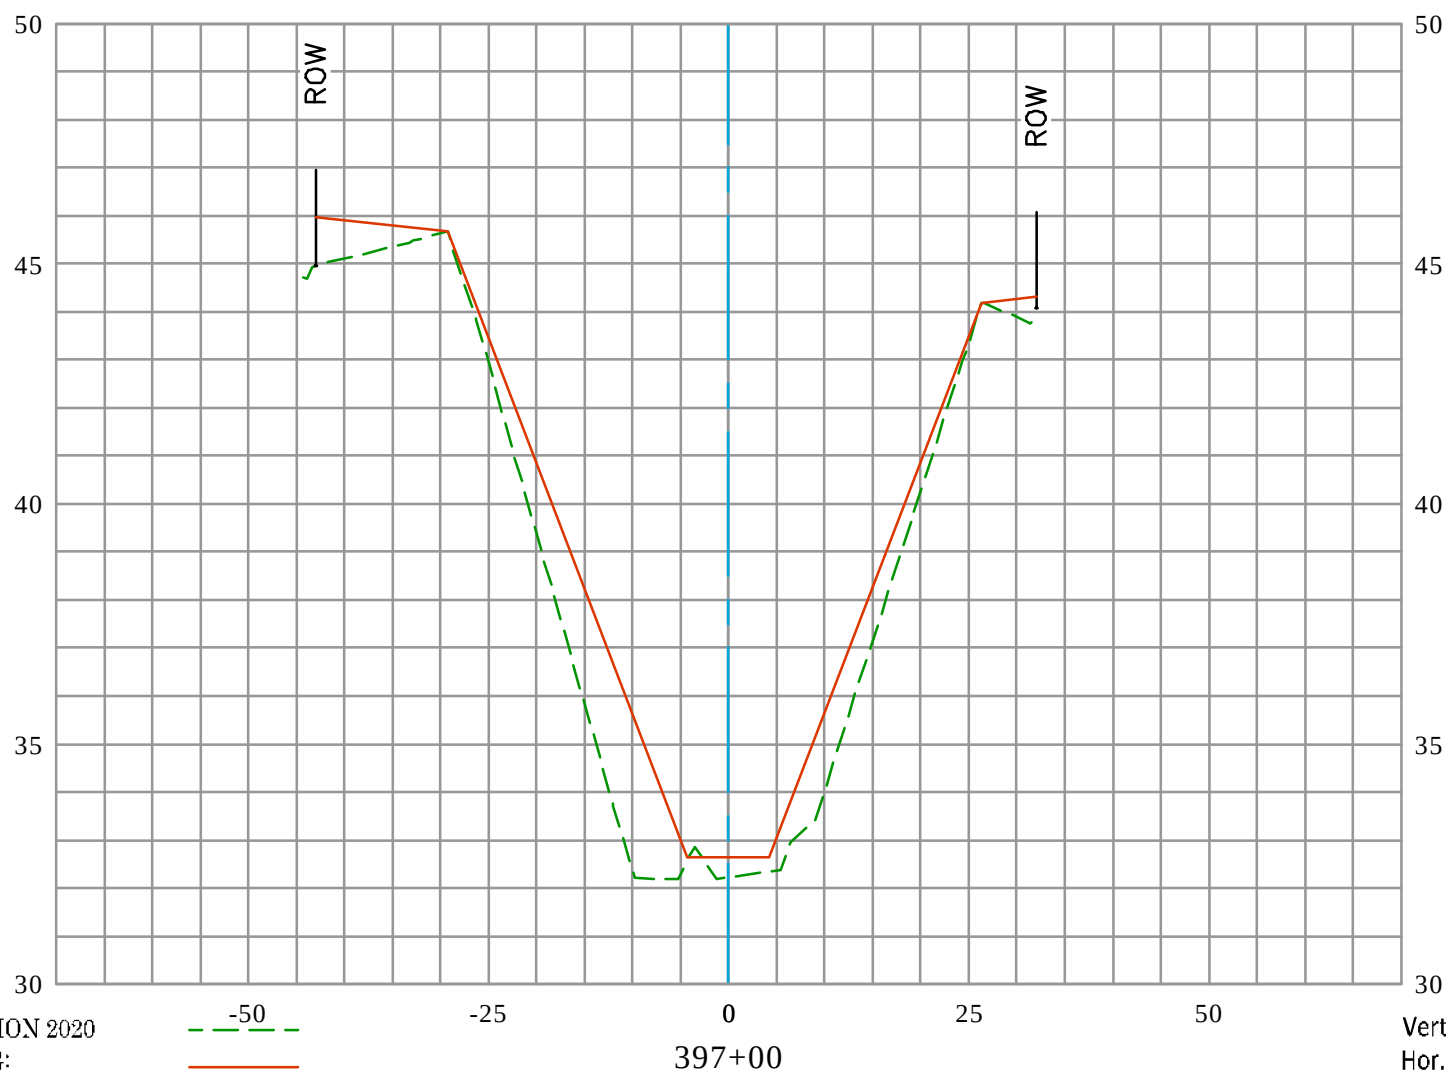


EXISTING CONDITION 2020
 RECORD DRAWING:
 D03-101-2A, D03-101-3A, & D03-101-7R
 DATE PREPARED: 01/24/2022

Vert. Scale: 1" = 4'
 Hor. Scale: 1" = 20'




GREENVILLE BANNING CHANNEL (D03) CL

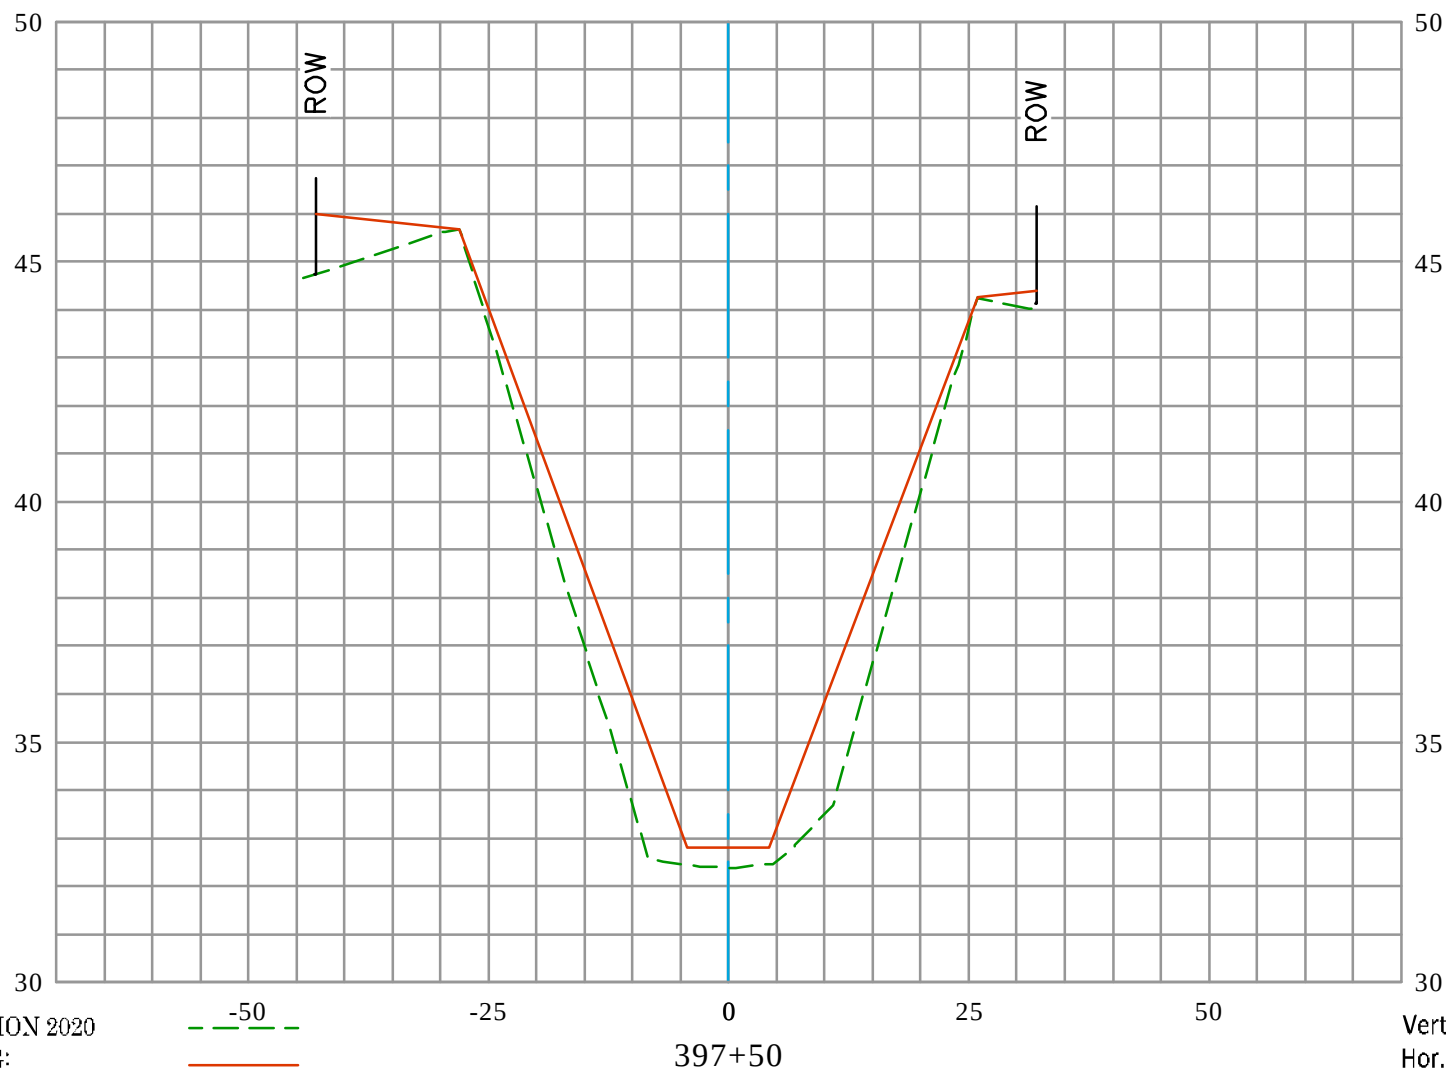

EXISTING CONDITION 2020
 RECORD DRAWING:
 D03-101-2A, D03-101-3A, & D03-101-7R
 DATE PREPARED: 01/24/2022




GREENVILLE BANNING CHANNEL (D03) CL

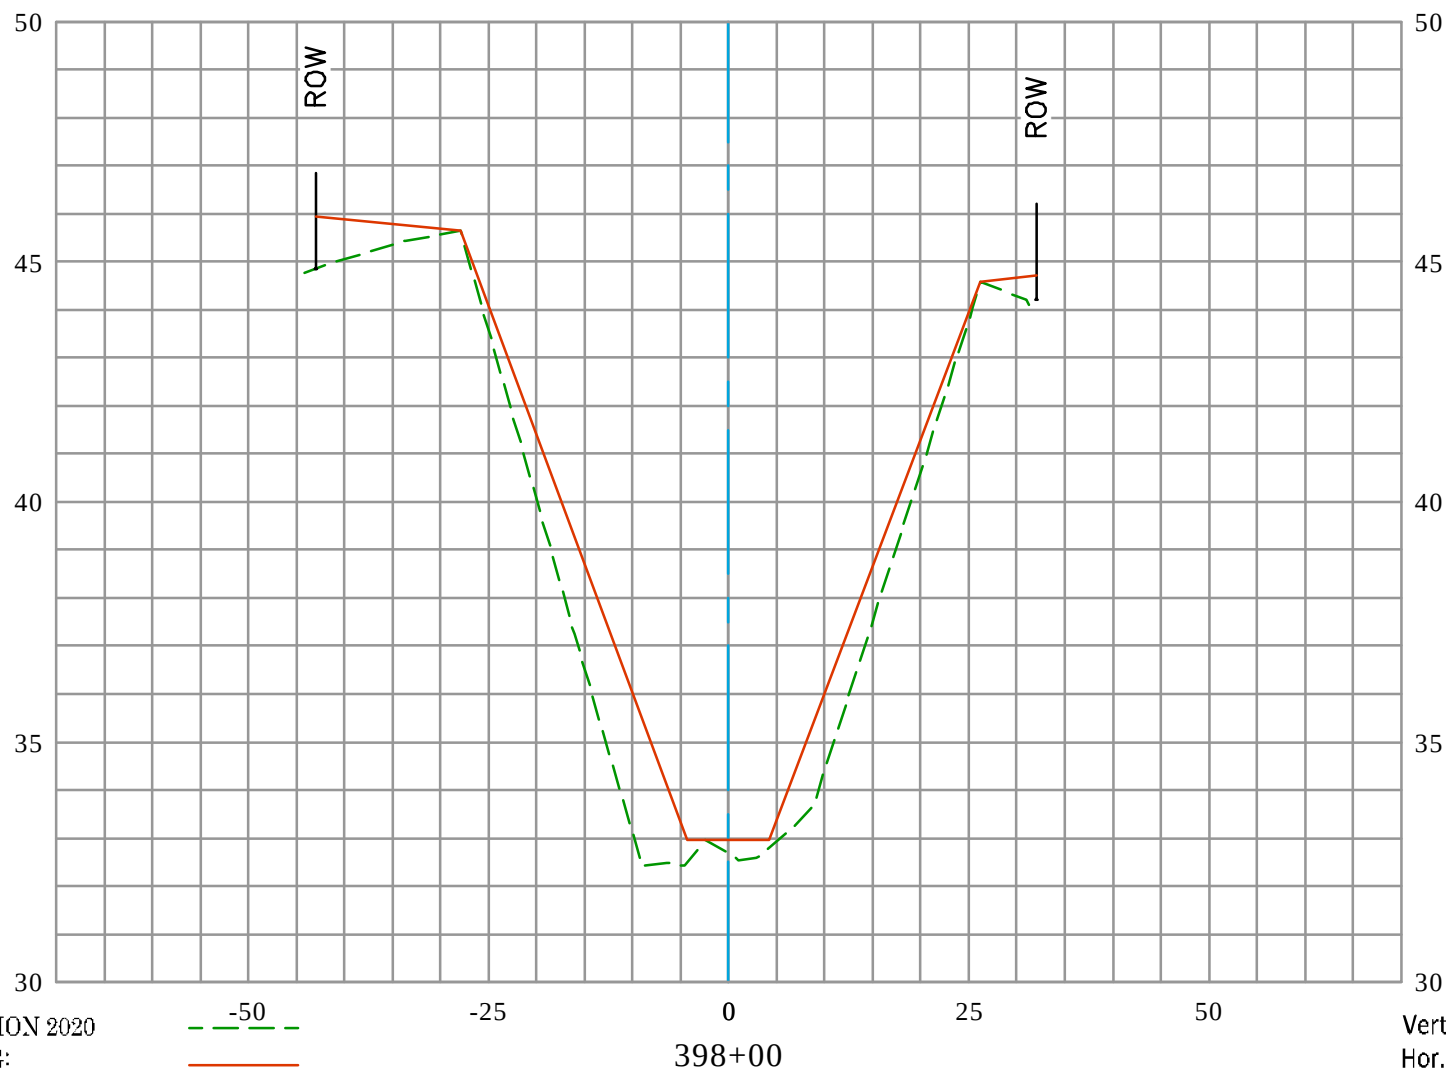

EXISTING CONDITION 2020
 RECORD DRAWING:
 D03-101-2A, D03-101-3A, & D03-101-7R
 DATE PREPARED: 01/24/2022




GREENVILLE BANNING CHANNEL (D03) CL

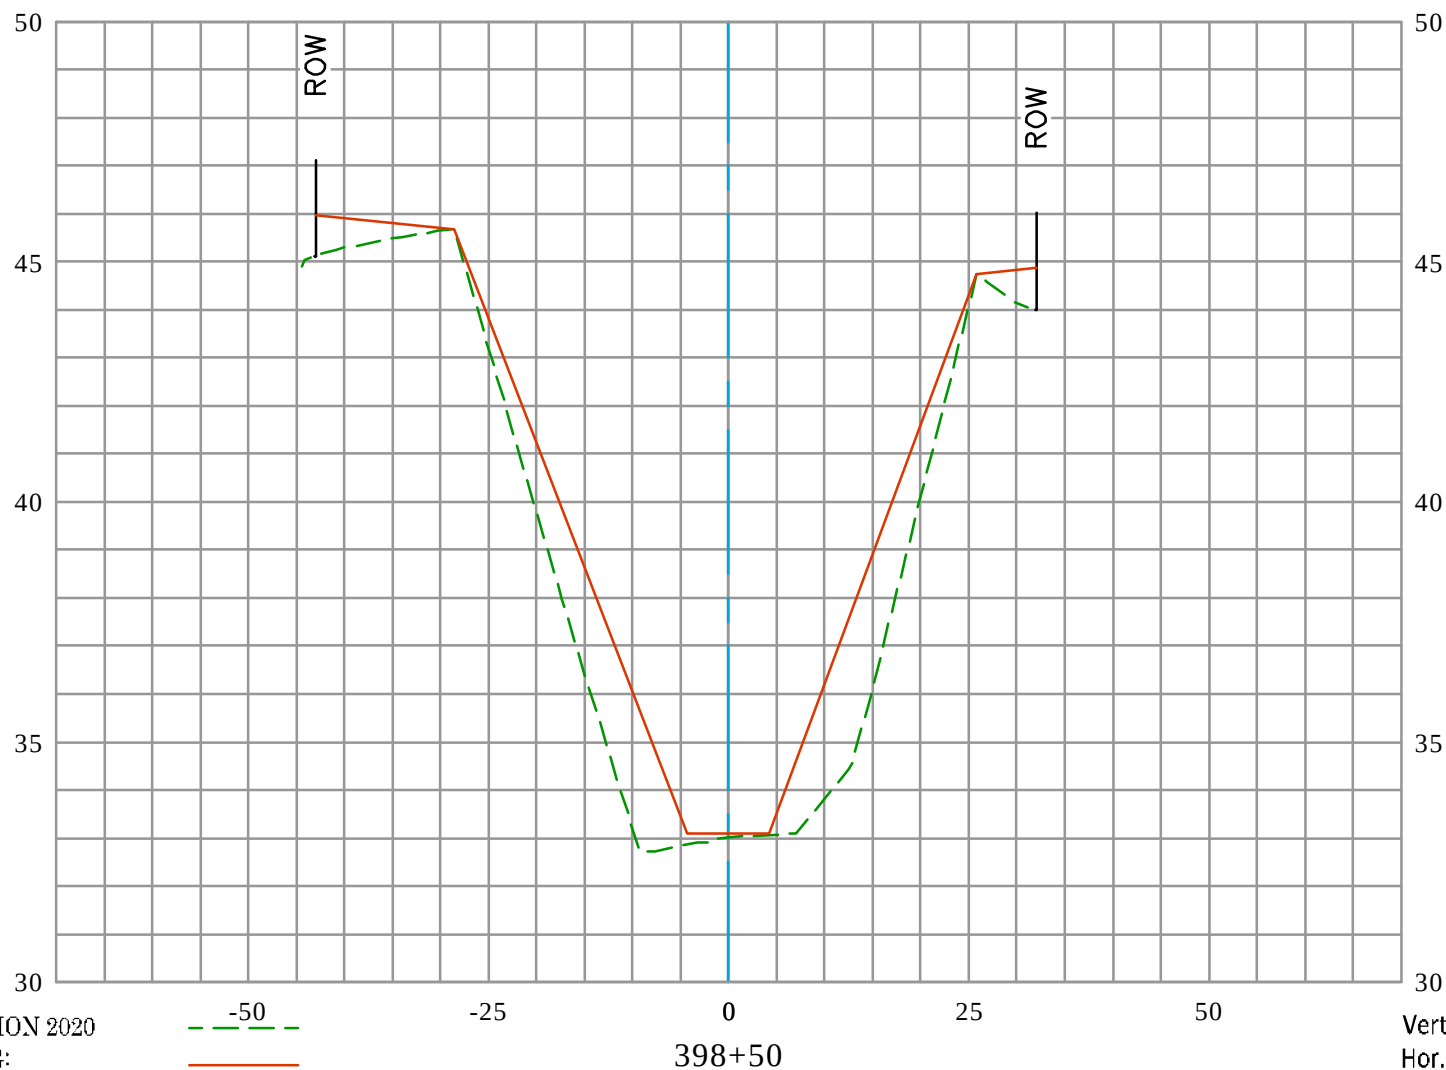

EXISTING CONDITION 2020
RECORD DRAWING:
D03-101-2A, D03-101-3A, & D03-101-7R
DATE PREPARED: 01/24/2022




GREENVILLE BANNING CHANNEL (D03) CL

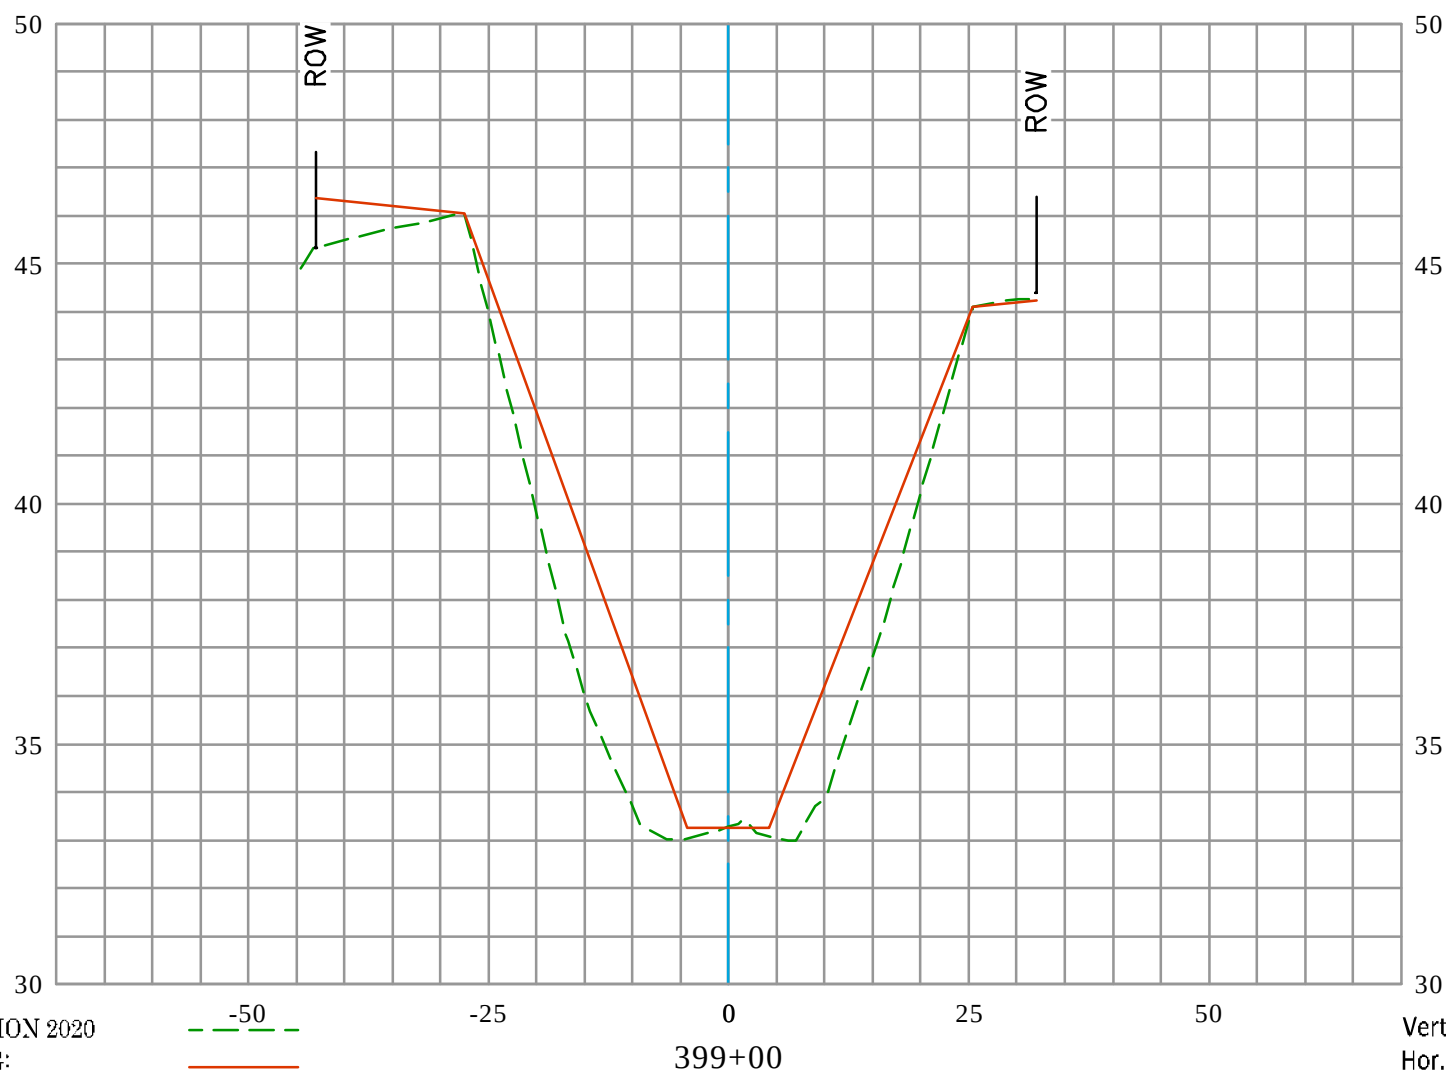

EXISTING CONDITION 2020
 RECORD DRAWING:
 D03-101-2A, D03-101-3A, & D03-101-7R
 DATE PREPARED: 01/24/2022



GREENVILLE BANNING CHANNEL (D03) CL

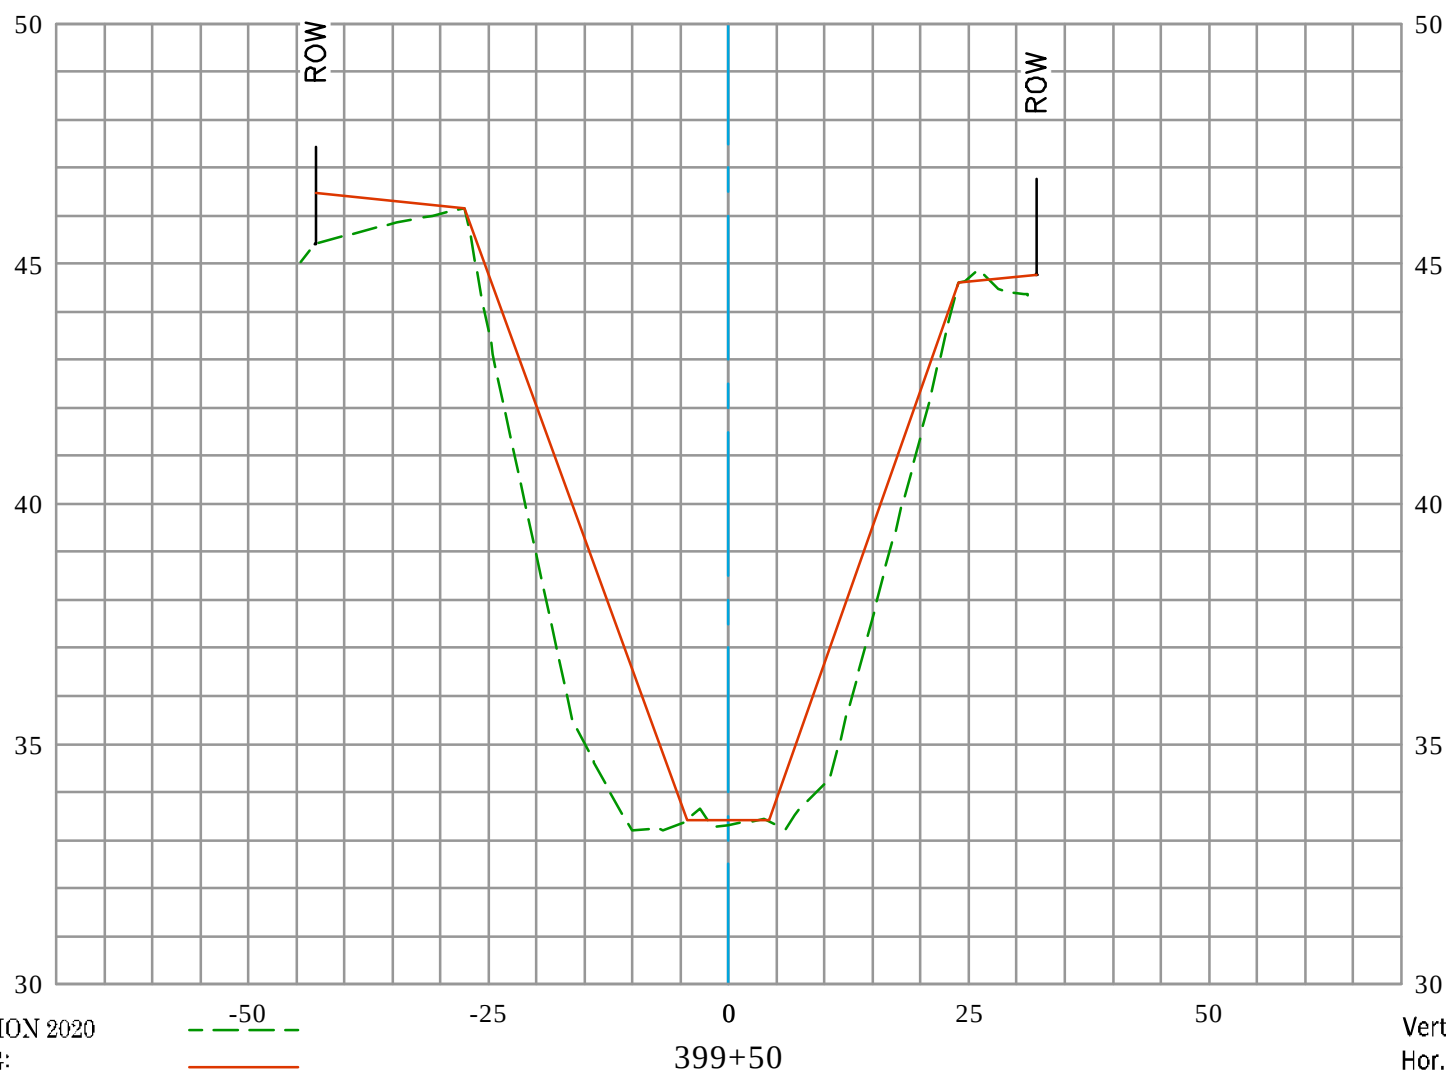


EXISTING CONDITION 2020
 RECORD DRAWING:
 D03-101-2A, D03-101-3A, & D03-101-7R
 DATE PREPARED: 01/24/2022

Vert. Scale: 1" = 4'
 Hor. Scale: 1" = 20'




GREENVILLE BANNING CHANNEL (D03) CL

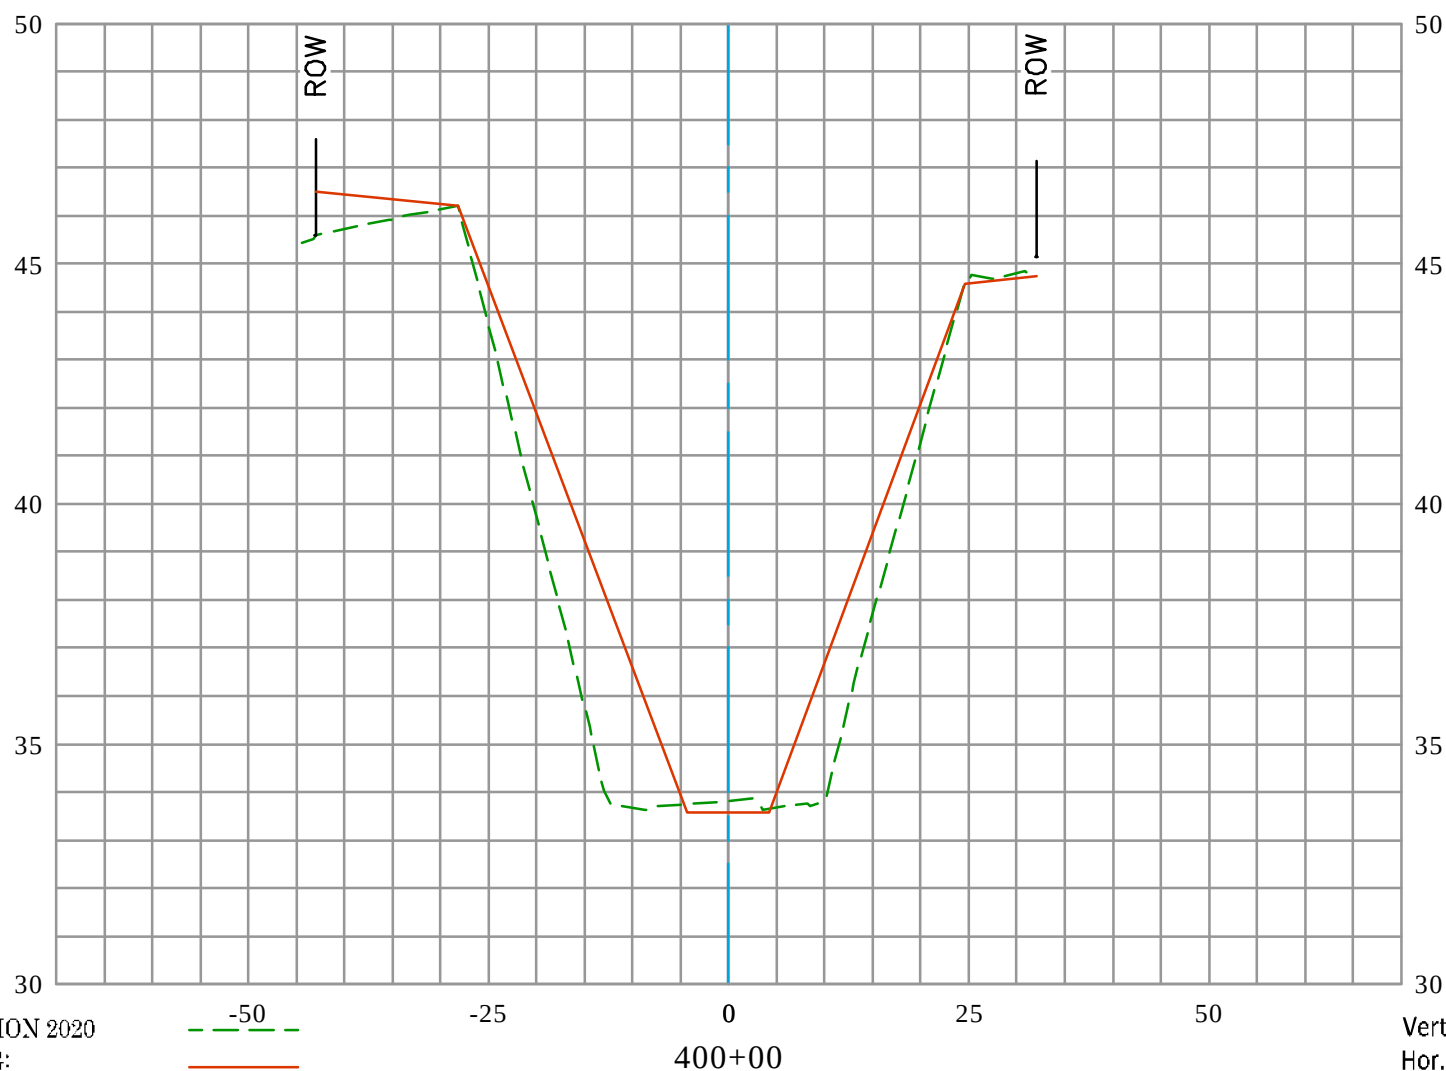

EXISTING CONDITION 2020
 RECORD DRAWING:
 D03-101-2A, D03-101-3A, & D03-101-7R
 DATE PREPARED: 01/24/2022




GREENVILLE BANNING CHANNEL (D03) CL

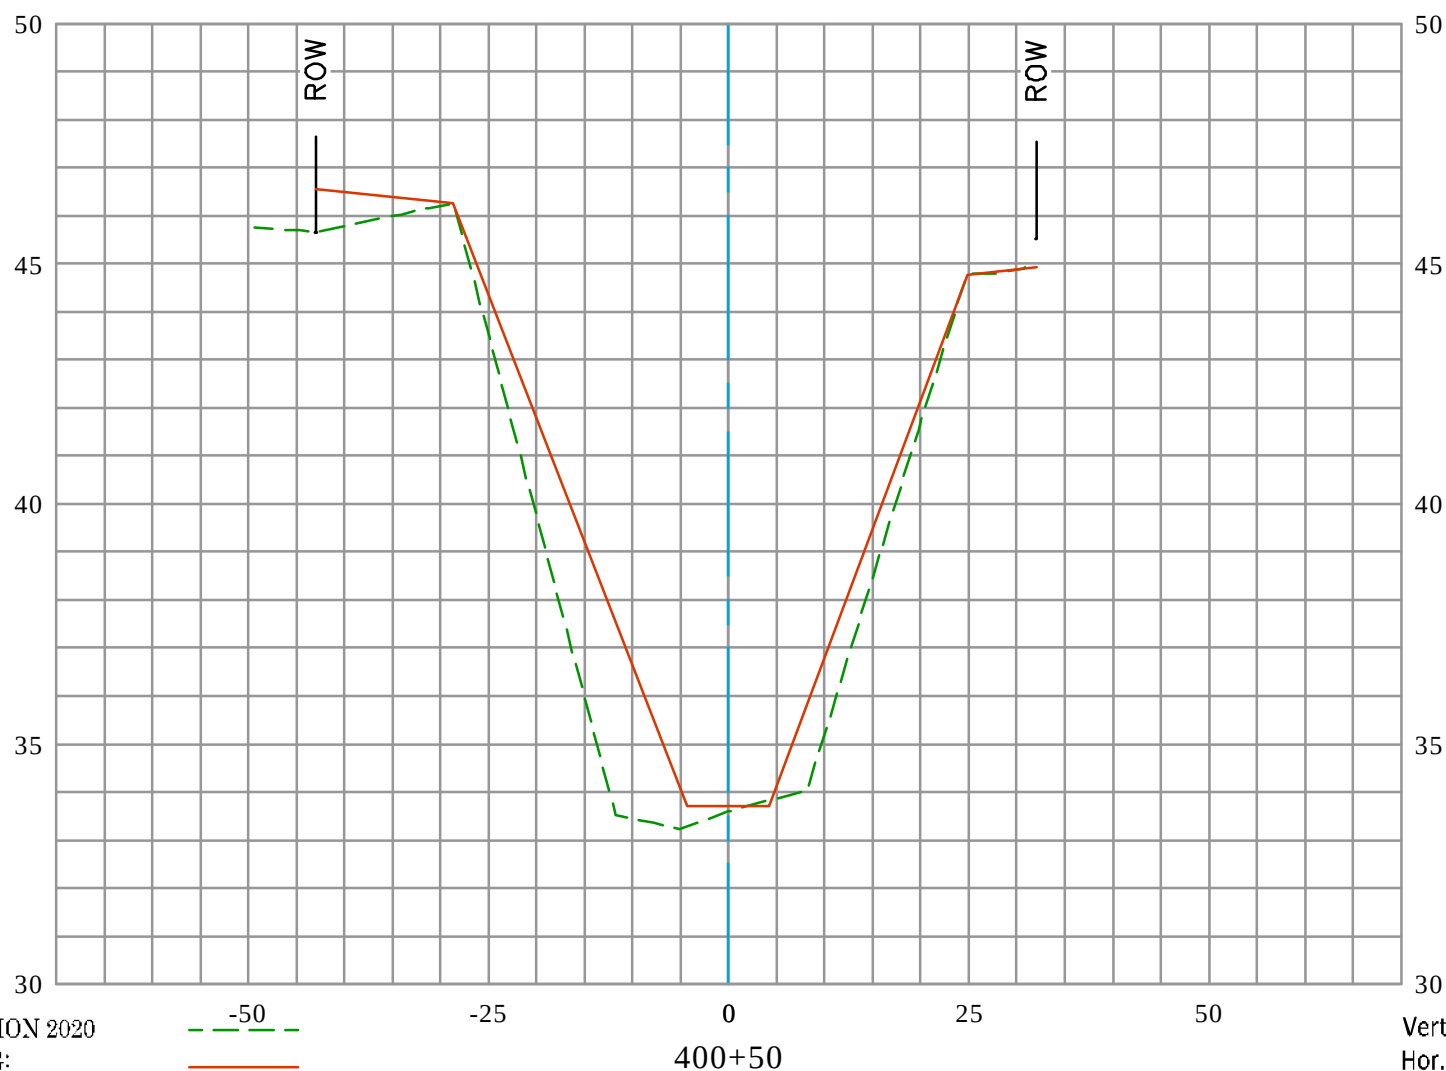

EXISTING CONDITION 2020
 RECORD DRAWING:
 D03-101-2A, D03-101-3A, & D03-101-7R
 DATE PREPARED: 01/24/2022



GREENVILLE BANNING CHANNEL (D03) CL

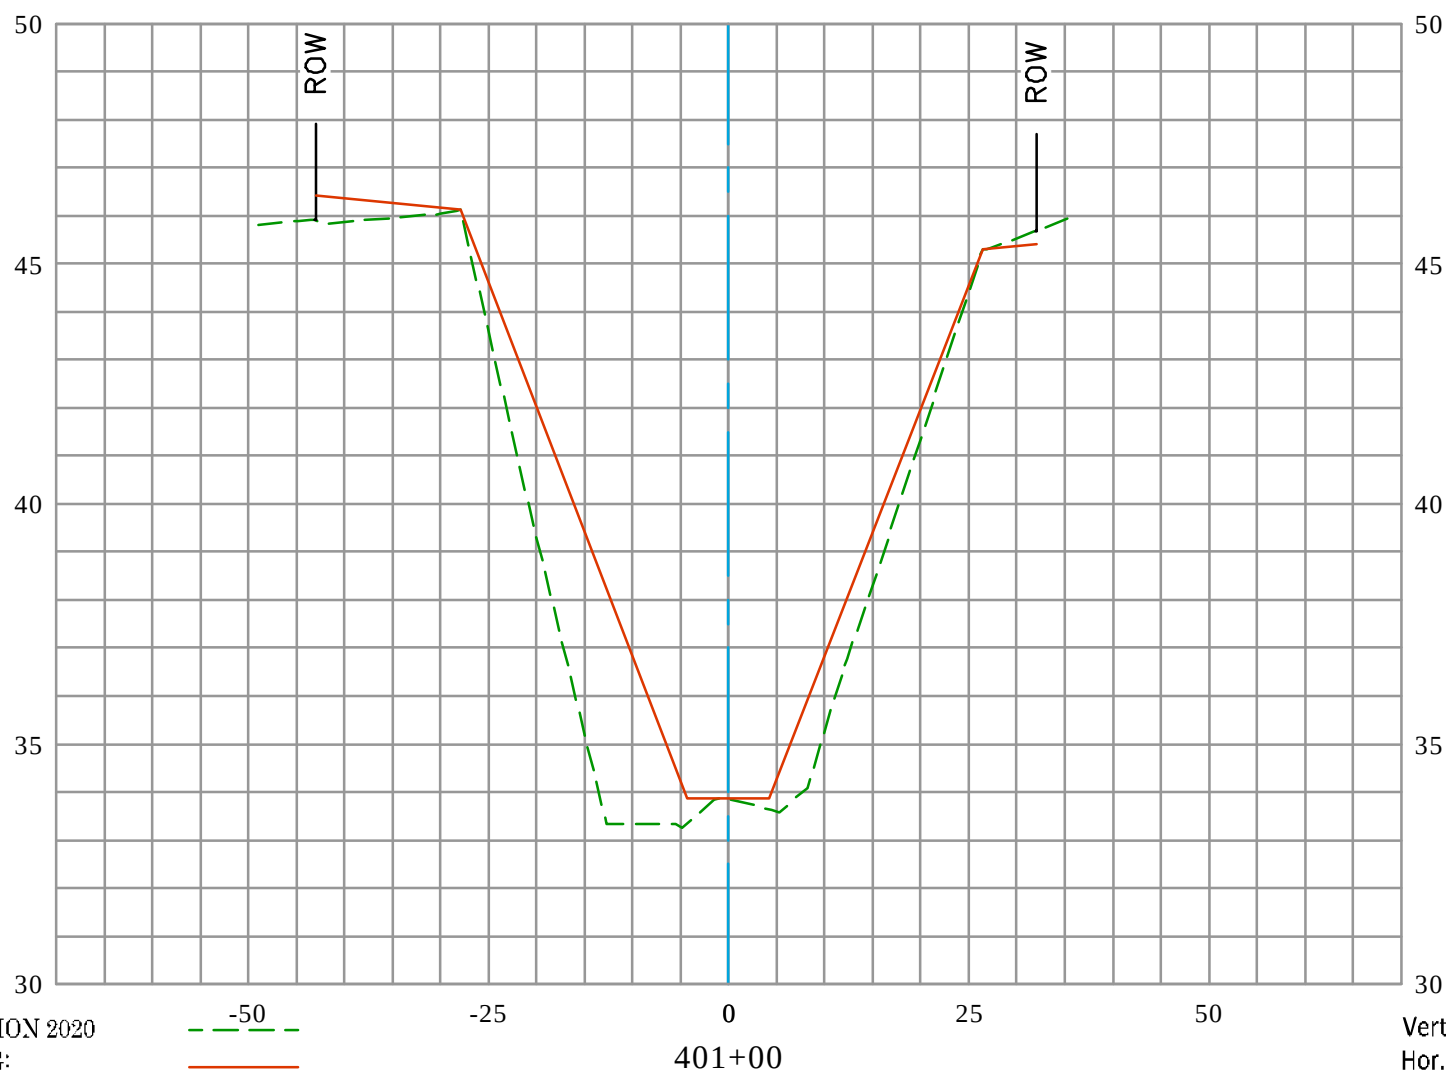


EXISTING CONDITION 2020
 RECORD DRAWING:
 D03-101-2A, D03-101-3A, & D03-101-7R
 DATE PREPARED: 01/24/2022

Vert. Scale: 1" = 4'
 Hor. Scale: 1" = 20'



GREENVILLE BANNING CHANNEL (D03) CL

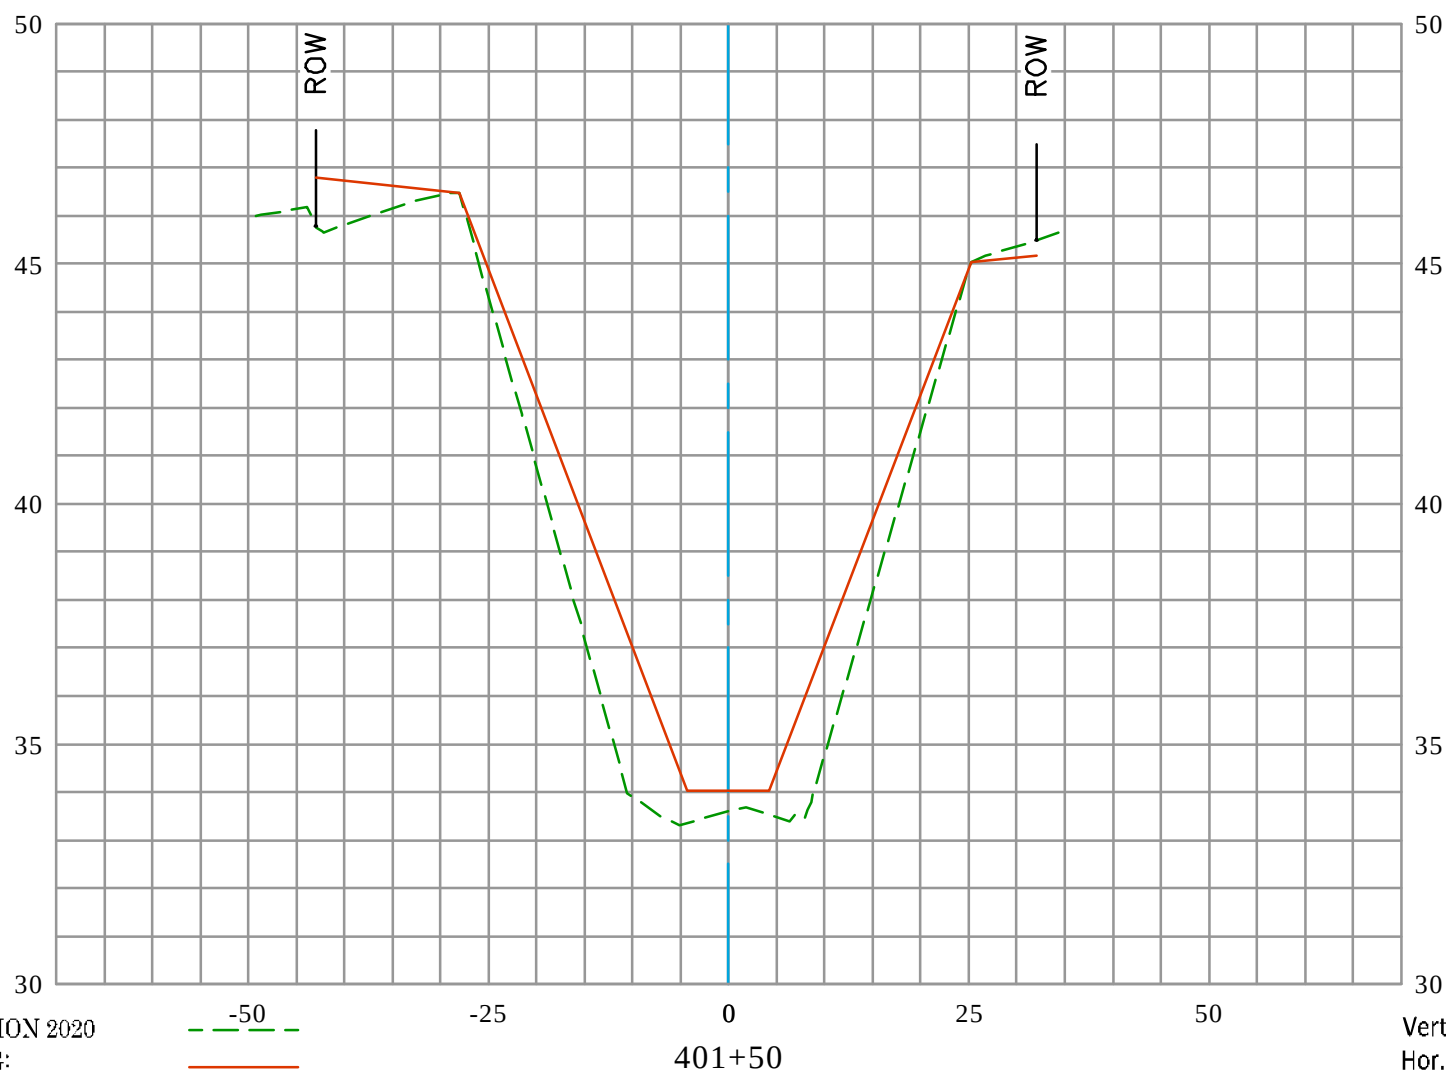


EXISTING CONDITION 2020
 RECORD DRAWING:
 D03-101-2A, D03-101-3A, & D03-101-7R
 DATE PREPARED: 01/24/2022

Vert. Scale: 1" = 4'
 Hor. Scale: 1" = 20'



GREENVILLE BANNING CHANNEL (D03) CL

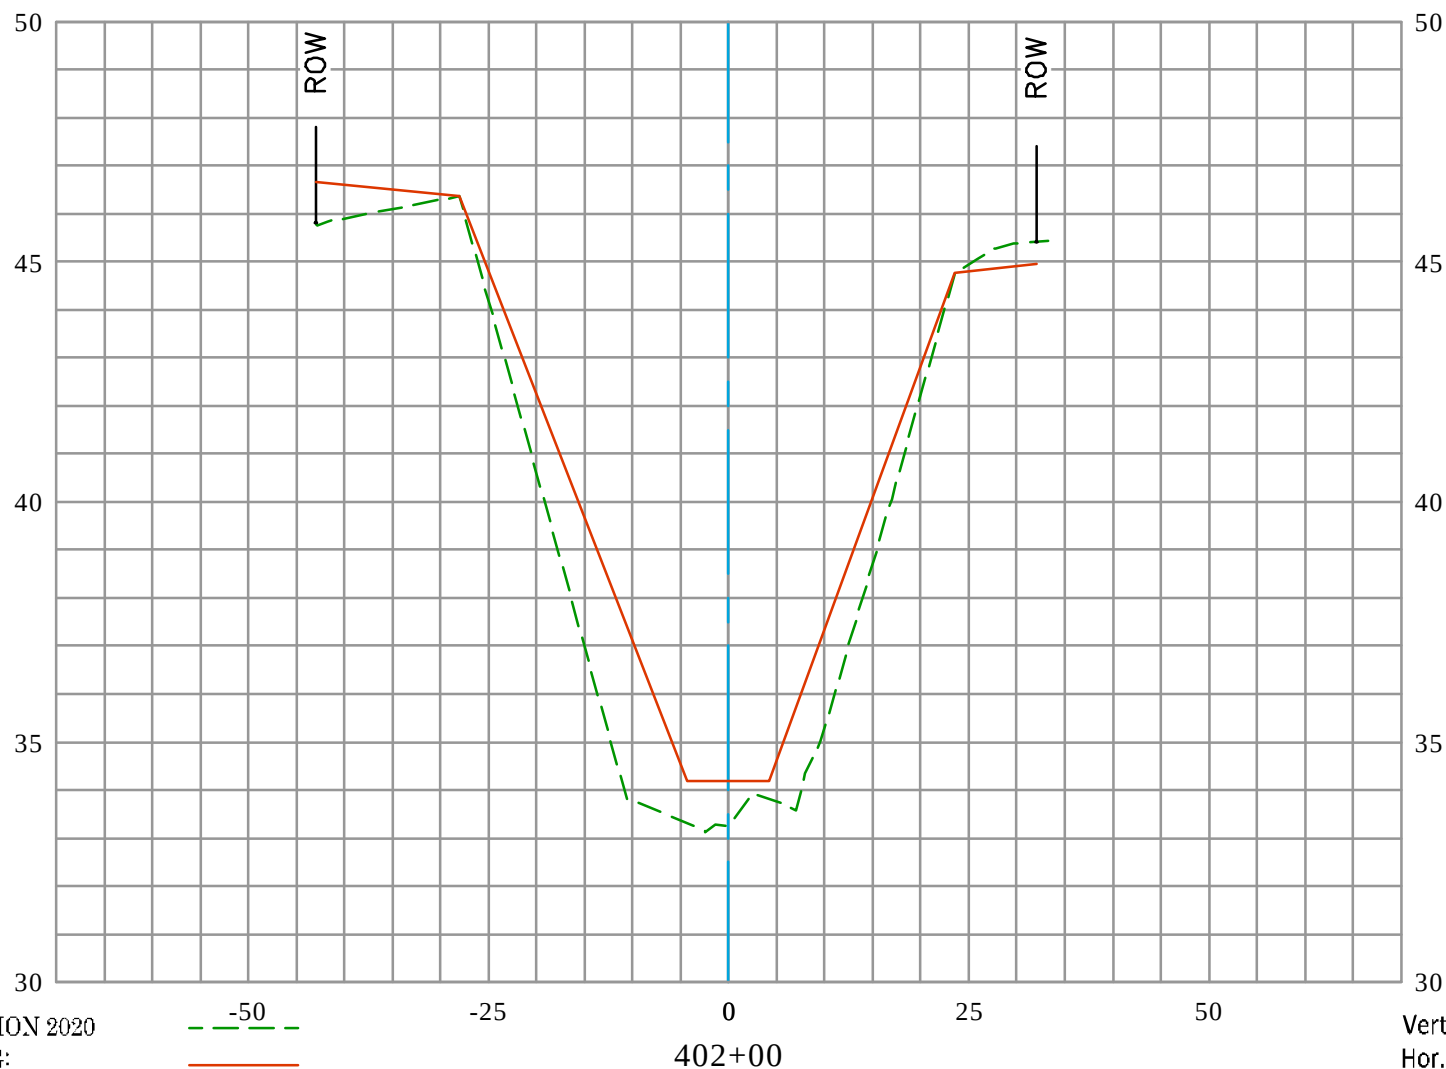


EXISTING CONDITION 2020
 RECORD DRAWING:
 D03-101-2A, D03-101-3A, & D03-101-7R
 DATE PREPARED: 01/24/2022

Vert. Scale: 1" = 4'
 Hor. Scale: 1" = 20'



GREENVILLE BANNING CHANNEL (D03) CL

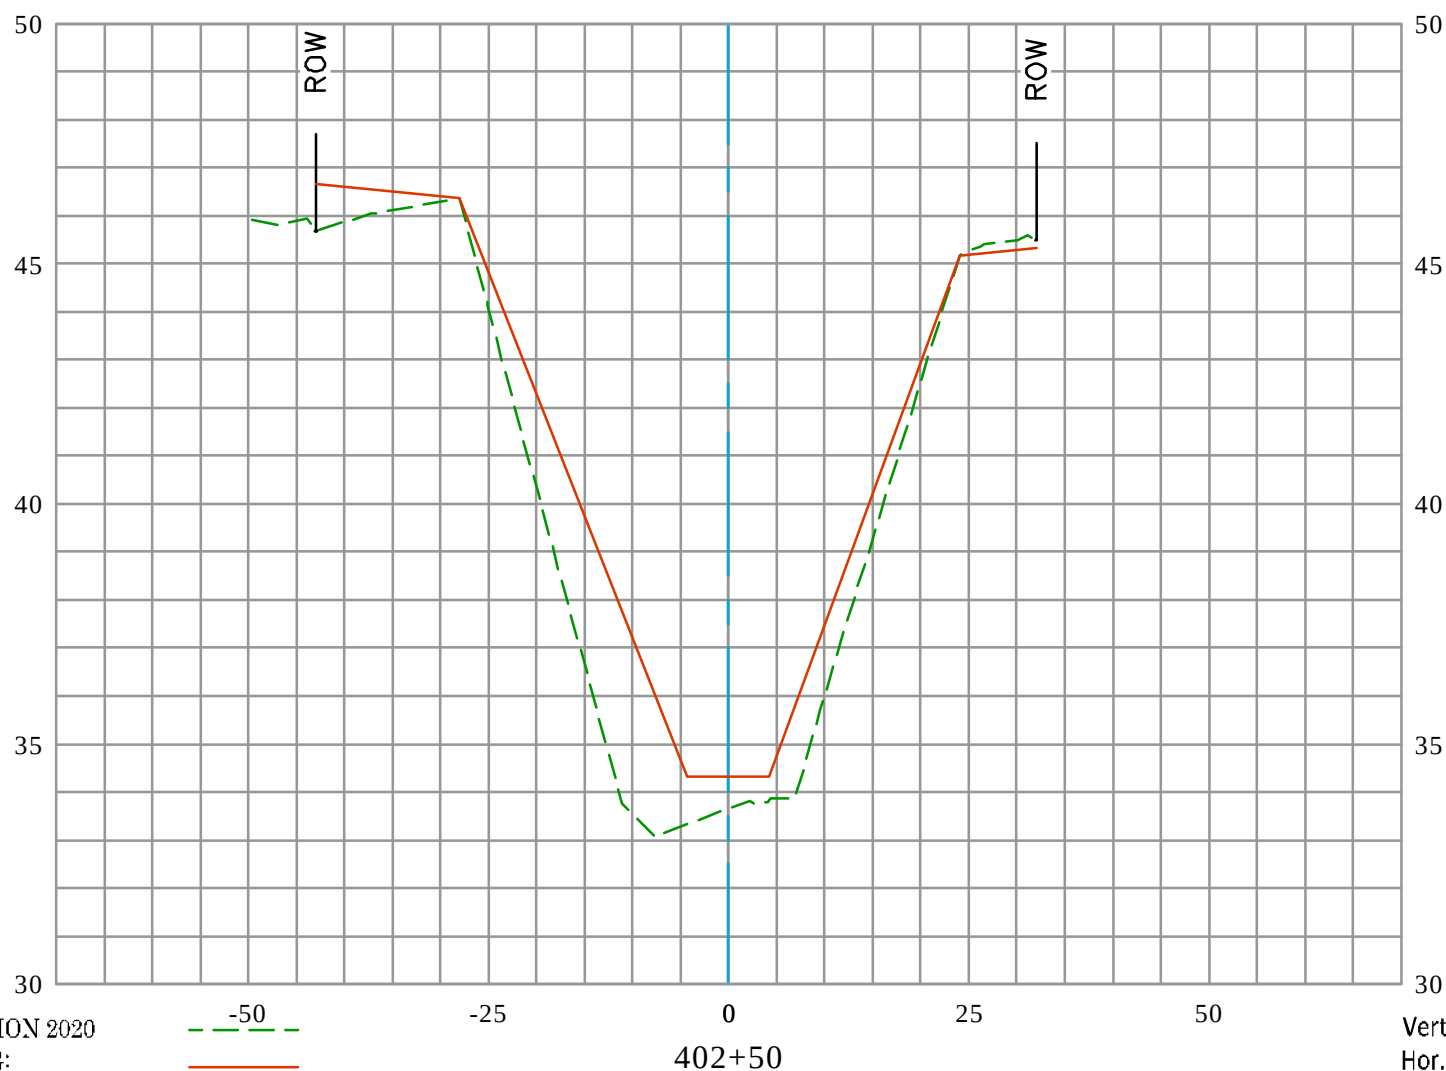


EXISTING CONDITION 2020
 RECORD DRAWING:
 D03-101-2A, D03-101-3A, & D03-101-7R
 DATE PREPARED: 01/24/2022

Vert. Scale: 1" = 4'
 Hor. Scale: 1" = 20'



GREENVILLE BANNING CHANNEL (D03) CL

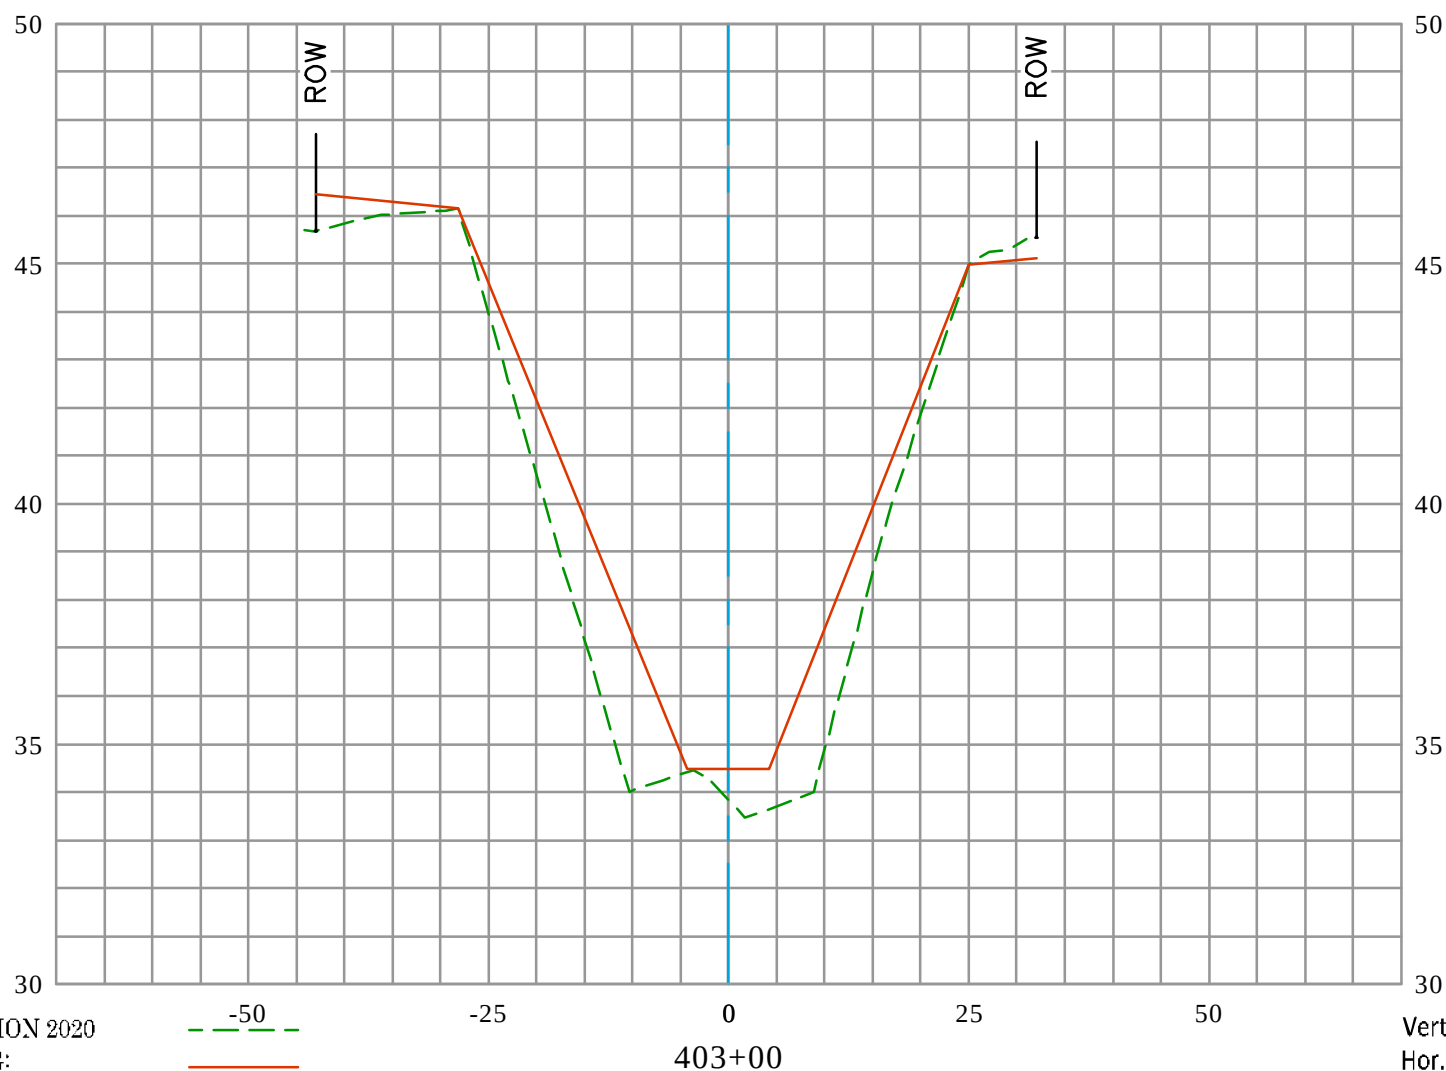


EXISTING CONDITION 2020
 RECORD DRAWING:
 D03-101-2A, D03-101-3A, & D03-101-7R
 DATE PREPARED: 01/24/2022

Vert. Scale: 1" = 4'
 Hor. Scale: 1" = 20'




GREENVILLE BANNING CHANNEL (D03) CL

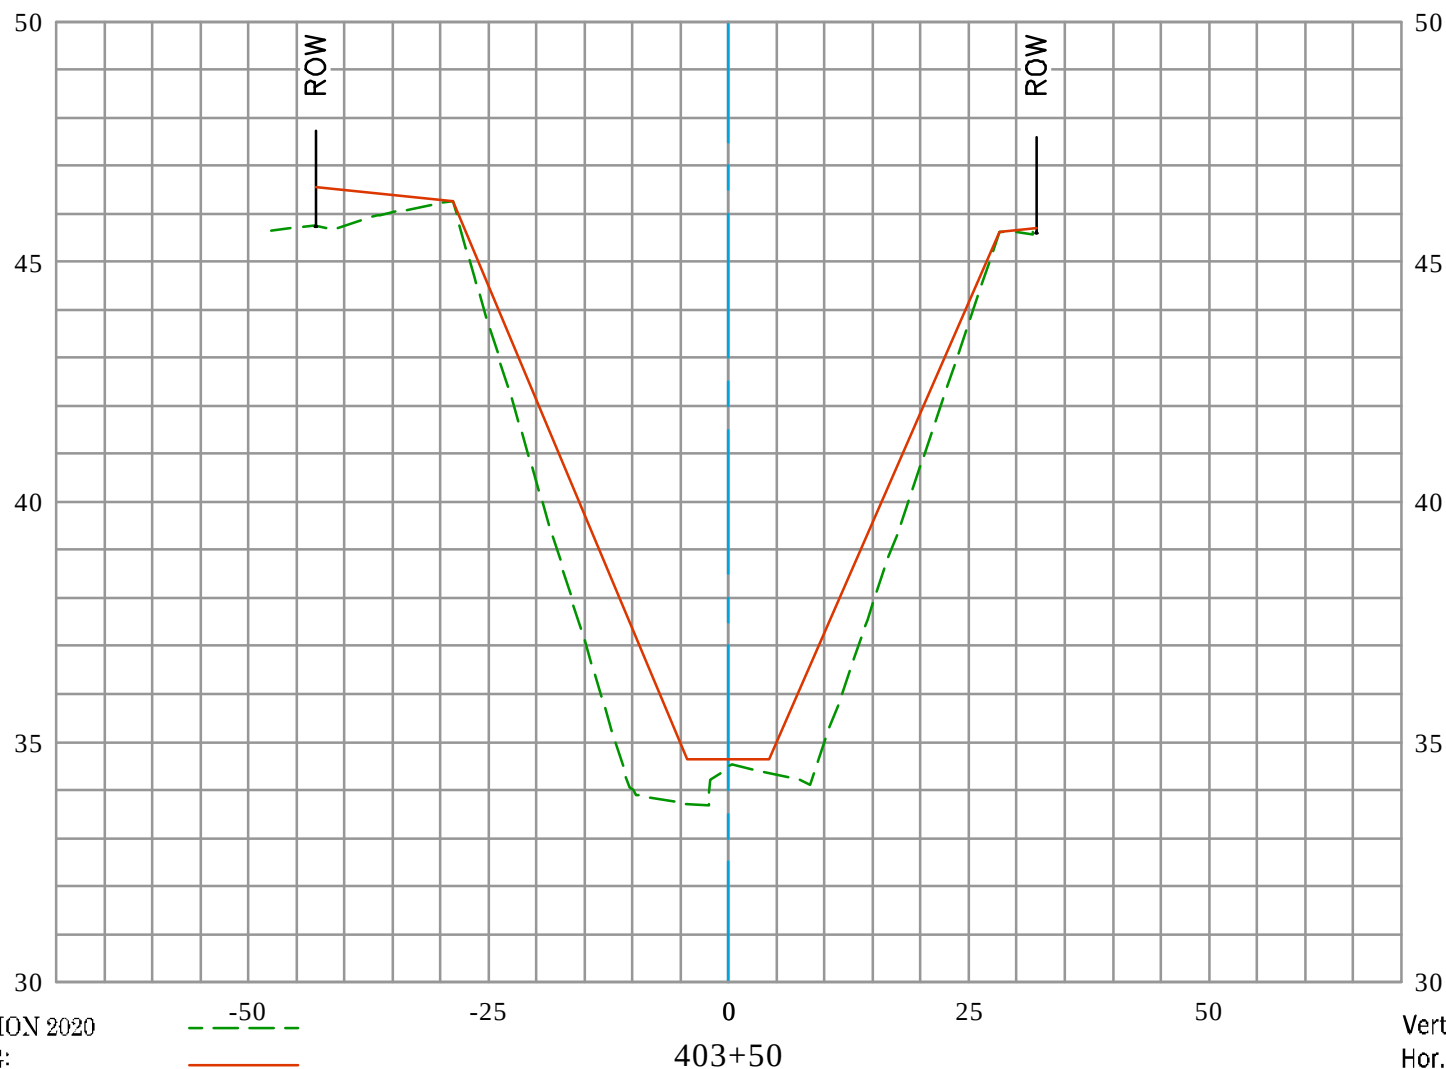

EXISTING CONDITION 2020
 RECORD DRAWING:
 D03-101-2A, D03-101-3A, & D03-101-7R
 DATE PREPARED: 01/24/2022



GREENVILLE BANNING CHANNEL (D03) CL

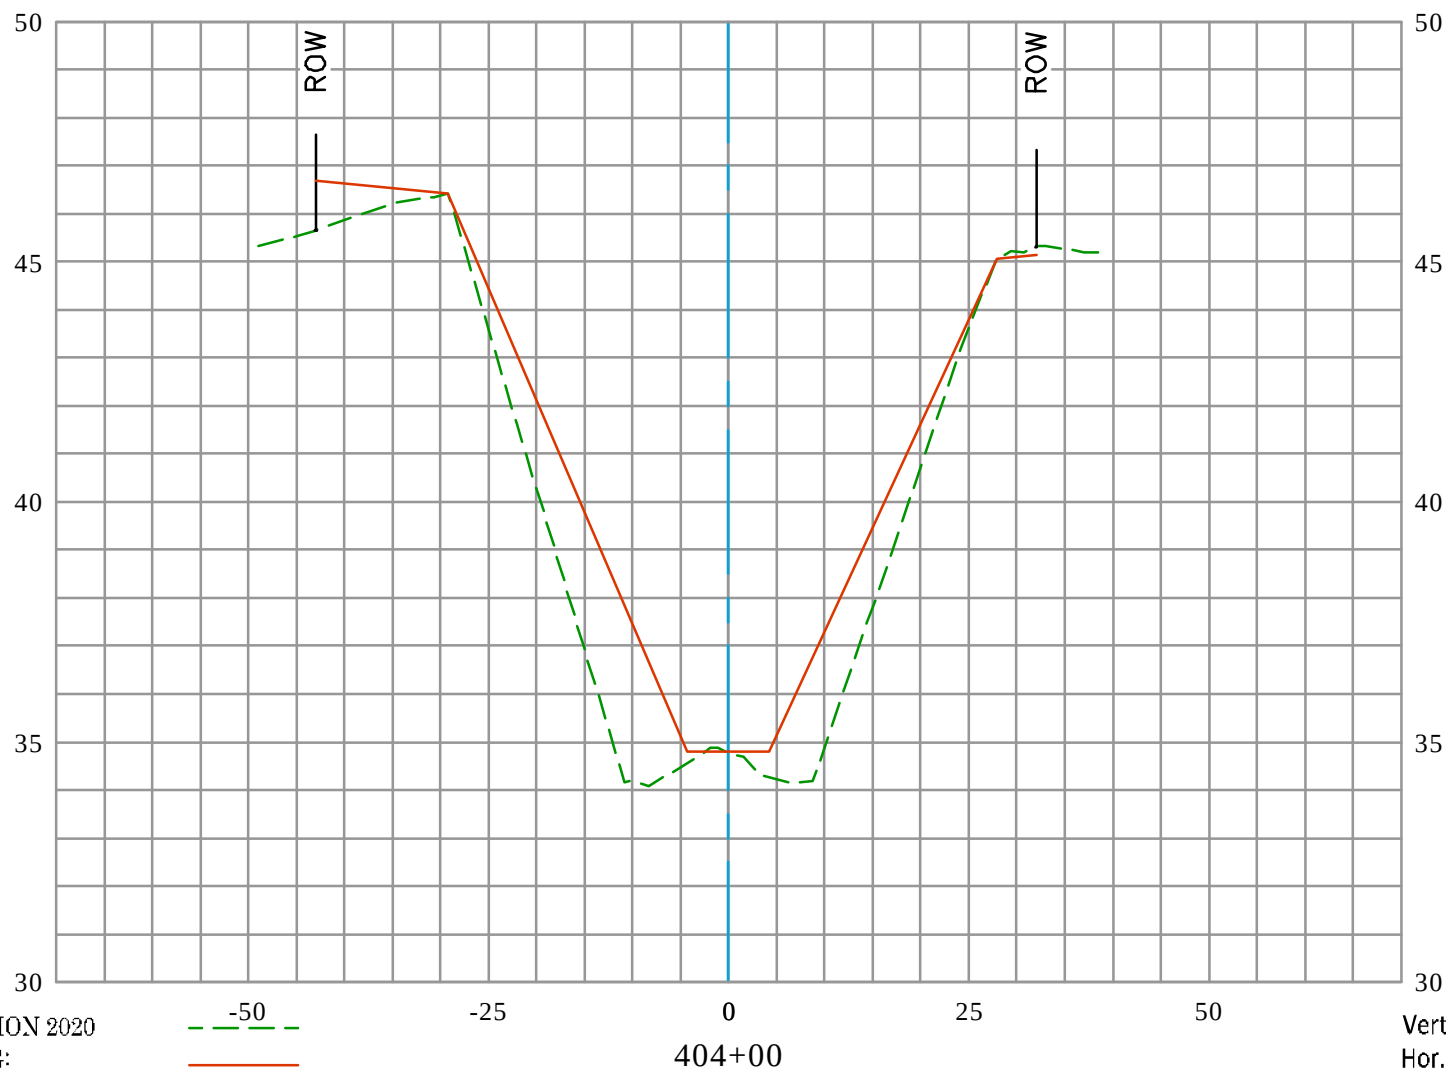


EXISTING CONDITION 2020
 RECORD DRAWING:
 D03-101-2A, D03-101-3A, & D03-101-7R
 DATE PREPARED: 01/24/2022

Vert. Scale: 1" = 4'
 Hor. Scale: 1" = 20'




GREENVILLE BANNING CHANNEL (D03) CL

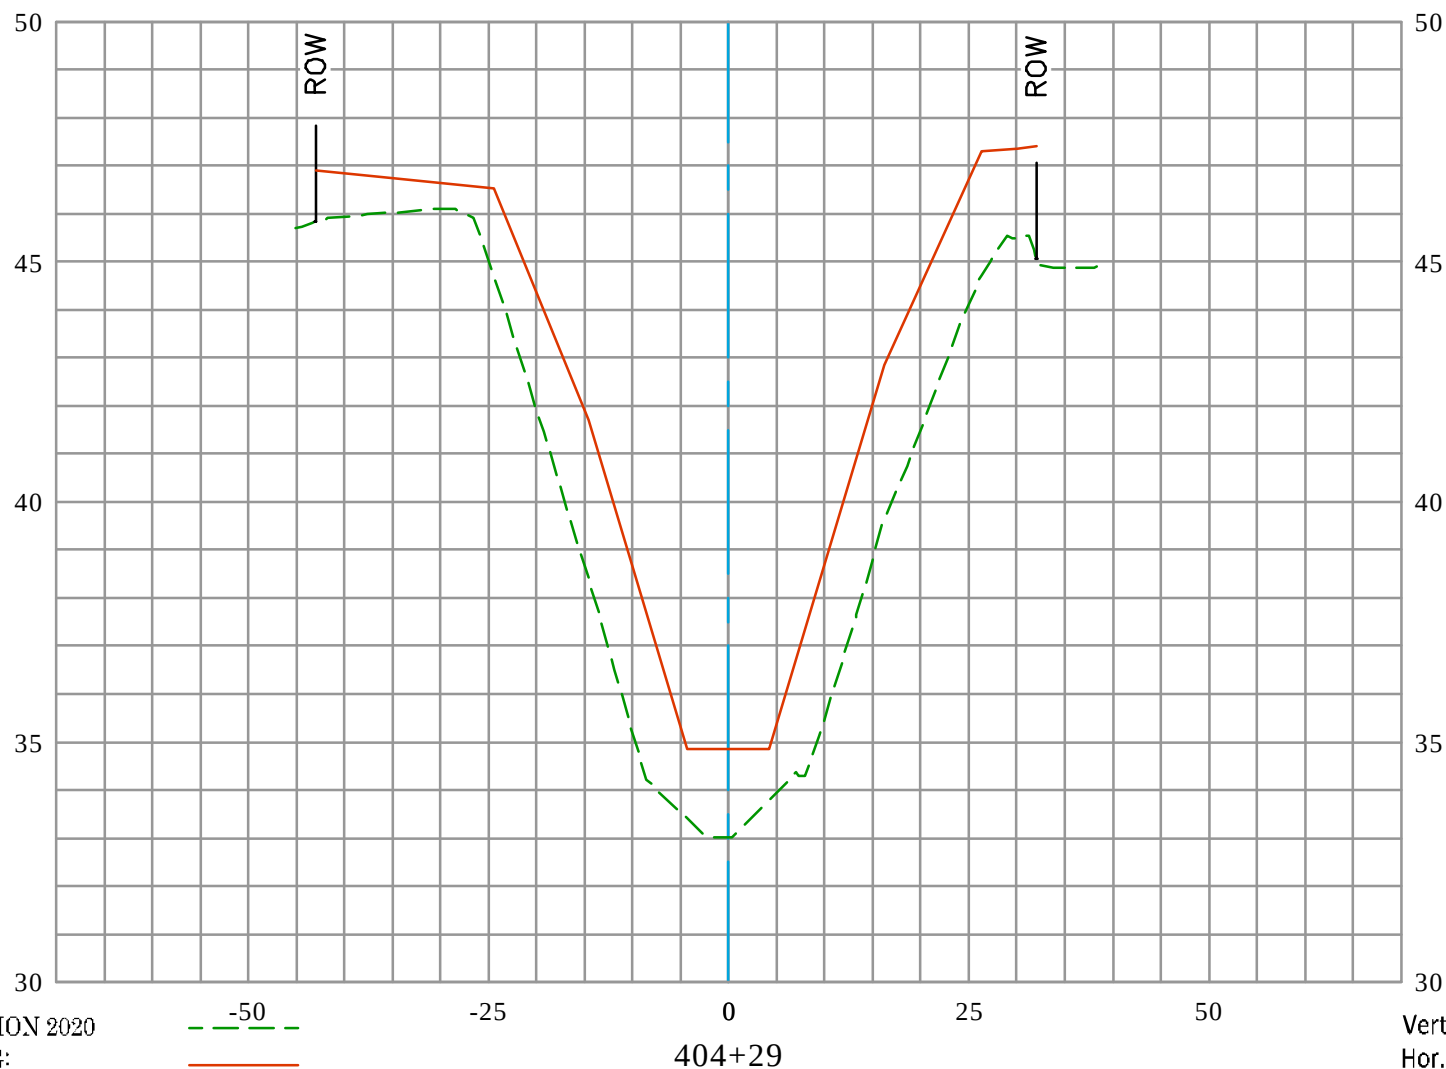

EXISTING CONDITION 2020
 RECORD DRAWING:
 D03-101-2A, D03-101-3A, & D03-101-7R
 DATE PREPARED: 01/24/2022

Vert. Scale: 1" = 4'
 Hor. Scale: 1" = 20'

GREENVILLE BANNING CHANNEL (D03) CL

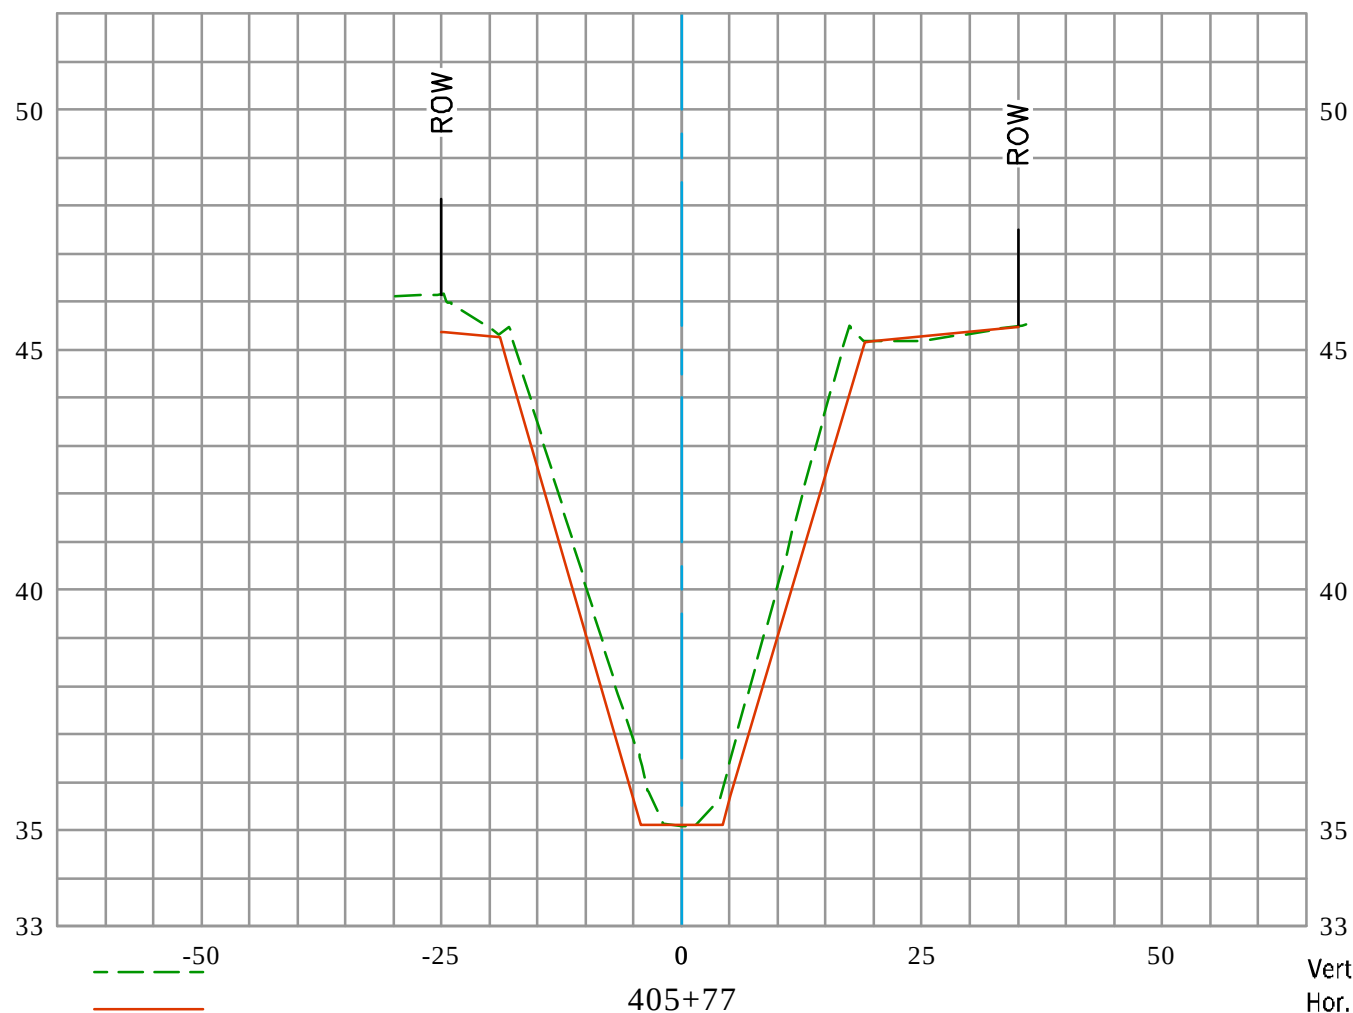


EXISTING CONDITION 2020
 RECORD DRAWING:
 D03-101-2A, D03-101-3A, & D03-101-7R
 DATE PREPARED: 01/24/2022

Vert. Scale: 1" = 4'
 Hor. Scale: 1" = 20'



GREENVILLE BANNING CHANNEL (D03) CL

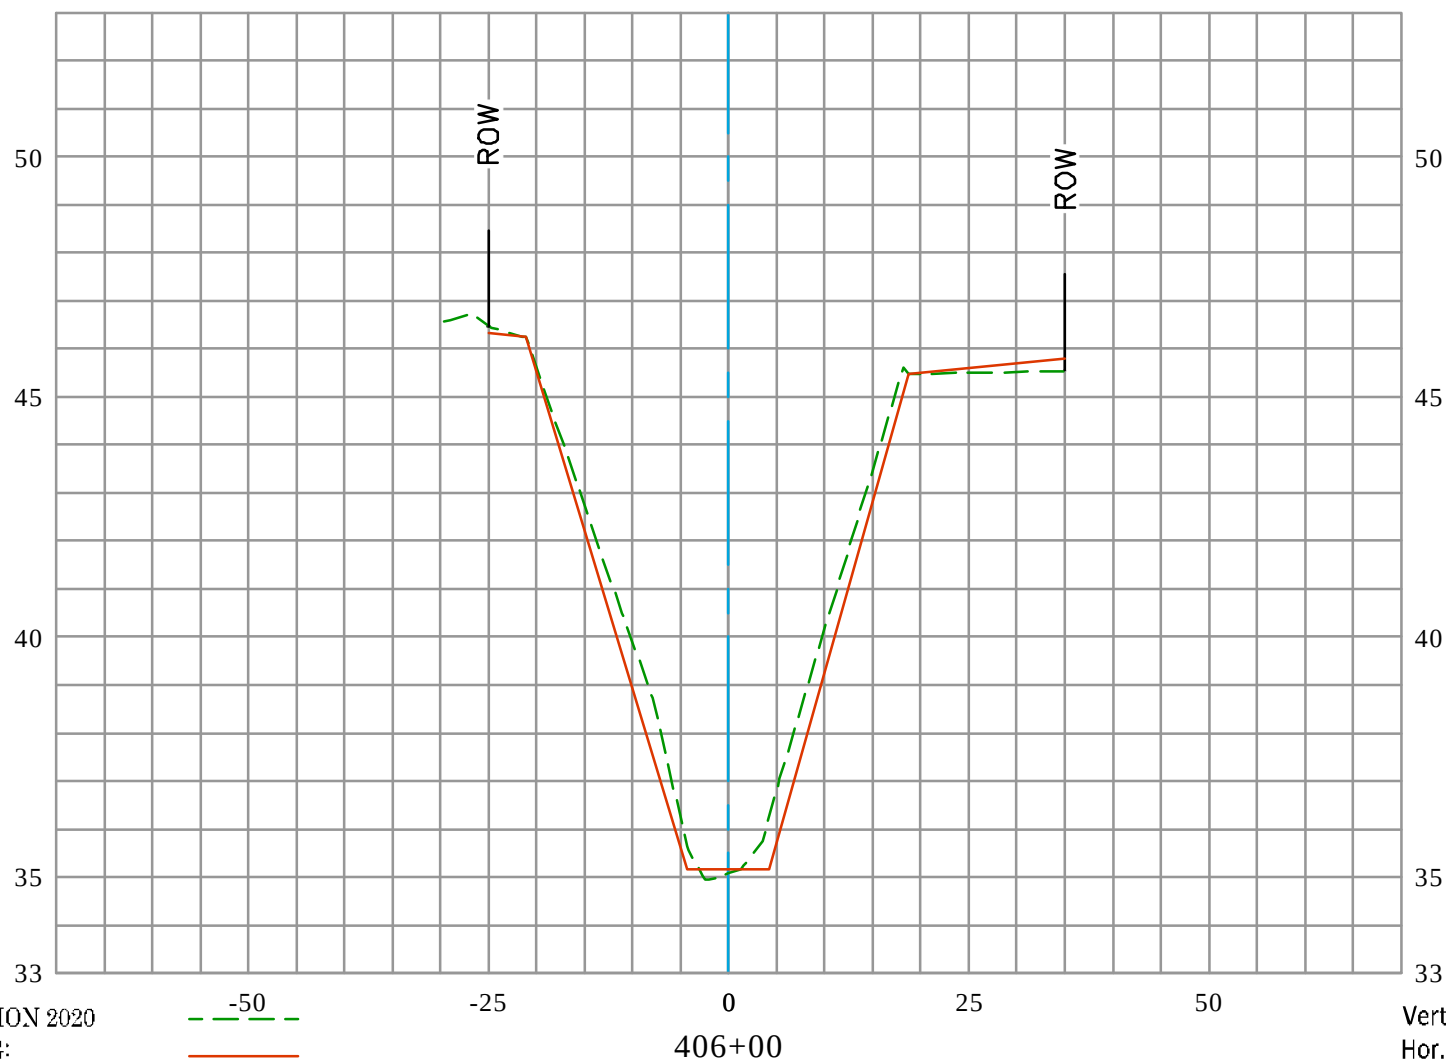


EXISTING CONDITION 2020
 RECORD DRAWING:
 D03-101-2A, D03-101-3A, & D03-101-7R
 DATE PREPARED: 01/24/2022

Vert. Scale: 1" = 4'
 Hor. Scale: 1" = 20'




GREENVILLE BANNING CHANNEL (D03) CL

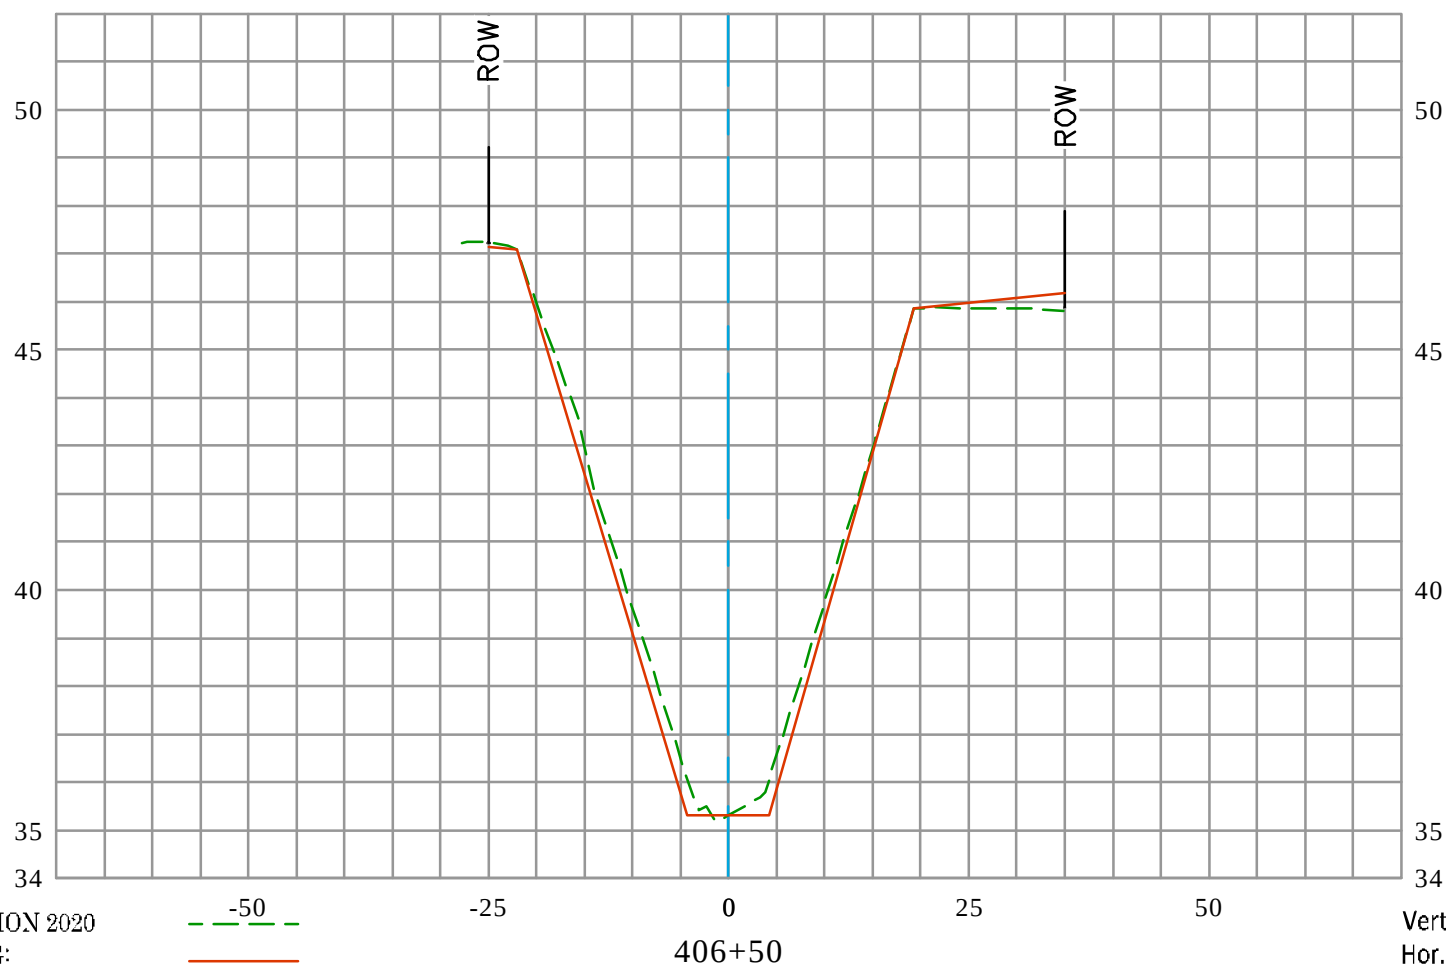

EXISTING CONDITION 2020
 RECORD DRAWING:
 D03-101-2A, D03-101-3A, & D03-101-7R
 DATE PREPARED: 01/24/2022



GREENVILLE BANNING CHANNEL (D03) CL

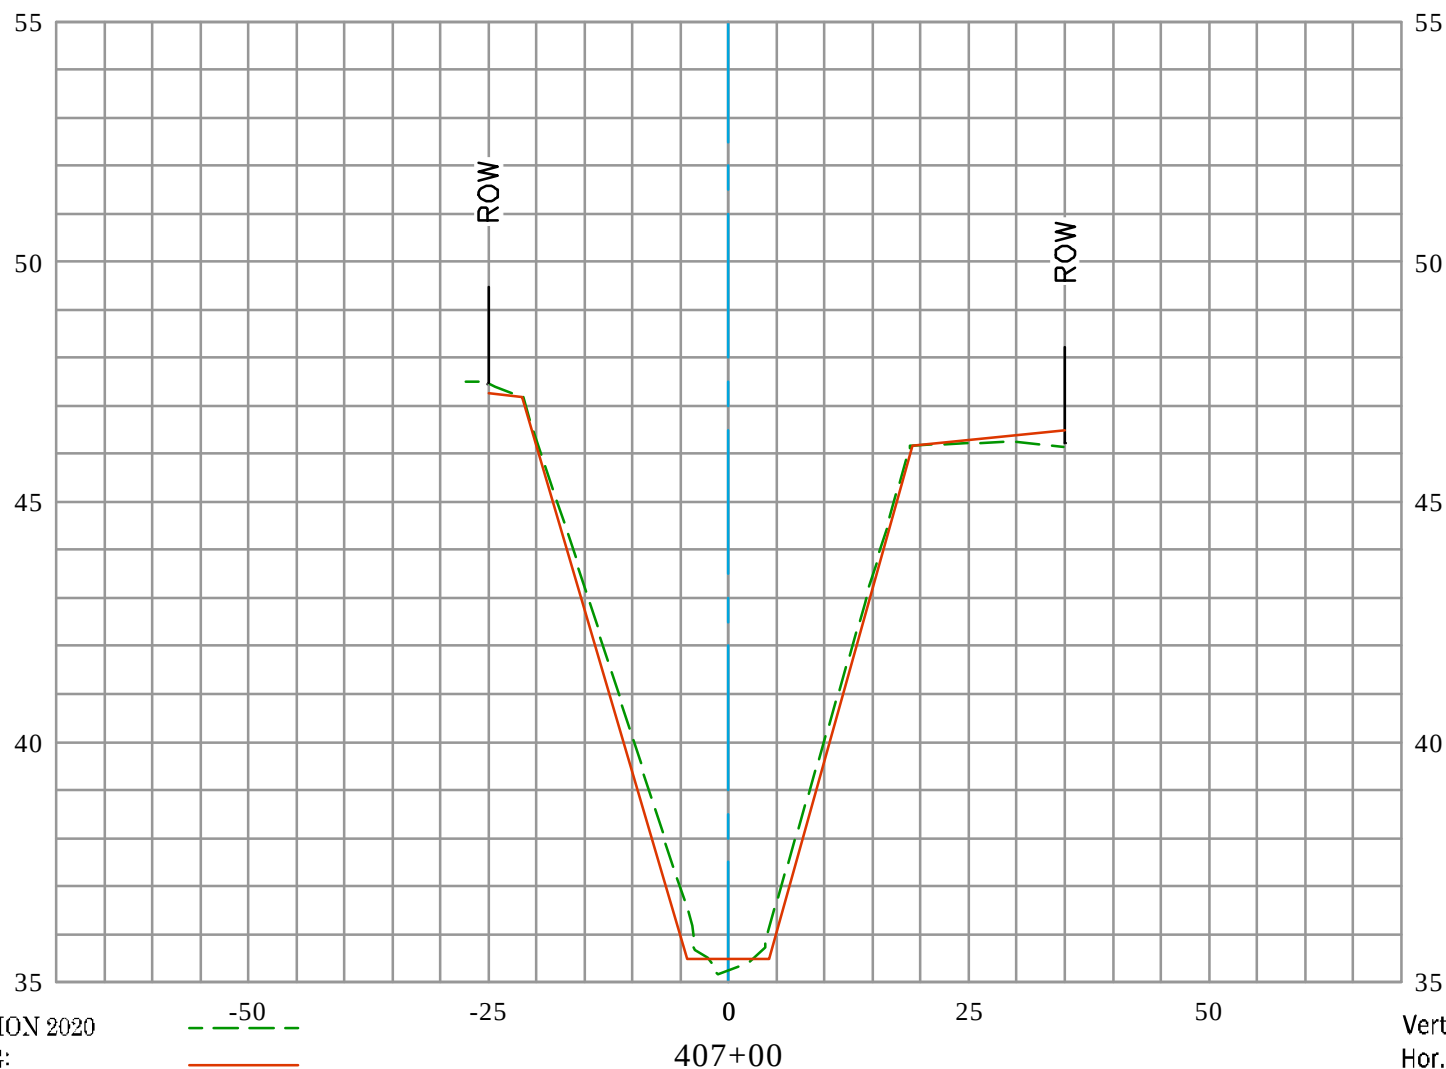


EXISTING CONDITION 2020
 RECORD DRAWING:
 D03-101-2A, D03-101-3A, & D03-101-7R
 DATE PREPARED: 01/24/2022

Vert. Scale: 1" = 4'
 Hor. Scale: 1" = 20'



GREENVILLE BANNING CHANNEL (D03) CL

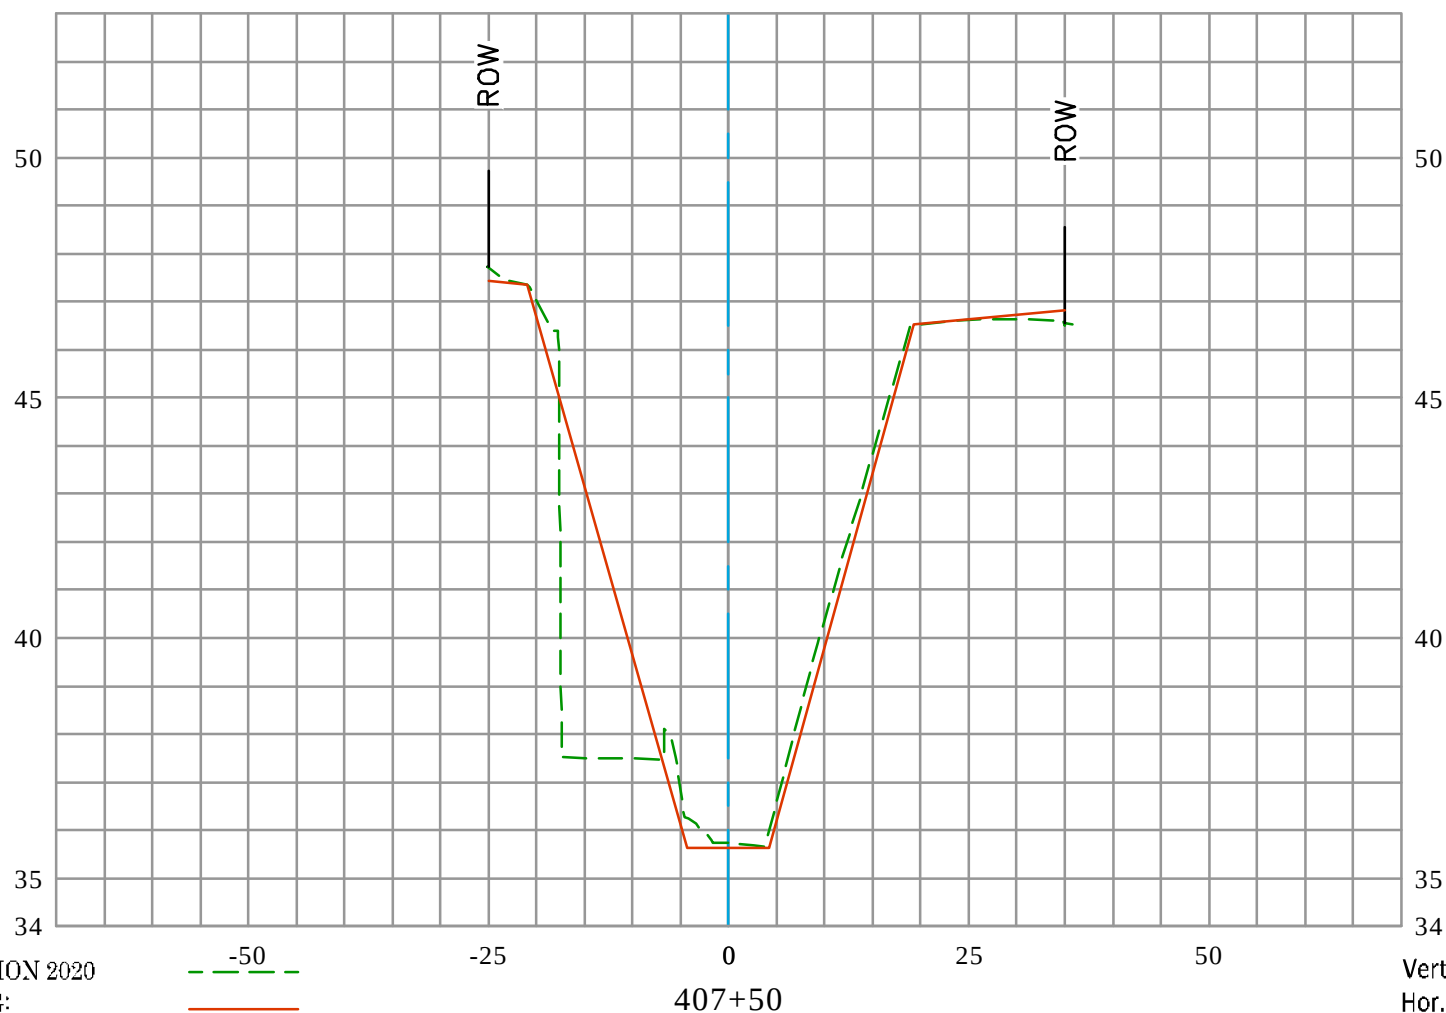


EXISTING CONDITION 2020
RECORD DRAWING:
D03-101-2A, D03-101-3A, & D03-101-7R
DATE PREPARED: 01/24/2022

Vert. Scale: 1" = 4'
Hor. Scale: 1" = 20'



GREENVILLE BANNING CHANNEL (D03) CL

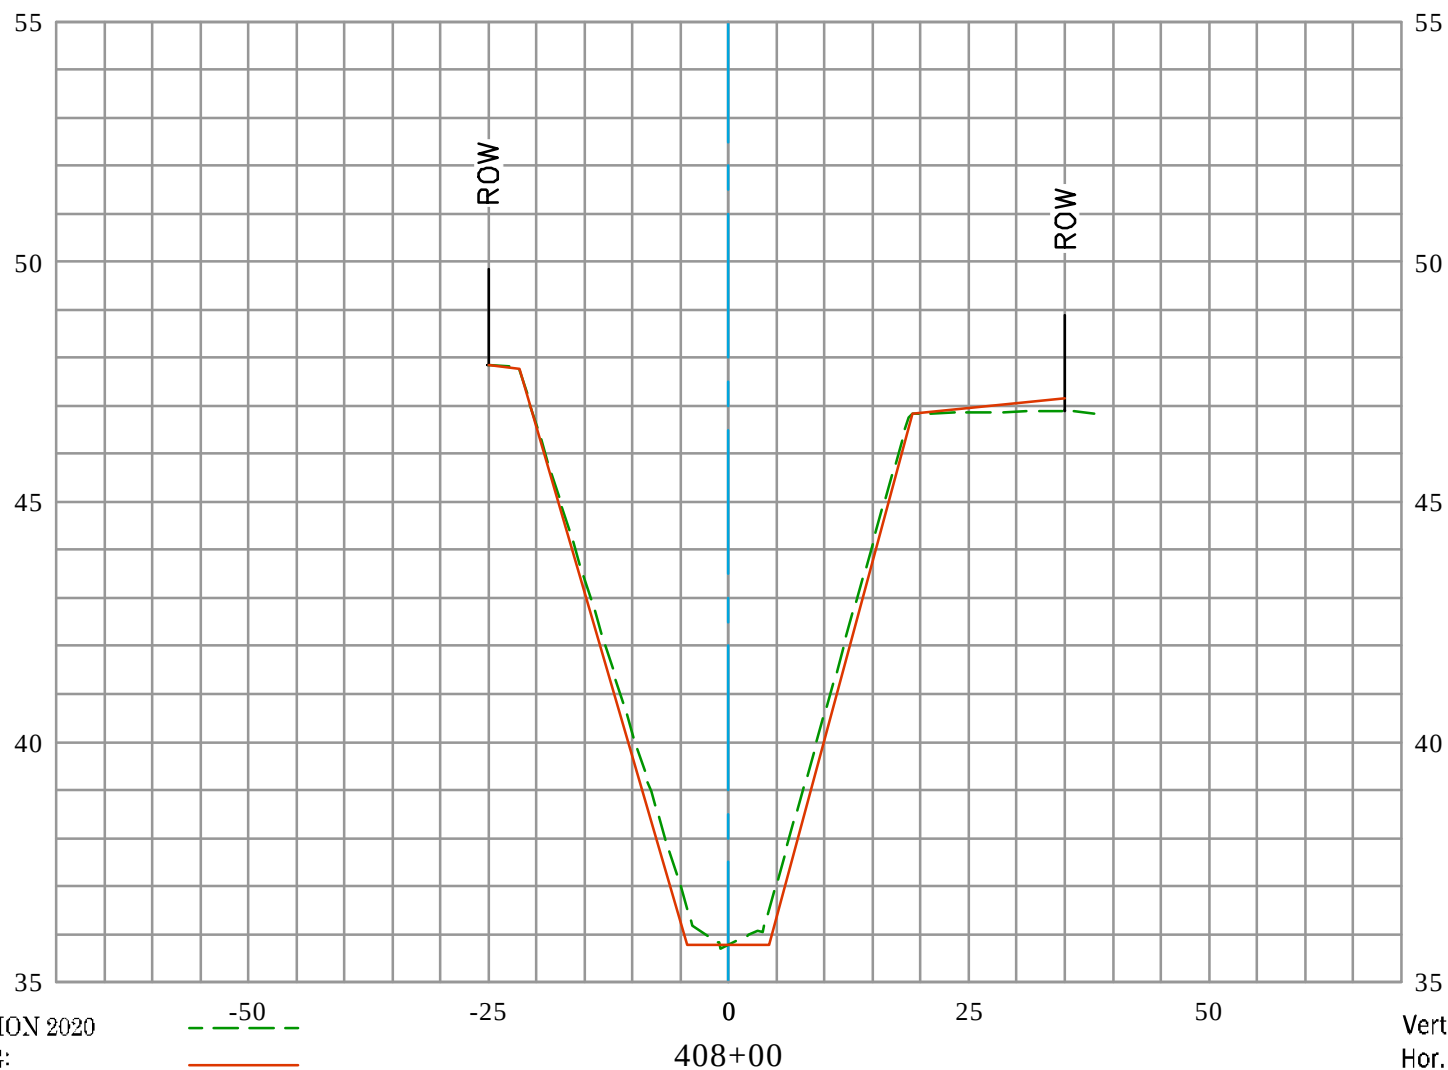


EXISTING CONDITION 2020
 RECORD DRAWING:
 D03-101-2A, D03-101-3A, & D03-101-7R
 DATE PREPARED: 01/24/2022

Vert. Scale: 1" = 4'
 Hor. Scale: 1" = 20'



GREENVILLE BANNING CHANNEL (D03) CL

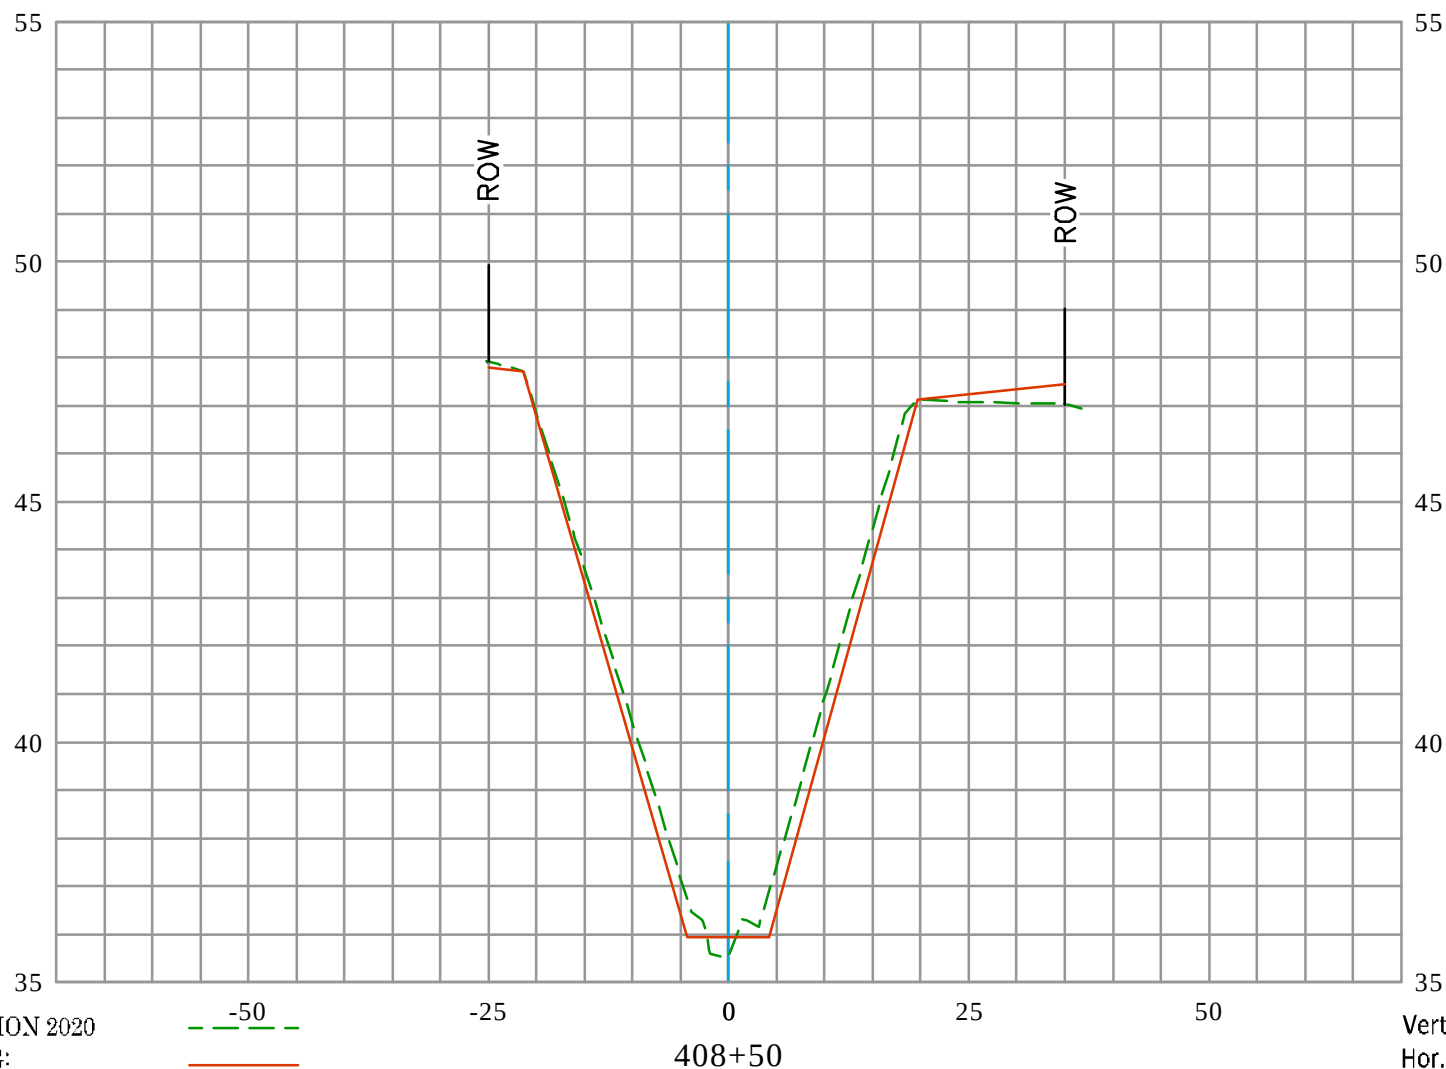


EXISTING CONDITION 2020
 RECORD DRAWING:
 D03-101-2A, D03-101-3A, & D03-101-7R
 DATE PREPARED: 01/24/2022

Vert. Scale: 1" = 4'
 Hor. Scale: 1" = 20'




GREENVILLE BANNING CHANNEL (D03) CL

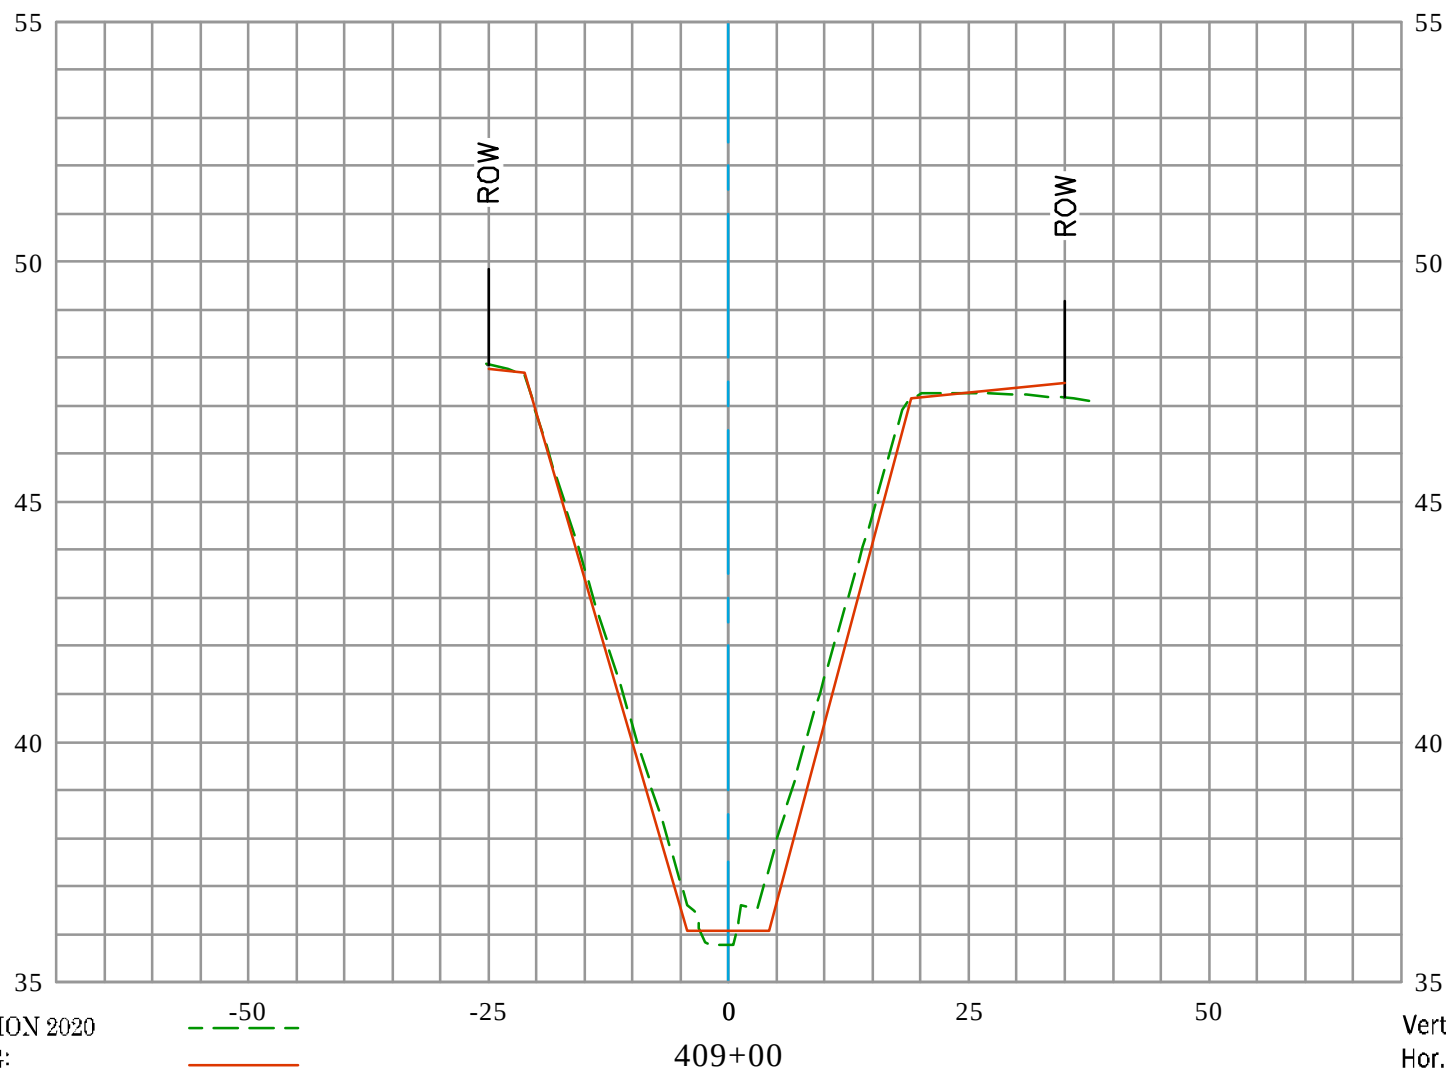



GREENVILLE BANNING CHANNEL (D03) CL

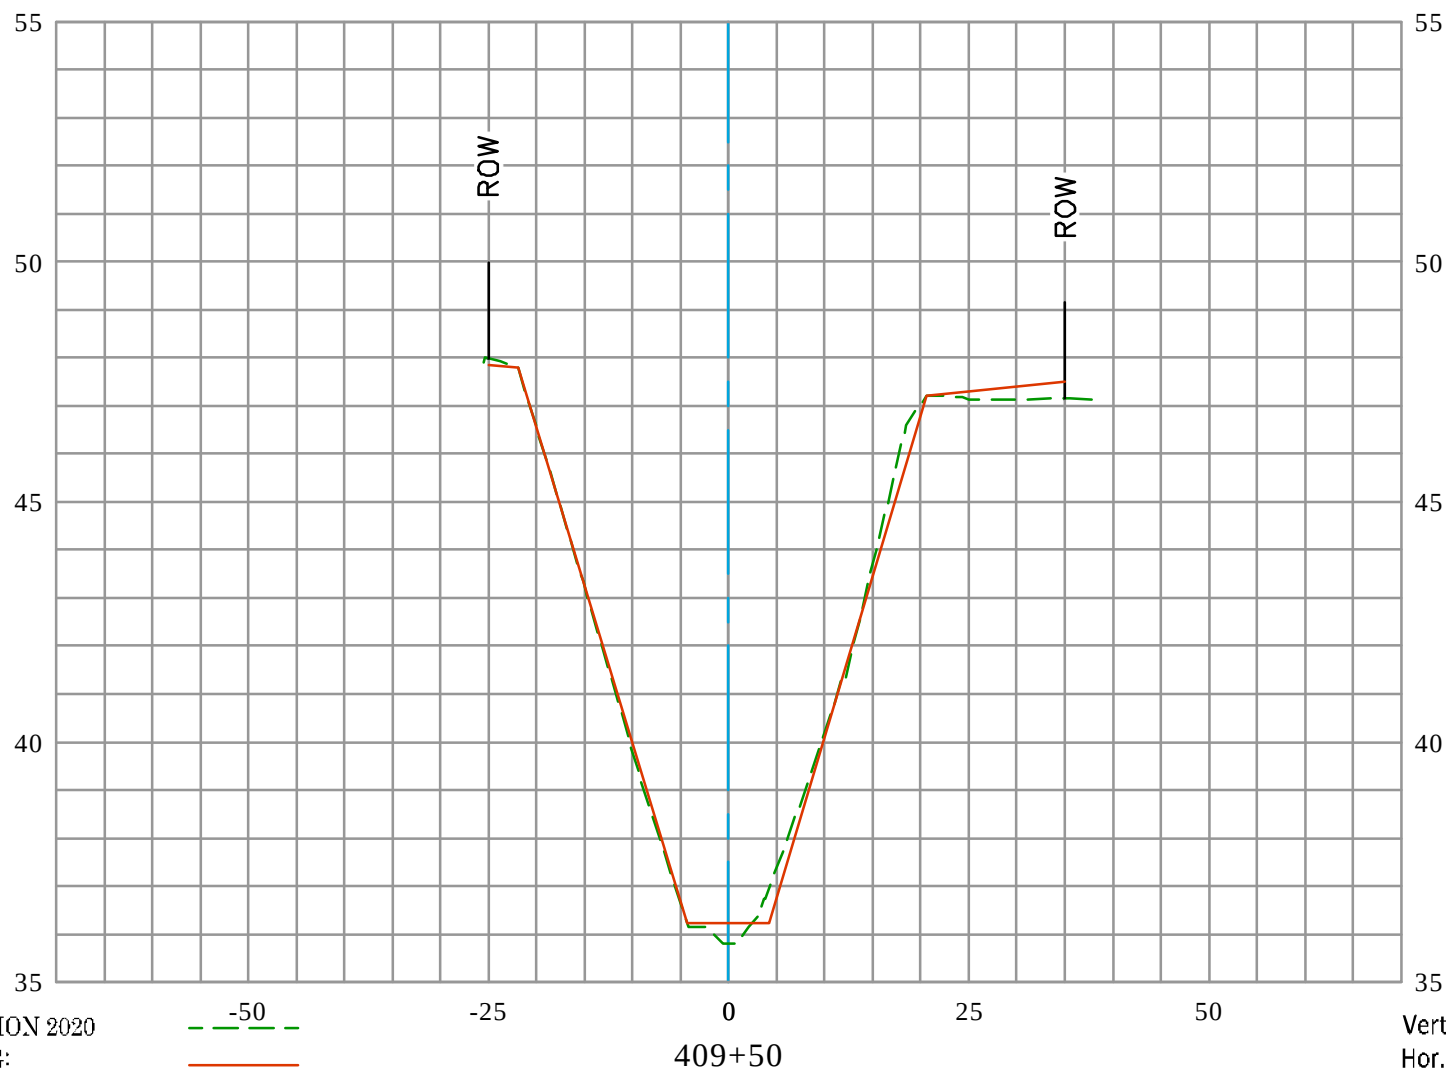


EXISTING CONDITION 2020
 RECORD DRAWING:
 D03-101-2A, D03-101-3A, & D03-101-7R
 DATE PREPARED: 01/24/2022

Vert. Scale: 1" = 4'
 Hor. Scale: 1" = 20'



GREENVILLE BANNING CHANNEL (D03) CL

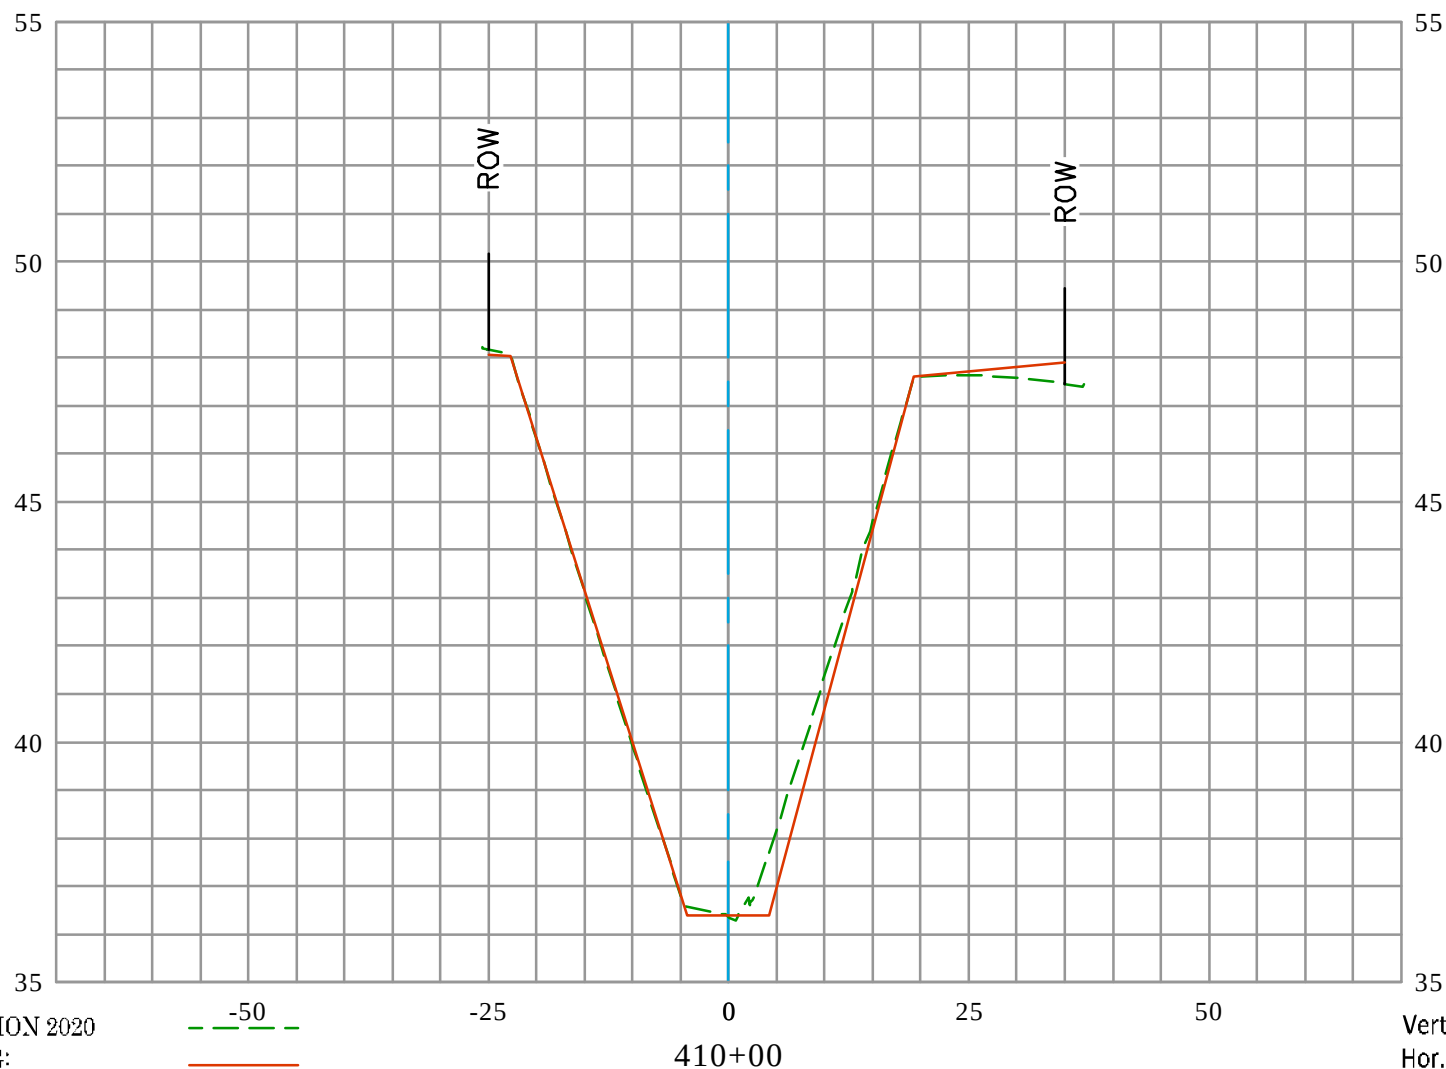


EXISTING CONDITION 2020
 RECORD DRAWING:
 D03-101-2A, D03-101-3A, & D03-101-7R
 DATE PREPARED: 01/24/2022

Vert. Scale: 1" = 4'
 Hor. Scale: 1" = 20'



GREENVILLE BANNING CHANNEL (D03) CL

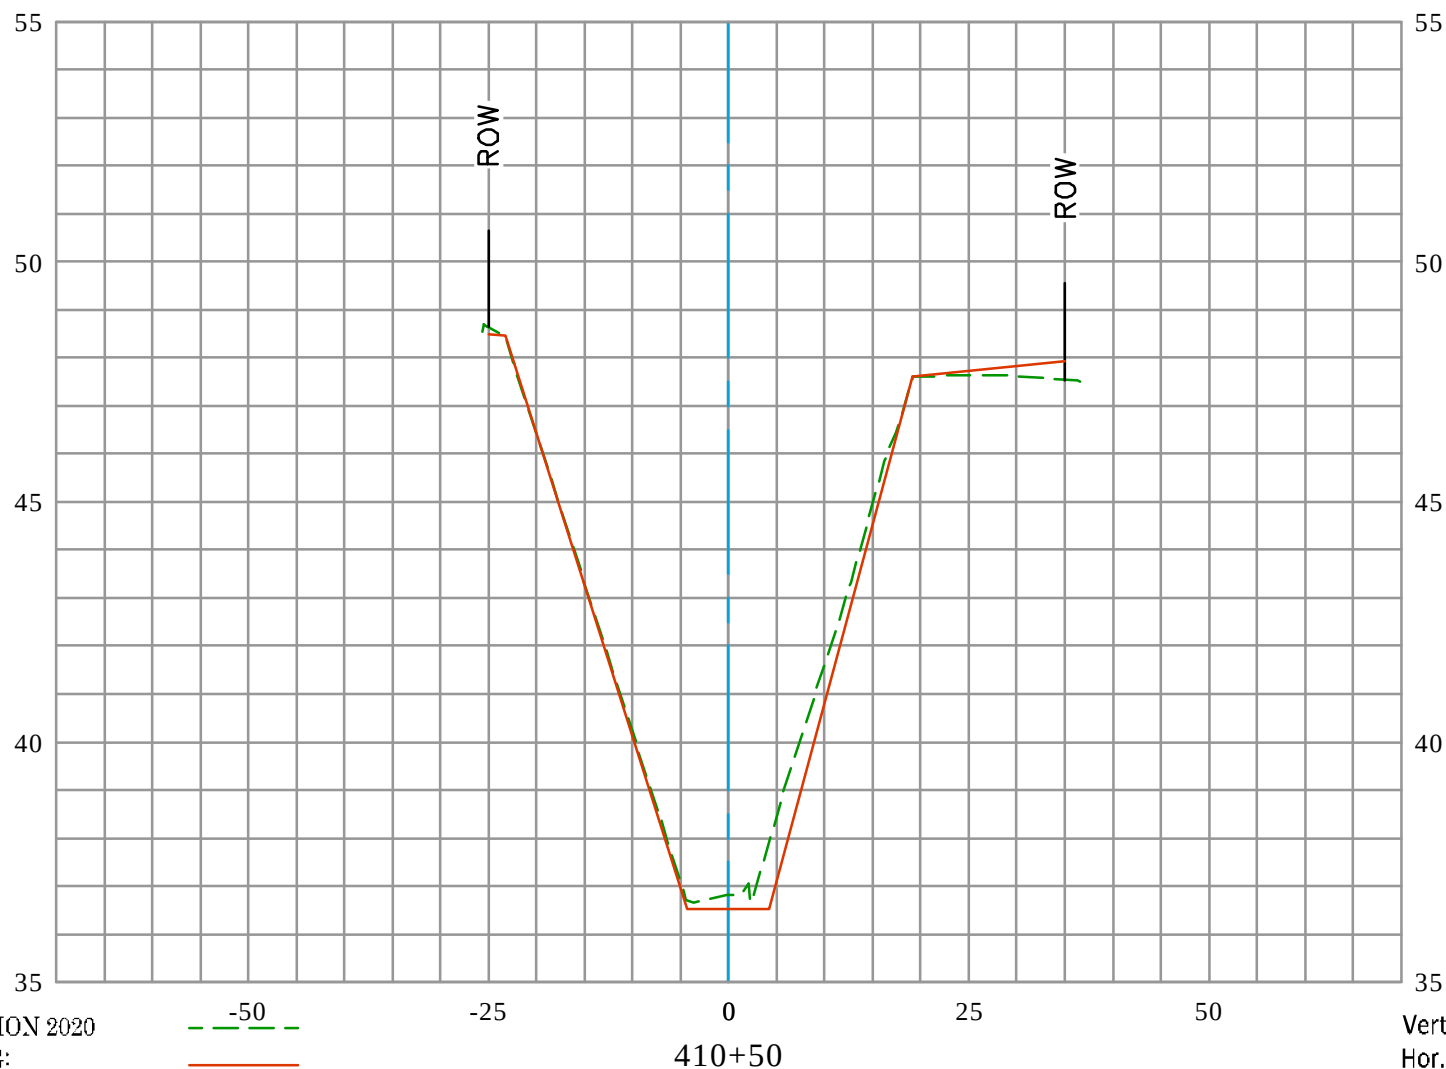


EXISTING CONDITION 2020
 RECORD DRAWING:
 D03-101-2A, D03-101-3A, & D03-101-7R
 DATE PREPARED: 01/24/2022

Vert. Scale: 1" = 4'
 Hor. Scale: 1" = 20'



GREENVILLE BANNING CHANNEL (D03) CL

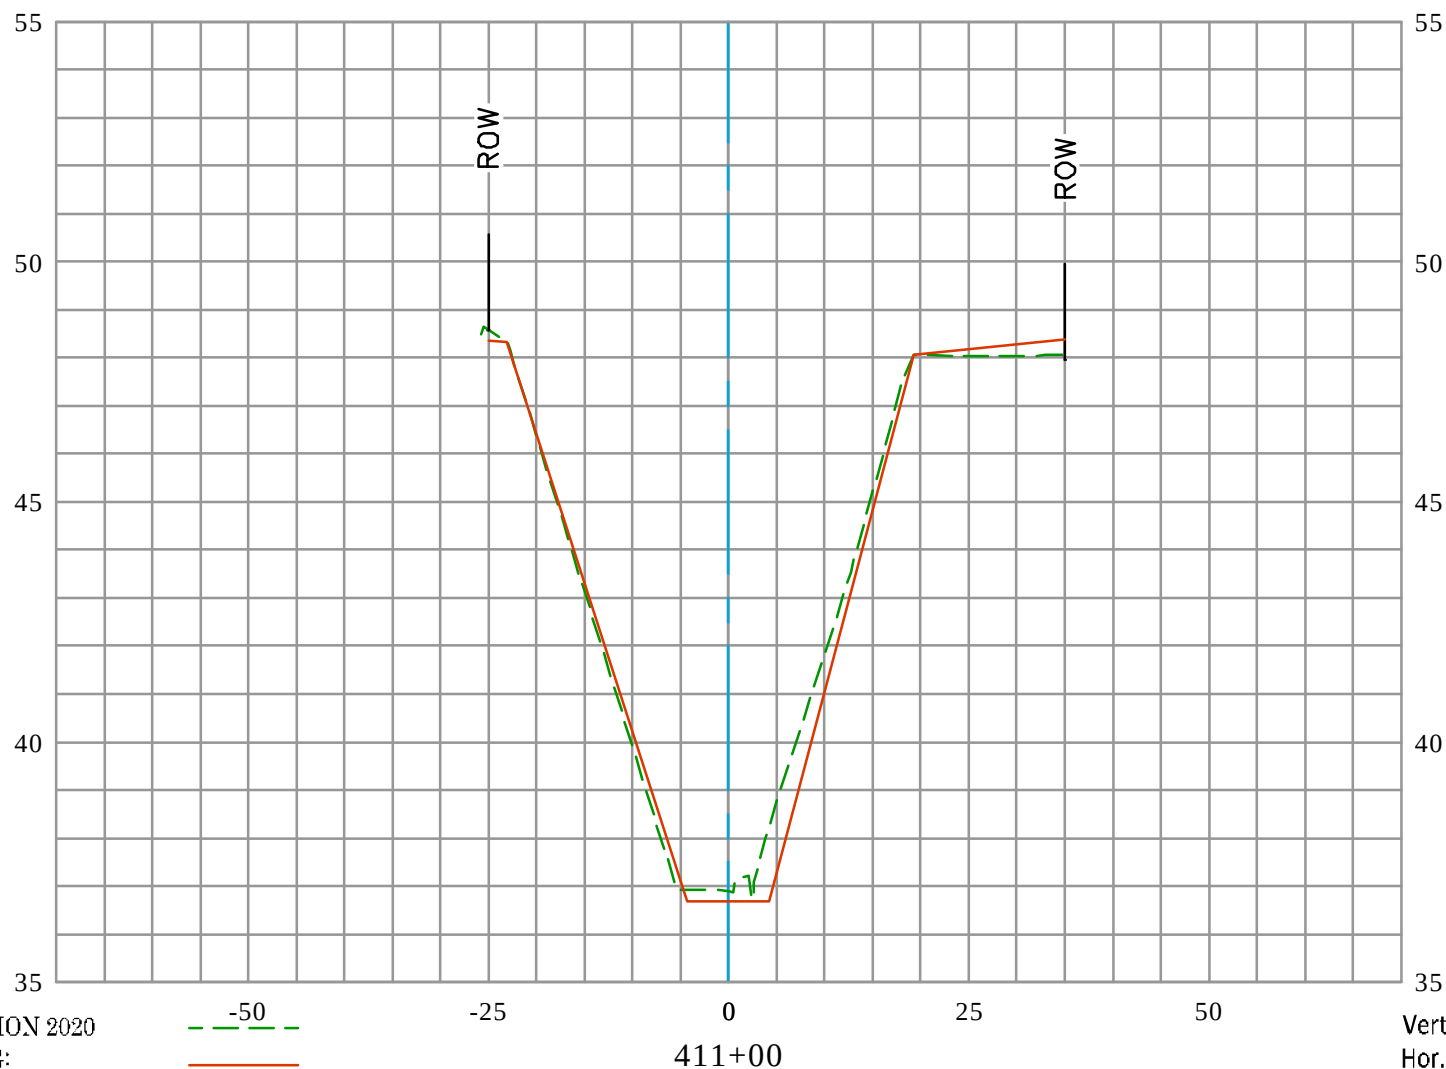


EXISTING CONDITION 2020
 RECORD DRAWING:
 D03-101-2A, D03-101-3A, & D03-101-7R
 DATE PREPARED: 01/24/2022

Vert. Scale: 1" = 4'
 Hor. Scale: 1" = 20'



GREENVILLE BANNING CHANNEL (D03) CL

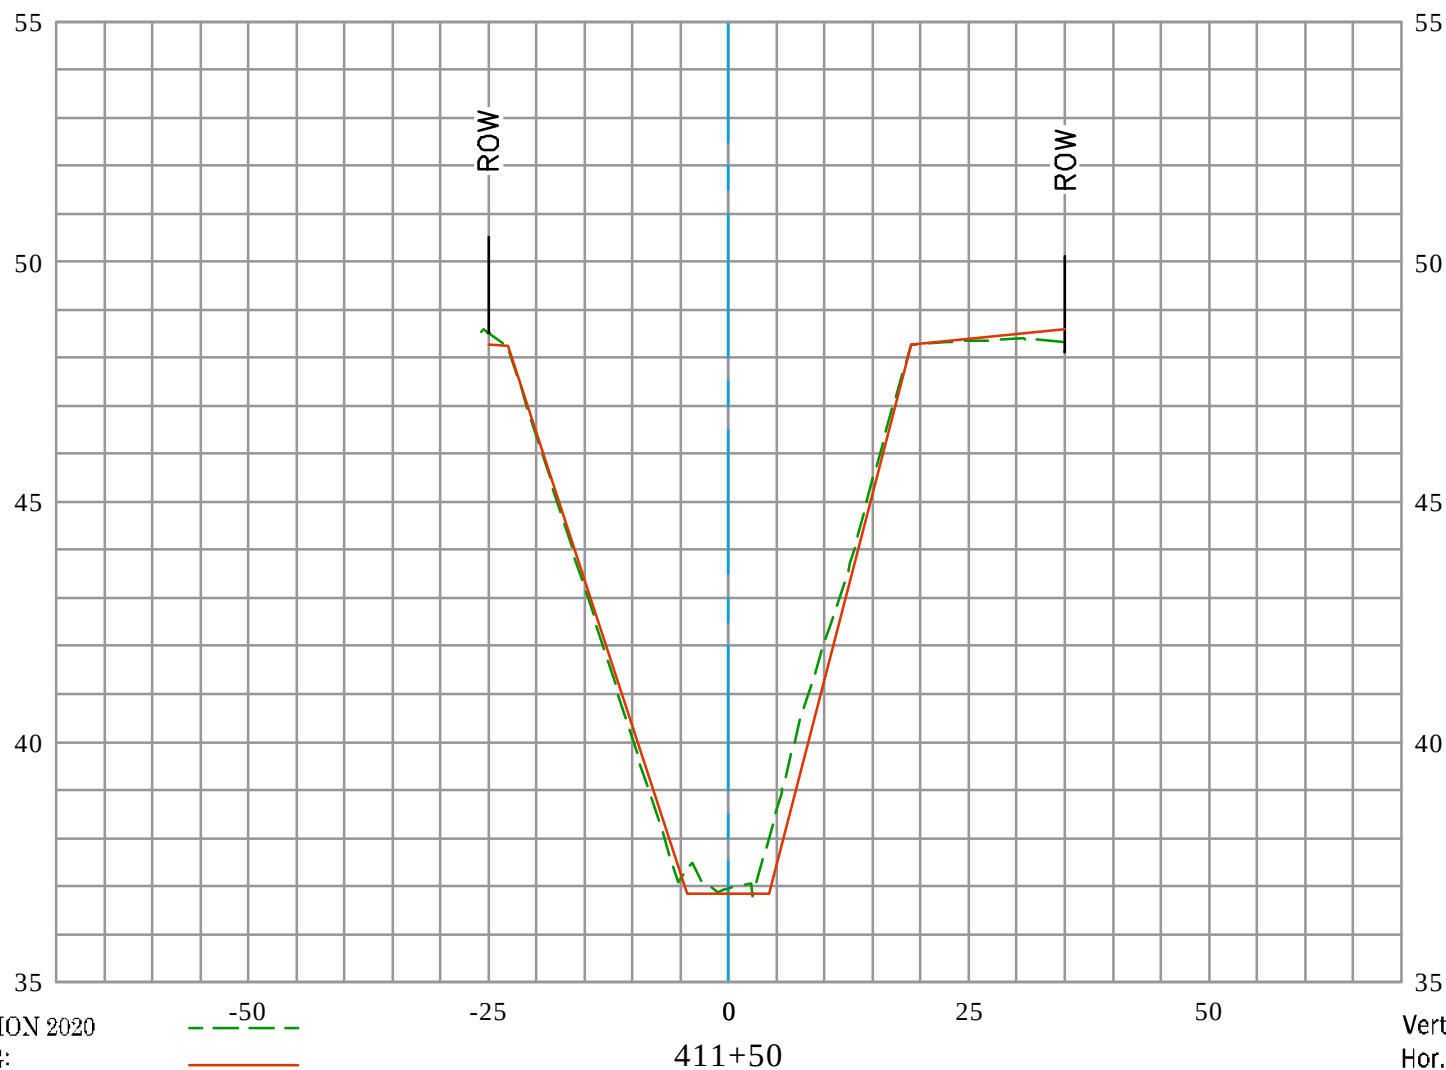


EXISTING CONDITION 2020
 RECORD DRAWING:
 D03-101-2A, D03-101-3A, & D03-101-7R
 DATE PREPARED: 01/24/2022

Vert. Scale: 1" = 4'
 Hor. Scale: 1" = 20'



GREENVILLE BANNING CHANNEL (D03) CL

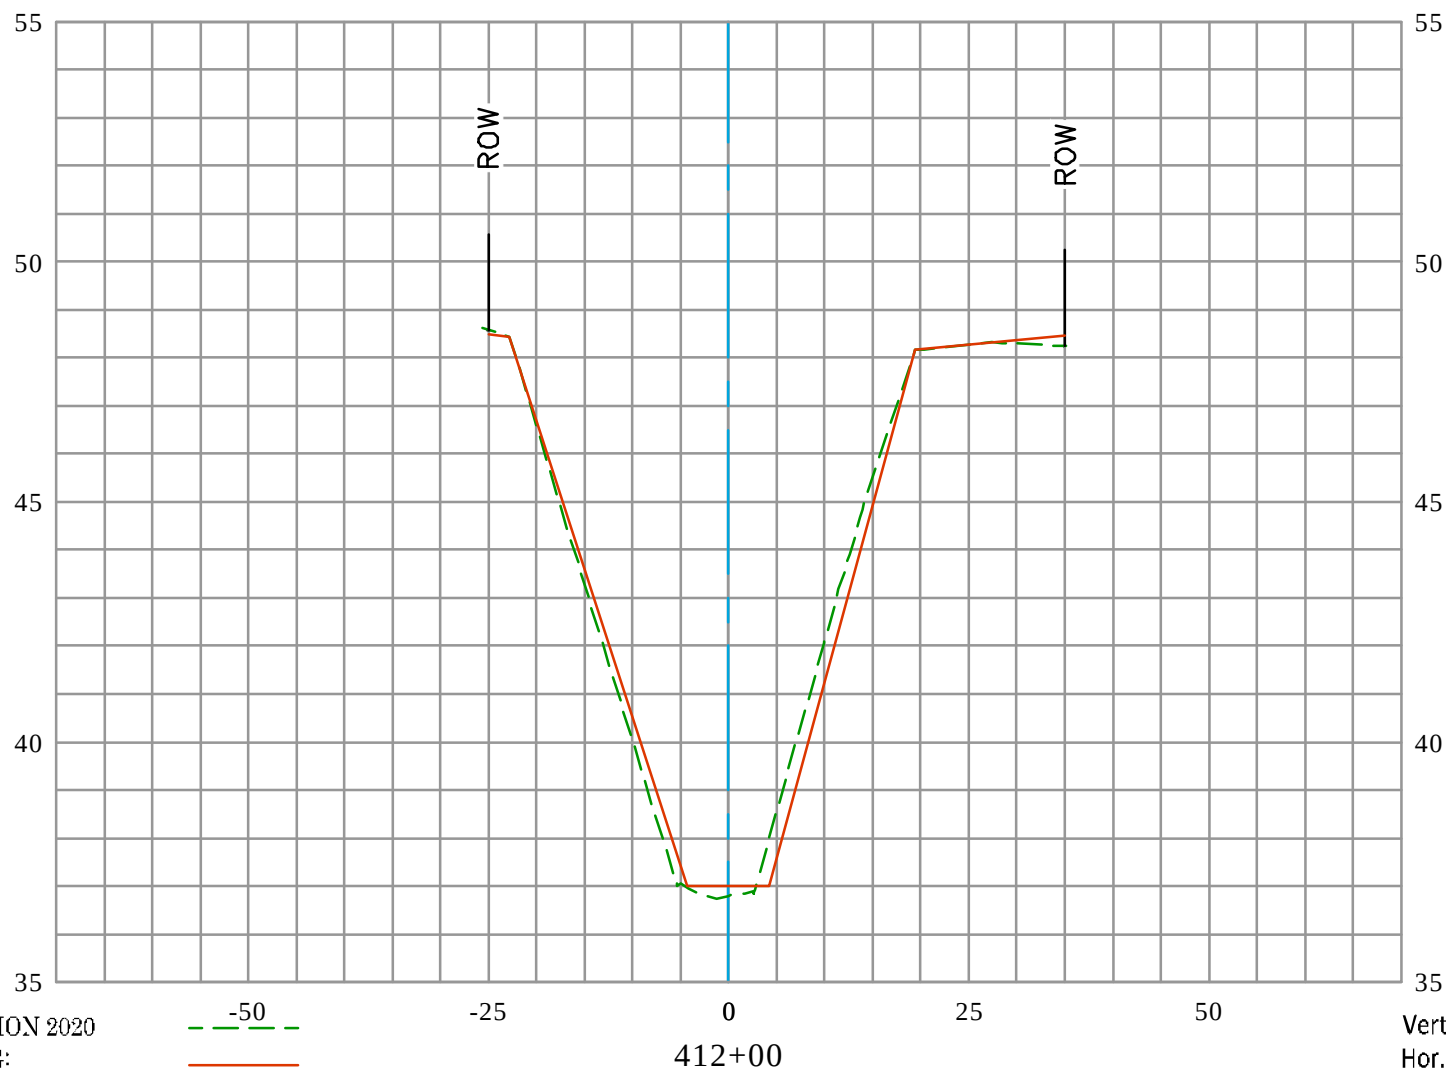


EXISTING CONDITION 2020
 RECORD DRAWING:
 D03-101-2A, D03-101-3A, & D03-101-7R
 DATE PREPARED: 01/24/2022

Vert. Scale: 1" = 4'
 Hor. Scale: 1" = 20'



GREENVILLE BANNING CHANNEL (D03) CL

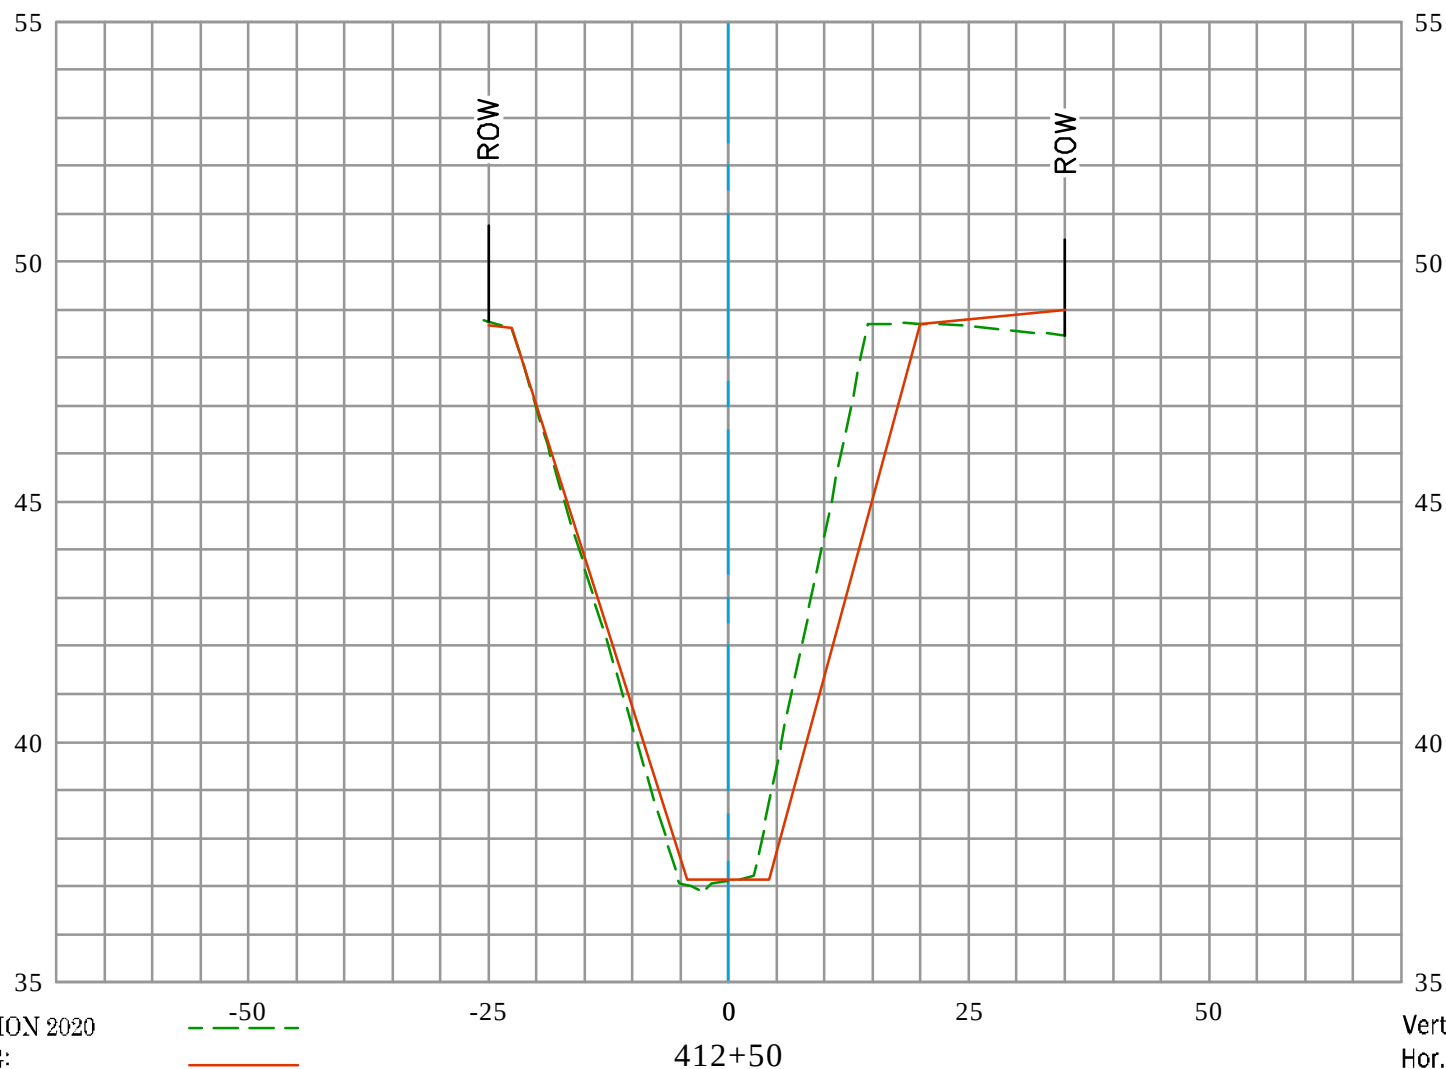


EXISTING CONDITION 2020
 RECORD DRAWING:
 D03-101-2A, D03-101-3A, & D03-101-7R
 DATE PREPARED: 01/24/2022

Vert. Scale: 1" = 4'
 Hor. Scale: 1" = 20'



GREENVILLE BANNING CHANNEL (D03) CL

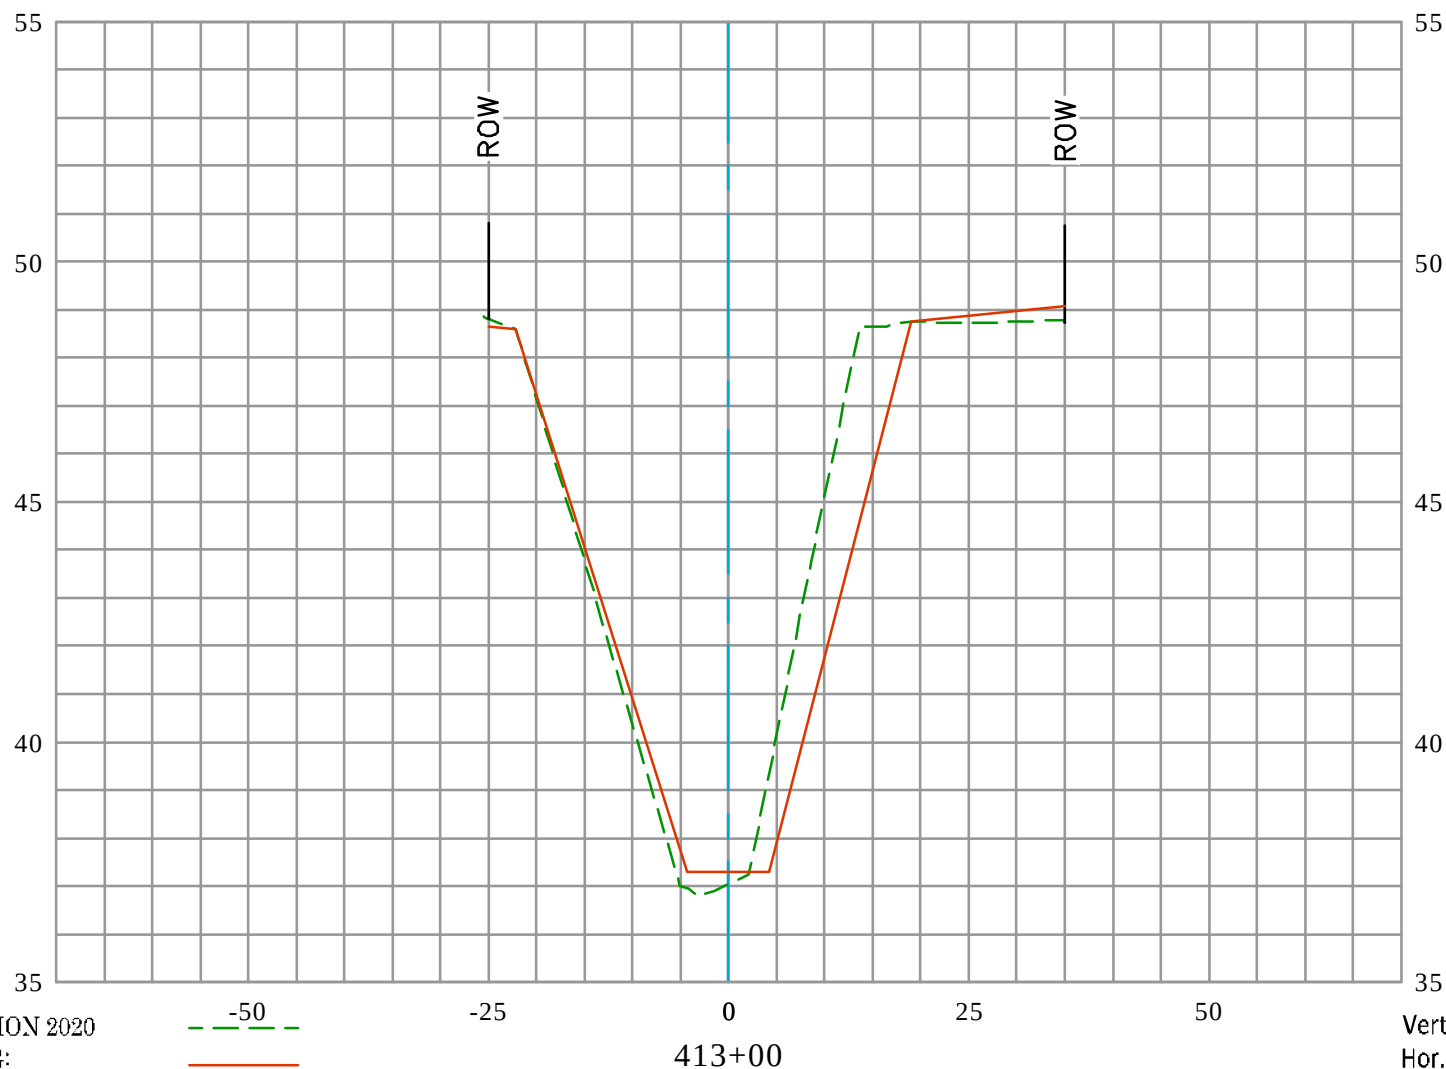


EXISTING CONDITION 2020
RECORD DRAWING:
D03-101-2A, D03-101-3A, & D03-101-7R
DATE PREPARED: 01/24/2022

Vert. Scale: 1" = 4'
Hor. Scale: 1" = 20'



GREENVILLE BANNING CHANNEL (D03) CL

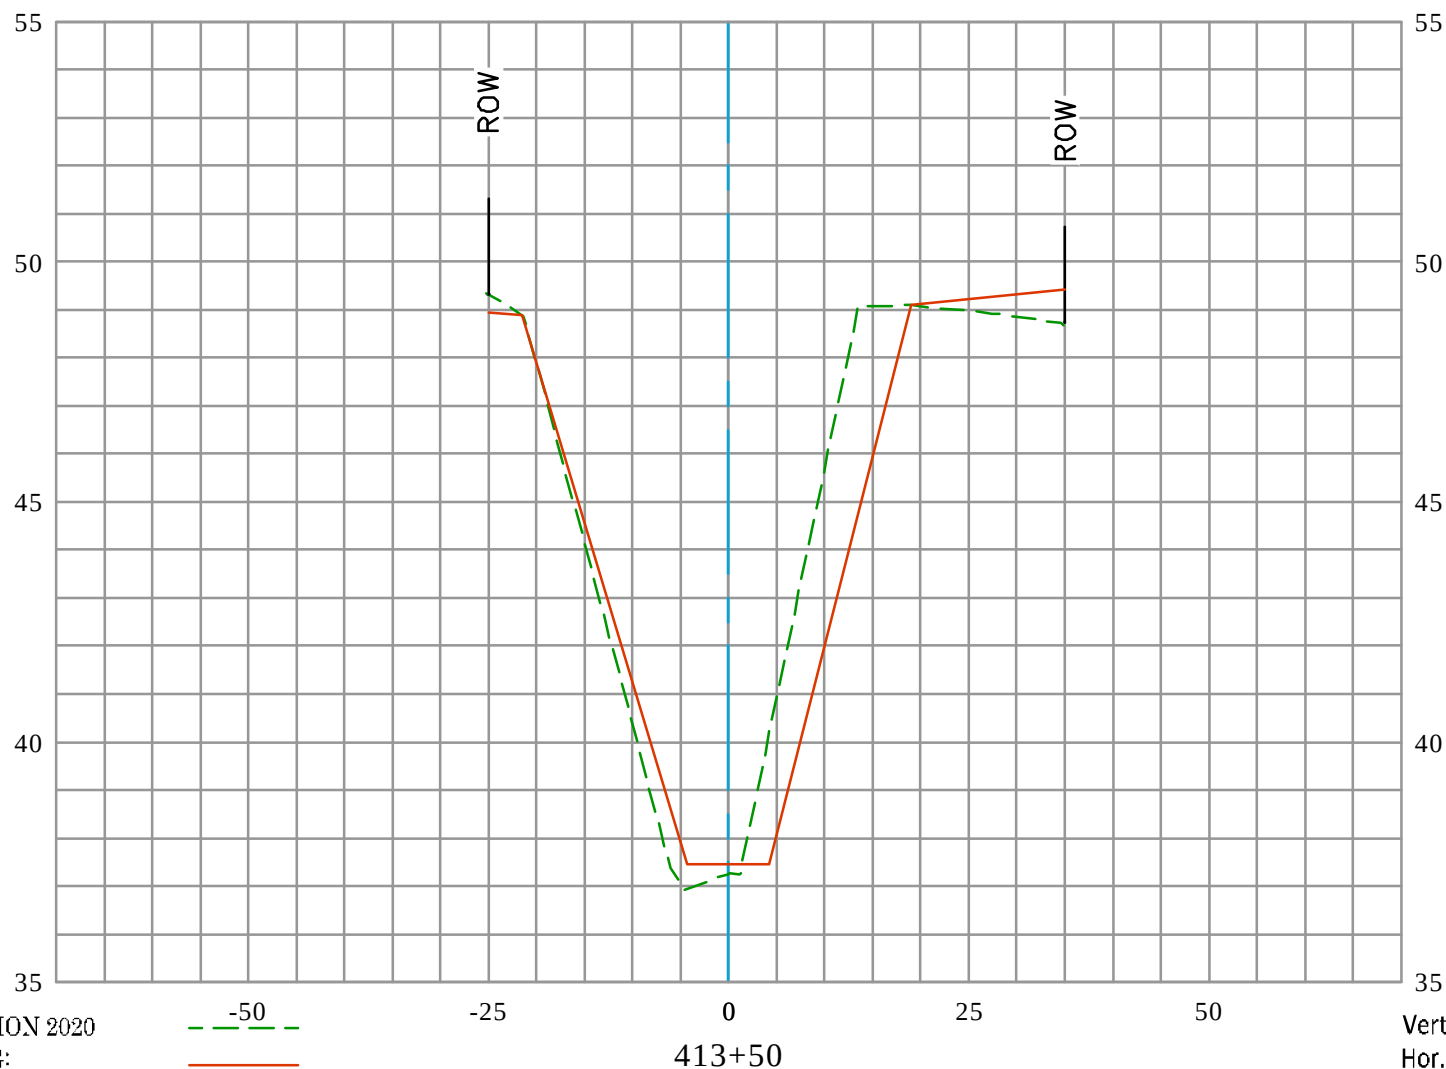


EXISTING CONDITION 2020
 RECORD DRAWING:
 D03-101-2A, D03-101-3A, & D03-101-7R
 DATE PREPARED: 01/24/2022

Vert. Scale: 1" = 4'
 Hor. Scale: 1" = 20'



GREENVILLE BANNING CHANNEL (D03) CL

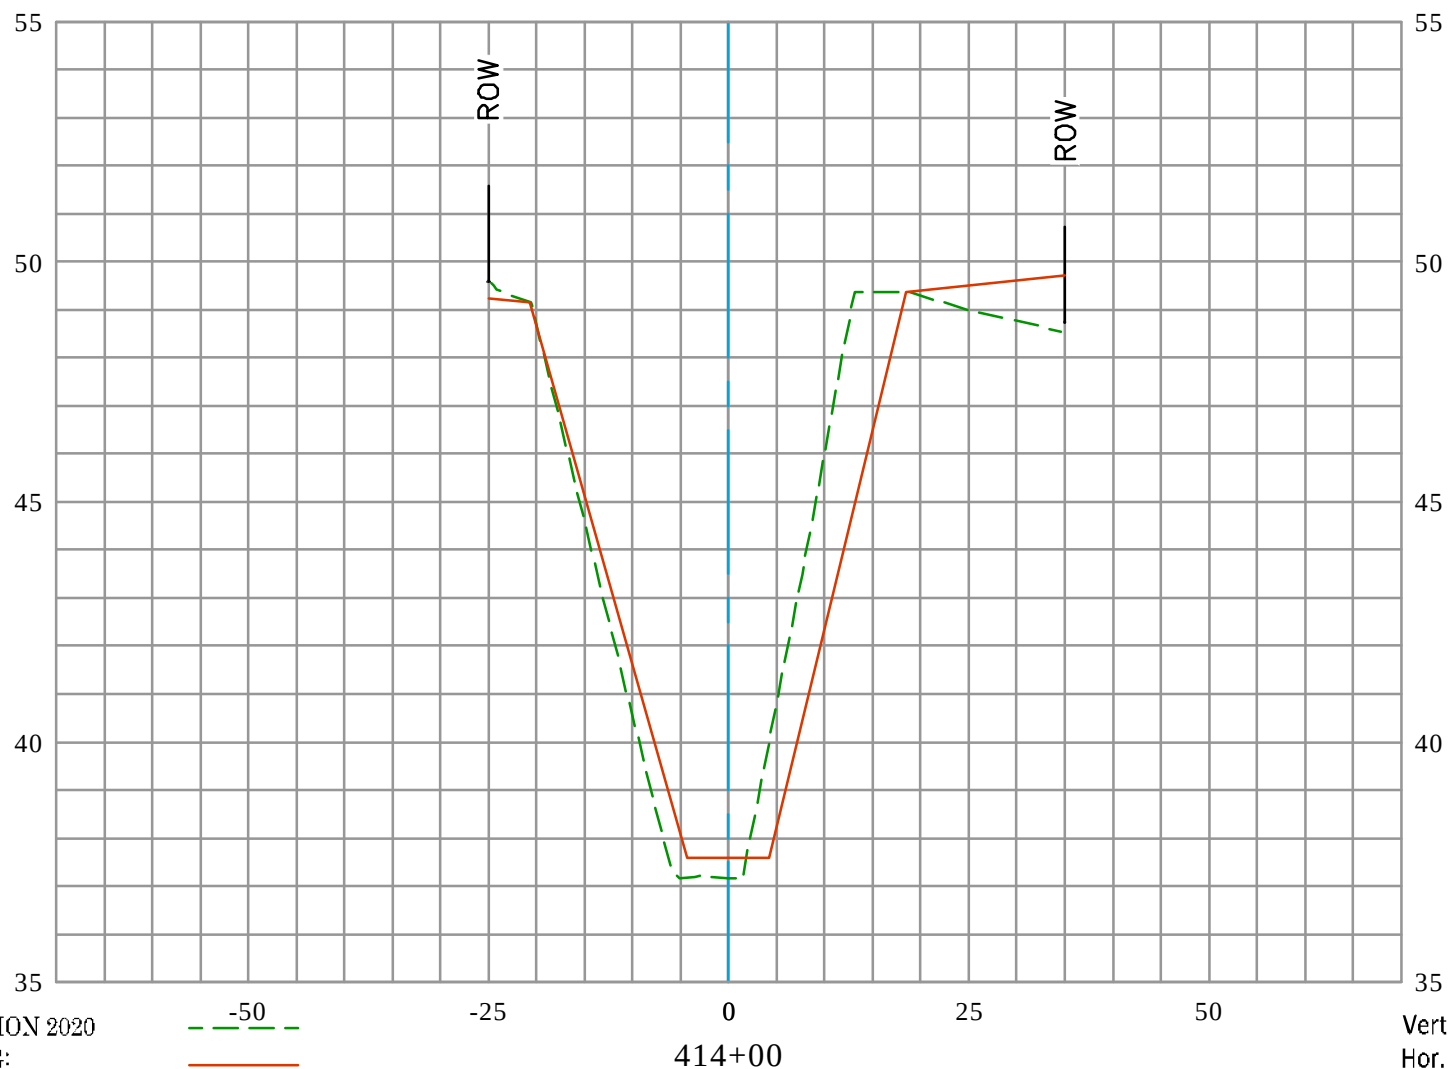


EXISTING CONDITION 2020
RECORD DRAWING:
D03-101-2A, D03-101-3A, & D03-101-7R
DATE PREPARED: 01/24/2022

Vert. Scale: 1" = 4'
Hor. Scale: 1" = 20'



GREENVILLE BANNING CHANNEL (D03) CL

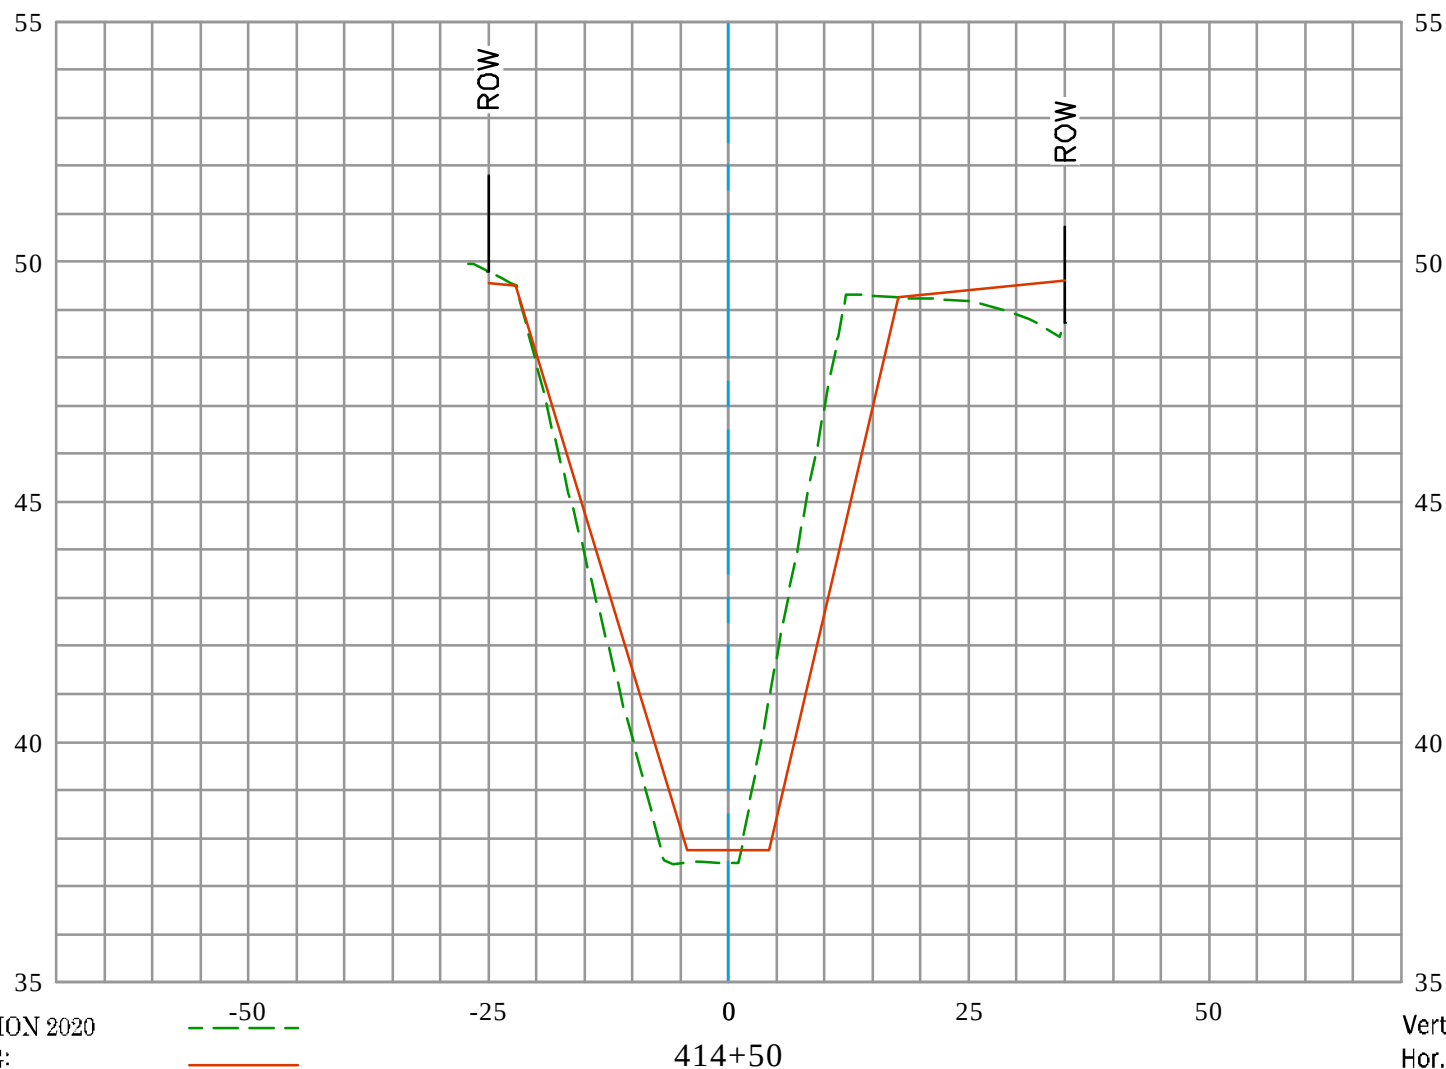


EXISTING CONDITION 2020
 RECORD DRAWING:
 D03-101-2A, D03-101-3A, & D03-101-7R
 DATE PREPARED: 01/24/2022

Vert. Scale: 1" = 4'
 Hor. Scale: 1" = 20'



GREENVILLE BANNING CHANNEL (D03) CL

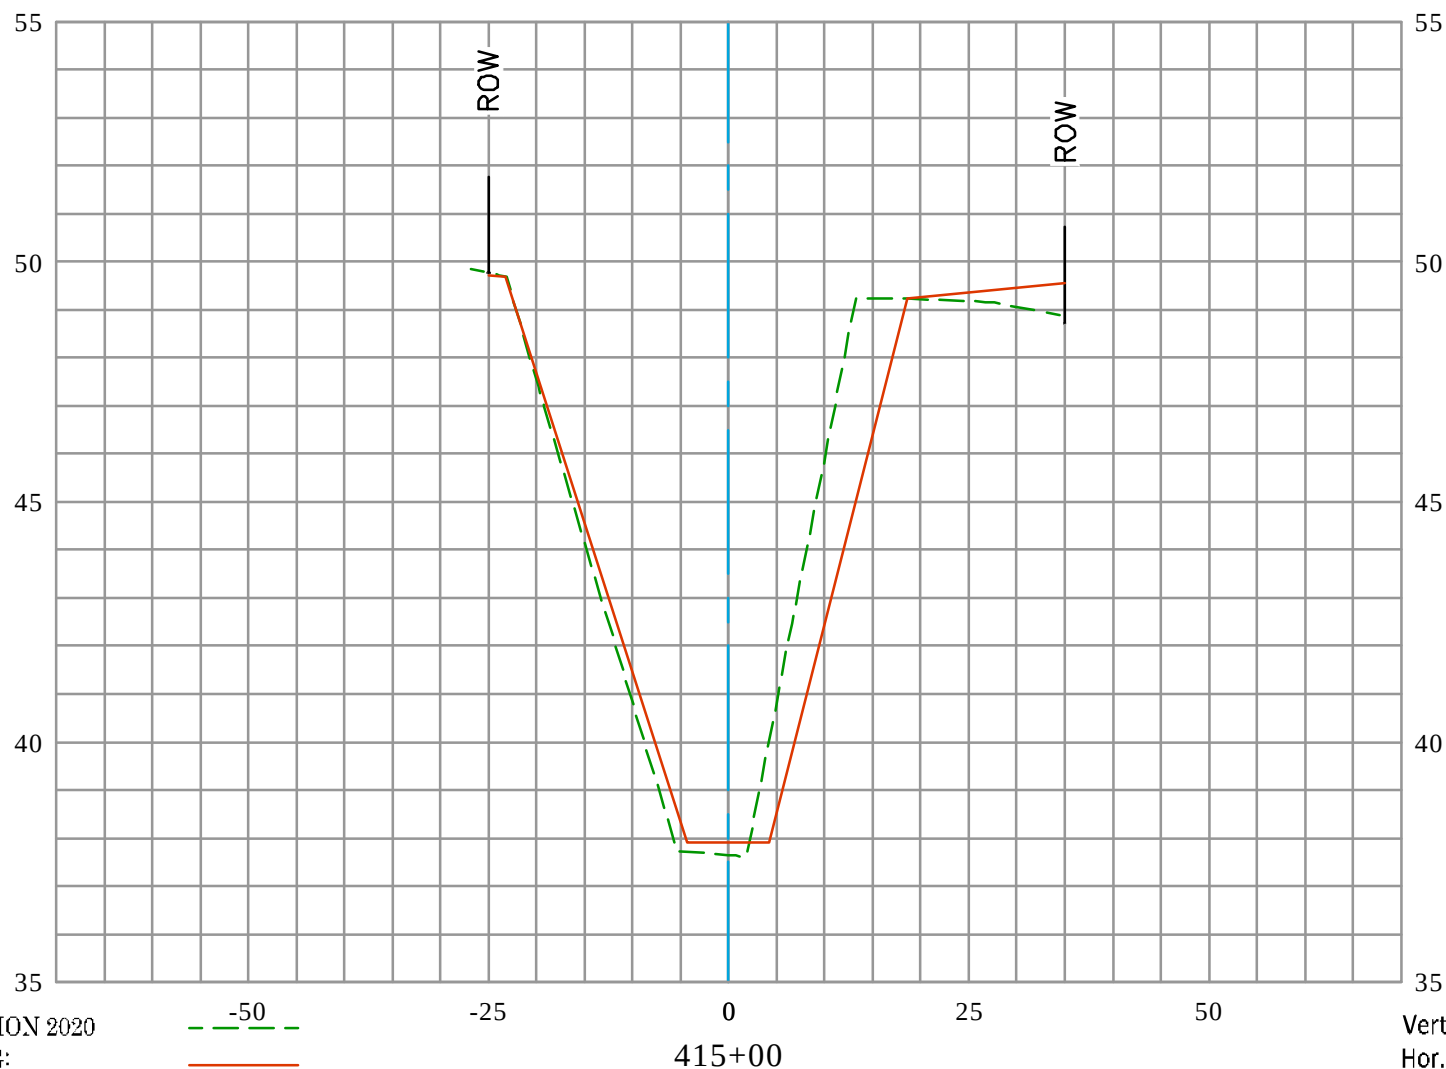


EXISTING CONDITION 2020
 RECORD DRAWING:
 D03-101-2A, D03-101-3A, & D03-101-7R
 DATE PREPARED: 01/24/2022

Vert. Scale: 1" = 4'
 Hor. Scale: 1" = 20'



GREENVILLE BANNING CHANNEL (D03) CL

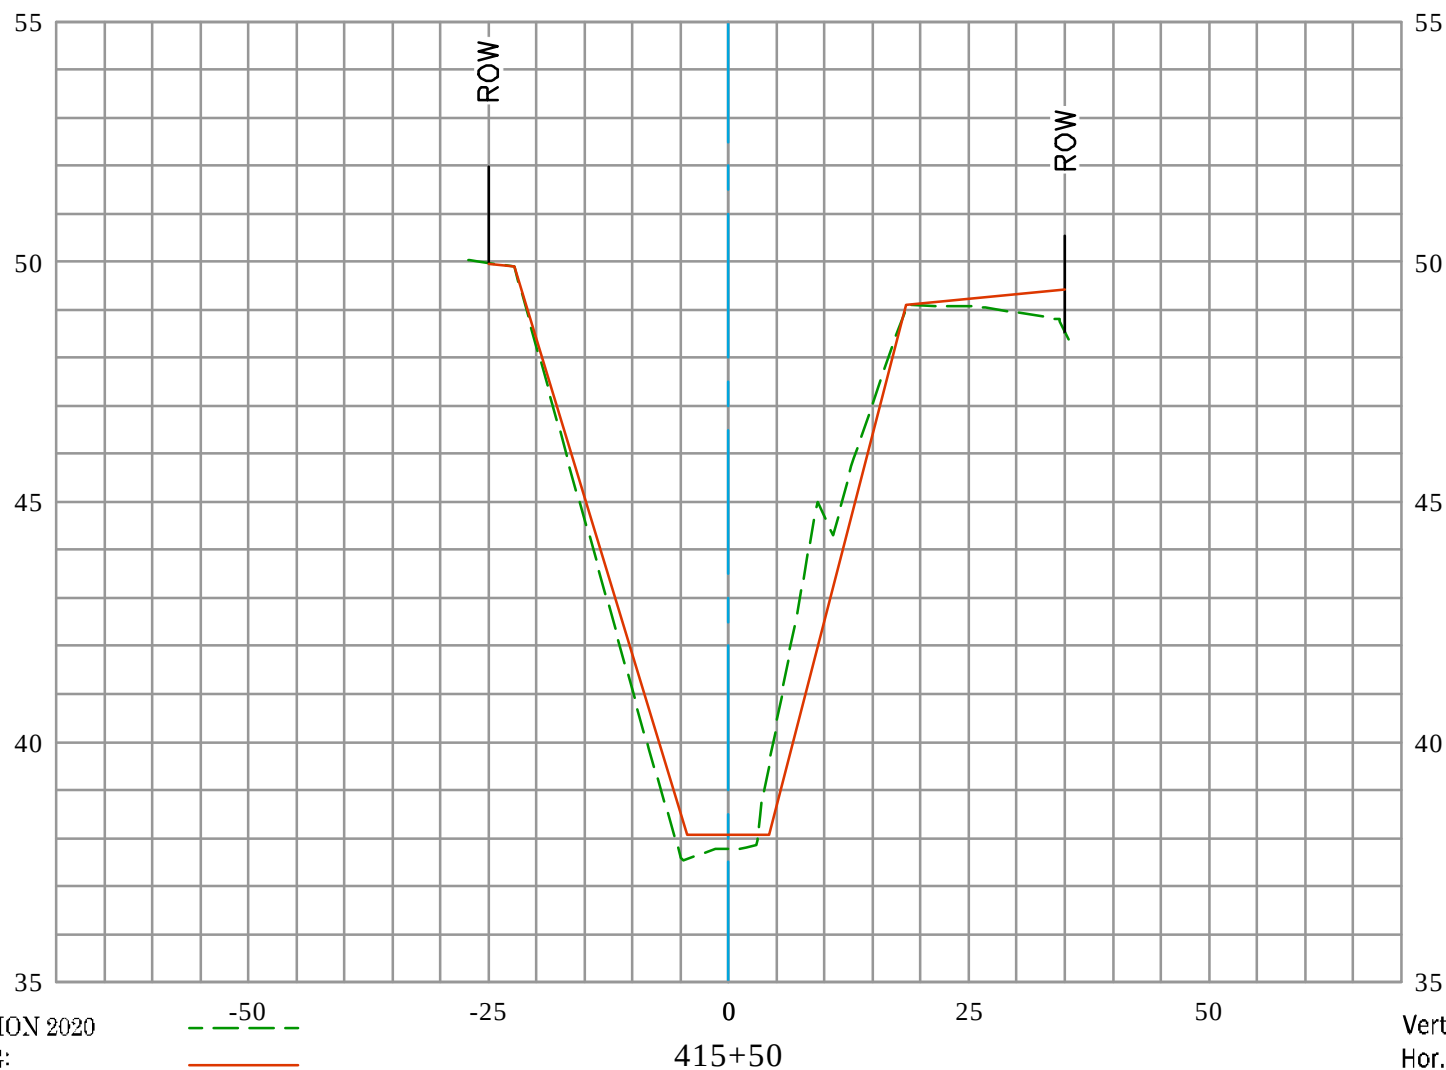


EXISTING CONDITION 2020
RECORD DRAWING:
D03-101-2A, D03-101-3A, & D03-101-7R
DATE PREPARED: 01/24/2022

Vert. Scale: 1" = 4'
Hor. Scale: 1" = 20'



GREENVILLE BANNING CHANNEL (D03) CL

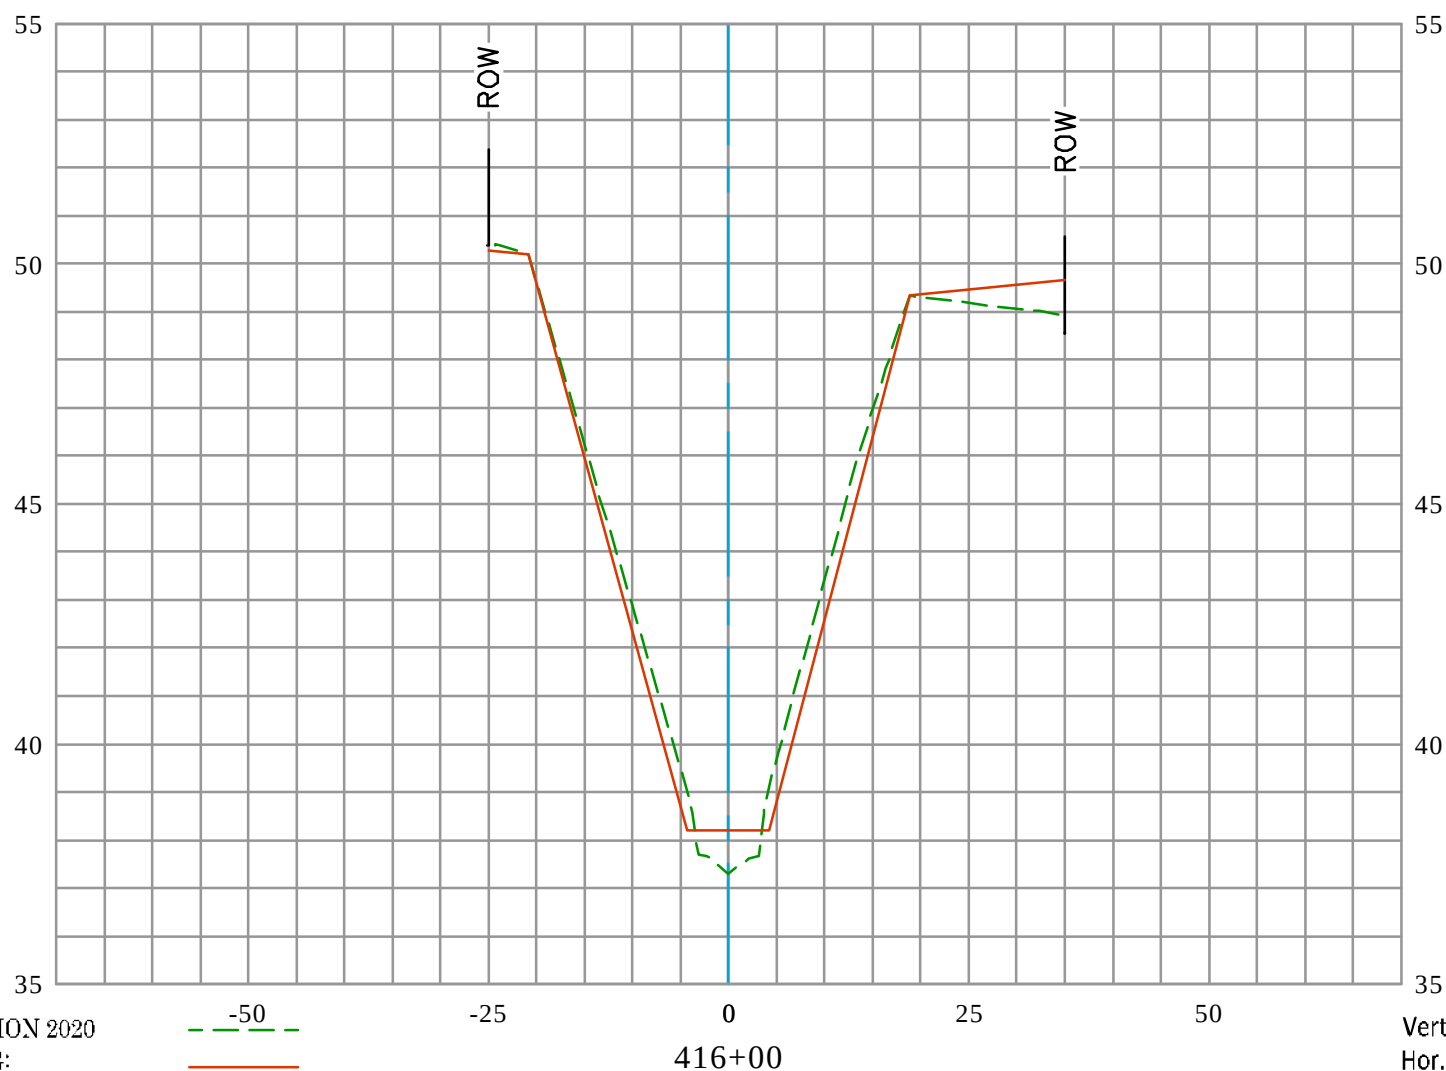


EXISTING CONDITION 2020
RECORD DRAWING:
D03-101-2A, D03-101-3A, & D03-101-7R
DATE PREPARED: 01/24/2022

Vert. Scale: 1" = 4'
Hor. Scale: 1" = 20'




GREENVILLE BANNING CHANNEL (D03) CL

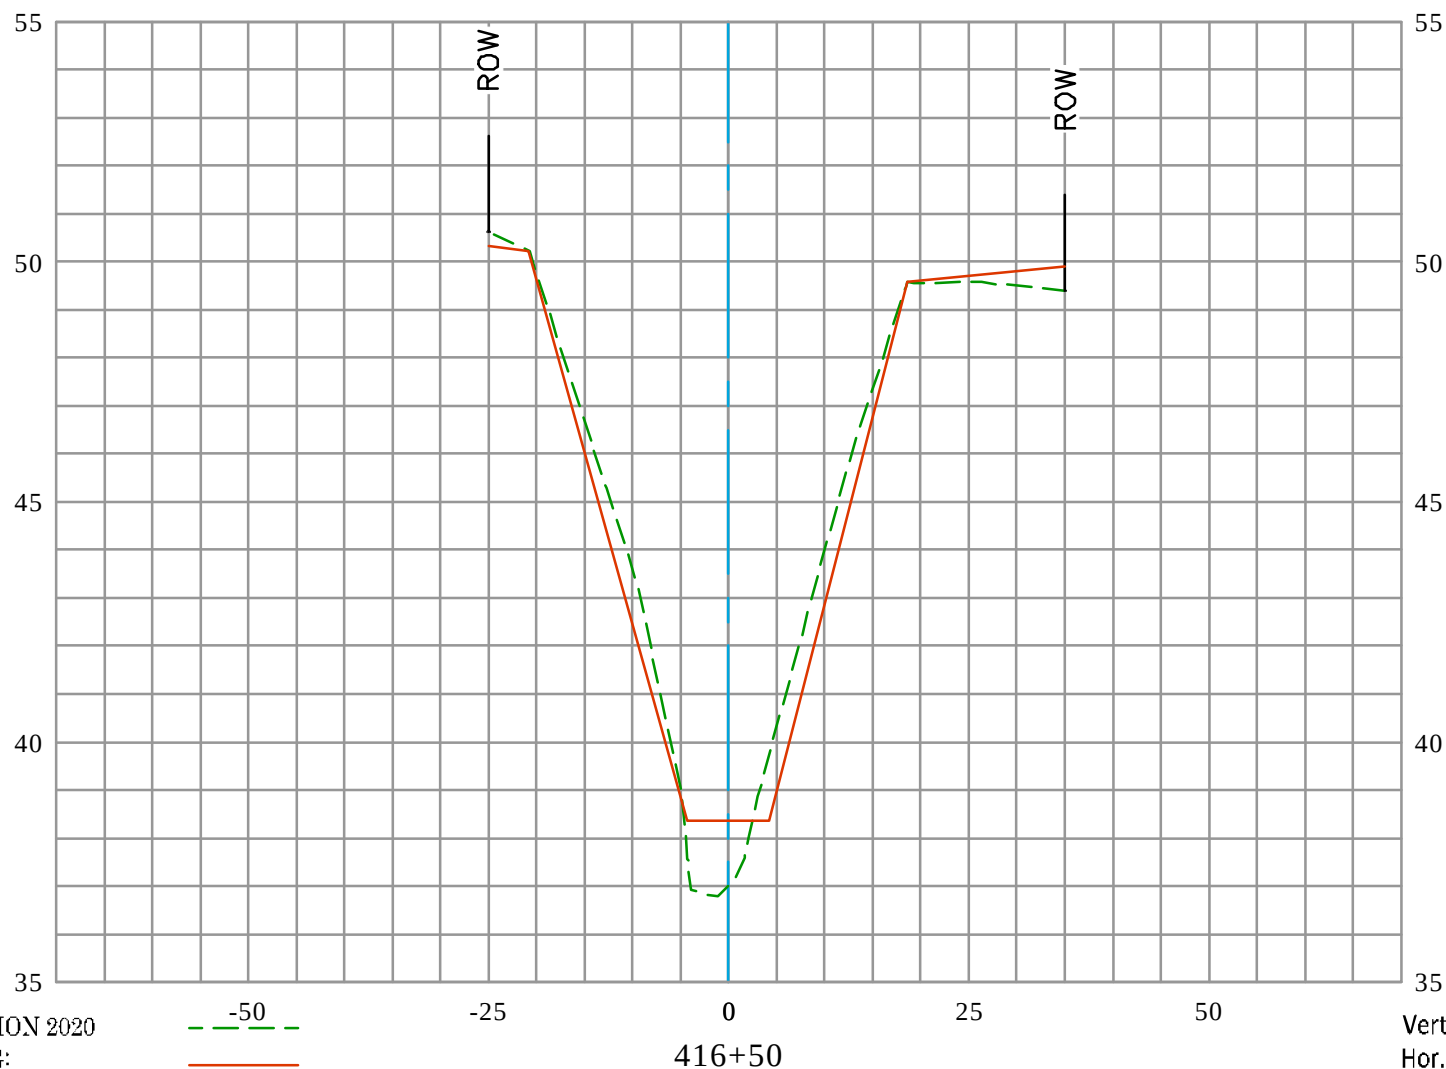

EXISTING CONDITION 2020
 RECORD DRAWING:
 D03-101-2A, D03-101-3A, & D03-101-7R
 DATE PREPARED: 01/24/2022

GREENVILLE BANNING CHANNEL (D03) CL


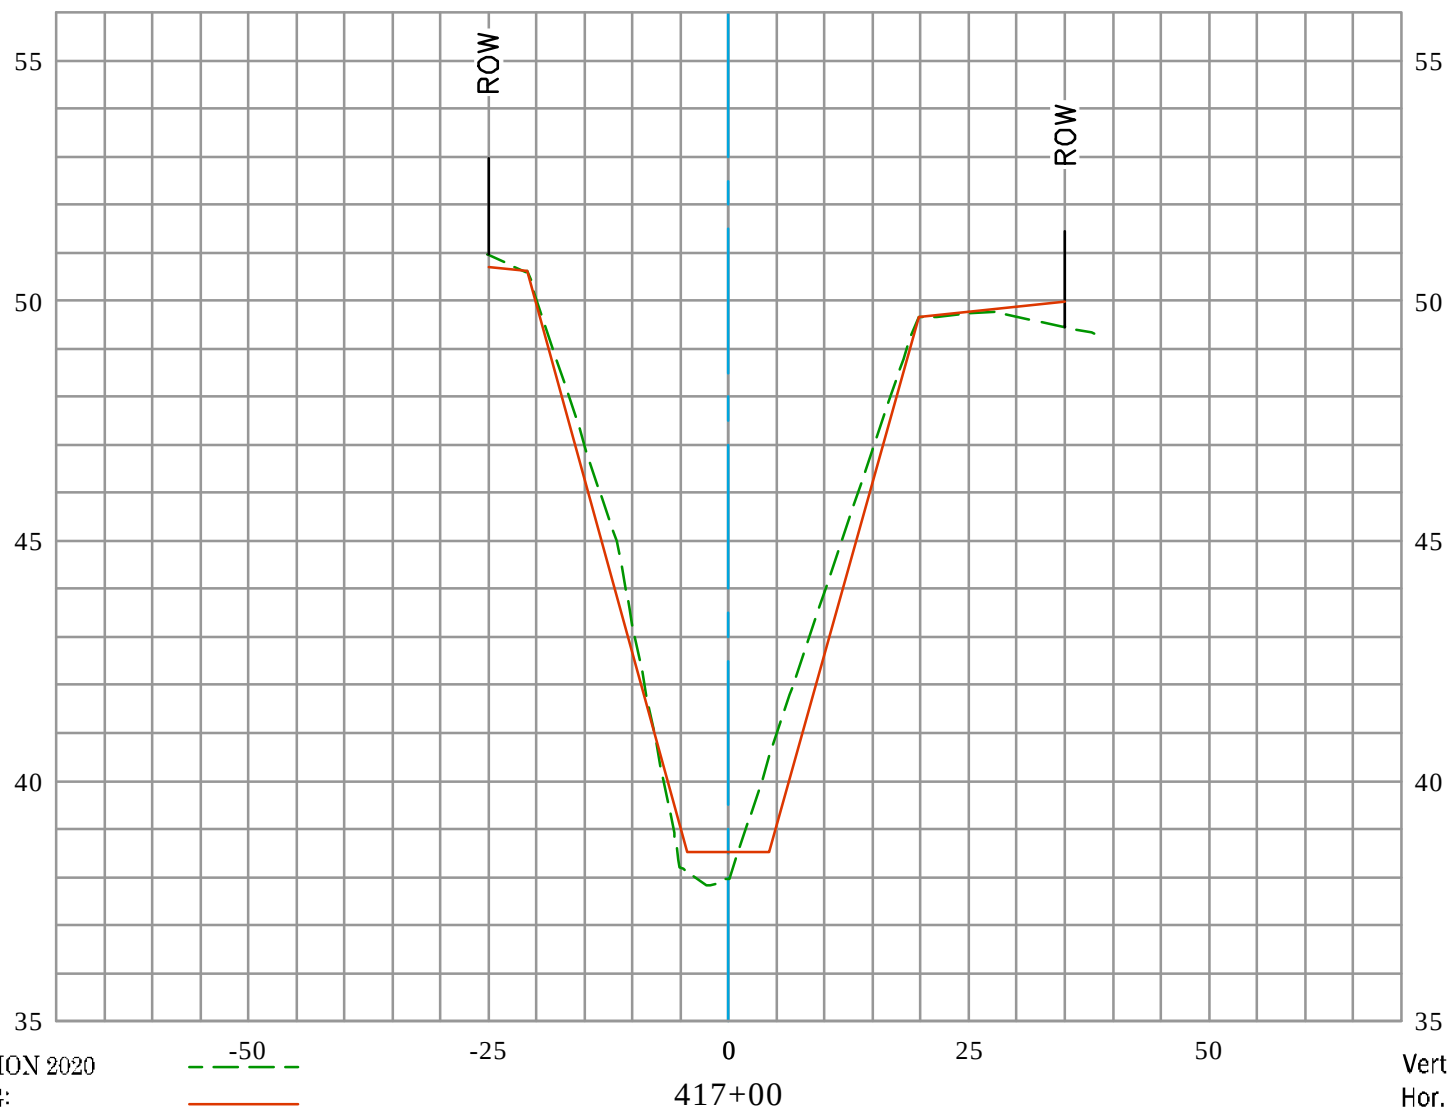


EXISTING CONDITION 2020
 RECORD DRAWING:
 D03-101-2A, D03-101-3A, & D03-101-7R
 DATE PREPARED: 01/24/2022

U.S. *Survey Foot*

OC Public Works
OC Survey/Field Services
Boundary Analysis & Mapping


GREENVILLE BANNING CHANNEL (D03) CL

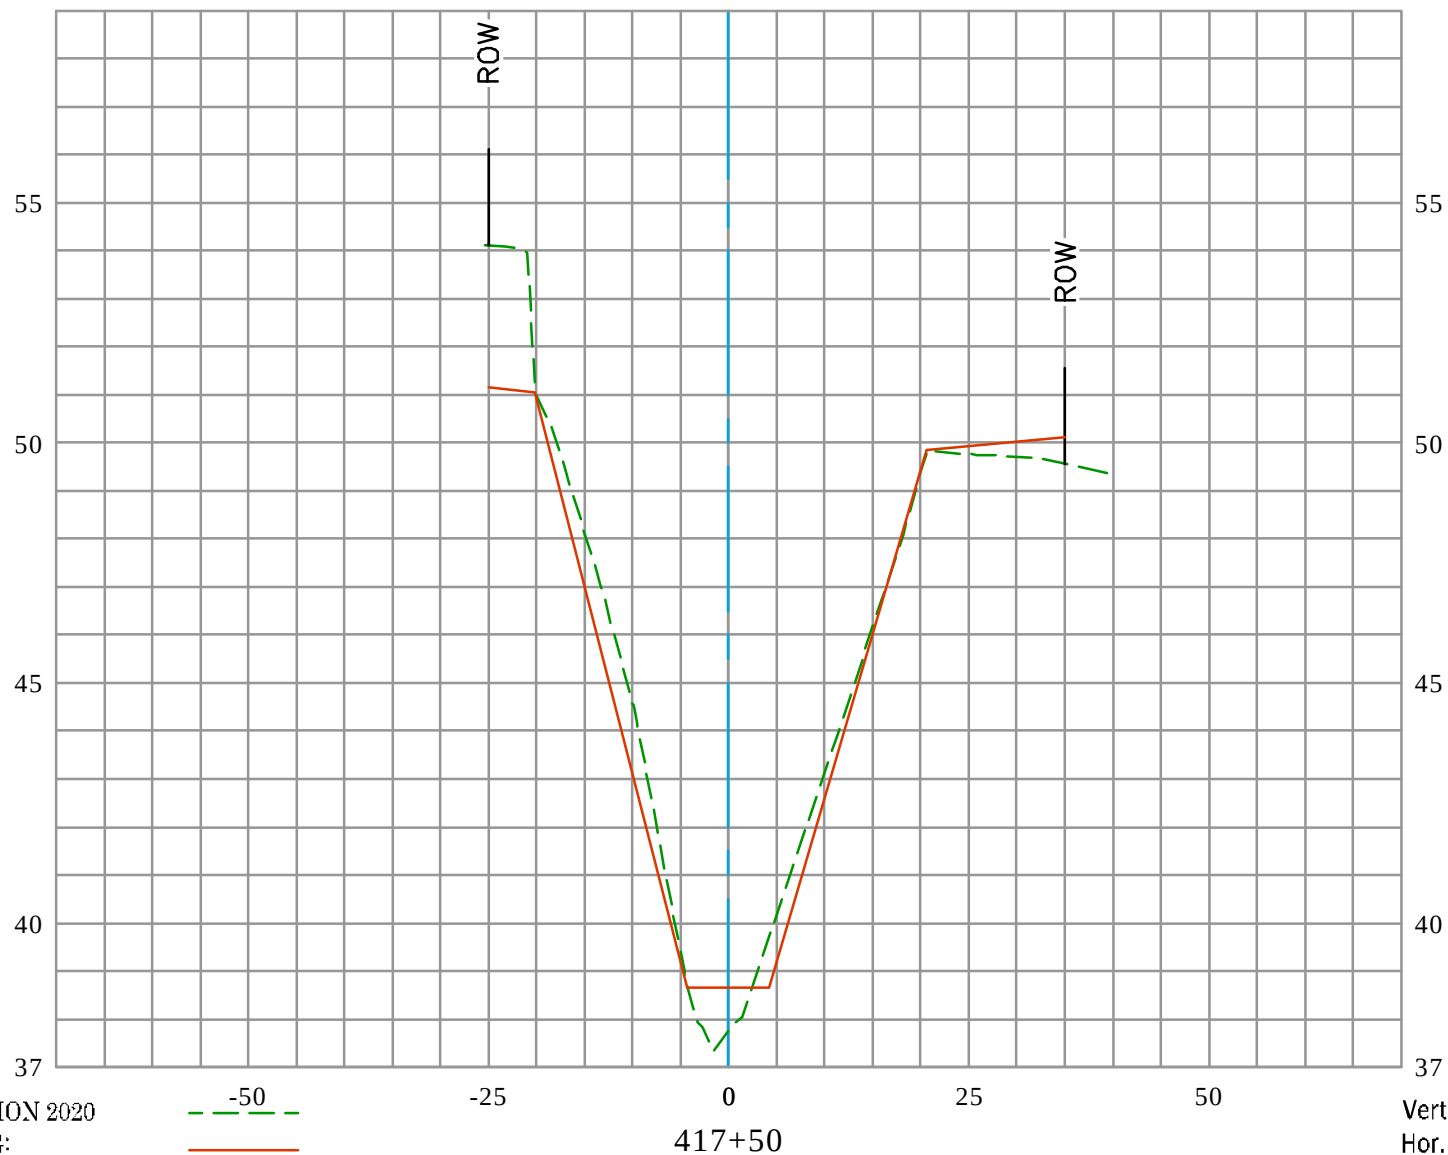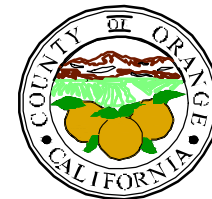

EXISTING CONDITION 2020
RECORD DRAWING:
D03-101-2A, D03-101-3A, & D03-101-7R
DATE PREPARED: 01/24/2022




GREENVILLE BANNING CHANNEL (D03) CL


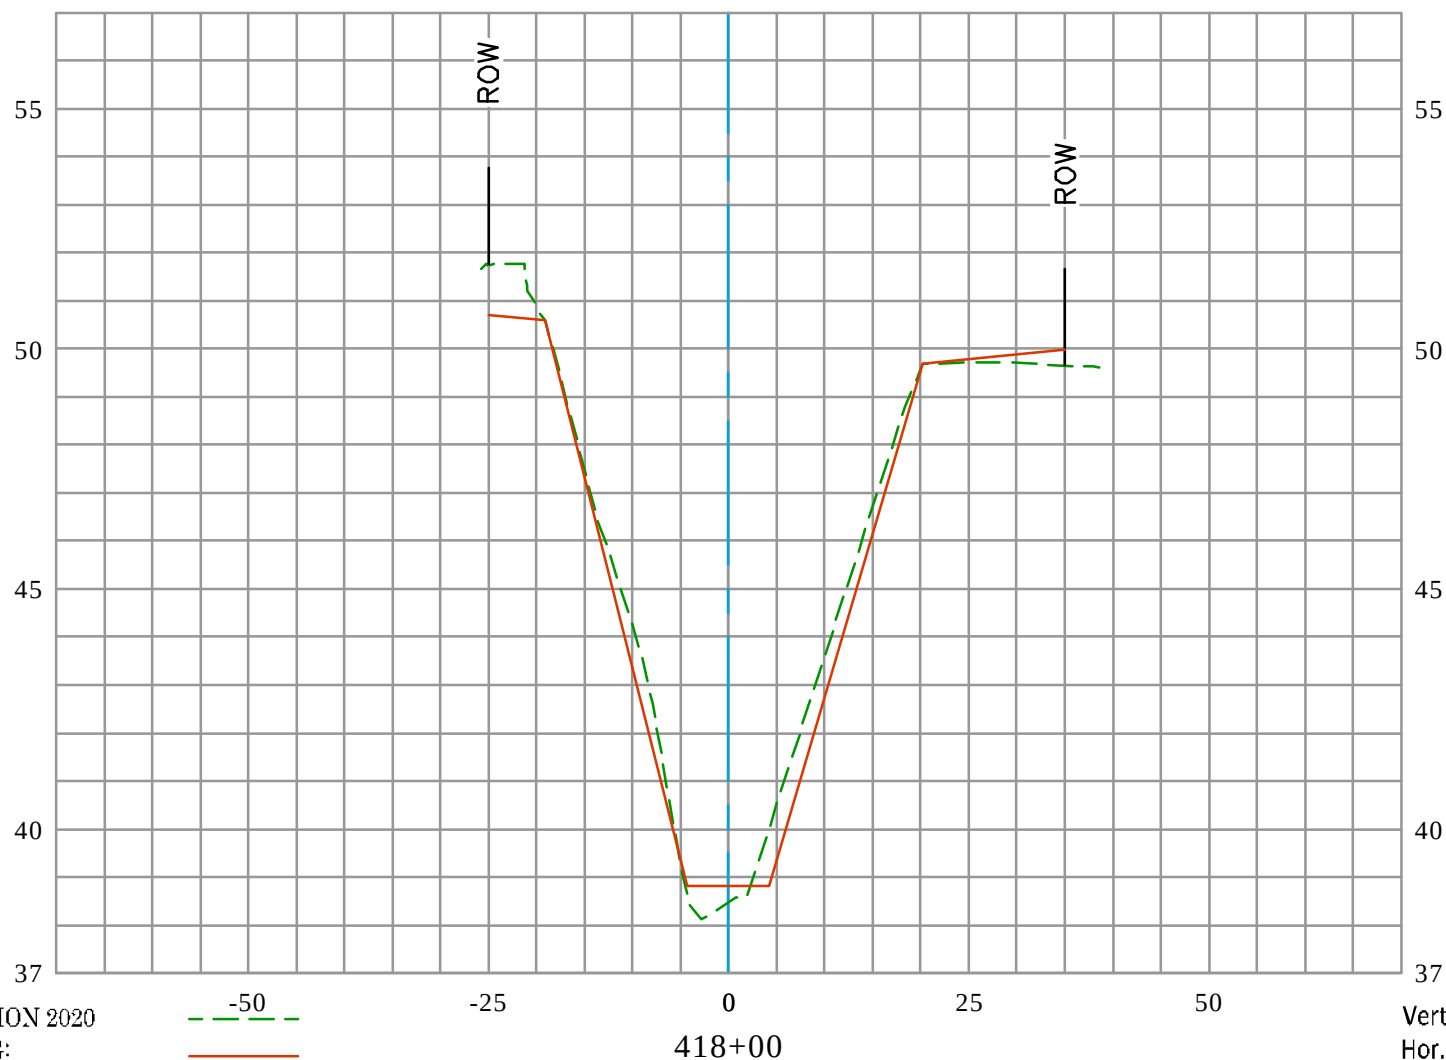


EXISTING CONDITION 2020
 RECORD DRAWING:
 D03-101-2A, D03-101-3A, & D03-101-7R
 DATE PREPARED: 01/24/2022

Vert. Scale: 1" = 4'
 Hor. Scale: 1" = 20'

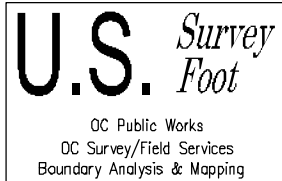


GREENVILLE BANNING CHANNEL (D03) CL

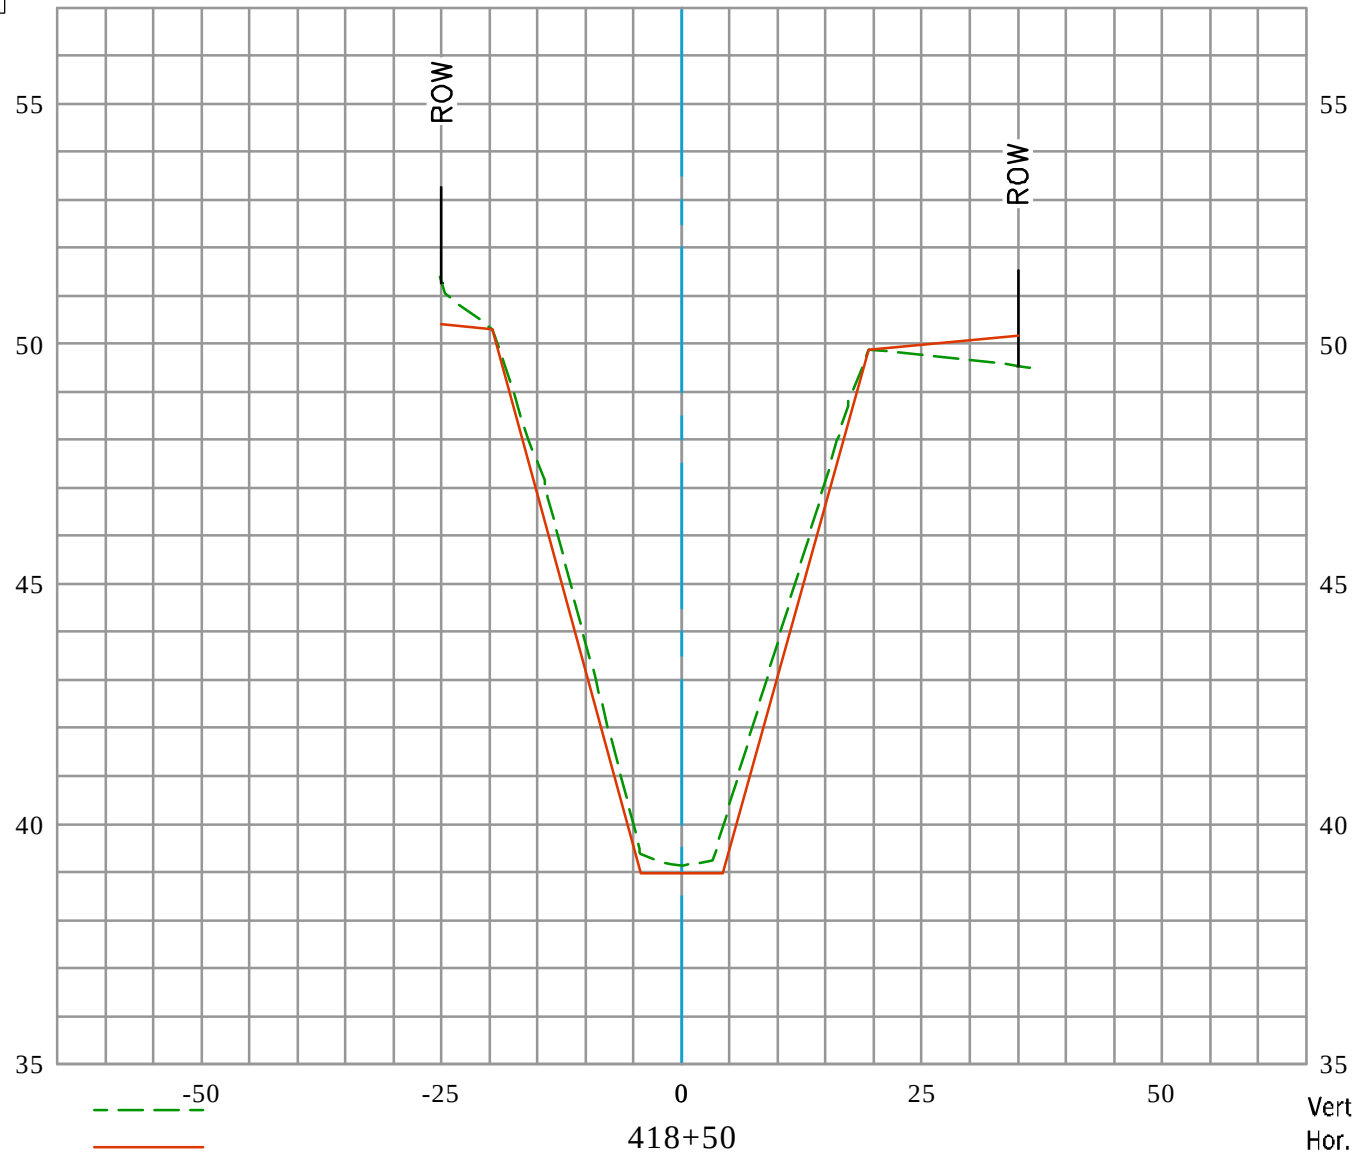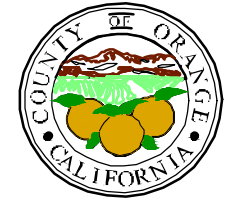

EXISTING CONDITION 2020
RECORD DRAWING:
D03-101-2A, D03-101-3A, & D03-101-7R
DATE PREPARED: 01/24/2022



GREENVILLE BANNING CHANNEL (D03) CL

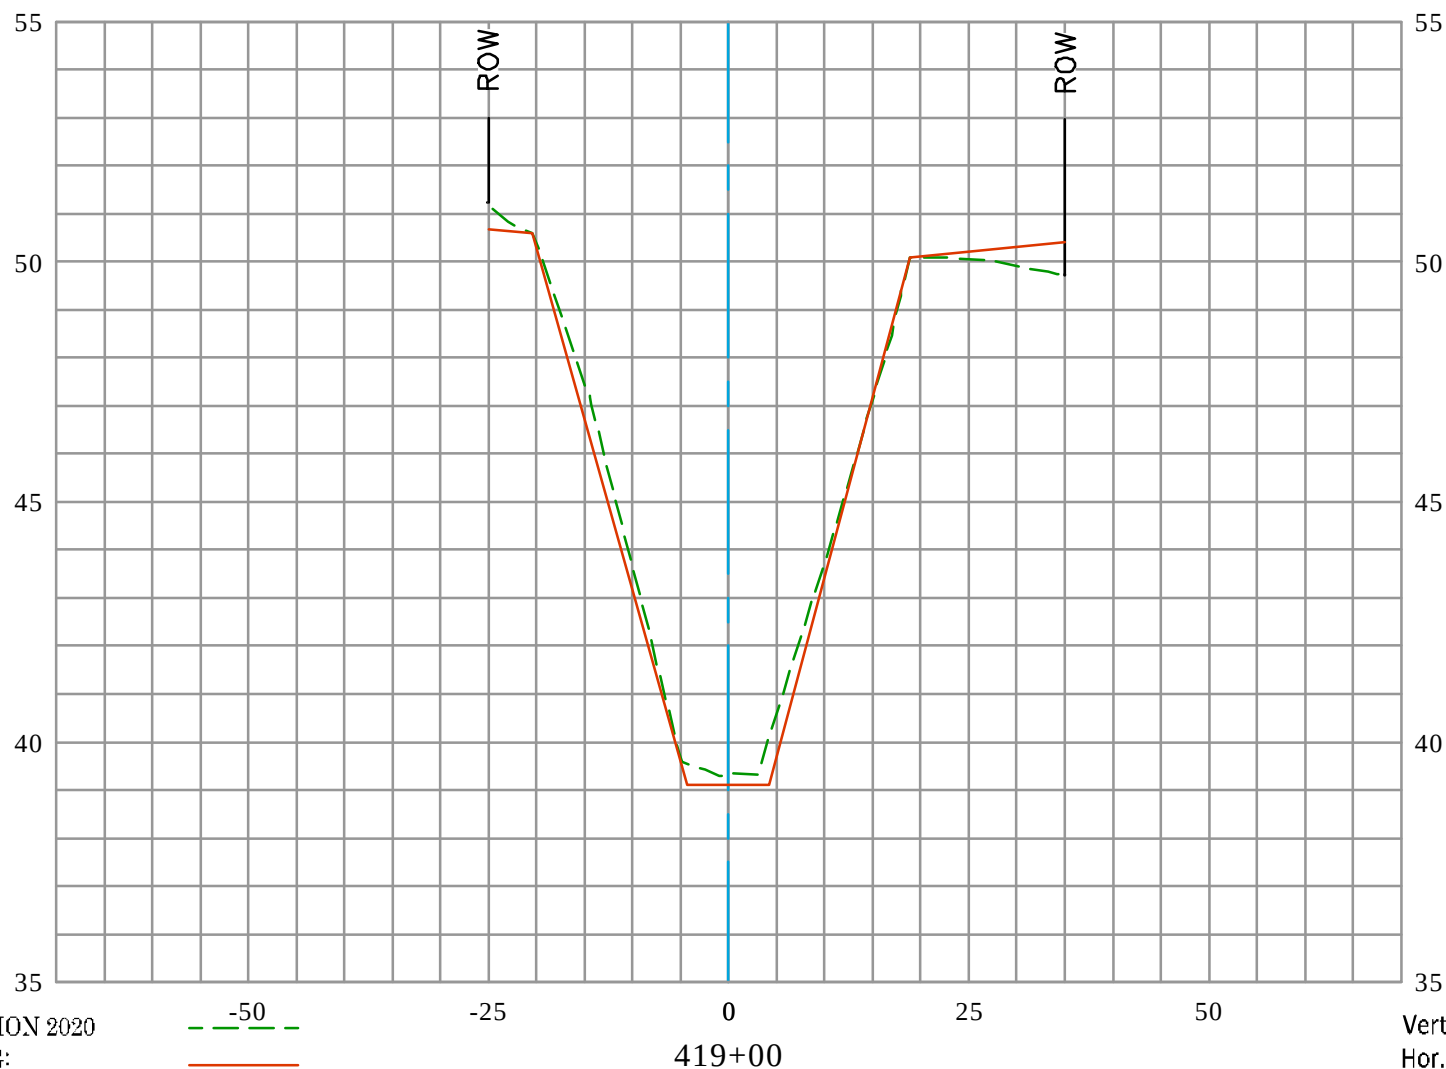


EXISTING CONDITION 2020
 RECORD DRAWING:
 D03-101-2A, D03-101-3A, & D03-101-7R
 DATE PREPARED: 01/24/2022

Vert. Scale: 1" = 4'
 Hor. Scale: 1" = 20'




GREENVILLE BANNING CHANNEL (D03) CL

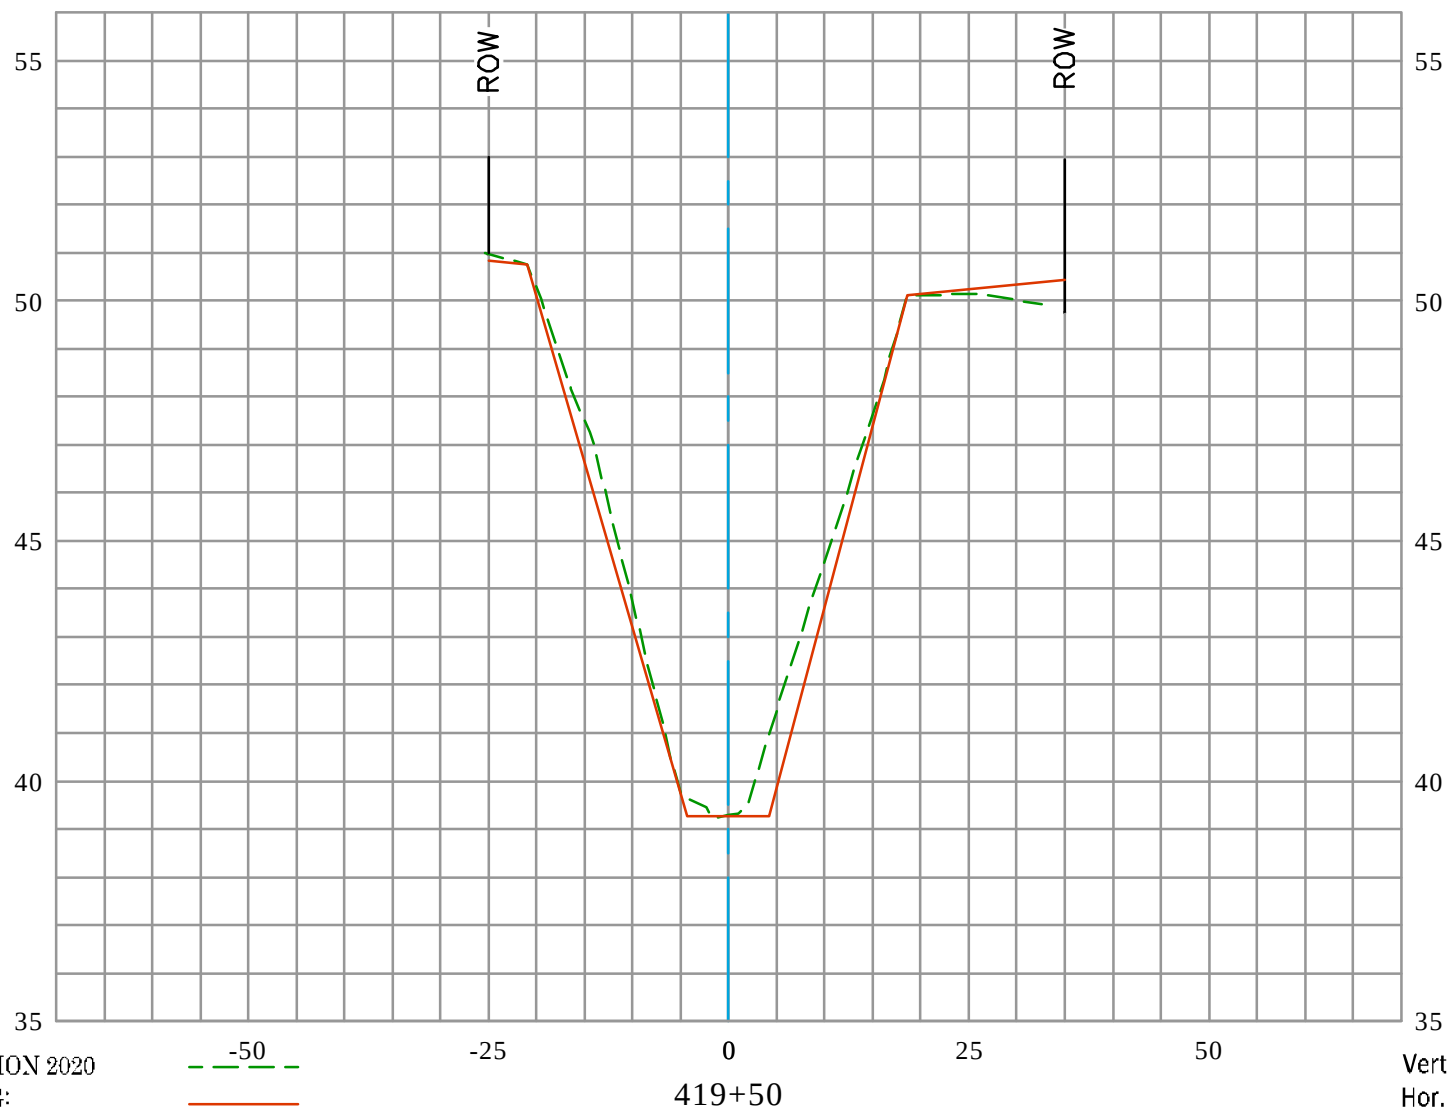

EXISTING CONDITION 2020
RECORD DRAWING:
D03-101-2A, D03-101-3A, & D03-101-7R
DATE PREPARED: 01/24/2022



GREENVILLE BANNING CHANNEL (D03) CL


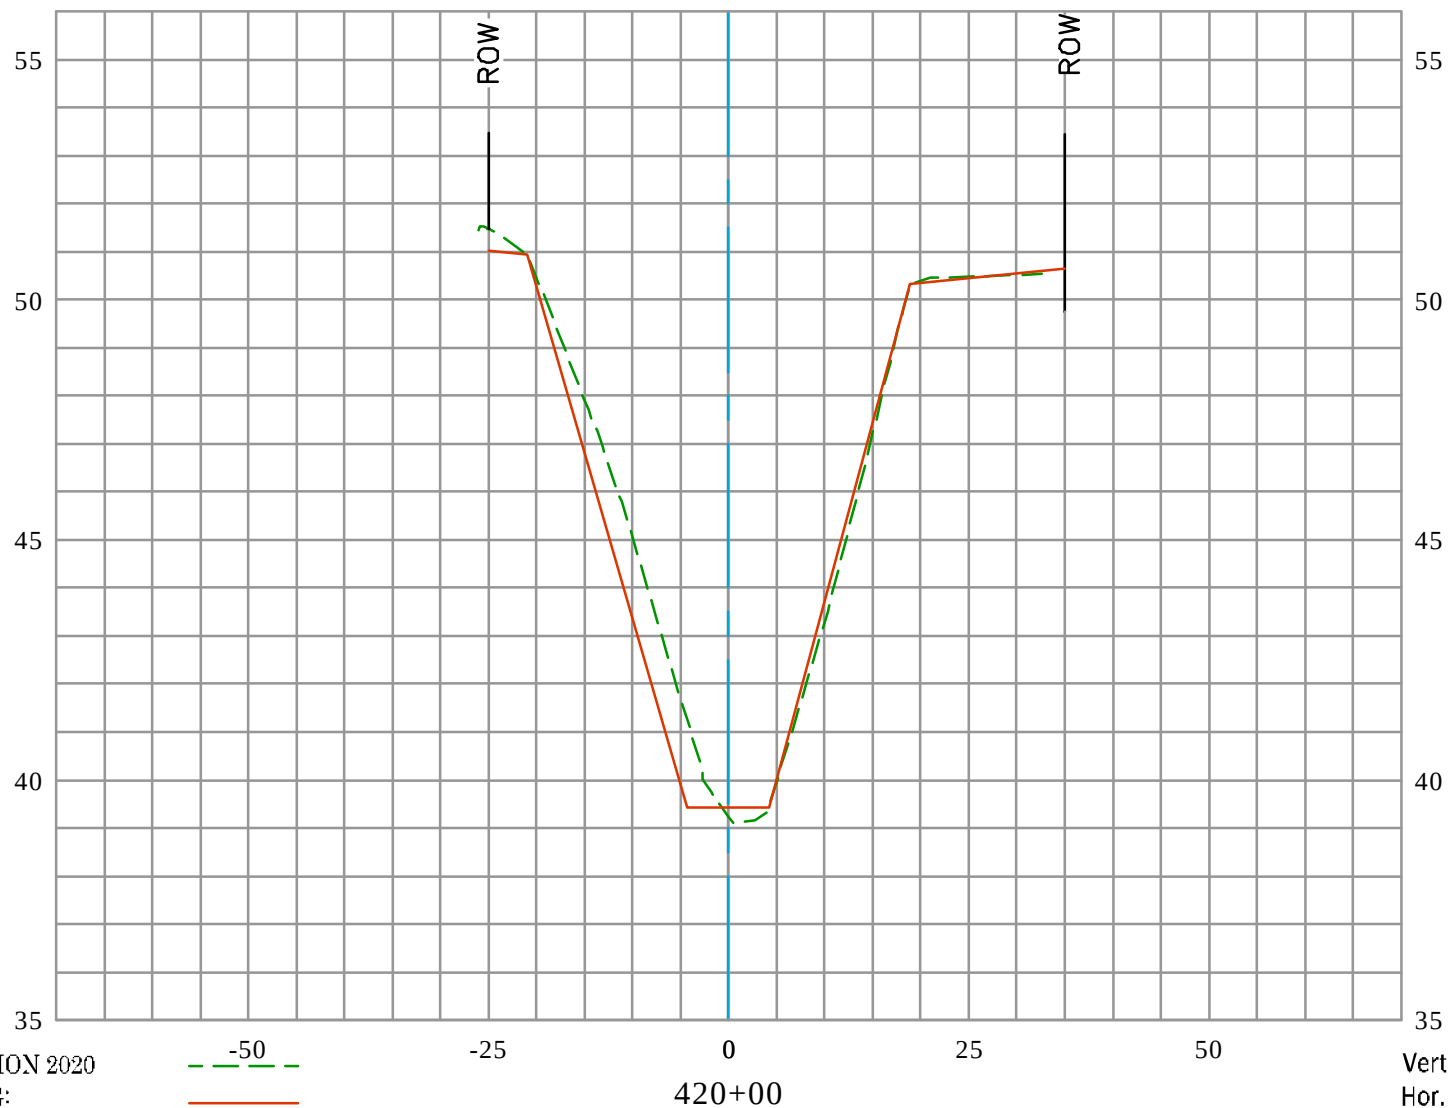


EXISTING CONDITION 2020
RECORD DRAWING:
D03-101-2A, D03-101-3A, & D03-101-7R
DATE PREPARED: 01/24/2022


U.S. Survey Foot

OC Public Works
OC Survey/Field Services
Boundary Analysis & Mapping


GREENVILLE BANNING CHANNEL (D03) CL

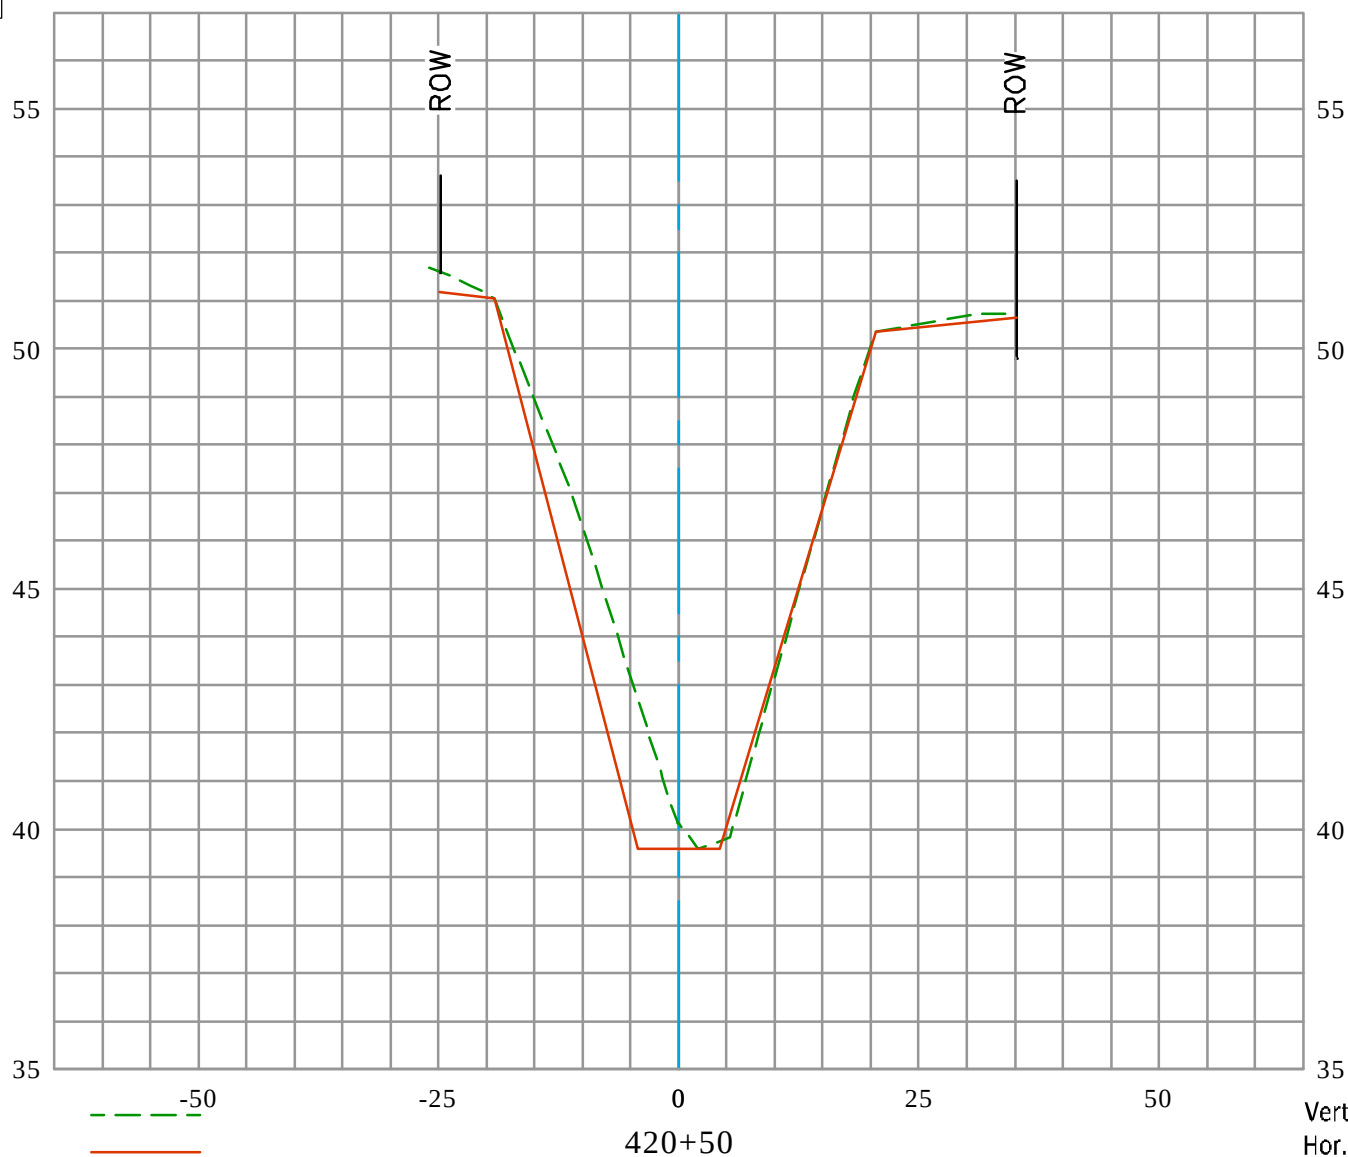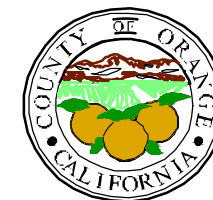

EXISTING CONDITION 2020
RECORD DRAWING:
D03-101-2A, D03-101-3A, & D03-101-7R
DATE PREPARED: 01/24/2022

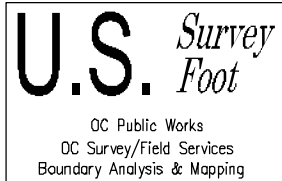

GREENVILLE BANNING CHANNEL (D03) CL

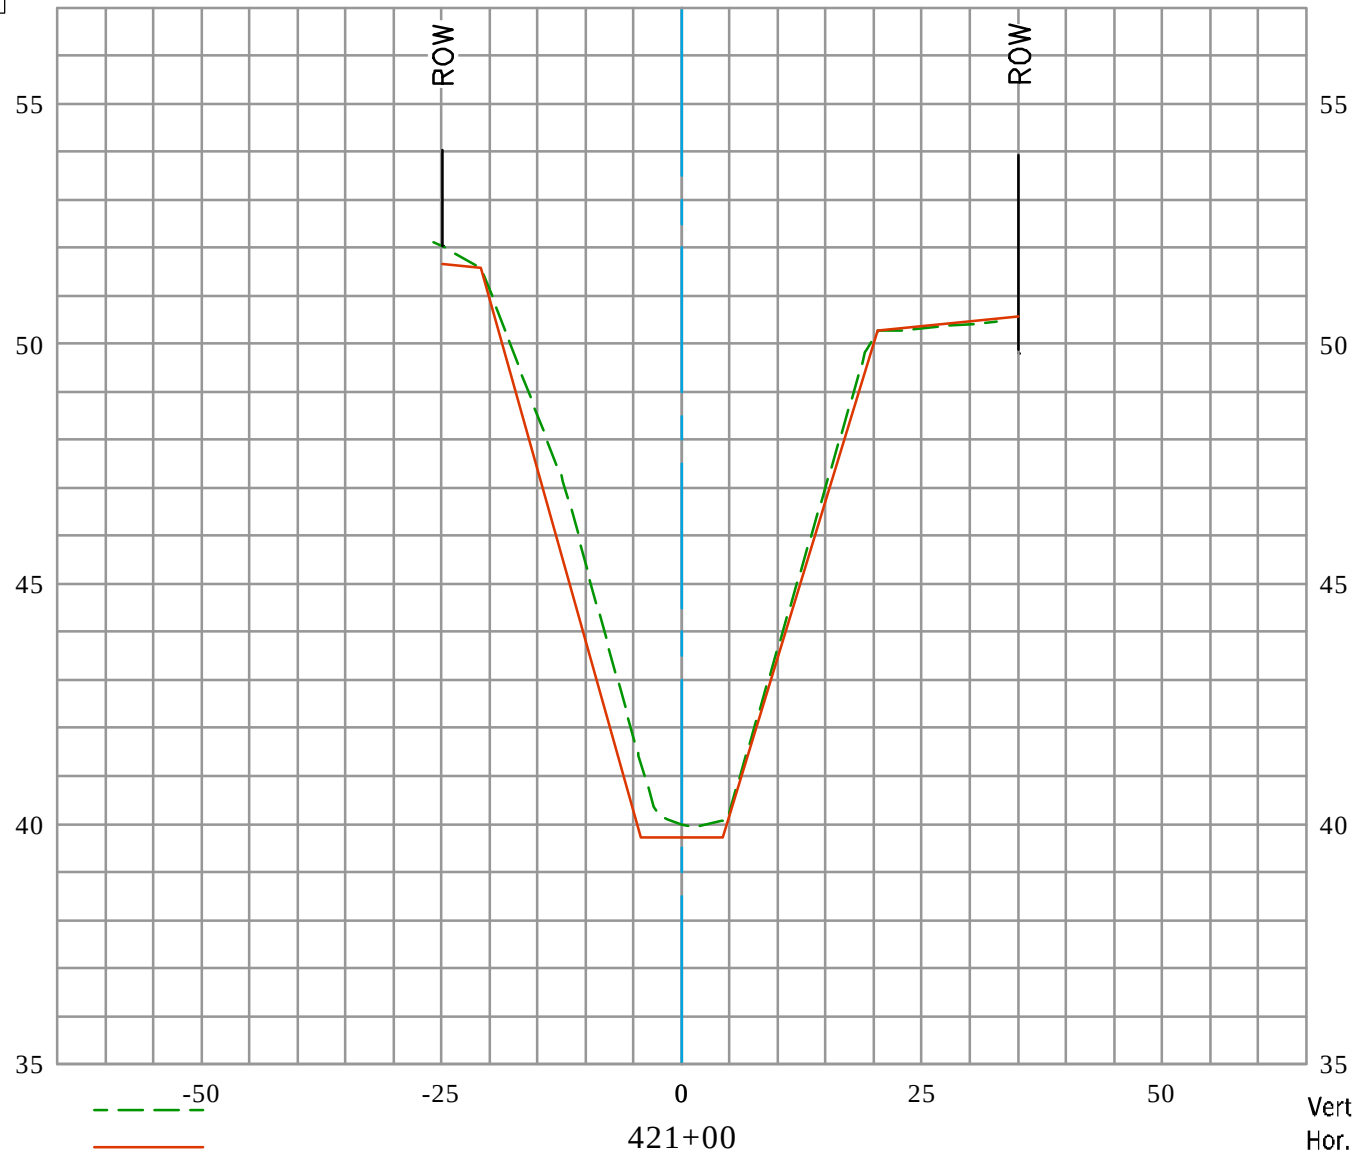


EXISTING CONDITION 2020
RECORD DRAWING:
D03-101-2A, D03-101-3A, & D03-101-7R
DATE PREPARED: 01/24/2022

U.S. Survey Foot


OC Public Works
OC Survey/Field Services
Boundary Analysis & Mapping

GREENVILLE BANNING CHANNEL (D03) CL

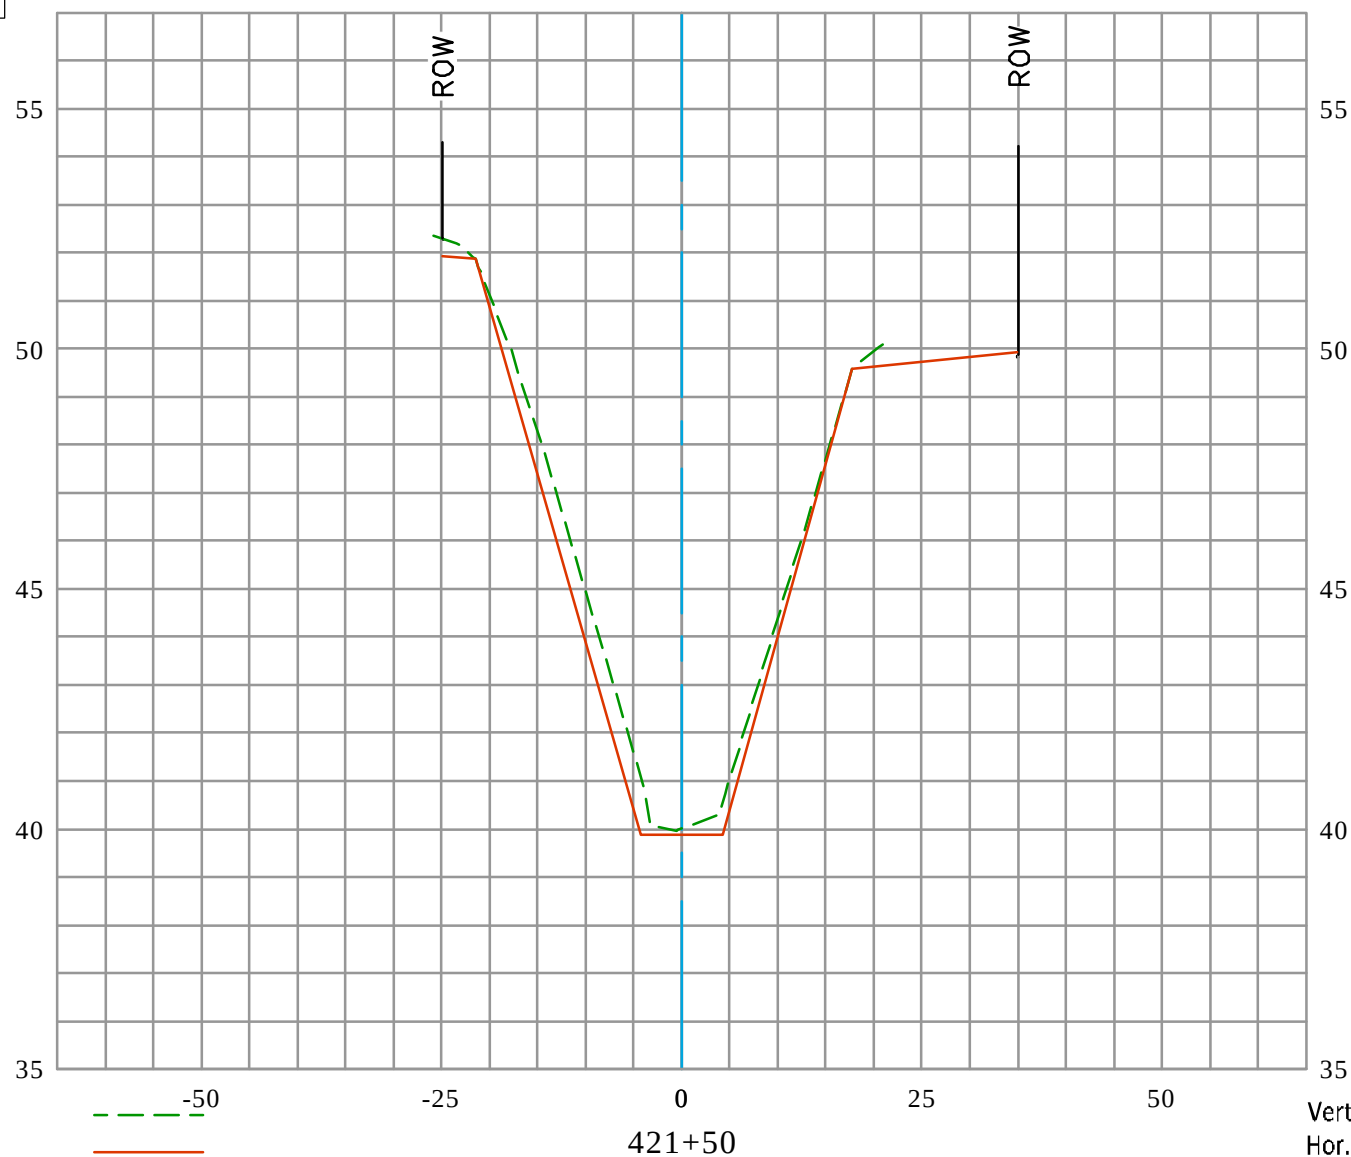






GREENVILLE BANNING CHANNEL (D03) CL

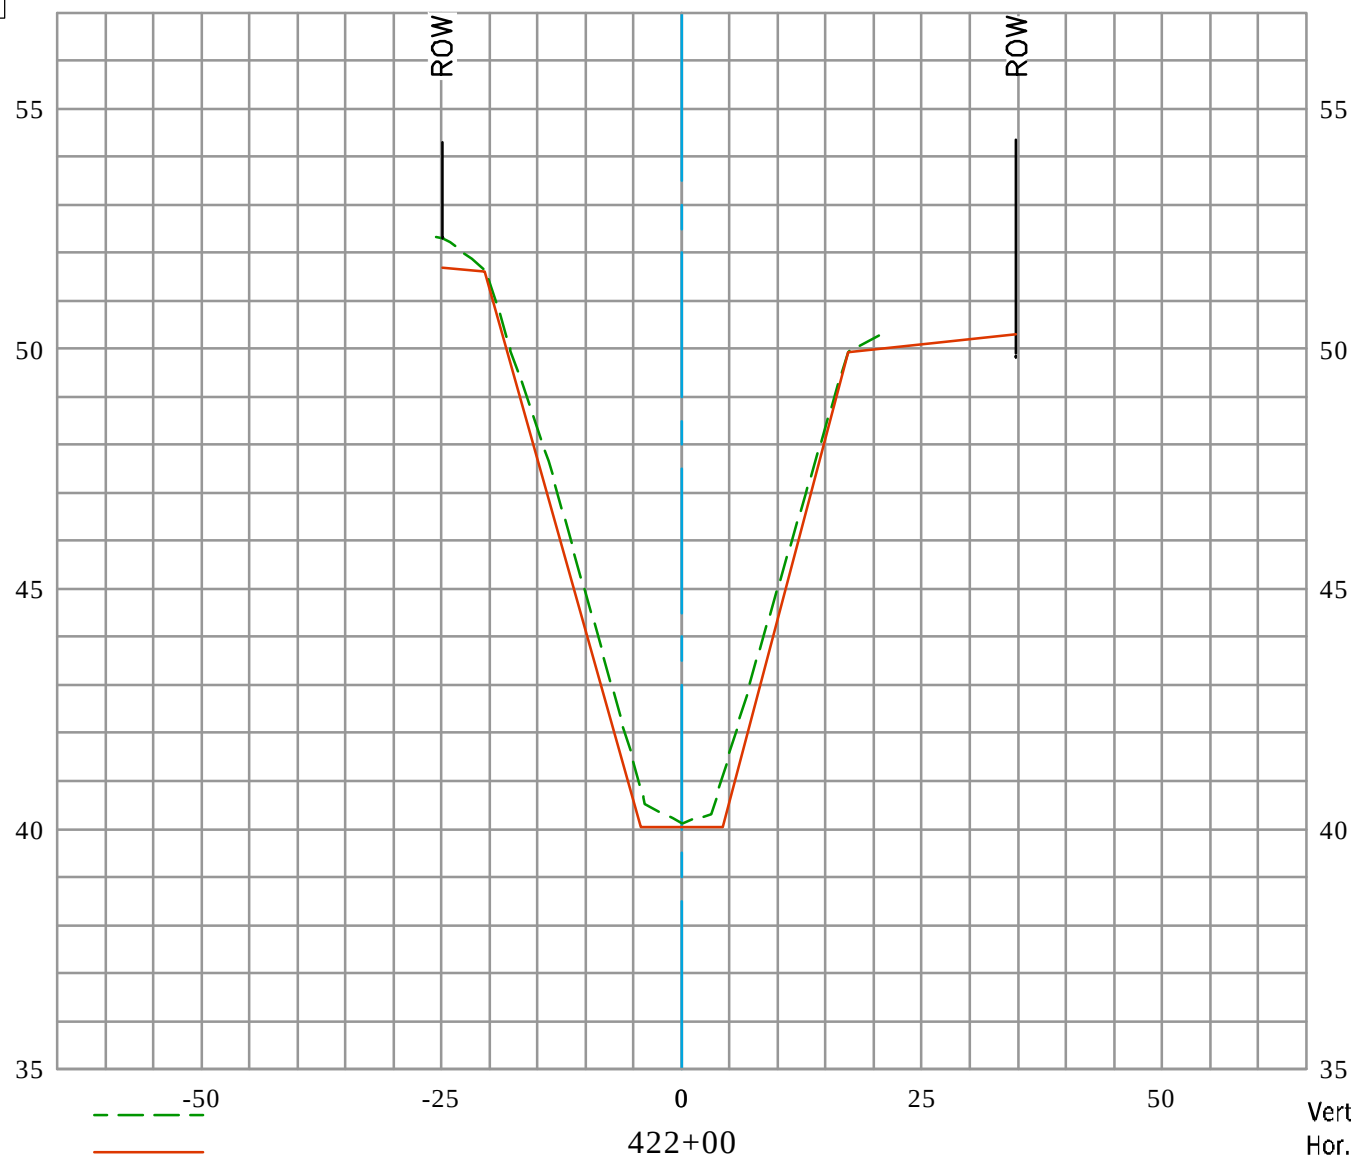

EXISTING CONDITION 2020
RECORD DRAWING:
D03-101-2A, D03-101-3A, & D03-101-7R
DATE PREPARED: 01/24/2022

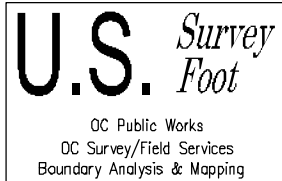

GREENVILLE BANNING CHANNEL (D03) CL

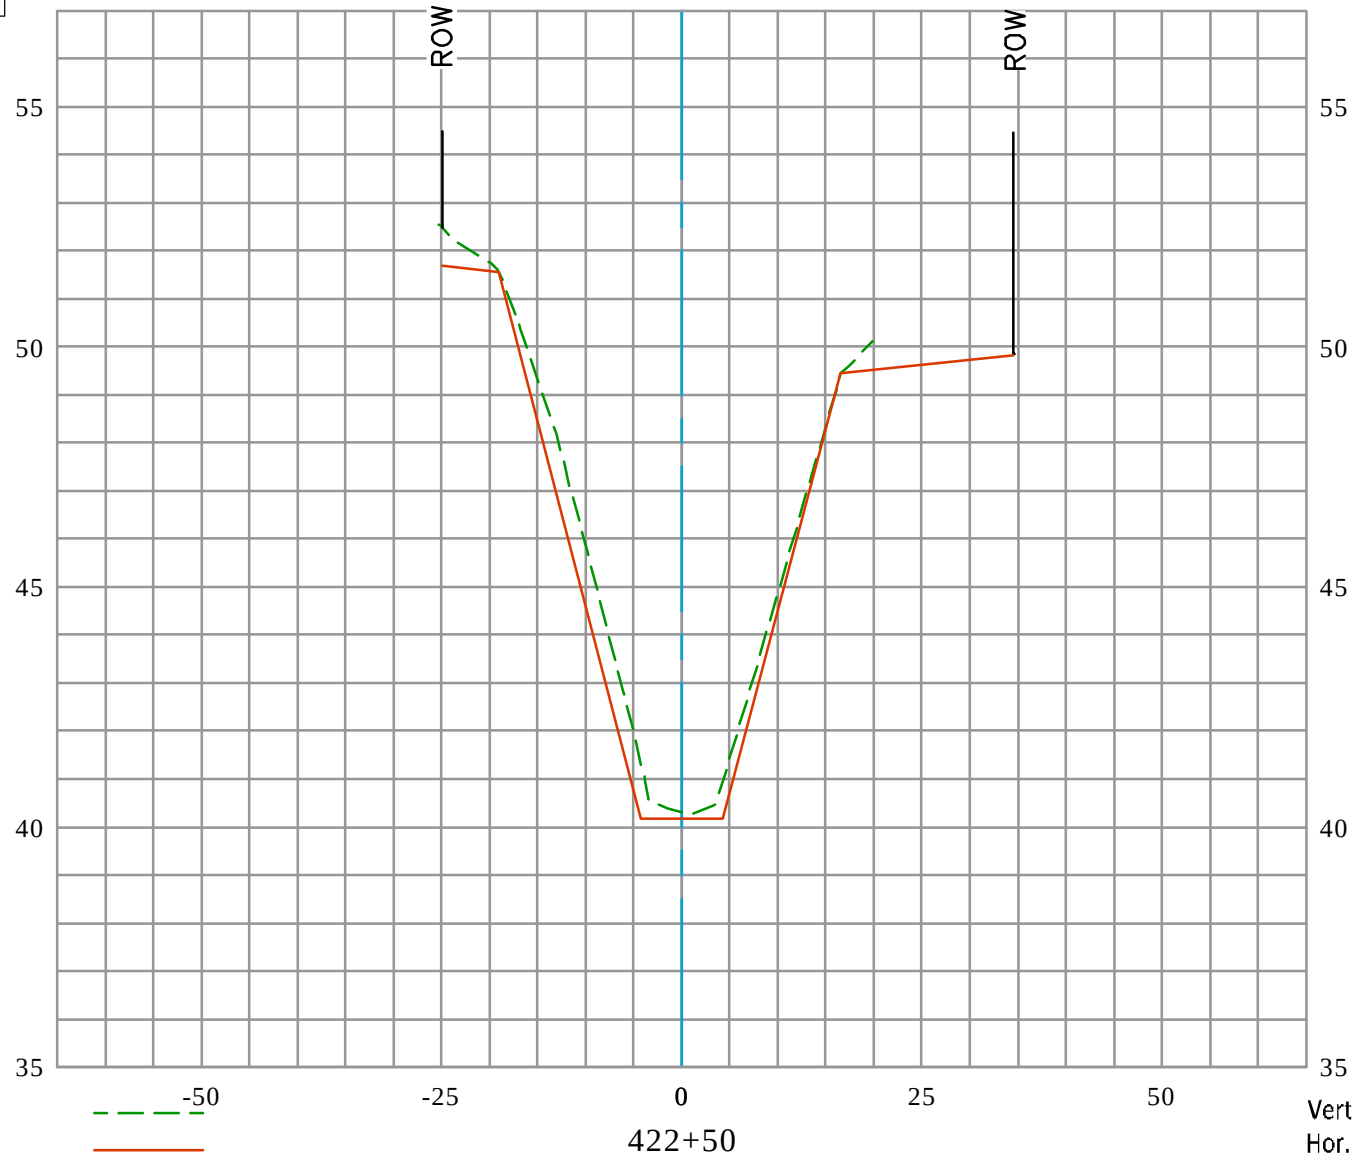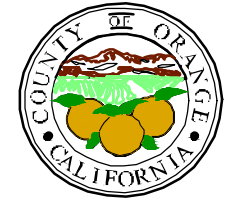


EXISTING CONDITION 2020
RECORD DRAWING:
D03-101-2A, D03-101-3A, & D03-101-7R
DATE PREPARED: 01/24/2022

Vert. Scale: 1" = 4'
Hor. Scale: 1" = 20'




GREENVILLE BANNING CHANNEL (D03) CL

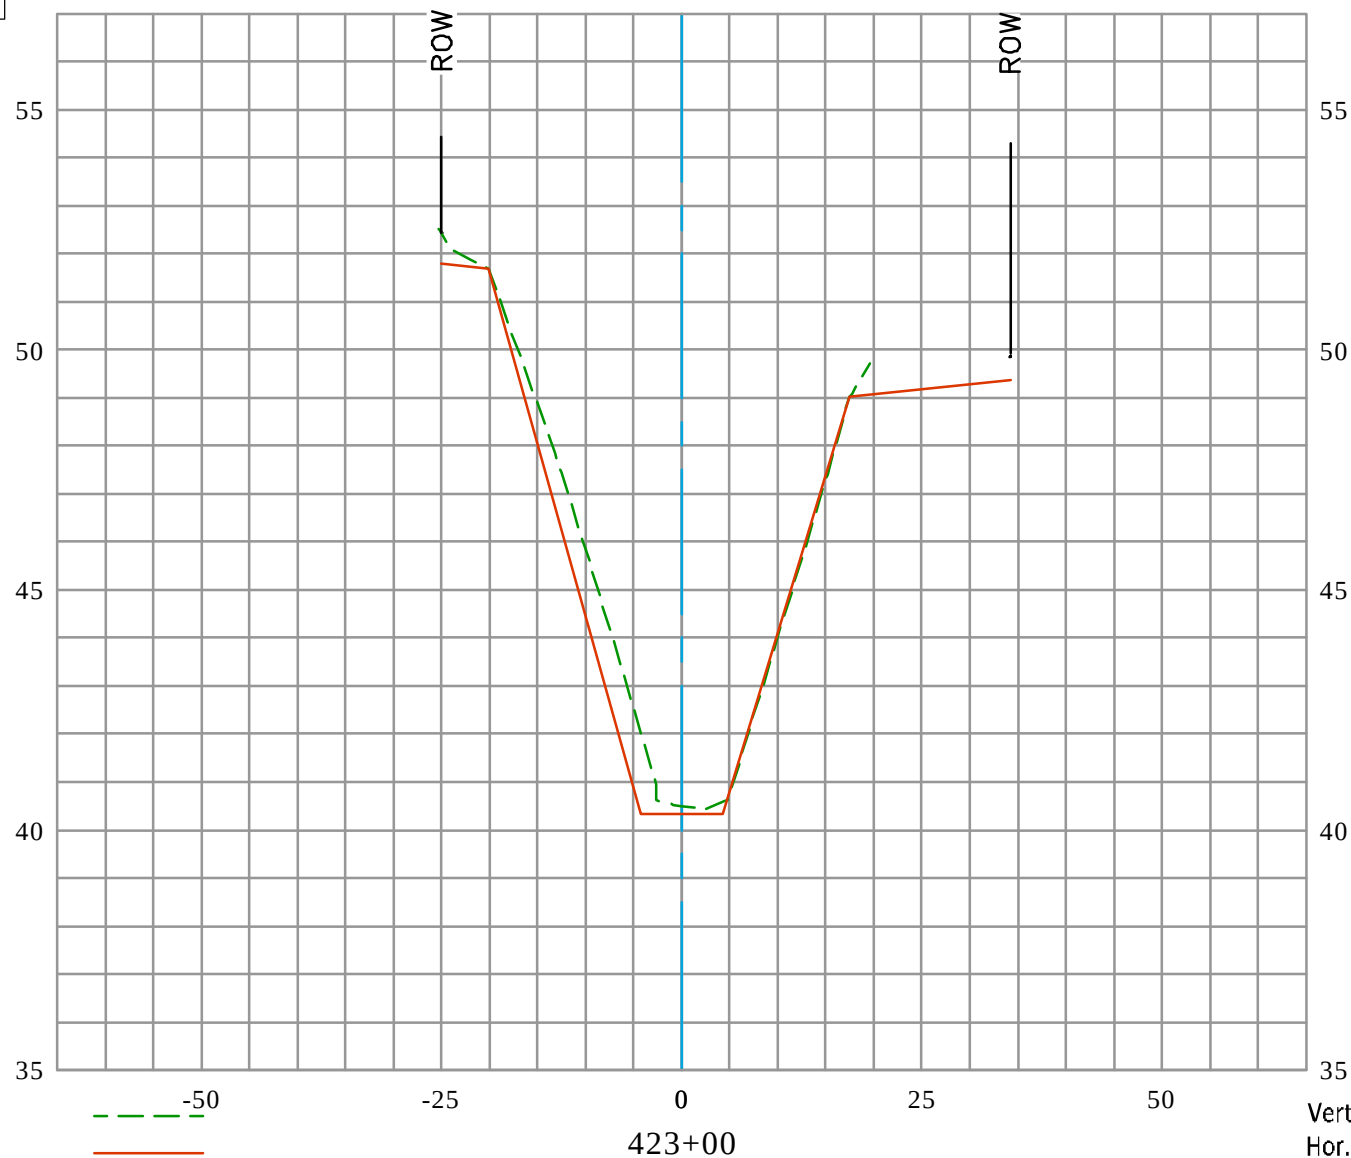

EXISTING CONDITION 2020
RECORD DRAWING:
D03-101-2A, D03-101-3A, & D03-101-7R
DATE PREPARED: 01/24/2022



GREENVILLE BANNING CHANNEL (D03) CL

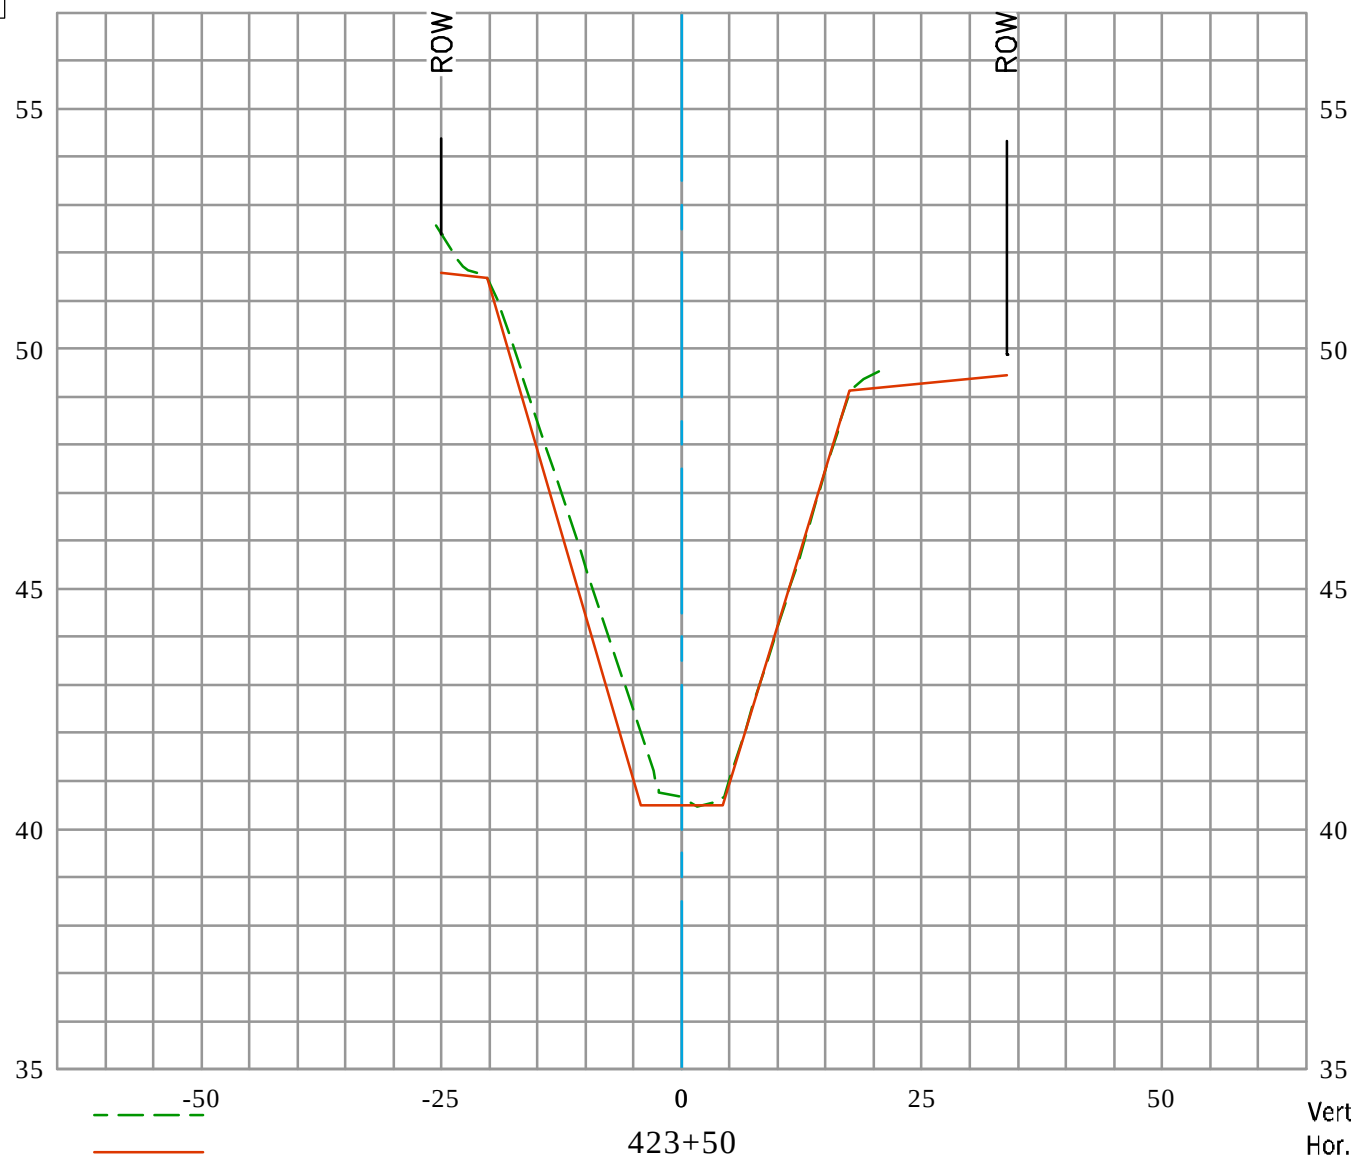


EXISTING CONDITION 2020
RECORD DRAWING:
D03-101-2A, D03-101-3A, & D03-101-7R
DATE PREPARED: 01/24/2022

Vert. Scale: 1" = 4'
Hor. Scale: 1" = 20'



GREENVILLE BANNING CHANNEL (D03) CL

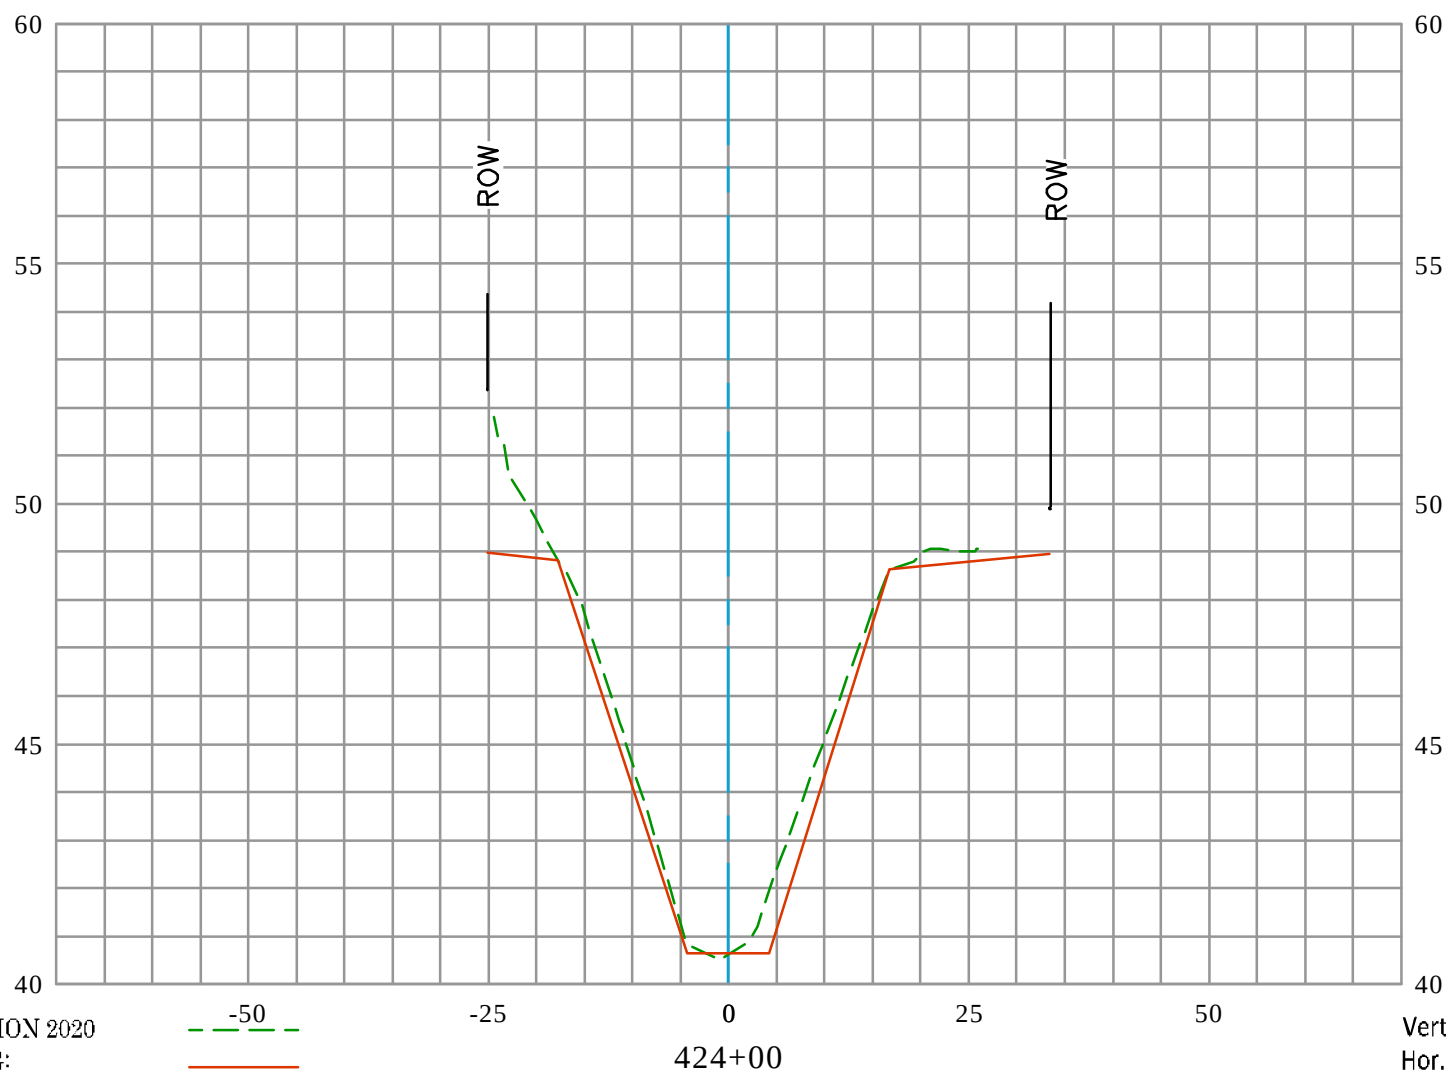


EXISTING CONDITION 2020
 RECORD DRAWING:
 D03-101-2A, D03-101-3A, & D03-101-7R
 DATE PREPARED: 01/24/2022

Vert. Scale: 1" = 4'
 Hor. Scale: 1" = 20'



GREENVILLE BANNING CHANNEL (D03) CL

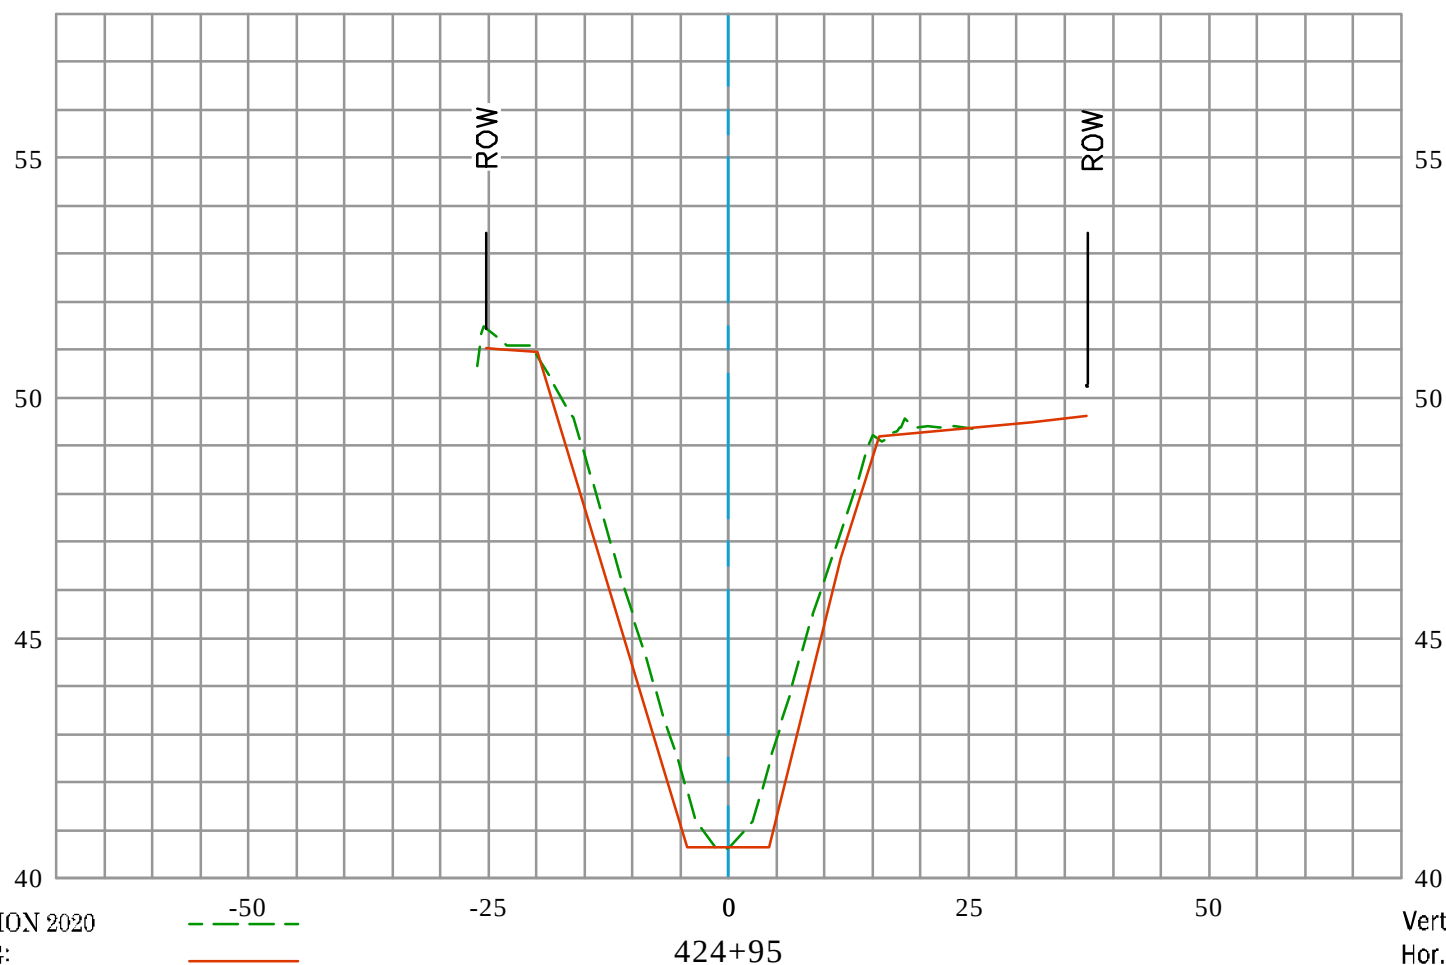


EXISTING CONDITION 2020
 RECORD DRAWING:
 D03-101-2A, D03-101-3A, & D03-101-7R
 DATE PREPARED: 01/24/2022

Vert. Scale: 1" = 4'
 Hor. Scale: 1" = 20'



GREENVILLE BANNING CHANNEL (D03) CL

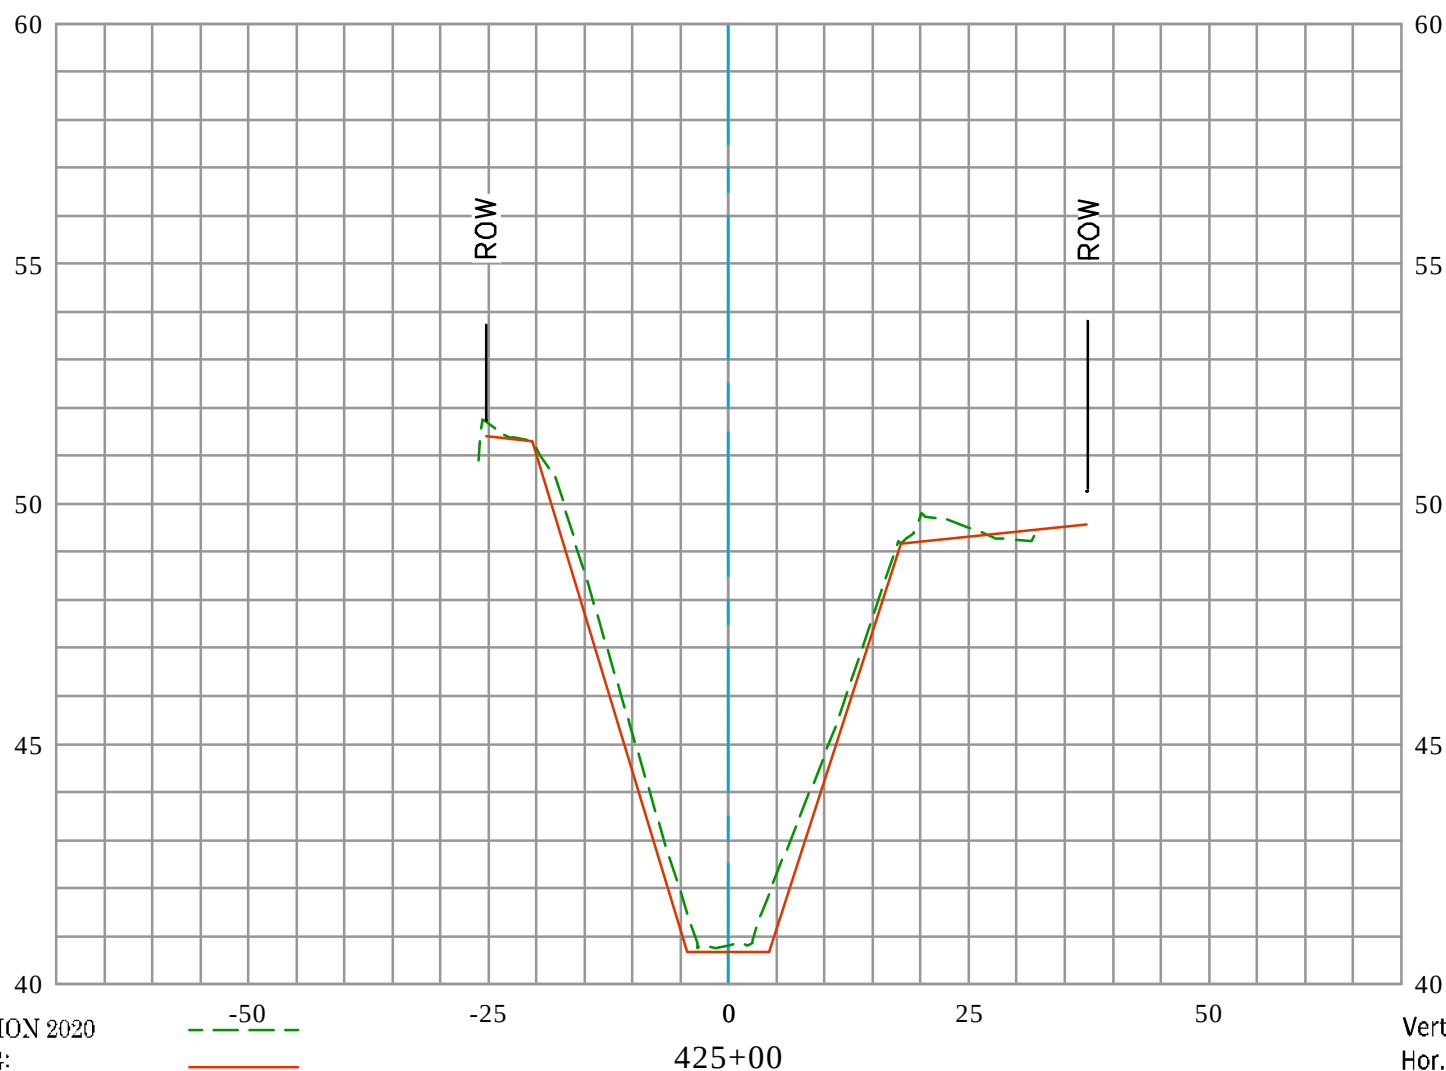


EXISTING CONDITION 2020
 RECORD DRAWING:
 D03-101-2A, D03-101-3A, & D03-101-7R
 DATE PREPARED: 01/24/2022

Vert. Scale: 1" = 4'
 Hor. Scale: 1" = 20'




GREENVILLE BANNING CHANNEL (D03) CL

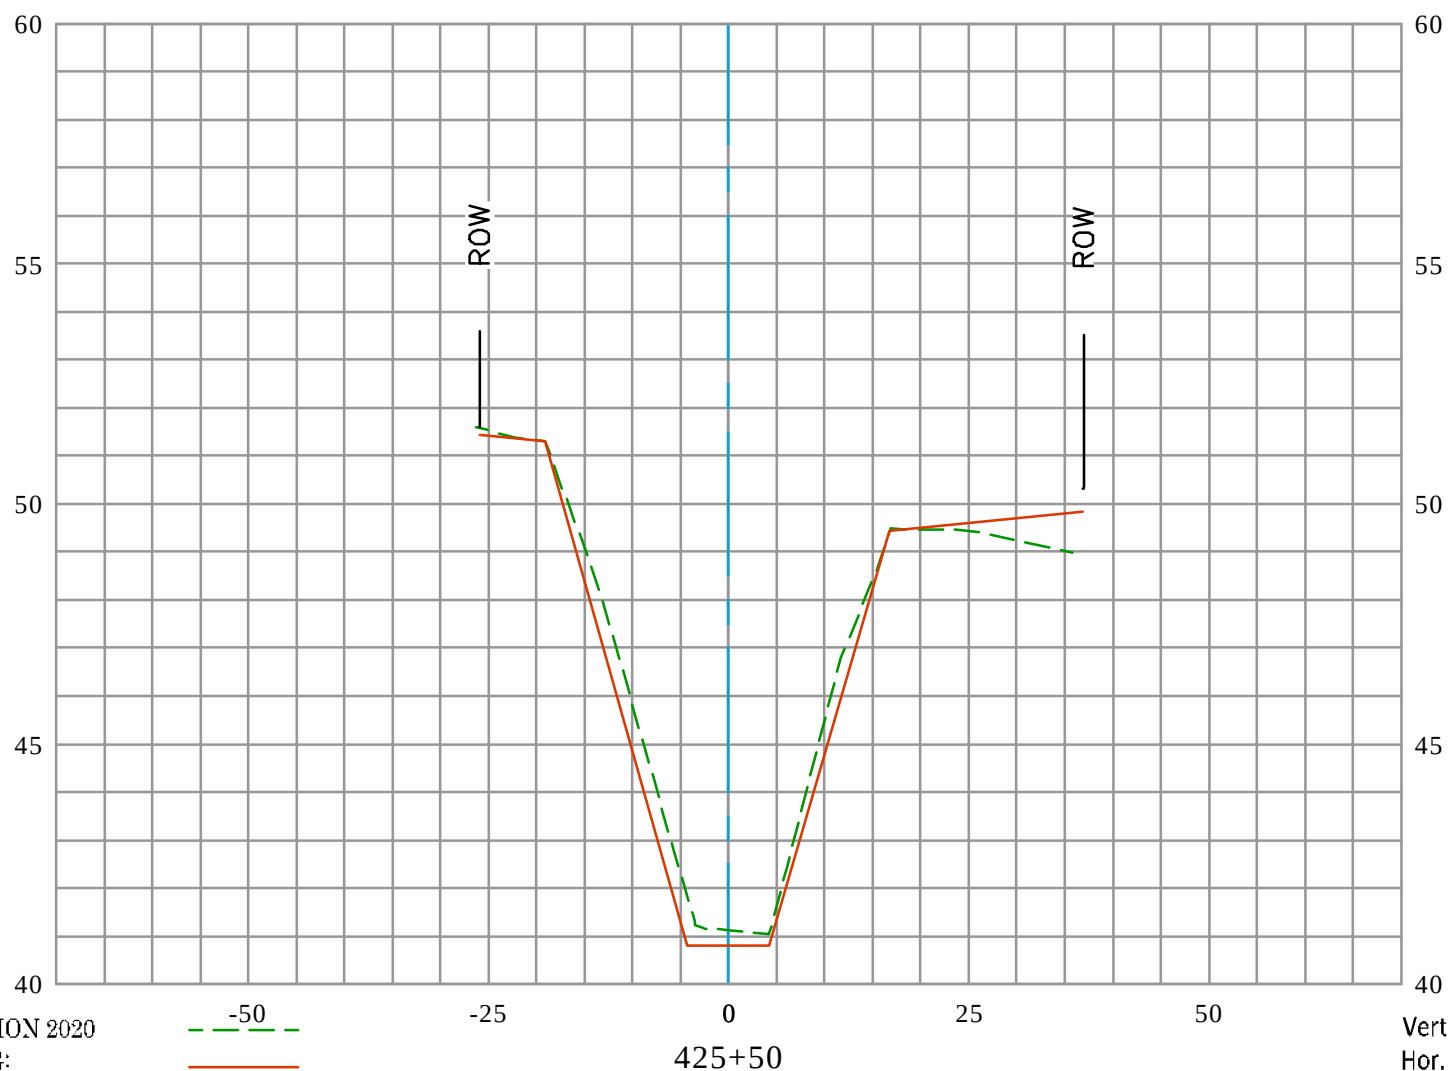

EXISTING CONDITION 2020
RECORD DRAWING:
D03-101-2A, D03-101-3A, & D03-101-7R
DATE PREPARED: 01/24/2022



GREENVILLE BANNING CHANNEL (D03) CL

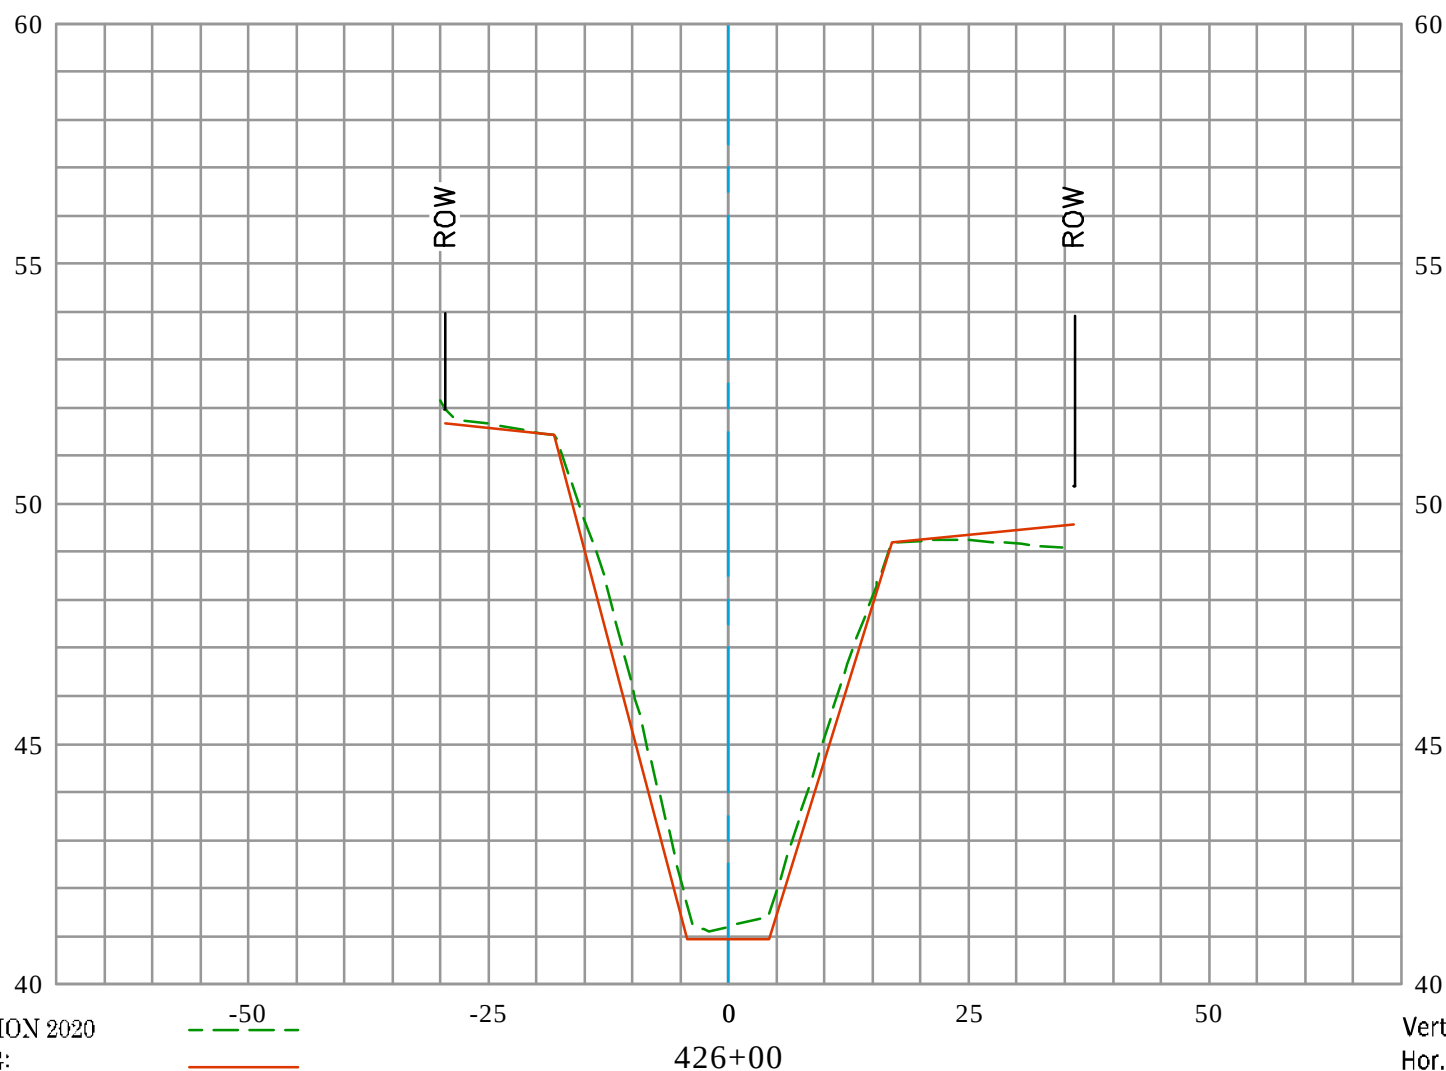


U.S. Survey Foot

OC Public Works
OC Survey/Field Services
Boundary Analysis & Mapping




GREENVILLE BANNING CHANNEL (D03) CL

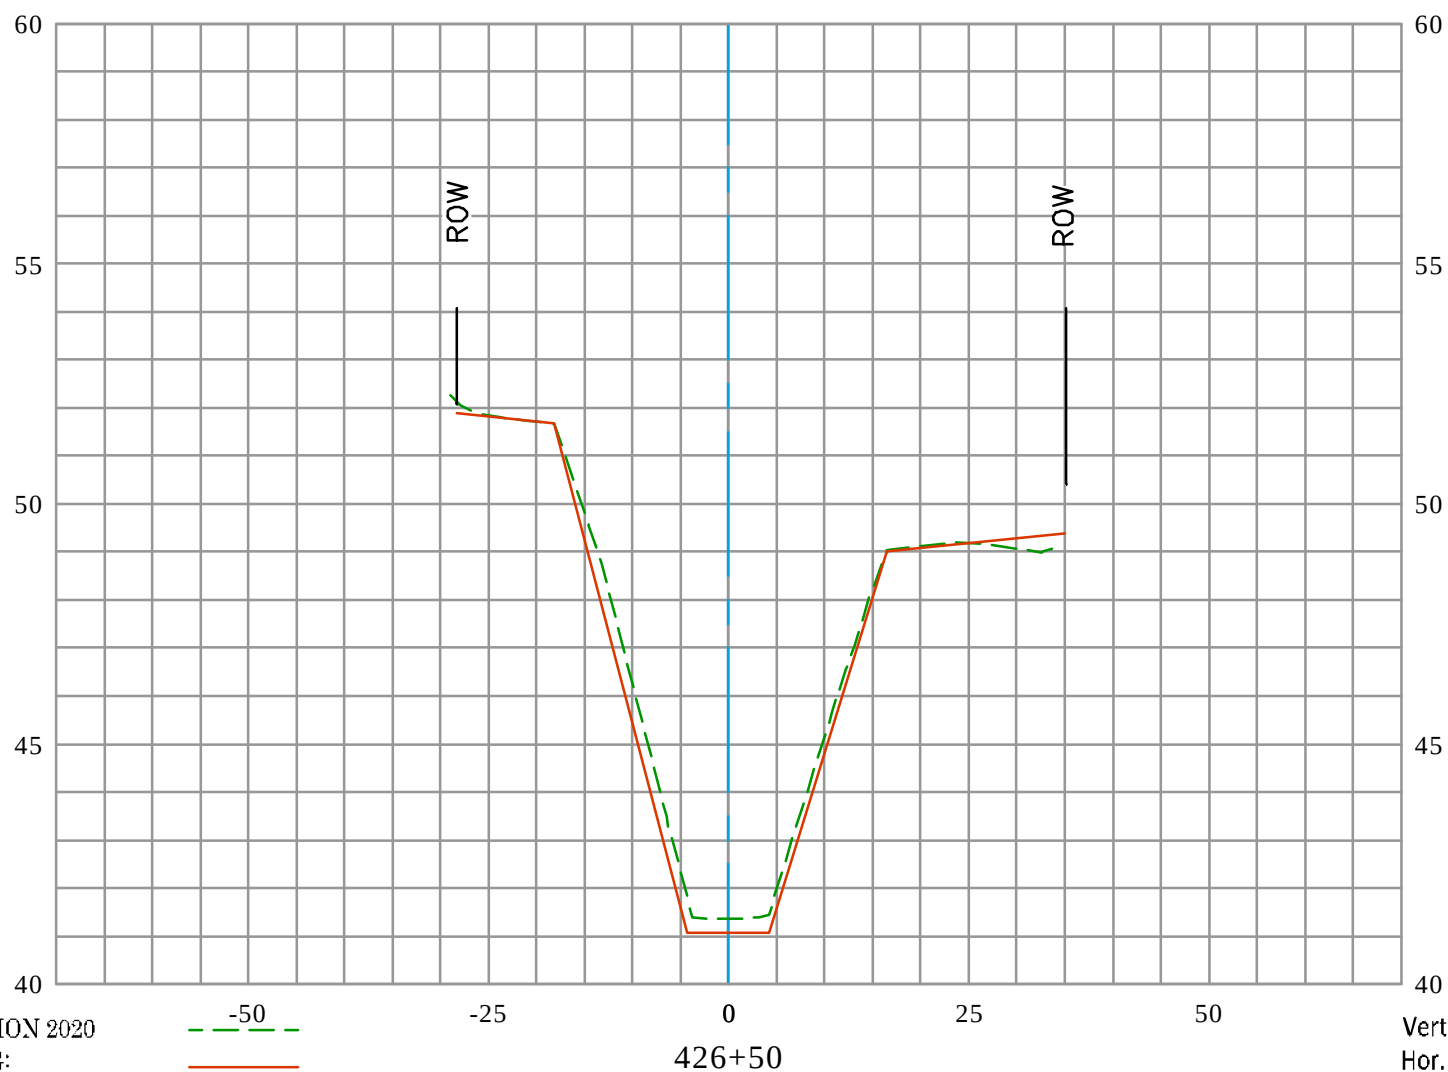



GREENVILLE BANNING CHANNEL (D03) CL

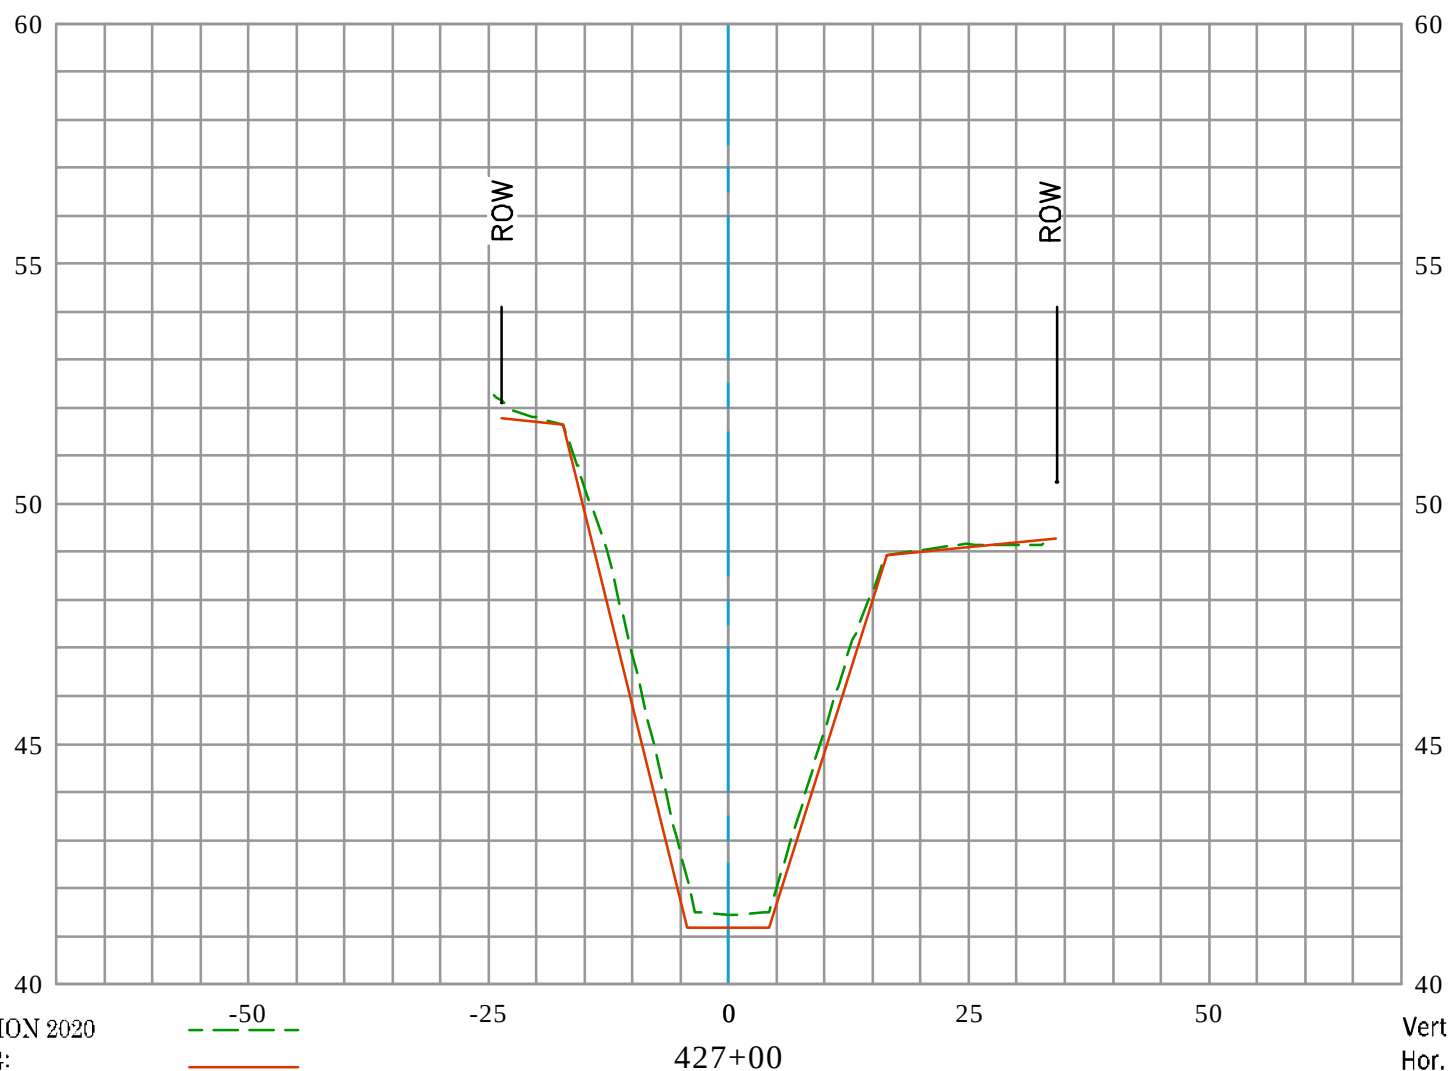


EXISTING CONDITION 2020
 RECORD DRAWING:
 D03-101-2A, D03-101-3A, & D03-101-7R
 DATE PREPARED: 01/24/2022

Vert. Scale: 1" = 4'
 Hor. Scale: 1" = 20'




GREENVILLE BANNING CHANNEL (D03) CL

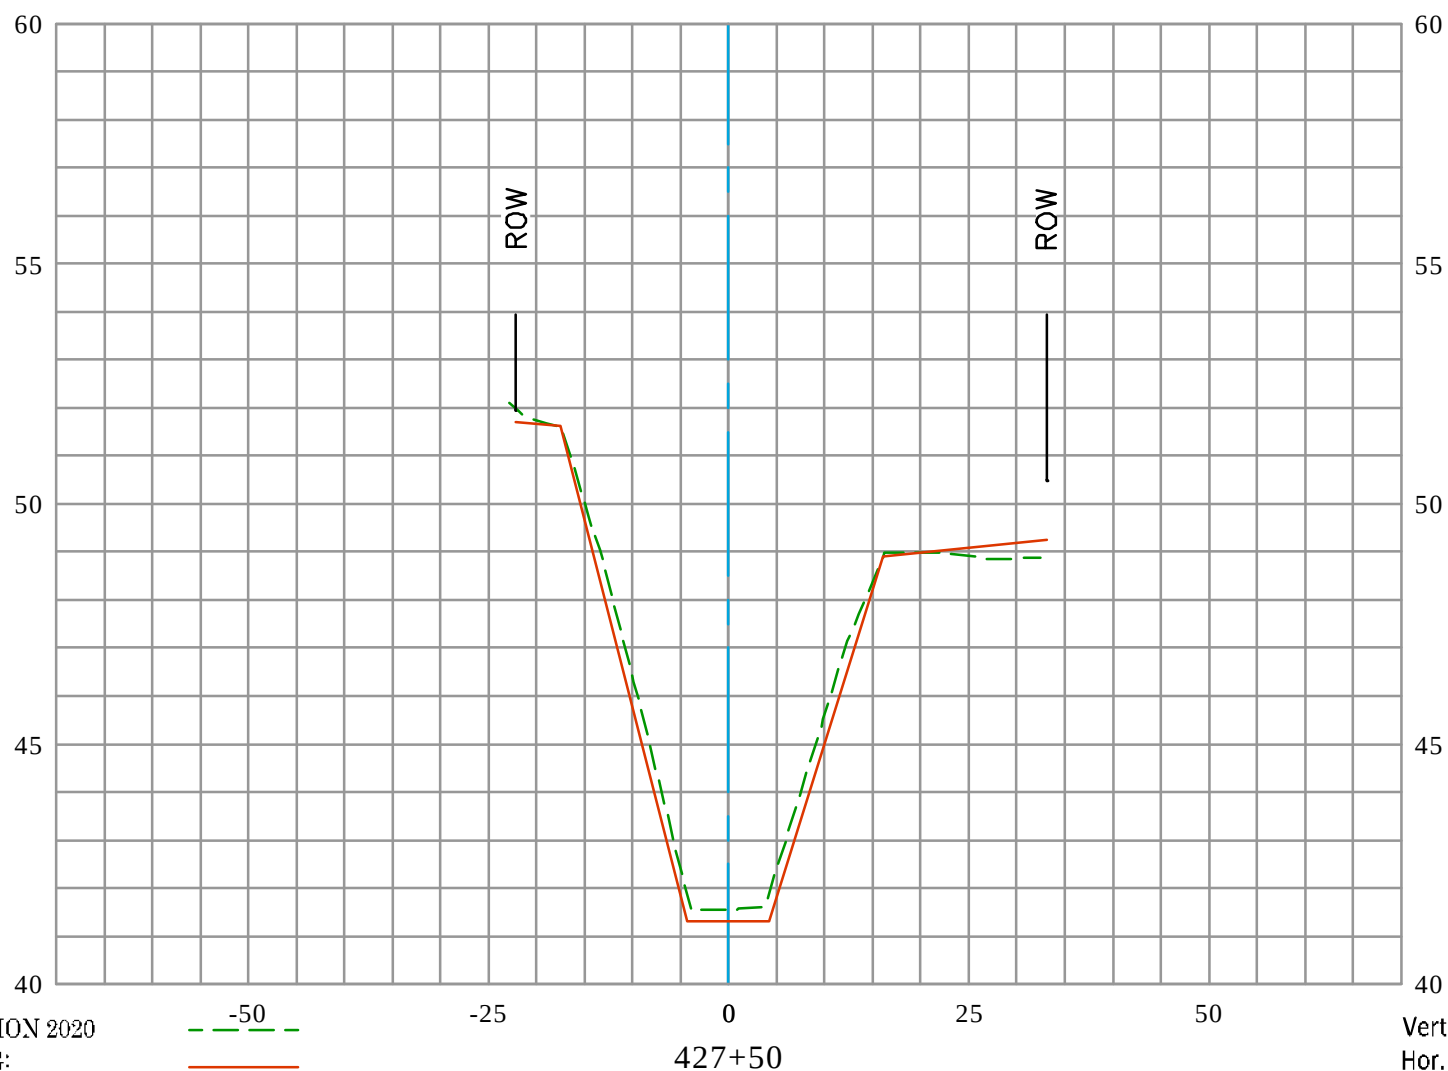

EXISTING CONDITION 2020
RECORD DRAWING:
D03-101-2A, D03-101-3A, & D03-101-7R
DATE PREPARED: 01/24/2022



GREENVILLE BANNING CHANNEL (D03) CL

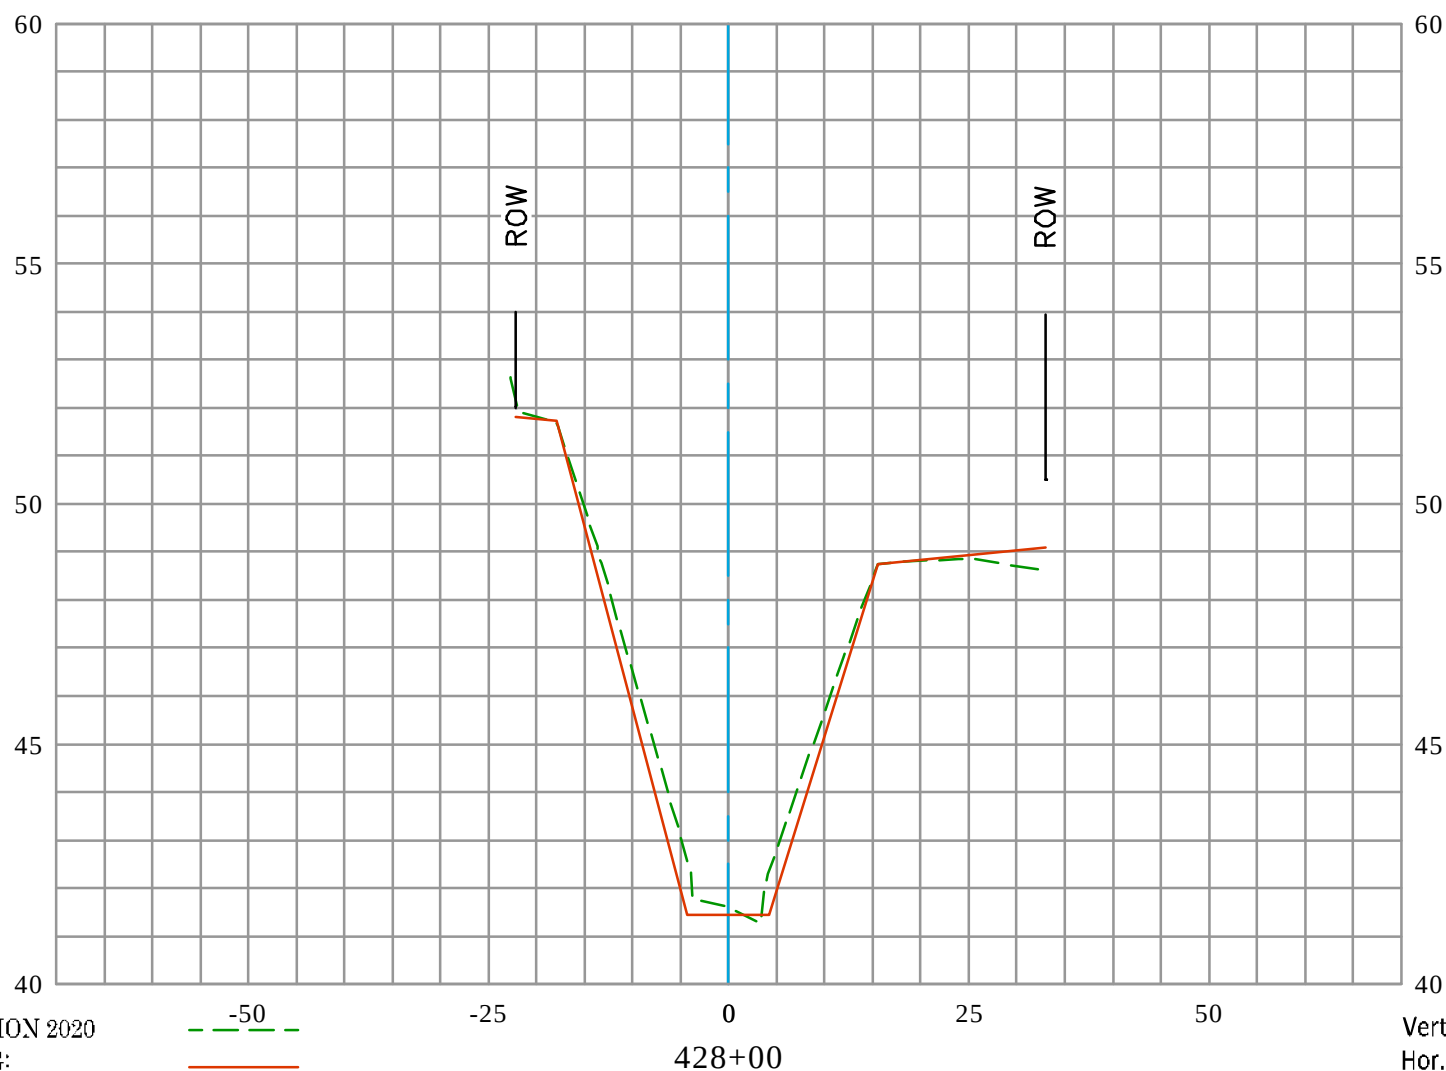


EXISTING CONDITION 2020
 RECORD DRAWING:
 D03-101-2A, D03-101-3A, & D03-101-7R
 DATE PREPARED: 01/24/2022

Vert. Scale: 1" = 4'
 Hor. Scale: 1" = 20'



GREENVILLE BANNING CHANNEL (D03) CL

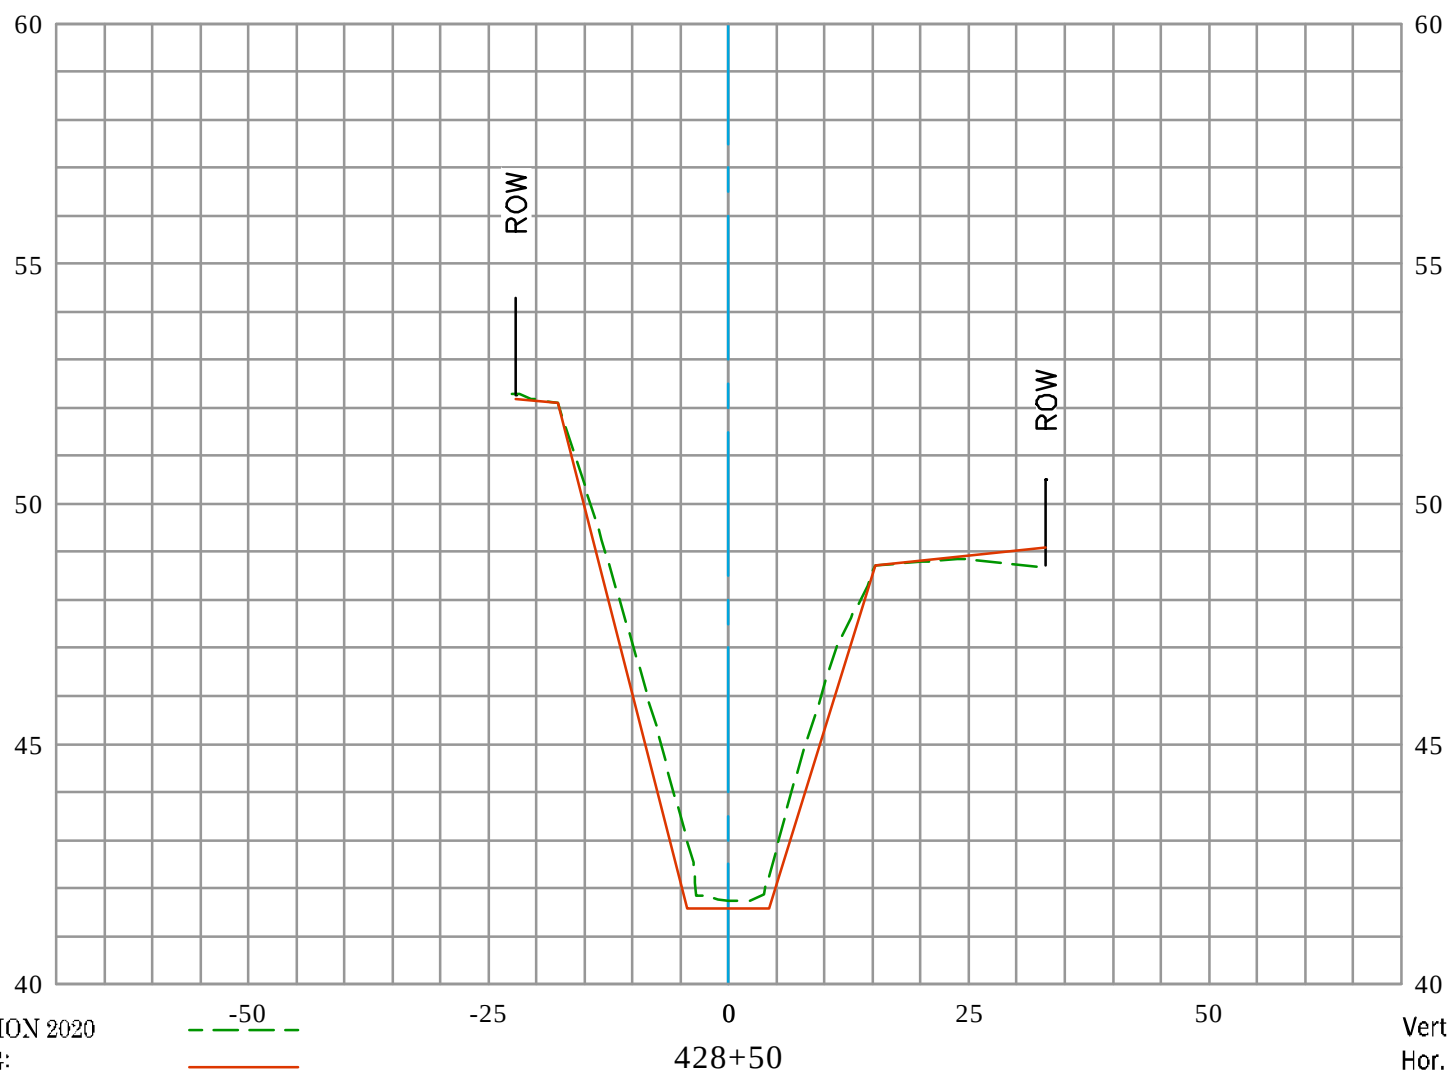


EXISTING CONDITION 2020
RECORD DRAWING:
D03-101-2A, D03-101-3A, & D03-101-7R
DATE PREPARED: 01/24/2022

Vert. Scale: 1" = 4'
Hor. Scale: 1" = 20'




GREENVILLE BANNING CHANNEL (D03) CL

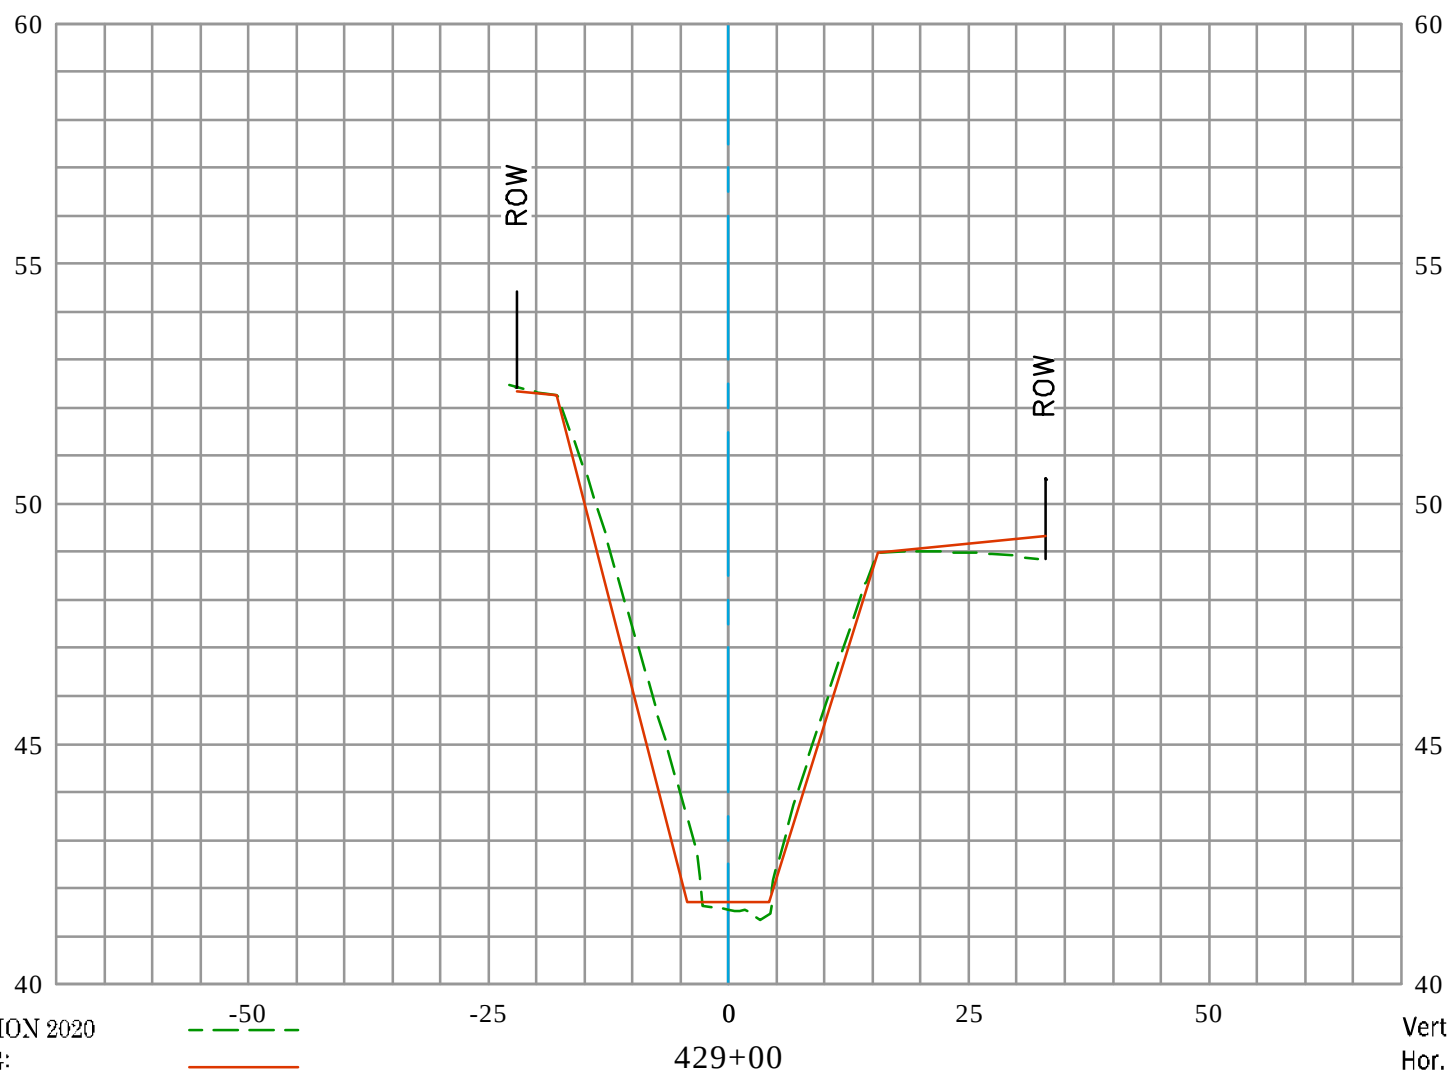

EXISTING CONDITION 2020
RECORD DRAWING:
D03-101-2A, D03-101-3A, & D03-101-7R
DATE PREPARED: 01/24/2022




GREENVILLE BANNING CHANNEL (D03) CL

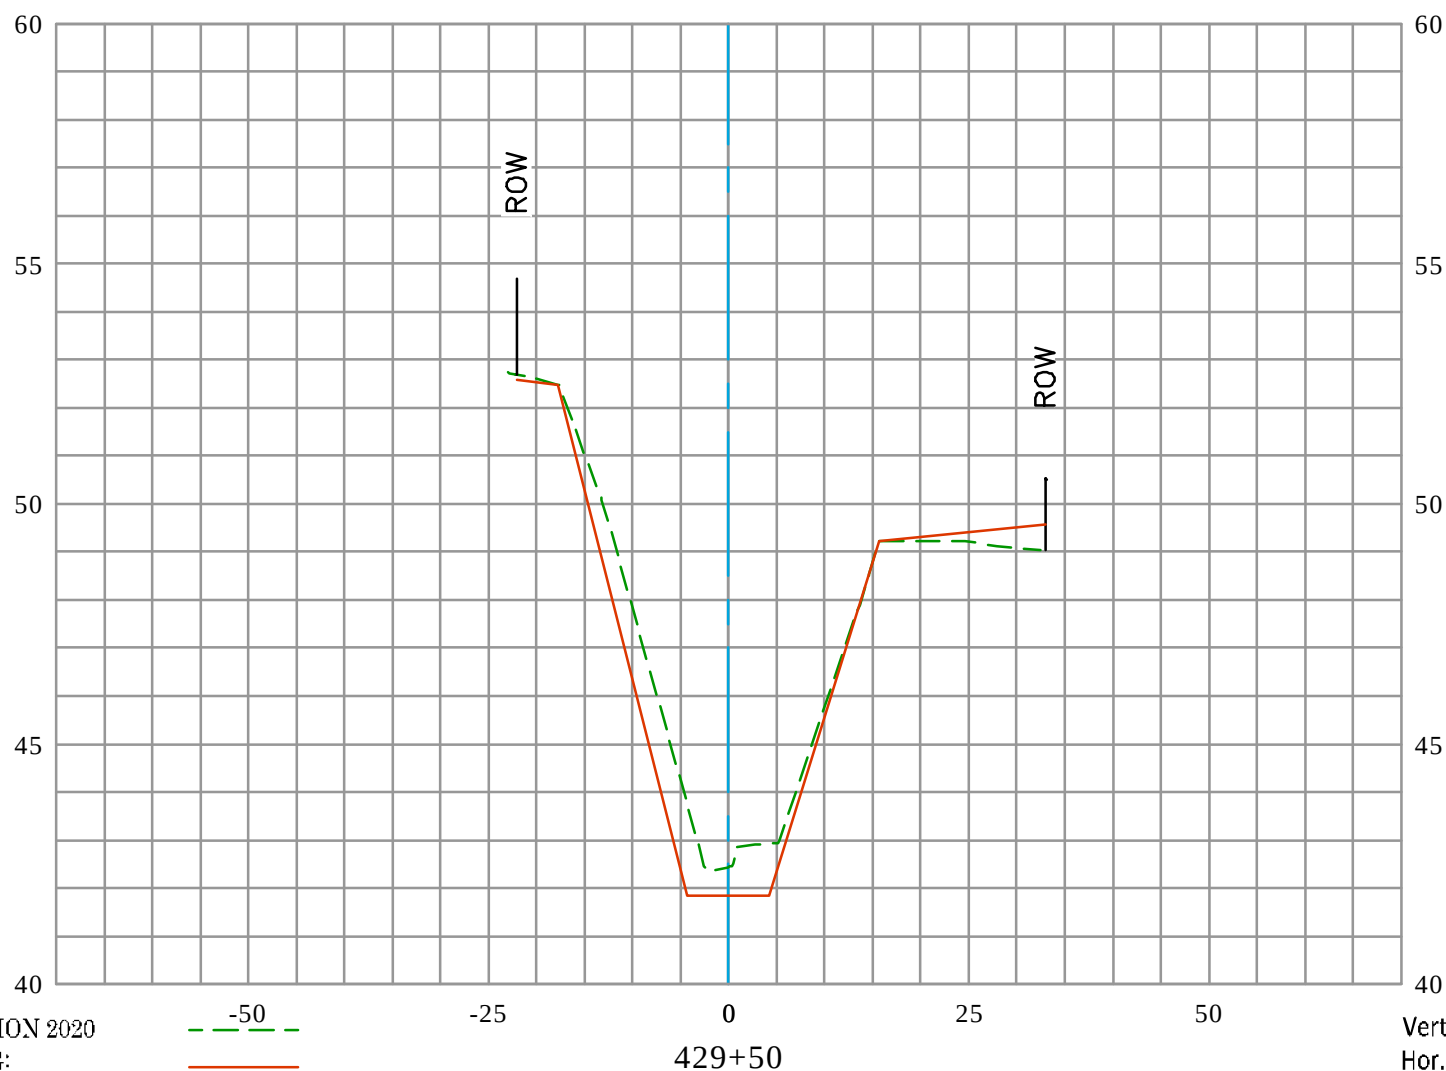

EXISTING CONDITION 2020
 RECORD DRAWING:
 D03-101-2A, D03-101-3A, & D03-101-7R
 DATE PREPARED: 01/24/2022



GREENVILLE BANNING CHANNEL (D03) CL

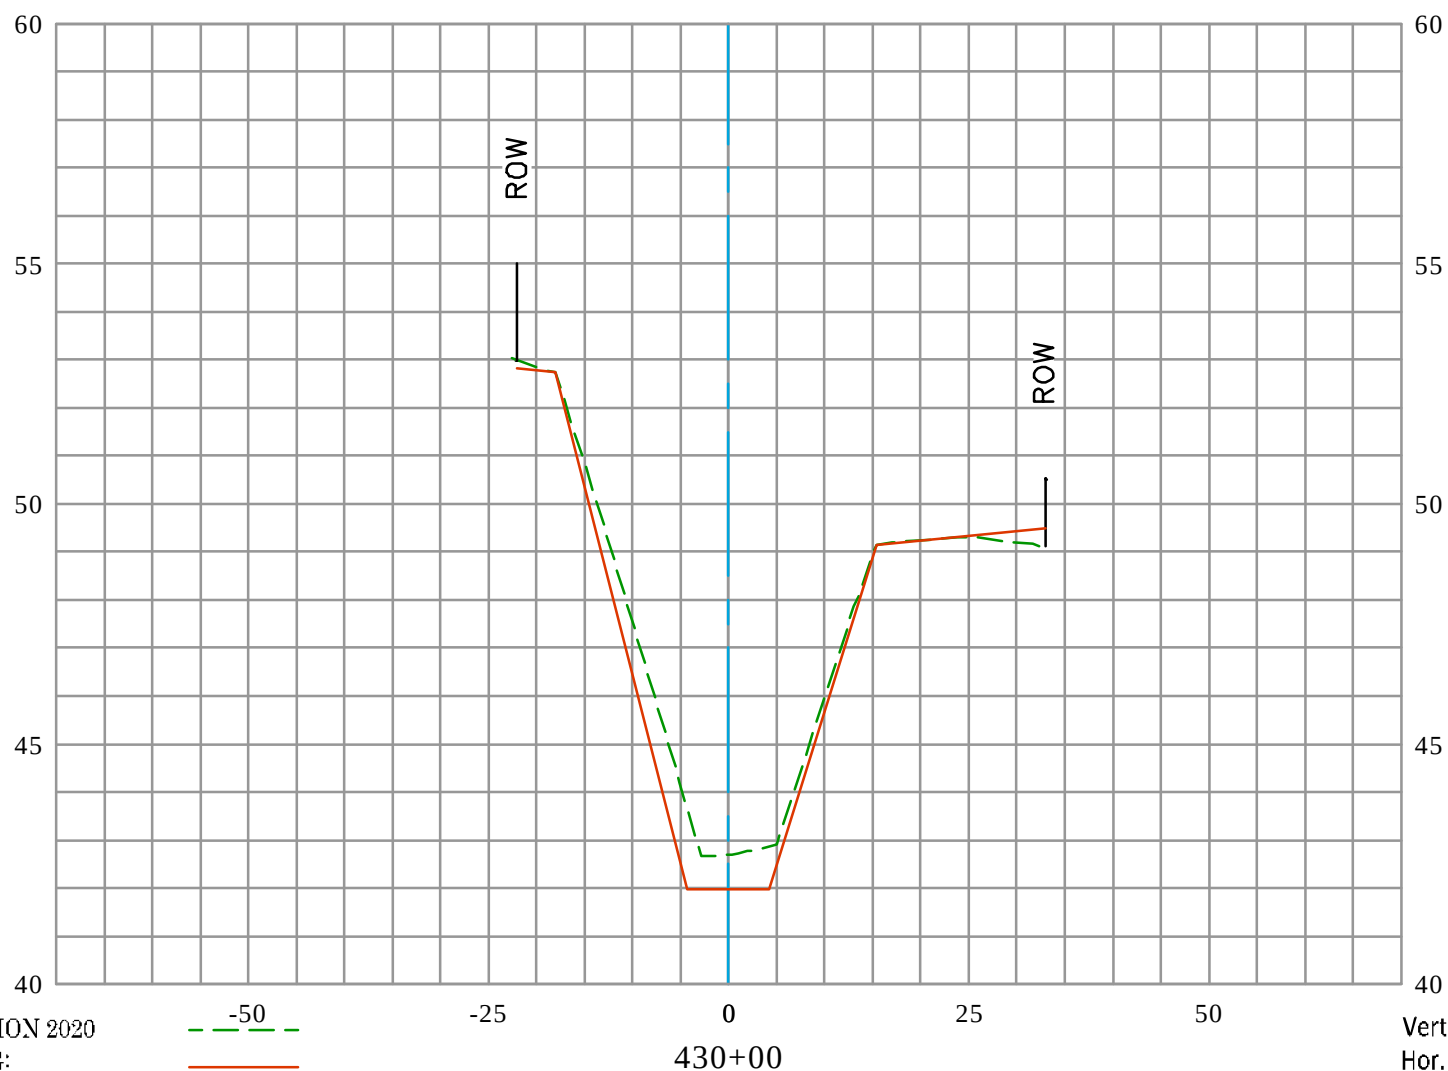


EXISTING CONDITION 2020
RECORD DRAWING:
D03-101-2A, D03-101-3A, & D03-101-7R
DATE PREPARED: 01/24/2022

Vert. Scale: 1" = 4'
Hor. Scale: 1" = 20'




GREENVILLE BANNING CHANNEL (D03) CL

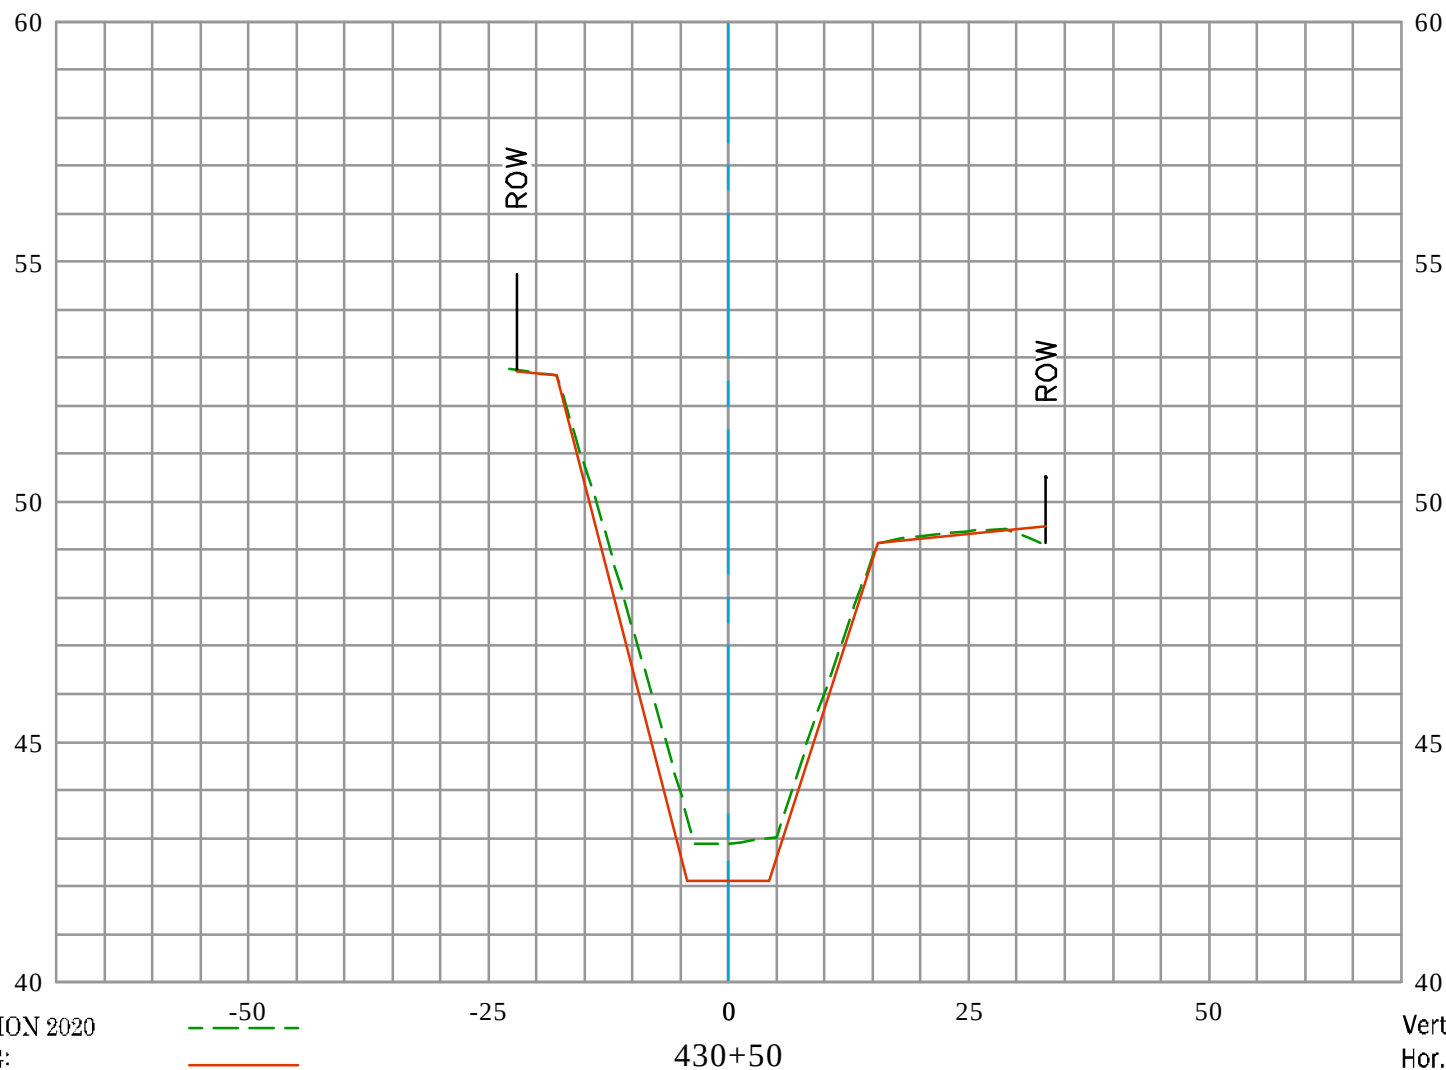



GREENVILLE BANNING CHANNEL (D03) CL

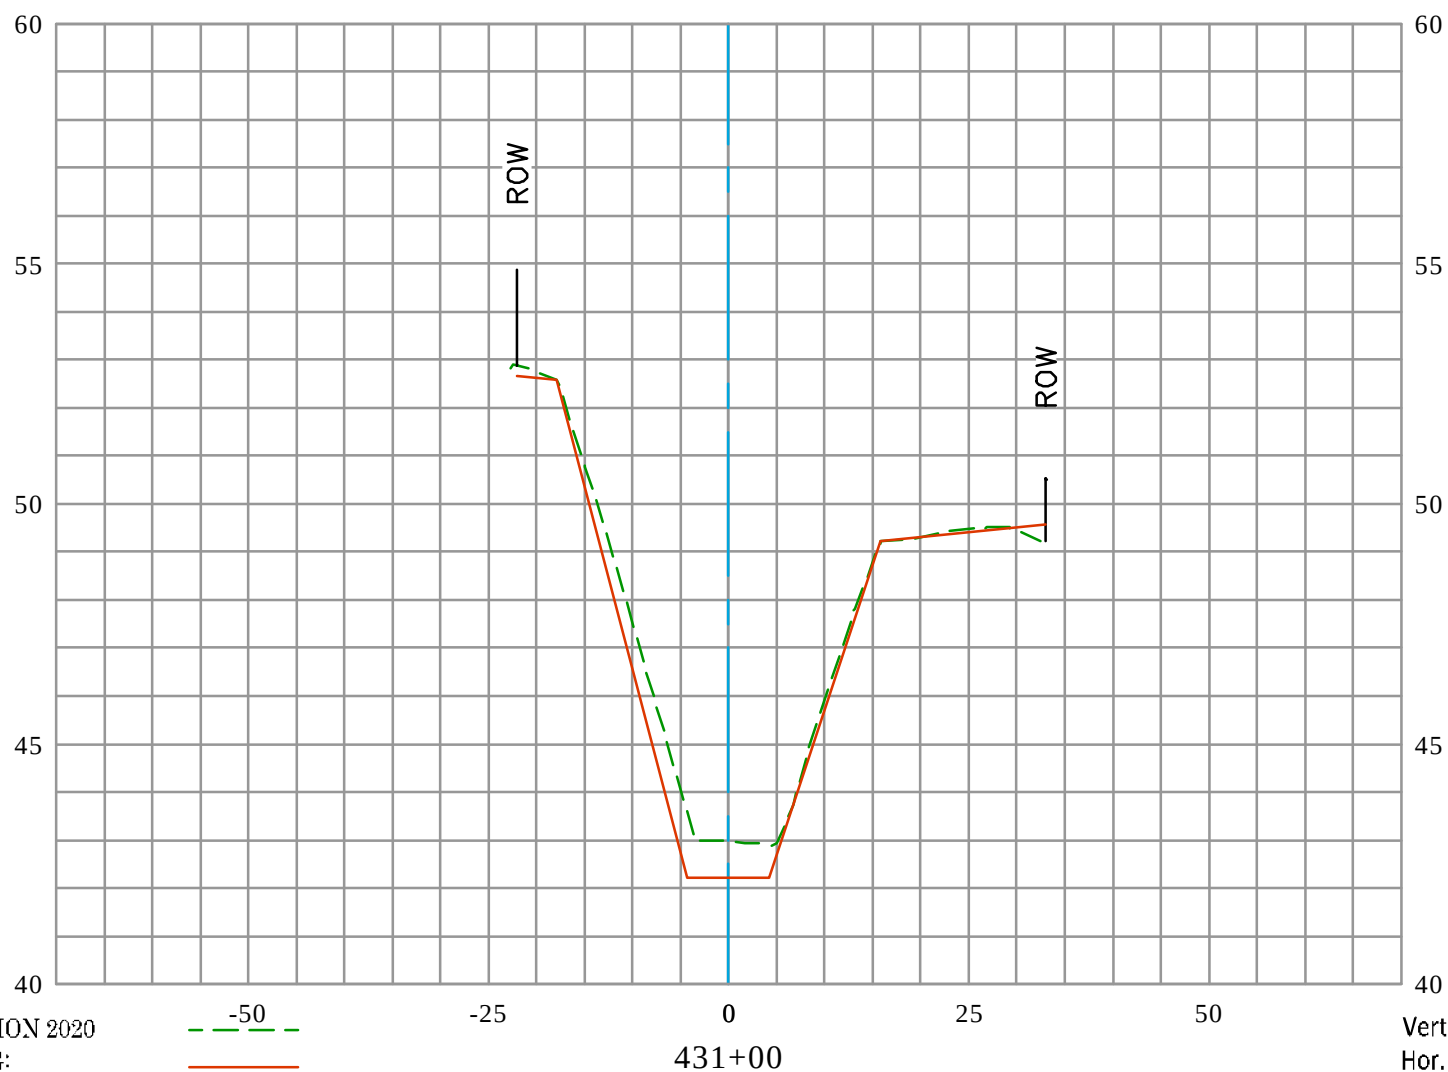


EXISTING CONDITION 2020
RECORD DRAWING:
D03-101-2A, D03-101-3A, & D03-101-7R
DATE PREPARED: 01/24/2022

Vert. Scale: 1" = 4'
Hor. Scale: 1" = 20'




GREENVILLE BANNING CHANNEL (D03) CL

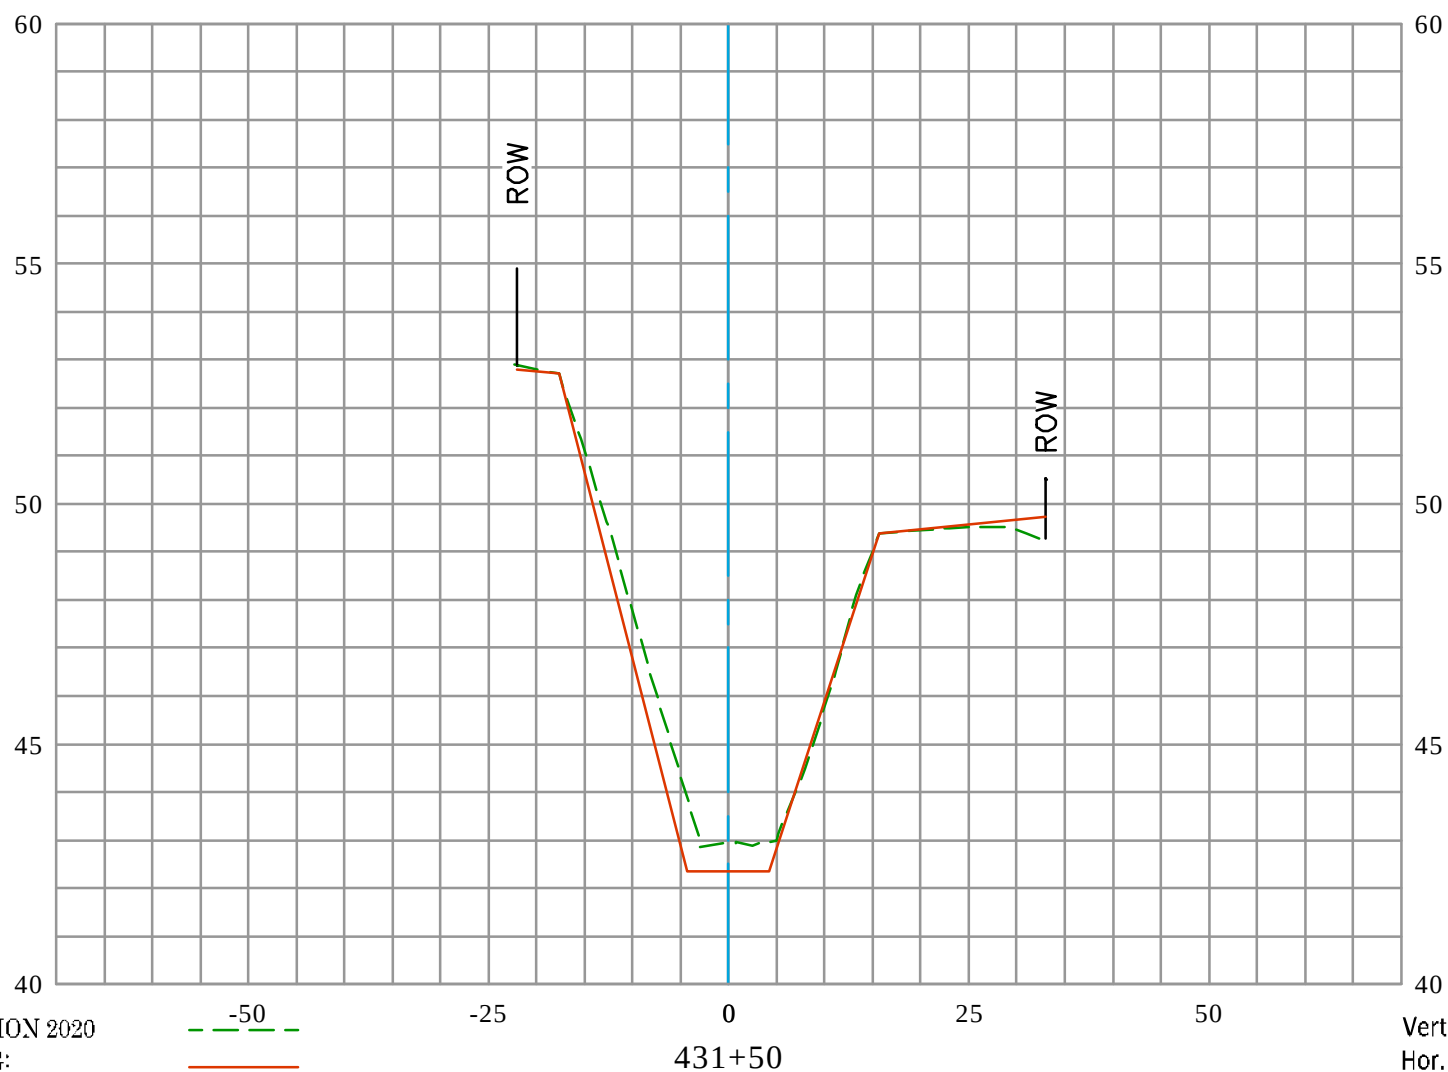




GREENVILLE BANNING CHANNEL (D03) CL

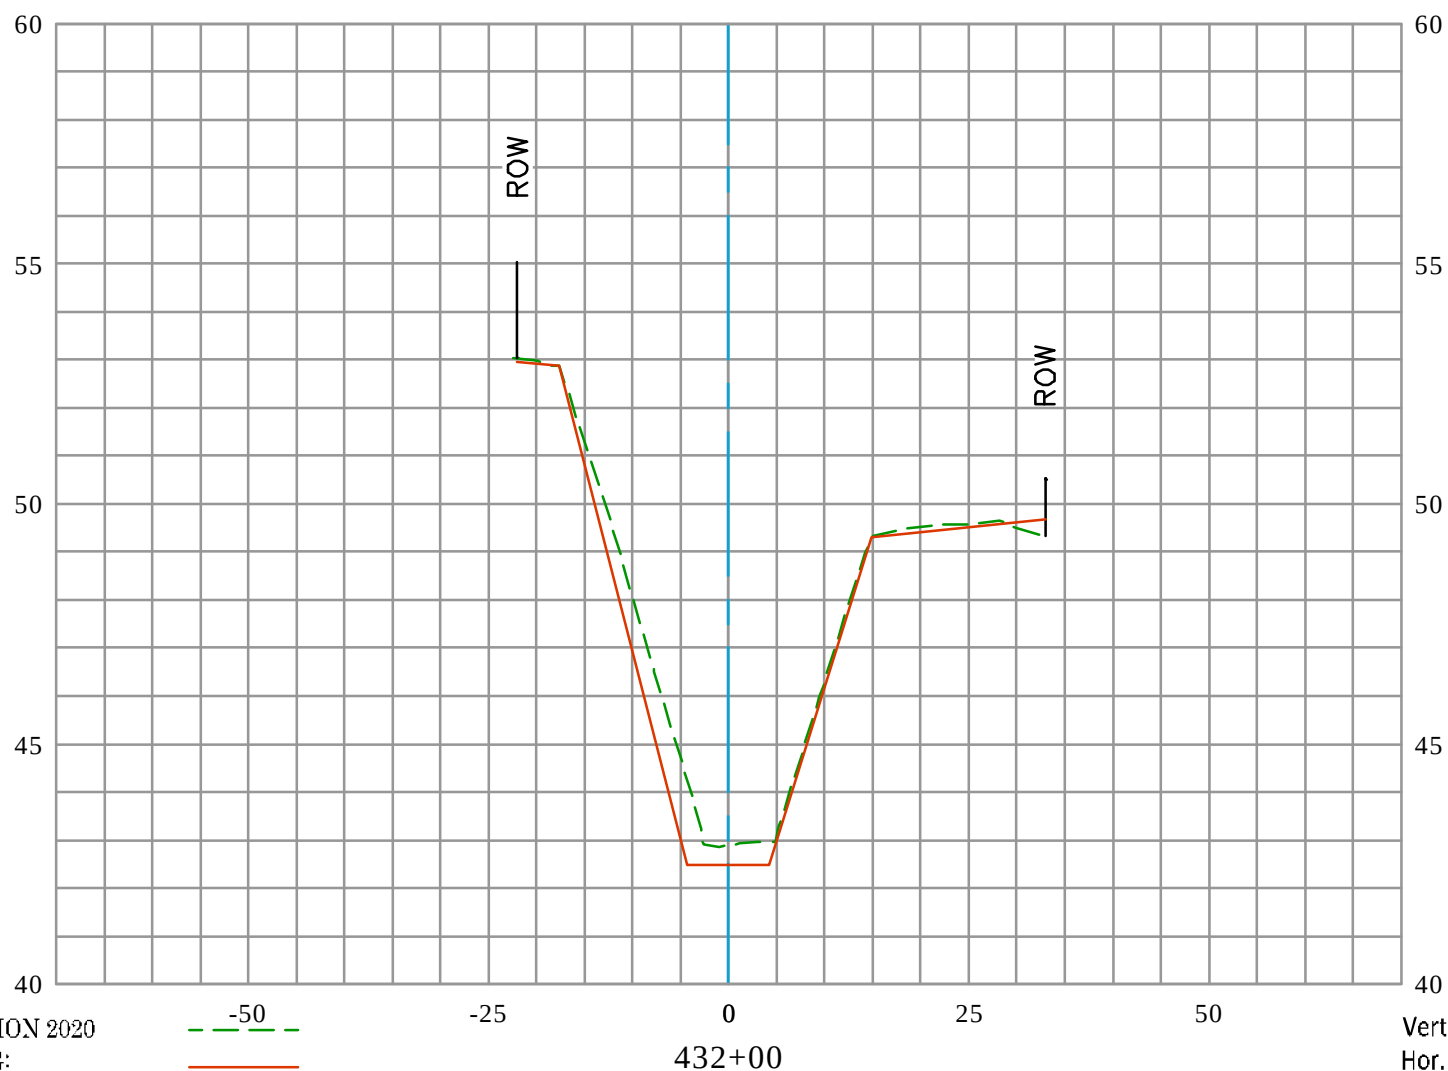

EXISTING CONDITION 2020
RECORD DRAWING:
D03-101-2A, D03-101-3A, & D03-101-7R
DATE PREPARED: 01/24/2022




GREENVILLE BANNING CHANNEL (D03) CL

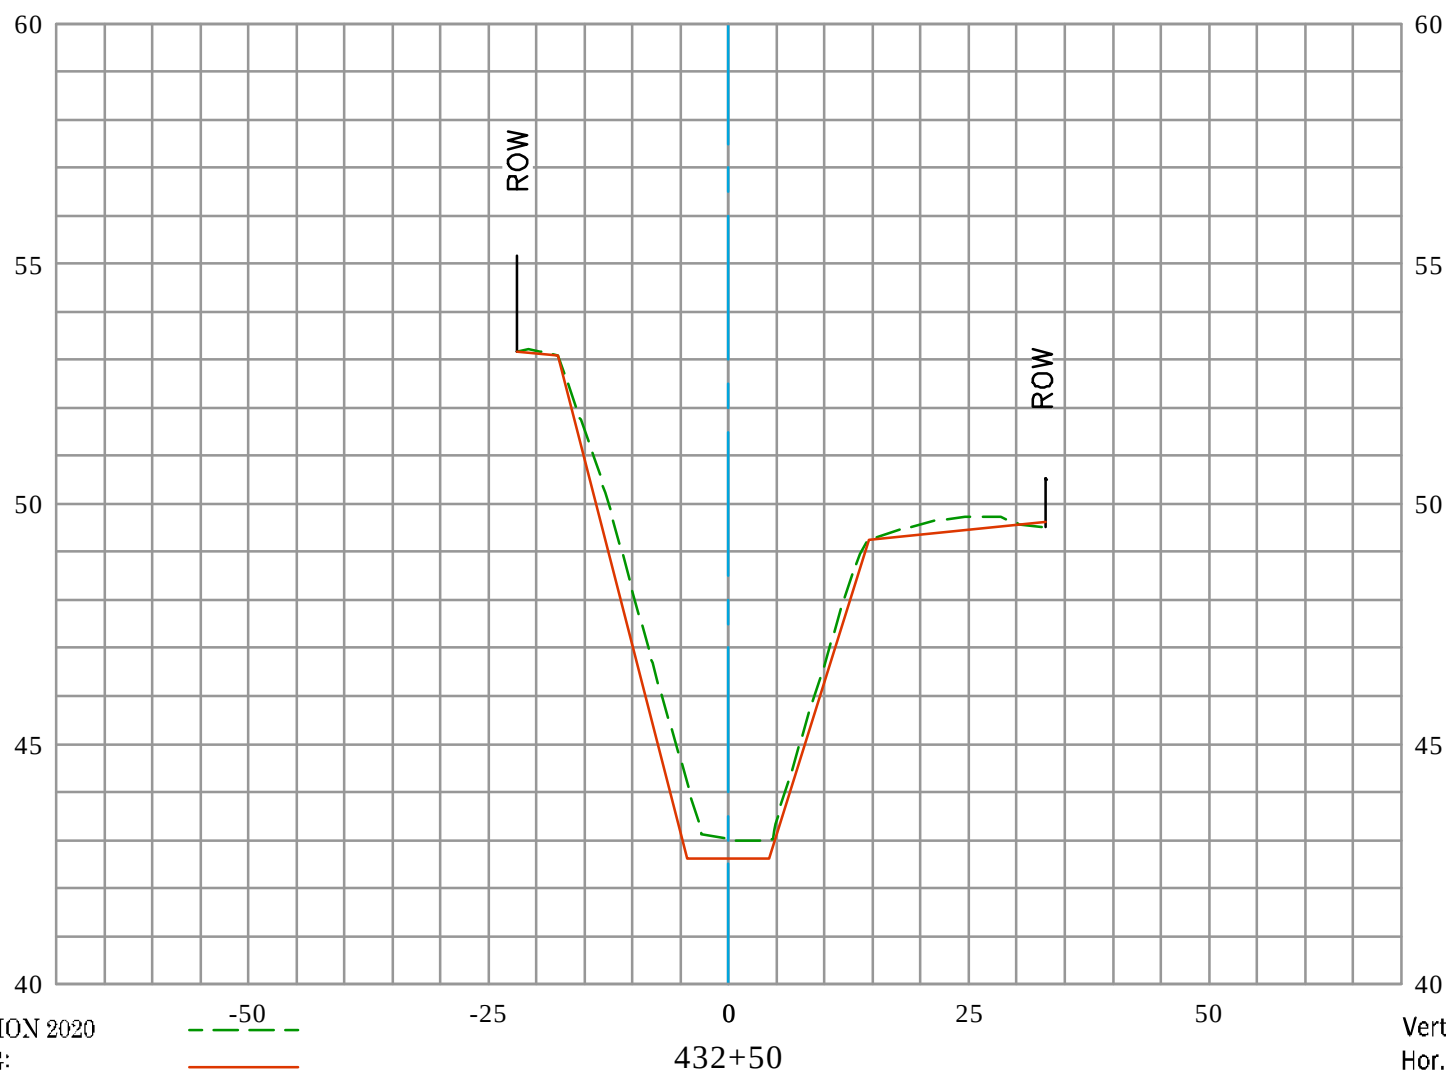

EXISTING CONDITION 2020
RECORD DRAWING:
D03-101-2A, D03-101-3A, & D03-101-7R
DATE PREPARED: 01/24/2022



GREENVILLE BANNING CHANNEL (D03) CL

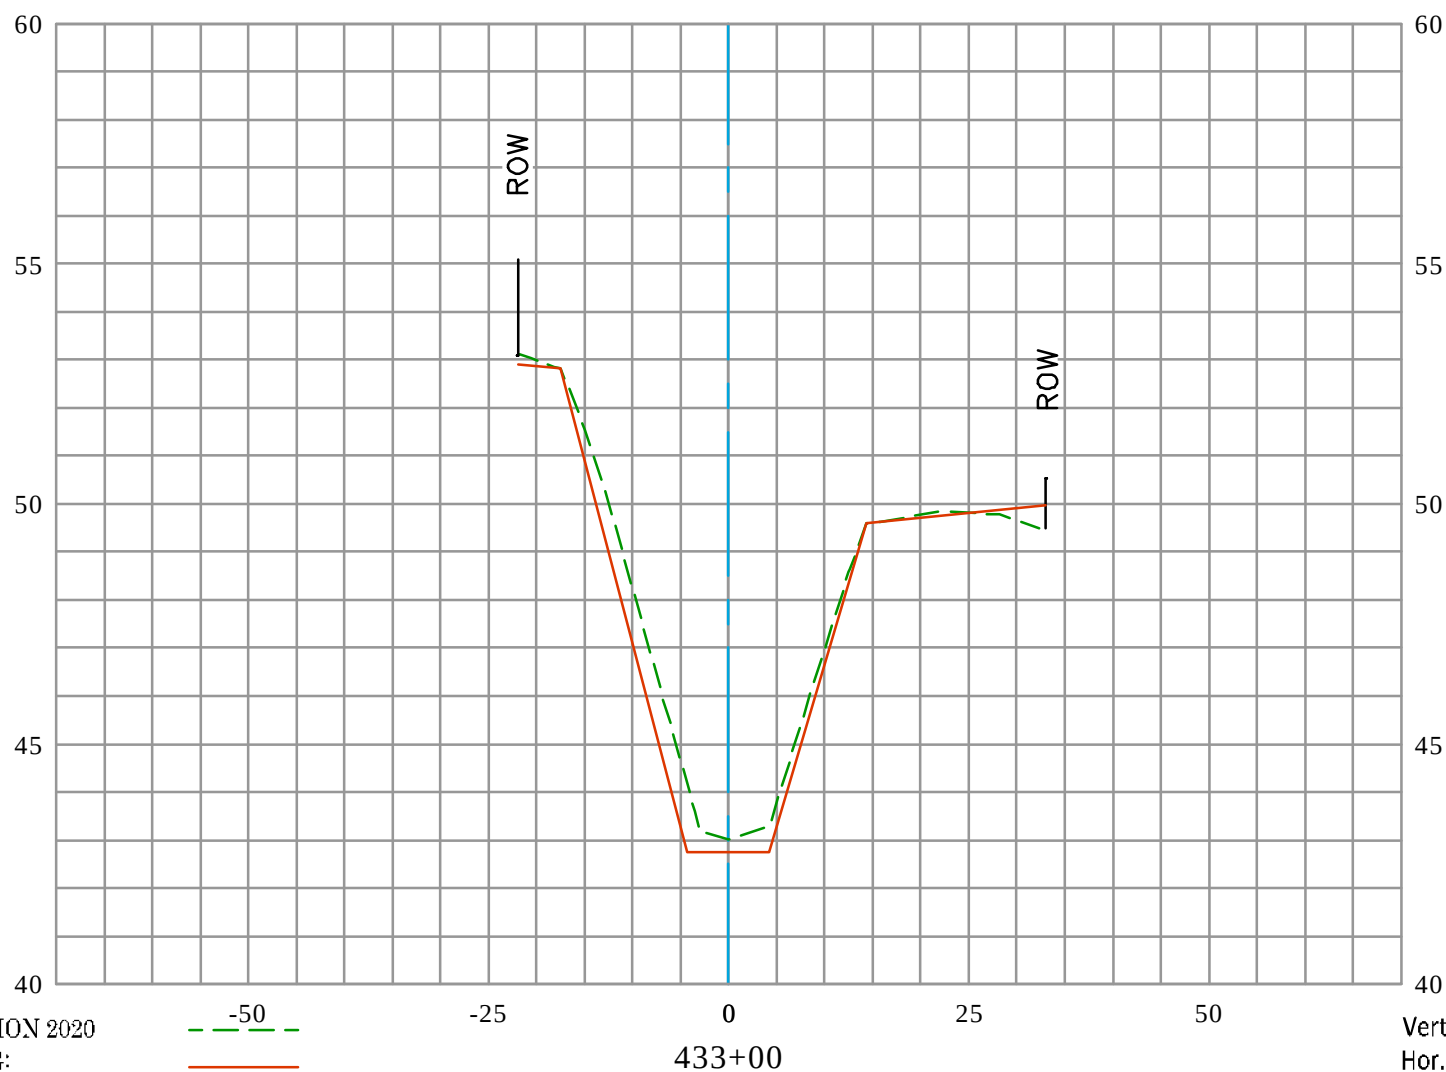


EXISTING CONDITION 2020
 RECORD DRAWING:
 D03-101-2A, D03-101-3A, & D03-101-7R
 DATE PREPARED: 01/24/2022

Vert. Scale: 1" = 4'
 Hor. Scale: 1" = 20'




GREENVILLE BANNING CHANNEL (D03) CL

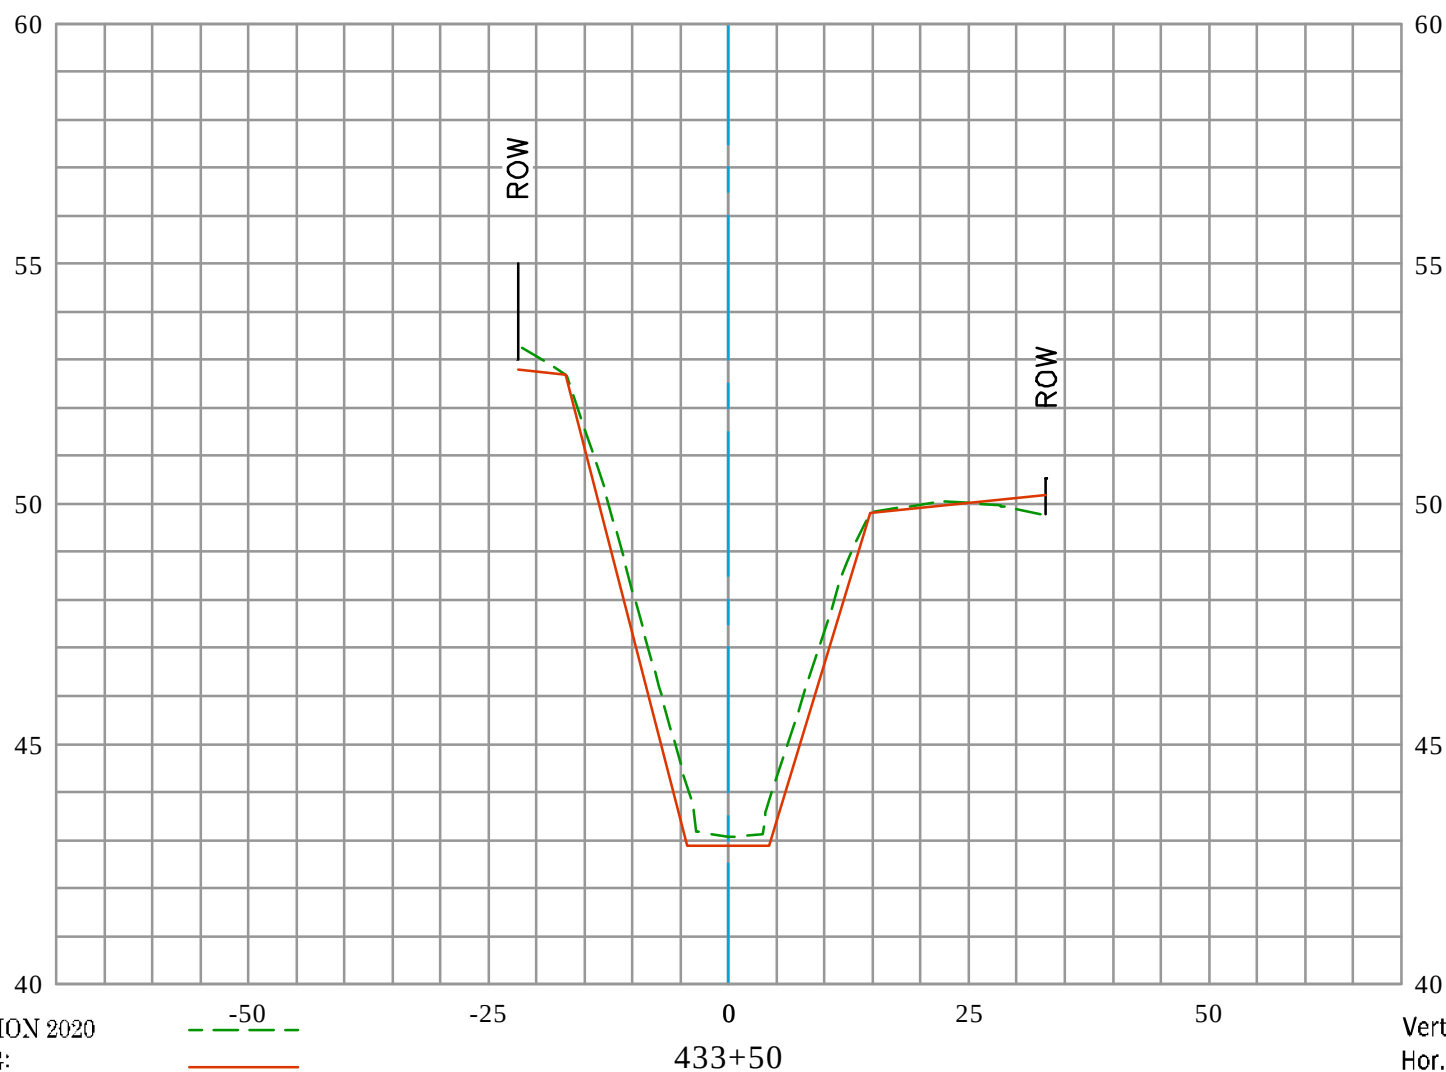

EXISTING CONDITION 2020
 RECORD DRAWING:
 D03-101-2A, D03-101-3A, & D03-101-7R
 DATE PREPARED: 01/24/2022




GREENVILLE BANNING CHANNEL (D03) CL

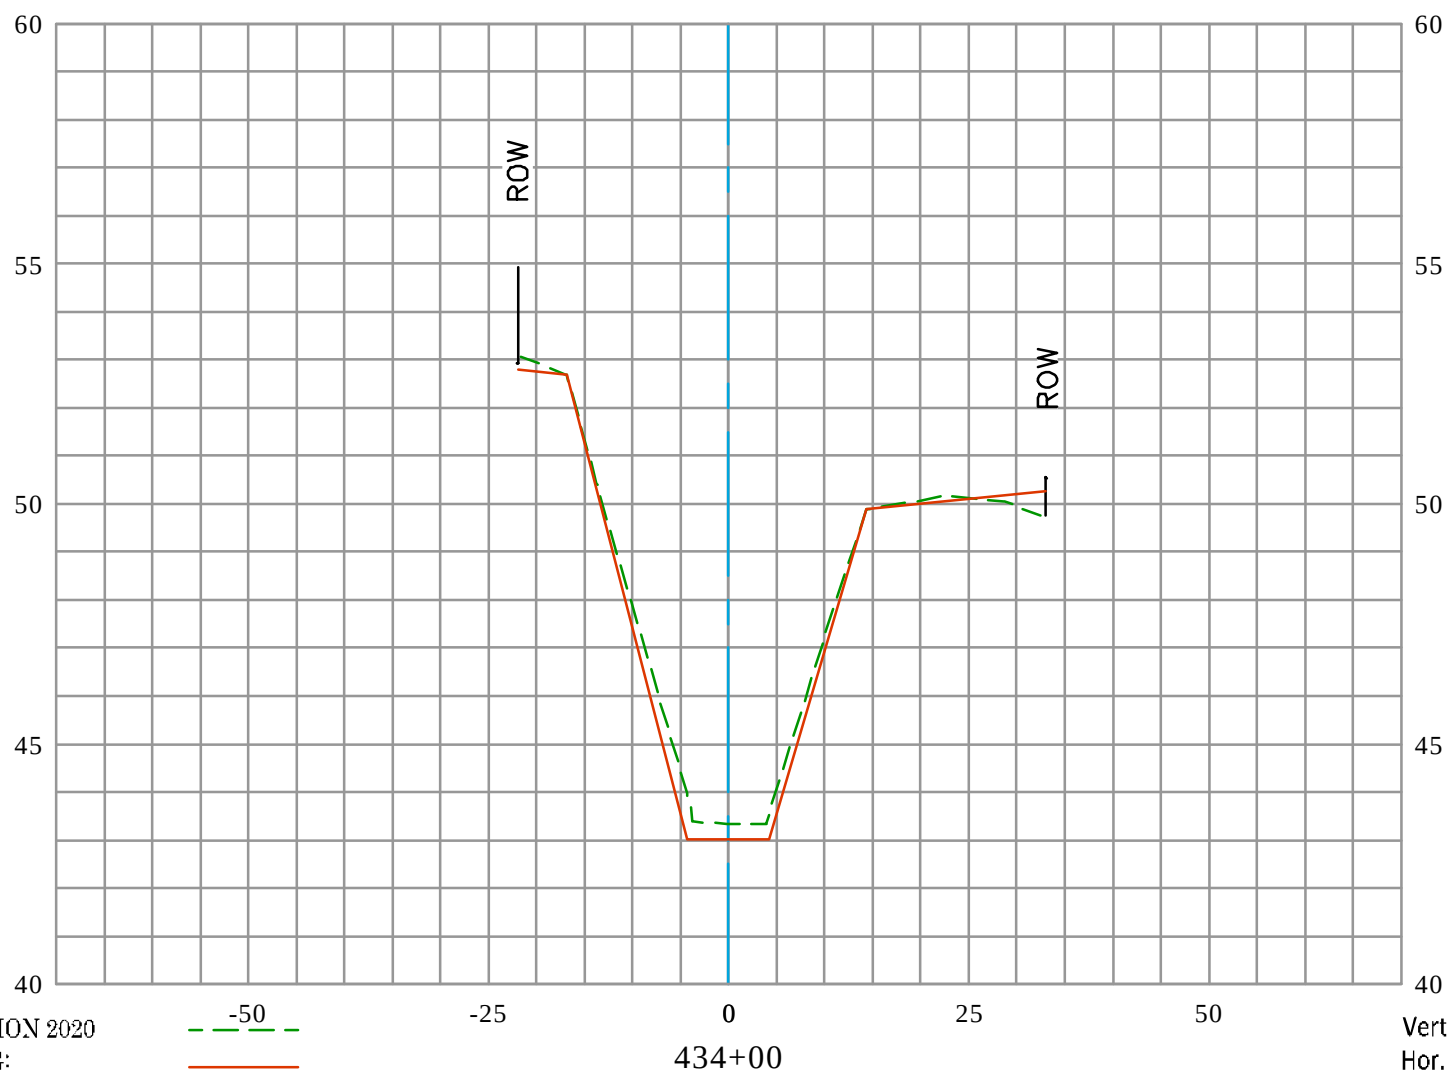



GREENVILLE BANNING CHANNEL (D03) CL

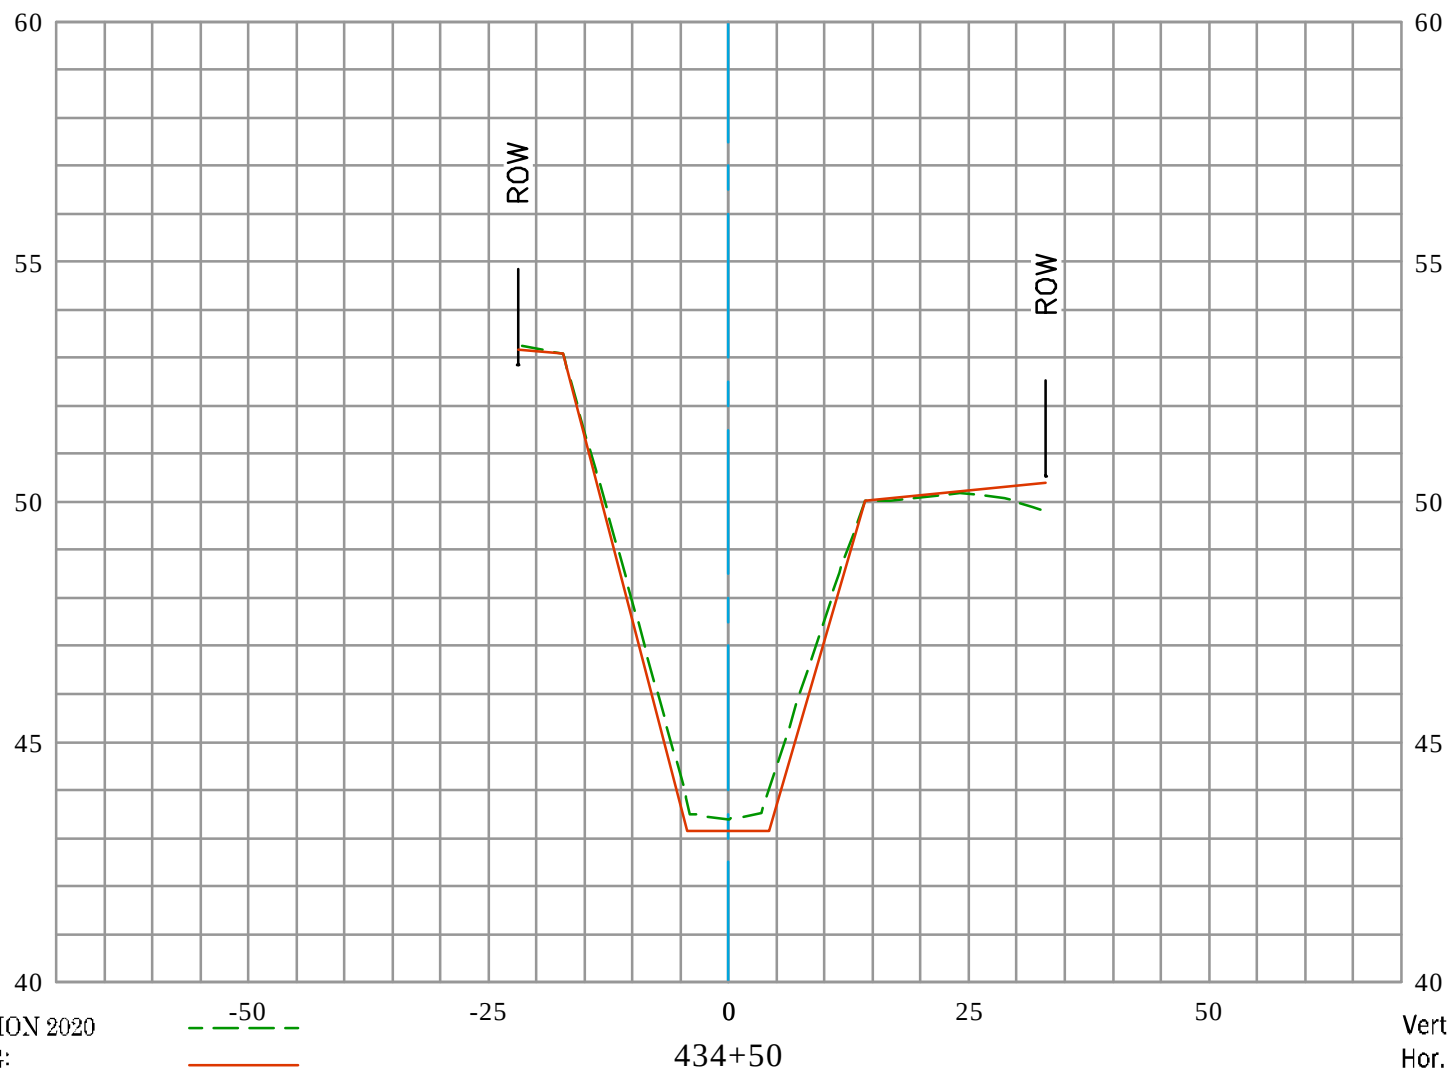

EXISTING CONDITION 2020
 RECORD DRAWING:
 D03-101-2A, D03-101-3A, & D03-101-7R
 DATE PREPARED: 01/24/2022


Vert. Scale: 1" = 4'
 Hor. Scale: 1" = 20'

U.S. Survey Foot

OC Public Works
OC Survey/Field Services
Boundary Analysis & Mapping




GREENVILLE BANNING CHANNEL (D03) CL

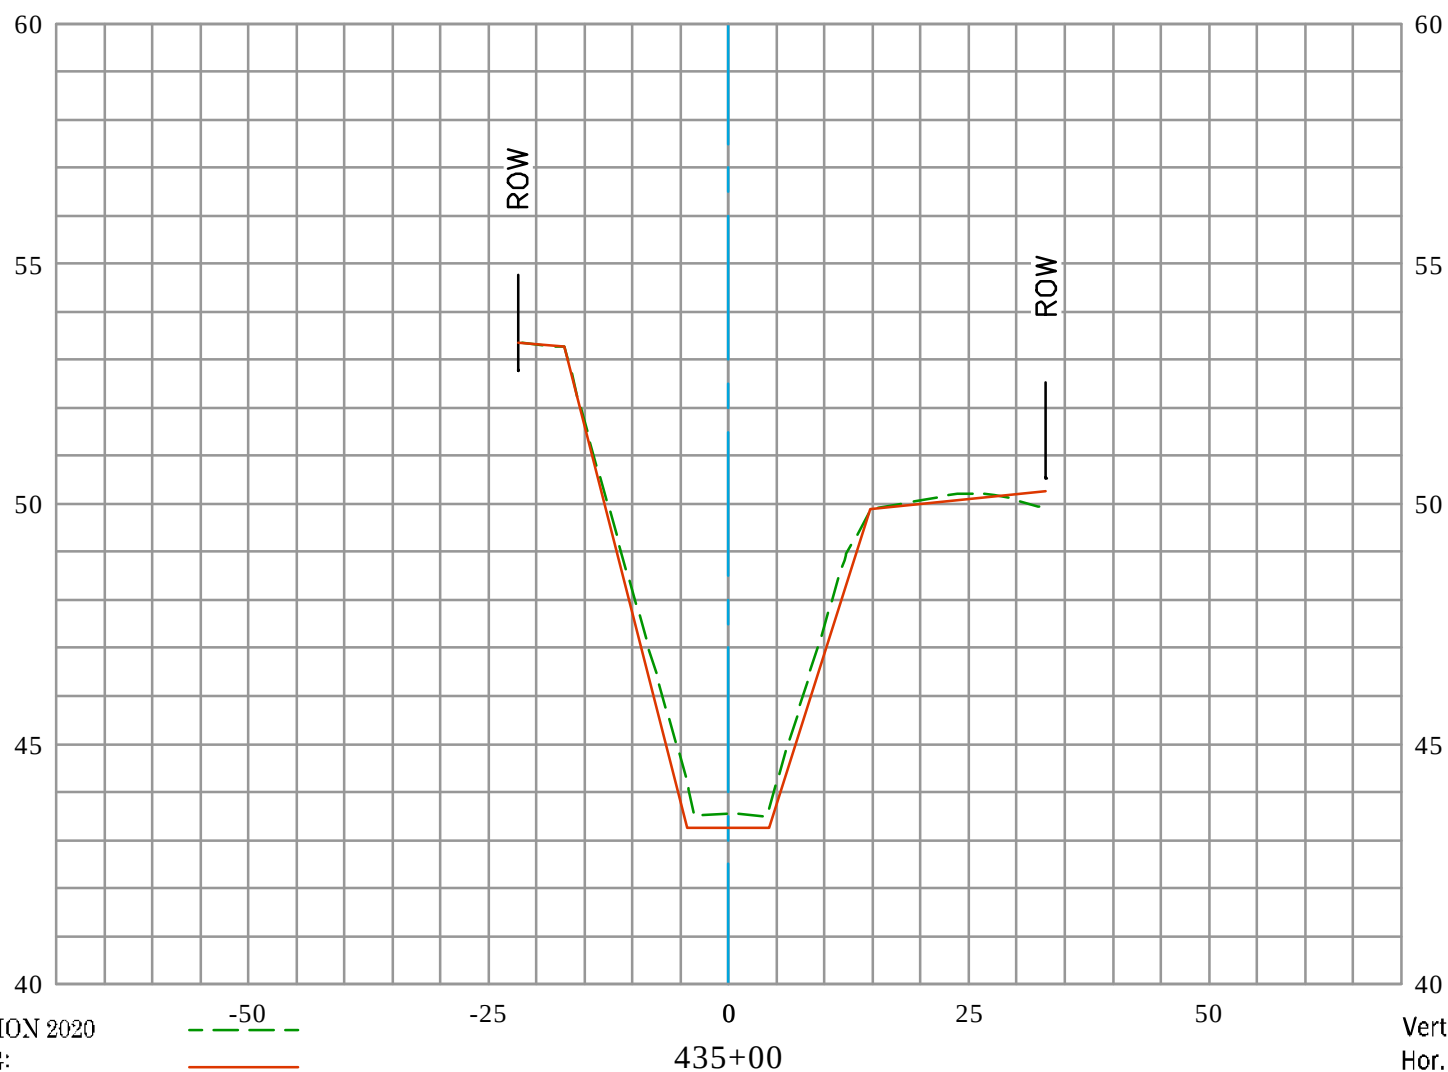

EXISTING CONDITION 2020
RECORD DRAWING:
D03-101-2A, D03-101-3A, & D03-101-7R
DATE PREPARED: 01/24/2022




GREENVILLE BANNING CHANNEL (D03) CL

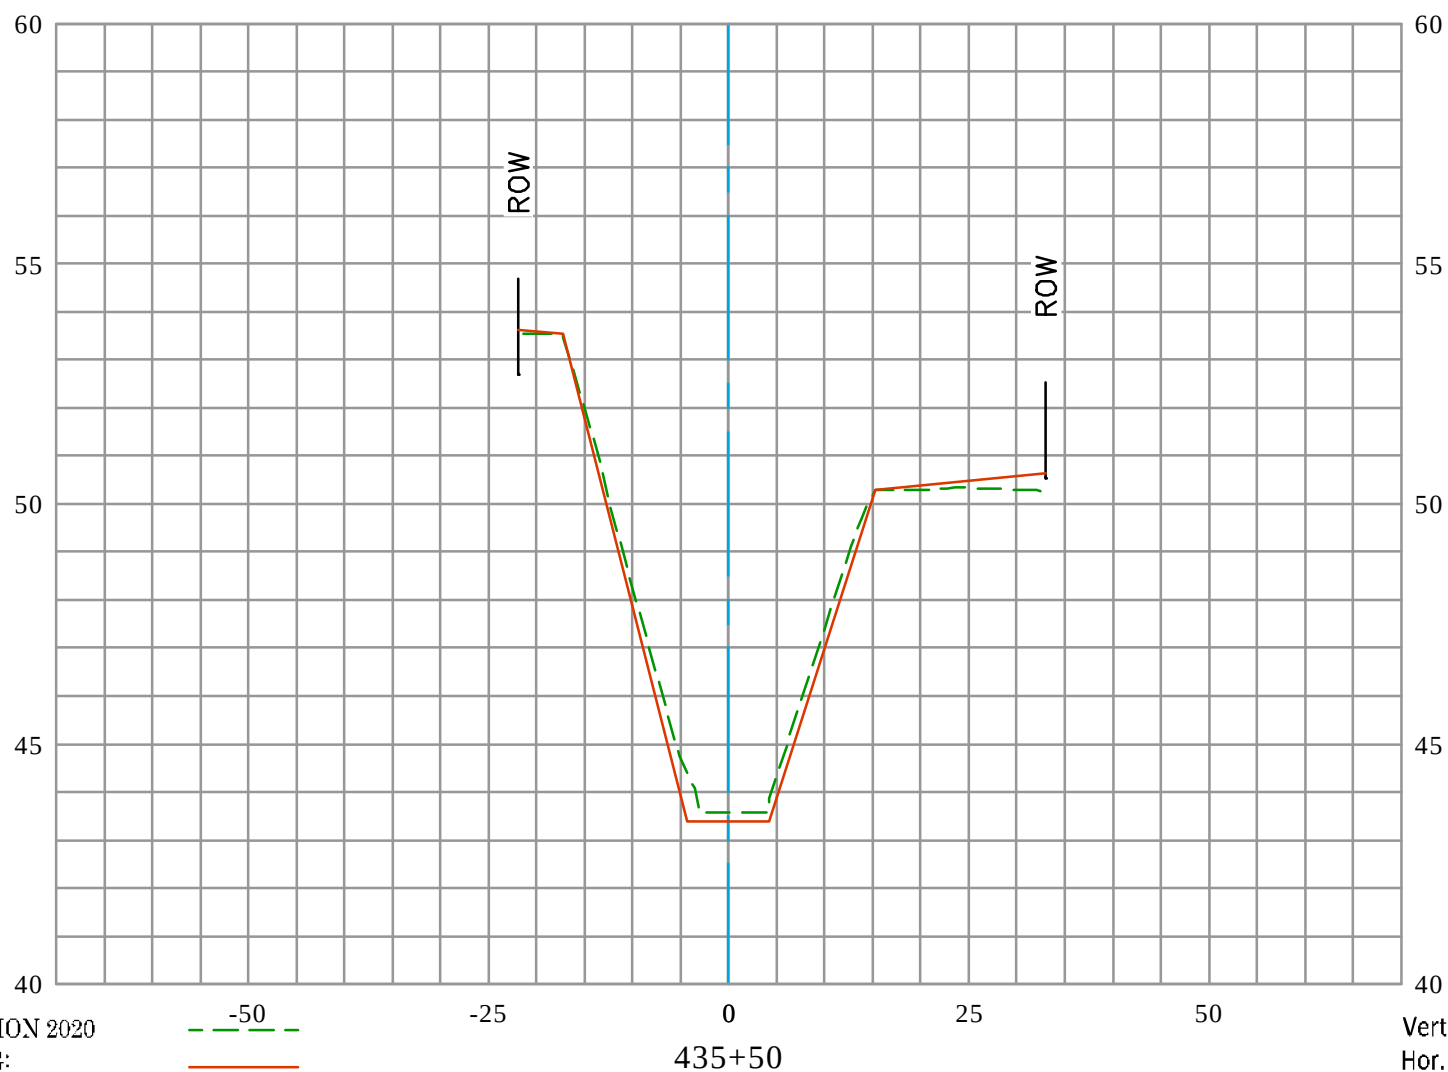

EXISTING CONDITION 2020
RECORD DRAWING:
D03-101-2A, D03-101-3A, & D03-101-7R
DATE PREPARED: 01/24/2022



GREENVILLE BANNING CHANNEL (D03) CL

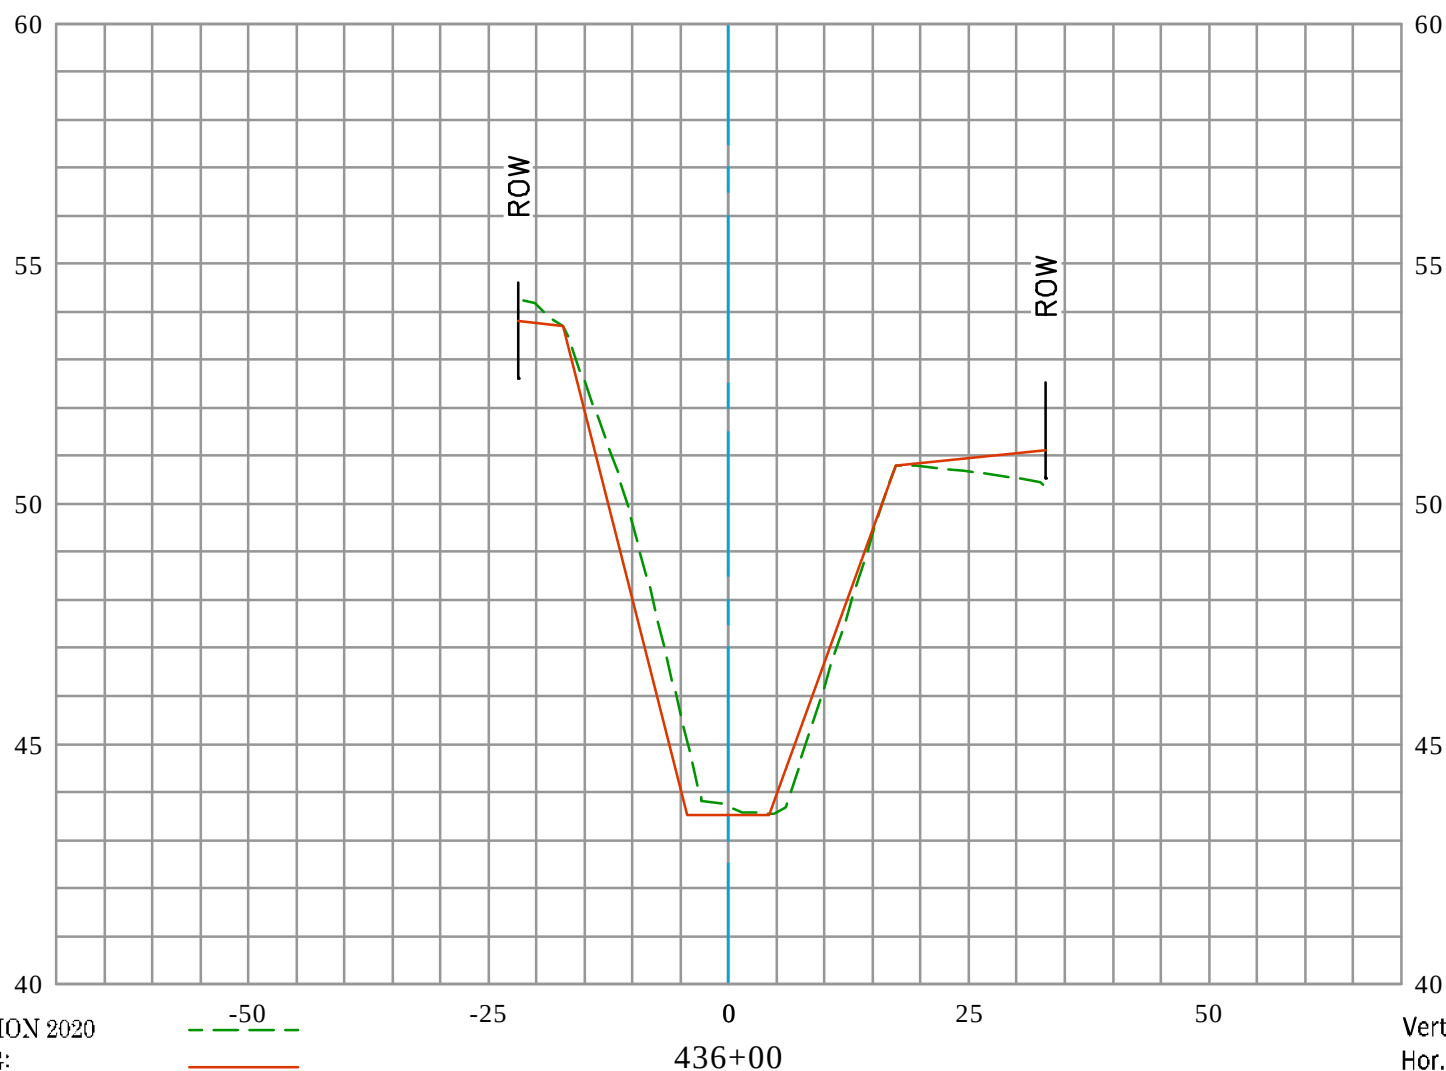


EXISTING CONDITION 2020
 RECORD DRAWING:
 D03-101-2A, D03-101-3A, & D03-101-7R
 DATE PREPARED: 01/24/2022

Vert. Scale: 1" = 4'
 Hor. Scale: 1" = 20'



GREENVILLE BANNING CHANNEL (D03) CL

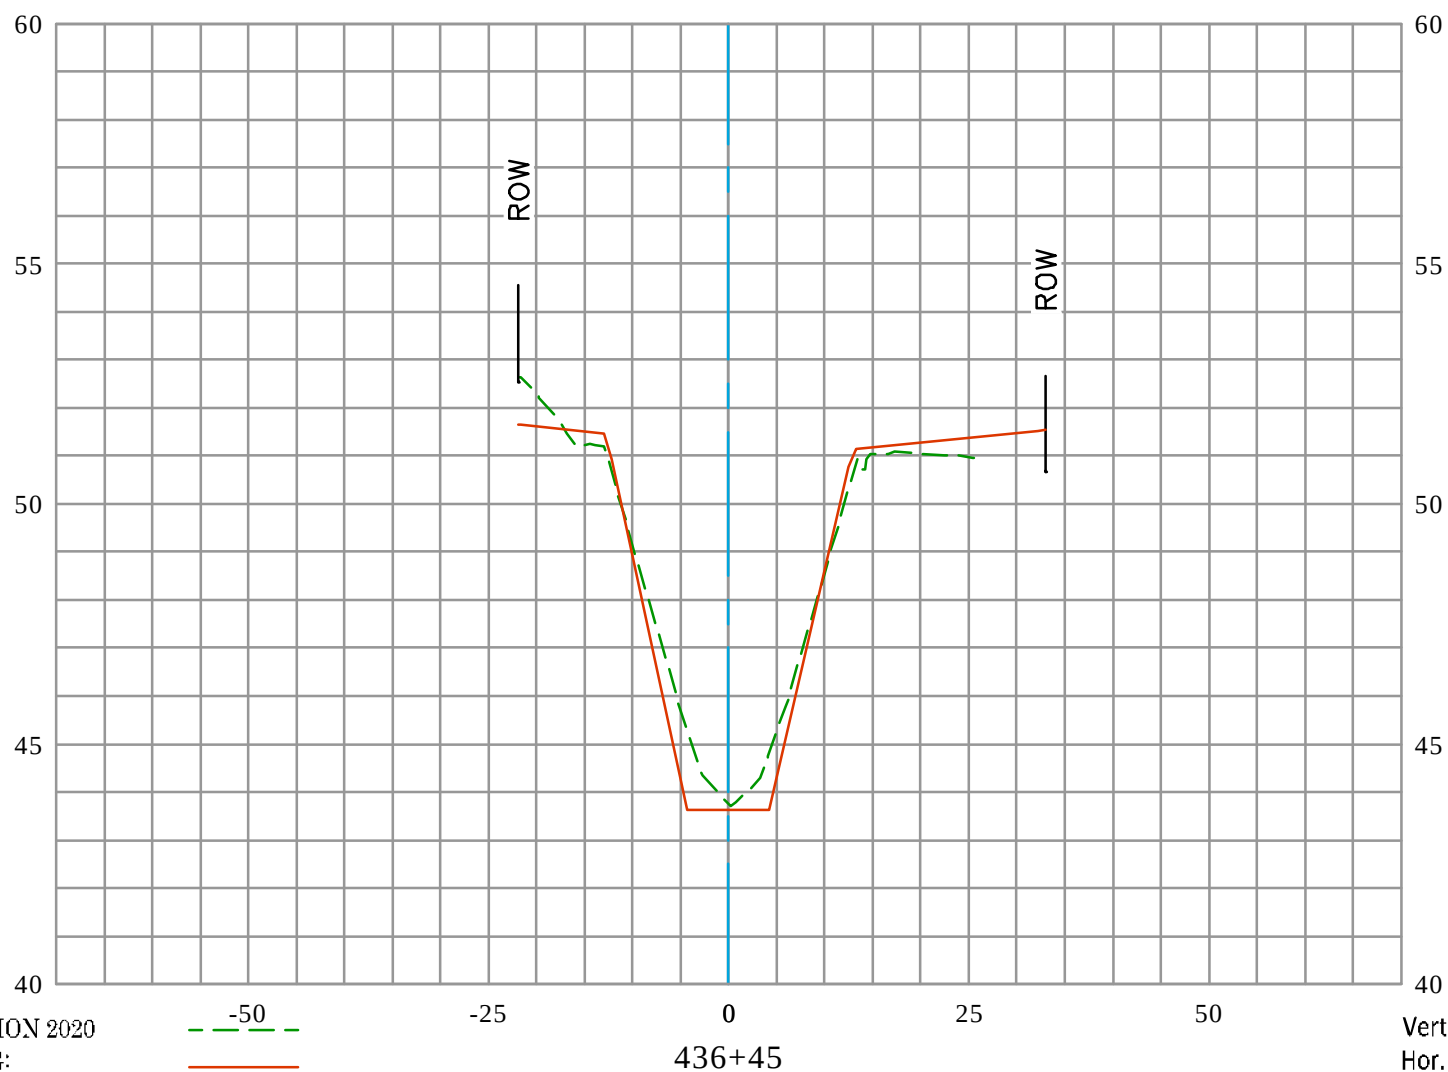


EXISTING CONDITION 2020
RECORD DRAWING:
D03-101-2A, D03-101-3A, & D03-101-7R
DATE PREPARED: 01/24/2022

Vert. Scale: 1" = 4'
Hor. Scale: 1" = 20'



GREENVILLE BANNING CHANNEL (D03) CL

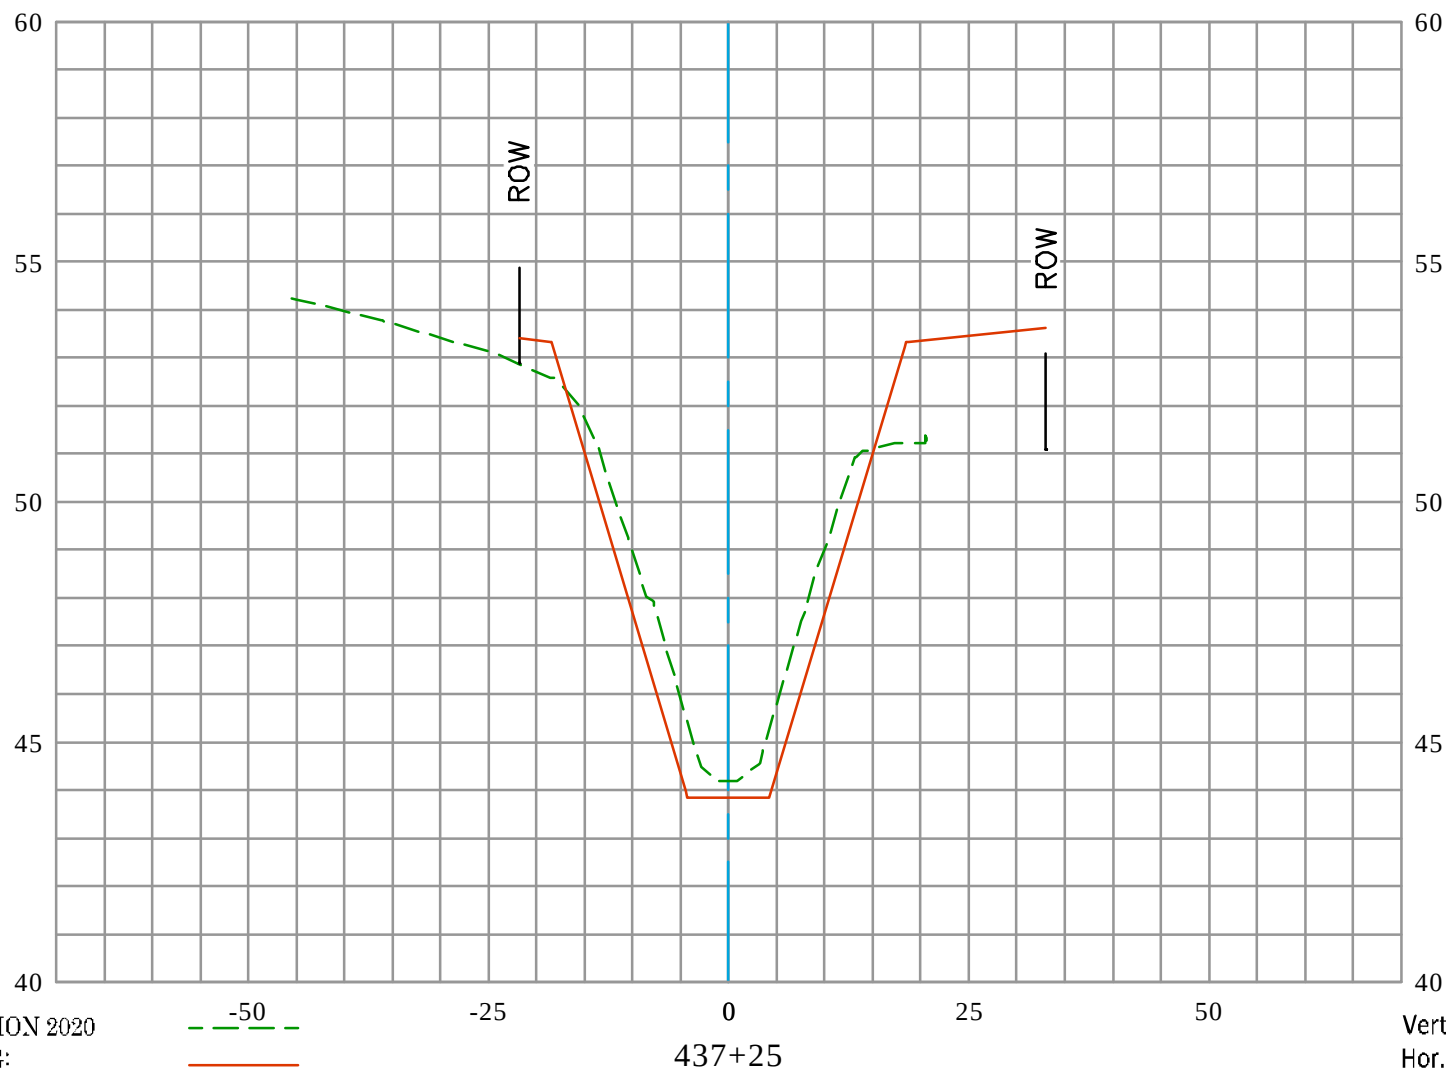


EXISTING CONDITION 2020
 RECORD DRAWING:
 D03-101-2A, D03-101-3A, & D03-101-7R
 DATE PREPARED: 01/24/2022

Vert. Scale: 1" = 4'
 Hor. Scale: 1" = 20'



GREENVILLE BANNING CHANNEL (D03) CL

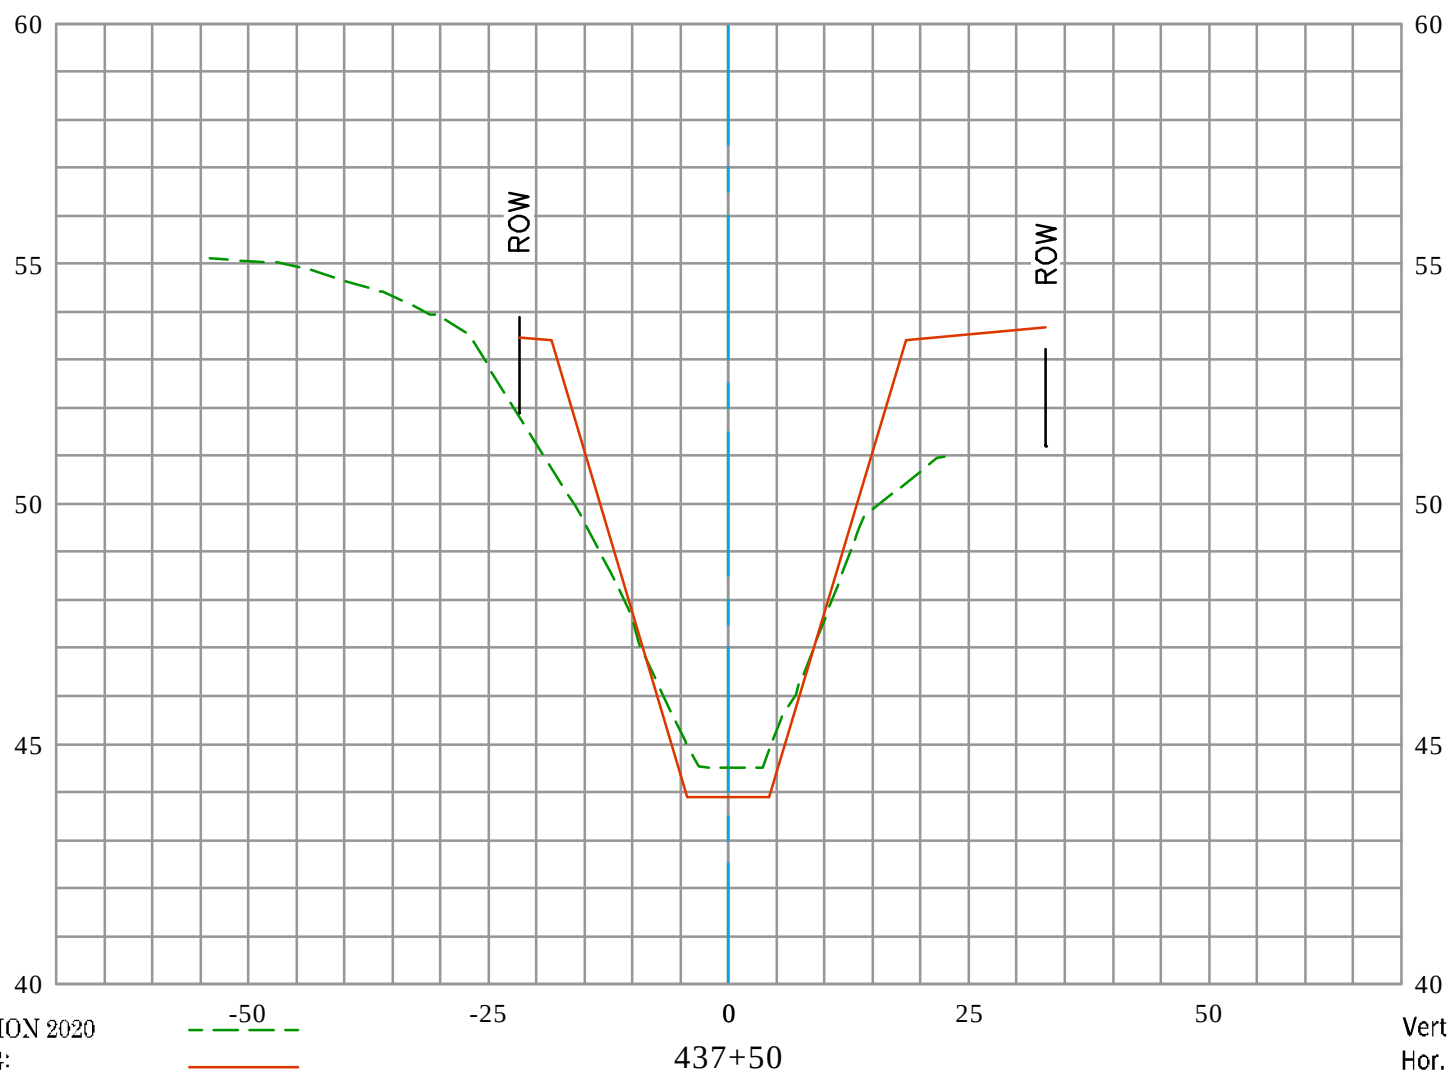


EXISTING CONDITION 2020
RECORD DRAWING:
D03-101-2A, D03-101-3A, & D03-101-7R
DATE PREPARED: 01/24/2022

Vert. Scale: 1" = 4'
Hor. Scale: 1" = 20'



GREENVILLE BANNING CHANNEL (D03) CL

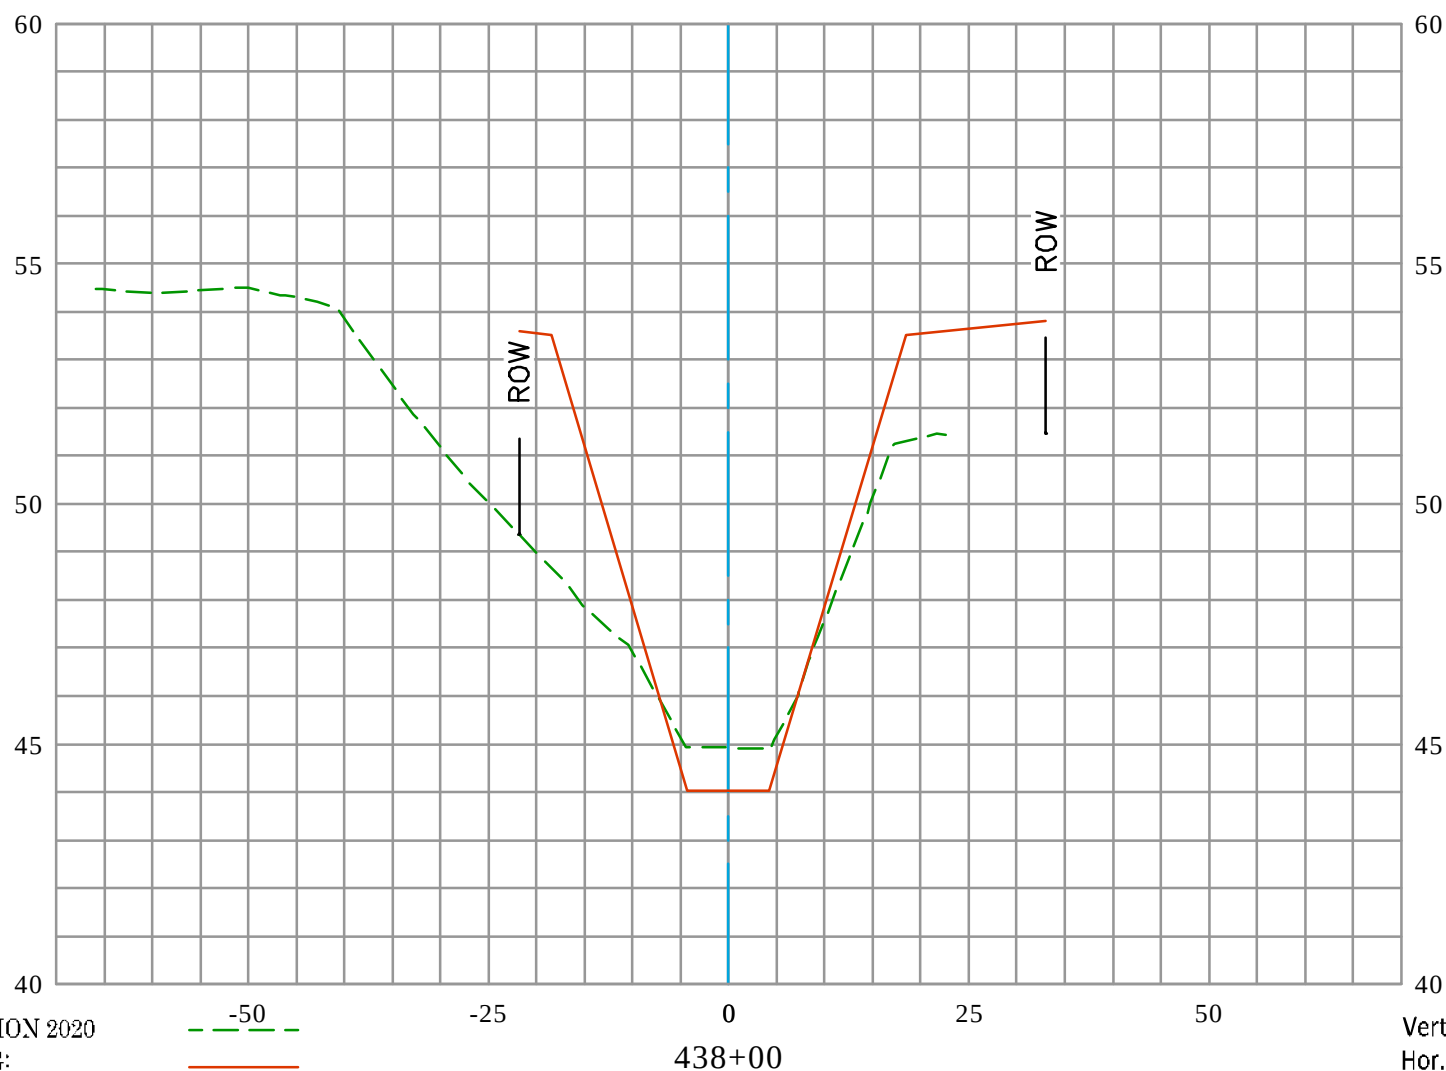


EXISTING CONDITION 2020
 RECORD DRAWING:
 D03-101-2A, D03-101-3A, & D03-101-7R
 DATE PREPARED: 01/24/2022

Vert. Scale: 1" = 4'
 Hor. Scale: 1" = 20'



GREENVILLE BANNING CHANNEL (D03) CL

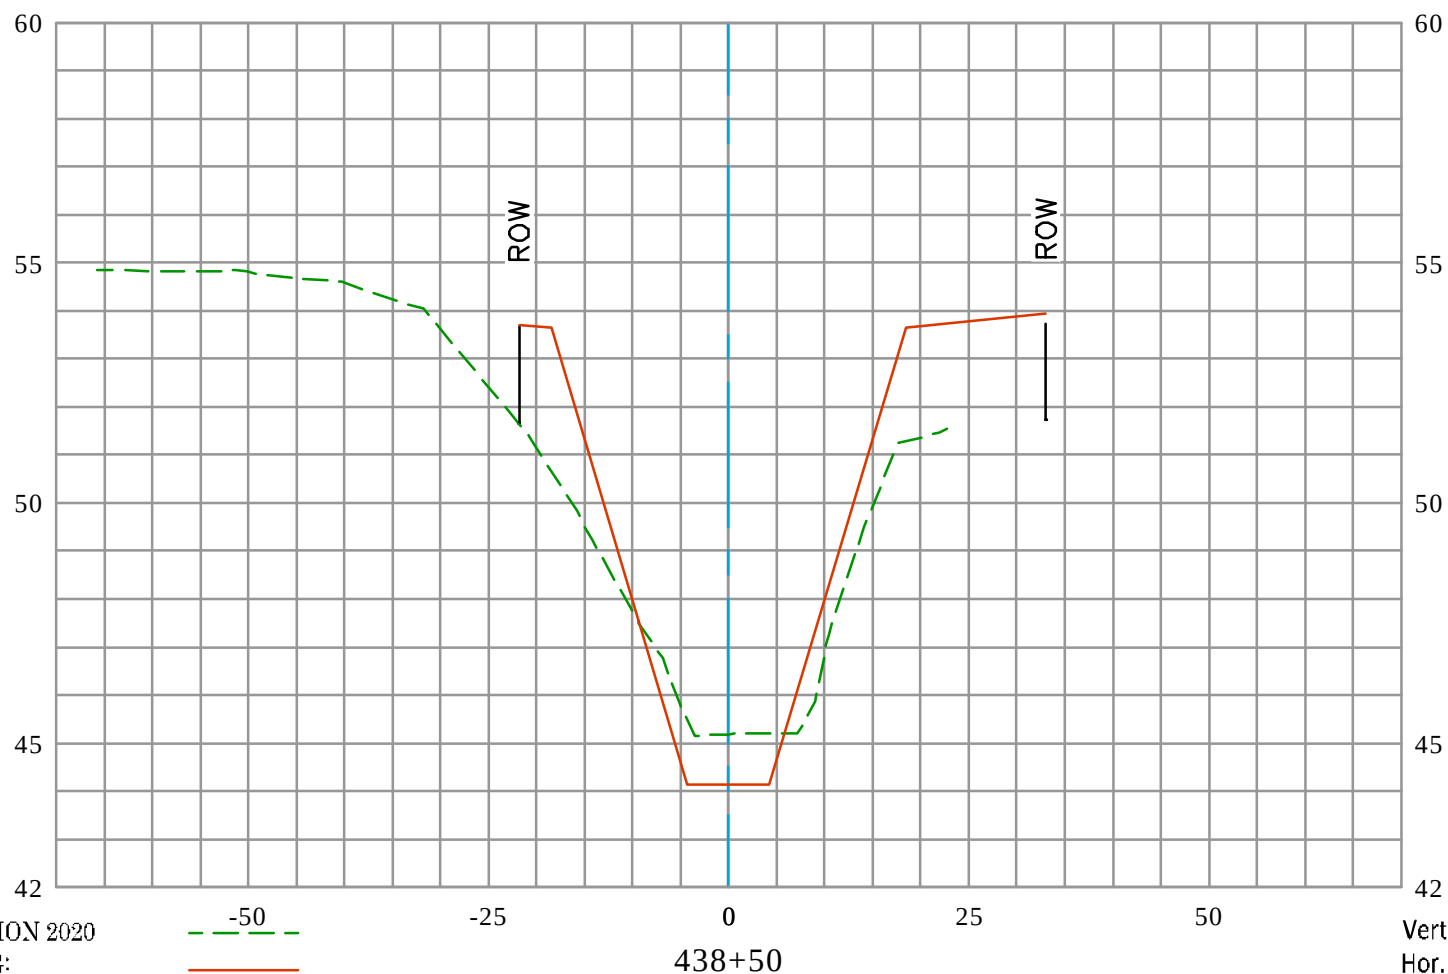


EXISTING CONDITION 2020
 RECORD DRAWING:
 D03-101-2A, D03-101-3A, & D03-101-7R
 DATE PREPARED: 01/24/2022

Vert. Scale: 1" = 4'
 Hor. Scale: 1" = 20'



GREENVILLE BANNING CHANNEL (D03) CL

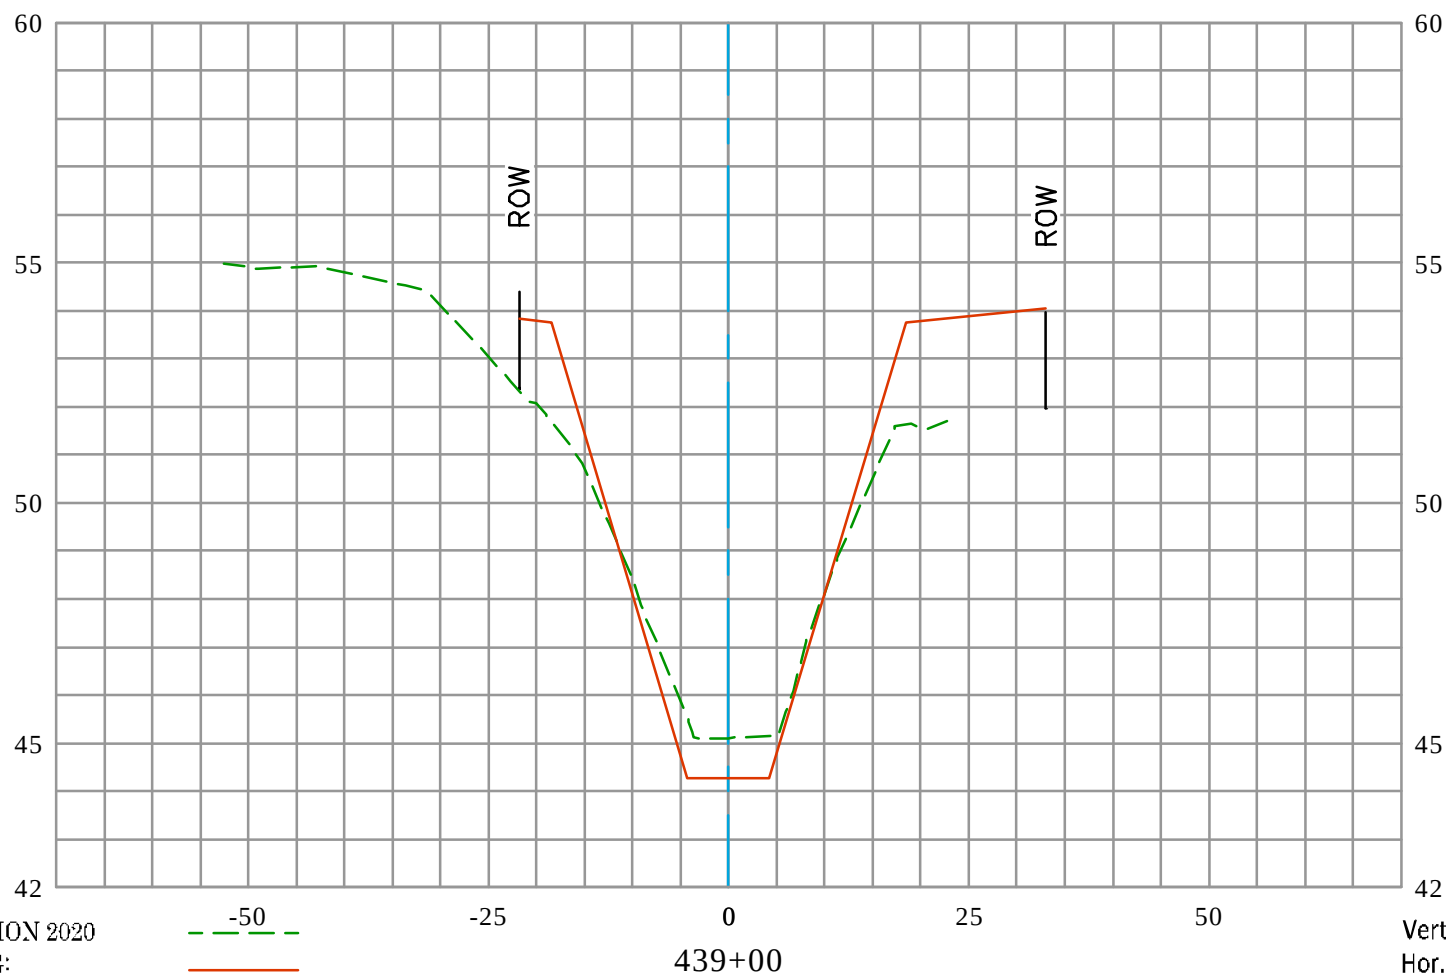


EXISTING CONDITION 2020
 RECORD DRAWING:
 D03-101-2A, D03-101-3A, & D03-101-7R
 DATE PREPARED: 01/24/2022

Vert. Scale: 1" = 4'
 Hor. Scale: 1" = 20'




GREENVILLE BANNING CHANNEL (D03) CL

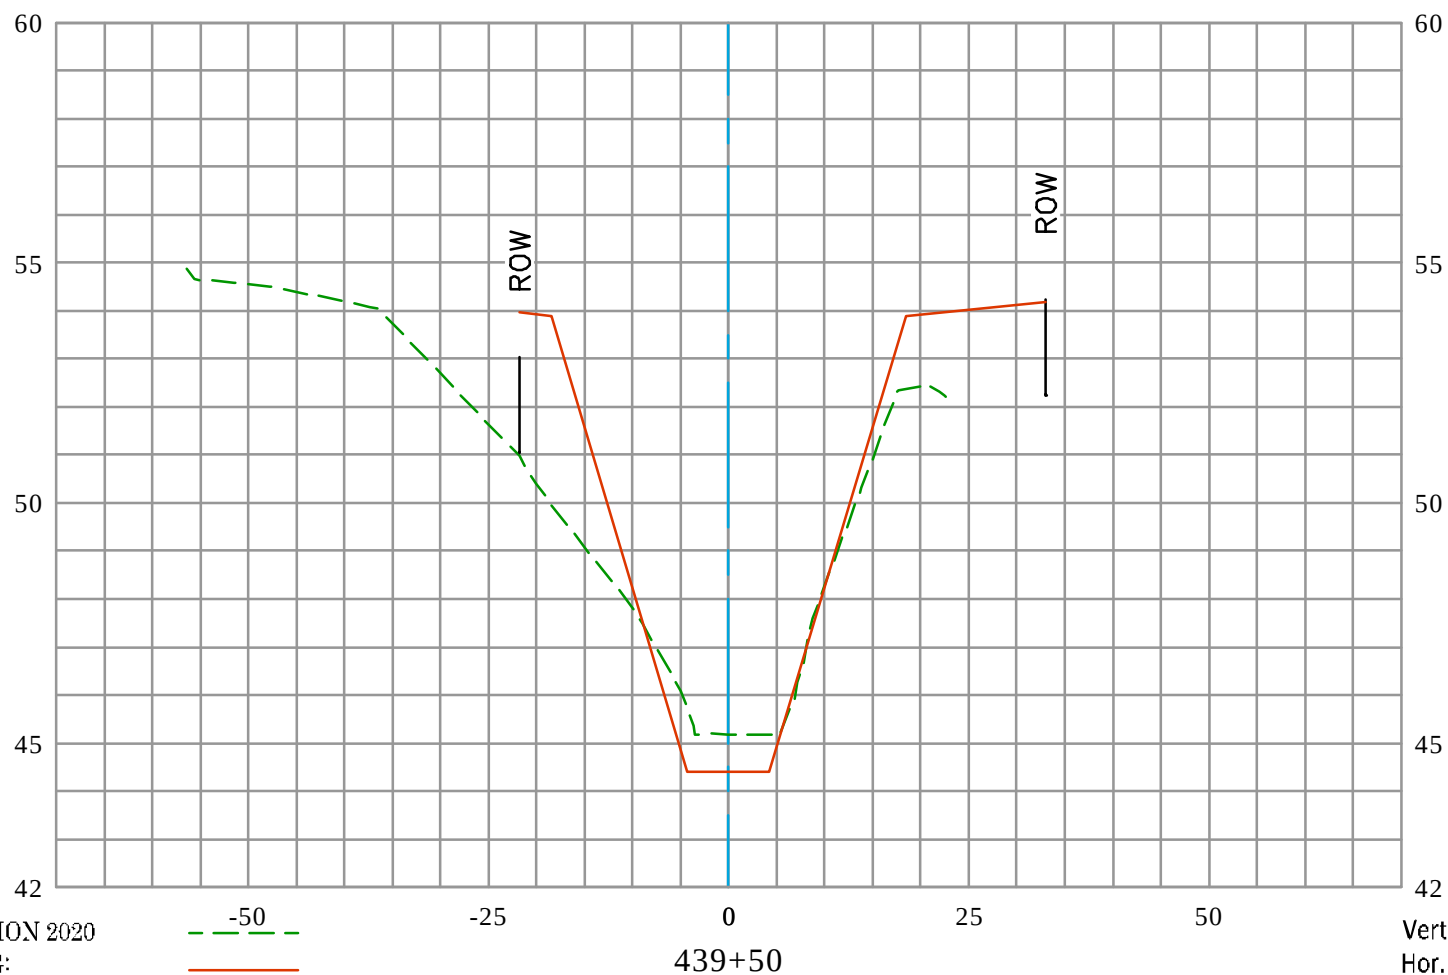

EXISTING CONDITION 2020
 RECORD DRAWING:
 D03-101-2A, D03-101-3A, & D03-101-7R
 DATE PREPARED: 01/24/2022

Vert. Scale: 1" = 4'
 Hor. Scale: 1" = 20'

GREENVILLE BANNING CHANNEL (D03) CL

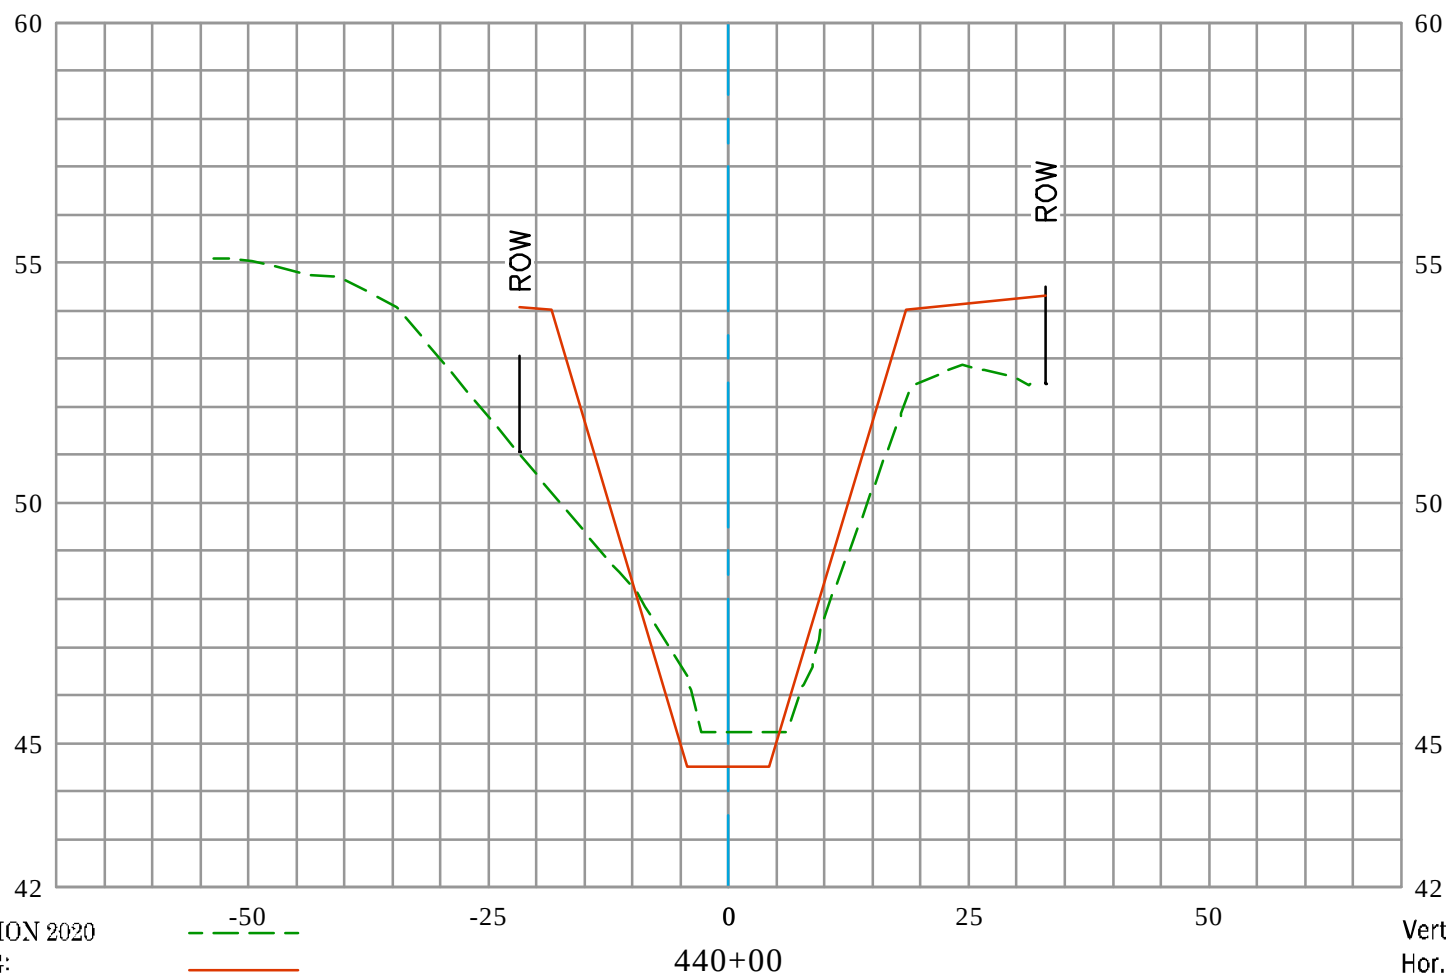


EXISTING CONDITION 2020
 RECORD DRAWING:
 D03-101-2A, D03-101-3A, & D03-101-7R
 DATE PREPARED: 01/24/2022

Vert. Scale: 1" = 4'
 Hor. Scale: 1" = 20'



GREENVILLE BANNING CHANNEL (D03) CL

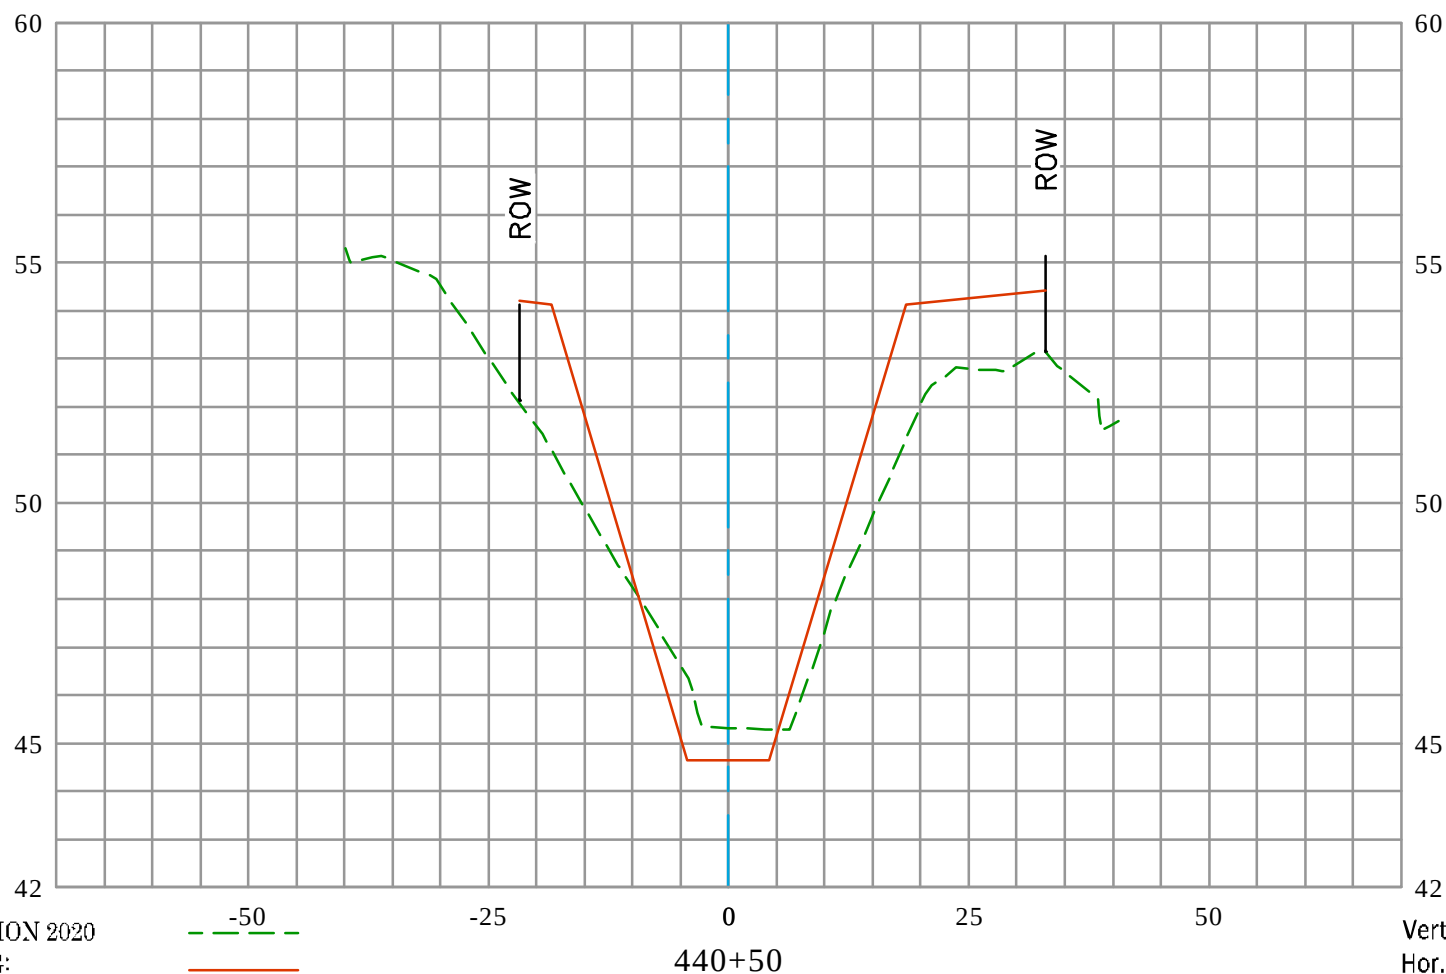


EXISTING CONDITION 2020
 RECORD DRAWING:
 D03-101-2A, D03-101-3A, & D03-101-7R
 DATE PREPARED: 01/24/2022

Vert. Scale: 1" = 4'
 Hor. Scale: 1" = 20'




GREENVILLE BANNING CHANNEL (D03) CL

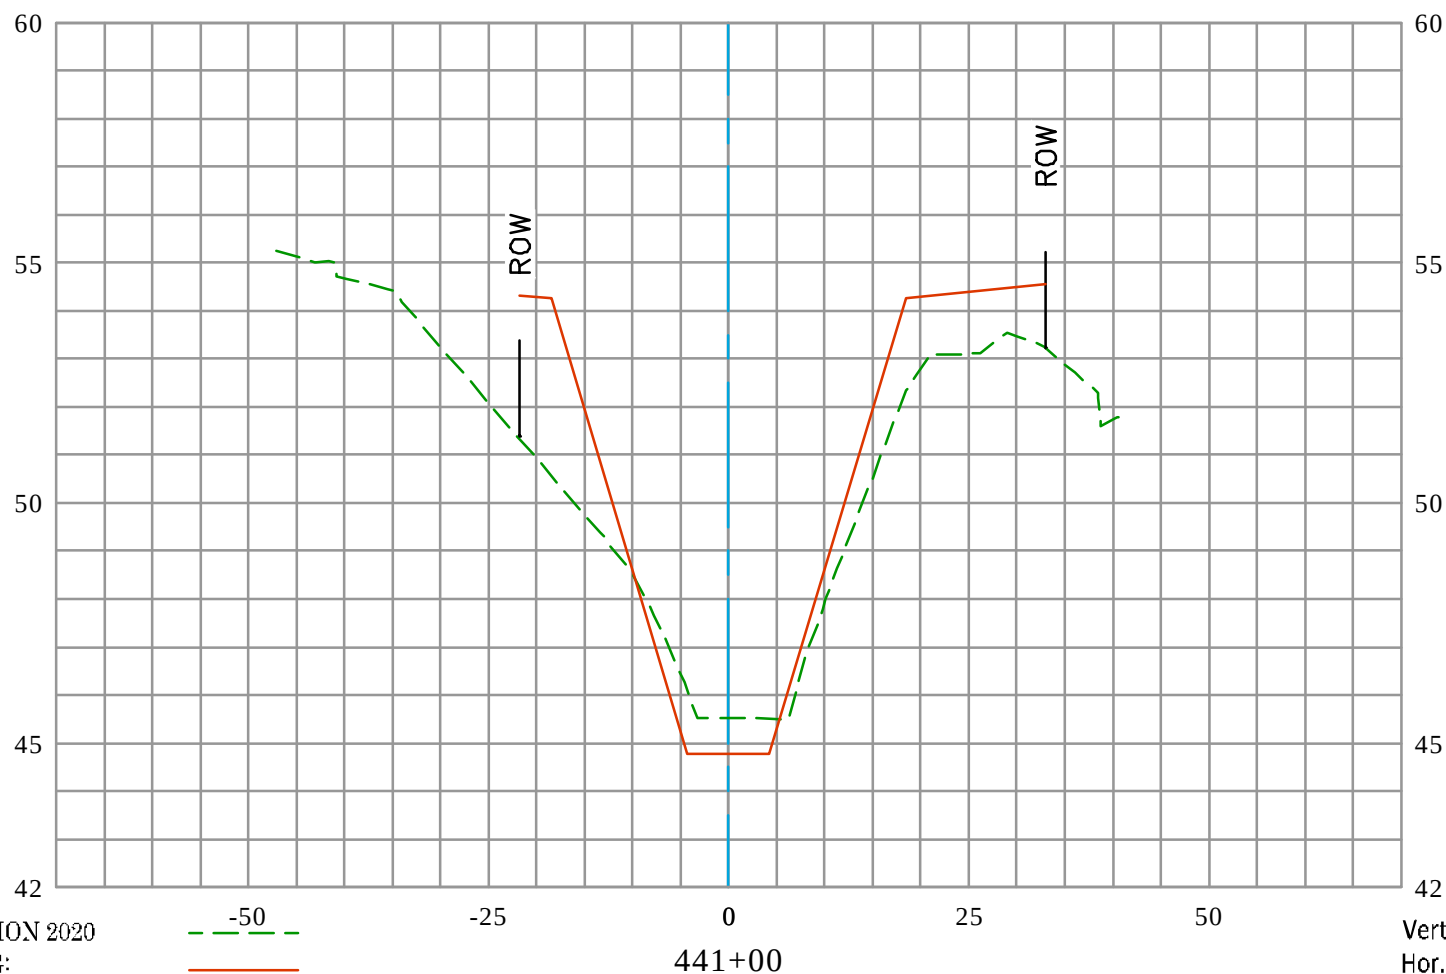

EXISTING CONDITION 2020
 RECORD DRAWING:
 D03-101-2A, D03-101-3A, & D03-101-7R
 DATE PREPARED: 01/24/2022

Vert. Scale: 1" = 4'
 Hor. Scale: 1" = 20'

GREENVILLE BANNING CHANNEL (D03) CL

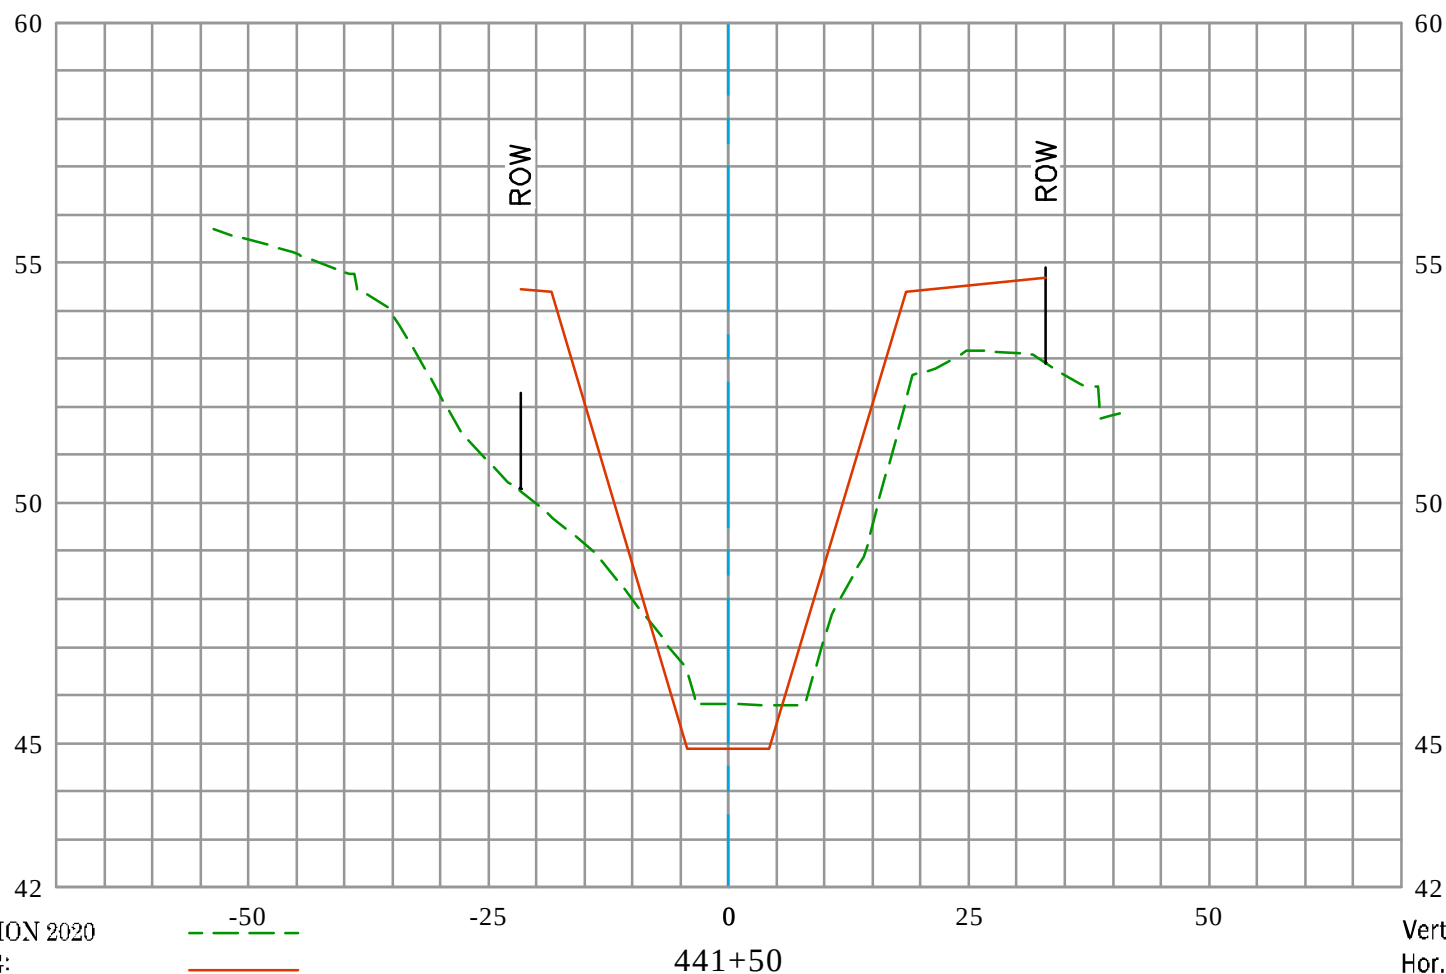


EXISTING CONDITION 2020
 RECORD DRAWING:
 D03-101-2A, D03-101-3A, & D03-101-7R
 DATE PREPARED: 01/24/2022

Vert. Scale: 1" = 4'
 Hor. Scale: 1" = 20'




GREENVILLE BANNING CHANNEL (D03) CL

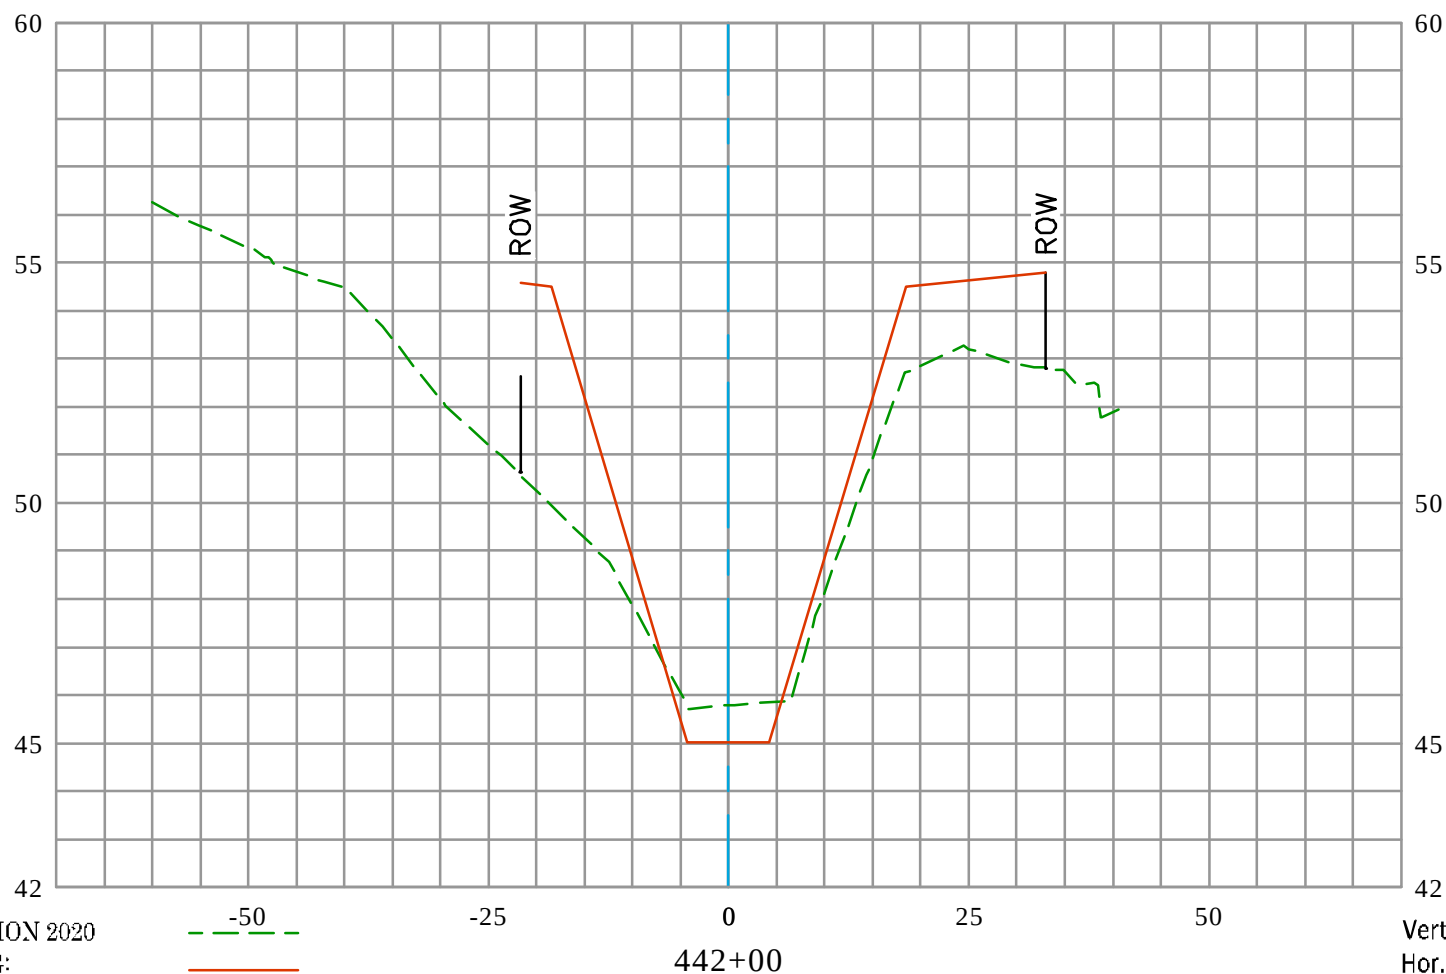

EXISTING CONDITION 2020
 RECORD DRAWING:
 D03-101-2A, D03-101-3A, & D03-101-7R
 DATE PREPARED: 01/24/2022

Vert. Scale: 1" = 4'
 Hor. Scale: 1" = 20'


GREENVILLE BANNING CHANNEL (D03) CL

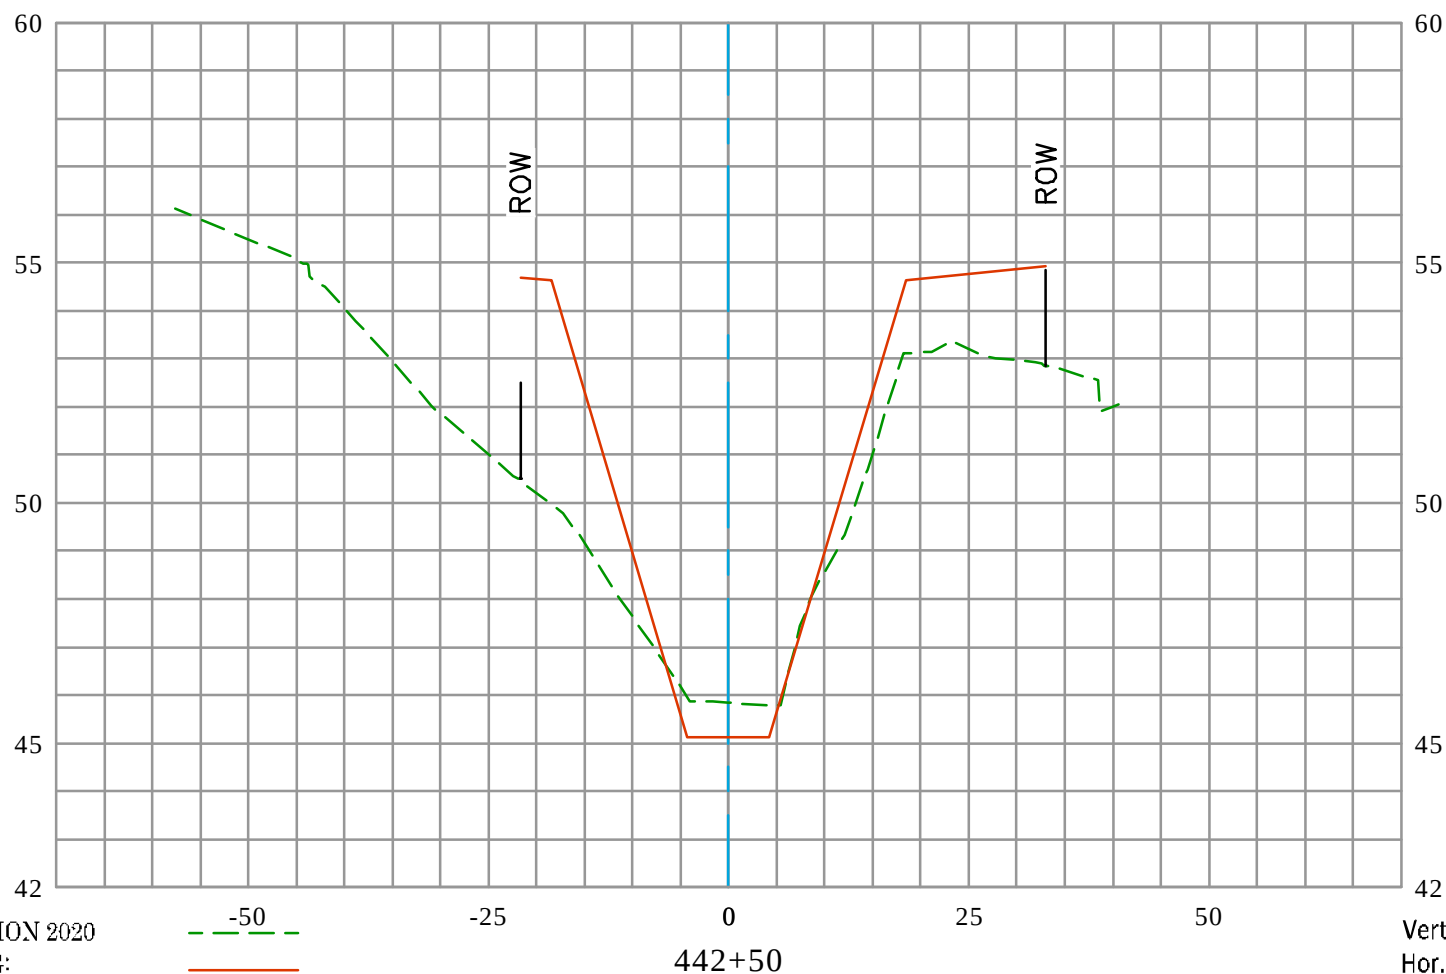

EXISTING CONDITION 2020
 RECORD DRAWING:
 D03-101-2A, D03-101-3A, & D03-101-7R
 DATE PREPARED: 01/24/2022

Vert. Scale: 1" = 4'
 Hor. Scale: 1" = 20'

GREENVILLE BANNING CHANNEL (D03) CL

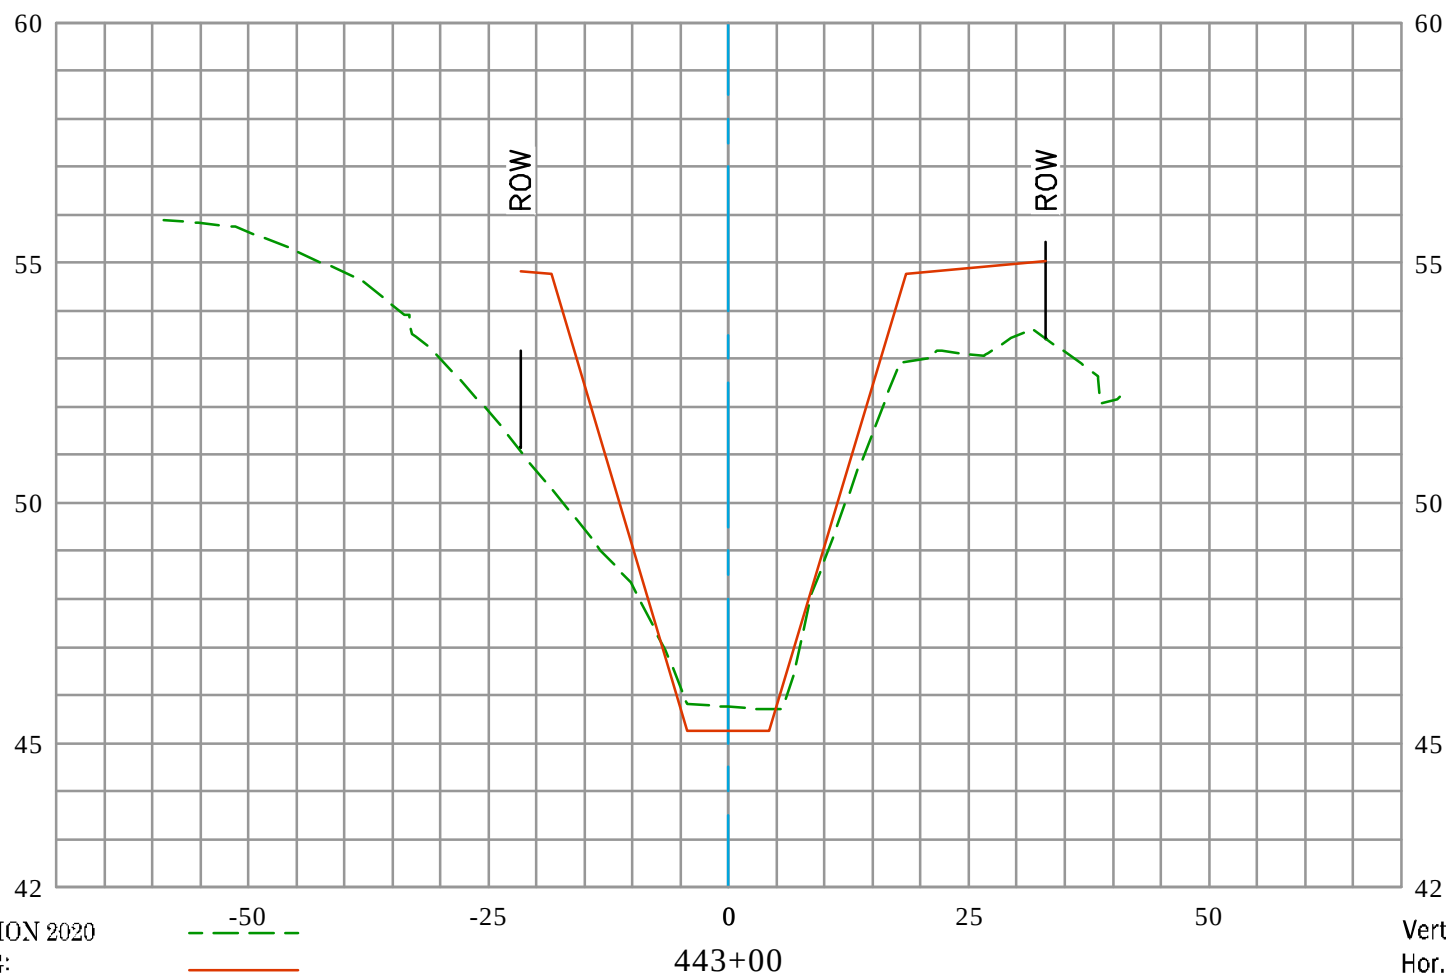


EXISTING CONDITION 2020
 RECORD DRAWING:
 D03-101-2A, D03-101-3A, & D03-101-7R
 DATE PREPARED: 01/24/2022

Vert. Scale: 1" = 4'
 Hor. Scale: 1" = 20'



GREENVILLE BANNING CHANNEL (D03) CL

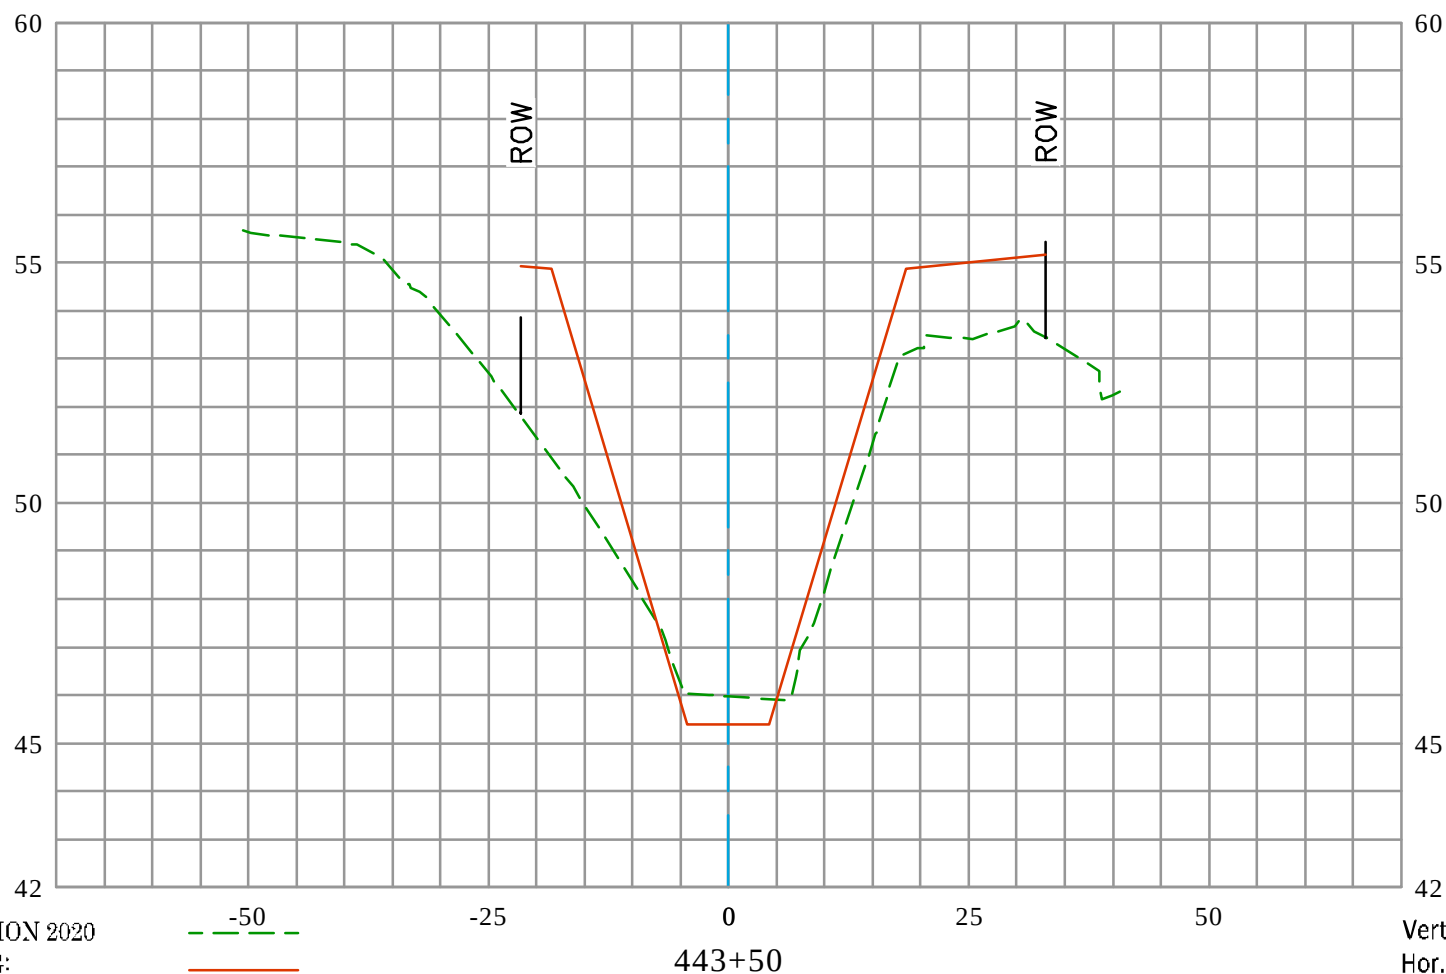


EXISTING CONDITION 2020
 RECORD DRAWING:
 D03-101-2A, D03-101-3A, & D03-101-7R
 DATE PREPARED: 01/24/2022

Vert. Scale: 1" = 4'
 Hor. Scale: 1" = 20'




GREENVILLE BANNING CHANNEL (D03) CL

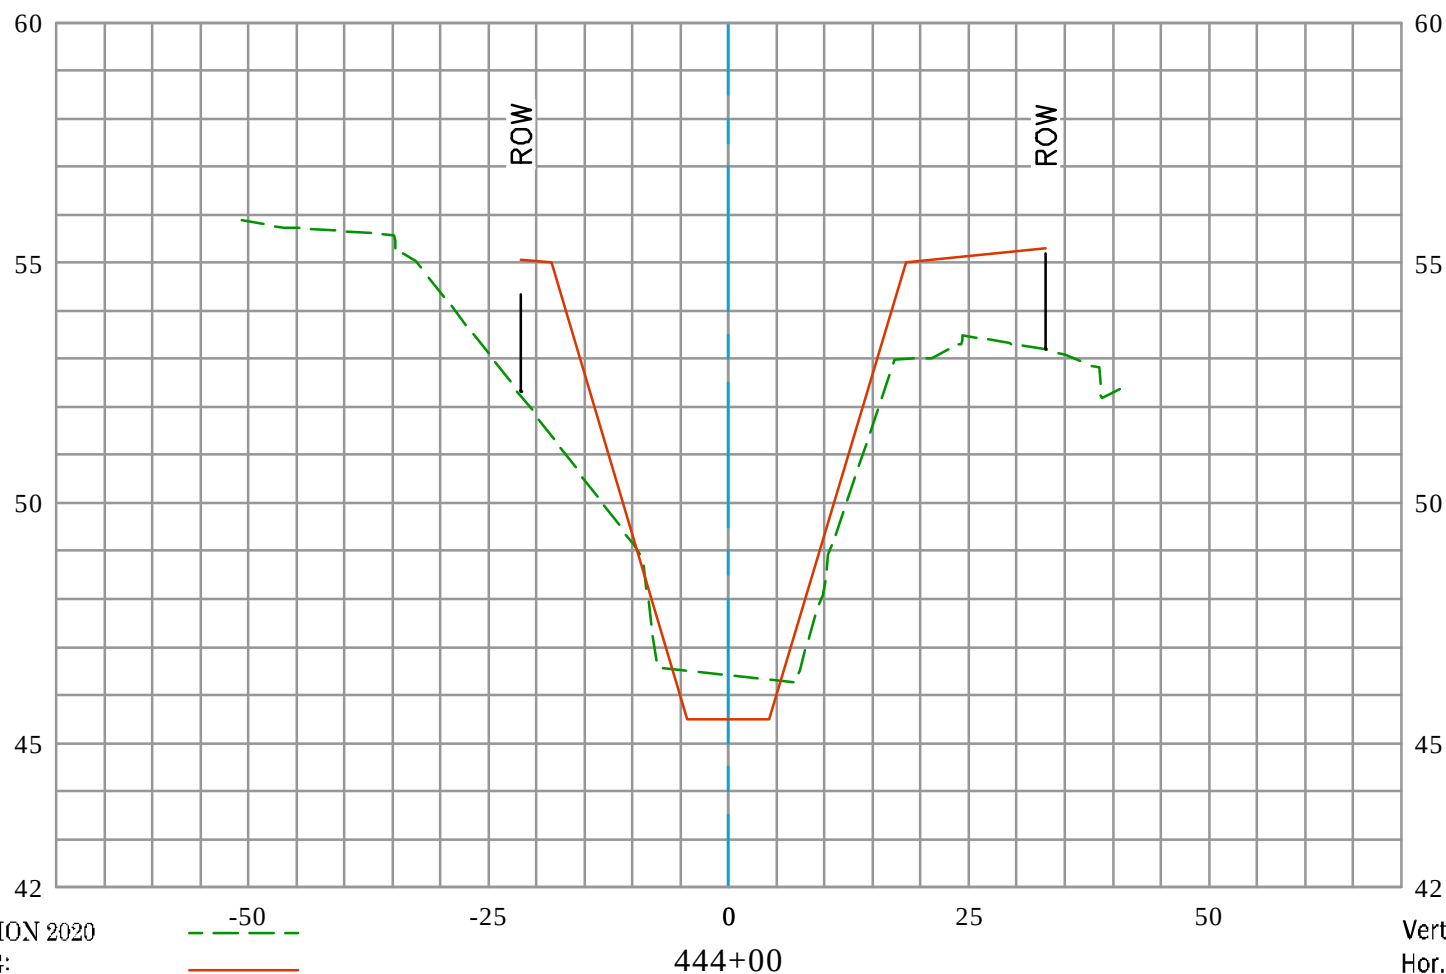

EXISTING CONDITION 2020
 RECORD DRAWING:
 D03-101-2A, D03-101-3A, & D03-101-7R
 DATE PREPARED: 01/24/2022

Vert. Scale: 1" = 4'
 Hor. Scale: 1" = 20'

GREENVILLE BANNING CHANNEL (D03) CL

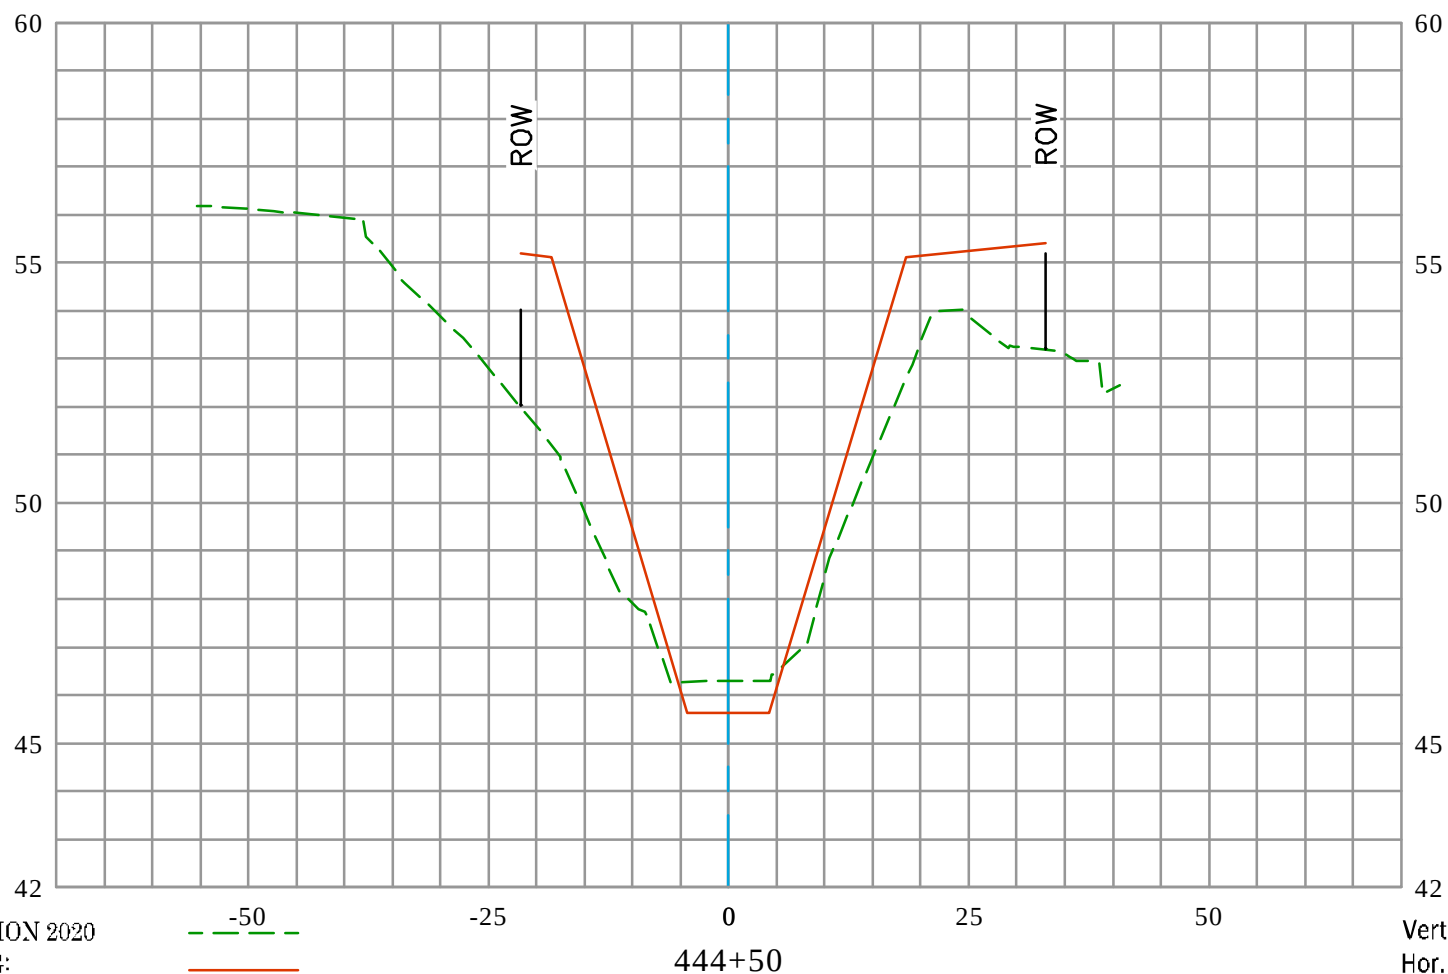


EXISTING CONDITION 2020
 RECORD DRAWING:
 D03-101-2A, D03-101-3A, & D03-101-7R
 DATE PREPARED: 01/24/2022

Vert. Scale: 1" = 4'
 Hor. Scale: 1" = 20'



GREENVILLE BANNING CHANNEL (D03) CL

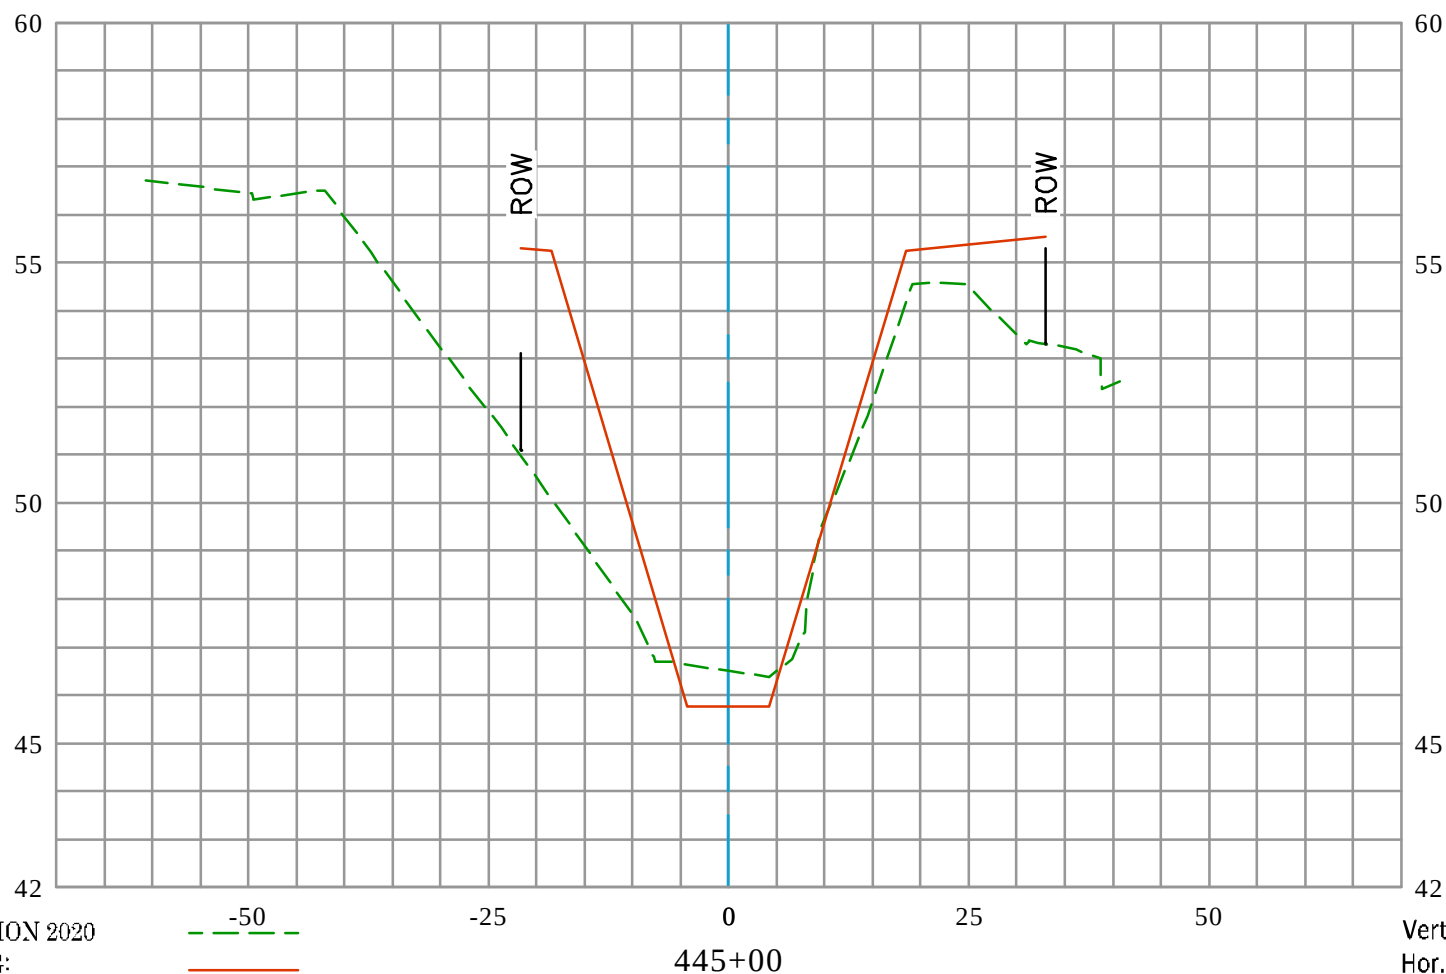


EXISTING CONDITION 2020
 RECORD DRAWING:
 D03-101-2A, D03-101-3A, & D03-101-7R
 DATE PREPARED: 01/24/2022

Vert. Scale: 1" = 4'
 Hor. Scale: 1" = 20'



GREENVILLE BANNING CHANNEL (D03) CL

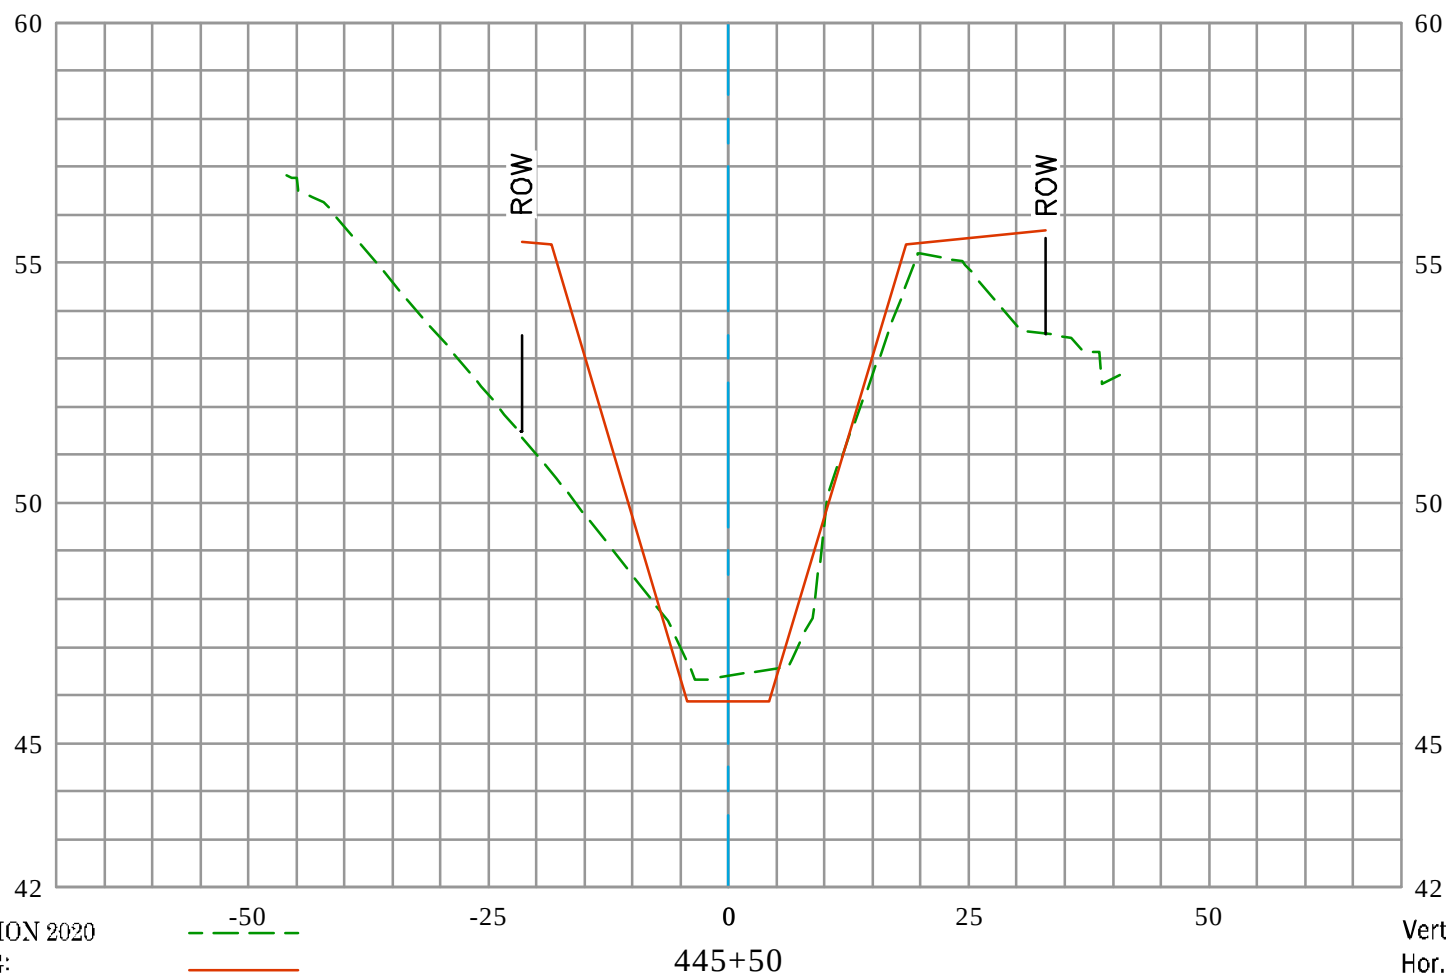


EXISTING CONDITION 2020
 RECORD DRAWING:
 D03-101-2A, D03-101-3A, & D03-101-7R
 DATE PREPARED: 01/24/2022

Vert. Scale: 1" = 4'
 Hor. Scale: 1" = 20'



GREENVILLE BANNING CHANNEL (D03) CL

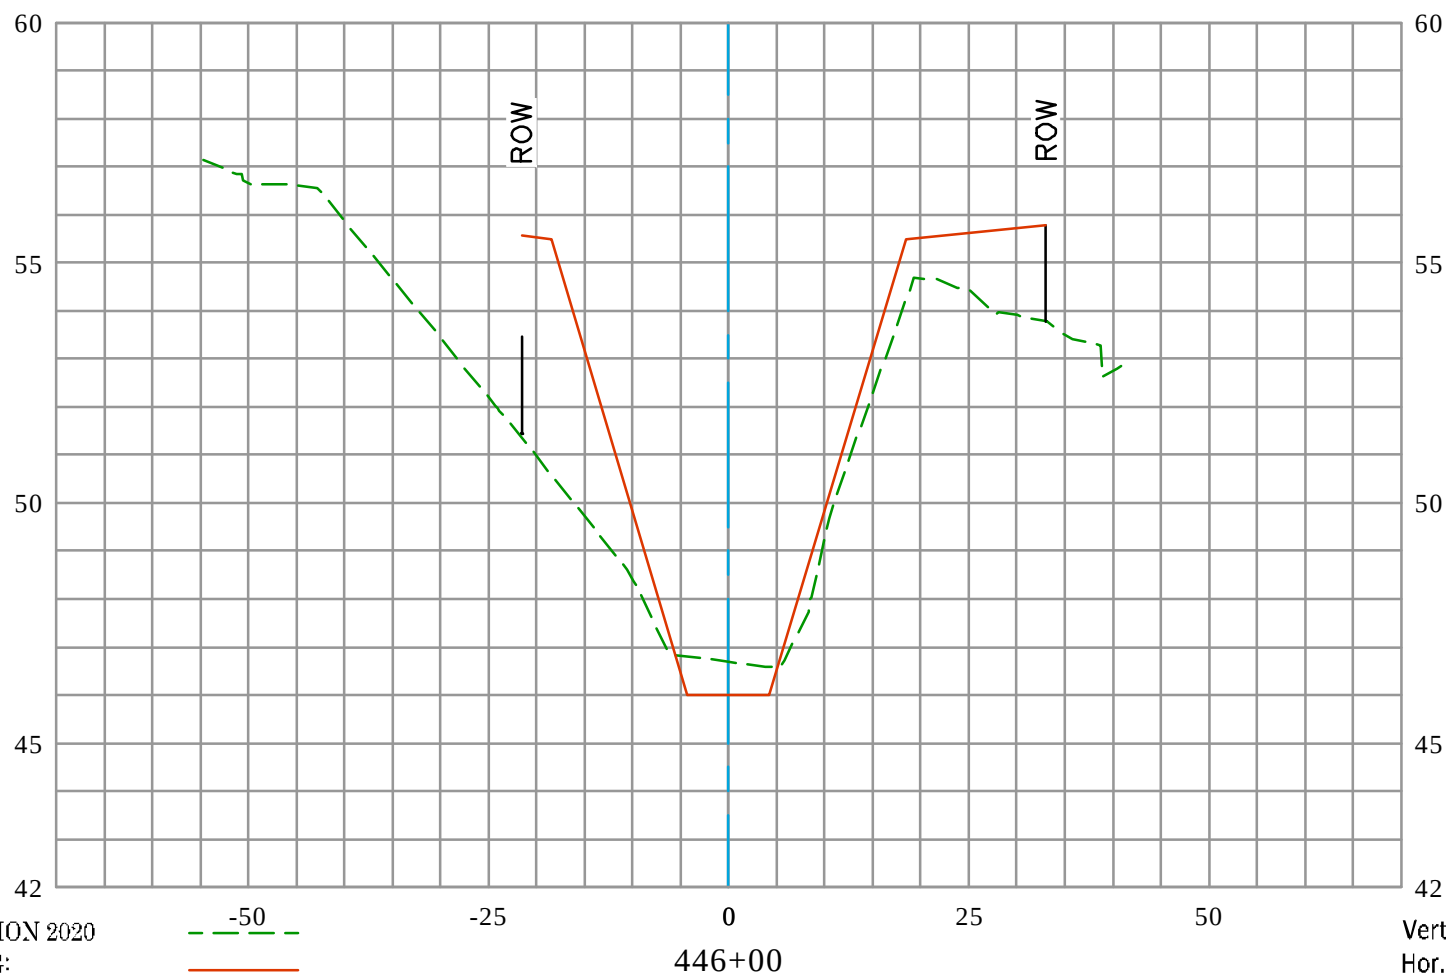


EXISTING CONDITION 2020
 RECORD DRAWING:
 D03-101-2A, D03-101-3A, & D03-101-7R
 DATE PREPARED: 01/24/2022

Vert. Scale: 1" = 4'
 Hor. Scale: 1" = 20'



GREENVILLE BANNING CHANNEL (D03) CL

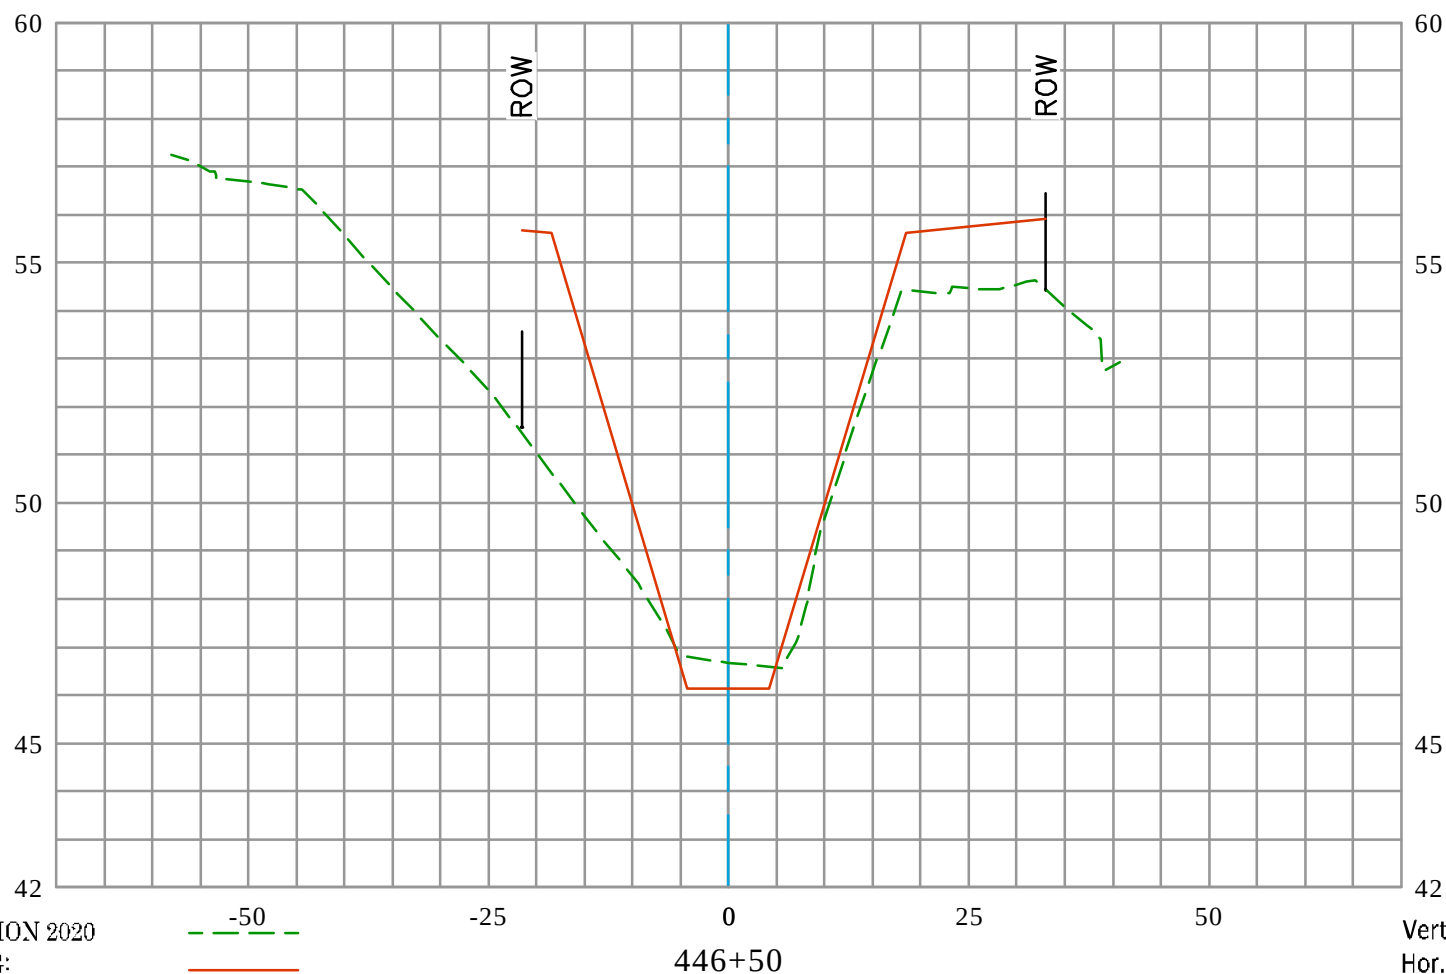


EXISTING CONDITION 2020
 RECORD DRAWING:
 D03-101-2A, D03-101-3A, & D03-101-7R
 DATE PREPARED: 01/24/2022

Vert. Scale: 1" = 4'
 Hor. Scale: 1" = 20'




GREENVILLE BANNING CHANNEL (D03) CL

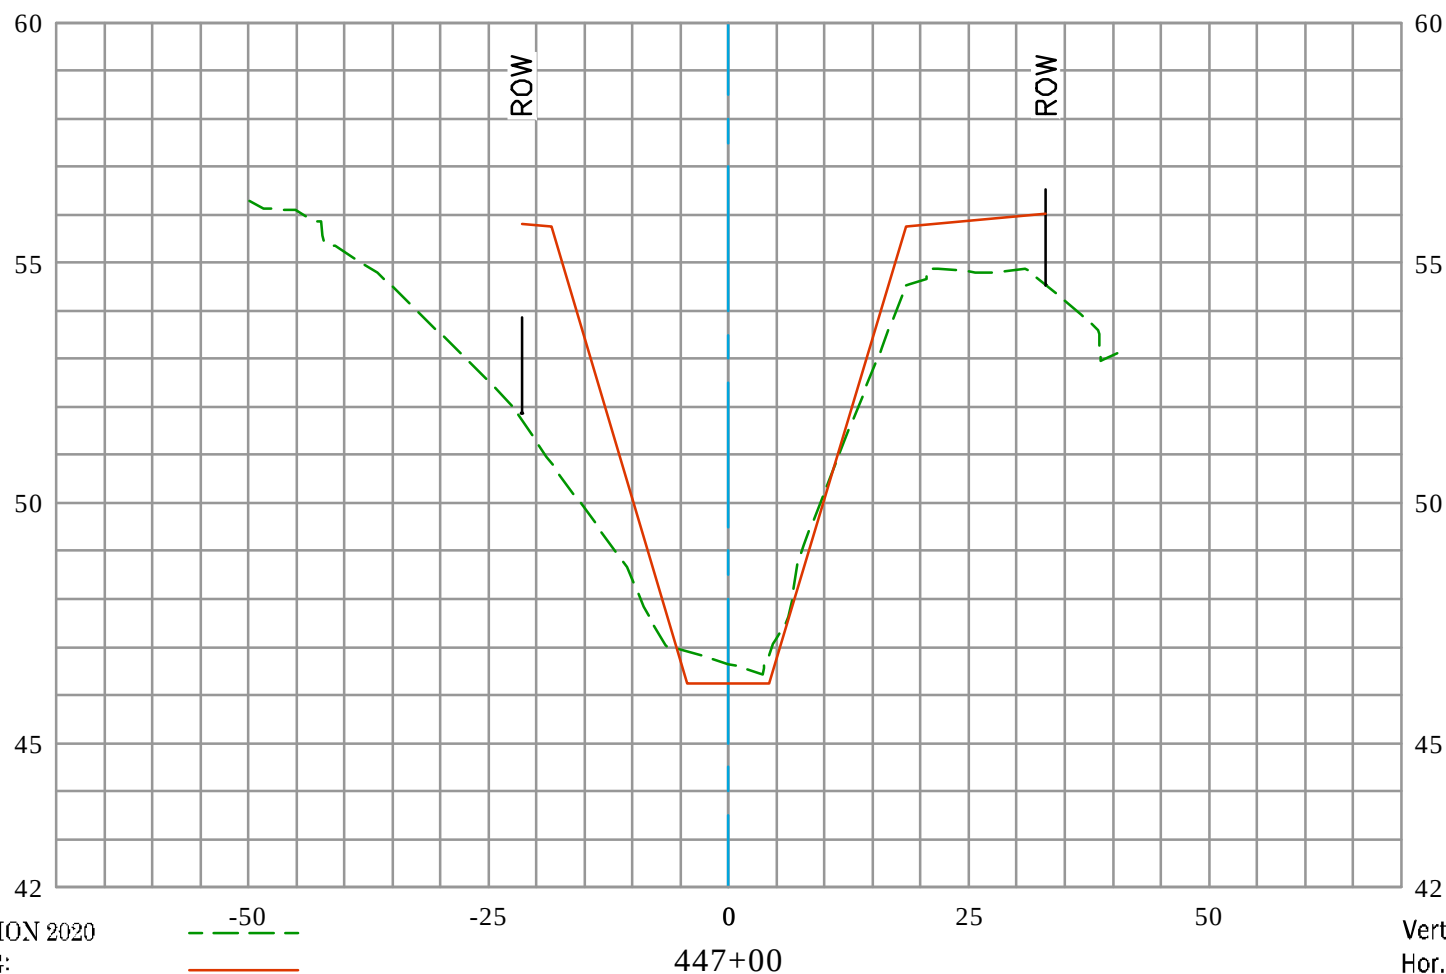

EXISTING CONDITION 2020
 RECORD DRAWING:
 D03-101-2A, D03-101-3A, & D03-101-7R
 DATE PREPARED: 01/24/2022



GREENVILLE BANNING CHANNEL (D03) CL

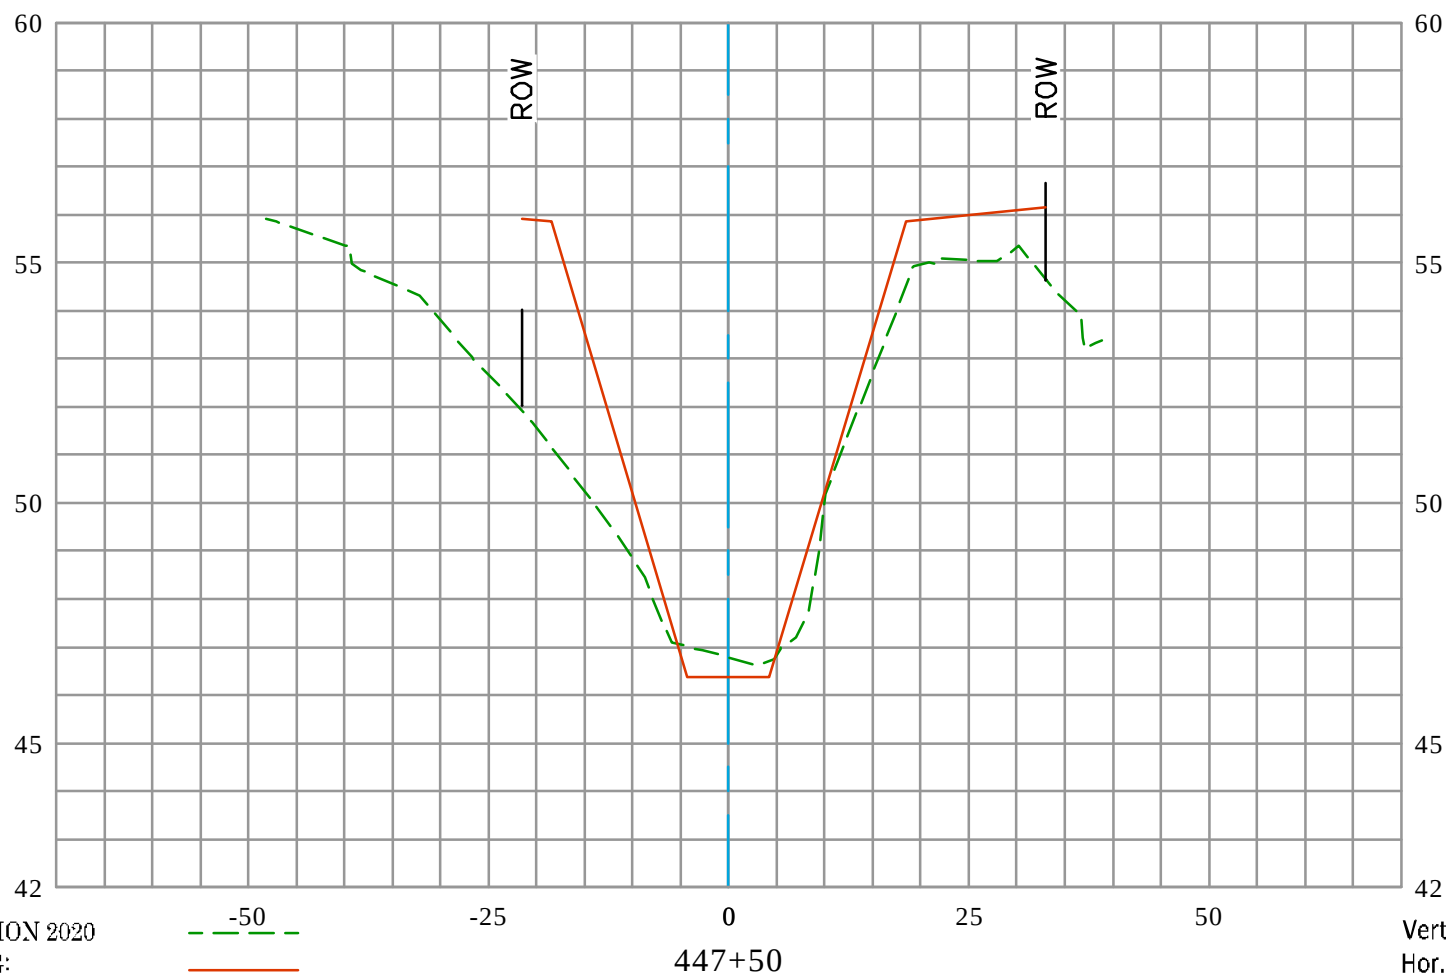


EXISTING CONDITION 2020
 RECORD DRAWING:
 D03-101-2A, D03-101-3A, & D03-101-7R
 DATE PREPARED: 01/24/2022

Vert. Scale: 1" = 4'
 Hor. Scale: 1" = 20'




GREENVILLE BANNING CHANNEL (D03) CL

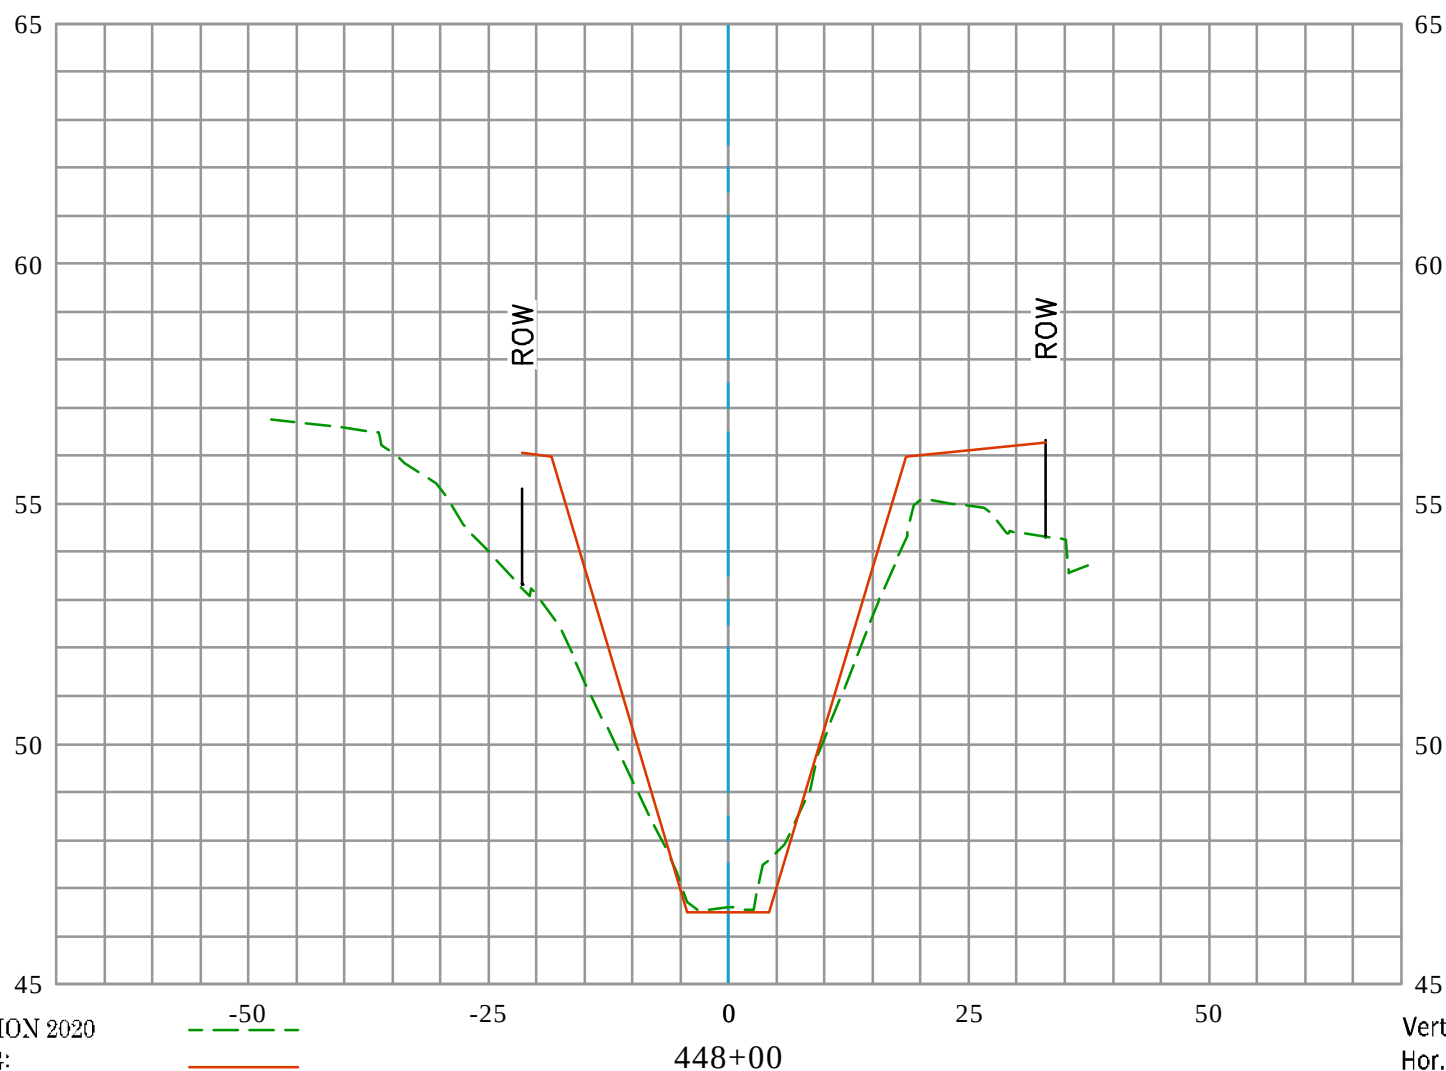

EXISTING CONDITION 2020
 RECORD DRAWING:
 D03-101-2A, D03-101-3A, & D03-101-7R
 DATE PREPARED: 01/24/2022



GREENVILLE BANNING CHANNEL (D03) CL

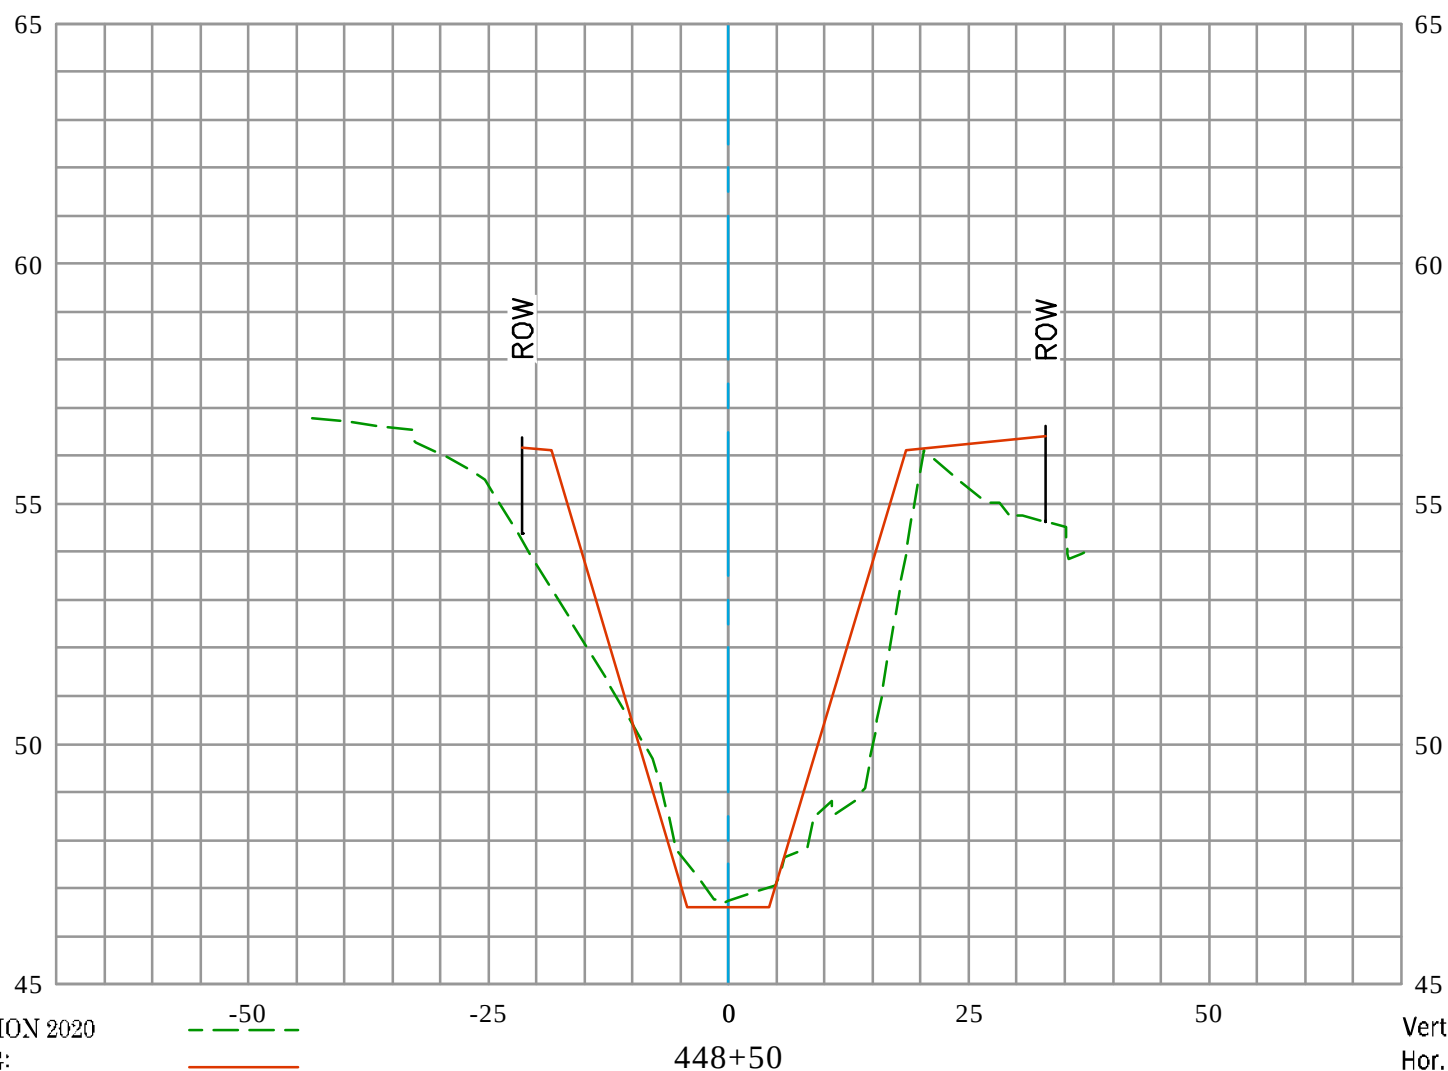


EXISTING CONDITION 2020
 RECORD DRAWING:
 D03-101-2A, D03-101-3A, & D03-101-7R
 DATE PREPARED: 01/24/2022

Vert. Scale: 1" = 4'
 Hor. Scale: 1" = 20'



GREENVILLE BANNING CHANNEL (D03) CL

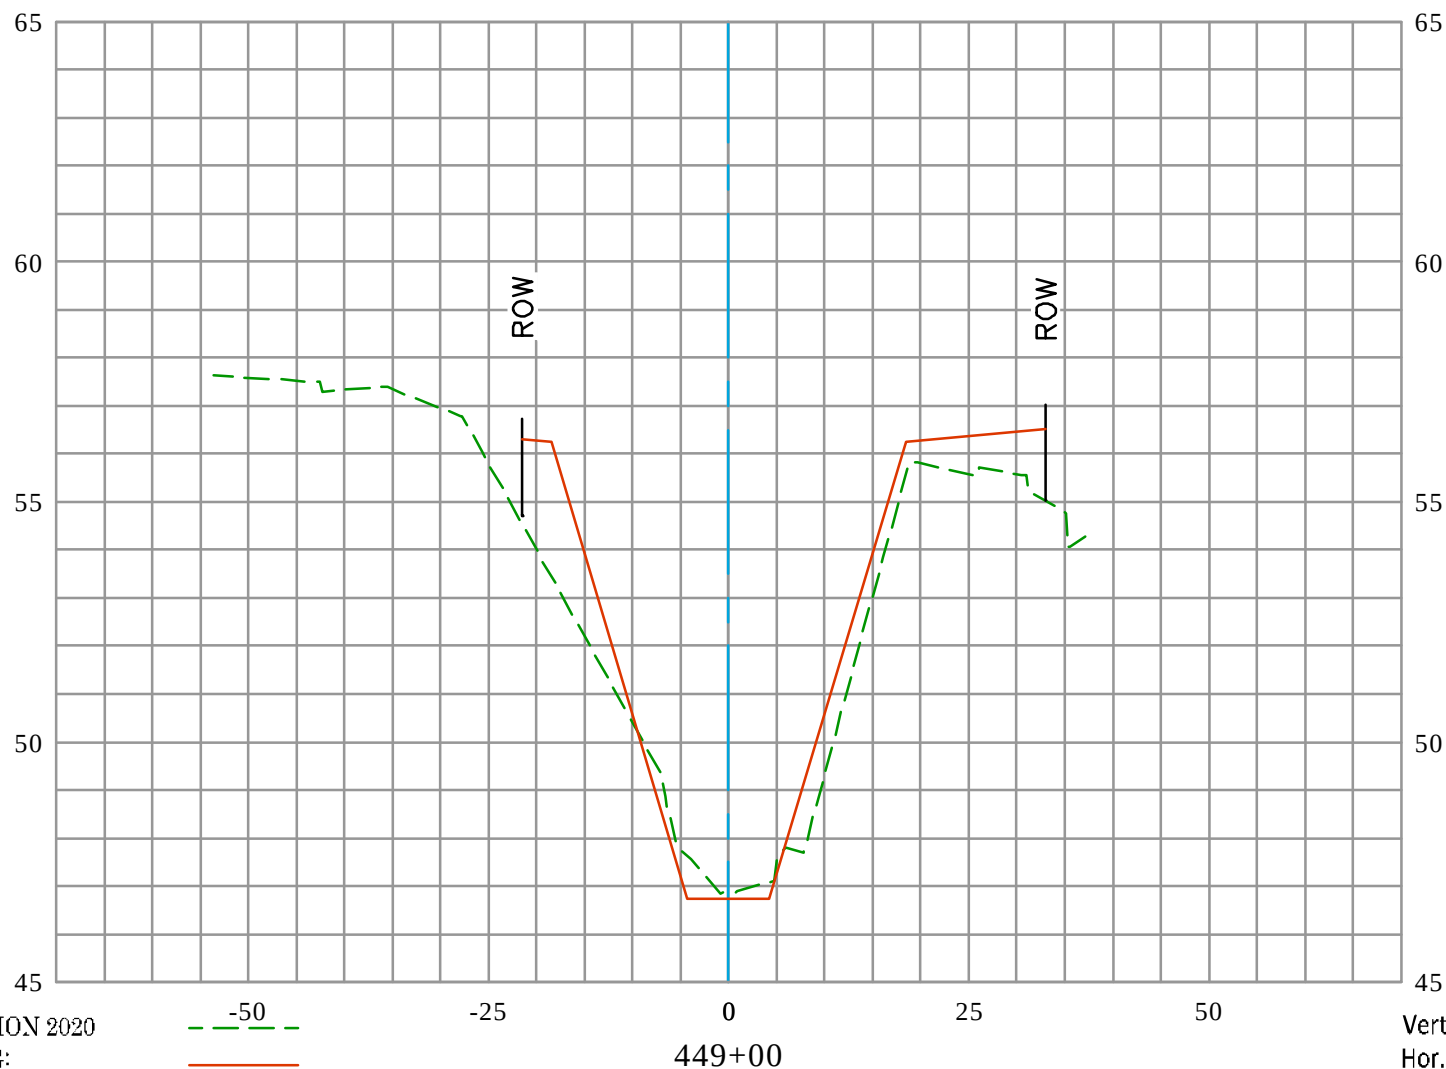


EXISTING CONDITION 2020
 RECORD DRAWING:
 D03-101-2A, D03-101-3A, & D03-101-7R
 DATE PREPARED: 01/24/2022

Vert. Scale: 1" = 4'
 Hor. Scale: 1" = 20'



GREENVILLE BANNING CHANNEL (D03) CL

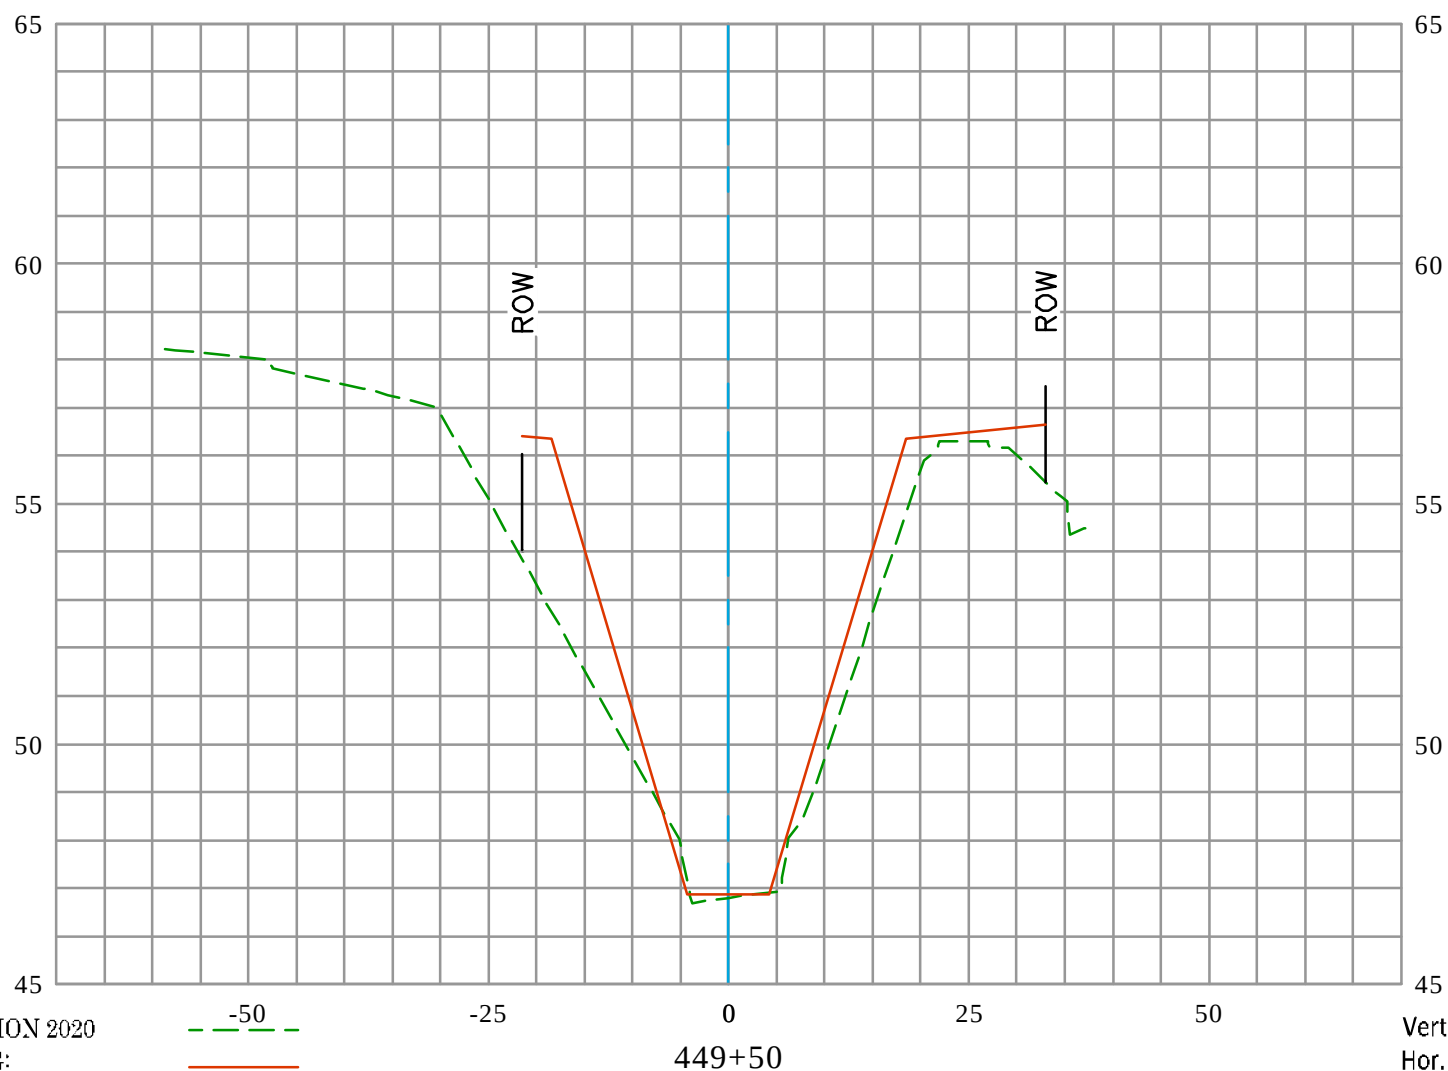


EXISTING CONDITION 2020
 RECORD DRAWING:
 D03-101-2A, D03-101-3A, & D03-101-7R
 DATE PREPARED: 01/24/2022

Vert. Scale: 1" = 4'
 Hor. Scale: 1" = 20'



GREENVILLE BANNING CHANNEL (D03) CL

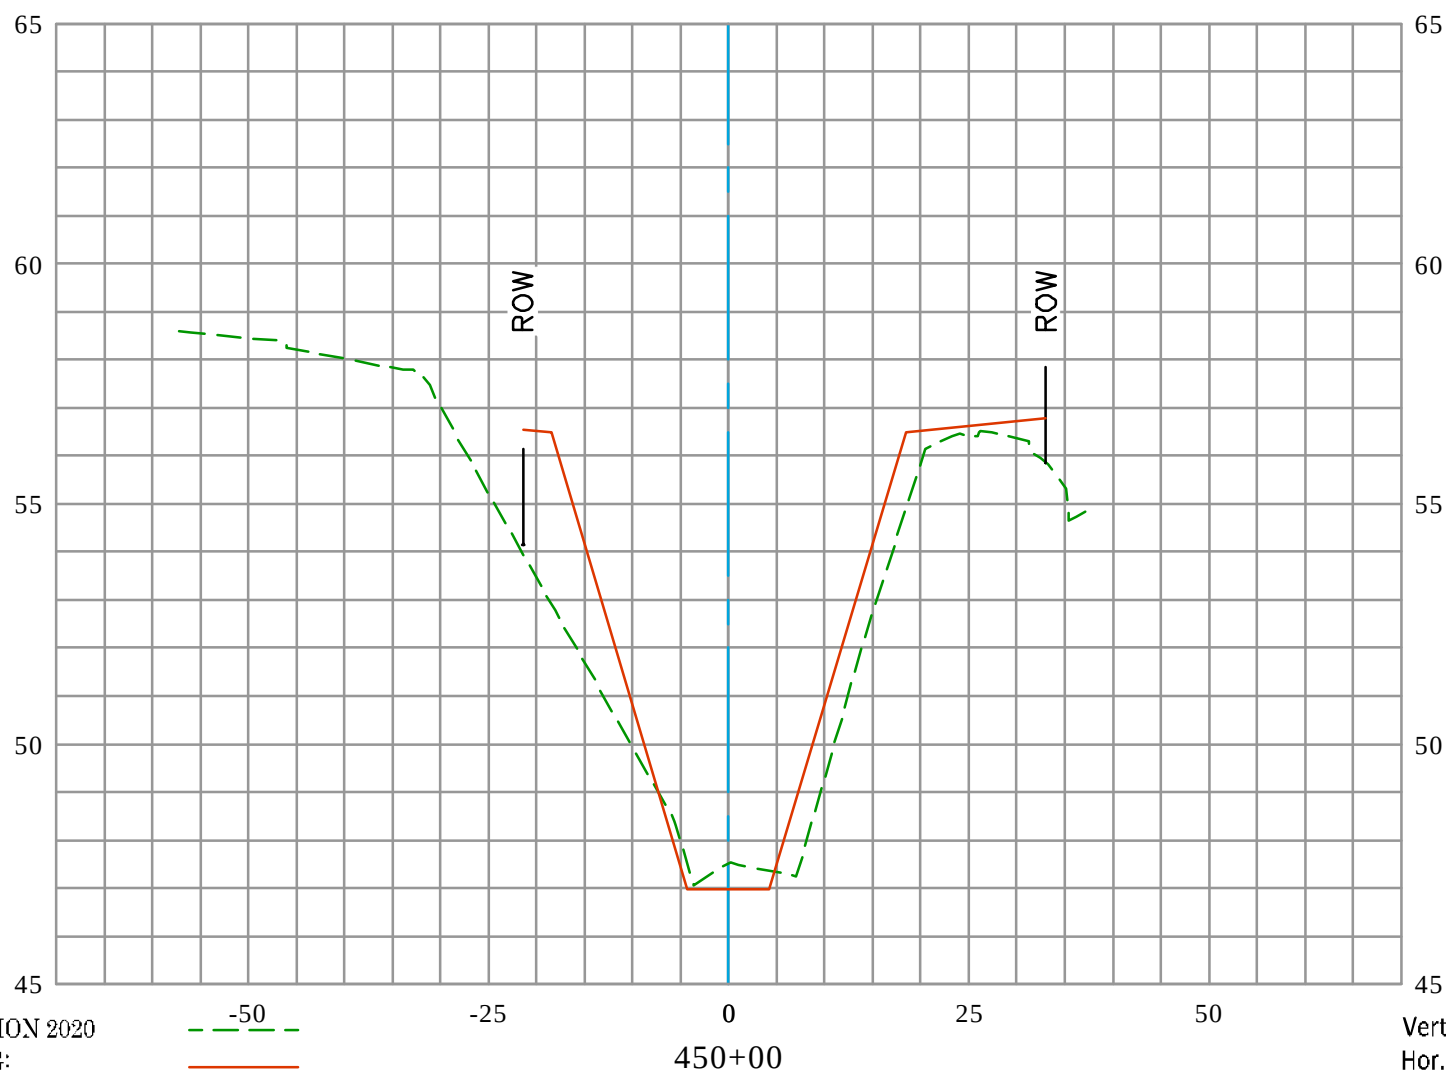


EXISTING CONDITION 2020
 RECORD DRAWING:
 D03-101-2A, D03-101-3A, & D03-101-7R
 DATE PREPARED: 01/24/2022

Vert. Scale: 1" = 4'
 Hor. Scale: 1" = 20'



GREENVILLE BANNING CHANNEL (D03) CL

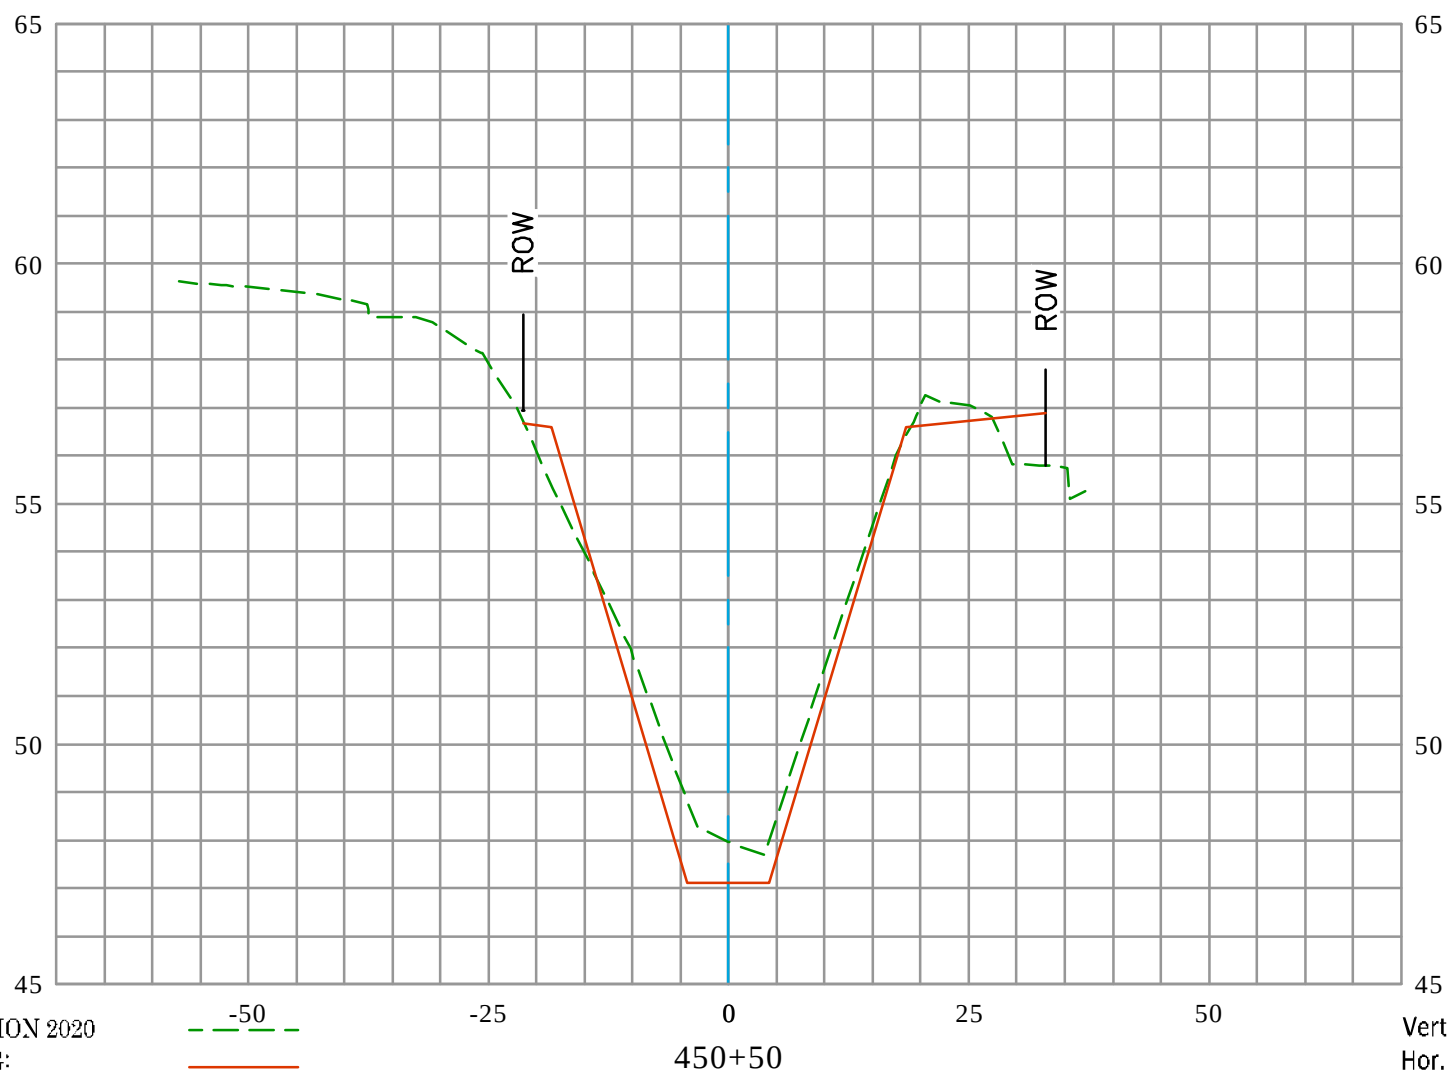


EXISTING CONDITION 2020
RECORD DRAWING:
D03-101-2A, D03-101-3A, & D03-101-7R
DATE PREPARED: 01/24/2022

Vert. Scale: 1" = 4'
Hor. Scale: 1" = 20'



GREENVILLE BANNING CHANNEL (D03) CL

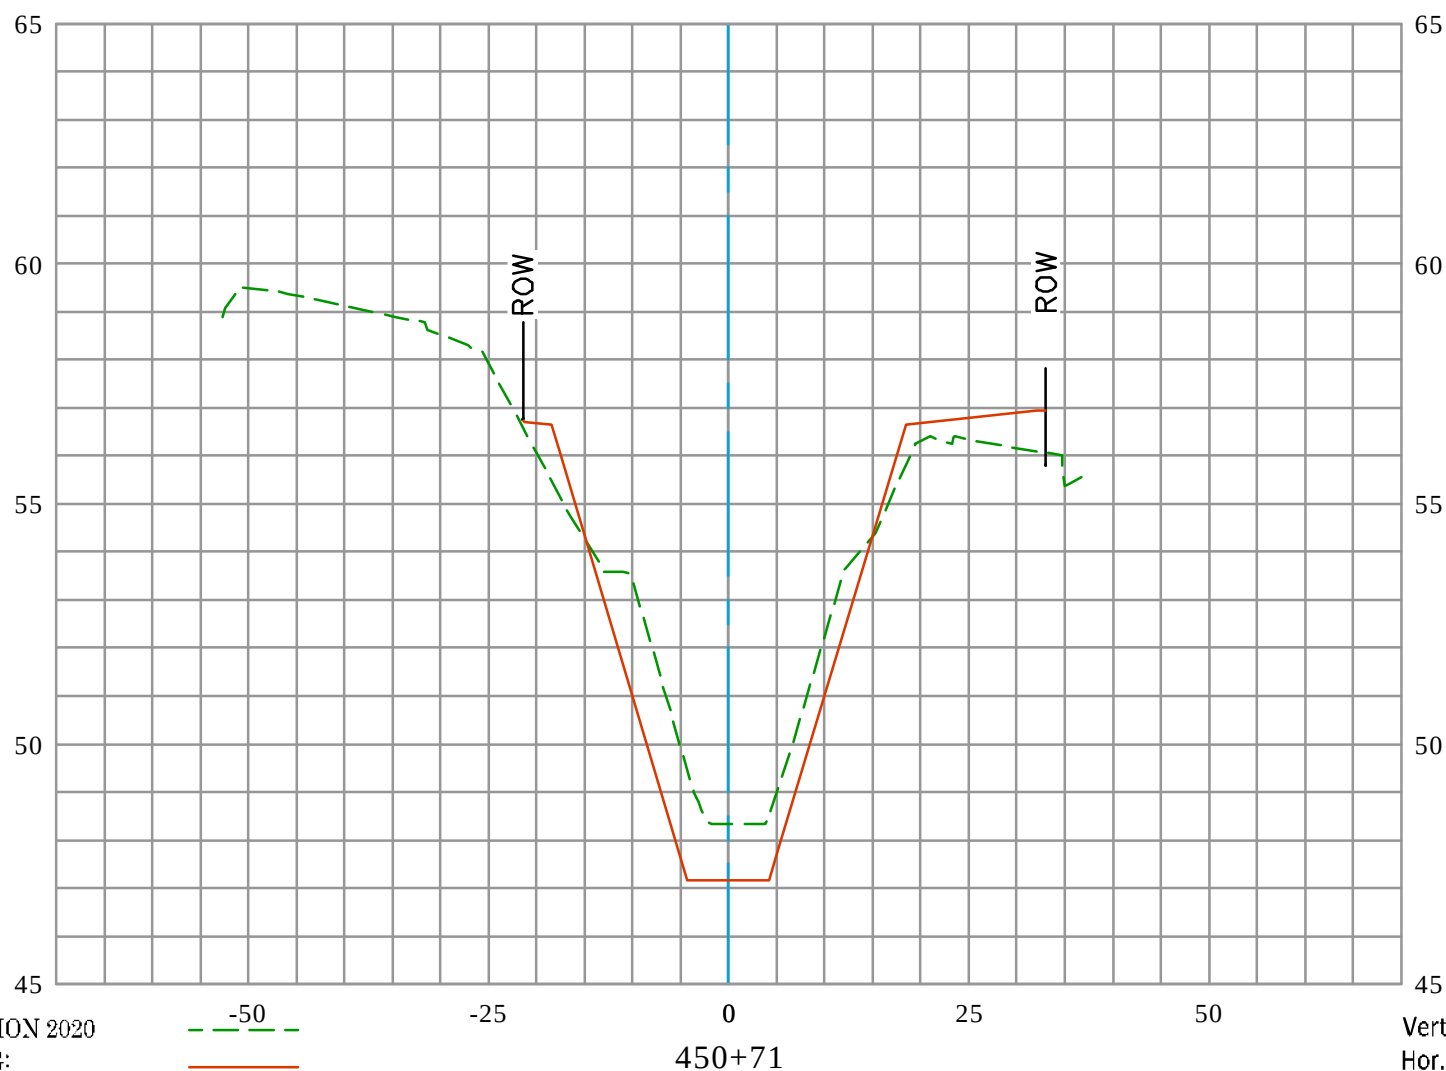

EXISTING CONDITION 2020
 RECORD DRAWING:
 D03-101-2A, D03-101-3A, & D03-101-7R
 DATE PREPARED: 01/24/2022

Vert. Scale: 1" = 4'
 Hor. Scale: 1" = 20'