
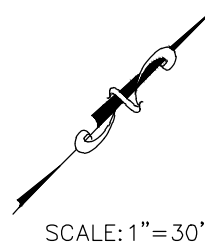


GATE 13

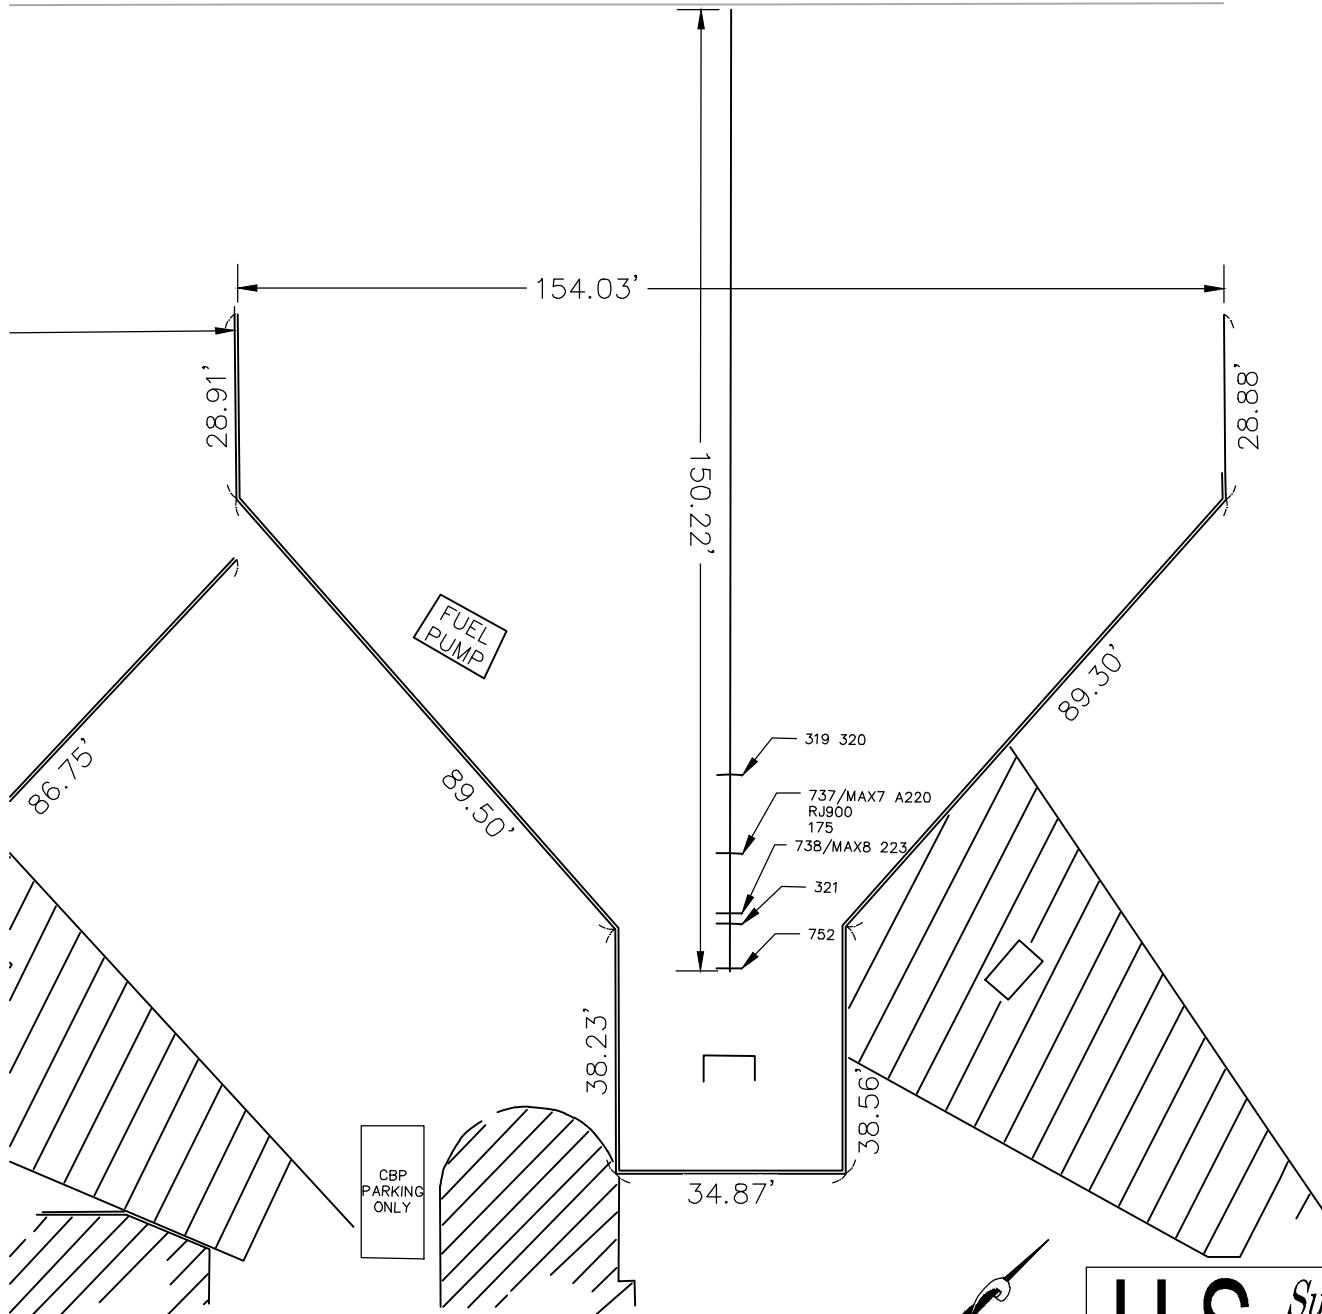

U.S. Survey Foot

OC Public Works
OC Survey/Field Services
Boundary Analysis & Mapping

EXHIBIT A

COUNTY OF ORANGE
OC PUBLIC WORKS/OC SURVEY/FIELD SERVICES

JWA GATE 13 APRON MARKINGS

NOTES:


MEASUREMENTS WERE CAPTURED PRECISELY AT THE CENTERLINE OF THE STRIPING. IN INSTANCES WHERE A RED AND YELLOW STRIPE CONFIGURATION WAS PRESENT, WE PERFORMED AN OFFSET OF THE RED LINE TO ACCURATELY DELINEATE ITS POSITION

DATE	04/15/2024
DRAWN BY:	K. MARTINEZ, LSIT
CHECKED BY:	E. MEDINA, PLS
W.O. # EC28869	FILE NO.




SHEET 1 OF 1


GATE 14

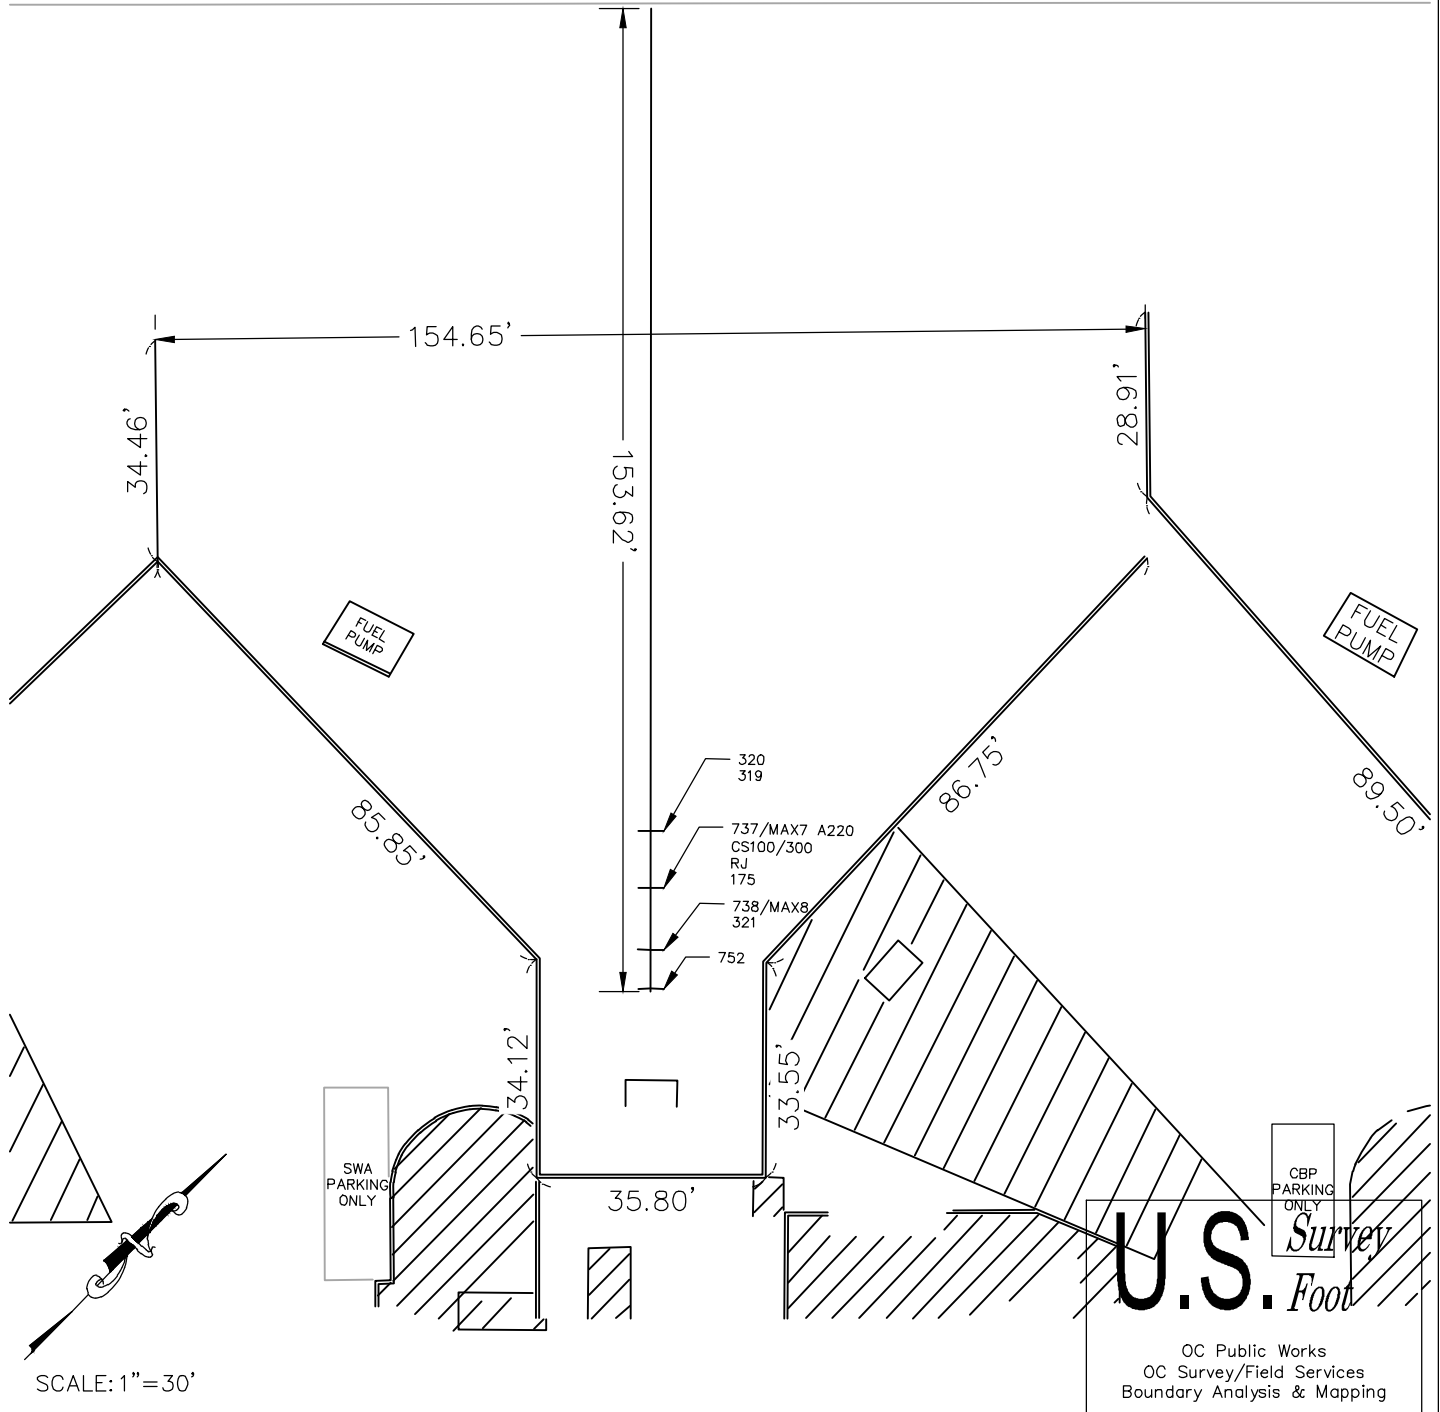

U.S. Survey Foot
 OC Public Works
 OC Survey/Field Services
 Boundary Analysis & Mapping

EXHIBIT A		COUNTY OF ORANGE OC PUBLIC WORKS/OC SURVEY/FIELD SERVICES		
NOTES:		JWA GATE 14 APRON MARKINGS		
MEASUREMENTS WERE CAPTURED PRECISELY AT THE CENTERLINE OF THE STRIPING. IN INSTANCES WHERE A RED AND YELLOW STRIPE CONFIGURATION WAS PRESENT, WE PERFORMED AN OFFSET OF THE RED LINE TO ACCURATELY DELINEATE ITS POSITION		DATE	04/15/2024	
		DRAWN BY:	K. MARTINEZ, LSIT	
		CHECKED BY:	E. MEDINA, PLS	
		W.O. # EC28869	FILE NO.	
				SHEET 1 OF 1


GATE 15

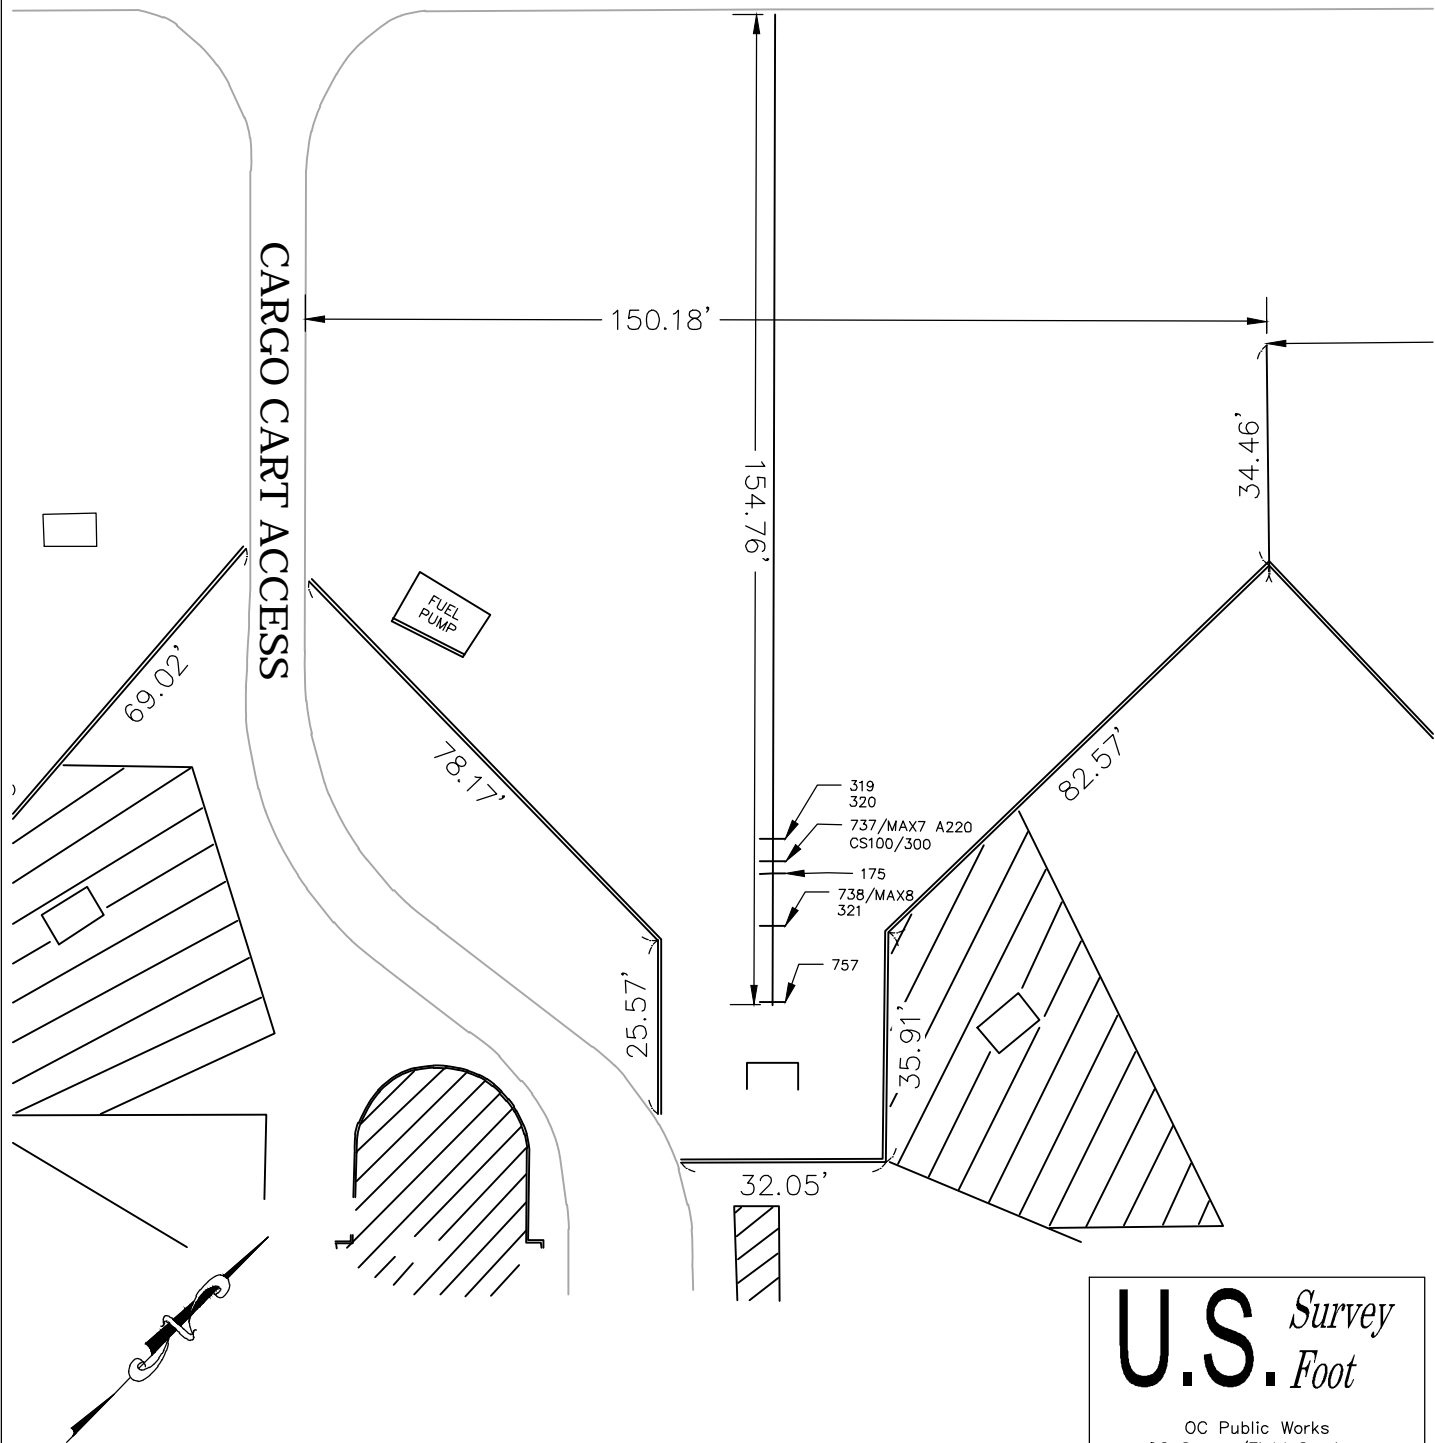

SCALE: 1"=30'

U.S. Survey
Foot

OC Public Works
OC Survey/Field Services
Boundary Analysis & Mapping

EXHIBIT A		COUNTY OF ORANGE OC PUBLIC WORKS/OC SURVEY/FIELD SERVICES		
NOTES: MEASUREMENTS WERE CAPTURED PRECISELY AT THE CENTERLINE OF THE STRIPING. IN INSTANCES WHERE A RED AND YELLOW STRIPE CONFIGURATION WAS PRESENT, WE PERFORMED AN OFFSET OF THE RED LINE TO ACCURATELY DELINEATE ITS POSITION	JWA GATE 15 APRON MARKINGS			
	DATE	04/15/2024		
	DRAWN BY:	K. MARTINEZ, LSIT		
	CHECKED BY:	E. MEDINA, PLS		
	W.O. # EC28869	FILE NO.	SHEET 1 OF 1	

GATE 16

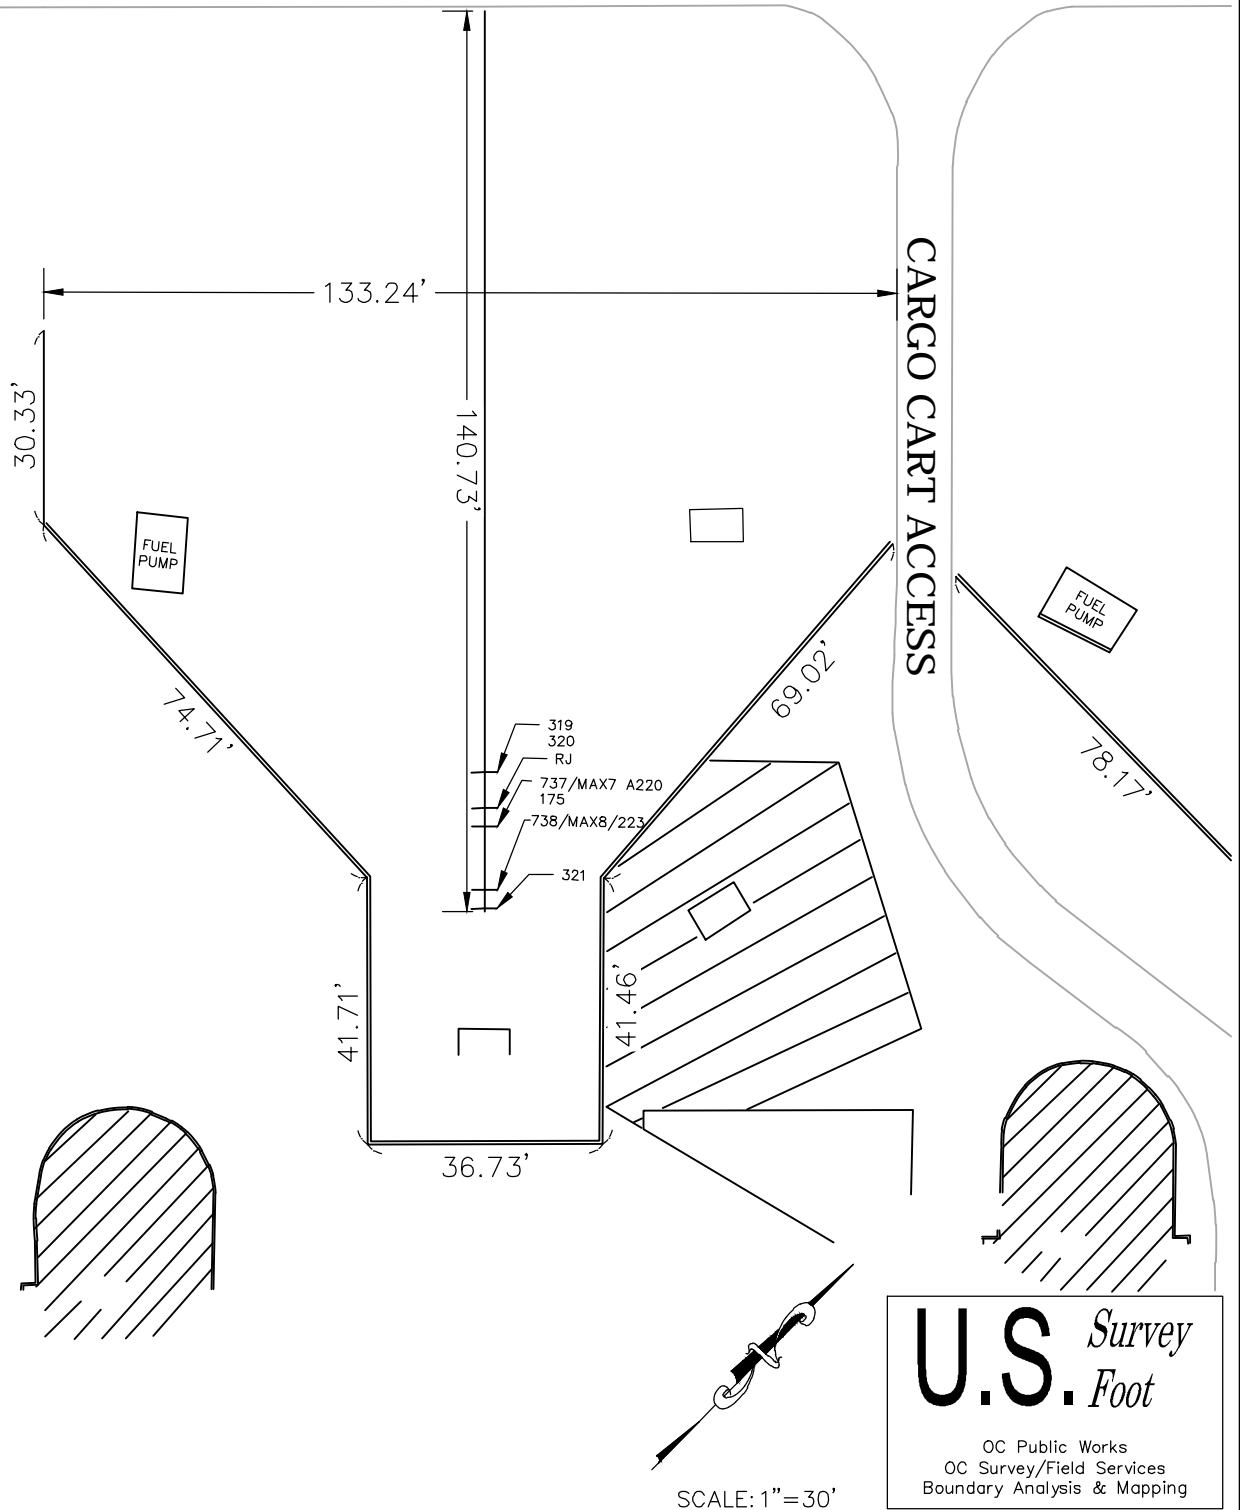


EXHIBIT A

COUNTY OF ORANGE
OC PUBLIC WORKS/OC SURVEY/FIELD SERVICES

JWA GATE 16 APRON MARKINGS

NOTES:


MEASUREMENTS WERE CAPTURED PRECISELY AT THE CENTERLINE OF THE STRIPING. IN INSTANCES WHERE A RED AND YELLOW STRIPE CONFIGURATION WAS PRESENT, WE PERFORMED AN OFFSET OF THE RED LINE TO ACCURATELY DELINEATE ITS POSITION

DATE	04/15/2024
DRAWN BY:	K. MARTINEZ, LSIT
CHECKED BY:	E. MEDINA, PLS
W.O. # EC28869	FILE NO.



SHEET 1 OF 1

GATE 18

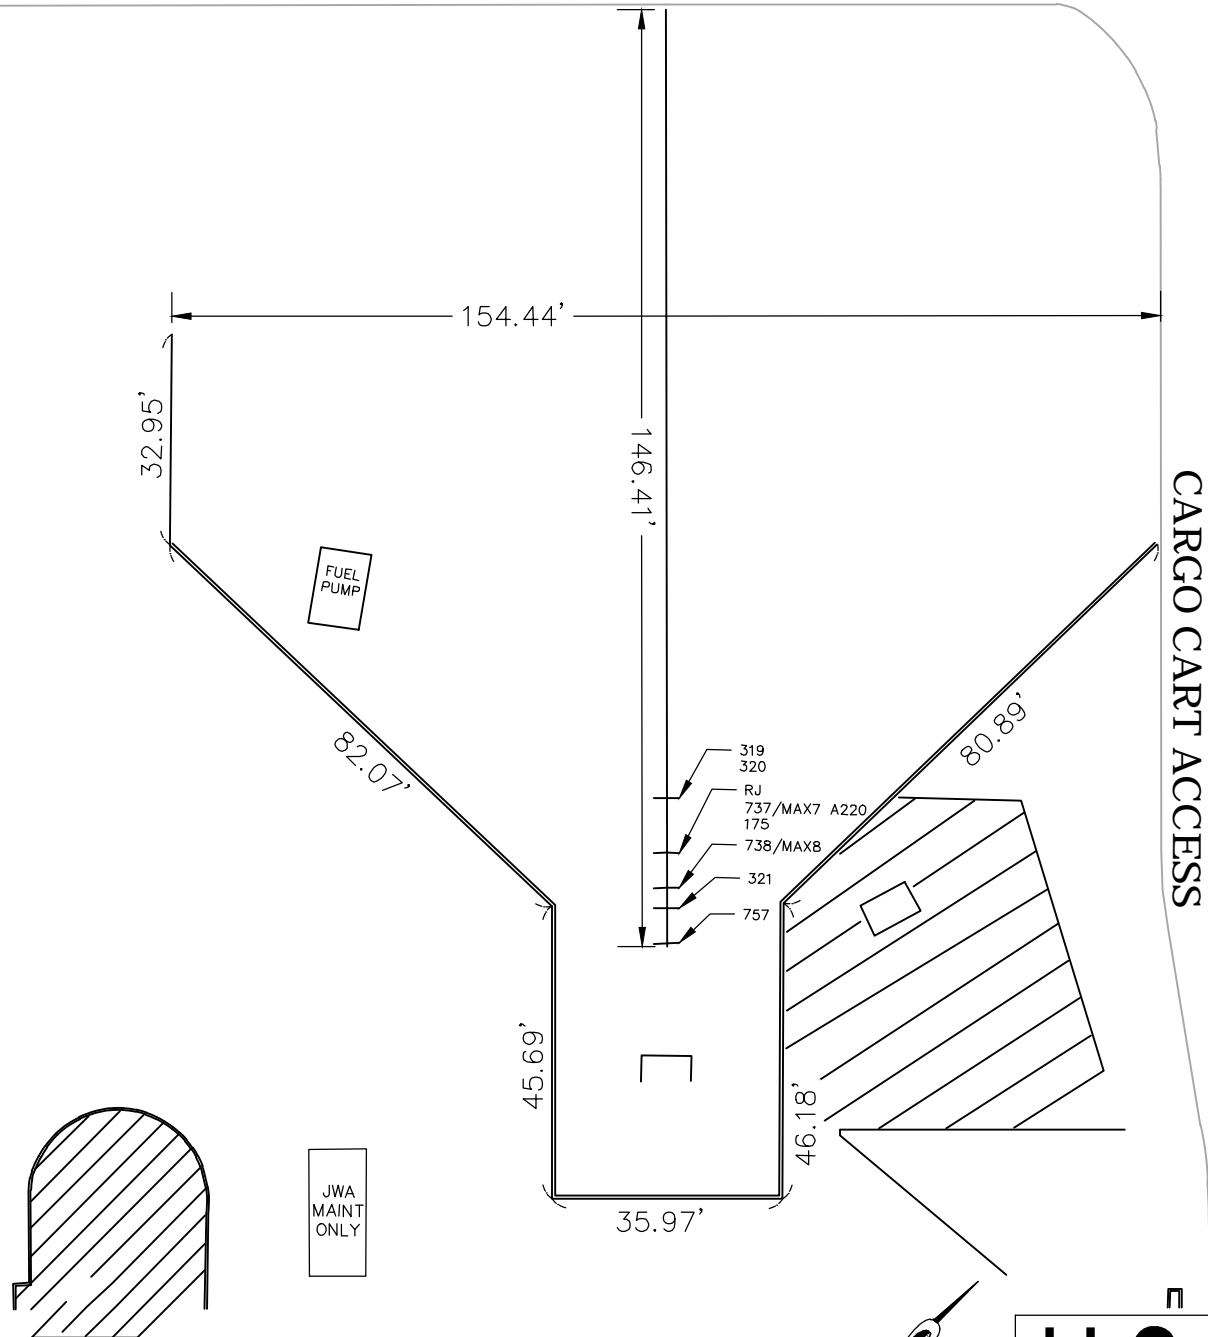

U.S. Survey Foot

OC Public Works
OC Survey/Field Services
Boundary Analysis & Mapping

SCALE: 1"=30'

EXHIBIT A

COUNTY OF ORANGE
OC PUBLIC WORKS/OC SURVEY/FIELD SERVICES

JWA GATE 18 APRON MARKINGS

NOTES:


MEASUREMENTS WERE CAPTURED PRECISELY AT THE CENTERLINE OF THE STRIPING. IN INSTANCES WHERE A RED AND YELLOW STRIPE CONFIGURATION WAS PRESENT, WE PERFORMED AN OFFSET OF THE RED LINE TO ACCURATELY DELINEATE ITS POSITION

DATE	04/15/2024
DRAWN BY:	K. MARTINEZ, LSIT
CHECKED BY:	E. MEDINA, PLS
W.O. # EC28869	FILE NO.



SHEET 1 OF 1

GATE 21

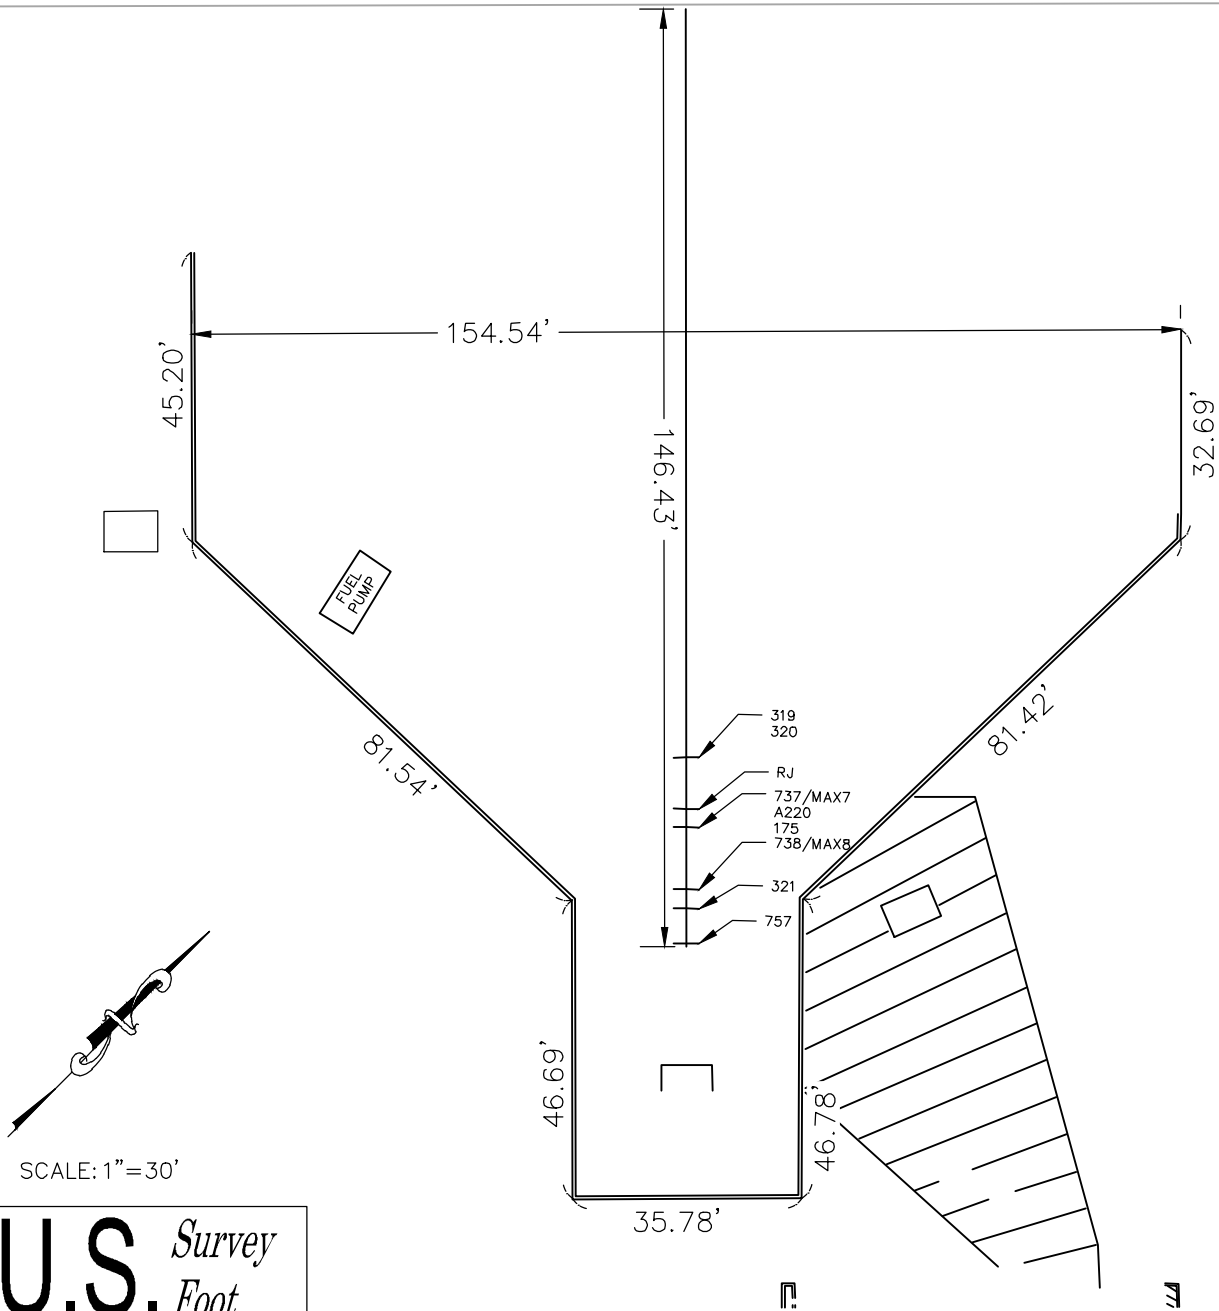

SCALE: 1"=30'

U.S. Survey Foot

OC Public Works
OC Survey/Field Services
Boundary Analysis & Mapping

EXHIBIT A

COUNTY OF ORANGE
OC PUBLIC WORKS/OC SURVEY/FIELD SERVICES

JWA GATE 21 APRON MARKINGS

NOTES:

MEASUREMENTS WERE CAPTURED PRECISELY AT THE CENTERLINE OF THE STRIPING. IN INSTANCES WHERE A RED AND YELLOW STRIPE CONFIGURATION WAS PRESENT, WE PERFORMED AN OFFSET OF THE RED LINE TO ACCURATELY DELINEATE ITS POSITION

DATE	04/15/2024
DRAWN BY:	K. MARTINEZ, LSIT
CHECKED BY:	E. MEDINA, PLS
W.O. # EC28869	FILE NO.



SHEET 1 OF 1