

BASIS OF BEARINGS

THE BASIS OF BEARINGS FOR THIS SURVEY IS BASED ON THE CALIFORNIA COORDINATE SYSTEM (CCS83), ZONE VI, NAD 83, OCS (1991.35) EPOCH ADJUSTMENT, AS DETERMINED LOCALLY BY A LINE BETWEEN CONTROL POINTS KR422 AND KR429 DERIVED FROM THE COORDINATES PROVIDED BY AND ON FILE WITH JWA SURVEY DATED 05-17-2022

HORIZONTAL AND VERTICAL DATUM

COORDINATES SHOWN ARE BASED ON THE CALIFORNIA COORDINATE SYSTEM (CCS83), ZONE VI, NAD 83, OCS (1991.35) EPOCH ADJUSTMENT.

VERTICAL DATUM: ASSUMED AS SHOWN HEREON.

ALL DISTANCES ARE BASED ON THE U.S. SURVEY FOOT.

NOTES

THE TIN SURFACE WITHIN THIS DATA SET HAS BEEN CREATED FROM TERRESTRIAL LASER SCANNING METHODS AND IT SHOULD BE CONSIDERED RELATIVE FOR THE SPECIFIC PURPOSE OF THIS CONTOUR MAP.




PURPOSE OF SURVEY

THE PURPOSE OF THE SURVEY IS TO PROVIDE A RELATIVE TOPOGRAPHIC MAP FOR CONCRETE SLOPE ANALYSIS FOR A PORTION OF PARKING STRUCTURE LEVEL 0 IN FRONT OF THE NEW ALAMO RENTAL KIOSK, AS SHOWN ON ARCHITECTURE DRAWING PLAN NO. 41021-J117

LEGEND

LINE PATTERN KEY

- Edge of Concrete
- Striping

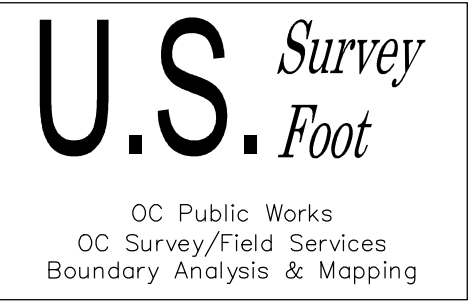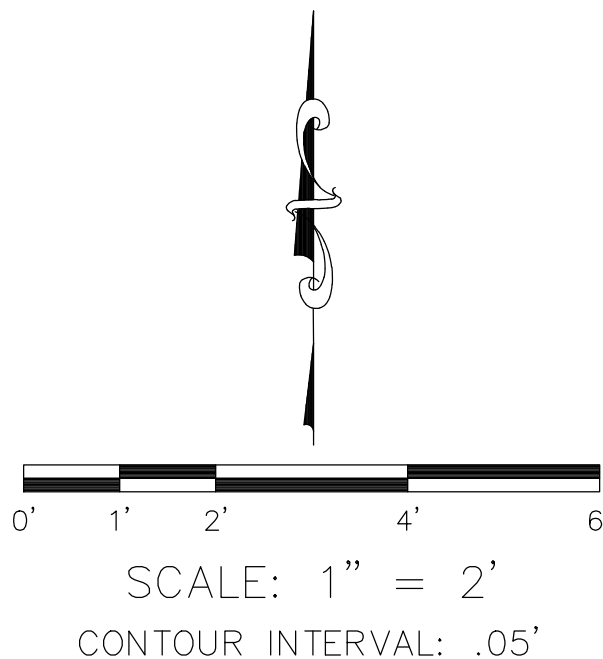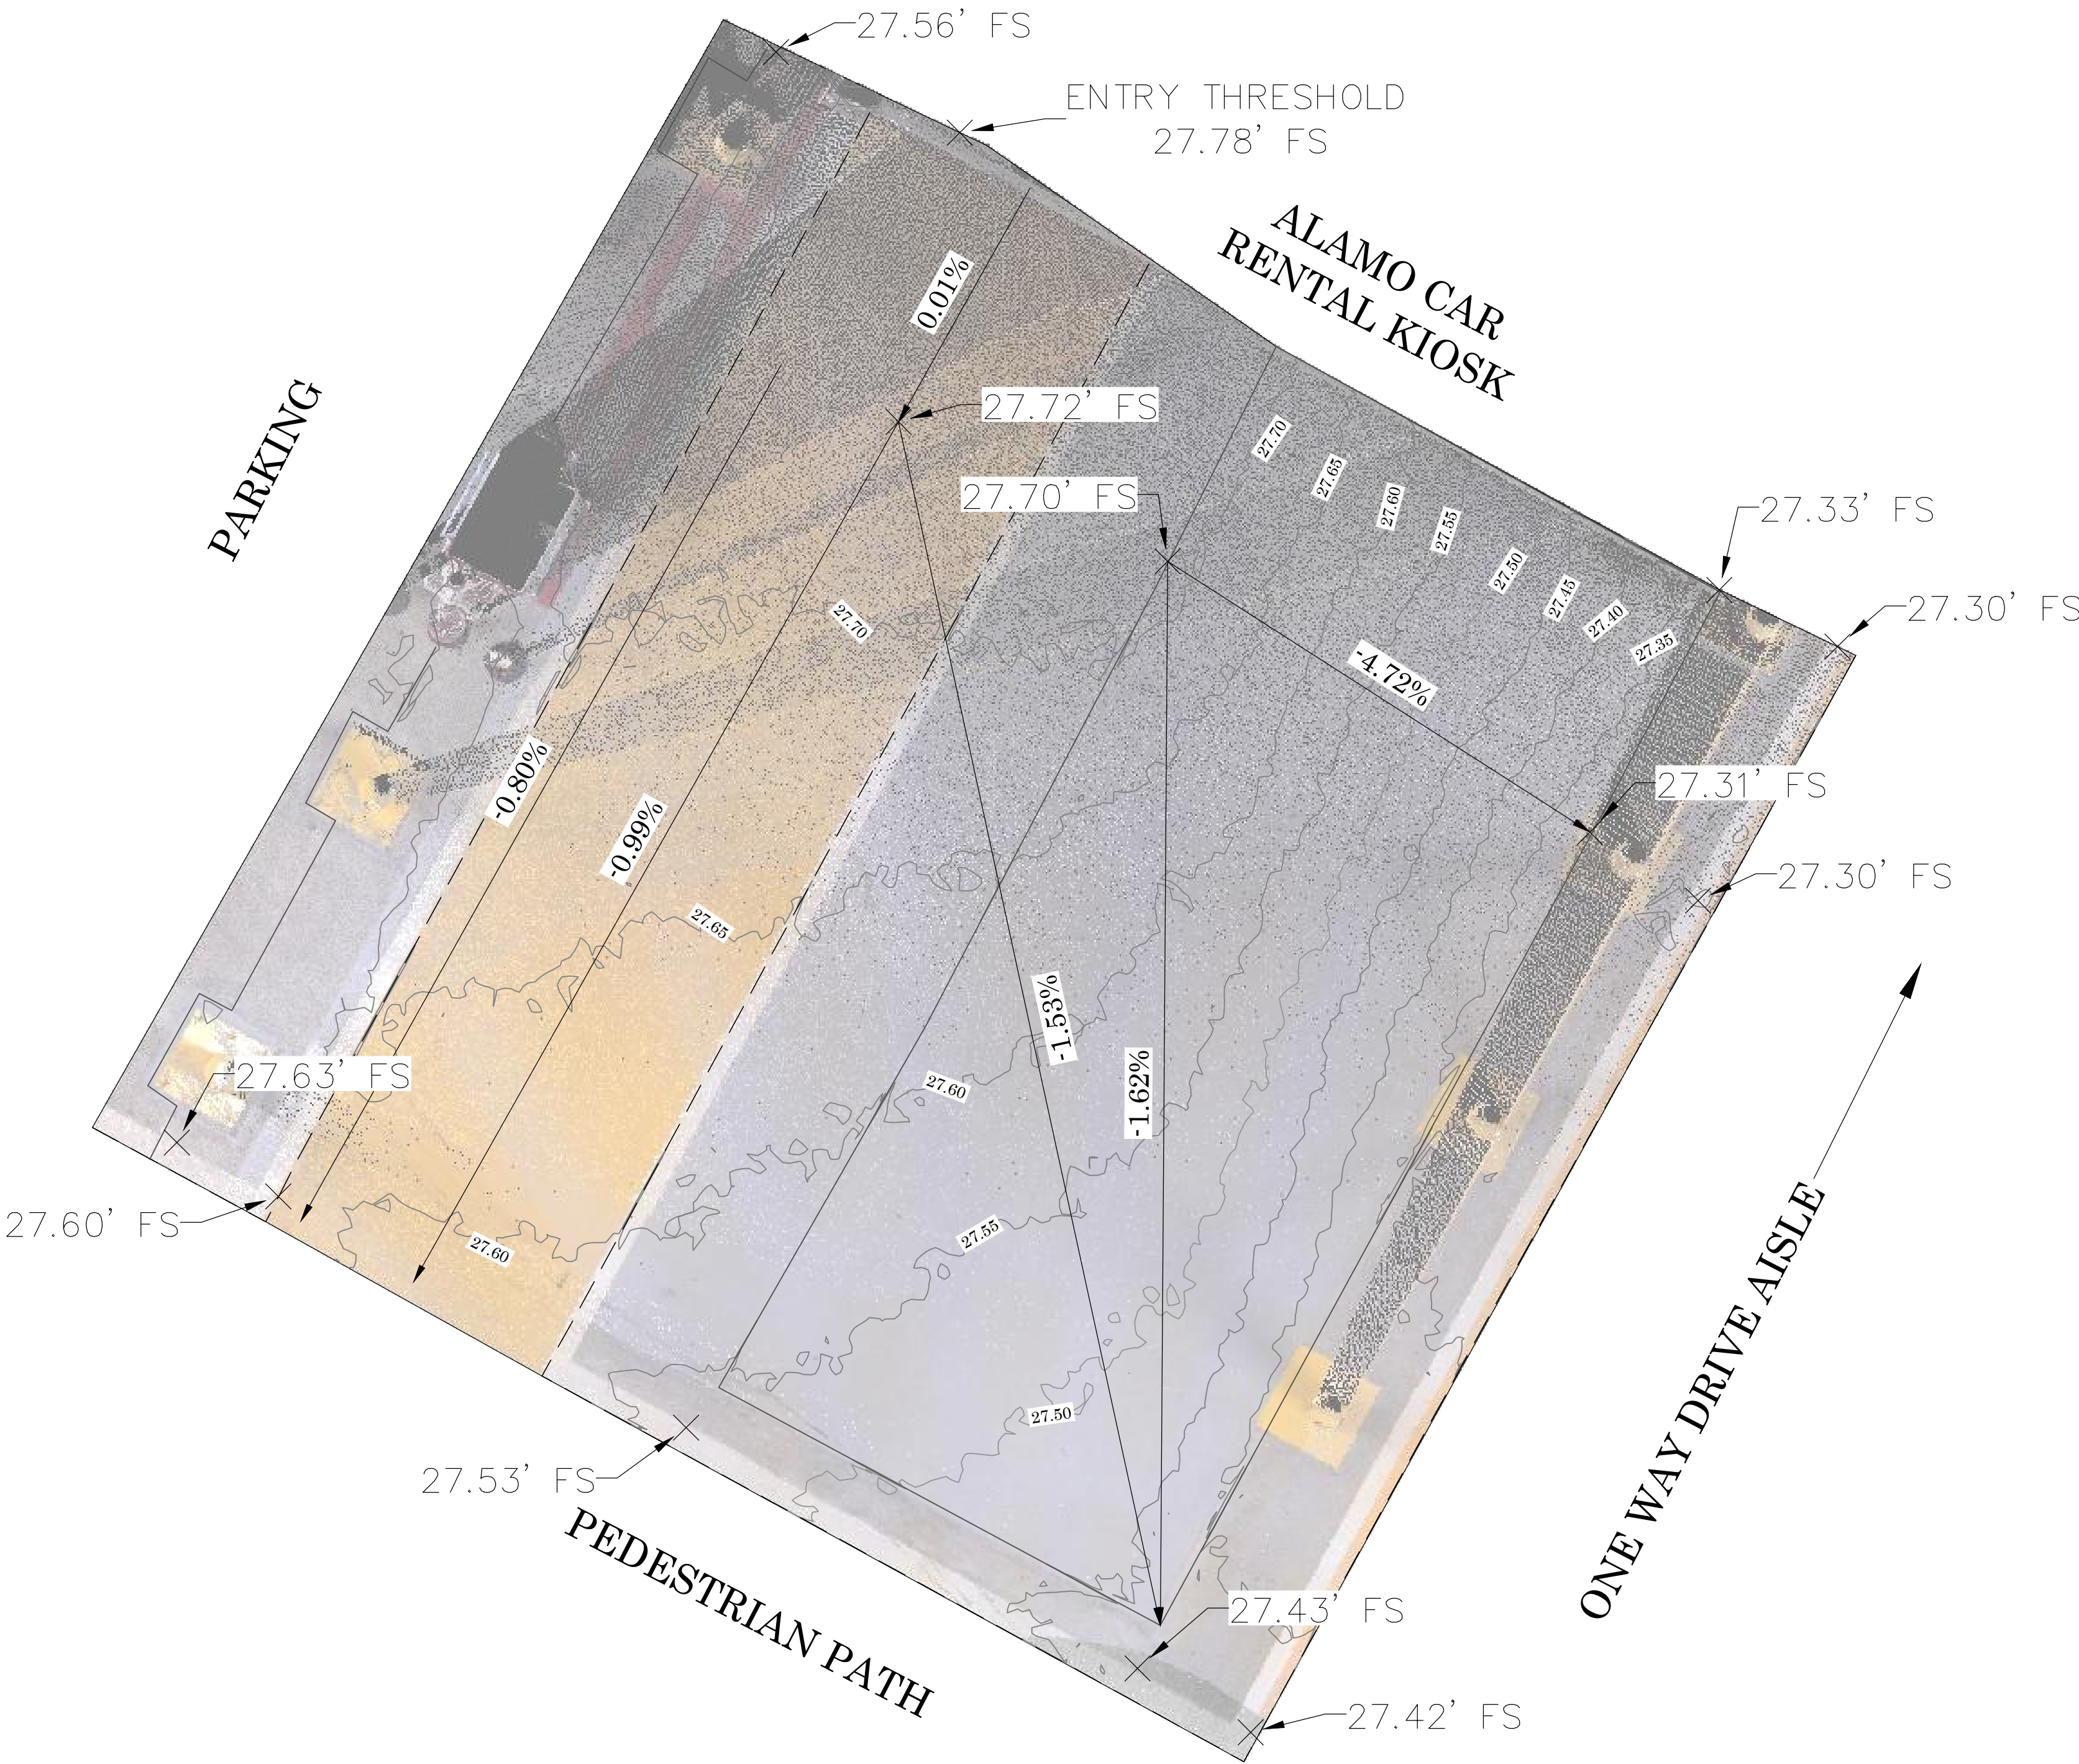

			COUNTY OF ORANGE OC PUBLIC WORKS OC SURVEY/FIELD SERVICES/BOUNDARY ANALYSIS & MAPPING				
			JWA ALAMO KIOSK RENTAL CAR RECONFIGURATION				
			AS-BUILT TOPOGRAPHIC MAP				
			PROJECT LIMITS: LANDING AND RAMP IN FRONT OF ALAMO CAR RENTAL KIOSK LEVEL 0 OF PARKING STRUCTURE.				
			DATE OF SURVEY: 05/18/2022		BY: R. MACIAS, PLS		SHEET NO.  1 of  1
			MAPPING		BY: R. BELTRAN		
			OFFICE CHECK		BY: E. MEDINA, PLS		
			FIELD CHECK		BY: R. MACIAS, PLS		
			SCALE: 1"=2'		W.O. #EX28P446		
			FILE: JWA_ALAMO KIOSK LEVEL 0		FILE # 2122PW-JWA0002		
MARK	DATE	ITEM					
REVISIONS							