



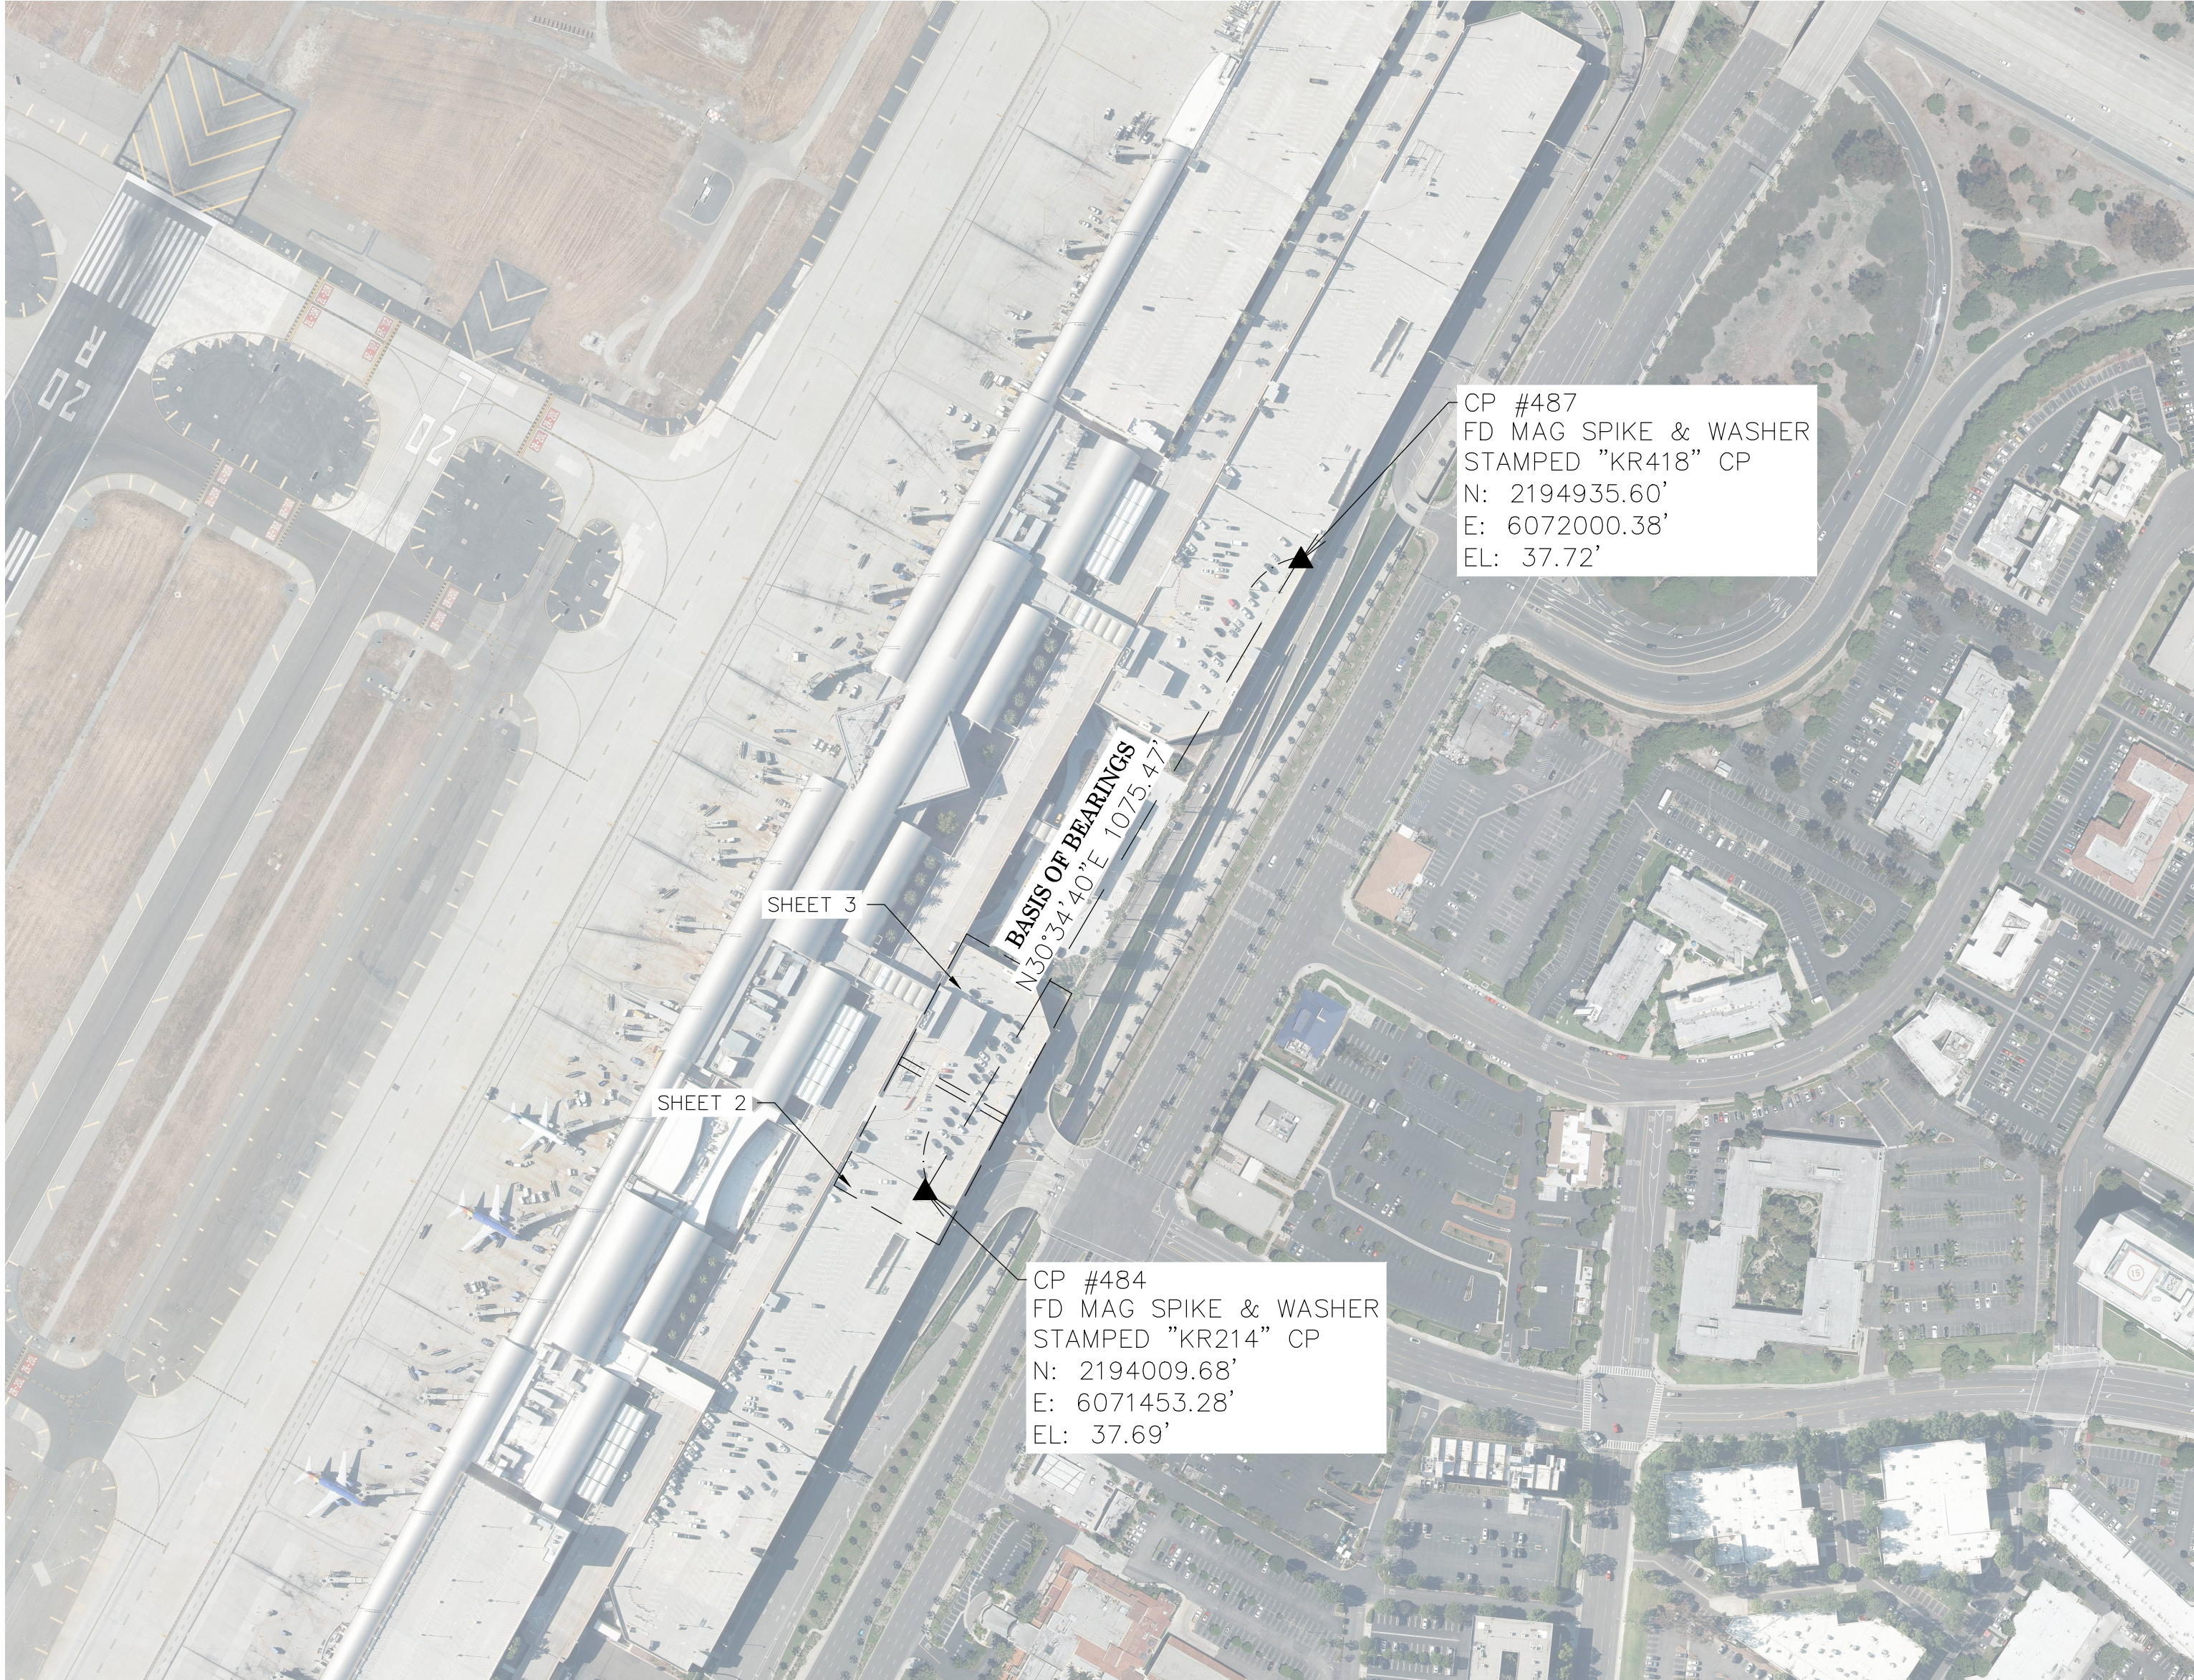

OC PUBLIC WORKS DEPARTMENT
JAMES TREADAWAY, DIRECTOR OF PUBLIC WORKS
KEVIN HILLS, COUNTY SURVEYOR
JOHN WAYNE AIRPORT
PARKING STRUCTURE B2 (LEVEL 1) AS-BUILT

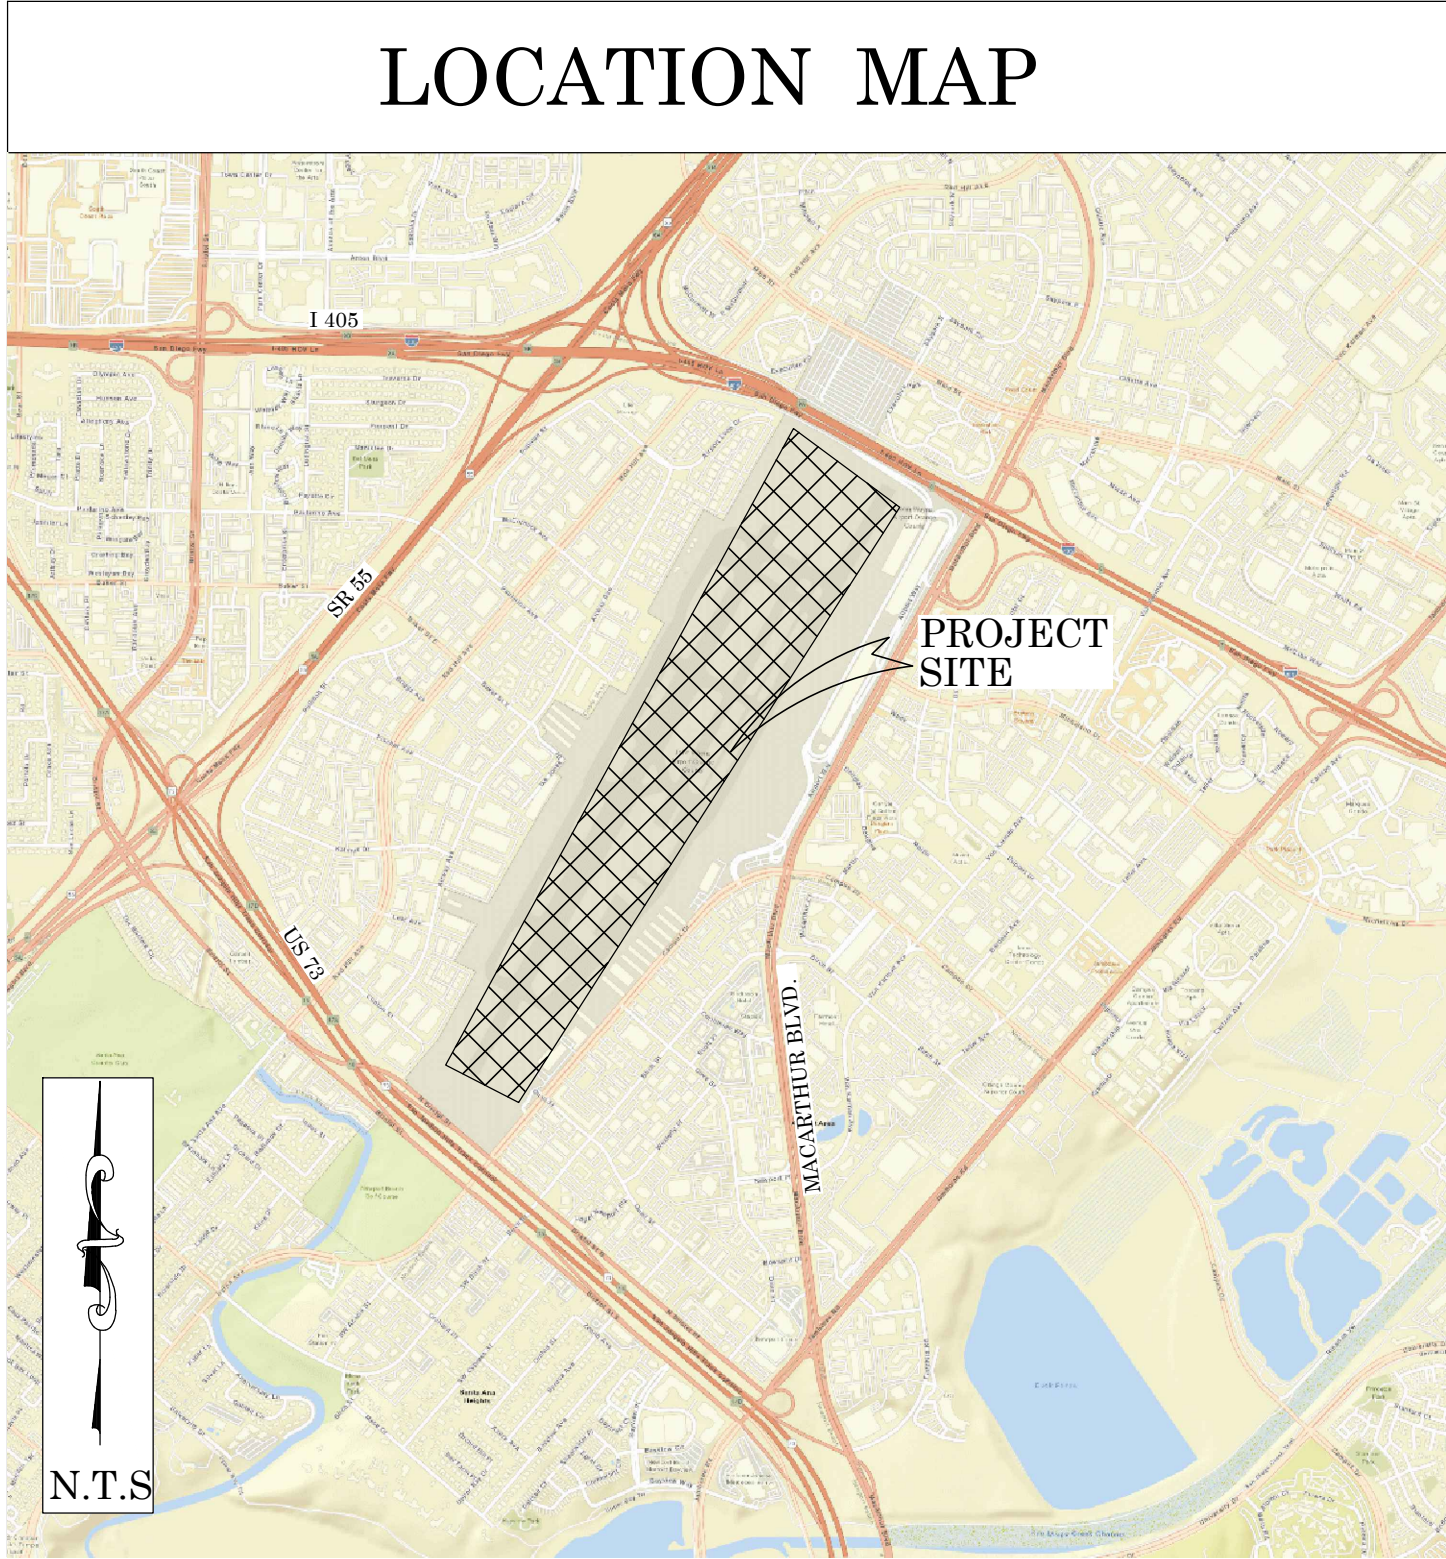

BASIS OF BEARINGS

THE BASIS OF BEARINGS FOR THIS SURVEY IS BASED ON THE CALIFORNIA COORDINATE SYSTEM (CCS83), ZONE VI, NAD 83, OCS (1991.35) EPOCH ADJUSTMENT, AS DETERMINED LOCALLY BY A LINE BETWEEN CONTROL POINTS KR484 AND KR487 DERIVED FROM THE COORDINATES PROVIDED BY AND ON FILE WITH JWA SURVEY DATED 02-28-2022.

HORIZONTAL AND VERTICAL DATUM

COORDINATES SHOWN ARE BASED ON THE CALIFORNIA COORDINATE SYSTEM (CCS83), ZONE VI, NAD 83, OCS (1991.35) EPOCH ADJUSTMENT.
VERTICAL DATUM: ASSUMED AS SHOWN HEREON.
ALL DISTANCES ARE BASED ON THE U.S. SURVEY FOOT.

SHEET INDEX

SHEET	NO.	DESCRIPTION
SHEET 1	1	TITLE SHEET
SHEET 2-3	2-3	TOPOGRAPHIC MAP


PURPOSE OF SURVEY

THE PURPOSE OF THE SURVEY IS TO PROVIDE AS-AS-BUILT SURVEY POST CONSTRUCTION.

SENIOR LAND SURVEYOR'S CERTIFICATE:

THIS MAP CORRECTLY REPRESENTS A SURVEY MADE BY ME OR UNDER MY DIRECTION IN CONFORMANCE WITH REQUIREMENTS OF THE PROFESSIONAL LAND SURVEYOR'S ACT; THIS 14 DAY OF JULY, 2023.

Elliott Medina
Elliott Medina, PLS.

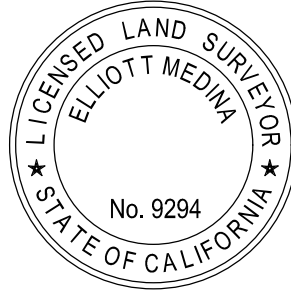

DEPUTY COUNTY SURVEYOR'S STATEMENT:

THIS MAP HAS BEEN EXAMINED IN ACCORDANCE WITH THE PROFESSIONAL LAND SURVEYOR'S ACT; THIS 14 DAY OF JULY, 2023.

Michael Lafontaine
Michael Lafontaine, PLS.



TOPOGRAPHIC MAPPING PROJECT

U.S. Survey Foot

OC Public Works
OC Survey/Field Services
Boundary Analysis & Mapping

				COUNTY OF ORANGE OC PUBLIC WORKS OC SURVEY/FIELD SERVICES/BOUNDARY ANALYSIS & MAPPING				
				JOHN WAYNE AIRPORT PARKING STRUCTURE B2 (LEVEL 1) AS-BUILT				
				TITLE SHEET				
				PROJECT LIMITS: PARKING STRUCTURE B2 (LEVEL 1)				
MARK	DATE			DATE OF SURVEY: MAY 2023		BY: J. KUHLE & PARTY		SHEET NO. 1 of 3
				MAPPING		BY: J. PEDRETTI		
				OFFICE CHECK		BY: H. AFIM, PLS		
		FIELD CHECK		BY: E. MEDINA, PLS				
		SCALE: N.T.S.		W.O. #EX28P446		FILE #2122PW-JWA0001		
REVISIONS		FILE: JWA_STRUCT B2 LABEL_TOPO_2023.DWG						


PARKING STRUCTURE B2, LEVEL 1

SEE SHEET 3



LEGEND	
DIF	Difference

NOTES:
STRIPING AND FLOOR PLAN FEATURES WERE DERIVED FROM SITE PLAN NO. 41021-J117, DATED 01/13/2021.
THE TIN SURFACE WITHIN THIS DATA SET HAS BEEN CREATED FROM TERRESTRIAL LASER SCANNING METHODS AND IT SHOULD BE CONSIDERED RELATIVE FOR THE SPECIFIC PURPOSE OF THIS CONTOUR MAP.
THE SPOT ELEVATIONS SHOWN ARE THE DIFFERENCE BETWEEN THE POST-CONSTRUCTION 2023 SURFACE AND THE PRE-CONSTRUCTION 2022 SURFACE.

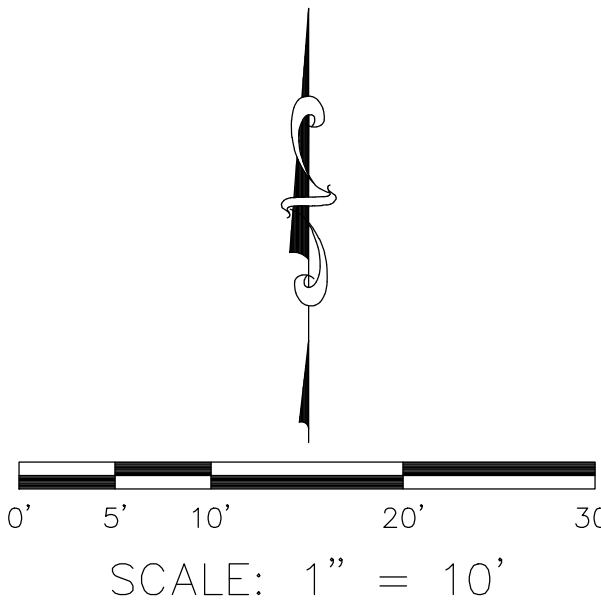


U.S. *Survey* *Foot*

OC Public Works
OC Survey/Field Services
Boundary Analysis & Mapping

COUNTY OF ORANGE OC PUBLIC WORKS OC SURVEY/FIELD SERVICES/BOUNDARY ANALYSIS & MAPPING		
JOHN WAYNE AIRPORT PARKING STRUCTURE B2 (LEVEL 1) AS-BUILT		
TOPOGRAPHIC MAP PROJECT LIMITS: PARKING STRUCTURE B2 (LEVEL 1)		
DATE OF SURVEY: MAY 2023	BY: J. KUHL & PARTY	SHEET NO. 3 of 3
MAPPING	BY: J. PEDRETTI	
OFFICE CHECK	BY: H. AFTIM, PLS	
FIELD CHECK	BY: E. MEDINA, PLS	
SCALE: 1" = 10'	W.O. #EX28P446 FILE #2122PW-JWA0001 FILE: JWA_STRUCT_B2_LABEL_TOPO_2023.DWG	
MARK	DATE	ITEM
REVISIONS		

PARKING STRUCTURE B2, LEVEL 1

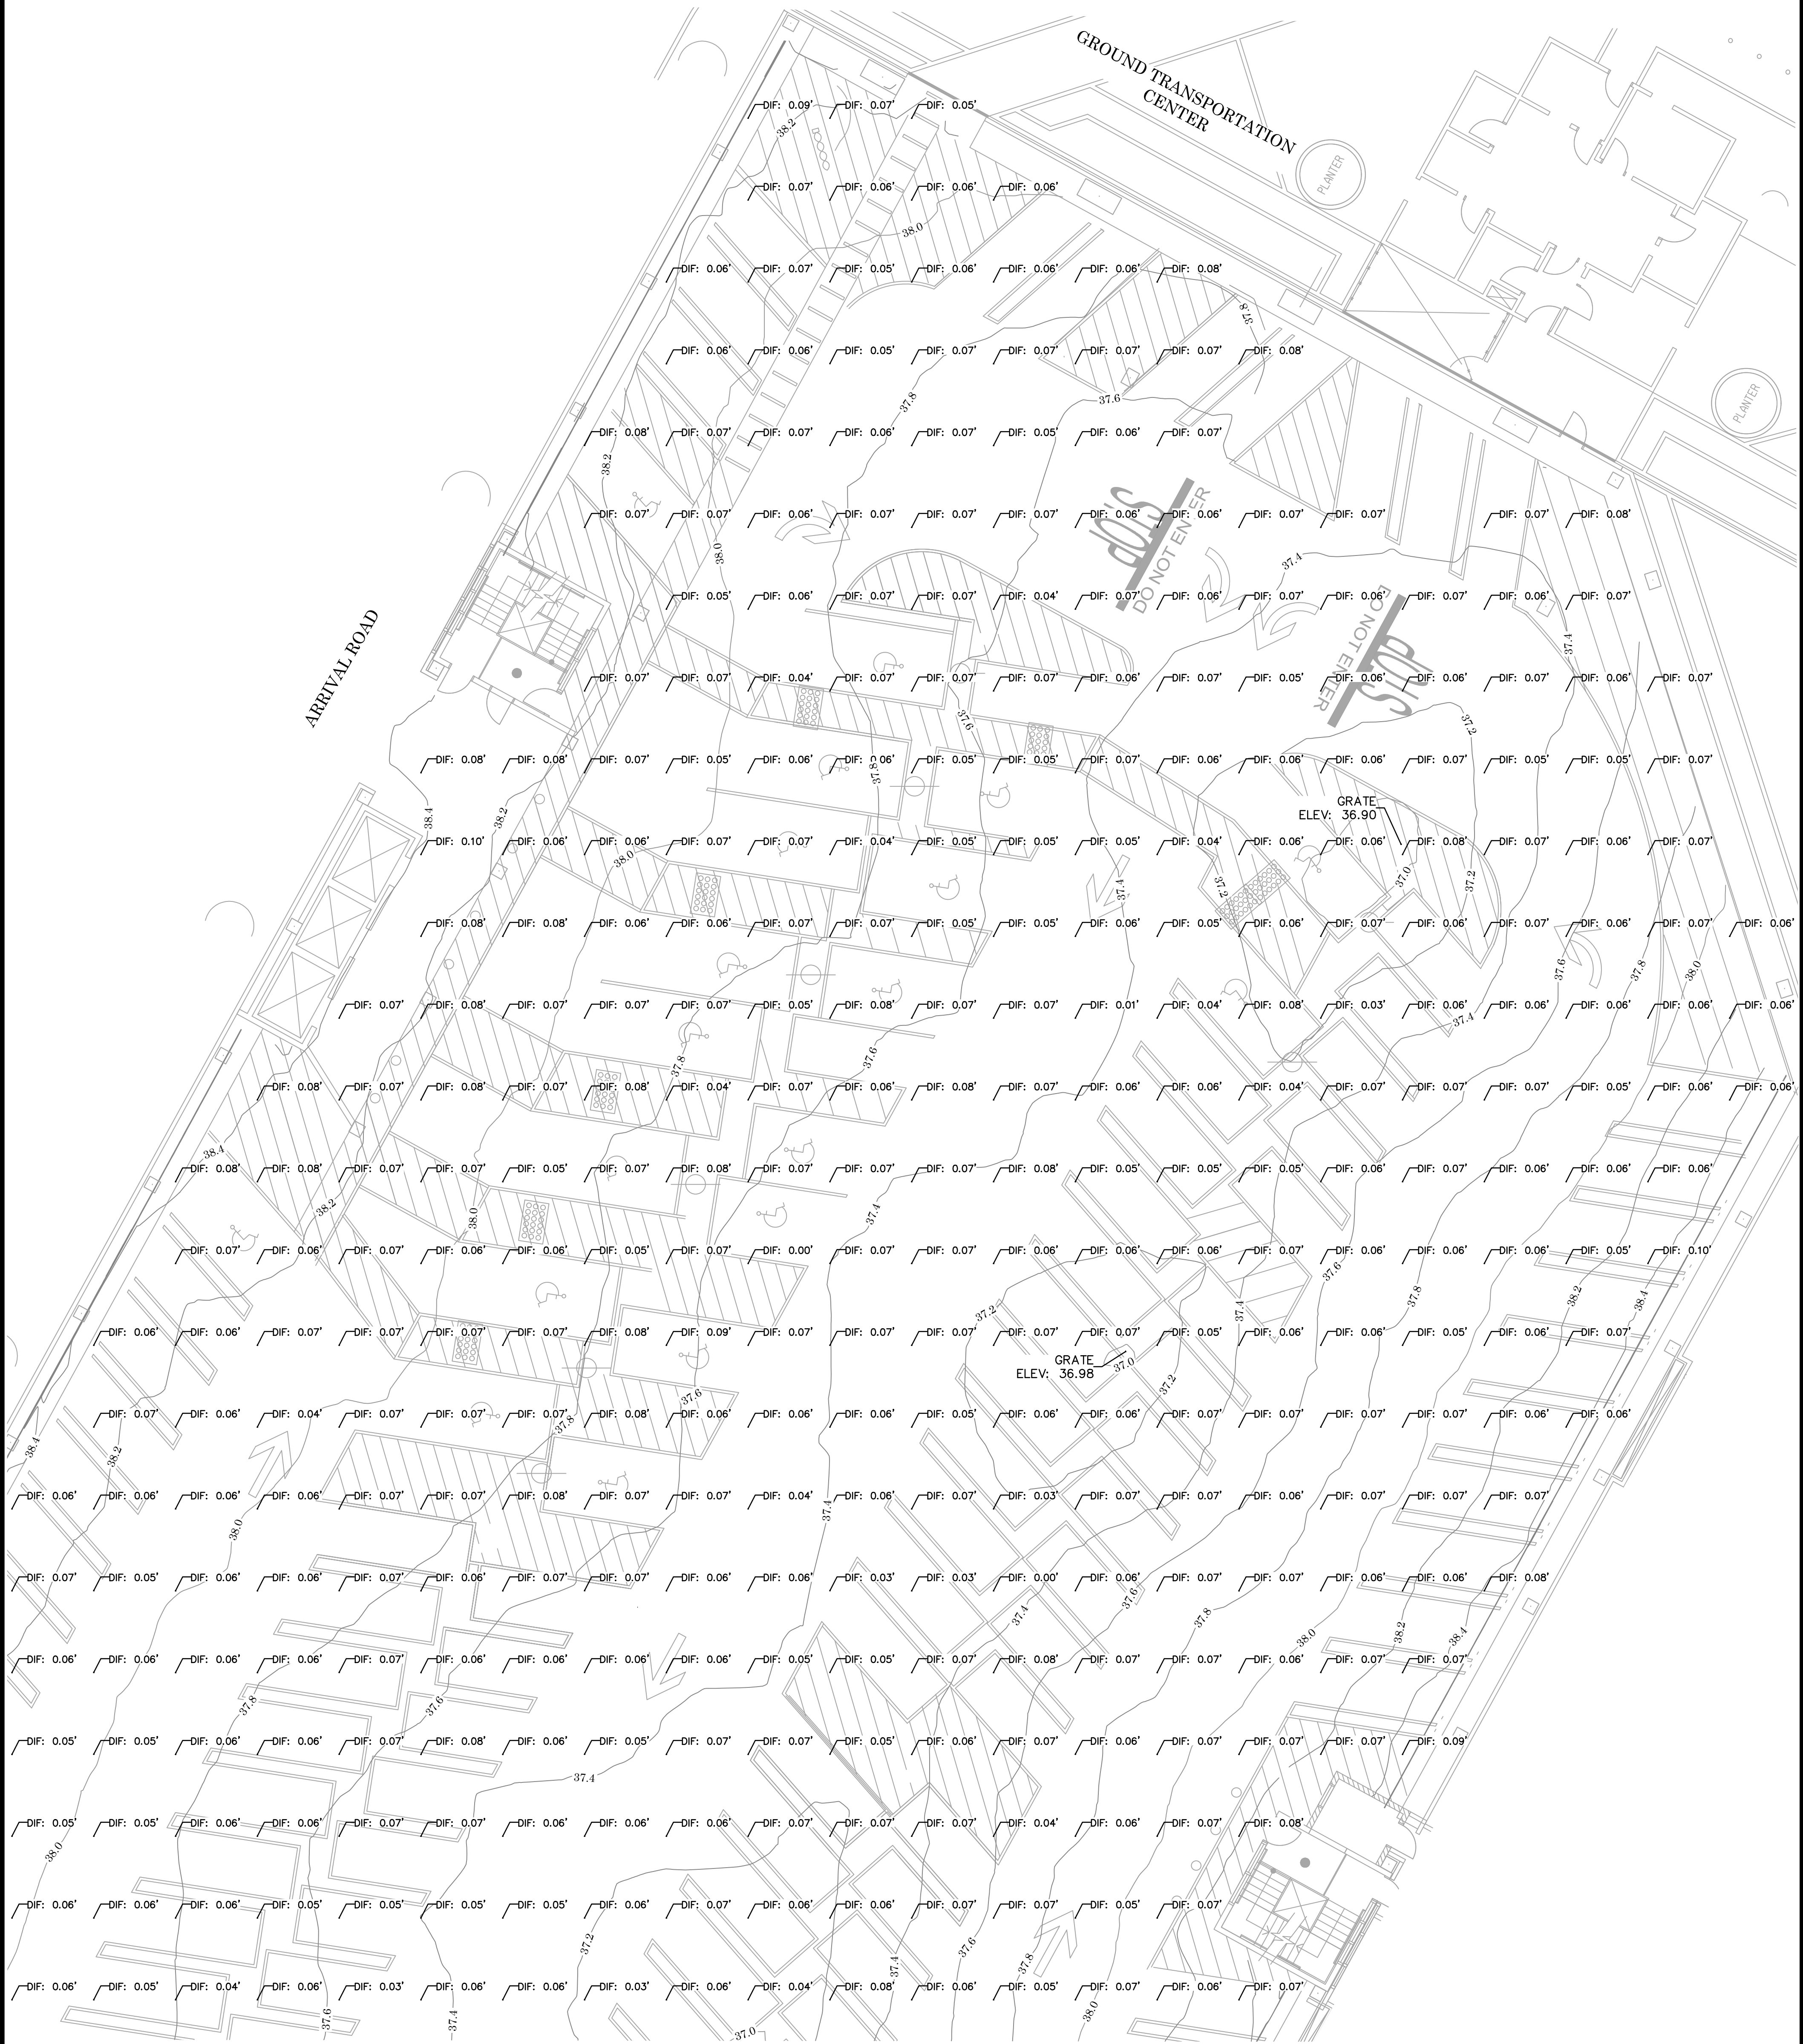


SEE SHEET 2

U.S. *Survey* Foot

OC Public Works
OC Survey/Field Services
Boundary Analysis & Mapping

LEGEND	
DIF	Difference

NOTES:
STRIPING AND FLOOR PLAN FEATURES WERE DERIVED FROM SITE PLAN NO. 41021-J117, DATED 01/13/2021.
THE TIN SURFACE WITHIN THIS DATA SET HAS BEEN CREATED FROM TERRESTRIAL LASER SCANNING METHODS AND IT SHOULD BE CONSIDERED RELATIVE FOR THE SPECIFIC PURPOSE OF THIS CONTOUR MAP.
THE SPOT ELEVATIONS SHOWN ARE THE DIFFERENCE BETWEEN THE POST-CONSTRUCTION 2023 SURFACE AND THE PRE-CONSTRUCTION 2022 SURFACE.

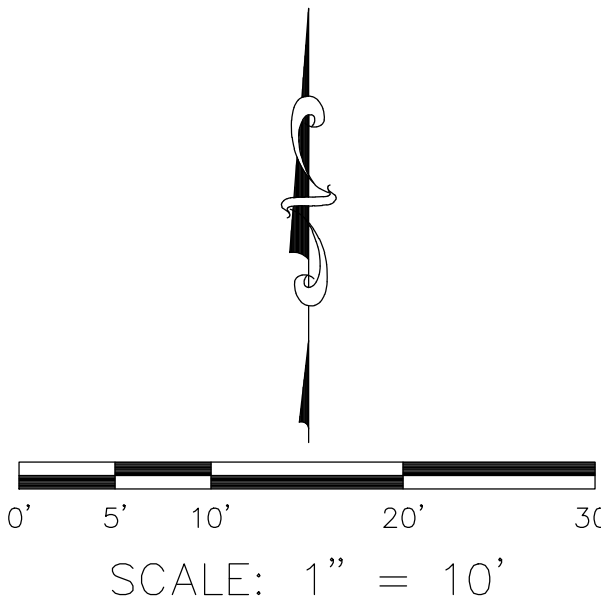

		COUNTY OF ORANGE OC PUBLIC WORKS OC SURVEY/FIELD SERVICES/BOUNDARY ANALYSIS & MAPPING					
		JOHN WAYNE AIRPORT PARKING STRUCTURE B2 (LEVEL 1) AS-BUILT					
		TOPOGRAPHIC MAP					
		PROJECT LIMITS: PARKING STRUCTURE B2 (LEVEL 1)					
		DATE OF SURVEY: MAY 2023					
		MAPPING		BY: J. KUHL & PARTY		SHEET NO. 2 of 3	
		OFFICE CHECK		BY: J. PEDRETTI, PLS			
		FIELD CHECK		BY: H. AFTIM, PLS			
				BY: E. MEDINA, PLS			
		SCALE: 1" = 10'		W.O. #EX28P446			FILE #2122PW-JWA0001
		FILE: JWA_STRUCT_B2_LABEL_TOPO_2023.DWG					
MARK	DATE	ITEM					
		REVISIONS					