

U.S. *Survey
Foot*

OC Public Works
OC Survey/Field Services
Boundary Analysis & Mapping

OC PUBLIC WORKS DEPARTMENT

JAMES TREADAWAY, DIRECTOR OF PUBLIC WORKS
KEVIN HILLS, COUNTY SURVEYOR



CANADA CHANNEL

REHABILITATION

SECTIONS WERE DERIVED FROM RECORD AS-BUILT PLAN F23-701-1, F23-701-2, AND F23-701-3. BETWEEN STATIONS 6+24.53 TO 43+43.66 AND O.C.S TOPOGRAPHIC SURVEY DATED MARCH, 2021.

THIS DOCUMENT IS SUPPLEMENTAL TO THE TOPOGRAPHIC SURVEY MAP DATED MARCH, 2021.

PROJECT CROSS SECTIONS


U.S. *Survey Foot*

OC Public Works
OC Survey/Field Services
Boundary Analysis & Mapping

CAÑADA CHANNEL (F23)

6+24.53

CL

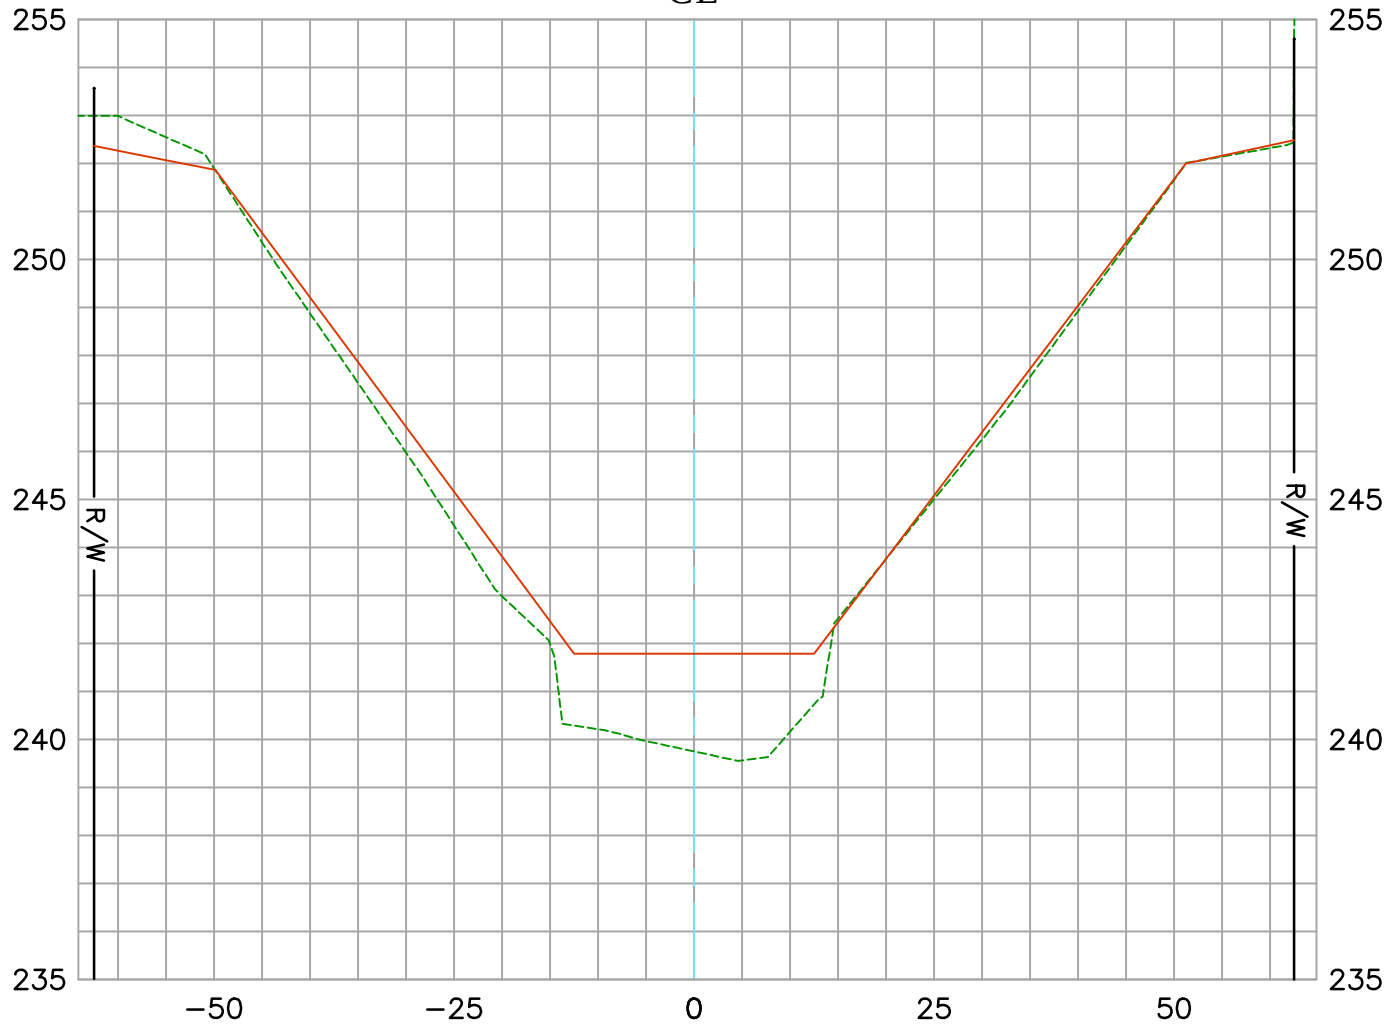

EXISTING CONDITION 03/18/2021
RECORD DRAWINGS:
F23-701-1, F23-701-2, & F23-701-3
DATE PREPARED: 11/01/2021

Vert. Scale: 1"=4'
Hor. Scale: 1"=20'


U.S. *Survey*
Foot

OC Public Works
OC Survey/Field Services
Boundary Analysis & Mapping

CAÑADA CHANNEL (F23)

6+50.00

CL

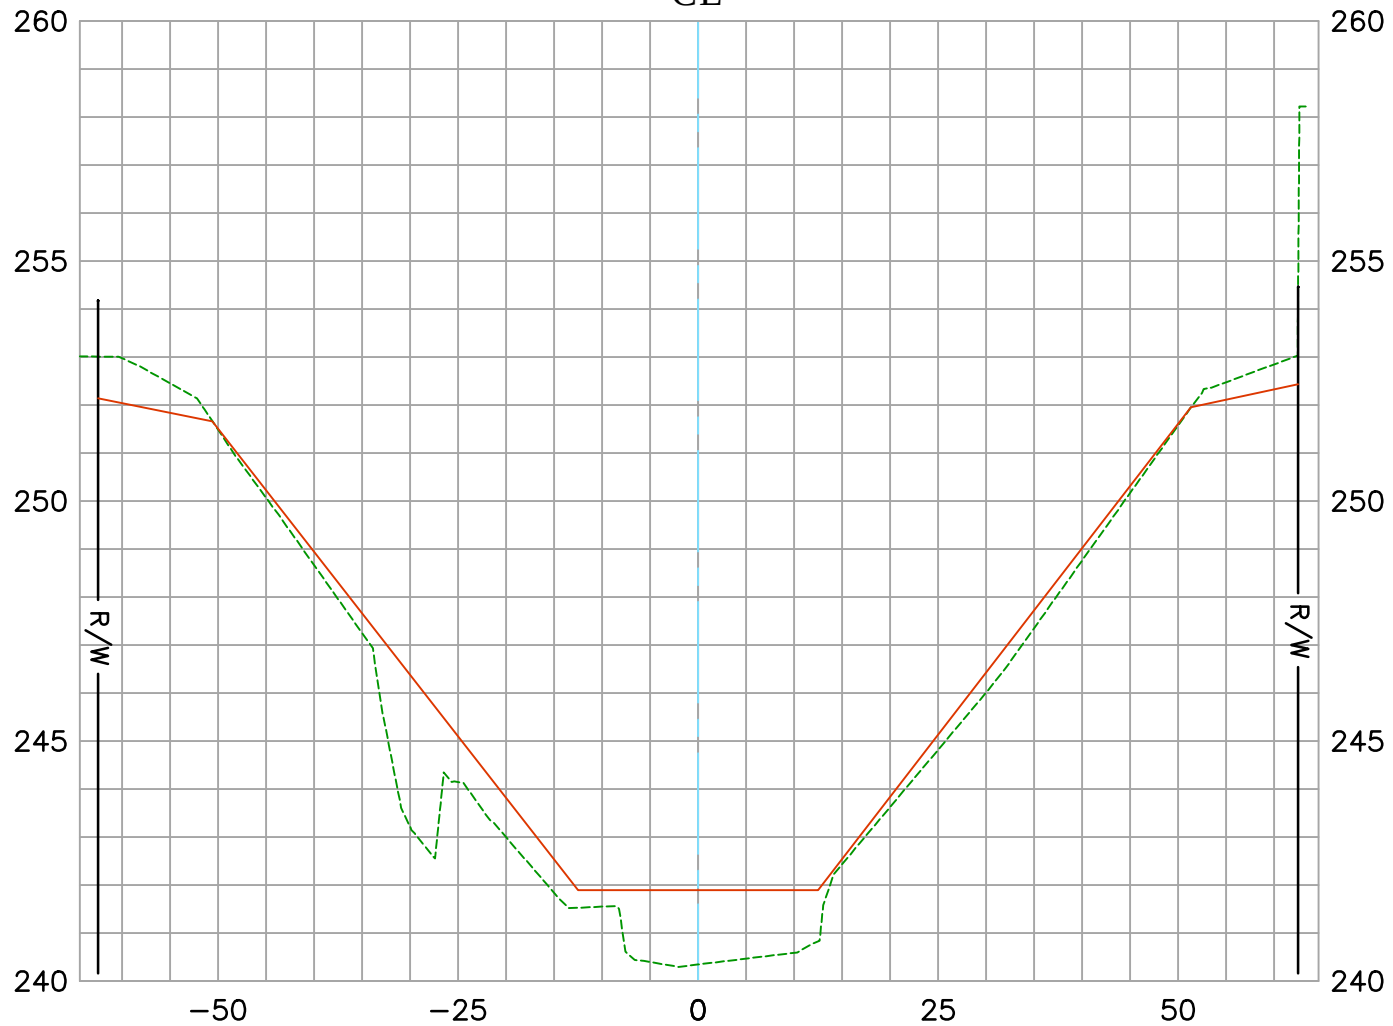

EXISTING CONDITION 03/18/2021
RECORD DRAWINGS:
F23-701-1, F23-701-2, & F23-701-3
DATE PREPARED: 11/01/2021

Vert. Scale: 1"=4'
Hor. Scale: 1"=20'


U.S. *Survey*
Foot

OC Public Works
OC Survey/Field Services
Boundary Analysis & Mapping

CAÑADA CHANNEL (F23)

7+00.00

CL

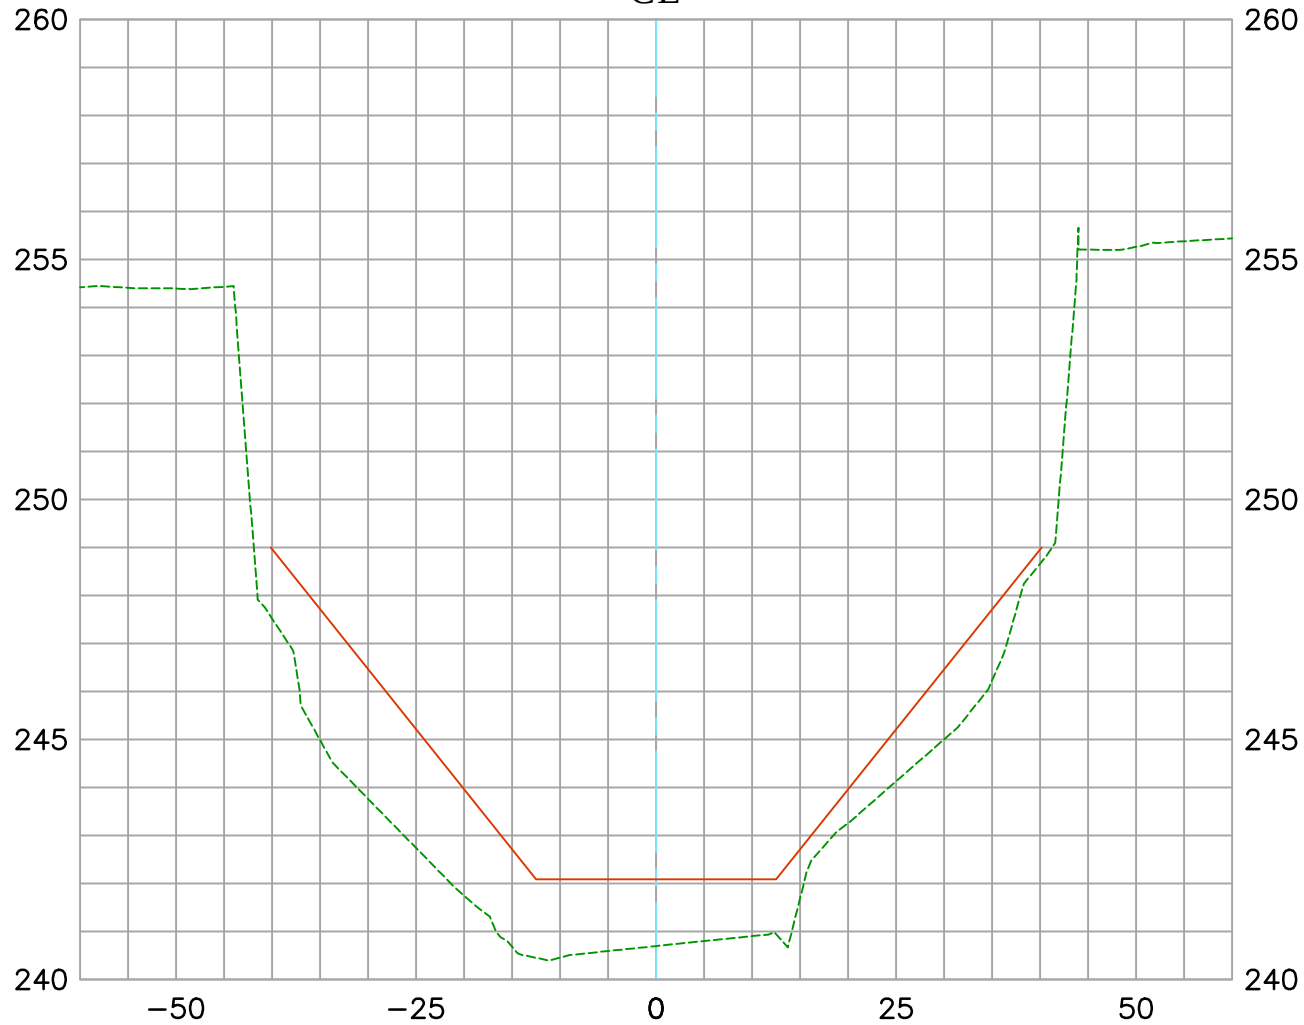

EXISTING CONDITION 03/18/2021
RECORD DRAWINGS:
F23-701-1, F23-701-2, & F23-701-3
DATE PREPARED: 11/01/2021

Vert. Scale: 1"=4'
Hor. Scale: 1"=20'



U.S. *Survey*
Foot

OC Public Works
OC Survey/Field Services
Boundary Analysis & Mapping

CAÑADA CHANNEL (F23)

7+50.00

CL

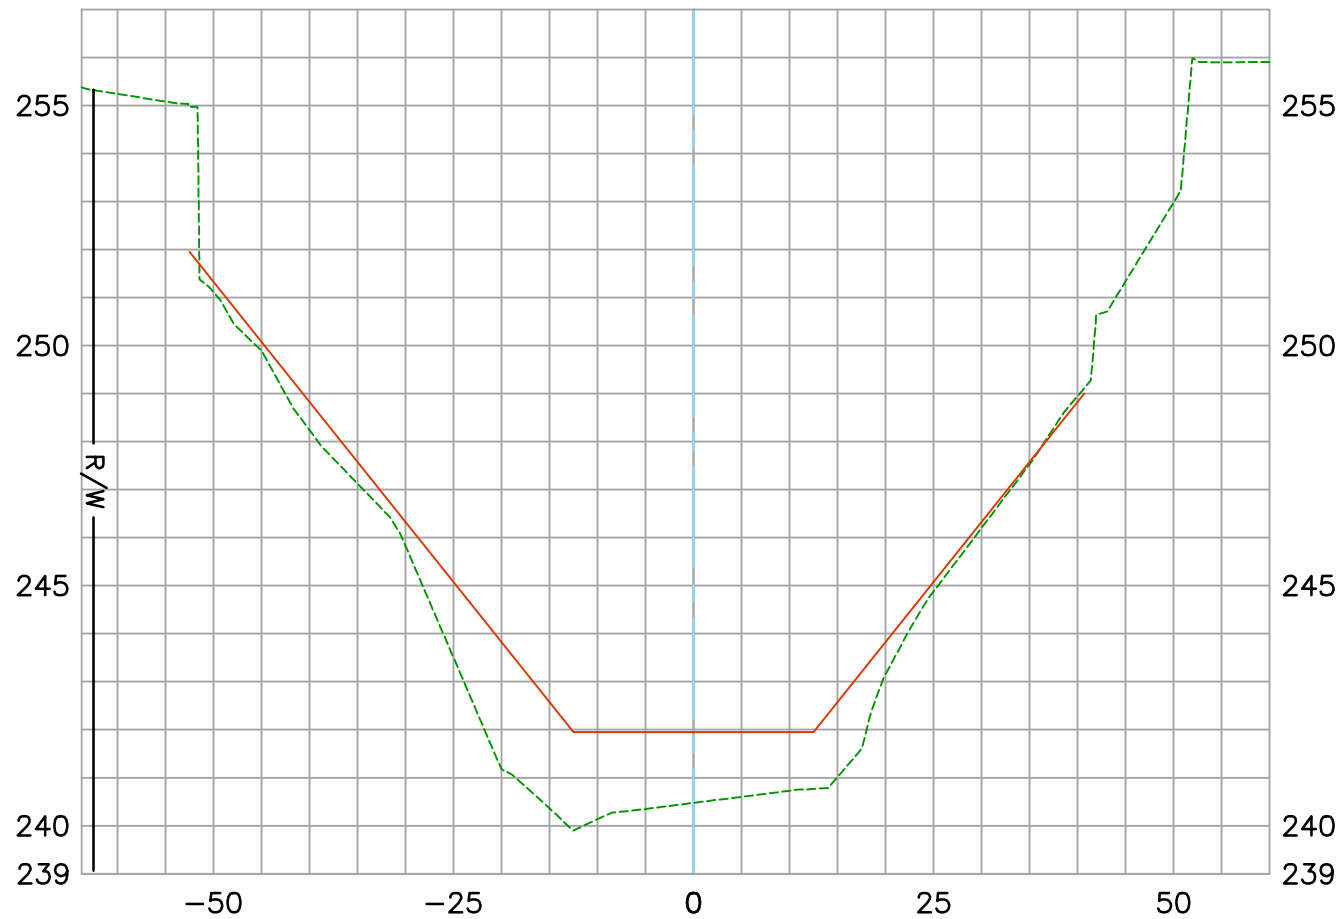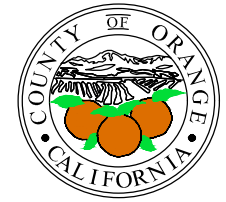

EXISTING CONDITION 03/18/2021
RECORD DRAWINGS:
F23-701-1, F23-701-2, & F23-701-3
DATE PREPARED: 11/01/2021

Vert. Scale: 1"=4'
Hor. Scale: 1"=20'


U.S. *Survey*
Foot

OC Public Works
OC Survey/Field Services
Boundary Analysis & Mapping

CAÑADA CHANNEL (F23)

8+00.00

CL

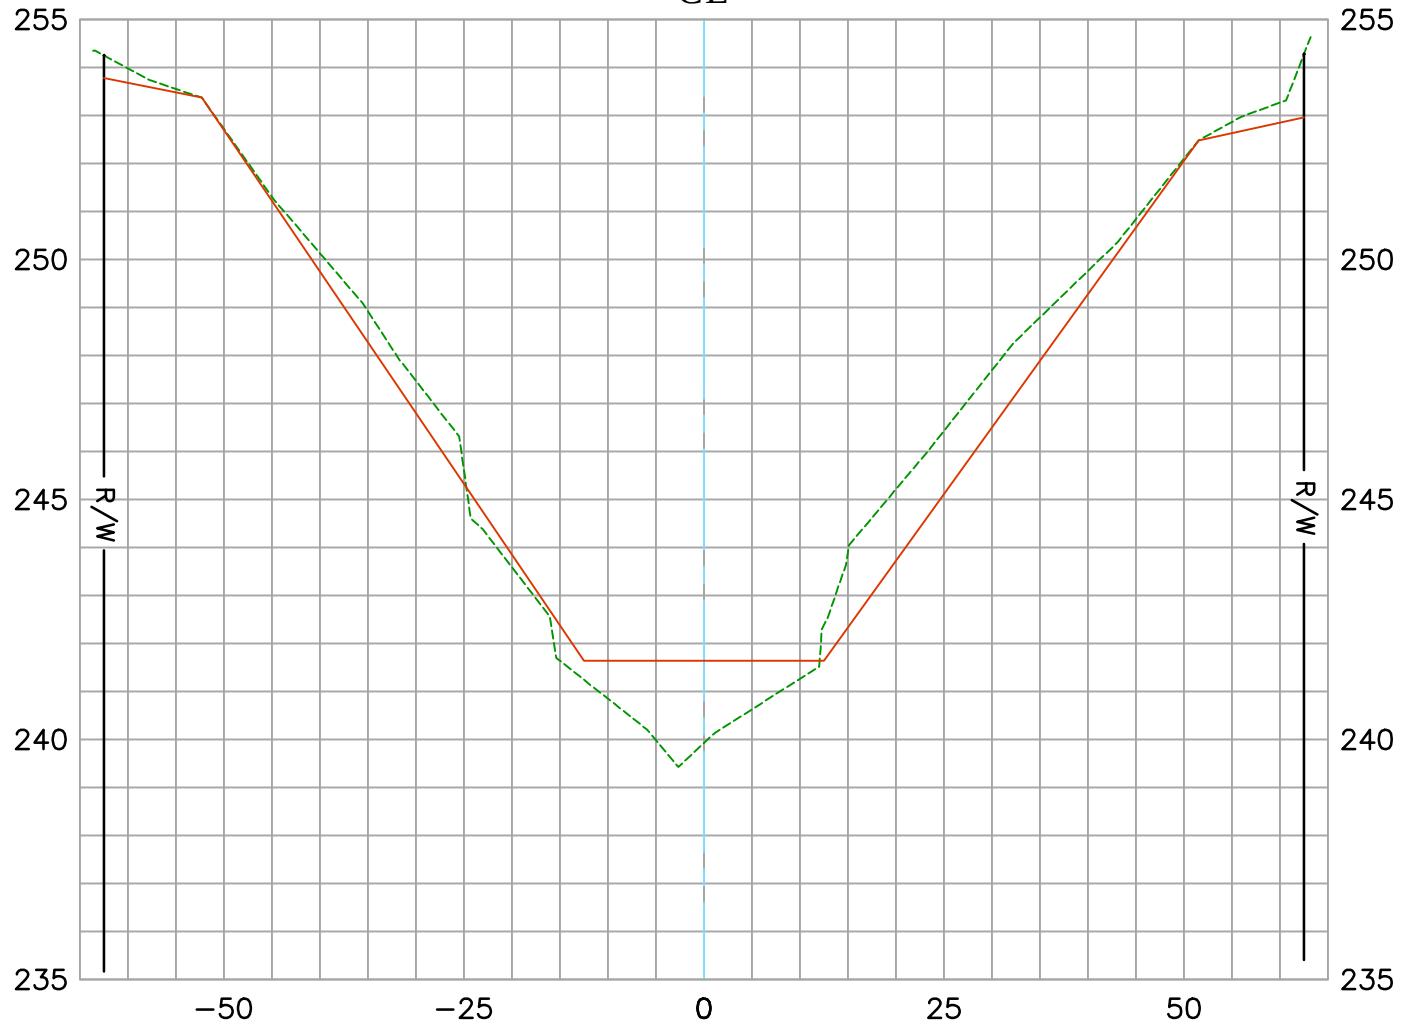

EXISTING CONDITION 03/18/2021
RECORD DRAWINGS:
F23-701-1, F23-701-2, & F23-701-3
DATE PREPARED: 11/01/2021

Vert. Scale: 1"=4'
Hor. Scale: 1"=20'



U.S. *Survey Foot*

OC Public Works
OC Survey/Field Services
Boundary Analysis & Mapping

CAÑADA CHANNEL (F23)

8+50.00

CL

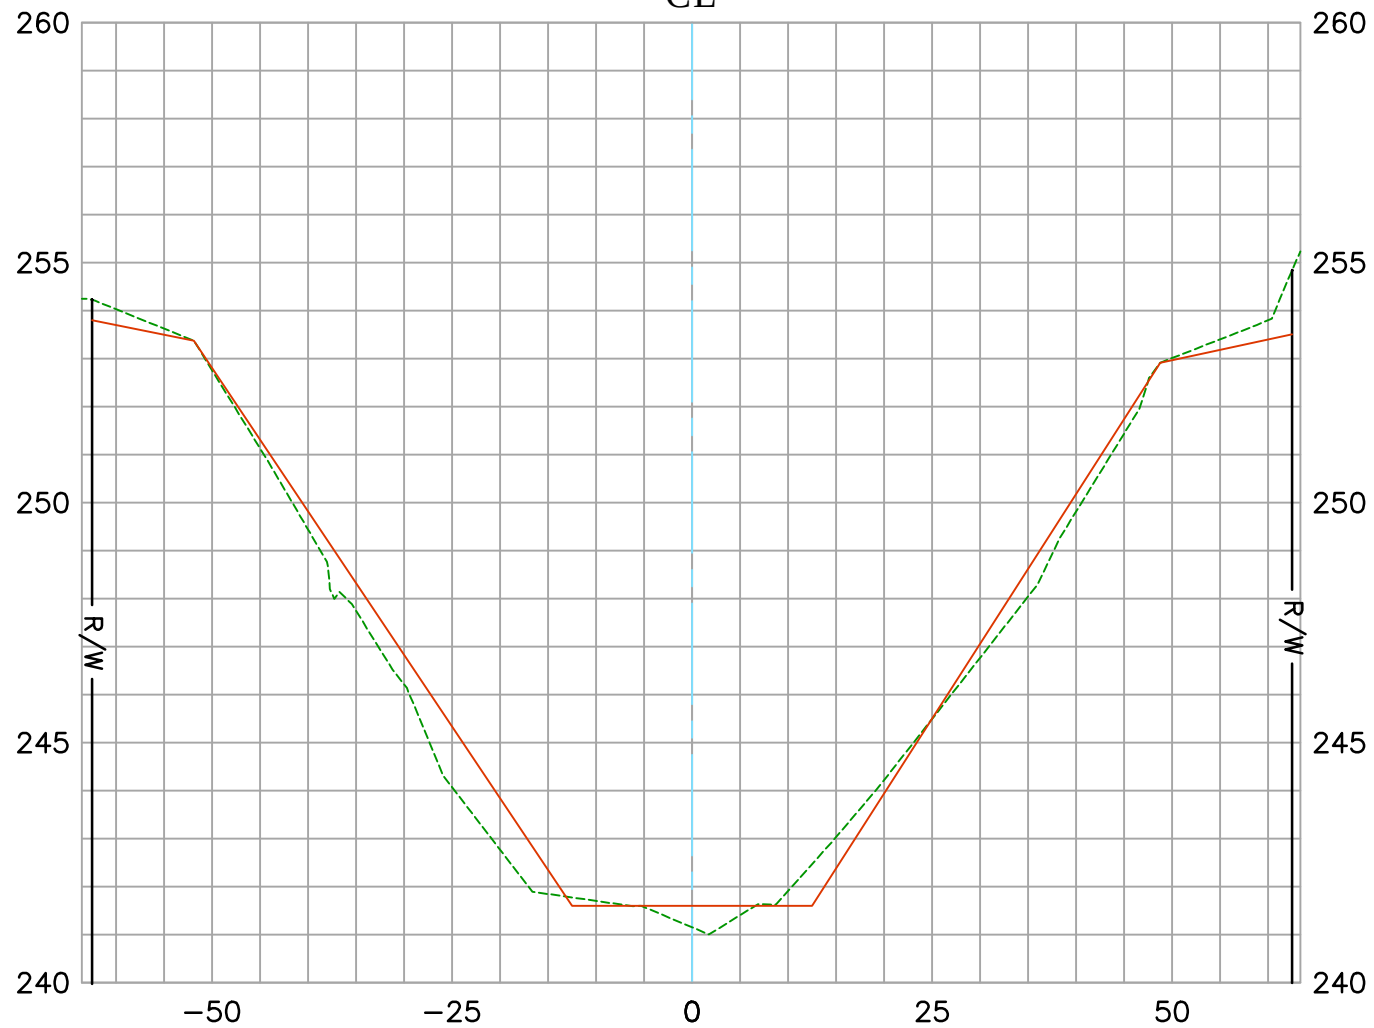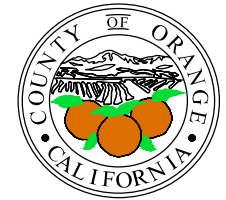

EXISTING CONDITION 03/18/2021
RECORD DRAWINGS:
F23-701-1, F23-701-2, & F23-701-3
DATE PREPARED: 11/01/2021

Vert. Scale: 1"=4'
Hor. Scale: 1"=20'


U.S. *Survey*
Foot

OC Public Works
OC Survey/Field Services
Boundary Analysis & Mapping

CAÑADA CHANNEL (F23)

9+00.00

CL

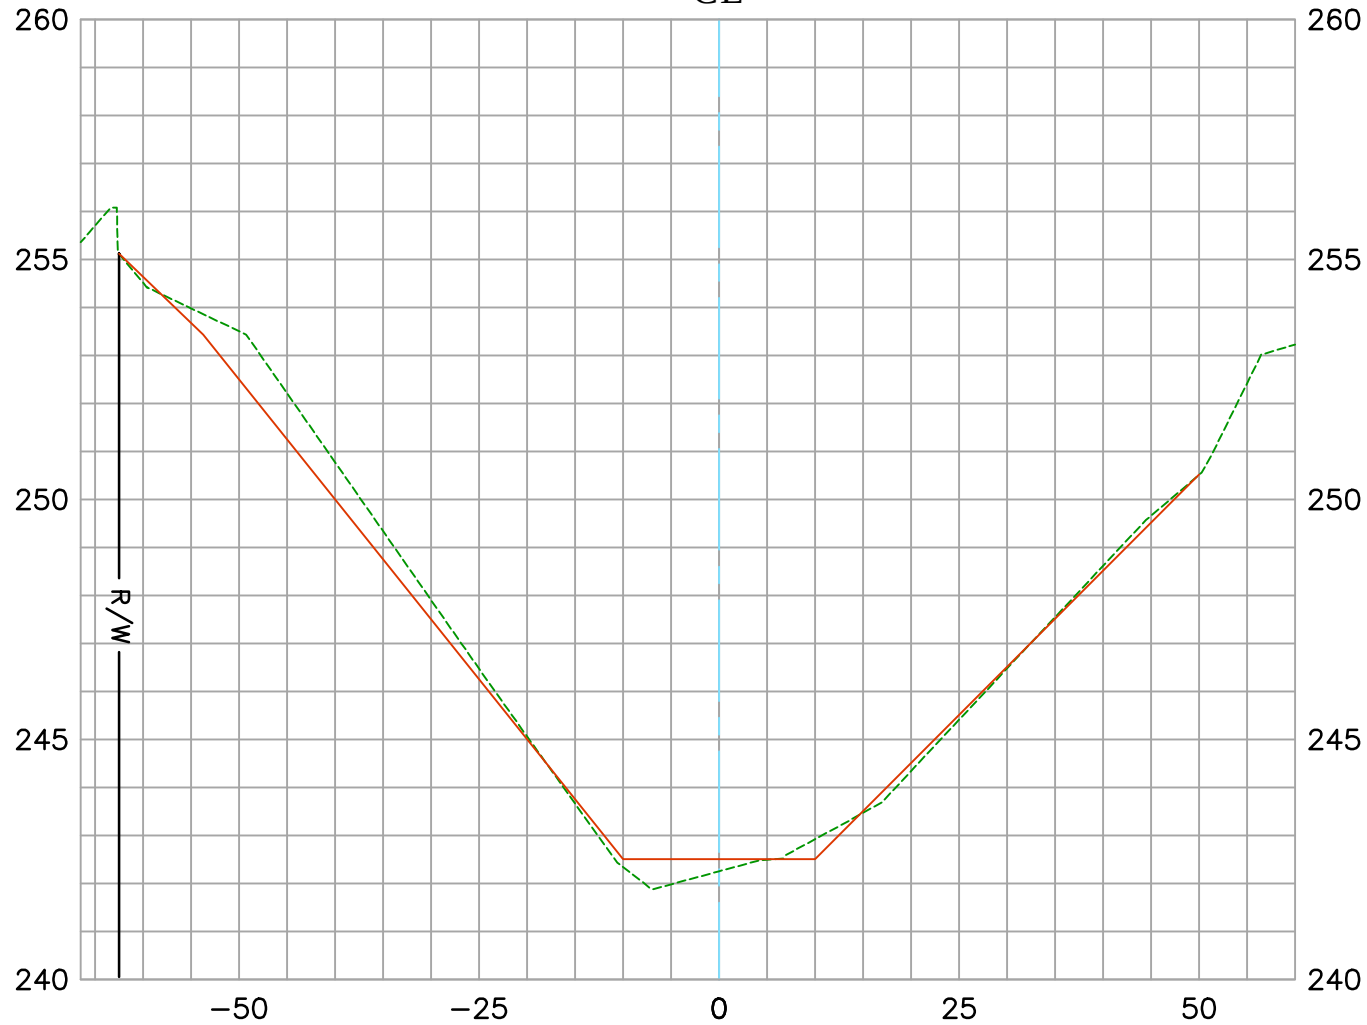

EXISTING CONDITION 03/18/2021

RECORD DRAWINGS:

F23-701-1, F23-701-2, & F23-701-3

DATE PREPARED: 11/01/2021

Vert. Scale: 1"=4'

Hor. Scale: 1"=20'



U.S. *Survey*
Foot

OC Public Works
OC Survey/Field Services
Boundary Analysis & Mapping

CAÑADA CHANNEL (F23)

9+50.00

CL

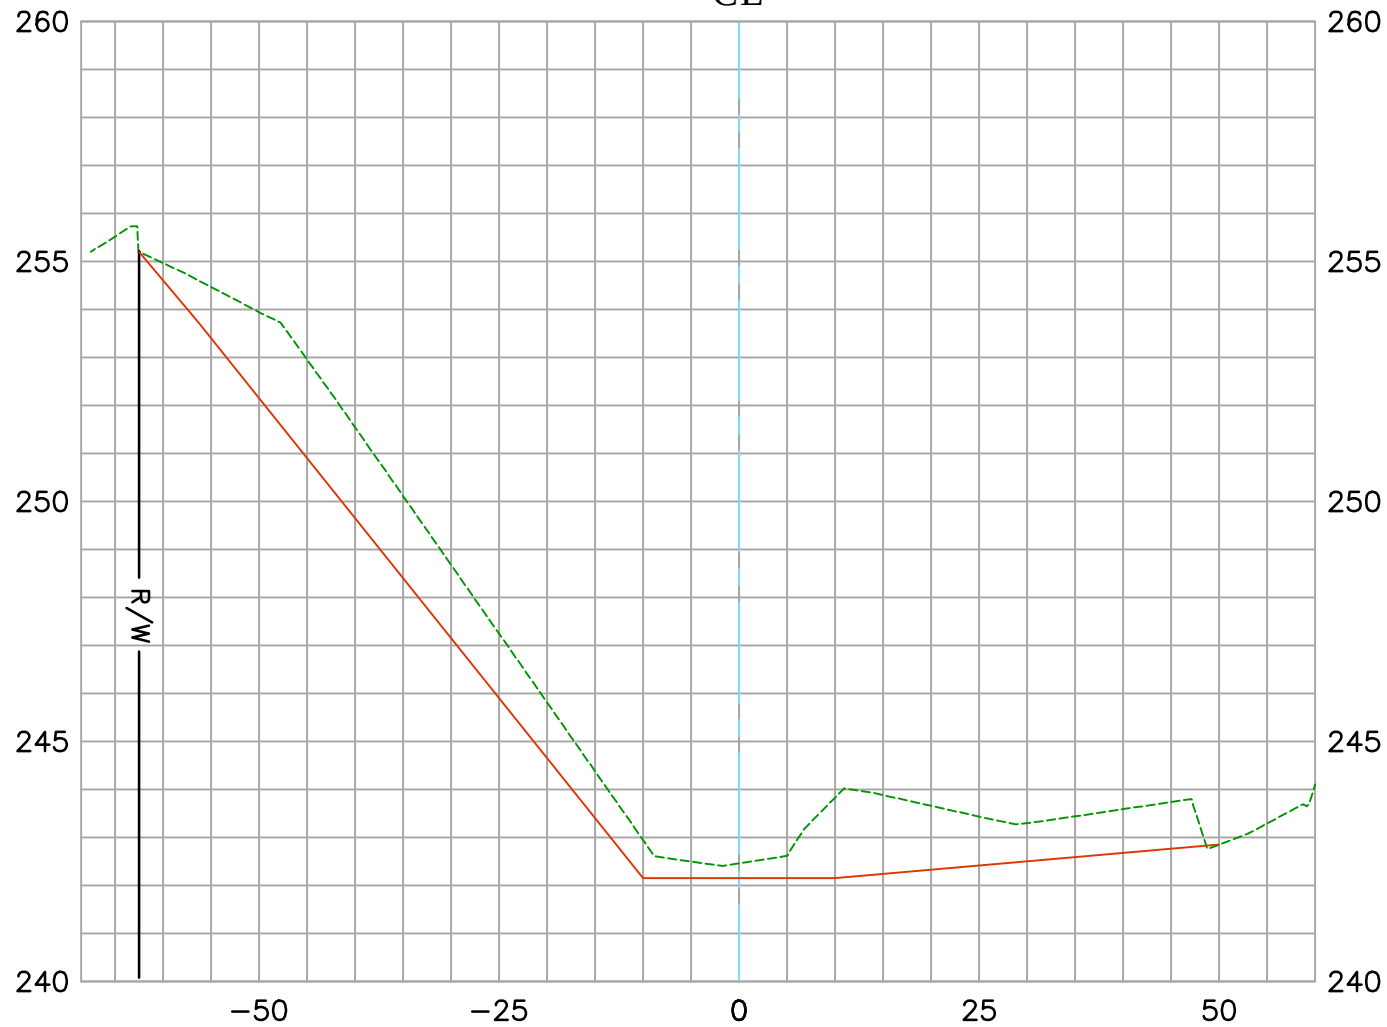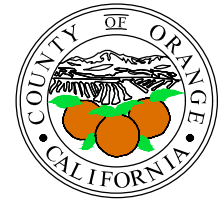

EXISTING CONDITION 03/18/2021
RECORD DRAWINGS:
F23-701-1, F23-701-2, & F23-701-3
DATE PREPARED: 11/01/2021

Vert. Scale: 1"=4'
Hor. Scale: 1"=20'


U.S. Survey
Foot

OC Public Works
OC Survey/Field Services
Boundary Analysis & Mapping

CAÑADA CHANNEL (F23)

10+16.94

CL

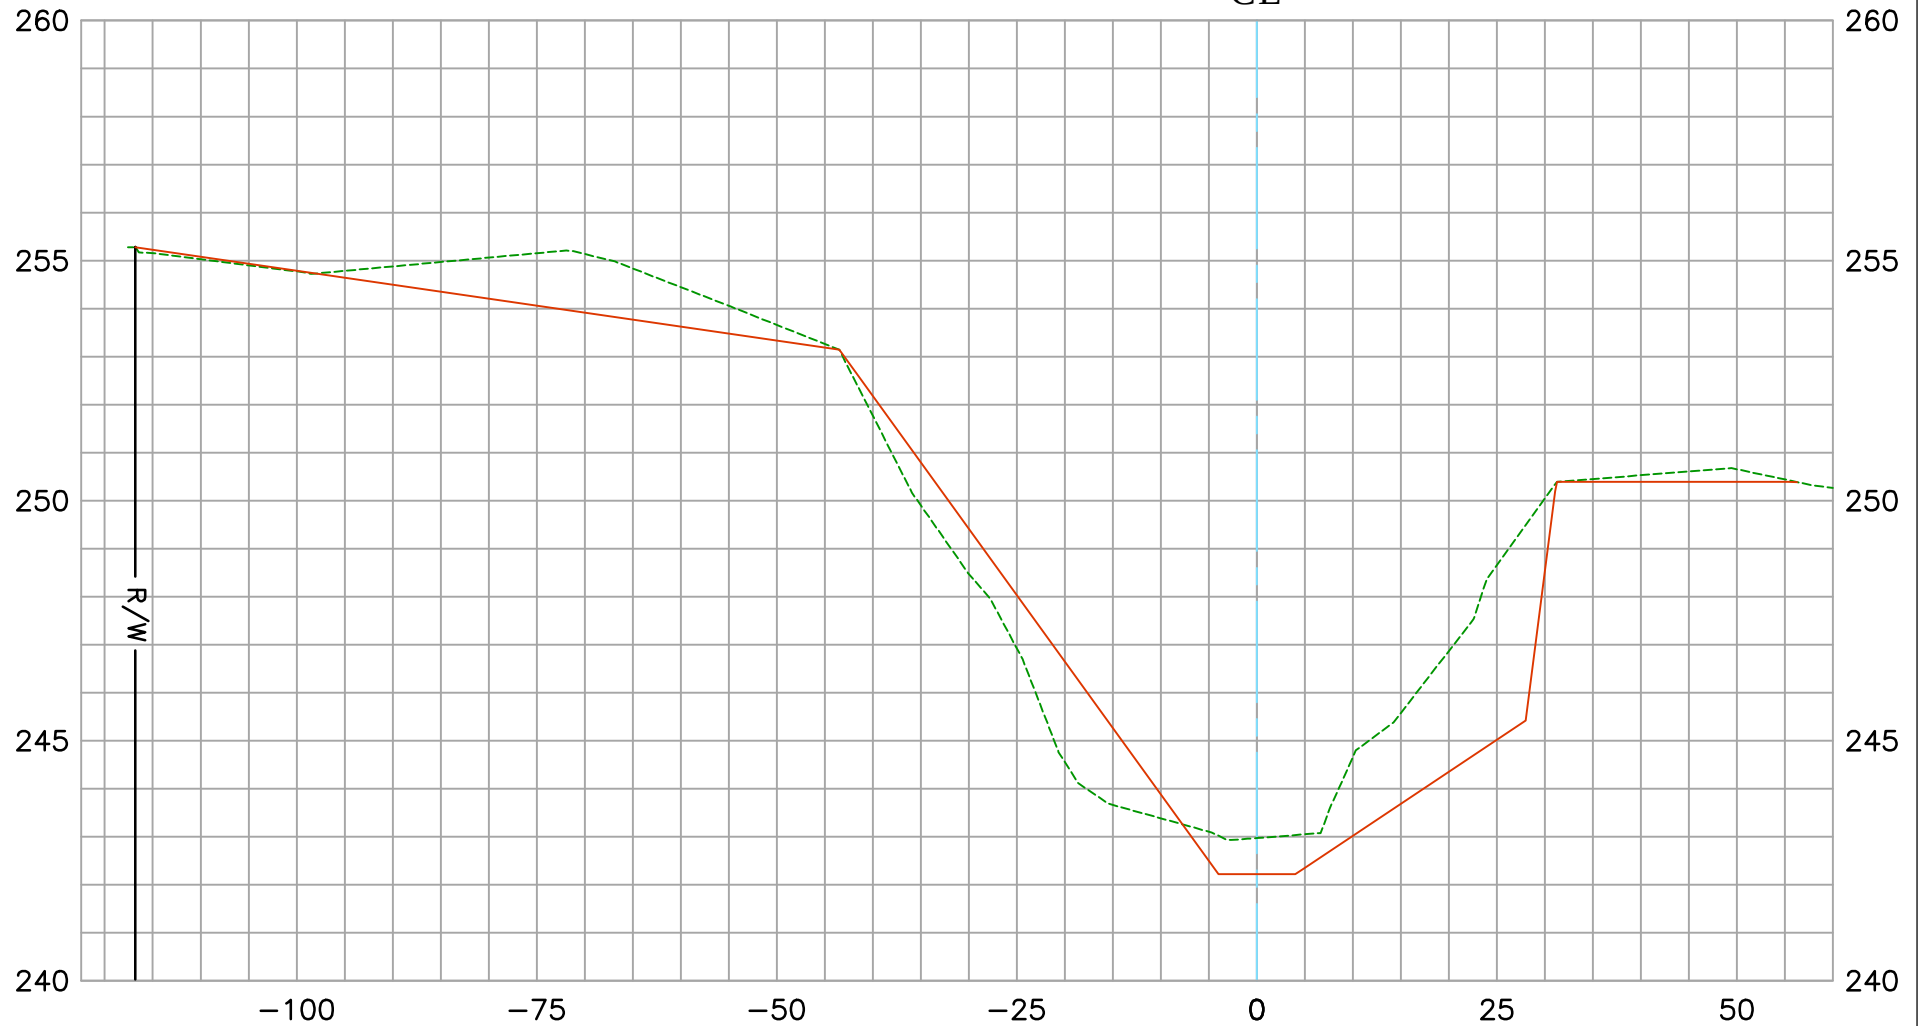

EXISTING CONDITION 03/18/2021
RECORD DRAWINGS:
F23-701-1, F23-701-2, & F23-701-3
DATE PREPARED: 11/01/2021

Vert. Scale: 1"=4'
Hor. Scale: 1"=20'

U.S. Survey
Foot

OC Public Works
OC Survey/Field Services
Boundary Analysis & Mapping

CAÑADA CHANNEL (F23)

10+50.00

CL



EXISTING CONDITION 03/18/2021
RECORD DRAWINGS:
F23-701-1, F23-701-2, & F23-701-3
DATE PREPARED: 11/01/2021

Vert. Scale: 1"=4'
Hor. Scale: 1"=20'


U.S. Survey Foot

OC Public Works
OC Survey/Field Services
Boundary Analysis & Mapping

CAÑADA CHANNEL (F23)

11+00.00

CL

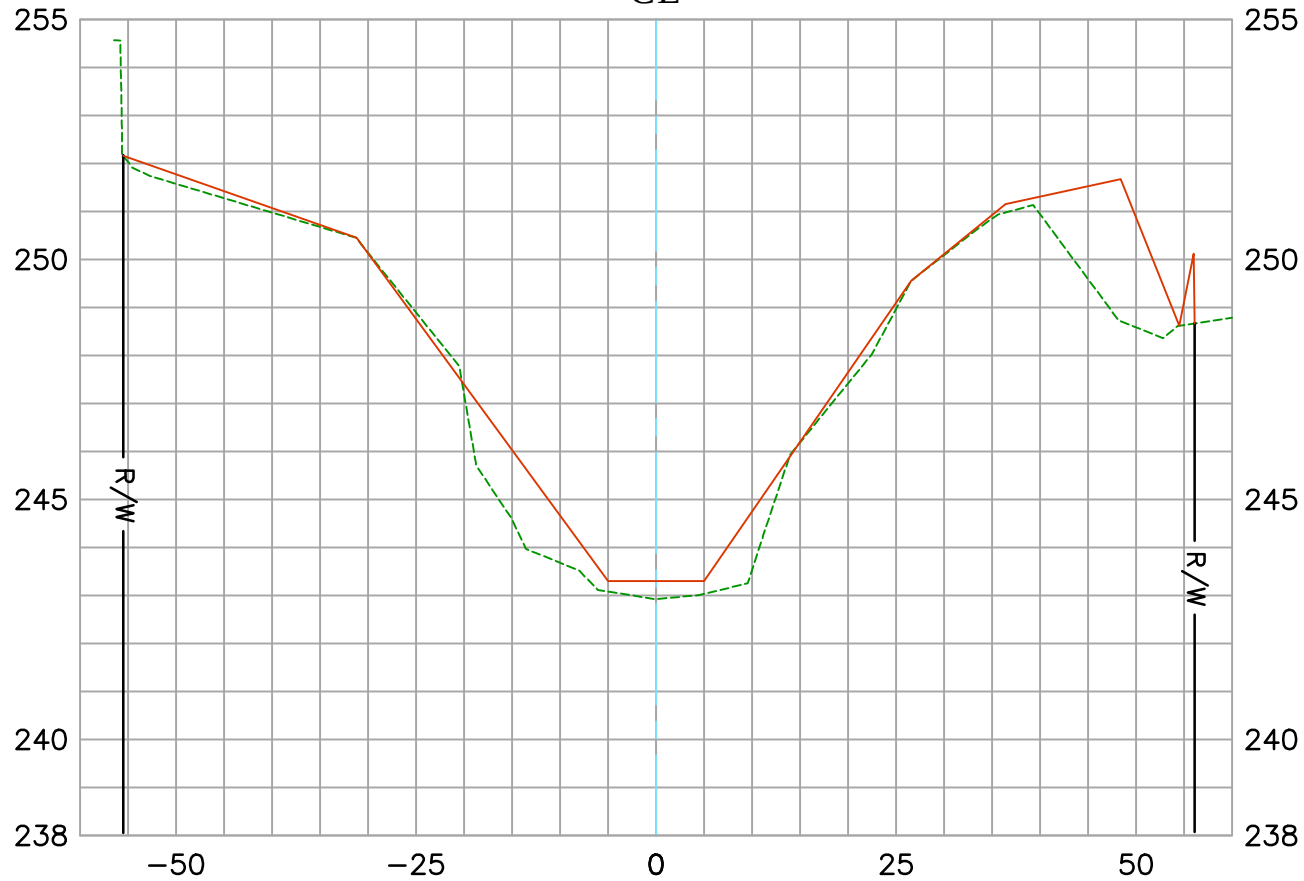

EXISTING CONDITION 03/18/2021
RECORD DRAWINGS:
F23-701-1, F23-701-2, & F23-701-3
DATE PREPARED: 11/01/2021

Vert. Scale: 1"=4'
Hor. Scale: 1"=20'


U.S. Survey Foot

OC Public Works
OC Survey/Field Services
Boundary Analysis & Mapping

CAÑADA CHANNEL (F23)

11+50.00

CL

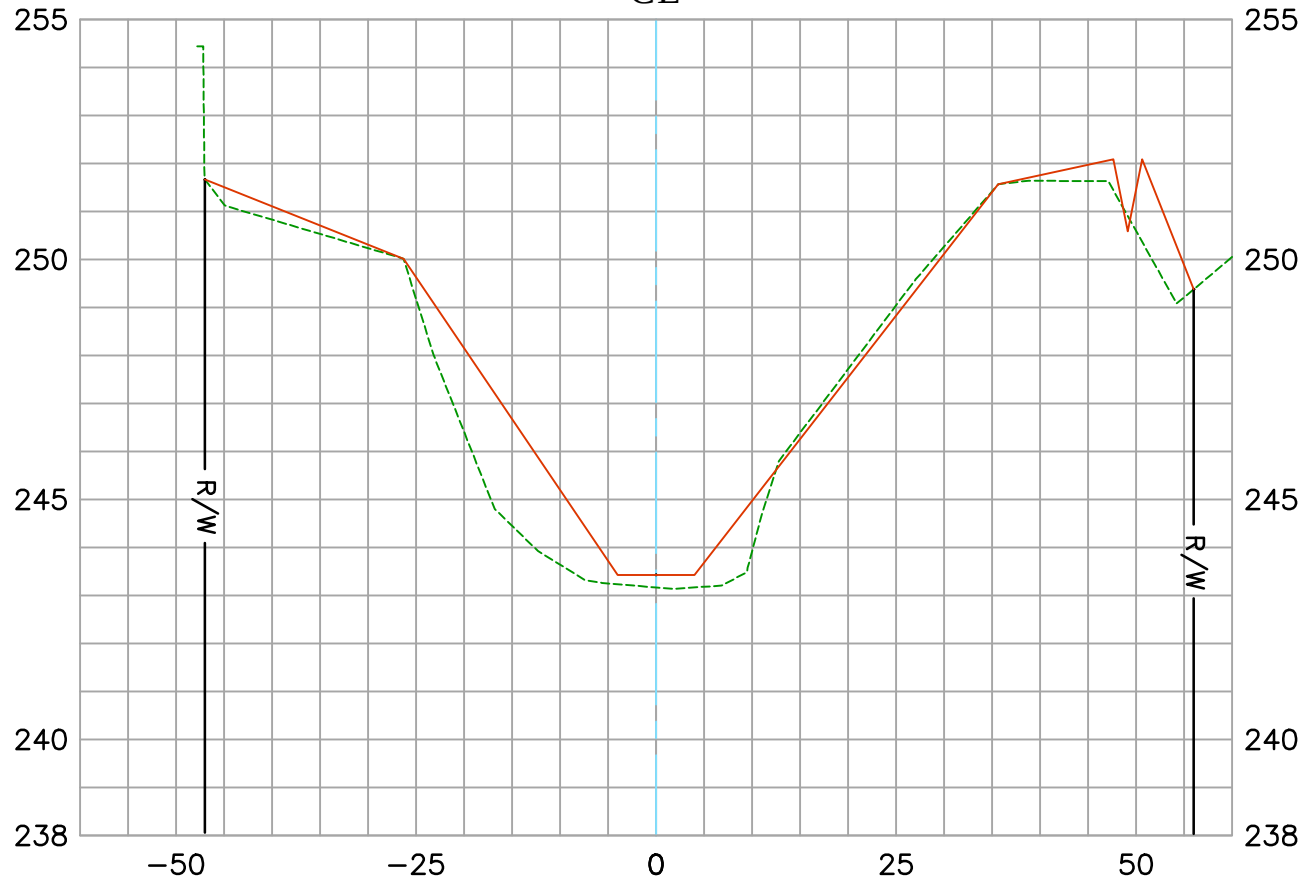

EXISTING CONDITION 03/18/2021
RECORD DRAWINGS:
F23-701-1, F23-701-2, & F23-701-3
DATE PREPARED: 11/01/2021

Vert. Scale: 1"=4'
Hor. Scale: 1"=20'


U.S. Survey Foot

OC Public Works
OC Survey/Field Services
Boundary Analysis & Mapping

CAÑADA CHANNEL (F23)

12+00.00

CL

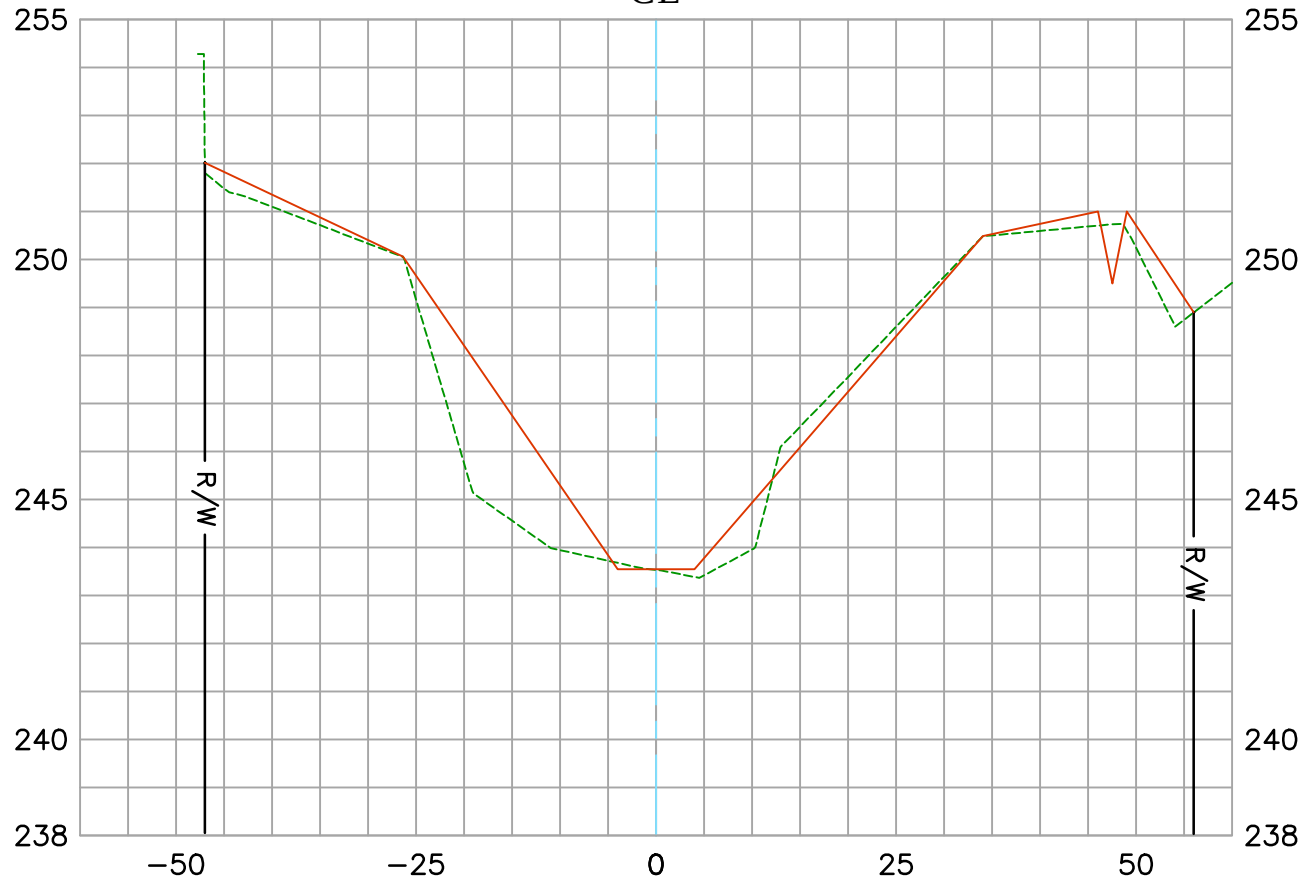

EXISTING CONDITION 03/18/2021
RECORD DRAWINGS:
F23-701-1, F23-701-2, & F23-701-3
DATE PREPARED: 11/01/2021

Vert. Scale: 1"=4'
Hor. Scale: 1"=20'

U.S. *Survey*
Foot


OC Public Works
OC Survey/Field Services
Boundary Analysis & Mapping



CAÑADA CHANNEL (F23)

12+50.00

CL

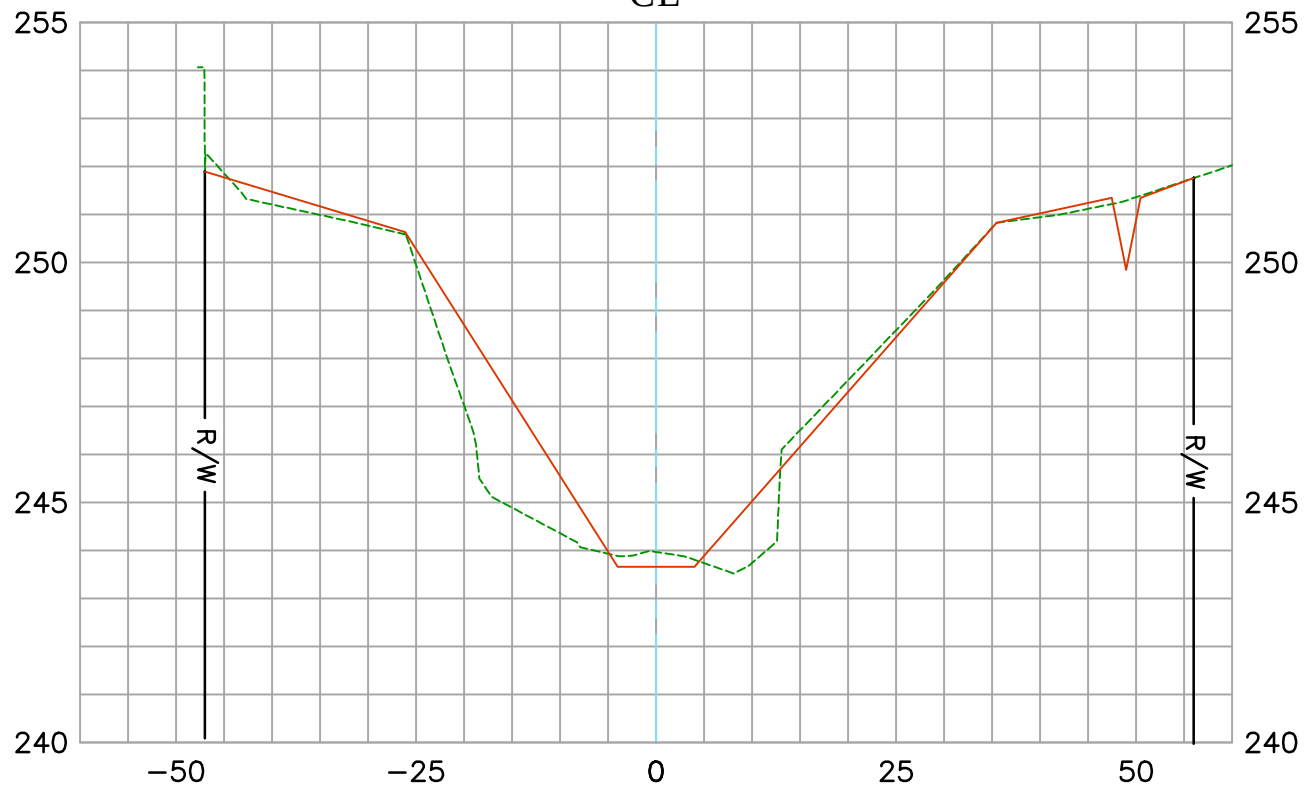

EXISTING CONDITION 03/18/2021
RECORD DRAWINGS:
F23-701-1, F23-701-2, & F23-701-3
DATE PREPARED: 11/01/2021

Vert. Scale: 1"=4'
Hor. Scale: 1"=20'


U.S. Survey Foot

OC Public Works
OC Survey/Field Services
Boundary Analysis & Mapping

CAÑADA CHANNEL (F23)

13+00.00

CL

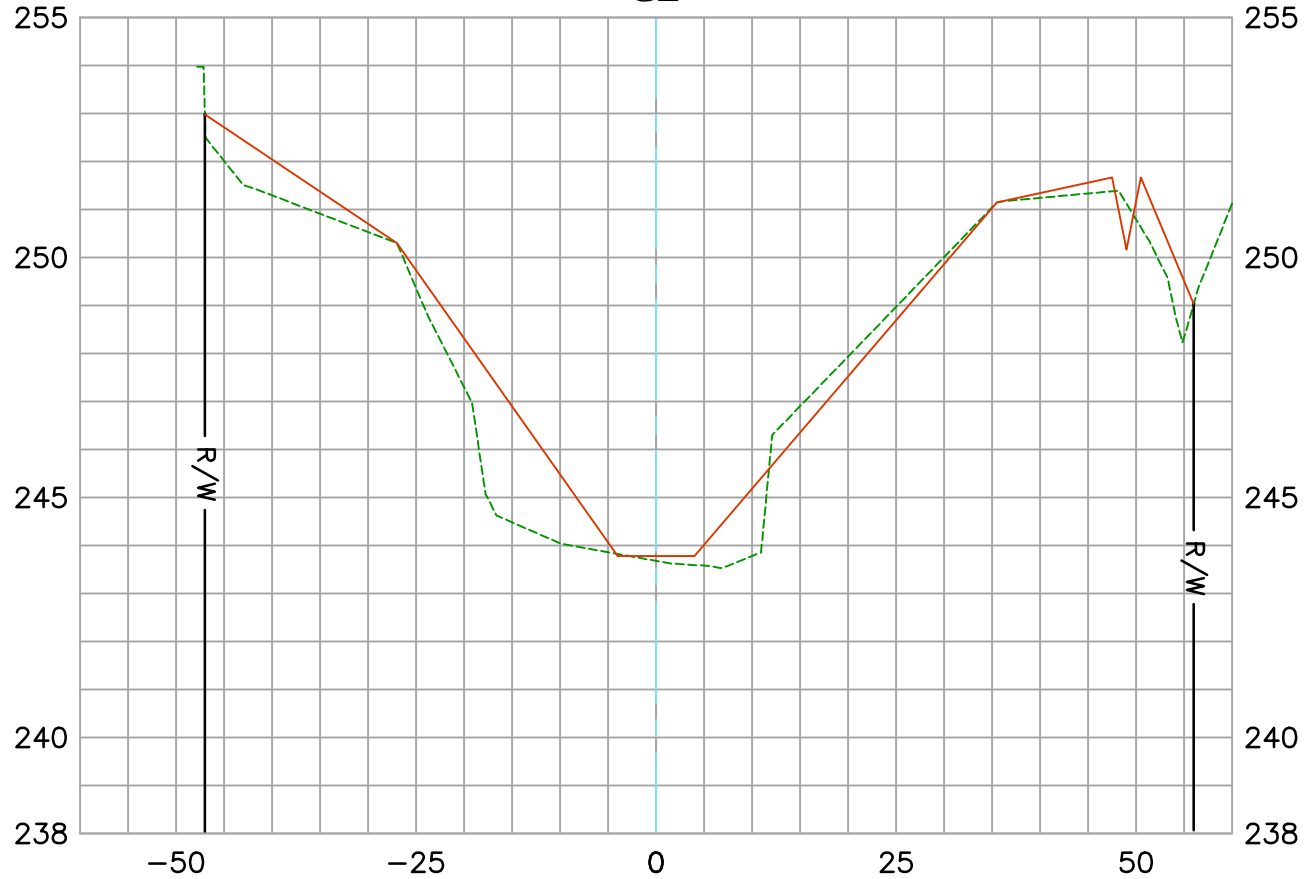


EXISTING CONDITION 03/18/2021
RECORD DRAWINGS:
F23-701-1, F23-701-2, & F23-701-3
DATE PREPARED: 11/01/2021

Vert. Scale: 1"=4'
Hor. Scale: 1"=20'

U.S. *Survey*
Foot


OC Public Works
OC Survey/Field Services
Boundary Analysis & Mapping

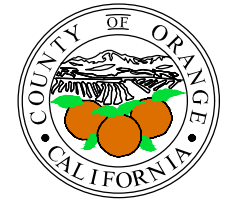

CAÑADA CHANNEL (F23)

13+50.00

CL

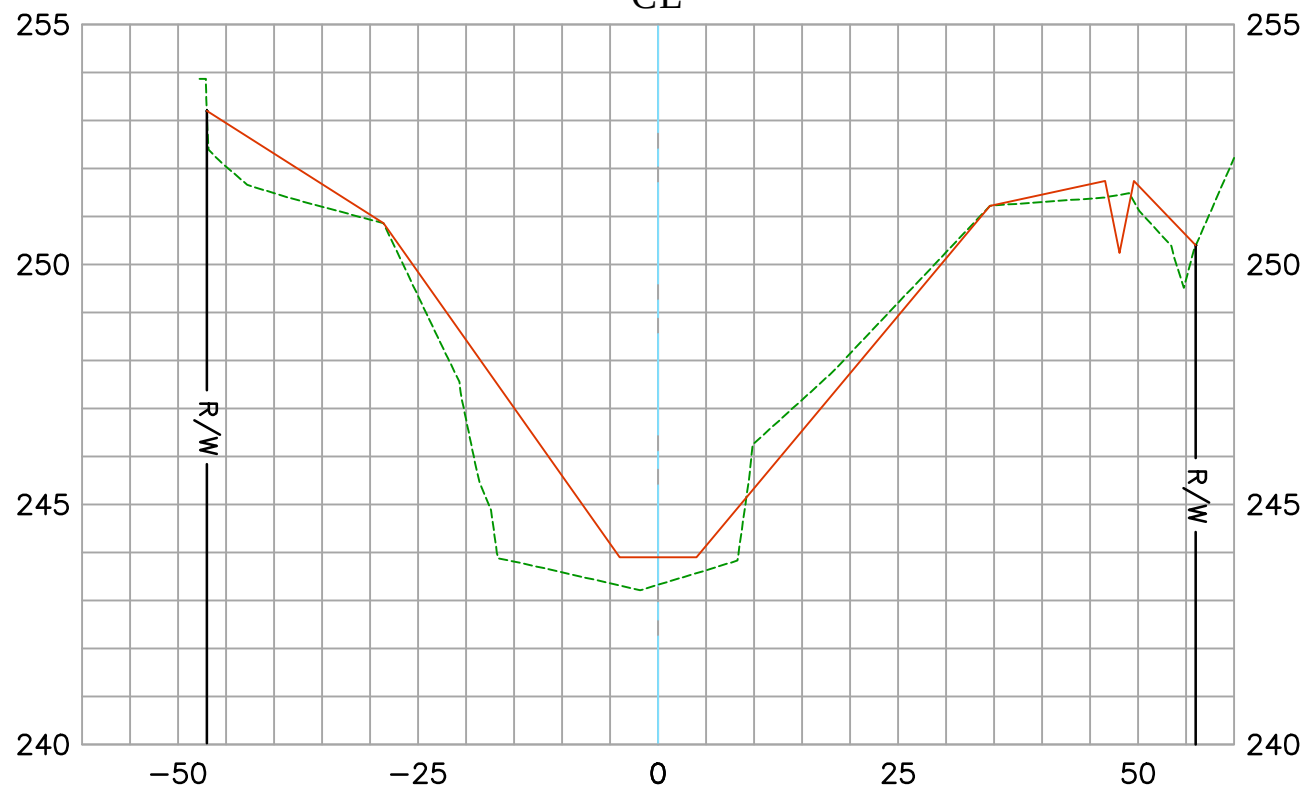

EXISTING CONDITION 03/18/2021
RECORD DRAWINGS:
F23-701-1, F23-701-2, & F23-701-3
DATE PREPARED: 11/01/2021

Vert. Scale: 1"=4'
Hor. Scale: 1"=20'


U.S. *Survey*
Foot

OC Public Works
OC Survey/Field Services
Boundary Analysis & Mapping

CAÑADA CHANNEL (F23)

14+00.00

CL

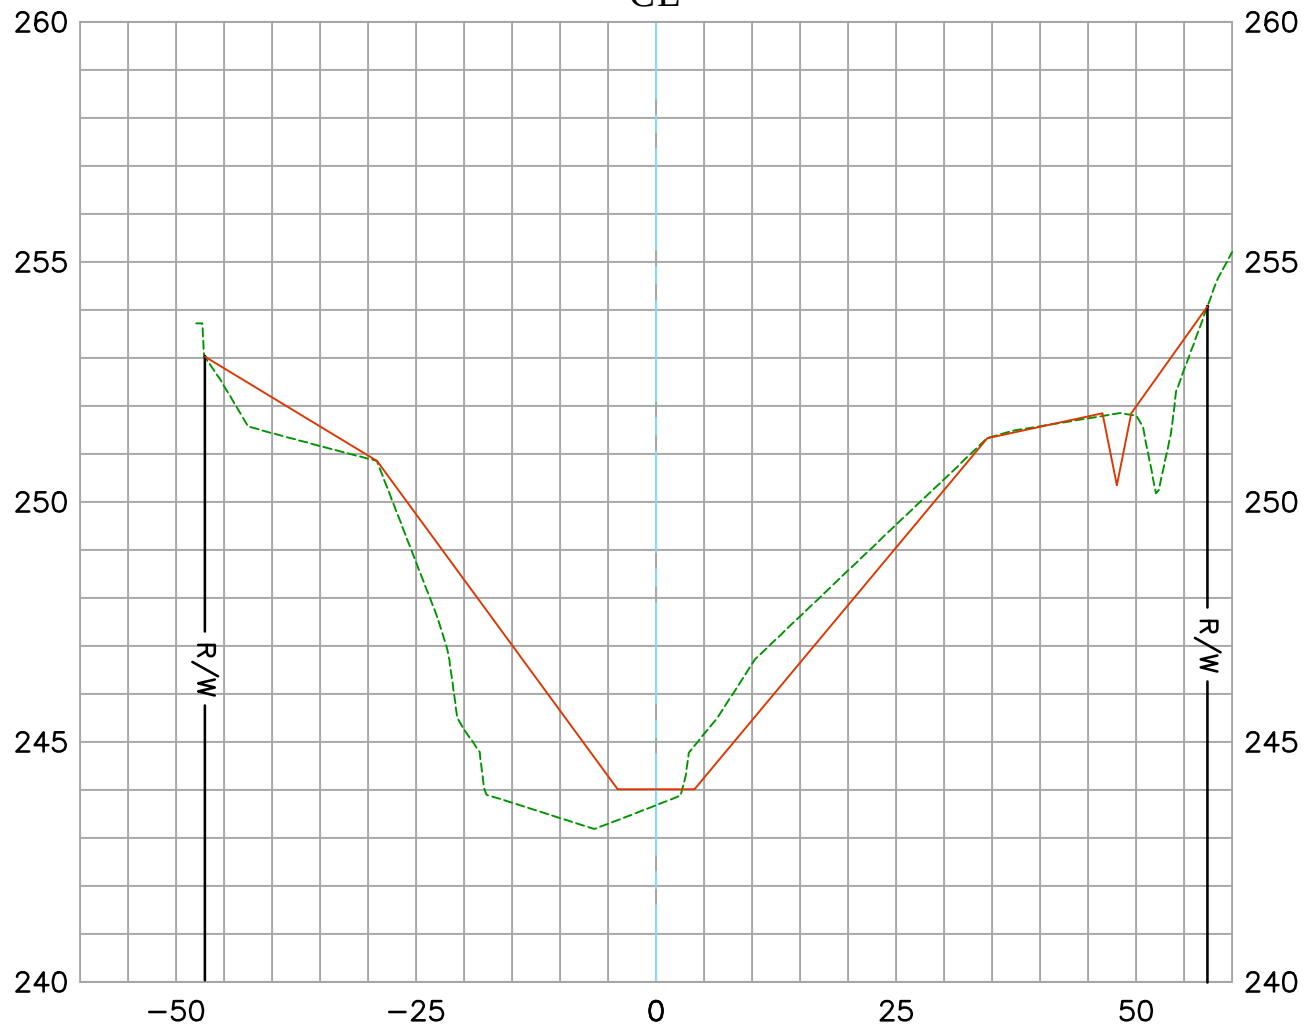

EXISTING CONDITION 03/18/2021
RECORD DRAWINGS:
F23-701-1, F23-701-2, & F23-701-3
DATE PREPARED: 11/01/2021

Vert. Scale: 1"=4'
Hor. Scale: 1"=20'


U.S. *Survey*
Foot

OC Public Works
OC Survey/Field Services
Boundary Analysis & Mapping

CAÑADA CHANNEL (F23)

14+50.00

CL

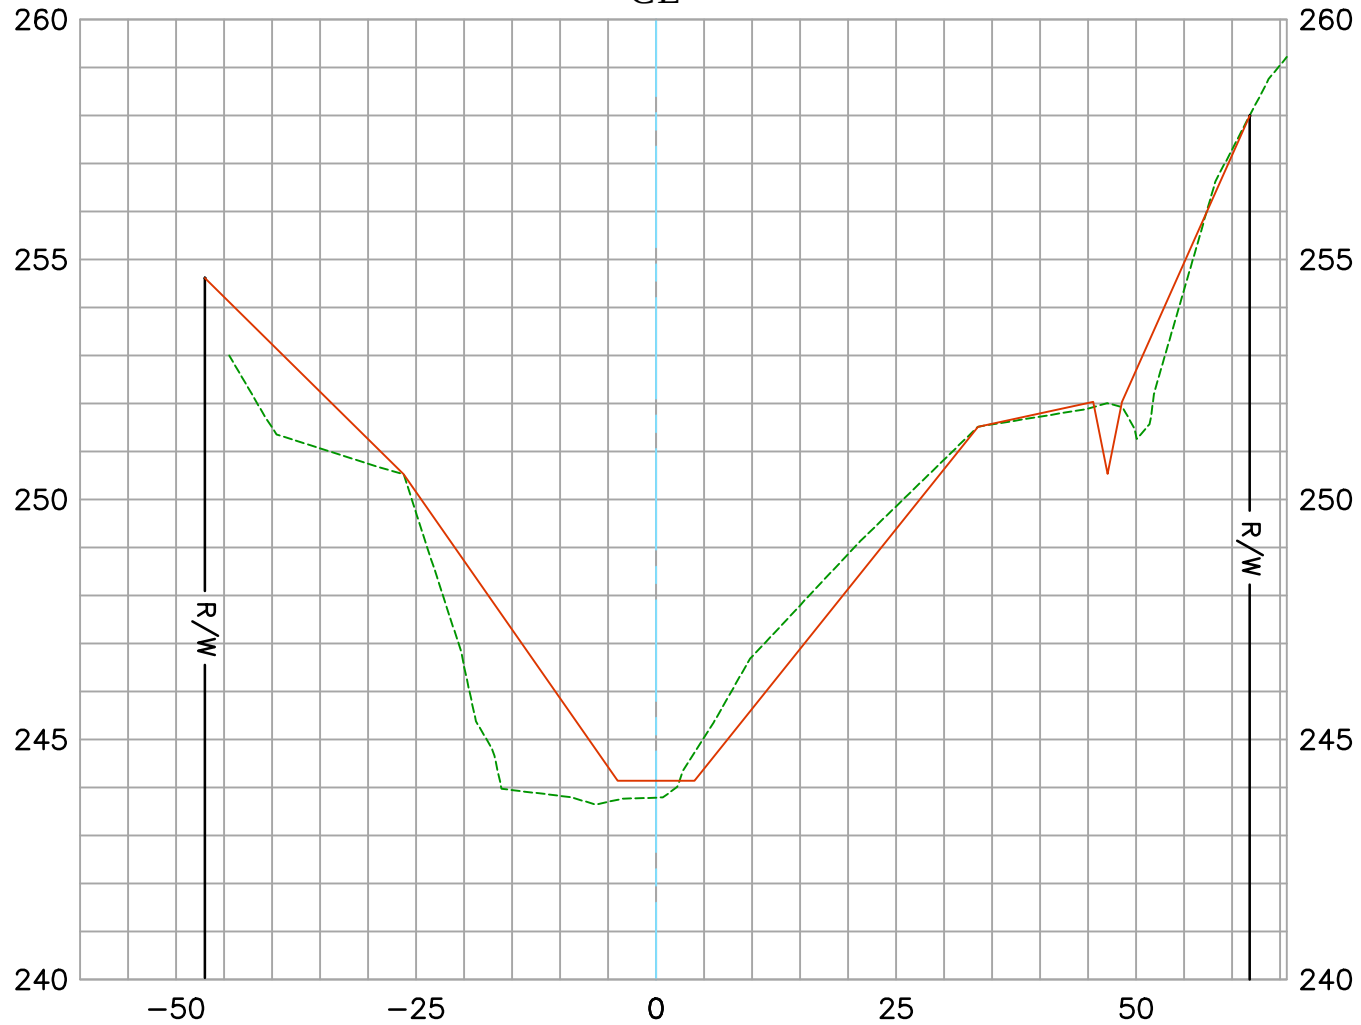

EXISTING CONDITION 03/18/2021
RECORD DRAWINGS:
F23-701-1, F23-701-2, & F23-701-3
DATE PREPARED: 11/01/2021

Vert. Scale: 1"=4'
Hor. Scale: 1"=20'

U.S. *Survey*
Foot


OC Public Works
OC Survey/Field Services
Boundary Analysis & Mapping



CAÑADA CHANNEL (F23)

15+00.00

CL

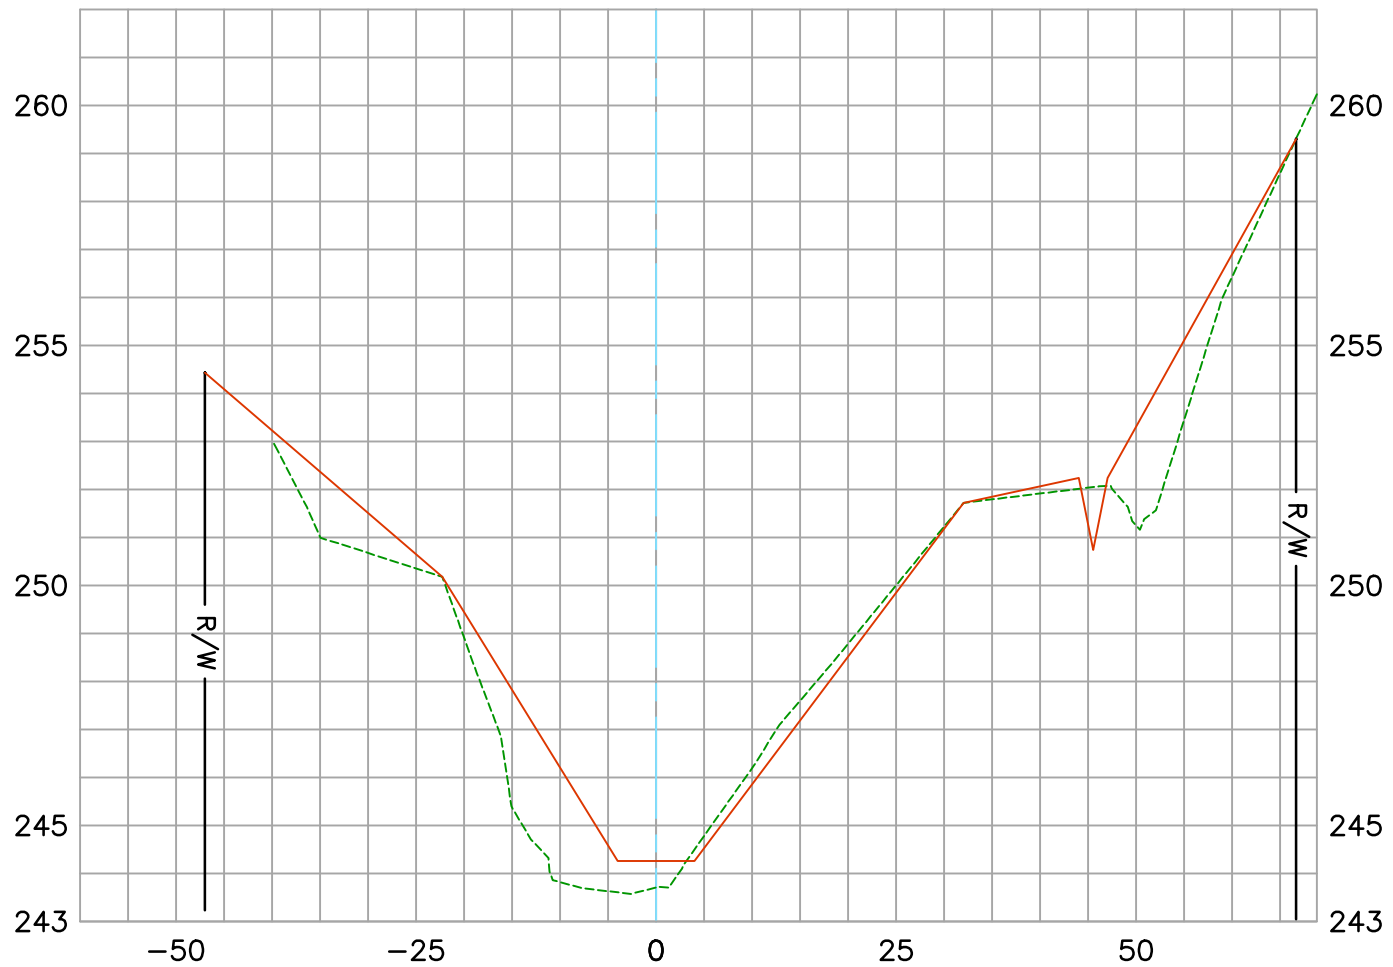

EXISTING CONDITION 03/18/2021
RECORD DRAWINGS:
F23-701-1, F23-701-2, & F23-701-3
DATE PREPARED: 11/01/2021

Vert. Scale: 1"=4'
Hor. Scale: 1"=20'


U.S. *Survey*
Foot

OC Public Works
OC Survey/Field Services
Boundary Analysis & Mapping

CAÑADA CHANNEL (F23)

15+50.00

CL

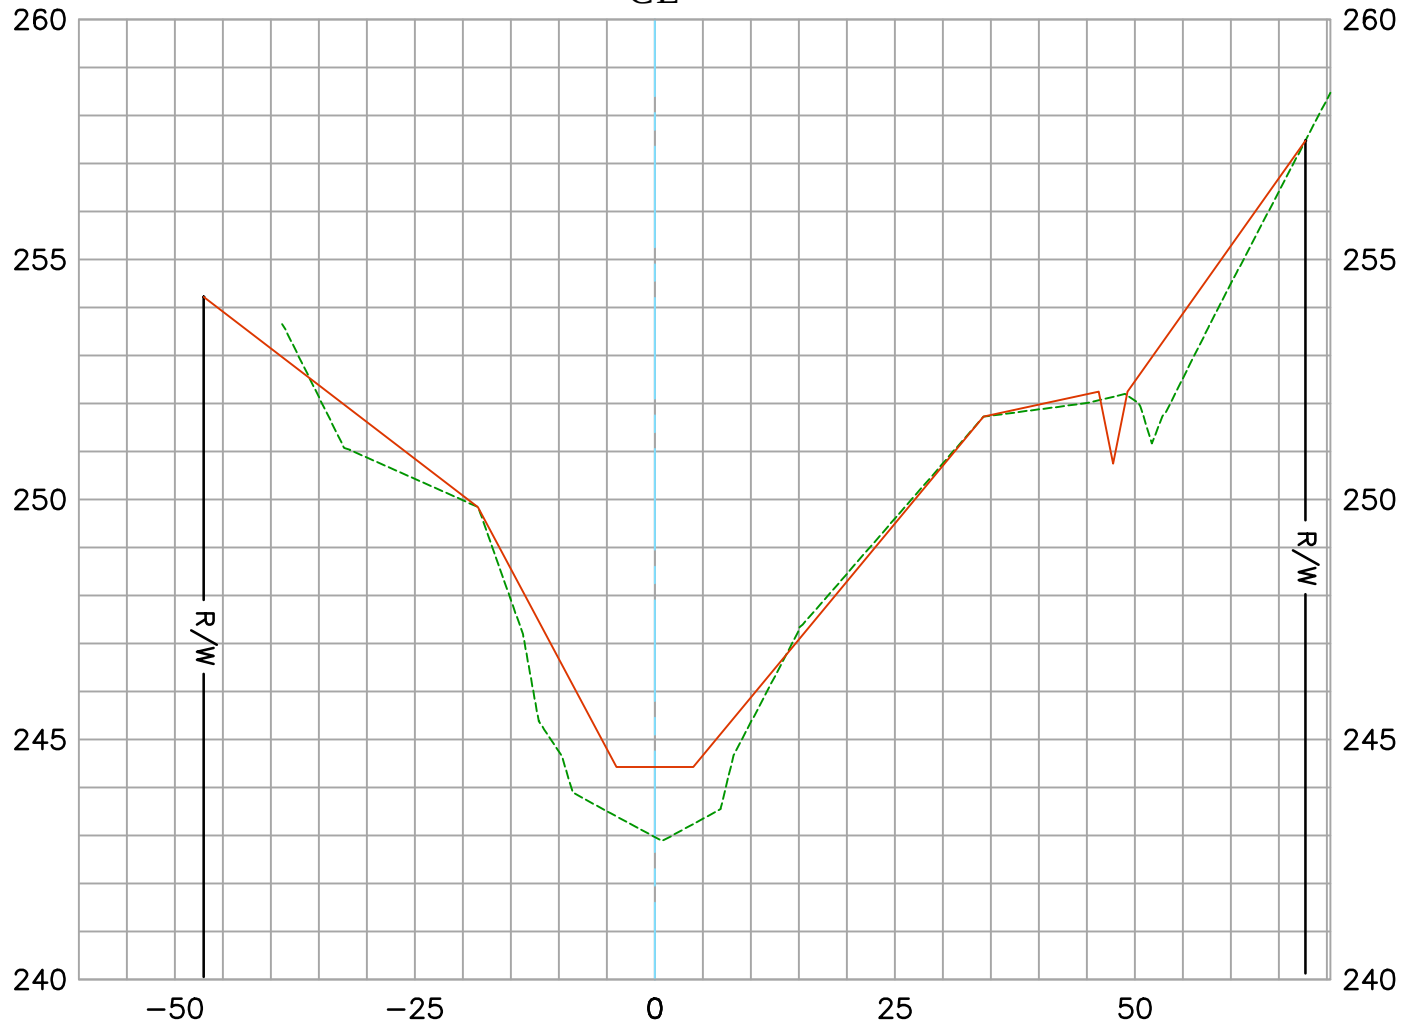

EXISTING CONDITION 03/18/2021
RECORD DRAWINGS:
F23-701-1, F23-701-2, & F23-701-3
DATE PREPARED: 11/01/2021

Vert. Scale: 1"=4'
Hor. Scale: 1"=20'



U.S. *Survey*
Foot

OC Public Works
OC Survey/Field Services
Boundary Analysis & Mapping

CAÑADA CHANNEL (F23)

16+00.00

CL

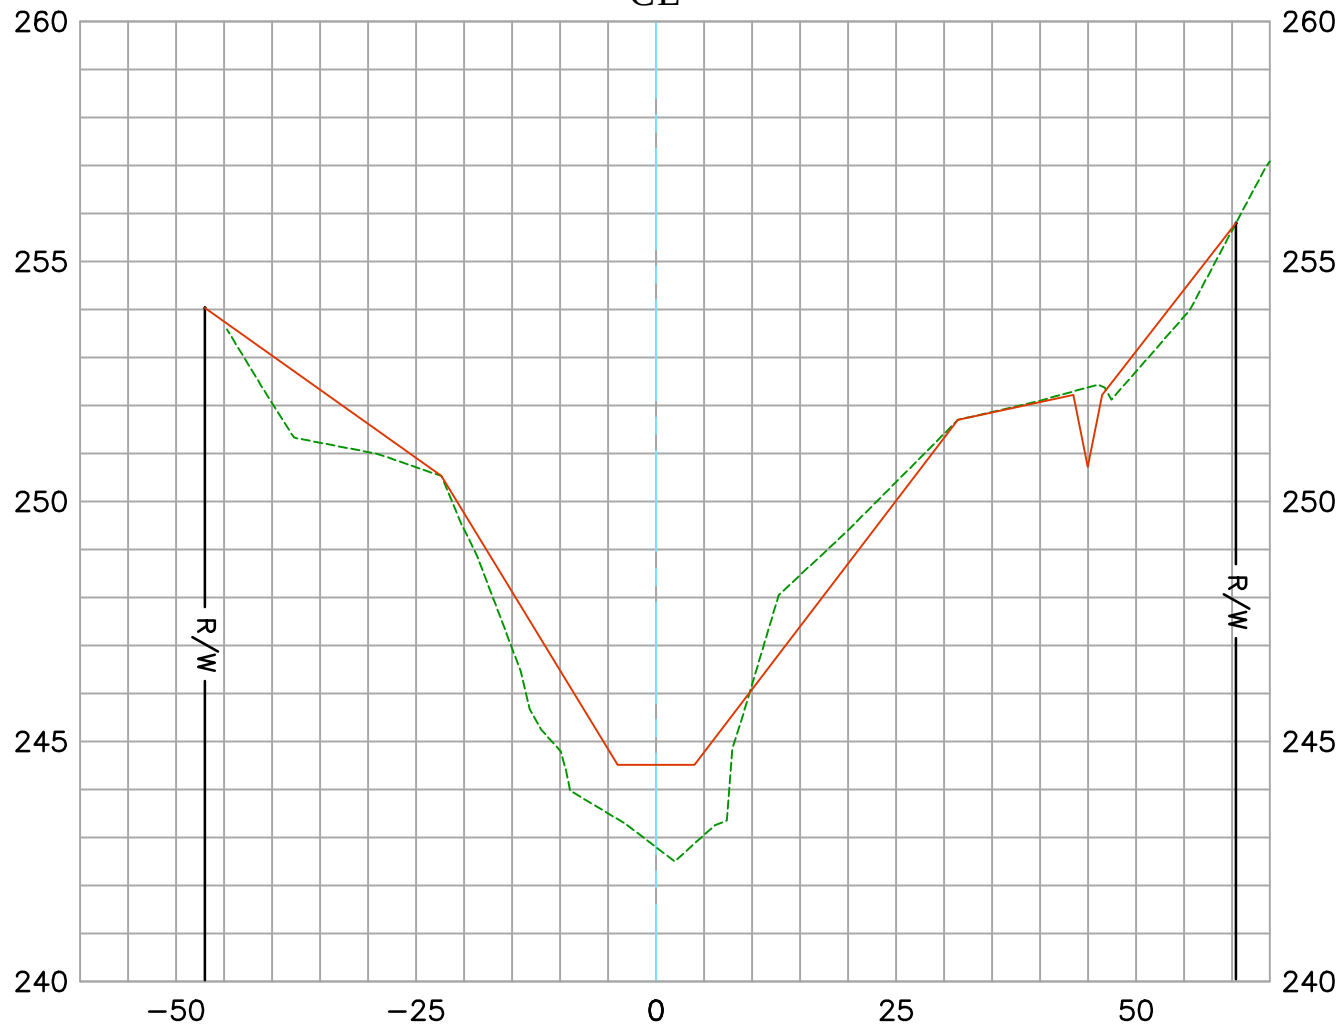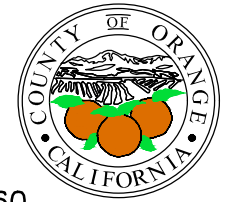

EXISTING CONDITION 03/18/2021
RECORD DRAWINGS:
F23-701-1, F23-701-2, & F23-701-3
DATE PREPARED: 11/01/2021

Vert. Scale: 1"=4'
Hor. Scale: 1"=20'



U.S. *Survey*
Foot

OC Public Works
OC Survey/Field Services
Boundary Analysis & Mapping

CAÑADA CHANNEL (F23)

16+50.00

CL

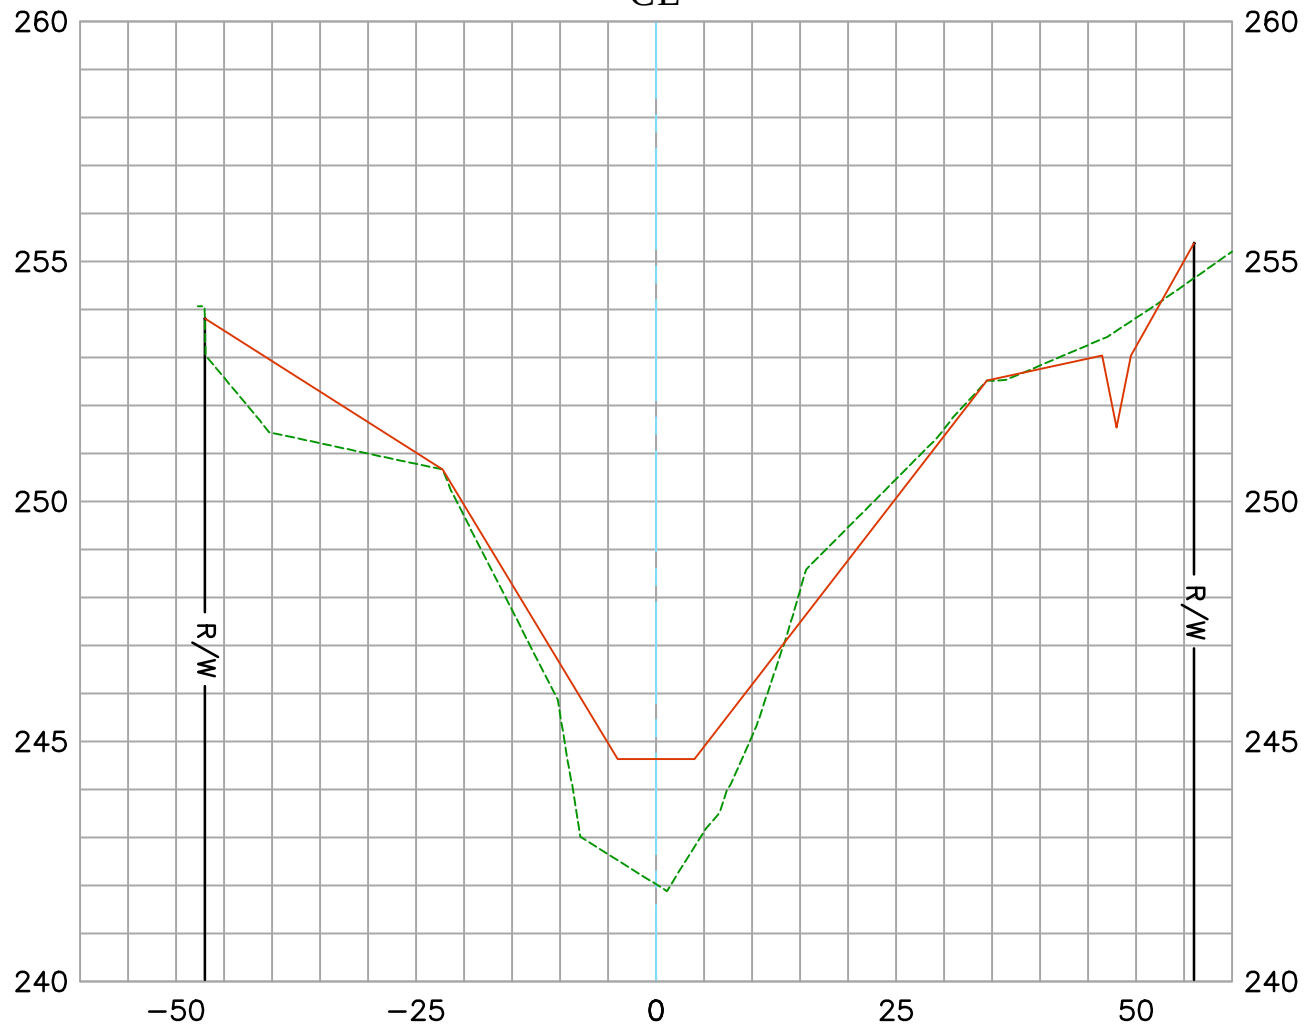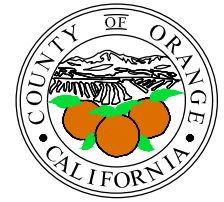

EXISTING CONDITION 03/18/2021
RECORD DRAWINGS:
F23-701-1, F23-701-2, & F23-701-3
DATE PREPARED: 11/01/2021

Vert. Scale: 1"=4'
Hor. Scale: 1"=20'


U.S. *Survey Foot*

OC Public Works
OC Survey/Field Services
Boundary Analysis & Mapping

CAÑADA CHANNEL (F23)

17+00.00

CL

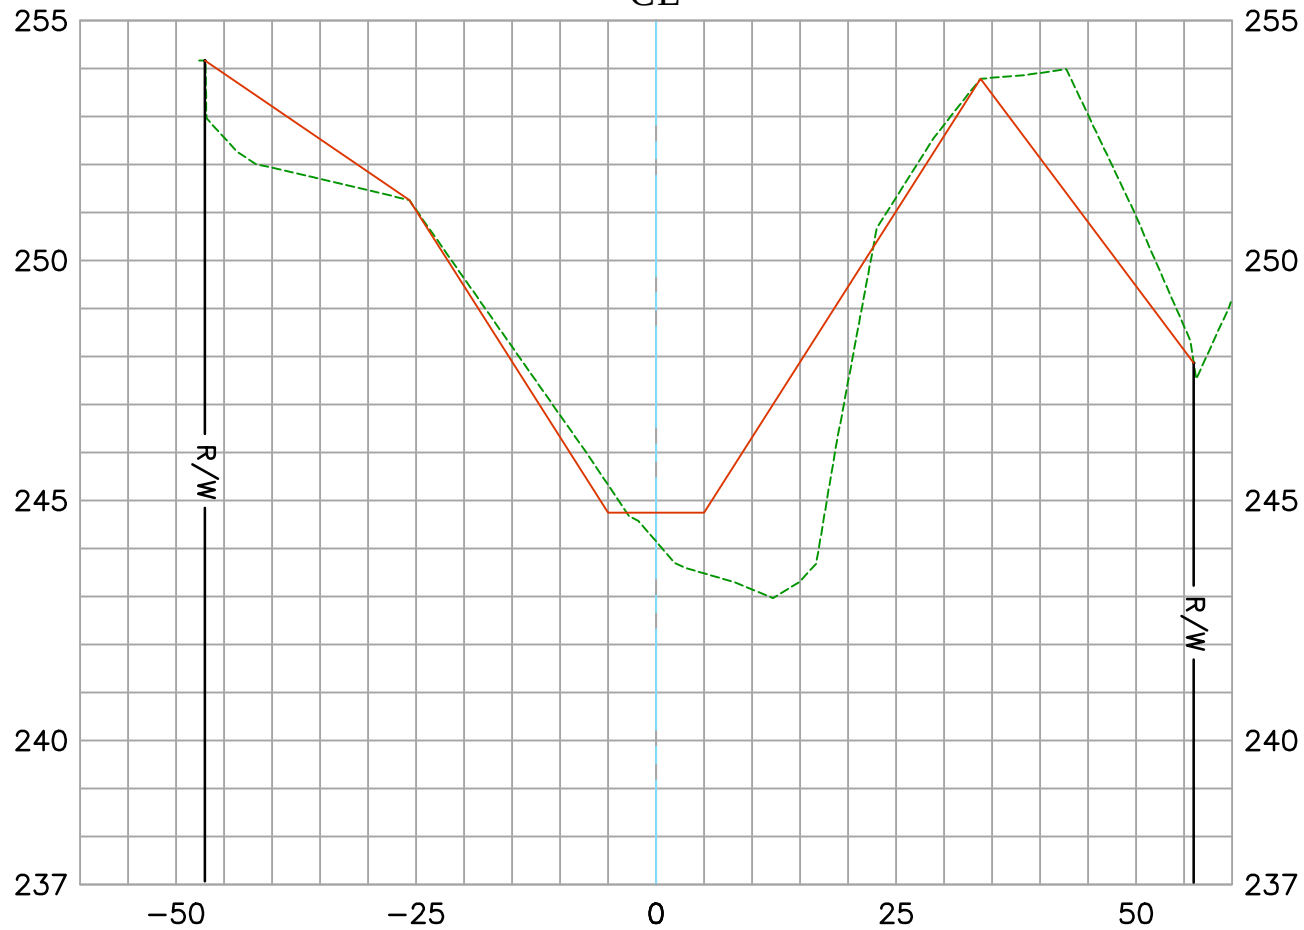

EXISTING CONDITION 03/18/2021
RECORD DRAWINGS:
F23-701-1, F23-701-2, & F23-701-3
DATE PREPARED: 11/01/2021

Vert. Scale: 1"=4'
Hor. Scale: 1"=20'


U.S. Survey Foot

OC Public Works
OC Survey/Field Services
Boundary Analysis & Mapping

CAÑADA CHANNEL (F23)

17+50.00

CL

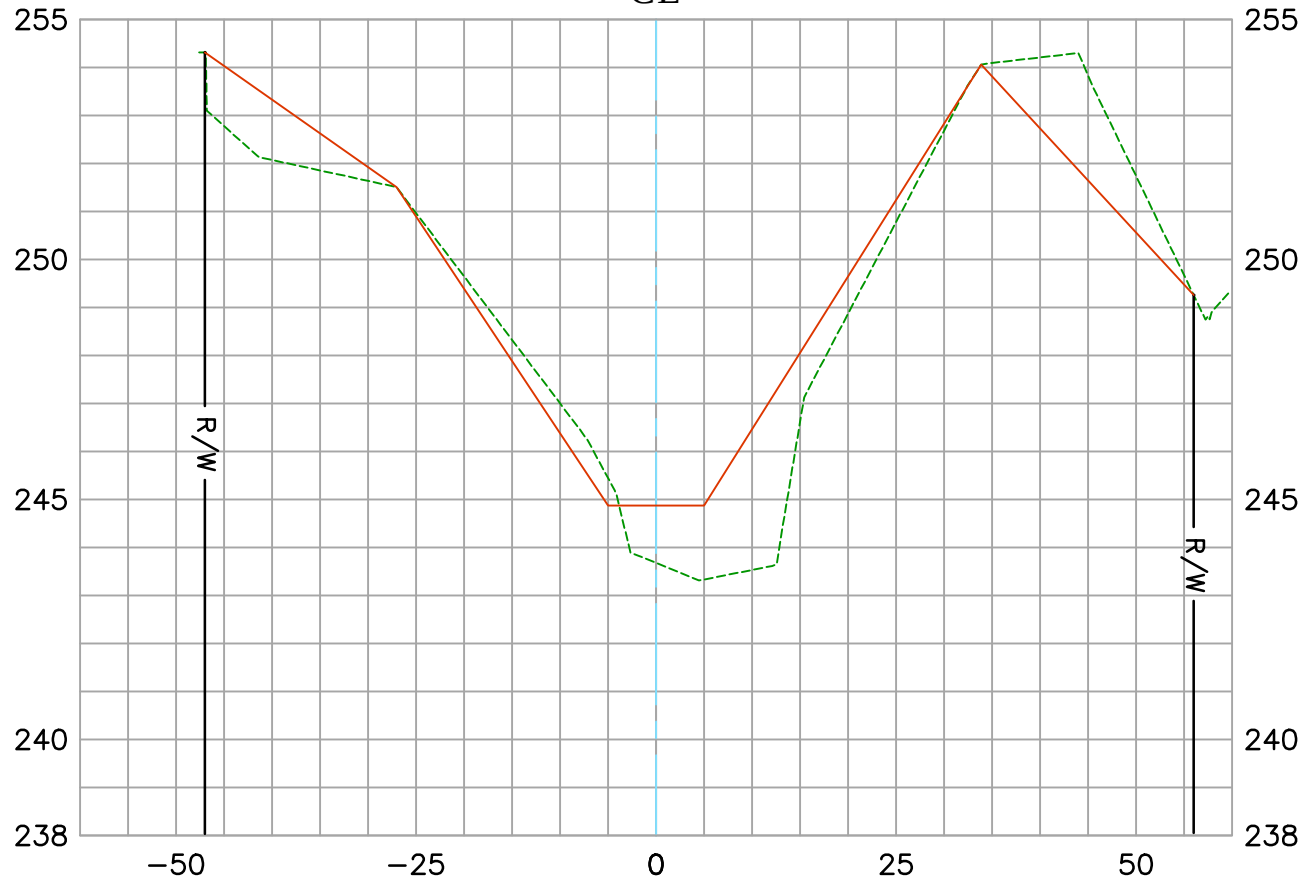

EXISTING CONDITION 03/18/2021
RECORD DRAWINGS:
F23-701-1, F23-701-2, & F23-701-3
DATE PREPARED: 11/01/2021

Vert. Scale: 1"=4'
Hor. Scale: 1"=20'


U.S. Survey Foot

OC Public Works
OC Survey/Field Services
Boundary Analysis & Mapping

CAÑADA CHANNEL (F23)

18+00.00

CL

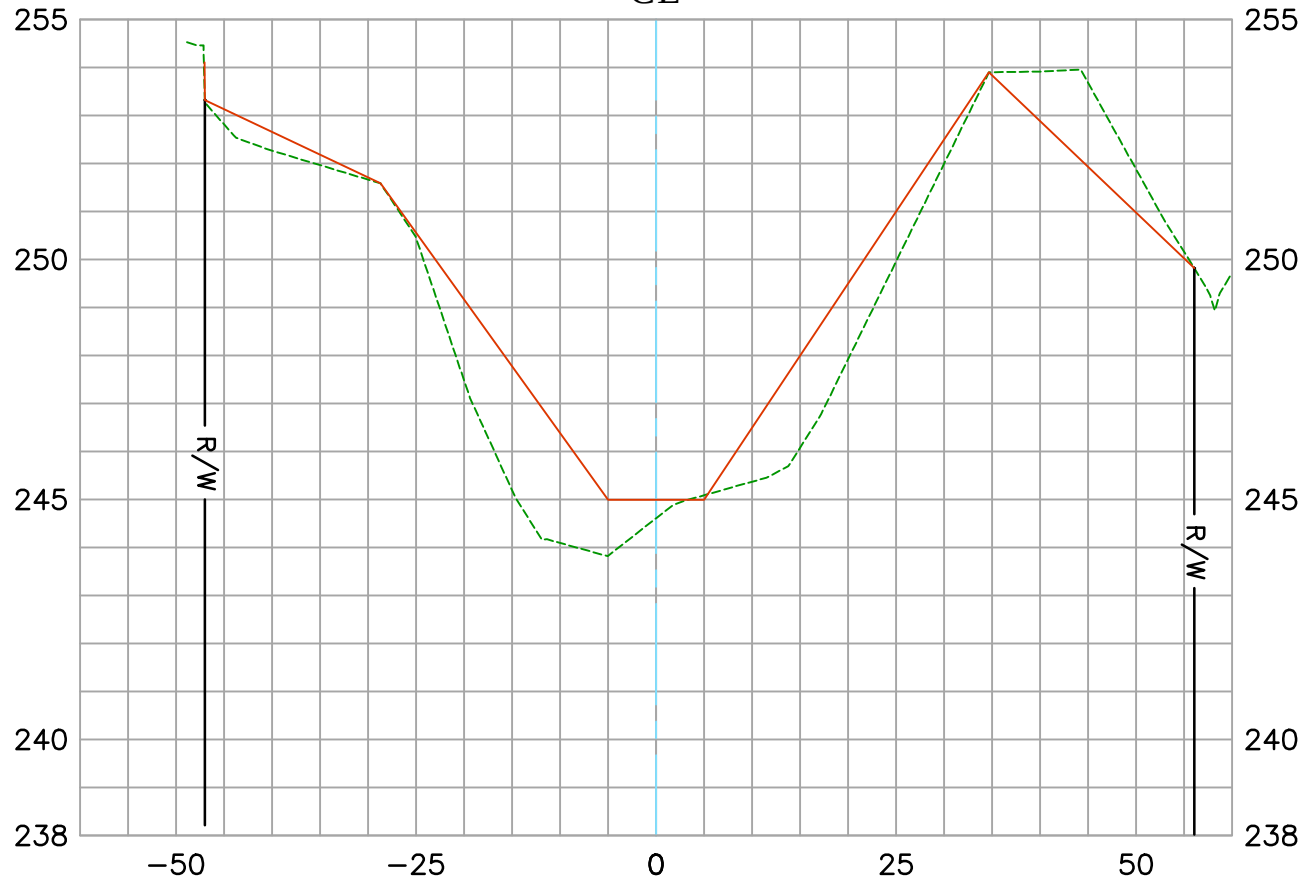

EXISTING CONDITION 03/18/2021
RECORD DRAWINGS:
F23-701-1, F23-701-2, & F23-701-3
DATE PREPARED: 11/01/2021


Vert. Scale: 1"=4'
Hor. Scale: 1"=20'

U.S. *Survey*
Foot

OC Public Works
OC Survey/Field Services
Boundary Analysis & Mapping



CAÑADA CHANNEL (F23)
18+50.00
CL

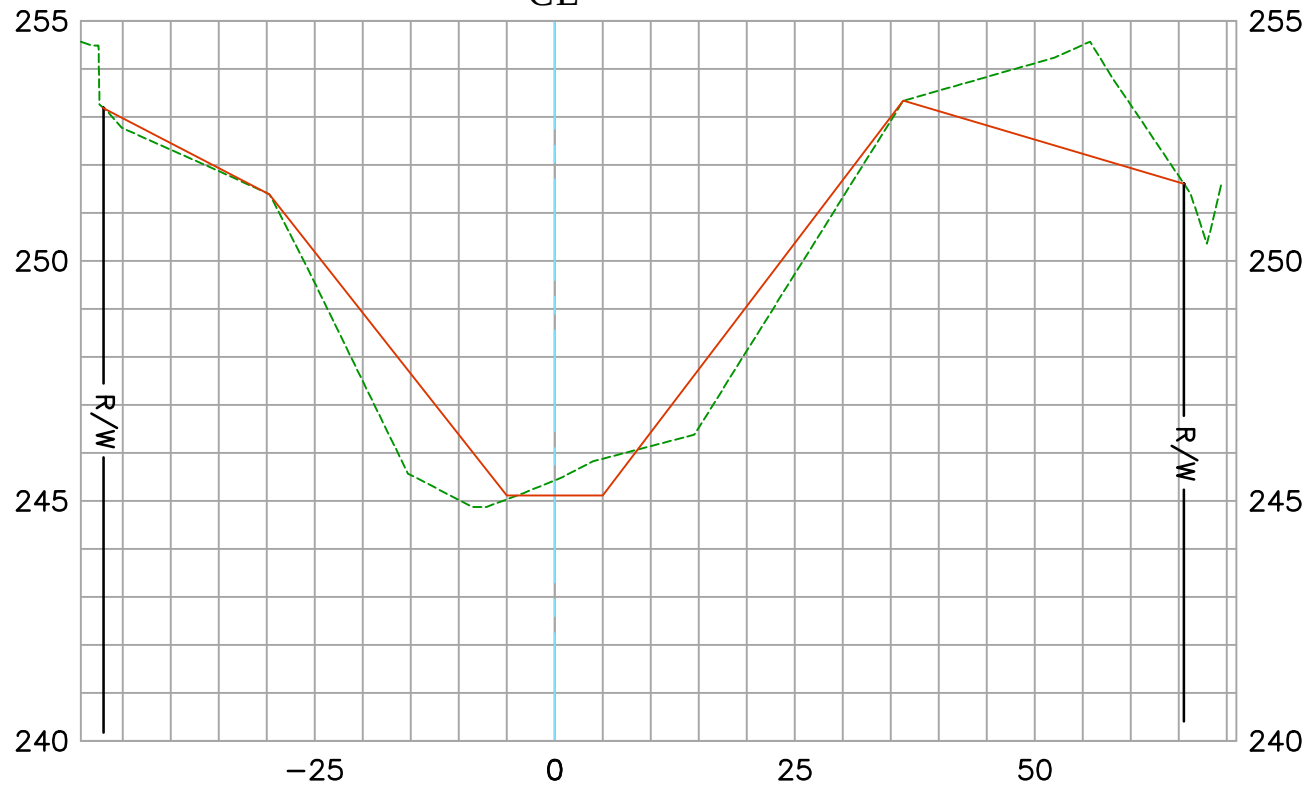

EXISTING CONDITION 03/18/2021
RECORD DRAWINGS:
F23-701-1, F23-701-2, & F23-701-3
DATE PREPARED: 11/01/2021

Vert. Scale: 1"=4'
Hor. Scale: 1"=20'

U.S. *Survey
Foot*


OC Public Works
OC Survey/Field Services
Boundary Analysis & Mapping



CAÑADA CHANNEL (F23)

19+00.00

CL

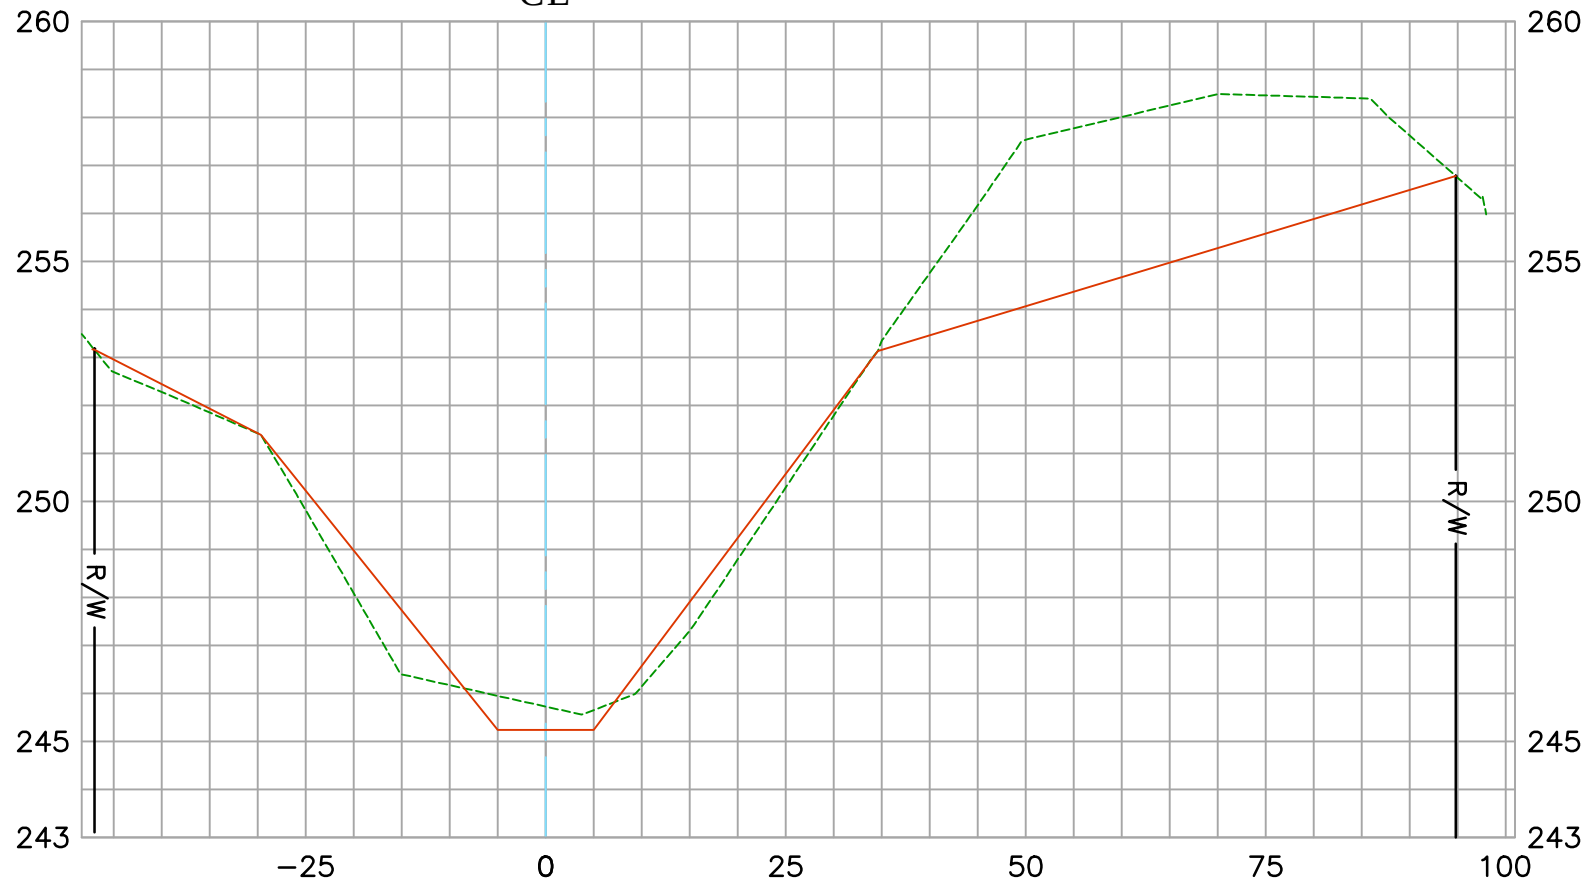

EXISTING CONDITION 03/18/2021
RECORD DRAWINGS:
F23-701-1, F23-701-2, & F23-701-3
DATE PREPARED: 11/01/2021

Vert. Scale: 1"=4'
Hor. Scale: 1"=20'


U.S. *Survey Foot*

OC Public Works
OC Survey/Field Services
Boundary Analysis & Mapping

CAÑADA CHANNEL (F23)

19+50.00

CL

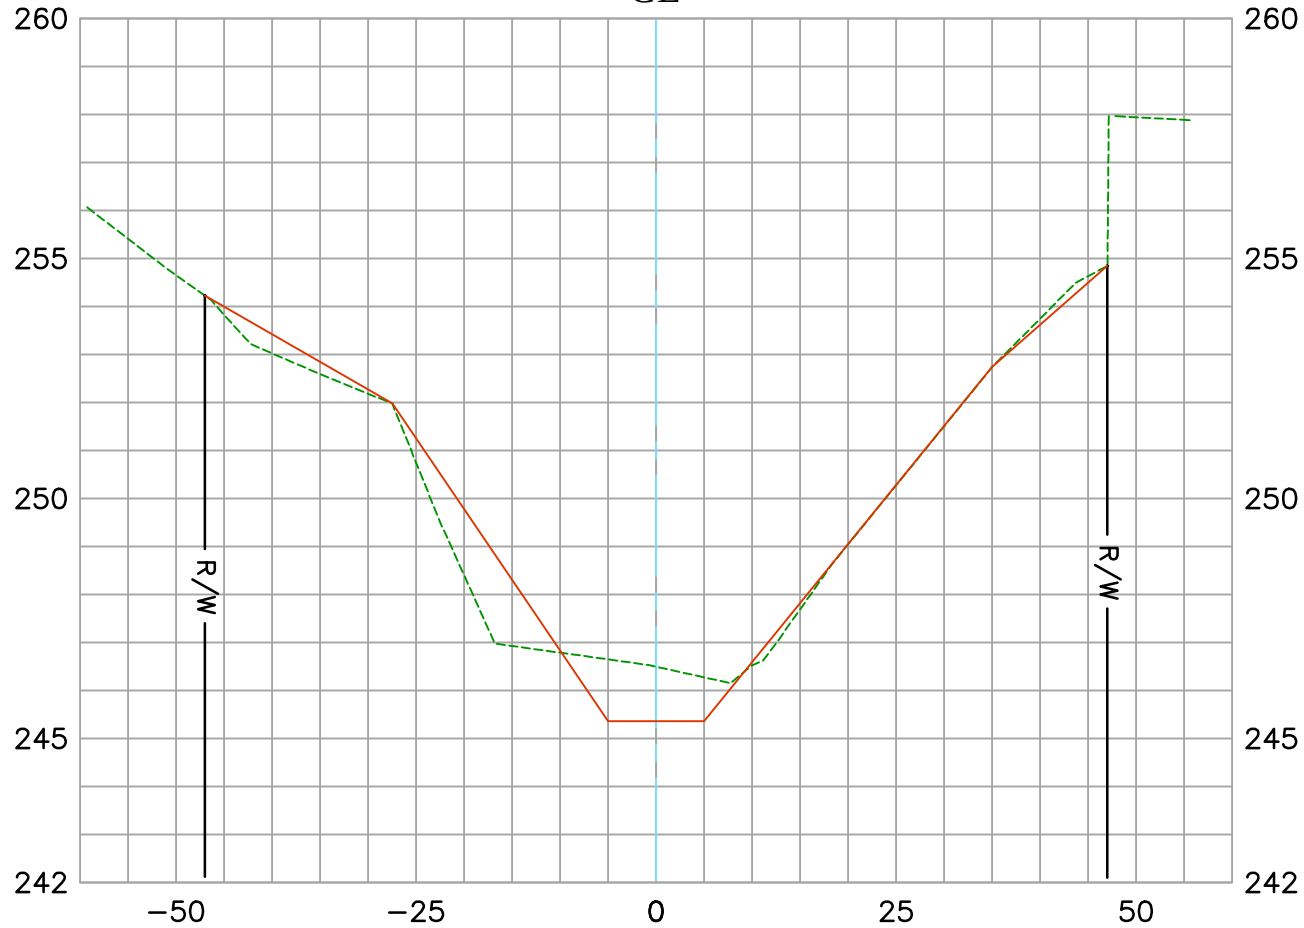

EXISTING CONDITION 03/18/2021
RECORD DRAWINGS:
F23-701-1, F23-701-2, & F23-701-3
DATE PREPARED: 11/01/2021

Vert. Scale: 1"=4'
Hor. Scale: 1"=20'


U.S. *Survey Foot*

OC Public Works
OC Survey/Field Services
Boundary Analysis & Mapping

CAÑADA CHANNEL (F23)

20+00.00

CL

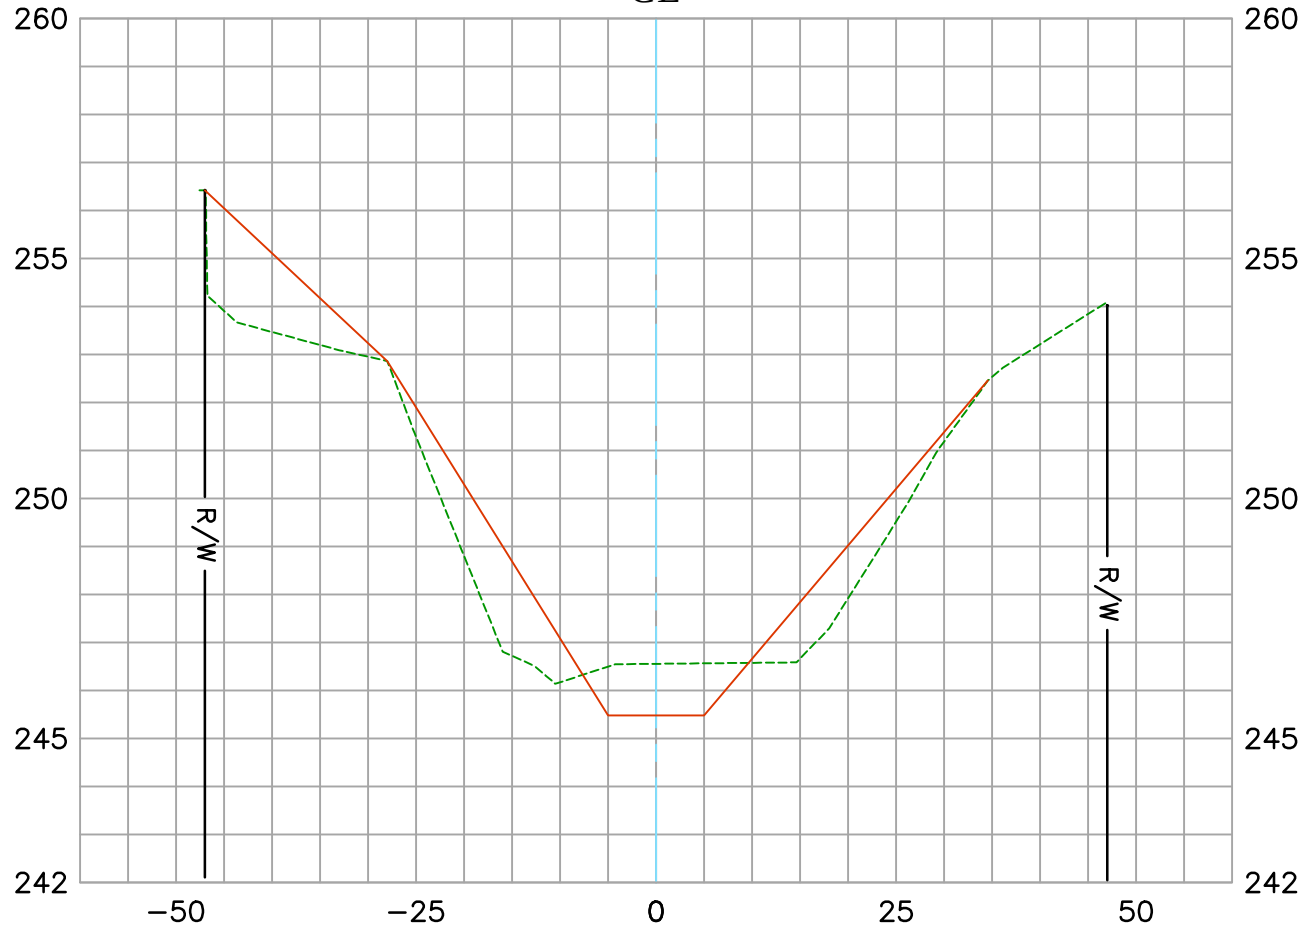

EXISTING CONDITION 03/18/2021
RECORD DRAWINGS:
F23-701-1, F23-701-2, & F23-701-3
DATE PREPARED: 11/01/2021

Vert. Scale: 1"=4'
Hor. Scale: 1"=20'


U.S. Survey Foot

OC Public Works
OC Survey/Field Services
Boundary Analysis & Mapping

CAÑADA CHANNEL (F23)

20+50.00

CL

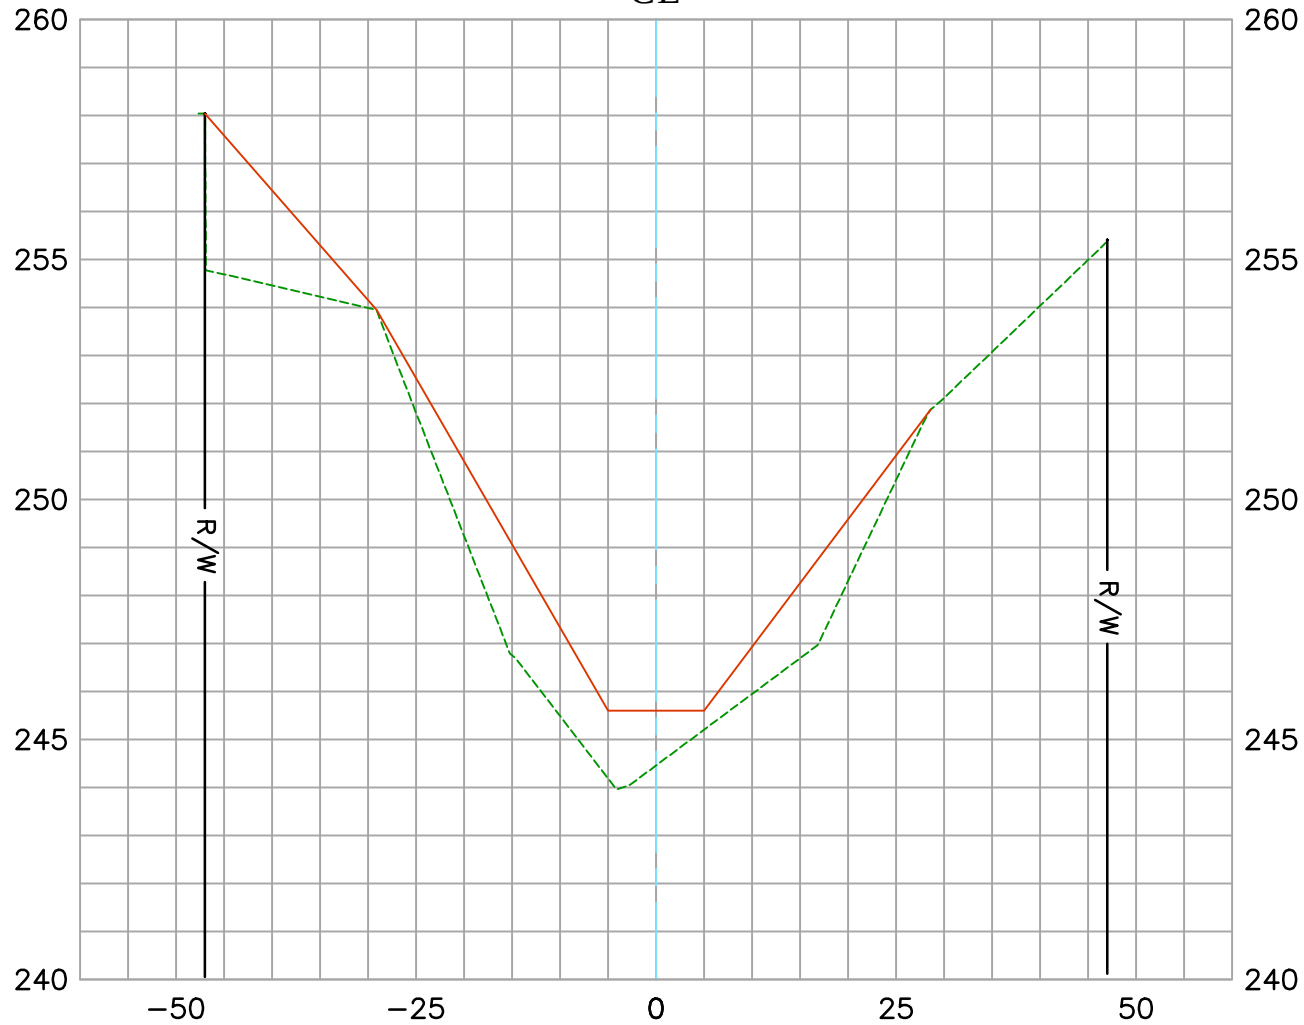

EXISTING CONDITION 03/18/2021
RECORD DRAWINGS:
F23-701-1, F23-701-2, & F23-701-3
DATE PREPARED: 11/01/2021

Vert. Scale: 1"=4'
Hor. Scale: 1"=20'


U.S. *Survey*
Foot

OC Public Works
OC Survey/Field Services
Boundary Analysis & Mapping

CAÑADA CHANNEL (F23)

21+00.00

CL

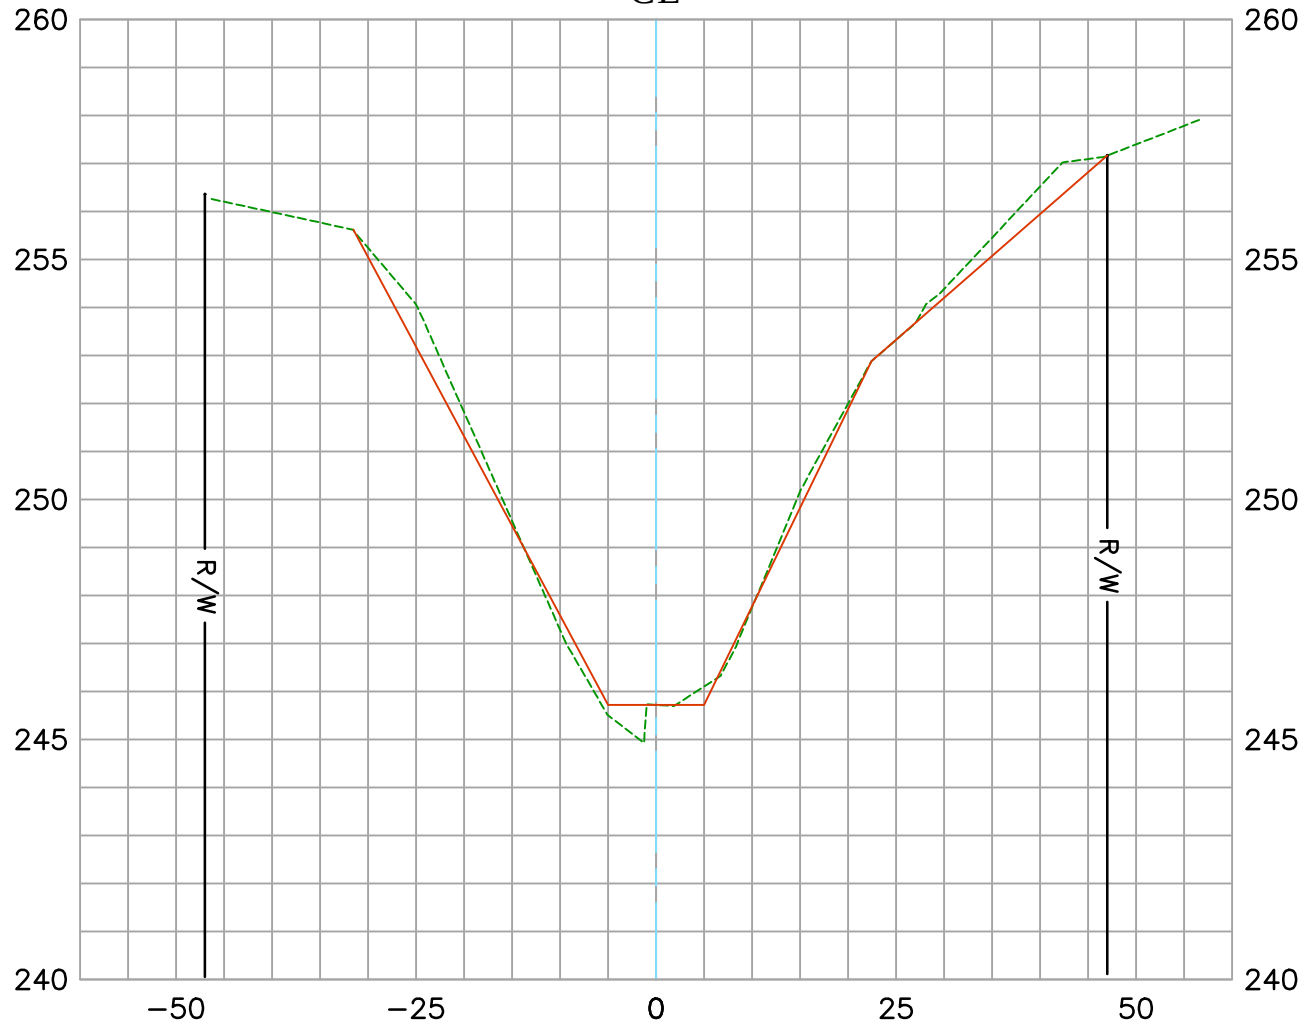

EXISTING CONDITION 03/18/2021
RECORD DRAWINGS:
F23-701-1, F23-701-2, & F23-701-3
DATE PREPARED: 11/01/2021

Vert. Scale: 1"=4'
Hor. Scale: 1"=20'

U.S. *Survey*
Foot


OC Public Works
OC Survey/Field Services
Boundary Analysis & Mapping



CAÑADA CHANNEL (F23)

21+17.12

CL

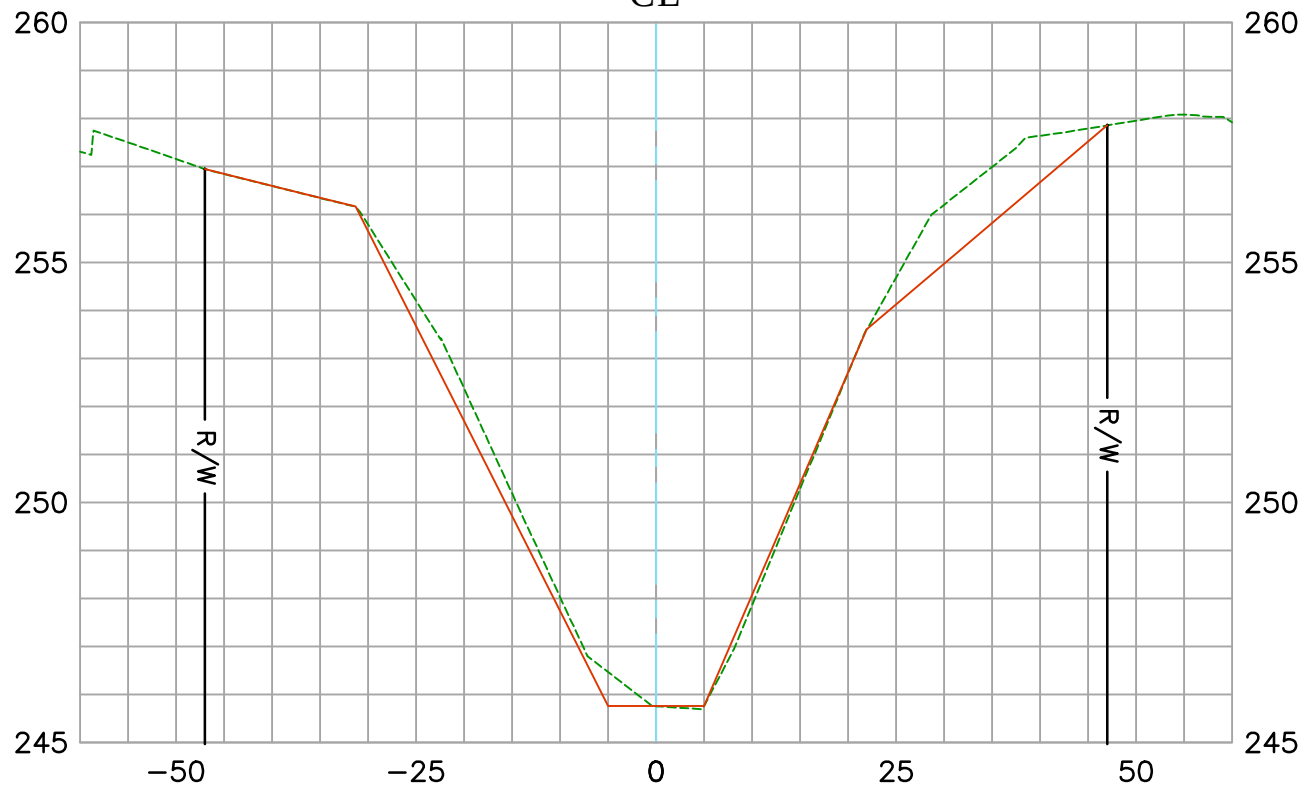

EXISTING CONDITION 03/18/2021
RECORD DRAWINGS:
F23-701-1, F23-701-2, & F23-701-3
DATE PREPARED: 11/01/2021

Vert. Scale: 1"=4'
Hor. Scale: 1"=20'


U.S. *Survey Foot*

OC Public Works
OC Survey/Field Services
Boundary Analysis & Mapping

CAÑADA CHANNEL (F23)

24+85.91

CL

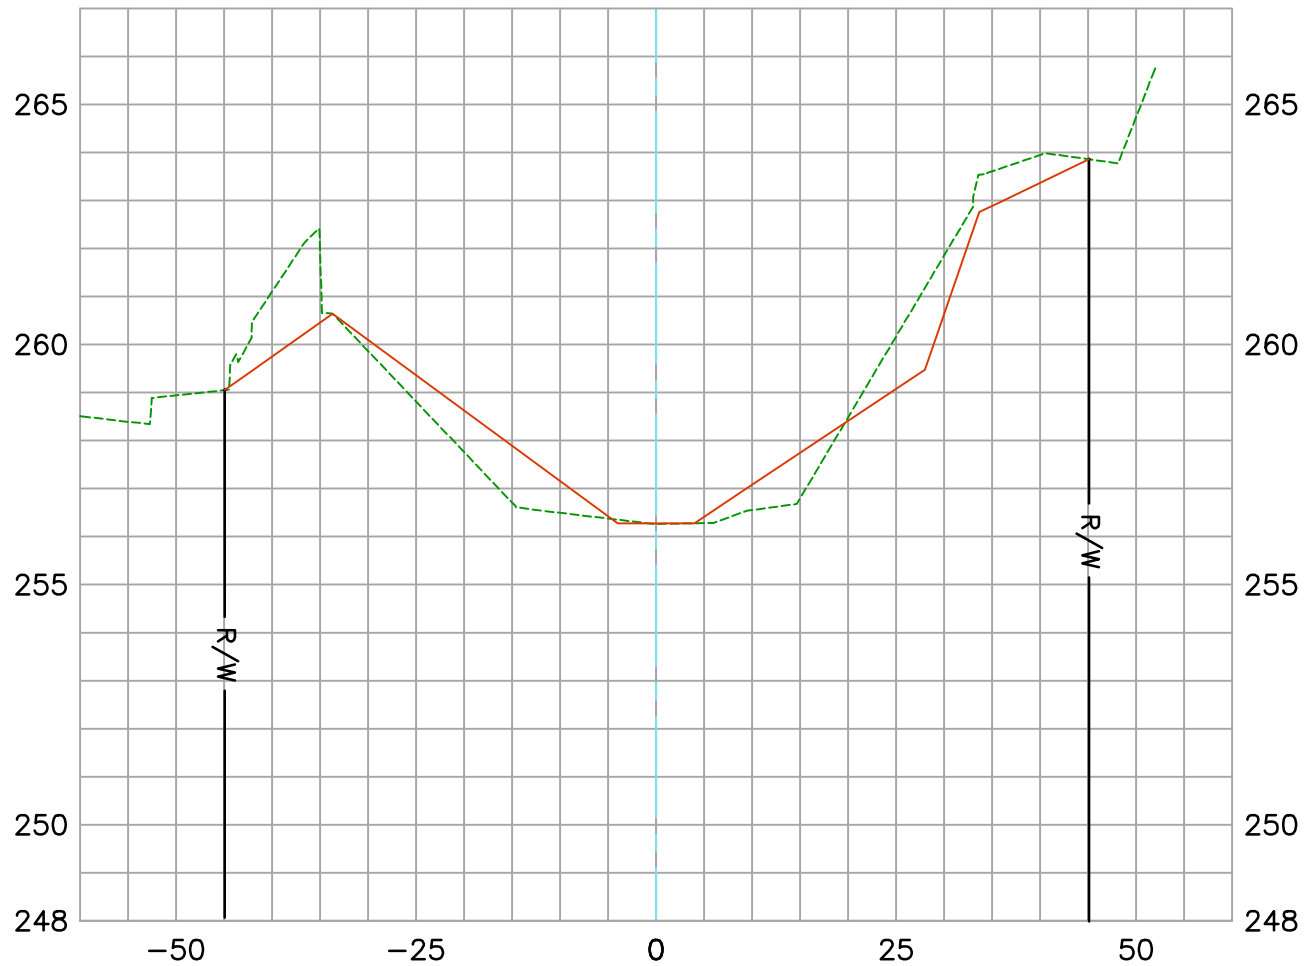

EXISTING CONDITION 03/18/2021

RECORD DRAWINGS:

F23-701-1, F23-701-2, & F23-701-3

DATE PREPARED: 11/01/2021

Vert. Scale: 1"=4'

Hor. Scale: 1"=20'


U.S. *Survey*
Foot

OC Public Works
OC Survey/Field Services
Boundary Analysis & Mapping

CAÑADA CHANNEL (F23)

25+00.00

CL

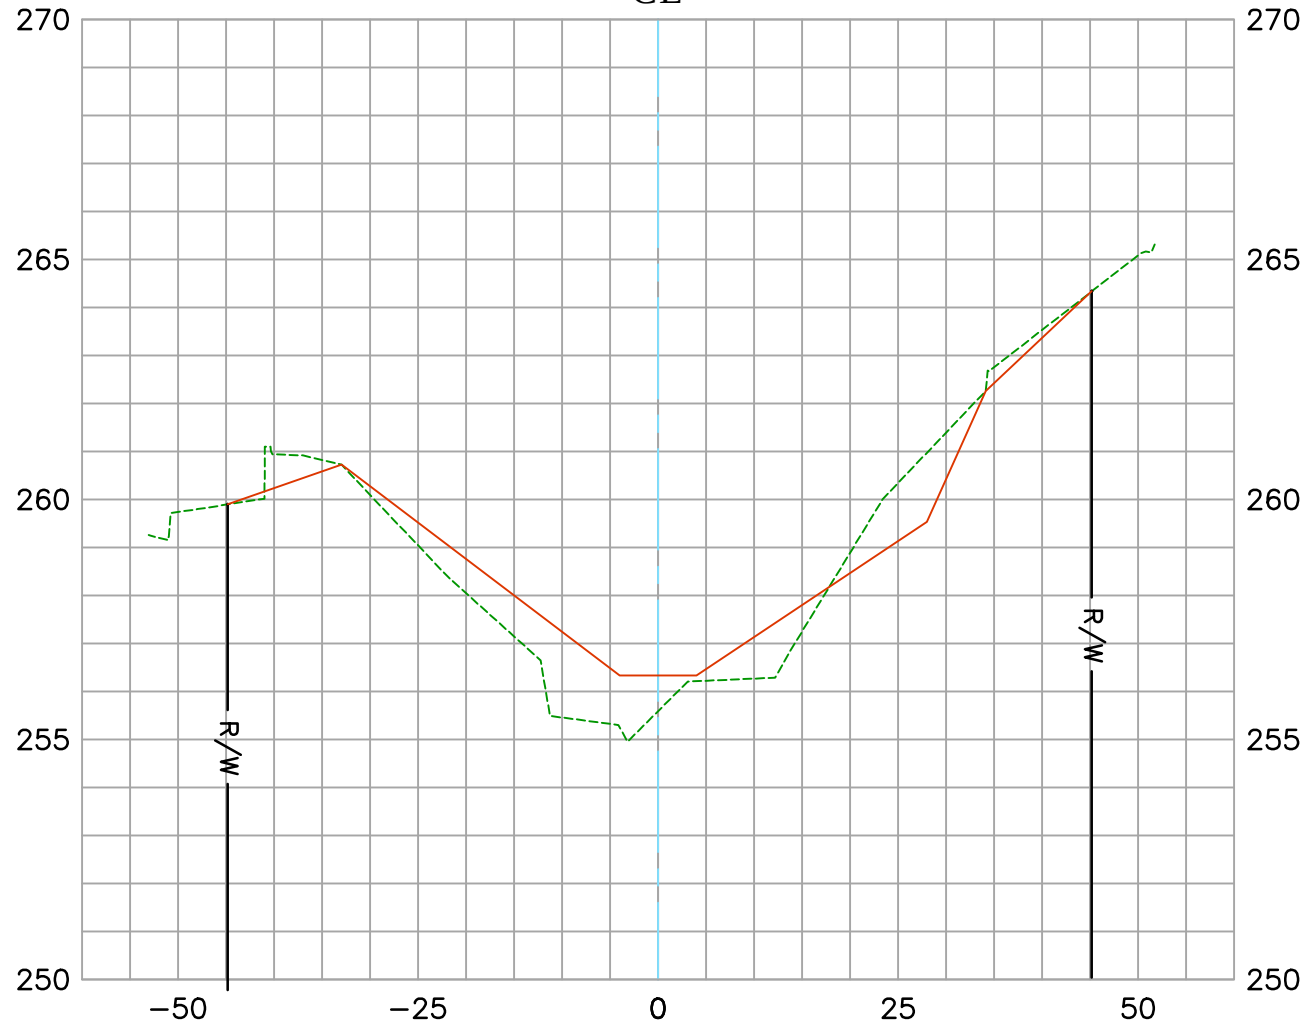

EXISTING CONDITION 03/18/2021
RECORD DRAWINGS:
F23-701-1, F23-701-2, & F23-701-3
DATE PREPARED: 11/01/2021

Vert. Scale: 1"=4'
Hor. Scale: 1"=20'


U.S. *Survey*
Foot

OC Public Works
OC Survey/Field Services
Boundary Analysis & Mapping

CAÑADA CHANNEL (F23)

25+50.00

CL

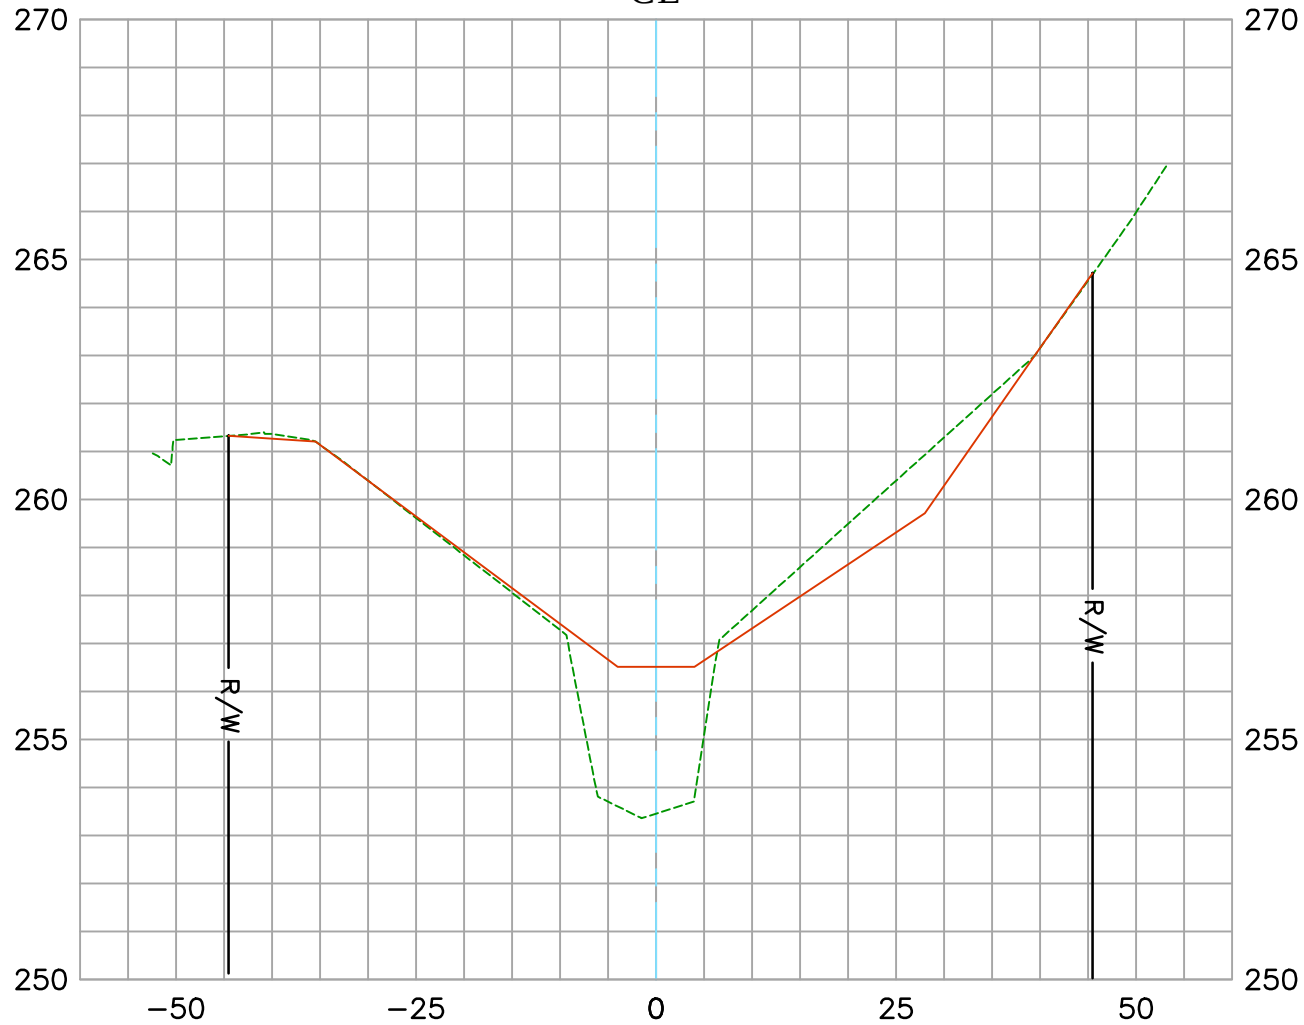

EXISTING CONDITION 03/18/2021
RECORD DRAWINGS:
F23-701-1, F23-701-2, & F23-701-3
DATE PREPARED: 11/01/2021

Vert. Scale: 1"=4'
Hor. Scale: 1"=20'


U.S. *Survey Foot*

OC Public Works
OC Survey/Field Services
Boundary Analysis & Mapping

CAÑADA CHANNEL (F23)

26+00.00

CL

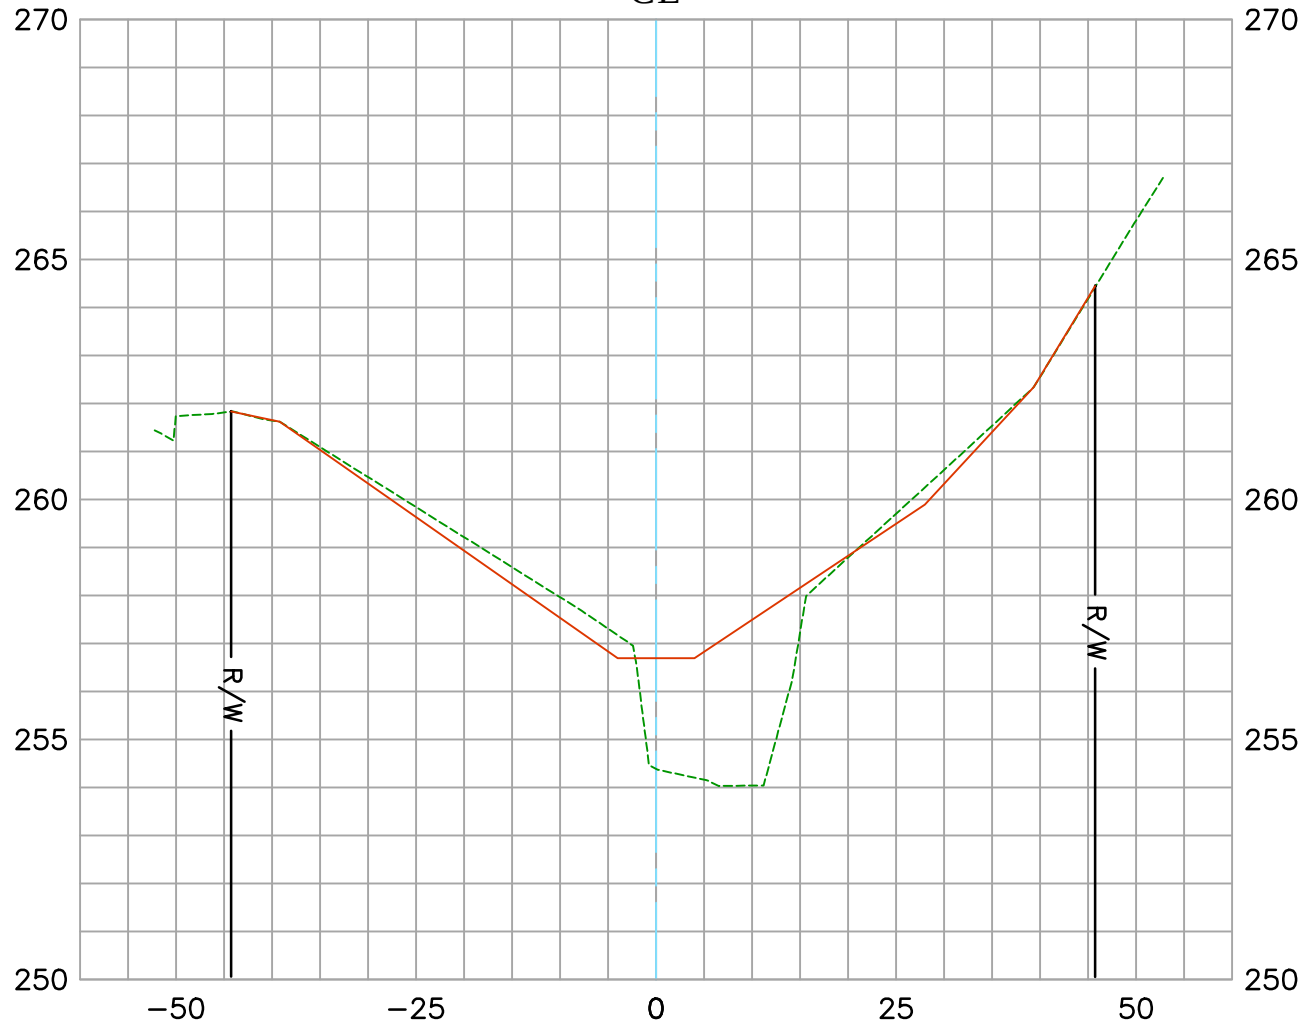

EXISTING CONDITION 03/18/2021
RECORD DRAWINGS:
F23-701-1, F23-701-2, & F23-701-3
DATE PREPARED: 11/01/2021

Vert. Scale: 1"=4'
Hor. Scale: 1"=20'


U.S. *Survey Foot*

OC Public Works
OC Survey/Field Services
Boundary Analysis & Mapping

CAÑADA CHANNEL (F23)

26+50.00

CL

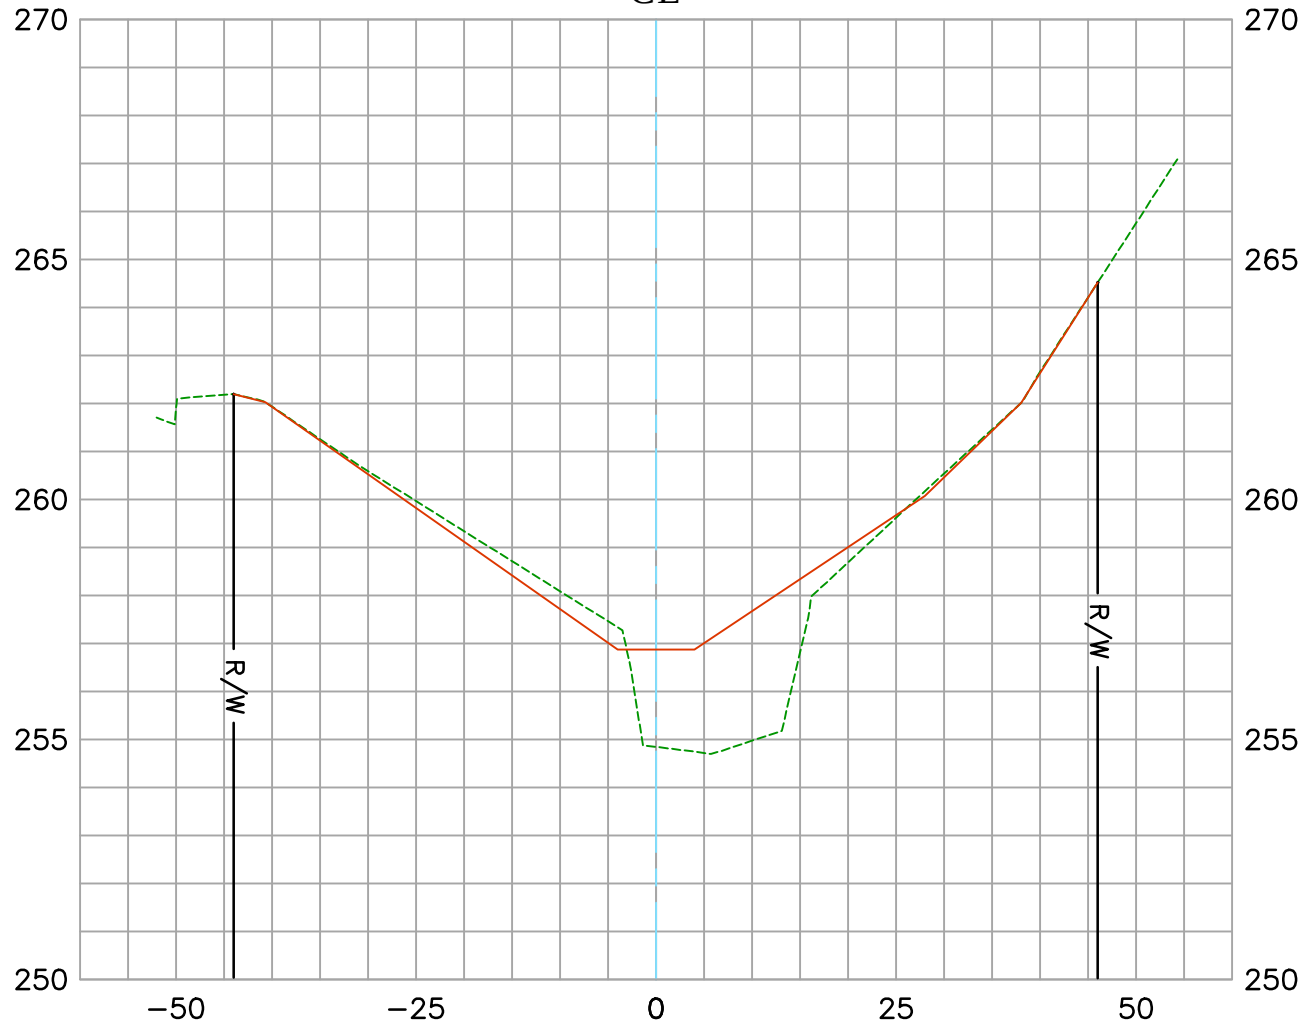

EXISTING CONDITION 03/18/2021
RECORD DRAWINGS:
F23-701-1, F23-701-2, & F23-701-3
DATE PREPARED: 11/01/2021

Vert. Scale: 1"=4'
Hor. Scale: 1"=20'


U.S. *Survey*
Foot

OC Public Works
OC Survey/Field Services
Boundary Analysis & Mapping

CAÑADA CHANNEL (F23)

27+00.00

CL

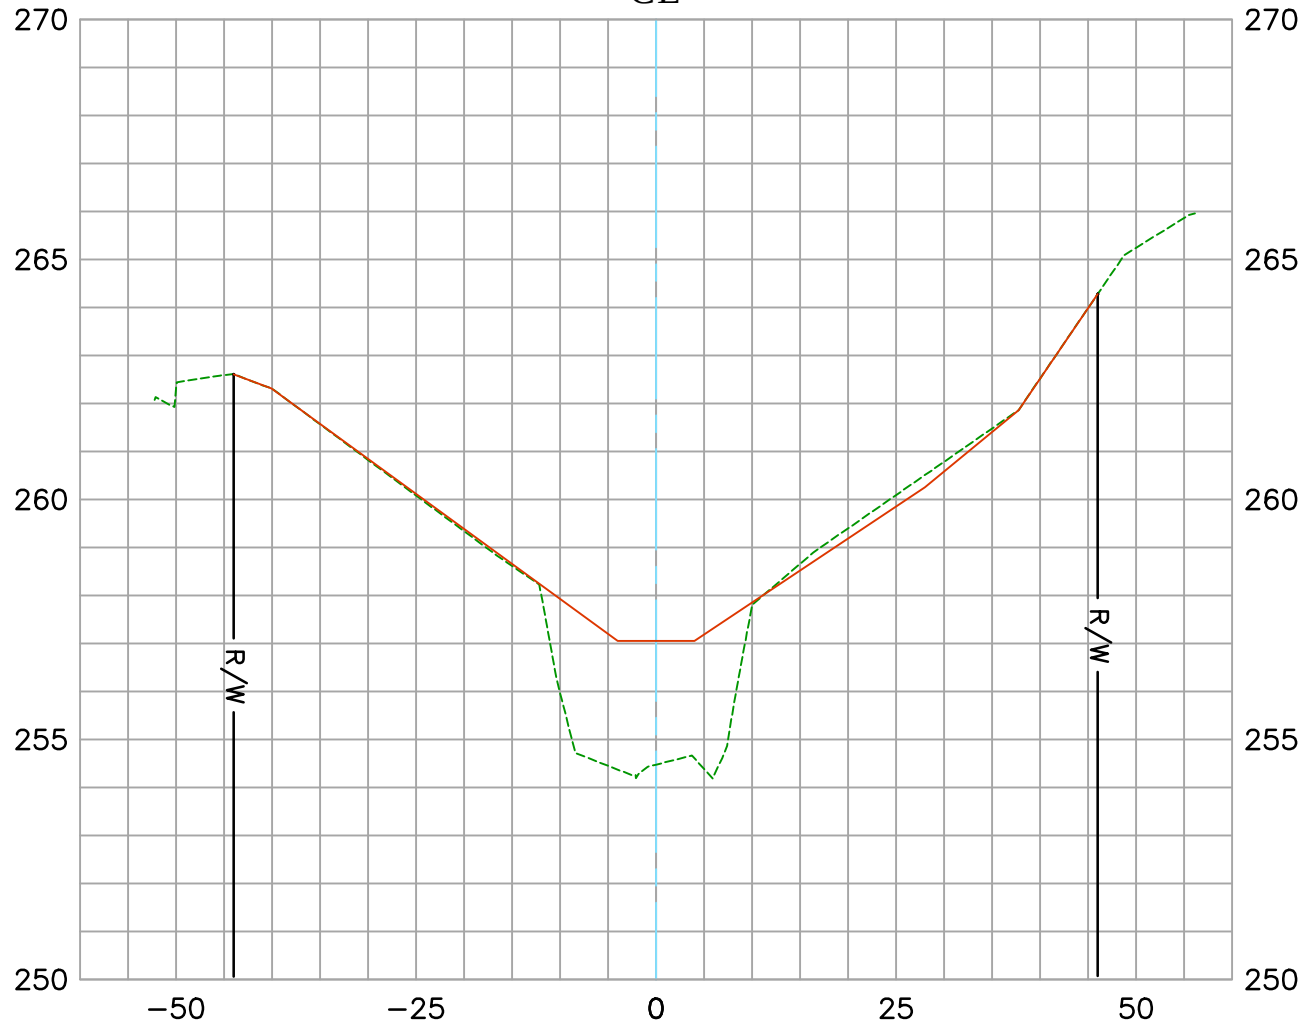

EXISTING CONDITION 03/18/2021
RECORD DRAWINGS:
F23-701-1, F23-701-2, & F23-701-3
DATE PREPARED: 11/01/2021

Vert. Scale: 1"=4'
Hor. Scale: 1"=20'

U.S. *Survey*
Foot


OC Public Works
OC Survey/Field Services
Boundary Analysis & Mapping



CAÑADA CHANNEL (F23)

27+50.00

CL

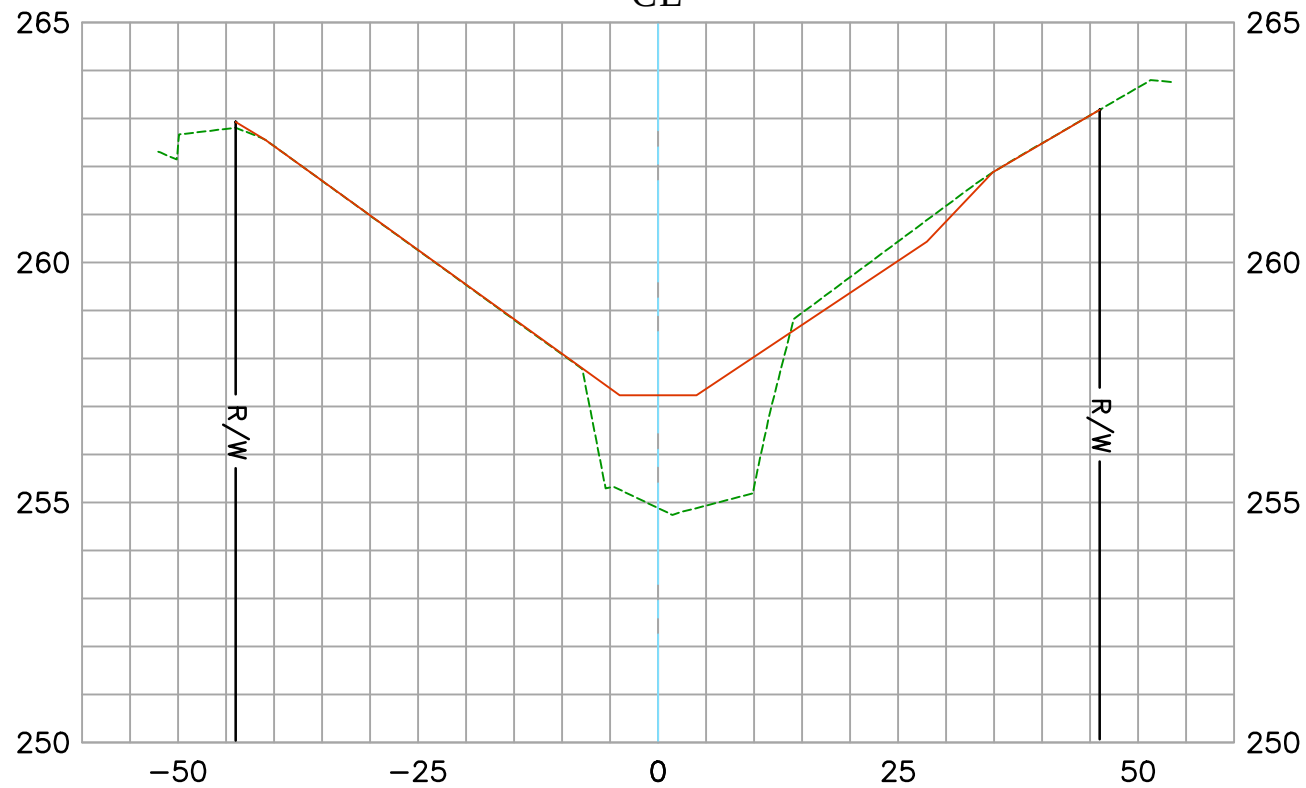

EXISTING CONDITION 03/18/2021
RECORD DRAWINGS:
F23-701-1, F23-701-2, & F23-701-3
DATE PREPARED: 11/01/2021

Vert. Scale: 1"=4'
Hor. Scale: 1"=20'

U.S. *Survey*
Foot


OC Public Works
OC Survey/Field Services
Boundary Analysis & Mapping



CAÑADA CHANNEL (F23)

28+00.00

CL

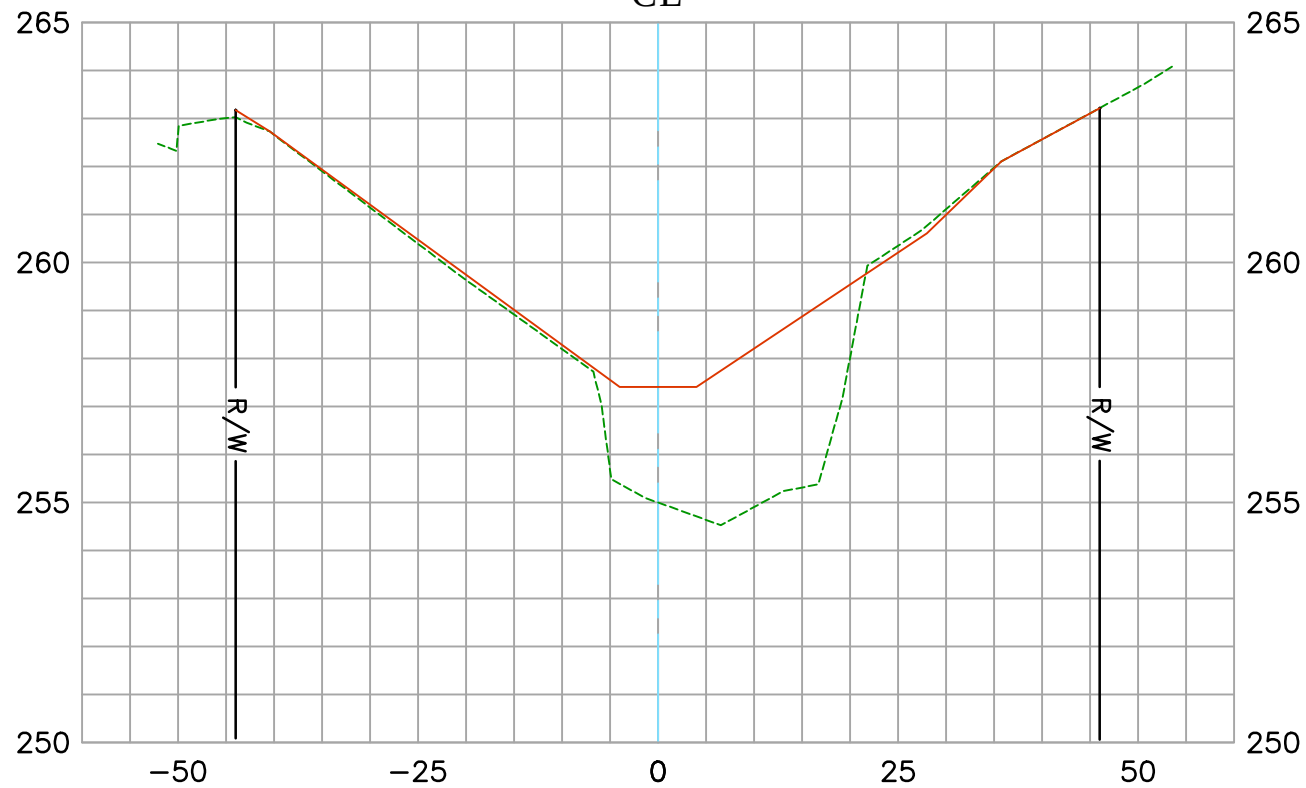


EXISTING CONDITION 03/18/2021
RECORD DRAWINGS:
F23-701-1, F23-701-2, & F23-701-3
DATE PREPARED: 11/01/2021

Vert. Scale: 1"=4'
Hor. Scale: 1"=20'

U.S. *Survey*
Foot


OC Public Works
OC Survey/Field Services
Boundary Analysis & Mapping

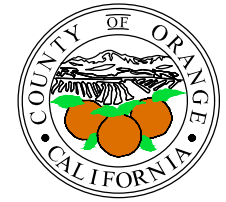

CAÑADA CHANNEL (F23)

28+50.00

CL

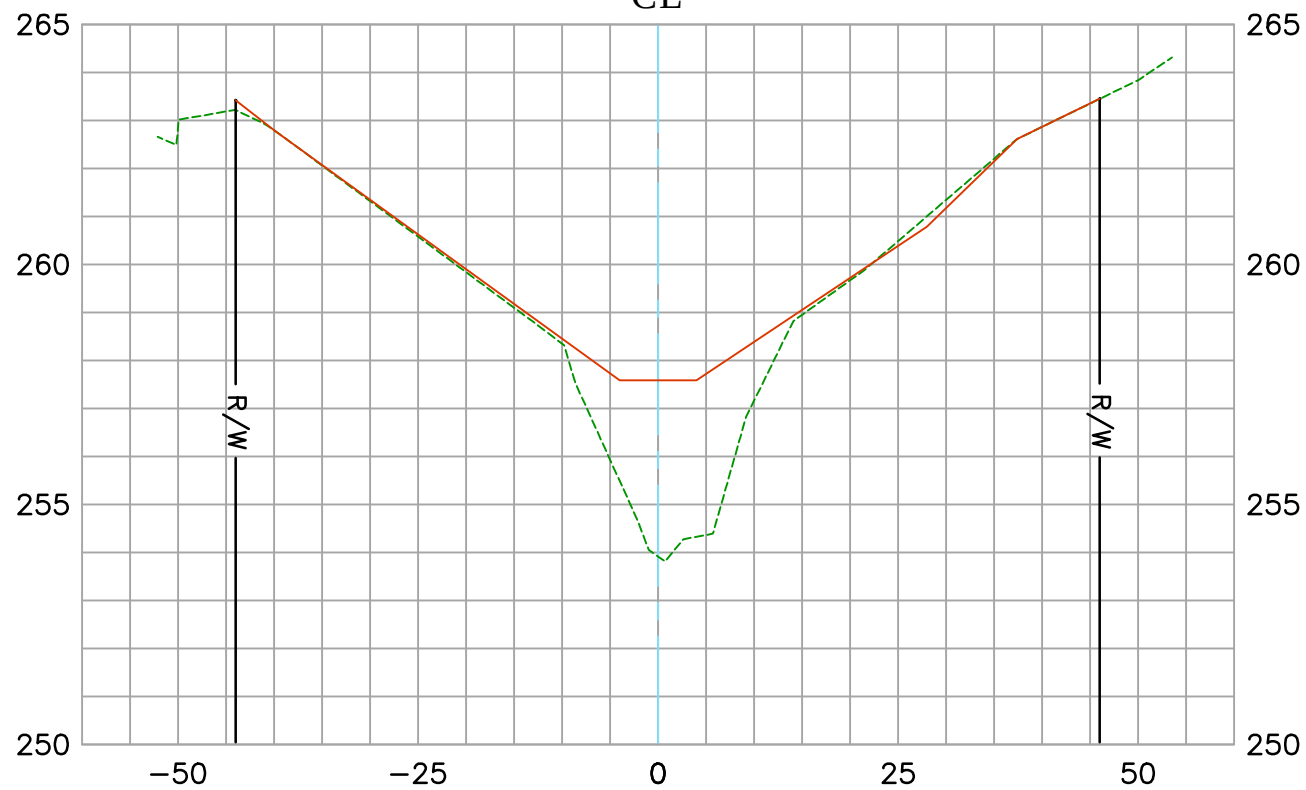

EXISTING CONDITION 03/18/2021
RECORD DRAWINGS:
F23-701-1, F23-701-2, & F23-701-3
DATE PREPARED: 11/01/2021

Vert. Scale: 1"=4'
Hor. Scale: 1"=20'

U.S. *Survey*
Foot


OC Public Works
OC Survey/Field Services
Boundary Analysis & Mapping



CAÑADA CHANNEL (F23)

29+00.00

CL

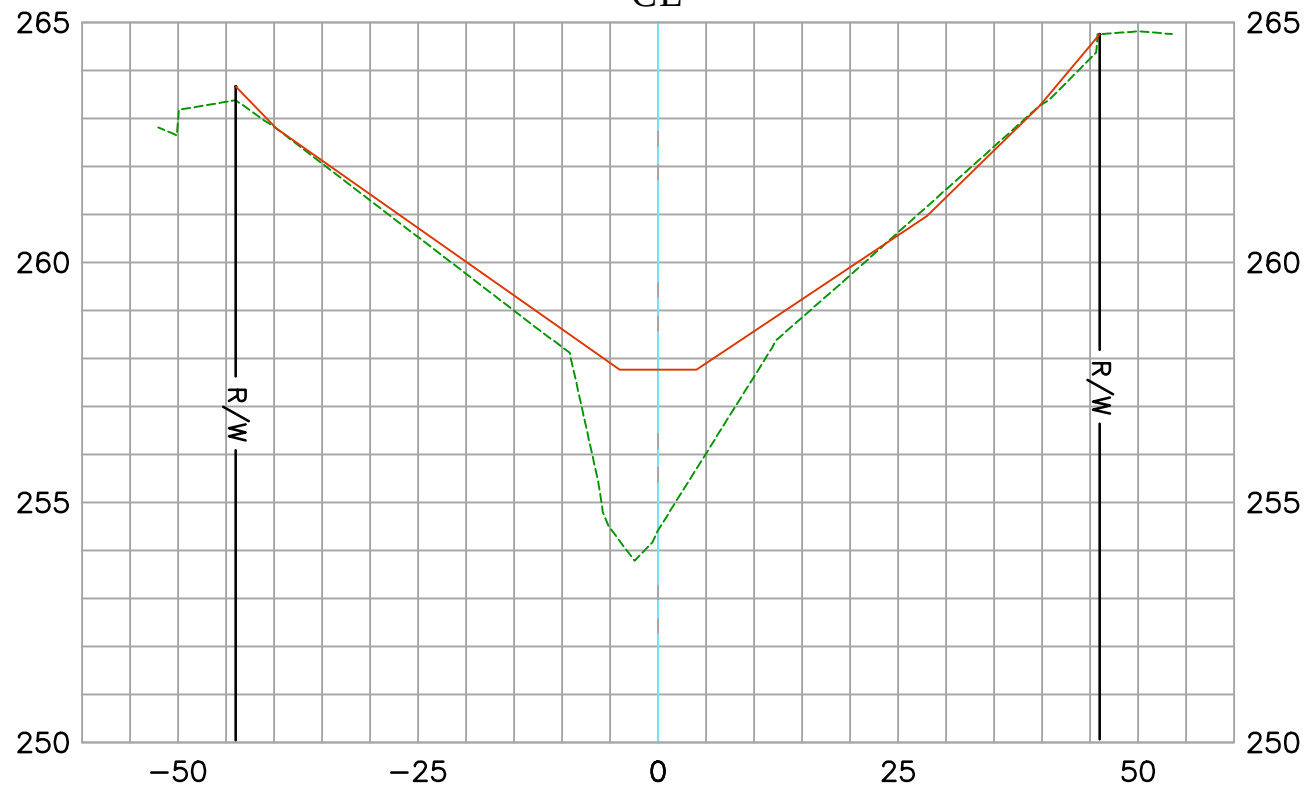

EXISTING CONDITION 03/18/2021
RECORD DRAWINGS:
F23-701-1, F23-701-2, & F23-701-3
DATE PREPARED: 11/01/2021

Vert. Scale: 1"=4'
Hor. Scale: 1"=20'



U.S. *Survey Foot*

OC Public Works
OC Survey/Field Services
Boundary Analysis & Mapping

CAÑADA CHANNEL (F23)

29+50.00

CL

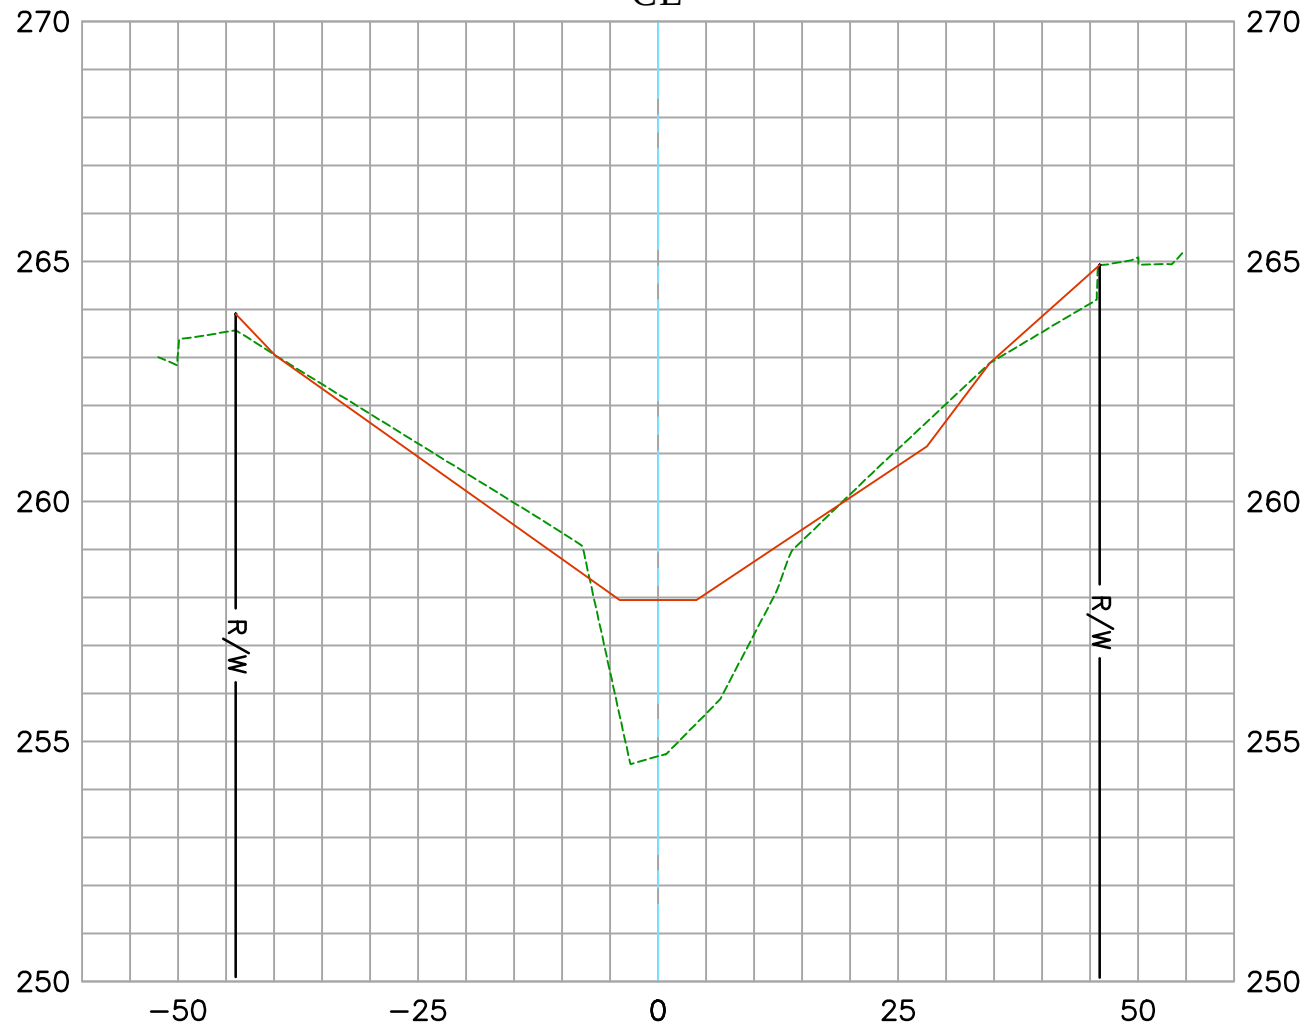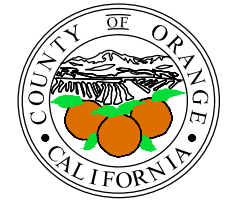

EXISTING CONDITION 03/18/2021
RECORD DRAWINGS:
F23-701-1, F23-701-2, & F23-701-3
DATE PREPARED: 11/01/2021

Vert. Scale: 1"=4'
Hor. Scale: 1"=20'


U.S. *Survey*
Foot

OC Public Works
OC Survey/Field Services
Boundary Analysis & Mapping

CAÑADA CHANNEL (F23)

30+00.00

CL

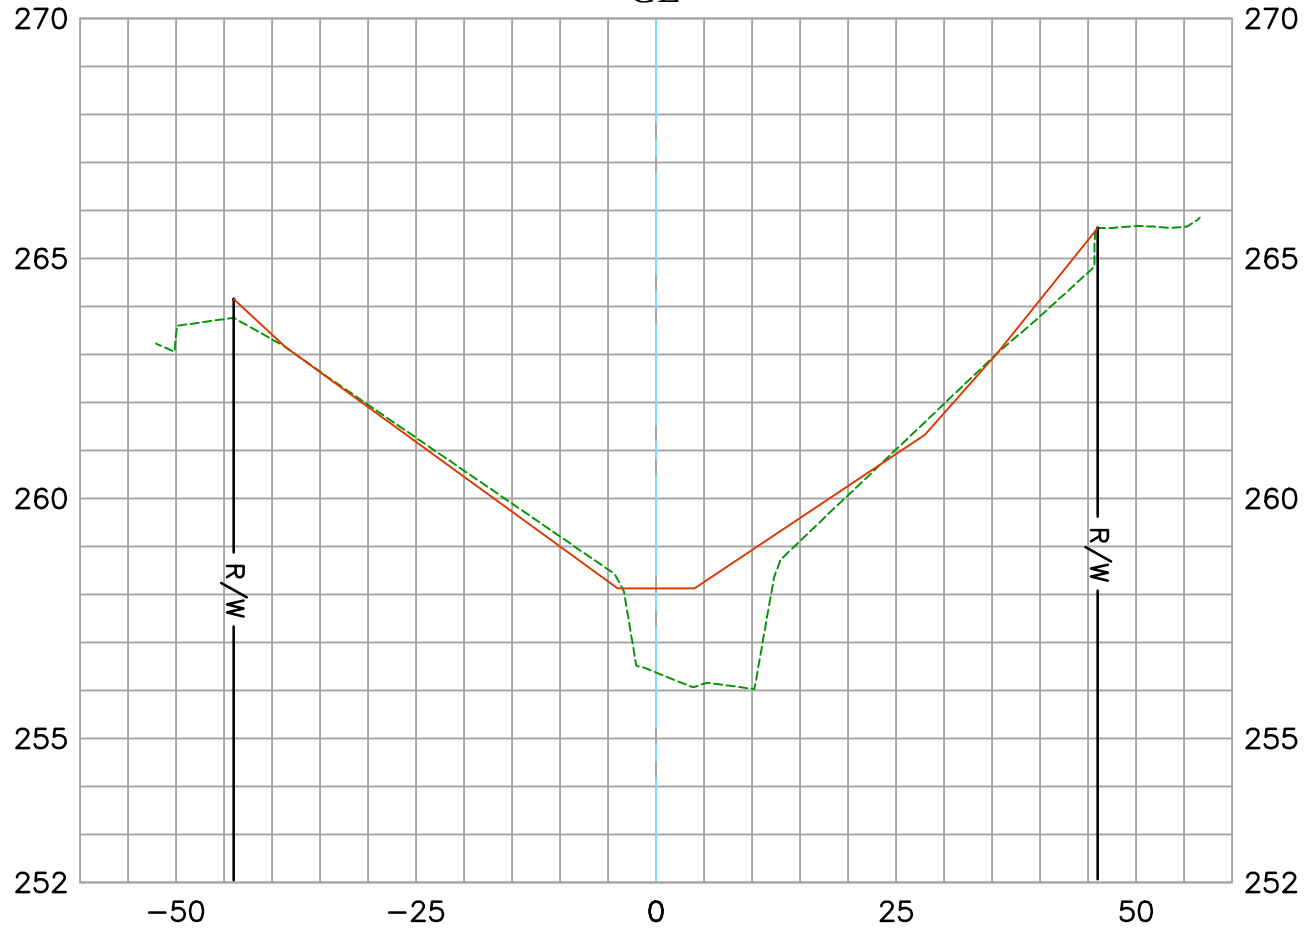

EXISTING CONDITION 03/18/2021
RECORD DRAWINGS:
F23-701-1, F23-701-2, & F23-701-3
DATE PREPARED: 11/01/2021

Vert. Scale: 1"=4'
Hor. Scale: 1"=20'


U.S. Survey
Foot

OC Public Works
OC Survey/Field Services
Boundary Analysis & Mapping

CAÑADA CHANNEL (F23)

30+50.00

CL

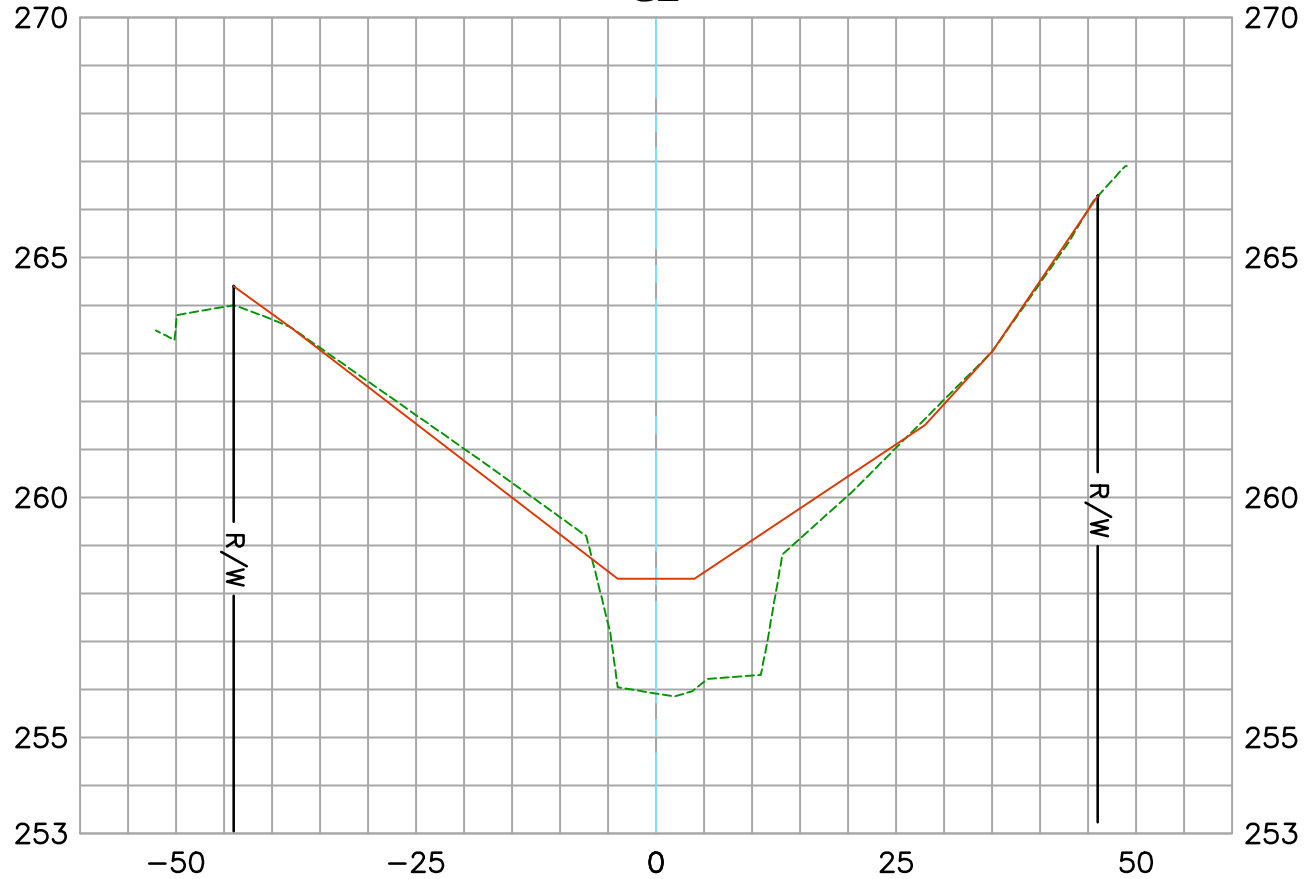

EXISTING CONDITION 03/18/2021
RECORD DRAWINGS:
F23-701-1, F23-701-2, & F23-701-3
DATE PREPARED: 11/01/2021

Vert. Scale: 1"=4'
Hor. Scale: 1"=20'


U.S. *Survey*
Foot

OC Public Works
OC Survey/Field Services
Boundary Analysis & Mapping

CAÑADA CHANNEL (F23)

31+00.00

CL

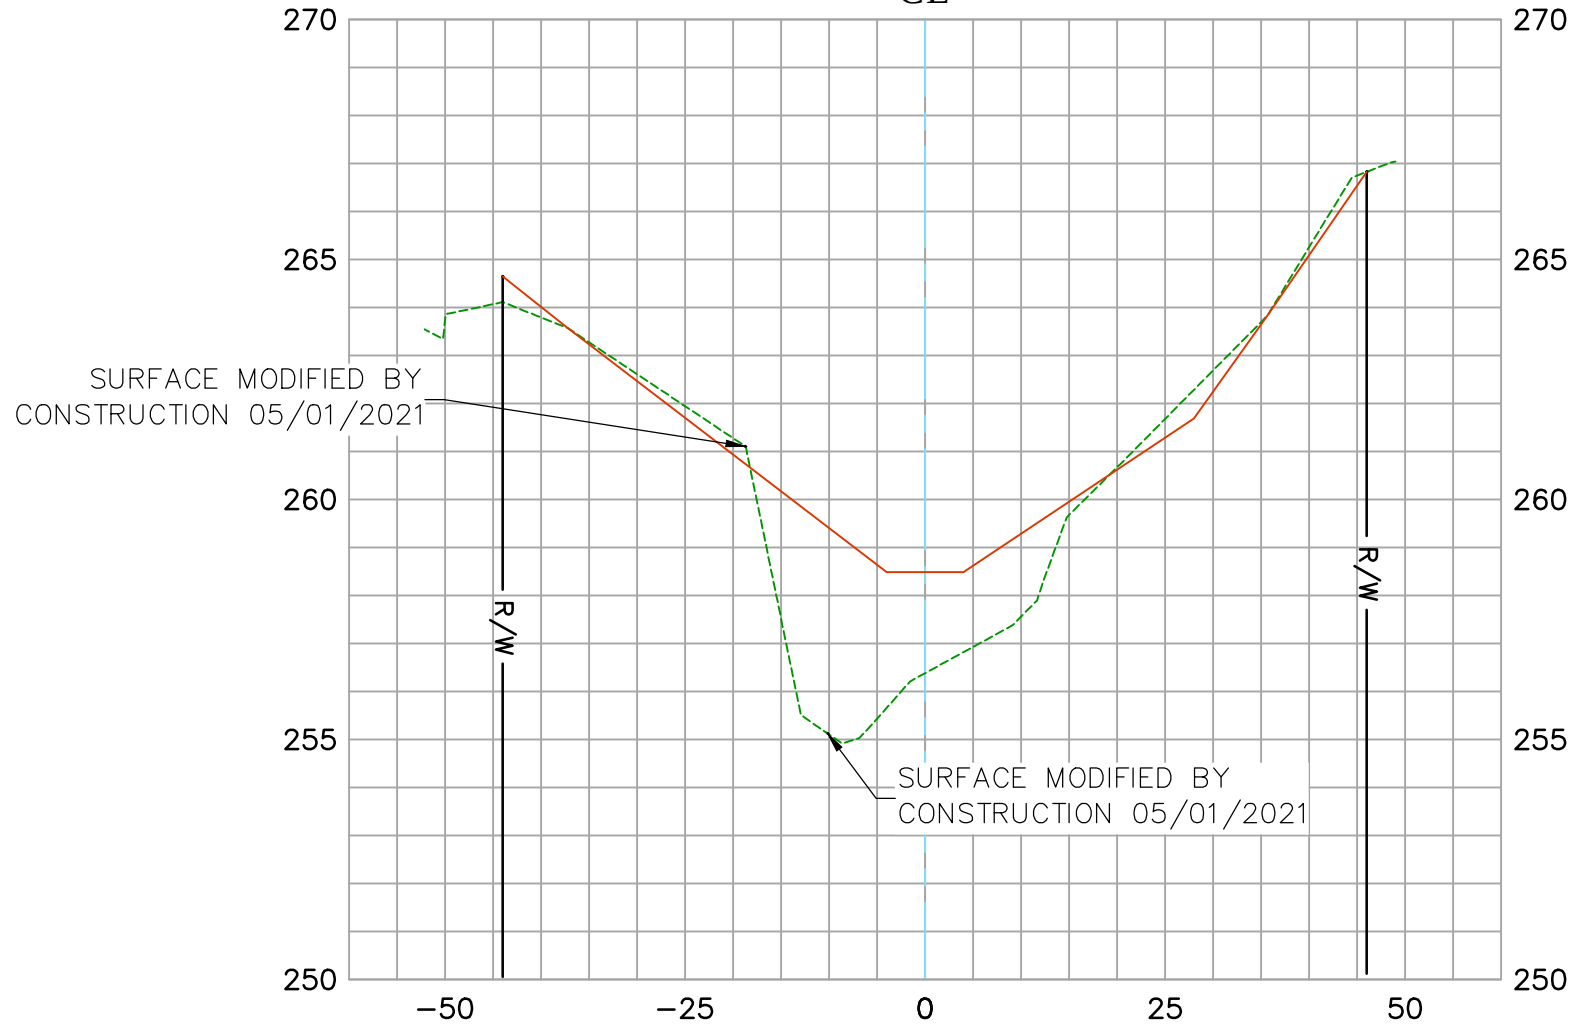

EXISTING CONDITION 03/18/2021
RECORD DRAWINGS:
F23-701-1, F23-701-2, & F23-701-3
DATE PREPARED: 11/01/2021

Vert. Scale: 1"=4'
Hor. Scale: 1"=20'

U.S. *Survey*
Foot


OC Public Works
OC Survey/Field Services
Boundary Analysis & Mapping



CAÑADA CHANNEL (F23)

31+50.00

CL

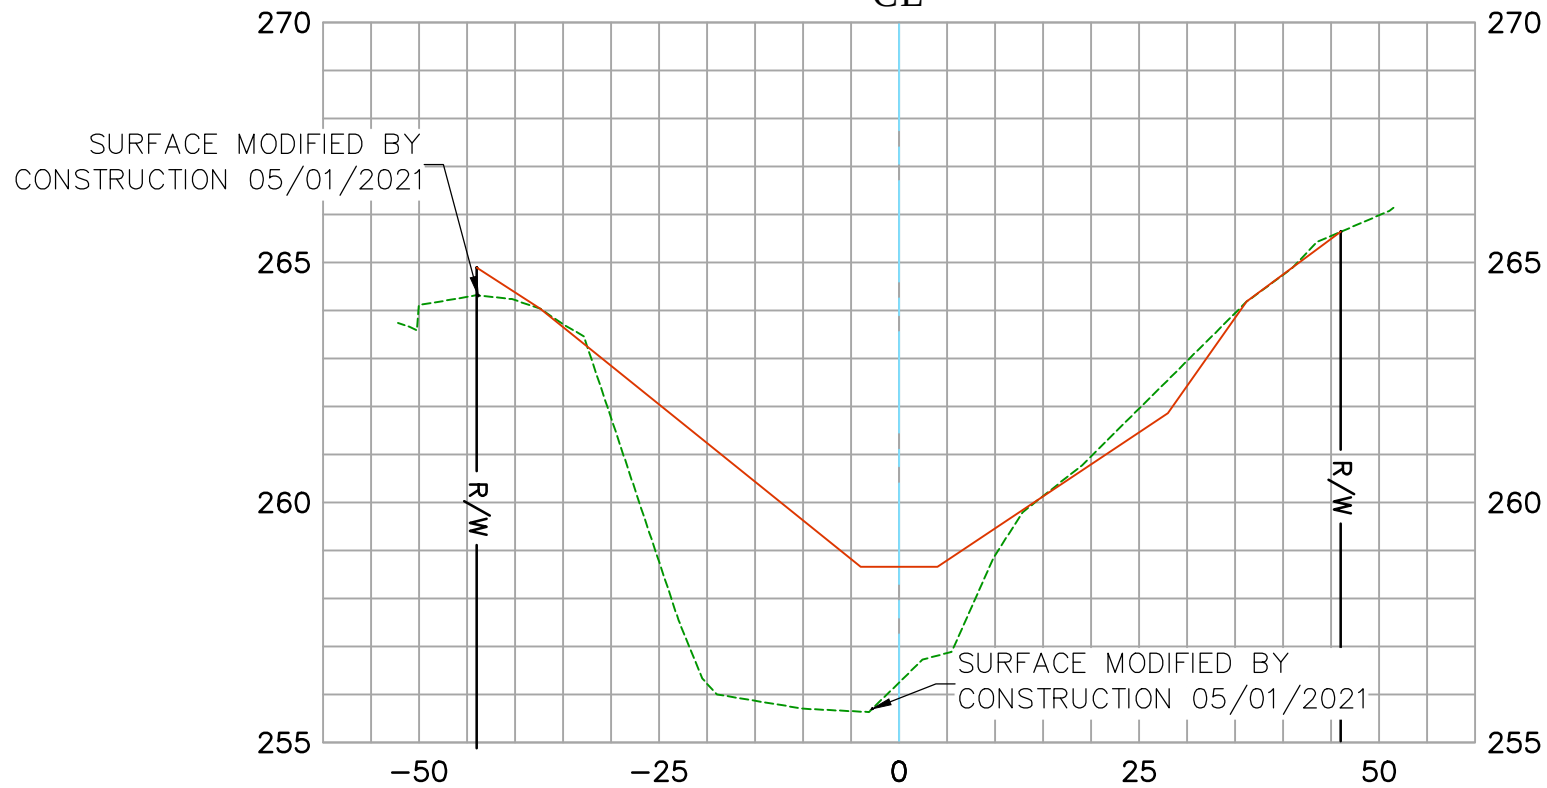

EXISTING CONDITION 03/18/2021
RECORD DRAWINGS:
F23-701-1, F23-701-2, & F23-701-3
DATE PREPARED: 11/01/2021

Vert. Scale: 1"=4'
Hor. Scale: 1"=20'

U.S. *Survey*
Foot


OC Public Works
OC Survey/Field Services
Boundary Analysis & Mapping



CAÑADA CHANNEL (F23)

32+00.00

CL

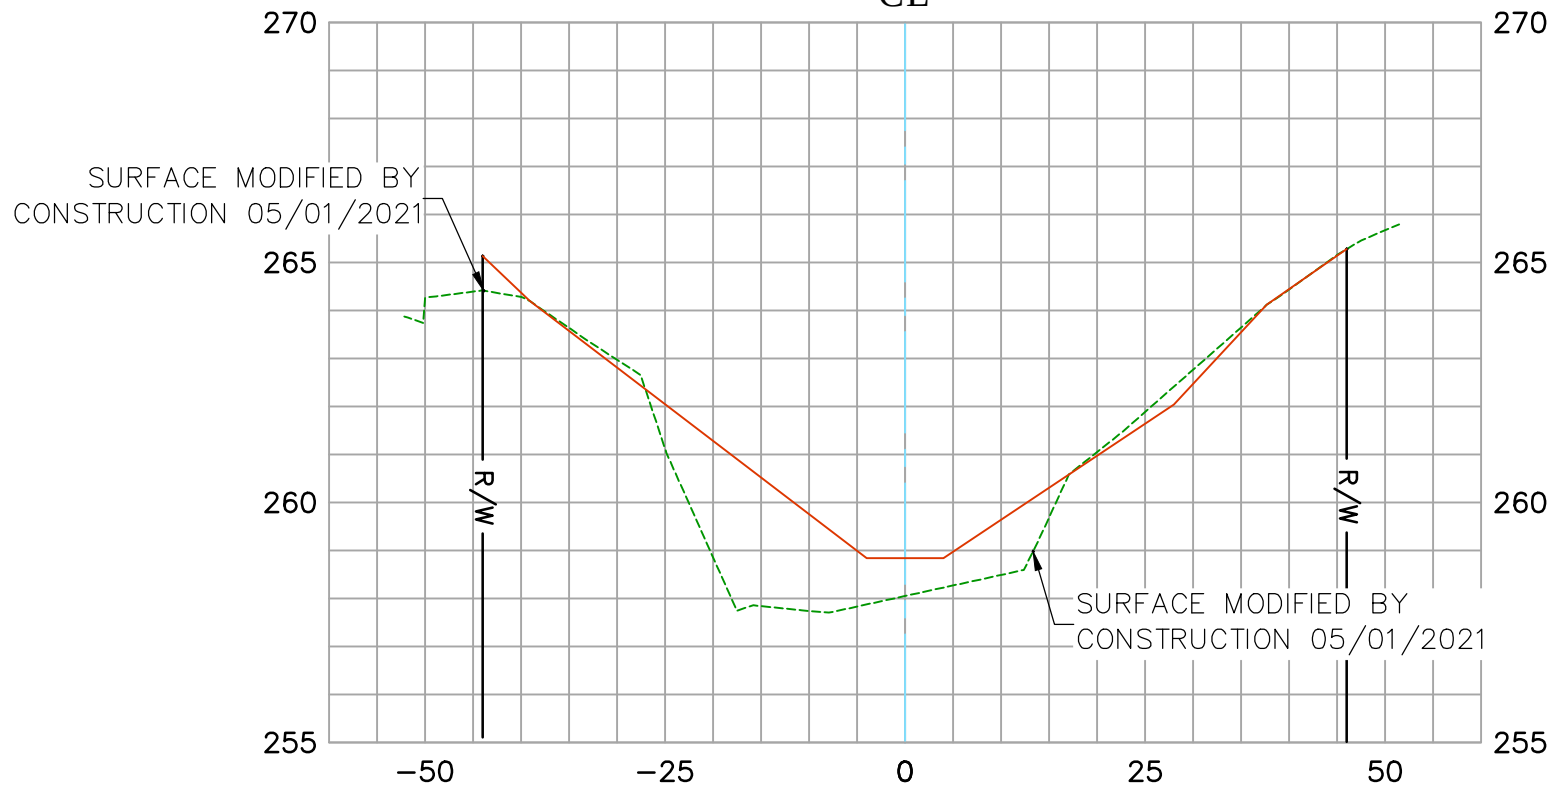

EXISTING CONDITION 03/18/2021
RECORD DRAWINGS:
F23-701-1, F23-701-2, & F23-701-3
DATE PREPARED: 11/01/2021

Vert. Scale: 1"=4'
Hor. Scale: 1"=20'

U.S. *Survey*
Foot


OC Public Works
OC Survey/Field Services
Boundary Analysis & Mapping



CAÑADA CHANNEL (F23)

32+50.00

CL

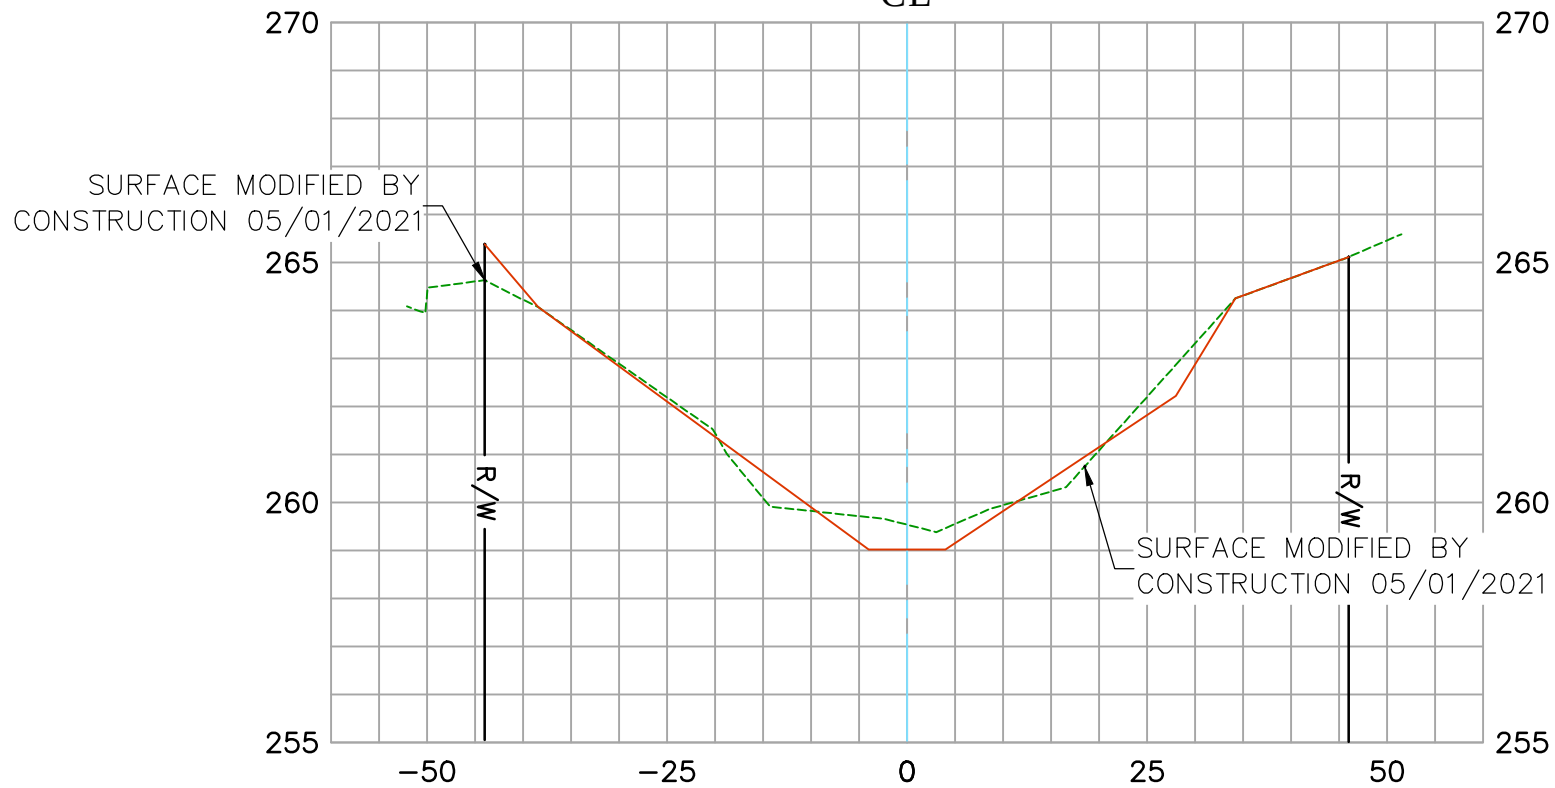

EXISTING CONDITION 03/18/2021
RECORD DRAWINGS:
F23-701-1, F23-701-2, & F23-701-3
DATE PREPARED: 11/01/2021

Vert. Scale: 1"=4'
Hor. Scale: 1"=20'

U.S. Survey Foot


OC Public Works
OC Survey/Field Services
Boundary Analysis & Mapping



CAÑADA CHANNEL (F23)

33+00.00

CL

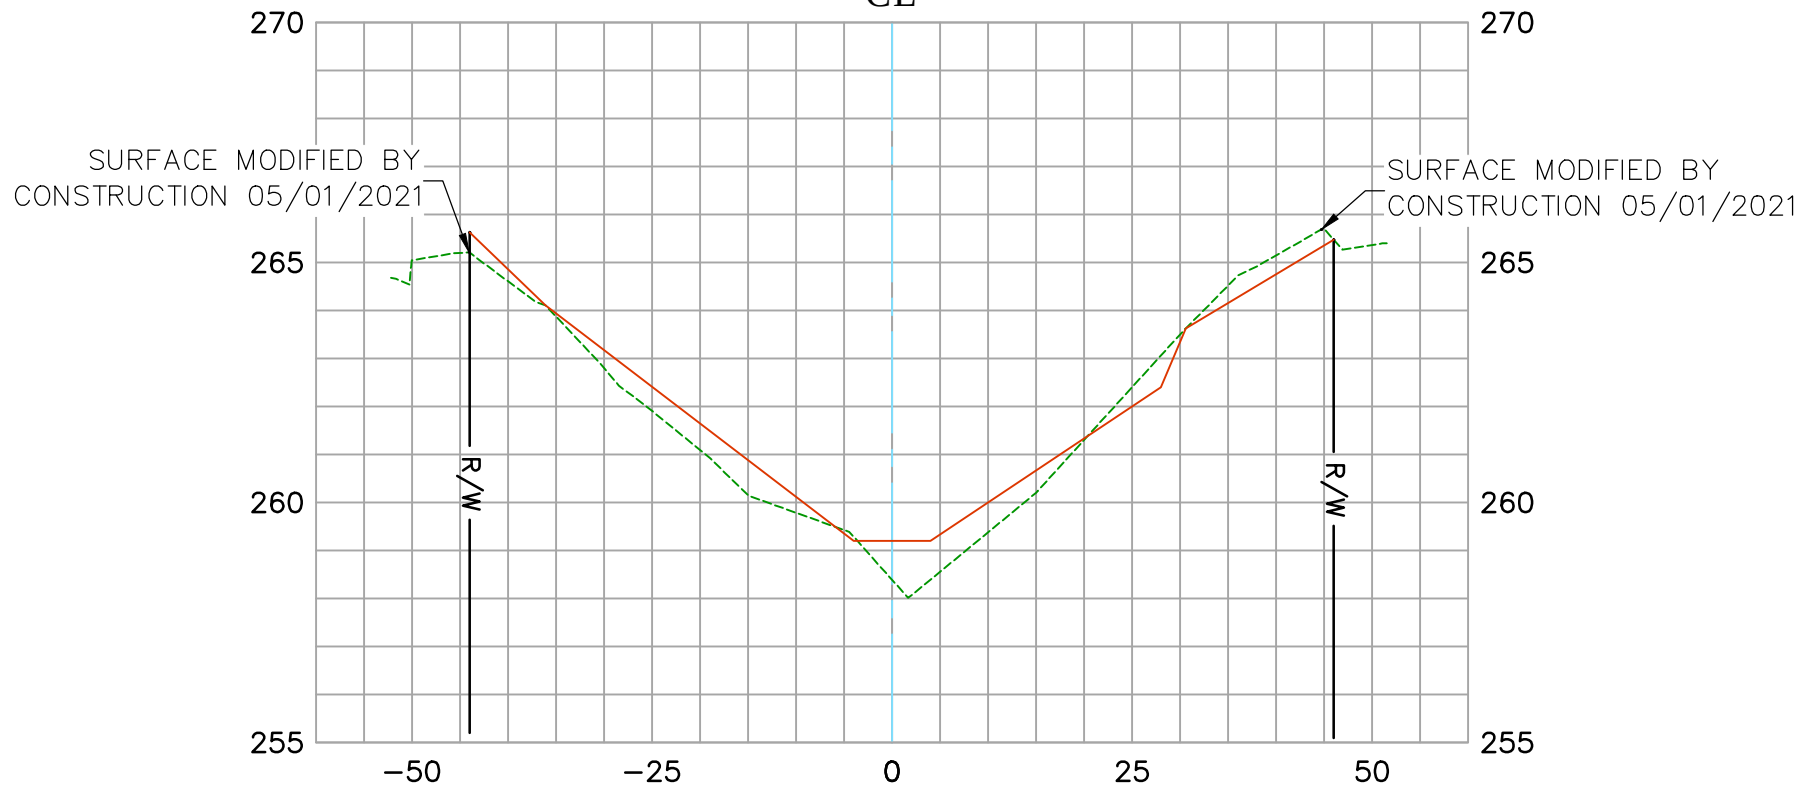

EXISTING CONDITION 03/18/2021
RECORD DRAWINGS:
F23-701-1, F23-701-2, & F23-701-3
DATE PREPARED: 11/01/2021

Vert. Scale: 1"=4'
Hor. Scale: 1"=20'

U.S. *Survey*
Foot


OC Public Works
OC Survey/Field Services
Boundary Analysis & Mapping



CAÑADA CHANNEL (F23)

33+36.05

CL

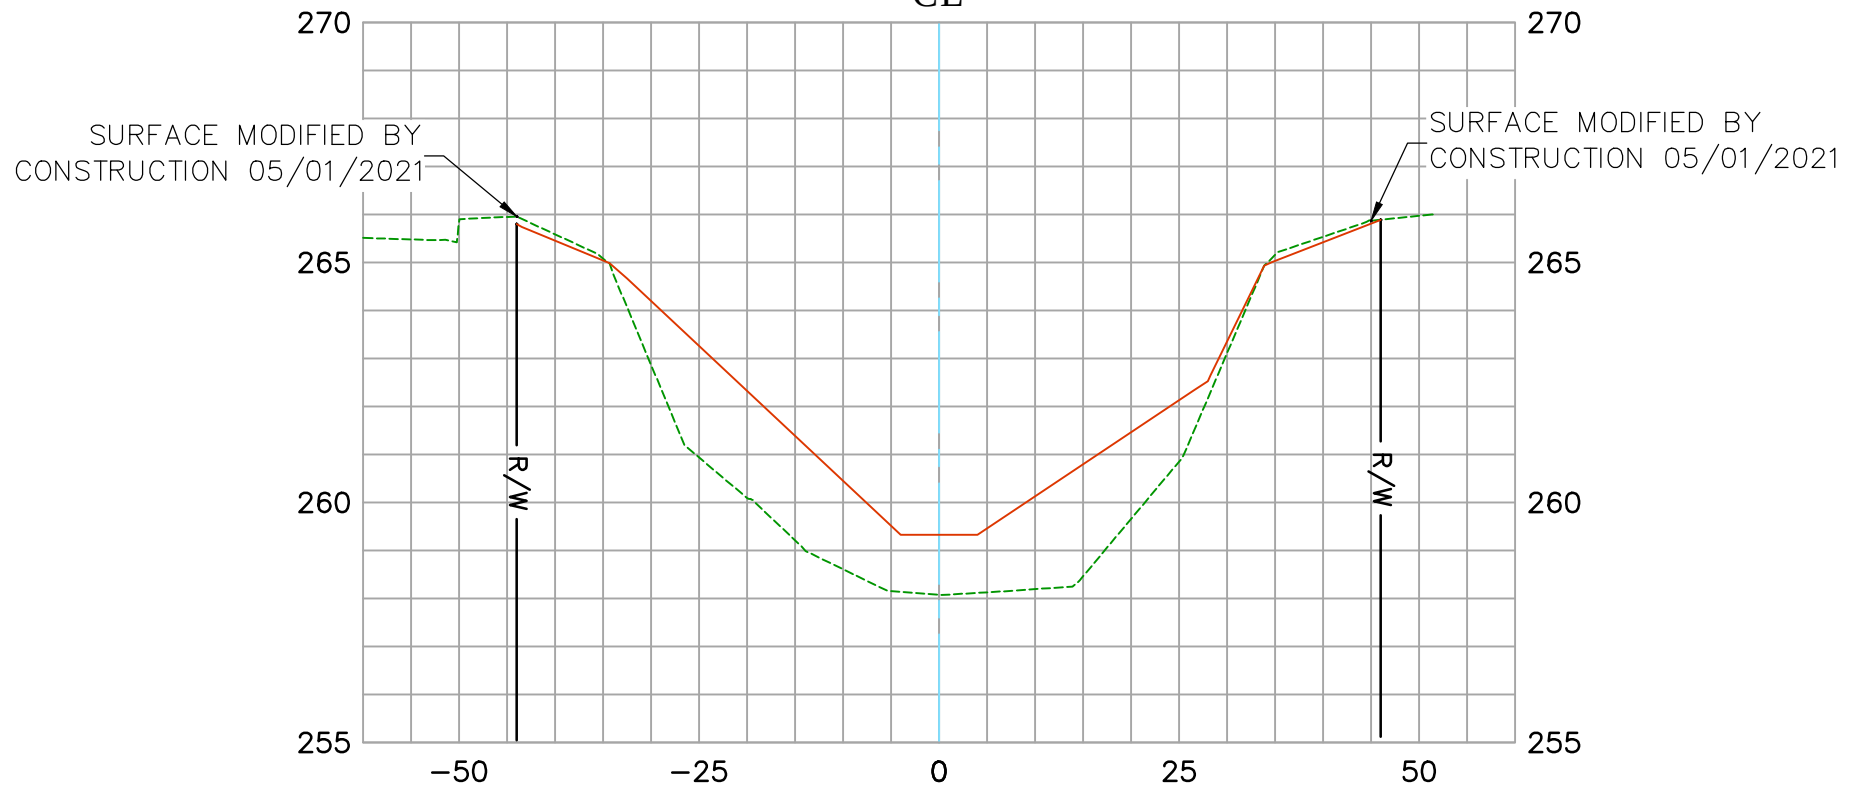

EXISTING CONDITION 03/18/2021
RECORD DRAWINGS:
F23-701-1, F23-701-2, & F23-701-3
DATE PREPARED: 11/01/2021

Vert. Scale: 1"=4'
Hor. Scale: 1"=20'


U.S. Survey Foot

OC Public Works
OC Survey/Field Services
Boundary Analysis & Mapping

CAÑADA CHANNEL (F23)

35+05.87

CL

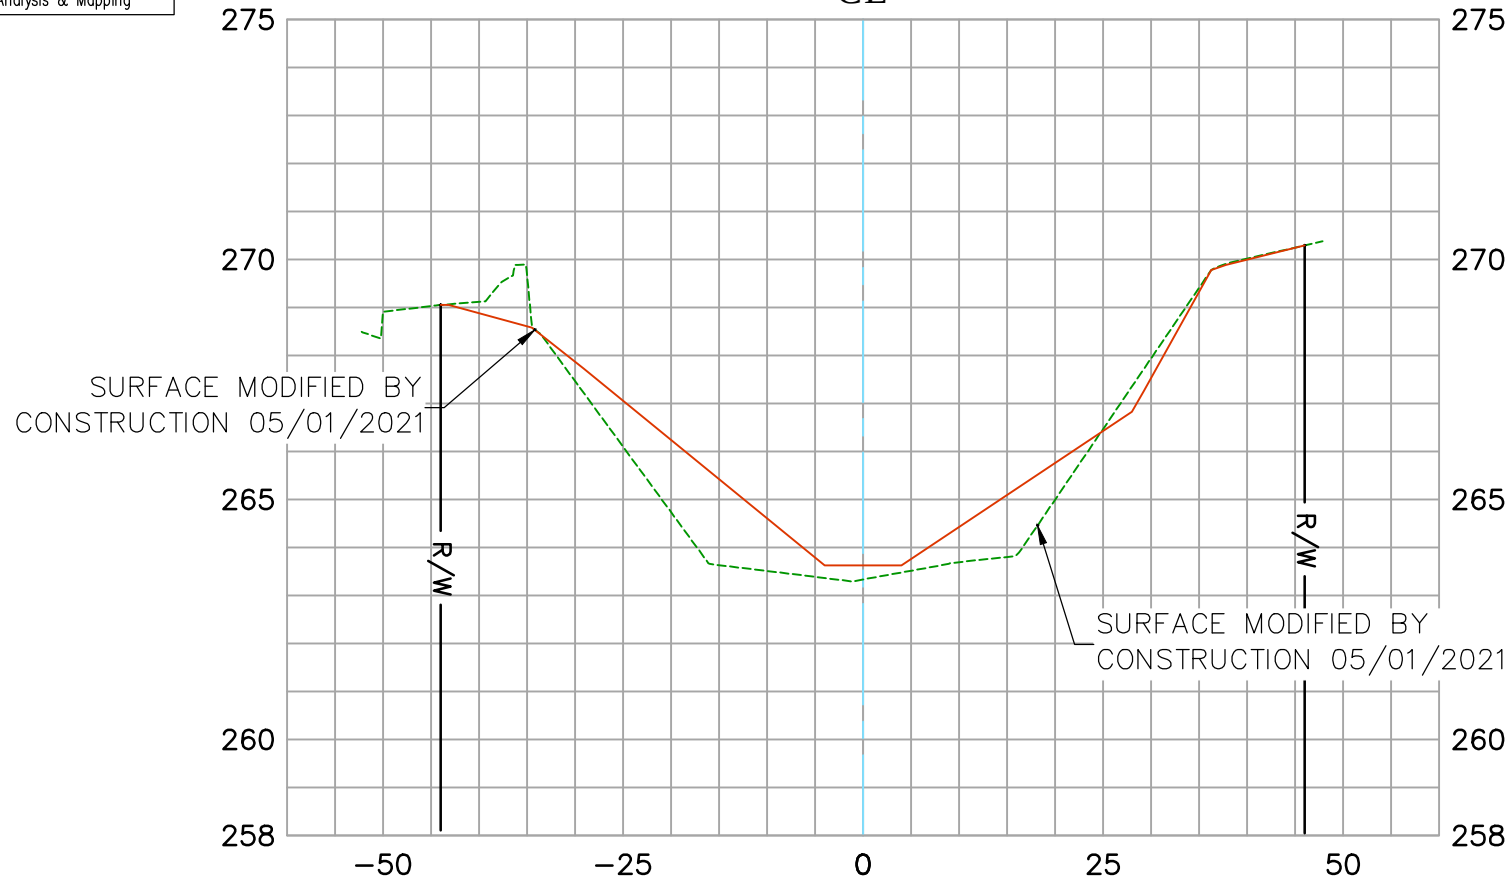

EXISTING CONDITION 03/18/2021
RECORD DRAWINGS:
F23-701-1, F23-701-2, & F23-701-3
DATE PREPARED: 11/01/2021

Vert. Scale: 1"=4'
Hor. Scale: 1"=20'


U.S. Survey Foot

OC Public Works
OC Survey/Field Services
Boundary Analysis & Mapping

CAÑADA CHANNEL (F23)

35+50.00

CL

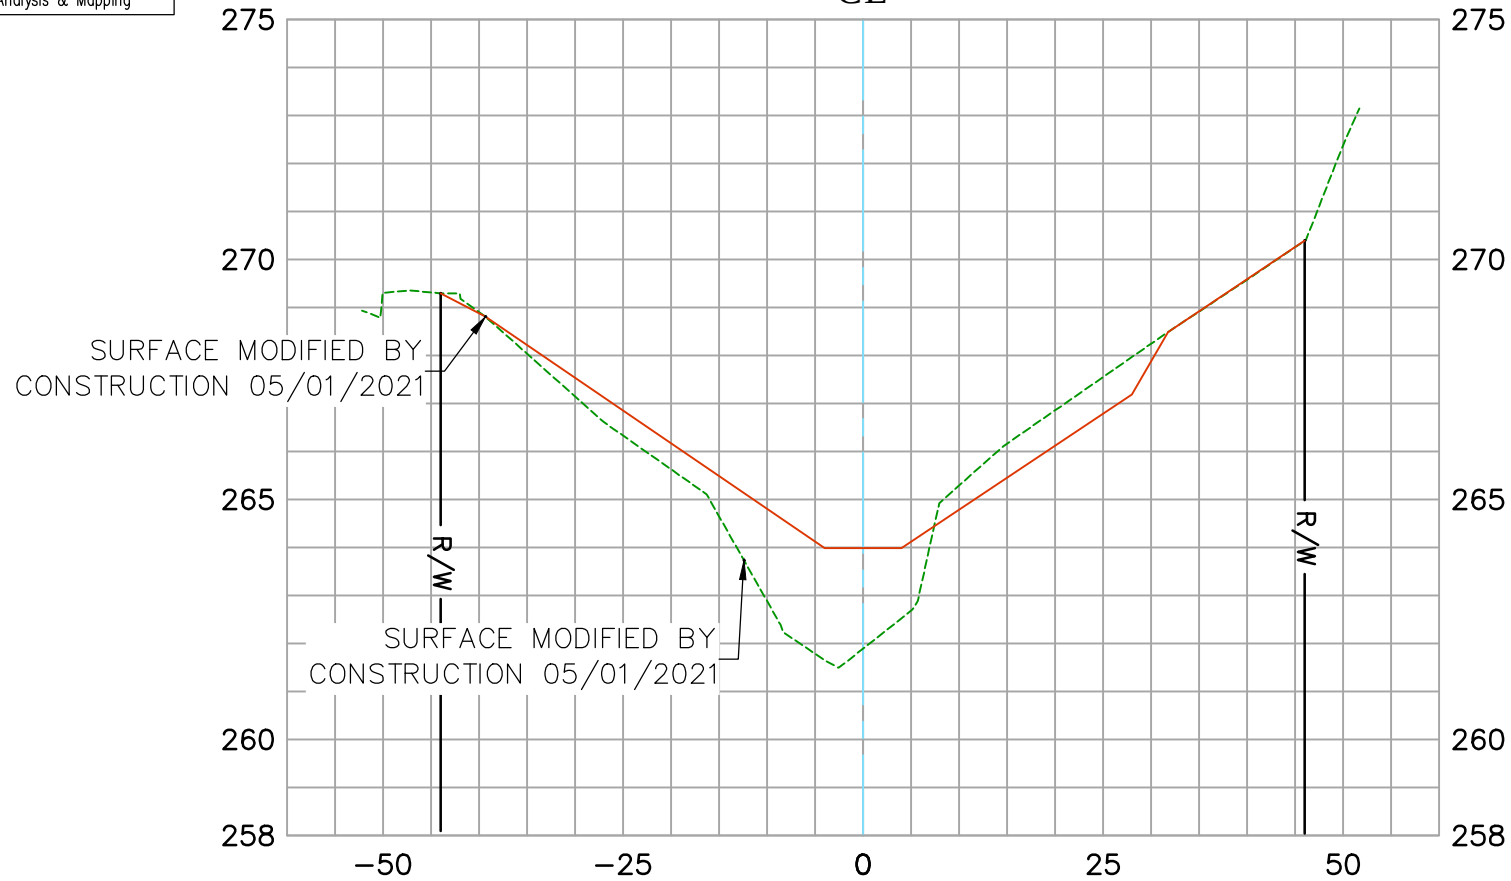

EXISTING CONDITION 03/18/2021
RECORD DRAWINGS:
F23-701-1, F23-701-2, & F23-701-3
DATE PREPARED: 11/01/2021

Vert. Scale: 1"=4'
Hor. Scale: 1"=20'


U.S. Survey Foot

OC Public Works
OC Survey/Field Services
Boundary Analysis & Mapping

CAÑADA CHANNEL (F23)

36+00.00

CL

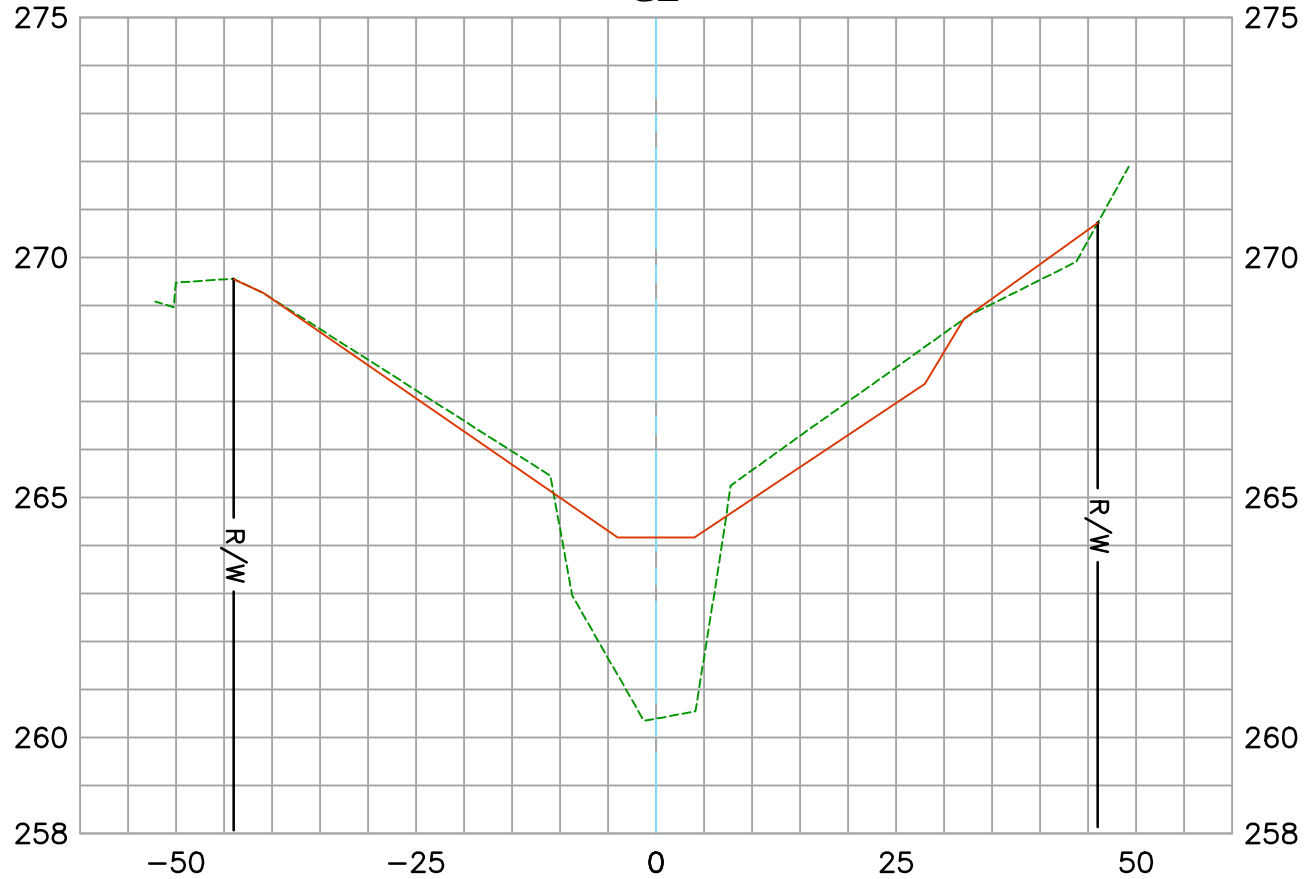

EXISTING CONDITION 03/18/2021
RECORD DRAWINGS:
F23-701-1, F23-701-2, & F23-701-3
DATE PREPARED: 11/01/2021

Vert. Scale: 1"=4'
Hor. Scale: 1"=20'


U.S. Survey Foot

OC Public Works
OC Survey/Field Services
Boundary Analysis & Mapping

CAÑADA CHANNEL (F23)

36+50.00

CL

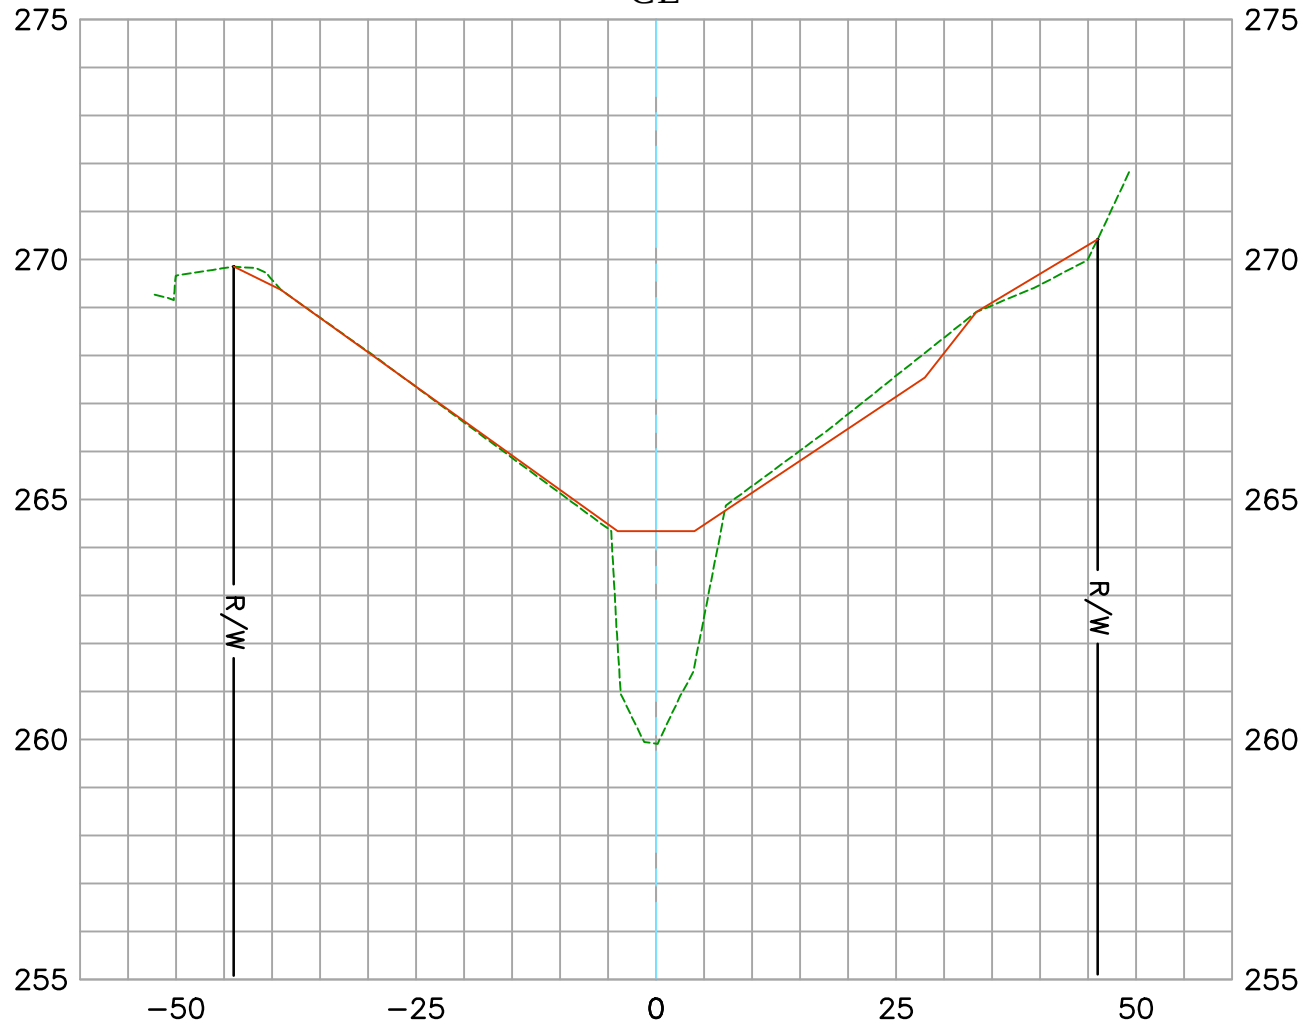

EXISTING CONDITION 03/18/2021
RECORD DRAWINGS:
F23-701-1, F23-701-2, & F23-701-3
DATE PREPARED: 11/01/2021

Vert. Scale: 1"=4'
Hor. Scale: 1"=20'

U.S. *Survey*
Foot


OC Public Works
OC Survey/Field Services
Boundary Analysis & Mapping



CAÑADA CHANNEL (F23)

37+00.00

CL

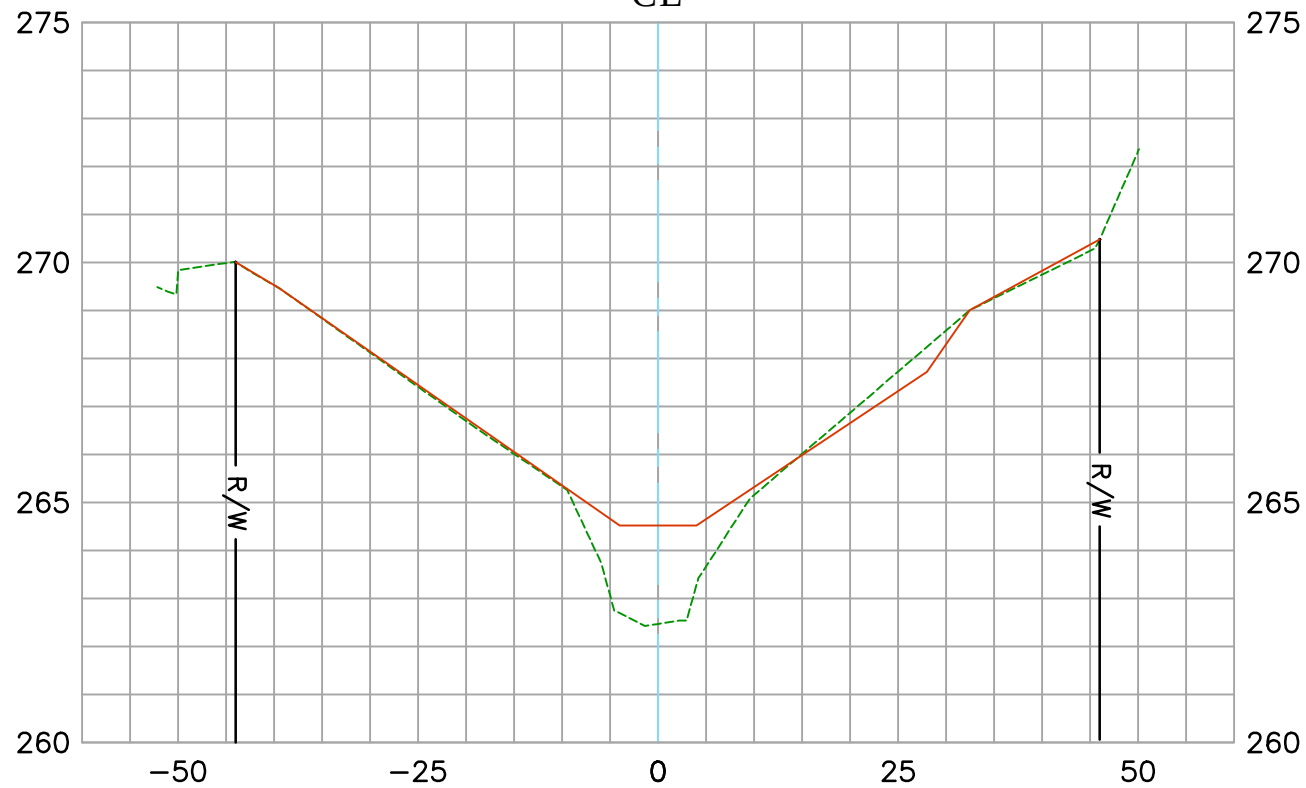

EXISTING CONDITION 03/18/2021
RECORD DRAWINGS:
F23-701-1, F23-701-2, & F23-701-3
DATE PREPARED: 11/01/2021

Vert. Scale: 1"=4'
Hor. Scale: 1"=20'

U.S. *Survey*
Foot


OC Public Works
OC Survey/Field Services
Boundary Analysis & Mapping



CAÑADA CHANNEL (F23)

37+50.00

CL

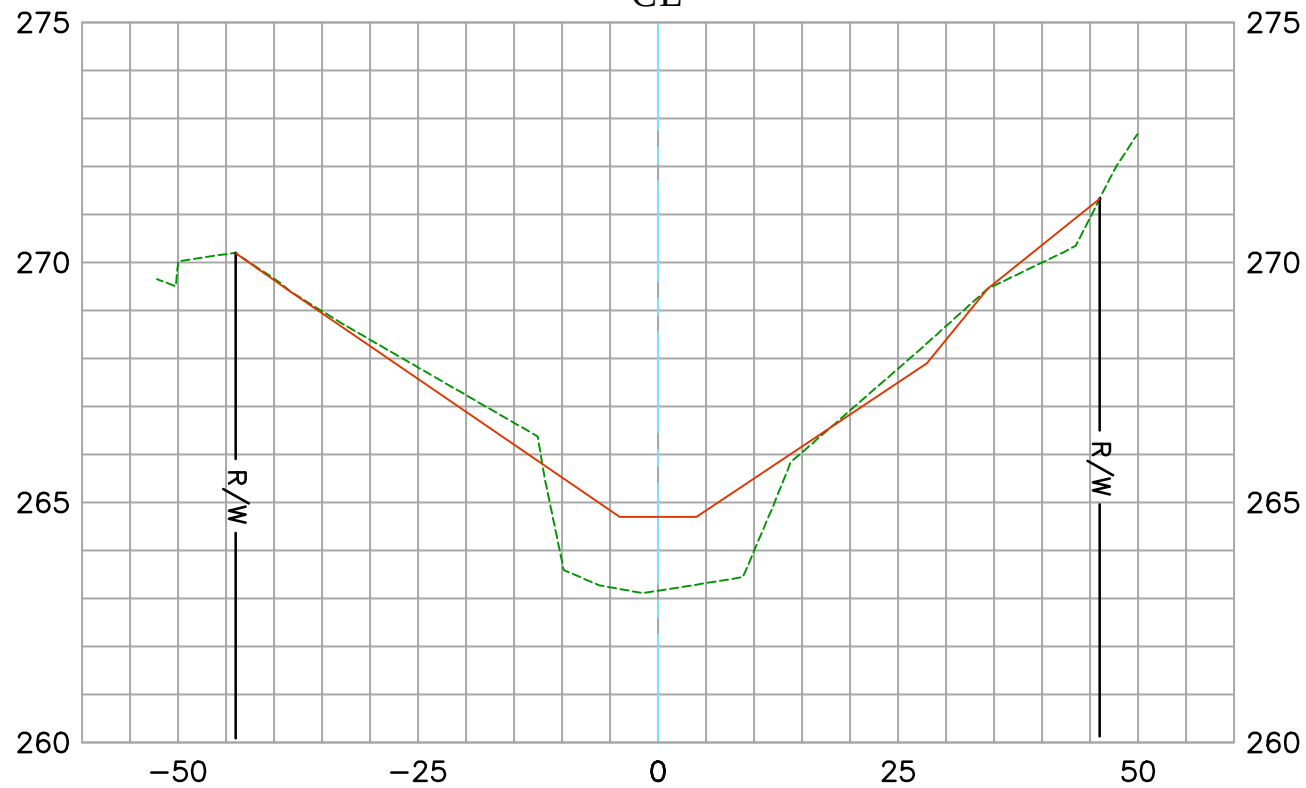

EXISTING CONDITION 03/18/2021
RECORD DRAWINGS:
F23-701-1, F23-701-2, & F23-701-3
DATE PREPARED: 11/01/2021

Vert. Scale: 1"=4'
Hor. Scale: 1"=20'

U.S. *Survey*
Foot


OC Public Works
OC Survey/Field Services
Boundary Analysis & Mapping



CAÑADA CHANNEL (F23)

38+00.00

CL

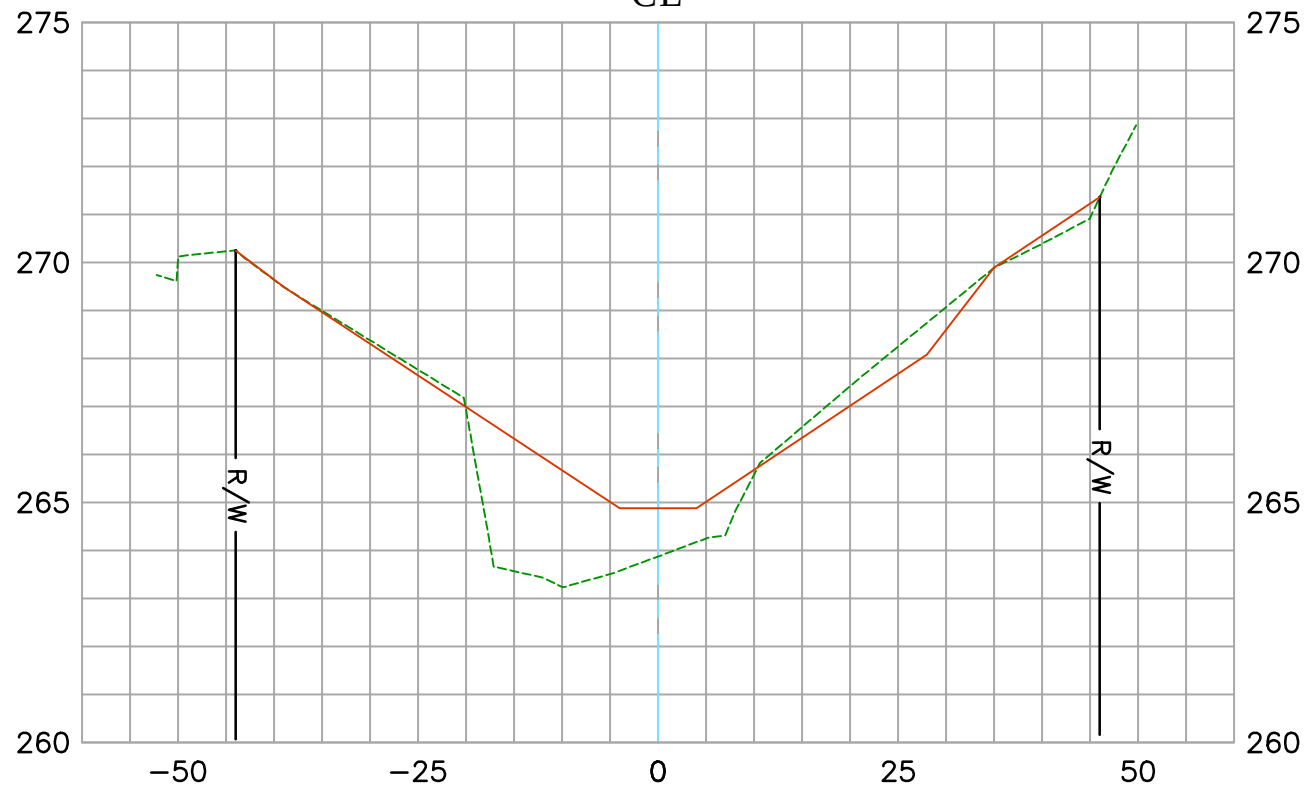

EXISTING CONDITION 03/18/2021
RECORD DRAWINGS:
F23-701-1, F23-701-2, & F23-701-3
DATE PREPARED: 11/01/2021

Vert. Scale: 1"=4'
Hor. Scale: 1"=20'

U.S. *Survey*
Foot


OC Public Works
OC Survey/Field Services
Boundary Analysis & Mapping



CAÑADA CHANNEL (F23)

38+50.00

CL

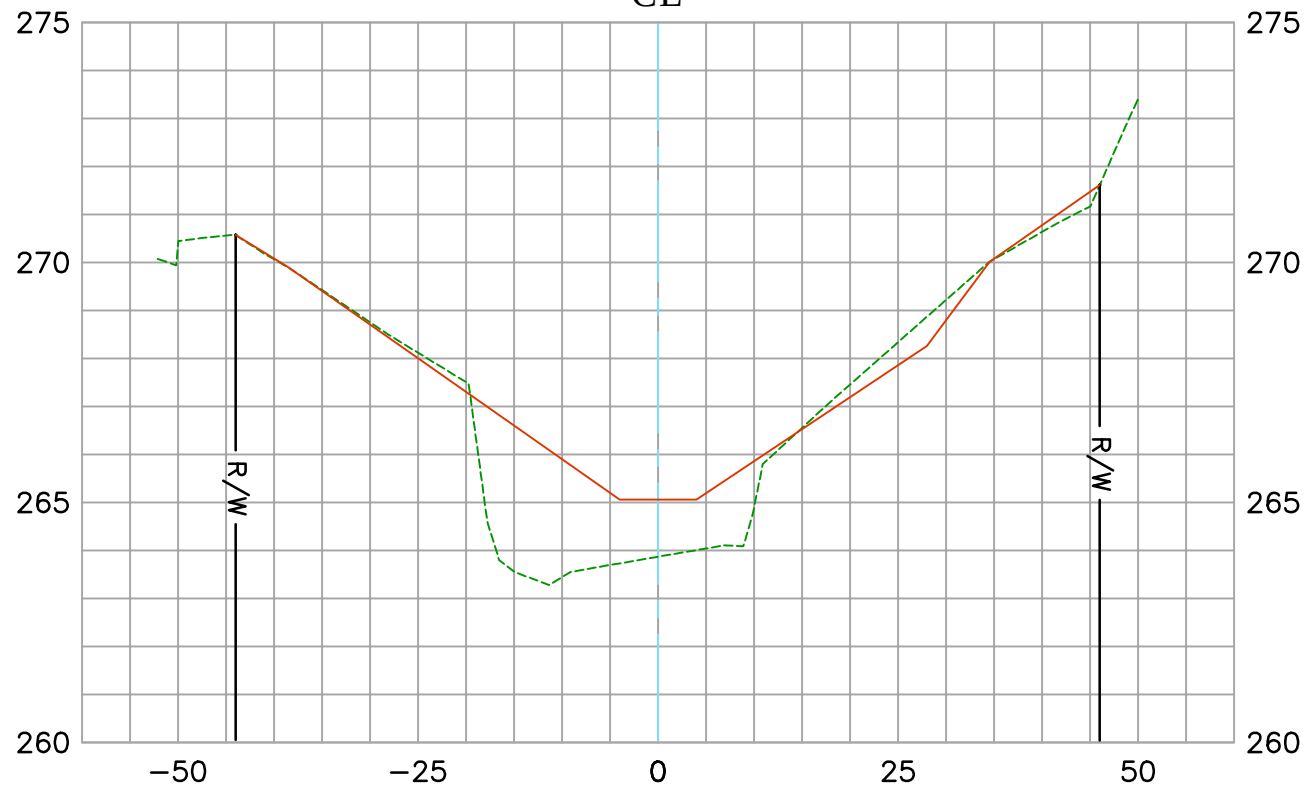

EXISTING CONDITION 03/18/2021
RECORD DRAWINGS:
F23-701-1, F23-701-2, & F23-701-3
DATE PREPARED: 11/01/2021

Vert. Scale: 1"=4'
Hor. Scale: 1"=20'

U.S. *Survey*
Foot


OC Public Works
OC Survey/Field Services
Boundary Analysis & Mapping



CAÑADA CHANNEL (F23)

39+00.00

CL

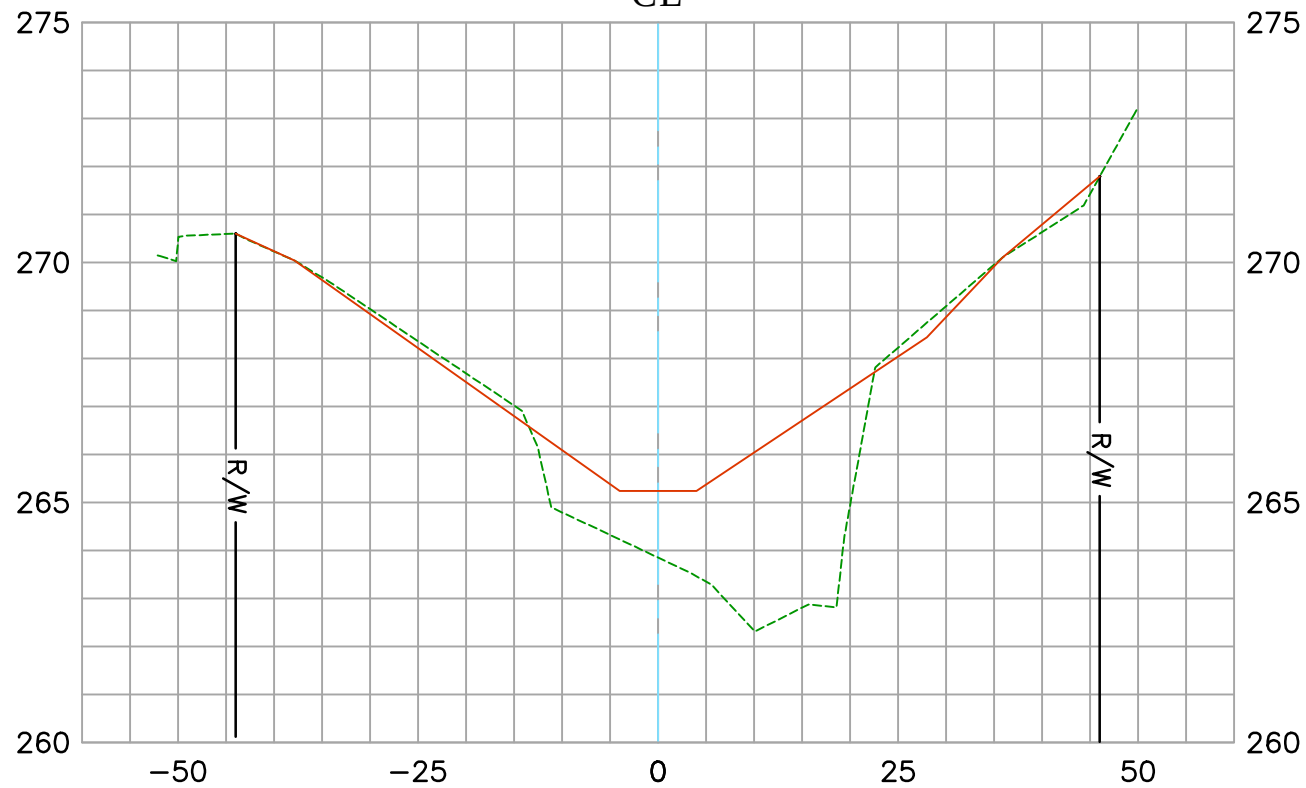

EXISTING CONDITION 03/18/2021
RECORD DRAWINGS:
F23-701-1, F23-701-2, & F23-701-3
DATE PREPARED: 11/01/2021

Vert. Scale: 1"=4'
Hor. Scale: 1"=20'

U.S. *Survey*
Foot


OC Public Works
OC Survey/Field Services
Boundary Analysis & Mapping



CAÑADA CHANNEL (F23)

39+50.00

CL

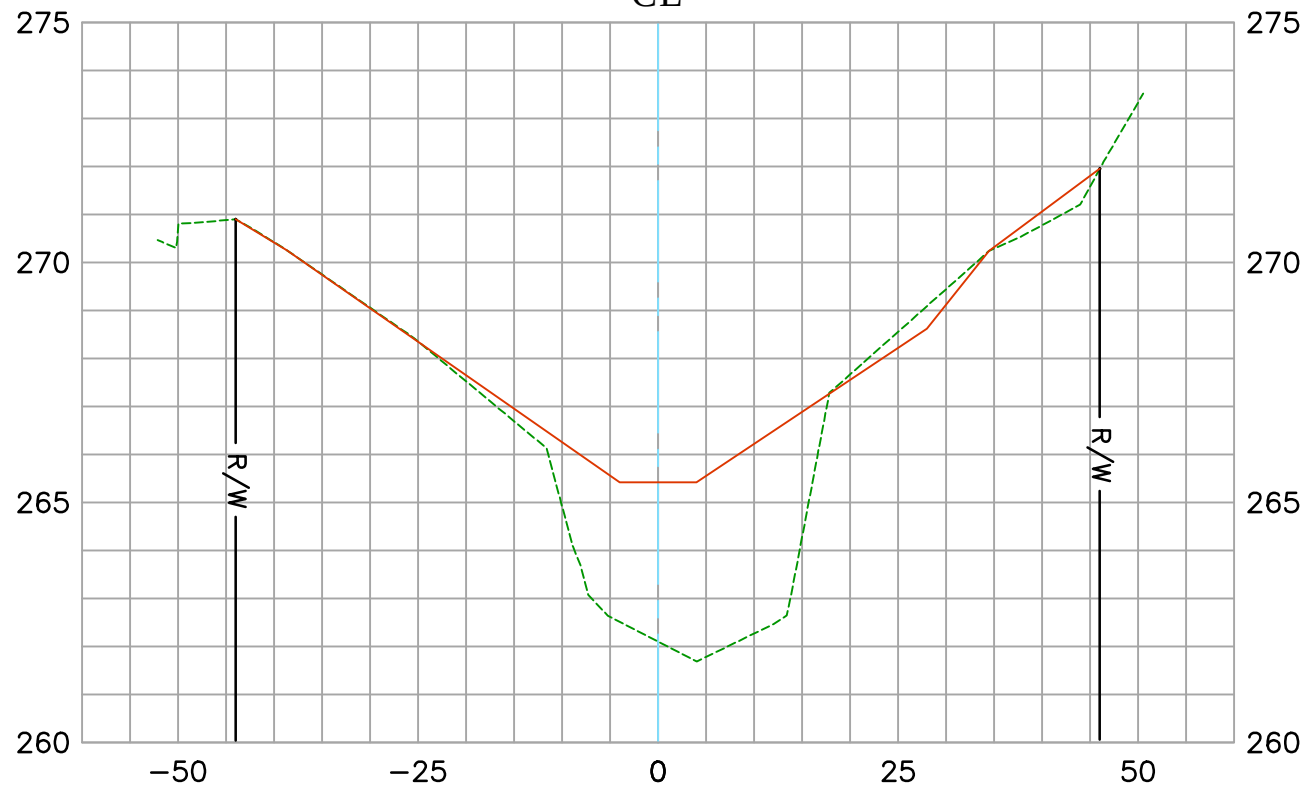

EXISTING CONDITION 03/18/2021
RECORD DRAWINGS:
F23-701-1, F23-701-2, & F23-701-3
DATE PREPARED: 11/01/2021

Vert. Scale: 1"=4'
Hor. Scale: 1"=20'

U.S. *Survey*
Foot


OC Public Works
OC Survey/Field Services
Boundary Analysis & Mapping



CAÑADA CHANNEL (F23)

40+00.00

CL

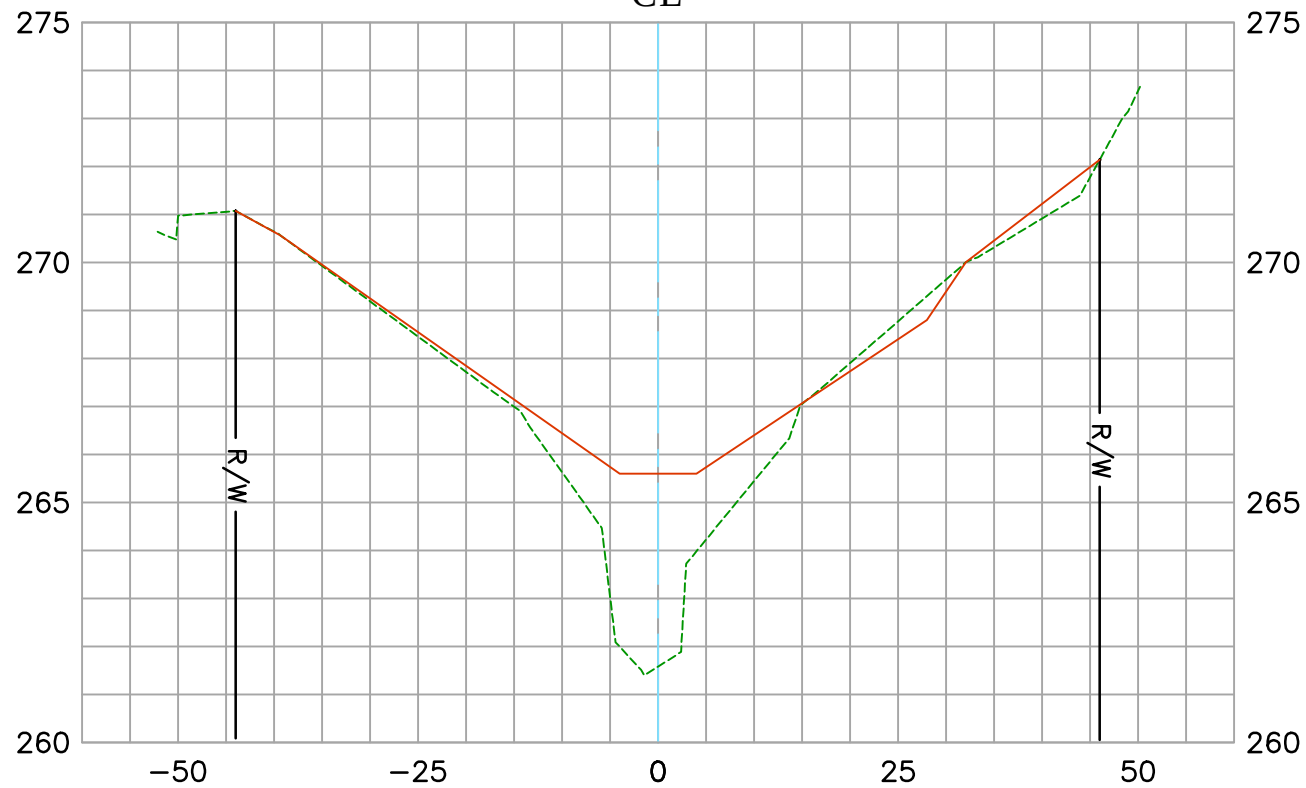

EXISTING CONDITION 03/18/2021
RECORD DRAWINGS:
F23-701-1, F23-701-2, & F23-701-3
DATE PREPARED: 11/01/2021

Vert. Scale: 1"=4'
Hor. Scale: 1"=20'

U.S. *Survey*
Foot


OC Public Works
OC Survey/Field Services
Boundary Analysis & Mapping



CAÑADA CHANNEL (F23)

40+50.00

CL

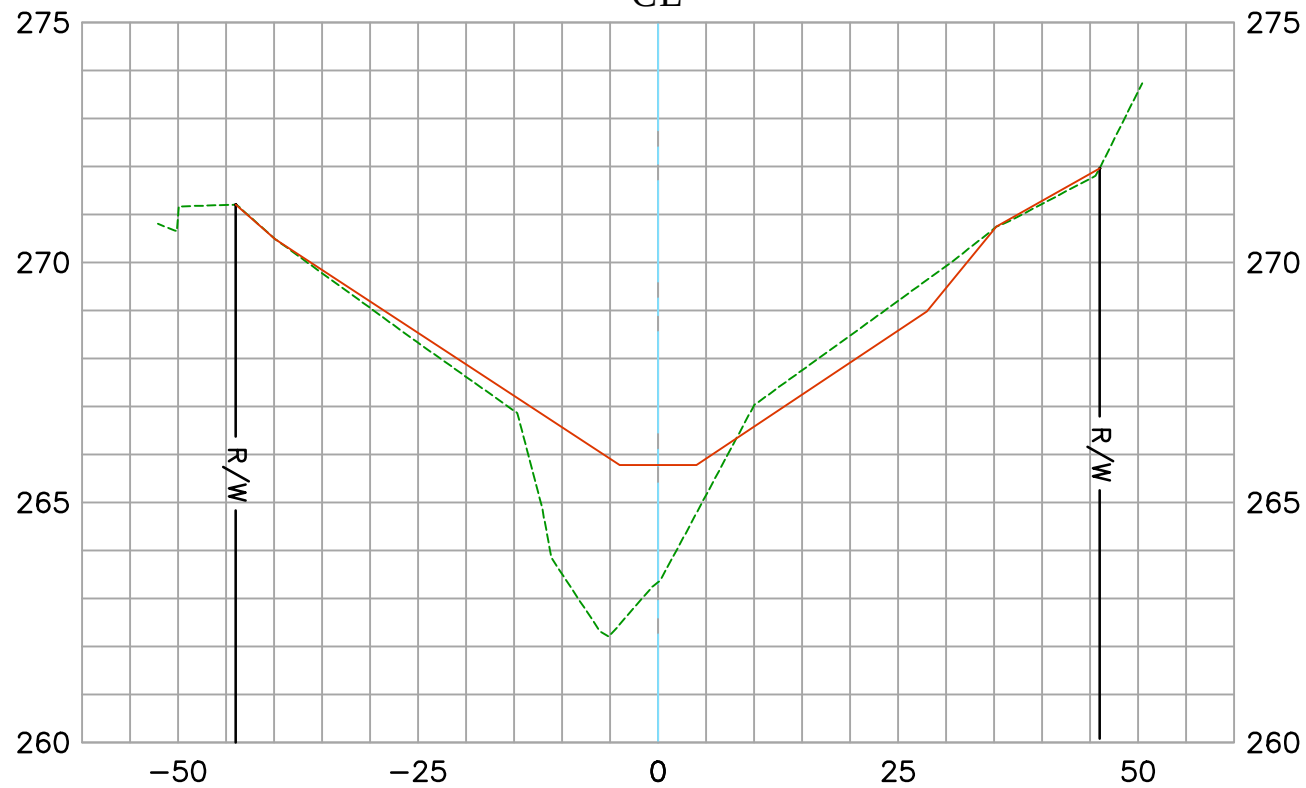

EXISTING CONDITION 03/18/2021
RECORD DRAWINGS:
F23-701-1, F23-701-2, & F23-701-3
DATE PREPARED: 11/01/2021

Vert. Scale: 1"=4'
Hor. Scale: 1"=20'

U.S. *Survey*
Foot


OC Public Works
OC Survey/Field Services
Boundary Analysis & Mapping



CAÑADA CHANNEL (F23)

41+00.00

CL

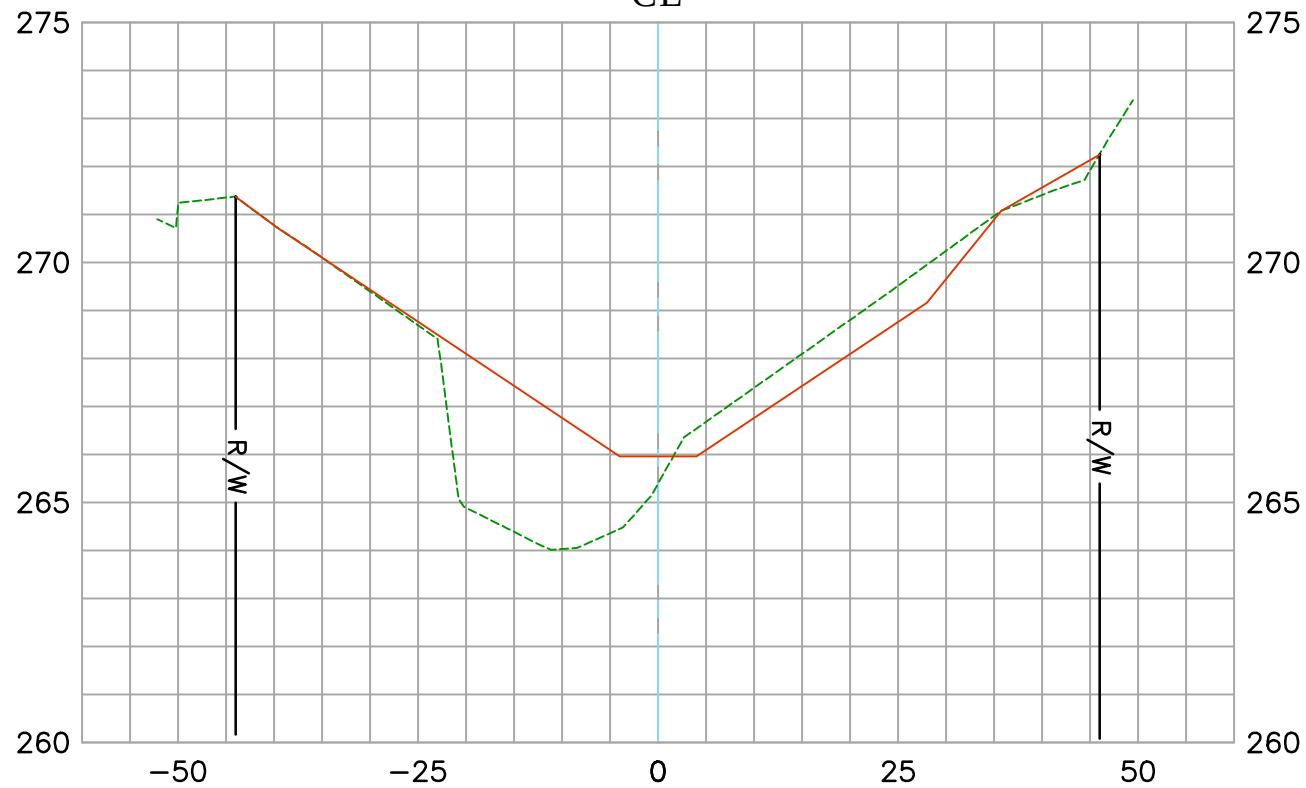

EXISTING CONDITION 03/18/2021
RECORD DRAWINGS:
F23-701-1, F23-701-2, & F23-701-3
DATE PREPARED: 11/01/2021

Vert. Scale: 1"=4'
Hor. Scale: 1"=20'

U.S. *Survey*
Foot


OC Public Works
OC Survey/Field Services
Boundary Analysis & Mapping



CAÑADA CHANNEL (F23)

41+50.00

CL

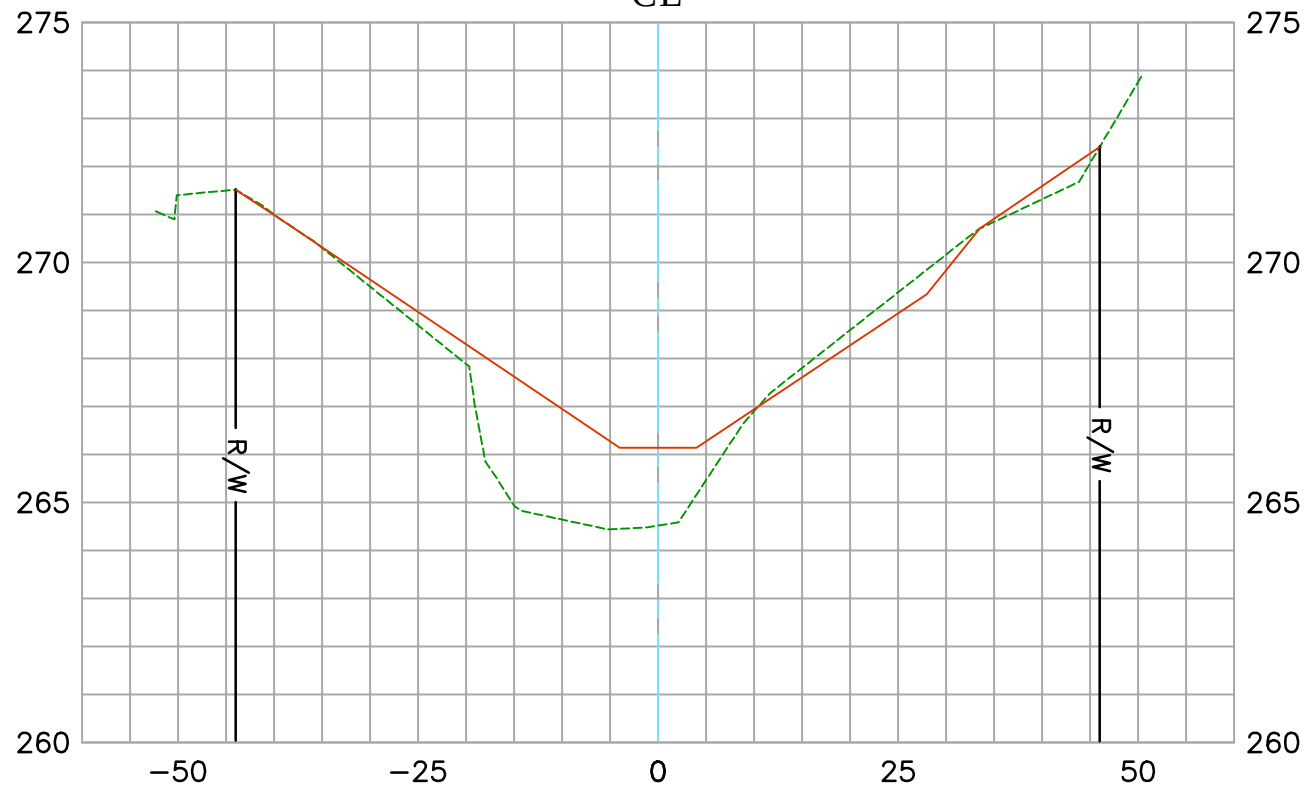

EXISTING CONDITION 03/18/2021
RECORD DRAWINGS:
F23-701-1, F23-701-2, & F23-701-3
DATE PREPARED: 11/01/2021

Vert. Scale: 1"=4'
Hor. Scale: 1"=20'


U.S. Survey Foot

OC Public Works
OC Survey/Field Services
Boundary Analysis & Mapping

CAÑADA CHANNEL (F23)

42+00.00

CL

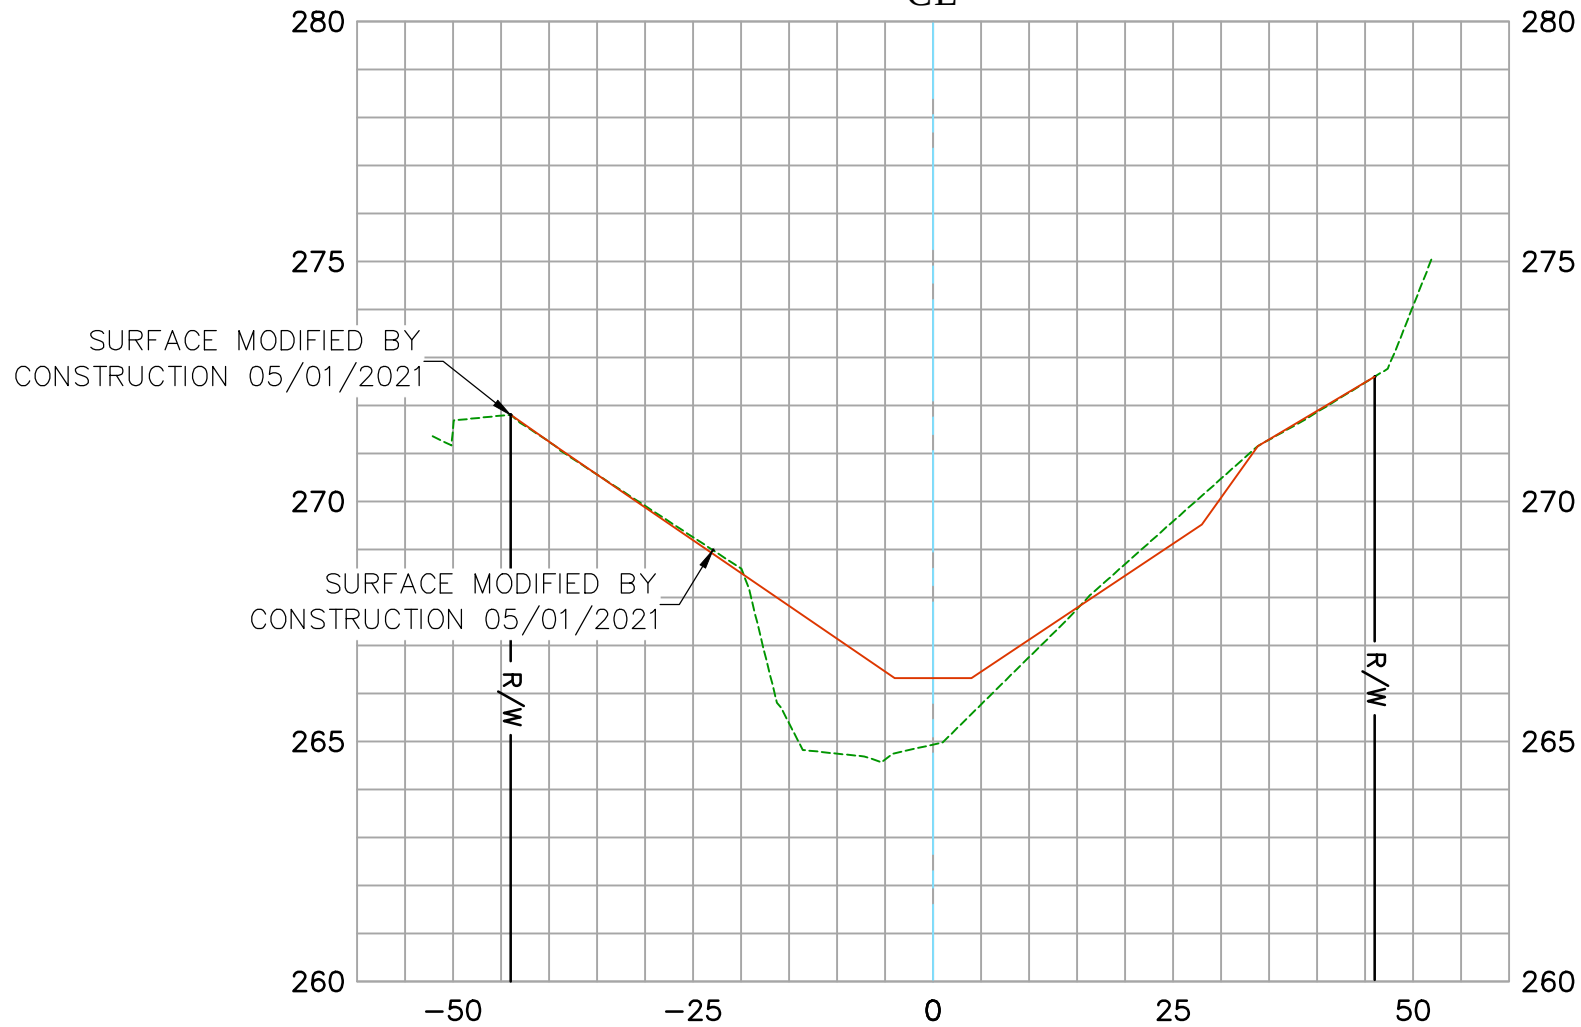

EXISTING CONDITION 03/18/2021
RECORD DRAWINGS:
F23-701-1, F23-701-2, & F23-701-3
DATE PREPARED: 11/01/2021

Vert. Scale: 1"=4'
Hor. Scale: 1"=20'

U.S. *Survey*
Foot

OC Public Works
OC Survey/Field Services
Boundary Analysis & Mapping

CAÑADA CHANNEL (F23)


42+50.00

CL



SURFACE MODIFIED BY
CONSTRUCTION 05/01/2021

SURFACE MODIFIED BY
CONSTRUCTION 05/01/2021

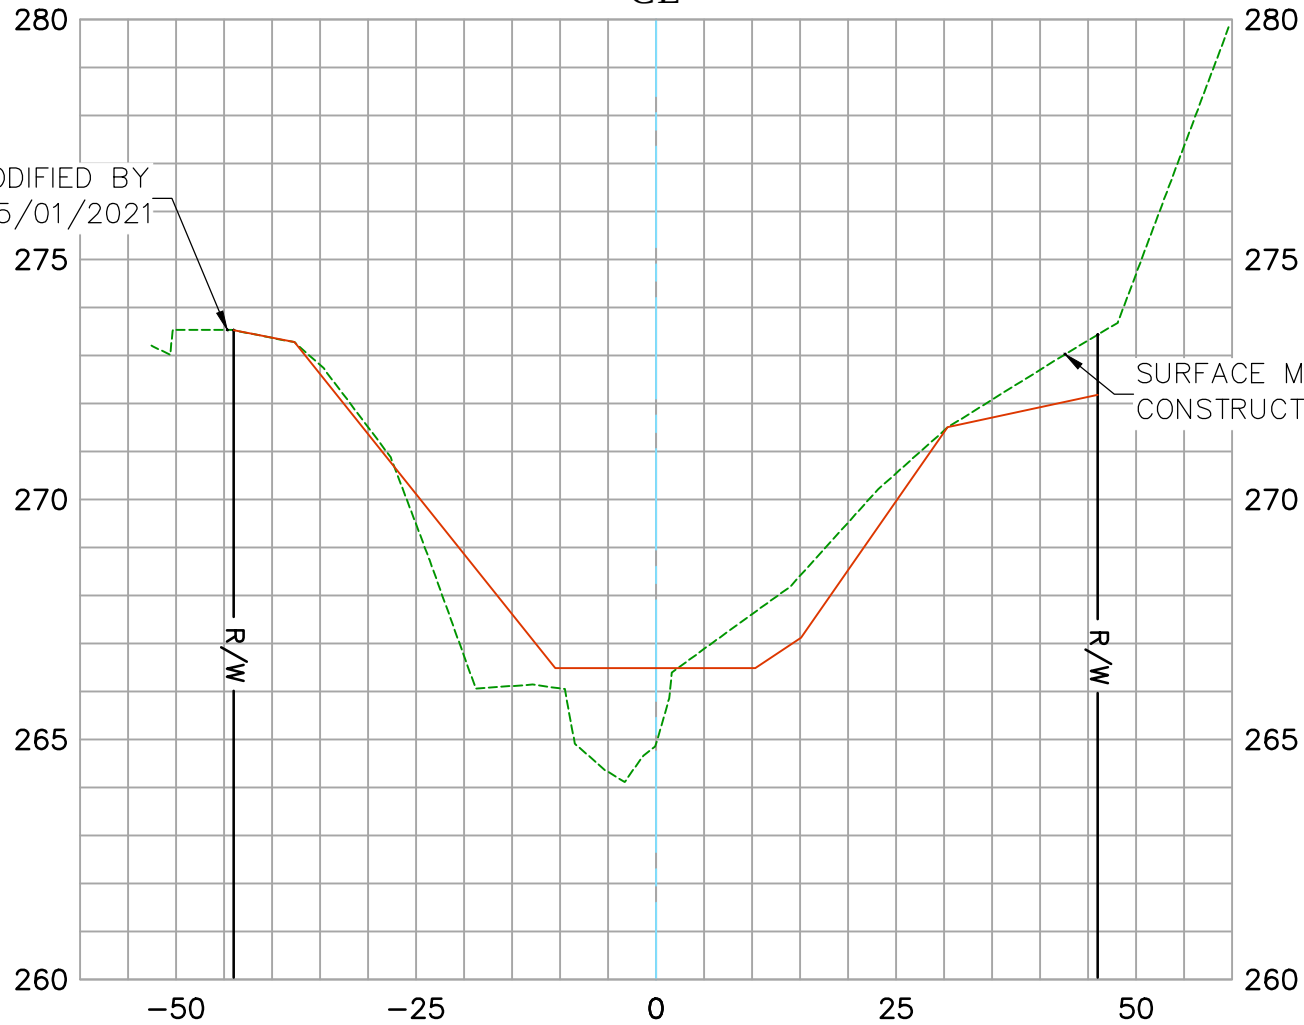

EXISTING CONDITION 03/18/2021
RECORD DRAWINGS:
F23-701-1, F23-701-2, & F23-701-3
DATE PREPARED: 11/01/2021

Vert. Scale: 1"=4'
Hor. Scale: 1"=20'

U.S. *Survey*
Foot


OC Public Works
OC Survey/Field Services
Boundary Analysis & Mapping

CAÑADA CHANNEL (F23)
43+00.00
CL



SURFACE MODIFIED BY
CONSTRUCTION 05/01/2021

SURFACE MODIFIED BY
CONSTRUCTION 05/01/2021

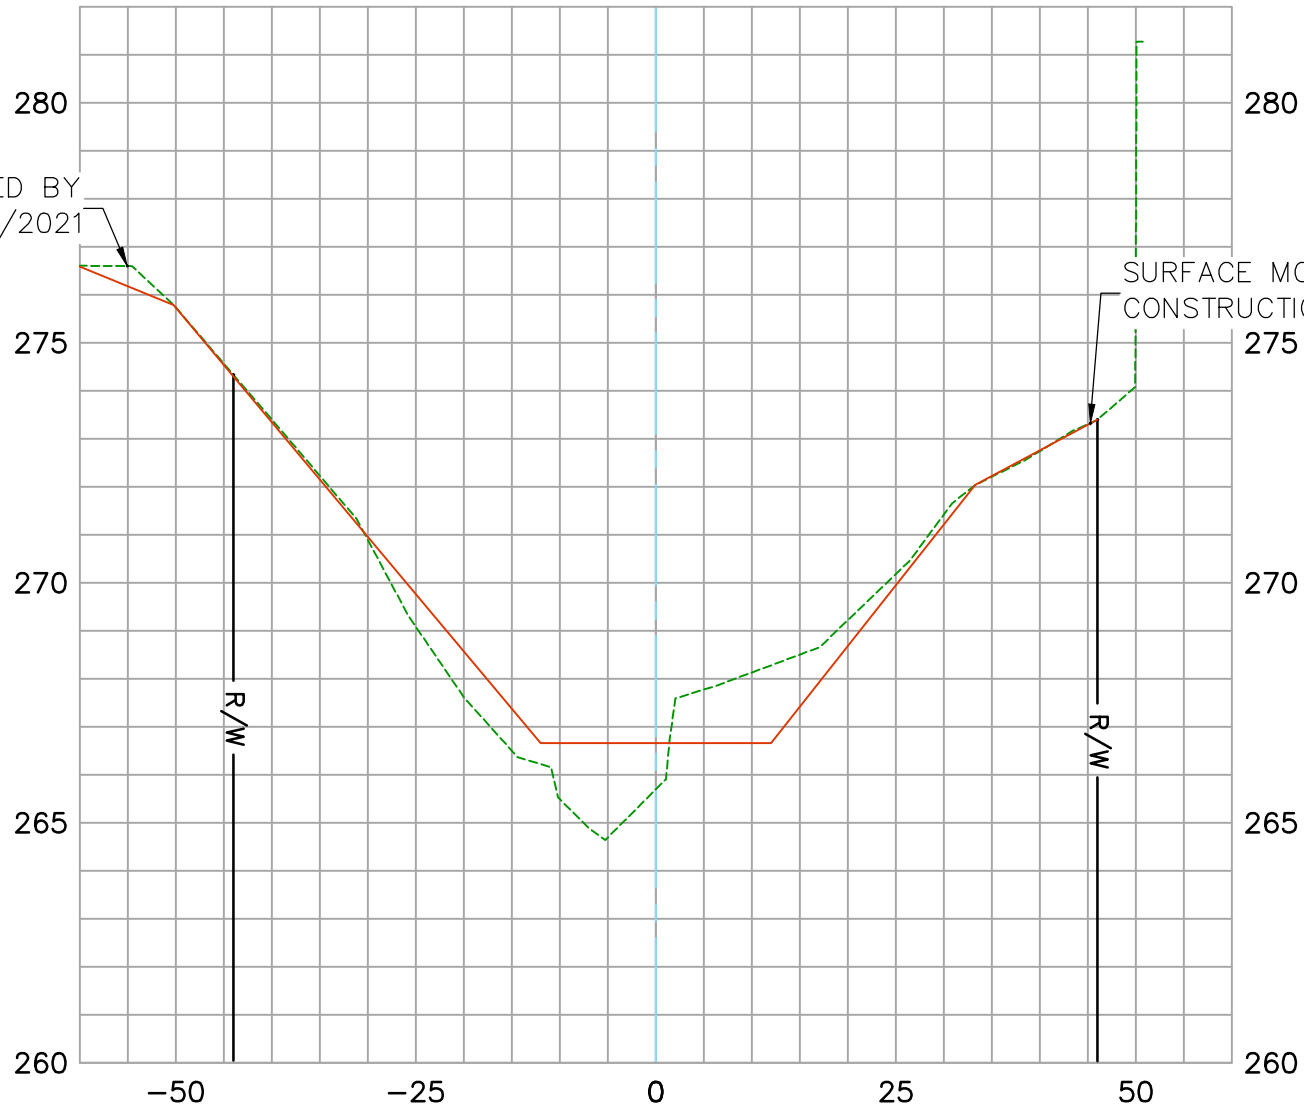

EXISTING CONDITION 03/18/2021
RECORD DRAWINGS:
F23-701-1, F23-701-2, & F23-701-3
DATE PREPARED: 11/01/2021

Vert. Scale: 1"=4'
Hor. Scale: 1"=20'

U.S. *Survey*
Foot


OC Public Works
OC Survey/Field Services
Boundary Analysis & Mapping



CAÑADA CHANNEL (F23)

43+43.66

CL

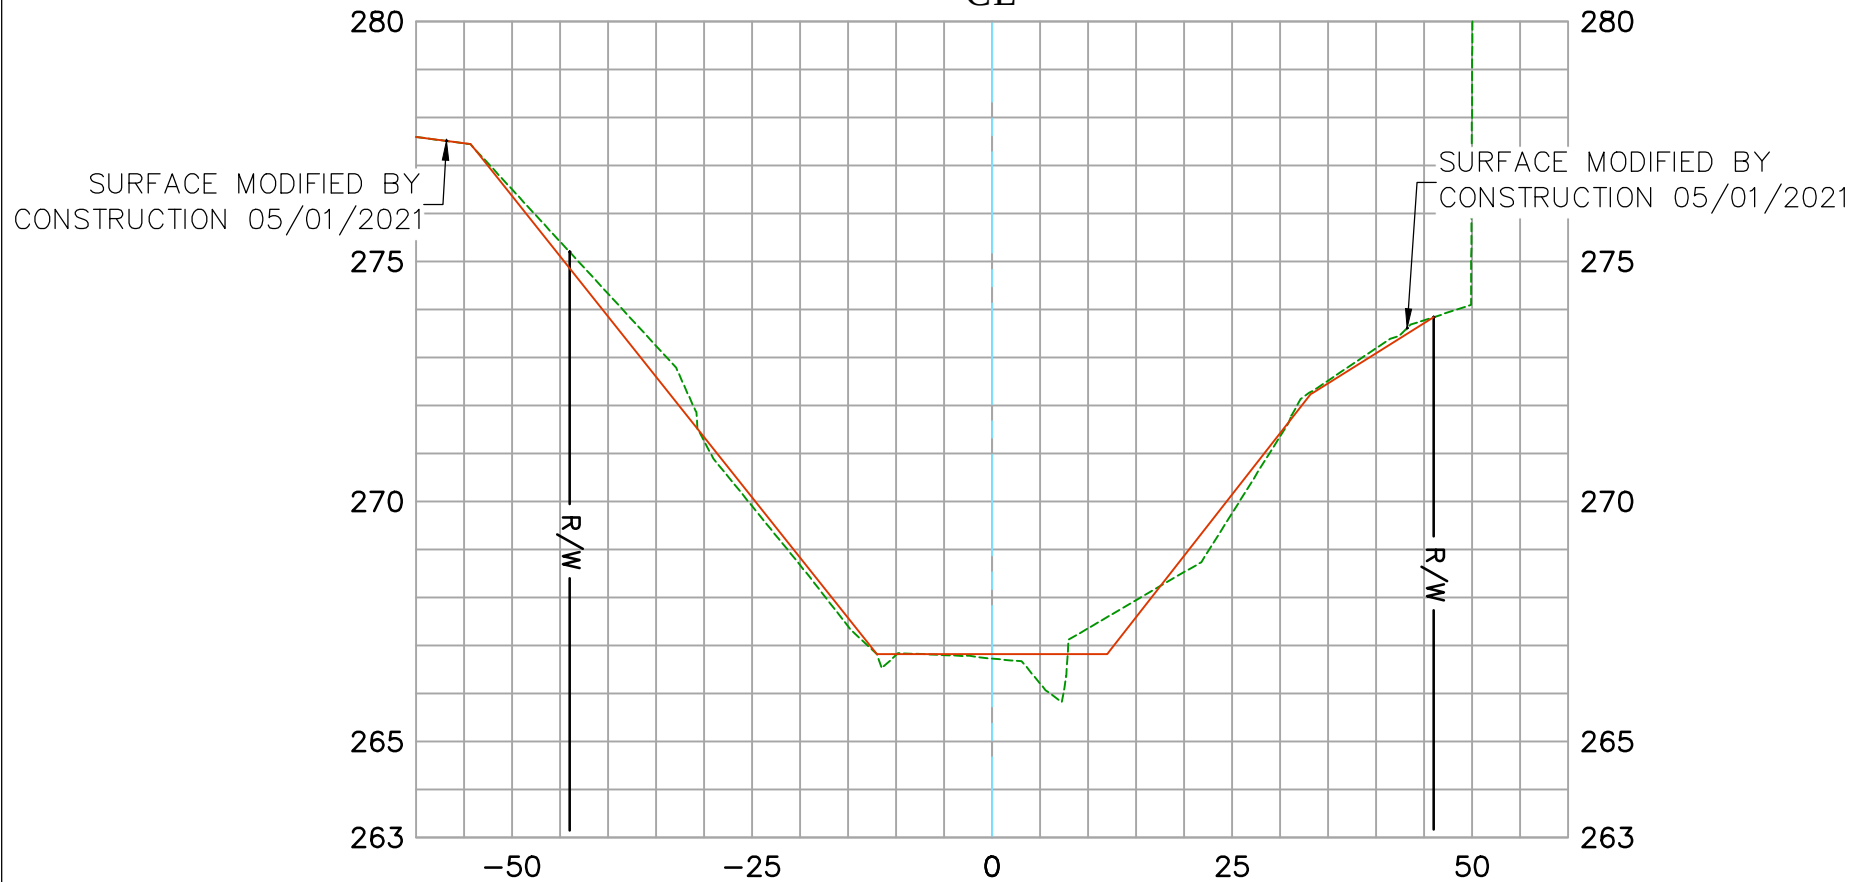

EXISTING CONDITION 03/18/2021
RECORD DRAWINGS:
F23-701-1, F23-701-2, & F23-701-3
DATE PREPARED: 11/01/2021

Vert. Scale: 1"=4'
Hor. Scale: 1"=20'