



1. ALL WORK SHALL CONFORM TO THE MOST CURRENT EDITION OF THE STANDARD SPECIFICATIONS FOR PUBLIC WORKS CONSTRUCTION, CITY OF IRVINE STANDARD DRAWINGS, CITY OF IRVINE STANDARD SPECIFICATIONS, THE UNIFORM BUILDING CODE, THE WORK AREA TRAFFIC CONTROL HANDBOOK (W.A.T.C.H. MANUAL), CALTRANS STANDARD SPECIFICATIONS, ADA, CALIFORNIA MUTCD AND TITLE 24.
2. THE CONTRACTOR SHALL TELEPHONE THE CITY OF IRVINE INSPECTIONS (949) 724-6500 AND THE CITY OF IRVINE TRAFFIC OPERATIONS (949) 724-7649, AT LEAST TWO WORKING DAYS (48 HOURS) PRIOR TO STARTING CONSTRUCTION.
3. ALL UNDERGROUND FACILITIES SHALL BE INSTALLED PRIOR TO SURFACING OF STREETS. THE INSTALLATION OF ALL UNDERGROUND FACILITIES CROSSING EXISTING ARTERIAL STREETS REQUIRES BORING OR JACKING, UNLESS OTHERWISE APPROVED BY THE CITY ENGINEER.
4. ANY EXISTING PAVEMENT DISTURBED BY THE CONSTRUCTION OF UNDERGROUND INSTALLATIONS SHALL BE COVERED BY A PERMIT ISSUED BY THE CITY OF IRVINE.
5. IT SHALL BE THE CONTRACTOR'S RESPONSIBILITY TO ARRANGE FOR AND COORDINATE THE RELOCATION OF ANY EXISTING UTILITIES DEEMED NECESSARY BY THE PROPOSED IMPROVEMENT.
6. WHENEVER IT BECOMES NECESSARY TO TUNNEL UNDER EXISTING IMPROVEMENTS, THE CONTRACTOR SHALL SUPPORT THOSE IMPROVEMENTS IN A MANNER APPROVED BY THE CITY ENGINEER, OR THE CONTRACTOR SHALL SAWCUT, REMOVE AND REPLACE THOSE IMPROVEMENTS IN ACCORDANCE WITH THE CITY OF IRVINE STANDARD DRAWINGS.
7. IT SHALL BE THE CONTRACTOR'S RESPONSIBILITY TO LOCATE NEW SEWER LATERALS CONSTRUCTED AND TO STAMP THE CURB WITH AN "S" ABOVE THE NEW LATERAL. INDIVIDUAL SEWER AND WATER SERVICES SHALL NOT BE LOCATED UNDER A DRIVEWAY.
8. IT SHALL BE THE CONTRACTOR'S RESPONSIBILITY TO LOCATE AND STAMP THE CURB ON EACH SIDE OF THE STREET WITH THE APPROPRIATE LETTER: "E" FOR EDISON, "T" FOR TELEPHONE, ETC., WHEREVER UNDERGROUND FACILITIES CROSS A STREET.
9. PRIOR TO PLACING OF UNDERGROUND UTILITIES, THE LOCATION OF ALL UNDERGROUND FACILITIES (ELECTRICAL, TELEPHONE, CABLE TV, GAS, ETC.) SHALL BE ADDED TO IMPROVEMENT PLANS.
10. IT SHALL BE THE CONTRACTOR'S RESPONSIBILITY TO VERIFY THE LOCATION OF ALL EXISTING UNDERGROUND UTILITIES (BY POT-HOLING OR OTHER MEANS). CONTRACTORS SHALL NOTIFY UNDERGROUND SERVICE ALERT (U.S.A.) (800) 422-4133 AT LEAST TWO (2) WORKING DAYS PRIOR TO ANY EXCAVATION TO LOCATE EXISTING UTILITIES.
11. ALL CONCRETE WORK AS SHOWN ON PLANS (CURB & GUTTER, STORM DRAIN, PIPE, MANHOLES, SIDEWALK, ETC.) SHALL BE EXTRA STRENGTH CONCRETE WITH 7 SACK TYPE II CEMENT OR 6 SACK TYPE V CEMENT, UNLESS DEEMED UNNECESSARY BY SULPHATE CONTENT TESTS AS APPROVED BY THE CITY OF IRVINE.
12. CONTRACTOR SHALL OBTAIN ANY REQUIRED O.S.H.A. PERMITS PRIOR TO ANY EXCAVATIONS.
13. ARROW BOARDS SHALL BE USED ON ANY LANE CLOSURES ON ARTERIAL STREETS.
14. SLURRY BACKFILL SHALL BE REQUIRED WHEN TUNNELING UNDER CURB AND GUTTER. SLURRY BACKFILL IS REQUIRED AROUND ALL MANHOLE CONSTRUCTION WITHIN PAVED STREETS.
15. THE FOLLOWING SIGN SHALL BE POSTED AT ALL STREET INTERSECTIONS AND TRACT ENTRANCES.

MAINTENANCE OF THIS STREET AND RIGHT-OF-WAY IS THE DEVELOPER'S RESPONSIBILITY.

DEVELOPER HERITAGE FIELDS PHONE (949) 456-2555

THE SIGN SHALL HAVE 3" HIGH (MINIMUM) LETTERING AND MUST BE INSTALLED PRIOR TO ANY OCCUPANCY. DEVELOPERS SHALL REMOVE SIGNS AT THE TIME OF CITY ACCEPTANCE OF STREET IMPROVEMENTS.
16. STREET CONSTRUCTION AND IMPROVEMENTS SHALL NOT BE OPENED FOR PUBLIC USE UNTIL ACCEPTED BY THE CITY.
17. ALL IMPROVEMENTS AND TRAFFIC SIGNAL WORK WITHIN THE STATE RIGHT-OF-WAY SHALL CONFORM TO CURRENT CALTRANS STANDARD SPECIFICATIONS.
18. CONTRACTOR SHALL VERIFY ALL EXISTING CONDITIONS AND DIMENSIONS BEFORE STARTING WORK. SHOULD CONDITIONS EXIST WHICH ARE CONTRARY TO THOSE SHOWN ON PLANS, THE DESIGN ENGINEER SHALL BE NOTIFIED BEFORE PROCEEDING WITH WORK.
19. IT SHALL BE THE RESPONSIBILITY OF THE CONTRACTOR TO ASSURE THAT ALL PIPES WALLS, ETC. ARE ADEQUATELY BRACED DURING CONSTRUCTION.
20. ALL WORK SHALL CONFORM TO THE PLANS AND SPECIFICATIONS IN ALL RESPECTS AND SHALL BE SUBJECT TO APPROVAL BY THE CITY'S INSPECTOR.
21. PURSUANT TO SECTION 8771 OF THE BUSINESS AND PROFESSIONS CODE, EXISTING SURVEY MONUMENTS SHALL BE NOTED AND DOCUMENTED BEFORE CONSTRUCTION. IF MONUMENTS ARE DISTURBED DURING CONSTRUCTION, THE CONTRACTOR SHALL PAY A LICENSED LAND SURVEYOR OR REGISTERED CIVIL ENGINEER TO RESET SUCH MONUMENTS, UNLESS OTHERWISE SPECIFIED OR DESIGNATED.
22. CONSTRUCTION ACTIVITIES MAY OCCUR BETWEEN 7:00 A.M. AND 7:00 P.M. MONDAYS THROUGH FRIDAYS, AND 9:00 A.M. AND 6:00 P.M. ON SATURDAYS. NO CONSTRUCTION ACTIVITIES SHALL BE PERMITTED OUTSIDE OF THESE HOURS OR ON SUNDAYS AND FEDERAL HOLIDAYS UNLESS A TEMPORARY WAIVER IS GRANTED BY THE CHIEF BUILDING OFFICIAL OR HIS OR HER AUTHORIZED REPRESENTATIVE.
23. NO WORK MAY OCCUR ON ARTERIAL STREETS BEFORE 9:00 A.M. OR CONTINUE AFTER 3:00 P.M. UNLESS A TEMPORARY WAIVER IS GRANTED BY THE CHIEF BUILDING OFFICIAL OR HIS OR HER AUTHORIZED REPRESENTATIVE.

24. IF THE CONTRACTOR WISHES TO ENGAGE IN CRUSHING OPERATIONS AT THE PROJECT SITE, HE OR SHE MUST PROVIDE A WRITTEN REQUEST AND OBTAIN THE CITY'S WRITTEN APPROVAL PRIOR TO AWARD OF THE CONSTRUCTION CONTRACT. THE WRITTEN REQUEST MUST STATE THE PROPOSED LOCATION OF THE CRUSHER AND THE SOURCE OF RUBBLE TO BE CRUSHED. THE CITY HAS THE OPTION TO PERMIT OR PROHIBIT CRUSHING OPERATIONS FOR UNTREATED BASE MATERIAL IN THE IMMEDIATE VICINITY OF THE PROJECT SITE. IF ALLOWED, THE CRUSHING OPERATION MUST BE IN COMPLIANCE WITH SECTION 200-2 OF THE STANDARD SPECIFICATIONS FOR PUBLIC WORKS CONSTRUCTION.

1. STATION SHOWN AS (0 + 00) ARE STORM DRAIN STATIONS AND ARE INDEPENDENT OF ALL CENTERLINE STATIONS.
2. ALL WORK SHALL CONFORM TO THE STANDARD SPECIFICATIONS FOR PUBLIC WORKS CONSTRUCTION, CITY OF IRVINE STANDARD DRAWINGS, CITY OF IRVINE STANDARD SPECIFICATIONS, ALL APPLICABLE GENERAL NOTES AND THE STANDARD SPECIFICATIONS OF THE STATE OF CALIFORNIA WHERE APPLICABLE.
3. ALL TRENCH EXCAVATIONS SHALL CONFORM TO STATE OF CALIFORNIA CONSTRUCTION SAFETY ORDERS.
4. ALL PIPES SHALL BE BEDDED IN ACCORDANCE WITH DETAILS SHOWN ON STD PLAN 318 UNLESS OTHERWISE NOTED.
5. THE CITY OF IRVINE INSPECTION DEPARTMENT SHALL BE NOTIFIED AT LEAST TWO WORKING DAYS (48 HOURS) PRIOR TO START OF WORK AT (949) 724-6500. A PRE-CONSTRUCTION CONFERENCE IS REQUIRED PRIOR TO START OF CONSTRUCTION.
6. R.C.P. SHALL CONFORM TO APPLICABLE A.S.T.M. STANDARDS.
7. ALL FILL MATERIAL SHALL BE COMPACTED TO MINIMUM 90% RELATIVE COMPACTION AS DETERMINED BY CALIFORNIA TEST METHODS 216F.
8. ALL MATERIAL TESTING FOR THE DRAINAGE FACILITIES SHALL BE PROVIDED BY THE CONTRACTOR OR DEVELOPER IN ACCORDANCE WITH THE NUMBER, LOCATION, AND FREQUENCY REQUESTED BY THE CITY INSPECTOR.

1. A PRE-PAVING MEETING SHALL BE HELD FORTY-EIGHT (48) HOURS PRIOR TO PAVING. THE CITY OF IRVINE INSPECTOR SHALL BE NOTIFIED FOR ATTENDANCE AT THIS MEETING.
2. ASPHALT CONCRETE MIX DESIGN AND PAVEMENT SHALL BE PER THE REQUIREMENTS OF THE CITY OF IRVINE.
3. UNTREATED BASE BENEATH ASPHALT CONCRETE SHALL BE COMPACTED TO MINIMUM OF 95% RELATIVE DENSITY. COMPACTION TESTING SHALL BE IN ACCORDANCE WITH ASTM D1557 AND D6938.
4. FINAL PAVEMENT SECTIONS MUST BE APPROVED BY THE ENGINEER. THE SOILS ENGINEER SHALL SUBMIT PAVEMENT SECTION RECOMMENDATIONS BASED ON "R" VALUE ANALYSIS OF THE SUBGRADE SOILS, AND CITY APPROVED TRAFFIC INDICES. "R" VALUE TESTS SHALL BE IN ACCORDANCE WITH STATE OF CALIFORNIA TESTING METHOD 301 OR ASTM D2844 OF THE SUBGRADE SOILS.

1. ALL EXISTING SURVEY MONUMENTS ON OR AROUND THE SITE MUST BE IDENTIFIED AND SHOWN HEREON. IF EXISTING MONUMENTS ARE PRESENT WITHIN THE PROPOSED CONSTRUCTION AREA, A RECORD OF SURVEY OR CORNER RECORD SHALL BE REQUIRED TO BE FILED WITH THE COUNTY SURVEYOR (PRIOR TO PLAN APPROVAL) IN ACCORDANCE WITH THE CALIFORNIA BUSINESS AND PROFESSIONS CODE. IF EXISTING SURVEY MONUMENTS ARE DISTURBED, THE PROJECT SURVEYOR WILL BE REQUIRED TO RE-ESTABLISH SAID MONUMENTS AND FILE A FINAL RECORD OF SURVEY OR CORNER RECORD WITH THE COUNTY SURVEYOR, PRIOR TO CITY OF IRVINE PROJECT ACCEPTANCE.

THE BEARINGS SHOWN HEREON ARE BASED ON THE BEARING
BETWEEN O.C.S. HORIZONTAL CONTROL STATION GPS NO.
6621 AND STATION GPS NO. 6678 BEING SOUTH 29°04'24"
EAST PER RECORDS ON FILE IN THE OFFICE OF THE ORANGE
COUNTY SURVEYOR.

ORANGE COUNTY SURVEYOR BENCHMARK NO. "3E-120-99"

DESCRIBED BY OCS 2002 - FOUND 3 3/4" OCS ALUMINUM BENCHMARK DISK STAMPED "3E-120-99", SET IN THE NORTHERLY CORNER OF A 4 FT. BY 11 FT. CONCRETE CATCH BASIN. MONUMENT IS LOCATED ALONG THE SOUTHWESTERLY SIDE OF IRVINE BOULEVARD, 500 FT. NORTHWESTERLY OF THE CENTERLINE OF N STREET AND 60 FT. SOUTHWESTERLY OF THE CENTERLINE OF IRVINE. MONUMENT IS SET LEVEL WITH THE SIDEWALK.

NAVD 88-1999 ADJ. ELEV.= 421.098



Know what's **below**.
Call before you dig.



PREPARED FOR:

Heritage Fields El Toro, LLC

Great Park 

NEIGHBORHOODS®

25 ENTERPRISE, SUITE 400
ALISO VIEJO CA 92656

CITY APPROVAL:

APPROVED BY:
CITY ENGINEER

[illegible]

APPROVED BY:
ORANGE COUNTY FIRE MARSHAL

[illegible]

APPROVED BY:
IRVINE RANCH WATER DISTRICT
SANITARY SEWER FACILITIES

APPROVED BY:
IRVINE RANCH WATER DISTRICT
WATER FACILITIES

**CONSTRUCTION PLANS FOR THE IMPROVEMENT OF
MARINE WAY
TITLE SHEET
FROM SKYHAWK TO 3800' EASTERLY**

CITY OF IRVINE
PUBLIC WORKS DEPARTMENT








PLAN CHECK NO.
00760917-EMC

PERMIT NO.
007666 14-MCE

CIP#
311309

SHEET
1
OF **28**

K-CGT-OT

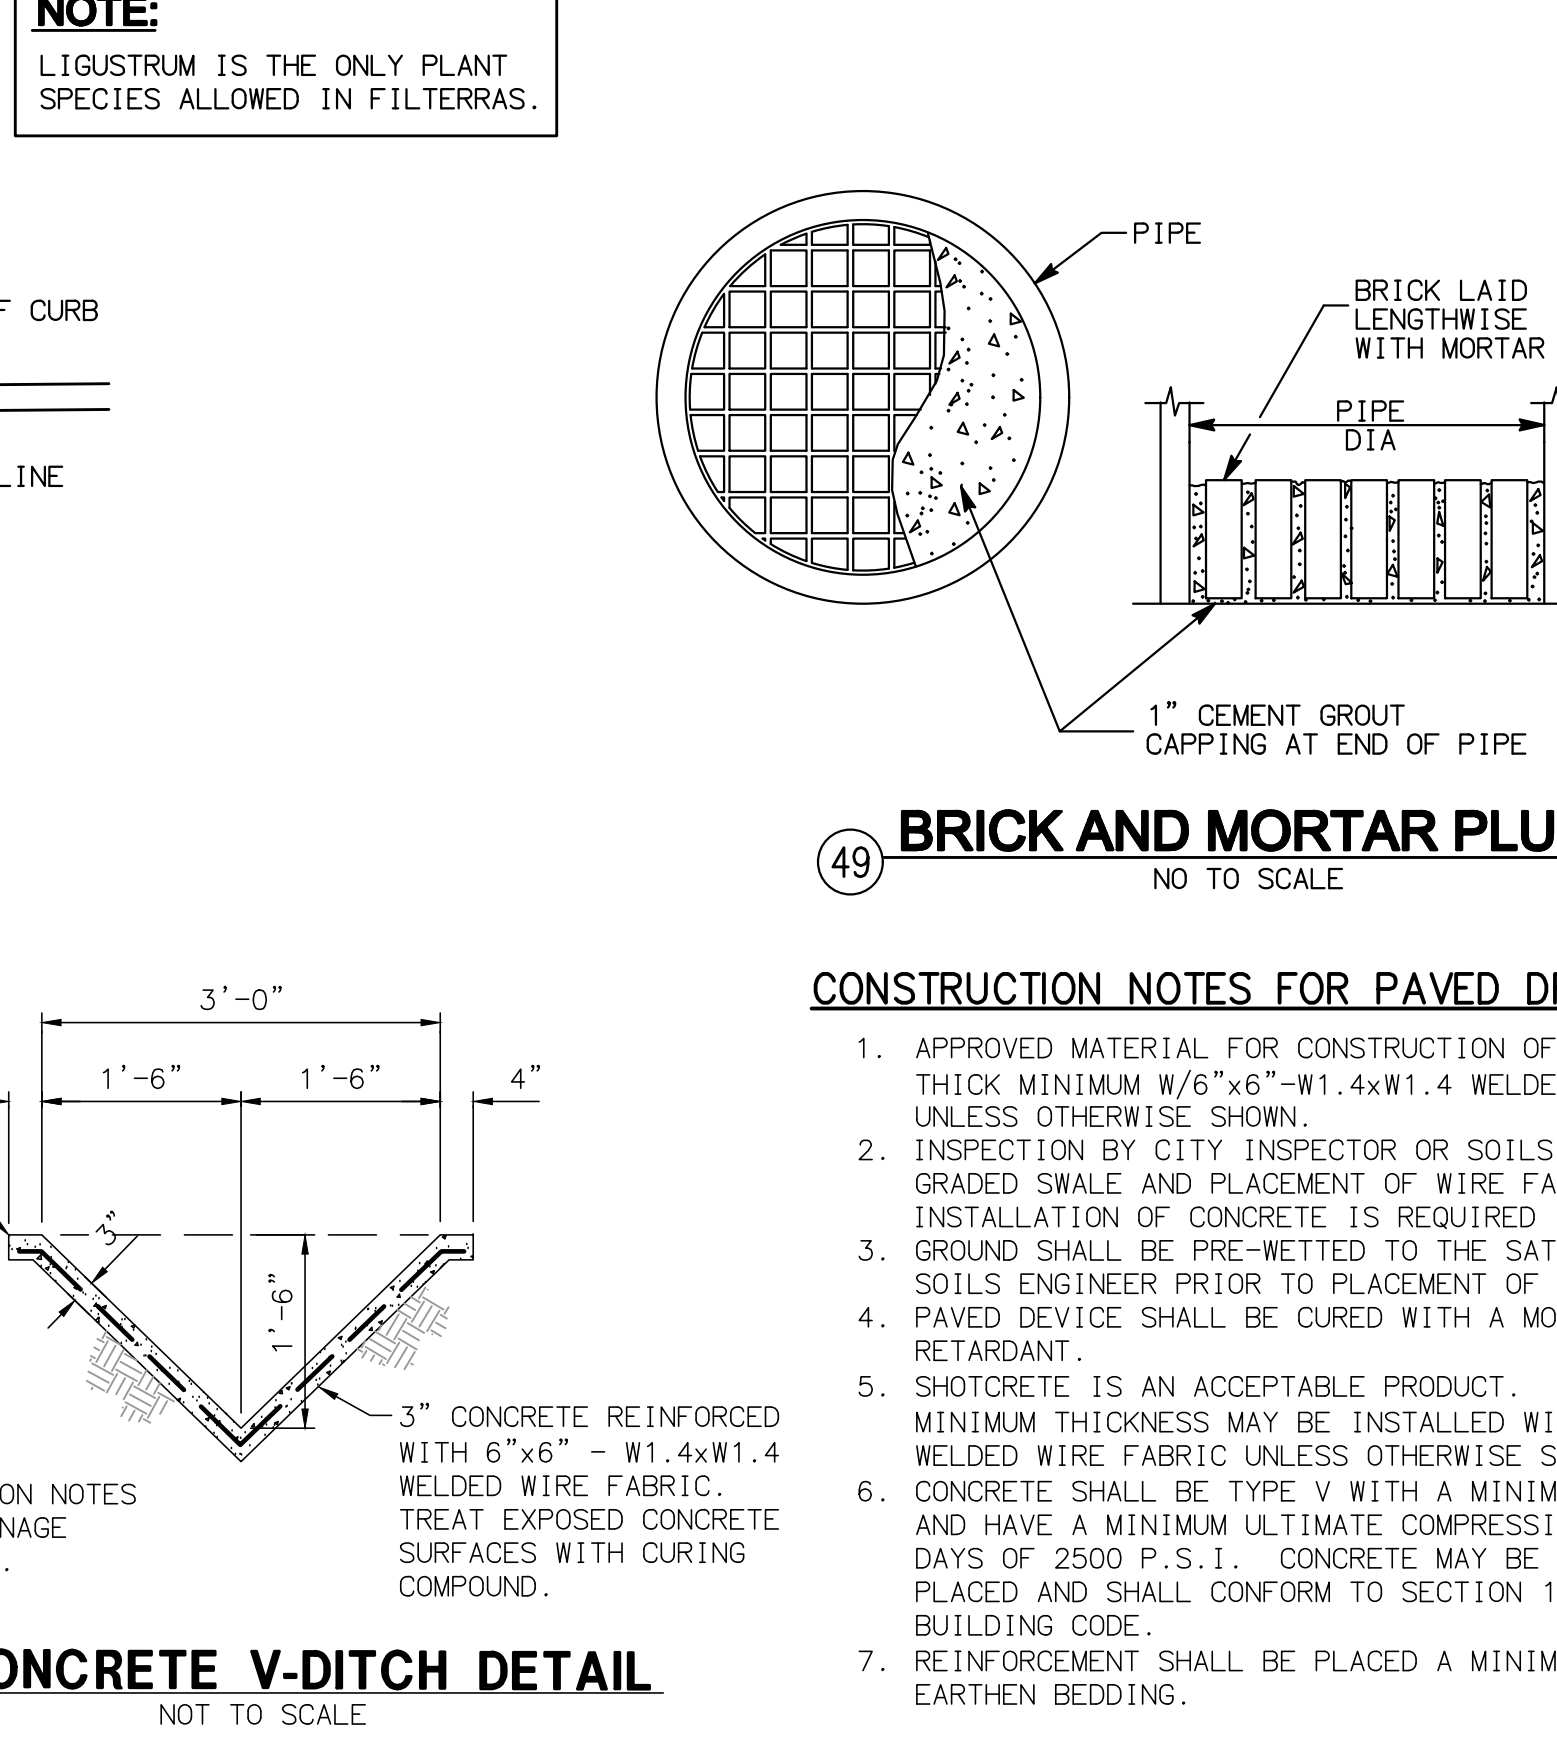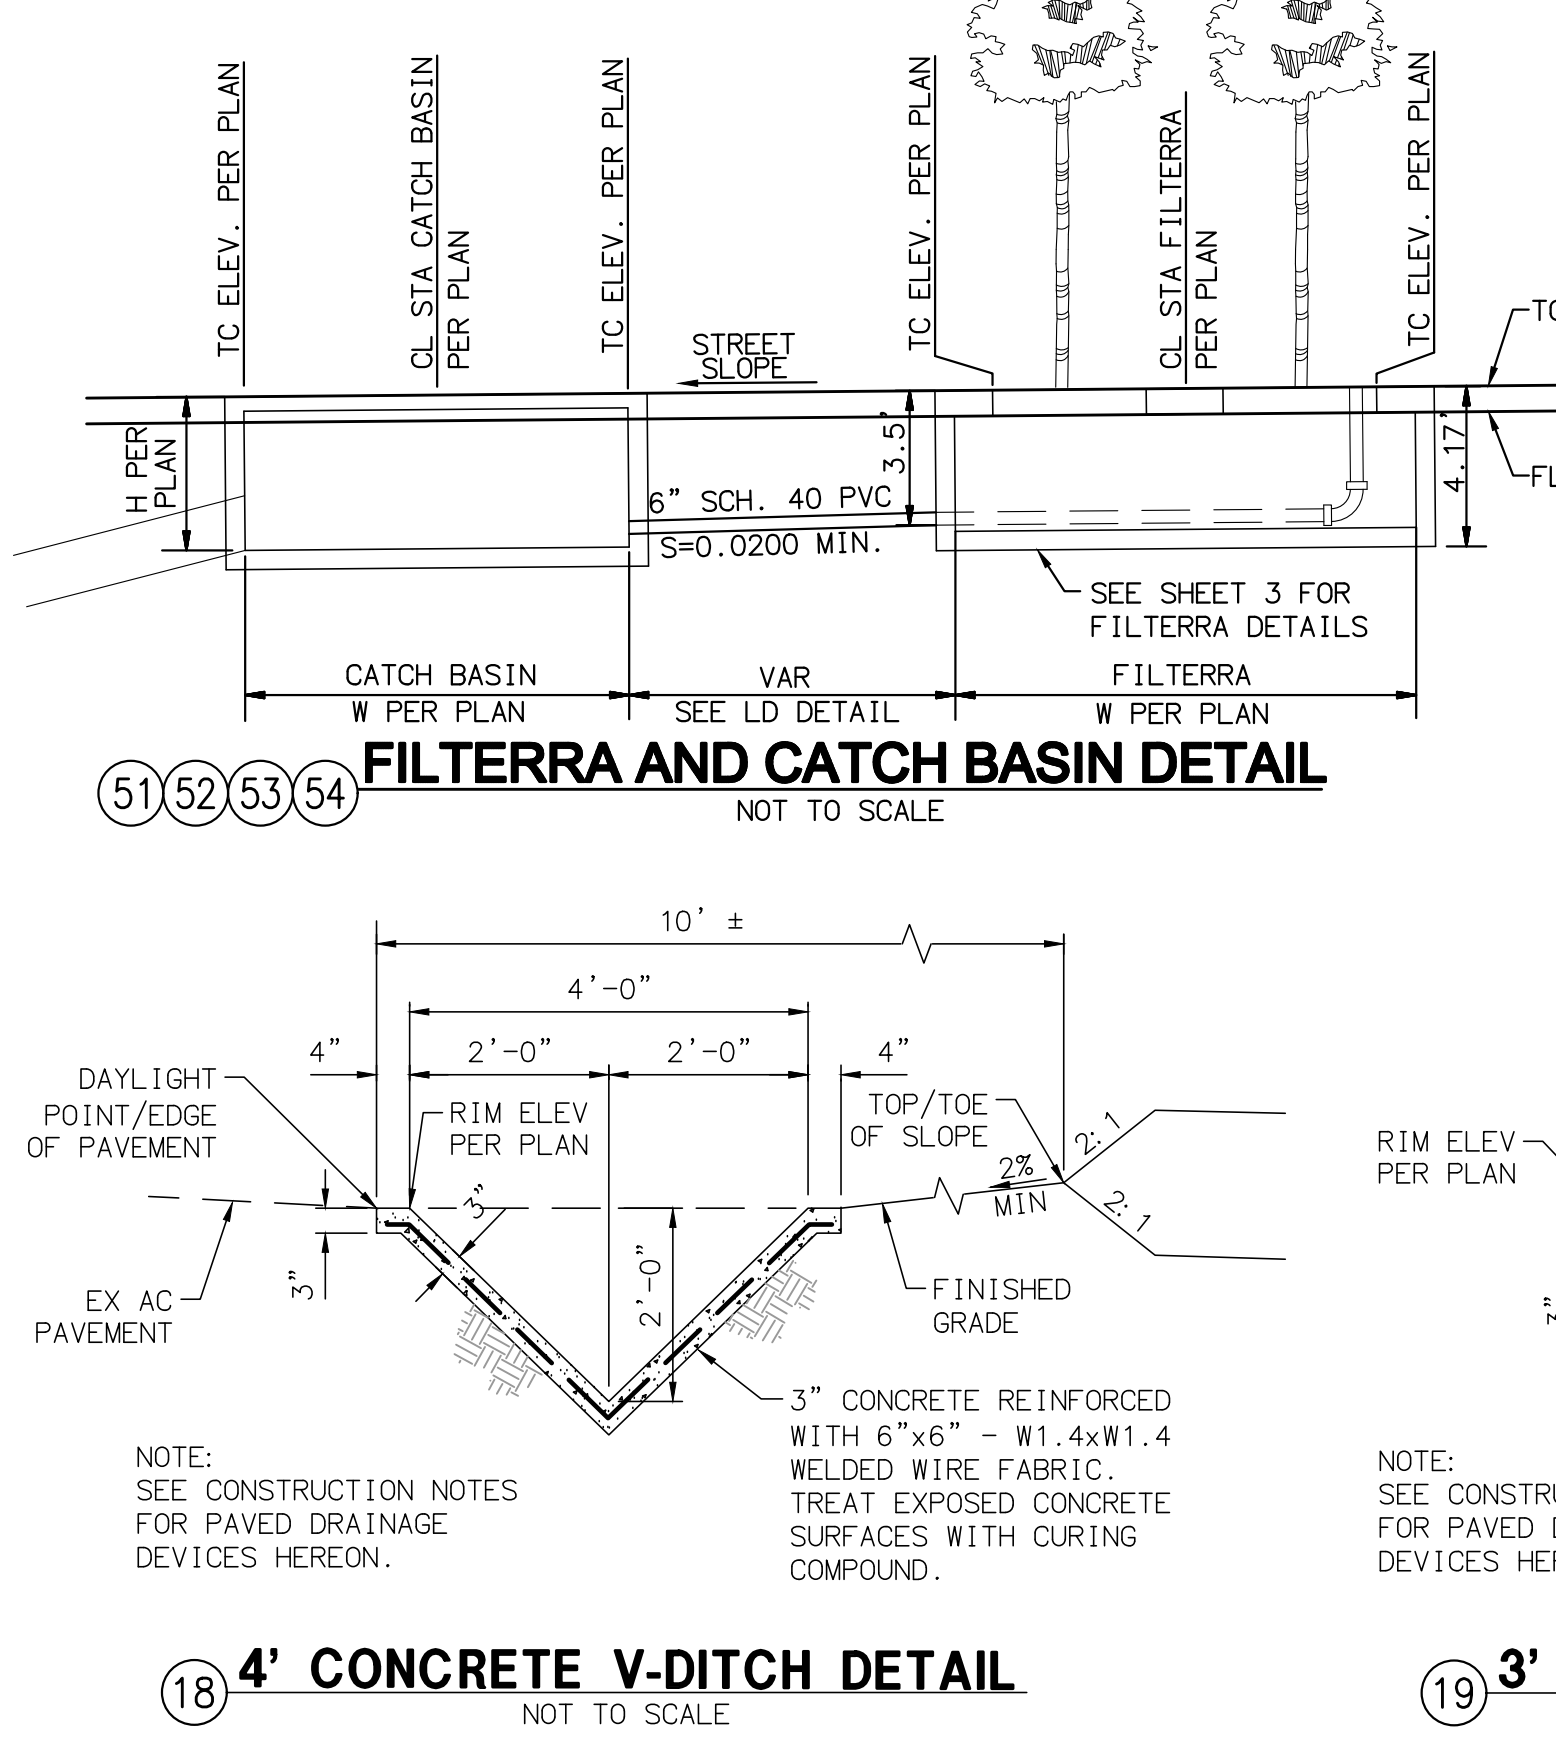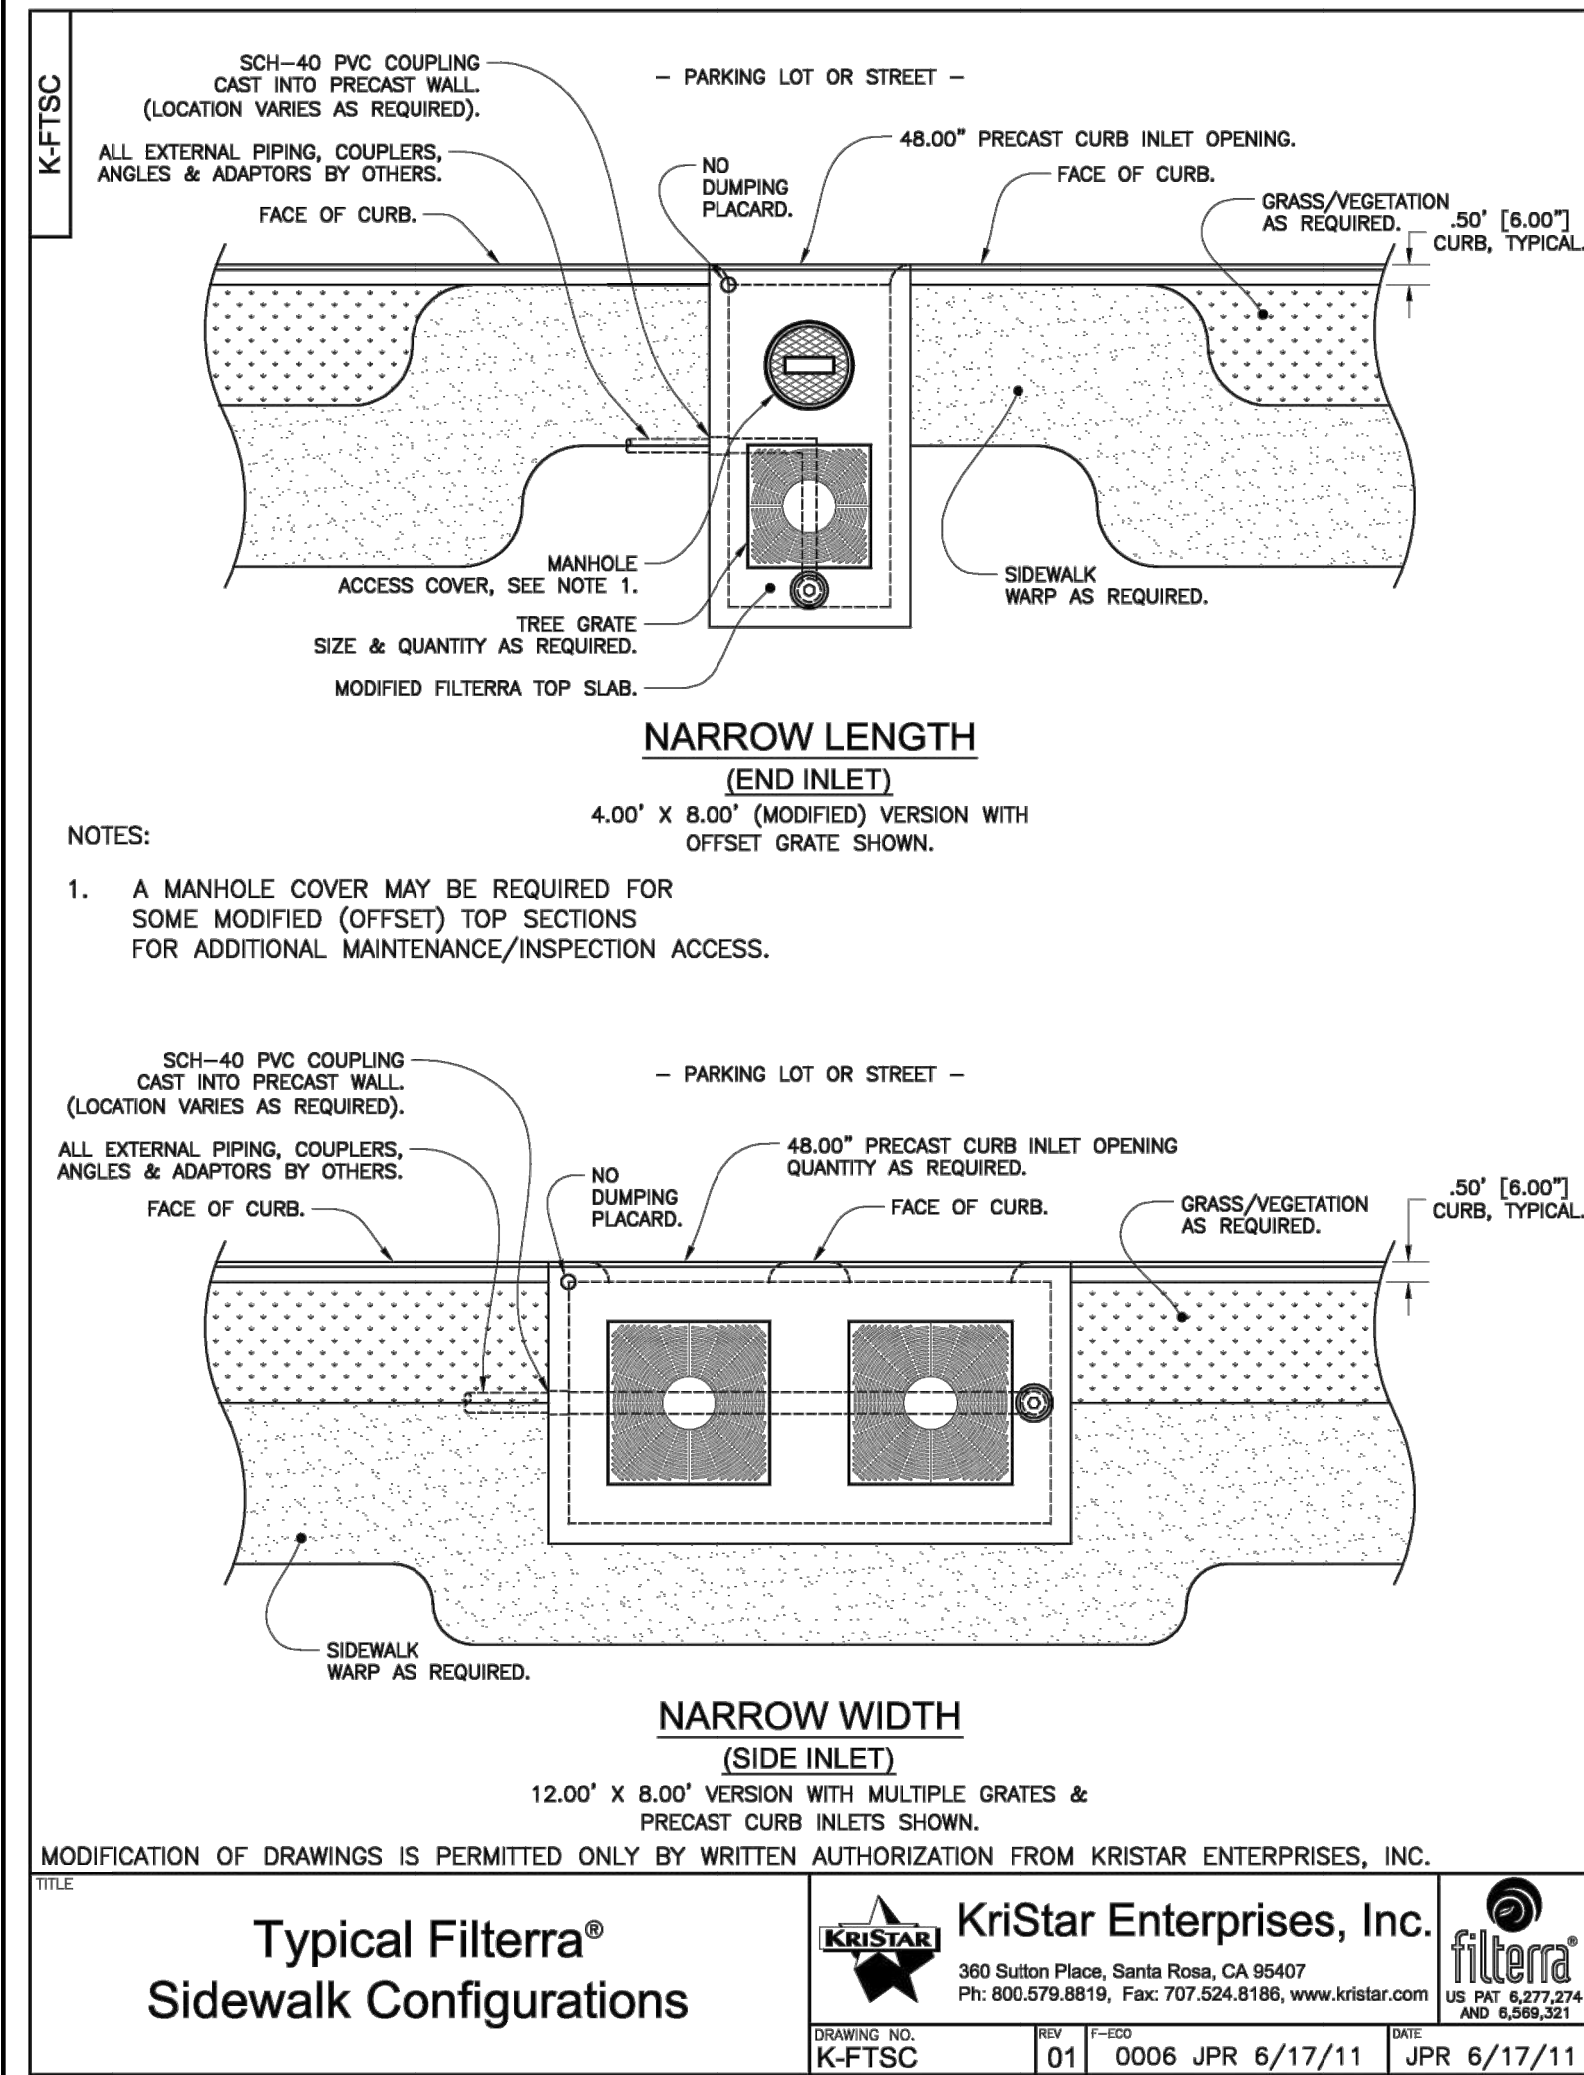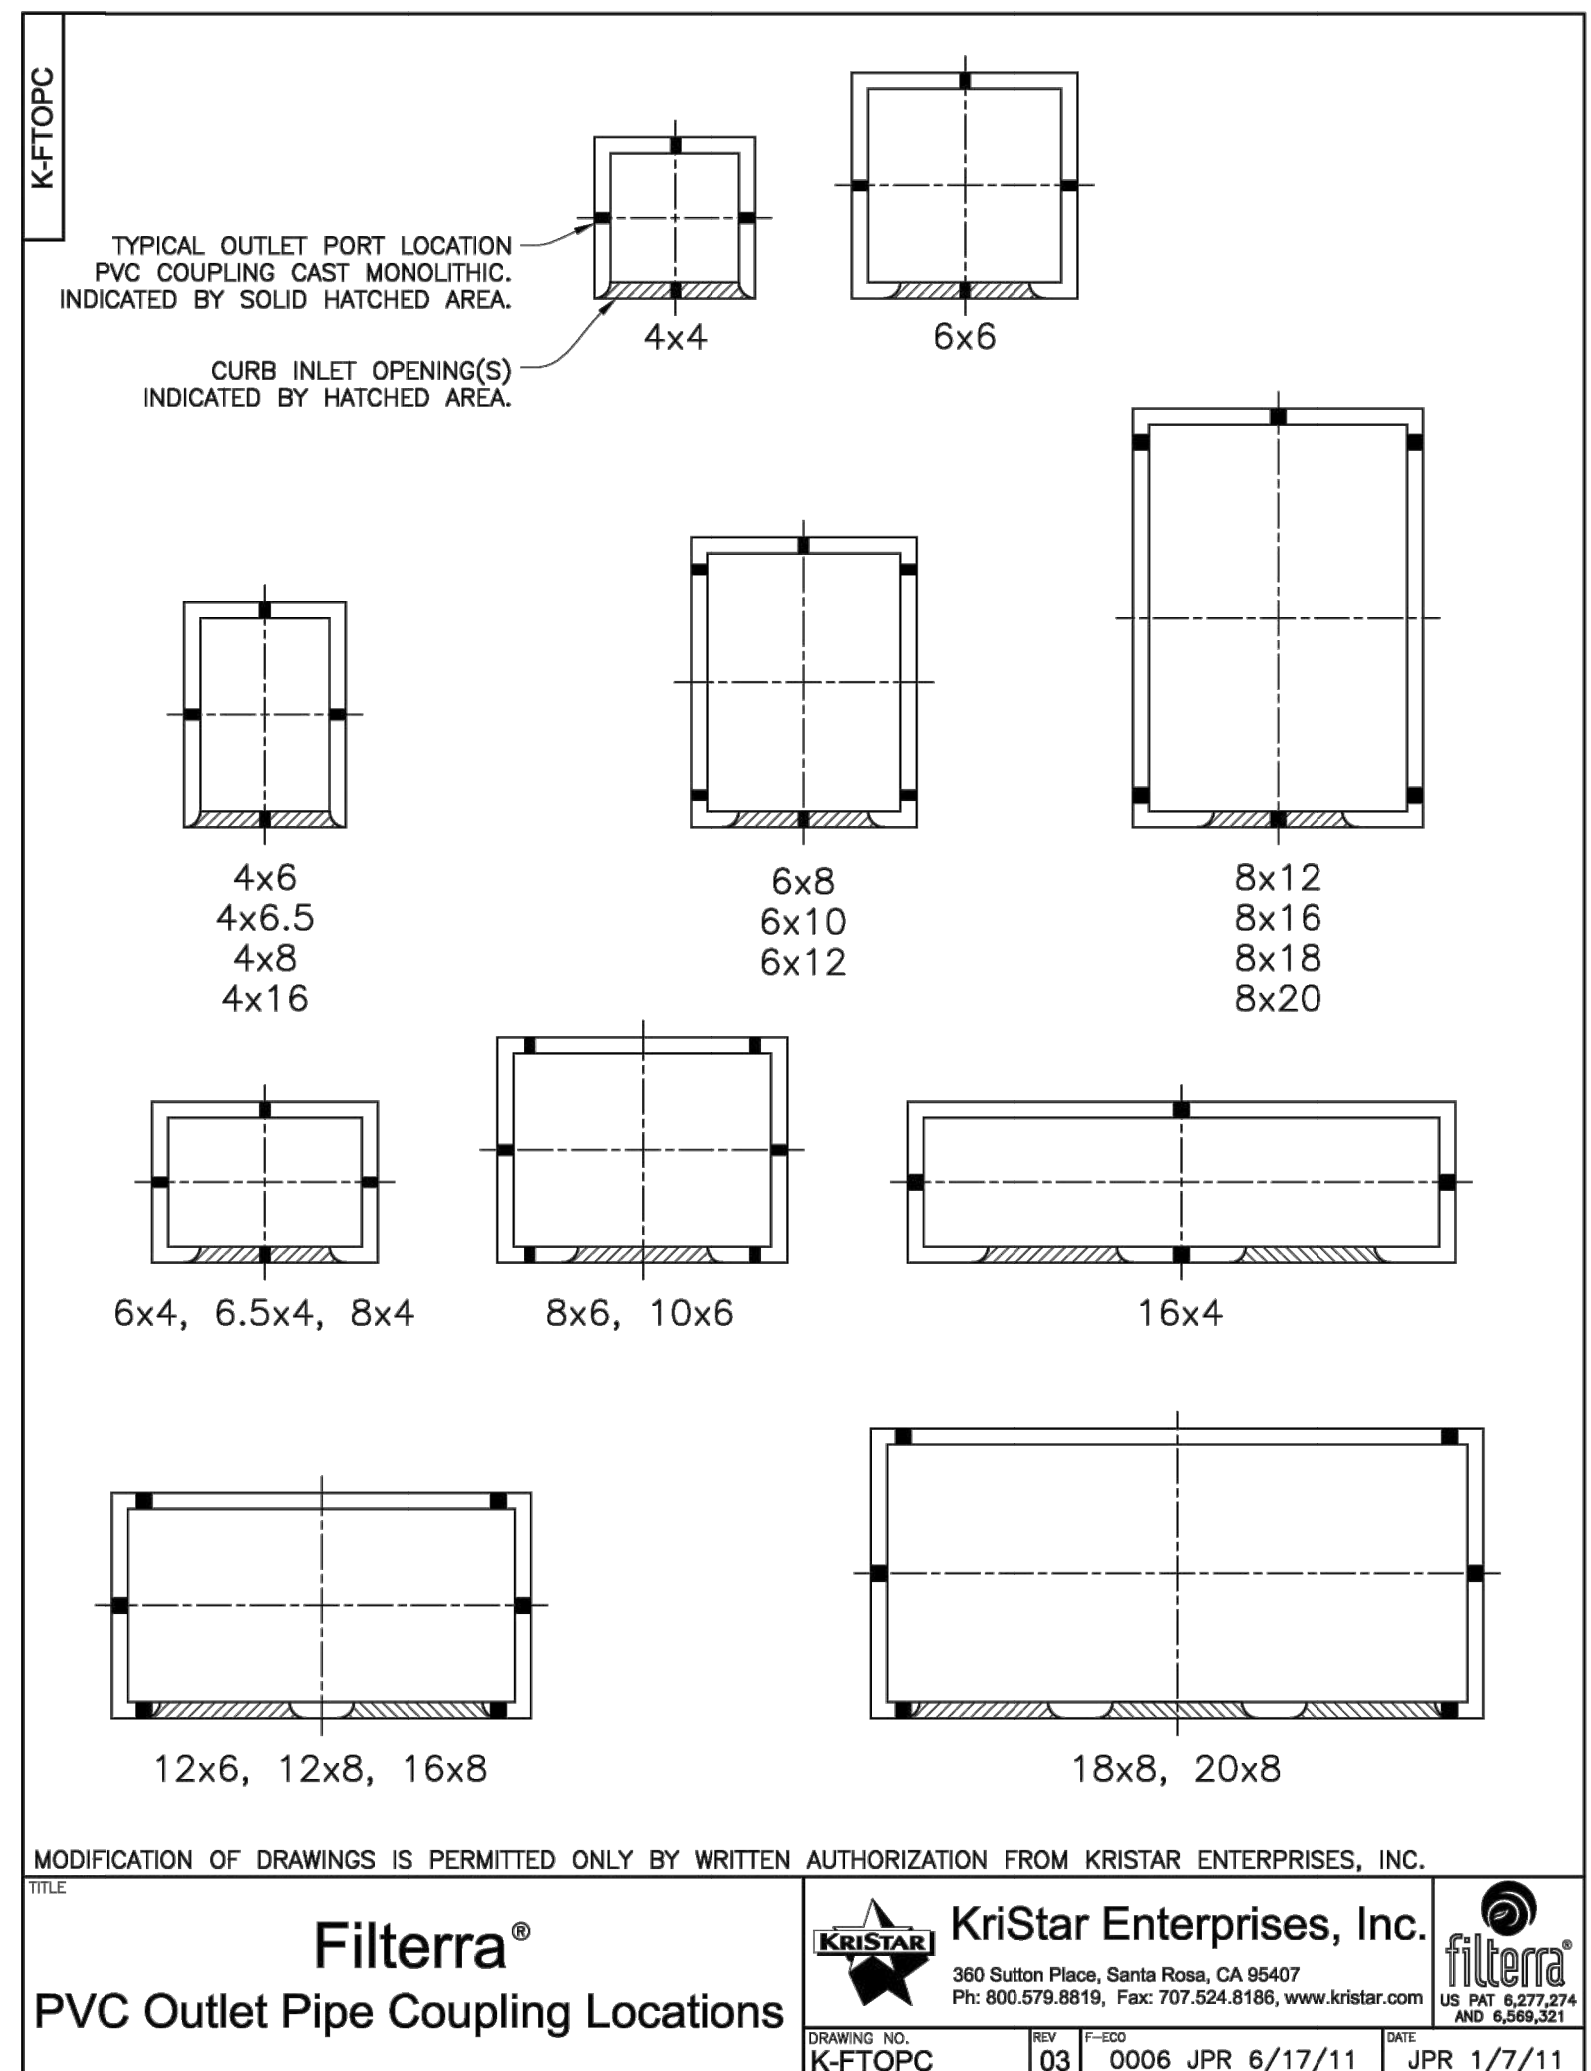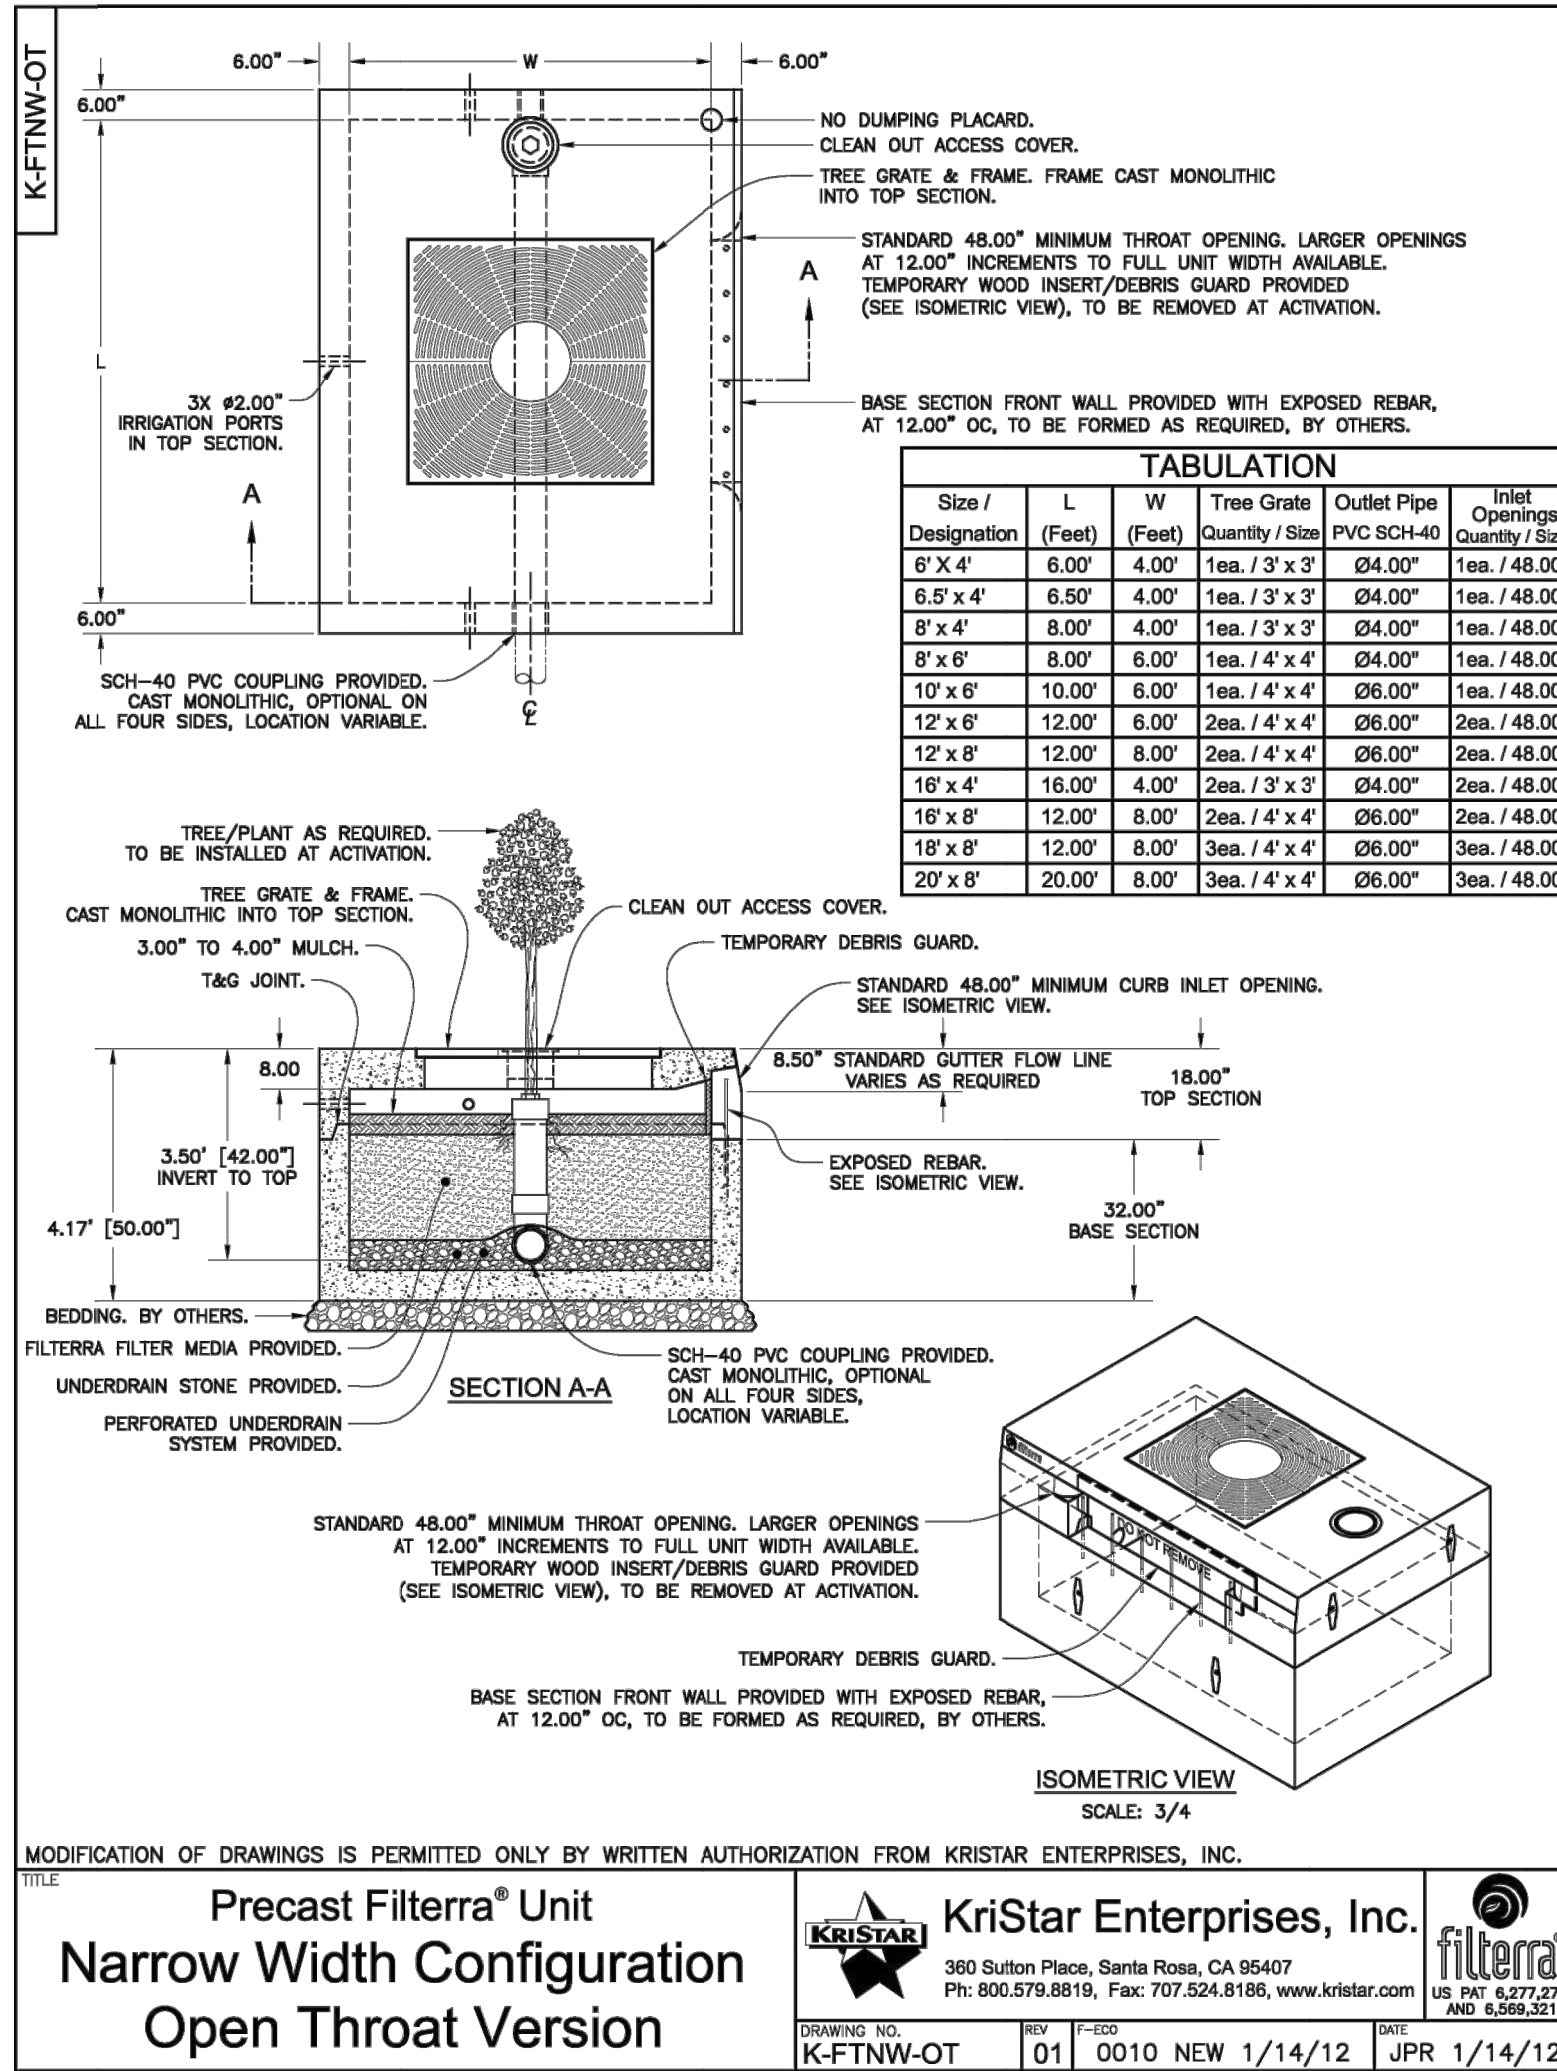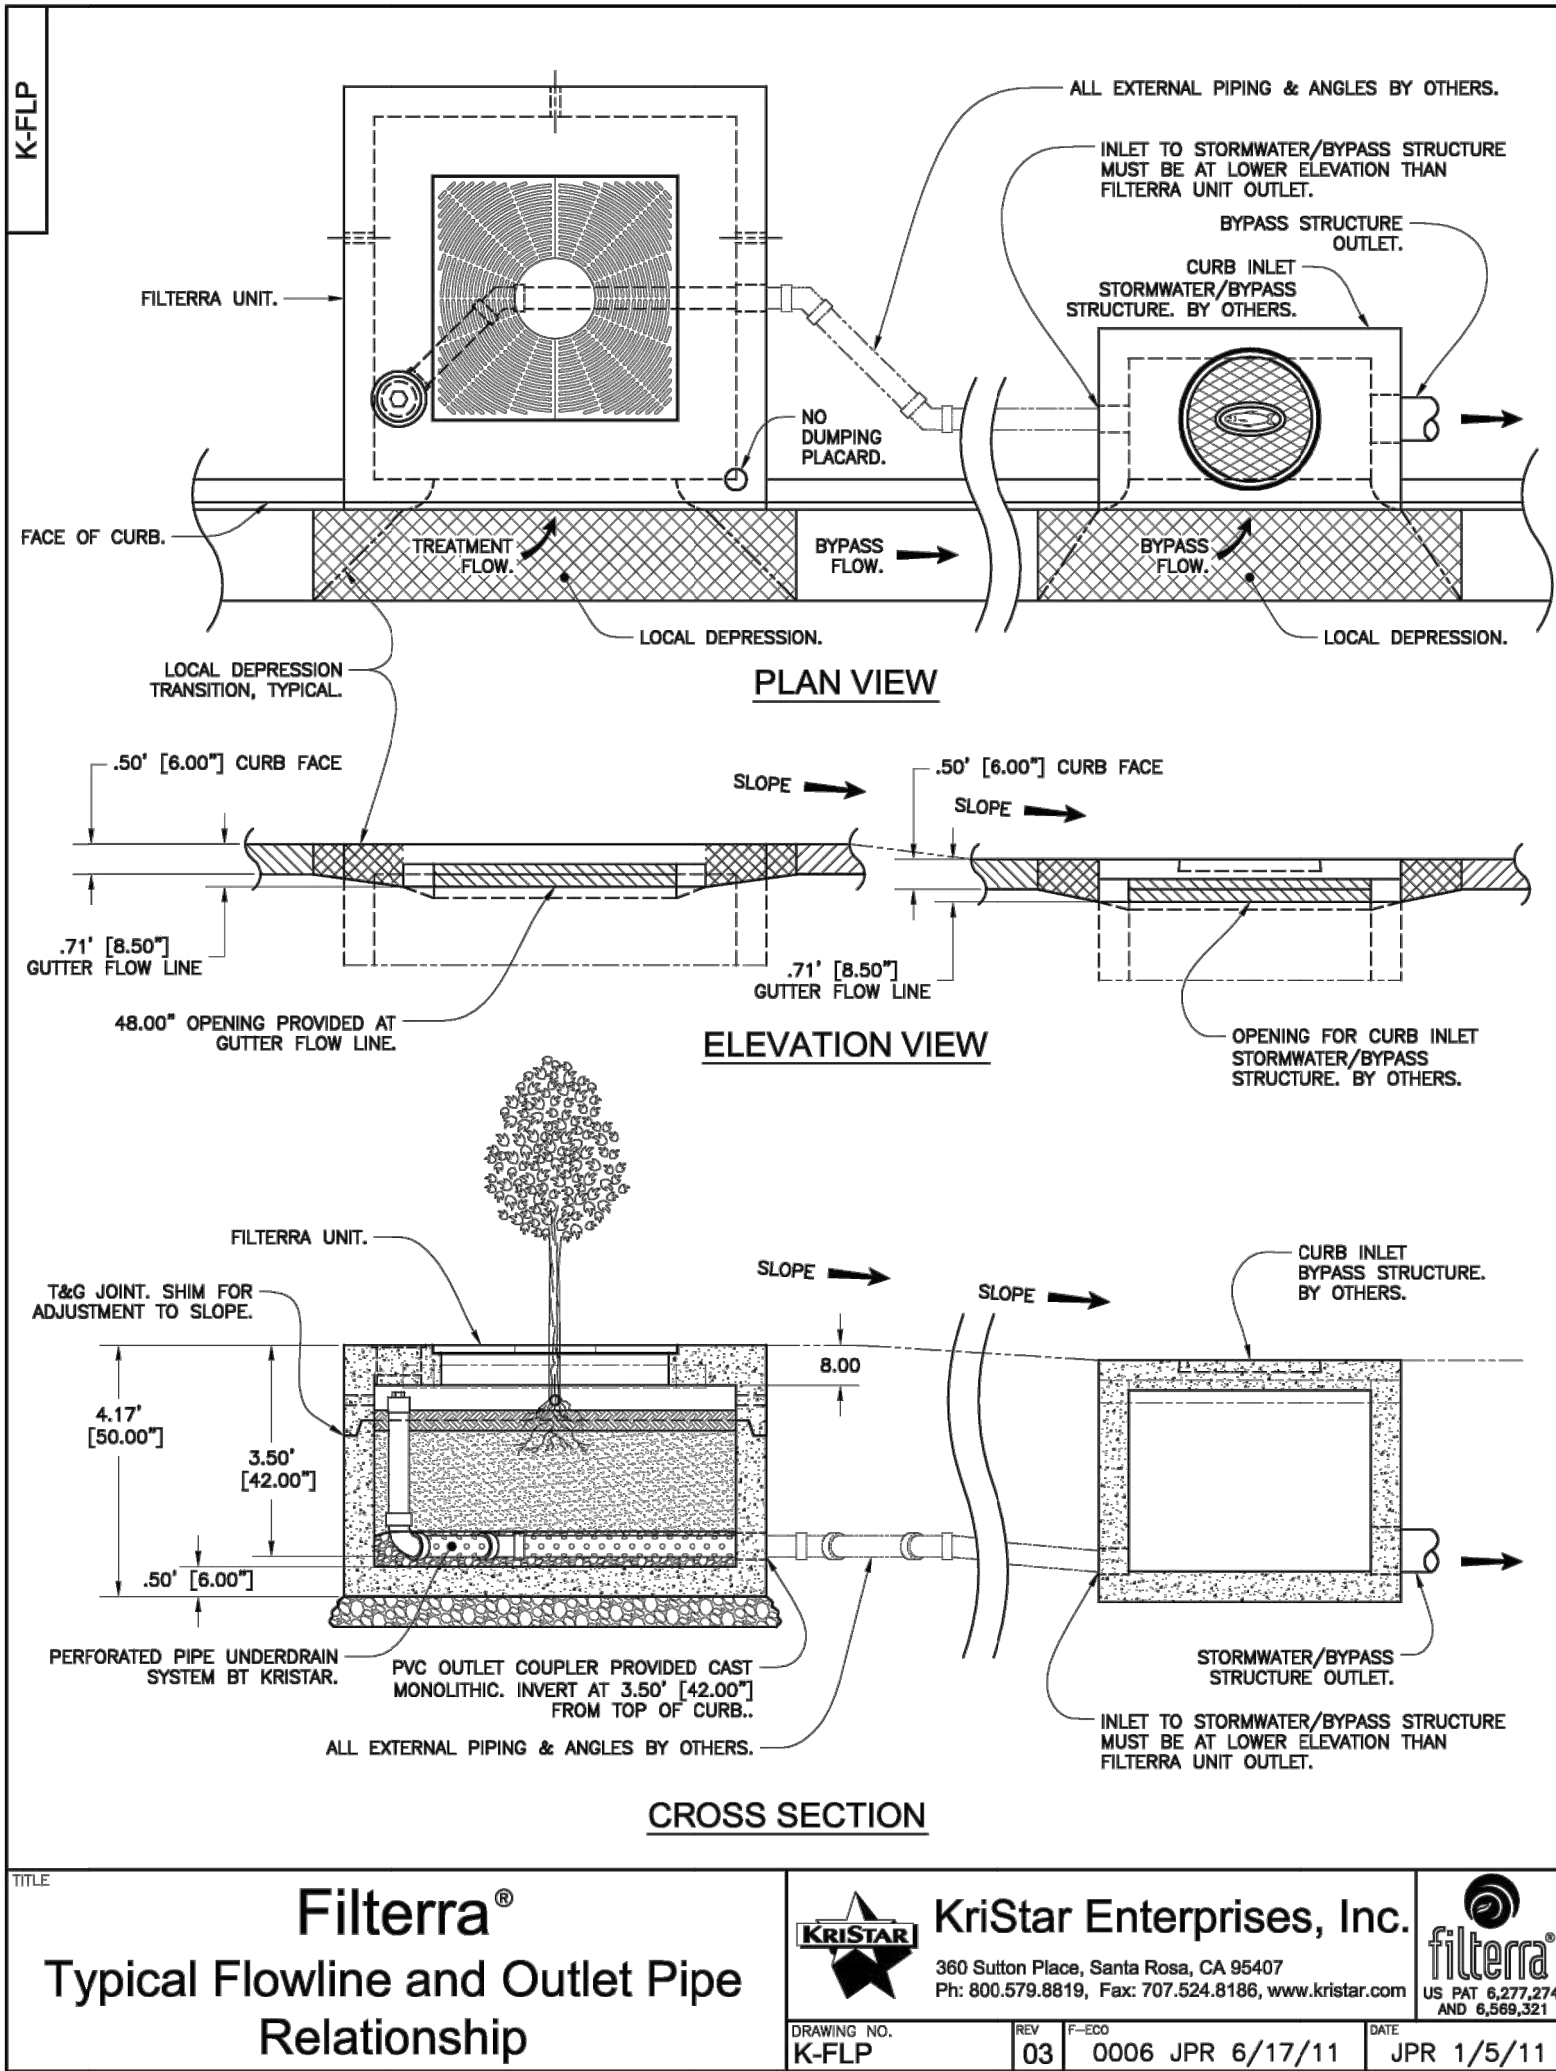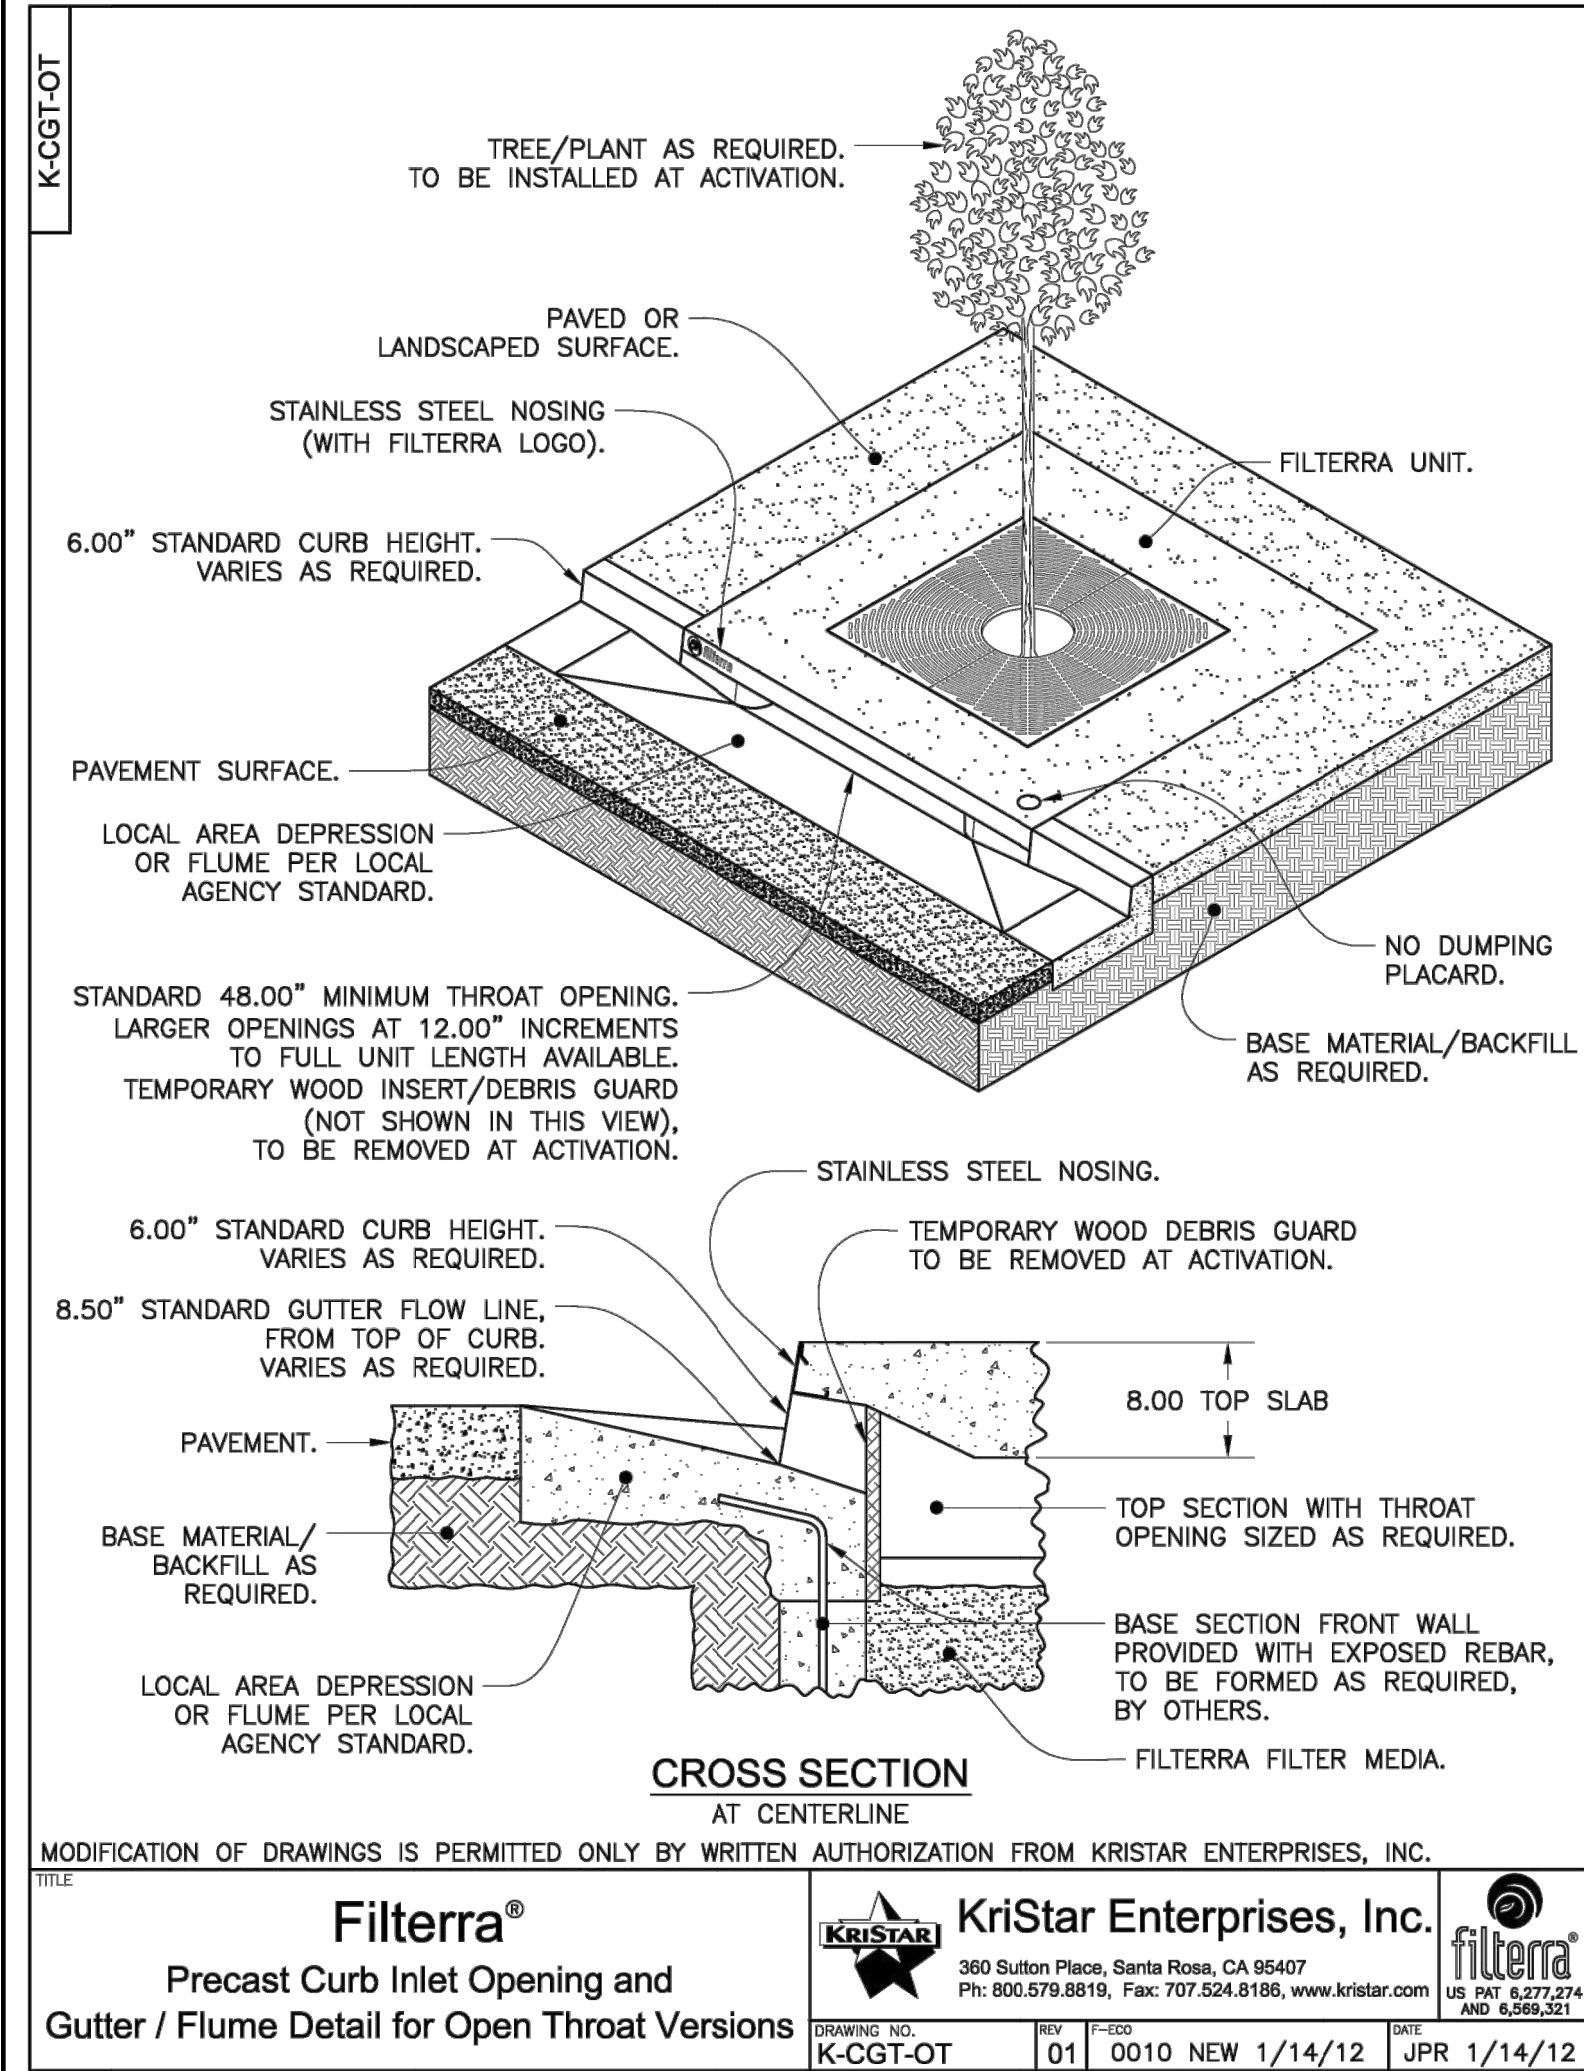

ABBREVIATIONS			
Δ	CURVE DELTA	NIC	NOT IN CONTRACT
AB	AGGREGATE BASE	OC	ORIGINAL GROUND
AC	ASPHALT CONCRETE	OC	ON CURVE
BC	BEGIN CURVE	OH	OVERHEAD
BCR	BEGIN CURB RETURN	OB	PULL BOX
BFP	BACK FLOW PREVENTER	PCC	POINT OF COMPOUND CURVE
BVC	BEGIN VERTICAL CURVE	PCC	PORTLAND CEMENT CONCRETE
BW	BACK OF WALK	PI	POINT OF INTERSECTION
C&G	CURB AND GUTTER	PL	PROPERTY/LOT LINE
CB	CATCH BASIN	POT	POINT ON CURVE
CF	CURB FACE	POT	POINT ON TANGENT
CL	CENTERLINE	PRC	POINT OF REVERSE CURVE
DWY	DRIVEWAY	PVC	POLYVINYL CHLORIDE
DW	DOMESTIC WATER	PVI	POINT OF VERTICAL INT
E	ELECTRIC	R	RADIUS
EASE	EASEMENT	RT	RIGHT
EC	END CURVE	RW	RECLAIMED WATER
ECR	END CURB RETURN	R/W	RIGHT OF WAY
EP	EDGE OF PAVEMENT	RCP	REINFORCED CONCRETE PIPE
ES	EDGE OF SHOULDER	S	SEWER
ETW	EDGE OF TRAVELED WAY	SD	STORM DRAIN
EVC	END VERTICAL CURVE	SL	STATION LINE
EX	EXISTING	SR	STATE ROUTE
FG	FINISH GRADE	SW	SIDEWALK
FH	FIRE HYDRANT	T	TELEPHONE
FL	FLOW LINE	TAN	TANGENT LENGTH
FS	FINISH SURFACE	TB	TOP OF BERM
GB	GAS BREAK	TC	TOP OF CURB
GM	GAS METER/SERVICE	TF	TEMPORARY CONSTRUCTION EASE
GV	GAS VALVE	TF	TOP OF FOOTING
GW	GUYWIRE	TG	TOP OF GRATE
HGL	HYDRAULIC GRADE LINE	TP	TURNING POINT
INV	INVERT	TM	TOP OF MASONRY
INT	INTERSECTION	TS	TRAFFIC SIGNAL/CONDUIT
JS	JUNCTION STRUCTURE	TSM	TOP OF MASONRY
LD	LENGTH	TW	TOP OF WALL
LD	LOCAL DEPRESSION	UNK	UNKNOWN
LQ	LAYOUT LINE	V	VALVE
LT	LEFT	VCP	VITRIFIED CLAY PIPE
MBGR	METAL BEAM GUARD RAIL	VLT	VAULT
MH	MANHOLE	VNT	VENT
MOC	MIDDLE OF CURVE	W	WATER
NB	NORTHBOUND	WM	WATER METER/SERVICE

Typical Filterra® Sidewalk Configurations

KriStar Enterprises, Inc.

360 Sutton Place, Santa Rosa, CA 95407
Ph: 800.579.8819, Fax: 707.524.8186, www.kristar.com

US Pat. 6,272,274 AND 6,569,321

DRAWING NO. K-FTSC 01 0006 JPR 6/17/11 JPR 6/17/11

4' CONCRETE V-DITCH DETAIL

NOT TO SCALE

3' CONCRETE V-DITCH DETAIL

NOT TO SCALE

CONSTRUCTION NOTES FOR PAVED DRAINAGE DEVICES

- APPROVED MATERIAL FOR CONSTRUCTION OF DEVICE IS 3" THICK MINIMUM W/6"x6"-W1.4xW1.4 WELDED WIRE FABRIC UNLESS OTHERWISE SHOWN.
- INSPECTION BY CITY INSPECTOR OR SOILS ENGINEER OF GRADED SWALE AND PLACEMENT OF WIRE FABRIC PRIOR TO INSTALLATION OF CONCRETE IS REQUIRED
- CONCRETE SHALL BE PRE-WETTED TO THE SATISFACTION OF THE SOILS ENGINEER PRIOR TO PLACEMENT OF CONCRETE.
- PAVED DEVICE SHALL BE CURED WITH A MOISTURE LOSS RETARDANT.
- SHOTCRETE IS AN ACCEPTABLE PRODUCT. SHOTCRETE WITH 3" MINIMUM THICKNESS MAY BE INSTALLED WITH 6"x6"-W1.4xW1.4 WELDED WIRE FABRIC UNLESS OTHERWISE SHOWN.
- CONCRETE SHALL BE TYPE V WITH A MINIMUM THICKNESS OF 3" AND HAVE A MINIMUM ULTIMATE COMPRESSION STRENGTH AT 28 DAYS OF 2500 P.S.I. CONCRETE MAY BE PNEUMATICALLY PLACED AND SHALL CONFORM TO SECTION 1924 OF THE UNIFORM BUILDING CODE.
- REINFORCEMENT SHALL BE PLACED A MINIMUM OF 1" CLEAR OF EARTHEN BEDDING.

CONSTRUCTION PLANS FOR THE IMPROVEMENT OF MARINE WAY

CONSTRUCTION DETAILS FROM SKYHAWK TO 3800' EASTERLY


CITY OF IRVINE PUBLIC WORKS DEPARTMENT

PLAN CHECK NO. 00760917-EMC

PERMIT NO. 00766614-MCE


PROJECT NO. 20.059

SHEET 3 OF 28

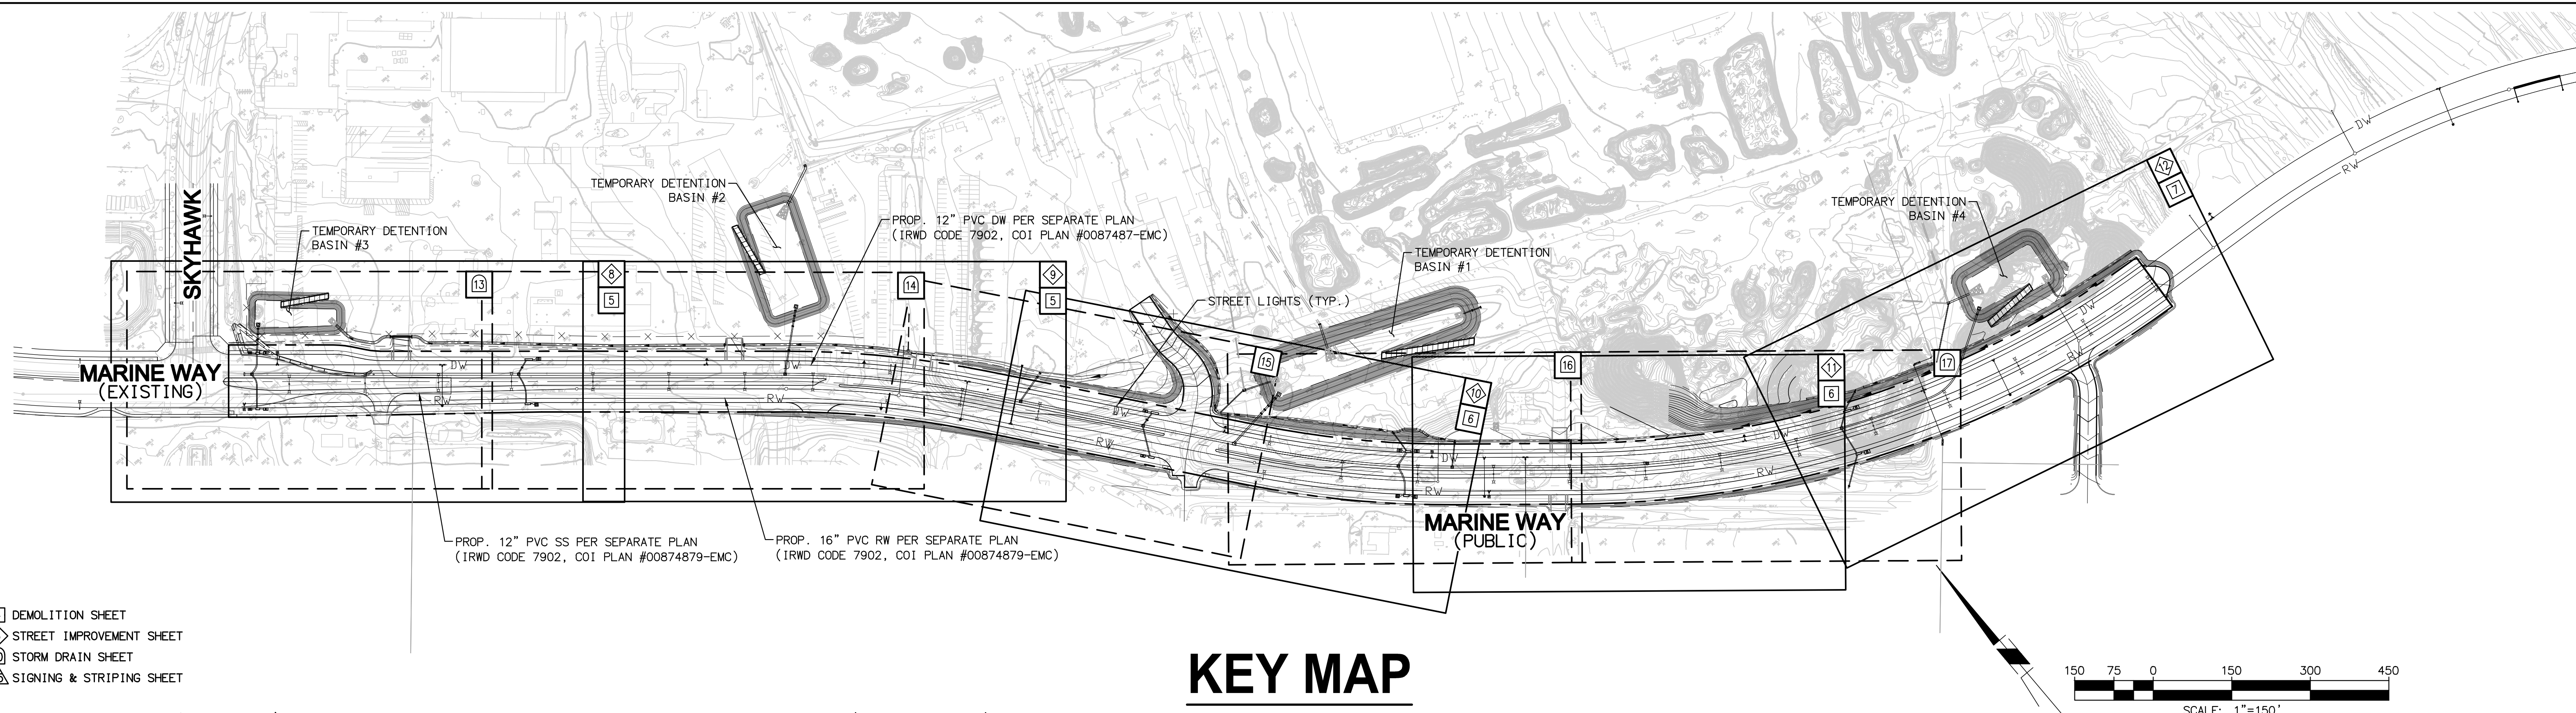

KEY MAP

4 DEMOLITION SHEET
6 STREET IMPROVEMENT SHEET
10 STORM DRAIN SHEET
15 SIGNING & STRIPING SHEET

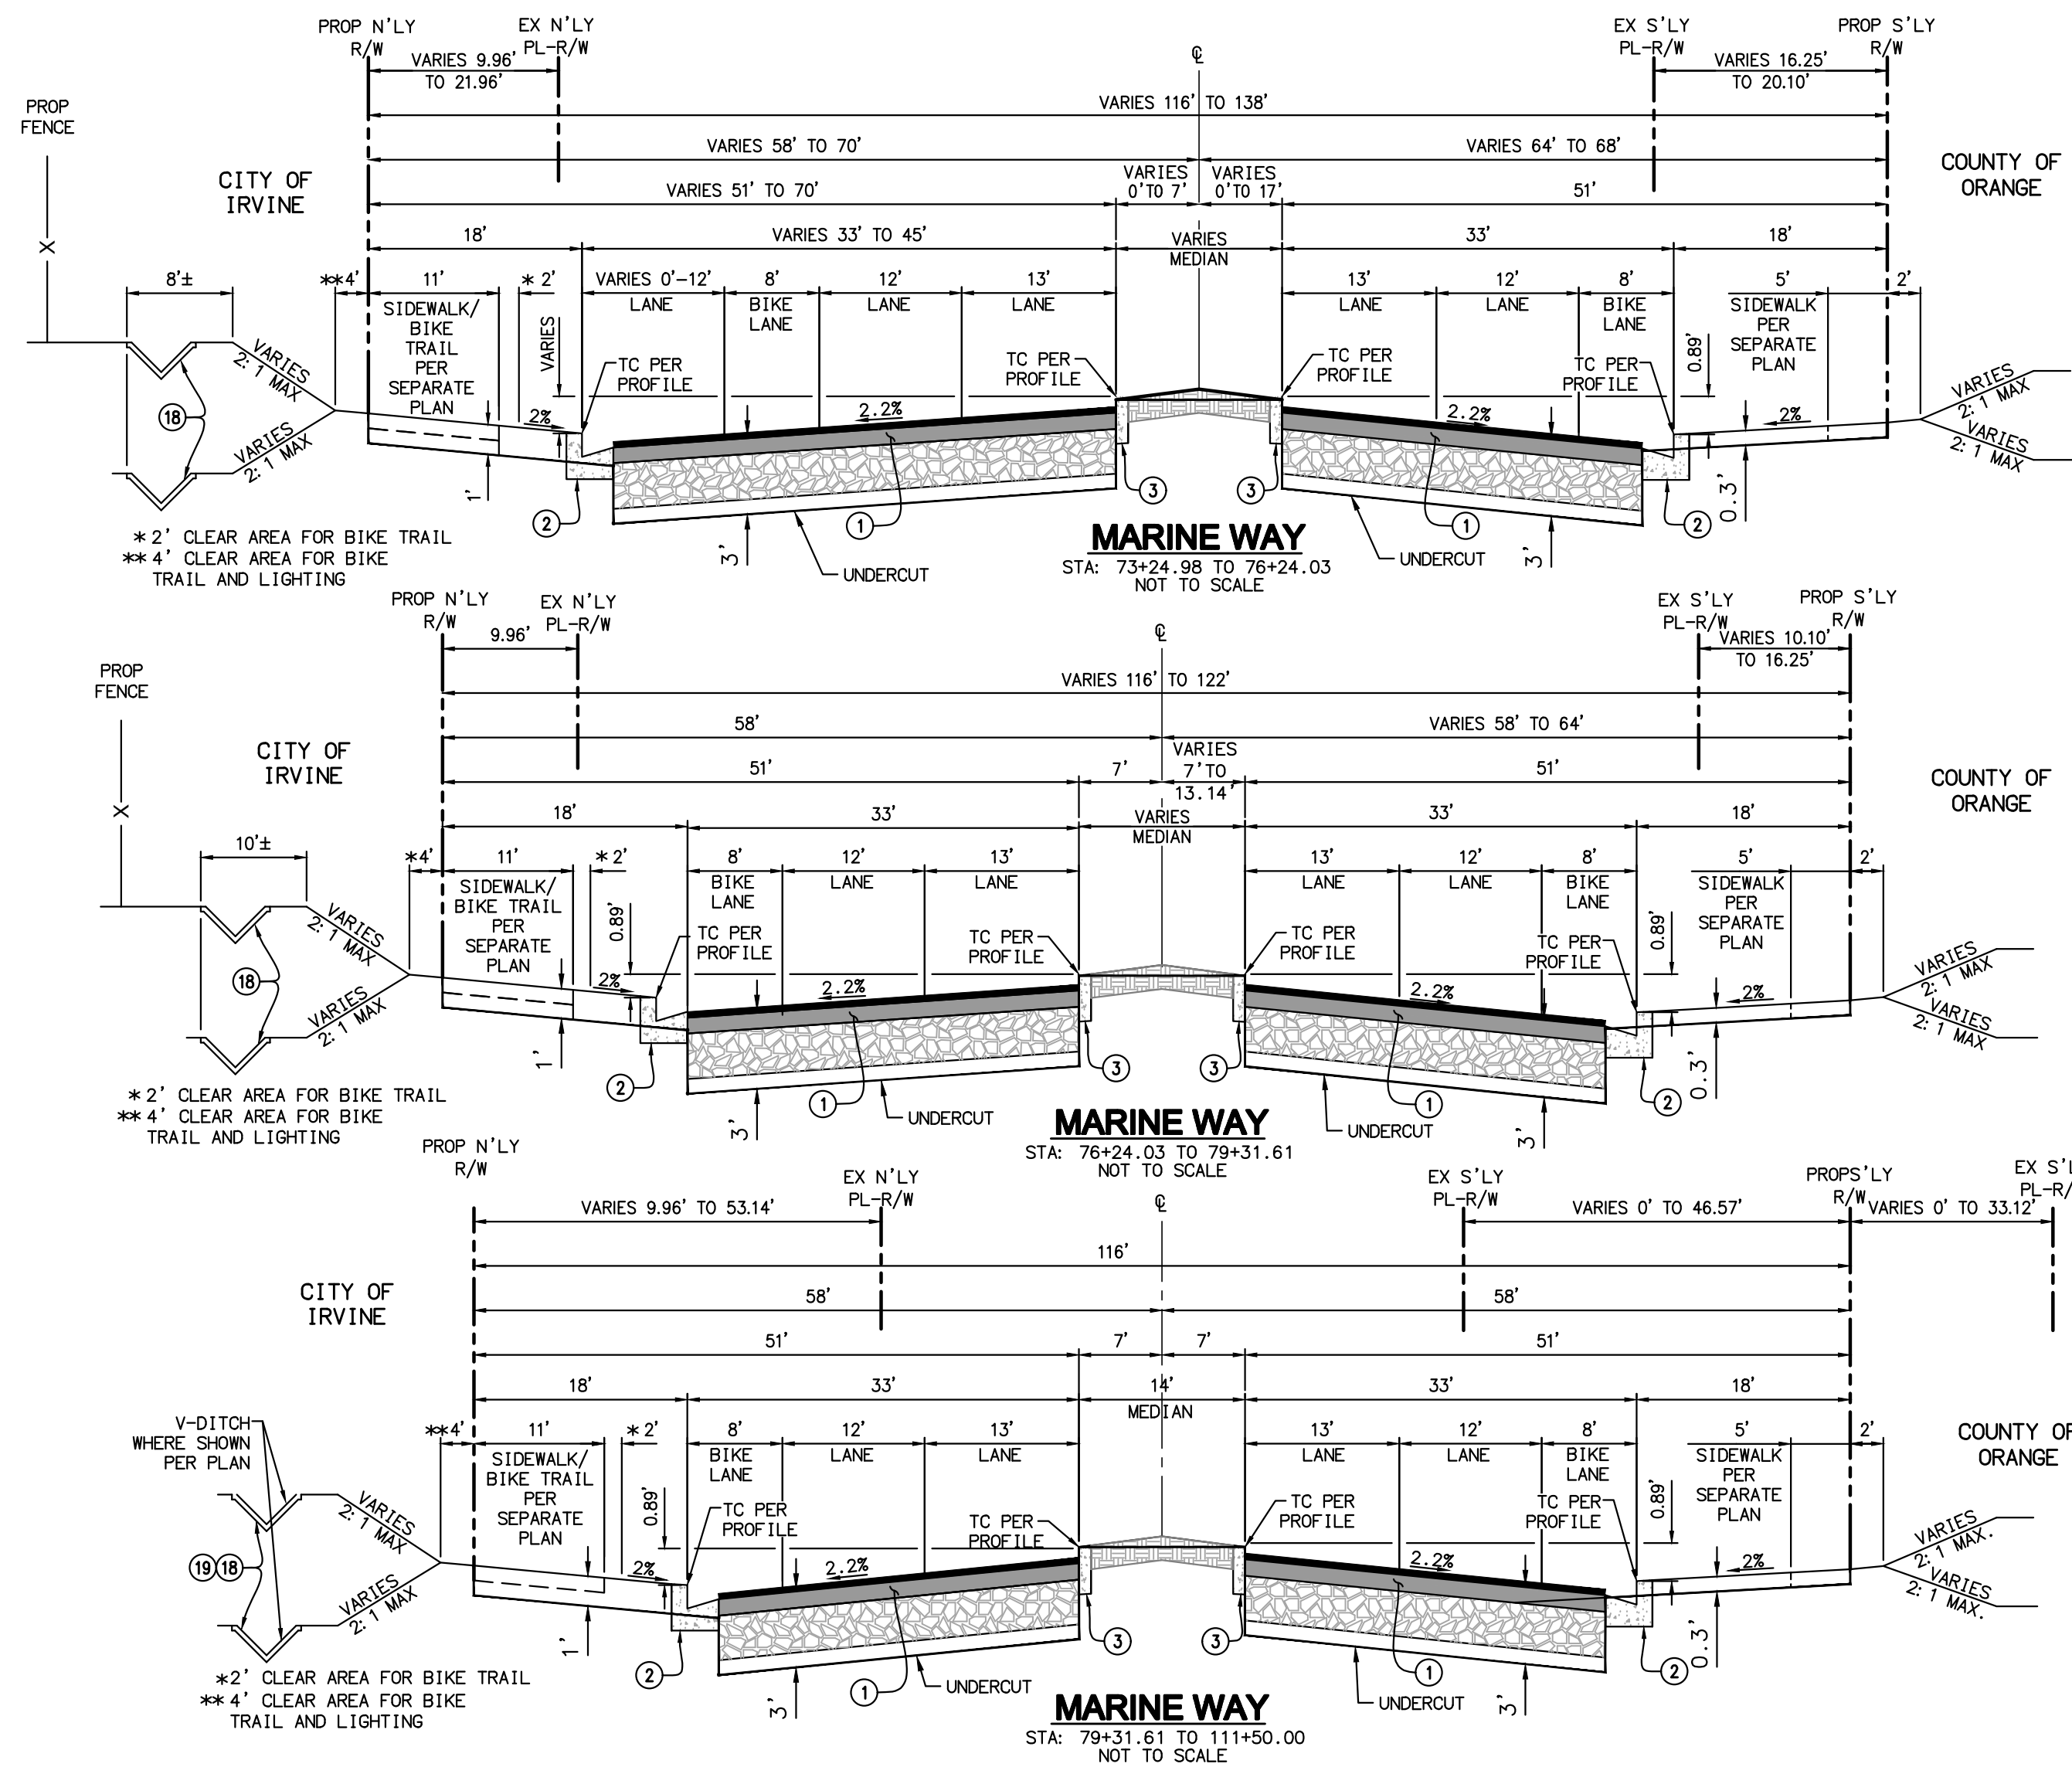

STREET CONSTRUCTION NOTES

- ① CONSTRUCT 2" ARHM OVER 4.5" AC OVER 19.5" CMB STRUCTURAL SECTION TO BE VERIFIED BY PROJECT SOILS ENGINEER DURING GRADING AND WITH APPROVAL OF THE CITY ENGINEER
- ② CONSTRUCT CONCRETE CURB AND GUTTER PER CITY OF IRVINE STD. PLAN NO. 200, TYPE A-2
- ③ CONSTRUCT CONCRETE CURB PER CITY OF IRVINE STD. PLAN NO. 200, TYPE B-8
- ④ CONSTRUCT 4" WIDE CONCRETE V-DITCH PER DETAIL ON SHEET 3
- ⑤ CONSTRUCT 3" WIDE CONCRETE V-DITCH PER DETAIL ON SHEET 3



7					
6					
5					
4					
3					
2					
1					
NO.	DATE	REVISIONS	ENGR.	APPROV.	DATE

DRAWN BY: SR
DESIGNED BY: J
CHECKED BY: J

PLAN PREPARED BY:	
-------------------	--

PROACTIVE
ENGINEERING CONSULTANTS
27042 Towne Centre Drive, Suite 110
Foothill Ranch, CA 92610 (949) 716-7460

JEFFREY C. LANGDON	R.C.E. 42429	DATE
--------------------	--------------	------

**CONSTRUCTION PLANS FOR THE IMPROVEMENT OF
MARINE WAY
KEY MAP, STREET SECTIONS AND CITY BMP NOTES
FROM SKYHAWK TO 3800' EASTERLY**

CITY OF IRVINE
PUBLIC WORKS DEPARTMENT

PLAN CHECK NO.	00760917-EMC
PERMIT NO.	00766614-MCE

PROJECT NO.
20.059

SHEET
4

OF **28**


\\pdata\10108417\CADD\IN8 Specialists\Div\Improve MarineWayS2\0059-004-ST.dwg 7/11/2022 4:08:35 PM

DEPARTMENT OF NAVY (DON) FACILITY NOTES

1. GRADING AND STORM DRAIN INSTALLATION ACTIVITIES WILL BE TAKING PLACE WITHIN A PORTION OF THE "INSTALLATION RESTORATION PROGRAM (IRP SITE 24) EASEMENTS , WHICH INCLUDE DEPARTMENT OF THE NAVY (DON) FACILITIES INCLUDING ELEVEN (11) NESTED MONITORING WELLS 24MW05A-B, 24MW08, 09DGMW75, AND 18PS06, TWELVE (12) EXTRACTION WELLS 24SGU-18, 24SGU-19, 24SGU-20, 24 SGU-21, 24SGU-22, 24SGU-23, 24SGU-24, 24SGU-25, 24SGU-26,24EX-13A, 24EX-13B, AND 24EX-13C WITH FORTY EIGHT (48) ASSOCIATED HAND BOXES (FOUR 4 ER EACH EXTRACTION WELL), ONE (1) CHECK VALVE VAULT, A LARGE VAULT, TWO (2) SMALL PULL BOXES, A BLIND FLANGE VAULT, AND A CONVEYANCE SYSTEM TRENCH CONTAINING PIPING, 480-VOLT CONDUIT, COOMUNICATION CONDUIT, AND A COPPER GROUND. THE ABOVE NAVY FACILITIES ARE DEPICTED ON EACH SHEET OF THIS PLAN SET HAVING CONSTRUCTION ACTIVITIES.
2. THE CONTRACTOR SHALL PROVIDE DON PERSONNEL AND ITS CONTRACTORS FULL ACCESS TO THE CONSTRUCTION SITE AT ALL TIMES.
3. THE CONTRACTOR SHALL NOT PERFORM WORK AT ANY AND ALL DON FACILITIES LOCATED BOTH WITHIN AND OUTSIDE THE IRP 24 EASEMENT (MONITORING WELLS, EXTRACTION WELLS, HAND BOXES, VAULTS, THE CONVEYANCE TRENCH, ETC.) WITHOUT THE CITY'S CONSTRUCTION MANAGER (JOE KIRKPATRICK, (949) 724-6320) AND INSPECTOR (TIM ANDERSON, (949) 724-6329 PRESENT AND ON-SITE AT ALL TIMES.
4. PRIOR TO COMMENCING CONSTRUCTION, THE CONTRACTOR SHALL CLEARLY ENSURE THAT THE EASEMENT AND LINES ARE VISIBLE TO ALL CONSTRUCTION PERSONNEL. THE IRP 24 EASEMENT IS FOURTEEN FEET (14 ') WIDE OVER THE CONVEYANCE SYSTEM TRENCH (SEVEN FEET (7') FROM BOTH SIDES OF THE CENTERLINE OF THE TRENCH) AND A TWENTYFIVE FOOT (25') RADIUS ORIGINATING FROM THE CENTER POINT OF EACH OF THE EXTRACTION WELL VAULTS. THE CONTRACTOR SHALL PROHIBIT CROSSING OF THE CONVEYANCE SYSTEM TRENCHES AT ALL LOCATIONS BEYOND THE CROSSINGS APPROVED BY DON. THE CROSSINGS SHALL BE PROTECTED BY STEEL PLATES TO PROTECT THE CONVEYANCE SYSTEM FROM DAMAGE BY VEHICLES AND EQUIPMENT. ALL CROSSING LOCATIONS SHALL BE CLEARLY MARKED BY APPROPRIATE SIGNAGE. ALL MARKINGS AND SIGNAGE ARE SUBJECT TO REVIEW OR PERIODIC INSPECTION AND APPROVAL BY THE DON.
5. THE CONTRACTOR SHALL PHYSICALLY MARK AND PROTECT ALL EXISTING MONITORING AND EXTRACTION WELLS, HAND BOXES, AND VAULTS AT A MINIMUM 10-FOOT RADIUS INPLACEBY K-RAIL WITH FLAGGING, AND/ OR FENCING. THESE DON FACILITIES SHALL ALSO BE PROTECTED FROM THE INTRUSION OF SILT, SOIL, AND OR DEBRIS. SEE MONITORING WELL / EXTRACTION WELL PROTECTION DETAILS A-F DRAWING NO C2-103A
6. THE CONTRACTOR SHALL PERFORM ALL EXCAVATION/ COMPACTION WORK OVER THE TOP OF THE CONVEYANCE TRENCH, PLUS ONE FOOT (1 '-0") ON EITHER SIDE OF THE TRENCH (EQUATING TO APPROXIMATELY 5.5 FEET IN WIDTH) BY HAND AND TO NO MORE THAN 90% RELATIVE COMPACTION. IN ADDITION, THE CONTRACTOR SHALL PERFORM ALL WORK WITHIN FOUR FEET (4'-0") OF ANY DON FACILITY (MONITORING WELLS, EXTRACTION WELLS, HAND BOXES, VAULTS, THE CONVEYANCE TRENCH, ETC.) LOCATED BOTH WITHIN AND OUTSIDE THE IRP SITE 24 EASEMENT BY HAND. AT UTILITY CROSSINGS, THE CONTRACTOR SHALL PERFORM WORK OVER THE TOP AND SURROUNDING CONDUIT BY HAND, AND AT MINIMUM DISTANCE OF TWO FEET (2'-0") FROM THE CONDUIT. THE CONTRACTOR MUST CONDUCT A PREINSTALLATION CONFERENCE. IN ACCORDANCE WITH DIVISION 01 SPECIFICATION SECTION 01310, A MINIMUM OF 20 WORKING DAYS PRIOR TO ANY SCHEDULED UNDERGROUND WORK CROSSING THE DON TRENCH. CONTRACTOR SHALL PROVIDE COORDINATION DRAWINGS FOR DON REVIEW/APPROVAL AT THE PRE-INSTALLATION CONFERENCE.
7. THE CONTRACTOR SHALL MAINTAIN A MINIMUM OF 18 INCHES (18") OF COVER OVER THE TOP OF THE EXISTING 480V AND COMMUNICATIONS LINES. IF THE DRAWINGS INDICATE OR INFER LESS THAN THE MINIMUM 18" OF COVER, THE CONTRACTOR SHALL IMMEDIATELY INFORM THE CONSTRUCTION MANAGER.
8. FOR NEW WATERLINE OVERCROSSINGS OF THE EXISTING 480V LINE, THE CONTRACTOR SHALL MAINTAIN A MINIMUM 12 INCH (12") SEPARATION. IF THE DRAWINGS INDICATE OR INFER LESS THAN THE MINIMUM 12" SEPARATION, THE CONTRACTOR SHALL IMMEDIATELY INFORM THE CONSTRUCTION MANAGER.
9. FOR ALL NEW UTILITY UNDER-CROSSINGS, THE CONTRACTOR SHALL MAINTAIN A MINIMUM OF 12 INCHES (12") BELOW THE BOTTOM OF THE EXISTING EXTRACTION SYSTEM TRENCH. THE CONTRACTOR MUST CONDUCT A PRE-INSTALLATION CONFERENCE, IN ACCORDANCE WITH PROJECT SPECIFICATION A MINIMUM OF 20 WORKING DAYS PRIOR TO ANY SCHEDULED UNDERGROUND WORK CROSSING THE DON TRENCH. CONTRACTOR TO PROVIDE COORDINATION DRAWINGS FOR DON REVIEW/APPROVAL AT THE PRE-INSTALLATION CONFERENCE.
10. FOR NEW ELECTRICAL OR COMMUNICATION LINE CROSSINGS OF THE EXISTING 480V LINE, THE CONTRACTOR SHALL COMPLY WITH MINIMUM SEPARATIONS AS PER PREVAILING STATE AND LOCAL CODES AND ORDINANCES. IF THE DRAWINGS INDICATE OR INFER SEPARATIONS OTHER THAN ALLOWED BY SUCH CODES AND ORDINANCES, THE CONTRACTOR SHALL IMMEDIATELY INFORM THE CONSTRUCTION MANAGER.
11. THE CONTRACTOR WILL BE RESPONSIBLE FOR THE REPAIR OF ANY DON FACILITIES DAMAGED IN THE COURSE OF RUNWAY DEMOLITION ACTIVITIES. SUCH REPAIR WORK WILL BE DONE TO THE SATISFACTION AND APPROVAL OF CONSTRUCTION MANAGER AND THE DON.
12. LARGE EQUIPMENT SHALL NOT CROSS THE CONVEYANCE SYSTEM TRENCH EXCEPT FOR AT THE LOCATIONS DESIGNATED AS DESCRIBED IN NOTE 4 ABOVE.
13. THE CONTRACTOR SHALL REPLACE ANY DISRUPTED UNDERGROUND WARNING TAPE WITHIN THE CONVEYANCE SYSTEM TRENCH.
14. CONTRACTOR SHALL CONFORM TO THE CONDITIONS IN THE DON PROJECT ENVIRONMENTAL REVIEW FORM (PERF) AND WORK IN EASEMENT AREA (WIEA).
15. CONTRACTOR SHALL FOLLOW REVISED PROTOCOL PLAN FOR UNKNOWN HAZARDOUS MATERIALS AND NON-RECYCLABLE MATERIALS PREPARED BY ENGEO INC. DATED OCTOBER 3, 2014, PROJECT NO 8506.0GP.000. THIS PLAN INCLUDES A REQUIREMENT THAT THE CONTRACTOR PROVIDE A SITE-SPECIFIC HEALTH AND SAFETY PLAN.




DETAIL A
NOT TO SCALE

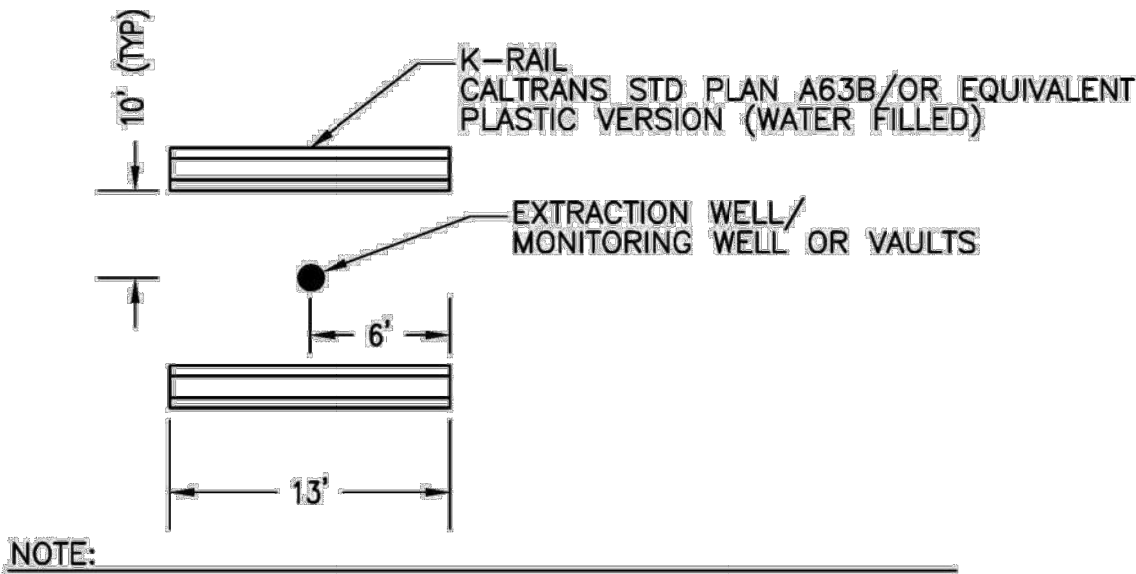

- NOTE:
1. CONTRACTOR SHALL PLACE WARNING TAPE AROUND THE WELL/ OPTIONAL ORANGE SNOW FENCE PER THE DIRECTION ENVIRONMENTAL COORDINATOR

DETAIL D
MONITORING WELL/IRP EXTRACTION WELL PROTECTION (OUTSIDE IMMEDIATE WORK AREA)


NOT TO SCALE

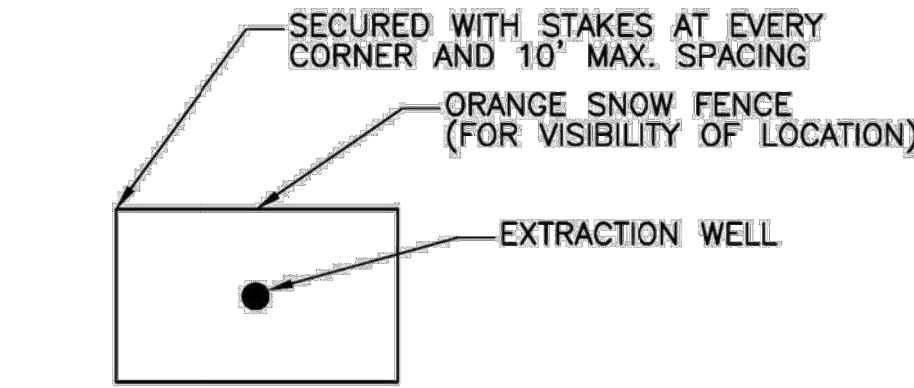

- NOTE:
1. CONTRACTOR SHALL INSTALL A VISIBLE BARRIER ORANGE SNOW FENCE AROUND THE WELL OR GROUP OF WELLS FOR VISUAL LOCATION

DETAIL B
MONITORING WELL/IRP EXTRACTION WELL PROTECTION (INSIDE IMMEDIATE WORK AREA)

NOT TO SCALE

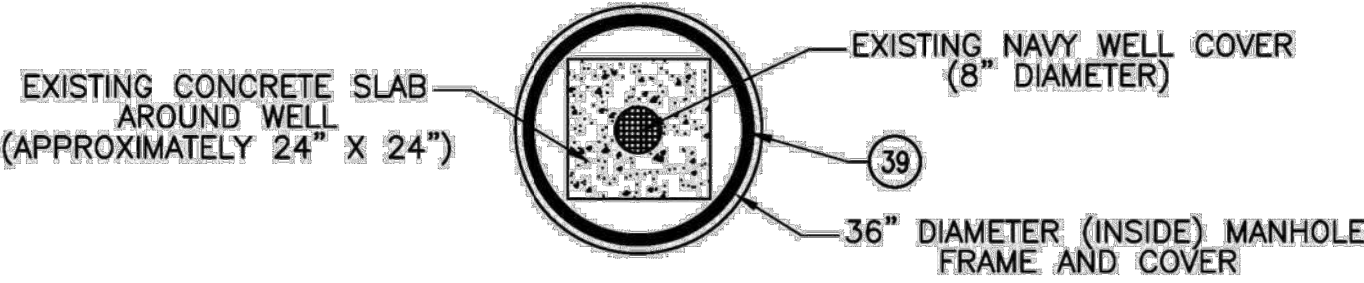


ALL WORK TO INSTALL THE MANHOLE GRADE RING AND RING AND COVER WILL BE PERFORMED OUTSIDE THE EXISTING CONCRETE PAD AROUND THE WELL COVER. THE EXISTING WELL AND COVER SHALL NOT BE TOUCHED OR DISTURBED IN ANY WAY. ALL WORK TO INSTALL THE MANHOLE RING AND COVER SHALL BE DONE BY HAND.

CONSTRUCTION NOTES

- 39- CONSTRUCT MONITORING WELL PROTECTIVE COVER SEE DETAILS C AND D ON DWG C1-105

DETAIL E
MONITORING WELL PROTECTIVE COVER



NOT TO SCALE

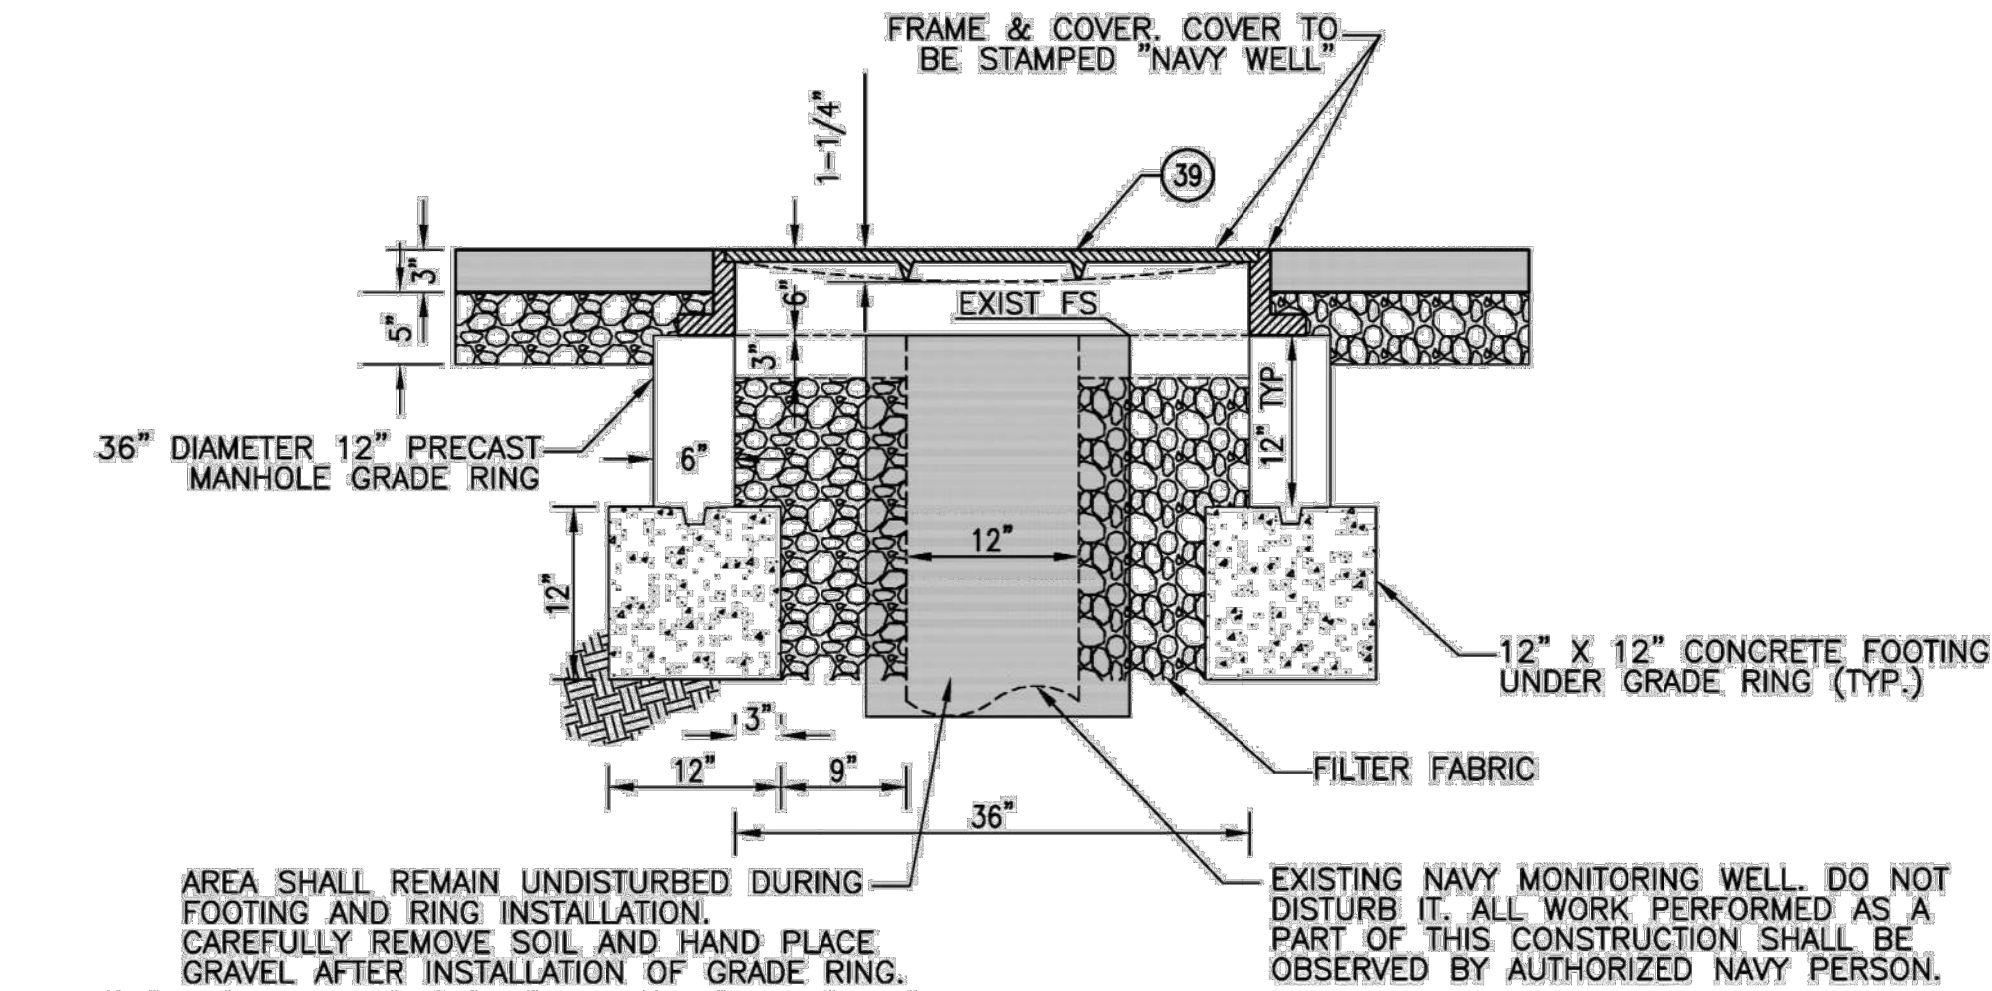

- PRECISE GRADING CONSTRUCTION NOTES
- 39- CONSTRUCT MONITORING WELL PROTECTIVE COVER SEE DETAILS C AND D ON DWG C1-105

DETAIL C
MONITORING WELL PROTECTIVE COVER


NOT TO SCALE

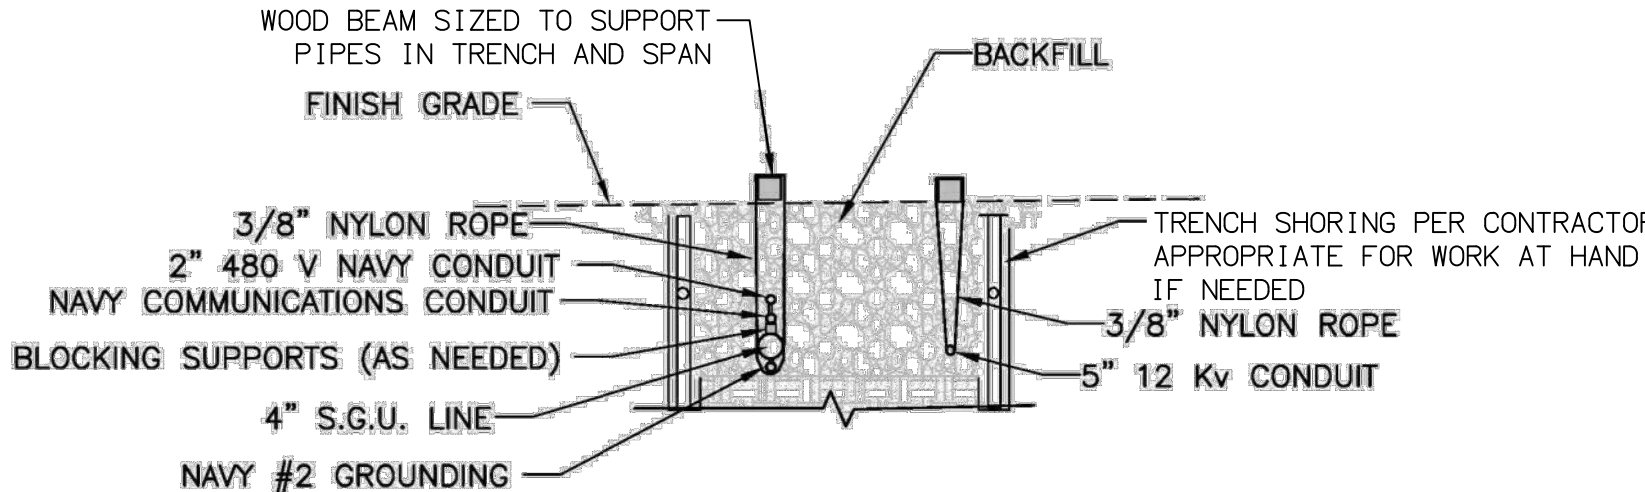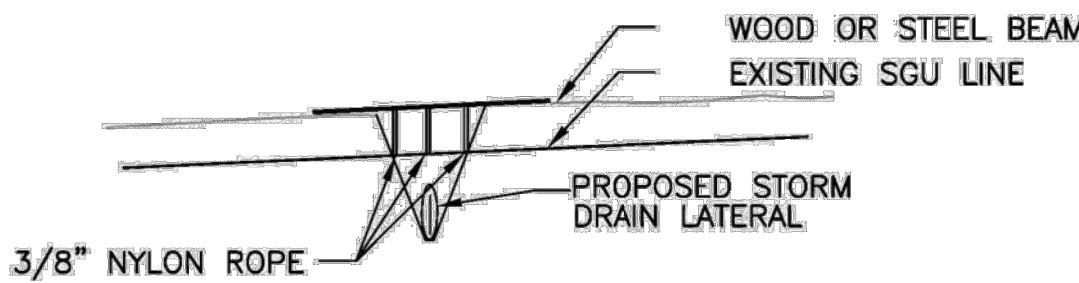

DETAIL F
PIPE AND CONDUIT SUPPORT AT UTILITY CROSSING

NOT TO SCALE


ALL CONCRETE TRAILS SCORE JOINTS NEED TO BE TOOLED; NOT SAW CUT

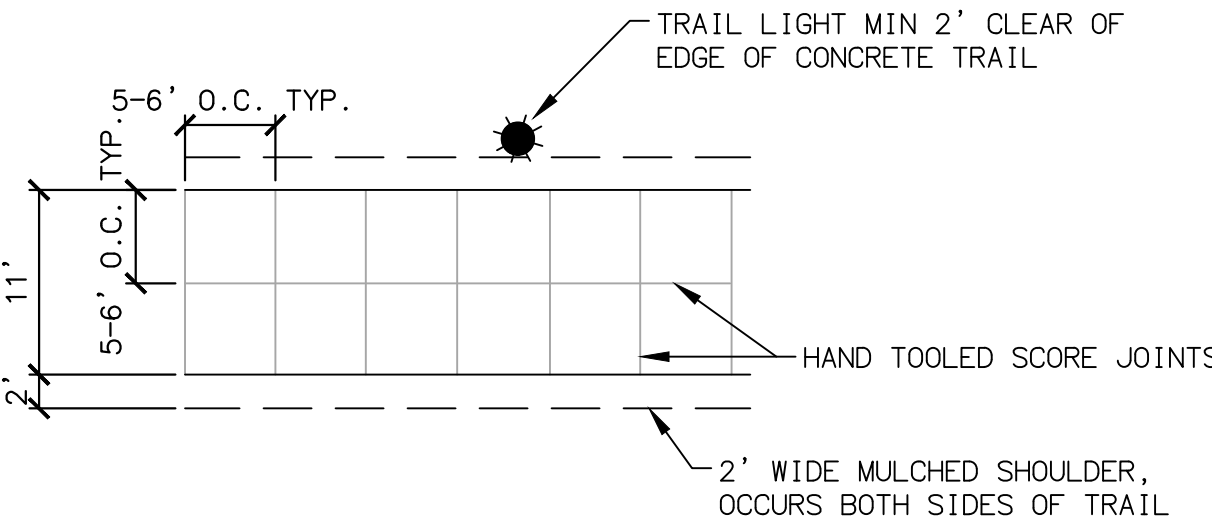

CLASS I PRIMARY TRAIL

TYPICAL TRAIL SCORING DETAIL

NOT TO SCALE

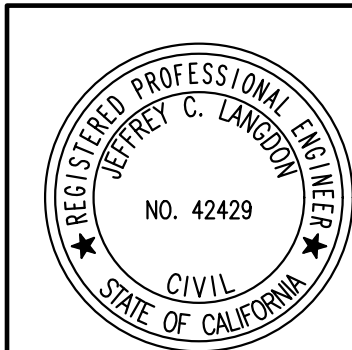

7						
6						
5						
4						
3						
2						
1						
NO.	DATE	REVISIONS	ENGR.	APPROV.	DATE	

DRAWN BY: SR	DATE 4/18
DESIGNED BY: JCL	DATE 4/18
CHECKED BY: JCL	DATE 4/18

PLAN PREPARED BY:
PROACTIVE
ENGINEERING CONSULTANTS
27042 Towne Centre Drive, Suite 110
Foothill Ranch, CA 92610 (949) 716-7460

JEFFREY C. LANGDON R.C.E. 42429 DATE

CONSTRUCTION PLANS FOR THE IMPROVEMENT OF
MARINE WAY
NAVY NOTES AND DETAILS
FROM SKYHAWK TO 3800' EASTER,Y

CITY OF IRVINE
PUBLIC WORKS DEPARTMENT

PLAN CHECK NO.
00760917-EMC
PERMIT NO.
00766614-MCE


PROJECT NO.
20.059
SHEET
4A
OF **28**

DEMOLITION GENERAL NOTES

1. REMOVE AND SALVAGE OF MATERIALS IMPLIES DELIVERING CONCRETE OR ASPHALT MATERIALS TO THE APPROPRIATE OWNERS STOCK PILE FOR CRUSHING.
2. CAPPING OF ALL PIPES AND CONDUITS ENDS INDICATED ARE TO BE PLUGGED WITH A WATER TIGHT PLUG APPROPRIATE FOR THE PIPE MATERIAL, BRICK AND MORTAR CAN BE USED FOR CONCRETE PIPE (SEE DETAIL SHEET 3)
3. OVERHEAD (OH) CABLES OF ELECTRIC, CABLE TV, TELEPHONE, OR OTHERS ARE TO BE REMOVED BACK TO THE 'NEAREST POLE' OR AERIAL CONNECTION POINT OFF SITE.
4. REMOVAL OF A SYSTEM IMPLIES ALL PARTS OF THE SYSTEM, INCLUDING BUT NOT LIMITED TO MANHOLES, CATCH BASINS, VAULTS, POLES, VALVES, HYDRANTS, THRUST BLOCKS AND MISCELLANEOUS STRUCTURES AND FOUNDATIONS.

DEMOLITION NOTES

- | | |
|---|---|
|  | CAP PIPE END |
|  | PROTECT IN PLACE |
|  | REMOVE AND DISPOSE |
|  | RELOCATE |
|  | REMOVE AND SALVAGE |
|  | SALVAGE |
| | |
|  | SAWCUT AND REMOVE
EX AC PAVEMENT |
|  | SAWCUT AND REMOVE
EX CONCRETE PAVEMENT |

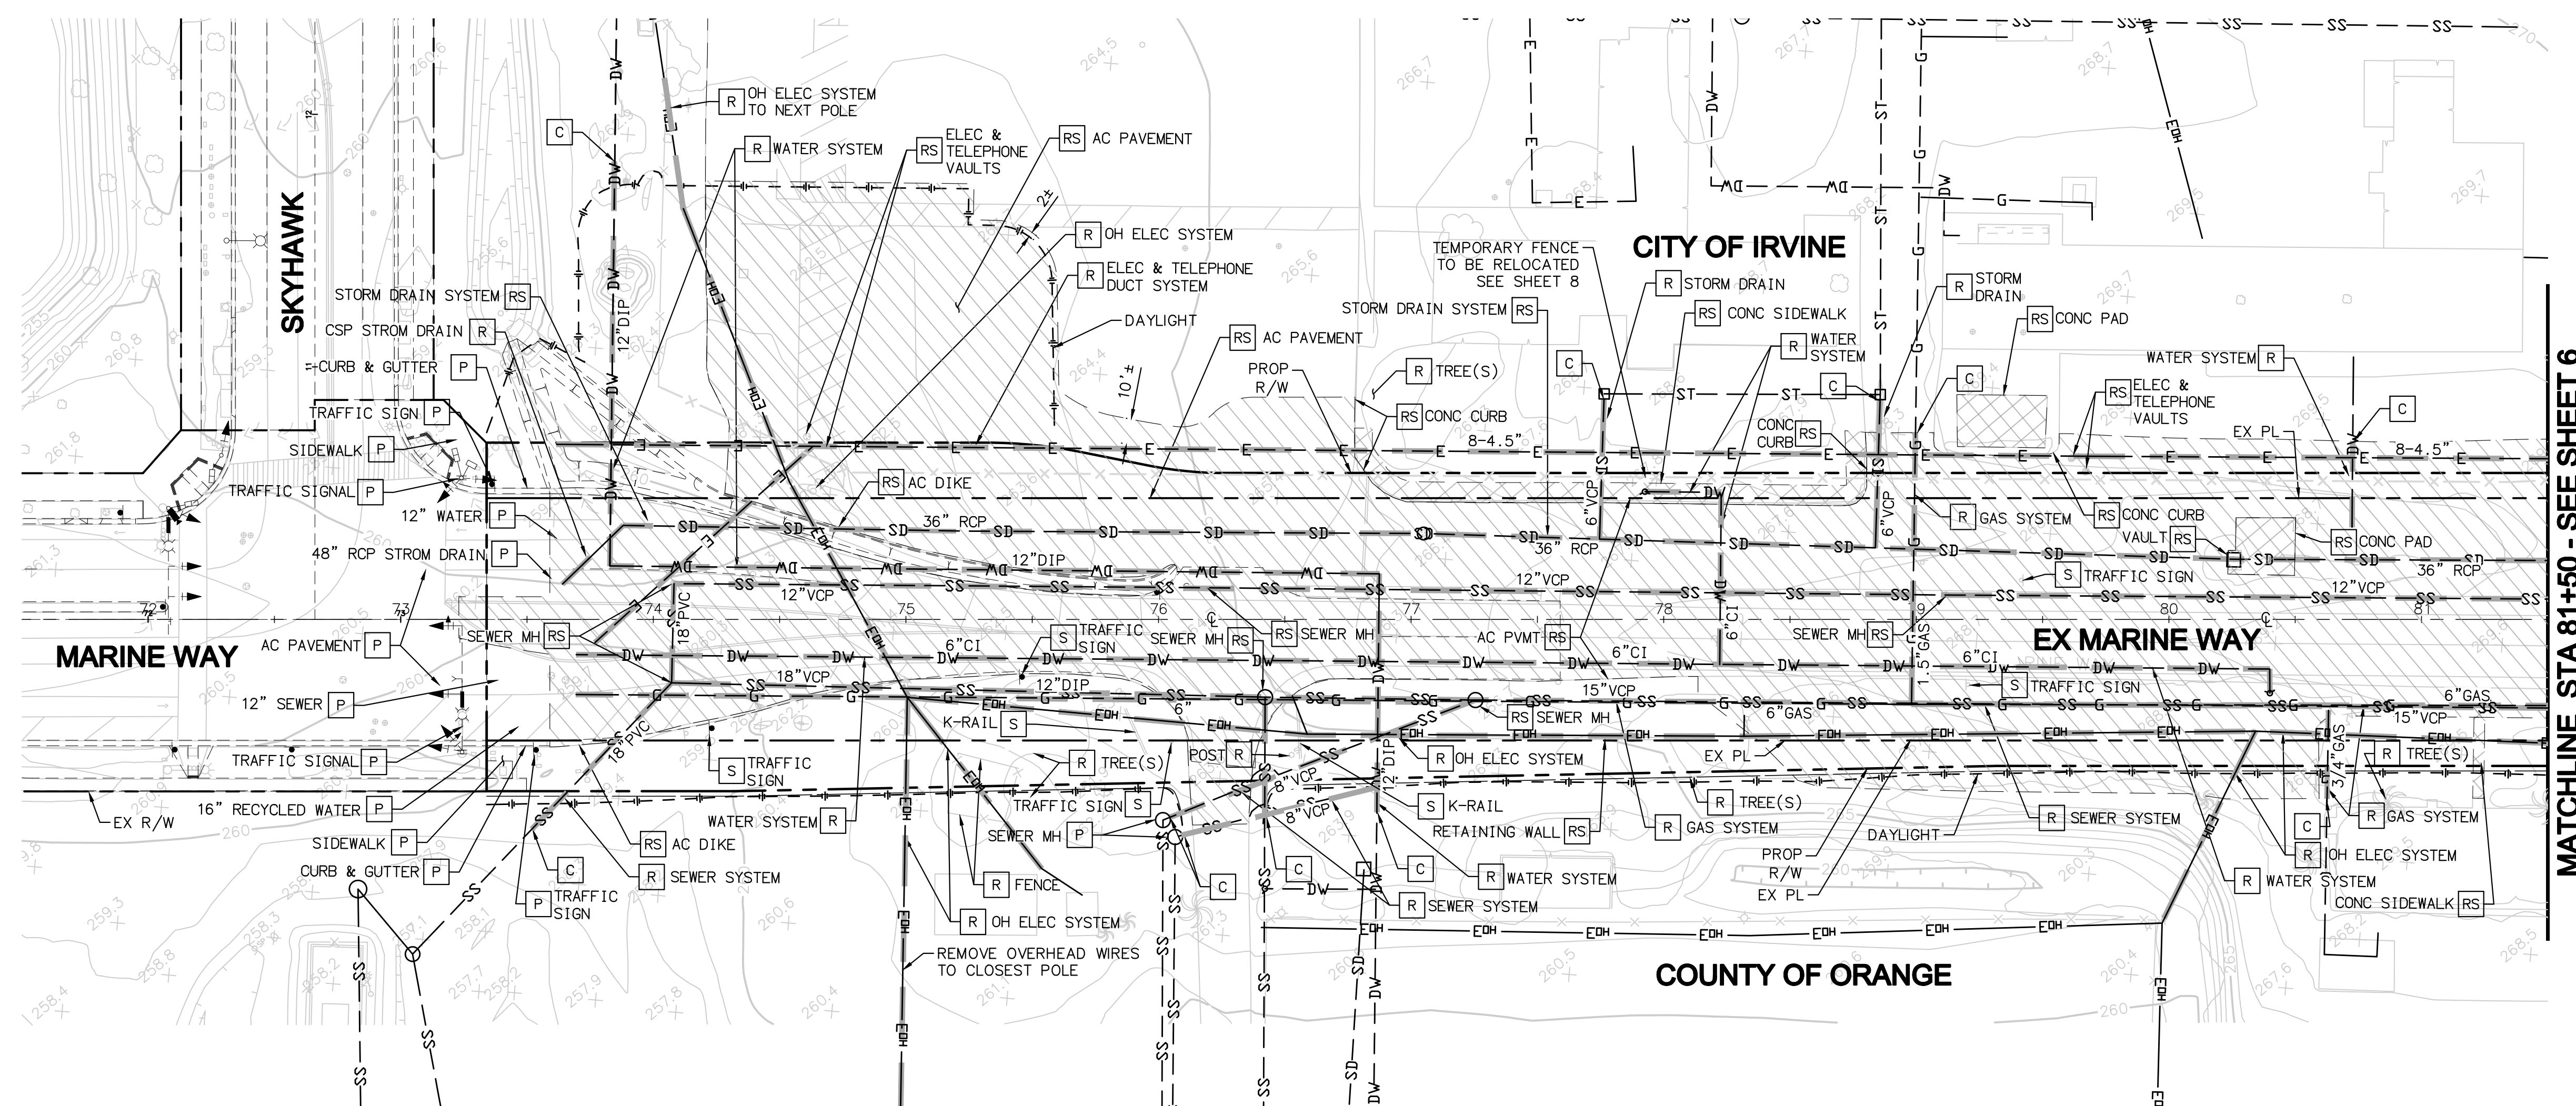

NOTE:
CONTRACTOR TO MAINTAIN/ALLOW
OR PROVIDE ACCESS TO EXISTING
PROPERTY OWNERS ALONG THE
FRONTAGE ON MARINE WAY.



7					
6					
5					
4					
3					
2					
1					
NO.	DATE	REVISIONS	ENGR.	APPROV.	DATE

DRAWN BY: SR	DATE 4/18
DESIGNED BY: JCL	DATE 4/18
CHECKED BY: JCL	DATE 4/18

PLAN PREPARED BY:

PROACTIVE
ENGINEERING CONSULTANTS

27042 Towne Centre Drive, Suite 110
Foothill Ranch, CA 92610 (949) 716-7460

JEFFREY C. LANGDON	R.C.E. 42429	D
--------------------	--------------	---

**CONSTRUCTION PLANS FOR THE IMPROVEMENT OF
MARINE WAY
DEMOLITION PLAN
FROM STA 73+30 TO STA 81+30**

CITY OF IRVINE
PUBLIC WORKS DEPARTMENT

PLAN CHECK NO.	00760917-EMC
PERMIT NO.	00766614-MCE

PROJECT NO.	20.059
-------------	--------

SHEET
5
OF **28**

- ☐ CAP PIPE END
- ☐ PROTECT IN PLACE
- ☐ REMOVE AND DISPOSE
- ☐ RELOCATE
- ☐ REMOVE AND SALVAGE
- ☐ SALVAGE

SAWCUT AND REMOVE
EX AC PAVEMENT

SAWCUT AND REMOVE
EX CONC PAVEMENT



MATCHLINE STA 90+50 - SEE 6A

SCALE 1"=40'

COUNTY OF ORANGE

CITY OF IRVINE

EX MARINE WAY

NOTE:
CONTRACTOR TO MAINTAIN/ALLOW
OR PROVIDE ACCESS TO EXISTING
PROPERTY OWNERS ALONG THE
FRONTAGE ON MARINE WAY.



7					
6					
5					
4					
3					
2					
1					
NO.	DATE	REVISIONS	ENGR.	APPROV.	DATE

DRAWN BY: SR	DATE 4/18
DESIGNED BY: JCL	DATE 4/18
CHECKED BY: JCL	DATE 4/18

PLAN PREPARED BY:

PROACTIVE
ENGINEERING CONSULTANTS

277042 Towne Centre Drive, Suite 110
Foothill Ranch, CA 92610 (949) 716-7460

JEFFREY C. LANGDON R.C.E. 42429 D

**CONSTRUCTION PLANS FOR THE IMPROVEMENT OF
MARINE WAY
DEMOLITION PLAN
FROM STA 81+30 TO STA 99+50**

CITY OF IRVINE
PUBLIC WORKS DEPARTMENT


PLAN CHECK NO.	00760917-EMC
PERMIT NO.	00766614-MCE

PROJECT NO.	20.059
SHEET	6
OF	28

☐ CAP PIPE END
☐ PROTECT IN PLACE
☐ REMOVE AND DISPOSE
☐ RELOCATE
☒ REMOVE AND SALVAGE
☐ SALVAGE

SAWCUT AND REMOVE
EX AC PAVEMENT

SAWCUT AND REMOVE
EX CONC PAVEMENT

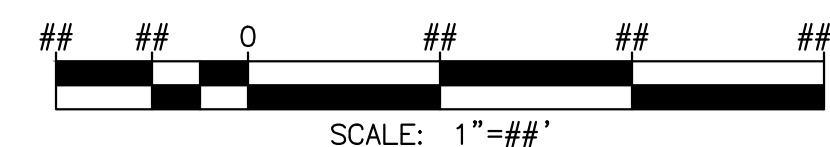

NOTE:
CONTRACTOR TO MAINTAIN/ALLOW
OR PROVIDE ACCESS TO EXISTING
PROPERTY OWNERS ALONG THE
FRONTAGE ON MARINE WAY.



7					
6					
5					
4					
3					
2					
1					
NO.	DATE	REVISIONS	ENGR.	APPROV.	DATE

DRAWN BY: SR	DATE 4/18
DESIGNED BY: JCL	DATE 4/18
CHECKED BY: JCL	DATE 4/18

PLAN PREPARED BY:

PROACTIVE
ENGINEERING CONSULTANTS

27042 Towne Centre Drive, Suite 110
Foothill Ranch, CA 92610 (949) 716-7460


JEFFREY C. LANGDON R.C.E. 42429 DA

**CONSTRUCTION PLANS FOR THE IMPROVEMENT OF
MARINE WAY
DEMOLITION PLAN
FROM STA 99+50 TO 11+05.40**

CITY OF IRVINE
PUBLIC WORKS DEPARTMENT


PLAN CHECK NO.	00760917-EMC
PERMIT NO.	00766614-MCE

PROJECT NO.	20.059
SHEET	7
OF	28

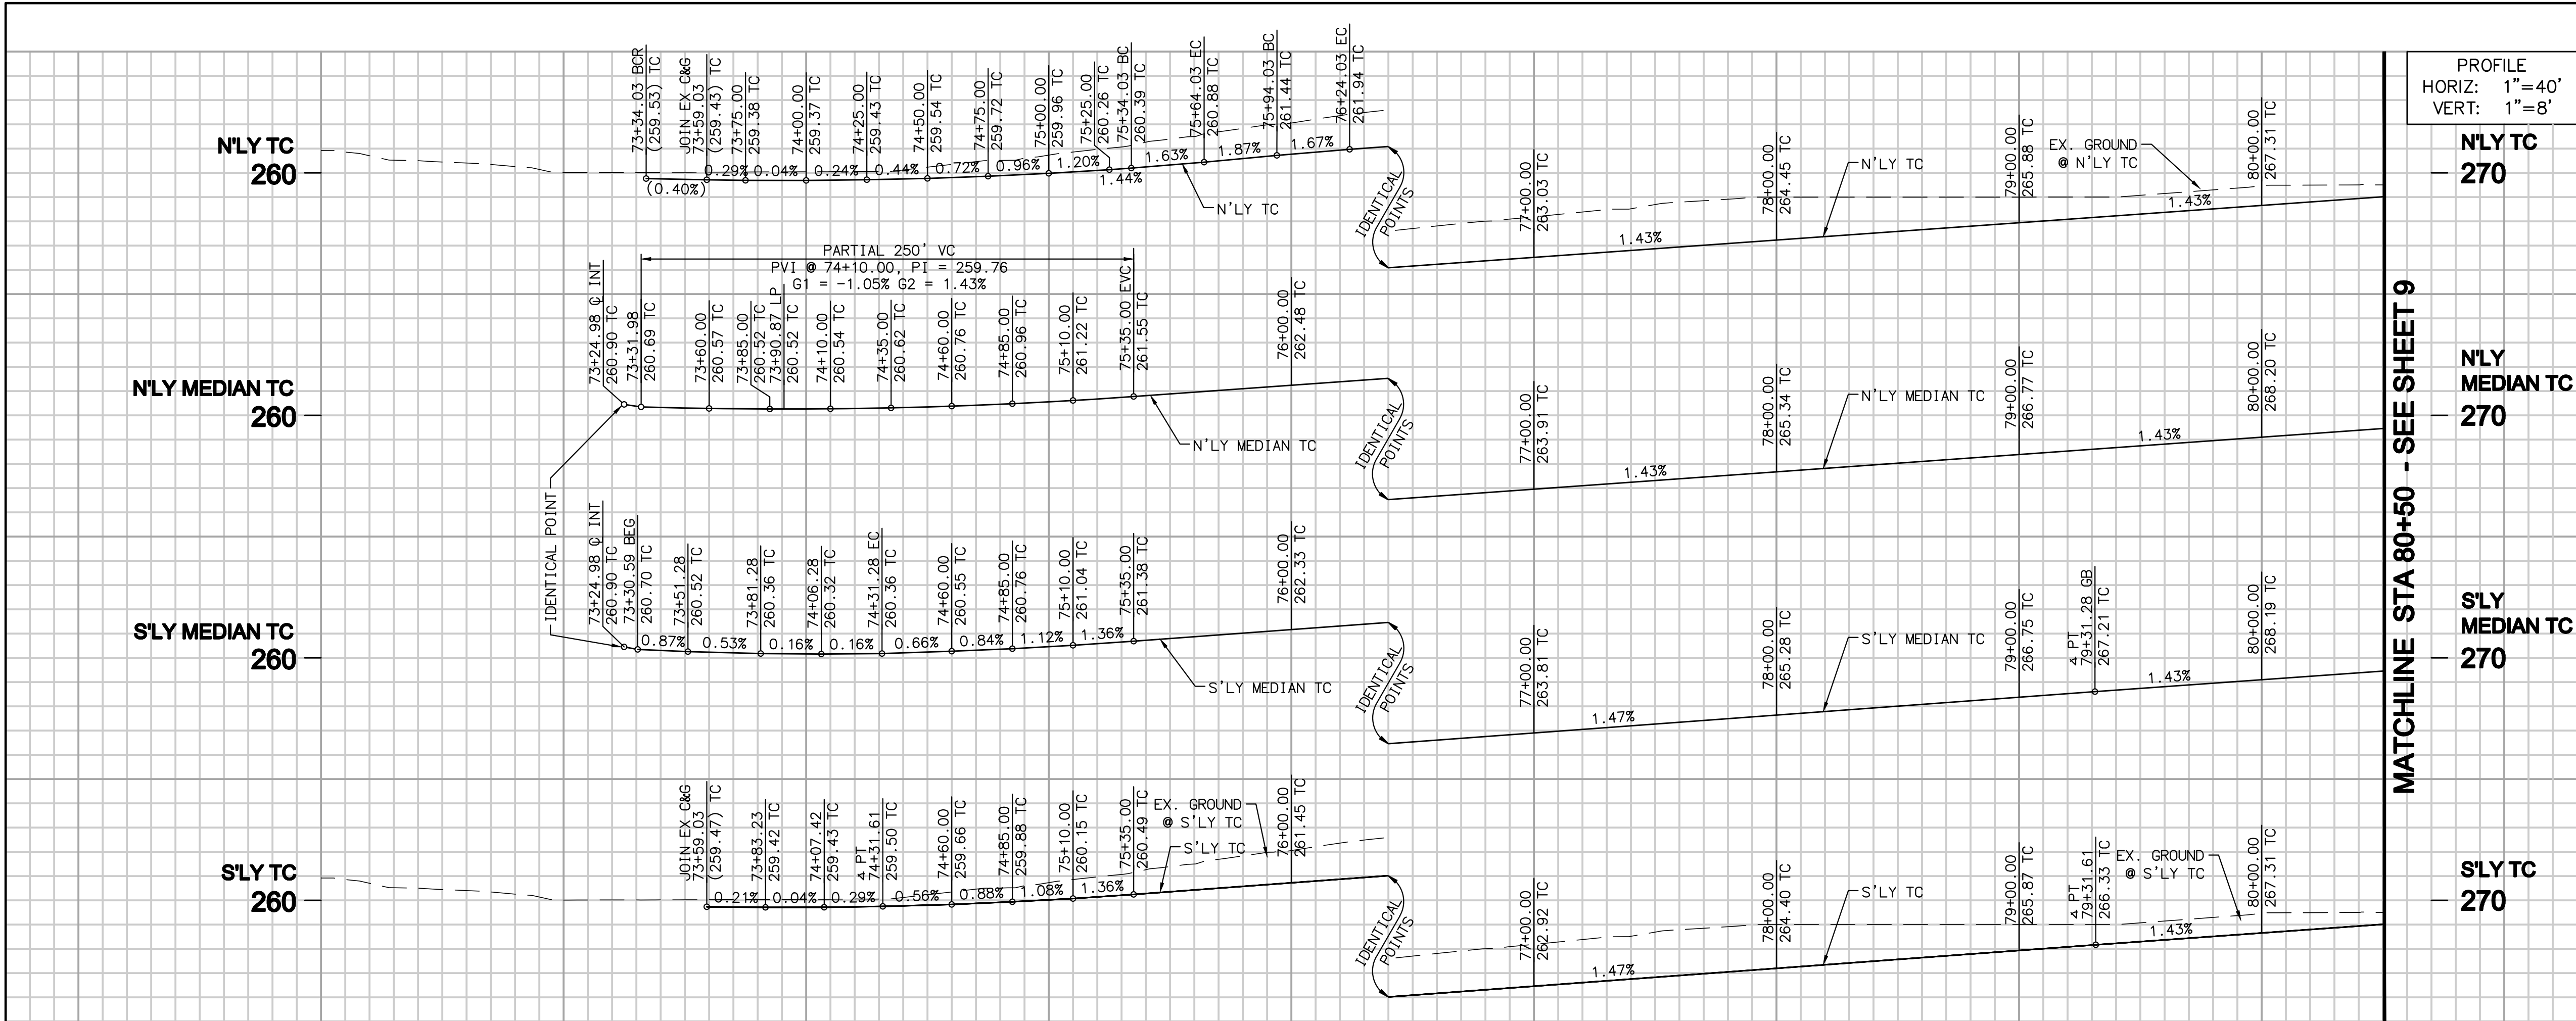


PROFILE
HORIZ: 1"=40'
VERT: 1"=8'


CENTERLINE PROFILE DATA			
PVI STA	PVI ELEV	GRADE	VC LENGTH
71+10.00	262.40	-1.05%	
74+10.00	259.25	1.48%	250'
85+50.00	275.54	-1.00%	200'

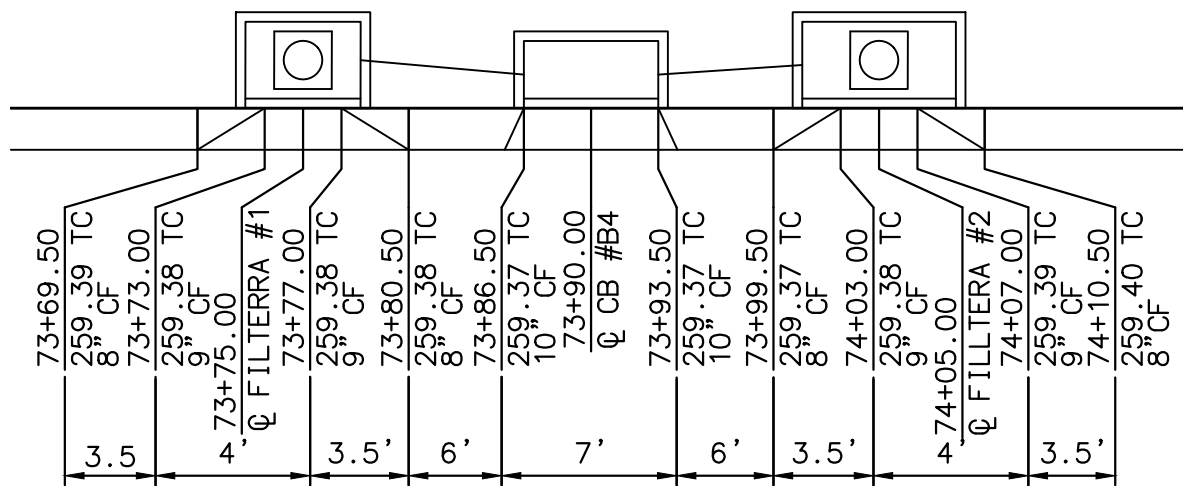

LOCAL DEPRESSION #B4
SCALE: 1"=10'

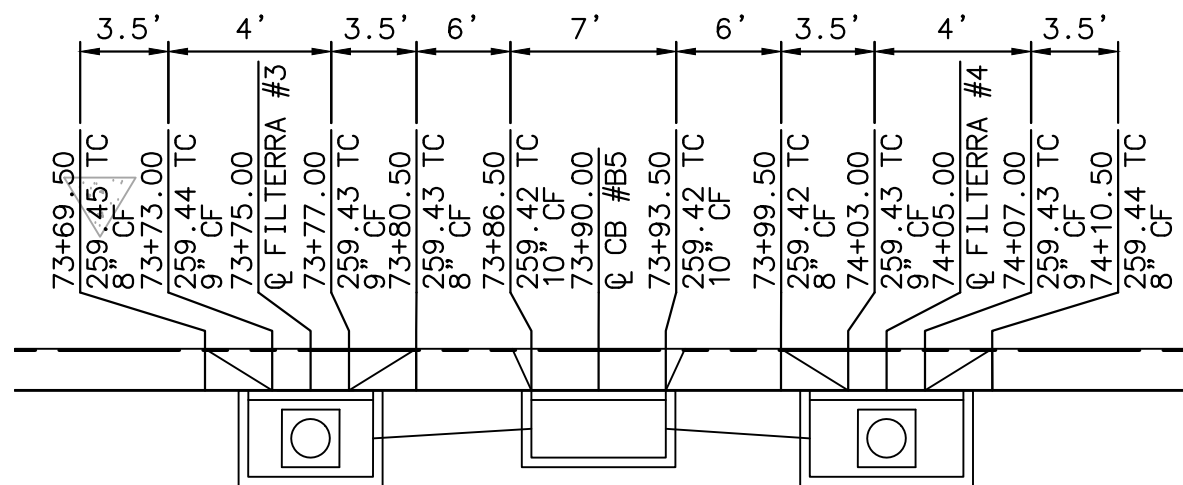

LOCAL DEPRESSION #B5
SCALE: 1"=10'

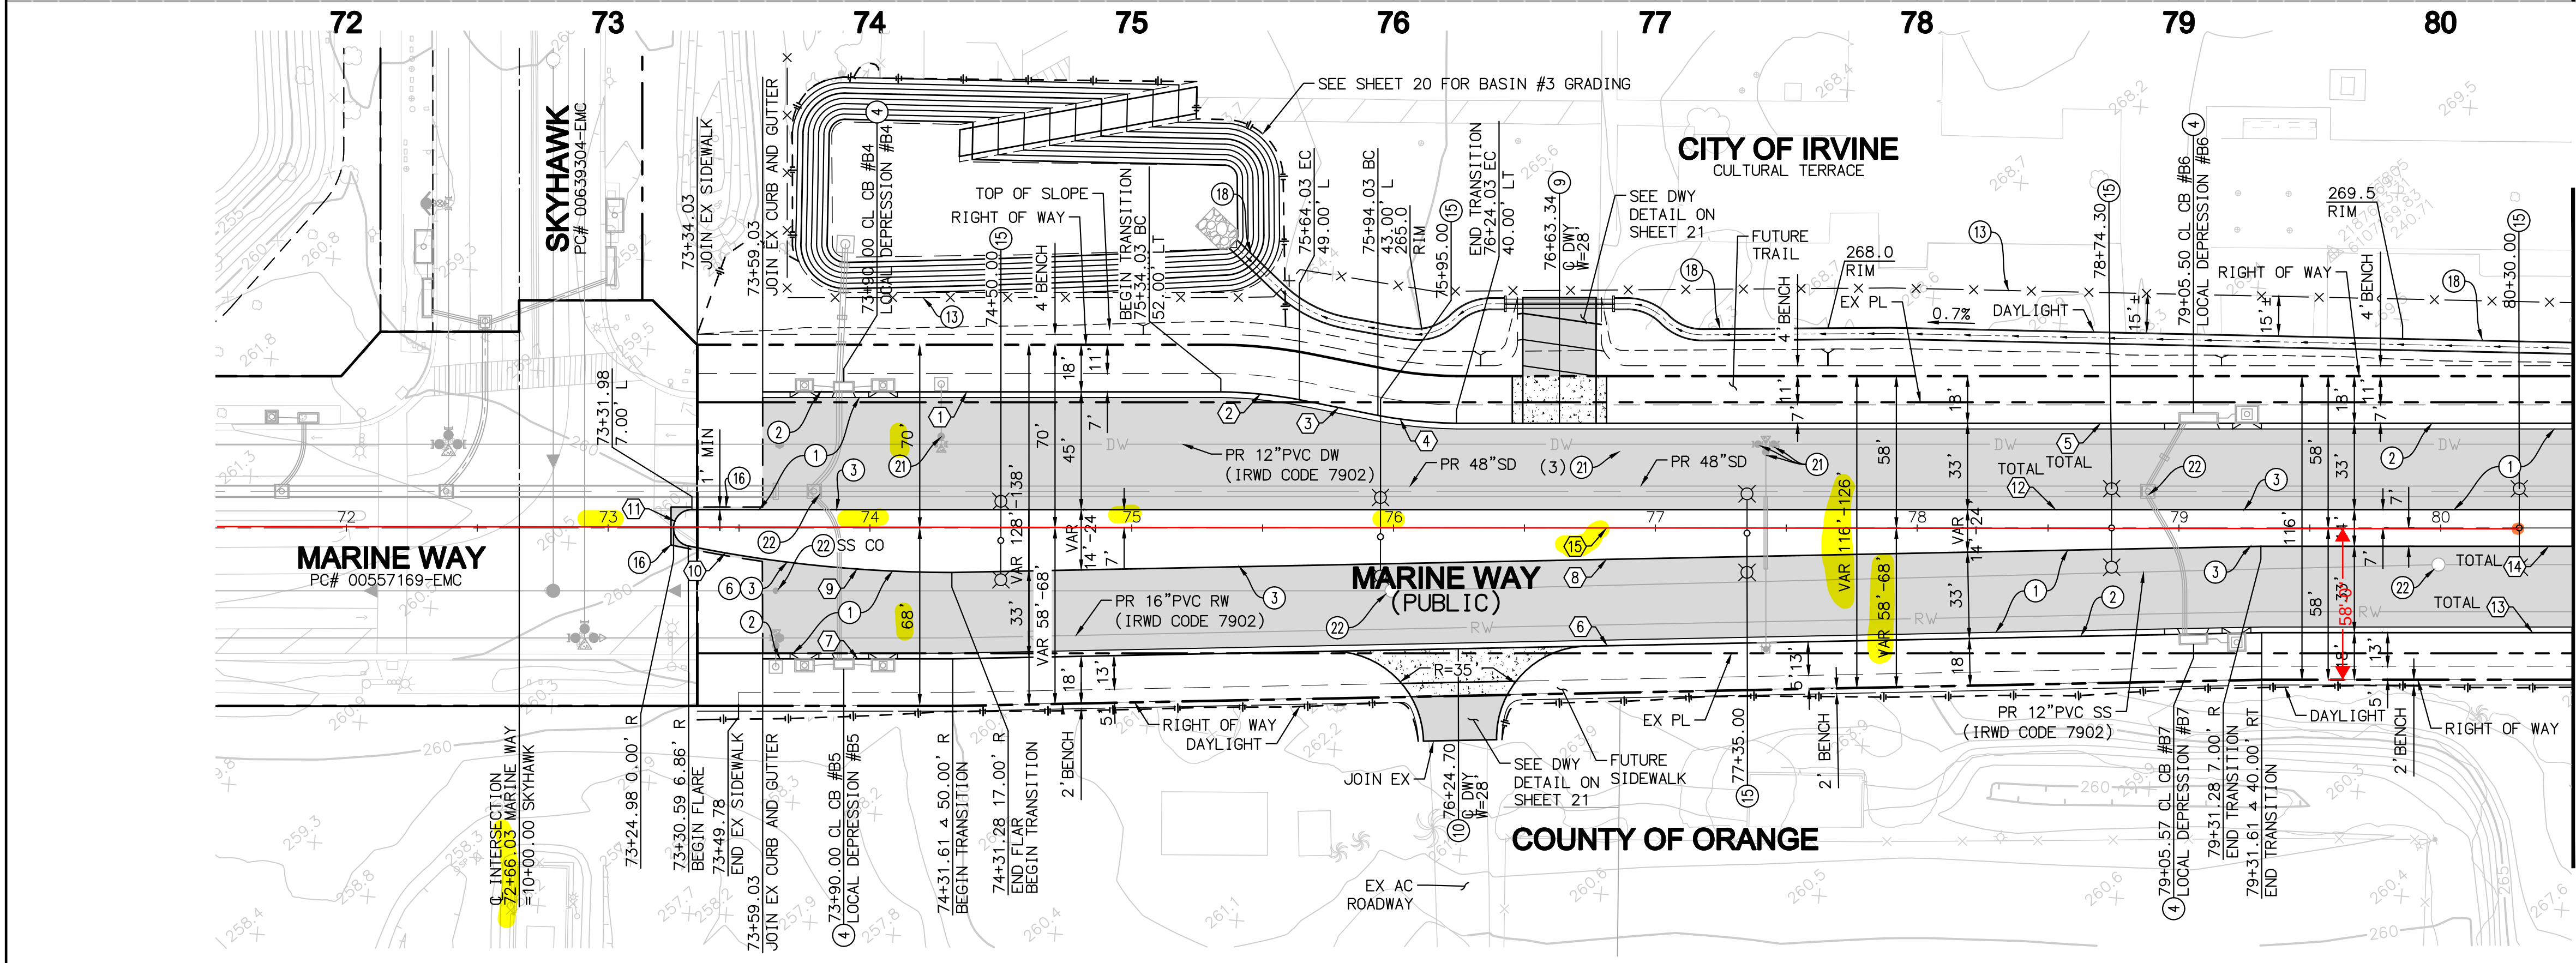


STREET CONSTRUCTION NOTES



- CONSTRUCT 2" ARM OVER 4.5" AC OVER 19.5" CMB STRUCTURAL SECTION TO BE VERIFIED BY PROJECT SOILS ENGINEER DURING GRADING AND WITH APPROVAL OF THE CITY ENGINEER
- CONSTRUCT CONCRETE CURB AND GUTTER PER CITY OF IRVINE STD. PLAN NO. 200, TYPE A-2
- CONSTRUCT CONCRETE CURB PER CITY OF IRVINE STD. PLAN NO. 200, TYPE B-8
- CONSTRUCT LOCAL DEPRESSION PER CITY OF IRVINE STD. PLAN NO. 303
- CONSTRUCT PARABOLIC MEDIAN CURB FLARE PER CITY OF IRVINE STD. PLAN NO. 108
- CONSTRUCT DRIVEWAY TYPE I PER CITY OF IRVINE STD. PLAN NO. 204 (WIDTH PER PLAN) X=4'
- CONSTRUCT DRIVEWAY TYPE II PER CITY OF IRVINE STD. PLAN NO. 205 (WIDTH PER PLAN)
- RELOCATE EXISTING TEMPORARY FENCE PER PLAN WITH GRAVEL BAGS ON LEG SUPPORTS
- DOUBLE ARM STREET LIGHT PER CITY OF IRVINE STD. PLAN 215 AND DETAIL SHEET 2, TO BE INSTALLED BY SEE
- CONSTRUCT FULL DEPTH AC TO PATCH PER CITY OF IRVINE STD. PLAN NO. 203 ALTERNATIVE A
- CONSTRUCT 4' WIDE CONCRETE V-DITCH PER DETAIL ON SHEET 3
- RAISE TO GRADE EXISTING WATER VALVE CAN
- RAISE TO MANHOLE TO GRADE

LINE/CURVE DATA TABLE

NO	BEARING/DELTA	RADIUS	LENGTH	TANGENT
1	N49°51'20"W	---	175.00'	---
2	10°04'07"	171.79'	30.19'	15.13'
3	N38°32'44"W	---	30.59'	---
4	10°04'07"	171.79'	30.19'	15.13'
5	N49°51'20"W	---	775.08'	---
6	N51°00'05"W	---	500.10'	---
7	N49°51'20"W	---	72.58'	---
8	N51°00'05"W	---	500.10'	---
9	08°09'54"	508.75'	72.50'	36.31'
10	03°15'04"	508.75'	28.87'	14.44'
11	168°32'30"	7.00'	20.59'	69.77'
TOTAL	N49°51'20"W	---	1067.13'	---
TOTAL	N49°51'20"W	---	467.50'	---
TOTAL	N49°51'20"W	---	467.83'	---
TOTAL	N49°51'20"W	---	1133.08'	---

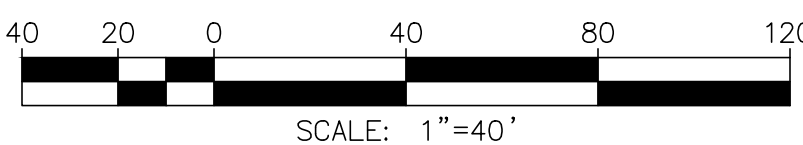

SEE SHEET 13 FOR SD IMPROVEMENTS

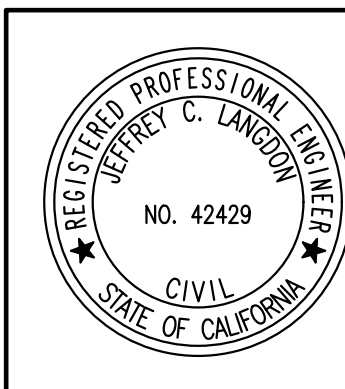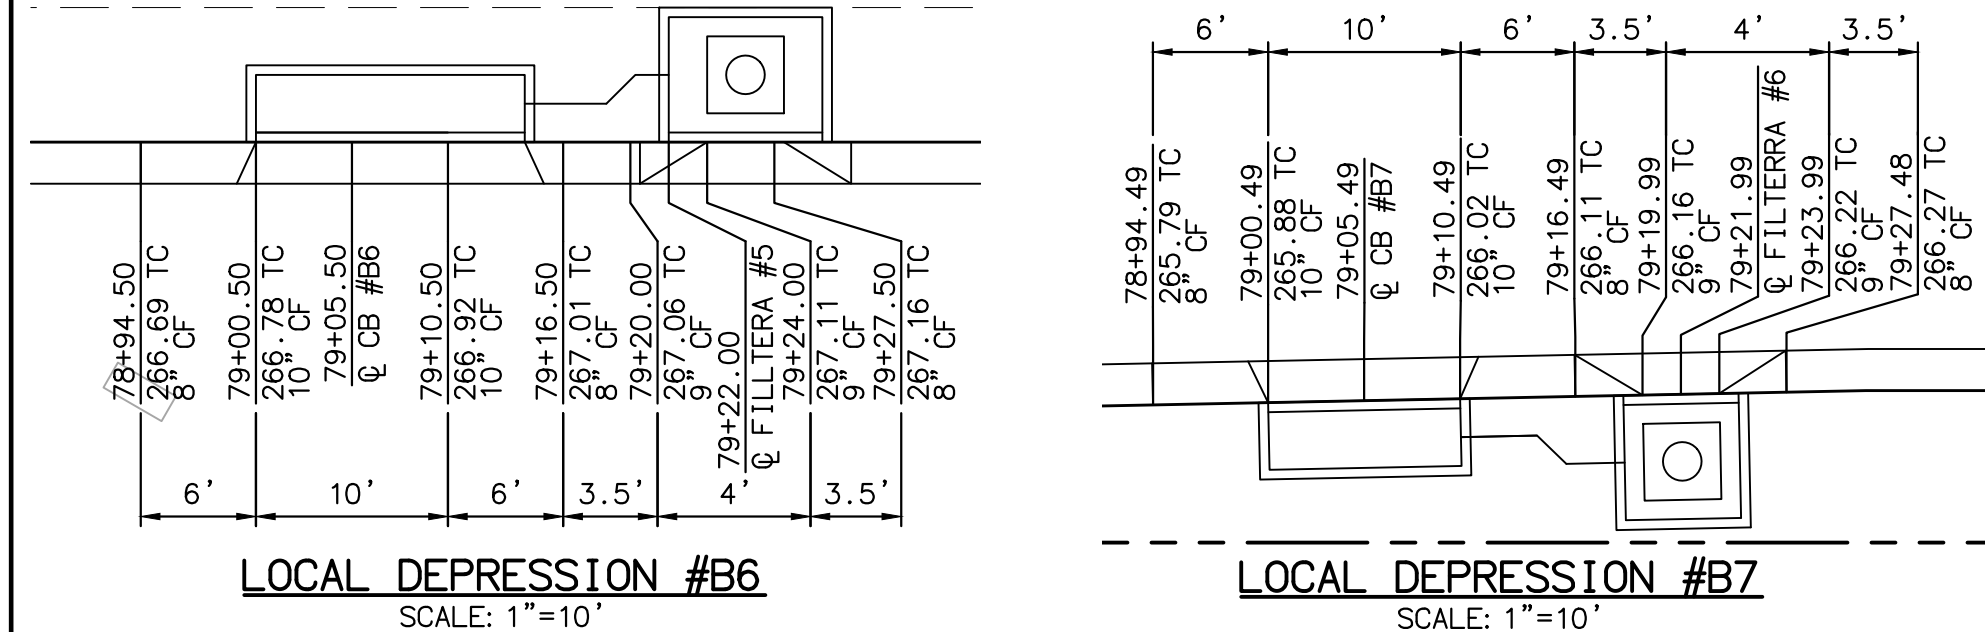


NO.	DATE	REVISIONS	ENGR.	APPROV.	DATE
7					
6					
5					
4					
3					
2					
1					

DRAWN BY: SR	DATE: 4/18
DESIGNED BY: JCL	DATE: 4/18
CHECKED BY: JCL	DATE: 4/18


PLAN PREPARED BY:
PROACTIVE
ENGINEERING CONSULTANTS
27042 Towne Centre Drive, Suite 110
Foothill Ranch, CA 92610 (949) 716-7460

CONSTRUCTION PLANS FOR THE IMPROVEMENT OF
MARINE WAY
STREET PLAN AND PROFILE
FROM STA 73+24.98 TO 80+50.00
CITY OF IRVINE
PUBLIC WORKS DEPARTMENT


PLAN CHECK NO. 00760917-EMC	PROJECT NO. 20.059
PERMIT NO. 00766614-MCE	SHEET 8 OF 28

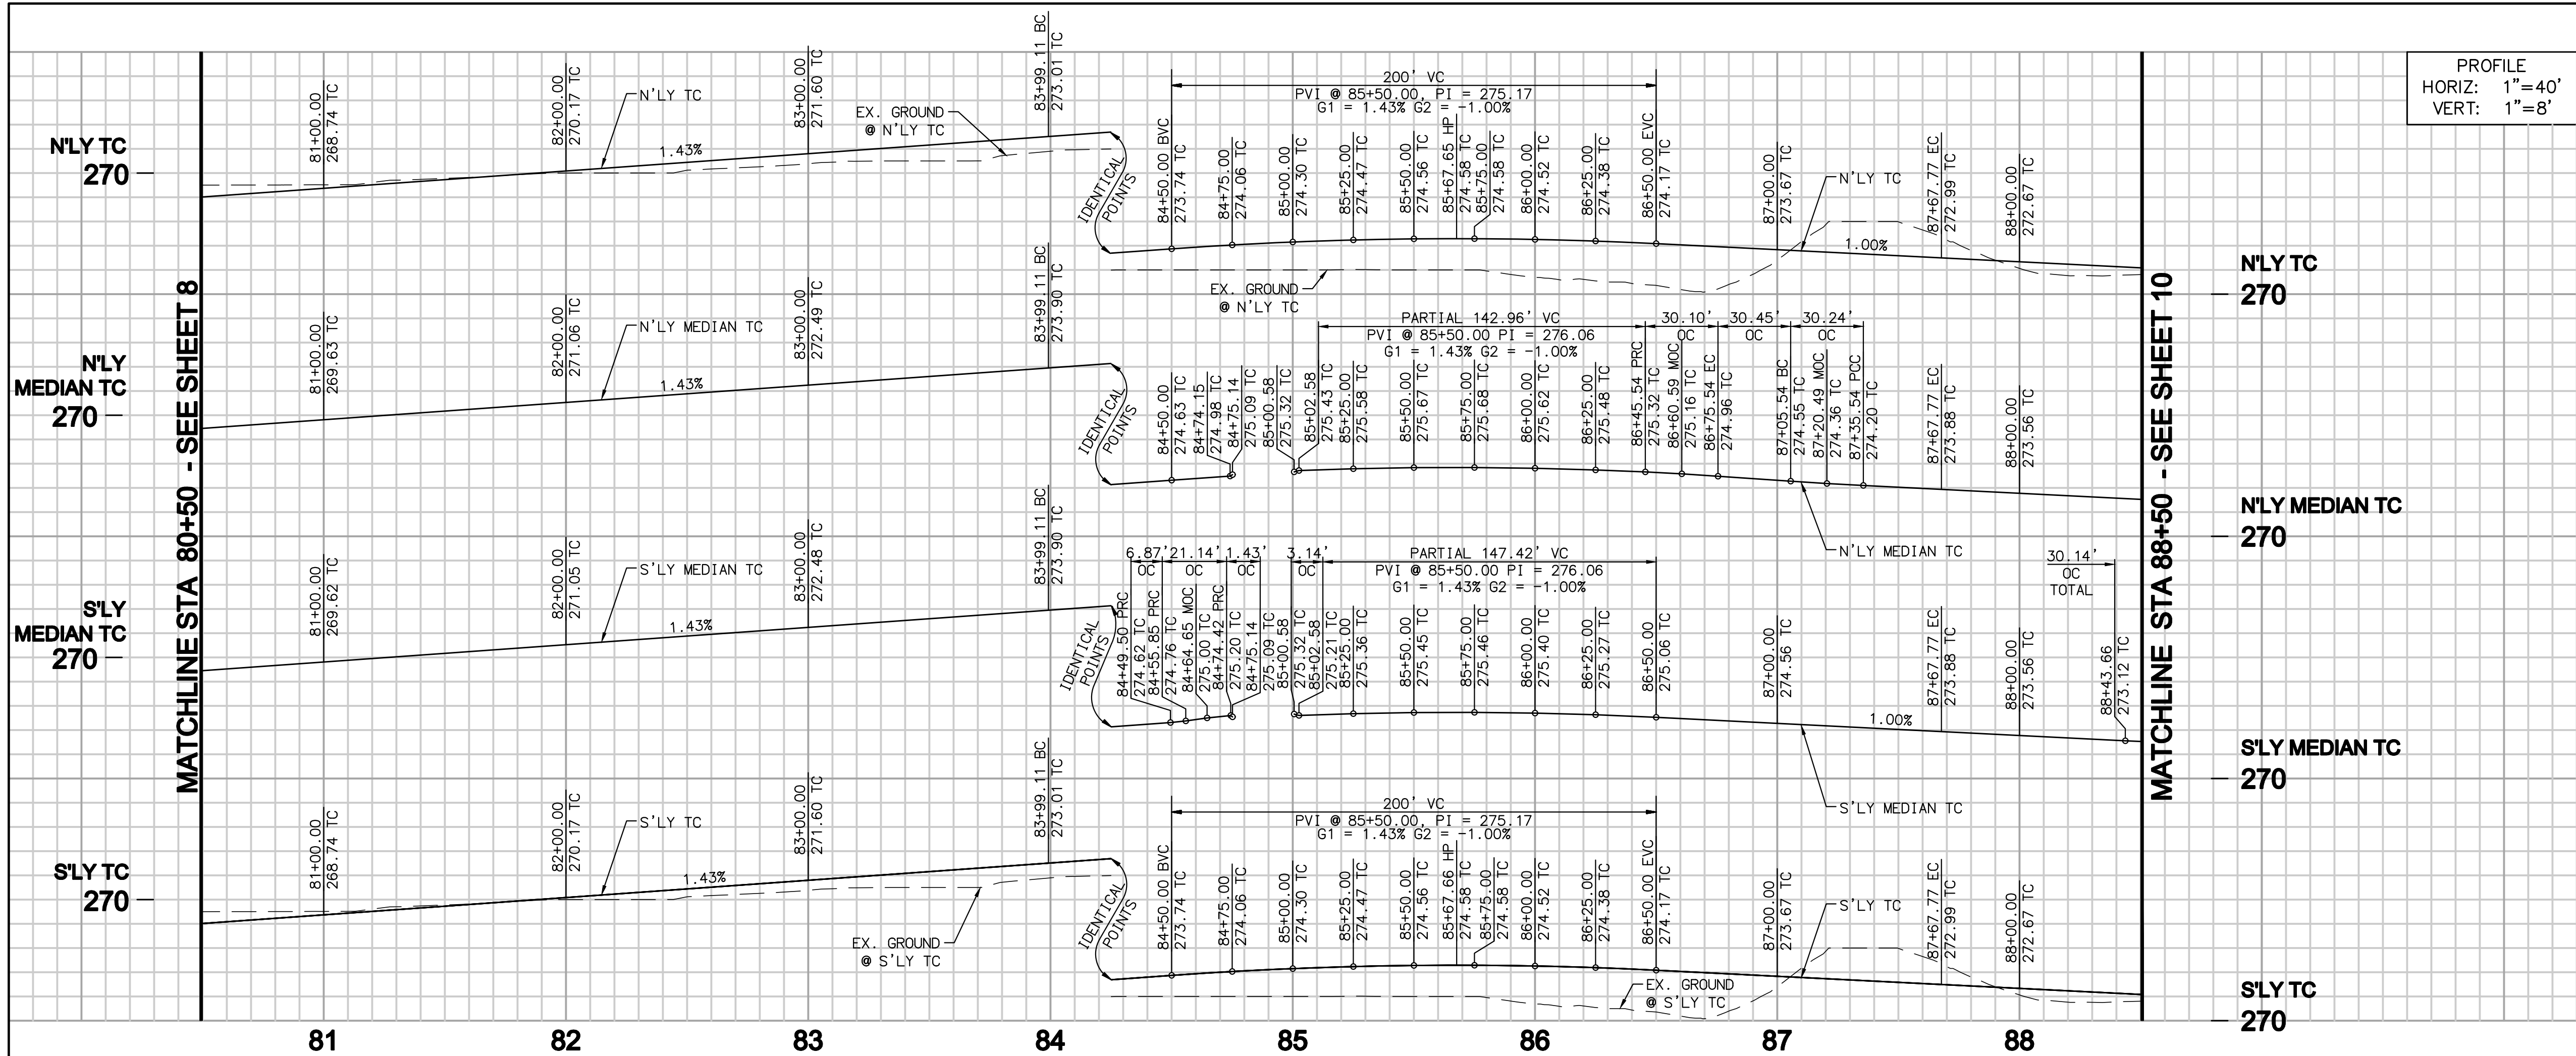

CENTERLINE PROFILE DATA			
PVI STA	PVI ELEV	GRADE	VC LENGTH
74+10.00	259.25	1.48%	250'
85+50.00	275.54	-1.00%	200'
96+00.00	265.04	1.00%	200'

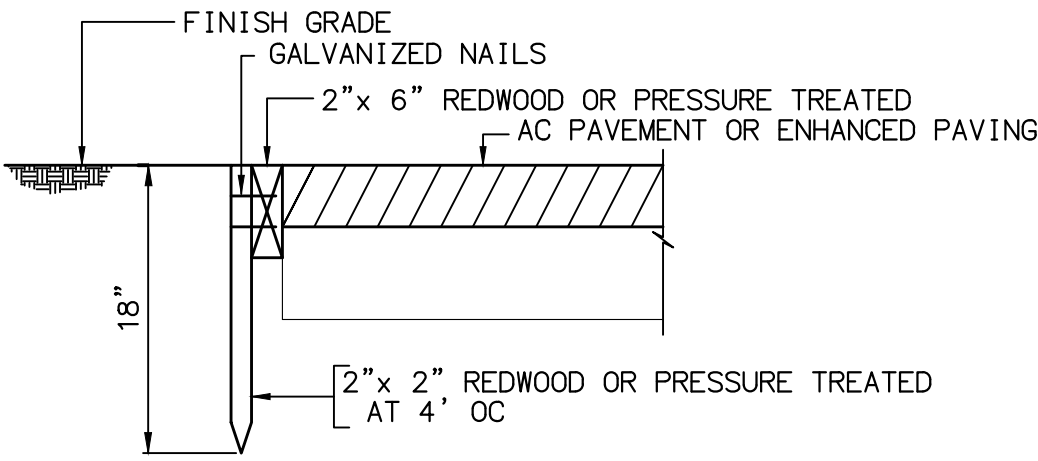

5 WOOD HEADER DETAIL
NOT TO SCALE

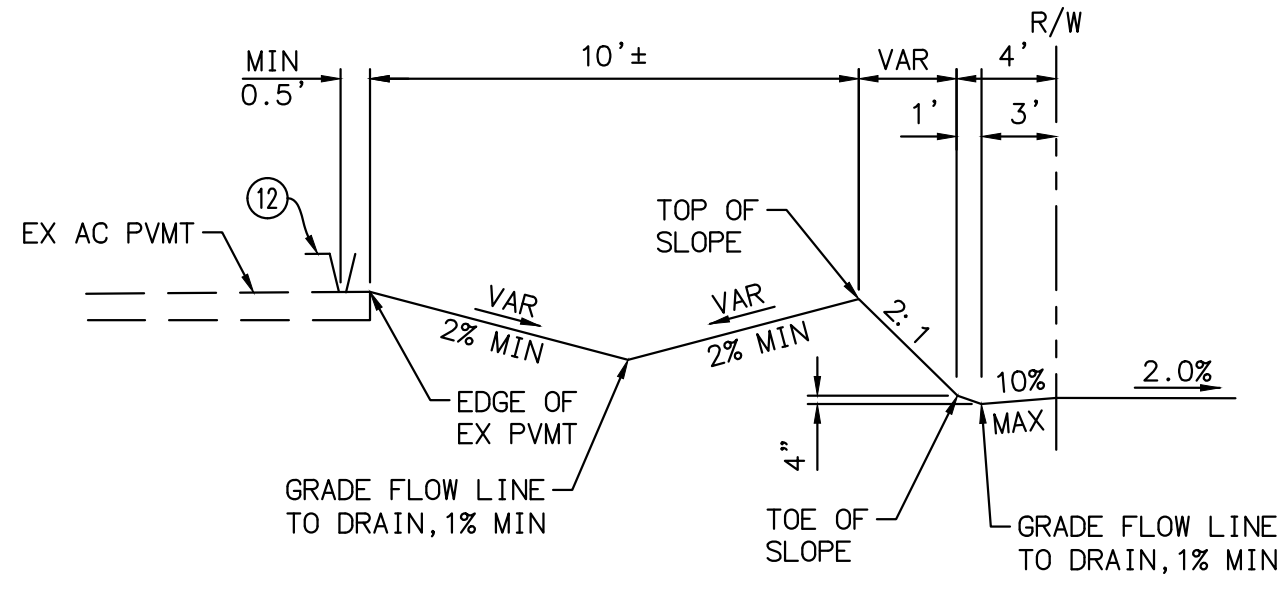


SECTION BB
NTS

STREET CONSTRUCTION NOTES



- CONSTRUCT 2" ARHM OVER 4.5" AC OVER 19.5" CMB STRUCTURAL SECTION TO BE VERIFIED BY PROJECT SOILS ENGINEER DURING GRADING AND WITH APPROVAL OF THE CITY ENGINEER
- CONSTRUCT CONCRETE CURB AND GUTTER PER CITY OF IRVINE STD. PLAN NO. 200, TYPE A-2
- CONSTRUCT CONCRETE CURB PER CITY OF IRVINE STD. PLAN NO. 200, TYPE B-8
- CONSTRUCT DRIVEWAY TYPE I PER CITY OF IRVINE STD. PLAN NO. 204 (WIDTH PER PLAN) X=4'
- CONSTRUCT DRIVEWAY TYPE II PER CITY OF IRVINE STD. PLAN NO. 205 (WIDTH PER PLAN)
- CONSTRUCT 8" AC CURB D1-8 PER SPWC STD. PLAN 120-2 (SEE SHEET 23)
- RELOCATE EXISTING TEMPORARY FENCE PER PLAN WITH GRAVEL BAGS ON LEG SUPPORTS
- SINGLE ARM STREET LIGHT PER CITY OF IRVINE STD. PLAN 215 AND DETAIL SHEET 2, TO BE INSTALLED BY SCE
- DOUBLE ARM STREET LIGHT PER CITY OF IRVINE STD. PLAN 215 AND DETAIL SHEET 2, TO BE INSTALLED BY SCE
- CONSTRUCT 4' WIDE CONCRETE V-DITCH PER DETAIL ON SHEET 3
- RAISE TO GRADE EXISTING WATER VALVE CAN
- RAISE TO MANHOLE TO GRADE

	LINE/CURVE DATA TABLE				
	NO	BEARING/DELTA	RADIUS	LENGTH	TANGENT
TOTAL	1	N49°51'20"W	--	775.08'	--
	2	11°14'08"	1920.00'	376.51'	188.86'
TOTAL	3	N38°37'12"W	--	540.70'	--
TOTAL	4	N38°37'12"W	--	540.70'	--
	5	11°14'08"	1840.00'	360.82'	180.99'
TOTAL	6	N49°51'20"W	--	467.50'	--
TOTAL	7	N49°51'20"W	--	1067.13'	--
	8	02°17'13"	1887.00'	75.32'	37.66'
	9	164°07'03"	1.00'	2.86'	7.17'
	10	24°13'25"	50.00'	21.14'	10.73'
	11	39°21'17"	10.00'	6.87'	3.58'
	12	01°32'08"	1873.00'	50.20'	25.10'
TOTAL	13	N49°51'20"W	--	467.83'	--
TOTAL	14	N38°37'12"W	--	359.55'	--
	15	00°58'56"	1887.00'	32.35'	16.17'
	16	10°26'38"	165.89'	30.24'	15.16'
	17	N50°25'32"W	--	30.45'	--
	18	08°38'36"	199.56'	30.10'	15.08'
	19	04°21'24"	1877.00'	142.72'	71.40'
	20	180°00'00"	2.00'	6.28'	--
TOTAL	21	08°04'55"	1873.00'	264.20'	132.32'
	22	N38°37'12"W	--	76.92'	--
TOTAL	23	09°28'25"	182.27'	30.14'	15.10'
TOTAL	24	N49°51'20"W	--	1306.11'	--
TOTAL	25	11°14'08"	1880.00'	368.66'	184.92'
TOTAL	26	N38°37'12"W	--	540.70'	--

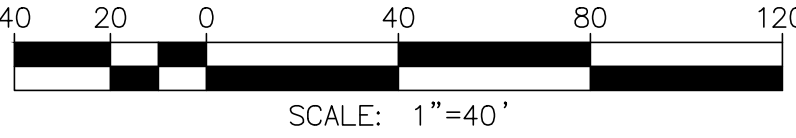

SCALE: 1"=40'

SEE SHEET 14 FOR SD IMPROVEMENTS

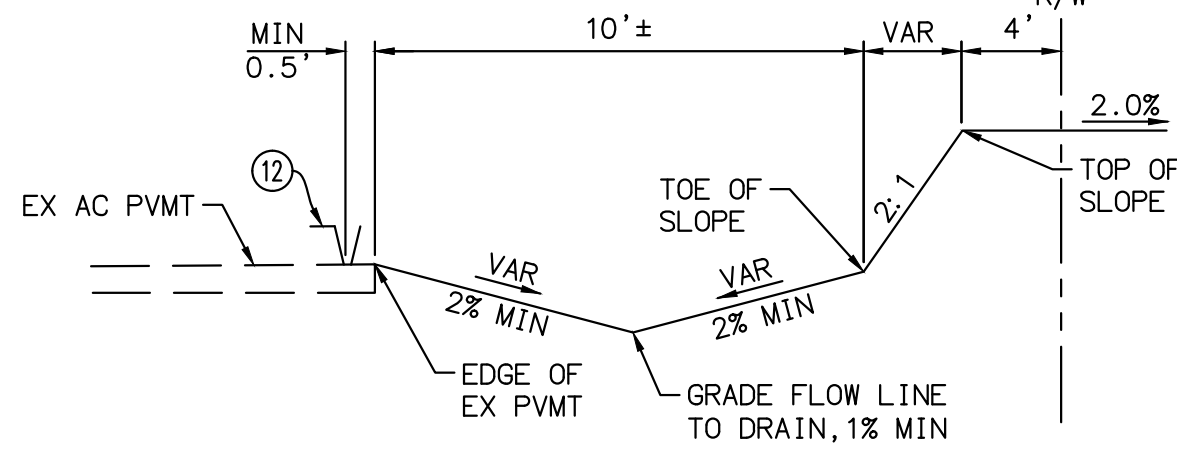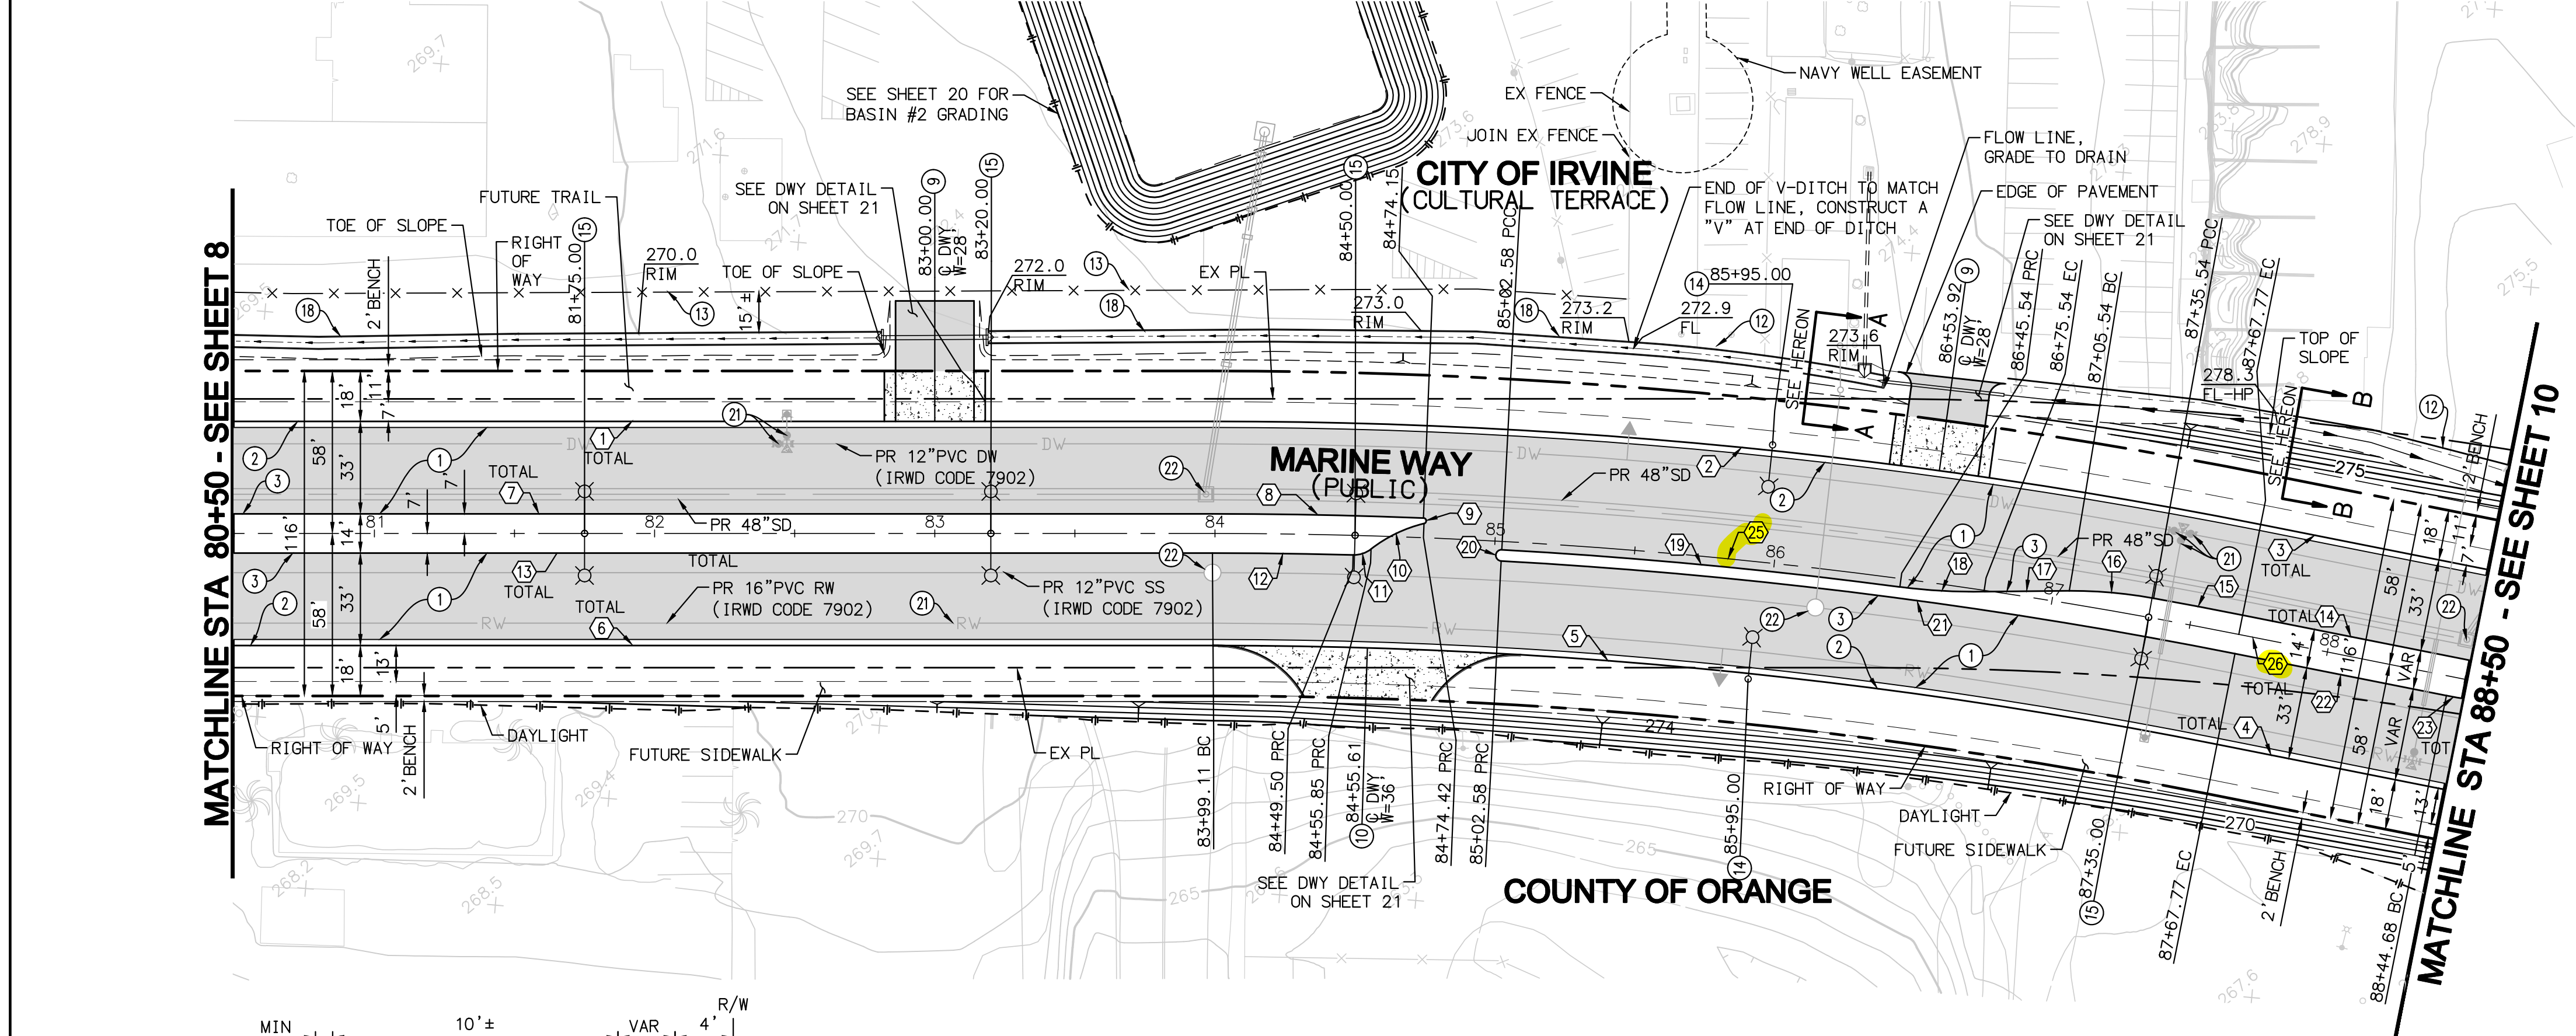

SECTION AA
NTS



NO.	DATE	REVISIONS	ENGR.	APPROV.	DATE
7					
6					
5					
4					
3					
2					
1					

DRAWN BY: SR	DATE: 4/18
DESIGNED BY: JCL	DATE: 4/18
CHECKED BY: JCL	DATE: 4/18

PLAN PREPARED BY:


PROACTIVE
ENGINEERING CONSULTANTS
27042 Towne Centre Drive, Suite 110
Foothill Ranch, CA 92610 (949) 716-7460

JEFFREY C. LANGDON R.C.E. 42429 DATE

CONSTRUCTION PLANS FOR THE IMPROVEMENT OF
MARINE WAY
STREET PLAN AND PROFILE
FROM STA 80+50.00 TO 88+50.00

CITY OF IRVINE
PUBLIC WORKS DEPARTMENT




PLAN CHECK NO. 00760917-EMC
PERMIT NO. 00766614-MCE
PROJECT NO. 20.059
SHEET 9 OF 28

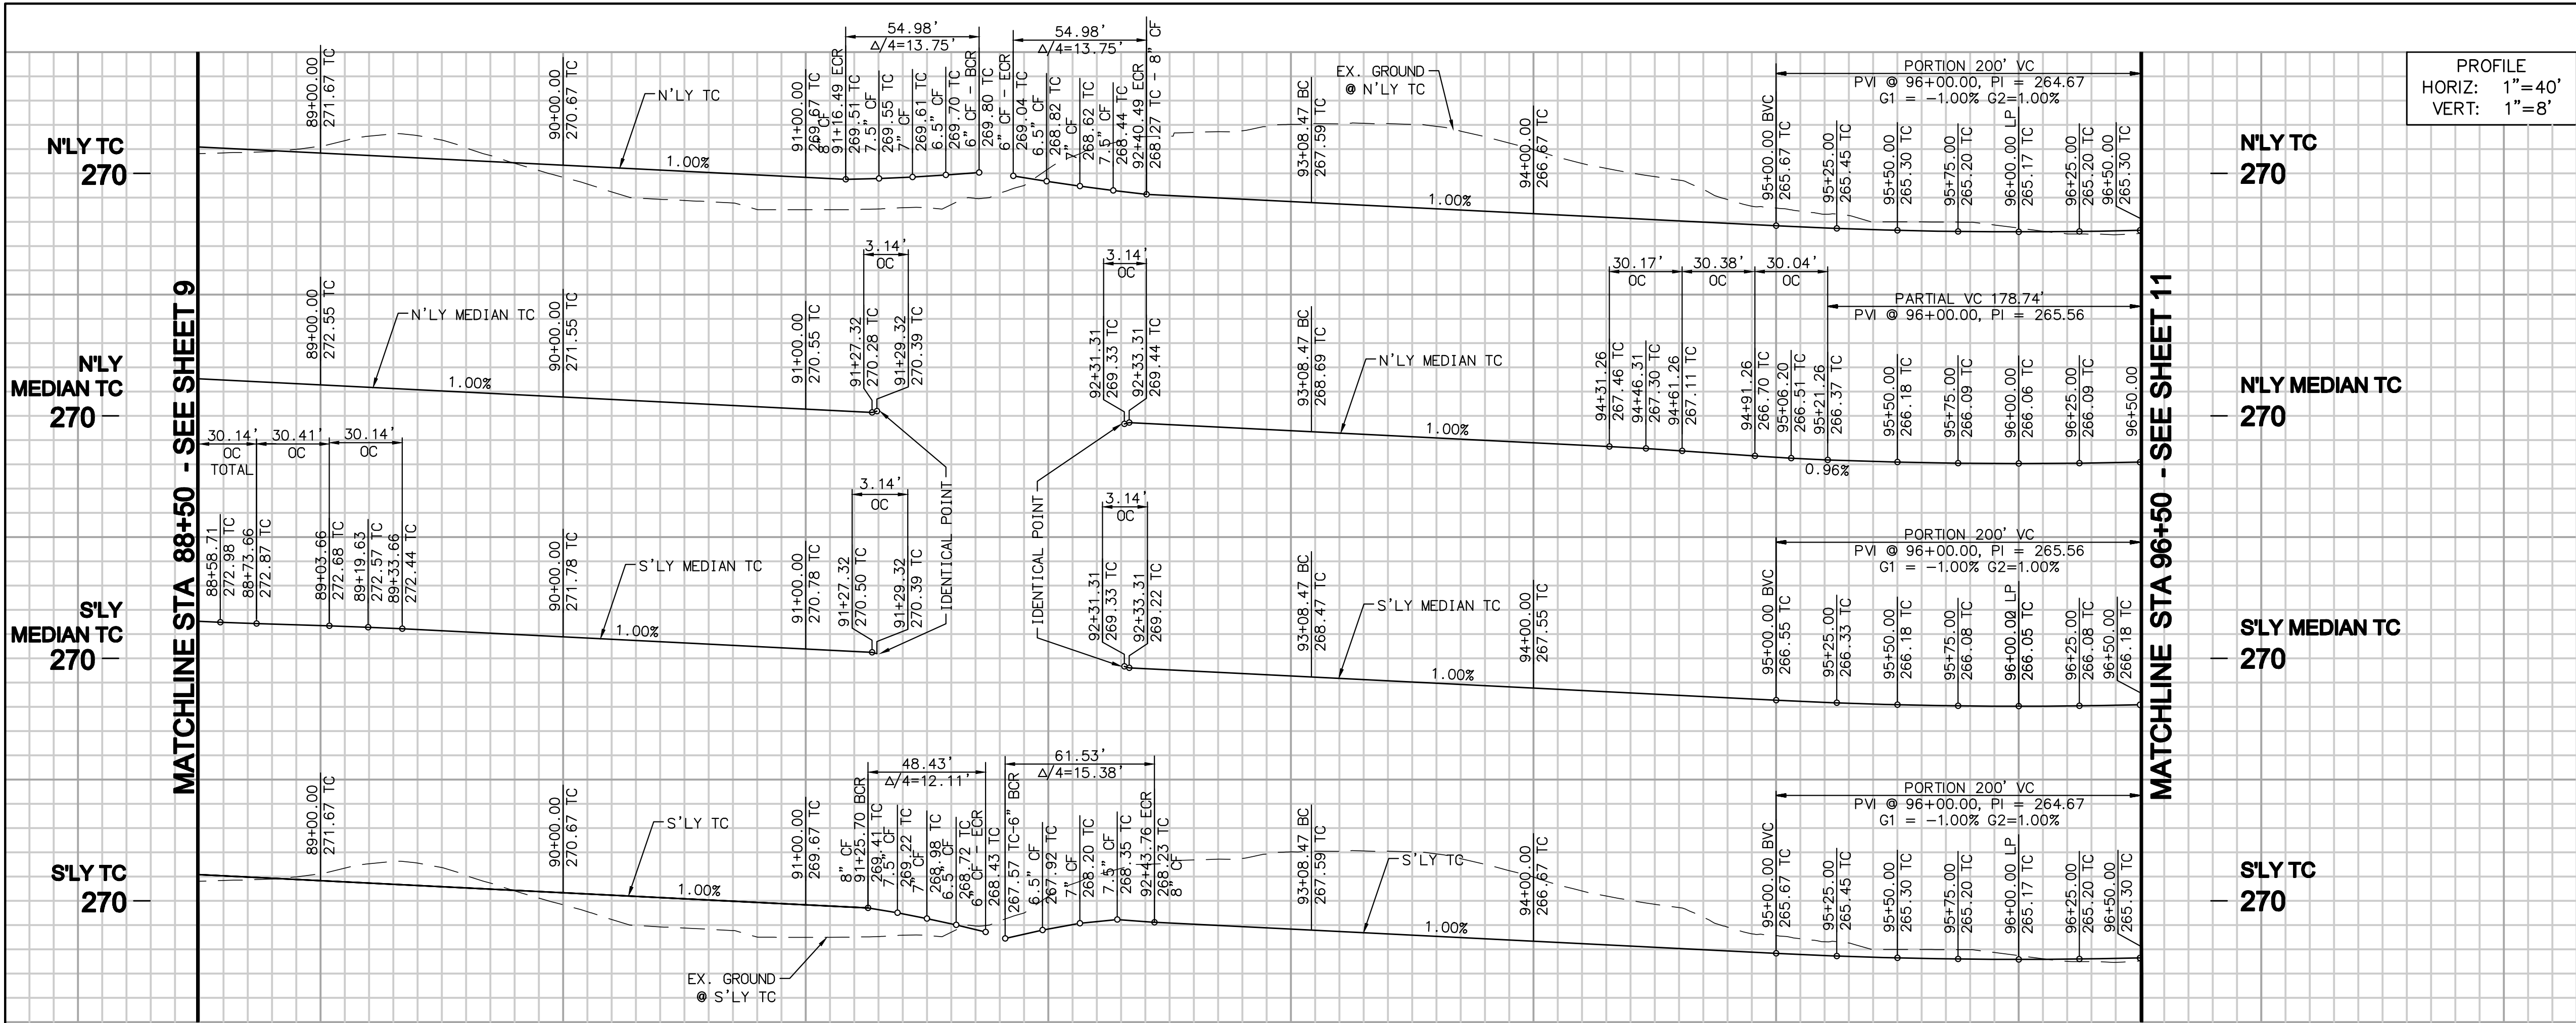

PROFILE
HORIZ: 1"=40'
VERT: 1"=8'

CENTERLINE PROFILE DATA

PVI STA	PVI ELEV	GRADE	VC LENGTH
85+50.00	275.54	-1.00%	200'
96+00.00	265.04	1.00%	200'
111+91.64	280.96		

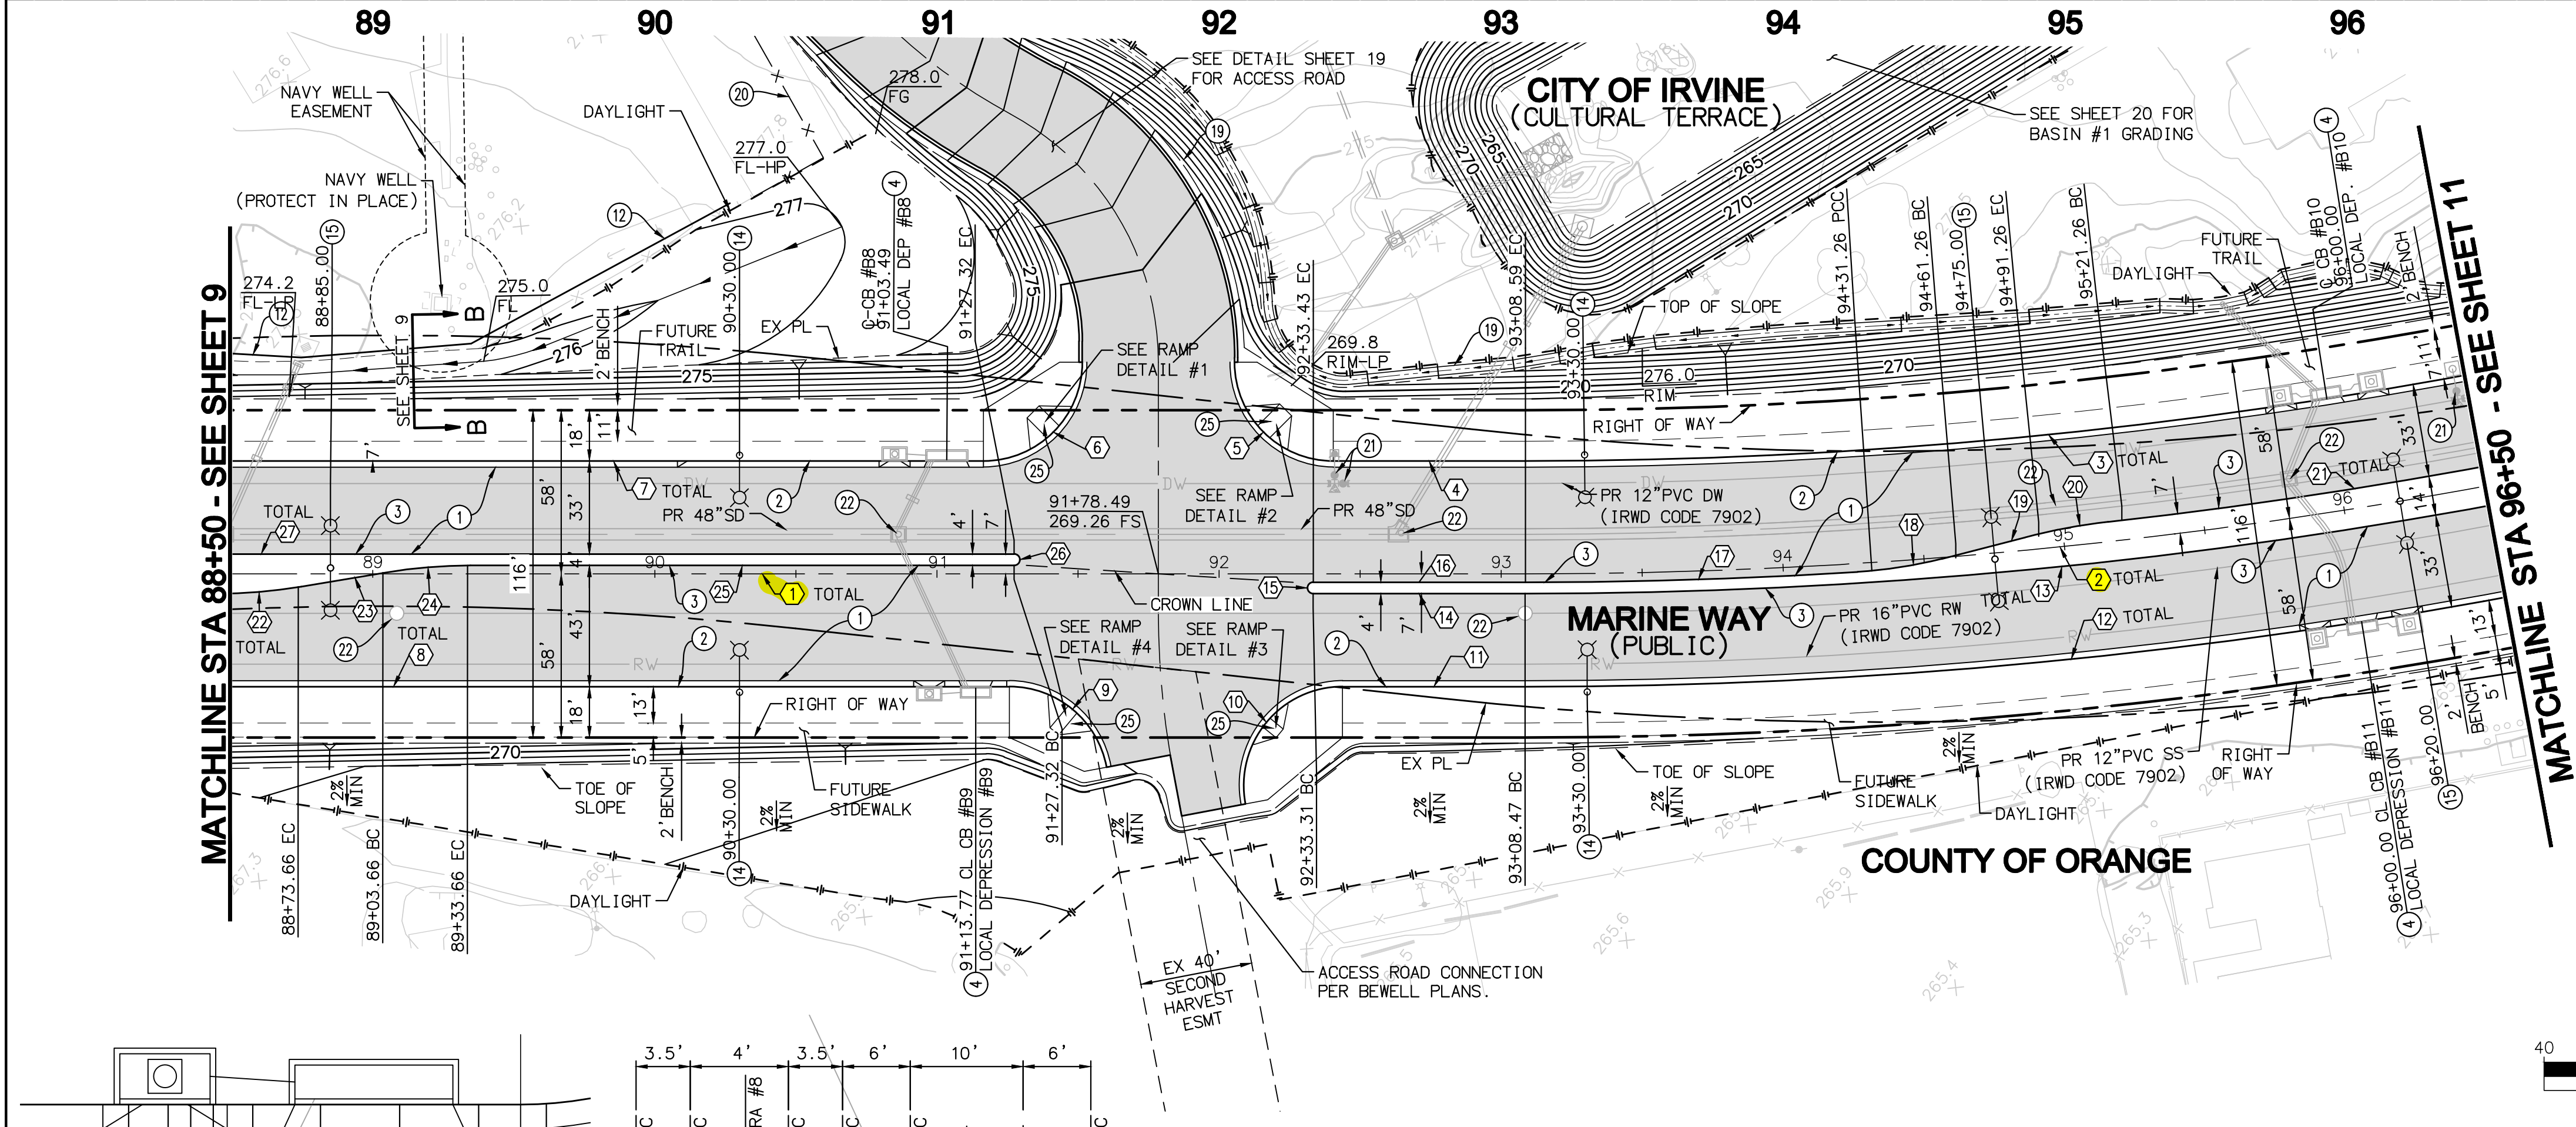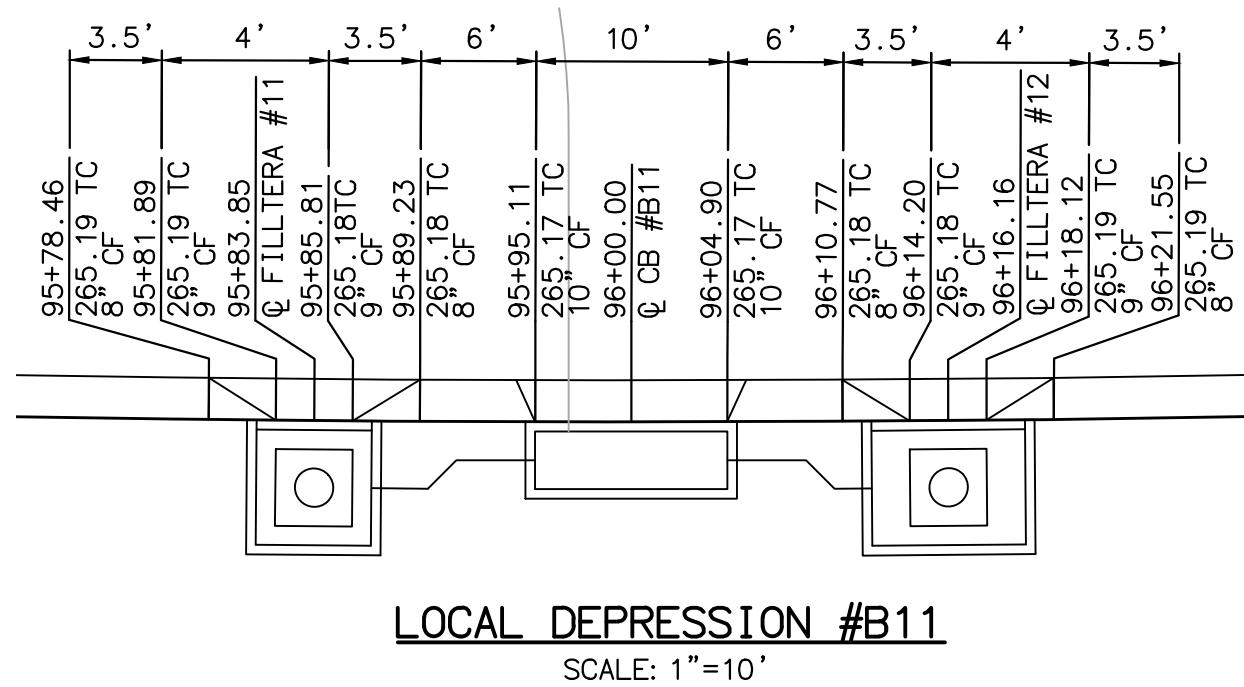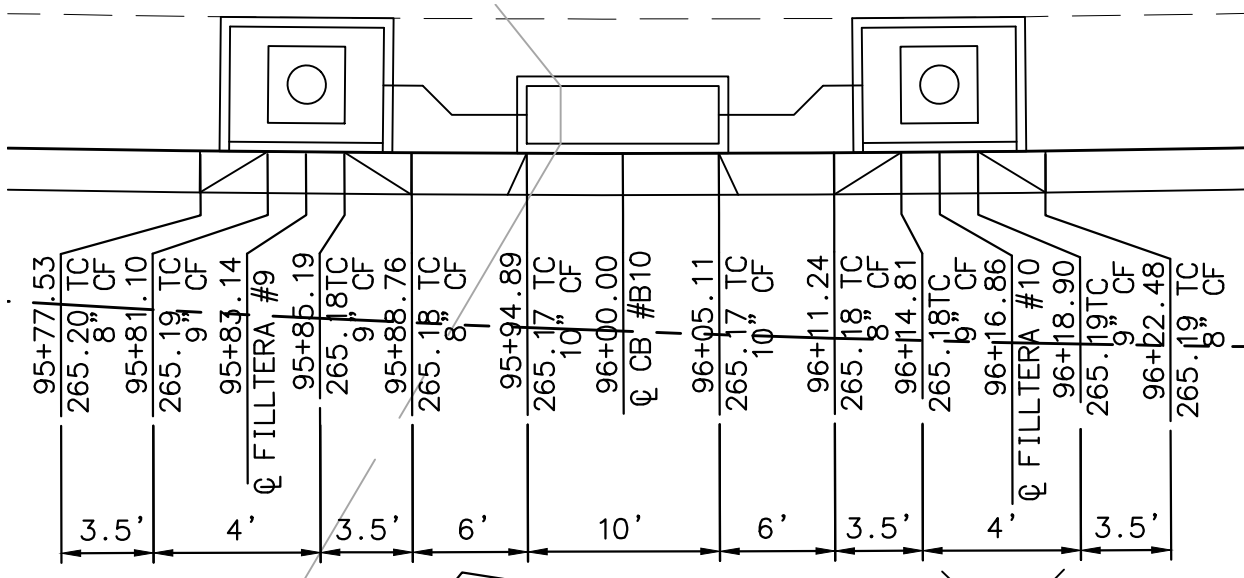

STREET CONSTRUCTION NOTES

- CONSTRUCT 2" ARHM OVER 4.5" AC OVER 19.5" OMB STRUCTURAL SECTION TO BE VERIFIED BY PROJECT SOILS ENGINEER DURING GRADING AND WITH APPROVAL OF THE CITY ENGINEER
- CONSTRUCT CONCRETE CURB AND GUTTER PER CITY OF IRVINE STD. PLAN NO. 200, TYPE A-2
- CONSTRUCT CONCRETE CURB PER CITY OF IRVINE STD. PLAN NO. 200, TYPE B-8
- CONSTRUCT LOCAL DEPRESSION PER CITY OF IRVINE STD. PLAN NO. 303
- CONSTRUCT 8" AC CURB D1-8 PER SPWPC STD. PLAN 120-2 (SEE SHEET 23)
- SINGLE ARM STREET LIGHT PER CITY OF IRVINE STD. PLAN 215 AND DETAIL SHEET 2, TO BE INSTALLED BY SCE
- DOUBLE ARM STREET LIGHT PER CITY OF IRVINE STD. PLAN 215 AND DETAIL SHEET 2, TO BE INSTALLED BY SCE
- CONSTRUCT 3' WIDE CONCRETE V-DITCH PER DETAIL ON SHEET 3
- INSTALL CHAIN LINK FENCE AND GATE PER SPWPC STD PLAN 600-3 (SEE SHEET 23)
- RAISE TO GRADE EXISTING WATER VALVE CAN
- RAISE TO MANHOLE TO GRADE
- CONSTRUCT ACCESS RAMP PER CITY OF IRVINE STD PLAN 202 AND DETAIL SHEET 22

LINE/CURVE DATA TABLE				
NO	BEARING/DELTA	RADIUS	LENGTH	TANGENT
1	N38°37'12"W	---	540.70'	---
2	11°34'28"	1880.00'	379.78'	190.54'
3	11°34'28"	1840.00'	371.70'	186.49'
4	N38°37'12"W	---	67.98'	---
5	90°00'00"	35.00'	54.98'	35.00'
6	90°00'00"	35.00'	54.98'	35.00'
7	N38°37'12"W	---	348.72'	---
8	N38°37'12"W	---	357.93'	---
9	79°16'51"	35.00'	48.43'	29.00'
10	100°43'09"	35.00'	61.53'	42.25'
11	N38°37'12"W	---	64.71'	---
12	11°34'28"	1920.00'	387.86'	194.59'
13	11°34'28"	1887.00'	381.20'	191.25'
14	N38°37'12"W	---	75.16'	---
15	180°00'00"	2.00'	6.28'	---
16	N38°37'12"W	---	75.16'	---
17	03°35'24"	1883.00'	117.98'	59.01'
18	10°23'18"	166.41'	30.17'	15.13'
19	N53°12'21"W	---	30.38'	---
20	08°35'16"	200.42'	30.04'	15.05'
21	05°14'30"	1873.00'	171.35'	85.73'
22	09°28'25"	182.27'	30.14'	15.10'
23	N48°04'57"W	---	30.41'	---
24	09°28'41"	182.19'	30.14'	15.10'
25	N38°37'12"W	---	192.64'	---
26	180°00'00"	2.00'	6.28'	---
27	N38°37'12"W	---	359.55'	---

SEE SHEET 15 FOR SD IMPROVEMENTS


PLAN PREPARED BY:
PROACTIVE
ENGINEERING CONSULTANTS
27042 Towne Centre Drive, Suite 110
Foothill Ranch, CA 92610 (949) 716-7460

CONSTRUCTION PLANS FOR THE IMPROVEMENT OF
MARINE WAY
STREET PLAN AND PROFILE
FROM STA 88+50.00 TO 96+50.00

CITY OF IRVINE
PUBLIC WORKS DEPARTMENT



PLAN CHECK NO.
00760917-EMC
PERMIT NO.
00766614-MCE


PROJECT NO.
20.059
SHEET
10
OF **28**

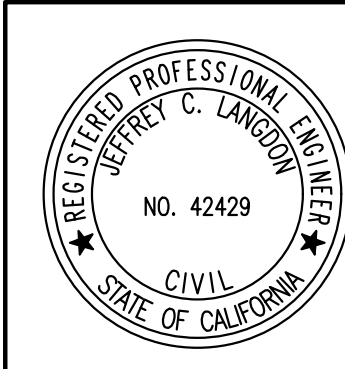



NO.	DATE	REVISIONS	ENGR.	APPROV.	DATE
7					
6					
5					
4					
3					
2					
1					

DRAWN BY: SR DATE 4/18
DESIGNED BY: JCL DATE 4/18
CHECKED BY: JCL DATE 4/18

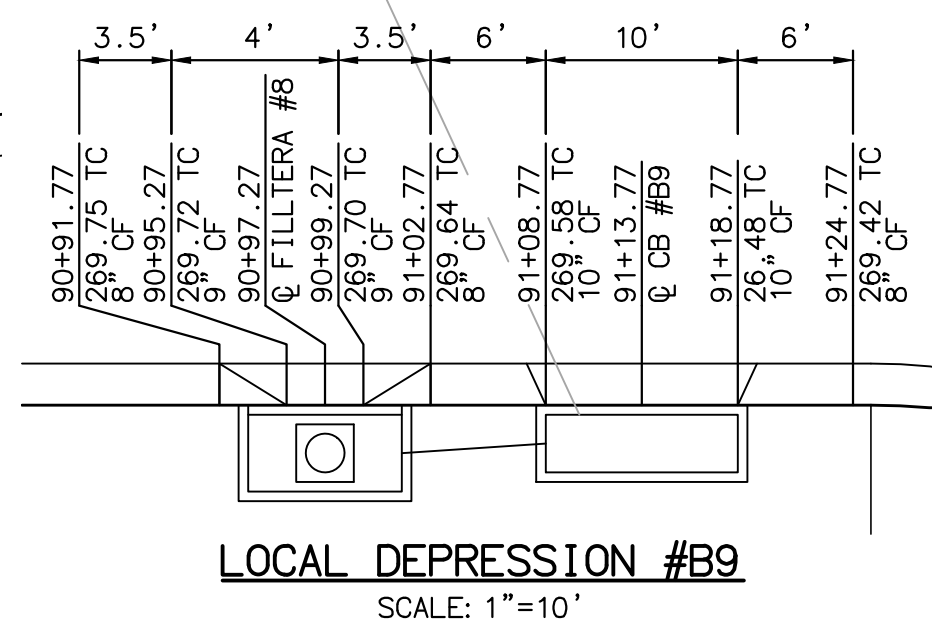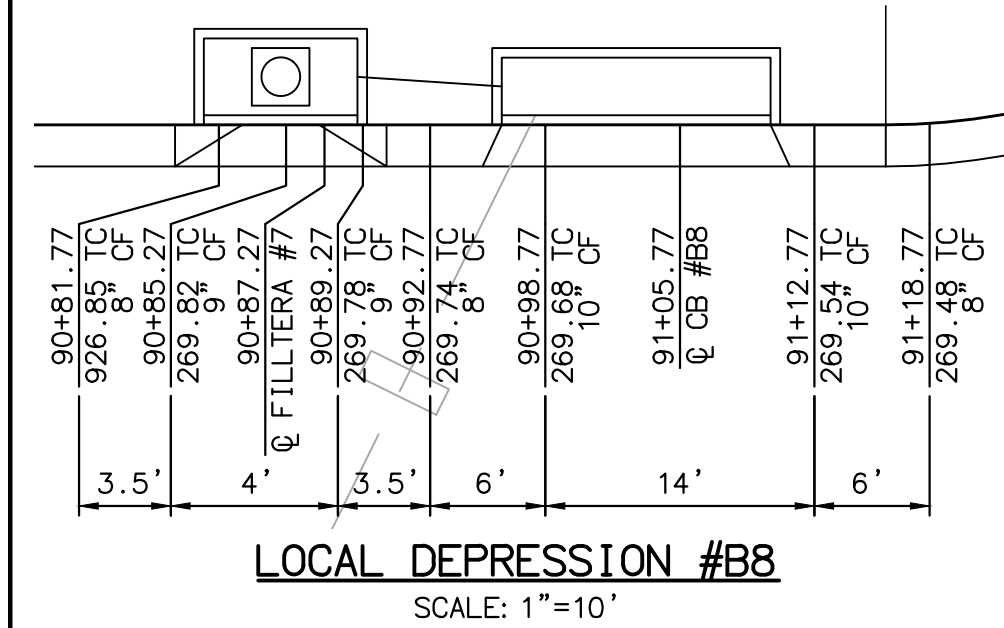

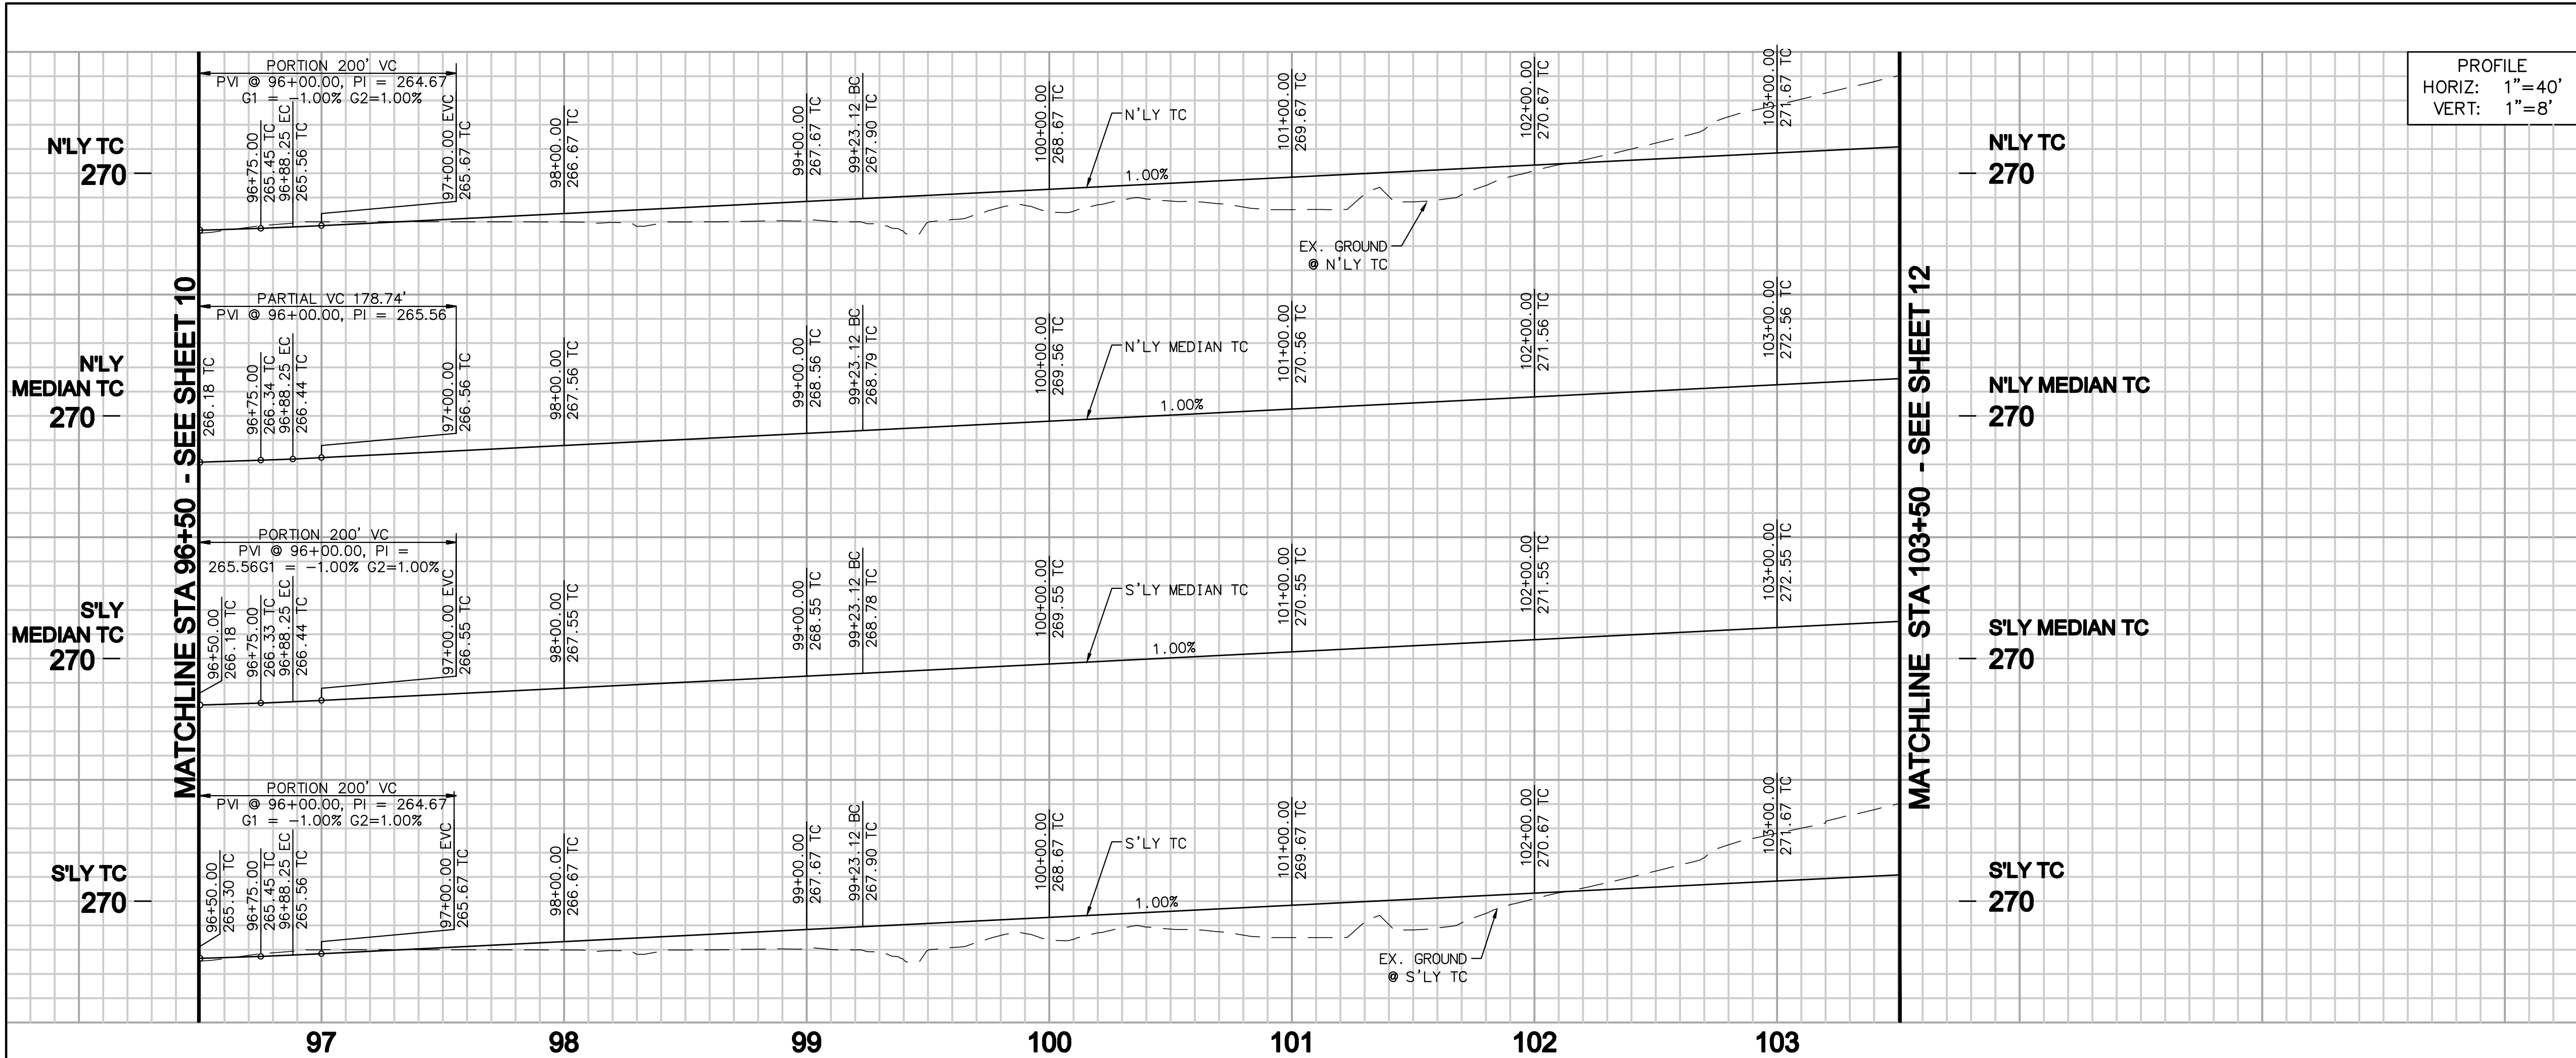

CENTERLINE PROFILE DATA			
PVI STA	PVI ELEV	GRADE	VC LENGTH
96+00.00	265.04	1.00%	200'
111+91.64	280.96		

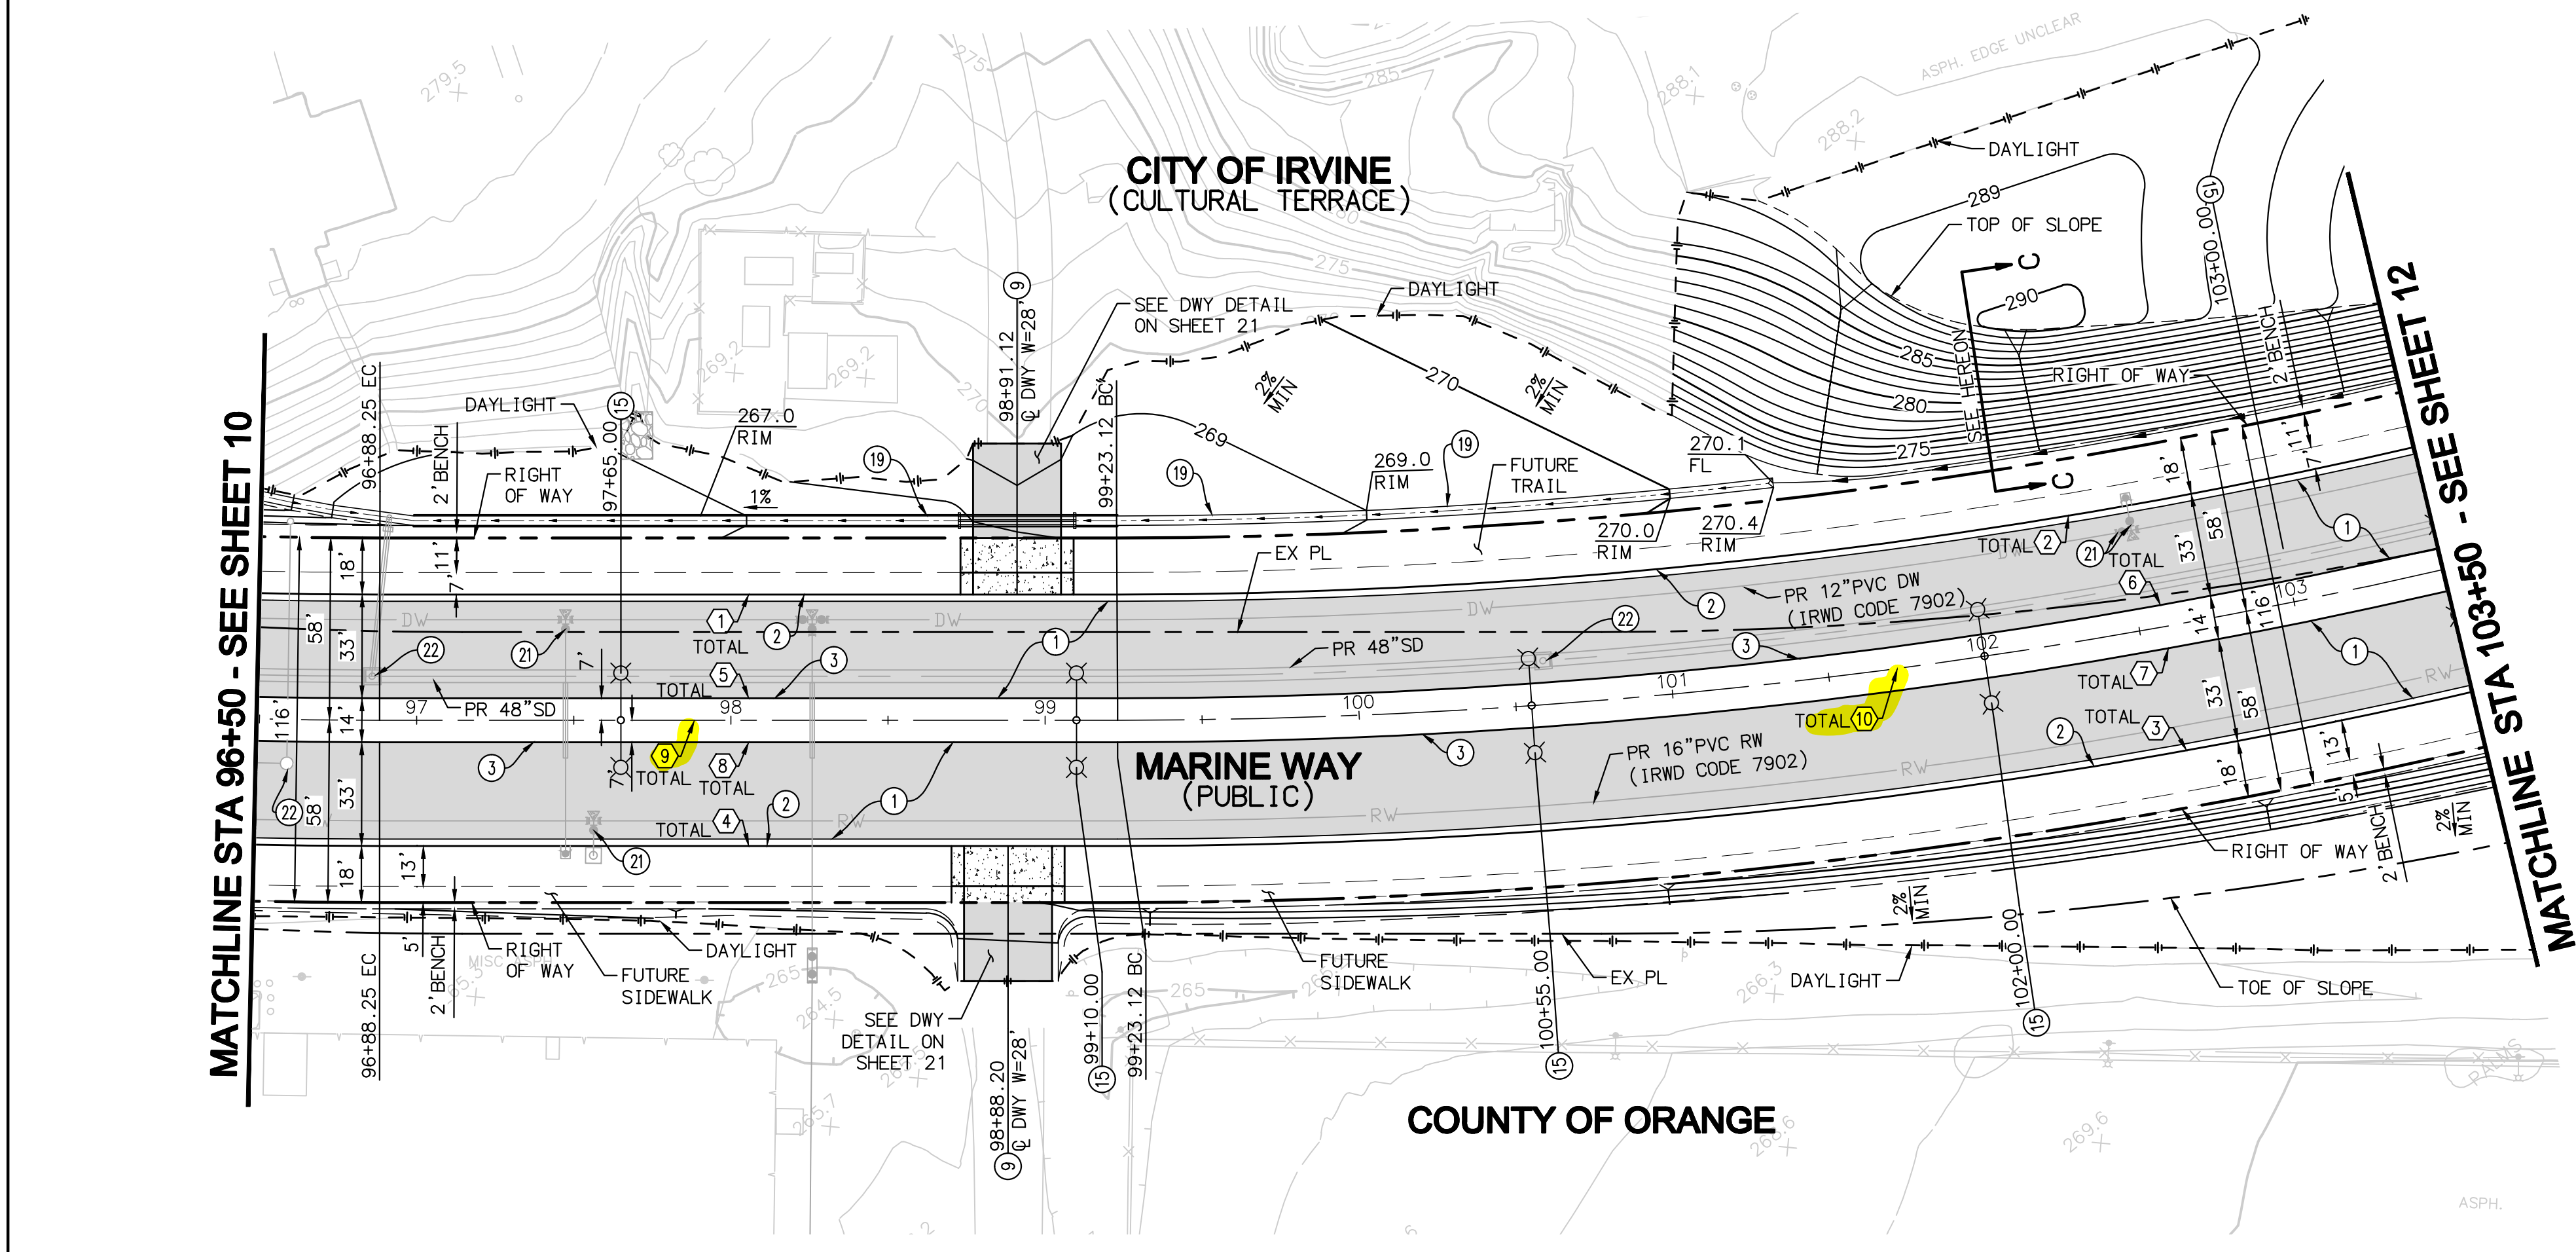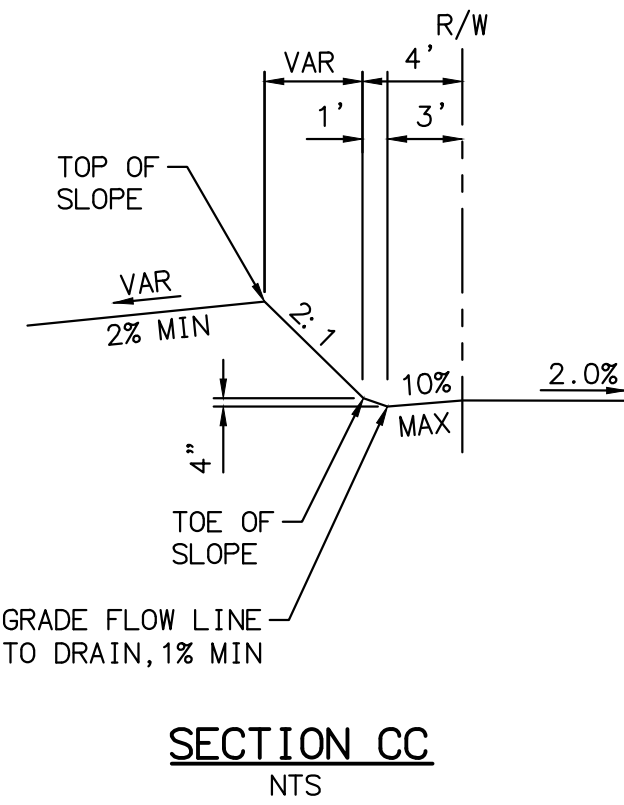

STREET CONSTRUCTION NOTES

- CONSTRUCT 2" ARHM OVER 4.5" AC OVER 19.5" CMB STRUCTURAL SECTION TO BE VERIFIED BY PROJECT SOILS ENGINEER DURING GRADING AND WITH APPROVAL OF THE CITY ENGINEER
- CONSTRUCT CONCRETE CURB AND GUTTER PER CITY OF IRVINE STD. PLAN NO. 200, TYPE A-2
- CONSTRUCT CONCRETE CURB PER CITY OF IRVINE STD. PLAN NO. 200, TYPE B-8
- CONSTRUCT DRIVEWAY TYPE I PER CITY OF IRVINE STD. PLAN NO. 204 (WIDTH PER PLAN) X=4'
- DOUBLE ARM STREET LIGHT PER CITY OF IRVINE STD. PLAN 215 AND DETAIL SHEET 2, TO BE INSTALLED BY SCE
- CONSTRUCT 3' WIDE CONCRETE V-DITCH PER DETAIL ON SHEET 3
- RAISE TO GRADE EXISTING WATER VALVE CAN
- RAISE TO MANHOLE TO GRADE


LINE/CURVE DATA TABLE				
NO	BEARING/DELTA	RADIUS	LENGTH	TANGENT
1	N50°11'40"W	---	234.87'	---
2	36°01'54"	1840.00'	1157.12'	598.41'
3	36°01'54"	1920.00'	1207.43'	624.43'
4	N50°11'40"W	---	234.87'	---
5	N50°11'40"W	---	234.87'	---
6	36°01'54"	1873.00'	1177.88'	609.15'
7	36°01'54"	1887.00'	1186.68'	613.70'
8	N50°11'40"W	---	234.87'	---
9	N50°11'40"W	---	234.87'	---
10	36°01'54"	1880.00'	1182.28'	611.42'

CITY OF IRVINE
(CULTURAL TERRACE)

MARINE WAY
(PUBLIC)

COUNTY OF ORANGE

SEE SHEET 16 FOR SD IMPROVEMENTS

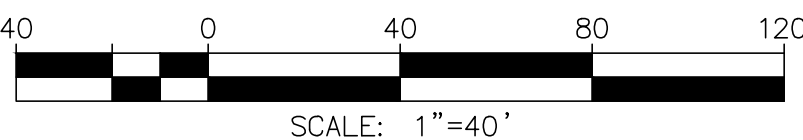

7						
6						
5						
4						
3						
2						
1						
NO.	DATE	REVISIONS	ENGR.	APPROV.	DATE	

DRAWN BY: SR	DATE 4/18
DESIGNED BY: JCL	DATE 4/18
CHECKED BY: JCL	DATE 4/18

PLAN PREPARED BY:
PROACTIVE
ENGINEERING CONSULTANTS
27842 Towne Centre Drive, Suite 110
Foothill Ranch, CA 92610 (949) 716-7460


JEFFREY C. LANGDON R.C.E. 42429 DATE

CONSTRUCTION PLANS FOR THE IMPROVEMENT OF
MARINE WAY
STREET PLAN AND PROFILE
FROM STA 96+50.00 TO 103+50.00

CITY OF IRVINE
PUBLIC WORKS DEPARTMENT


PLAN CHECK NO.
00760917-EMC
PERMIT NO.
00766614-MCE

PROJECT NO.
20.059
SHEET
11
OF 28

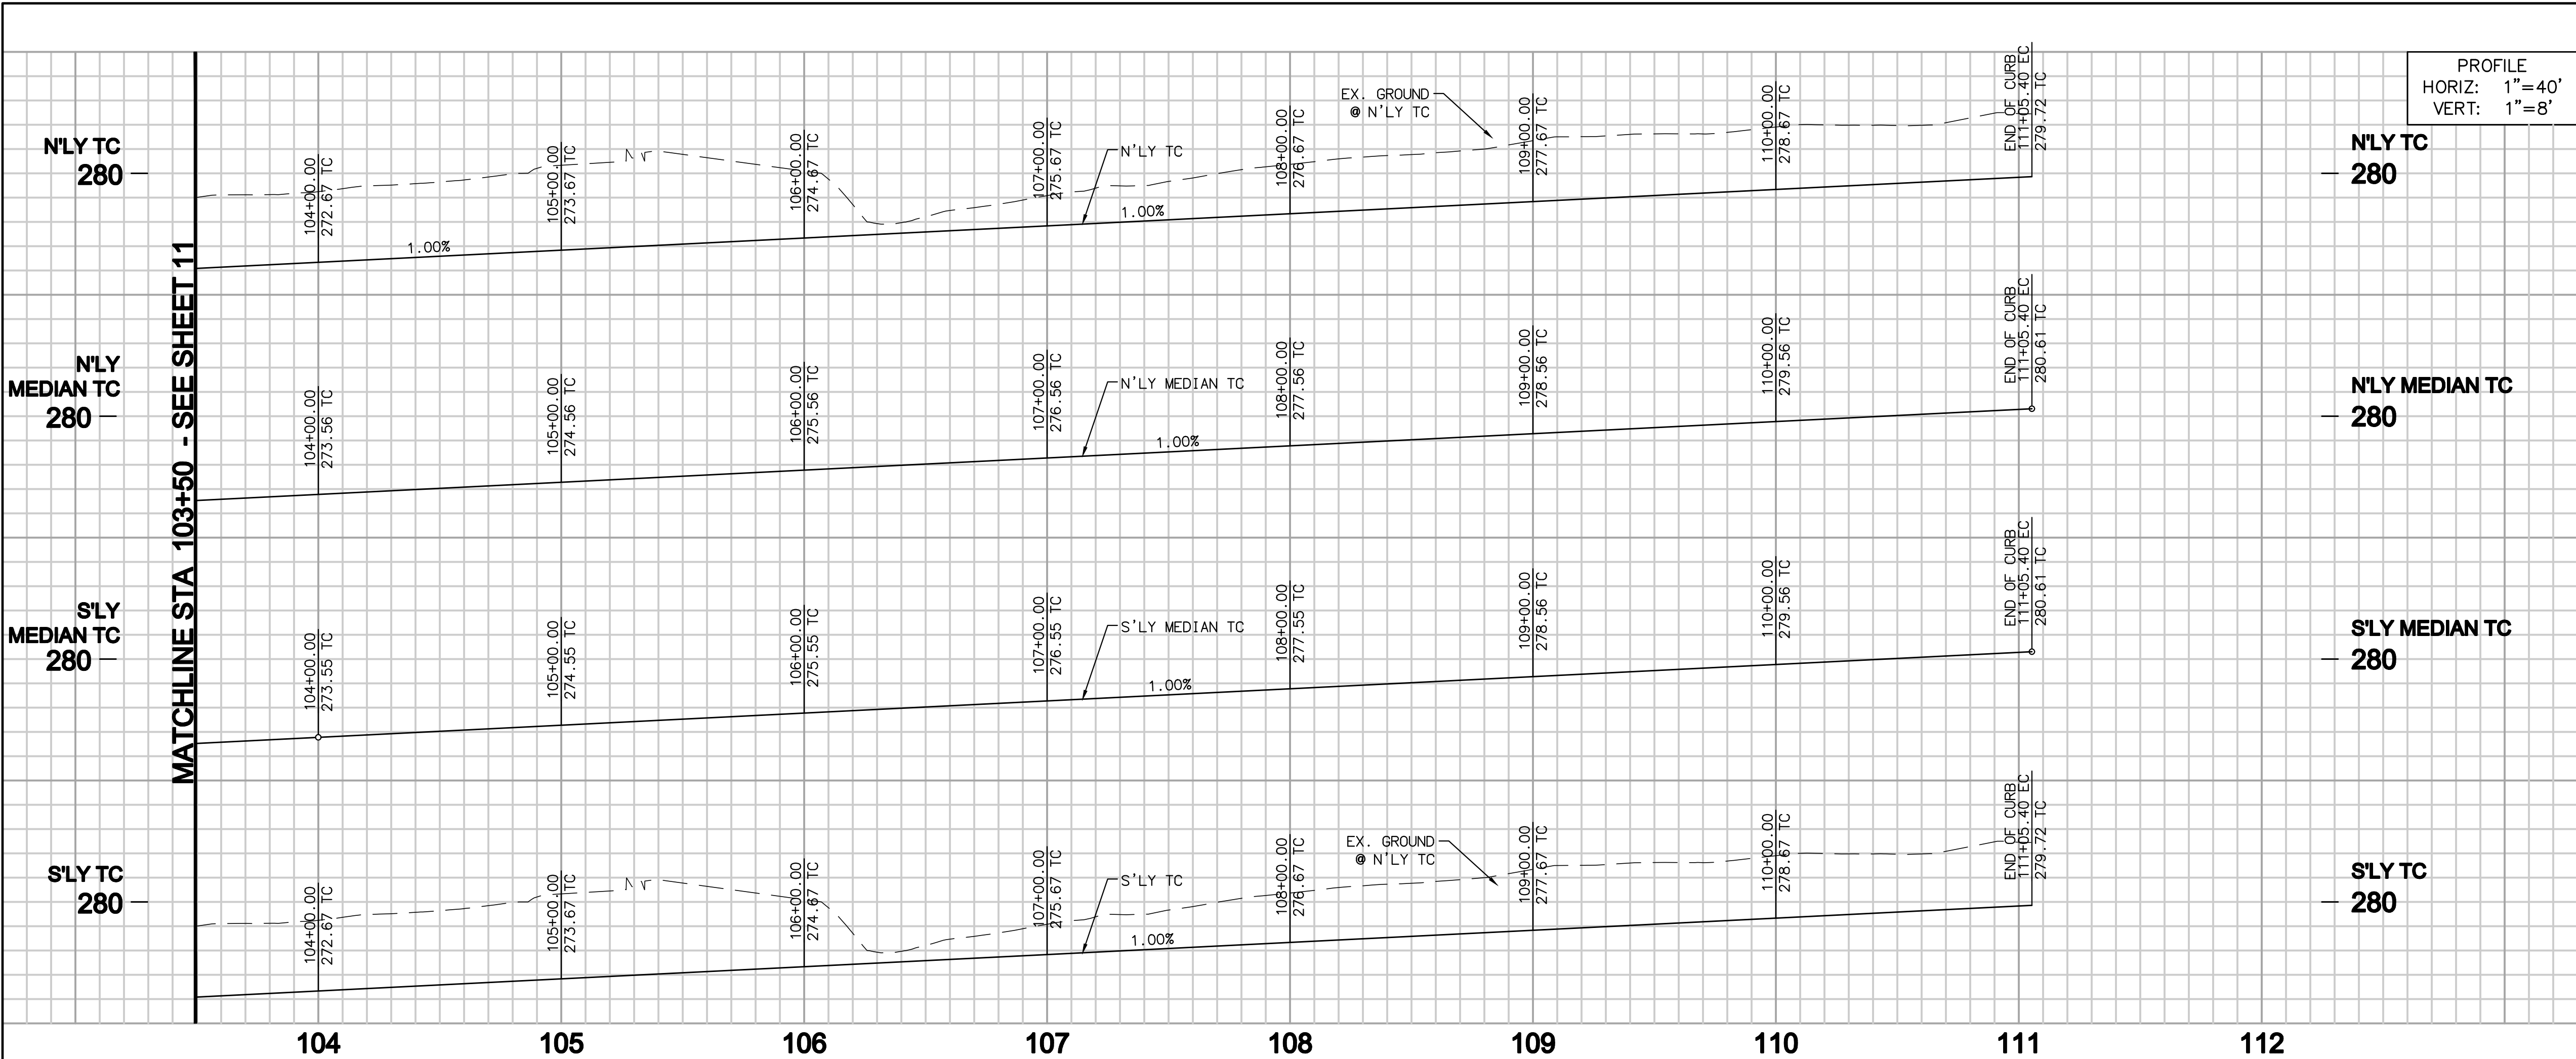


CENTERLINE PROFILE DATA

PVI STA	PVI ELEV	GRADE	VC LENGTH
96+00.00	265.04	1.00%	200'
114+00.00	283.04		

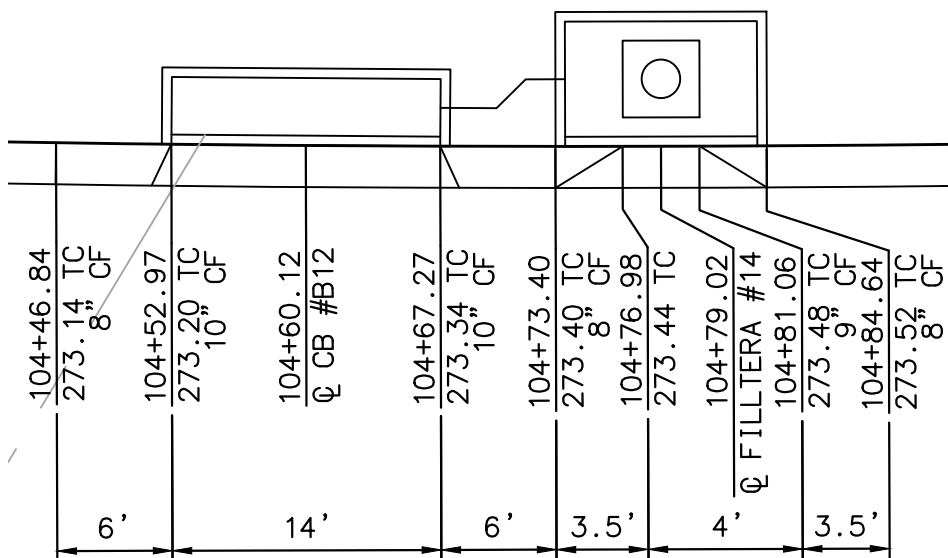

LOCAL DEPRESSION #B12
SCALE: 1"=10'

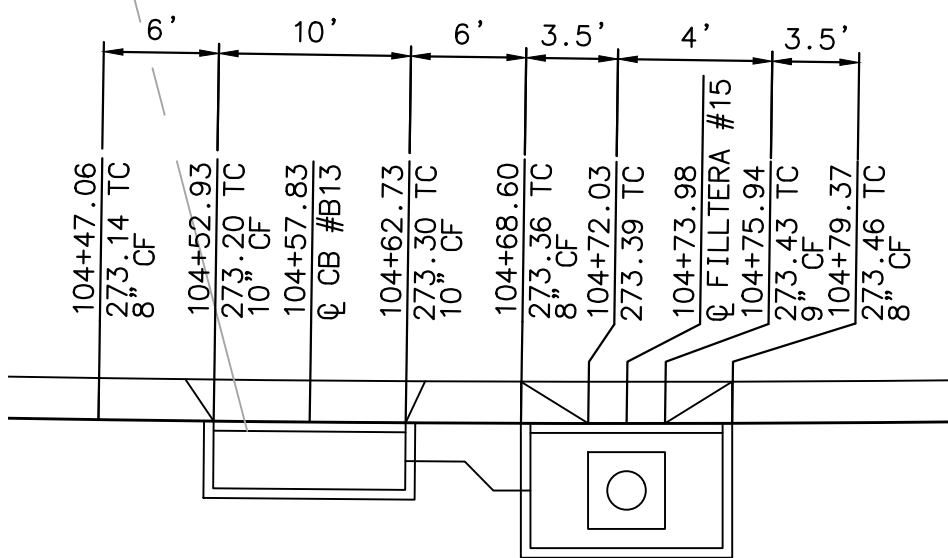


LOCAL DEPRESSION #B13
SCALE: 1"=10'

STREET CONSTRUCTION NOTES


- CONSTRUCT 2" ARHM OVER 4.5" AC OVER 19.5" CMB STRUCTURAL SECTION TO BE VERIFIED BY PROJECT SOILS ENGINEER DURING GRADING AND WITH APPROVAL OF THE CITY ENGINEER
- CONSTRUCT CONCRETE CURB AND GUTTER PER CITY OF IRVINE STD. PLAN NO. 200, TYPE A-2
- CONSTRUCT CONCRETE CURB PER CITY OF IRVINE STD. PLAN NO. 200, TYPE B-8
- CONSTRUCT LOCAL DEPRESSION PER CITY OF IRVINE STD. PLAN NO. 303
- INSTALL WOOD HEADER PER DETAIL ON SHEET 9
- CONSTRUCT DRIVEWAY TYPE 11 PER CITY OF IRVINE STD. PLAN NO. 205 (WIDTH PER PLAN)
- CONSTRUCT DEAD END SIGNING PER CITY OF IRVINE STD. PLAN NO. 400 & 401
- DOUBLE ARM STREET LIGHT PER CITY OF IRVINE STD. PLAN 215 AND DETAIL SHEET 2, TO BE INSTALLED BY SCE
- CONSTRUCT 3' WIDE CONCRETE V-DITCH PER DETAIL ON SHEET 3
- RAISE TO GRADE EXISTING WATER VALVE CAN
- RAISE TO MANHOLE TO GRADE
- INSTALL 8" CMB OVER COMPACTED NATIVE PER SOIL ENGINEER

LINE/CURVE DATA TABLE

NO	BEARING/DELTA	RADIUS	LENGTH	TANGENT
1	36°01'54"	1880.00'	1182.28'	611.42'
2	36°01'54"	1840.00'	1157.12'	598.41'
3	36°01'54"	1873.00'	1177.88'	609.15'
4	36°01'54"	1887.00'	1186.68'	613.70'
5	36°01'54"	1920.00'	1207.43'	624.43'

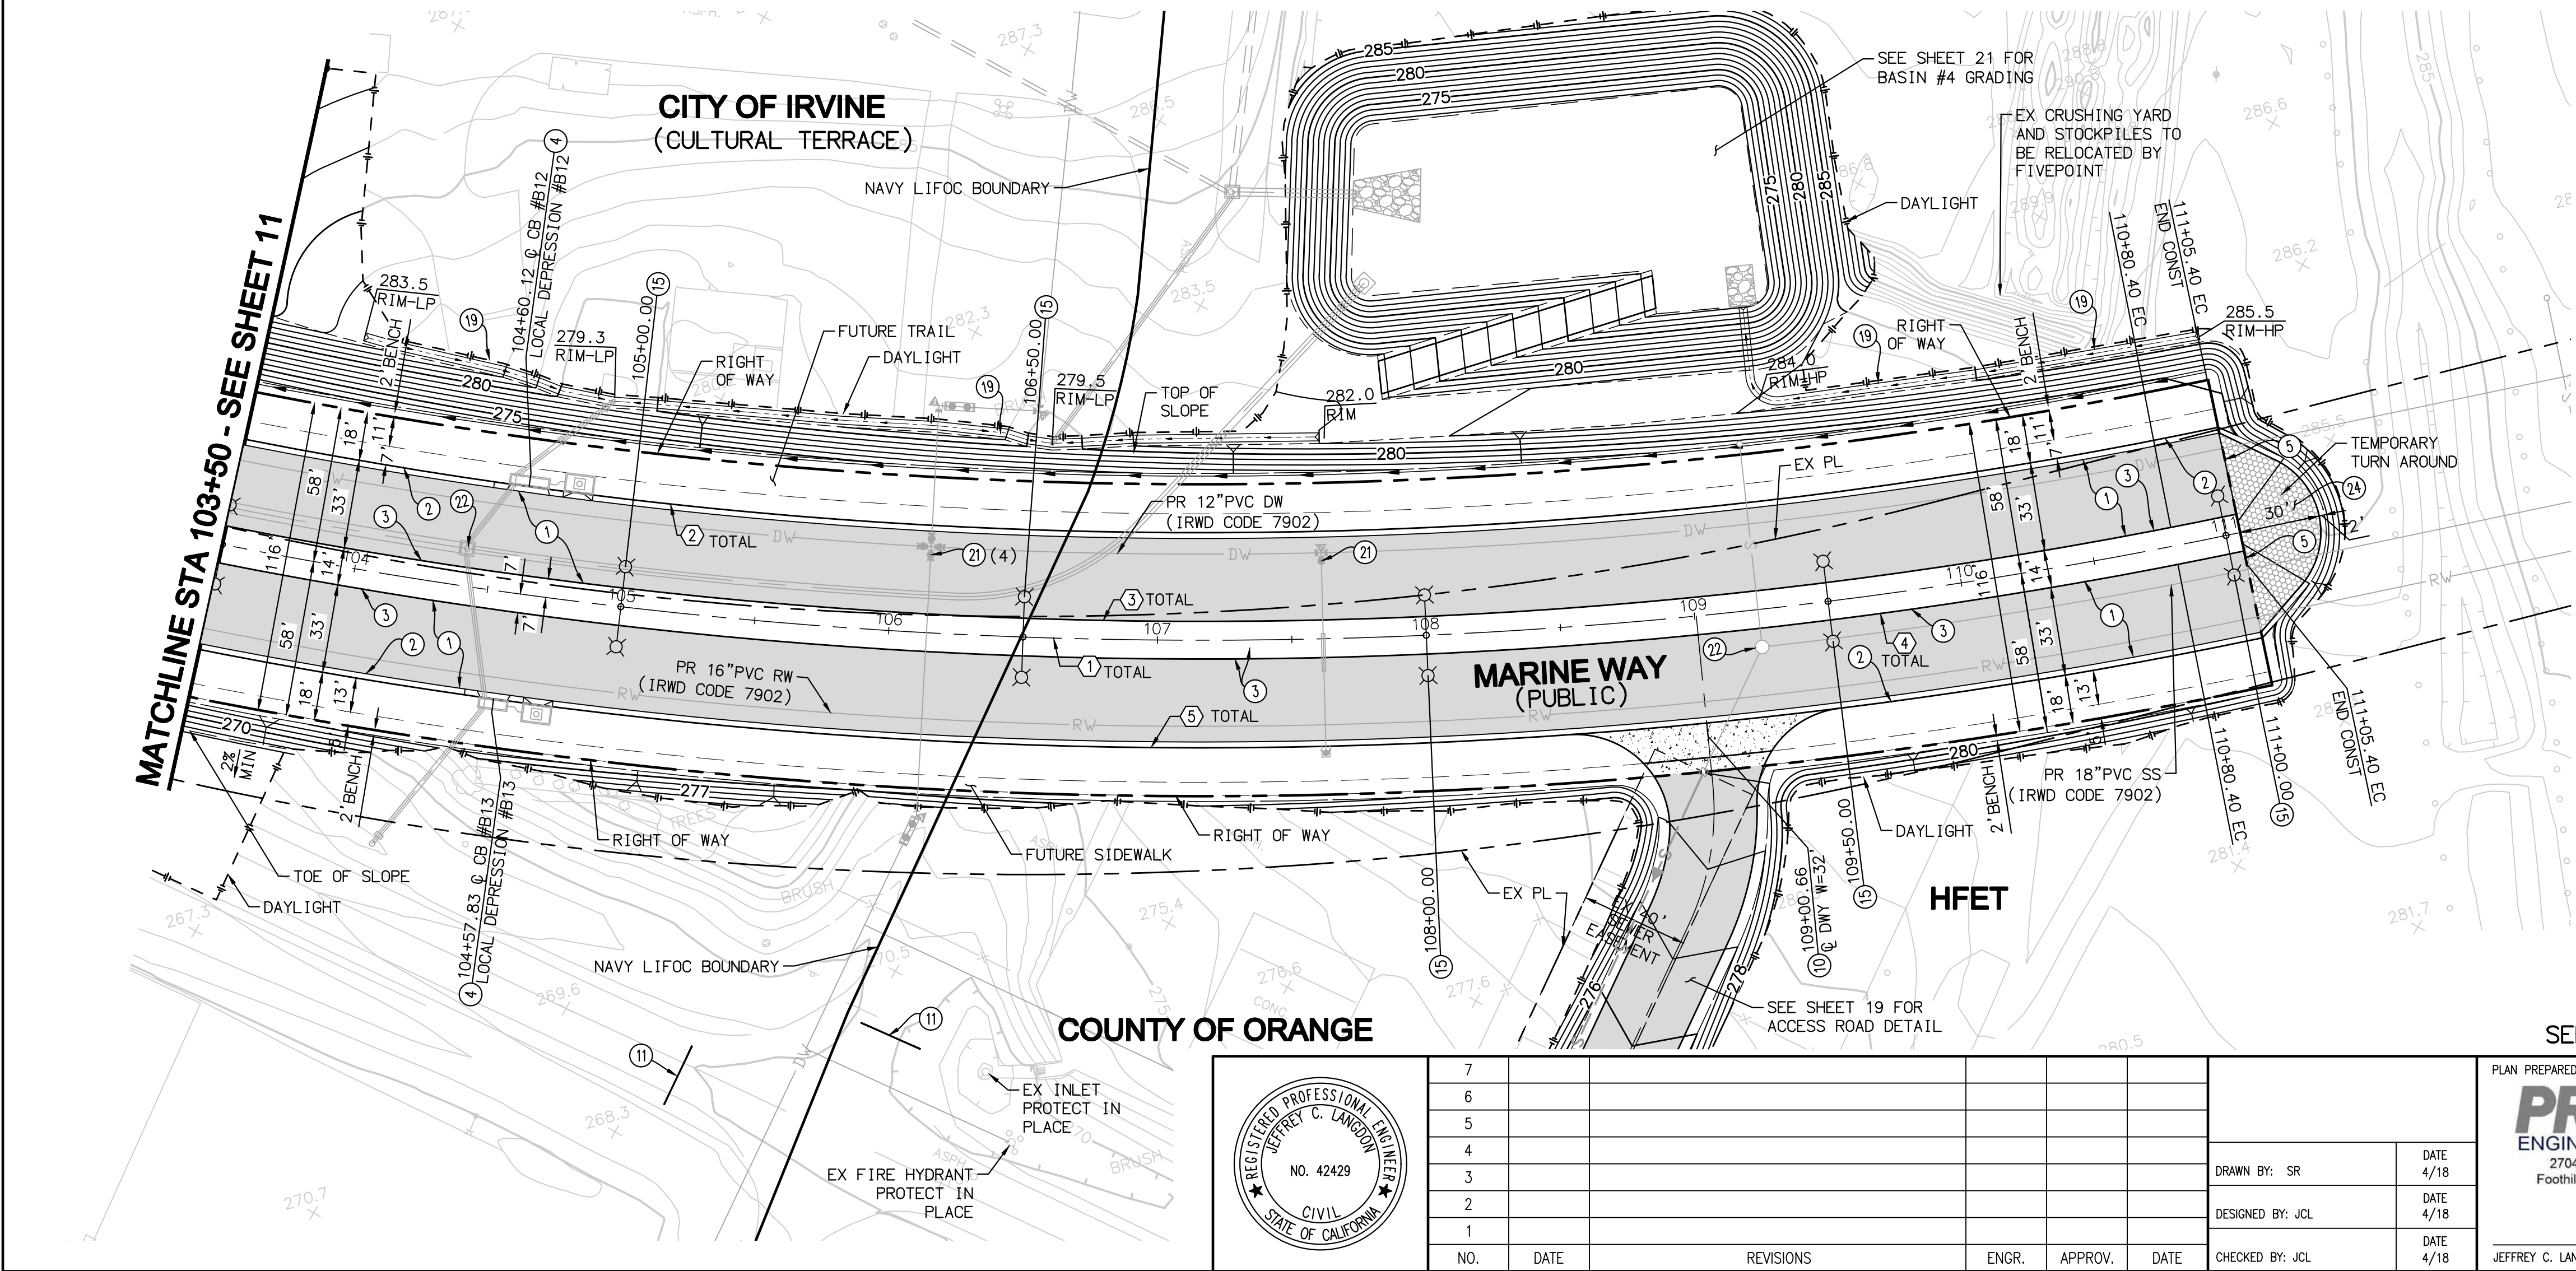

SEE SHEET 17 FOR SD IMPROVEMENTS

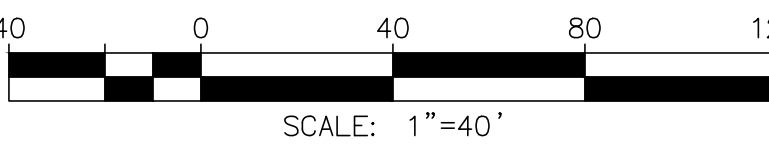

NO.	DATE	REVISIONS	ENGR.	APPROV.	DATE
7					
6					
5					
4					
3					
2					
1					

DRAWN BY: SR	DATE: 4/18
DESIGNED BY: JCL	DATE: 4/18
CHECKED BY: JCL	DATE: 4/18

PLAN PREPARED BY:
PROACTIVE
ENGINEERING CONSULTANTS
27842 Towne Centre Drive, Suite 110
Foothill Ranch, CA 92610 (949) 716-7460



JEFFREY C. LANGDON R.C.E. 42429 DATE

CONSTRUCTION PLANS FOR THE IMPROVEMENT OF
MARINE WAY
STREET PLAN AND PROFILE
FROM STA 103+50.00 TO 111+50.00

CITY OF IRVINE
PUBLIC WORKS DEPARTMENT

PLAN CHECK NO.
00760917-EMC
PERMIT NO.
00766614-MCE

PROJECT NO.
20.059
SHEET
12
OF 28

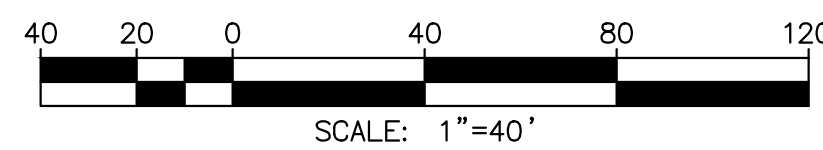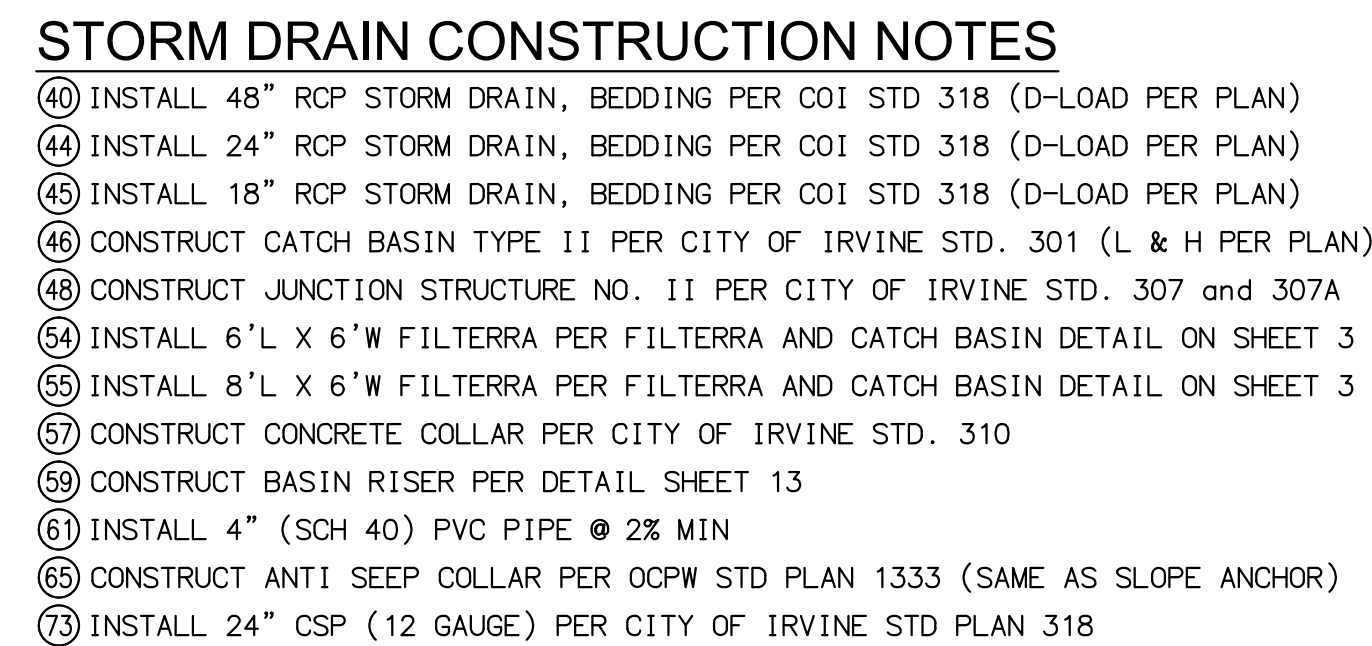

DRAWN BY: SR	DATE 4/18
DESIGNED BY: JCL	DATE 4/18
CHECKED BY: JCL	DATE 4/18



JEFFREY C. LANGDON R.C.E. 42429

CITY OF IRVINE
PUBLIC WORKS DEPARTMENT

PROJECT NO.
20.059


SHEET
14

OF **28**

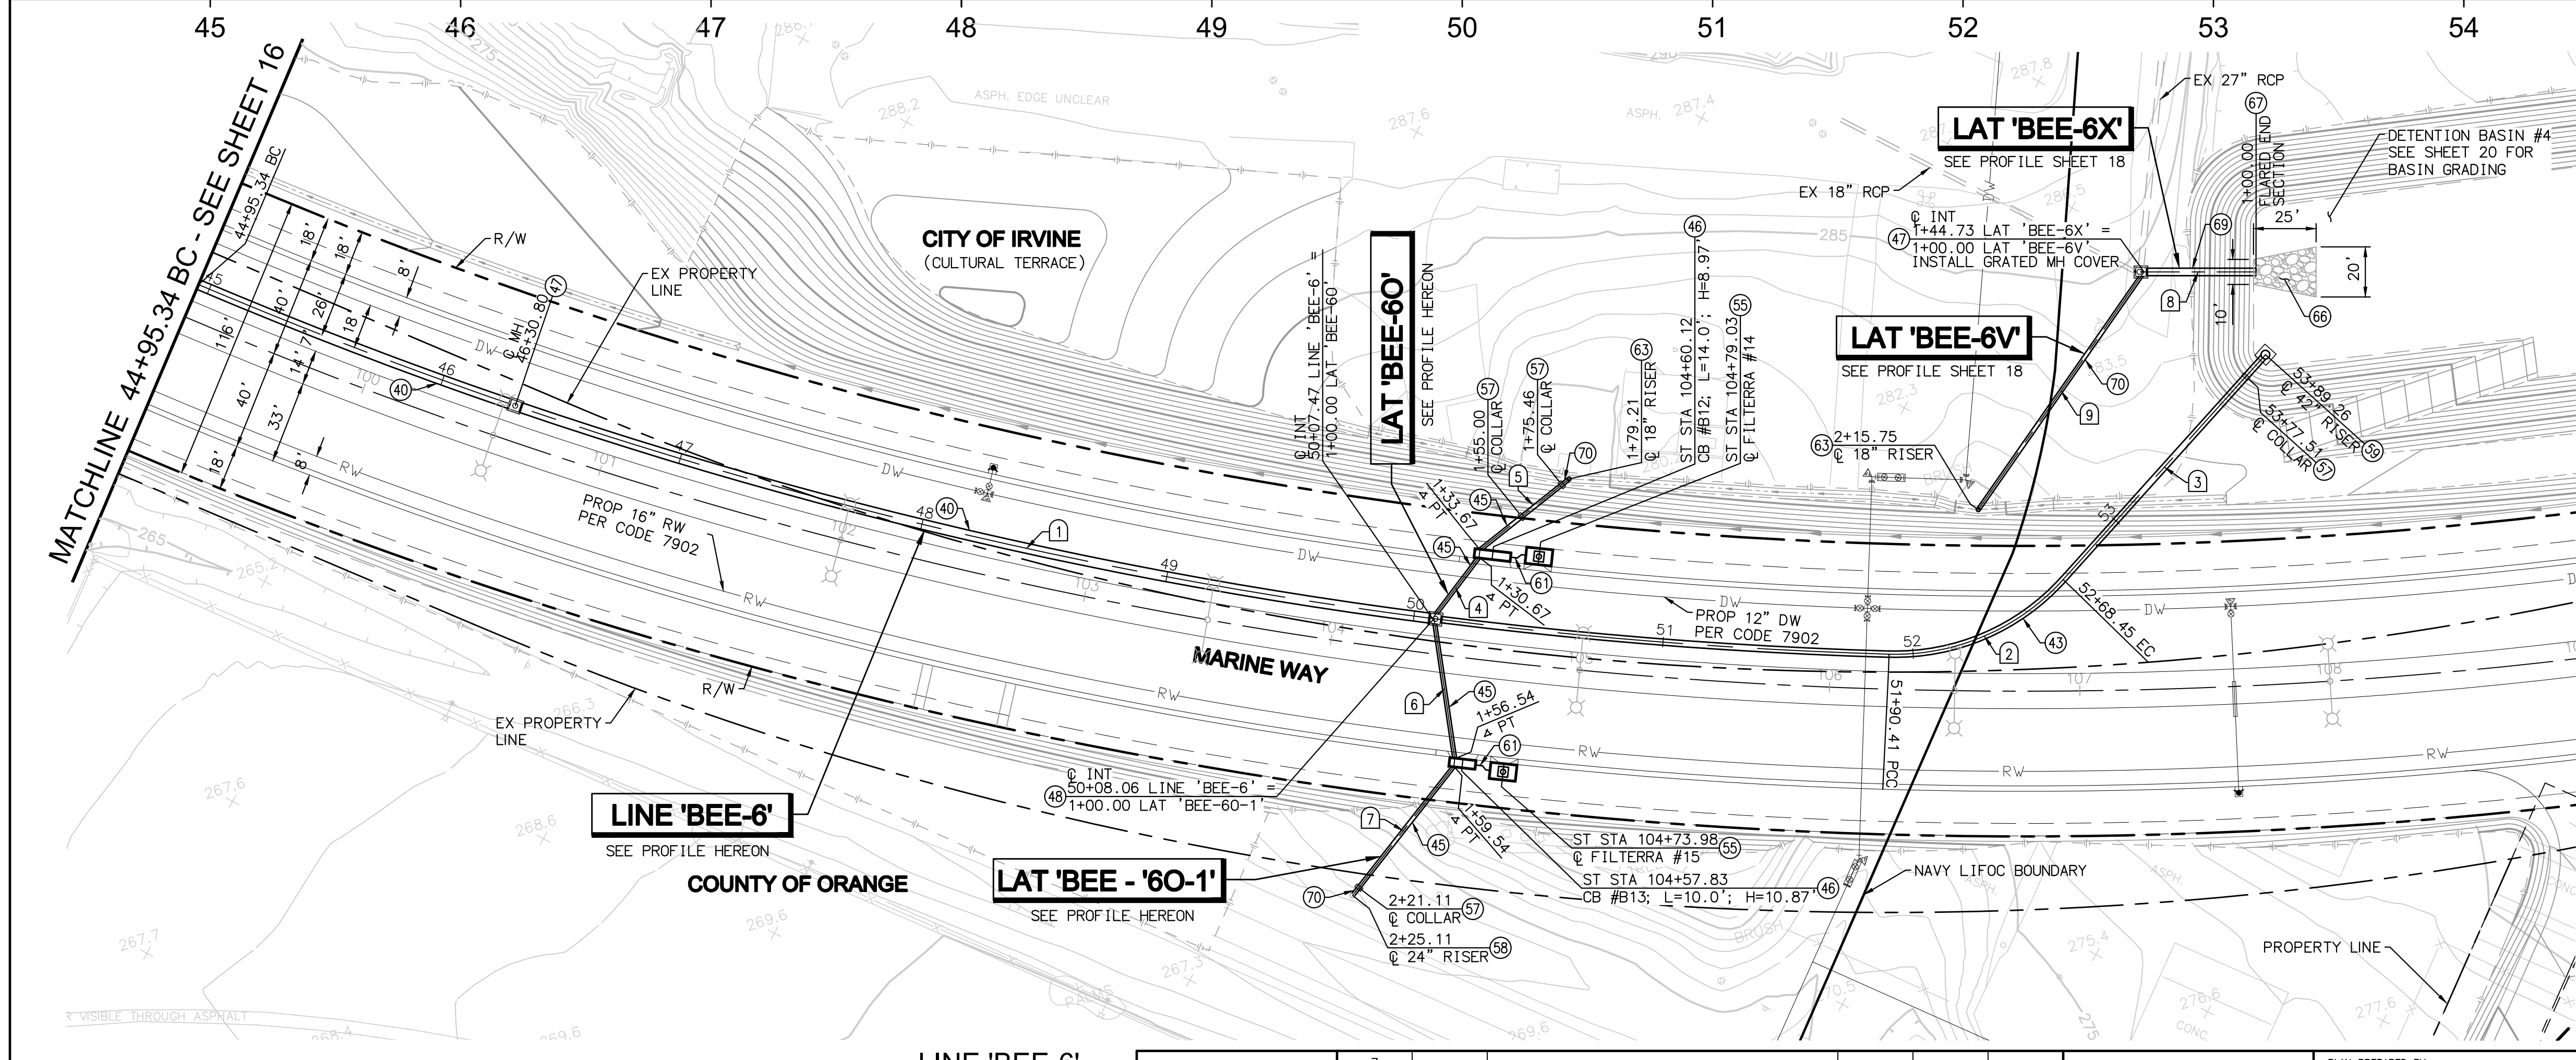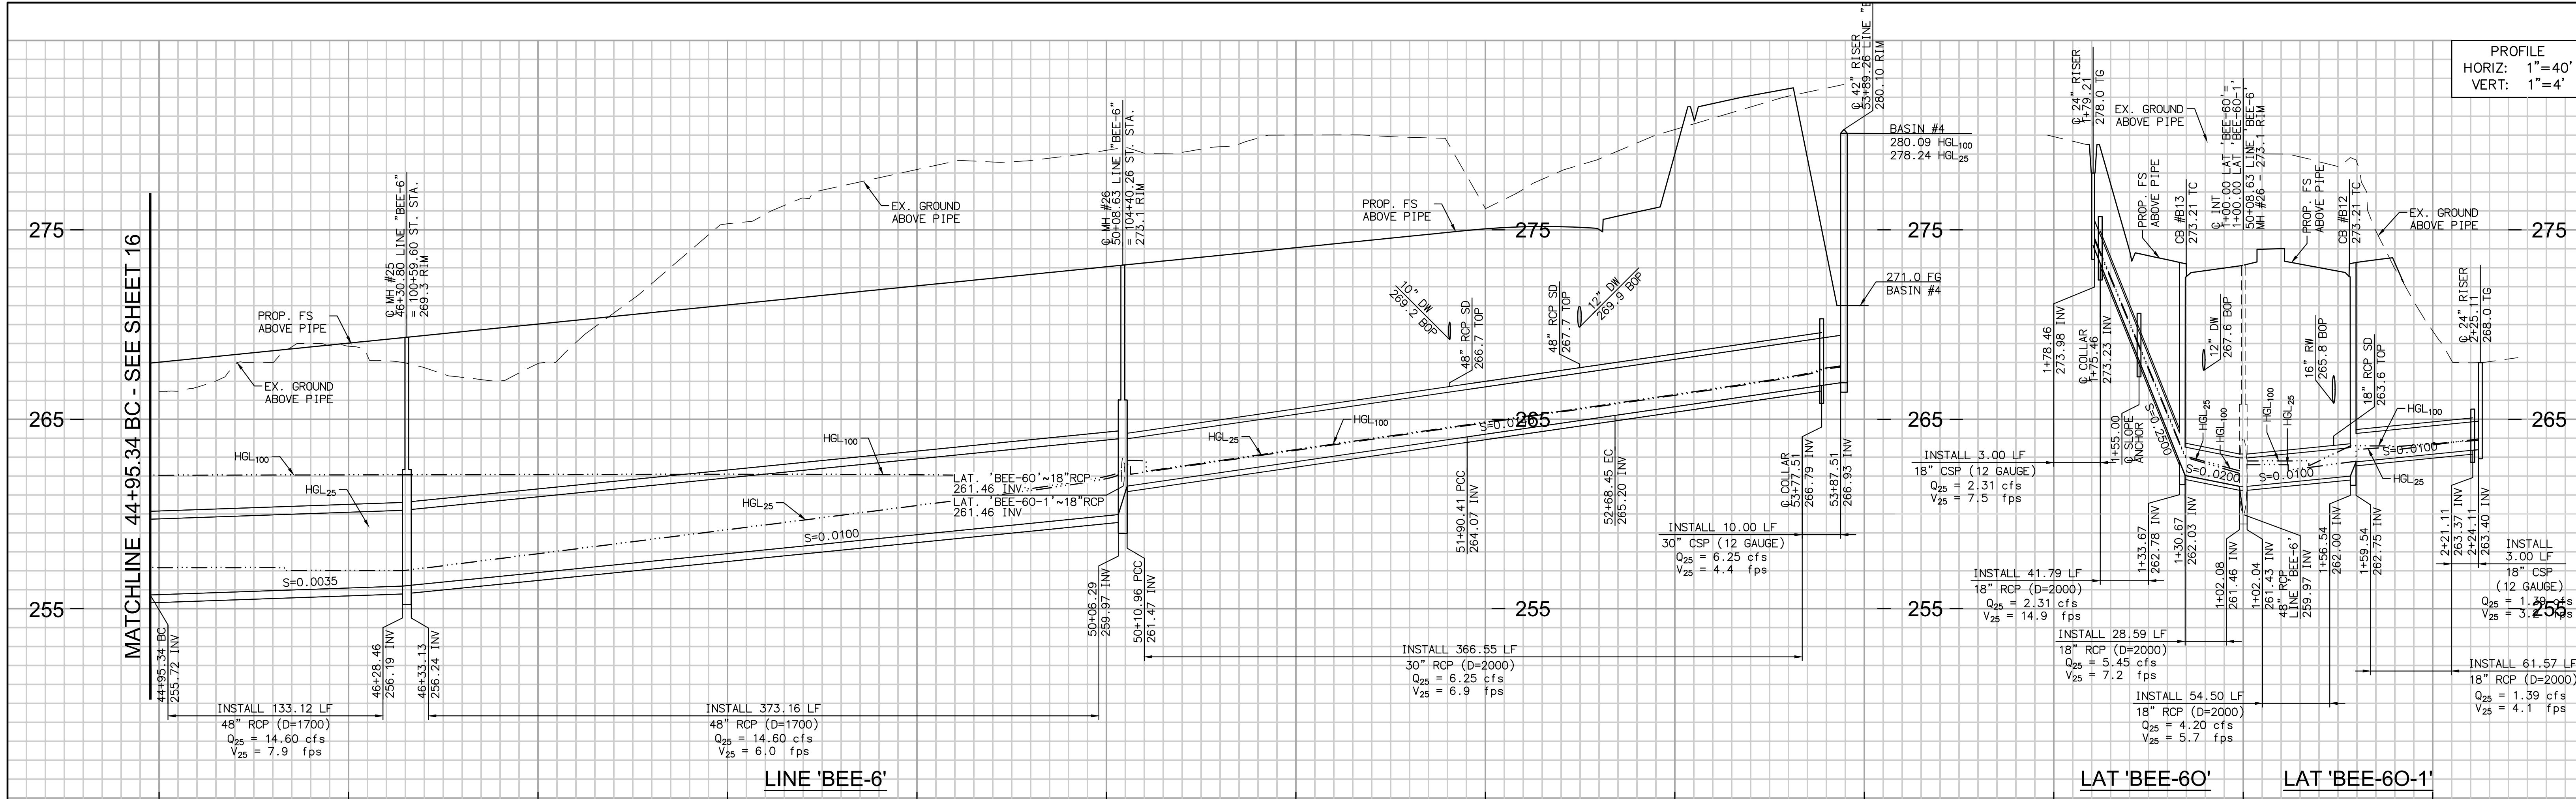

- ### STORM DRAIN CONSTRUCTION NOTES
- INSTALL 48" RCP STORM DRAIN, BEDDING PER COI STD 318 (D-LOAD PER PLAN)
 - INSTALL 30" RCP STORM DRAIN, BEDDING PER COI STD 318 (D-LOAD PER PLAN)
 - INSTALL 18" RCP STORM DRAIN, BEDDING PER COI STD 318 (D-LOAD PER PLAN)
 - CONSTRUCT CATCH BASIN TYPE 11 PER CITY OF IRVINE STD. 301 (L & H PER PLAN)
 - CONSTRUCT JUNCTION STRUCTURE NO. 1 PER CITY OF IRVINE STD. 306 AND 306A
 - CONSTRUCT JUNCTION STRUCTURE NO. 11 PER CITY OF IRVINE STD. 307 AND 307A
 - INSTALL 8" L X 6" W FILTERRA PER FILTERRA AND CATCH BASIN DETAIL ON SHEET 3
 - CONSTRUCT CONCRETE COLLAR PER CITY OF IRVINE STD. 310
 - CONSTRUCT CSP RISER PER CITY OF IRVINE STD PLAN 304
 - CONSTRUCT BASIN RISER PER DETAIL SHEET 13
 - INSTALL 4" (SCH 40) PVC PIPE @ 2% MIN
 - CONSTRUCT CSP DROP INLET PER CITY OF IRVINE STD PLAN 304, AS MODIFIED PER DETAIL SHEET 19
 - INSTALL UNGROUTED RIP RAP PER DETAIL ON SHEET 15
 - CONSTRUCT CSP FLARED END SECTION, PIPE SIZE PER PLAN
 - INSTALL 36" CSP (12 GAUGE) PER CITY OF IRVINE STD PLAN 318
 - INSTALL 18" CSP (12 GAUGE) PER CITY OF IRVINE STD PLAN 318

LINE/CURVE DATA TABLE				
NO	BEARING/DELTA	RADIUS	LENGTH	TANGENT
1	21°20'32"	1866.00'	695.07'	351.61'
2	49°41'04"	90.00'	78.04'	41.67'
3	N 58°46'44" E	---	120.81'	---
4	N 54°02'39" E	---	30.67'	---
5	N 68°19'24" E	---	45.54'	---
6	N 08°23'17" E	---	56.54'	---
7	N 54°52'38" E	---	65.58'	---
8	N 73°11'46" W	---	46.22'	---
9	N 51°41'22" E	---	115.75'	---

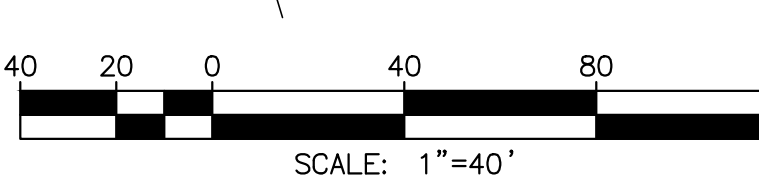

REGISTERED PROFESSIONAL ENGINEER
JEFFREY C. LANGDON
NO. 42429
CIVIL
STATE OF CALIFORNIA

NO.	DATE	REVISIONS	ENGR.	APPROV.	DATE
7					
6					
5					
4					
3					
2					
1					

PLAN PREPARED BY:
PROACTIVE
ENGINEERING CONSULTANTS
27042 Towne Centre Drive, Suite 110
Foothill Ranch, CA 92610 (949) 716-7460

DRAWN BY: SR
DATE: 4/18

DESIGNED BY: JCL
DATE: 4/18

CHECKED BY: JCL
DATE: 4/18

PLAN CHECK NO.
00760917-EMC




PERMIT NO.
00766614-MCE

PROJECT NO.
20.059


SHEET
17
OF
28

CONSTRUCTION PLANS FOR THE IMPROVEMENT OF
MARINE WAY
STORM DRAIN PLAN AND PROFILE
LINE 'BEE-6' FROM STA 44+95.34 TO 53+89.26
LATERALS 'BEE-60', 'BEE-60-1', 'BEE-6V' & 'BEE-6X'

CITY OF IRVINE
PUBLIC WORKS DEPARTMENT

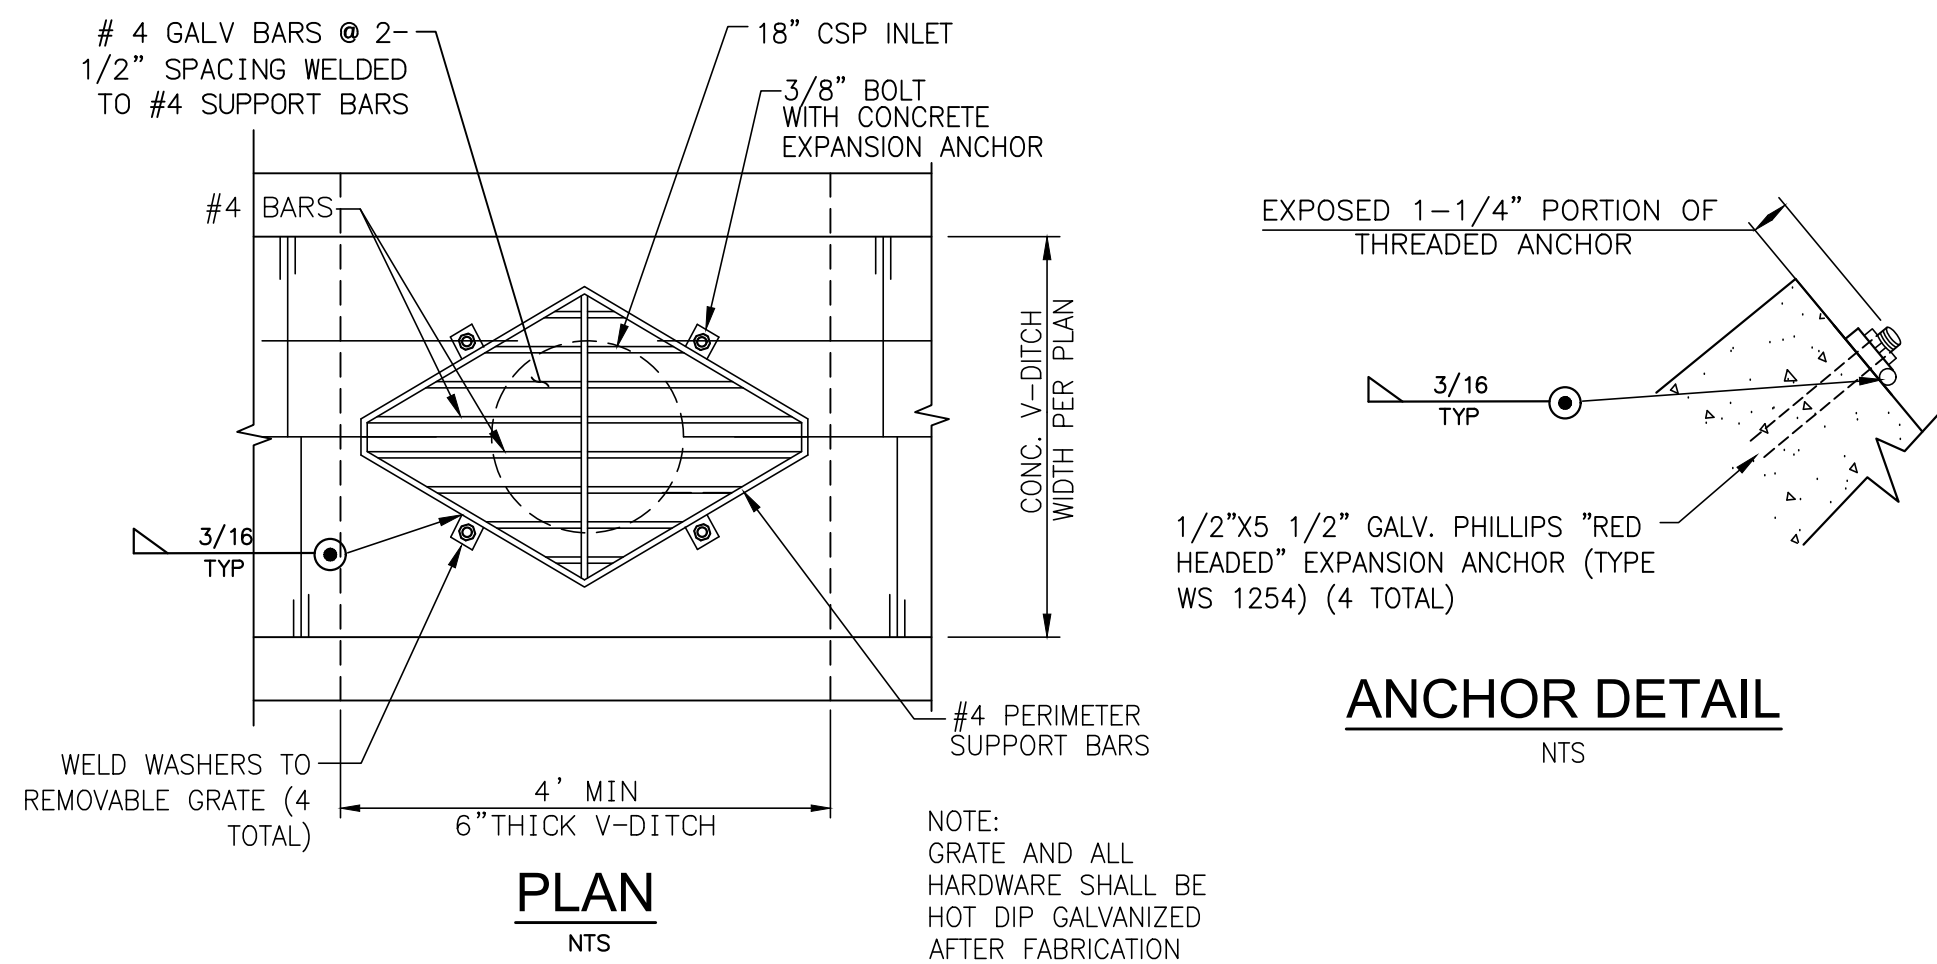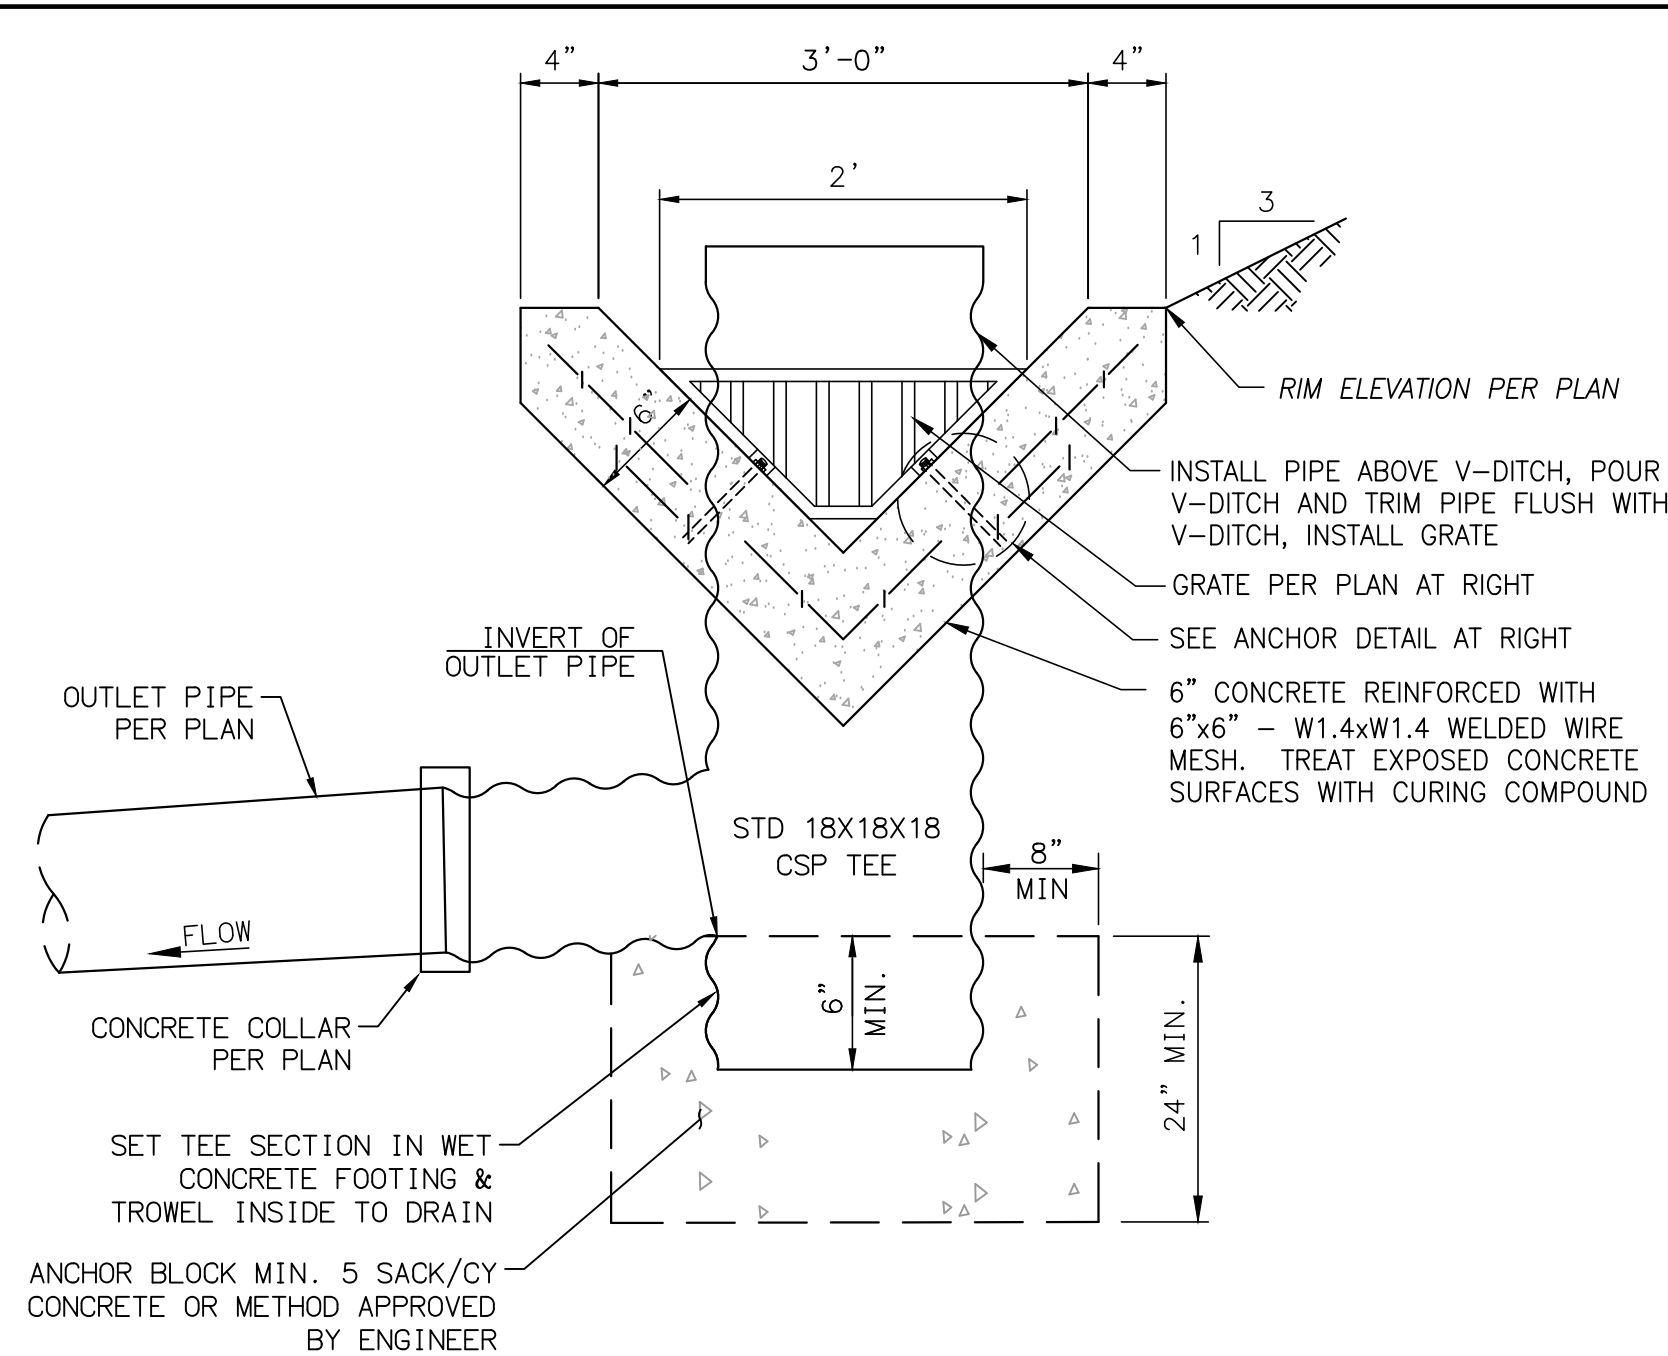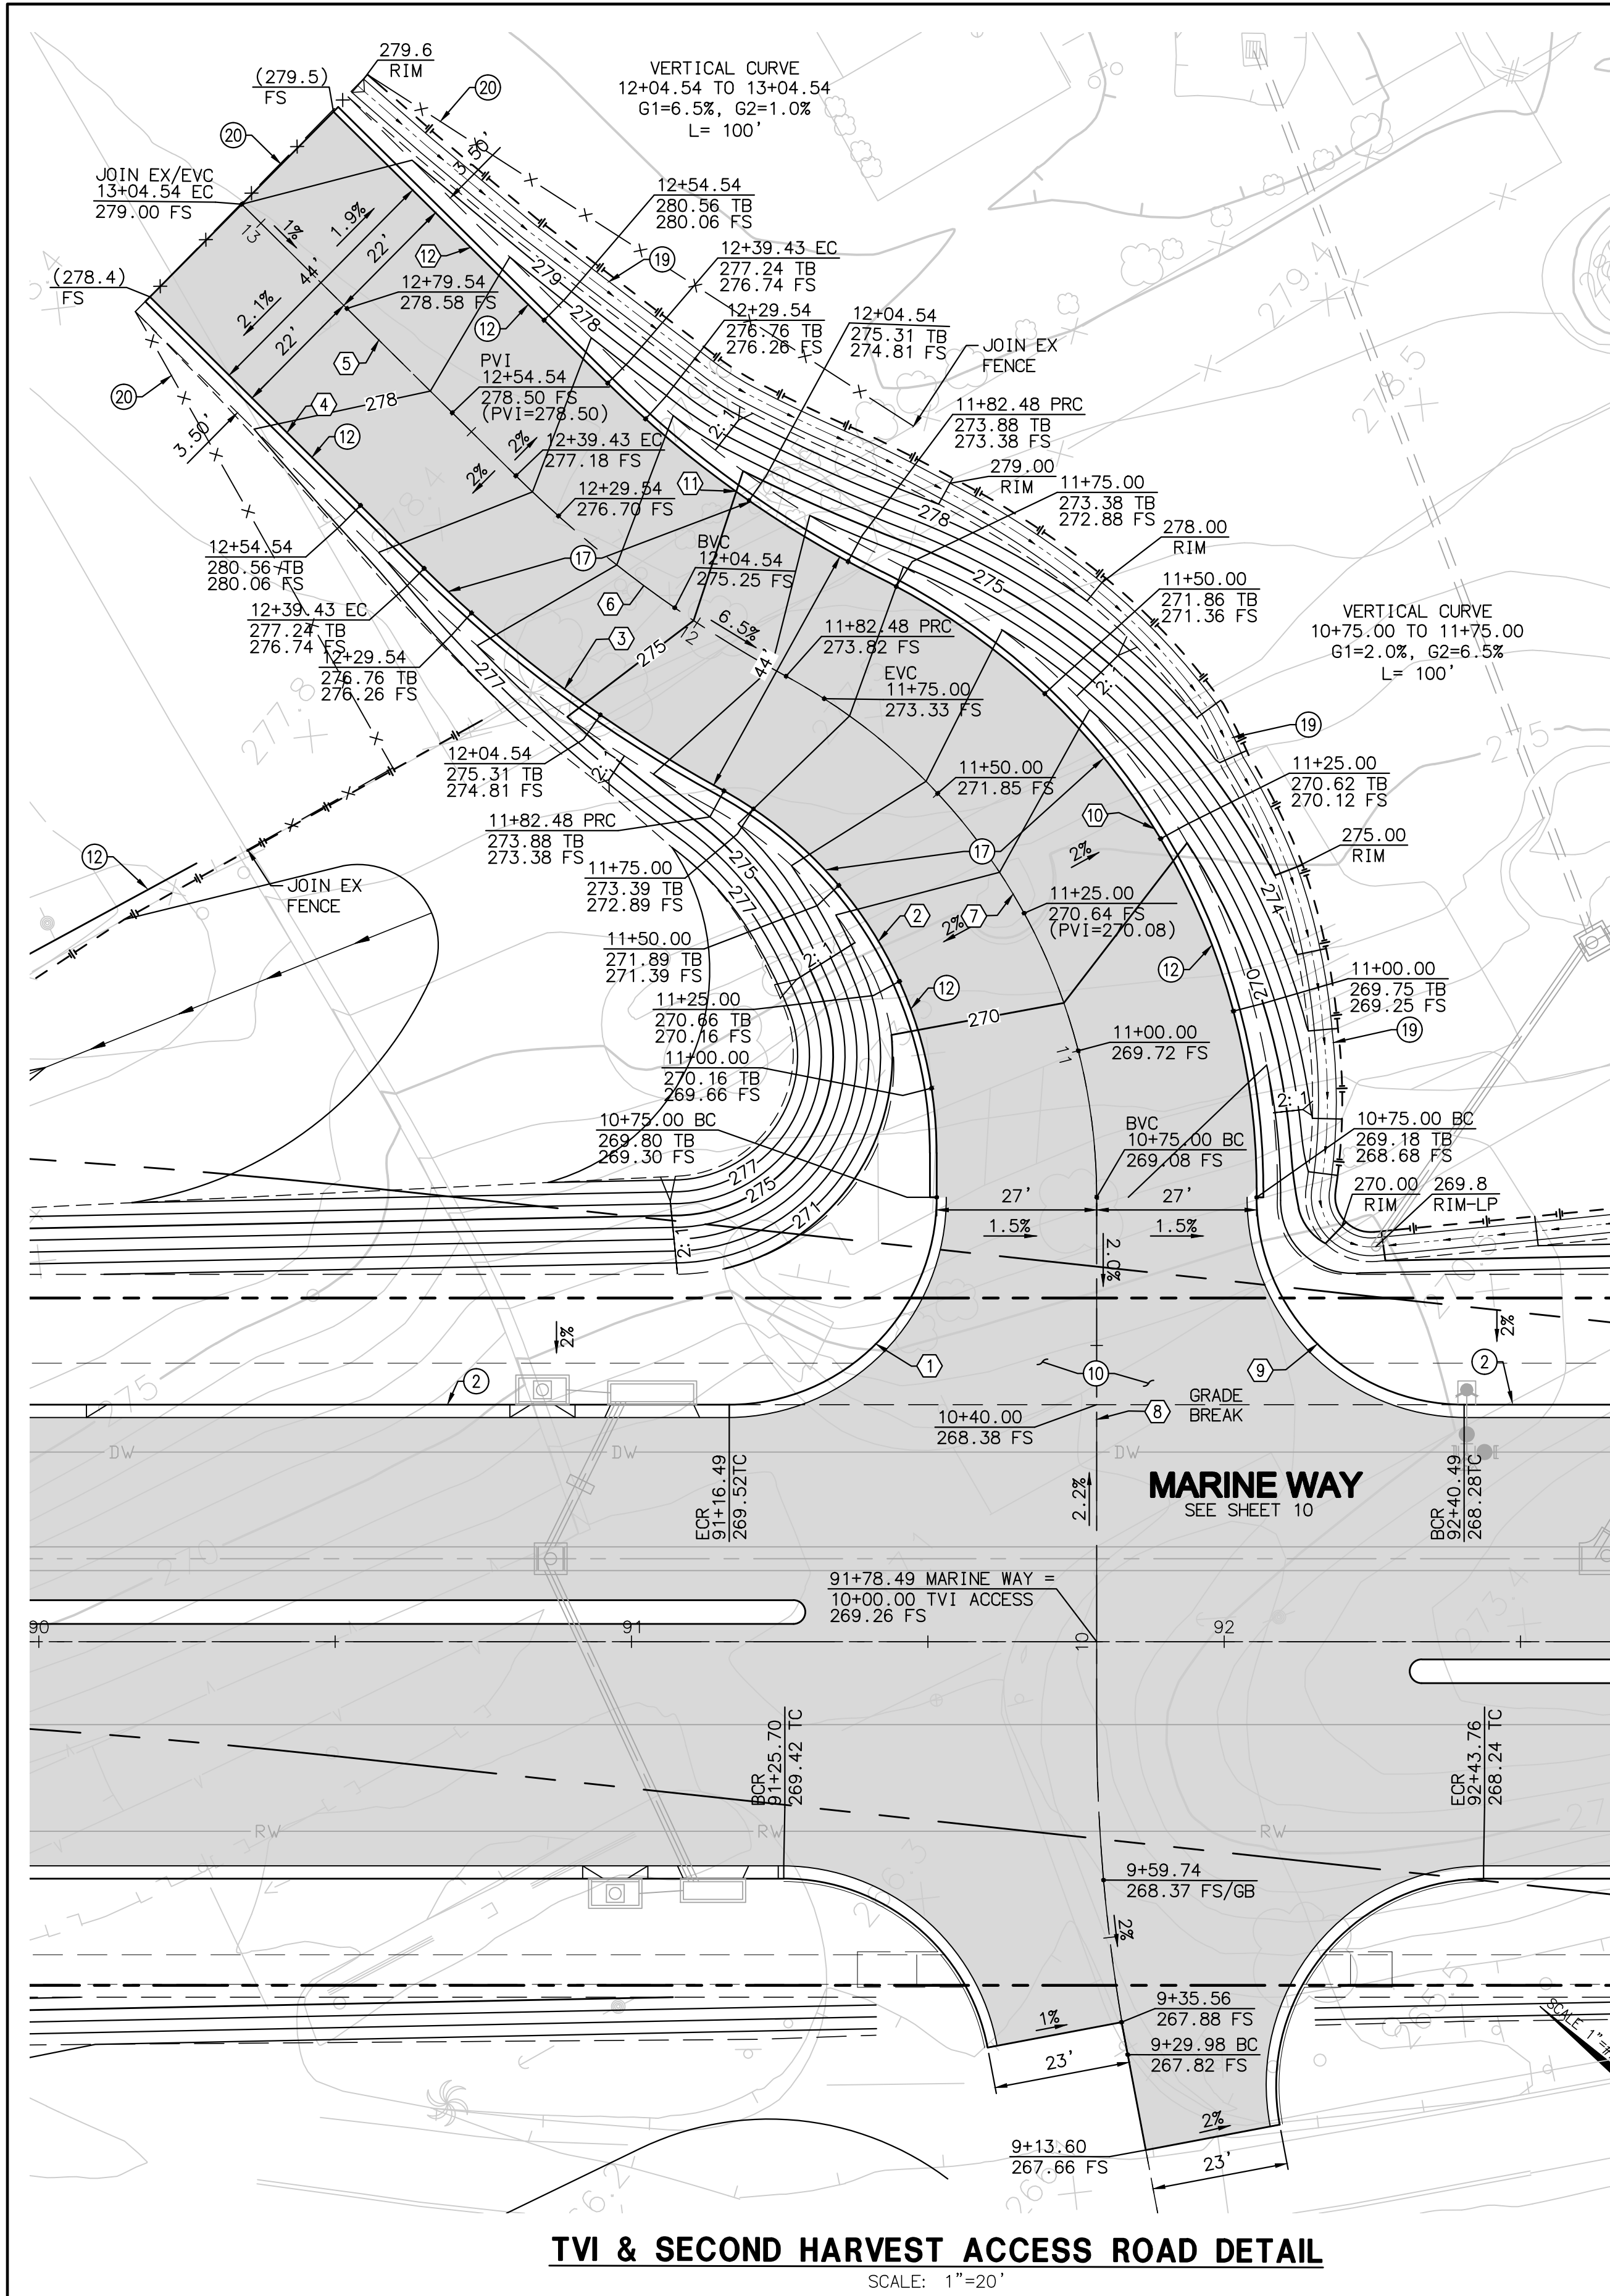


LINE/CURVE DATA TABLE				
NO	BEARING/DELTA	RADIUS	LENGTH	TANGENT
1	90°00'00"	35.00'	54.98'	35.00'
2	61°24'11"	70.00'	75.02'	41.57'
3	16°07'57"	222.00'	62.51'	31.46'
4	N06°06'34"E	---	65.12'	---
5	N06°06'34"E	---	65.12'	---
6	16°18'46"	200.00'	56.94'	28.67'
7	61°35'00"	100.00'	107.48'	59.59'
8	N51°22'48"E	---	75.00'	---
9	90°00'00"	35.00'	54.98'	35.00'
10	63°29'38"	115.00'	127.44'	71.16'
11	18°13'24"	178.00'	56.61'	28.55'
12	N06°06'34"E	---	65.12'	---
13	60°10'26"	35.00'	36.76'	20.28'
14	17°16'52"	84.00'	25.34'	12.76'
15	N40°39'34"E	---	153.47'	---
16	90°10'25"	35.00'	55.08'	35.11'
17	N40°39'34"E	---	204.72'	---
18	30°38'30"	100.00'	53.48'	27.40'
19	N10°01'04"E	---	62.98'	---
20	60°29'29"	35.00'	36.95'	20.41'
21	26°19'35"	116.00'	53.30'	27.13'
22	N40°39'34"E	---	152.90'	---
23	90°58'10"	35.00'	55.57'	35.60'

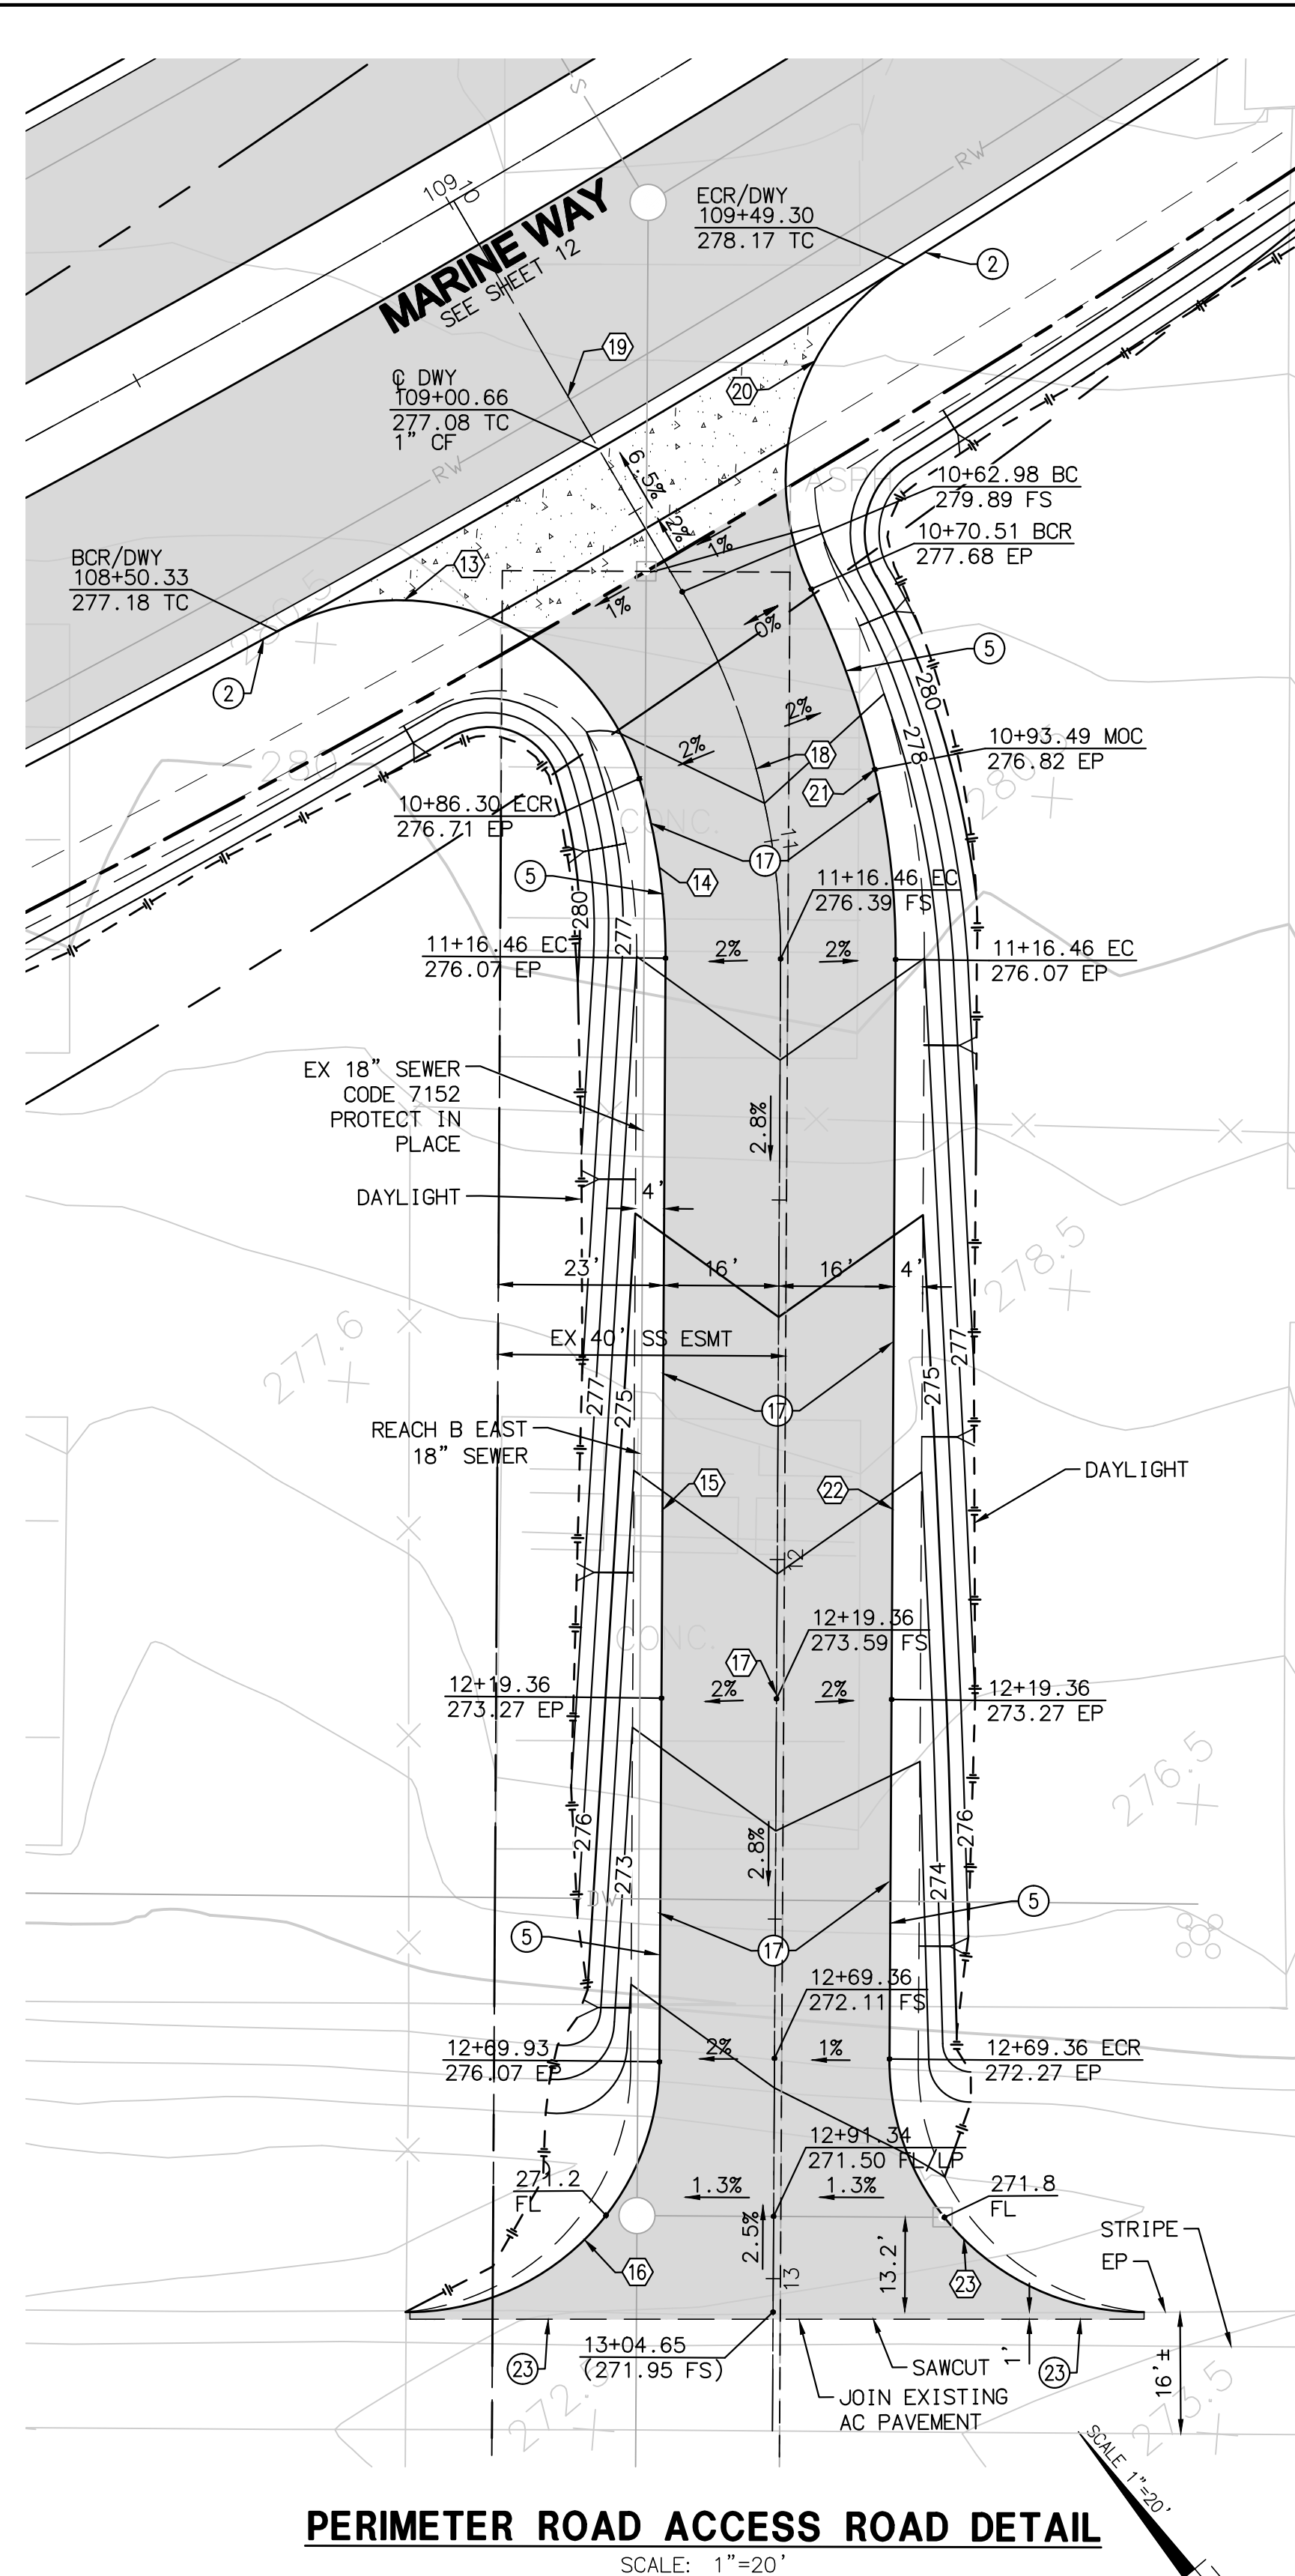

STREET CONSTRUCTION NOTES

- ② CONSTRUCT CONCRETE CURB AND GUTTER PER CITY OF IRVINE STD. PLAN NO. 200, TYPE A-2
- ⑤ INSTALL WOOD HEADER PER DETAIL ON SHEET 9
- ⑩ CONSTRUCT DRIVEWAY TYPE II PER CITY OF IRVINE STD. PLAN NO. 205 (WIDTH PER PLAN)
- ⑫ CONSTRUCT 8" AC CURB D1-8 PER SPWPC STD. PLAN 120-2 (SEE SHEET 23)
- ⑬ CONSTRUCT 4" AC OVER 8" CMB DRIVEWAY ON COMPACTED NATIVE PER SOILS ENGINEER
- ⑰ CONSTRUCT 3' WIDE CONCRETE V-DITCH PER DETAIL ON SHEET 3
- ⑳ INSTALL CHAIN LINK FENCE AND GATE PER SPWPC STD PLAN 600-3 (SEE SHEET 23)
- ㉓ SAWCUT AND REMOVE EXISTING 1' MINIMUM AC PAVEMENT

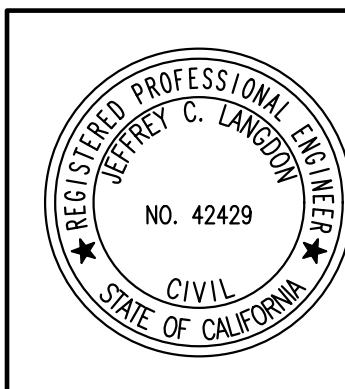

NO.	DATE	REVISIONS	ENGR.	APPROV.	DATE
7					
6					
5					
4					
3					
2					
1					


DRAWN BY: SR	DATE: 4/18
DESIGNED BY: JCL	DATE: 4/18
CHECKED BY: JCL	DATE: 4/18

PLAN PREPARED BY:
PROACTIVE
 ENGINEERING CONSULTANTS
 27042 Towne Centre Drive, Suite 110
 Foothill Ranch, CA 92610 (949) 716-7460

CONSTRUCTION PLANS FOR THE IMPROVEMENT OF
MARINE WAY
 DRIVEWAY DETAILS

CITY OF IRVINE
 PUBLIC WORKS DEPARTMENT


PLAN CHECK NO. 00760917-EMC	PROJECT NO. 20.059
PERMIT NO. 00766614-MCE	SHEET 19 OF 28

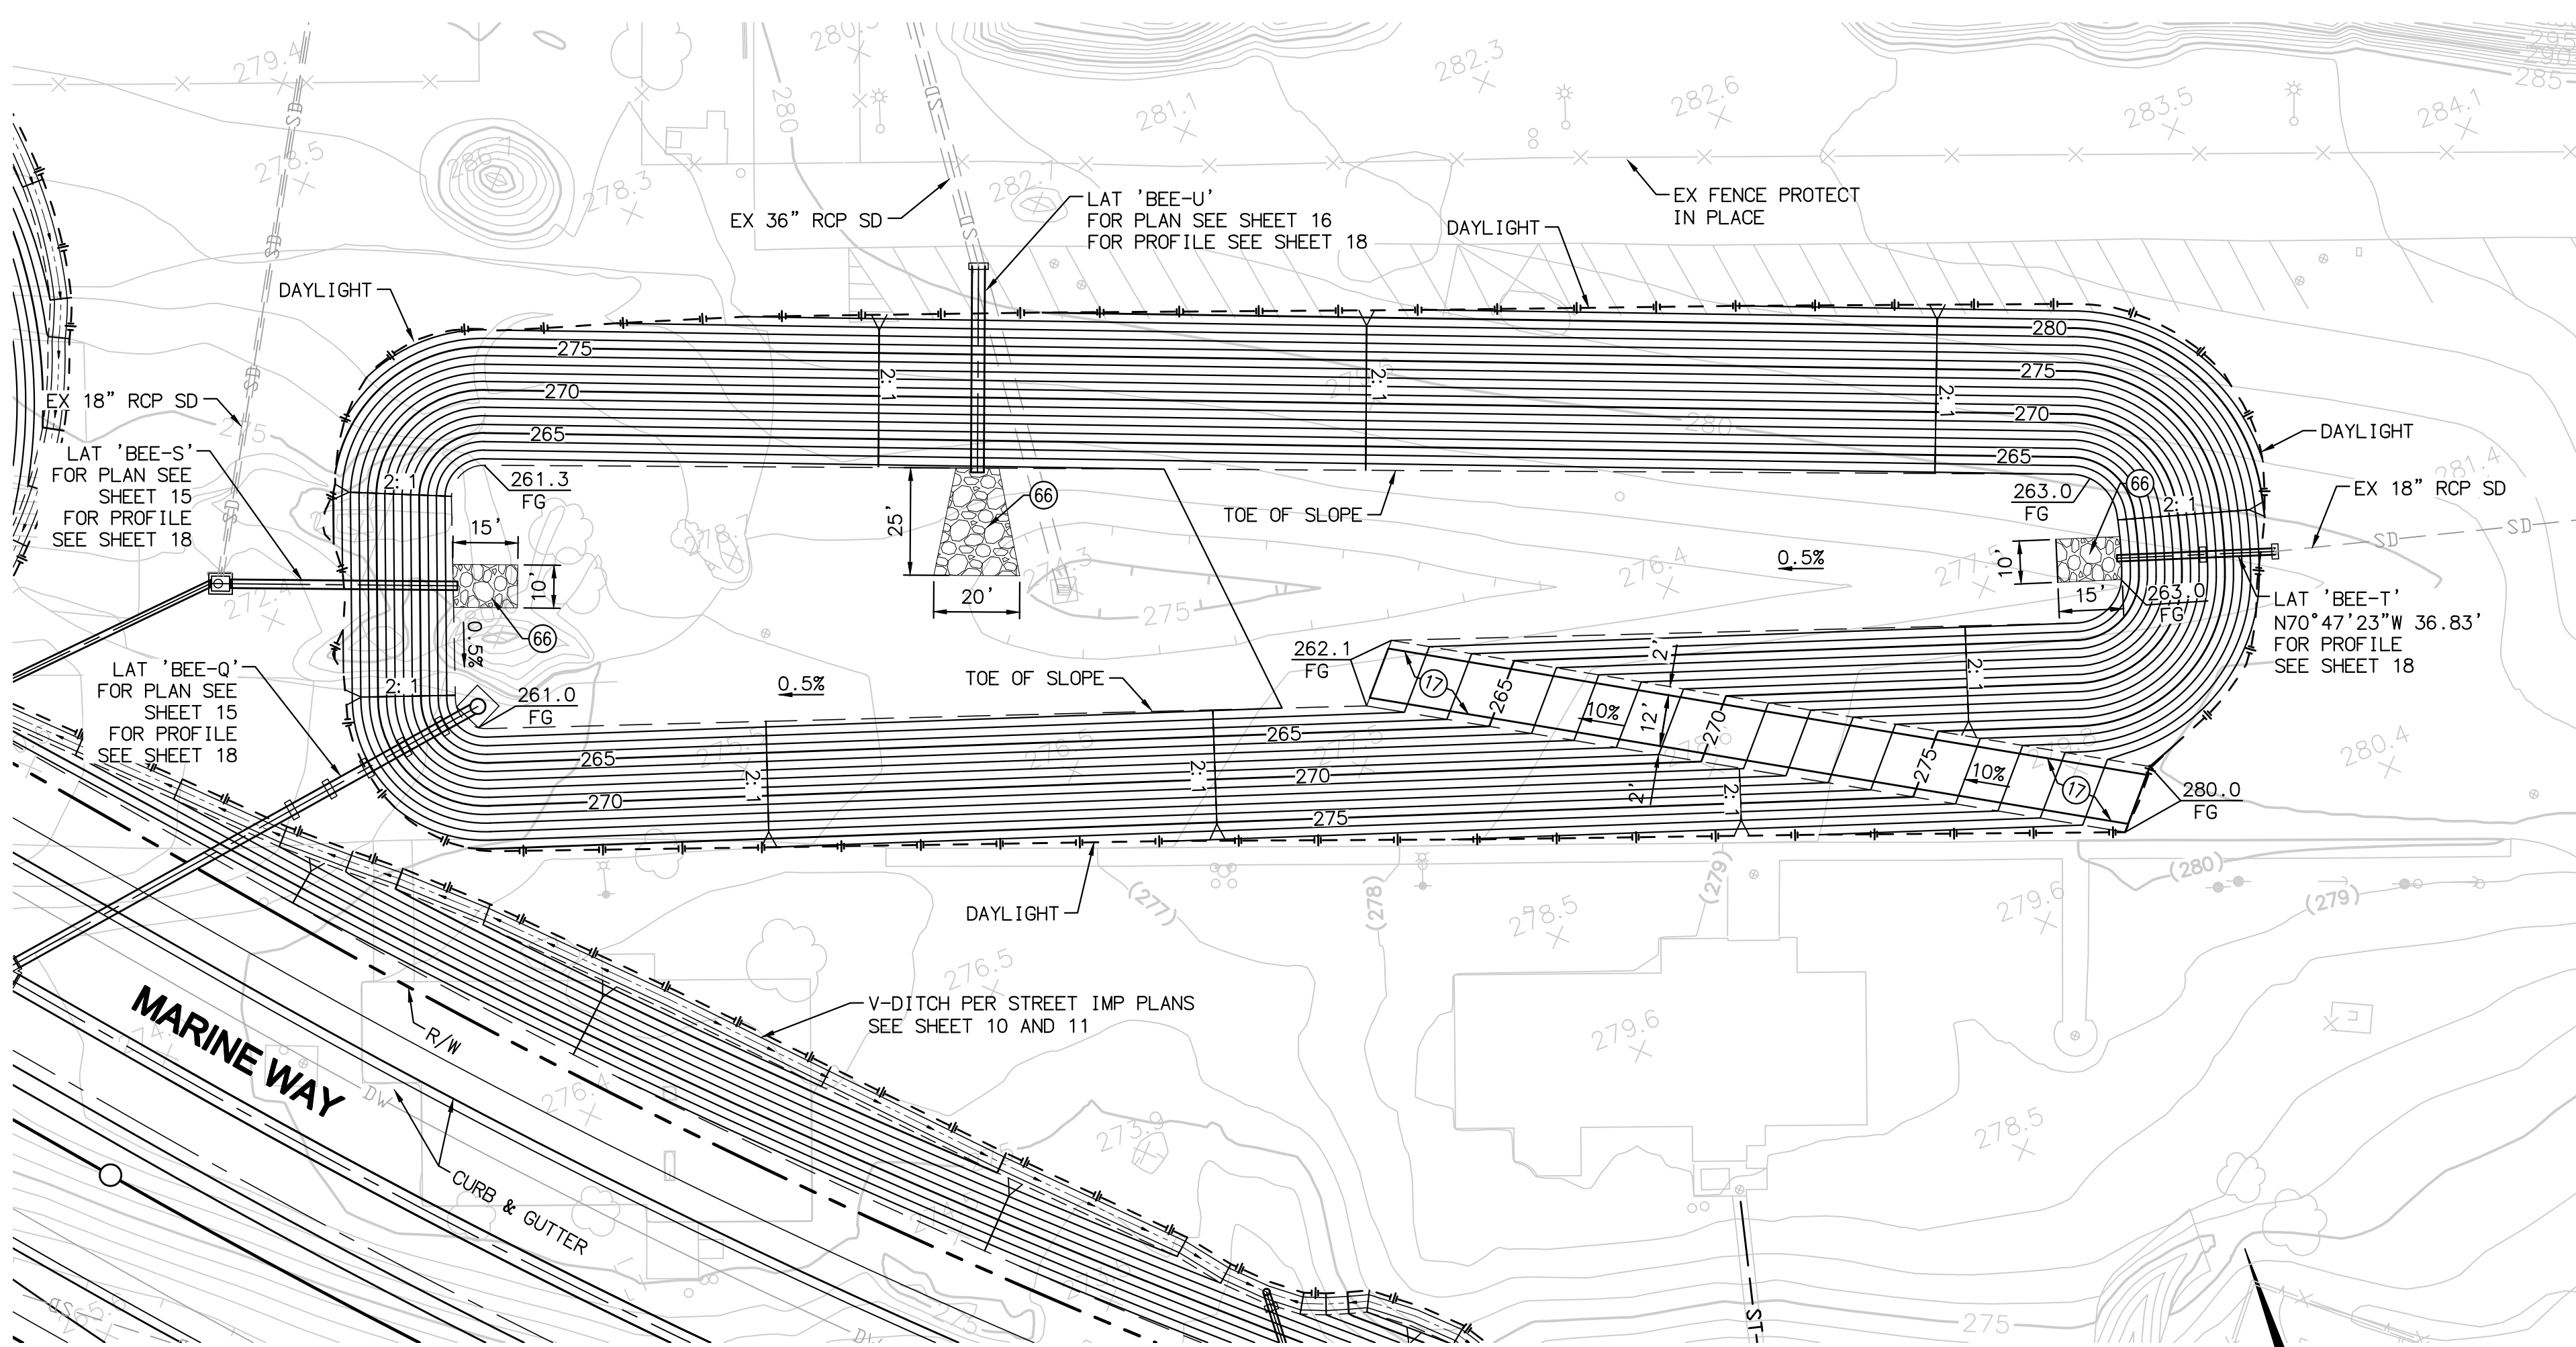

DETENTION BASIN #1

SCALE: 1"=30'

NOTE: SEE SHEET 6A FOR DEMOLITION
SEE SHEET 10 & 11 FOR STREET IMPROVEMENT
SEE SHEET 15 & 16 FOR STORM DRAIN IMPROVEMENT

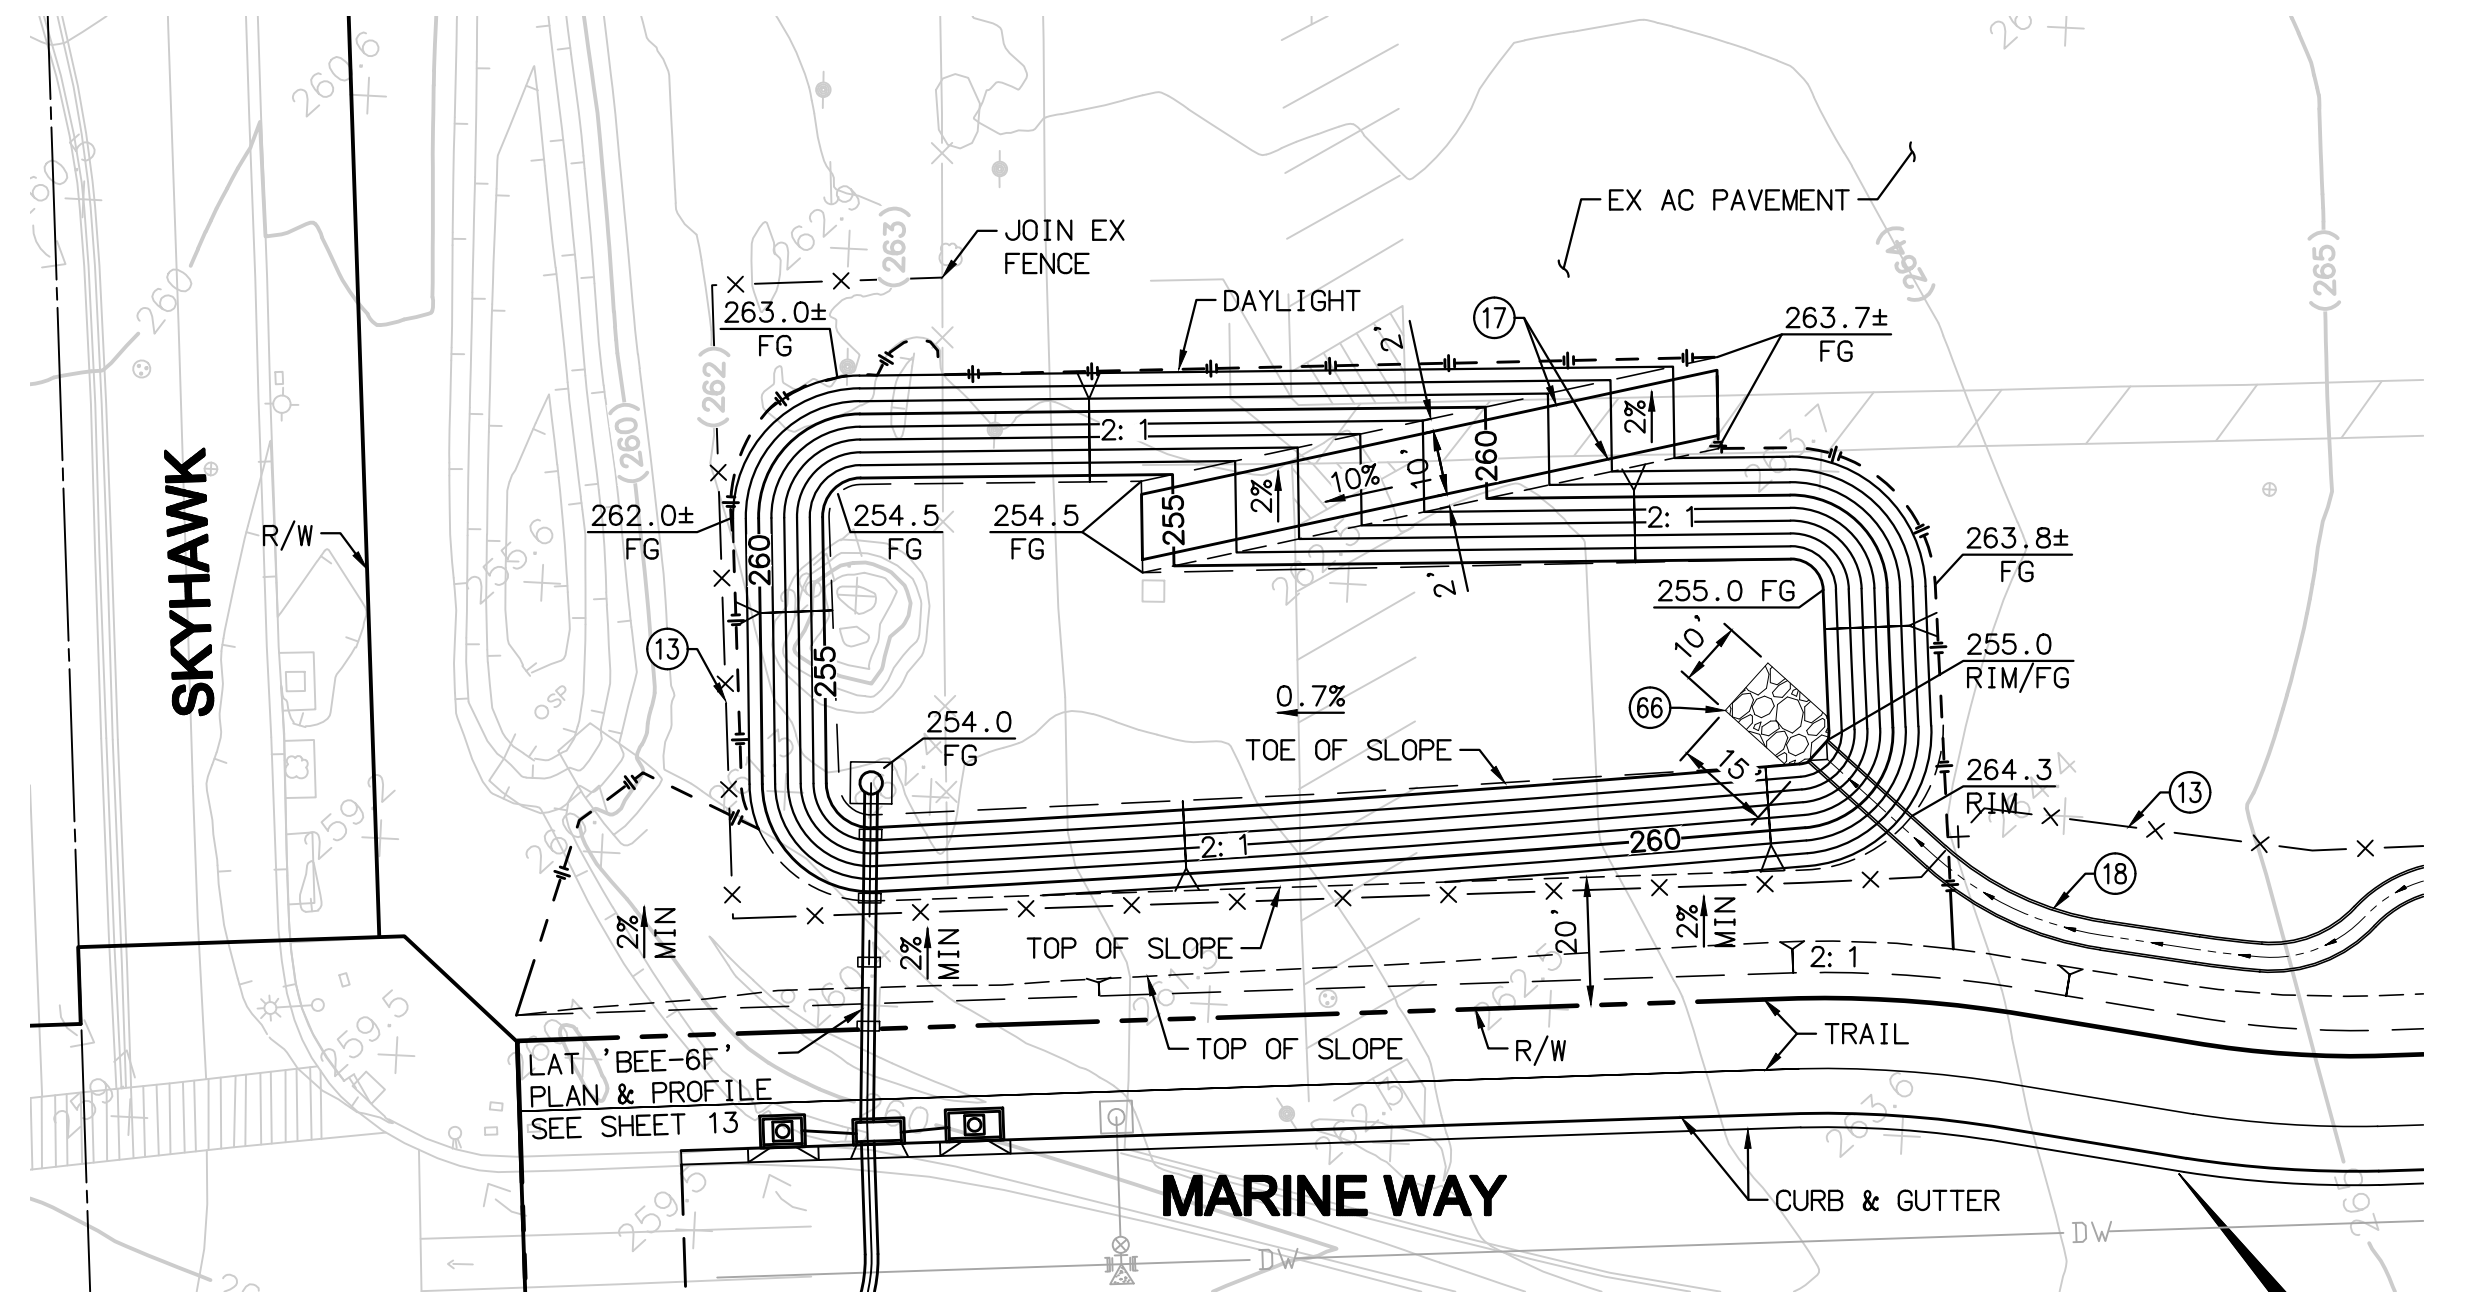

DETENTION BASIN #3

SCALE: 1"=30'


NOTE: SEE SHEET 5 FOR DEMOLITION
SEE SHEET 8 FOR STREET IMPROVEMENT
SEE SHEET 13 FOR STORM DRAIN IMPROVEMENT

STREET CONSTRUCTION NOTES

- 13 RELOCATE EXISTING TEMPORARY FENCE PER PLAN WITH GRAVEL BAGS ON LEG SUPPORTS
- 17 CONSTRUCT 4" AC OVER 8" CMB DRIVEWAY ON COMPACTED NATIVE PER SOILS ENGINEER
- 18 CONSTRUCT 4' WIDE CONCRETE V-DITCH PER DETAIL ON SHEET 3

STORM DRAIN CONSTRUCTION NOTES


- 42 REMOVE GRATED INLET, FILL CATCH BASIN WITH CMB, POUR 6" THICK TOP TO MATCH EX CONCRETE SWALE
- 49 INSTALL BRICK AND MORTAR PLUG PER DETAIL SHEET 3
- 64 CONSTRUCT GRATING CATCH BASIN PER SPPWC STD PALN 304-3 (SEE SHEET 22)
- 66 INSTALL UNGROUTED RIP RAP PER DETAIL ON SHEET 15
- 69 INSTALL 36" CSP (12 GAUGE) PER CITY OF IRVINE STD PLAN 318

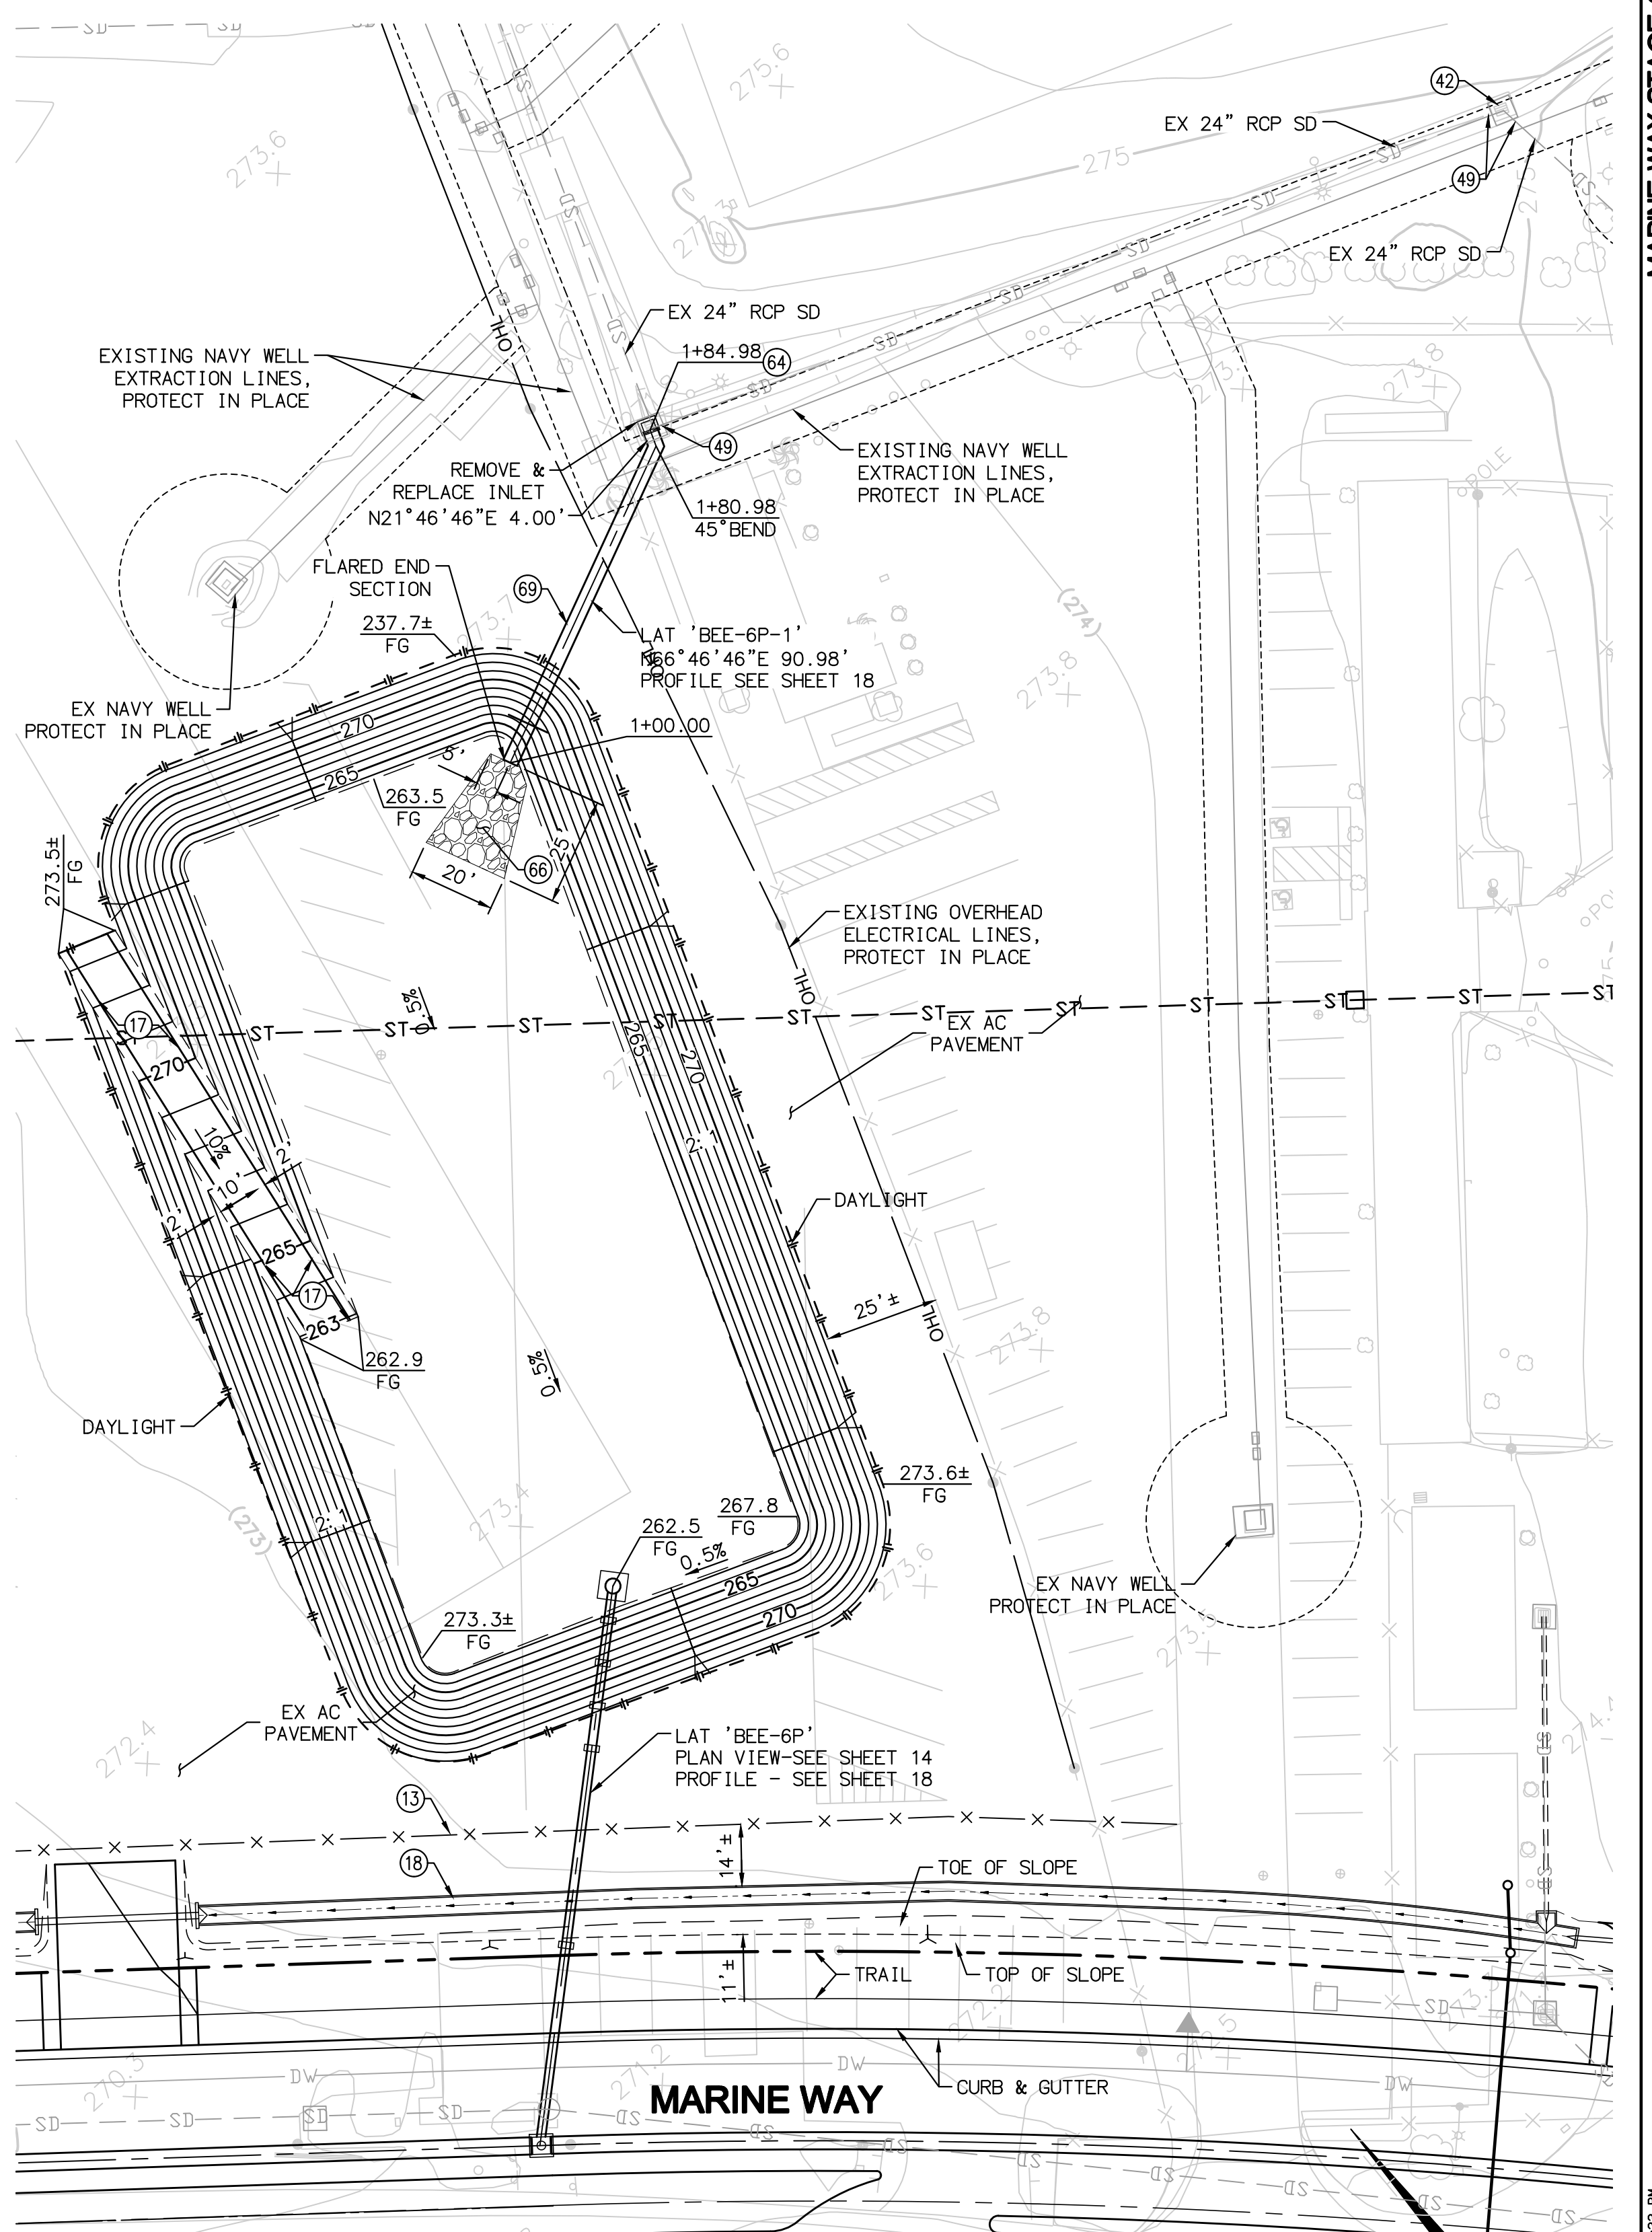

DETENTION BASIN #2

SCALE: 1"=30'

NOTE: SEE SHEET 6 FOR DEMOLITION
SEE SHEET 9 FOR STREET IMPROVEMENT
SEE SHEET 14 FOR STORM DRAIN IMPROVEMENT

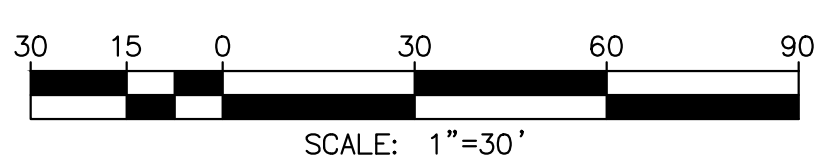

7						
6						
5						
4						
3						
2						
1						
NO.	DATE	REVISIONS	ENGR.	APPROV.	DATE	

DRAWN BY: SR	DATE 4/18
DESIGNED BY: JCL	DATE 4/18
CHECKED BY: JCL	DATE 4/18








PLAN PREPARED BY:
PROACTIVE
ENGINEERING CONSULTANTS
27042 Towne Centre Drive, Suite 110
Foothill Ranch, CA 92610 (949) 716-7460

JEFFREY C. LANGDON R.C.E. 42429 DATE

**CONSTRUCTION PLANS FOR THE IMPROVEMENT OF
MARINE WAY
BASIN DETAILS**

**CITY OF IRVINE
PUBLIC WORKS DEPARTMENT**

PLAN CHECK NO. 00760917-EMC
PERMIT NO. 00766614-MCE
PROJECT NO. 20.059
SHEET 20 OF 28

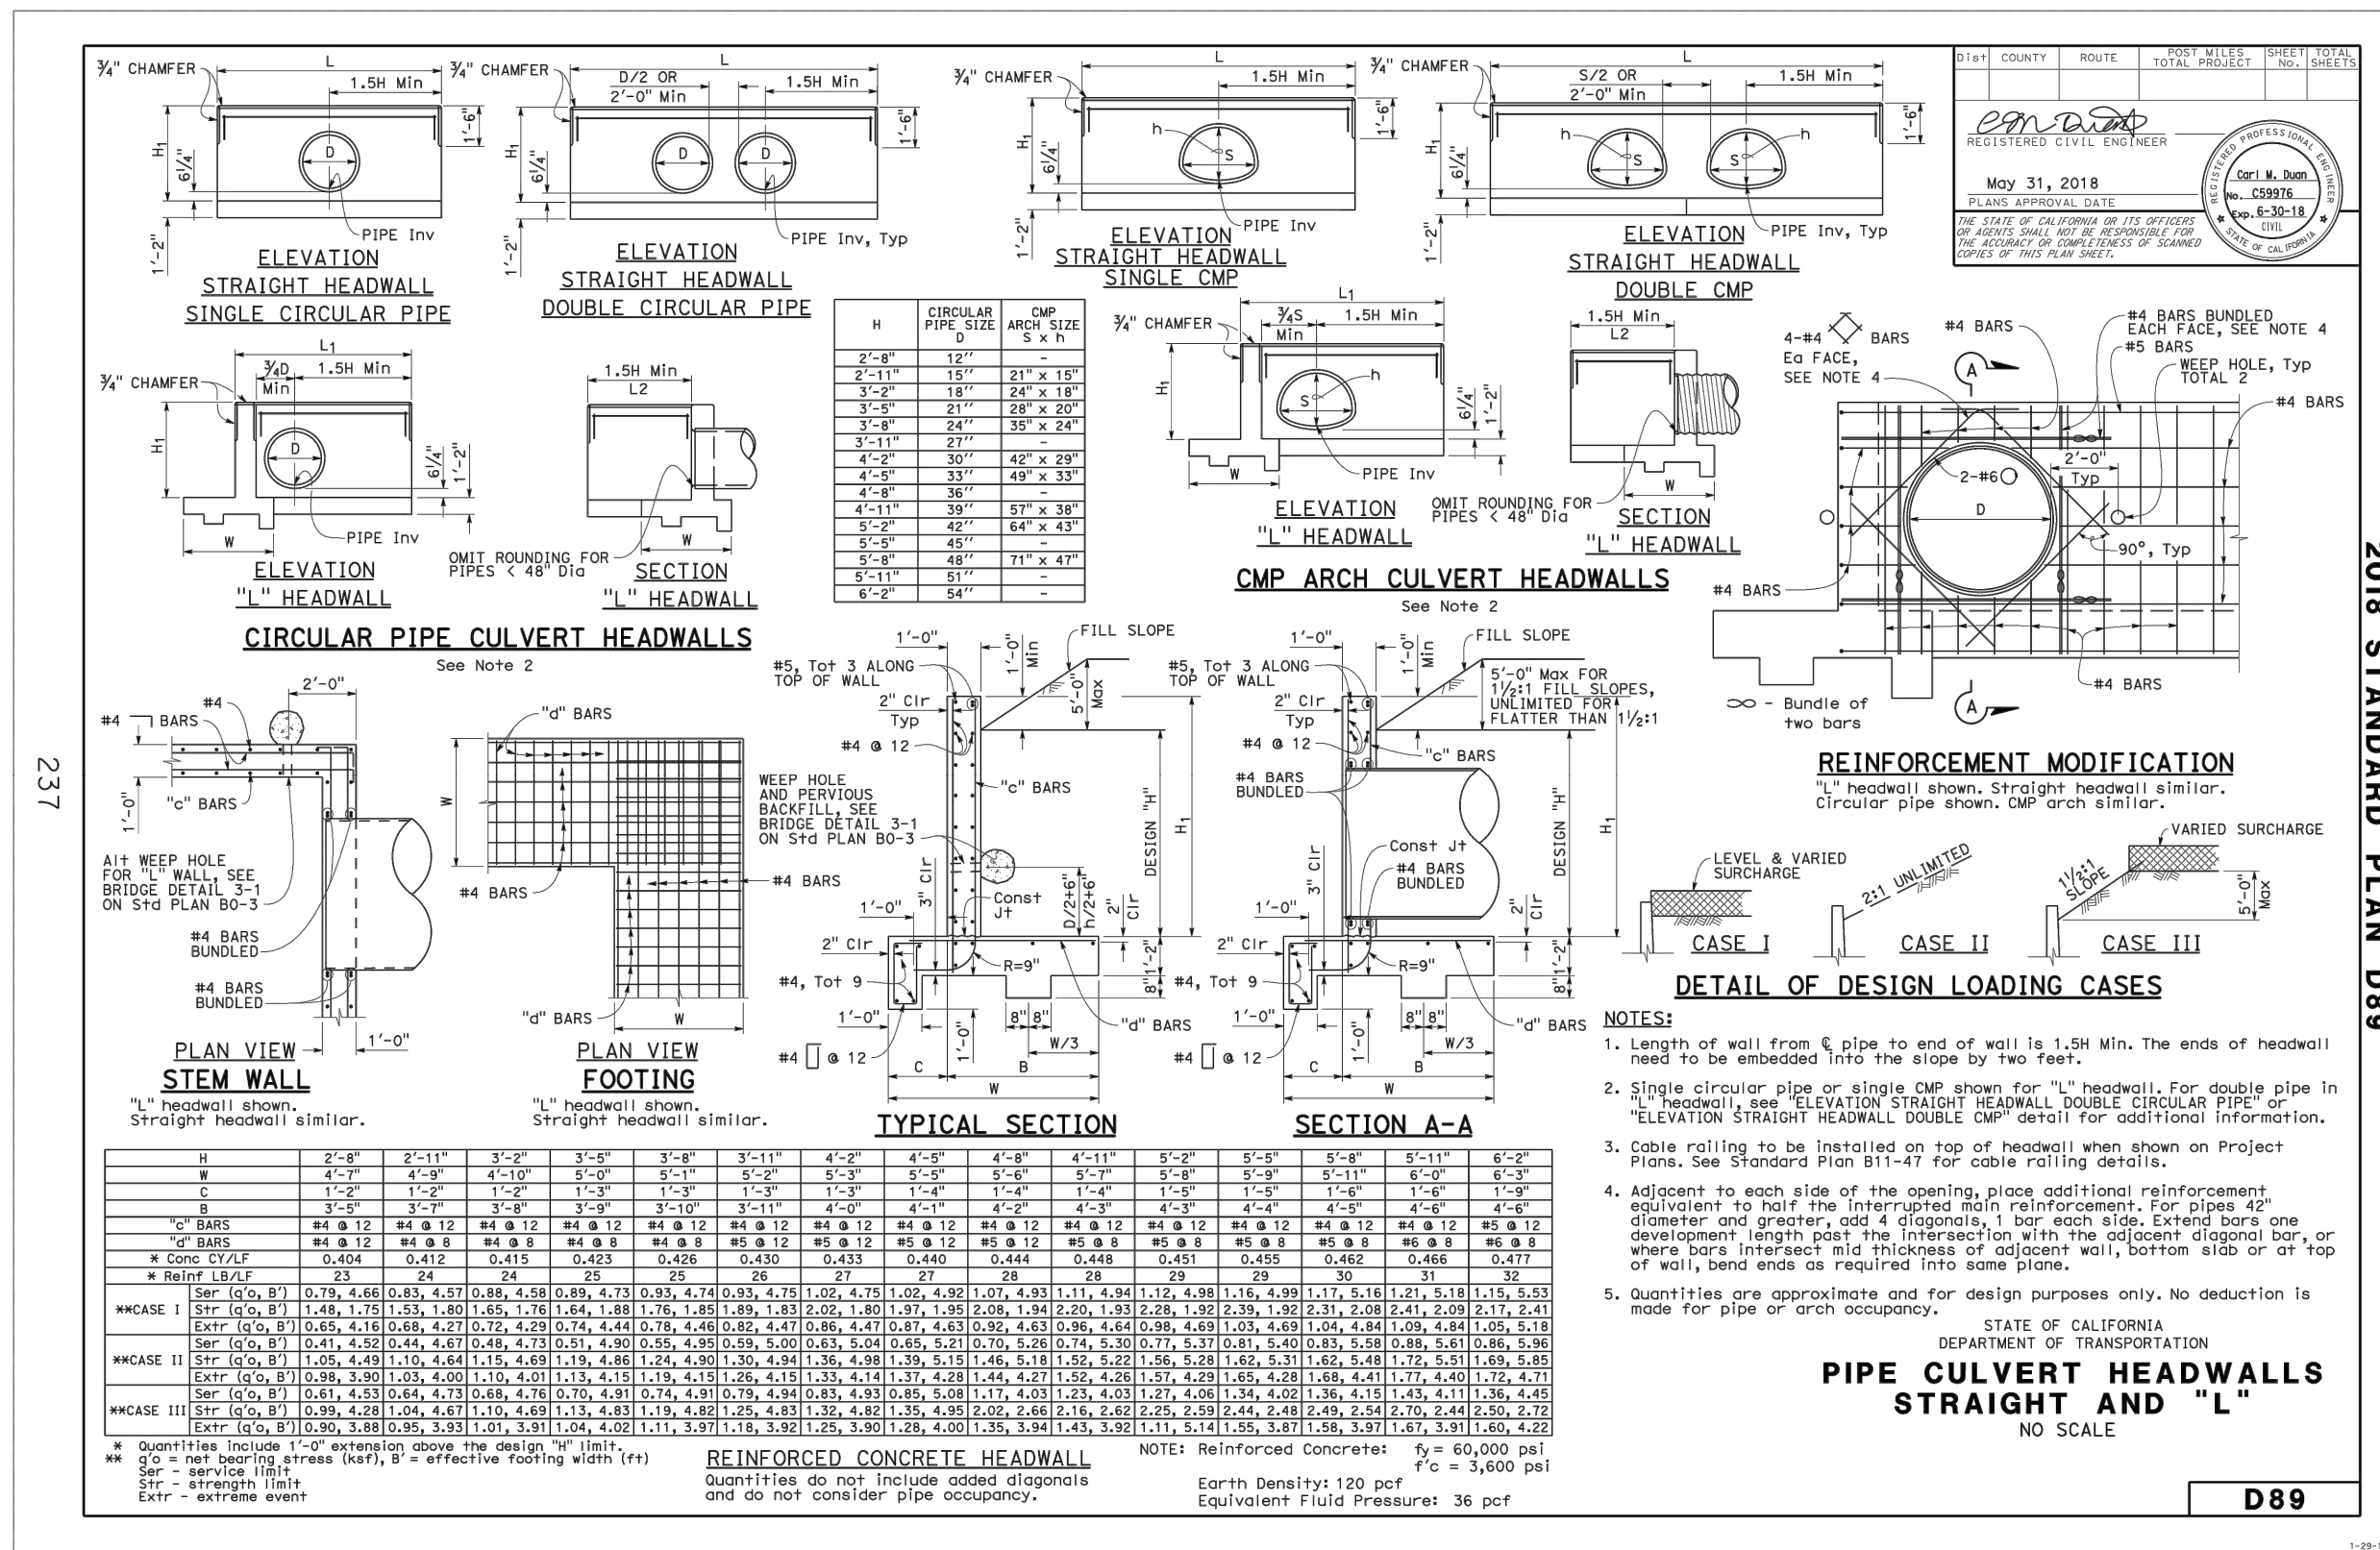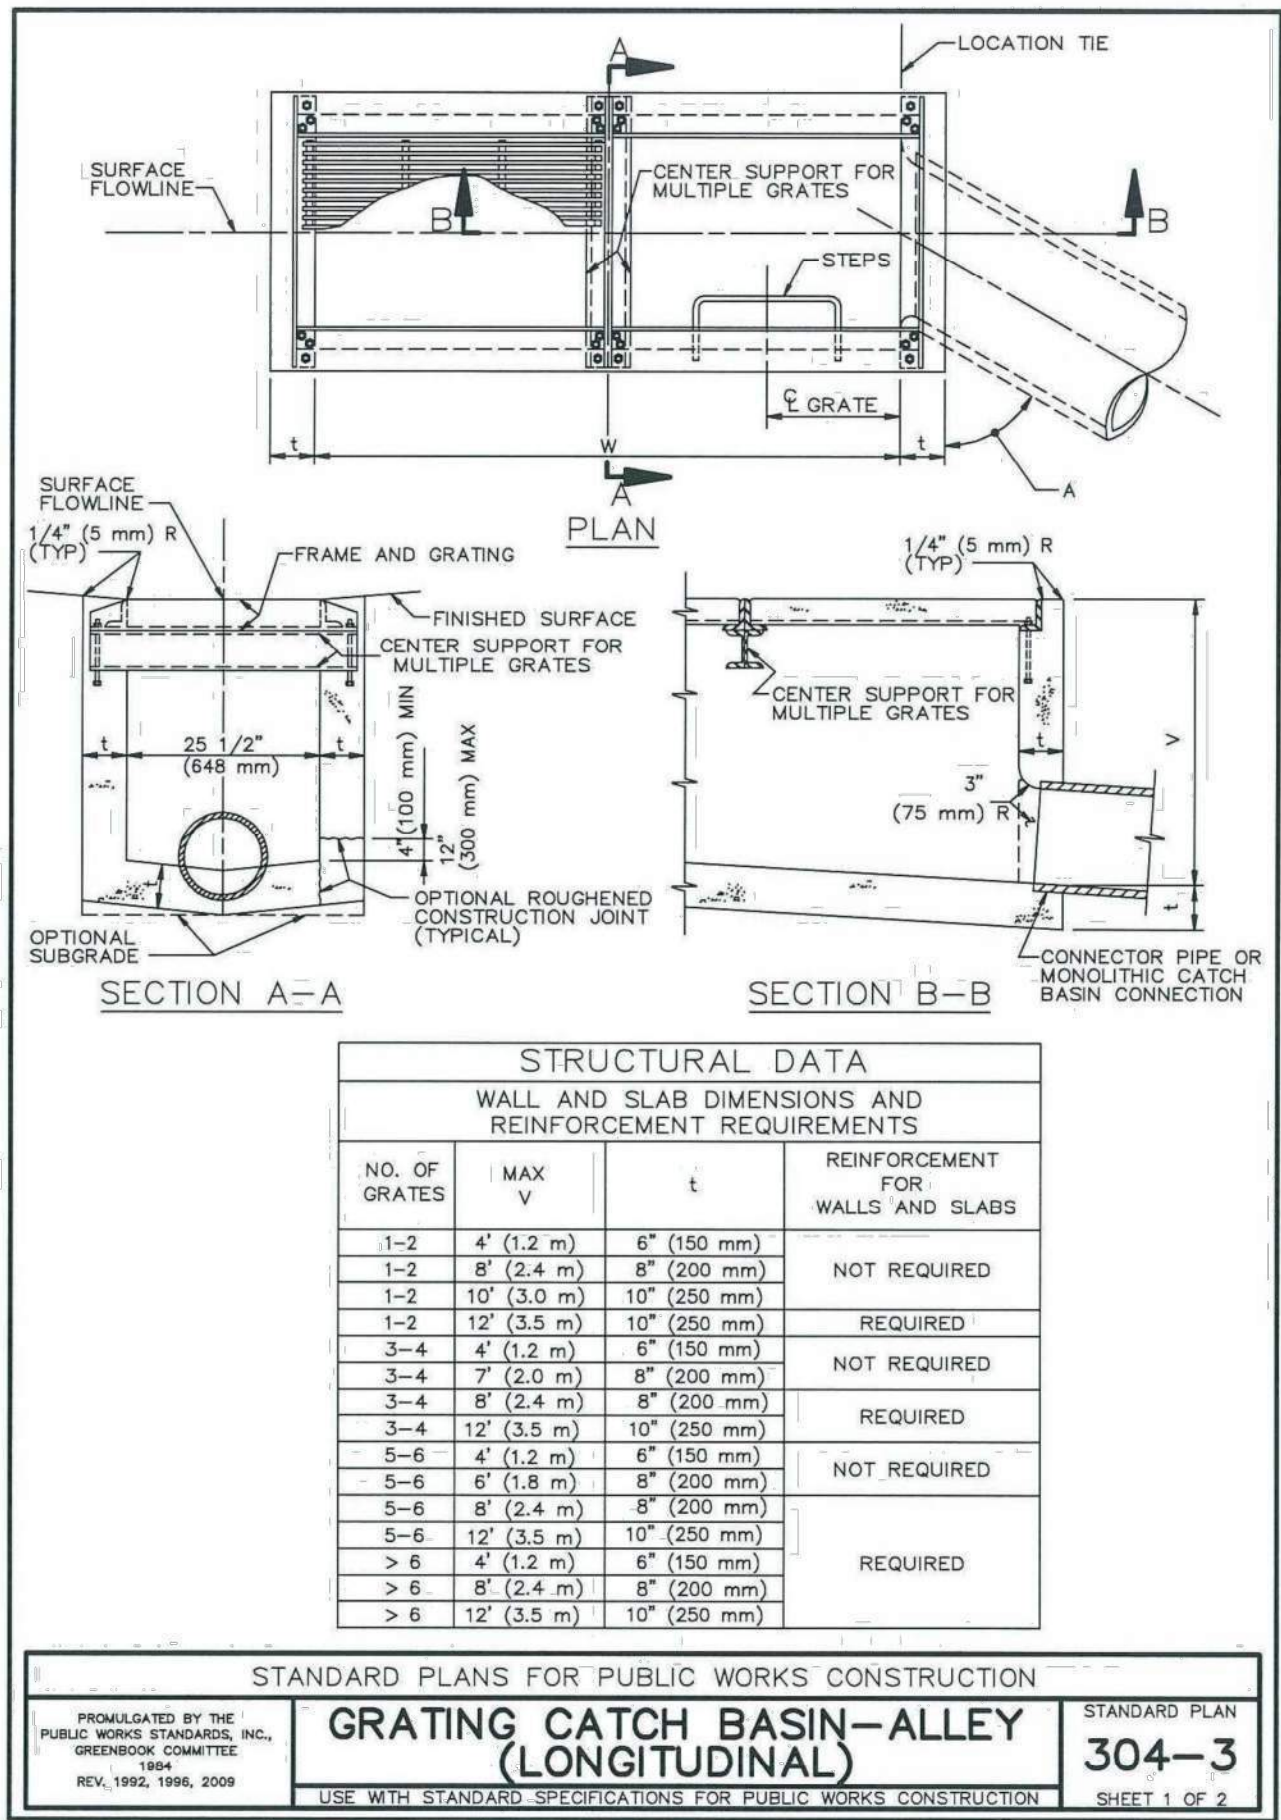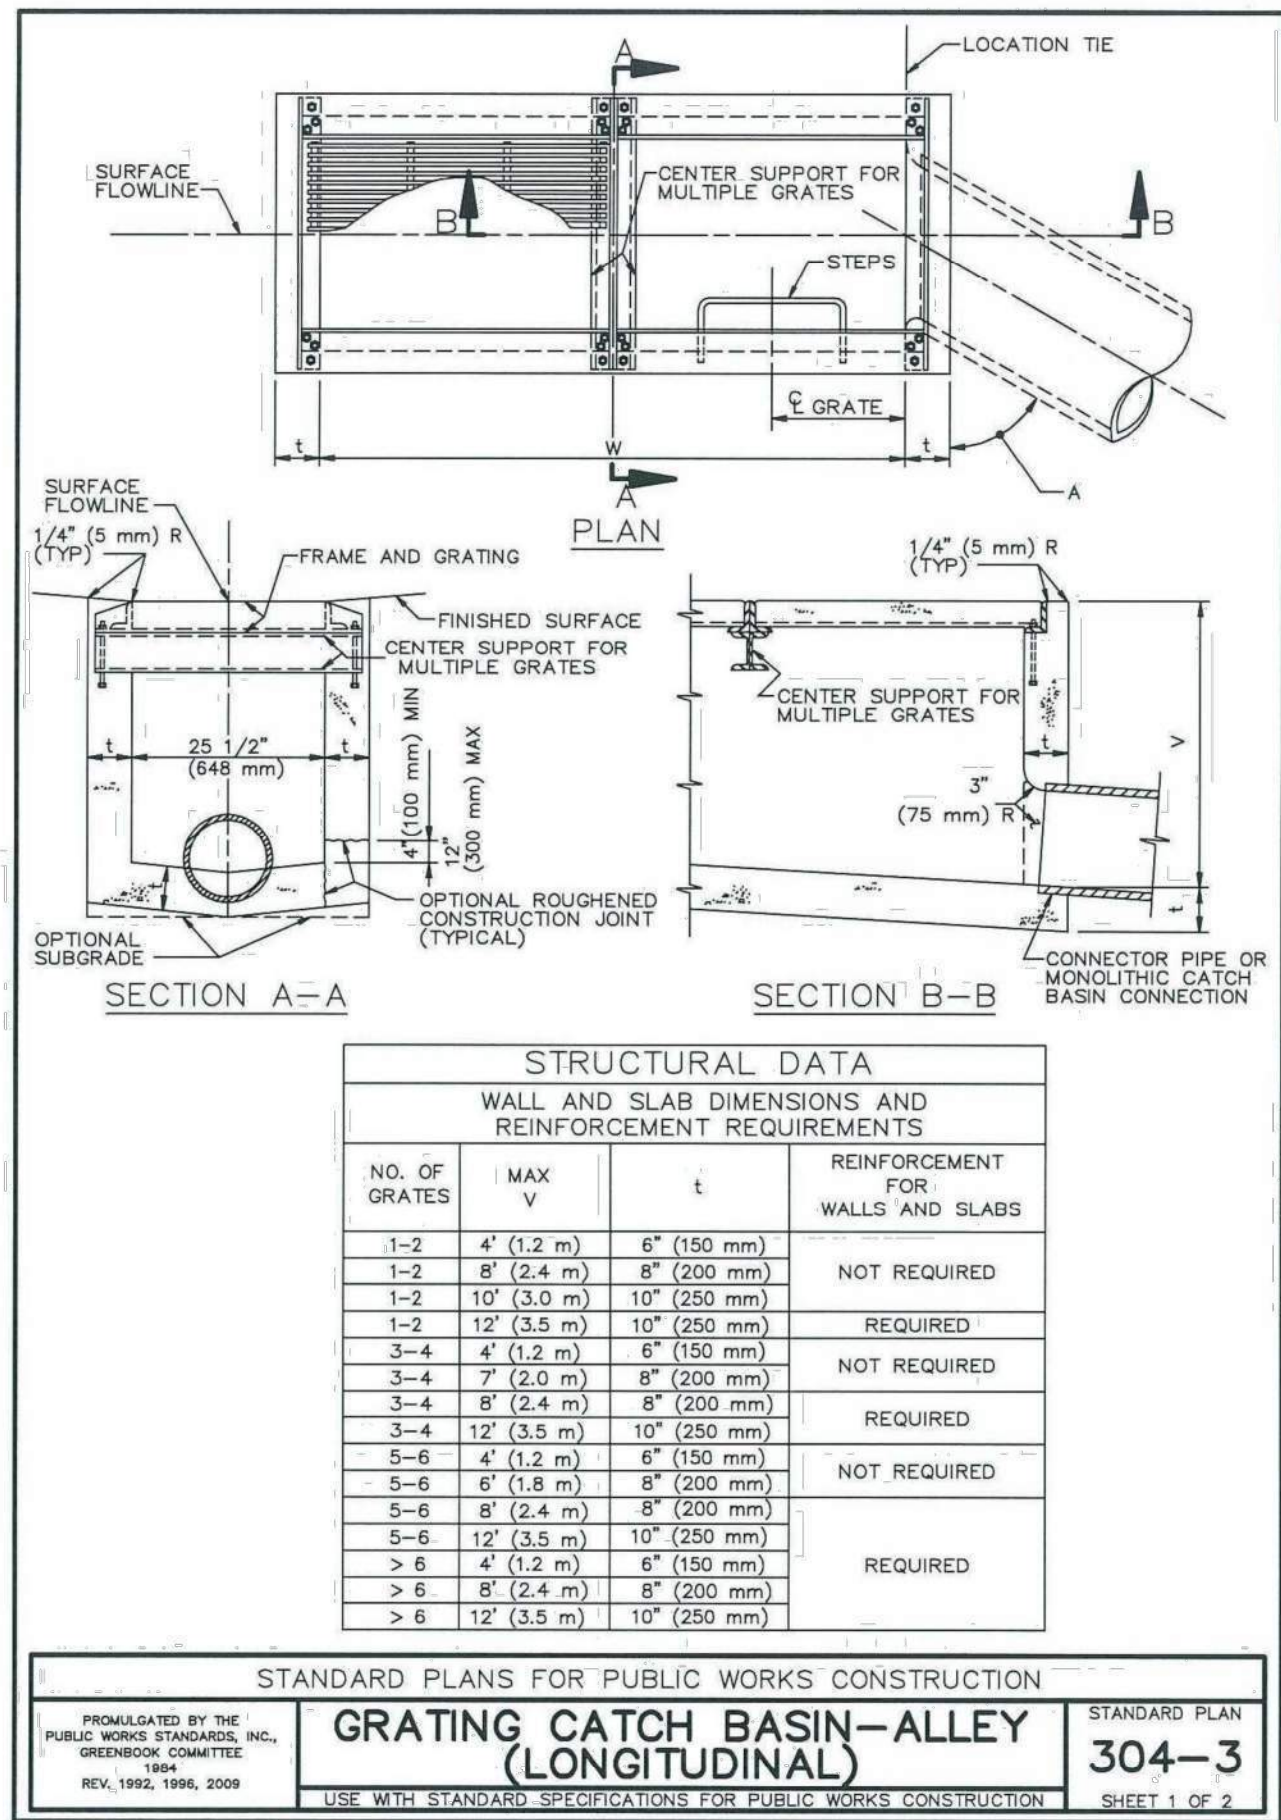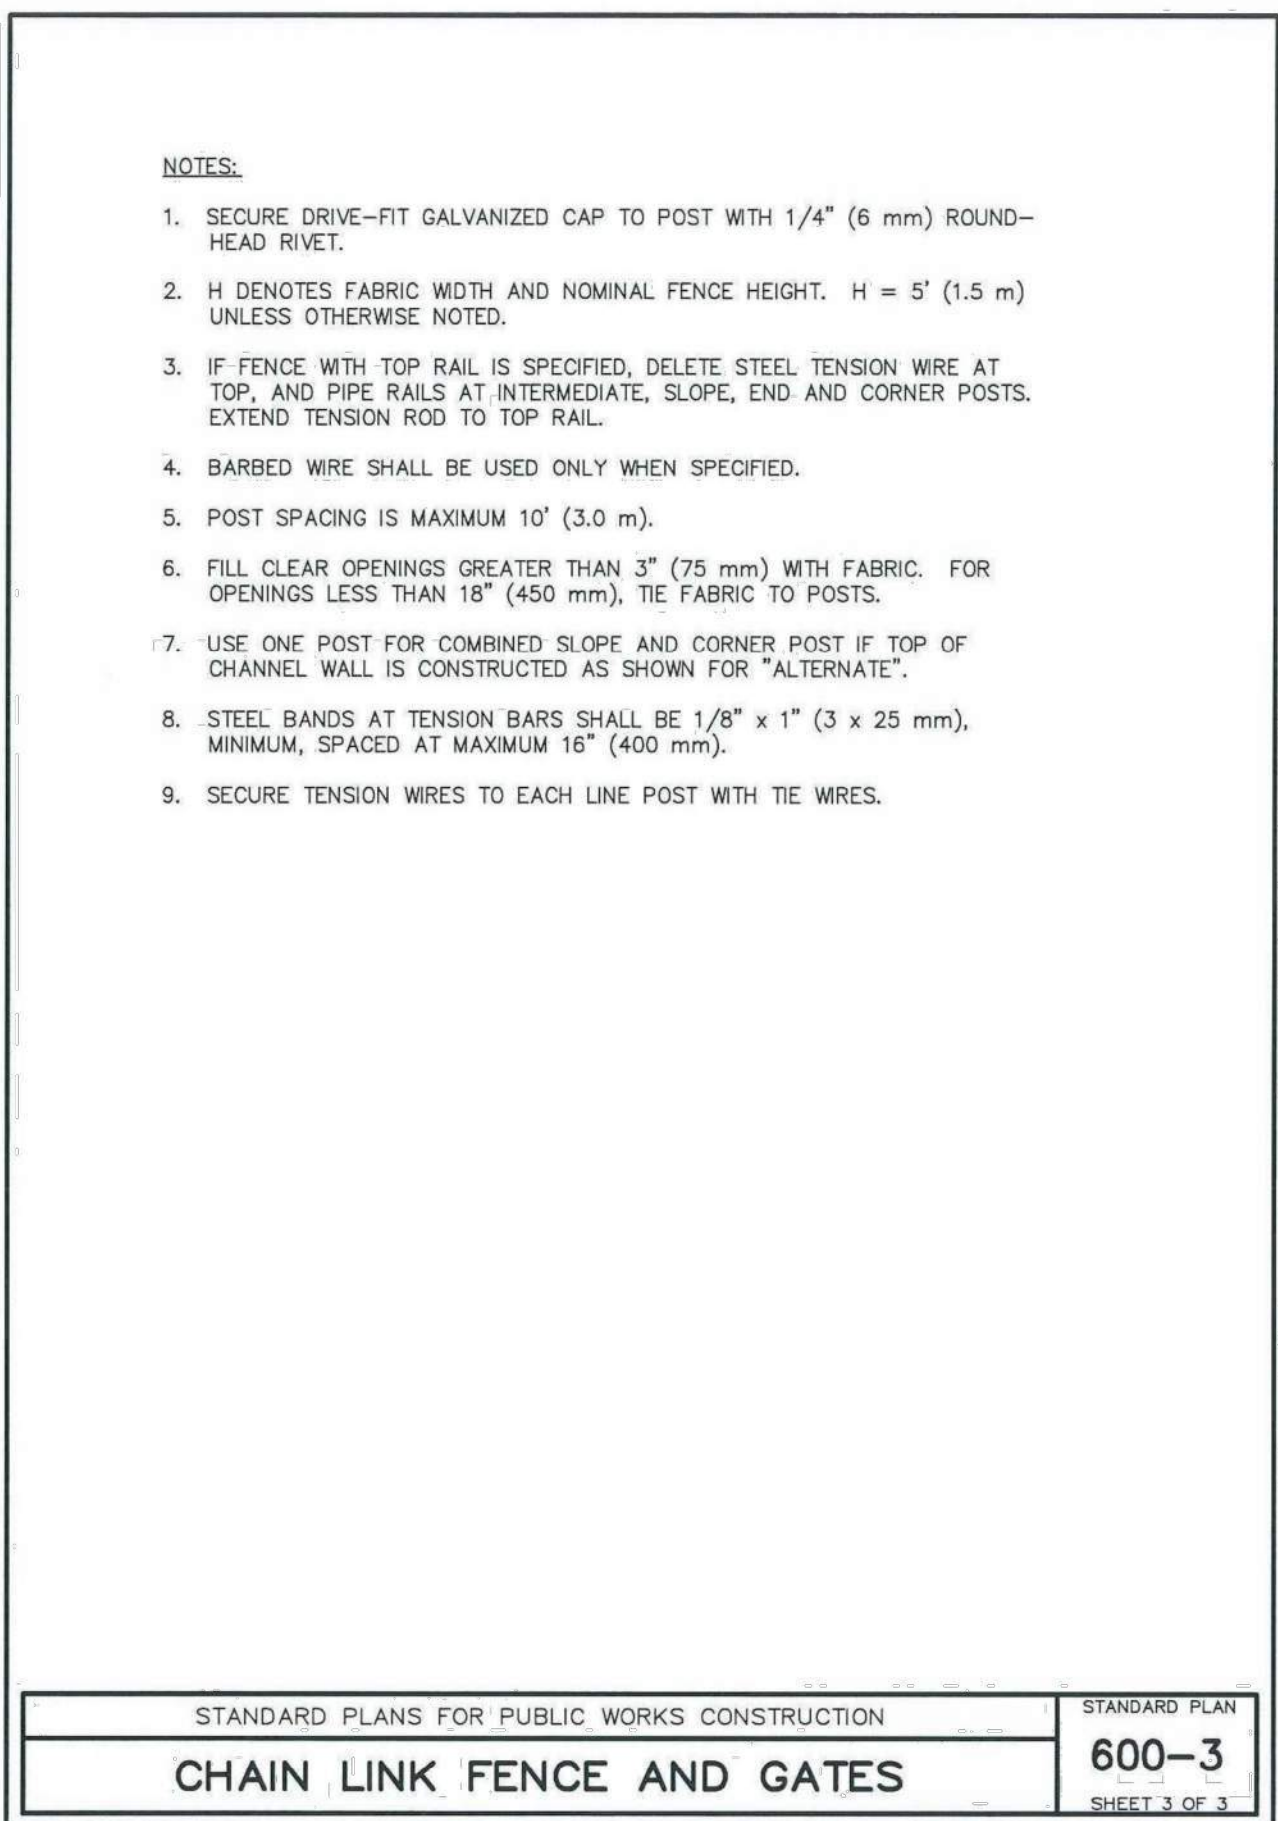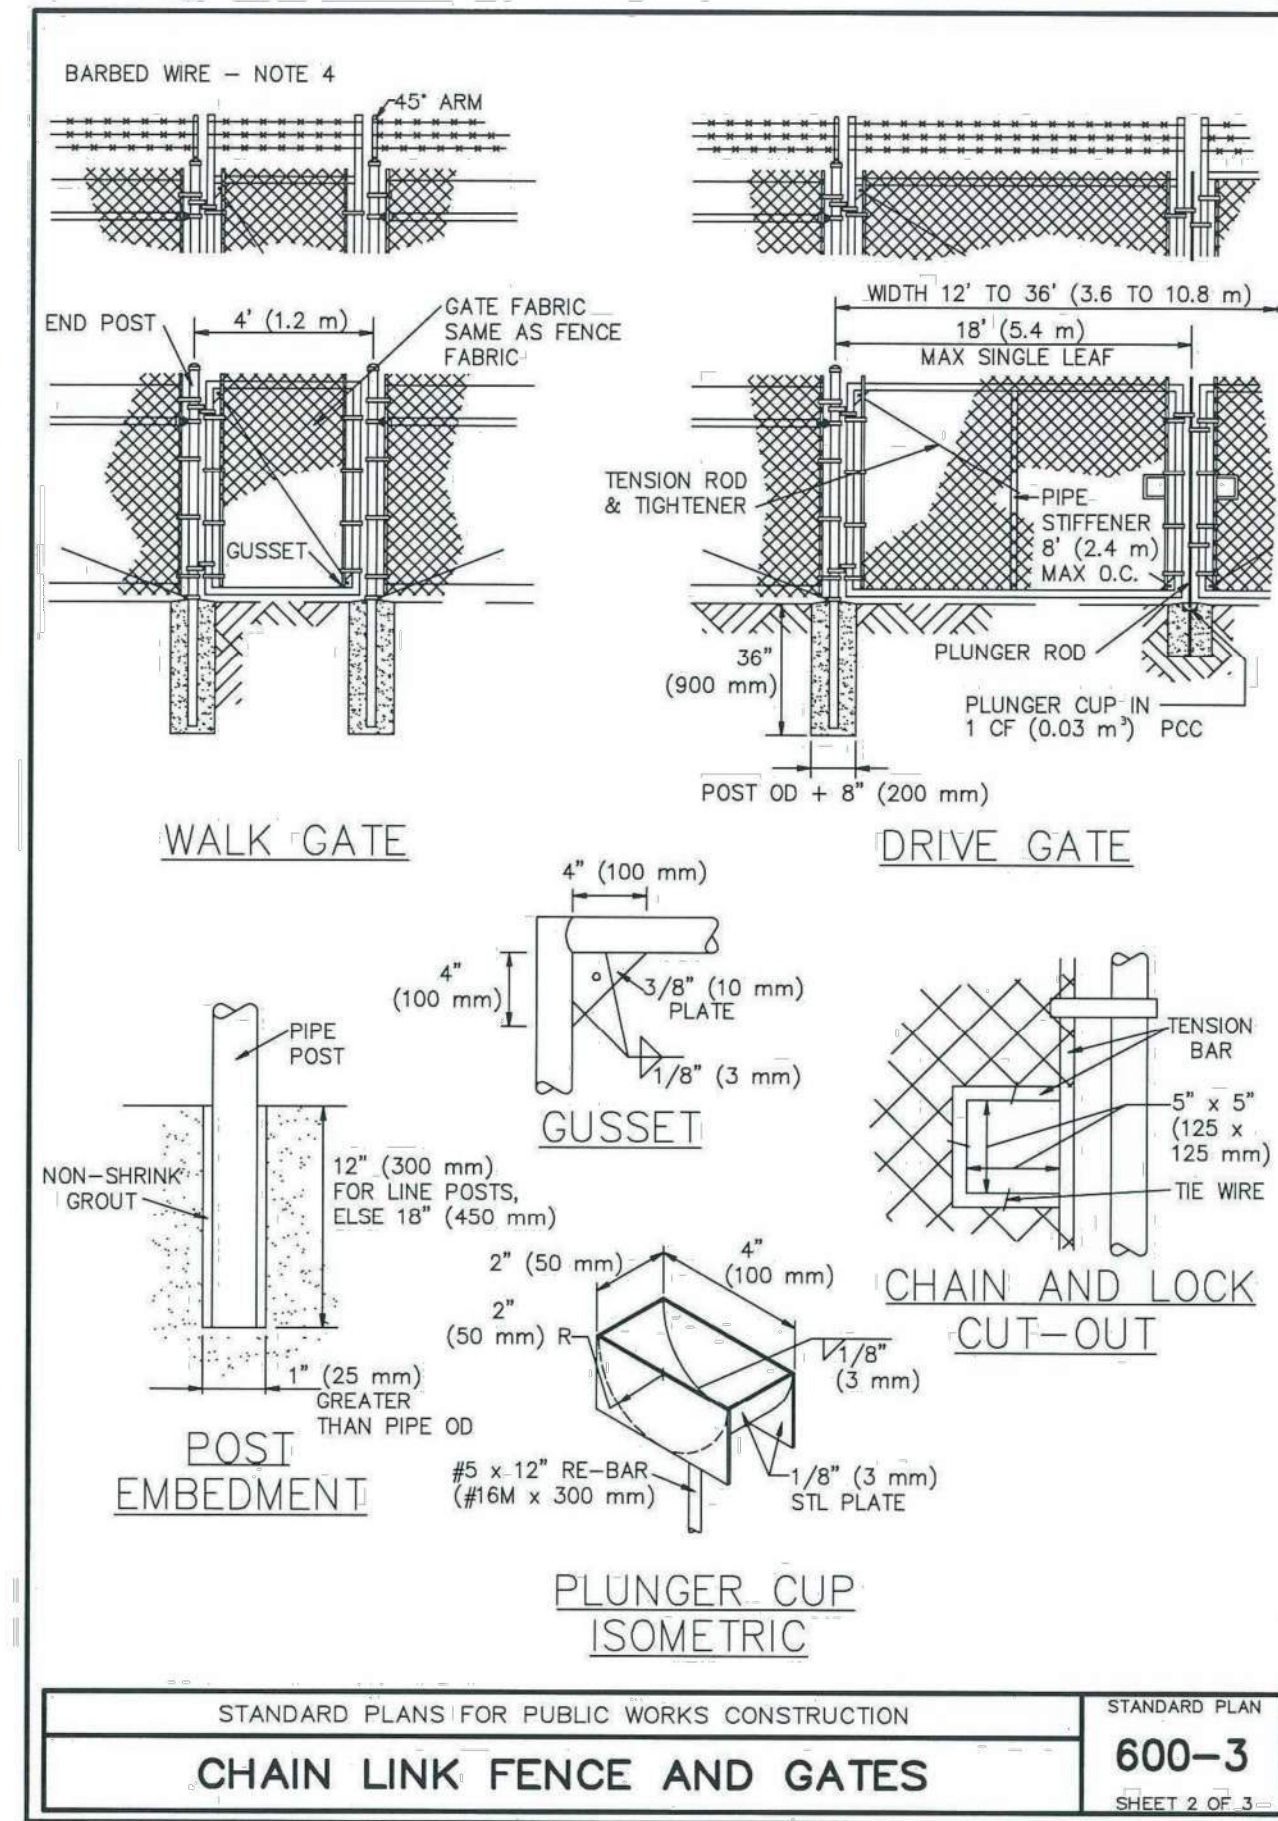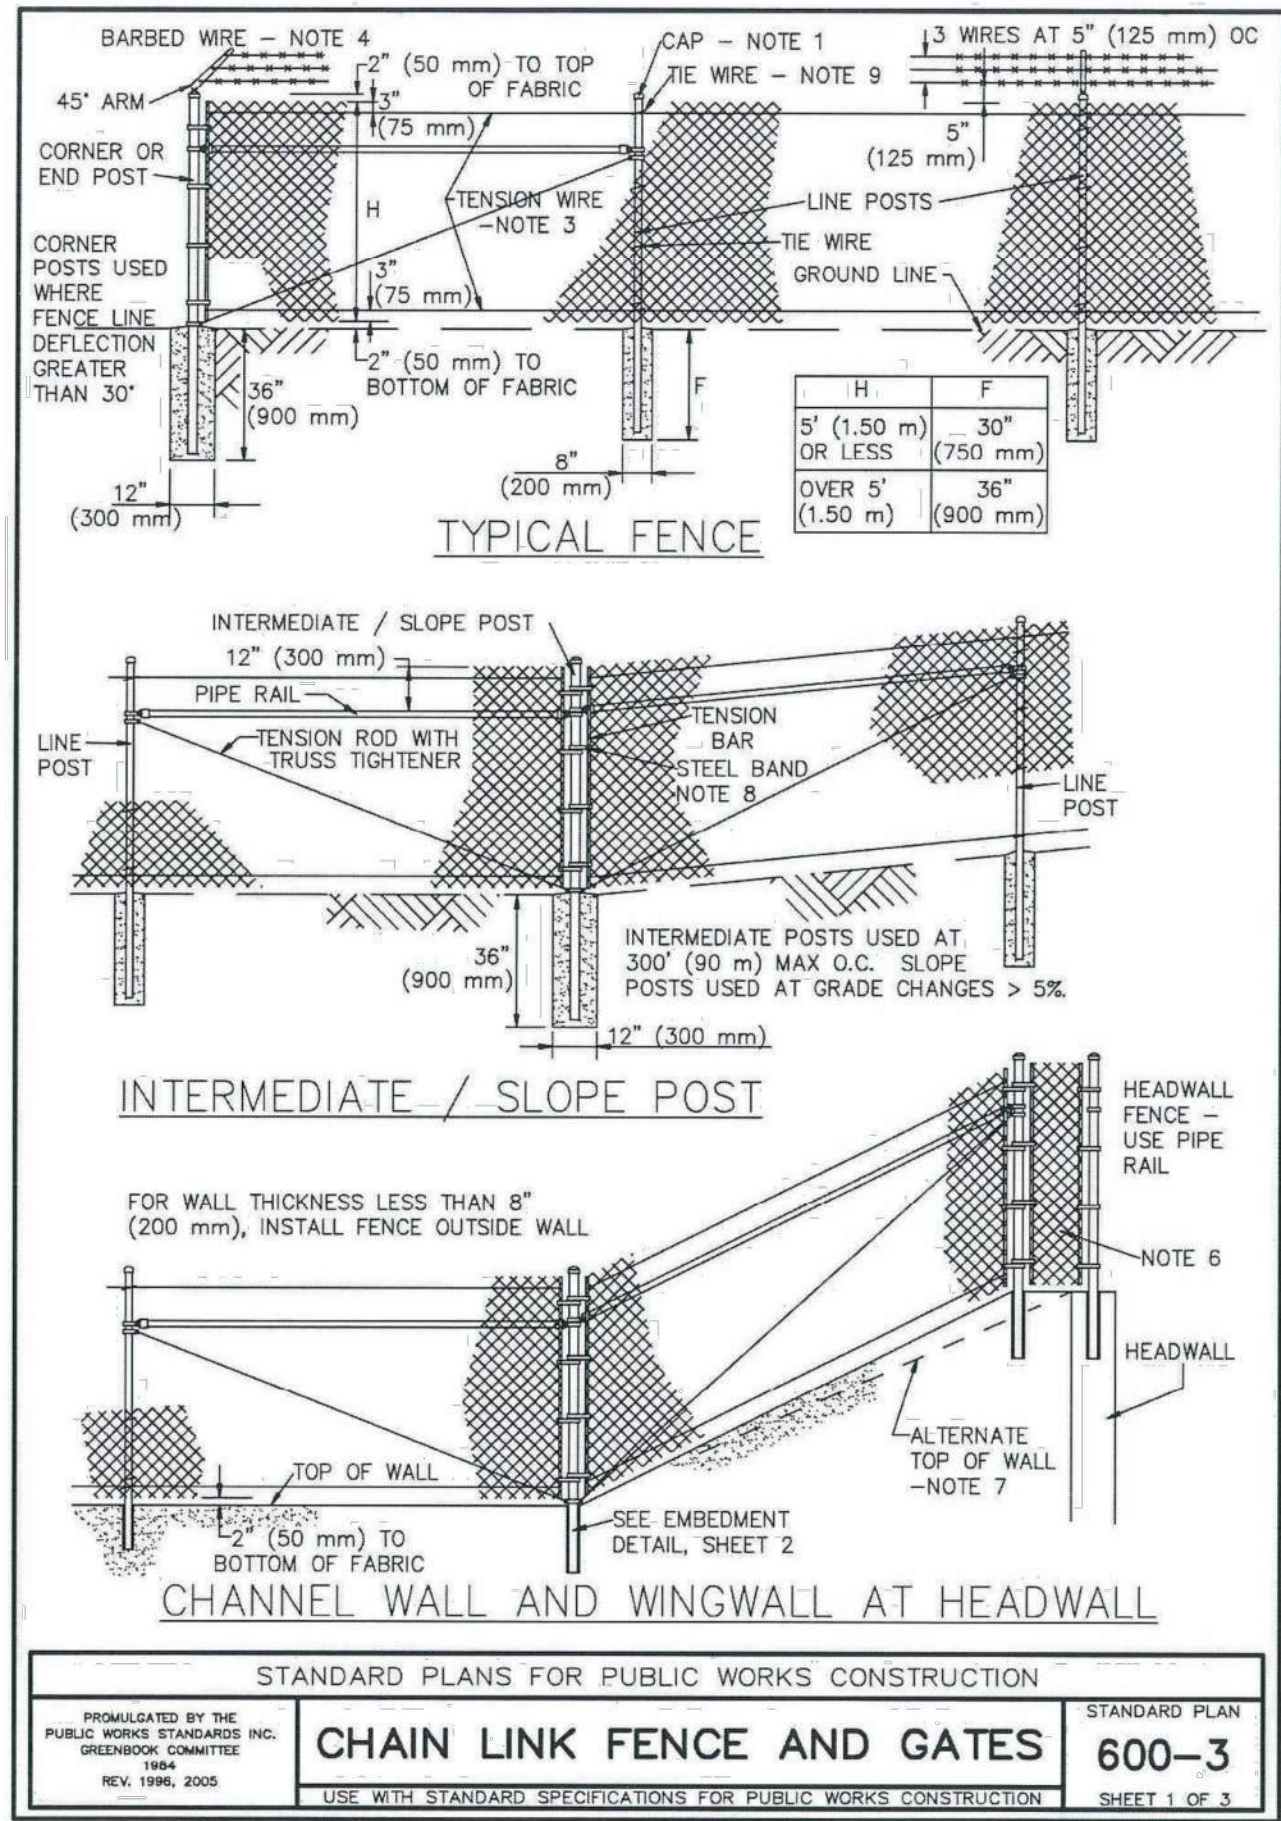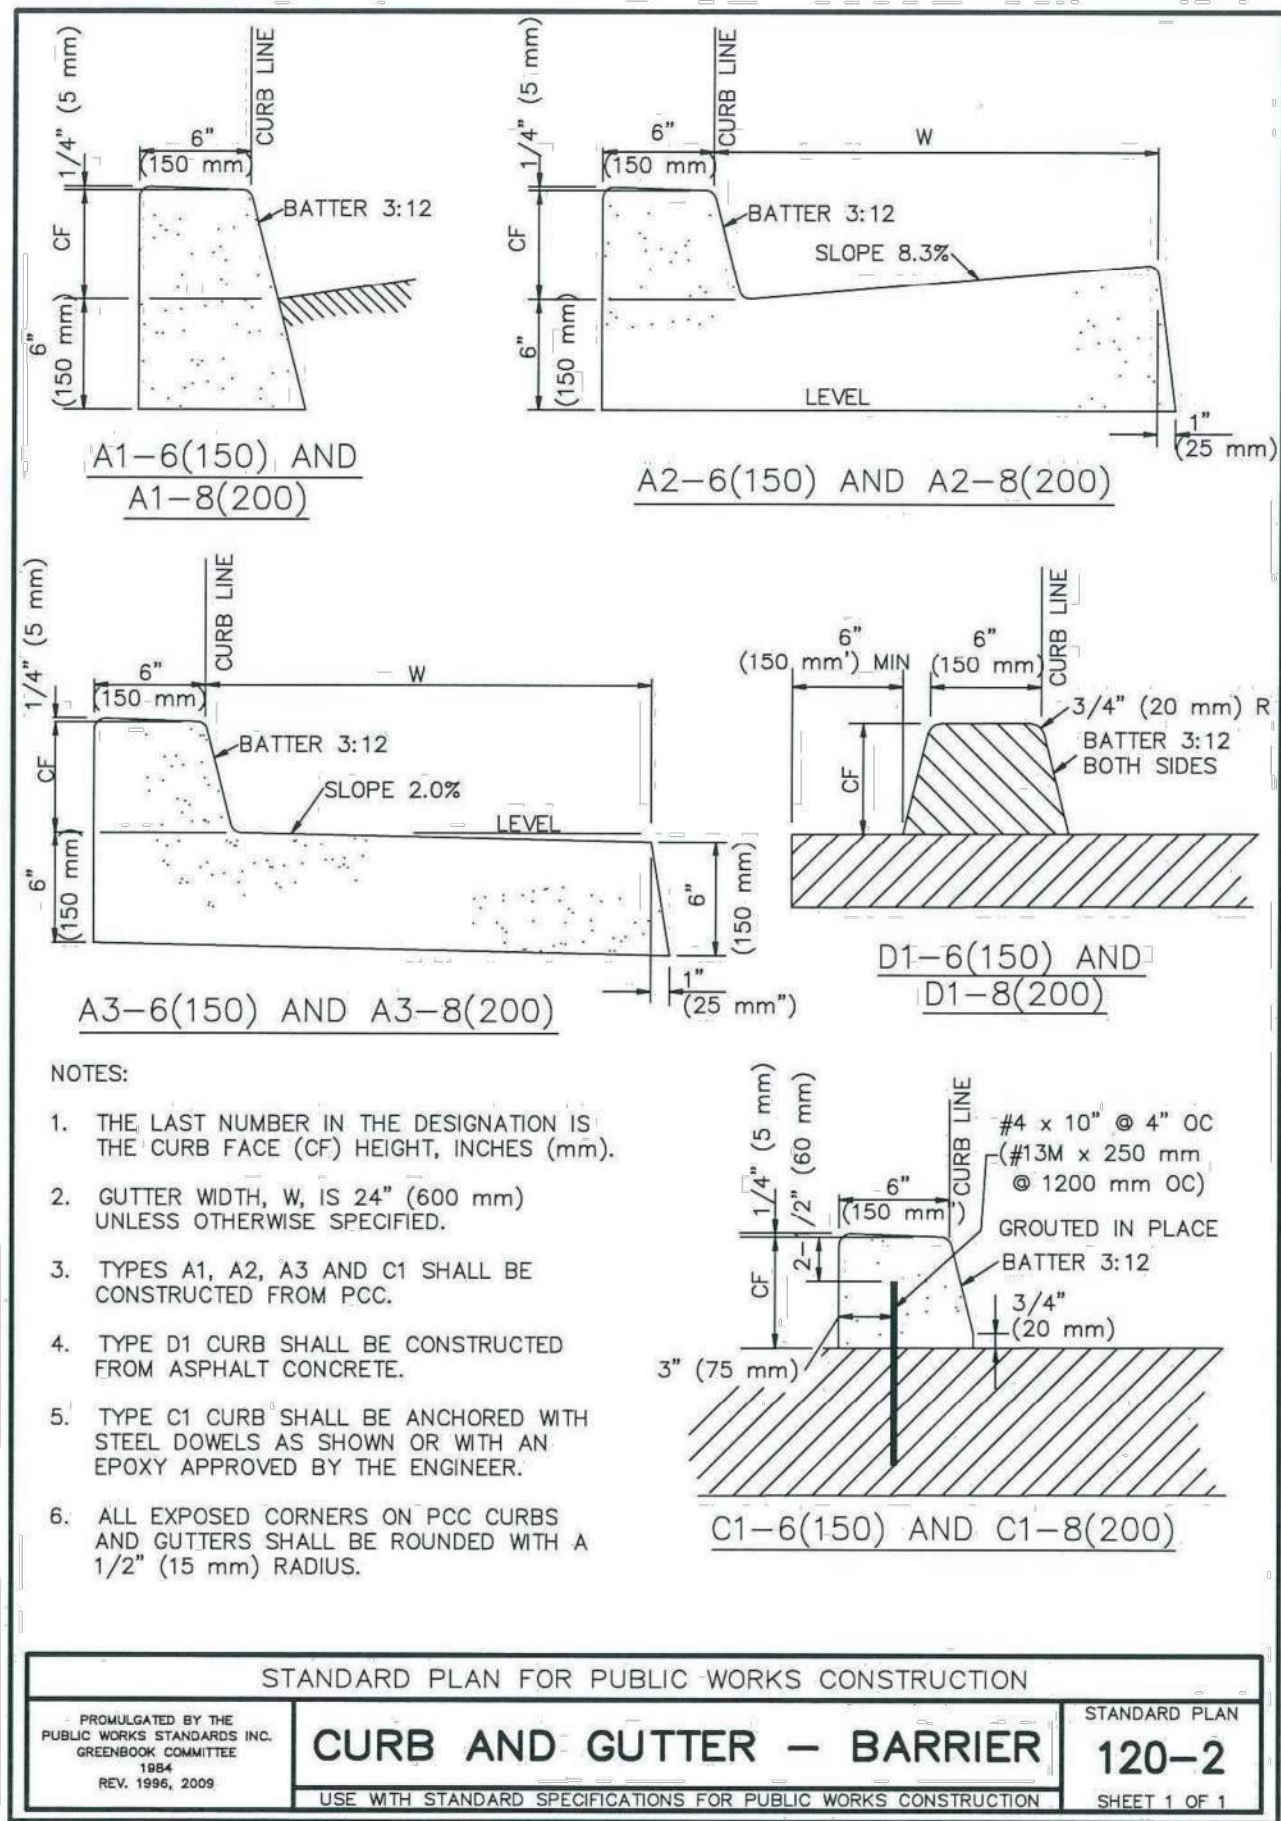

NO.	DATE	REVISIONS	ENGR.	APPROV.	DATE
7					
6					
5					
4					
3					
2					
1					
NO.	DATE	REVISIONS	ENGR.	APPROV.	DATE

PLAN PREPARED BY:
PROACTIVE
 ENGINEERING CONSULTANTS
 27042 Towne Centre Drive, Suite 110
 Foothill Ranch, CA 92610 (949) 716-7460

CONSTRUCTION PLANS FOR THE IMPROVEMENT OF
MARINE WAY
 STANDARD PLANS
 FROM SKYHAWK TO 3800' EAST

CITY OF IRVINE
 PUBLIC WORKS DEPARTMENT

PLAN CHECK NO. 00760917-EMC	PROJECT NO. 20.059
PERMIT NO. 00766614-MCE	SHEET 23
	OF 28

Δ = EXACT POLE LOCATIONS DETERMINED BY FIELD ENGINEER; POTHOLE POLE FOUNDATIONS PRIOR TO ORDERING POLES

8. THE CONTRACTOR SHALL GROUT ALL NEW PULL BOXES AND INCLUDE A 1" DRAIN.
9. ALL NEW VEHICLE INDICATIONS SHALL BE 12" RED, YELLOW, AND GREEN L.E.D. WITH METAL HOUSING AND BACK PLATES (SEE PROVISIONS FOR APPROVED MODELS).
10. NEW PEDESTRIAN INDICATIONS SHALL BE L.E.D. MODULE TYPE WITH AUDIBLE COUNTDOWN TIMER FUNCTION (SEE SPECIAL PROVISIONS FOR APPROVED MODELS).
11. THE ENGINEER SHALL APPROVE THE EXACT LOCATION OF ALL PULL BOXES, CONDUITS, LOOP DETECTORS, CONTROLLER AND POLES IN THE FIELD.
12. NEW LOOPS SHALL BE 6" DIA. TYPE E. LOOPS SHALL HAVE 4 TURNS.
13. ALL TRAFFIC LOOPS, SIGNING, PAVEMENT MARKERS AND STRIPING SHALL BE COMPLETED PRIOR TO TURN ON.
14. THE CONDUCTOR SCHEDULE IS FURNISHED AS AN INSTALLATION GUIDELINE ONLY. IT SHALL BE THE RESPONSIBILITY OF THE CONTRACTOR TO PROVIDE THE CORRECT CONDUCTORS REQUIRED FOR THE INTENDED OPERATION.
15. ALL WIRING AND EQUIPMENT SHALL BE MARKED (TAGGED) WITHIN THE CONTROLLER CABINET FOR PHASE IDENTIFICATION.
16. UNGROUNDED SIGNAL LIGHT CONDUCTORS SHALL NOT BE SPLICED.




CCTV FURNISH AND INSTALL IP-CCTV CAMERA AND WIRING TO SUPPORT IP-CCTV OPERATION PER PLAN. MODEL NO. AXIS Q6075-E CAMERA WITH AXIS T91A67 ARM (POE CAT5E).

NOTE: ALL EQUIPMENT SHALL BE NEW





PROPOSED BICYCLE VIDEO
DETECTION ZONE


NOTE: DETAILS FOR REFERENCE
AND NOT DRAWN TO SCALE

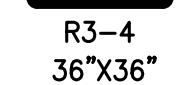



◆ SENSOR CHANNELS DESIGNATED FOR RIGHT TURN DELAY FUNCTIONALITY IN CONTROLLER

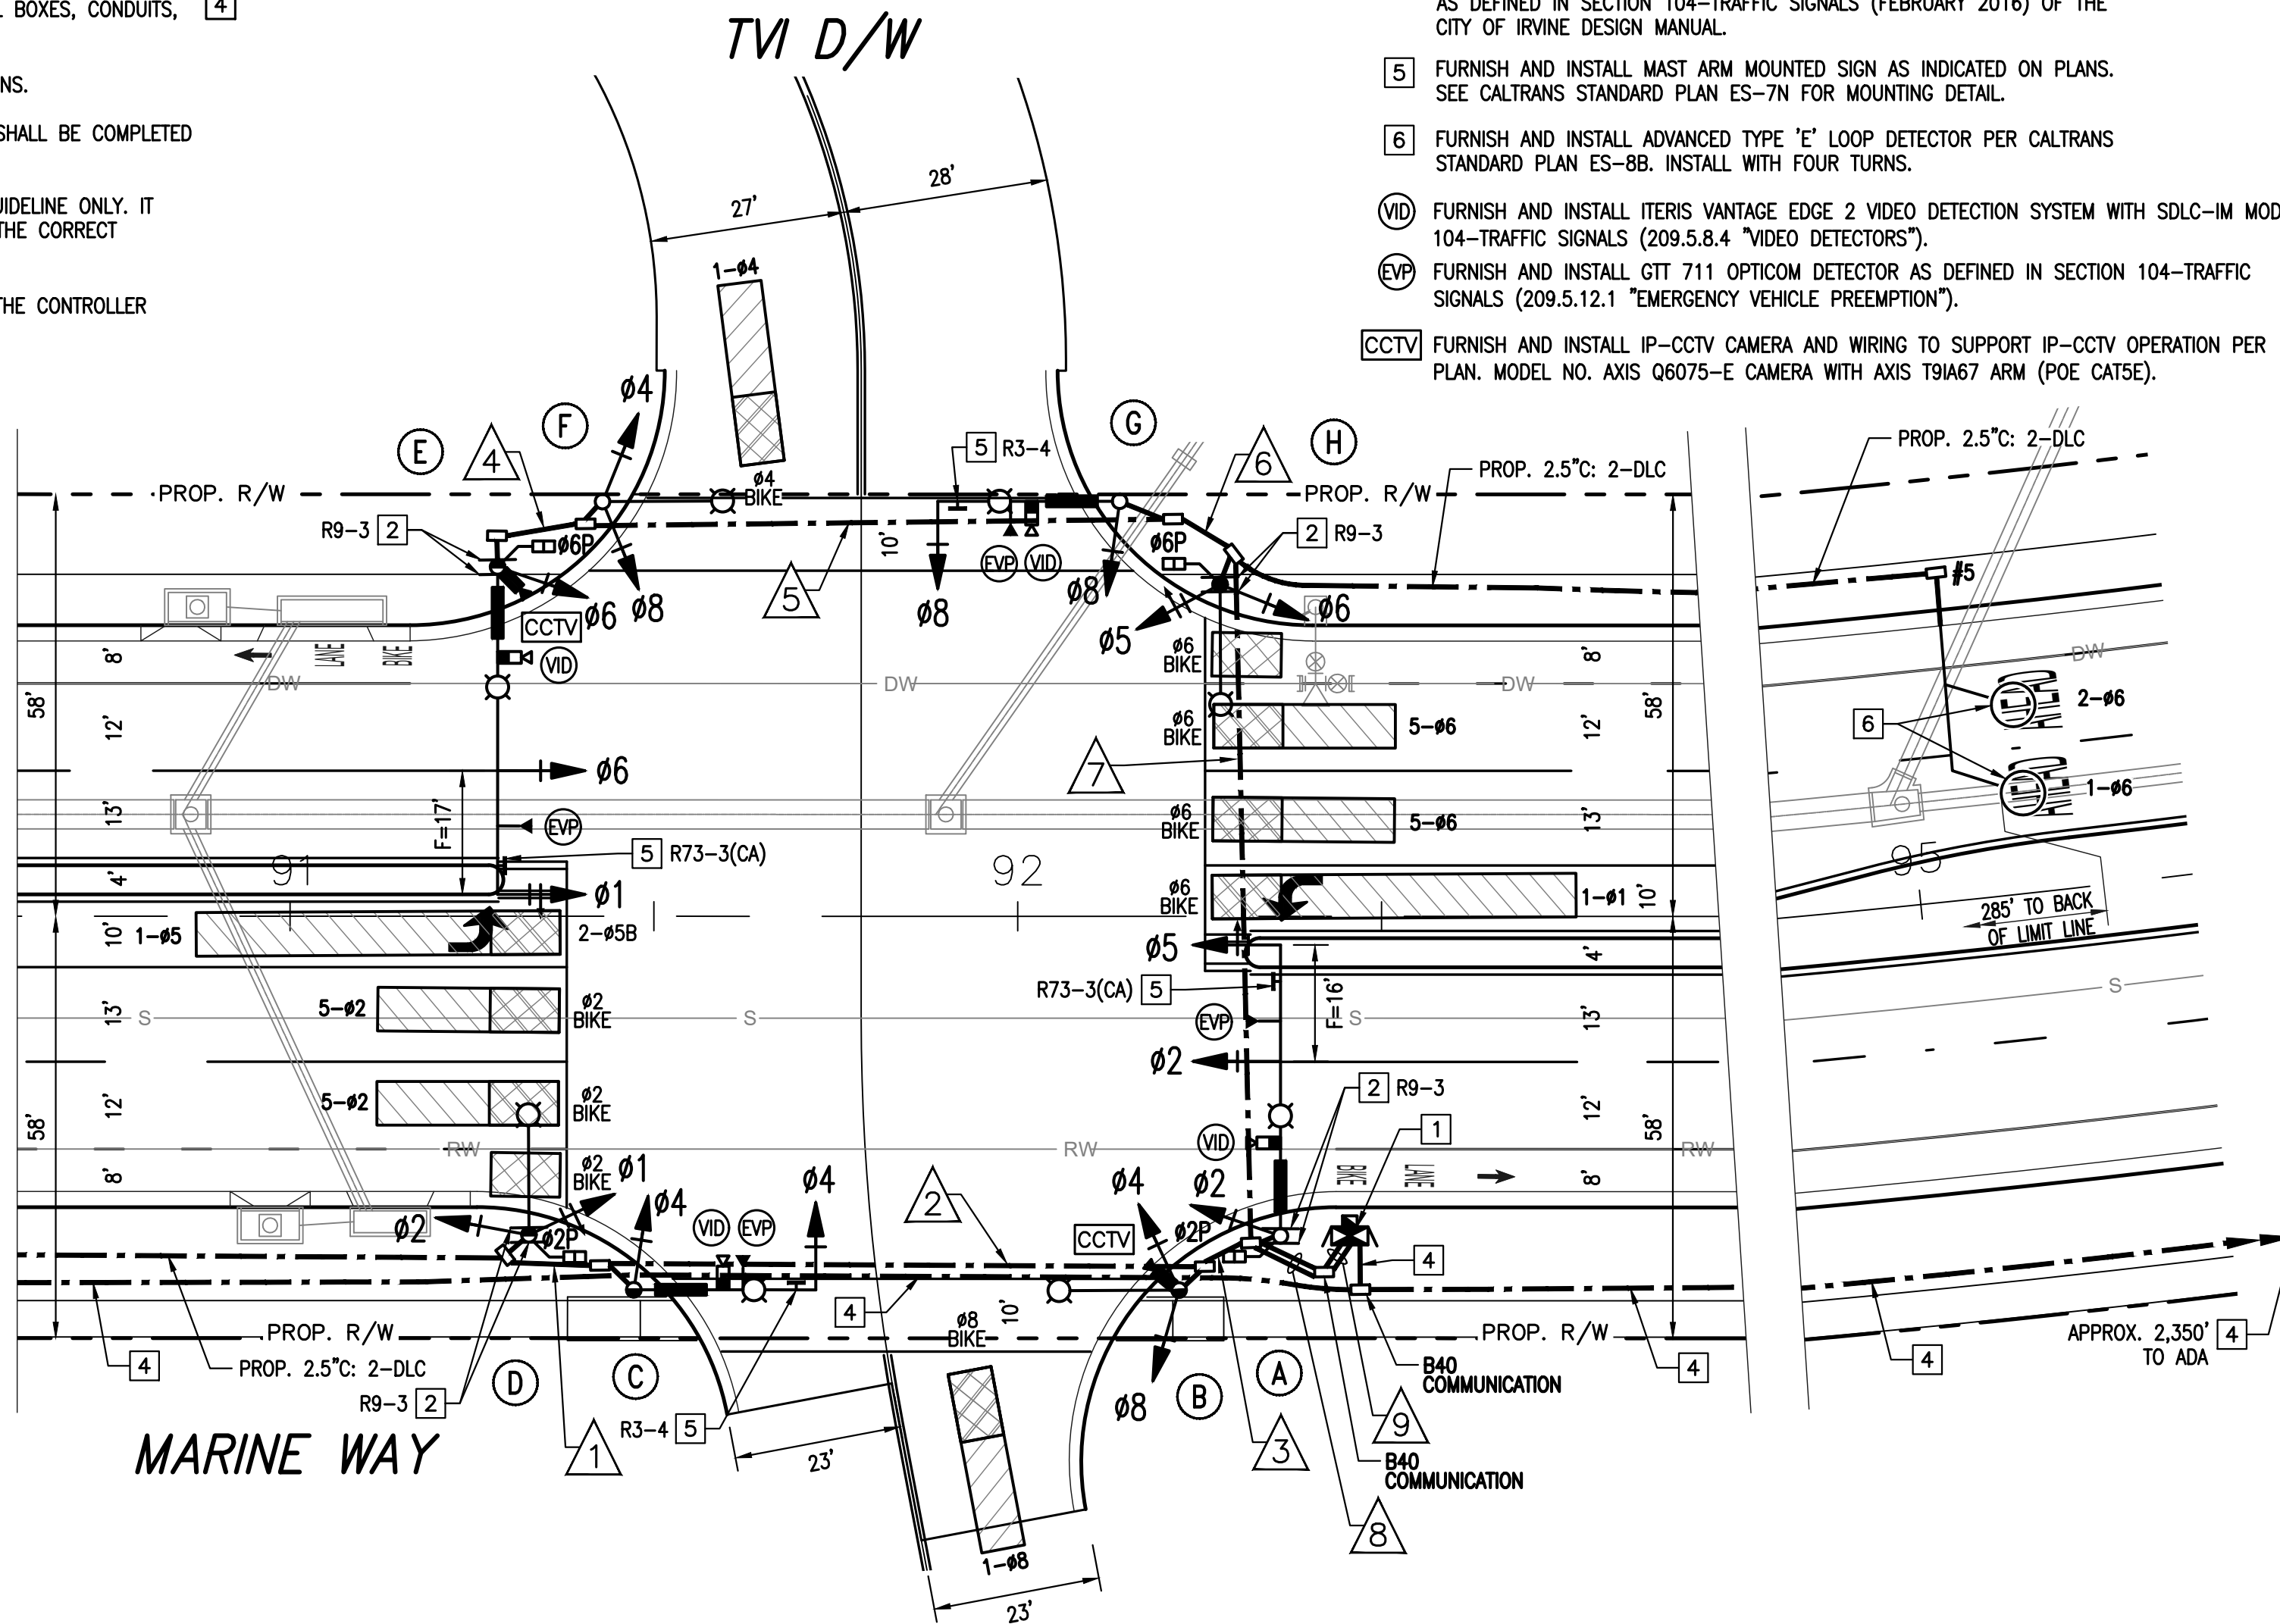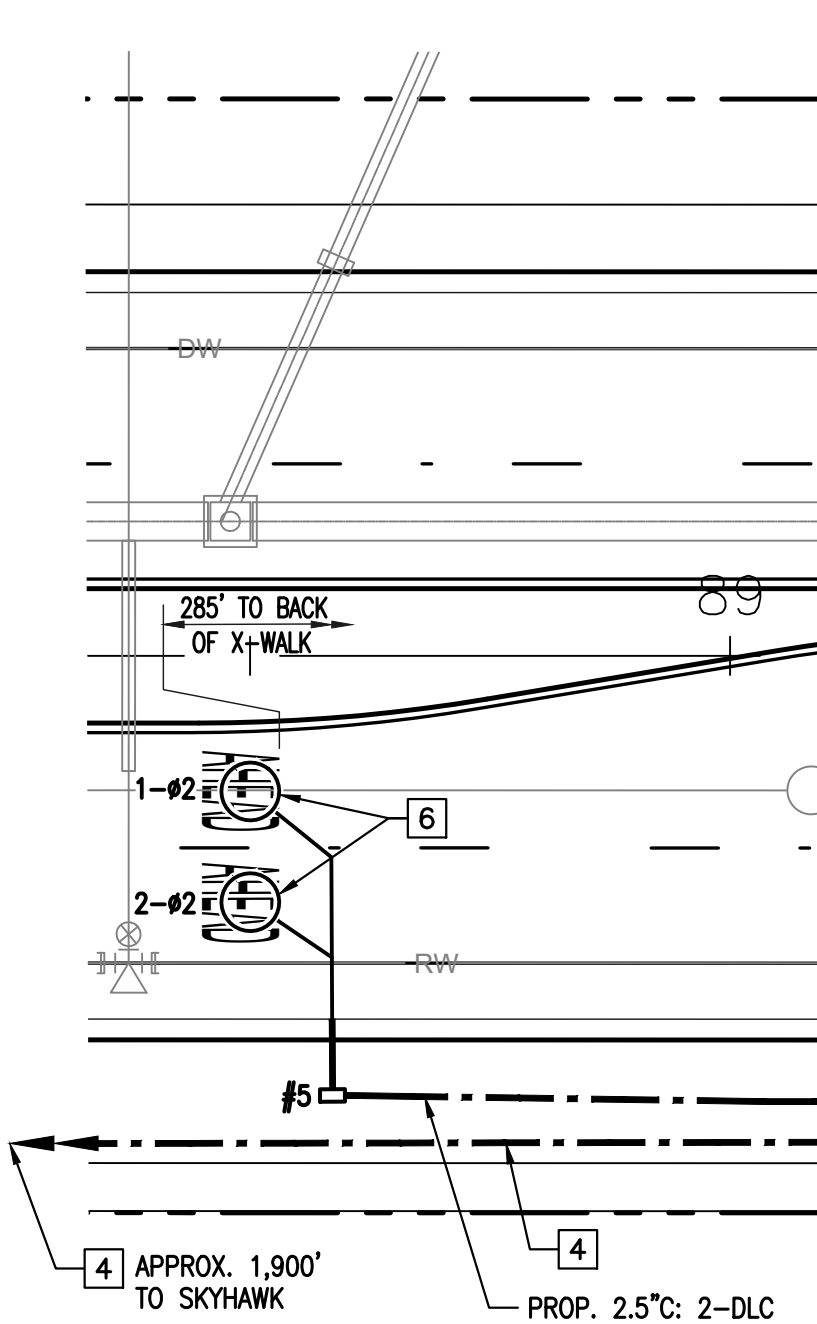

SCALE: 1" = 20'

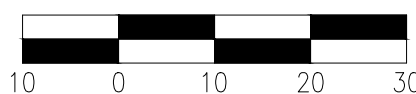

7								
6								
5								
4								
3								
2								
1								
NO.	DATE	REVISIONS	ENGR.	TJW	APPROV.	DATE	CHECKED BY:	DATE

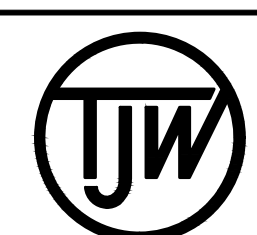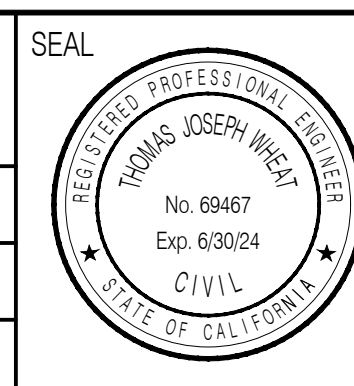

TJW ENGINEERING, INC.
Traffic Engineering &
Transportation Planning Consultants
41 Irvine Center Dr., Suite 200, Irvine, CA 92618
t: (949) 878-3509 f: (949) 878-3593
www.tjwengineering.com

FOR PLANCHECK ONLY

THOMAS JOSEPH WHEAT R.C.E. No. 69467

Exp. 6/30/24

MARINE WAY at
SECOND HARVEST PROP. D/W

CITY OF IRVINE
PUBLIC WORKS DEPARTMENT

PLAN CHECK NO.

PERMIT NO.

PROJECT NO.

SHEET

25
OF 28




Know what's below.
Call before you dig.

1. SIGNING AND STRIPING SHALL CONFORM TO PART 2 SIGNS AND PART 3 MARKINGS OF THE CALIFORNIA MANUAL ON UNIFORM TRAFFIC CONTROL DEVICES (CA MUTCD) AND ANY ADDENDUMS THERE TO OR LATEST EDITION, THESE PLANS AND SPECIAL PROVISIONS.
2. DETAIL 9 LANE LINE STRIPING PATTERN IN PART 3 MARKINGS SHALL BE USED ON ALL MULTILANE STREETS REGARDLESS OF STREET DESIGN SPEED.
3. PAVEMENT LEGENDS SHALL MATCH THE CITY STENCILS OR EQUIVALENT,
4. ALL STRIPING AND PAVEMENT MARKINGS SHALL BE REFLECTORIZED AND APPLIED IN TWO COATS. A MINIMUM OF SEVEN DAYS SHALL BE PROVIDED BETWEEN FIRST AND SECOND COATS.
5. ALL CONFLICTING STRIPINGS, PAVEMENT MARKINGS, AND CURB PAINT SHALL BE REMOVED BY WET SANDBLASTING OR OTHER APPROVED METHOD PRIOR TO INSTALLATION OF NEW STRIPING. ALL CONFLICTING RAISED PAVEMENT MARKERS SHALL BE REMOVED.
6. PAVEMENT THAT IS DAMAGED DUE TO REMOVAL OF MARKERS OR STRIPING SHALL BE REPAIRED TO THE SATISFACTION OF THE CITY INSPECTOR.
7. THE CONTRACTOR SHALL CONTACT THE CITY OF IRVINE INSPECTION SERVICES FOR INSPECTION 48 HOURS PRIOR TO BEGINNING OF CONSTRUCTION.
8. THE CONTRACTOR SHALL VERIFY ALL EXISTING CONDITIONS AND DIMENSIONS BEFORE STARTING WORK IF CONDITIONS EXIST WHICH ARE CONTRARY TO THOSE SHOWN ON THESE PLANS. THE CITY OF IRVINE INSPECTION SERVICES SHALL BE NOTIFIED BEFORE PROCEEDING WITH WORK.
9. ALL WORK SHALL CONFORM TO THE PLANS AND SPECIFICATIONS IN ALL RESPECTS AND SHALL BE SUBJECT TO APPROVAL BY THE CITY ENGINEER.
10. ALL TRAFFIC CONTROL WORK FOR CONSTRUCTION SHALL CONFORM TO PART 6 – TEMPORARY TRAFFIC CONTROL OF THE CALIFORNIA MANUAL ON UNIFORM TRAFFIC CONTROL DEVICES (CA MUTCD) AND ANY ADDENDUMS THERE TO OR LATEST EDITION AND ALL O.S.H.A. REQUIREMENTS.

11. THE CONTRACTOR SHALL HAVE ALL TRAFFIC CONTROL CONSTRUCTION SIGNS, DELINEATORS, ETC., PROPERLY INSTALLED PRIOR TO COMMENCING CONSTRUCTION.
12. THE CONTRACTOR SHALL MAINTAIN ALL TRAFFIC CONTROL SIGNS, DELINEATORS, ETC., TO ENSURE PROPER FLOW AND SAFETY OF TRAFFIC WHILE WORKING IN THE STREET.
13. ADDITIONAL TRAFFIC CONTROL DEVICES MAY BE REQUIRED IN THE FIELD. THE CONTRACTOR SHALL BE RESPONSIBLE FOR ANY ADDITIONAL TRAFFIC CONTROL DEVICES REQUIRED BY THE CITY INSPECTOR/ REPRESENTATIVE TO ASSURE PUBLIC SAFETY AT ALL TIMES.
14. THE CONTRACTOR SHALL UTILIZE A FLAGMAN DURING CONSTRUCTION WORK AS DEEMED NECESSARY BY THE CITY INSPECTOR.
15. ARROW BOARDS SHALL BE USED ON ANY LANE CLOSURE ON ARTERIAL STREETS.
16. STRIPING SHALL BE CAT TRACKED AND APPROVED BY THE CITY INSPECTOR PRIOR TO FINAL INSTALLATION.
17. CROSSWALK SHALL CONFORM TO THE CITY OF IRVINE STANDARD PLAN NO. 203.
18. ALL SIGN FACE REFLECTIVE SHEETING SHALL BE HIGH INTENSITY GRADE WITH PROTECTIVE OVERLAY FILM.
19. ALL SIGN POSTS SHALL BE 2"x2" PERFORATED SQUARE TUBE INSTALLED WITH ACCOMPANYING SLEEVE PER THE CITY OF IRVINE REQUIREMENTS. CITY OF IRVINE SPECIAL SIGN R26EB SIGN SHALL BE INSTALLED ON "U" CHANNEL POST OR ON STREET LIGHT POLE.
20. ADVANCED STREET NAME SIGNS AND STREET NAME SIGNS SHALL BE SILVER LETTERS WITH "IRVINE BROWN" BACKGROUND.
21. BLUE RAISED REFLECTIVE PAVEMENT MARKERS SHALL BE INSTALLED ADJACENT TO ALL EXISTING FIRE HYDRANTS IN ACCORDANCE WITH THE LATEST EDITION OF THE CALIFORNIA MANUAL ON UNIFORM TRAFFIC CONTROL DEVICES (CA MUTCD).

 R26(S)(CA) 12"x18"	 W9-1 36"x36"	 R6-2 30"x36"	 TYPE N-1(CA) 18"x18"	 W4-2(R) 36"x36"	 R3-7(R) 36"x36"	 R4-7 24"x30"	 W16-1P 18"x24"
 W1-4(R) 36"x36"	 W1-7 48"x24"	 R81(CA) 12"x8"	 W11-1 30"x30"	 W6-3 36"x36"	 W3-3 36"x36"	 R6-1(R) 54"x18"	 R81B(CA) 8"x5"



(E)	EXISTING SIGN TO REMAIN.
(FH)	INSTALL BLUE REFLECTIVE FIRE HYDRANT PAVEMENT MARKER PER CA MUTCD AND CALTRANS STANDARDS.
(IS)	INSTALL SIGN AND POST.
(RL)	RELOCATE EXISTING SIGN.
(RS)	REMOVE AND SALVAGE EXISTING SIGN AND POST.
(PM)	INSTALL THERMOPLASTIC PAVEMENT MARKING AS SHOWN PER CA--MUTCD STANDARDS.
(TX)	INSTALL THERMOPLASTIC 12" SOLID WHITE LIMIT LINE OR CROSSWALK PER CA--MUTCD STANDARDS.
(XX)	REMOVE CONFLICTING STRIPING OR MARKINGS BY WET SANDBLASTING PROCESS.
(T6)	INSTALL THERMOPLASTIC 6" SOLID WHITE LANE LINE STRIPE.
(9)	INSTALL THERMOPLASTIC 6" WHITE LANE LINE SKIP STRIPE PER CALTRANS STD. PLAN A20A - DETAIL 9.
(22)	INSTALL THERMOPLASTIC 6" DOUBLE YELLOW CENTERLINE STRIPE PER CALTRANS STD. PLAN A20A - DETAIL 22
(26)	INSTALL RED--YELLOW RETROREFLECTIVE MARKER LEFT EDGELINE ALONG RAISED MEDIAN PER CALTRANS STD. PLAN A20B - DETAIL 26.
(29)	INSTALL THERMOPLASTIC 6" DOUBLE YELLOW MEDIAN STRIPE PER CALTRANS STD. PLAN A20B - DETAIL 29.
(38)	INSTALL THERMOPLASTIC 8" WHITE CHANNELIZING LANE LINE STRIPE PER CALTRANS STD. PLAN A20D - DETAIL 38.
(39)	INSTALL THERMOPLASTIC 6" WHITE BIKE LANE STRIPE PER CALTRANS STD. PLAN A20D - DETAIL 39.
(39A)	INSTALL THERMOPLASTIC 6" WHITE BIKE LANE INTERSECTION STRIPE PER CALTRANS STD. PLAN A20D - DETAIL 39A.
(S)	SIGNALIZED INTERSECTION

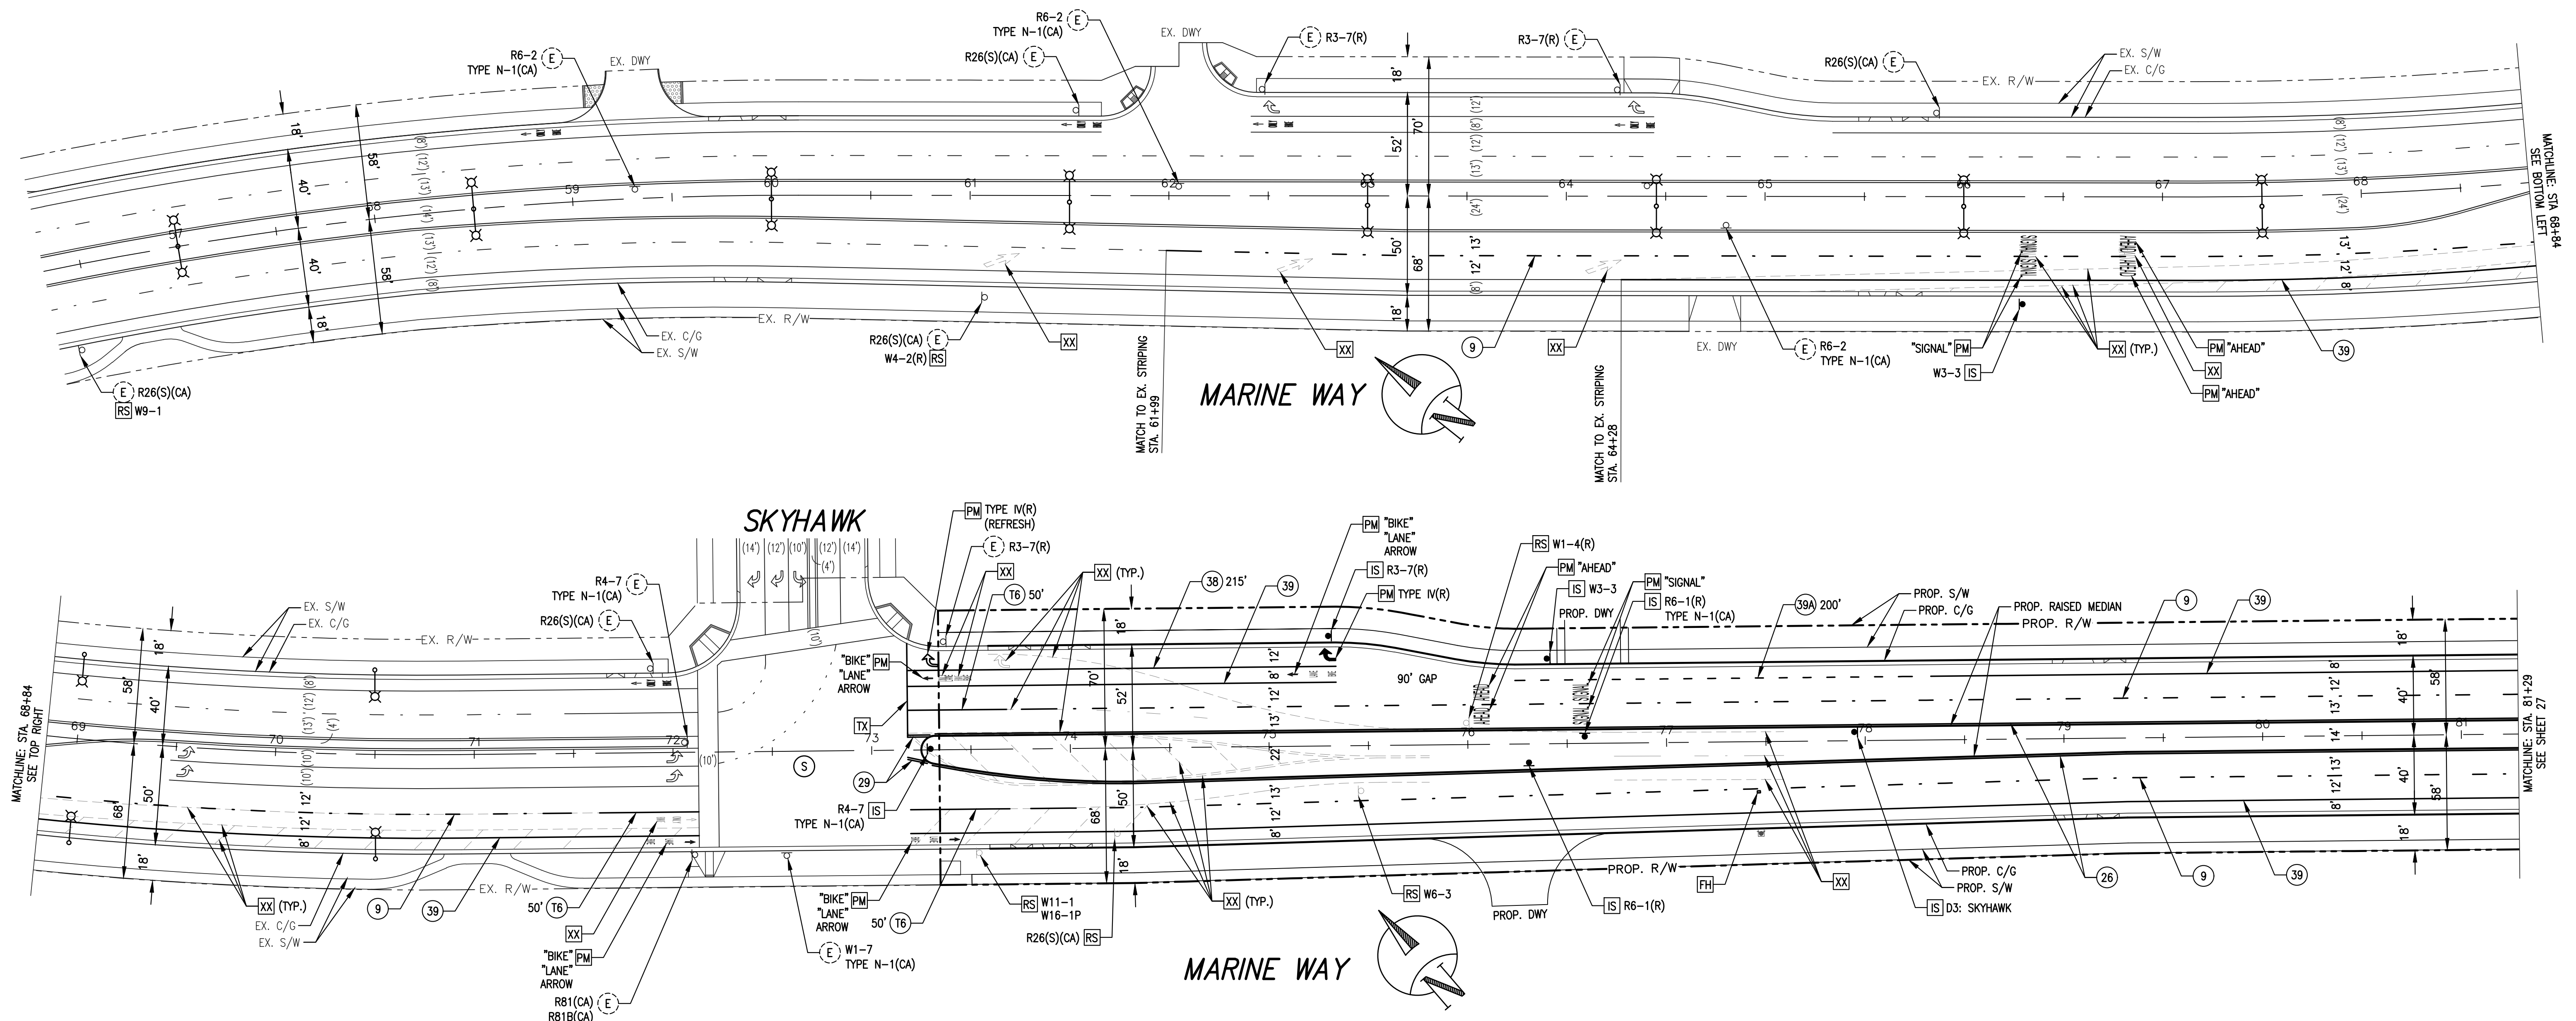

SCALE: 1" = 40'

A horizontal graphic scale bar divided into four equal segments. The segments are shaded in a checkerboard pattern: white, black, white, black. Below the bar, numerical labels are placed at the boundaries: 20 at the left end, 0 at the first boundary, 20 at the second boundary, 40 at the third boundary, and 60 at the right end.

7						DRAWN BY: KM DATE DESIGNED BY: KM DATE CHECKED BY: DATE
6						
5						
4						
3						
2						
1			TJW			
NO.	DATE	REVISIONS	FNDR.	APPROV.	DATE	

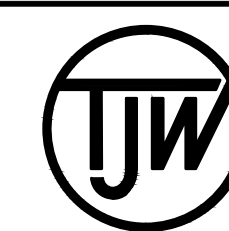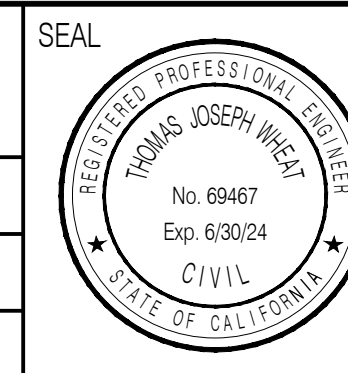

TJW ENGINEERING, INC.
Traffic Engineering &
Transportation Planning Consultants
9841 Irvine Center Dr., Suite 200, Irvine, CA 92618
t: (949) 878-3509 f: (949) 878-3593
www.tjwengineering.com

FOR PLANCHECK ONLY

THOMAS JOSEPH WHEAT R.C.E. No. 69467

Exp. 6/30/24

MARINE WAY
from STA. 56+50 to STA. 81+29

CITY OF IRVINE
PUBLIC WORKS DEPARTMENT

PLAN CHECK NO.	—
PERMIT NO.	—
PROJECT NO.	

SHEET


26 OF 28

1. SIGNING AND STRIPING SHALL CONFORM TO PART 2 SIGNS AND PART 3 MARKINGS OF THE CALIFORNIA MANUAL ON UNIFORM TRAFFIC CONTROL DEVICES (CA MUTCD) AND ANY ADDENDUMS THERE TO OR LATEST EDITION, THESE PLANS AND SPECIAL PROVISIONS.
2. DETAIL 9 LANE LINE STRIPING PATTERN IN PART 3 MARKINGS SHALL BE USED ON ALL MULTILANE STREETS REGARDLESS OF STREET DESIGN SPEED.
3. PAVEMENT LEGENDS SHALL MATCH THE CITY STENCILS OR EQUIVALENT,
4. ALL STRIPING AND PAVEMENT MARKINGS SHALL BE REFLECTORIZED AND APPLIED IN TWO COATS. A MINIMUM OF SEVEN DAYS SHALL BE PROVIDED BETWEEN FIRST AND SECOND COATS.
5. ALL CONFLICTING STRIPINGS, PAVEMENT MARKINGS, AND CURB PAINT SHALL BE REMOVED BY WET SANDBLASTING OR OTHER APPROVED METHOD PRIOR TO INSTALLATION OF NEW STRIPING. ALL CONFLICTING RAISED PAVEMENT MARKERS SHALL BE REMOVED.
6. PAVEMENT THAT IS DAMAGED DUE TO REMOVAL OF MARKERS OR STRIPING SHALL BE REPAIRED TO THE SATISFACTION OF THE CITY INSPECTOR.
7. THE CONTRACTOR SHALL CONTACT THE CITY OF IRVINE INSPECTION SERVICES FOR INSPECTION 48 HOURS PRIOR TO BEGINNING OF CONSTRUCTION.
8. CONTRACTOR SHALL VERIFY ALL EXISTING CONDITIONS AND DIMENSIONS BEFORE STARTING WORK IF CONDITIONS EXIST WHICH ARE CONTRARY TO THOSE SHOWN ON THESE PLANS. THE CITY OF IRVINE INSPECTION SERVICES SHALL BE NOTIFIED BEFORE PROCEEDING WITH WORK.
9. ALL WORK SHALL CONFORM TO THE PLANS AND SPECIFICATIONS IN ALL RESPECTS AND SHALL BE SUBJECT TO APPROVAL BY THE CITY ENGINEER.
10. ALL TRAFFIC CONTROL WORK FOR CONSTRUCTION SHALL CONFORM TO PART 6 – TEMPORARY TRAFFIC CONTROL OF THE CALIFORNIA MANUAL ON UNIFORM TRAFFIC CONTROL DEVICES (CA MUTCD) AND ANY ADDENDUMS THERE TO OR LATEST EDITION AND ALL O.S.H.A. REQUIREMENTS.

11. THE CONTRACTOR SHALL HAVE ALL TRAFFIC CONTROL CONSTRUCTION SIGNS, DELINEATORS, ETC., PROPERLY INSTALLED PRIOR TO COMMENCING CONSTRUCTION.
12. THE CONTRACTOR SHALL MAINTAIN ALL TRAFFIC CONTROL SIGNS, DELINEATORS, ETC., TO ENSURE PROPER FLOW AND SAFETY OF TRAFFIC WHILE WORKING IN THE STREET.
13. ADDITIONAL TRAFFIC CONTROL DEVICES MAY BE REQUIRED IN THE FIELD. THE CONTRACTOR SHALL BE RESPONSIBLE FOR ANY ADDITIONAL TRAFFIC CONTROL DEVICES REQUIRED BY THE CITY INSPECTOR/ REPRESENTATIVE TO ASSURE PUBLIC SAFETY AT ALL TIMES.
14. THE CONTRACTOR SHALL UTILIZE A FLAGMAN DURING CONSTRUCTION WORK AS DEEMED NECESSARY BY THE CITY INSPECTOR.
15. ARROW BOARDS SHALL BE USED ON ANY LANE CLOSURE ON ARTERIAL STREETS.
16. STRIPING SHALL BE CAT TRACKED AND APPROVED BY THE CITY INSPECTOR PRIOR TO FINAL INSTALLATION.
17. CROSSWALK SHALL CONFORM TO THE CITY OF IRVINE STANDARD PLAN NO. 203.
18. ALL SIGN FACE REFLECTIVE SHEETING SHALL BE HIGH INTENSITY GRADE WITH PROTECTIVE OVERLAY FILM.
19. ALL SIGN POSTS SHALL BE 2"x2" PERFORATED SQUARE TUBE INSTALLED WITH ACCOMPANYING SLEEVE PER THE CITY OF IRVINE REQUIREMENTS. CITY OF IRVINE SPECIAL SIGN R26EB SIGN SHALL BE INSTALLED ON "U" CHANNEL POST OR ON STREET LIGHT POLE.
20. ADVANCED STREET NAME SIGNS AND STREET NAME SIGNS SHALL BE SILVER LETTERS WITH "IRVINE BROWN" BACKGROUND.
21. BLUE RAISED REFLECTIVE PAVEMENT MARKERS SHALL BE INSTALLED ADJACENT TO ALL EXISTING FIRE HYDRANTS IN ACCORDANCE WITH THE LATEST EDITION OF THE CALIFORNIA MANUAL ON UNIFORM TRAFFIC CONTROL DEVICES (CA MUTCD).

R26(S)(CA) 12"X18"	R6-2 30"X36"	TYPE N-1(CA) 18"X18"	R3-7(R) 36"X36"	R4-7 24"X30"	W1-7 48"X24"
R5-1 36"X36"	R5-1a 36"X24"	W3-3 36"X36"	R1-1 36"X36"	R3-2 36"X36"	R3-5(R) 30"X36"

(E)	EXISTING SIGN TO REMAIN.
(FH)	INSTALL BLUE REFLECTIVE FIRE HYDRANT PAVEMENT MARKER PER CA MUTCD AND CALTRANS STANDARDS.
(IS)	INSTALL SIGN AND POST.
(RL)	RELOCATE EXISTING SIGN.
(RS)	REMOVE AND SALVAGE EXISTING SIGN AND POST.
(PM)	INSTALL THERMOPLASTIC PAVEMENT MARKING AS SHOWN PER CA-MUTCD STANDARDS.
(TX)	INSTALL THERMOPLASTIC 12" SOLID WHITE LIMIT LINE OR CROSSWALK PER CA-MUTCD STANDARDS.
(XX)	REMOVE CONFLICTING STRIPING OR MARKINGS BY WET SANDBLASTING PROCESS.
(T6)	INSTALL THERMOPLASTIC 6" SOLID WHITE LANE LINE STRIPE.
(9)	INSTALL THERMOPLASTIC 6" WHITE LANE LINE SKIP STRIPE PER CALTRANS STD. PLAN A20A – DETAIL 9.
(22)	INSTALL THERMOPLASTIC 6" DOUBLE YELLOW CENTERLINE STRIPE PER CALTRANS STD. PLAN A20A – DETAIL 22
(26)	INSTALL RED-YELLOW RETROREFLECTIVE MARKER LEFT EDGELINE ALONG RAISED MEDIAN PER CALTRANS STD. PLAN A20B – DETAIL 26.
(29)	INSTALL THERMOPLASTIC 6" DOUBLE YELLOW MEDIAN STRIPE PER CALTRANS STD. PLAN A20B – DETAIL 29.
(38)	INSTALL THERMOPLASTIC 8" WHITE CHANNELIZING LANE LINE STRIPE PER CALTRANS STD. PLAN A20D – DETAIL 38.
(39)	INSTALL THERMOPLASTIC 6" WHITE BIKE LANE STRIPE PER CALTRANS STD. PLAN A20D – DETAIL 39.
(39A)	INSTALL THERMOPLASTIC 6" WHITE BIKE LANE INTERSECTION STRIPE PER CALTRANS STD. PLAN A20D – DETAIL 39A.
(S)	SIGNALIZED INTERSECTION

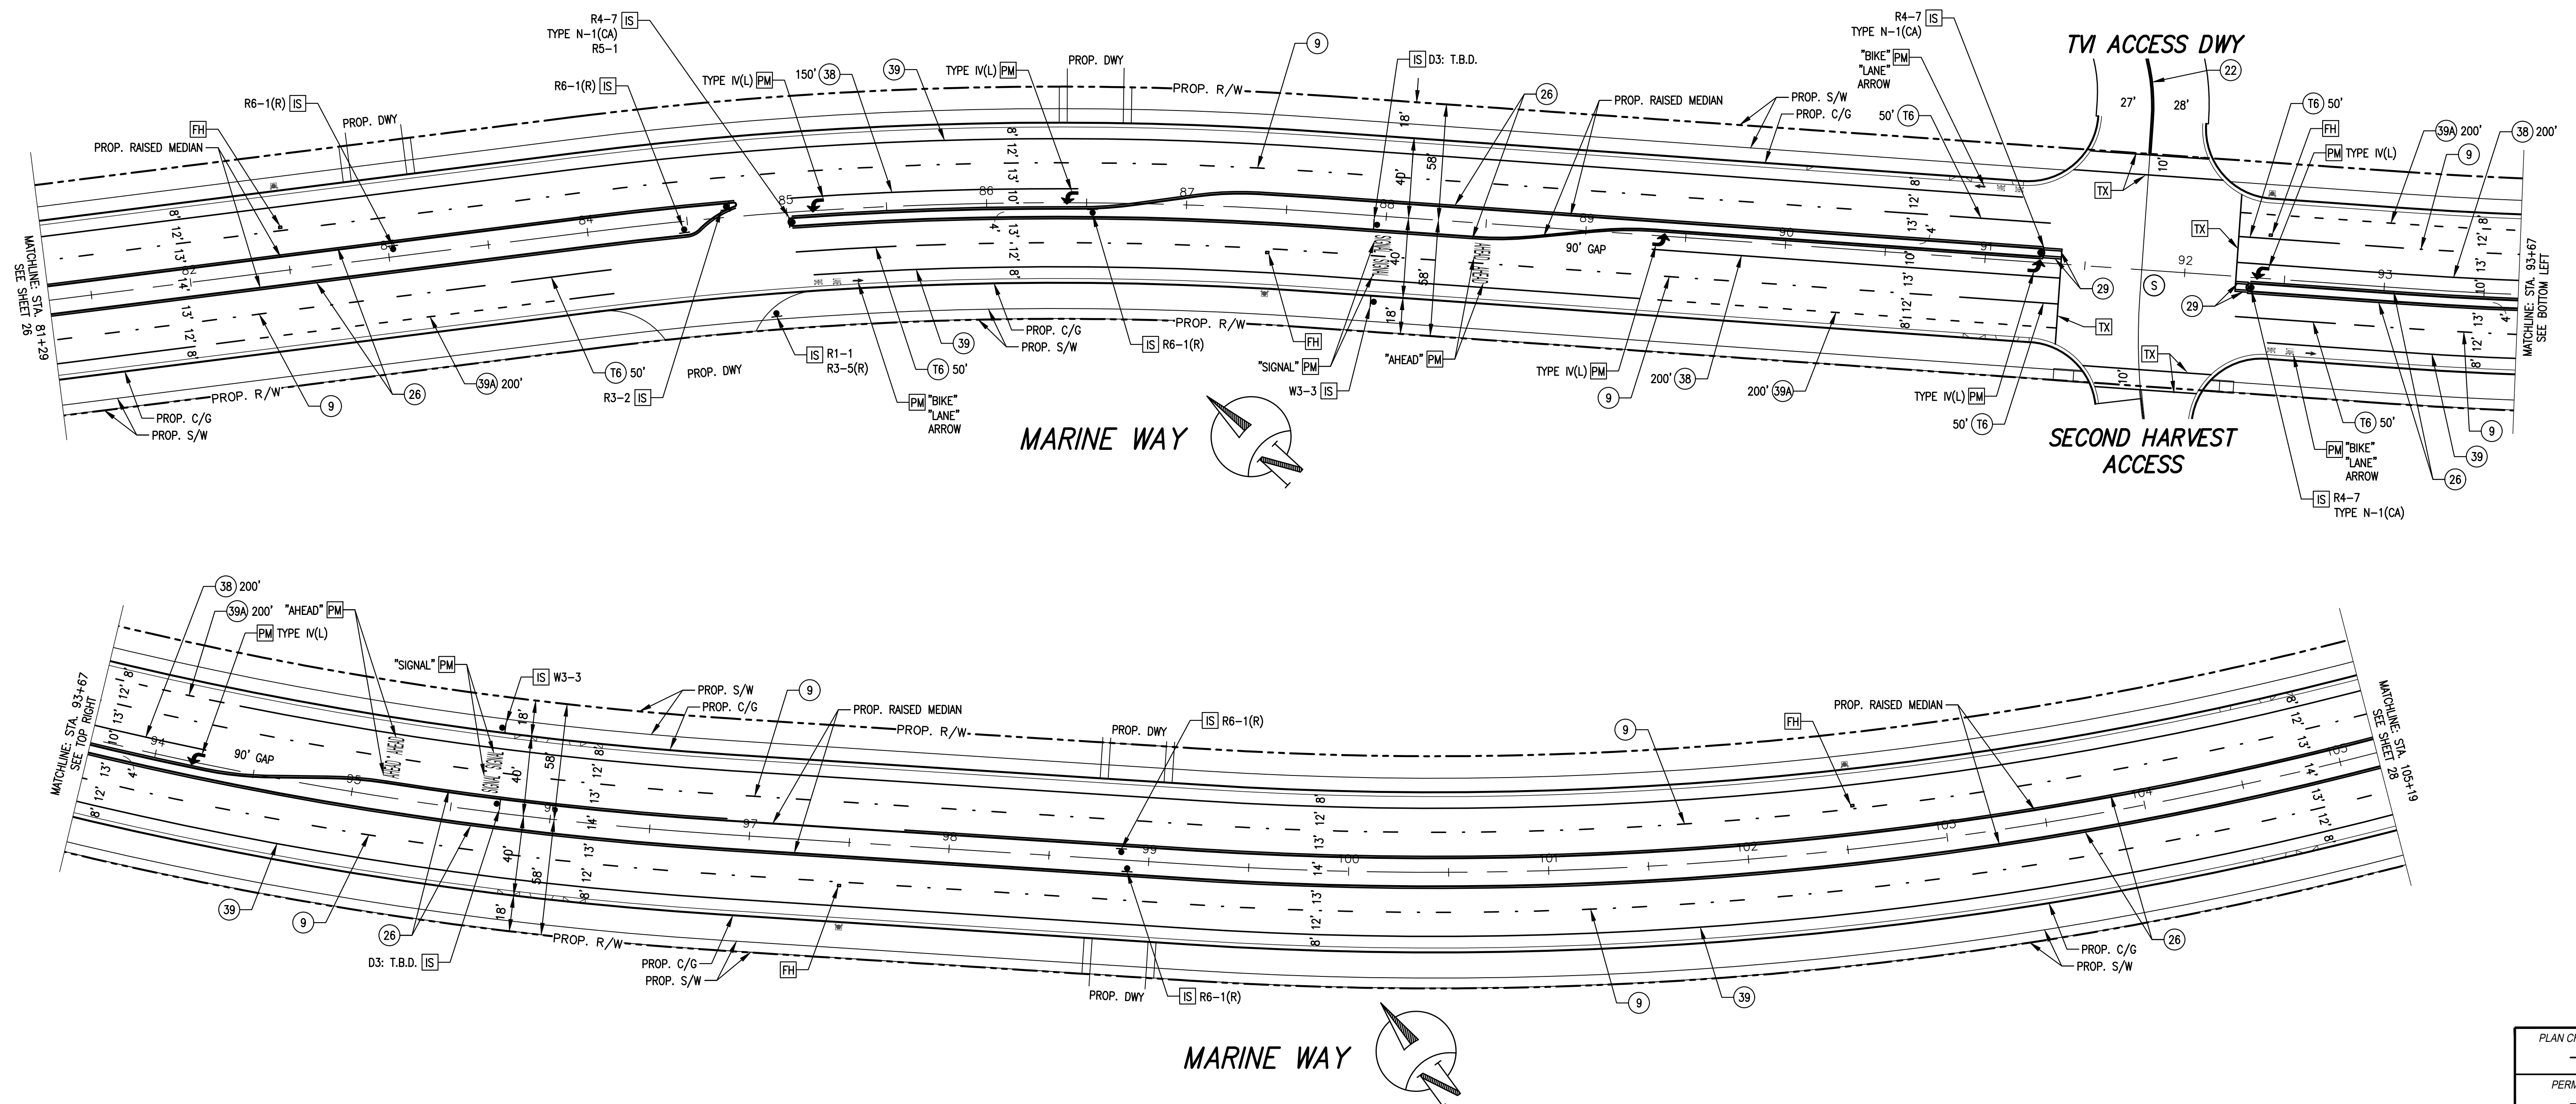



Know what's below.
Call before you dig.

SCALE: 1" = 40'

A horizontal scale bar divided into four equal segments. The segments are shaded in a checkerboard pattern: white, black, white, black. Below the bar, numerical labels are placed at the boundaries: 20 at the left end, 0 at the first boundary, 20 at the second boundary, 40 at the third boundary, and 60 at the right end.

7						DRAWN BY: KM DATE DESIGNED BY: KM DATE CHECKED BY: DATE
6						
5						
4						
3						
2						
1			TJW			
NO.	DATE	REVISIONS	FNDR.	APPROV.	DATE	

SEAL

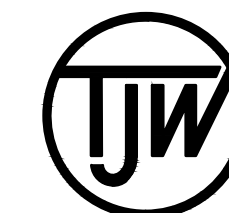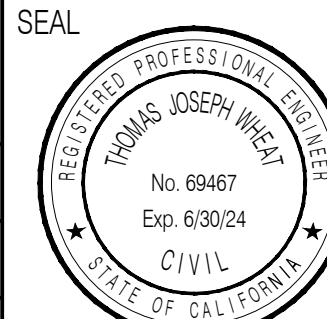

TJW ENGINEERING, INC.
Traffic Engineering &
Transportation Planning Consultants
841 Irvine Center Dr., Suite 200, Irvine, CA 92618
t: (949) 878-3509 f: (949) 878-3593
www.tjwengineering.com

FOR PLANCHECK ONLY

THOMAS JOSEPH WHEAT R.C.E. No. 69467

Exp. 6/30/24

MARINE WAY
from STA. 81+29 to STA. 105+19

CITY OF IRVINE
PUBLIC WORKS DEPARTMENT

PLAN CHECK NO.

PERMIT NO.

PROJECT NO.

SHEET


27
OF 28

1. SIGNING AND STRIPING SHALL CONFORM TO PART 2 SIGNS AND PART 3 MARKINGS OF THE CALIFORNIA MANUAL ON UNIFORM TRAFFIC CONTROL DEVICES (CA MUTCD) AND ANY ADDENDUMS THERE TO OR LATEST EDITION, THESE PLANS AND SPECIAL PROVISIONS.
2. DETAIL 9 LANE LINE STRIPING PATTERN IN PART 3 MARKINGS SHALL BE USED ON ALL MULTILANE STREETS REGARDLESS OF STREET DESIGN SPEED.
3. PAVEMENT LEGENDS SHALL MATCH THE CITY STENCILS OR EQUIVALENT,
4. ALL STRIPING AND PAVEMENT MARKINGS SHALL BE REFLECTORIZED AND APPLIED IN TWO COATS. A MINIMUM OF SEVEN DAYS SHALL BE PROVIDED BETWEEN FIRST AND SECOND COATS.
5. ALL CONFLICTING STRIPINGS, PAVEMENT MARKINGS, AND CURB PAINT SHALL BE REMOVED BY WET SANDBLASTING OR OTHER APPROVED METHOD PRIOR TO INSTALLATION OF NEW STRIPING. ALL CONFLICTING RAISED PAVEMENT MARKERS SHALL BE REMOVED.
6. PAVEMENT THAT IS DAMAGED DUE TO REMOVAL OF MARKERS OR STRIPING SHALL BE REPAIRED TO THE SATISFACTION OF THE CITY INSPECTOR.
7. THE CONTRACTOR SHALL CONTACT THE CITY OF IRVINE INSPECTION SERVICES FOR INSPECTION 48 HOURS PRIOR TO BEGINNING OF CONSTRUCTION
8. CONTRACTOR SHALL VERIFY ALL EXISTING CONDITIONS AND DIMENSIONS BEFORE STARTING WORK. IF CONDITIONS EXIST WHICH ARE CONTRARY TO THOSE SHOWN ON THESE PLANS, THE CITY OF IRVINE INSPECTION SERVICES SHALL BE NOTIFIED BEFORE PROCEEDING WITH WORK.
9. ALL WORK SHALL CONFORM TO THE PLANS AND SPECIFICATIONS IN ALL RESPECTS AND SHALL BE SUBJECT TO APPROVAL BY THE CITY ENGINEER.
10. ALL TRAFFIC CONTROL WORK FOR CONSTRUCTION SHALL CONFORM TO PART 6 - TEMPORARY TRAFFIC CONTROL OF THE CALIFORNIA MANUAL ON UNIFORM TRAFFIC CONTROL DEVICES (CA MUTCD) AND ANY ADDENDUMS THERE TO OR LATEST EDITION AND ALL O.S.H.A. REQUIREMENTS.

11. THE CONTRACTOR SHALL HAVE ALL TRAFFIC CONTROL CONSTRUCTION SIGNS, DELINEATORS, ETC., PROPERLY INSTALLED PRIOR TO COMMENCING CONSTRUCTION.
12. THE CONTRACTOR SHALL MAINTAIN ALL TRAFFIC CONTROL SIGNS, DELINEATORS, ETC., TO ENSURE PROPER FLOW AND SAFETY OF TRAFFIC WHILE WORKING IN THE STREET.
13. ADDITIONAL TRAFFIC CONTROL DEVICES MAY BE REQUIRED IN THE FIELD. THE CONTRACTOR SHALL BE RESPONSIBLE FOR ANY ADDITIONAL TRAFFIC CONTROL DEVICES REQUIRED BY THE CITY INSPECTOR/ REPRESENTATIVE TO ASSURE PUBLIC SAFETY AT ALL TIMES.
14. THE CONTRACTOR SHALL UTILIZE A FLAGMAN DURING CONSTRUCTION WORK AS DEEMED NECESSARY BY THE CITY INSPECTOR.
15. ARROW BOARDS SHALL BE USED ON ANY LANE CLOSURE ON ARTERIAL STREETS.
16. STREET CLOSURES SHALL BE CAT TRACKED AND APPROVED BY THE CITY INSPECTOR PRIOR TO FINAL INSTALLATION.
17. CROSSWALK SHALL CONFORM TO THE CITY OF IRVINE STANDARD PLAN NO. 203.
18. ALL SIGN FACE REFLECTIVE SHEETING SHALL BE HIGH INTENSITY GRADE WITH PROTECTIVE OVERLAY FILM.
19. ALL SIGN POSTS SHALL BE 2"x2" PERFORATED SQUARE TUBE INSTALLED WITH ACCOMPANYING SLEEVE PER THE CITY OF IRVINE REQUIREMENTS. CITY OF IRVINE SPECIAL SIGN R26B SIGN SHALL BE INSTALLED ON "U" CHANNEL POST OR ON STREET LIGHT POLE.
20. ADVANCED STREET NAME SIGNS AND STREET NAME SIGNS SHALL BE SILVER LETTERS WITH "IRVINE BROWN" BACKGROUND.
21. BLUE RAISED REFLECTIVE PAVEMENT MARKERS SHALL BE INSTALLED ADJACENT TO ALL EXISTING FIRE HYDRANTS IN ACCORDANCE WITH THE LATEST EDITION OF THE CALIFORNIA MANUAL ON UNIFORM TRAFFIC CONTROL DEVICES (CA MUTCD).



 R6-1(R)
54"x18"

 TYPE N-1(CA)
18"x18"

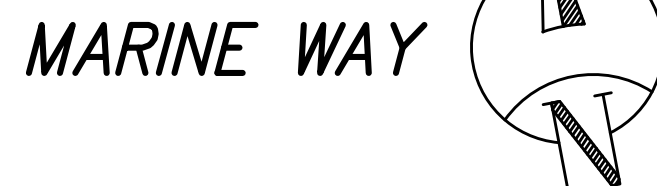

(E)	EXISTING SIGN TO REMAIN.
(FH)	INSTALL BLUE REFLECTIVE FIRE HYDRANT PAVEMENT MARKER PER CA MUTCD AND CALTRANS STANDARDS.
(IS)	INSTALL SIGN AND POST.
(RL)	RELOCATE EXISTING SIGN.
(RS)	REMOVE AND SALVAGE EXISTING SIGN AND POST.
(PM)	INSTALL THERMOPLASTIC PAVEMENT MARKING AS SHOWN PER CA-MUTCD STANDARDS.
(TX)	INSTALL THERMOPLASTIC 12" SOLID WHITE LIMIT LINE OR CROSSWALK PER CA-MUTCD STANDARDS.
(XX)	REMOVE CONFLICTING STRIPING OR MARKINGS BY WET SANDBLASTING PROCESS.
(16)	INSTALL THERMOPLASTIC 6" SOLID WHITE LANE LINE STRIPE.
(9)	INSTALL THERMOPLASTIC 6" WHITE LANE LINE SKIP STRIPE PER CALTRANS STD. PLAN A20A – DETAIL 9.
(22)	INSTALL THERMOPLASTIC 6" DOUBLE YELLOW CENTERLINE STRIPE PER CALTRANS STD. PLAN A20A – DETAIL 22
(26)	INSTALL RED-YELLOW RETROREFLECTIVE MARKER LEFT EDGELINE ALONG RAISED MEDIAN PER CALTRANS STD. PLAN A20B – DETAIL 26.
(29)	INSTALL THERMOPLASTIC 6" DOUBLE YELLOW MEDIAN STRIPE PER CALTRANS STD. PLAN A20B – DETAIL 29.
(38)	INSTALL THERMOPLASTIC 8" WHITE CHANNELIZING LANE LINE STRIPE PER CALTRANS STD. PLAN A20D – DETAIL 38.
(39)	INSTALL THERMOPLASTIC 6" WHITE BIKE LANE STRIPE PER CALTRANS STD. PLAN A20D – DETAIL 39.
(39A)	INSTALL THERMOPLASTIC 6" WHITE BIKE LANE INTERSECTION STRIPE PER CALTRANS STD. PLAN A20D – DETAIL 39A.
(S)	SIGNALIZED INTERSECTION

7							
6							
5							
4							
3						DRAWN BY:	KM DATE -
2				TJW		DESIGNED BY:	KM DATE -
1						CHECKED BY:	DATE -
NO.	DATE	REVISIONS	ENGR.	APPROV.	DATE		

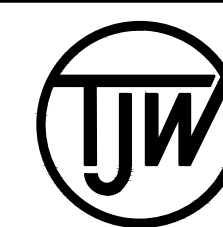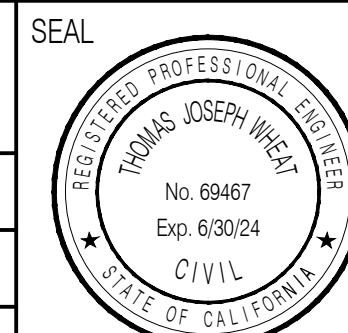

TJW ENGINEERING, INC.
Traffic Engineering &
Transportation Planning Consultants
341 Irvine Center Dr., Suite 200, Irvine, CA 92618
t: (949) 878-3509 f: (949) 878-3593
www.tjwengineering.com

FOR PLANCHECK ONLY

THOMAS JOSEPH WHEAT	R.C.E. No. 69467	Exp. 6/30/24
---------------------	------------------	--------------

SIGNING AND STRIPING PLAN
MARINE WAY
from STA. 105+19 to STA. 111+05



CITY OF IRVINE
PUBLIC WORKS DEPARTMENT

PLAN CHECK NO.	—
PERMIT NO.	—
PROJECT NO.	
SHEET	
28	28
OF	

☐ CAP PIPE END
☐ PROTECT IN PLACE
☐ REMOVE AND DISPOSE
☐ RELOCATE
☒ REMOVE AND SALVAGE
☐ SALVAGE

SAWCUT AND REMOVE
EX AC PAVEMENT

SAWCUT AND REMOVE
EX CONC PAVEMENT

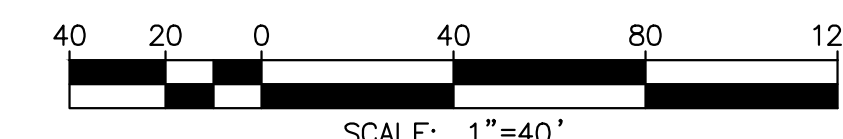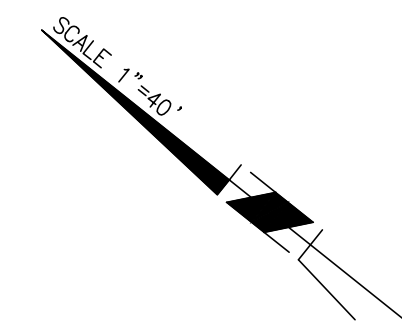

NOTE:
CONTRACTOR TO MAINTAIN/ALLOW
OR PROVIDE ACCESS TO EXISTING
PROPERTY OWNERS ALONG THE
FRONTAGE ON MARINE WAY.



7					
6					
5					
4					
3					
2					
1					
NO.	DATE	REVISIONS	ENGR.	APPROV.	DATE

DRAWN BY: SR	DATE 4/18
DESIGNED BY: JCL	DATE 4/18
CHECKED BY: JCL	DATE 4/18

PLAN PREPARED BY:

PROACTIVE
ENGINEERING CONSULTANTS


27042 Towne Centre Drive, Suite 110
Foothill Ranch, CA 92610 (949) 716-7460

JEFFREY C. LANGDON R.C.E. 42429 DA

**CONSTRUCTION PLANS FOR THE IMPROVEMENT OF
MARINE WAY
DEMOLITION PLAN
FROM STA 81+30 TO STA 99+50**

**CITY OF IRVINE
PUBLIC WORKS DEPARTMENT**

PLAN CHECK NO. 00760917-EMC
PERMIT NO. 00766614-MCE
PROJECT NO. 20.059
SHEET 6A OF 28

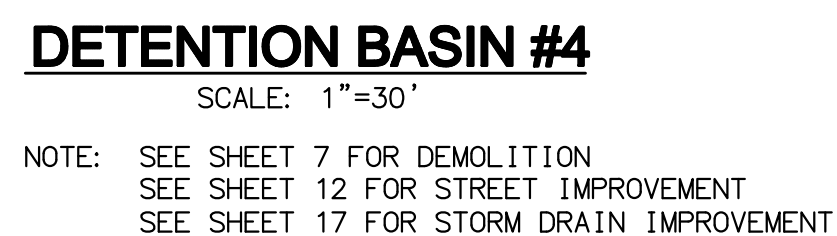

- 5 INSTALL WOOD HEADER PER DETAIL ON SHEET 9
- 6 CONSTRUCT DRIVEWAY TYPE I PER CITY OF IRVINE STD. PLAN NO. 204 (WIDTH PER PLAN) $x=4'$
- 7 CONSTRUCT DRIVEWAY TYPE II PER CITY OF IRVINE STD. PLAN NO. 205 (WIDTH PER PLAN)
- 8 CONSTRUCT 8" AC CURB D1-8 PER SPWCC STD. PLAN 120-2 (SEE SHEET 23)
- 9 CONSTRUCT 4" AC OVER 8" CMB DRIVEWAY ON COMPACTED NATIVE PER SOILS ENGINEER
- 10 CONSTRUCT 4' WIDE CONCRETE V-DITCH PER DETAIL ON SHEET 3
- 11 CONSTRUCT 3' WIDE CONCRETE V-DITCH PER DETAIL ON SHEET 3

(50) CONSTRUCT HEADWALL PER CALTRANS STD D89 (SEE SHEET 23)
 (66) INSTALL UNGROUTED RIP RAP PER DETAIL ON SHEET 15
 (70) INSTALL 18" CSP (12 GAUGE) PER CITY OF IRVINE STD PLAN 318
 (72) INSTALL 12" CSP (12 GAUGE) PER CITY OF IRVINE STD PLAN 318

	7							PLAN PREPARED BY: PROACTIVE ENGINEERING CONSULTANTS 27042 Towne Centre Drive, Suite 110 Foothill Ranch, CA 92610 (949) 716-7460	CONSTRUCTION PLANS FOR THE IMPROVEMENT OF MARINE WAY BASIN AND DRIVEWAY DETAILS	PROJECT NO. 20.059
	6									
	5								SHEET	
	4								21 OF 28	
	3									
	2									
	1									
NO.	DATE	REVISIONS		ENGR.	APPROV.	DATE	CHECKED BY: JCL	DATE 4/18	CITY OF IRVINE PUBLIC WORKS DEPARTMENT	
							JEFFREY C. LANGDON	R.C.E. 42429	DATE	