


OCEAN VIEW CHANNEL (C06)

27+57.96

CL CONSTRUCTION

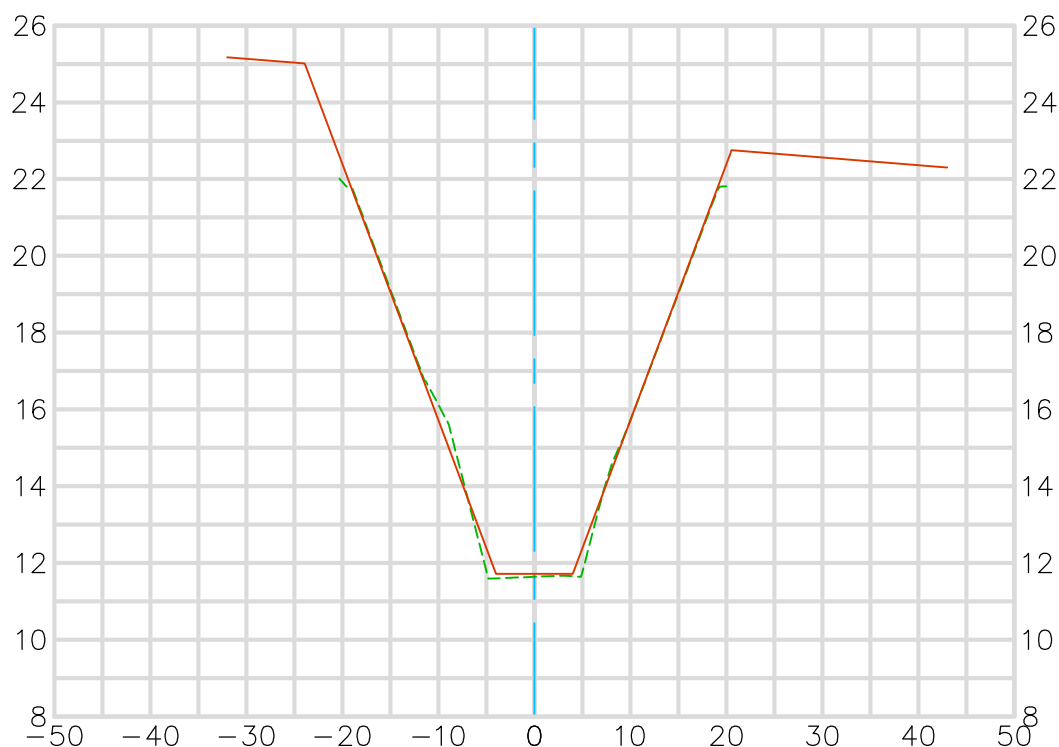

Existing Condition 2018
 Record Plan 1960-1966
 C06-101-2-A 1960, C06-101-4-A 1963, C06-103-1-M1966
 Modified Per Engineer's Directive
 Prepared 8/21/19


Horizontal Scale 1" = 20'
 Vertical Scale 1" = 5'

U.S. Survey Foot

OC Public Works/
OC Survey/Field Services
Boundary Analysis & Mapping



OCEAN VIEW CHANNEL (C06) 28+00.00 CL CONSTRUCTION

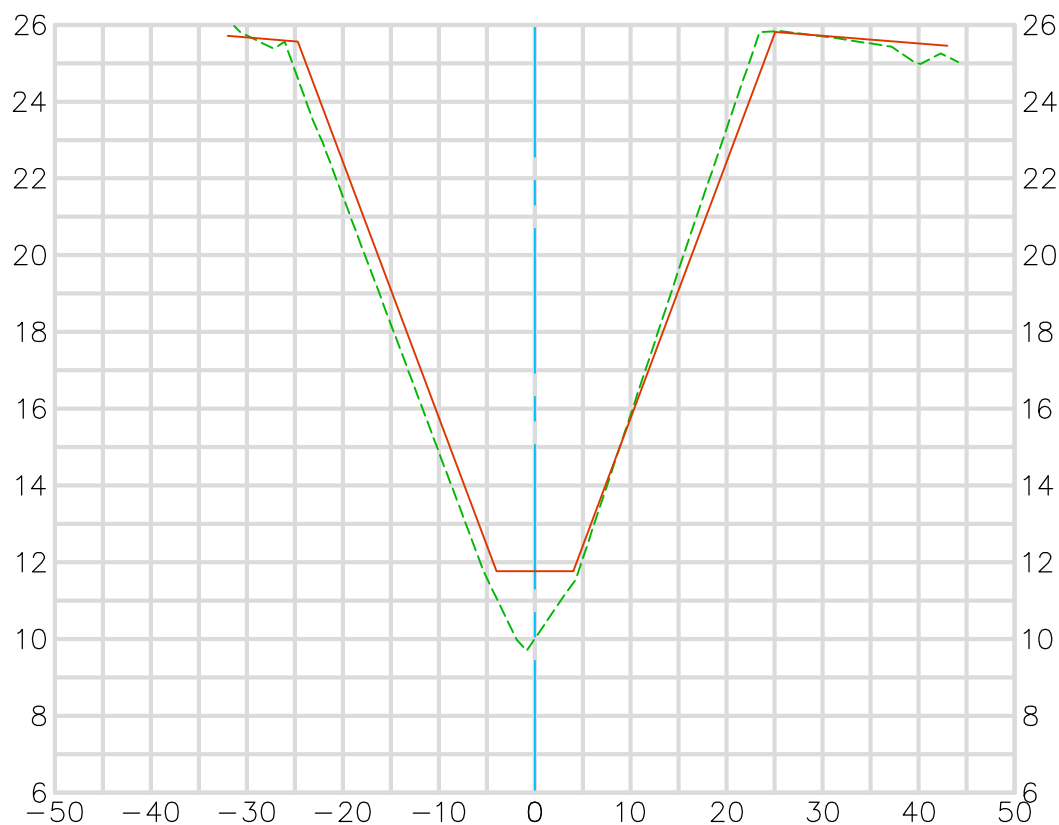


Existing Condition 2018
Record Plan 1960-1966
C06-101-2-A 1960, C06-101-4-A 1963, C06-103-1-M1966
Modified Per Engineer's Directive
Prepared 8/21/19

Horizontal Scale 1" = 20'
Vertical Scale 1" = 5'

OCEAN VIEW CHANNEL (C06)

28+50.00

CL CONSTRUCTION

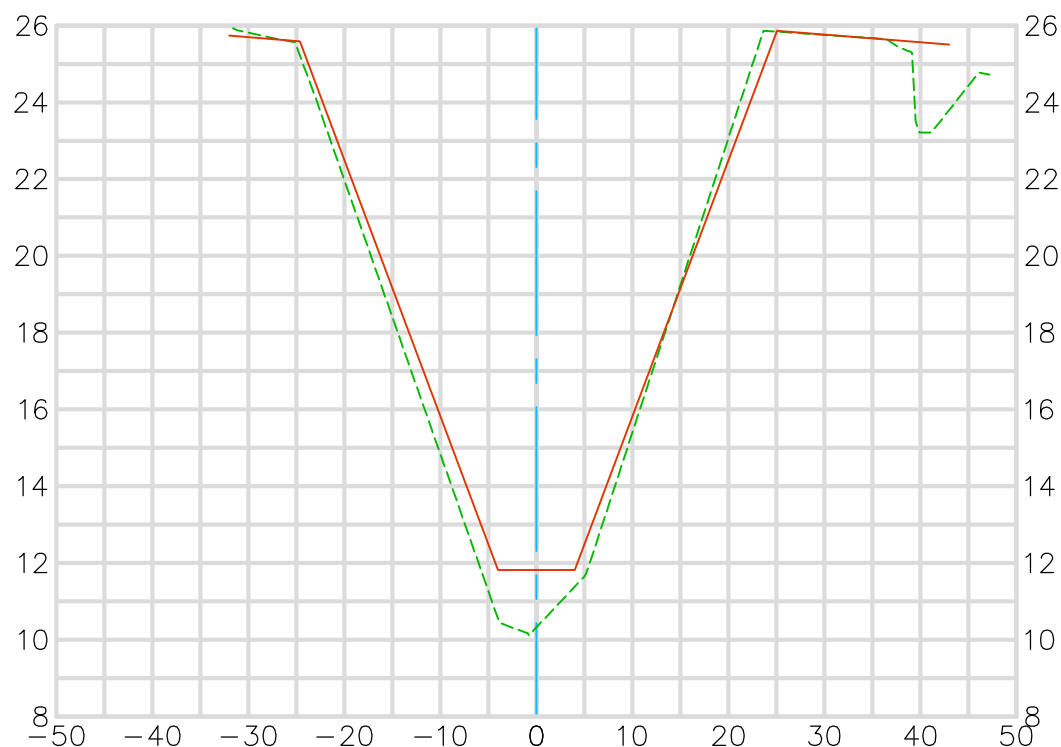

Existing Condition 2018
 Record Plan 1960-1966
 C06-101-2-A 1960, C06-101-4-A 1963, C06-103-1-M1966
 Modified Per Engineer's Directive
 Prepared 8/21/19

Horizontal Scale 1" = 20'
 Vertical Scale 1" = 5'

OCEAN VIEW CHANNEL (C06)

29+00.00

CL CONSTRUCTION




Existing Condition 2018
Record Plan 1960-1966
C06-101-2-A 1960, C06-101-4-A 1963, C06-103-1-M1966
Modified Per Engineer's Directive
Prepared 8/21/19

Horizontal Scale 1" = 20'
Vertical Scale 1" = 5'

OCEAN VIEW CHANNEL (C06)

29+50.00

CL CONSTRUCTION

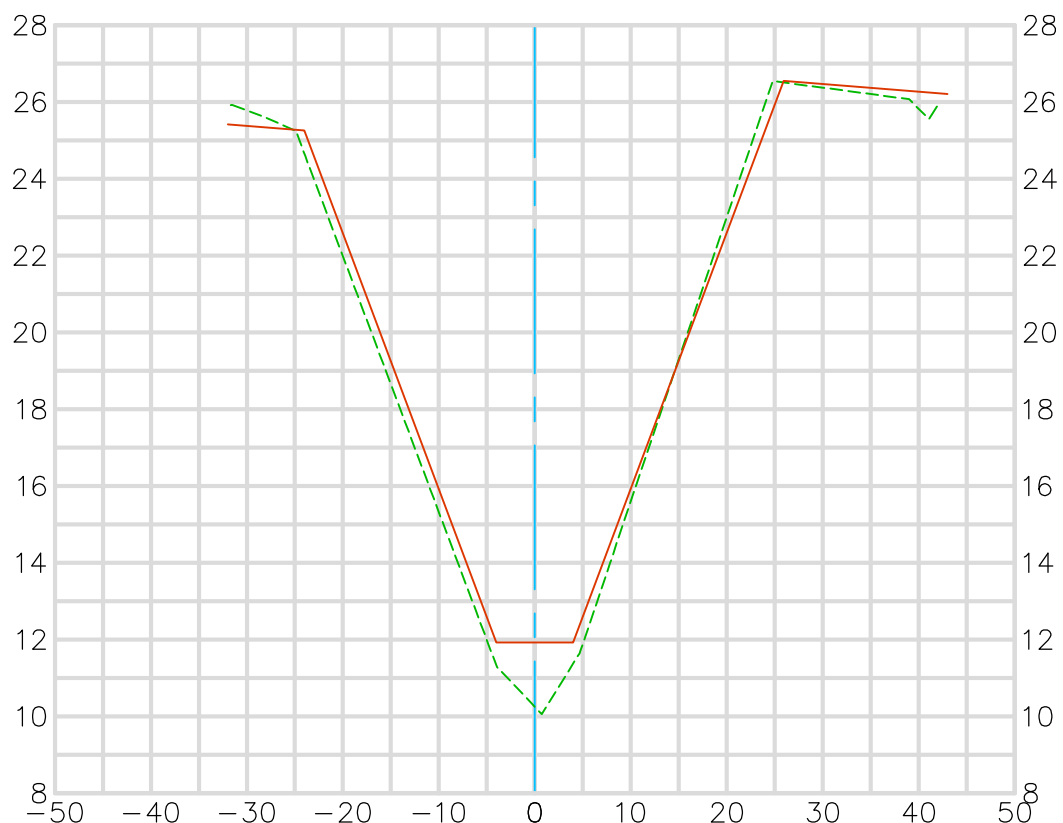


Existing Condition 2018
 Record Plan 1960-1966
 C06-101-2-A 1960, C06-101-4-A 1963, C06-103-1-M1966
 Modified Per Engineer's Directive
 Prepared 8/21/19

Horizontal Scale 1" = 20'
 Vertical Scale 1" = 5'

OCEAN VIEW CHANNEL (C06)

30+00.00

CL CONSTRUCTION

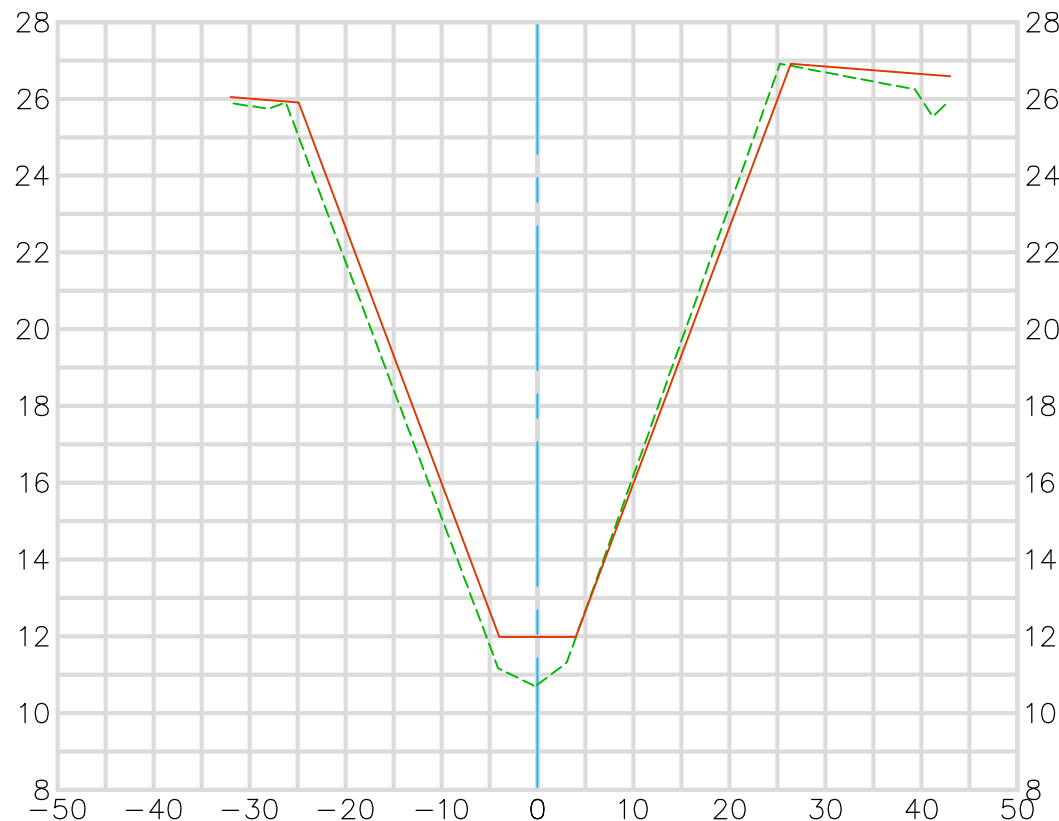


Existing Condition 2018
 Record Plan 1960-1966
 C06-101-2-A 1960, C06-101-4-A 1963, C06-103-1-M1966
 Modified Per Engineer's Directive
 Prepared 8/21/19

Horizontal Scale 1" = 20'
 Vertical Scale 1" = 5'

OCEAN VIEW CHANNEL (C06)

30+50.00

CL CONSTRUCTION

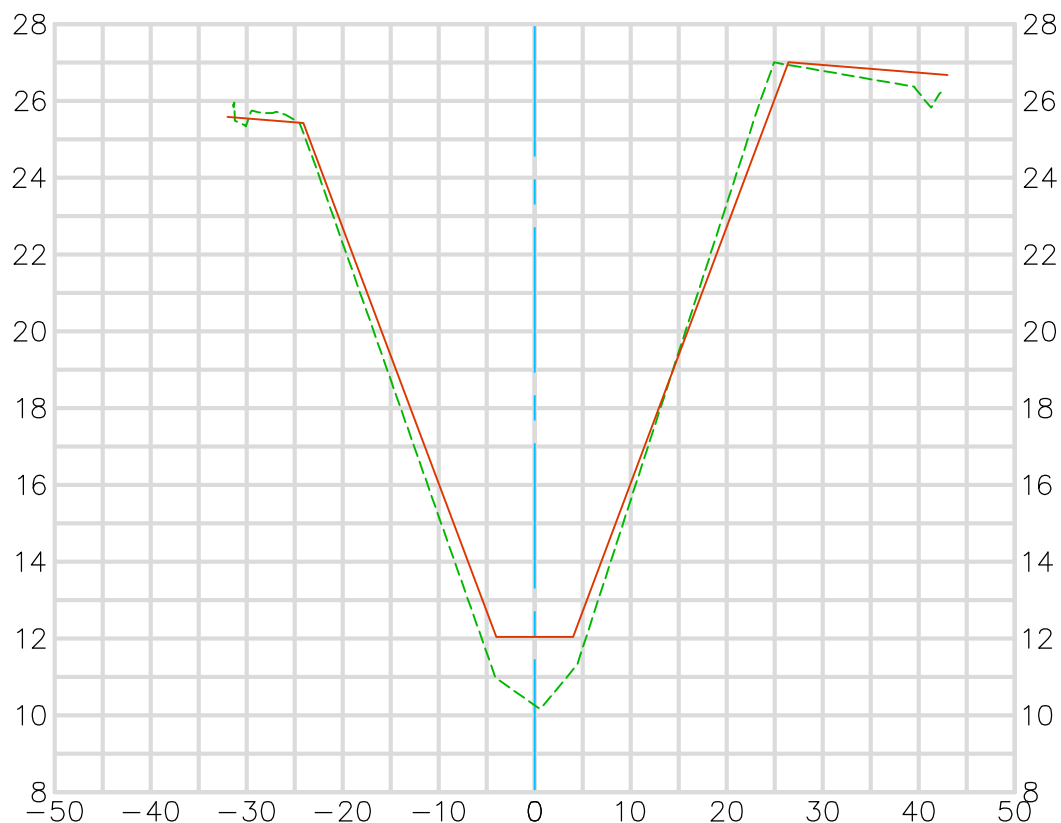

Existing Condition 2018
 Record Plan 1960-1966
 C06-101-2-A 1960, C06-101-4-A 1963, C06-103-1-M1966
 Modified Per Engineer's Directive
 Prepared 8/21/19

Horizontal Scale 1" = 20'
 Vertical Scale 1" = 5'

OCEAN VIEW CHANNEL (C06)

31+00.00

CL CONSTRUCTION




Existing Condition 2018
 Record Plan 1960-1966
 C06-101-2-A 1960, C06-101-4-A 1963, C06-103-1-M1966
 Modified Per Engineer's Directive
 Prepared 8/21/19

Horizontal Scale 1" = 20'
 Vertical Scale 1" = 5'

OCEAN VIEW CHANNEL (C06)

31+50.00

CL CONSTRUCTION

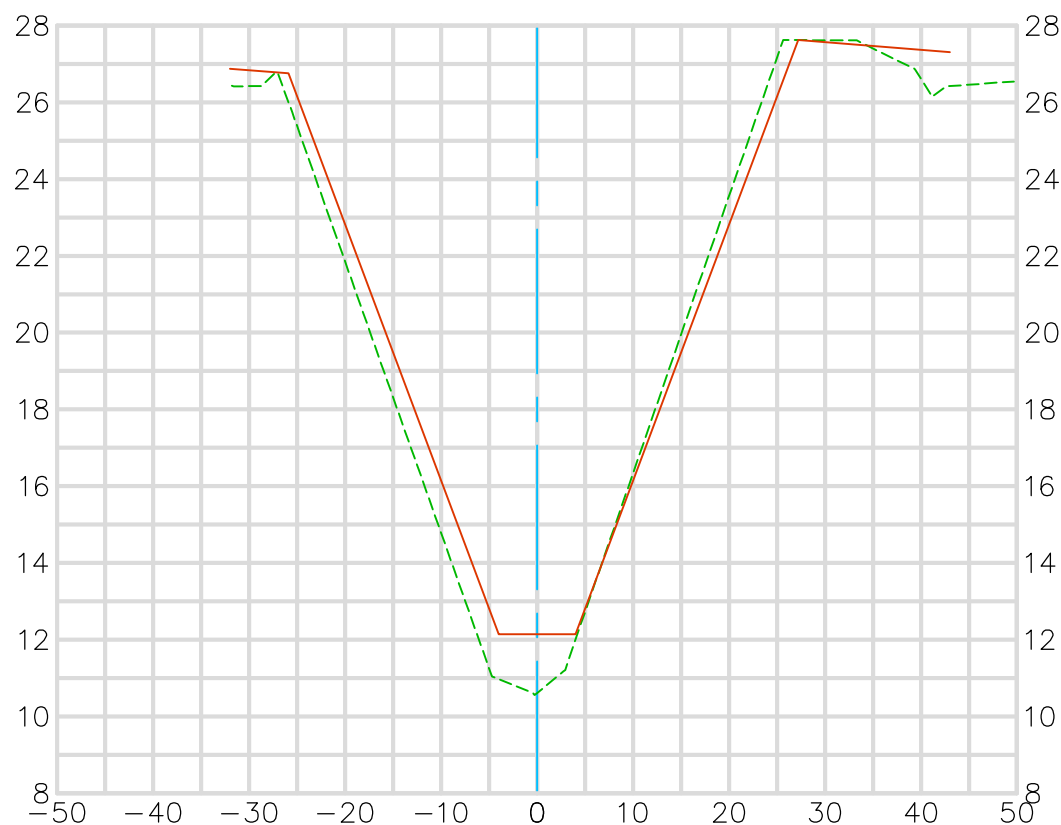

Existing Condition 2018
 Record Plan 1960-1966
 C06-101-2-A 1960, C06-101-4-A 1963, C06-103-1-M1966
 Modified Per Engineer's Directive
 Prepared 8/21/19

Horizontal Scale 1" = 20'
 Vertical Scale 1" = 5'

U.S. Survey Foot


OC Public Works/
OC Survey/Field Services
Boundary Analysis & Mapping



OCEAN VIEW CHANNEL (C06)

32+00.00

CL CONSTRUCTION

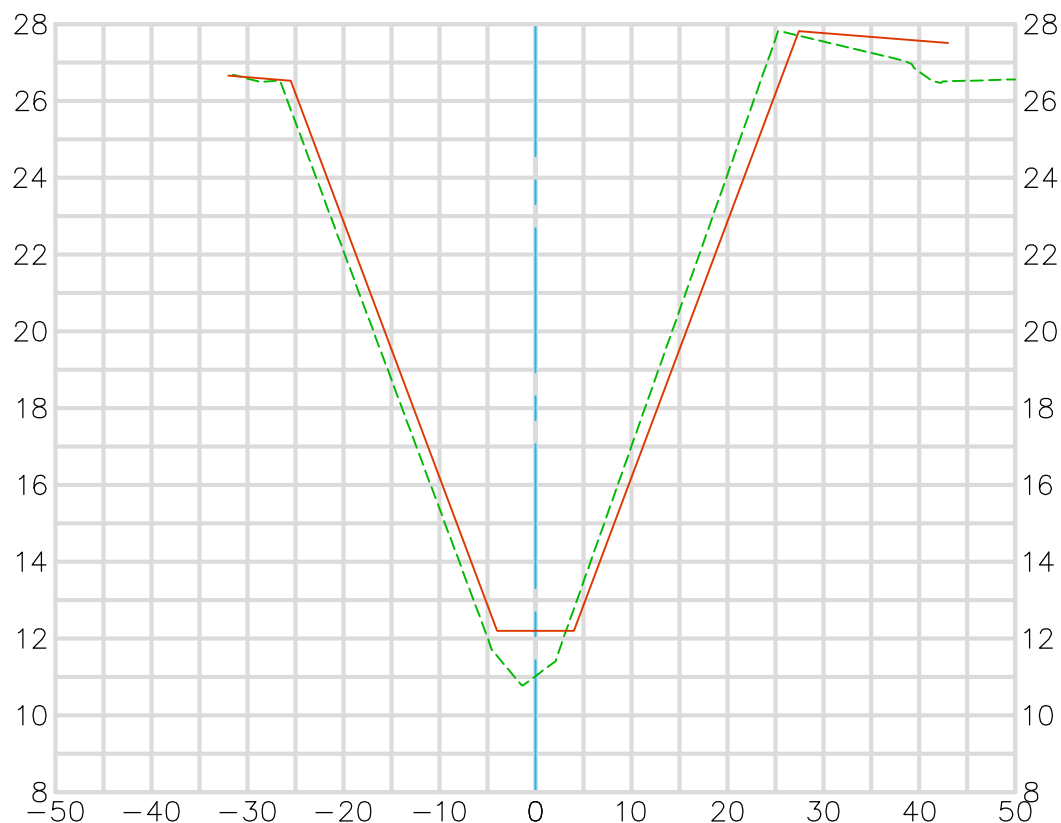


Existing Condition 2018
Record Plan 1960-1966
C06-101-2-A 1960, C06-101-4-A 1963, C06-103-1-M1966
Modified Per Engineer's Directive
Prepared 8/21/19

Horizontal Scale 1" = 20'
Vertical Scale 1" = 5'

OCEAN VIEW CHANNEL (C06)

32+50.00

CL CONSTRUCTION

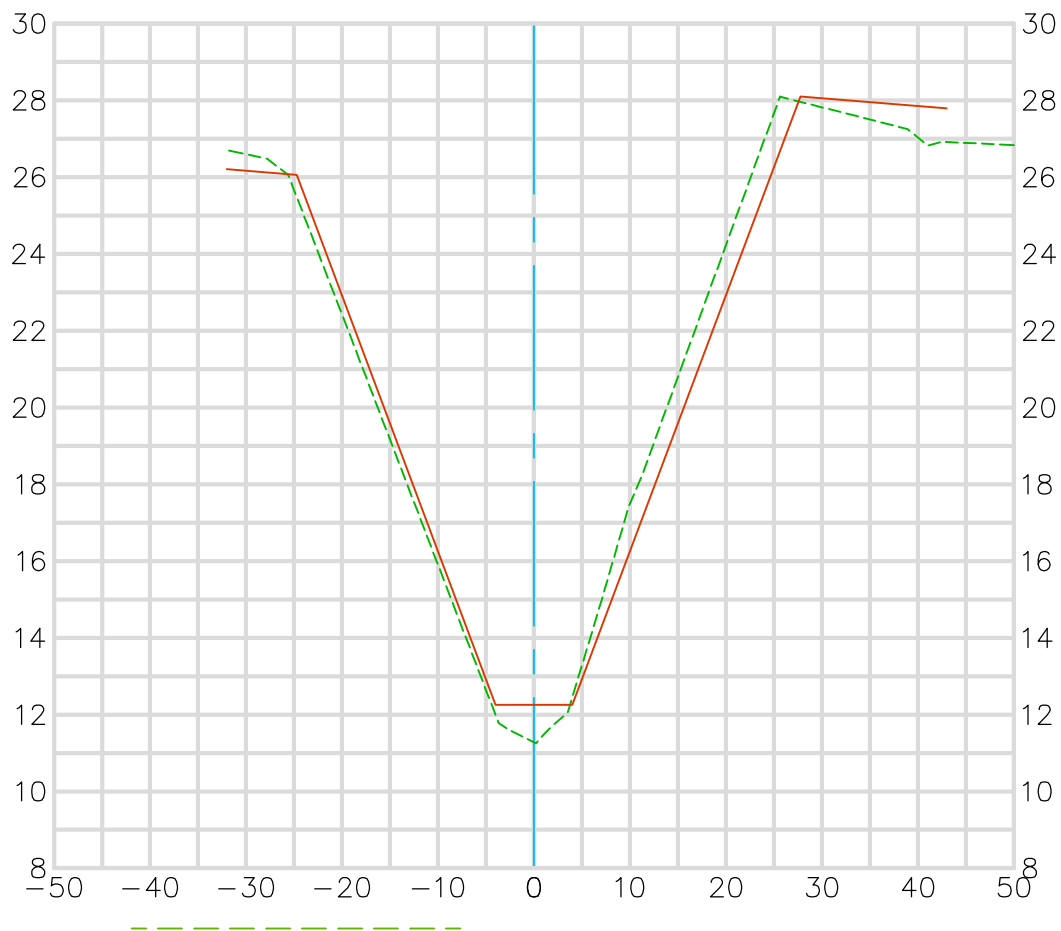


Existing Condition 2018
 Record Plan 1960-1966
 C06-101-2-A 1960, C06-101-4-A 1963, C06-103-1-M1966
 Modified Per Engineer's Directive
 Prepared 8/21/19

Horizontal Scale 1" = 20'
 Vertical Scale 1" = 5'

OCEAN VIEW CHANNEL (C06)

33+00.00

CL CONSTRUCTION

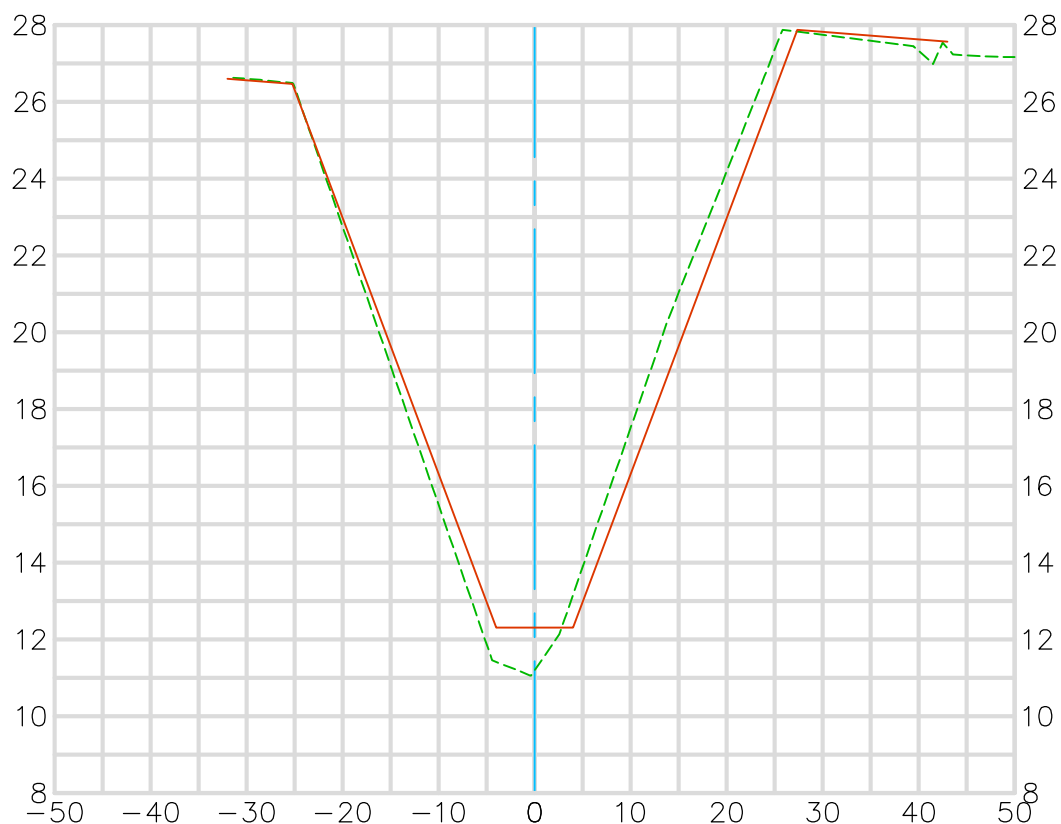

Existing Condition 2018
Record Plan 1960-1966
C06-101-2-A 1960, C06-101-4-A 1963, C06-103-1-M1966
Modified Per Engineer's Directive
Prepared 8/21/19

Horizontal Scale 1" = 20'
Vertical Scale 1" = 5'

OCEAN VIEW CHANNEL (C06)

33+50.00

CL CONSTRUCTION




Existing Condition 2018
 Record Plan 1960-1966
 C06-101-2-A 1960, C06-101-4-A 1963, C06-103-1-M1966
 Modified Per Engineer's Directive
 Prepared 8/21/19

Horizontal Scale 1" = 20'
 Vertical Scale 1" = 5'

OCEAN VIEW CHANNEL (C06)

34+00.00

CL CONSTRUCTION

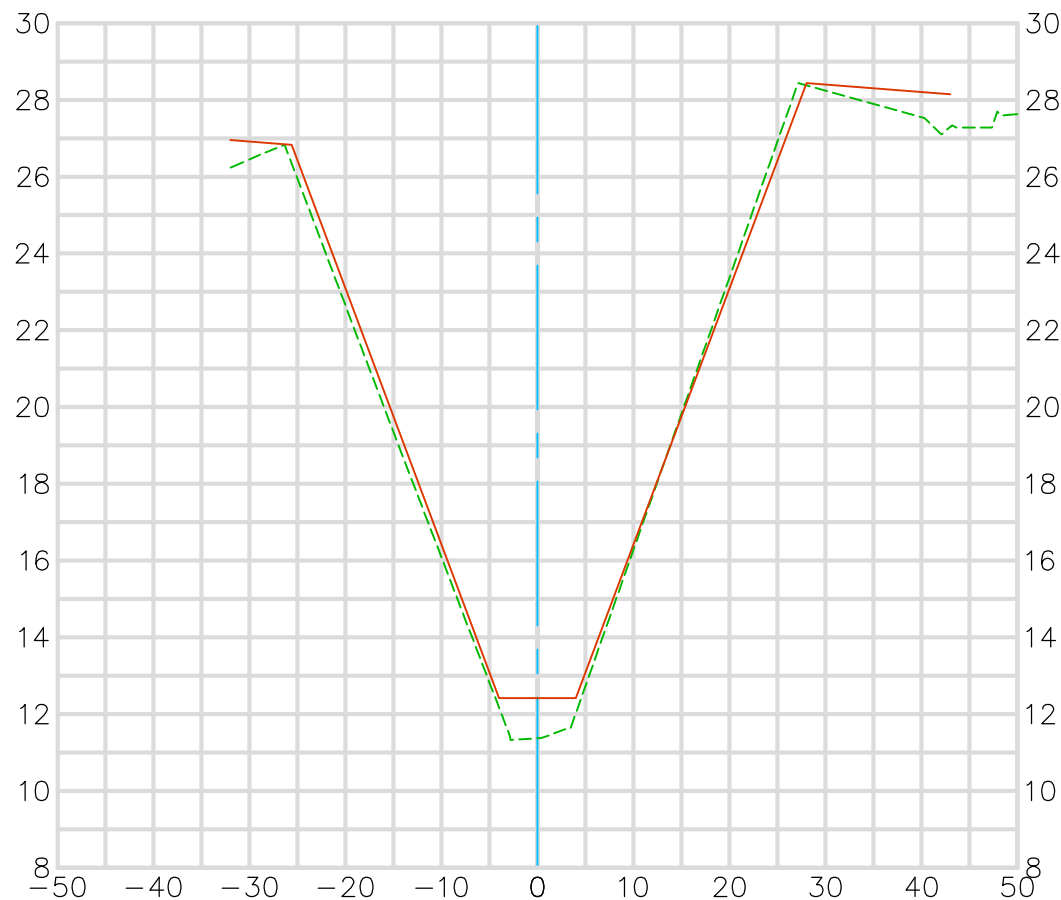


Existing Condition 2018
 Record Plan 1960-1966
 C06-101-2-A 1960, C06-101-4-A 1963, C06-103-1-M1966
 Modified Per Engineer's Directive
 Prepared 8/21/19

Horizontal Scale 1" = 20'
 Vertical Scale 1" = 5'

OCEAN VIEW CHANNEL (C06)

34+50.00

CL CONSTRUCTION

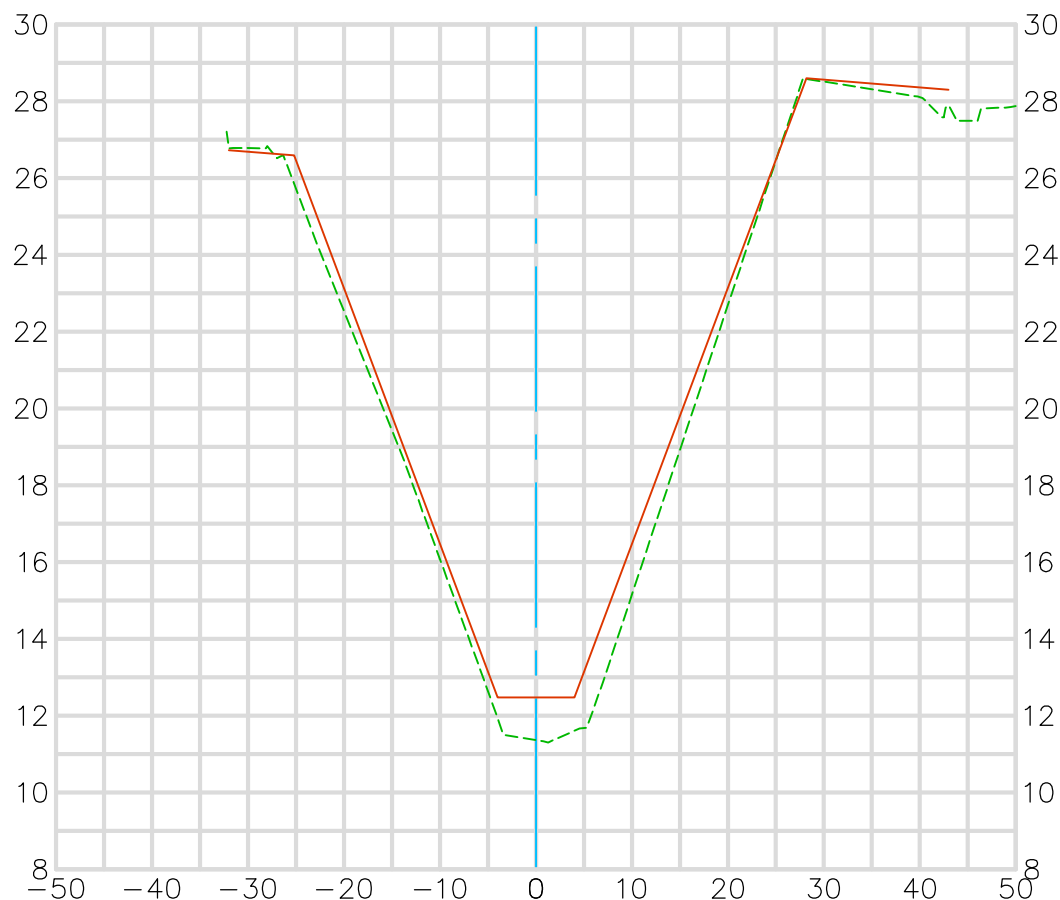

Existing Condition 2018
 Record Plan 1960-1966
 C06-101-2-A 1960, C06-101-4-A 1963, C06-103-1-M1966
 Modified Per Engineer's Directive
 Prepared 8/21/19


Horizontal Scale 1" = 20'
 Vertical Scale 1" = 5'

**U.S. Survey
Foot**

OC Public Works/
OC Survey/Field Services
Boundary Analysis & Mapping



OCEAN VIEW CHANNEL (C06) 35+00.00 CL CONSTRUCTION

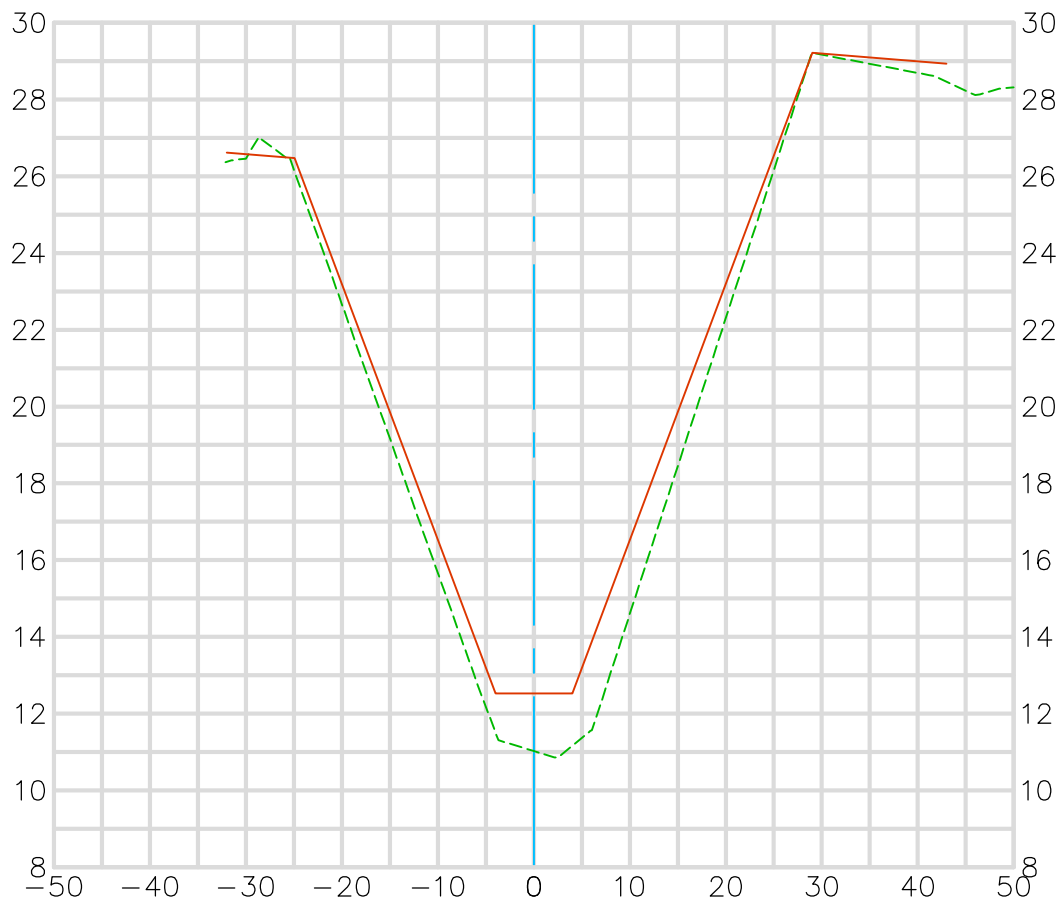


Existing Condition 2018
Record Plan 1960-1966
C06-101-2-A 1960, C06-101-4-A 1963, C06-103-1-M1966
Modified Per Engineer's Directive
Prepared 8/21/19

Horizontal Scale 1" = 20'
Vertical Scale 1" = 5'

OCEAN VIEW CHANNEL (C06)

35+50.00

CL CONSTRUCTION

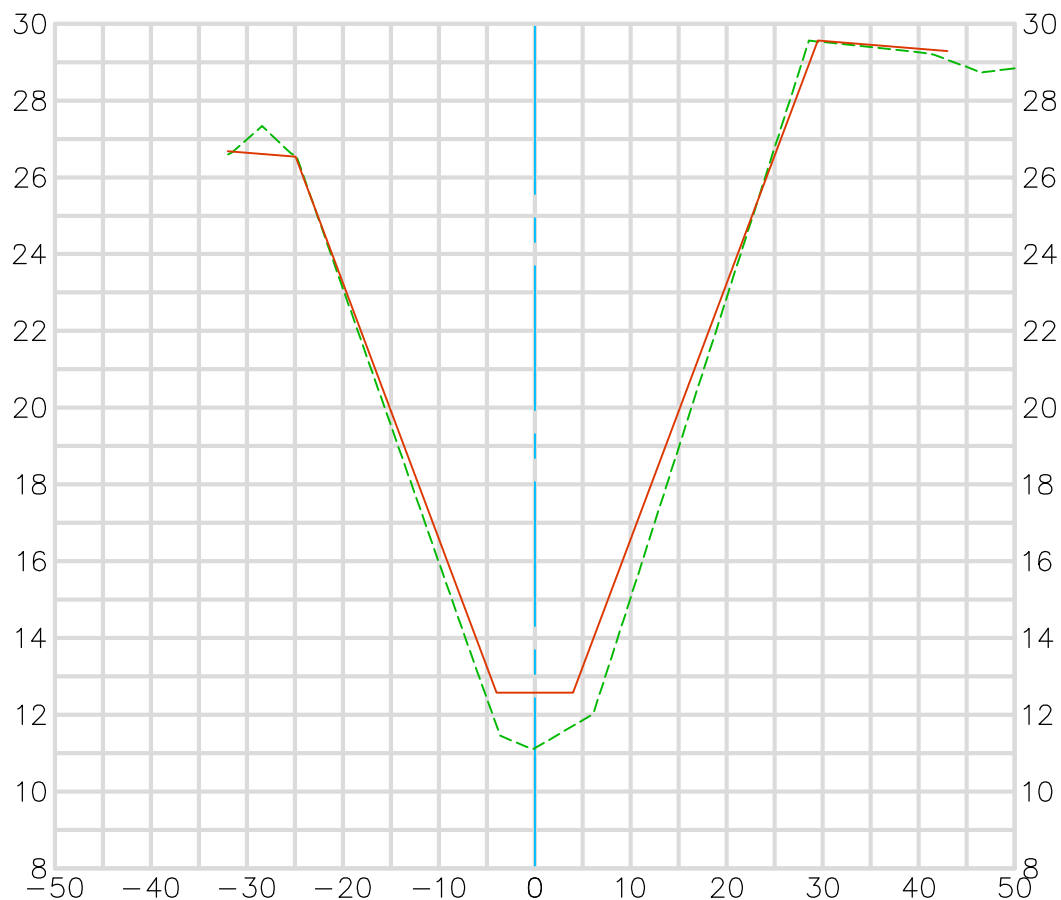

Existing Condition 2018
 Record Plan 1960-1966
 C06-101-2-A 1960, C06-101-4-A 1963, C06-103-1-M1966
 Modified Per Engineer's Directive
 Prepared 8/21/19

Horizontal Scale 1" = 20'
 Vertical Scale 1" = 5'

**U.S. Survey
Foot**


OC Public Works/
OC Survey/Field Services
Boundary Analysis & Mapping



OCEAN VIEW CHANNEL (C06)

36+00.00

CL CONSTRUCTION

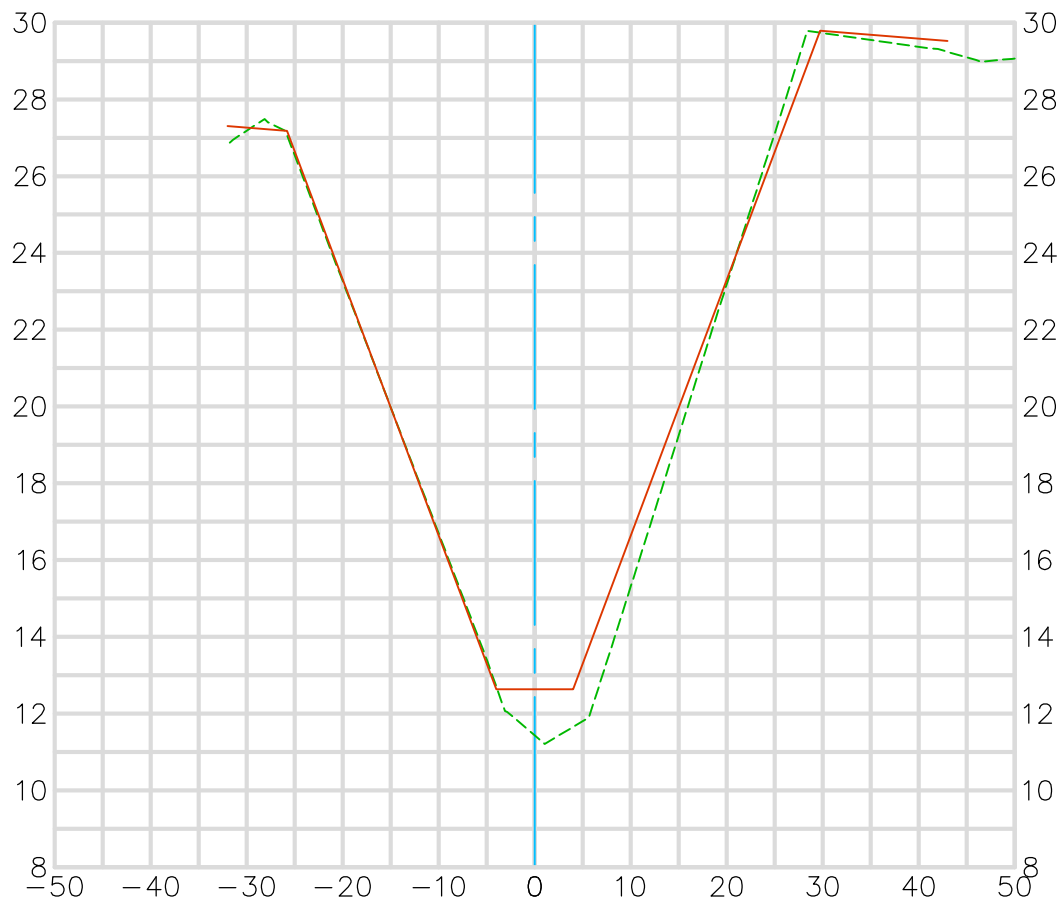

Existing Condition 2018
Record Plan 1960-1966
C06-101-2-A 1960, C06-101-4-A 1963, C06-103-1-M 1966
Modified Per Engineer's Directive
Prepared 8/21/19

Horizontal Scale 1" = 20'
Vertical Scale 1" = 5'


**U.S. Survey
Foot**

OC Public Works/
OC Survey/Field Services
Boundary Analysis & Mapping

OCEAN VIEW CHANNEL (C06)

36+50.00

CL CONSTRUCTION

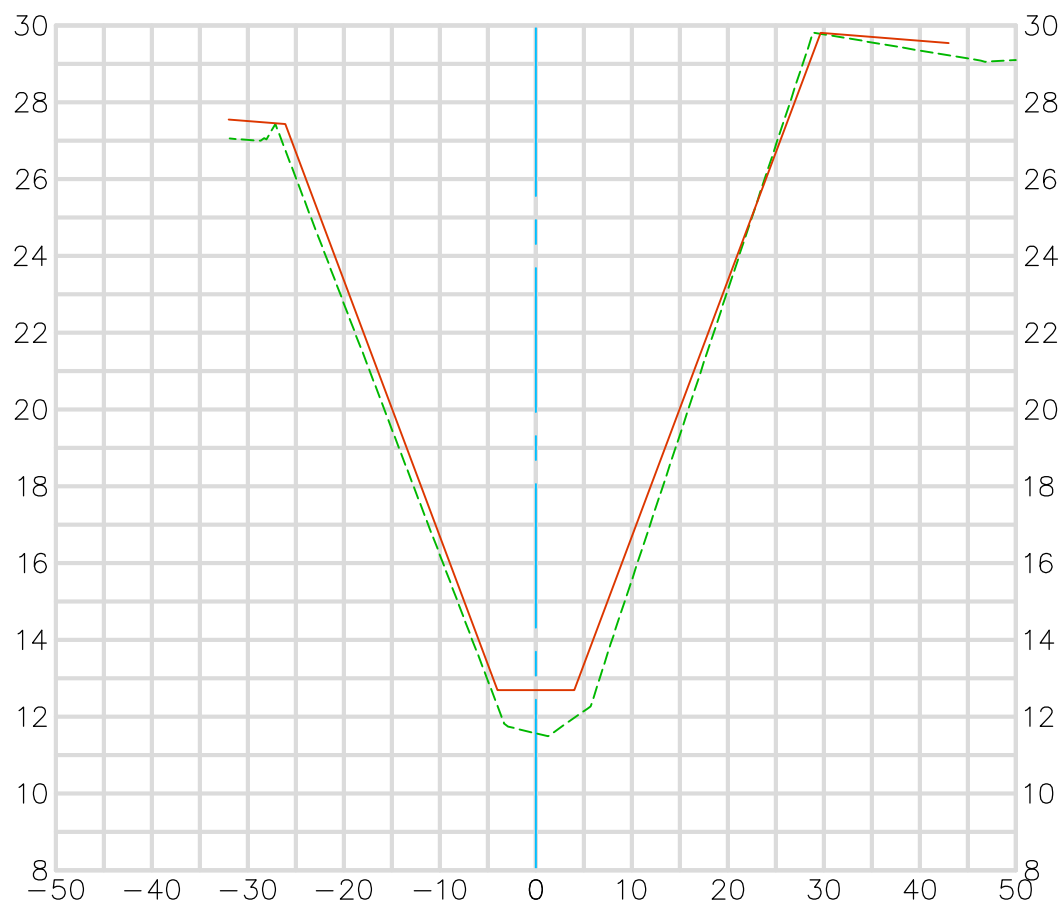

Existing Condition 2018
Record Plan 1960-1966
C06-101-2-A 1960, C06-101-4-A 1963, C06-103-1-M1966
Modified Per Engineer's Directive
Prepared 8/21/19

Horizontal Scale 1" = 20'
Vertical Scale 1" = 5'

**U.S. Survey
Foot**


OC Public Works/
OC Survey/Field Services
Boundary Analysis & Mapping



OCEAN VIEW CHANNEL (C06)

37+00.00

CL CONSTRUCTION

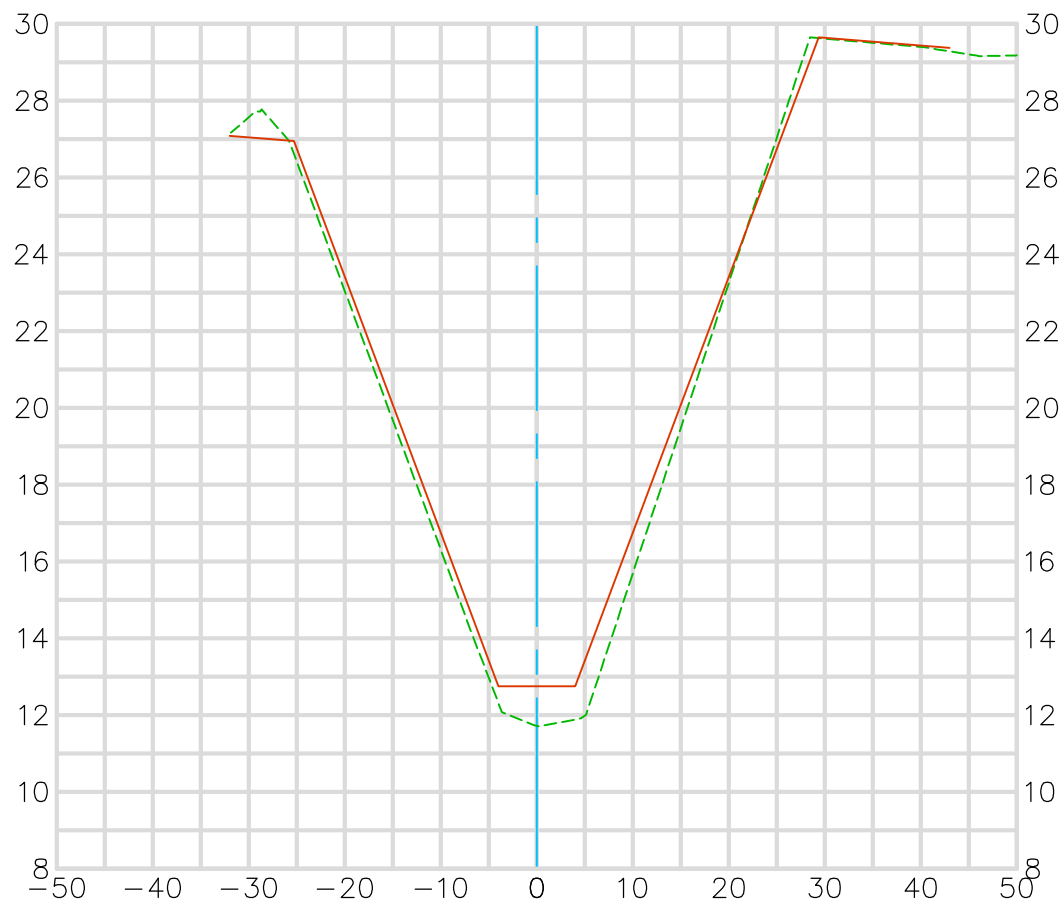

Existing Condition 2018
Record Plan 1960-1966
C06-101-2-A 1960, C06-101-4-A 1963, C06-103-1-M1966
Modified Per Engineer's Directive
Prepared 8/21/19

Horizontal Scale 1" = 20'
Vertical Scale 1" = 5'

**U.S. Survey
Foot**


OC Public Works/
OC Survey/Field Services
Boundary Analysis & Mapping



OCEAN VIEW CHANNEL (C06)


37+50.00

CL CONSTRUCTION

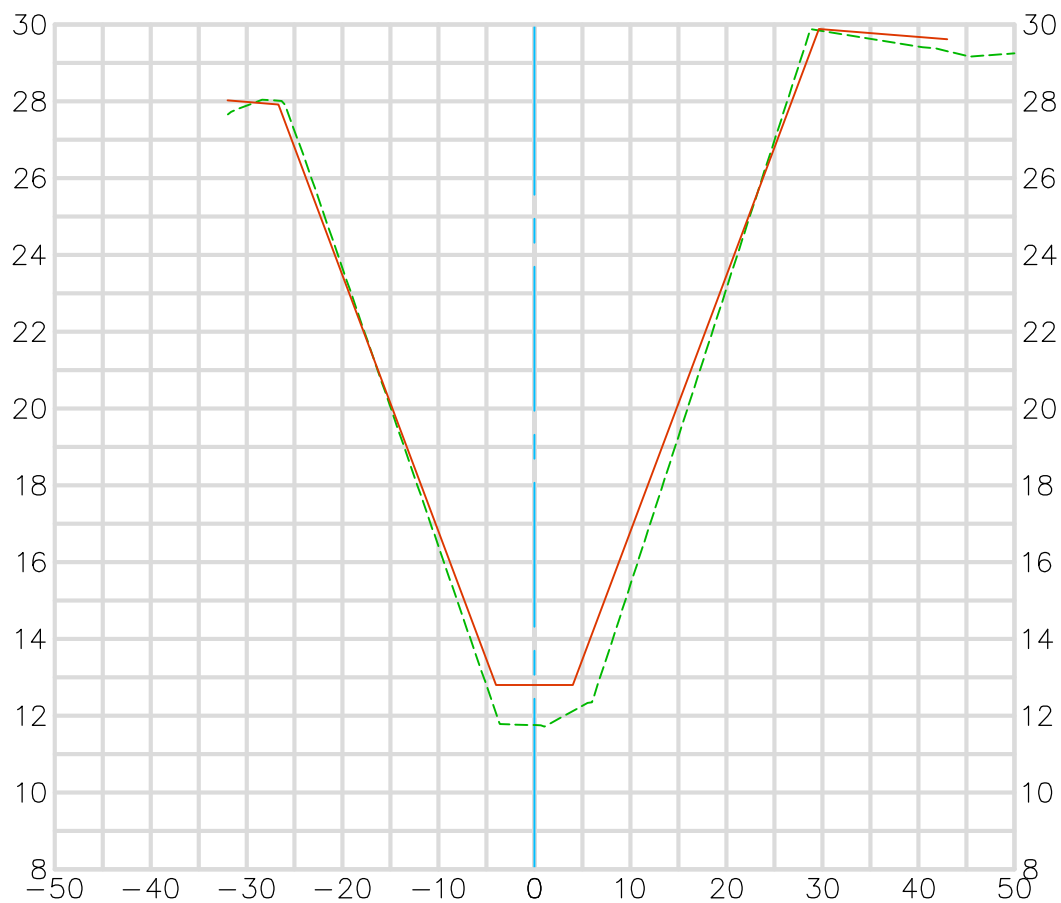

Existing Condition 2018
Record Plan 1960-1966
C06-101-2-A 1960, C06-101-4-A 1963, C06-103-1-M1966
Modified Per Engineer's Directive
Prepared 8/21/19


Horizontal Scale 1" = 20'
Vertical Scale 1" = 5'

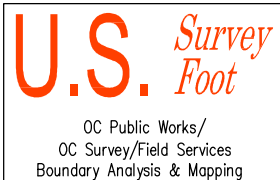

OCEAN VIEW CHANNEL (C06)

38+00.00

CL CONSTRUCTION

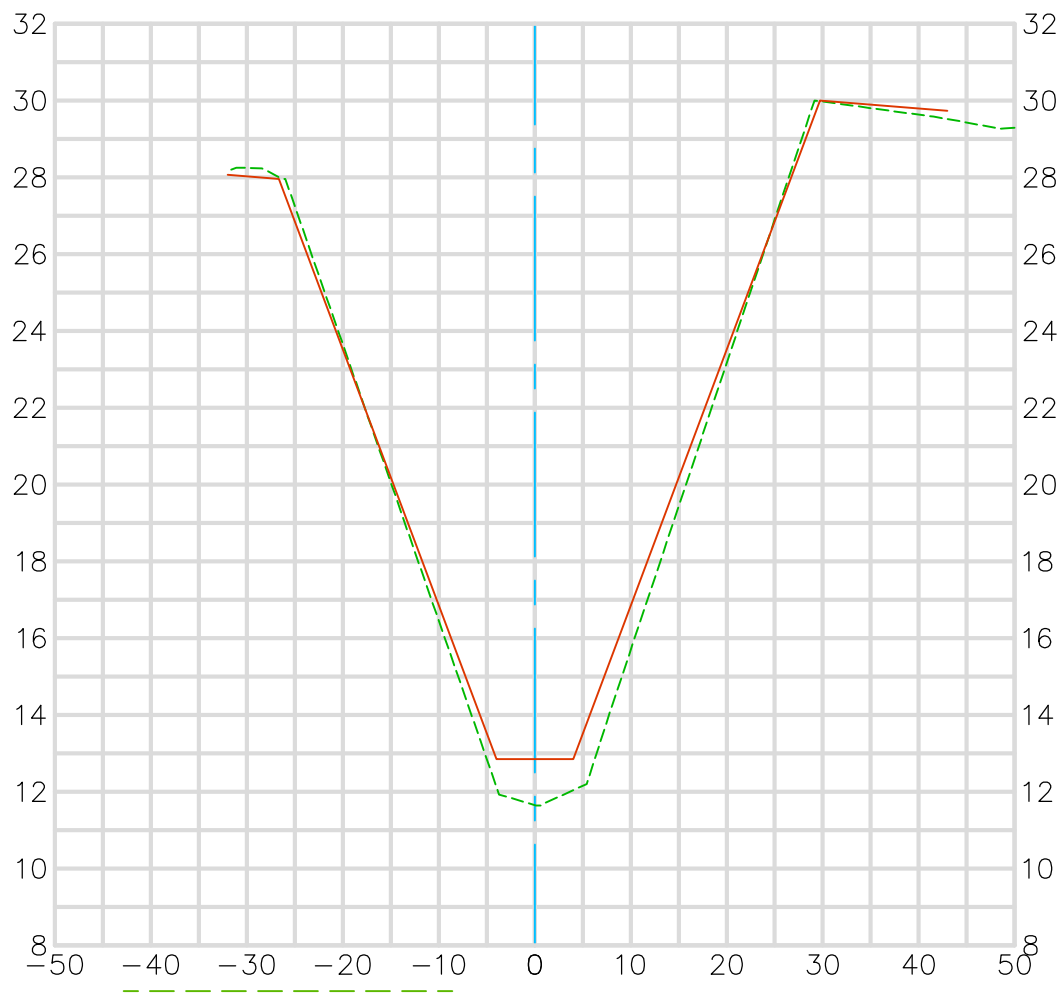

Existing Condition 2018
Record Plan 1960-1966
C06-101-2-A 1960, C06-101-4-A 1963, C06-103-1-M1966
Modified Per Engineer's Directive
Prepared 8/21/19

Horizontal Scale 1" = 20'
Vertical Scale 1" = 5'


U.S. *Survey
Foot*

OC Public Works/
OC Survey/Field Services
Boundary Analysis & Mapping

OCEAN VIEW CHANNEL (C06)

38+50.00

CL CONSTRUCTION

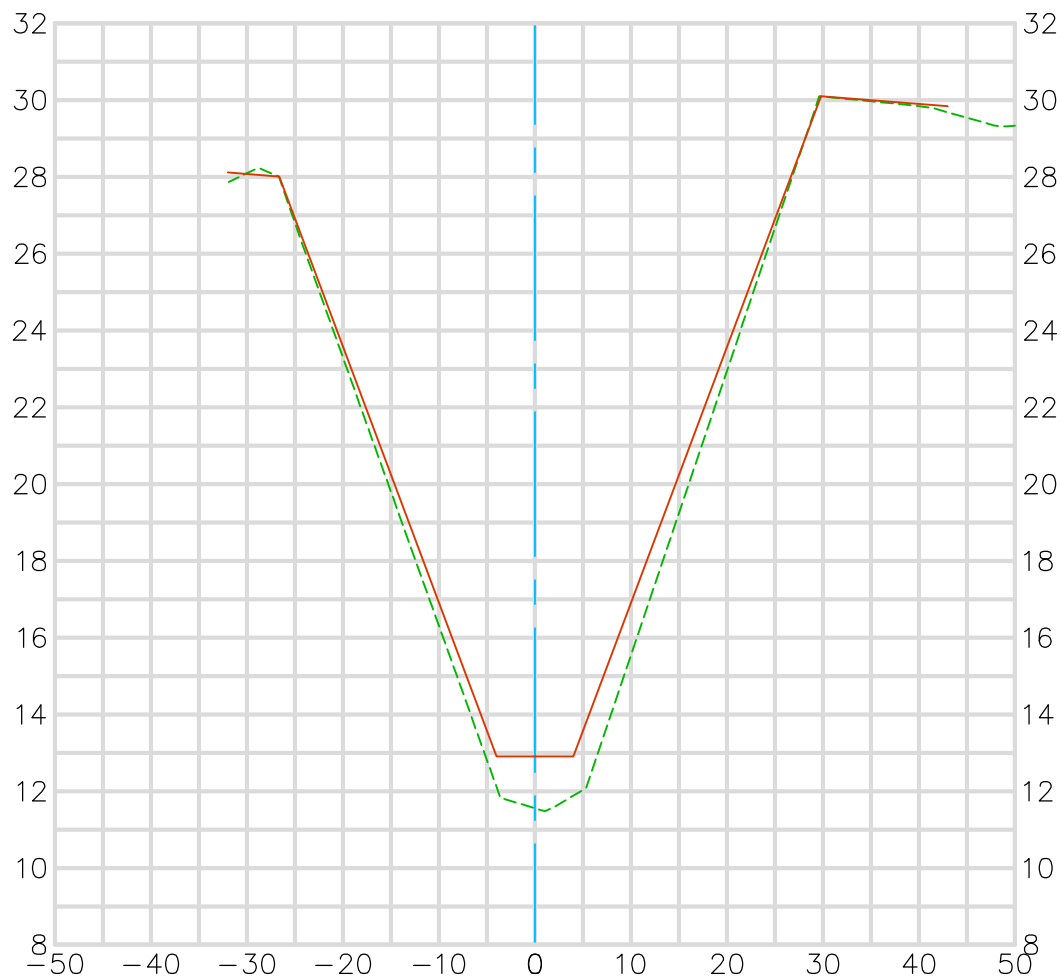

Existing Condition 2018

Record Plan 1960-1966

C06-101-2-A 1960, C06-101-4-A 1963, C06-103-1-M1966

Modified Per Engineer's Directive

Prepared 8/21/19

Horizontal Scale 1" = 20'

Vertical Scale 1" = 5'


**U.S. Survey
Foot**

OC Public Works/
OC Survey/Field Services
Boundary Analysis & Mapping

OCEAN VIEW CHANNEL (C06)

39+00.00

CL CONSTRUCTION

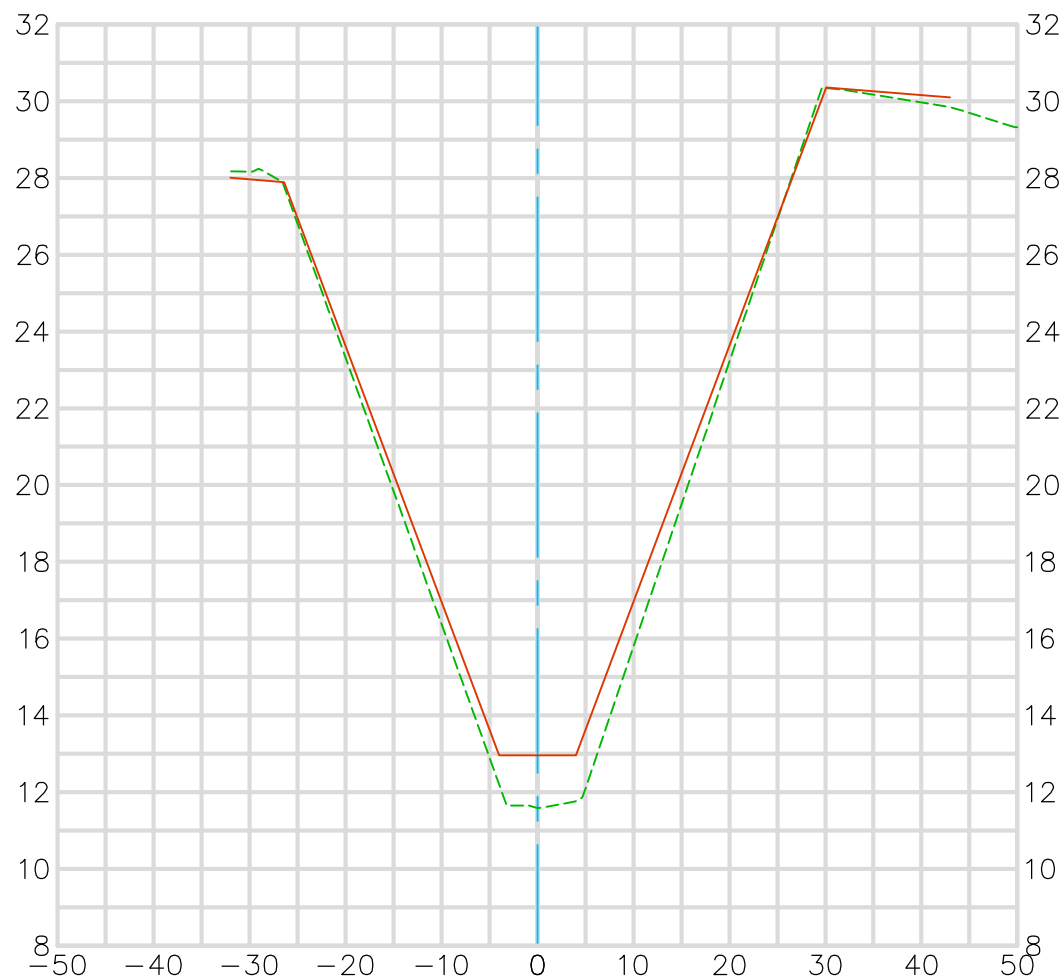

Existing Condition 2018
Record Plan 1960-1966
C06-101-2-A 1960, C06-101-4-A 1963, C06-103-1-M1966
Modified Per Engineer's Directive
Prepared 8/21/19

Horizontal Scale 1" = 20'
Vertical Scale 1" = 5'


**U.S. Survey
Foot**

OC Public Works/
OC Survey/Field Services
Boundary Analysis & Mapping

OCEAN VIEW CHANNEL (C06)

39+50.00

CL CONSTRUCTION

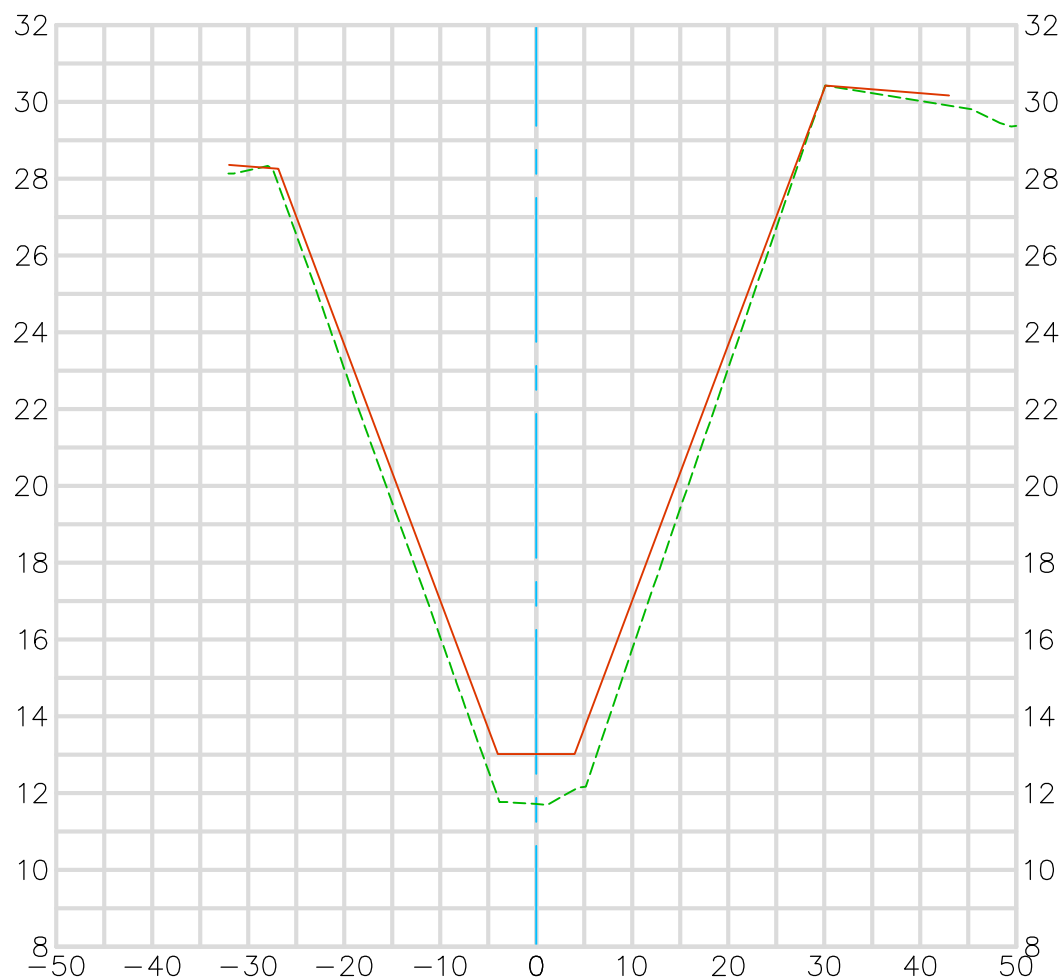


Existing Condition 2018
Record Plan 1960-1966
C06-101-2-A 1960, C06-101-4-A 1963, C06-103-1-M1966
Modified Per Engineer's Directive
Prepared 8/21/19

Horizontal Scale 1" = 20'
Vertical Scale 1" = 5'

**U.S. Survey
Foot**

OC Public Works/
OC Survey/Field Services
Boundary Analysis & Mapping

OCEAN VIEW CHANNEL (C06) 40+00.00 CL CONSTRUCTION

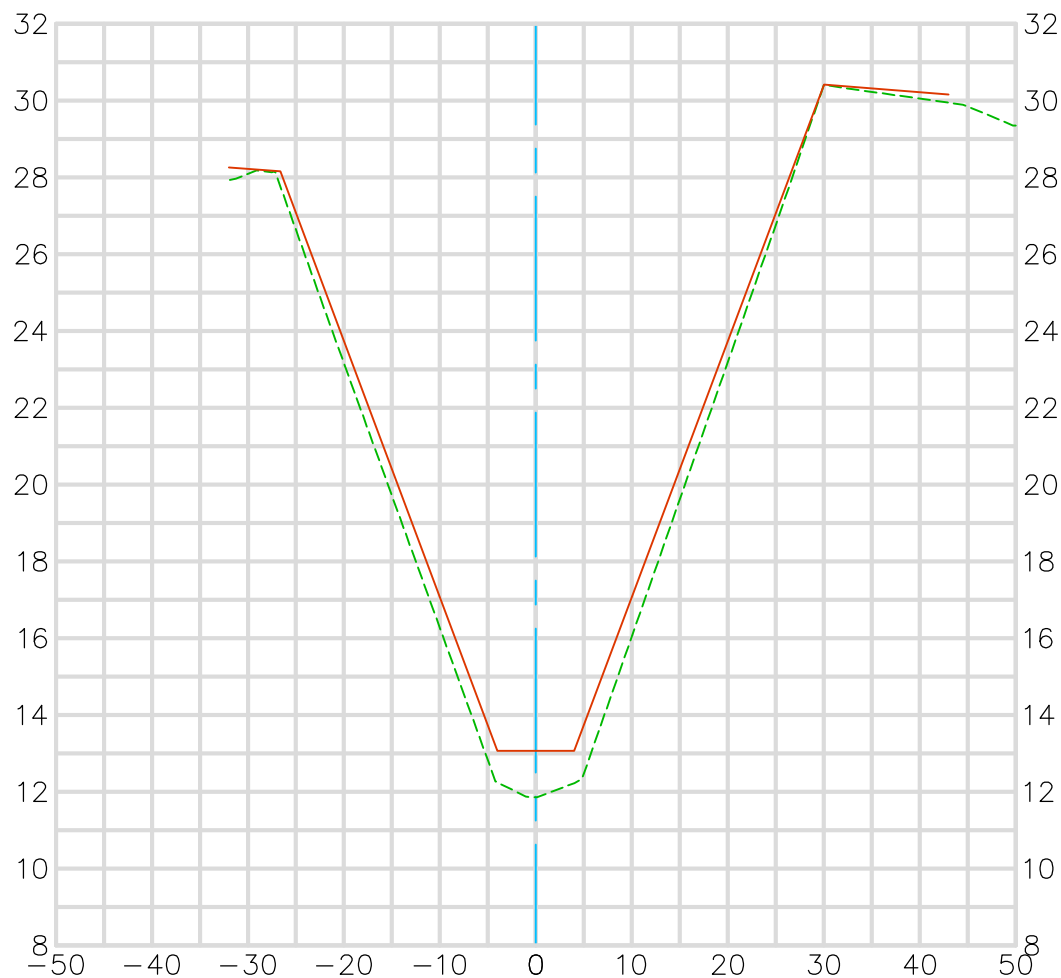


Existing Condition 2018
Record Plan 1960-1966
C06-101-2-A 1960, C06-101-4-A 1963, C06-103-1-M1966
Modified Per Engineer's Directive
Prepared 8/21/19

Horizontal Scale 1" = 20'
Vertical Scale 1" = 5'

**U.S. Survey
Foot**

OC Public Works/
OC Survey/Field Services
Boundary Analysis & Mapping

OCEAN VIEW CHANNEL (C06) 40+50.00 CL CONSTRUCTION

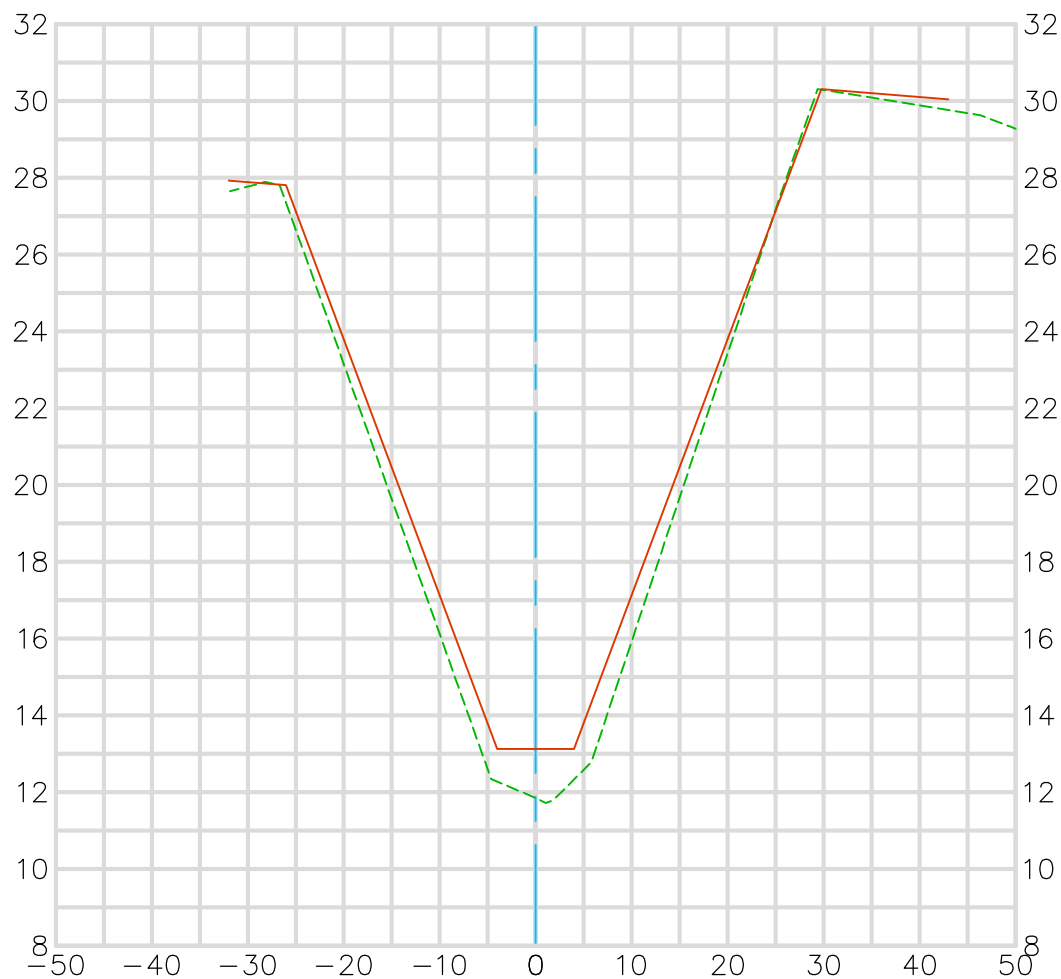

Existing Condition 2018
Record Plan 1960-1966
C06-101-2-A 1960, C06-101-4-A 1963, C06-103-1-M1966
Modified Per Engineer's Directive
Prepared 8/21/19

Horizontal Scale 1" = 20'
Vertical Scale 1" = 5'


**U.S. Survey
Foot**

OC Public Works/
OC Survey/Field Services
Boundary Analysis & Mapping

OCEAN VIEW CHANNEL (C06)

41+00.00

CL CONSTRUCTION

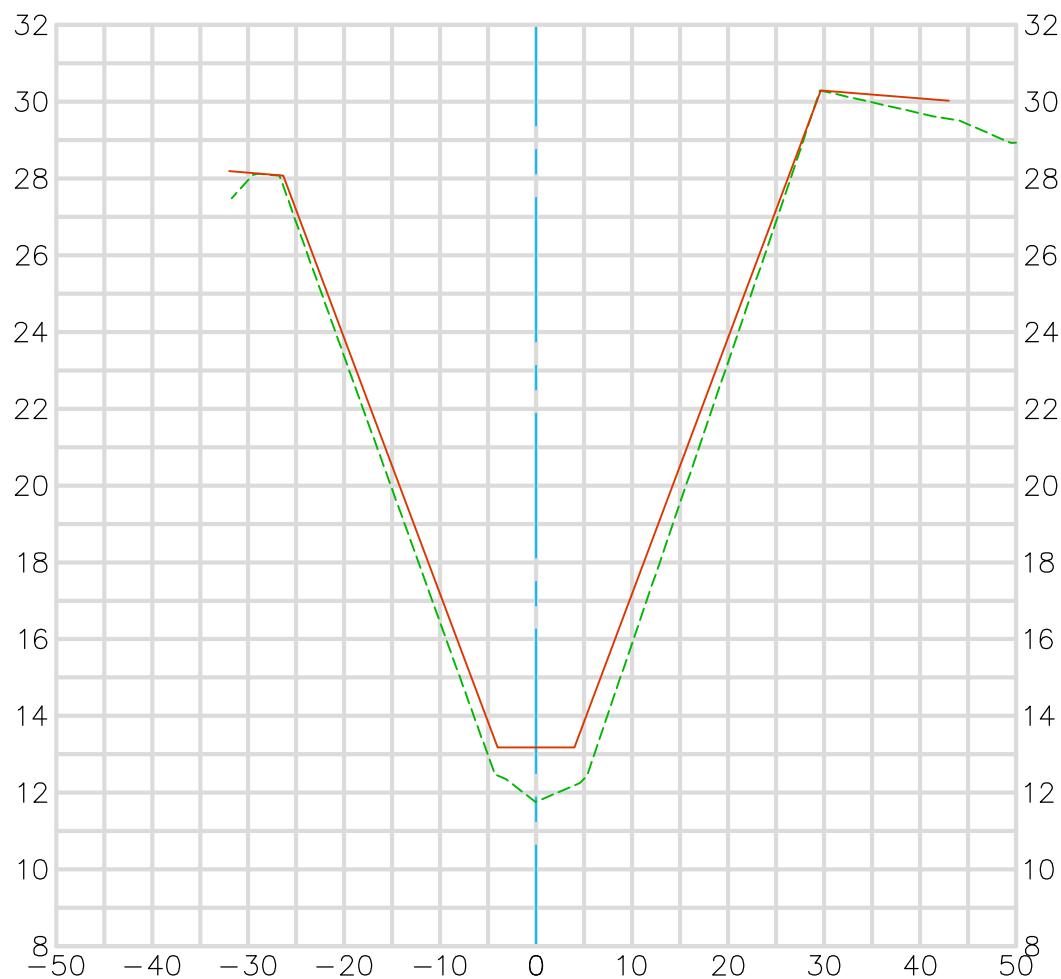


Existing Condition 2018
Record Plan 1960-1966
C06-101-2-A 1960, C06-101-4-A 1963, C06-103-1-M1966
Modified Per Engineer's Directive
Prepared 8/21/19

Horizontal Scale 1" = 20'
Vertical Scale 1" = 5'

**U.S. Survey
Foot**

OC Public Works/
OC Survey/Field Services
Boundary Analysis & Mapping

OCEAN VIEW CHANNEL (C06) 41+50.00 CL CONSTRUCTION

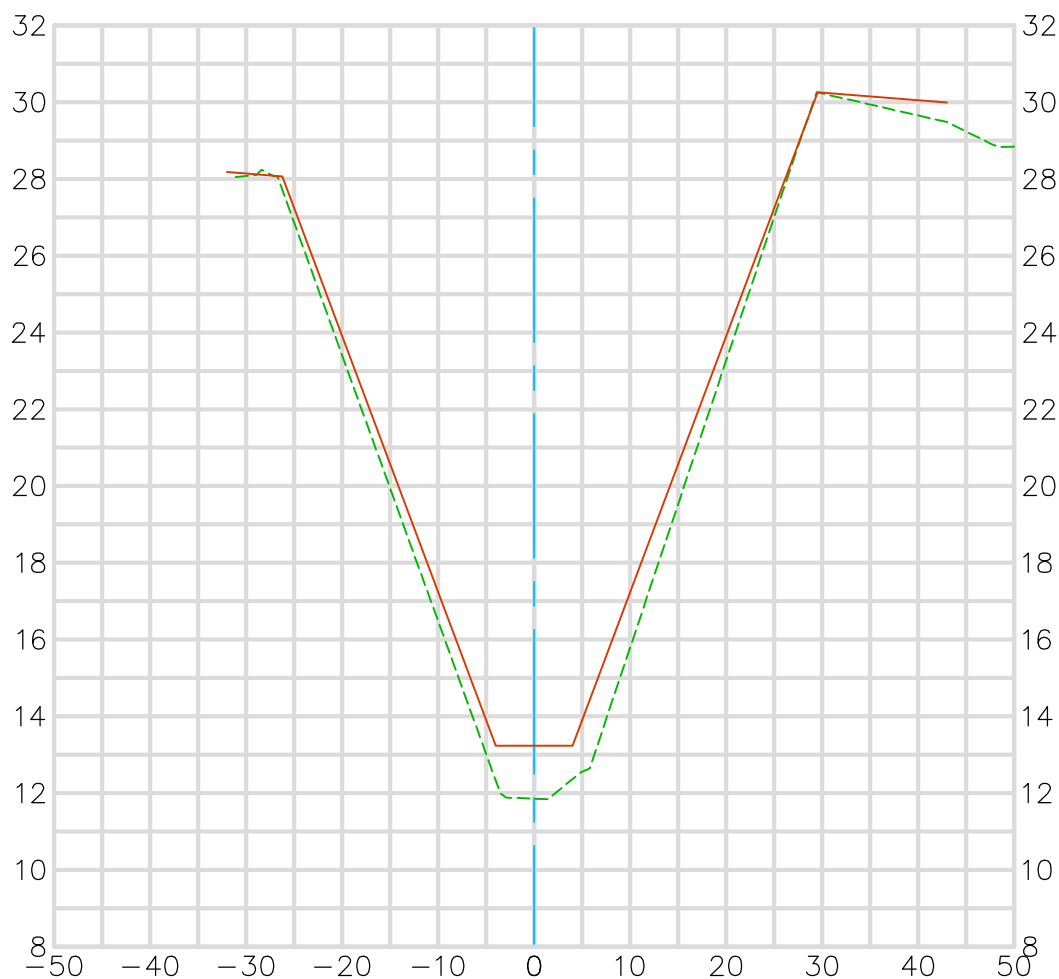

Existing Condition 2018

Record Plan 1960-1966


C06-101-2-A 1960, C06-101-4-A 1963, C06-103-1-M1966

Modified Per Engineer's Directive

Prepared 8/21/19

Horizontal Scale 1" = 20'


Vertical Scale 1" = 5'

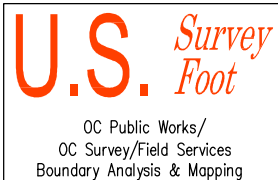

OCEAN VIEW CHANNEL (C06)

42+00.00

CL CONSTRUCTION

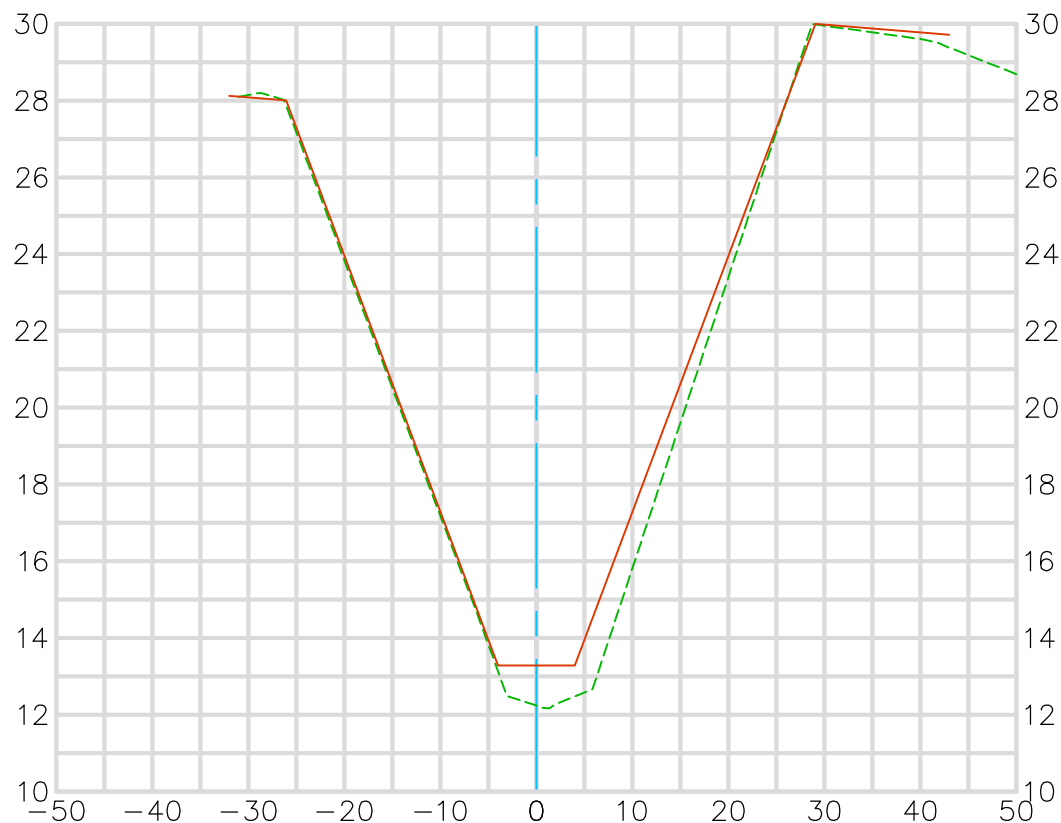


Existing Condition 2018
Record Plan 1960-1966
C06-101-2-A 1960, C06-101-4-A 1963, C06-103-1-M1966
Modified Per Engineer's Directive
Prepared 8/21/19

Horizontal Scale 1" = 20'
Vertical Scale 1" = 5'

**U.S. Survey
Foot**

OC Public Works/
OC Survey/Field Services
Boundary Analysis & Mapping

OCEAN VIEW CHANNEL (C06) 42+50.00 CL CONSTRUCTION

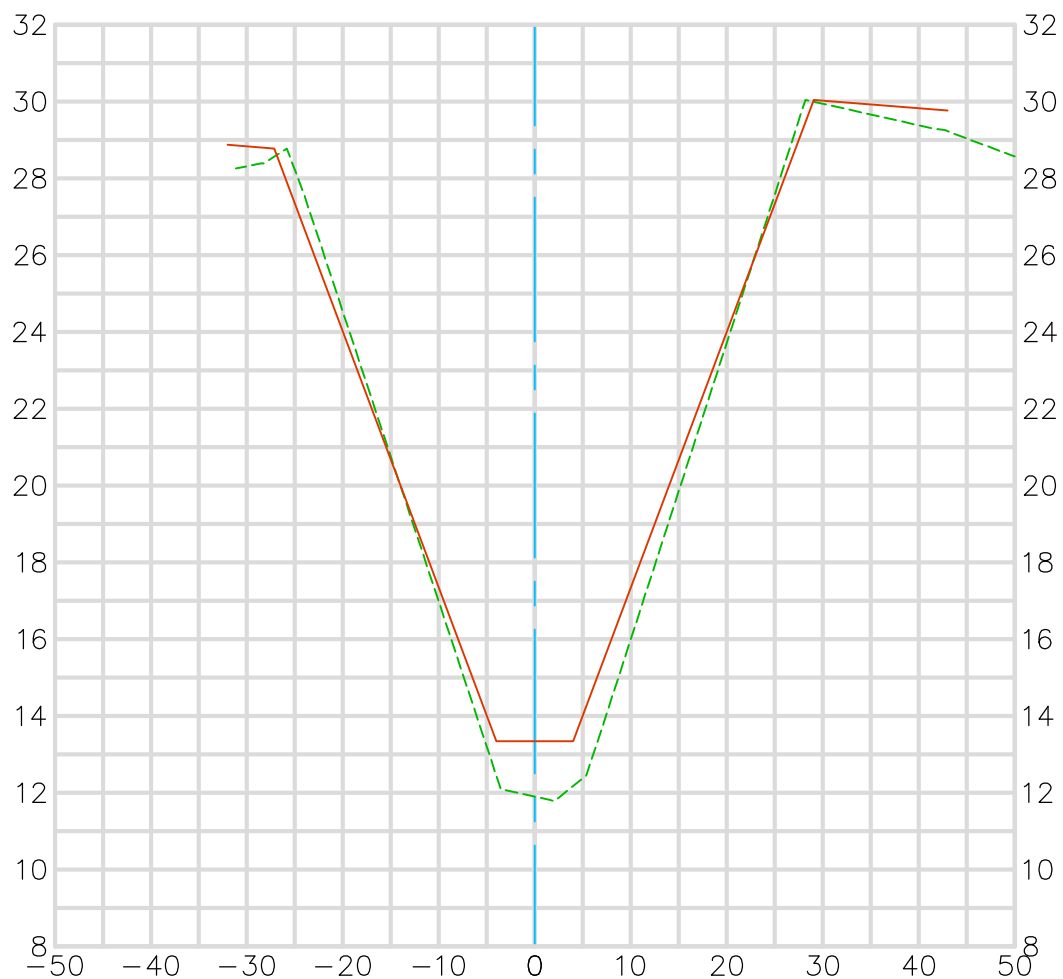

Existing Condition 2018
Record Plan 1960-1966
C06-101-2-A 1960, C06-101-4-A 1963, C06-103-1-M1966
Modified Per Engineer's Directive
Prepared 8/21/19

Horizontal Scale 1" = 20'
Vertical Scale 1" = 5'

U.S. Survey Foot

OC Public Works/
OC Survey/Field Services
Boundary Analysis & Mapping

OCEAN VIEW CHANNEL (C06) 43+00.00 CL CONSTRUCTION



Existing Condition 2018
Record Plan 1960-1966
C06-101-2-A 1960, C06-101-4-A 1963, C06-103-1-M1966
Modified Per Engineer's Directive
Prepared 8/21/19

Horizontal Scale 1" = 20'
Vertical Scale 1" = 5'


**U.S. Survey
Foot**

OC Public Works/
OC Survey/Field Services
Boundary Analysis & Mapping

OCEAN VIEW CHANNEL (C06)


43+50.00

CL CONSTRUCTION

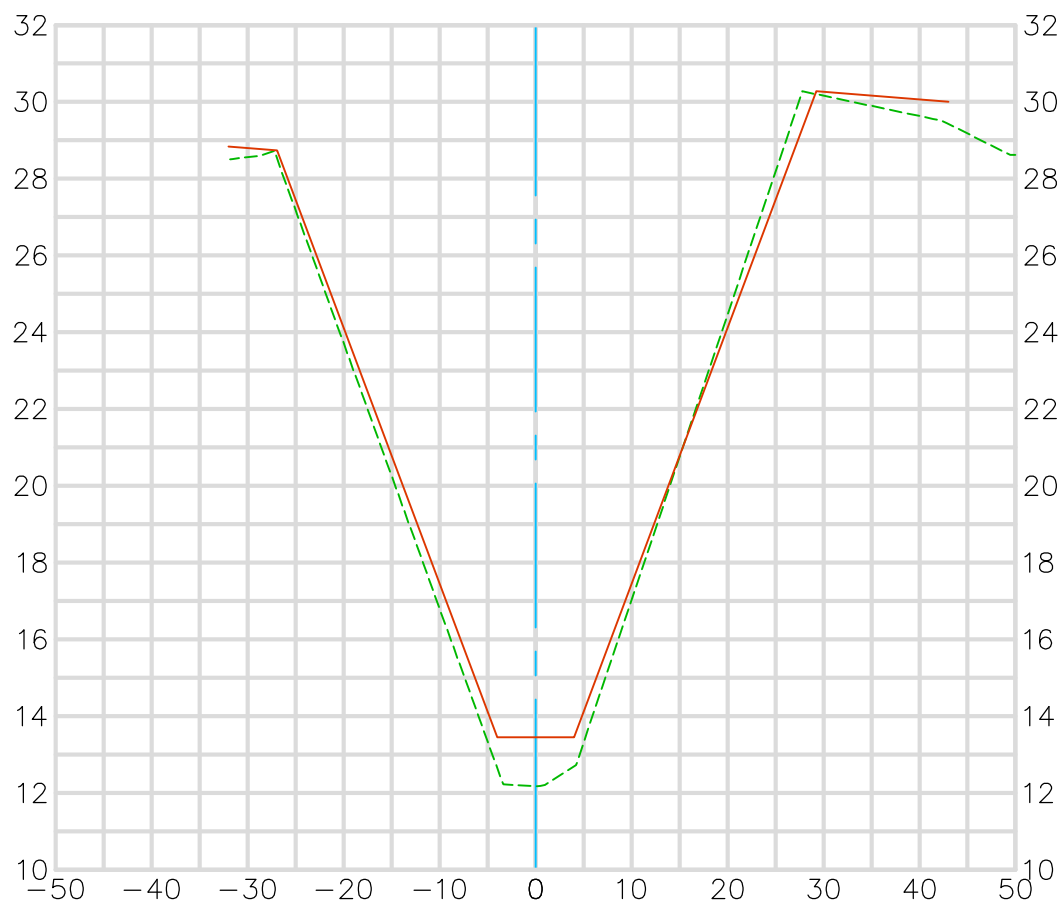

Existing Condition 2018
Record Plan 1960-1966
C06-101-2-A 1960, C06-101-4-A 1963, C06-103-1-M1966
Modified Per Engineer's Directive
Prepared 8/21/19


Horizontal Scale 1" = 20'
Vertical Scale 1" = 5'

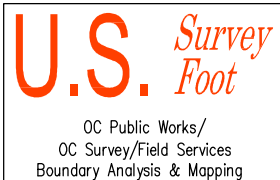

OCEAN VIEW CHANNEL (C06)

44+00.00

CL CONSTRUCTION

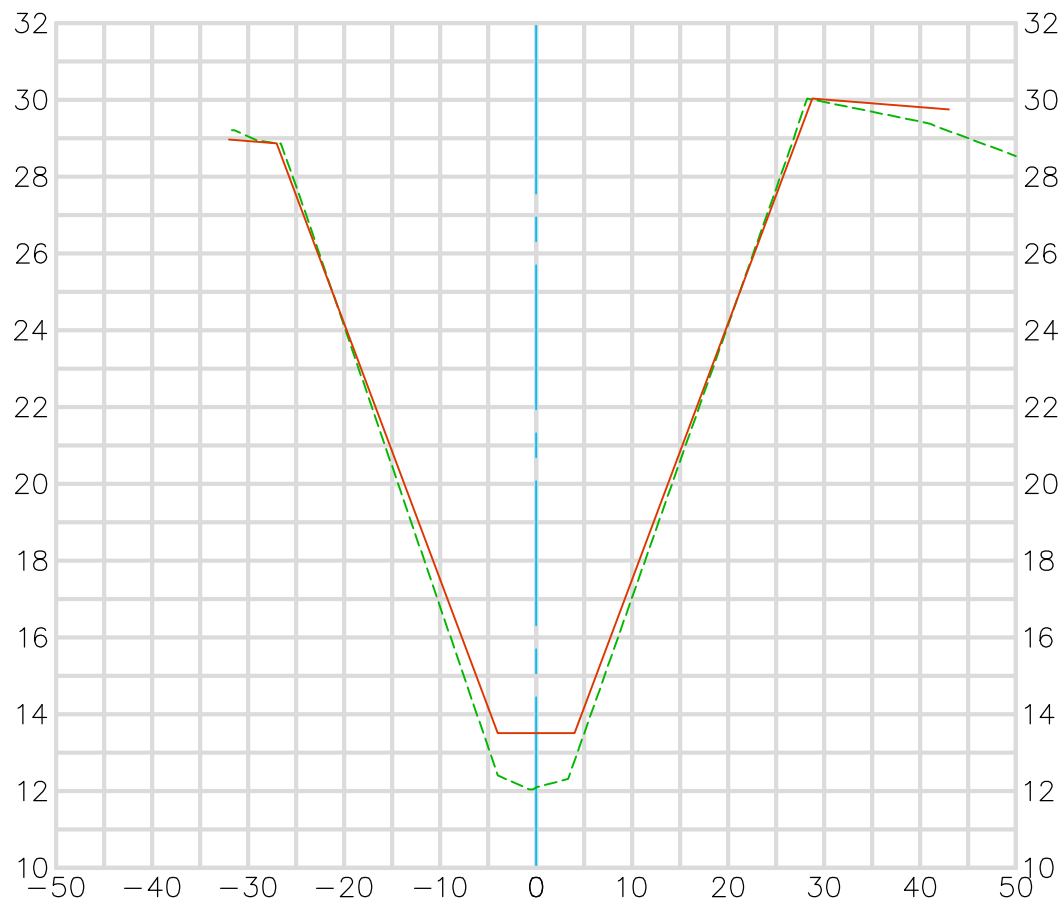


Existing Condition 2018
Record Plan 1960-1966
C06-101-2-A 1960, C06-101-4-A 1963, C06-103-1-M1966
Modified Per Engineer's Directive
Prepared 8/21/19

Horizontal Scale 1" = 20'
Vertical Scale 1" = 5'

OCEAN VIEW CHANNEL (C06)

44+50.00

CL CONSTRUCTION

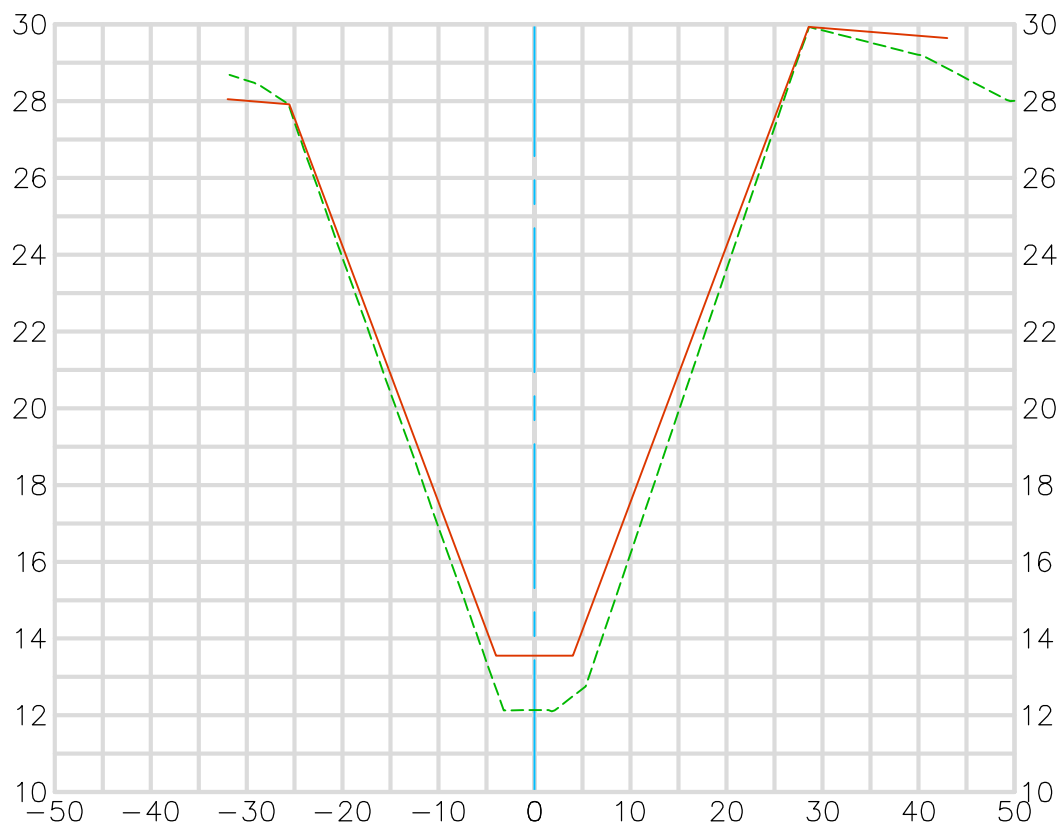


Existing Condition 2018
 Record Plan 1960-1966
 C06-101-2-A 1960, C06-101-4-A 1963, C06-103-1-M1966
 Modified Per Engineer's Directive
 Prepared 8/21/19

Horizontal Scale 1" = 20'
 Vertical Scale 1" = 5'

OCEAN VIEW CHANNEL (C06)

45+00.00

CL CONSTRUCTION

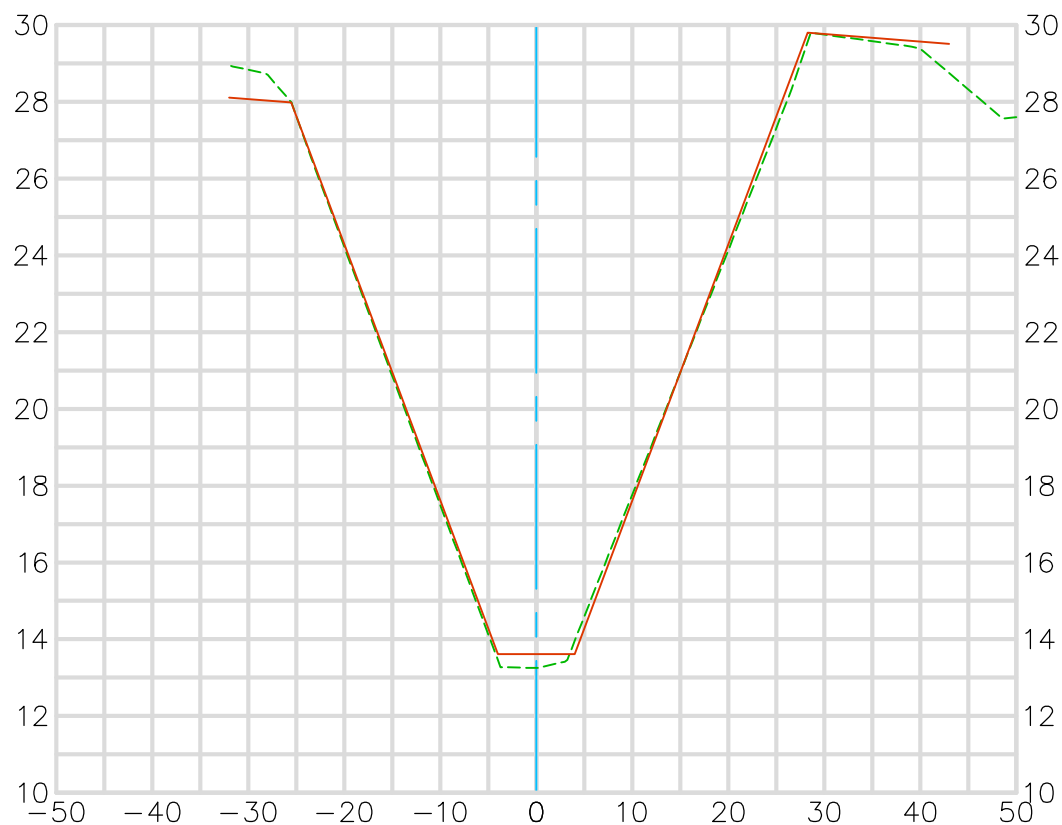


Existing Condition 2018
 Record Plan 1960-1966
 C06-101-2-A 1960, C06-101-4-A 1963, C06-103-1-M1966
 Modified Per Engineer's Directive
 Prepared 8/21/19

Horizontal Scale 1" = 20'
 Vertical Scale 1" = 5'

OCEAN VIEW CHANNEL (C06)


45+50.00

CL CONSTRUCTION

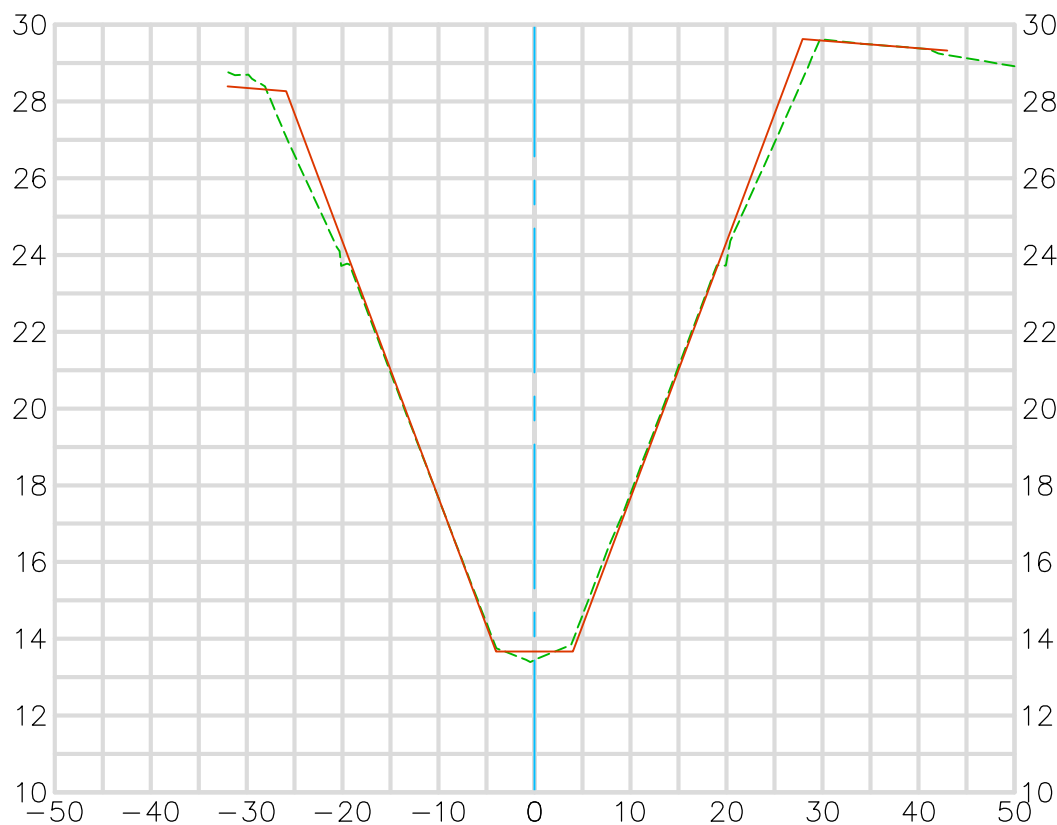

Existing Condition 2018
 Record Plan 1960-1966
 C06-101-2-A 1960, C06-101-4-A 1963, C06-103-1-M1966
 Modified Per Engineer's Directive
 Prepared 8/21/19


Horizontal Scale 1" = 20'
 Vertical Scale 1" = 5'

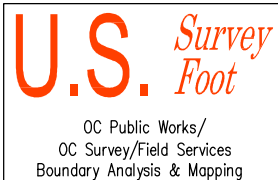

OCEAN VIEW CHANNEL (C06)


46+00.00

CL CONSTRUCTION

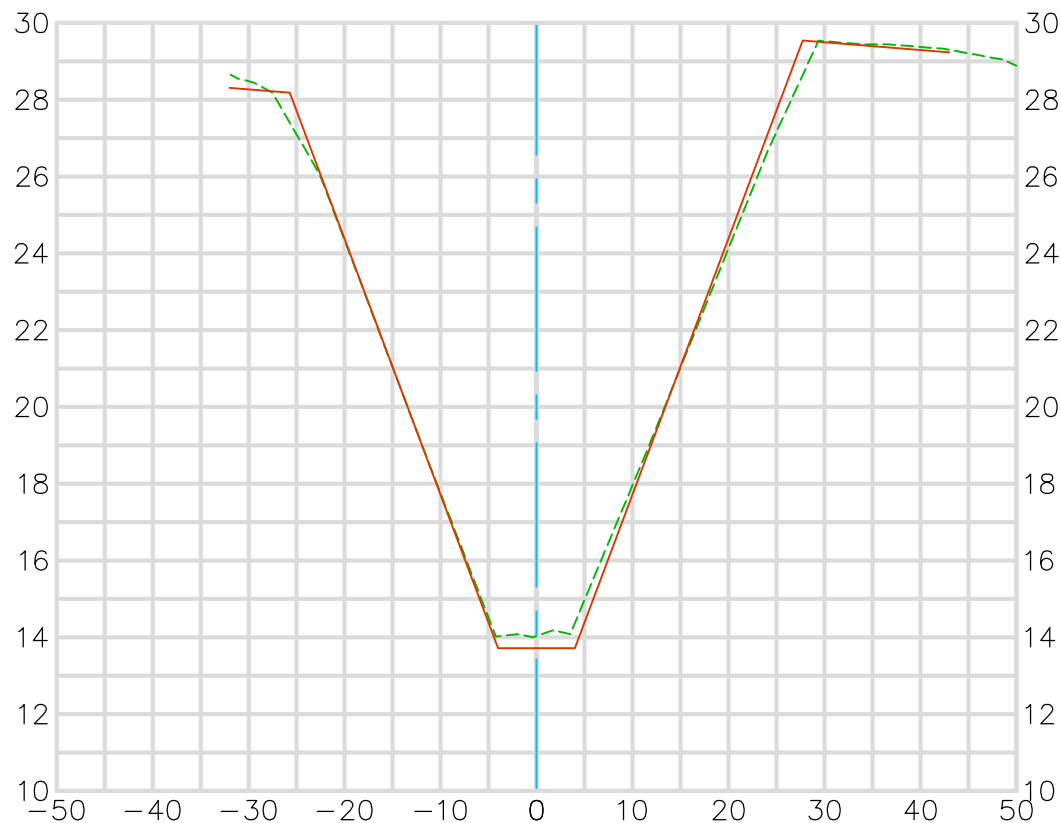

Existing Condition 2018
Record Plan 1960-1966
C06-101-2-A 1960, C06-101-4-A 1963, C06-103-1-M1966
Modified Per Engineer's Directive
Prepared 8/21/19


Horizontal Scale 1" = 20'
Vertical Scale 1" = 5'

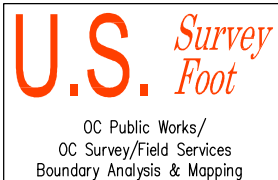

OCEAN VIEW CHANNEL (C06)


46+50.00

CL CONSTRUCTION

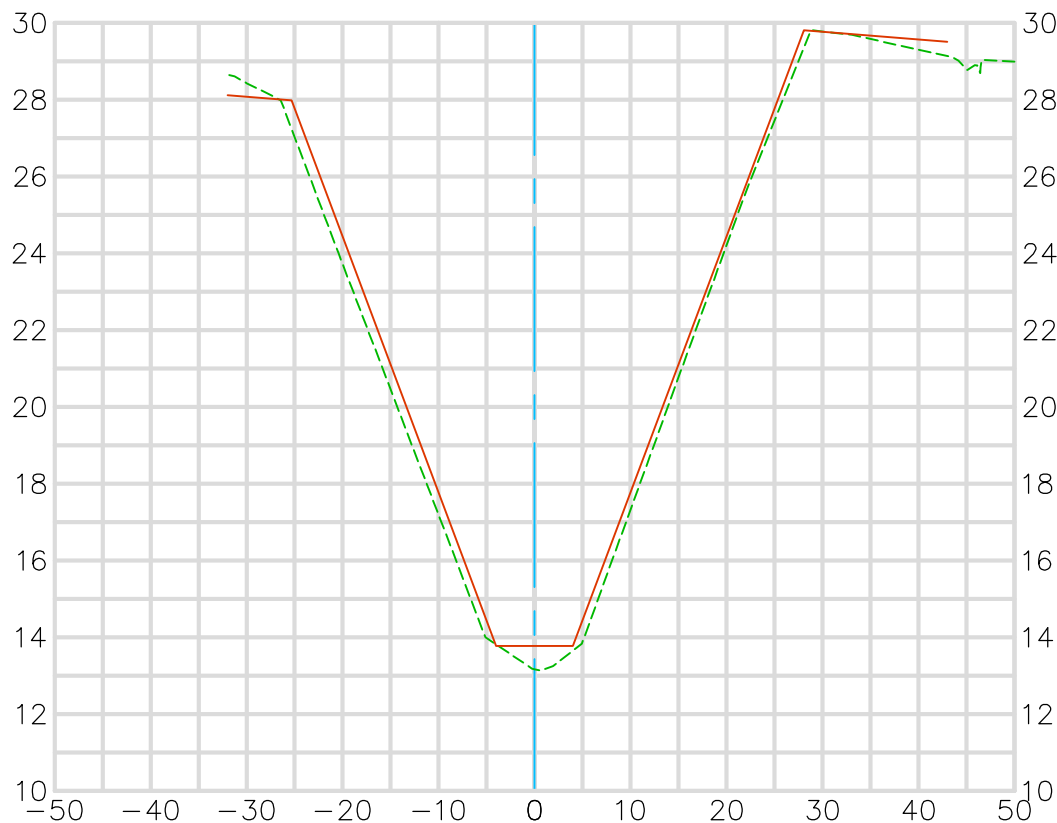

Existing Condition 2018
Record Plan 1960-1966
C06-101-2-A 1960, C06-101-4-A 1963, C06-103-1-M1966
Modified Per Engineer's Directive
Prepared 8/21/19


Horizontal Scale 1" = 20'
Vertical Scale 1" = 5'

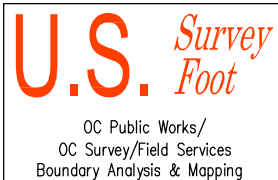

OCEAN VIEW CHANNEL (C06)


47+00.00

CL CONSTRUCTION

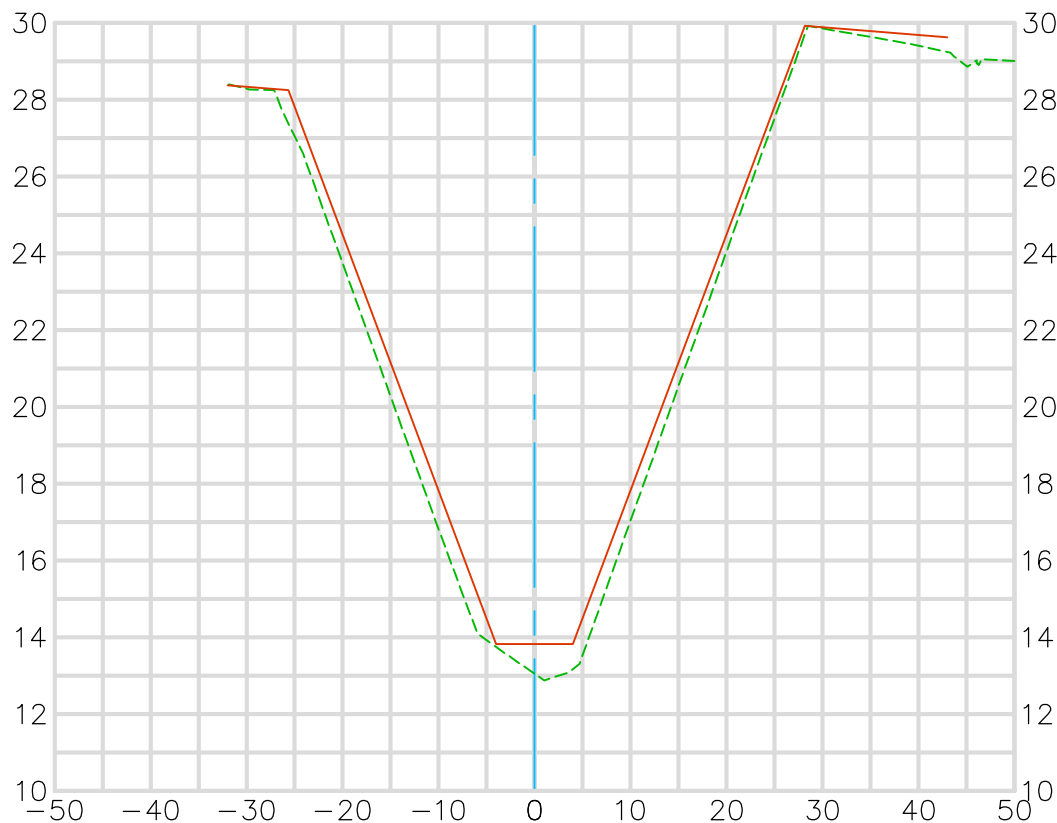

Existing Condition 2018
Record Plan 1960-1966
C06-101-2-A 1960, C06-101-4-A 1963, C06-103-1-M1966
Modified Per Engineer's Directive
Prepared 8/21/19


Horizontal Scale 1" = 20'
Vertical Scale 1" = 5'

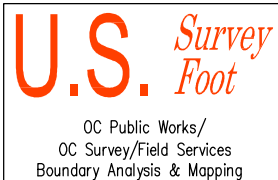

OCEAN VIEW CHANNEL (C06)


47+50.00

CL CONSTRUCTION

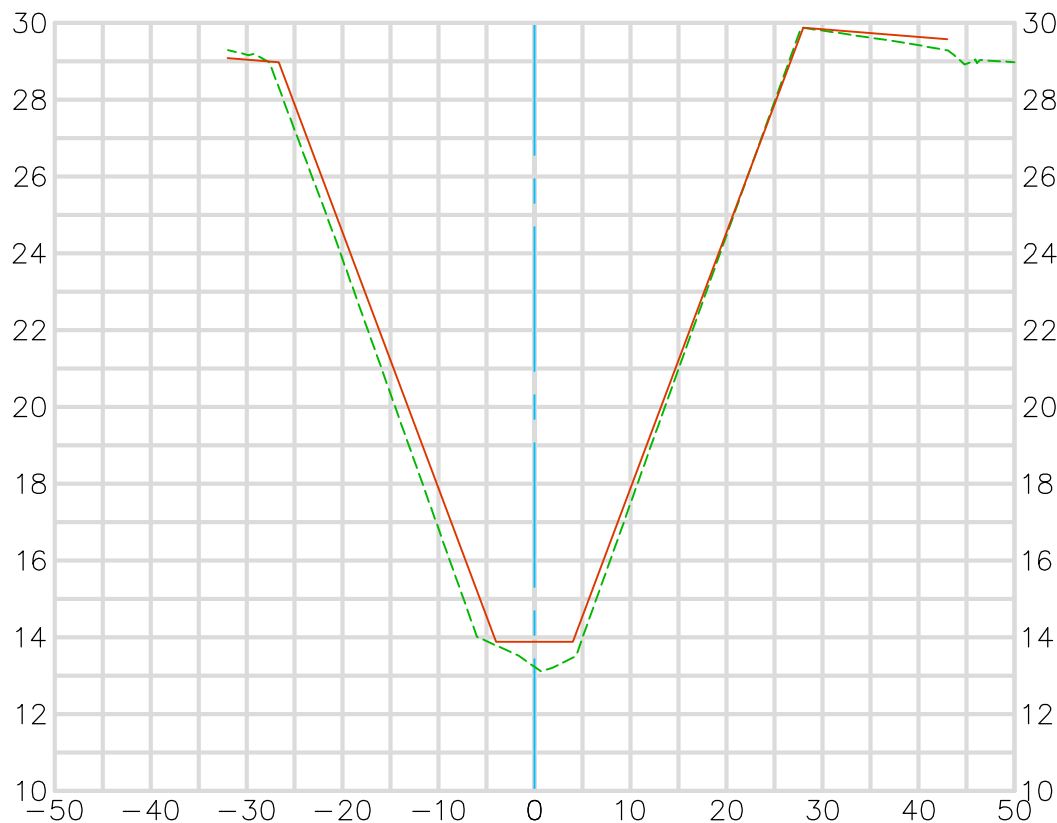

Existing Condition 2018
Record Plan 1960-1966
C06-101-2-A 1960, C06-101-4-A 1963, C06-103-1-M1966
Modified Per Engineer's Directive
Prepared 8/21/19


Horizontal Scale 1" = 20'
Vertical Scale 1" = 5'

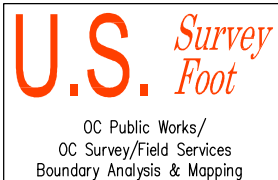

OCEAN VIEW CHANNEL (C06)

48+00.00

CL CONSTRUCTION

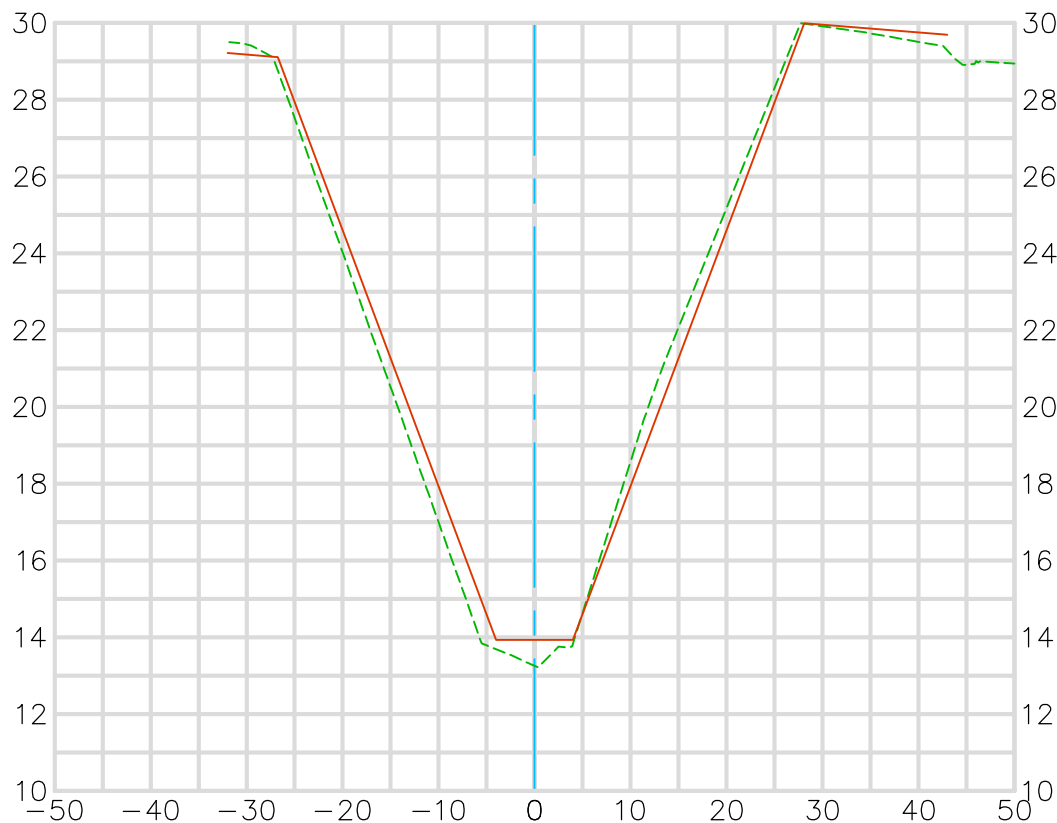

Existing Condition 2018
Record Plan 1960-1966
C06-101-2-A 1960, C06-101-4-A 1963, C06-103-1-M1966
Modified Per Engineer's Directive
Prepared 8/21/19

Horizontal Scale 1" = 20'
Vertical Scale 1" = 5'

OCEAN VIEW CHANNEL (C06)


48+50.00

CL CONSTRUCTION



Existing Condition 2018
Record Plan 1960-1966
C06-101-2-A 1960, C06-101-4-A 1963, C06-103-1-M1966
Modified Per Engineer's Directive
Prepared 8/21/19



Horizontal Scale 1" = 20'
Vertical Scale 1" = 5'

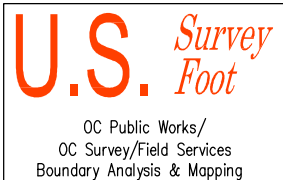

OCEAN VIEW CHANNEL (C06)


49+00.00

CL CONSTRUCTION

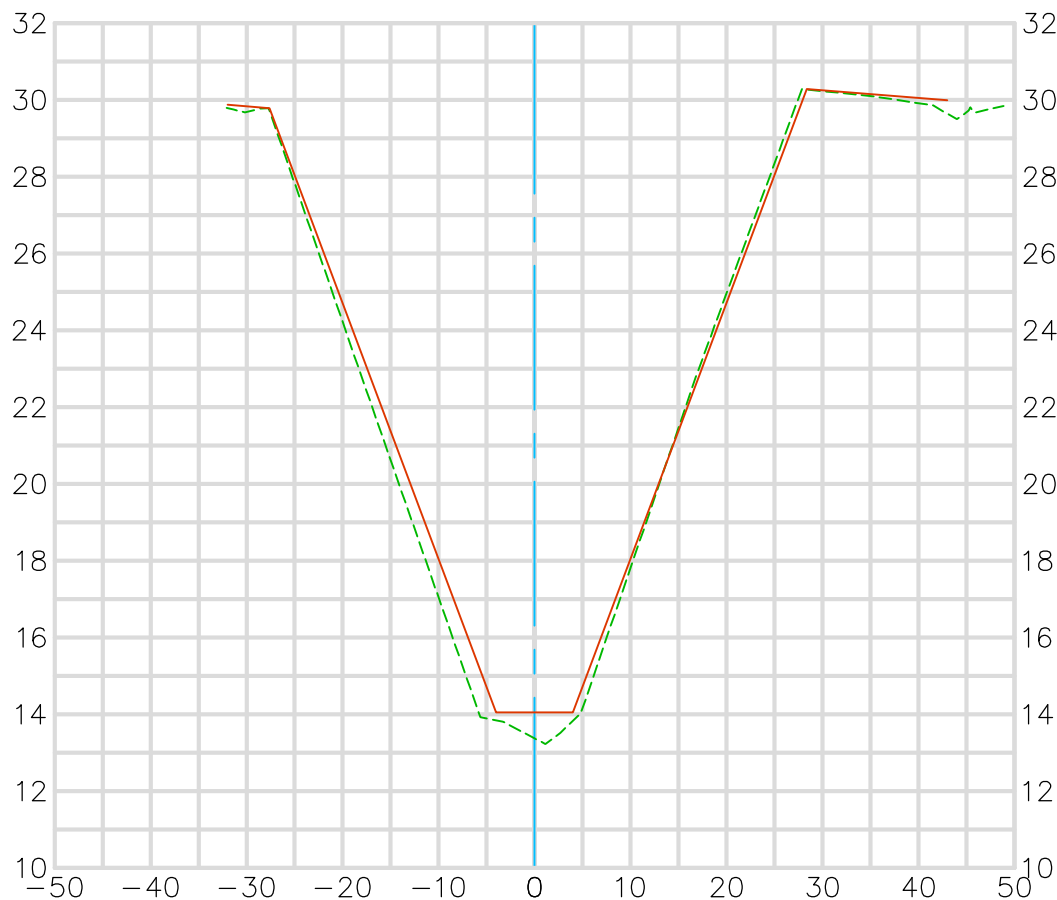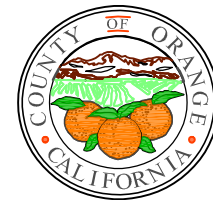

Existing Condition 2018
Record Plan 1960-1966
C06-101-2-A 1960, C06-101-4-A 1963, C06-103-1-M1966
Modified Per Engineer's Directive
Prepared 8/21/19


Horizontal Scale 1" = 20'
Vertical Scale 1" = 5'

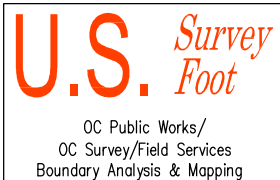

OCEAN VIEW CHANNEL (C06)

49+50.00

CL CONSTRUCTION

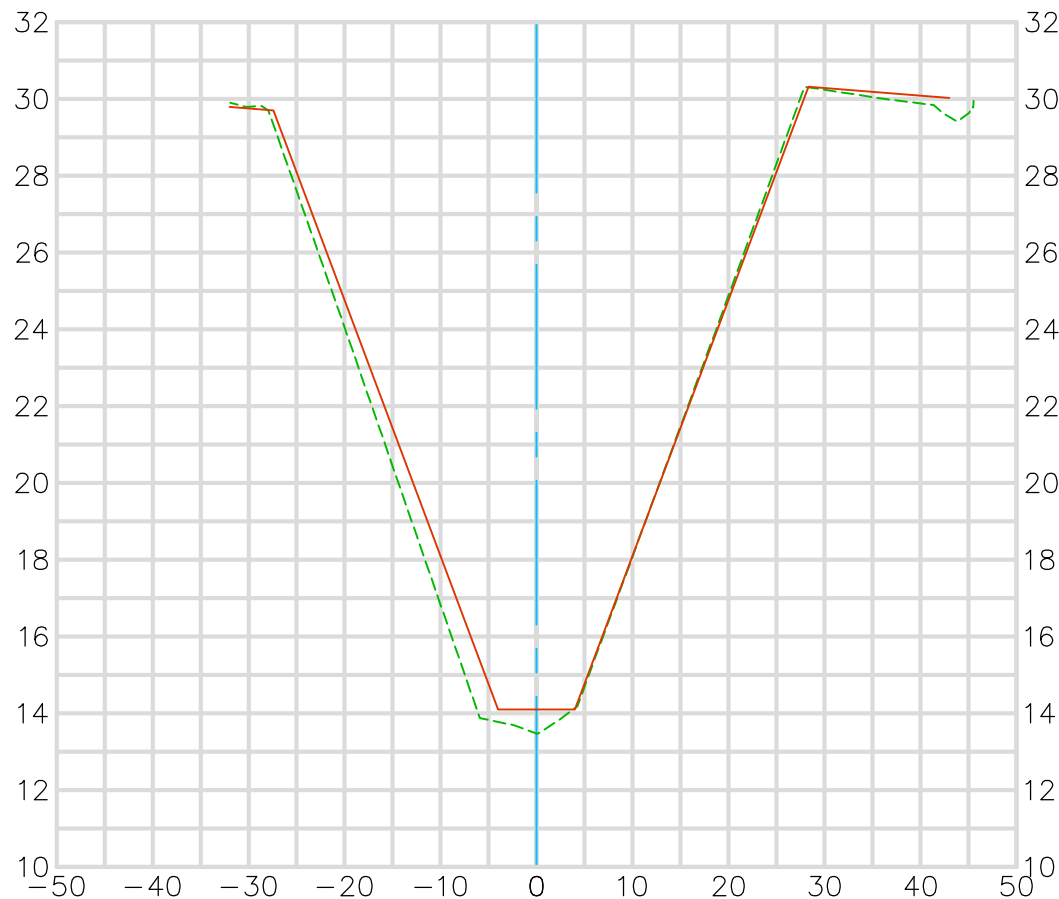


Existing Condition 2018
Record Plan 1960-1966
C06-101-2-A 1960, C06-101-4-A 1963, C06-103-1-M1966
Modified Per Engineer's Directive
Prepared 8/21/19

Horizontal Scale 1" = 20'
Vertical Scale 1" = 5'

OCEAN VIEW CHANNEL (C06)


50+00.00

CL CONSTRUCTION

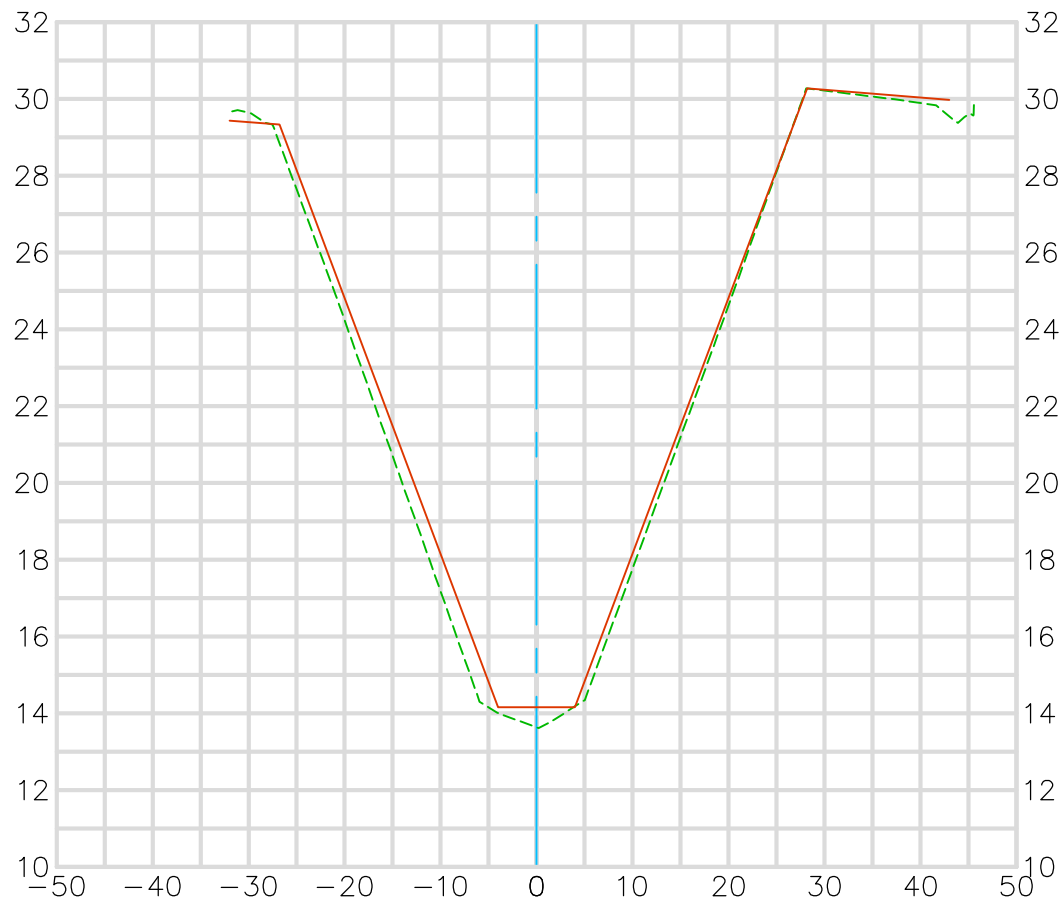

Existing Condition 2018
 Record Plan 1960-1966
 C06-101-2-A 1960, C06-101-4-A 1963, C06-103-1-M1966
 Modified Per Engineer's Directive
 Prepared 8/21/19


Horizontal Scale 1" = 20'
 Vertical Scale 1" = 5'

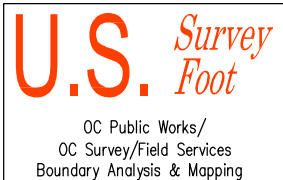

OCEAN VIEW CHANNEL (C06)

50+50.00

CL CONSTRUCTION

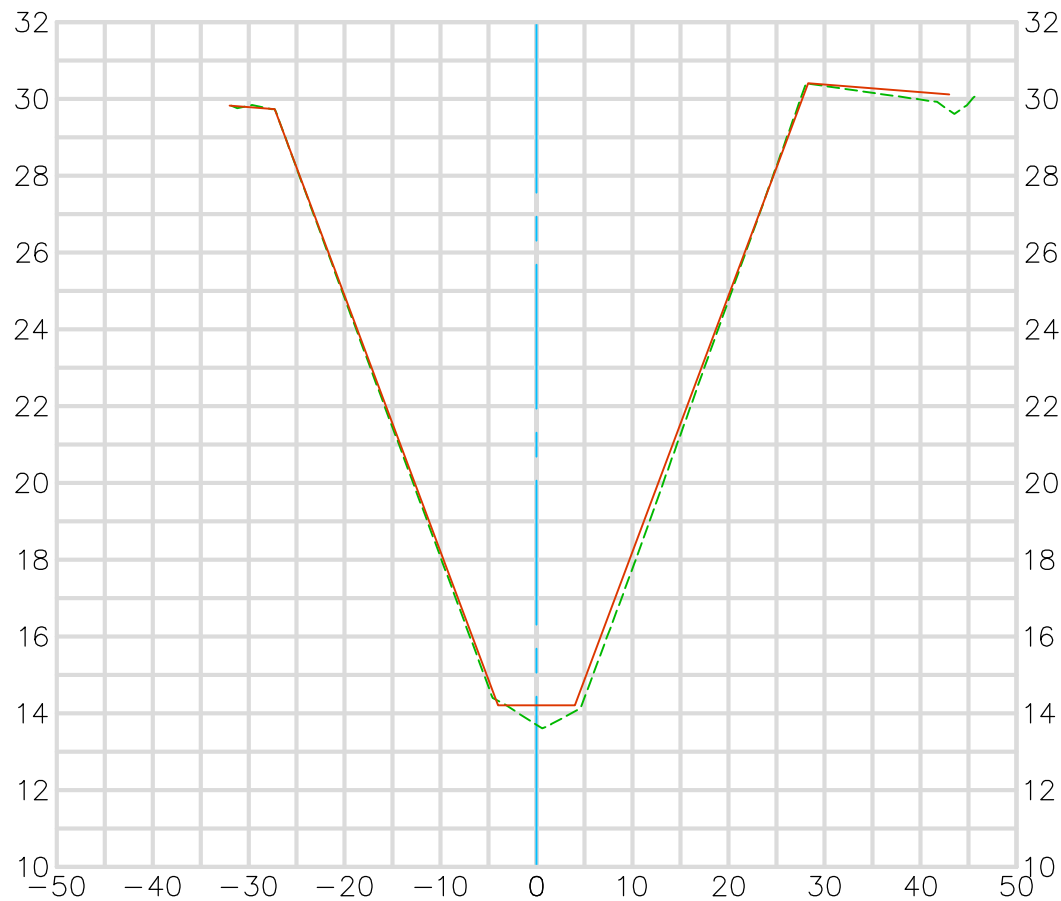


Existing Condition 2018
Record Plan 1960-1966
C06-101-2-A 1960, C06-101-4-A 1963, C06-103-1-M1966
Modified Per Engineer's Directive
Prepared 8/21/19

Horizontal Scale 1" = 20'
Vertical Scale 1" = 5'

OCEAN VIEW CHANNEL (C06)

51+00.00

CL CONSTRUCTION

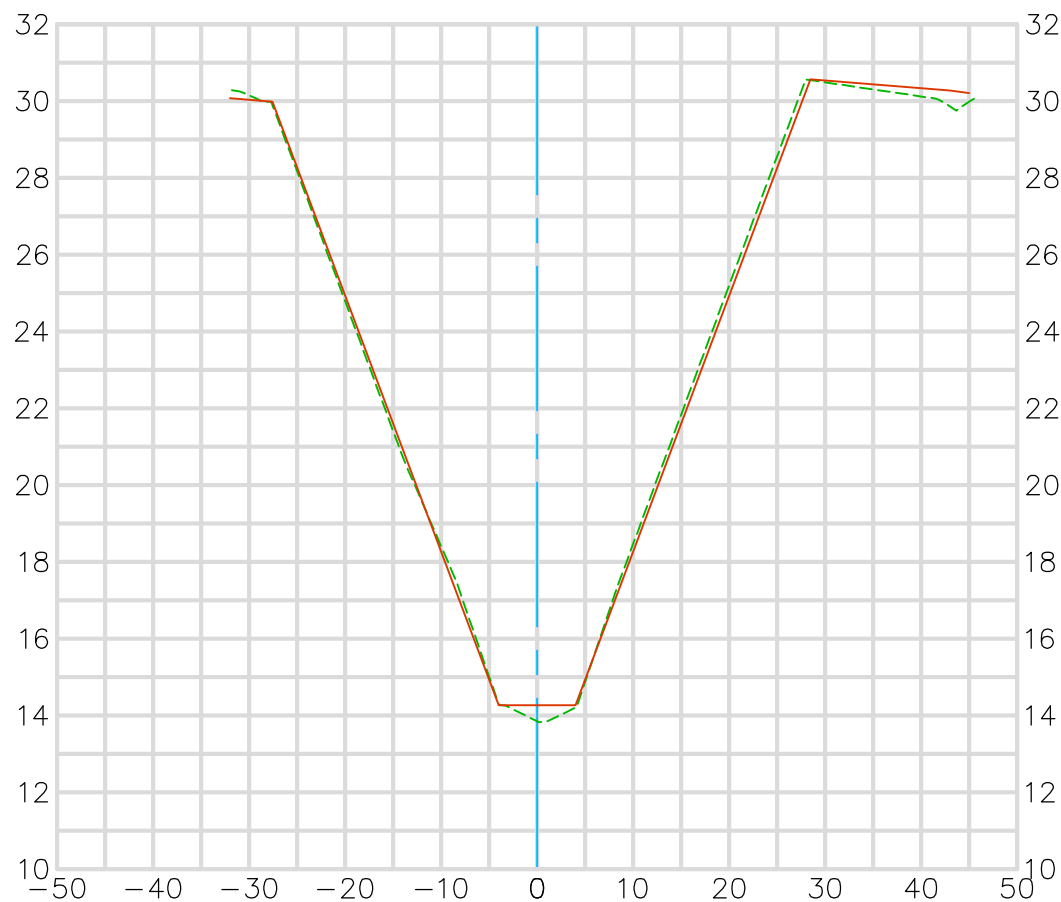


Existing Condition 2018
 Record Plan 1960-1966
 C06-101-2-A 1960, C06-101-4-A 1963, C06-103-1-M1966
 Modified Per Engineer's Directive
 Prepared 8/21/19

Horizontal Scale 1" = 20'
 Vertical Scale 1" = 5'

OCEAN VIEW CHANNEL (C06)

51+50.00

CL CONSTRUCTION

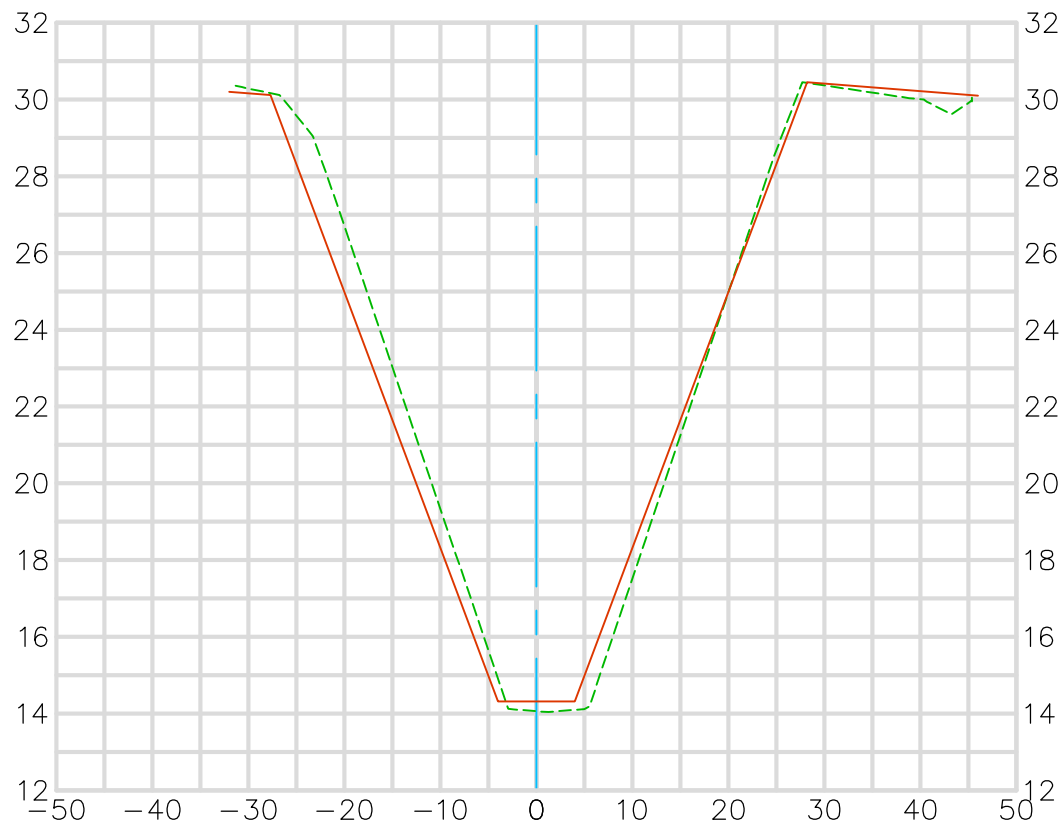


Existing Condition 2018
 Record Plan 1960-1966
 C06-101-2-A 1960, C06-101-4-A 1963, C06-103-1-M1966
 Modified Per Engineer's Directive
 Prepared 8/21/19

Horizontal Scale 1" = 20'
 Vertical Scale 1" = 5'

OCEAN VIEW CHANNEL (C06)

52+00.00

CL CONSTRUCTION

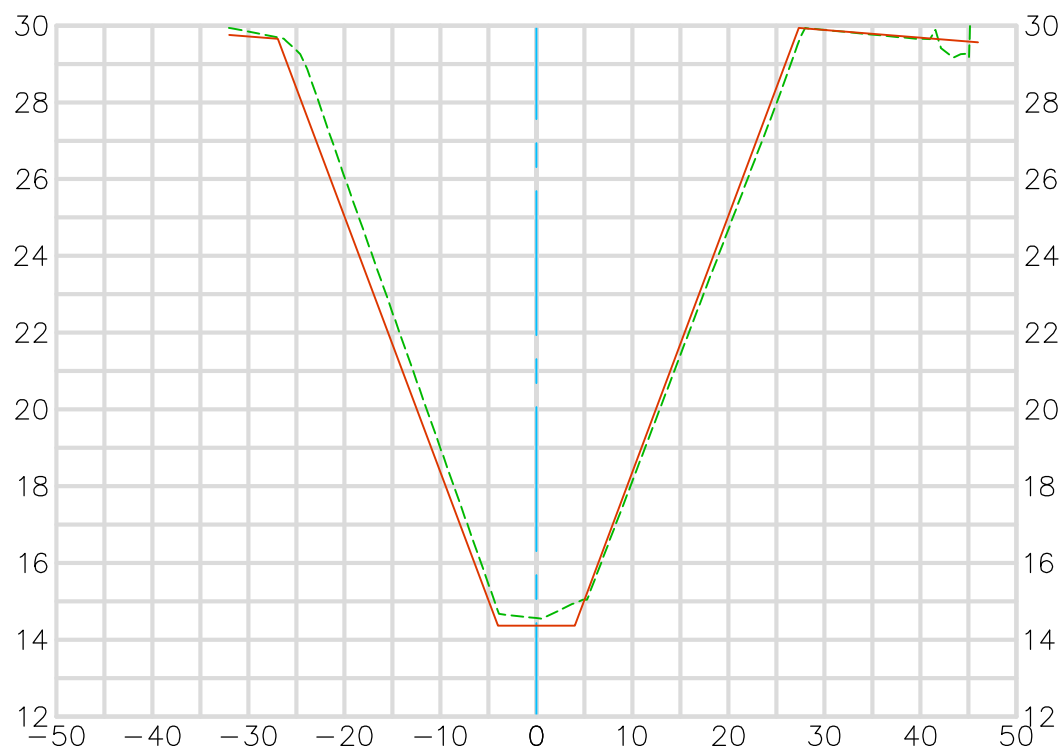


Existing Condition 2018
 Record Plan 1960-1966
 C06-101-2-A 1960, C06-101-4-A 1963, C06-103-1-M1966
 Modified Per Engineer's Directive
 Prepared 8/21/19

Horizontal Scale 1" = 20'
 Vertical Scale 1" = 5'

OCEAN VIEW CHANNEL (C06)

52+24.14

CL CONSTRUCTION

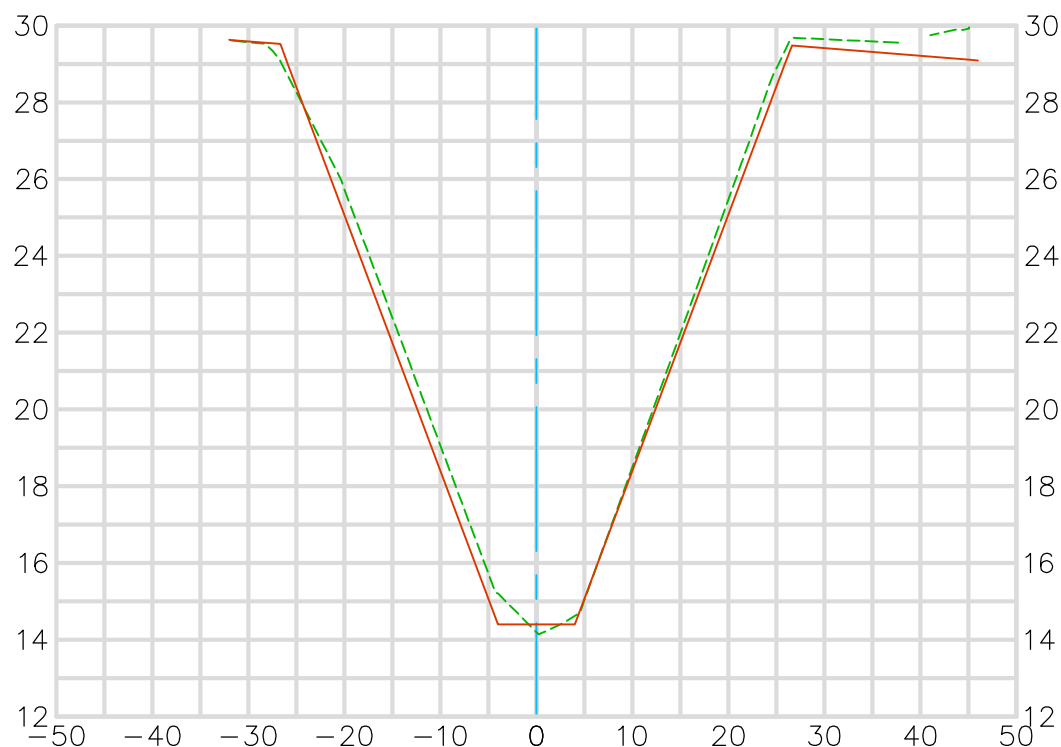


Existing Condition 2018
 Record Plan 1960-1966
 C06-101-2-A 1960, C06-101-4-A 1963, C06-103-1-M1966
 Modified Per Engineer's Directive
 Prepared 8/21/19

Horizontal Scale 1" = 20'
 Vertical Scale 1" = 5'

OCEAN VIEW CHANNEL (C06)

53+30.94

CL CONSTRUCTION

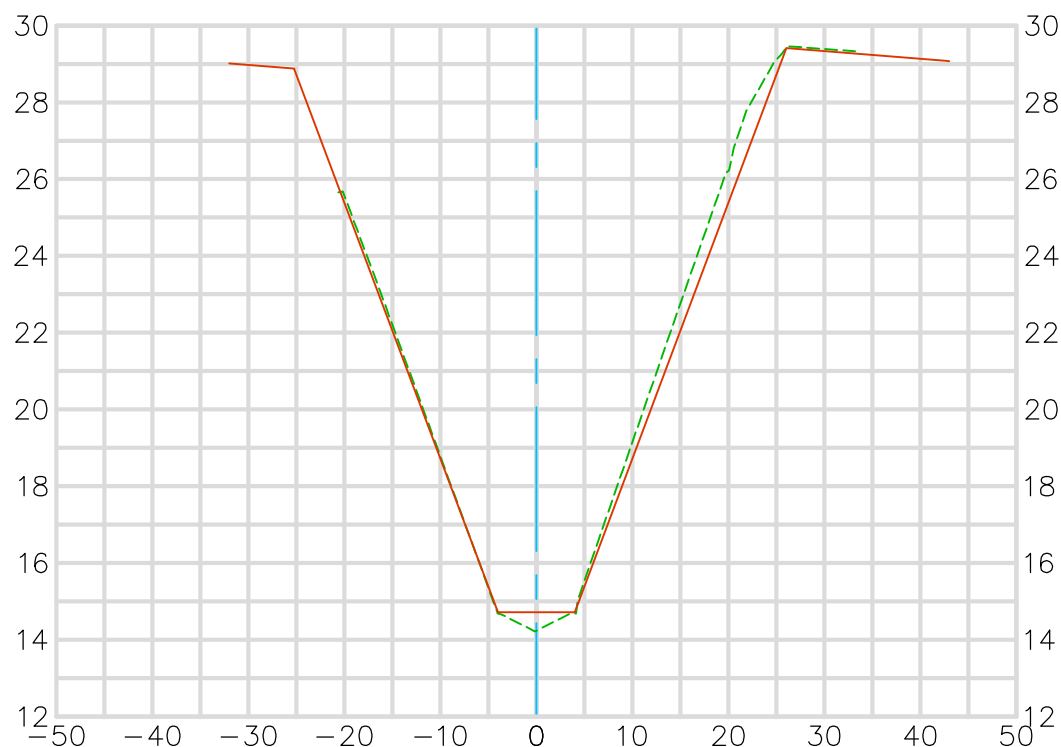


Existing Condition 2018
Record Plan 1960-1966
C06-101-2-A 1960, C06-101-4-A 1963, C06-103-1-M1966
Modified Per Engineer's Directive
Prepared 8/21/19

Horizontal Scale 1" = 20'
Vertical Scale 1" = 5'

OCEAN VIEW CHANNEL (C06)

53+50.00

CL CONSTRUCTION

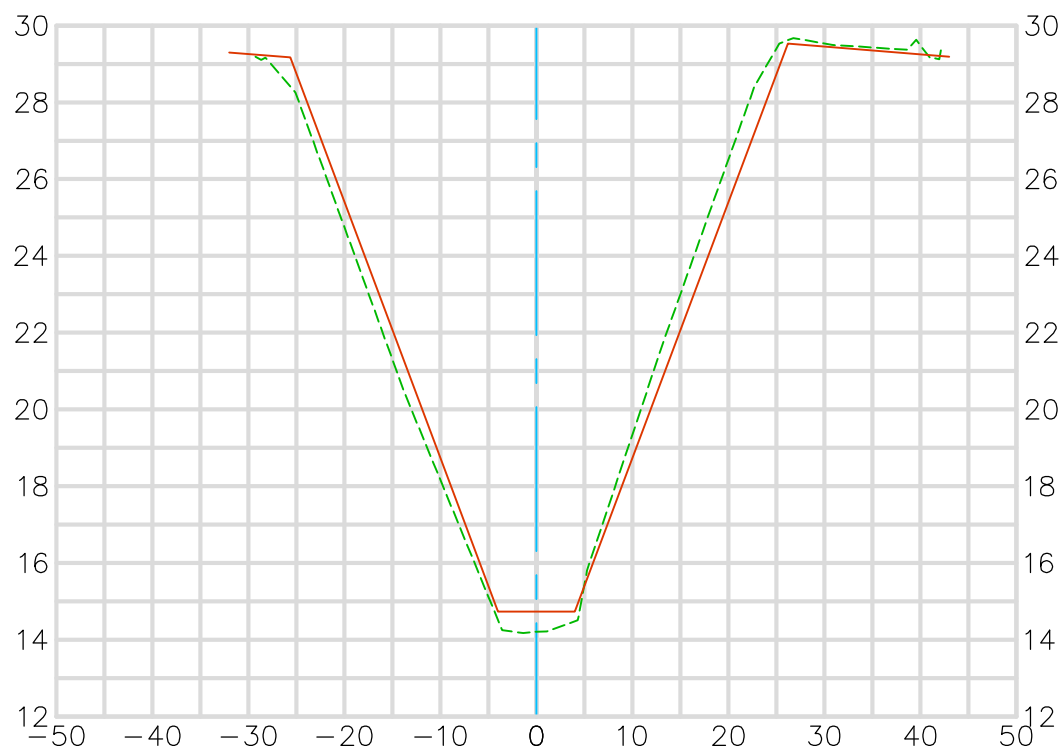

Existing Condition 2018
 Record Plan 1960-1966
 C06-101-2-A 1960, C06-101-4-A 1963, C06-103-1-M1966
 Modified Per Engineer's Directive
 Prepared 8/21/19

Horizontal Scale 1" = 20'
 Vertical Scale 1" = 5'


**U.S. Survey
Foot**

OC Public Works/
OC Survey/Field Services
Boundary Analysis & Mapping

OCEAN VIEW CHANNEL (C06)

54+00.00

CL CONSTRUCTION

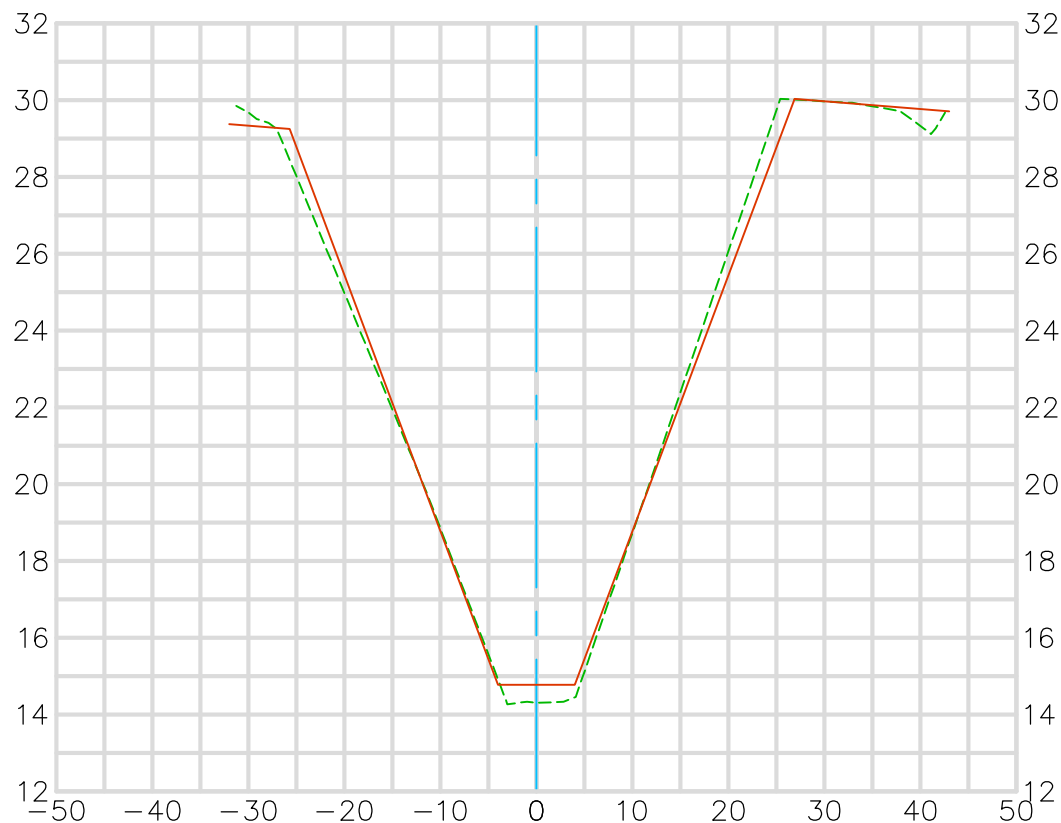

Existing Condition 2018
Record Plan 1960-1966
C06-101-2-A 1960, C06-101-4-A 1963, C06-103-1-M1966
Modified Per Engineer's Directive
Prepared 8/21/19

Horizontal Scale 1" = 20'
Vertical Scale 1" = 5'


**U.S. Survey
Foot**

OC Public Works/
OC Survey/Field Services
Boundary Analysis & Mapping

OCEAN VIEW CHANNEL (C06)

54+50.00

CL CONSTRUCTION

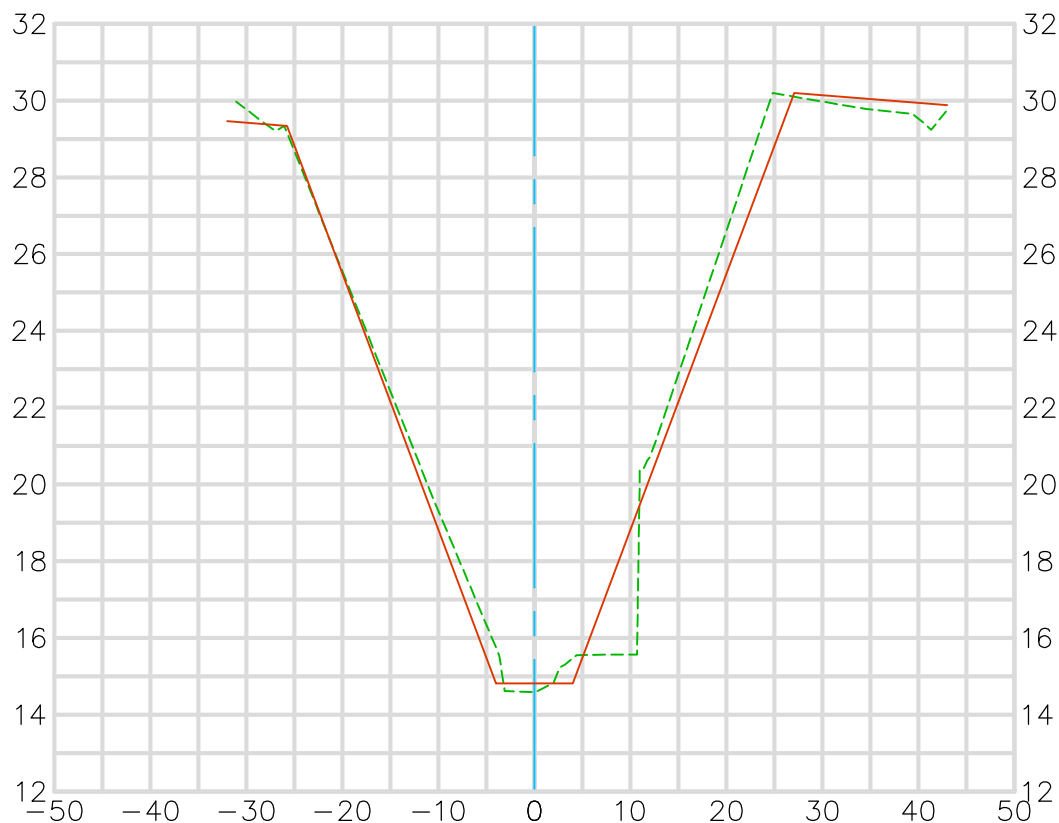


Existing Condition 2018
Record Plan 1960-1966
C06-101-2-A 1960, C06-101-4-A 1963, C06-103-1-M1966
Modified Per Engineer's Directive
Prepared 8/21/19

Horizontal Scale 1" = 20'
Vertical Scale 1" = 5'

OCEAN VIEW CHANNEL (C06)

55+00.00

CL CONSTRUCTION

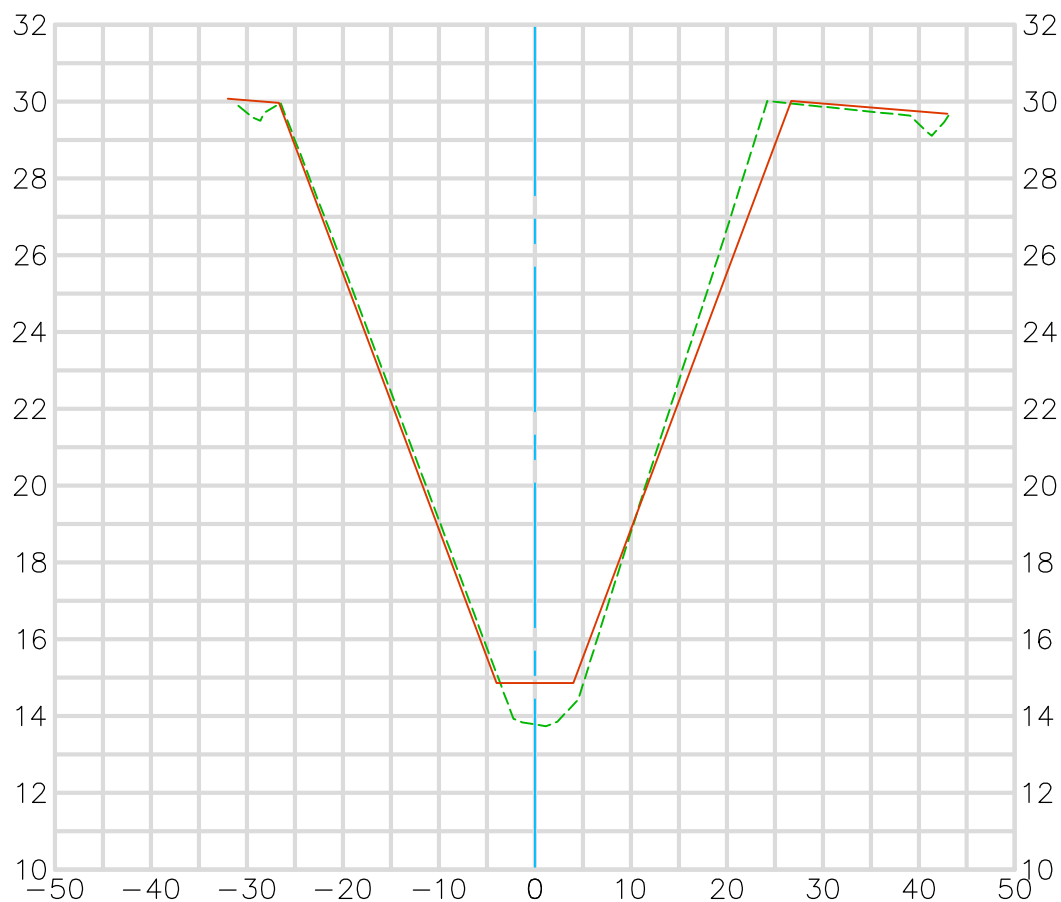

Existing Condition 2018
 Record Plan 1960-1966
 C06-101-2-A 1960, C06-101-4-A 1963, C06-103-1-M1966
 Modified Per Engineer's Directive
 Prepared 8/21/19

Horizontal Scale 1" = 20'
 Vertical Scale 1" = 5'

OCEAN VIEW CHANNEL (C06)

55+50.00

CL CONSTRUCTION




Existing Condition 2018
 Record Plan 1960-1966
 C06-101-2-A 1960, C06-101-4-A 1963, C06-103-1-M1966
 Modified Per Engineer's Directive
 Prepared 8/21/19

Horizontal Scale 1" = 20'
 Vertical Scale 1" = 5'

OCEAN VIEW CHANNEL (C06)

56+00.00

CL CONSTRUCTION

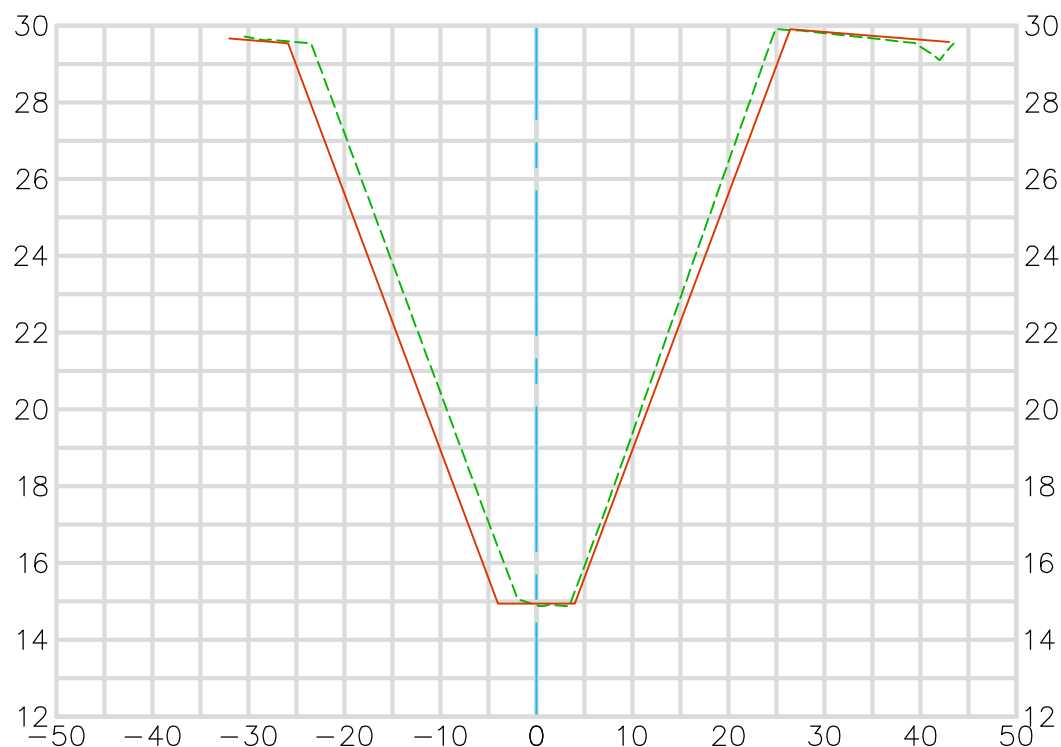

Existing Condition 2018
 Record Plan 1960-1966
 C06-101-2-A 1960, C06-101-4-A 1963, C06-103-1-M1966
 Modified Per Engineer's Directive
 Prepared 8/21/19

Horizontal Scale 1" = 20'
 Vertical Scale 1" = 5'

OCEAN VIEW CHANNEL (C06)

56+50.00

CL CONSTRUCTION



Existing Condition 2018
 Record Plan 1960-1966
 C06-101-2-A 1960, C06-101-4-A 1963, C06-103-1-M1966
 Modified Per Engineer's Directive
 Prepared 8/21/19

Horizontal Scale 1" = 20'
 Vertical Scale 1" = 5'

OCEAN VIEW CHANNEL (C06)

57+00.00

CL CONSTRUCTION




Existing Condition 2018
 Record Plan 1960-1966
 C06-101-2-A 1960, C06-101-4-A 1963, C06-103-1-M1966
 Modified Per Engineer's Directive
 Prepared 8/21/19

Horizontal Scale 1" = 20'
 Vertical Scale 1" = 5'

OCEAN VIEW CHANNEL (C06)

57+50.00

CL CONSTRUCTION

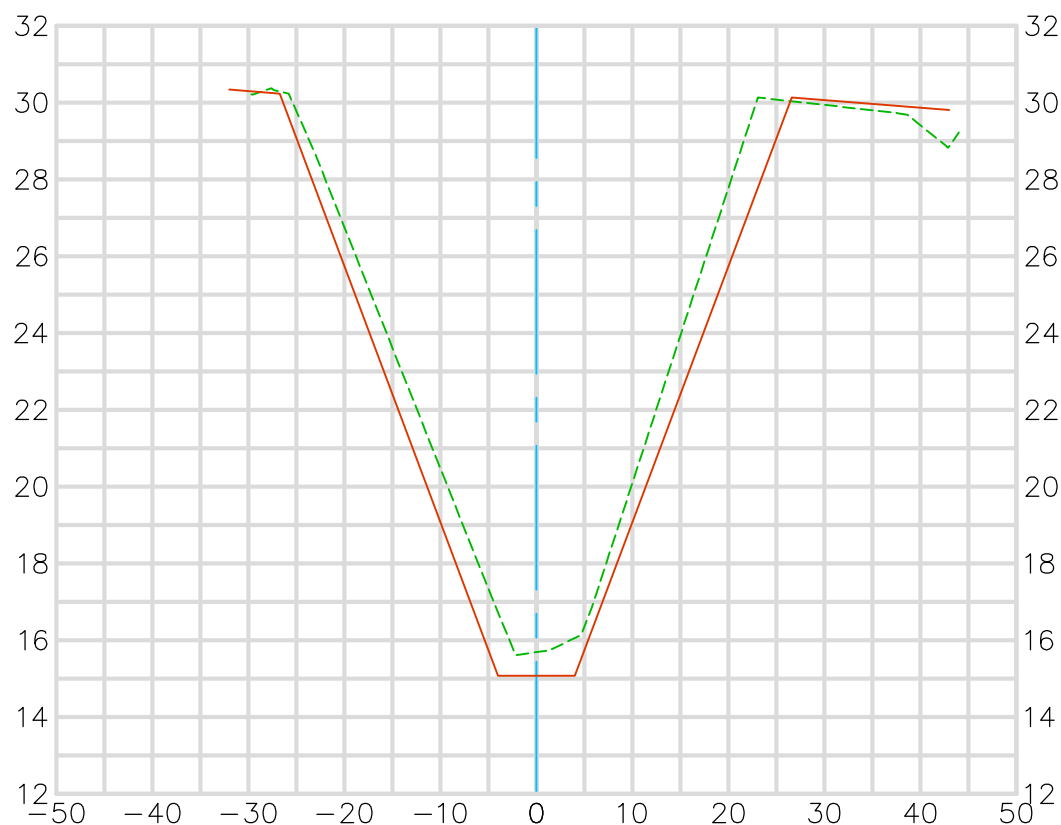


Existing Condition 2018
 Record Plan 1960-1966
 C06-101-2-A 1960, C06-101-4-A 1963, C06-103-1-M1966
 Modified Per Engineer's Directive
 Prepared 8/21/19

Horizontal Scale 1" = 20'
 Vertical Scale 1" = 5'

OCEAN VIEW CHANNEL (C06)

58+00.00

CL CONSTRUCTION

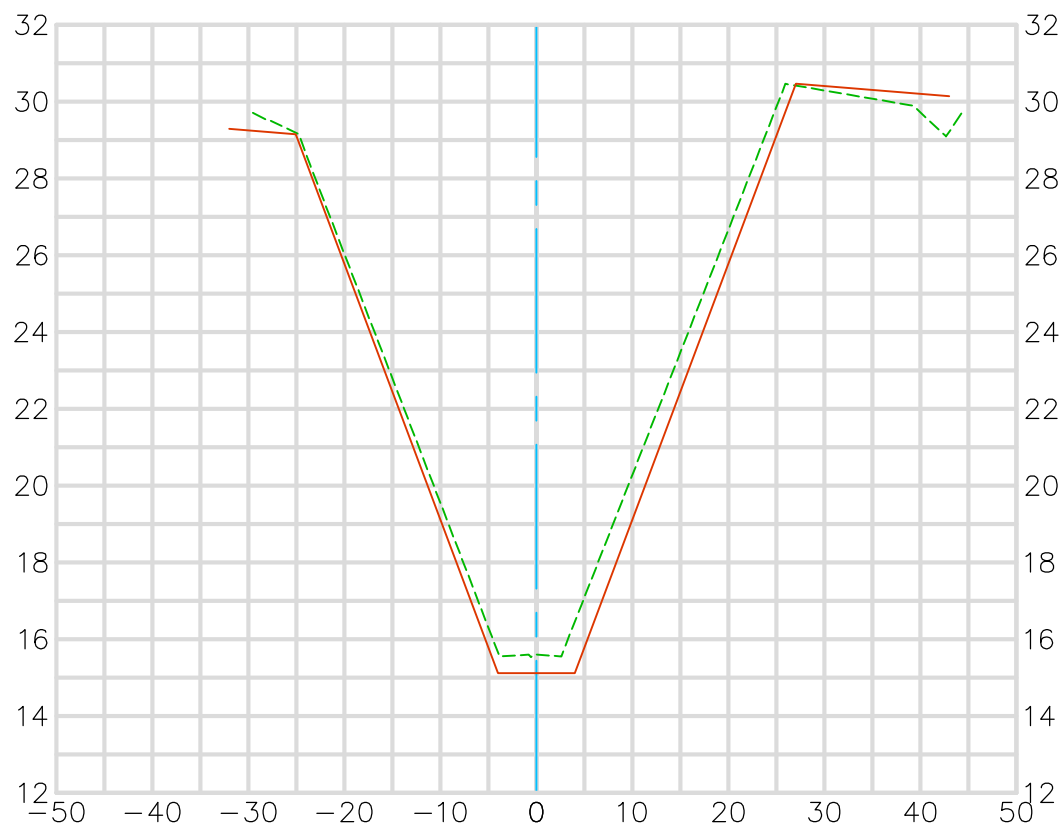


Existing Condition 2018
 Record Plan 1960-1966
 C06-101-2-A 1960, C06-101-4-A 1963, C06-103-1-M1966
 Modified Per Engineer's Directive
 Prepared 8/21/19

Horizontal Scale 1" = 20'
 Vertical Scale 1" = 5'

OCEAN VIEW CHANNEL (C06)

58+50.00

CL CONSTRUCTION

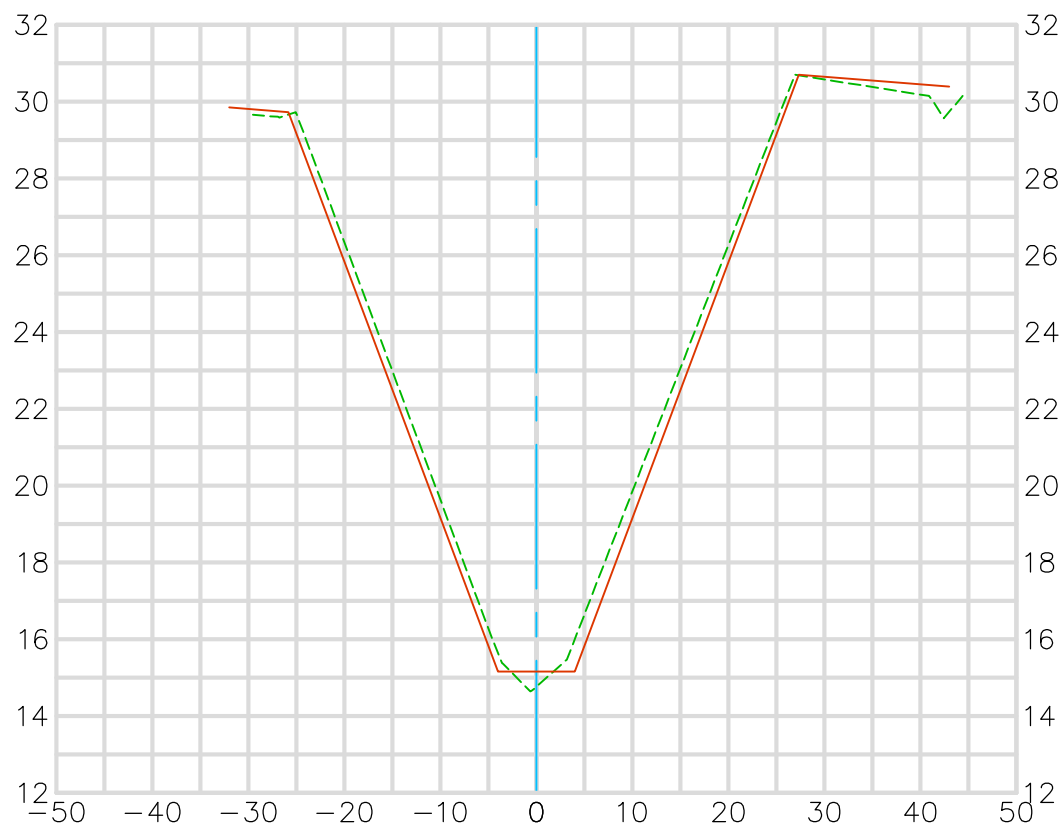


Existing Condition 2018
 Record Plan 1960-1966
 C06-101-2-A 1960, C06-101-4-A 1963, C06-103-1-M1966
 Modified Per Engineer's Directive
 Prepared 8/21/19

Horizontal Scale 1" = 20'
 Vertical Scale 1" = 5'

OCEAN VIEW CHANNEL (C06)

59+00.00

CL CONSTRUCTION

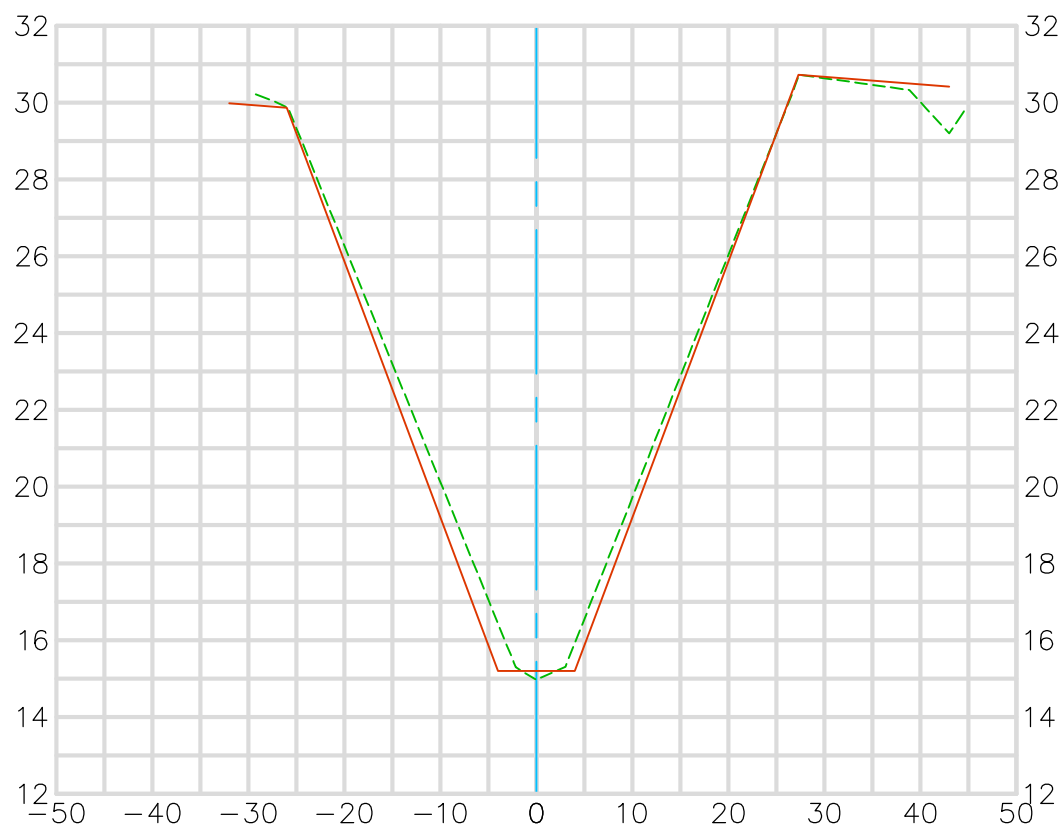

Existing Condition 2018
Record Plan 1960-1966
C06-101-2-A 1960, C06-101-4-A 1963, C06-103-1-M1966
Modified Per Engineer's Directive
Prepared 8/21/19

Horizontal Scale 1" = 20'
Vertical Scale 1" = 5'

OCEAN VIEW CHANNEL (C06)

59+50.00

CL CONSTRUCTION




Existing Condition 2018
 Record Plan 1960-1966
 C06-101-2-A 1960, C06-101-4-A 1963, C06-103-1-M1966
 Modified Per Engineer's Directive
 Prepared 8/21/19

Horizontal Scale 1" = 20'
 Vertical Scale 1" = 5'

OCEAN VIEW CHANNEL (C06)

60+00.00

CL CONSTRUCTION

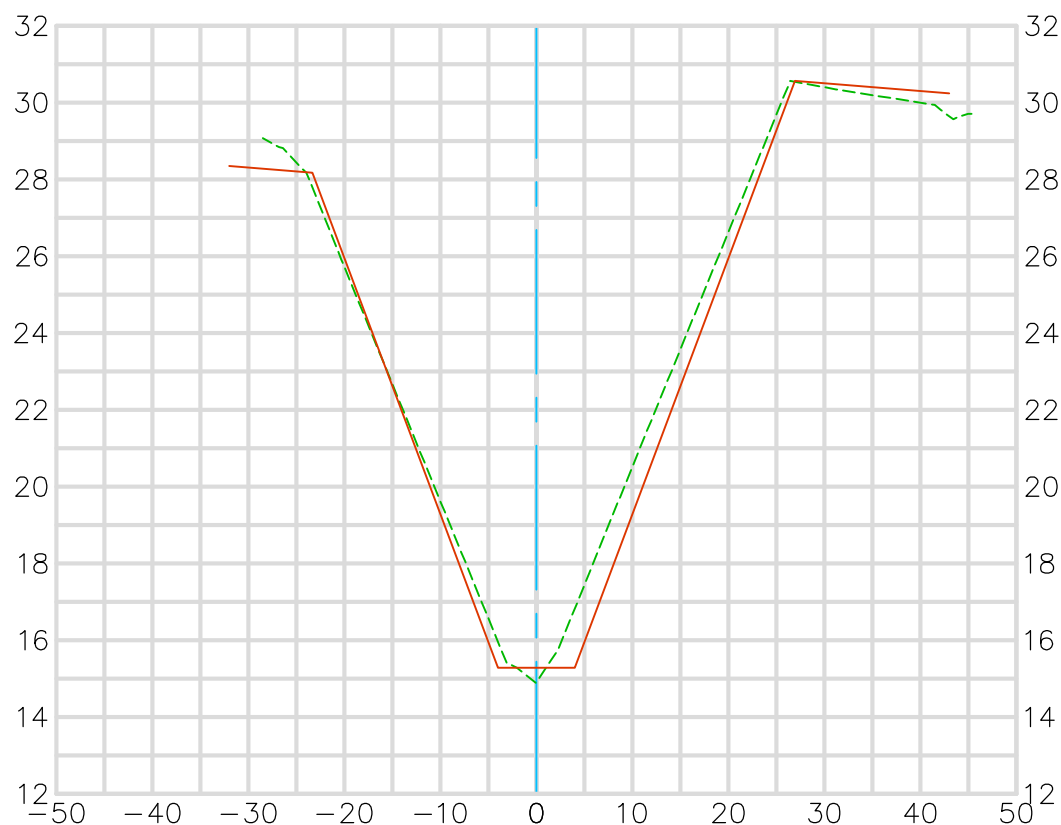


Existing Condition 2018
 Record Plan 1960-1966
 C06-101-2-A 1960, C06-101-4-A 1963, C06-103-1-M1966
 Modified Per Engineer's Directive
 Prepared 8/21/19

Horizontal Scale 1" = 20'
 Vertical Scale 1" = 5'

OCEAN VIEW CHANNEL (C06)

60+50.00

CL CONSTRUCTION

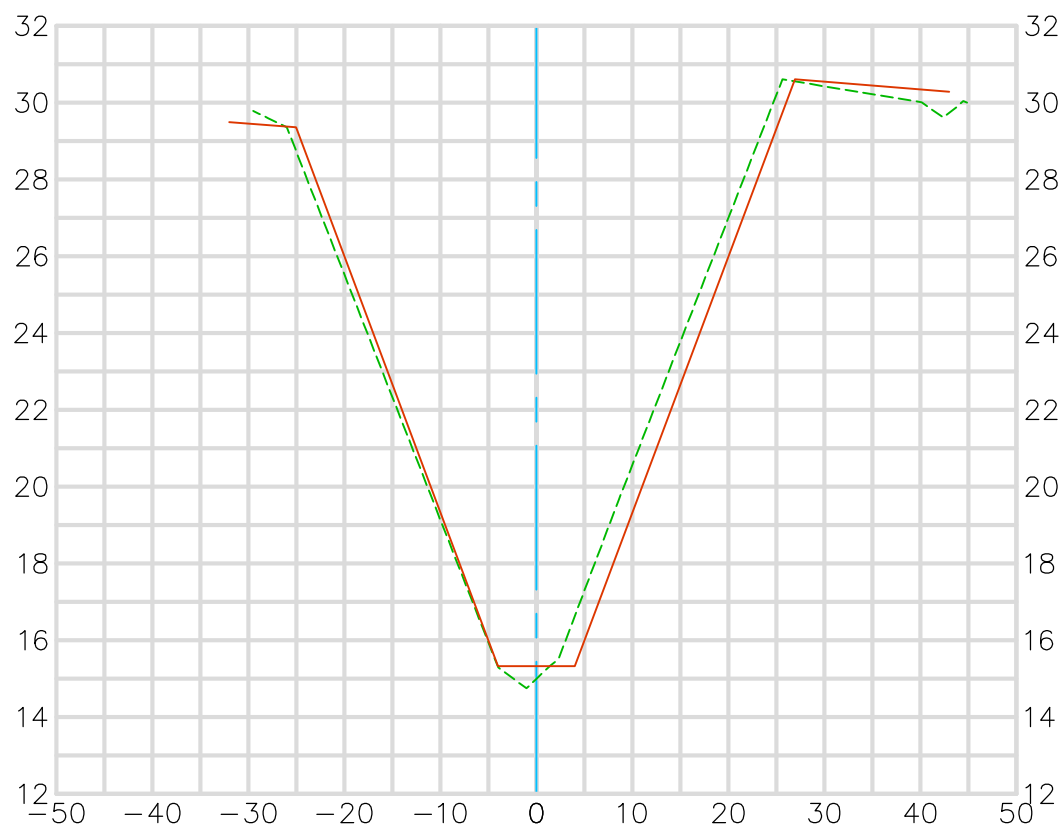


Existing Condition 2018
 Record Plan 1960-1966
 C06-101-2-A 1960, C06-101-4-A 1963, C06-103-1-M1966
 Modified Per Engineer's Directive
 Prepared 8/21/19

Horizontal Scale 1" = 20'
 Vertical Scale 1" = 5'

OCEAN VIEW CHANNEL (C06)


61+00.00

CL CONSTRUCTION

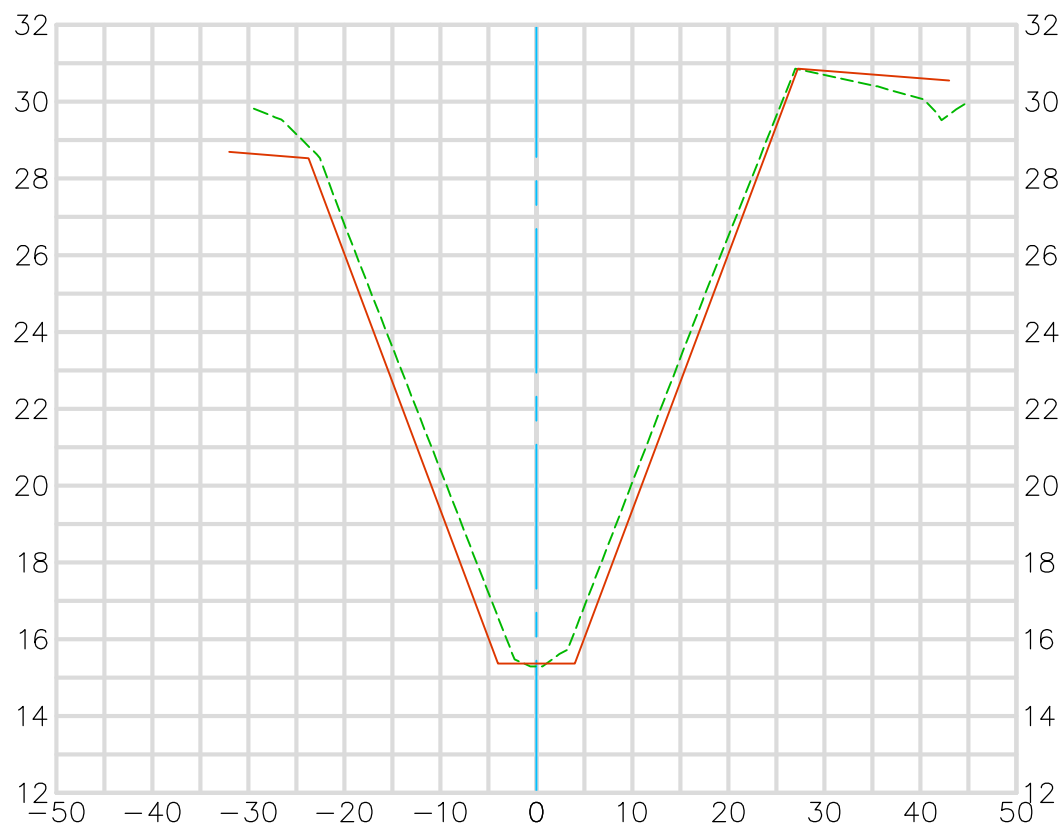

Existing Condition 2018
 Record Plan 1960-1966
 C06-101-2-A 1960, C06-101-4-A 1963, C06-103-1-M1966
 Modified Per Engineer's Directive
 Prepared 8/21/19


Horizontal Scale 1" = 20'
 Vertical Scale 1" = 5'

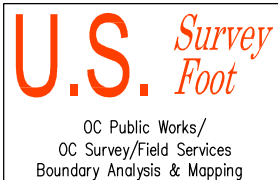

OCEAN VIEW CHANNEL (C06)

61+50.00


CL CONSTRUCTION

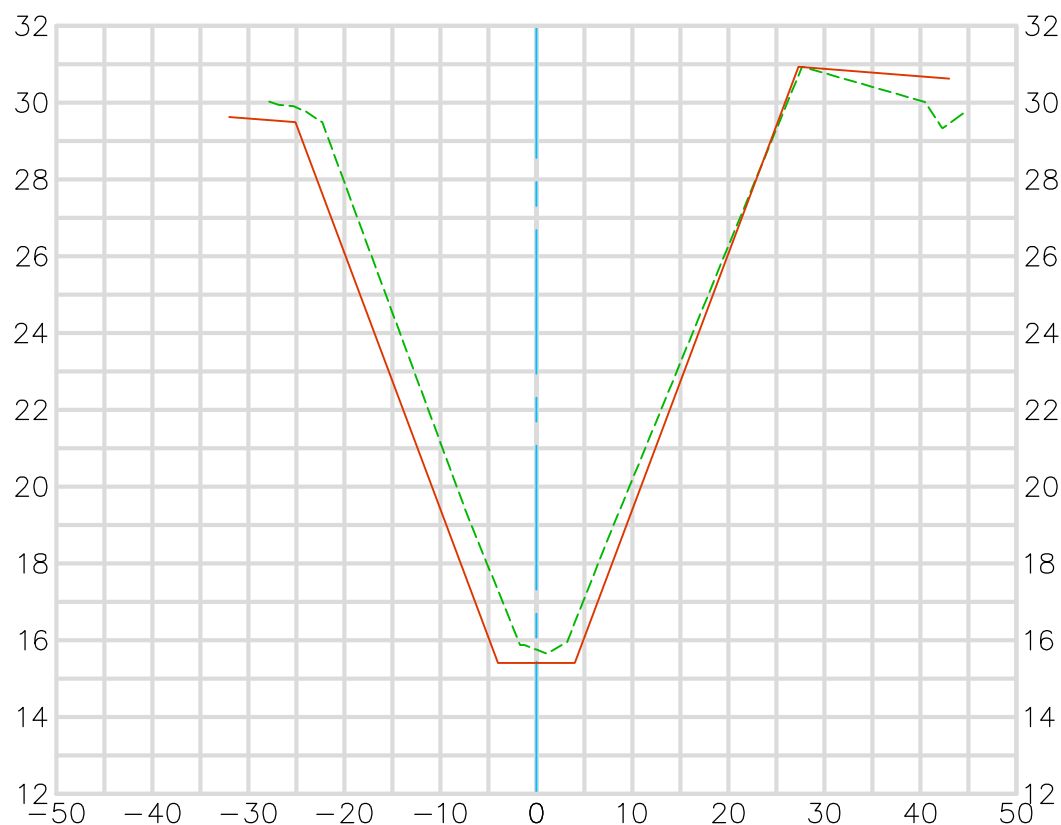

Existing Condition 2018
Record Plan 1960-1966
C06-101-2-A 1960, C06-101-4-A 1963, C06-103-1-M1966
Modified Per Engineer's Directive
Prepared 8/21/19

Horizontal Scale 1" = 20'
Vertical Scale 1" = 5'

OCEAN VIEW CHANNEL (C06) 62+00.00 CL CONSTRUCTION

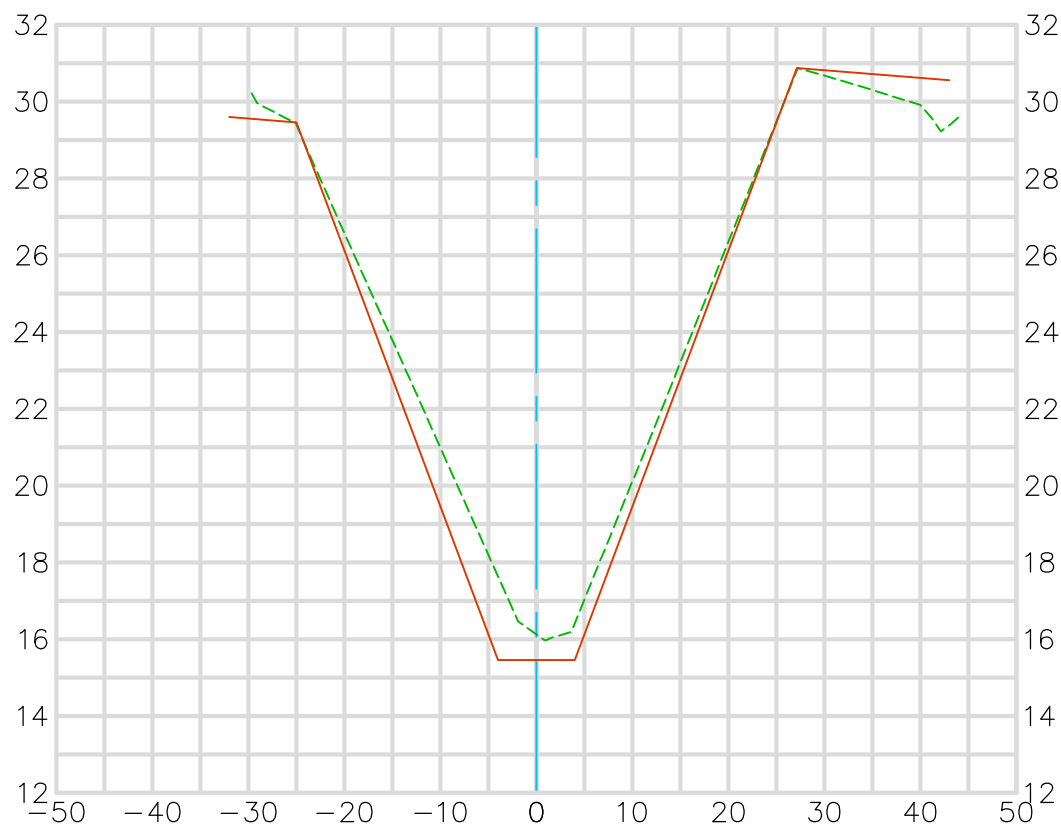


Existing Condition 2018
Record Plan 1960-1966
C06-101-2-A 1960, C06-101-4-A 1963, C06-103-1-M1966
Modified Per Engineer's Directive
Prepared 8/21/19

Horizontal Scale 1" = 20'
Vertical Scale 1" = 5'

OCEAN VIEW CHANNEL (C06)

62+50.00

CL CONSTRUCTION

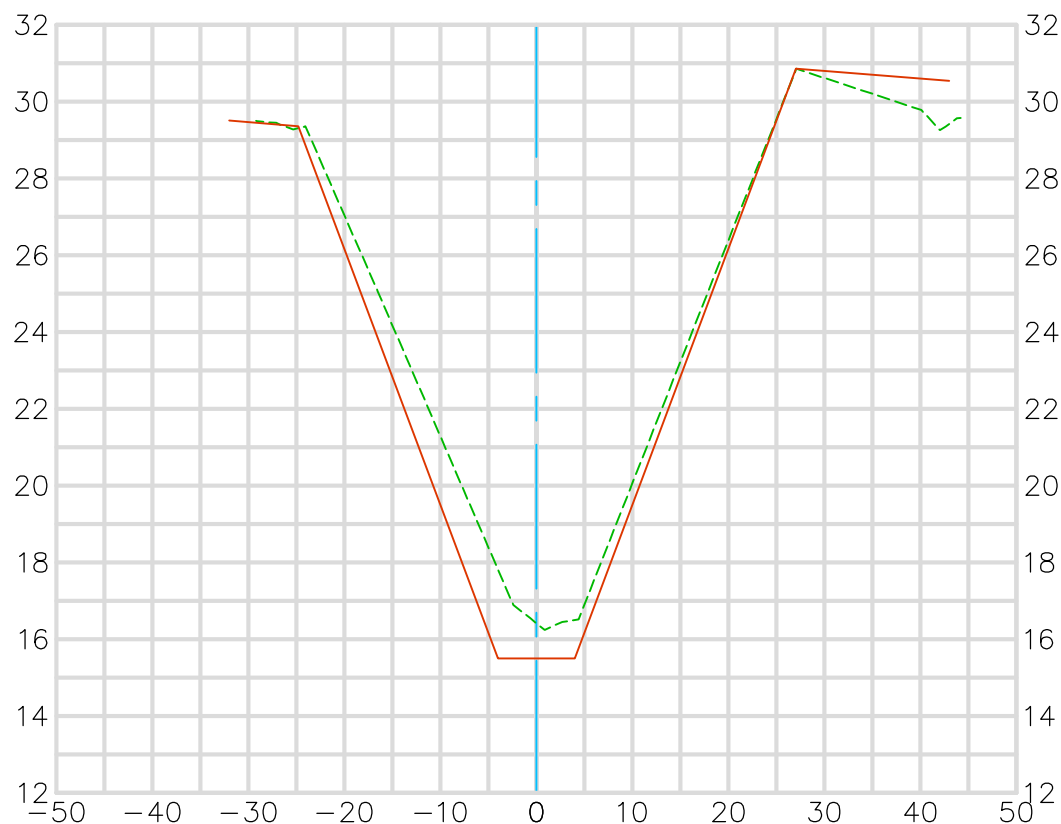


Existing Condition 2018
 Record Plan 1960-1966
 C06-101-2-A 1960, C06-101-4-A 1963, C06-103-1-M1966
 Modified Per Engineer's Directive
 Prepared 8/21/19

Horizontal Scale 1" = 20'
 Vertical Scale 1" = 5'

OCEAN VIEW CHANNEL (C06)

63+00.00

CL CONSTRUCTION

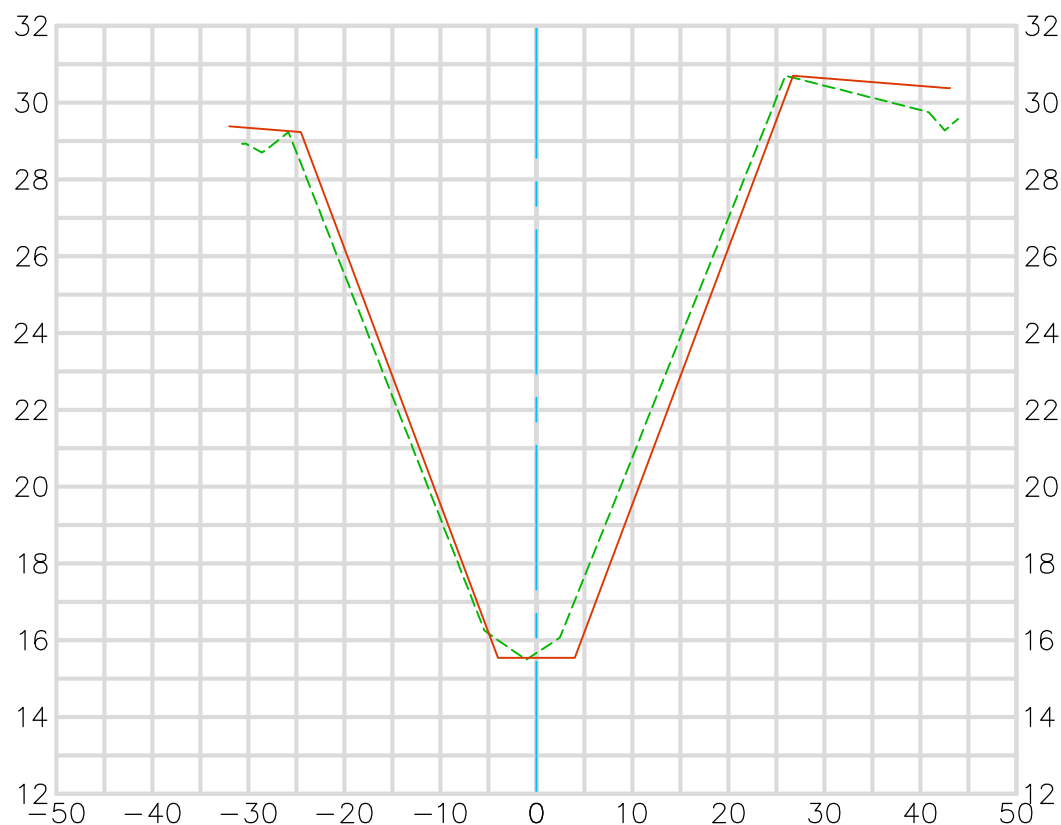


Existing Condition 2018
 Record Plan 1960-1966
 C06-101-2-A 1960, C06-101-4-A 1963, C06-103-1-M1966
 Modified Per Engineer's Directive
 Prepared 8/21/19

Horizontal Scale 1" = 20'
 Vertical Scale 1" = 5'

OCEAN VIEW CHANNEL (C06)

63+50.00

CL CONSTRUCTION

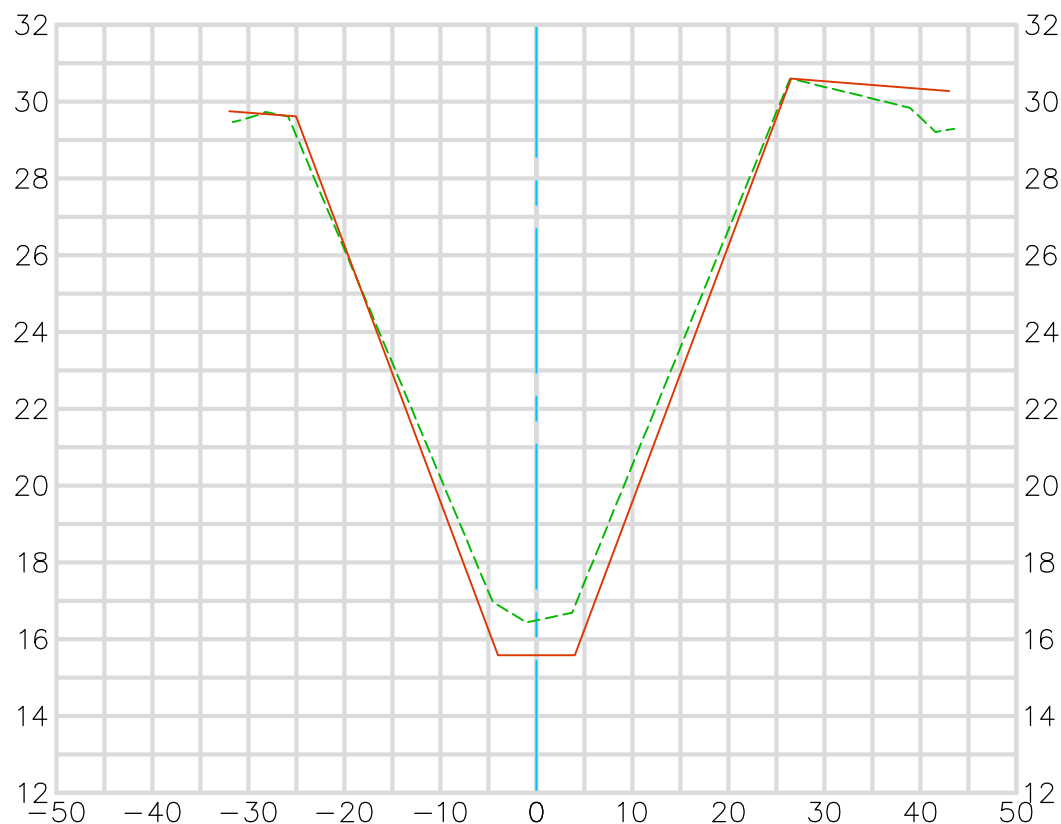


Existing Condition 2018
 Record Plan 1960-1966
 C06-101-2-A 1960, C06-101-4-A 1963, C06-103-1-M1966
 Modified Per Engineer's Directive
 Prepared 8/21/19

Horizontal Scale 1" = 20'
 Vertical Scale 1" = 5'

OCEAN VIEW CHANNEL (C06)

64+00.00

CL CONSTRUCTION

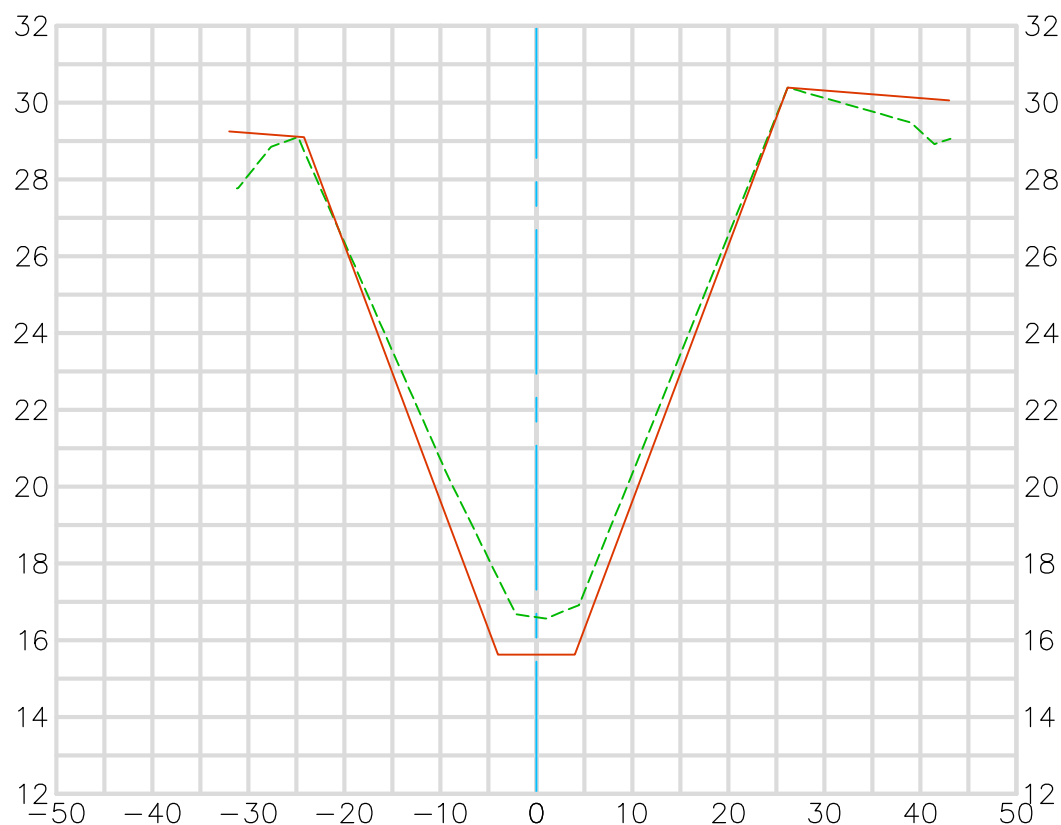


Existing Condition 2018
 Record Plan 1960-1966
 C06-101-2-A 1960, C06-101-4-A 1963, C06-103-1-M1966
 Modified Per Engineer's Directive
 Prepared 8/21/19

Horizontal Scale 1" = 20'
 Vertical Scale 1" = 5'

OCEAN VIEW CHANNEL (C06)

64+50.00

CL CONSTRUCTION

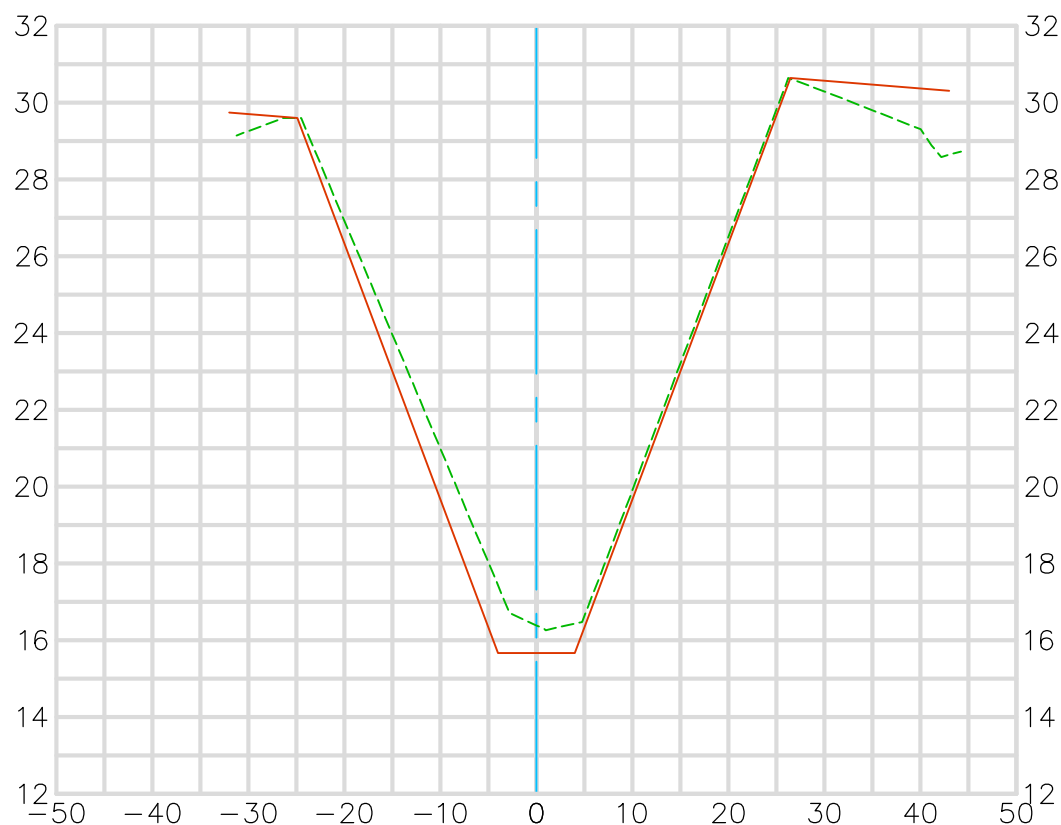


Existing Condition 2018
 Record Plan 1960-1966
 C06-101-2-A 1960, C06-101-4-A 1963, C06-103-1-M1966
 Modified Per Engineer's Directive
 Prepared 8/21/19

Horizontal Scale 1" = 20'
 Vertical Scale 1" = 5'

OCEAN VIEW CHANNEL (C06)


65+00.00

CL CONSTRUCTION

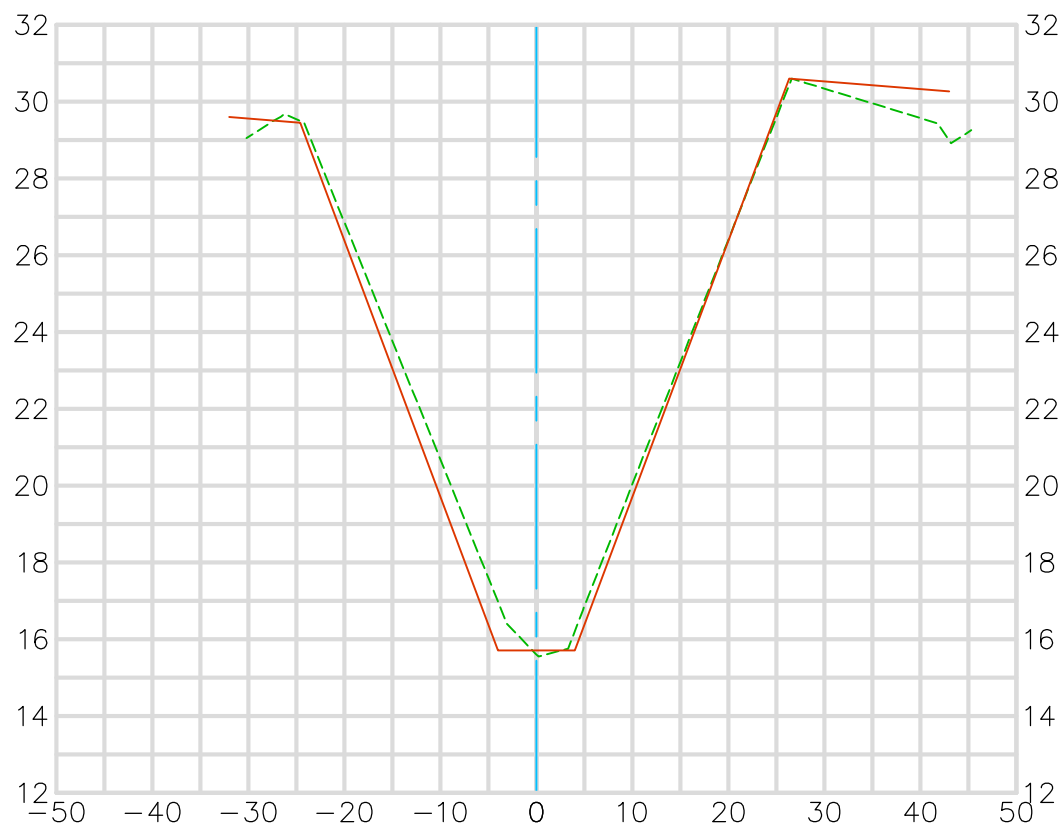

Existing Condition 2018
 Record Plan 1960-1966
 C06-101-2-A 1960, C06-101-4-A 1963, C06-103-1-M1966
 Modified Per Engineer's Directive
 Prepared 8/21/19

Horizontal Scale 1" = 20'
 Vertical Scale 1" = 5'

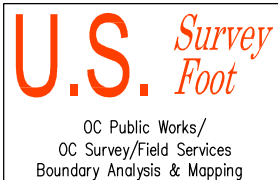

OCEAN VIEW CHANNEL (C06)

65+50.00

CL CONSTRUCTION




Existing Condition 2018
Record Plan 1960-1966
C06-101-2-A 1960, C06-101-4-A 1963, C06-103-1-M1966
Modified Per Engineer's Directive
Prepared 8/21/19

Horizontal Scale 1" = 20'
Vertical Scale 1" = 5'

OCEAN VIEW CHANNEL (C06)

66+00.00

CL CONSTRUCTION

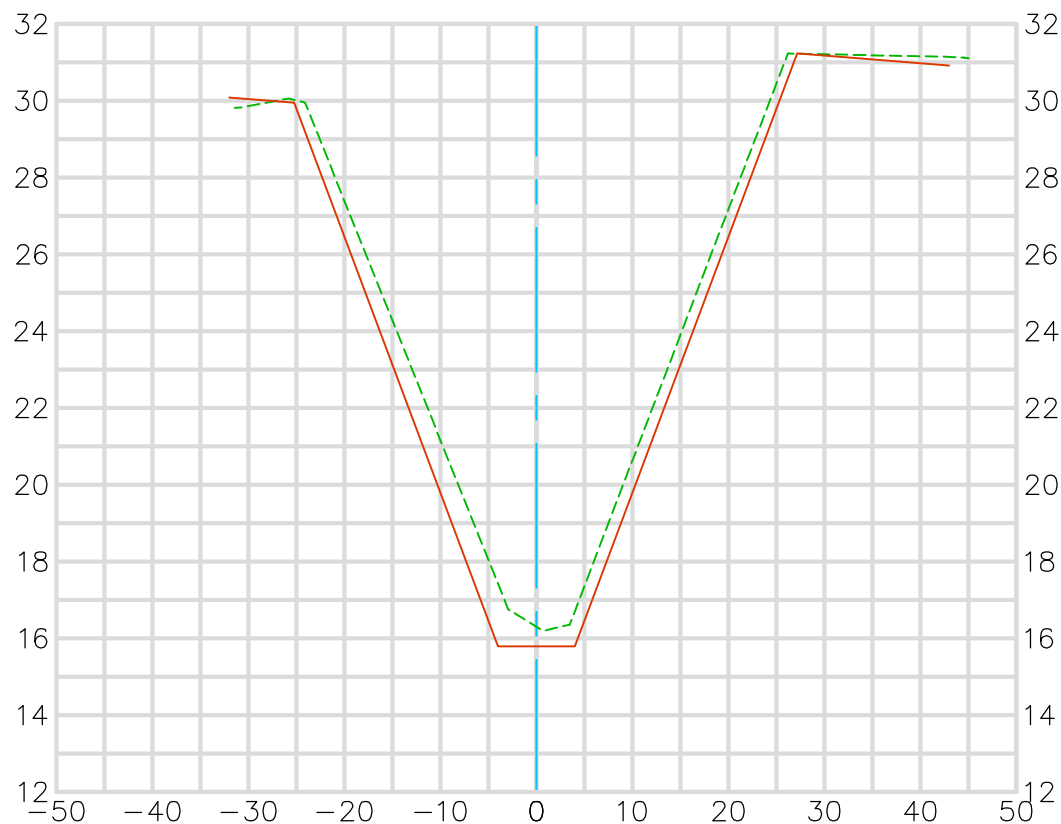


Existing Condition 2018
 Record Plan 1960-1966
 C06-101-2-A 1960, C06-101-4-A 1963, C06-103-1-M1966
 Modified Per Engineer's Directive
 Prepared 8/21/19

Horizontal Scale 1" = 20'
 Vertical Scale 1" = 5'

OCEAN VIEW CHANNEL (C06)

66+50.00

CL CONSTRUCTION

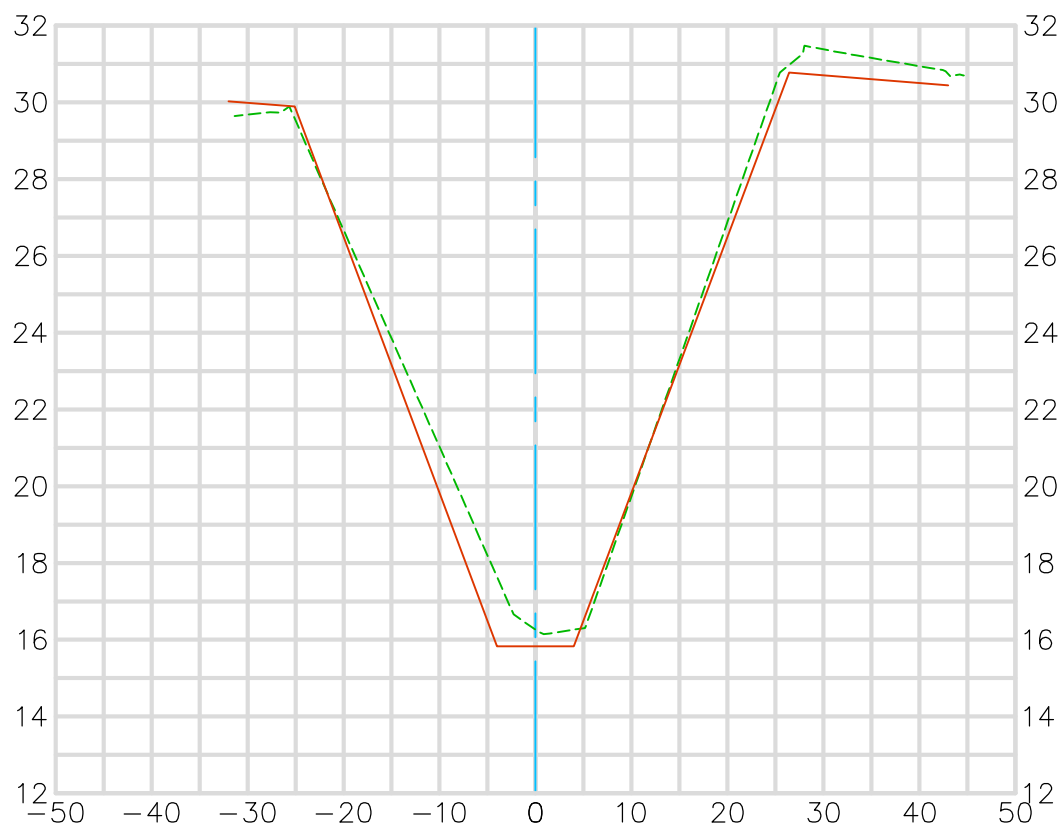


Existing Condition 2018
 Record Plan 1960-1966
 C06-101-2-A 1960, C06-101-4-A 1963, C06-103-1-M1966
 Modified Per Engineer's Directive
 Prepared 8/21/19

Horizontal Scale 1" = 20'
 Vertical Scale 1" = 5'

OCEAN VIEW CHANNEL (C06)

67+00.00

CL CONSTRUCTION

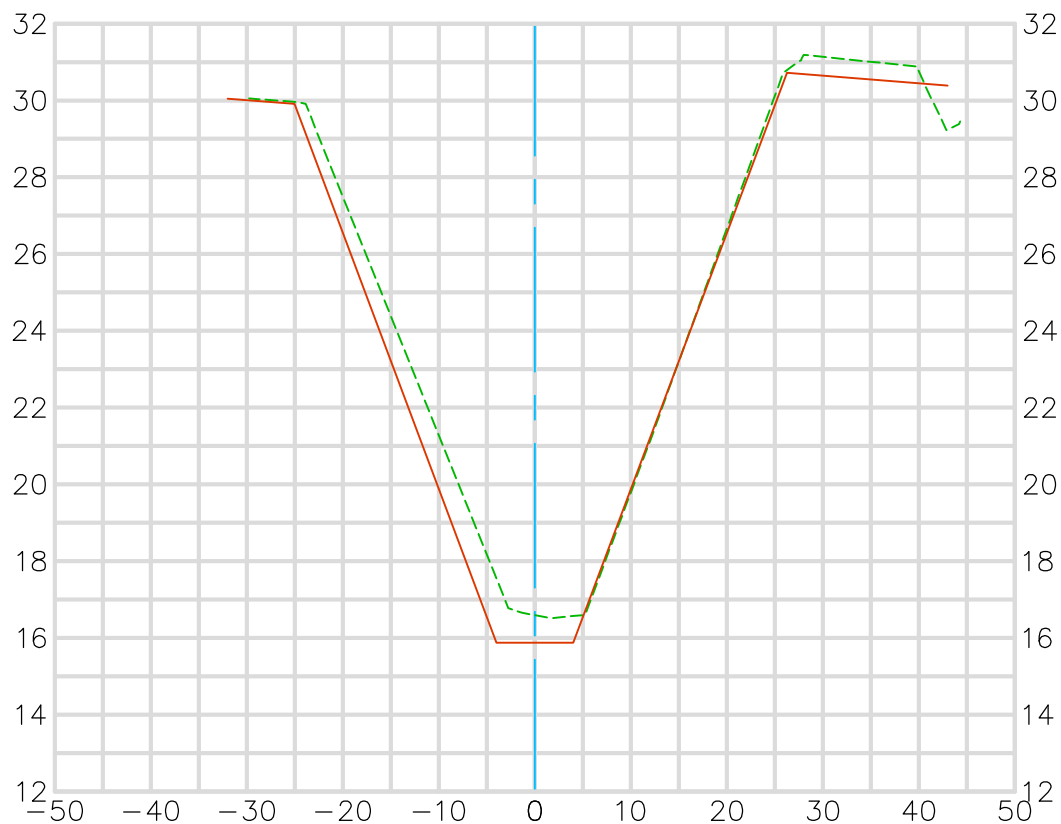


Existing Condition 2018
 Record Plan 1960-1966
 C06-101-2-A 1960, C06-101-4-A 1963, C06-103-1-M1966
 Modified Per Engineer's Directive
 Prepared 8/21/19

Horizontal Scale 1" = 20'
 Vertical Scale 1" = 5'

OCEAN VIEW CHANNEL (C06)

67+50.00

CL CONSTRUCTION

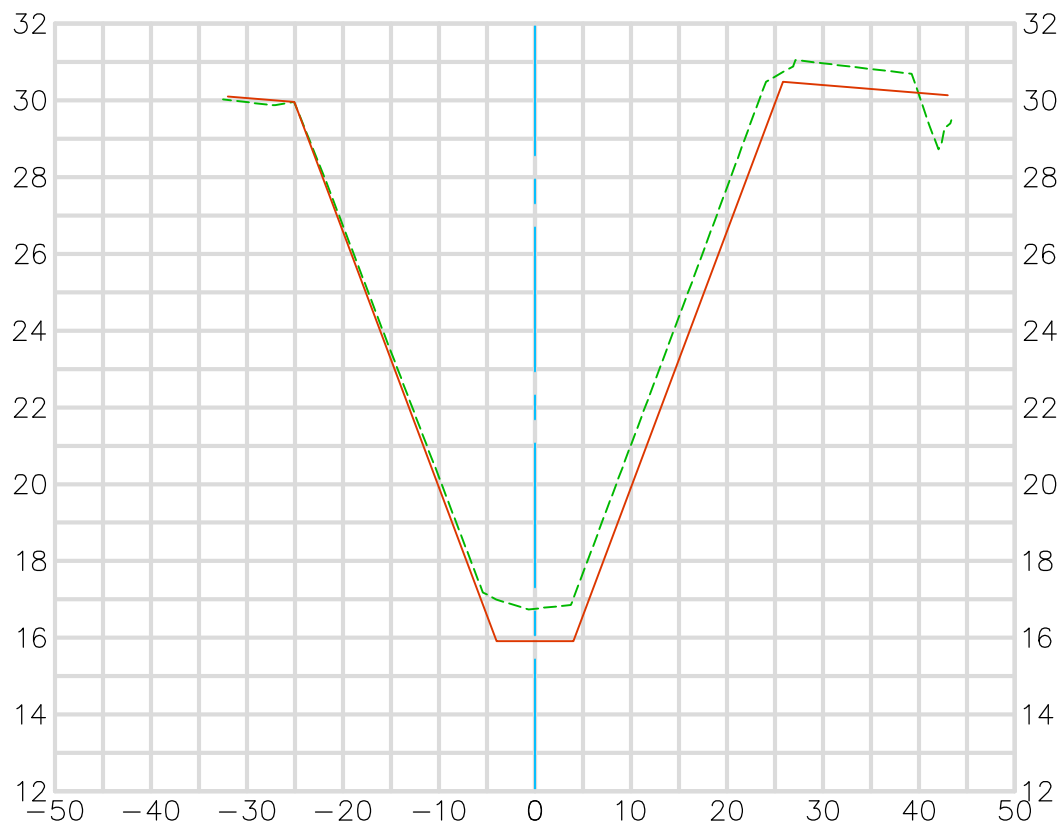


Existing Condition 2018
 Record Plan 1960-1966
 C06-101-2-A 1960, C06-101-4-A 1963, C06-103-1-M1966
 Modified Per Engineer's Directive
 Prepared 8/21/19

Horizontal Scale 1" = 20'
 Vertical Scale 1" = 5'

OCEAN VIEW CHANNEL (C06)

68+00.00

CL CONSTRUCTION

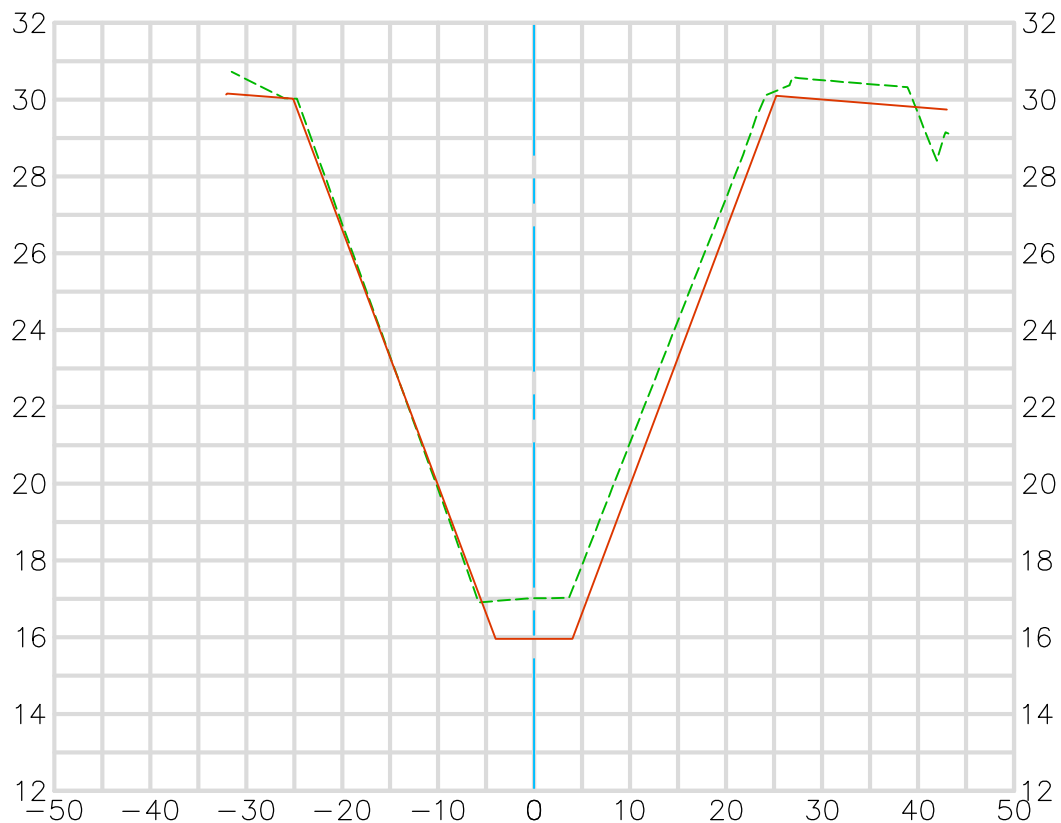


Existing Condition 2018
Record Plan 1960-1966
C06-101-2-A 1960, C06-101-4-A 1963, C06-103-1-M1966
Modified Per Engineer's Directive
Prepared 8/21/19

Horizontal Scale 1" = 20'
Vertical Scale 1" = 5'

OCEAN VIEW CHANNEL (C06)

68+46.51

CL CONSTRUCTION

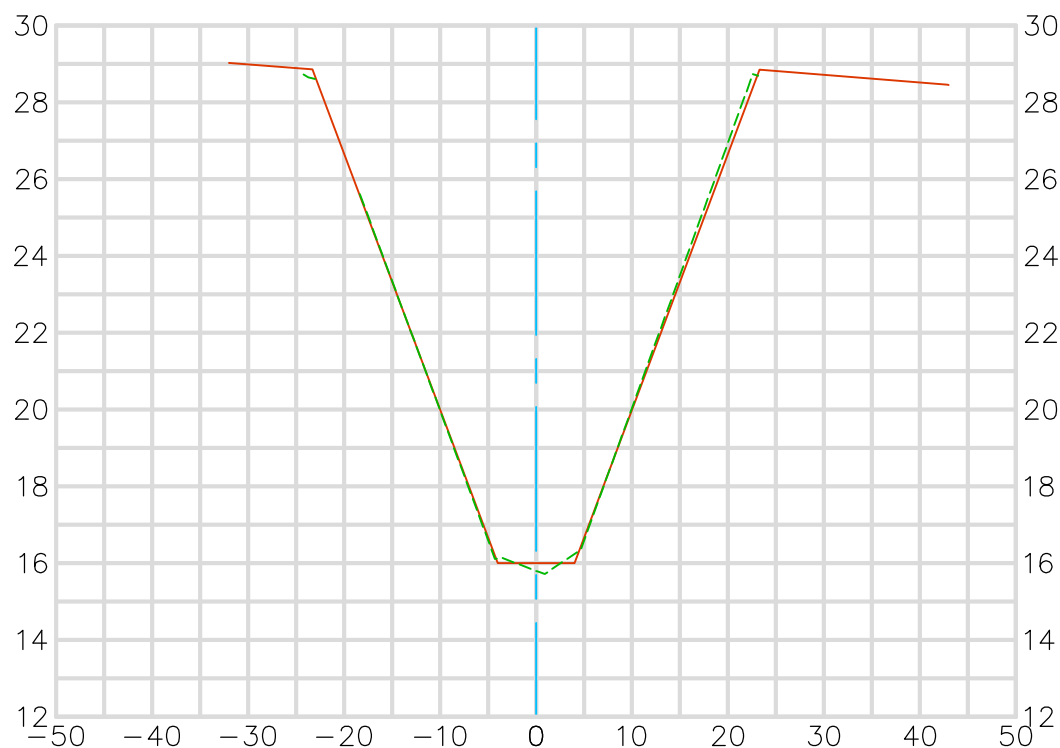

Existing Condition 2018
 Record Plan 1960-1966
 C06-101-2-A 1960, C06-101-4-A 1963, C06-103-1-M1966
 Modified Per Engineer's Directive
 Prepared 8/21/19

Horizontal Scale 1" = 20'
 Vertical Scale 1" = 5'