

**U.S. Survey
Foot**


OC Public Works/Engineering Services
OC Survey/Field Services
Boundary Analysis & Mapping



OCEAN VIEW CHANNEL (C06)

114+50.00

CL CONSTRUCTION

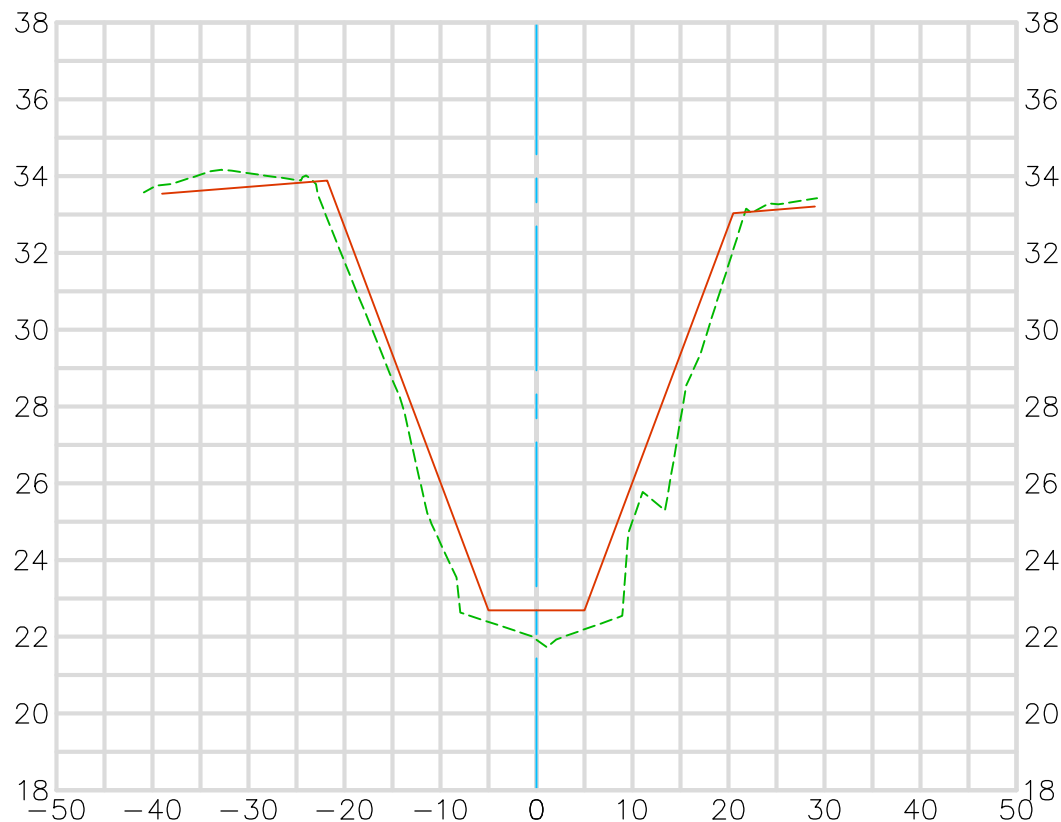

Existing Condition 2018 ---
Record Plan 1960-1966 ---
CO6-101-2-A 1960, CO6-101-4-A 1963, CO6-103-1-M 1966
Modified Per Engineer's Directive
Prepared 8/21/19

Horizontal Scale 1" = 20'
Vertical Scale 1" = 5'

**U.S. Survey
Foot**


OC Public Works/Engineering Services
OC Survey/Field Services
Boundary Analysis & Mapping



OCEAN VIEW CHANNEL (C06)

115+00.00

CL CONSTRUCTION

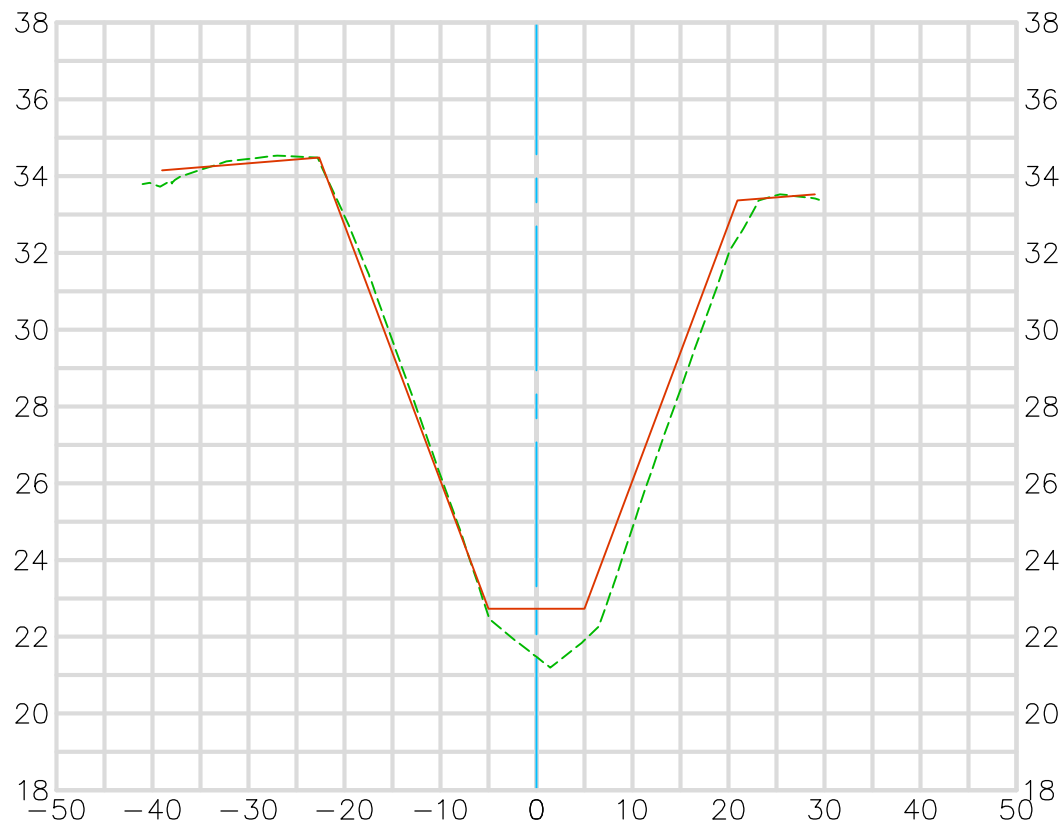

Existing Condition 2018 ---
Record Plan 1960-1966 ---
CO6-101-2-A 1960, CO6-101-4-A 1963, CO6-103-1-M 1966
Modified Per Engineer's Directive
Prepared 8/21/19

Horizontal Scale 1" = 20'
Vertical Scale 1" = 5'

**U.S. Survey
Foot**


OC Public Works/Engineering Services
OC Survey/Field Services
Boundary Analysis & Mapping



OCEAN VIEW CHANNEL (C06)


115+50.00

CL CONSTRUCTION

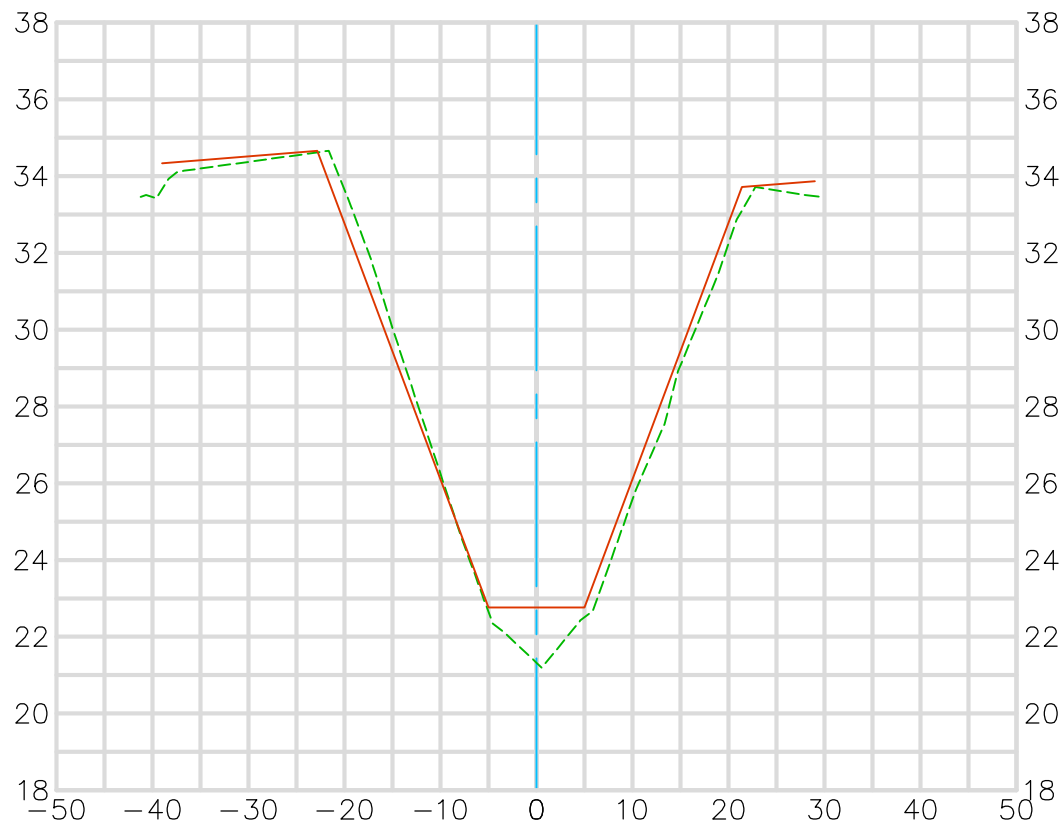

Existing Condition 2018 ---
Record Plan 1960-1966 ---
CO6-101-2-A 1960, CO6-101-4-A 1963, CO6-103-1-M 1966
Modified Per Engineer's Directive
Prepared 8/21/19


Horizontal Scale 1" = 20'
Vertical Scale 1" = 5'

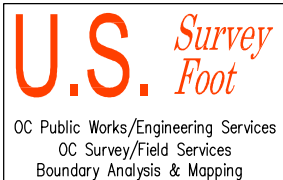

OCEAN VIEW CHANNEL (C06)

116+00.00

CL CONSTRUCTION

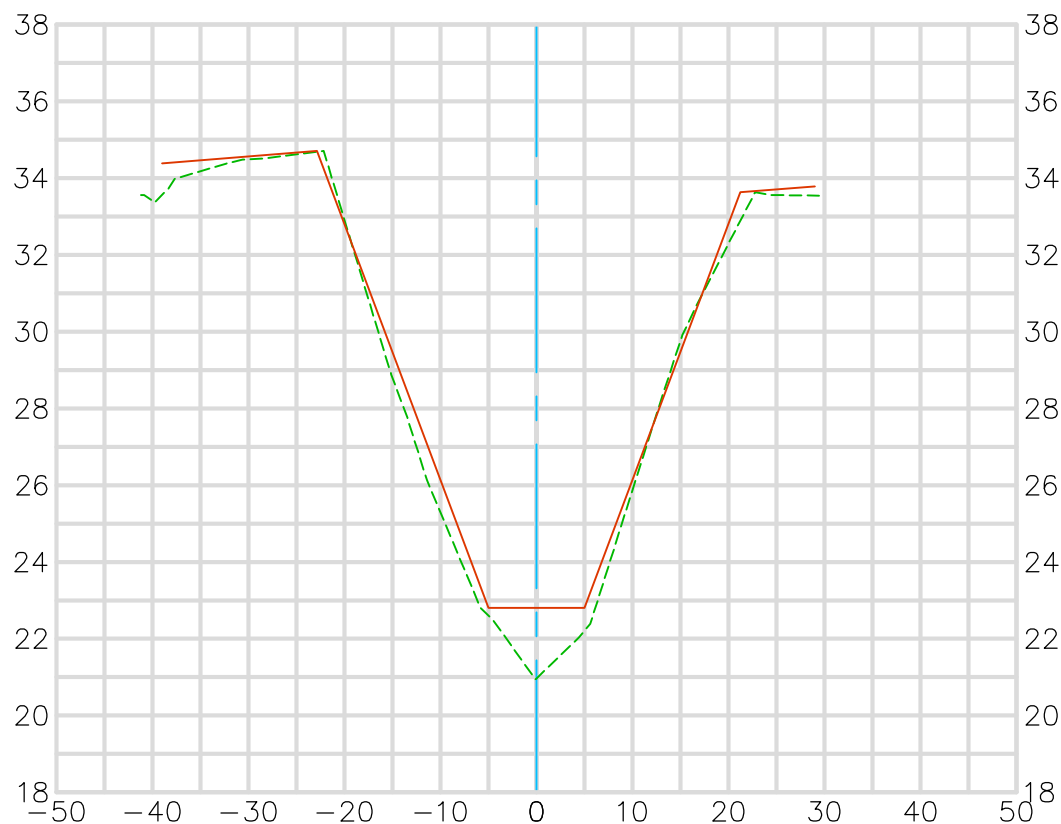

Existing Condition 2018 ---
Record Plan 1960-1966 ---
CO6-101-2-A 1960, CO6-101-4-A 1963, CO6-103-1-M 1966
Modified Per Engineer's Directive
Prepared 8/21/19

Horizontal Scale 1" = 20'
Vertical Scale 1" = 5'

**U.S. Survey
Foot**


OC Public Works/Engineering Services
OC Survey/Field Services
Boundary Analysis & Mapping



OCEAN VIEW CHANNEL (C06)

116+50.00

CL CONSTRUCTION

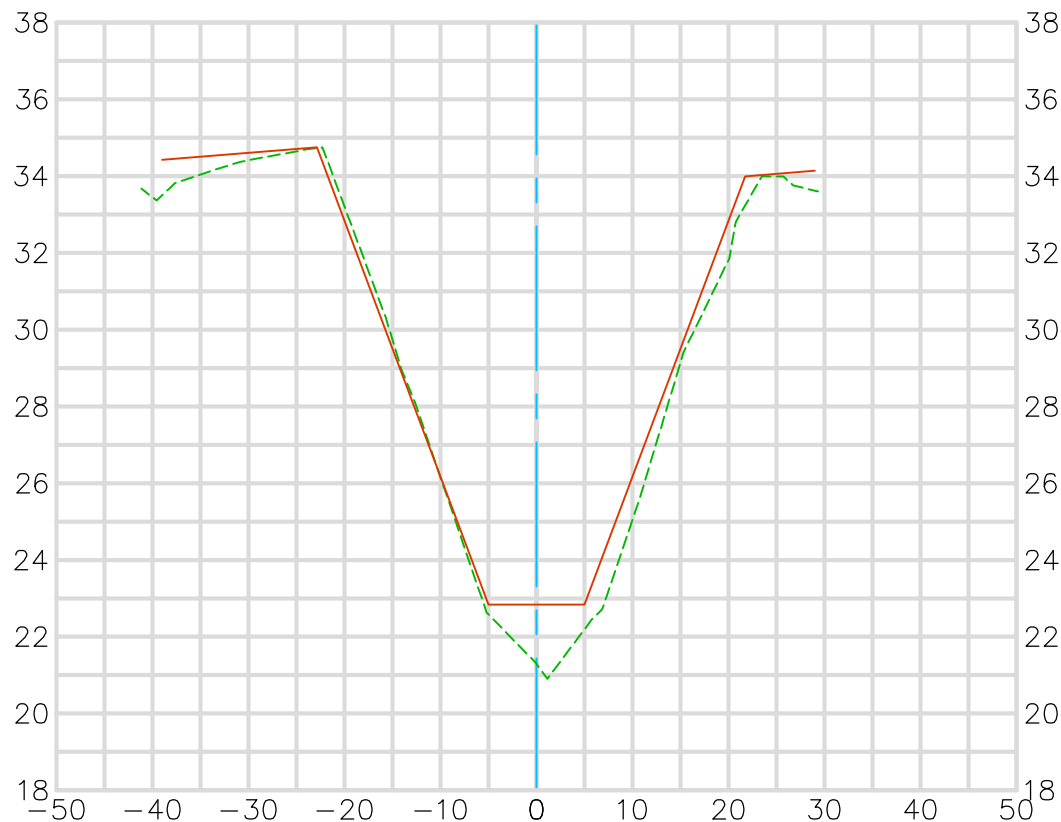

Existing Condition 2018 ---
Record Plan 1960-1966 ---
CO6-101-2-A 1960, CO6-101-4-A 1963, CO6-103-1-M 1966
Modified Per Engineer's Directive
Prepared 8/21/19

Horizontal Scale 1" = 20'
Vertical Scale 1" = 5'

U.S. Survey Foot


OC Public Works/Engineering Services
OC Survey/Field Services
Boundary Analysis & Mapping



OCEAN VIEW CHANNEL (C06)

117+00.00

CL CONSTRUCTION

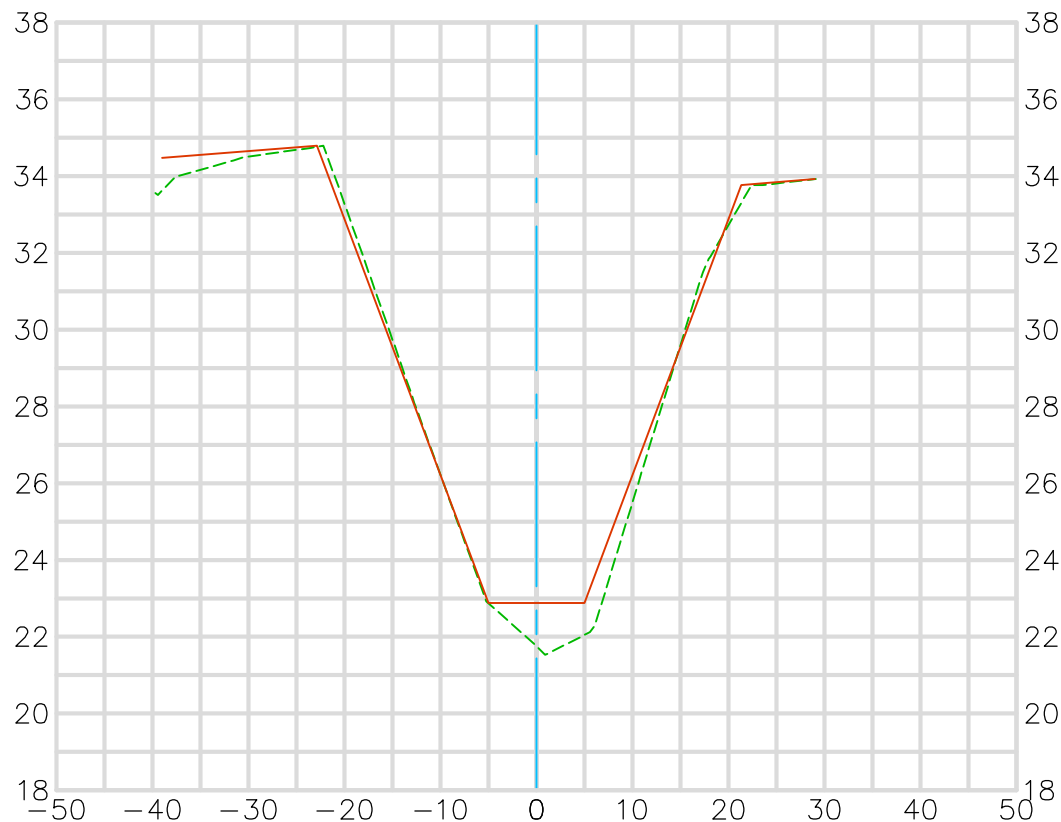

Existing Condition 2018 ---
Record Plan 1960-1966 ---
CO6-101-2-A 1960, CO6-101-4-A 1963, CO6-103-1-M 1966
Modified Per Engineer's Directive
Prepared 8/21/19

Horizontal Scale 1" = 20'
Vertical Scale 1" = 5'

**U.S. Survey
Foot**


OC Public Works/Engineering Services
OC Survey/Field Services
Boundary Analysis & Mapping



OCEAN VIEW CHANNEL (C06)

117+50.00

CL CONSTRUCTION

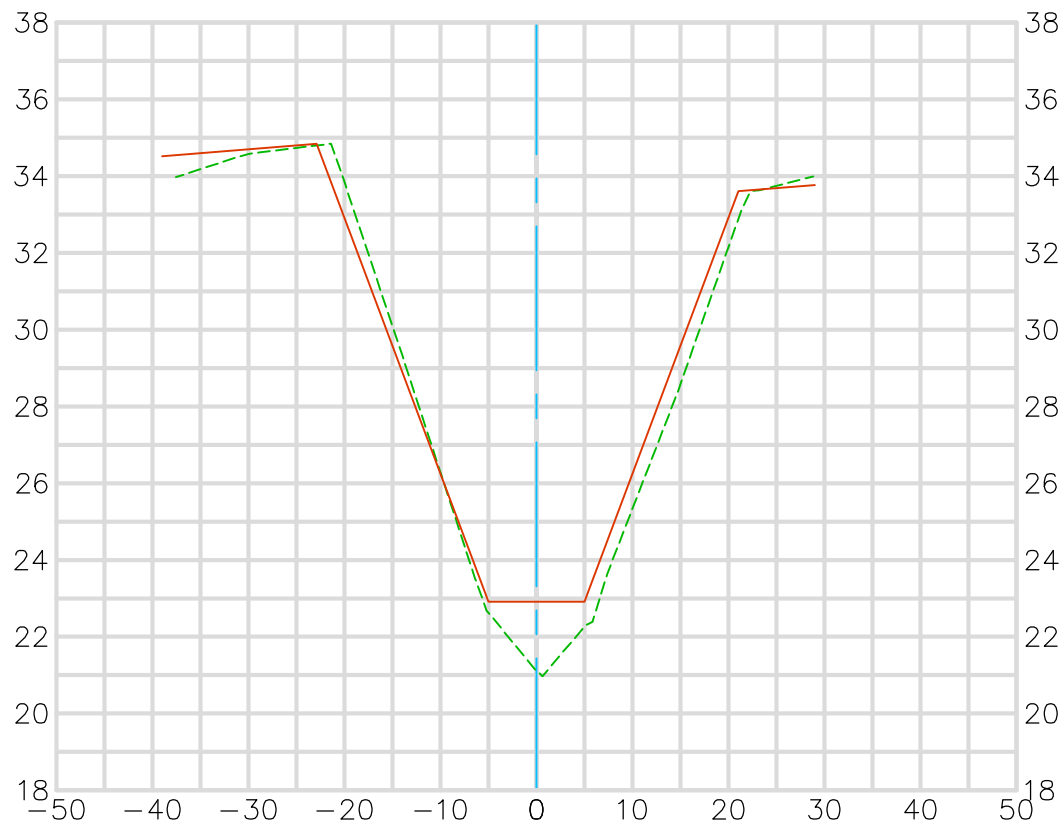

Existing Condition 2018 ---
Record Plan 1960-1966 ---
CO6-101-2-A 1960, CO6-101-4-A 1963, CO6-103-1-M 1966
Modified Per Engineer's Directive
Prepared 8/21/19

Horizontal Scale 1" = 20'
Vertical Scale 1" = 5'

**U.S. Survey
Foot**


OC Public Works/Engineering Services
OC Survey/Field Services
Boundary Analysis & Mapping



OCEAN VIEW CHANNEL (C06)

118+00.00

CL CONSTRUCTION

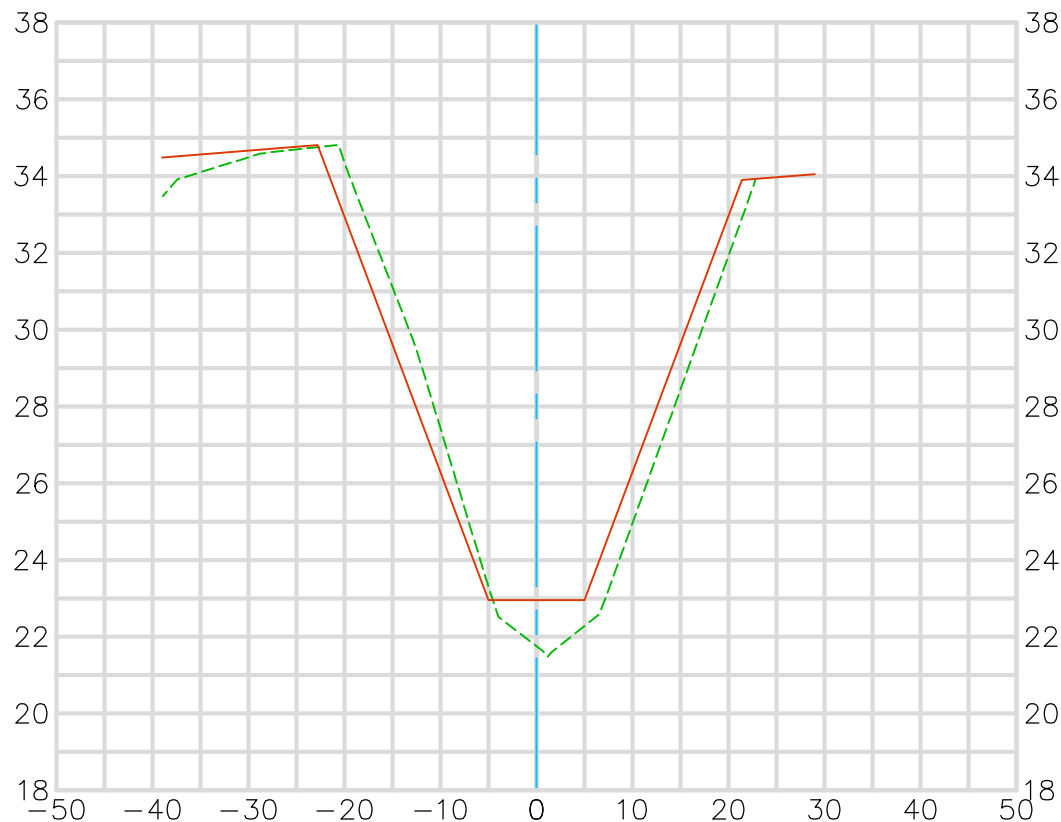

Existing Condition 2018 ---
Record Plan 1960-1966 ---
CO6-101-2-A 1960, CO6-101-4-A 1963, CO6-103-1-M 1966
Modified Per Engineer's Directive
Prepared 8/21/19

Horizontal Scale 1" = 20'
Vertical Scale 1" = 5'

**U.S. Survey
Foot**


OC Public Works/Engineering Services
OC Survey/Field Services
Boundary Analysis & Mapping



OCEAN VIEW CHANNEL (C06)

118+50.00

CL CONSTRUCTION

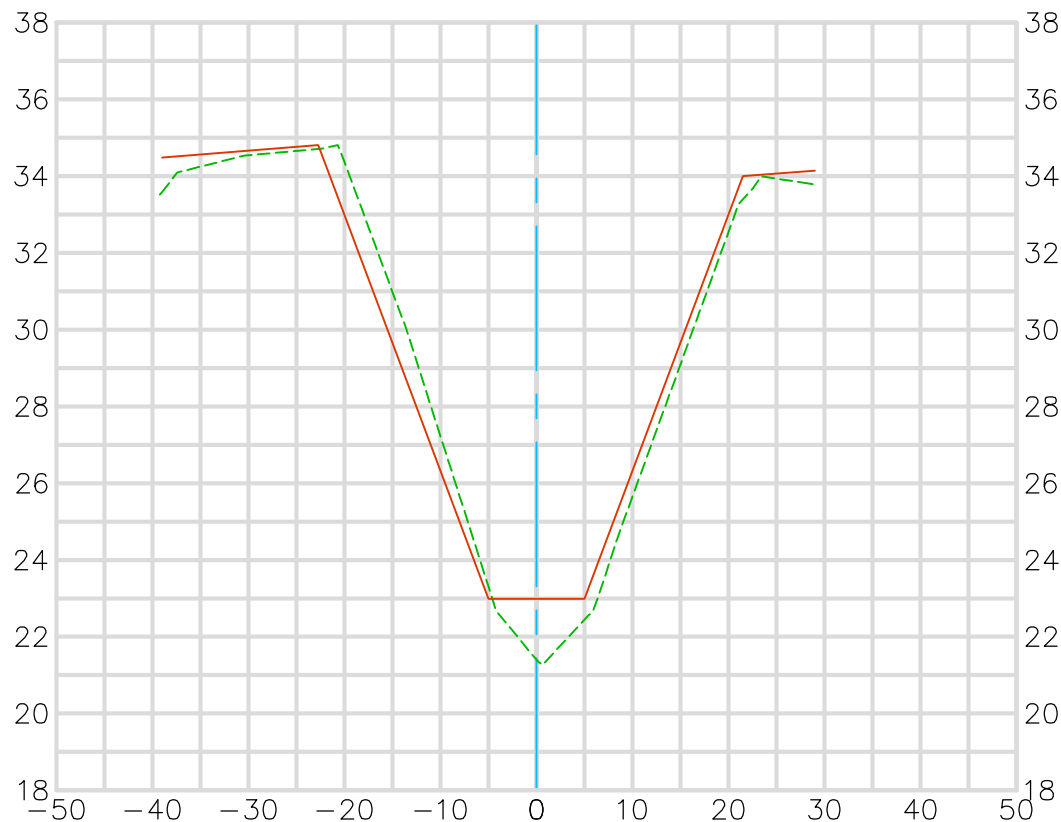


Existing Condition 2018 ---
Record Plan 1960-1966 ---
CO6-101-2-A 1960, CO6-101-4-A 1963, CO6-103-1-M 1966
Modified Per Engineer's Directive
Prepared 8/21/19

Horizontal Scale 1" = 20'
Vertical Scale 1" = 5'

OCEAN VIEW CHANNEL (C06)

119+00.00

CL CONSTRUCTION

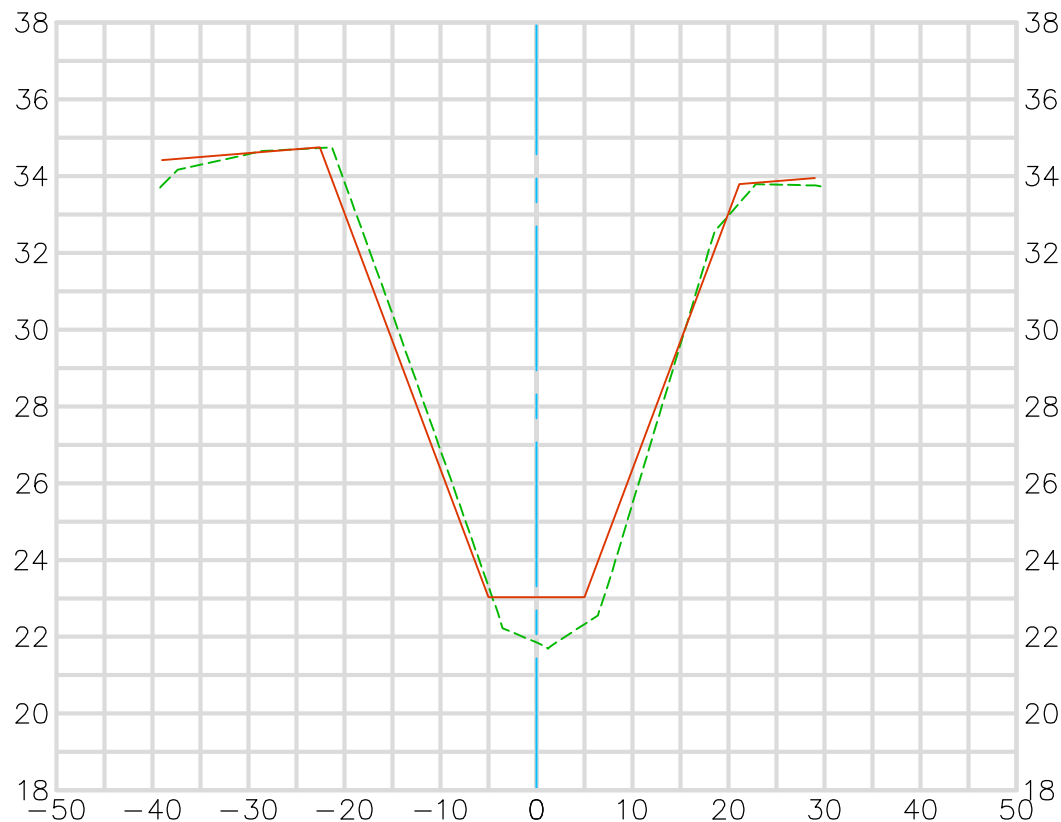

Existing Condition 2018 ---
 Record Plan 1960-1966 ---
 CO6-101-2-A 1960, CO6-101-4-A 1963, CO6-103-1-M 1966
 Modified Per Engineer's Directive
 Prepared 8/21/19

Horizontal Scale 1" = 20'
 Vertical Scale 1" = 5'

**U.S. Survey
Foot**


OC Public Works/Engineering Services
OC Survey/Field Services
Boundary Analysis & Mapping



OCEAN VIEW CHANNEL (C06)

119+50.00


CL CONSTRUCTION

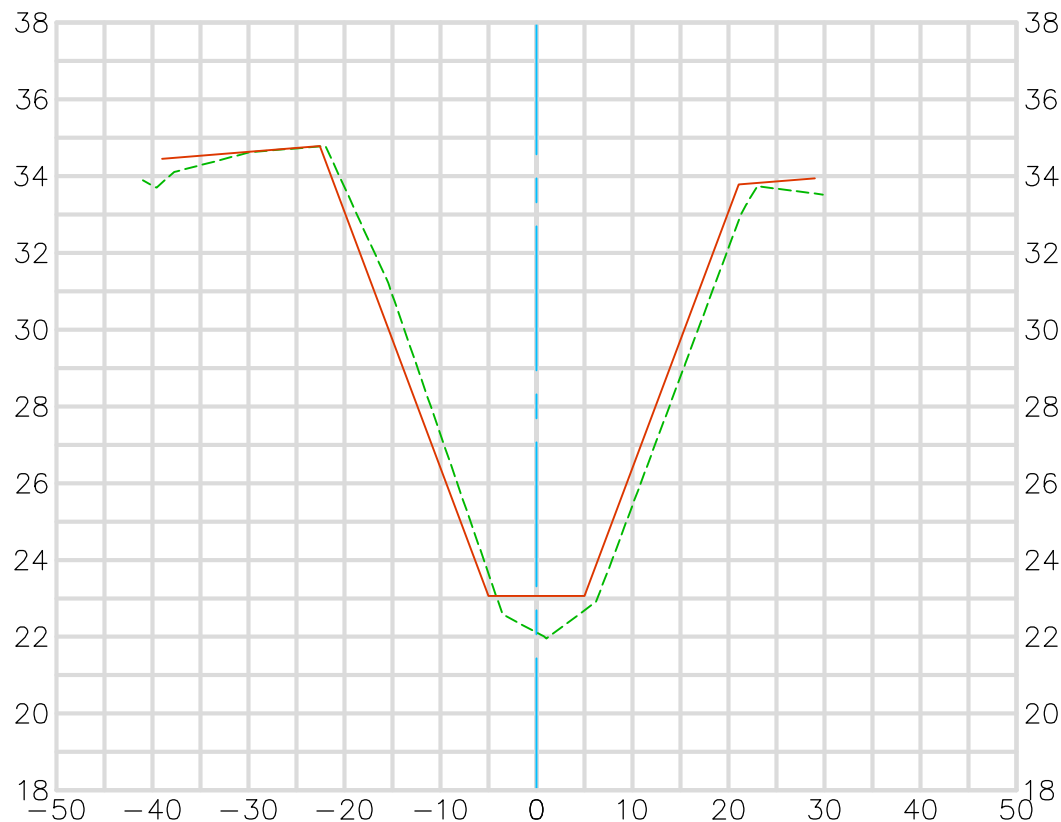

Existing Condition 2018 ---
Record Plan 1960-1966 ---
CO6-101-2-A 1960, CO6-101-4-A 1963, CO6-103-1-M 1966
Modified Per Engineer's Directive
Prepared 8/21/19

Horizontal Scale 1" = 20'
Vertical Scale 1" = 5'

OCEAN VIEW CHANNEL (C06) 120+00.00 CL CONSTRUCTION

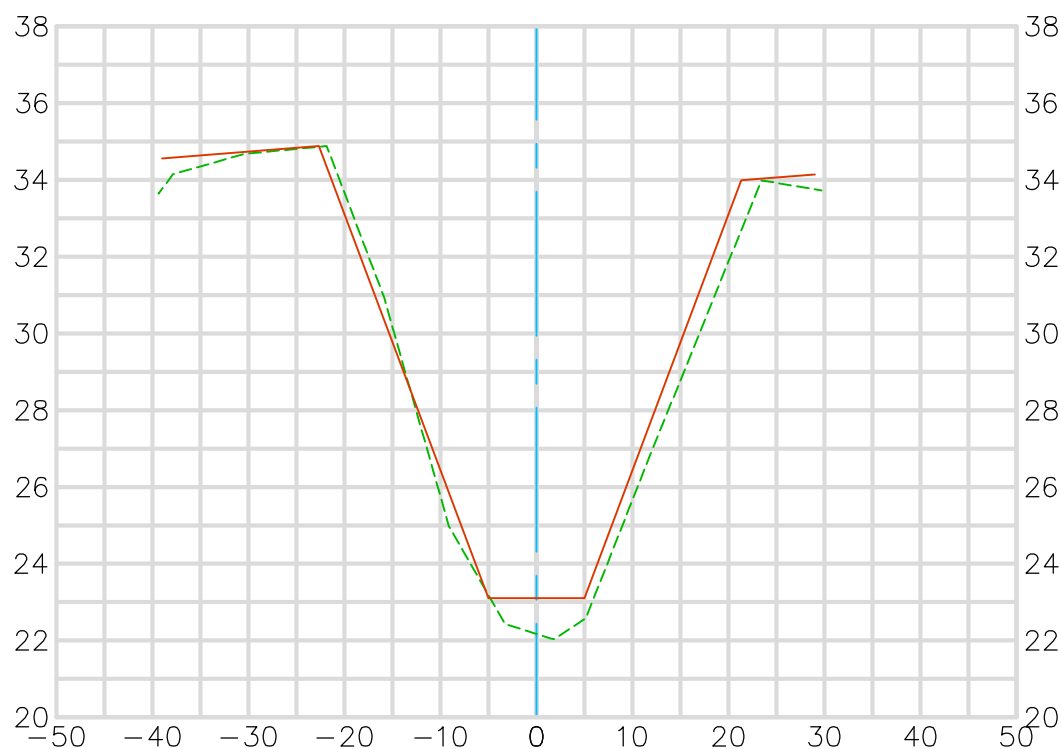

Existing Condition 2018 ---
 Record Plan 1960-1966 ---
 CO6-101-2-A 1960, CO6-101-4-A 1963, CO6-103-1-M 1966
 Modified Per Engineer's Directive
 Prepared 8/21/19

Horizontal Scale 1" = 20'
 Vertical Scale 1" = 5'

U.S. Survey Foot


OC Public Works/Engineering Services
OC Survey/Field Services
Boundary Analysis & Mapping



OCEAN VIEW CHANNEL (C06)

120+50.00

CL CONSTRUCTION

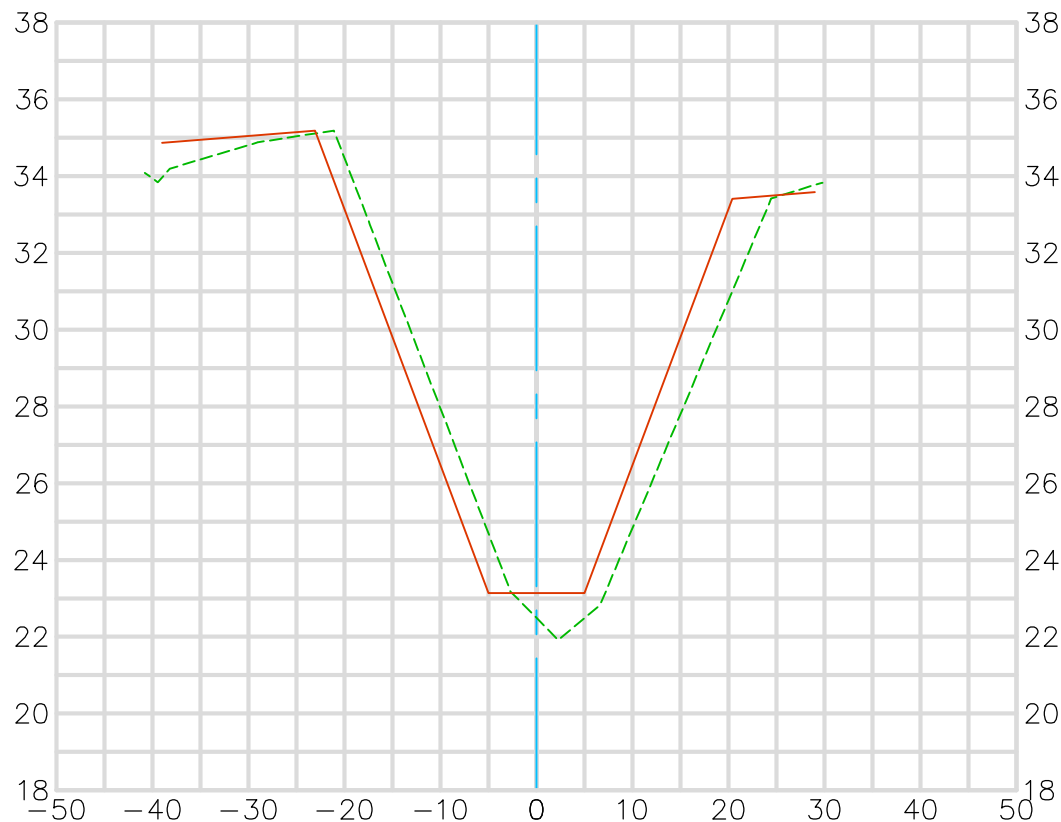

Existing Condition 2018 ---
Record Plan 1960-1966 ---
CO6-101-2-A 1960, CO6-101-4-A 1963, CO6-103-1-M 1966
Modified Per Engineer's Directive
Prepared 8/21/19

Horizontal Scale 1" = 20'
Vertical Scale 1" = 5'

**U.S. Survey
Foot**


OC Public Works/Engineering Services
OC Survey/Field Services
Boundary Analysis & Mapping



OCEAN VIEW CHANNEL (C06)

121+00.00

CL CONSTRUCTION

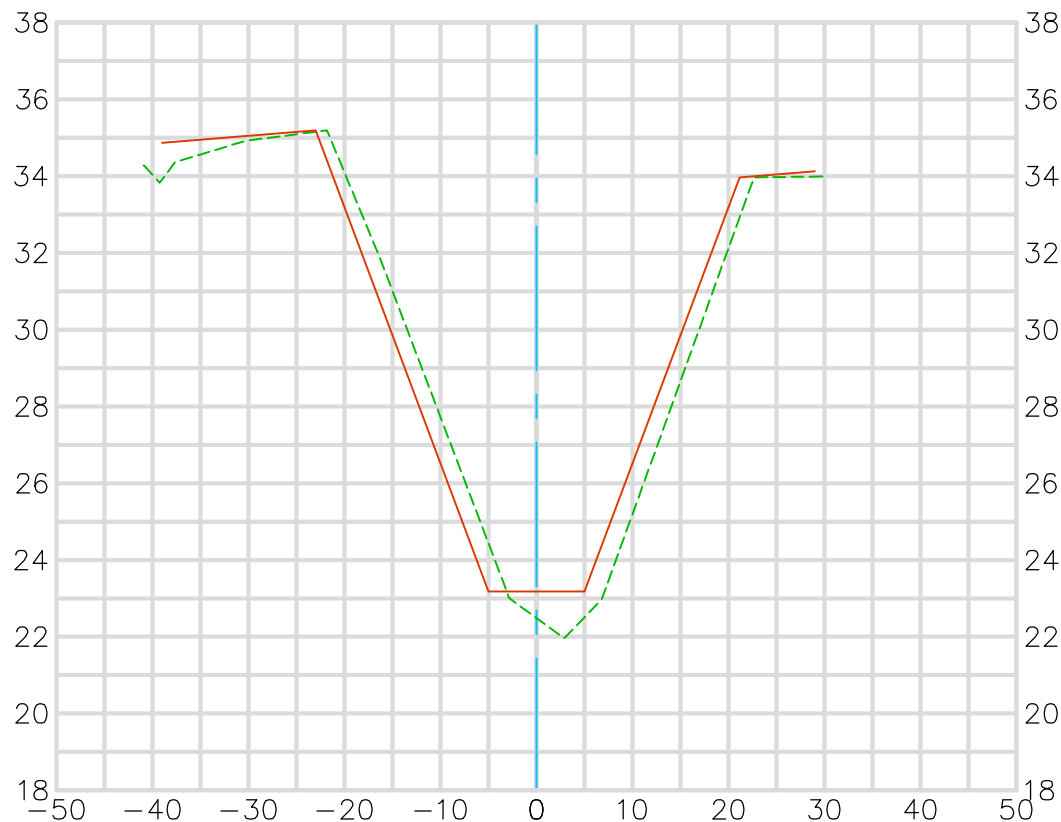

Existing Condition 2018 ---
Record Plan 1960-1966 ---
CO6-101-2-A 1960, CO6-101-4-A 1963, CO6-103-1-M 1966
Modified Per Engineer's Directive
Prepared 8/21/19

Horizontal Scale 1" = 20'
Vertical Scale 1" = 5'

**U.S. Survey
Foot**


OC Public Works/Engineering Services
OC Survey/Field Services
Boundary Analysis & Mapping



OCEAN VIEW CHANNEL (C06)

121+50.00

CL CONSTRUCTION

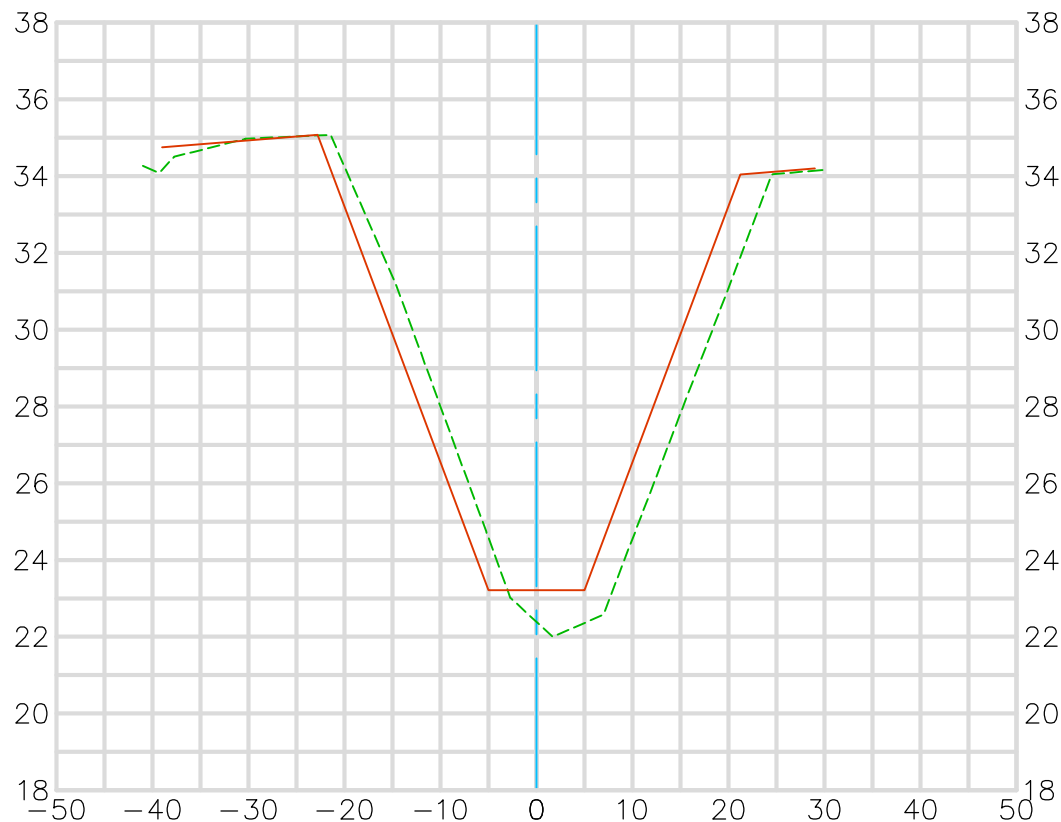

Existing Condition 2018 ---
Record Plan 1960-1966 —
CO6-101-2-A 1960, CO6-101-4-A 1963, CO6-103-1-M 1966
Modified Per Engineer's Directive
Prepared 8/21/19

Horizontal Scale 1" = 20'
Vertical Scale 1" = 5'

**U.S. Survey
Foot**


OC Public Works/Engineering Services
OC Survey/Field Services
Boundary Analysis & Mapping



OCEAN VIEW CHANNEL (C06)

122+00.00

CL CONSTRUCTION

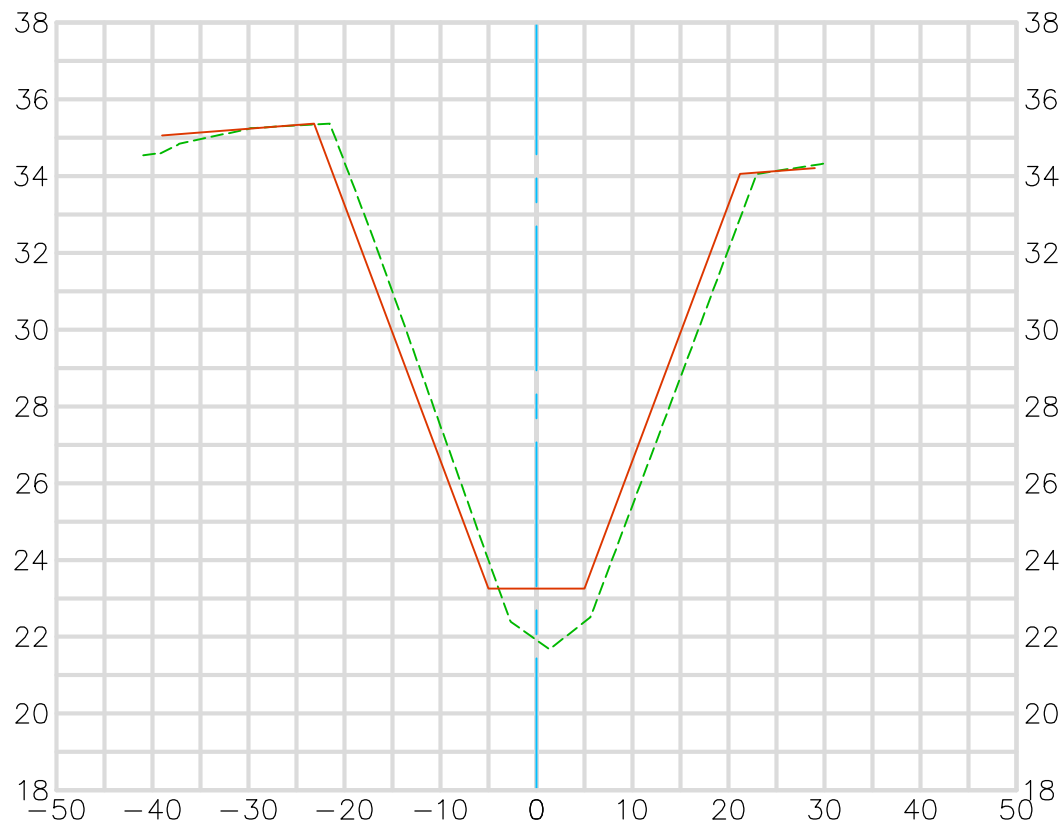

Existing Condition 2018 ---
Record Plan 1960-1966 ---
CO6-101-2-A 1960, CO6-101-4-A 1963, CO6-103-1-M 1966
Modified Per Engineer's Directive
Prepared 8/21/19


Horizontal Scale 1" = 20'
Vertical Scale 1" = 5'

U.S. Survey Foot

OC Public Works/Engineering Services
OC Survey/Field Services
Boundary Analysis & Mapping



OCEAN VIEW CHANNEL (C06) 122+50.00 CL CONSTRUCTION

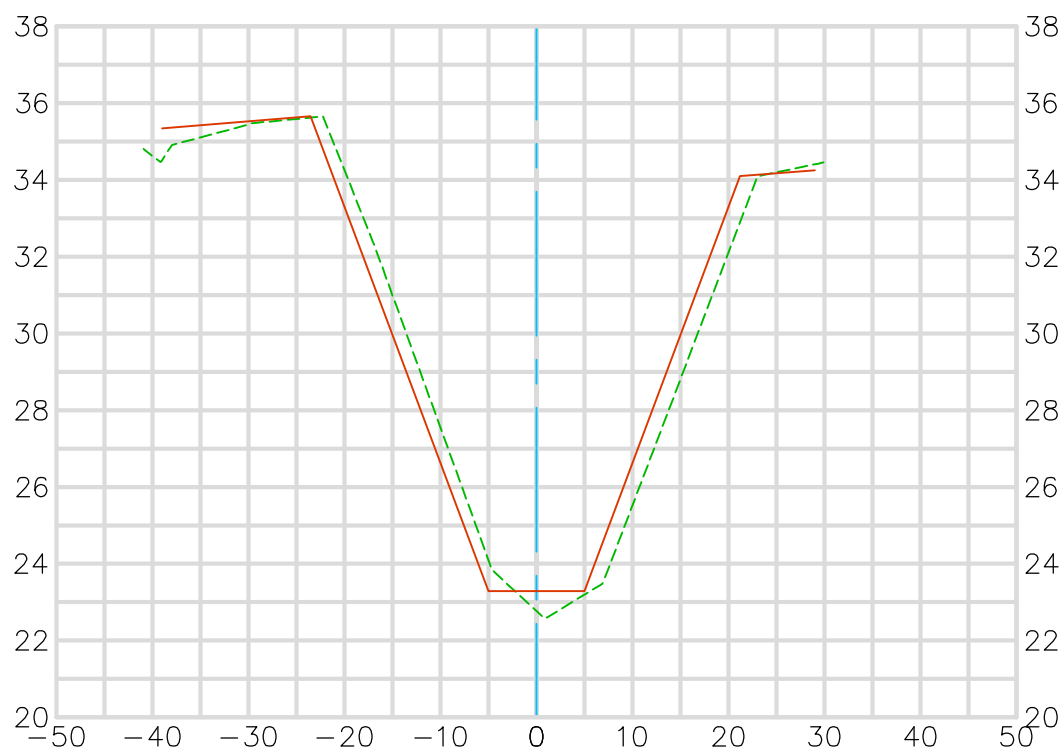

Existing Condition 2018 ---
Record Plan 1960-1966 ---
CO6-101-2-A 1960, CO6-101-4-A 1963, CO6-103-1-M 1966
Modified Per Engineer's Directive
Prepared 8/21/19


Horizontal Scale 1" = 20'
Vertical Scale 1" = 5'

U.S. Survey Foot

OC Public Works/Engineering Services
OC Survey/Field Services
Boundary Analysis & Mapping




OCEAN VIEW CHANNEL (C06) 123+00.00 CL CONSTRUCTION

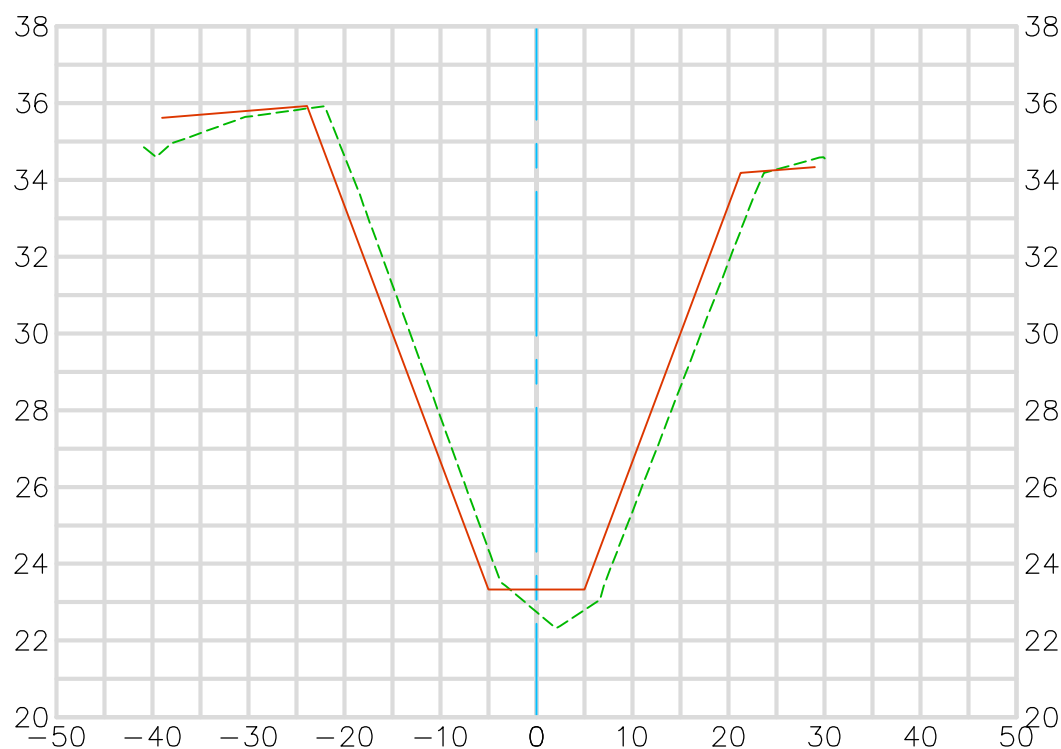

Existing Condition 2018 ---
Record Plan 1960-1966 ---
CO6-101-2-A 1960, CO6-101-4-A 1963, CO6-103-1-M 1966
Modified Per Engineer's Directive
Prepared 8/21/19

Horizontal Scale 1" = 20'
Vertical Scale 1" = 5'

OCEAN VIEW CHANNEL (C06) 123+50.00 CL CONSTRUCTION

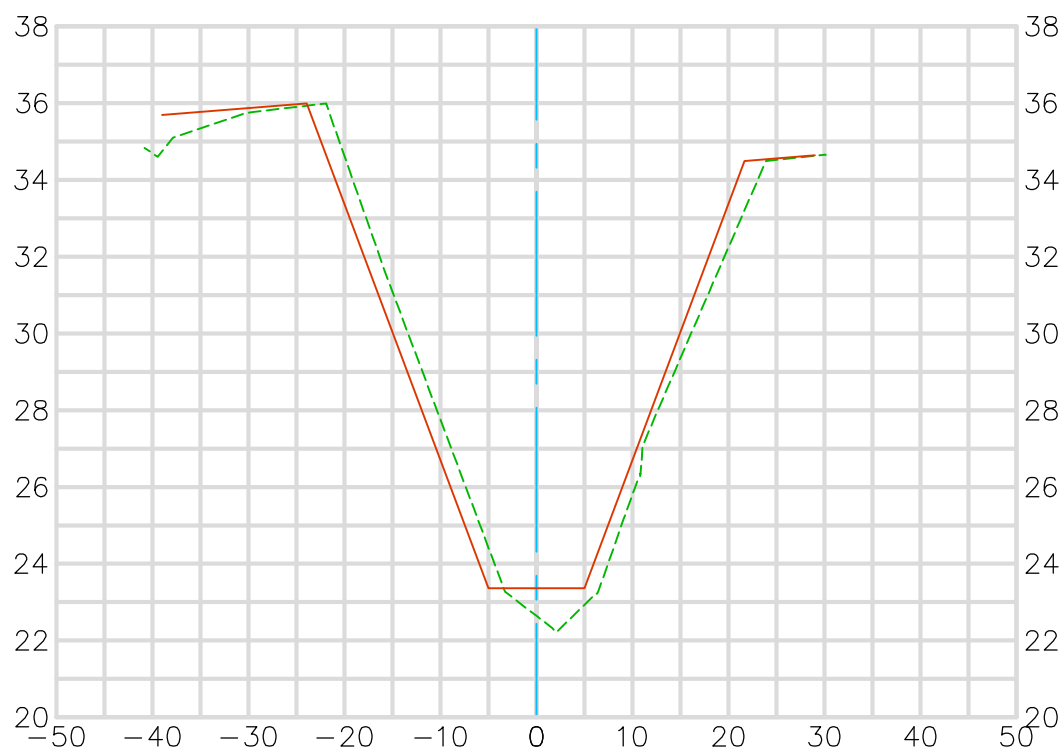


Existing Condition 2018 ---
 Record Plan 1960-1966 ---
 CO6-101-2-A 1960, CO6-101-4-A 1963, CO6-103-1-M 1966
 Modified Per Engineer's Directive
 Prepared 8/21/19

Horizontal Scale 1" = 20'
 Vertical Scale 1" = 5'

U.S. Survey Foot

OC Public Works/Engineering Services
OC Survey/Field Services
Boundary Analysis & Mapping

OCEAN VIEW CHANNEL (C06) 124+00.00 CL CONSTRUCTION

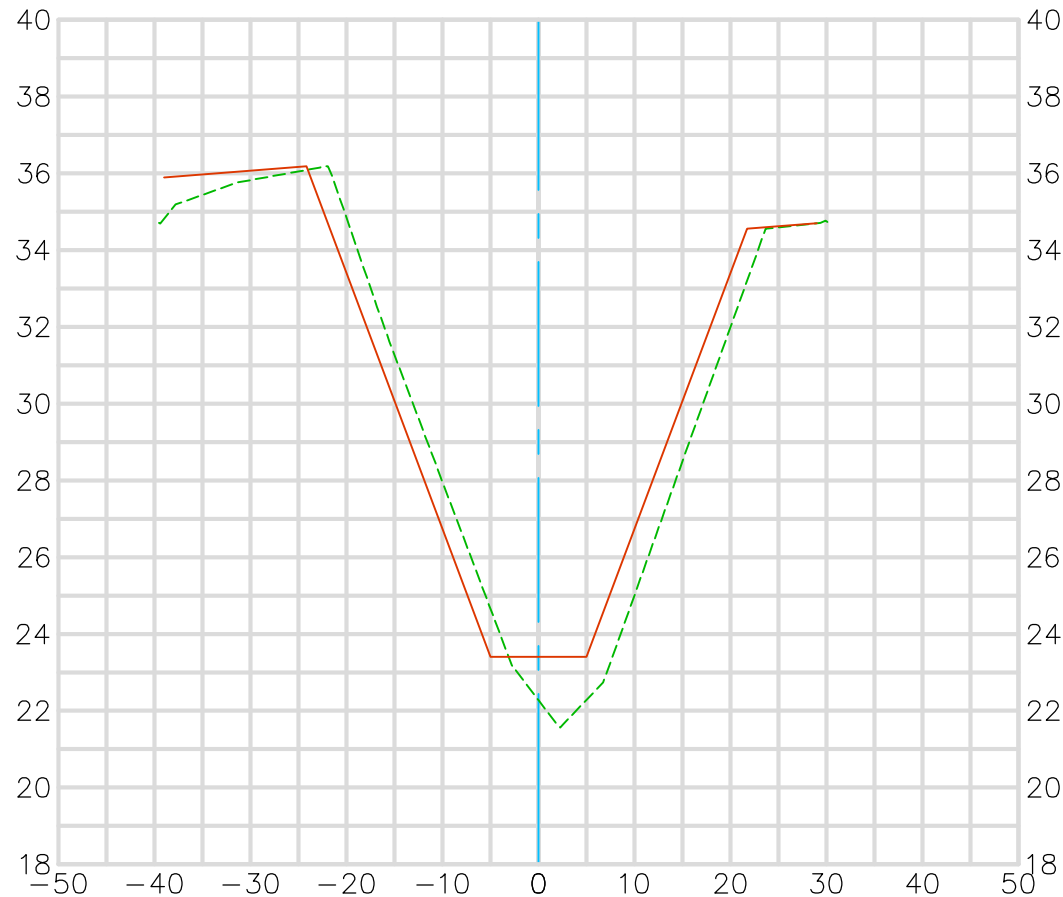


Existing Condition 2018 
Record Plan 1960-1966 
CO6-101-2-A 1960, CO6-101-4-A 1963, CO6-103-1-M 1966
Modified Per Engineer's Directive
Prepared 8/21/19

Horizontal Scale 1" = 20'
Vertical Scale 1" = 5'

**U.S. Survey
Foot**

OC Public Works/Engineering Services
OC Survey/Field Services
Boundary Analysis & Mapping

OCEAN VIEW CHANNEL (C06) 124+50.00 CL CONSTRUCTION

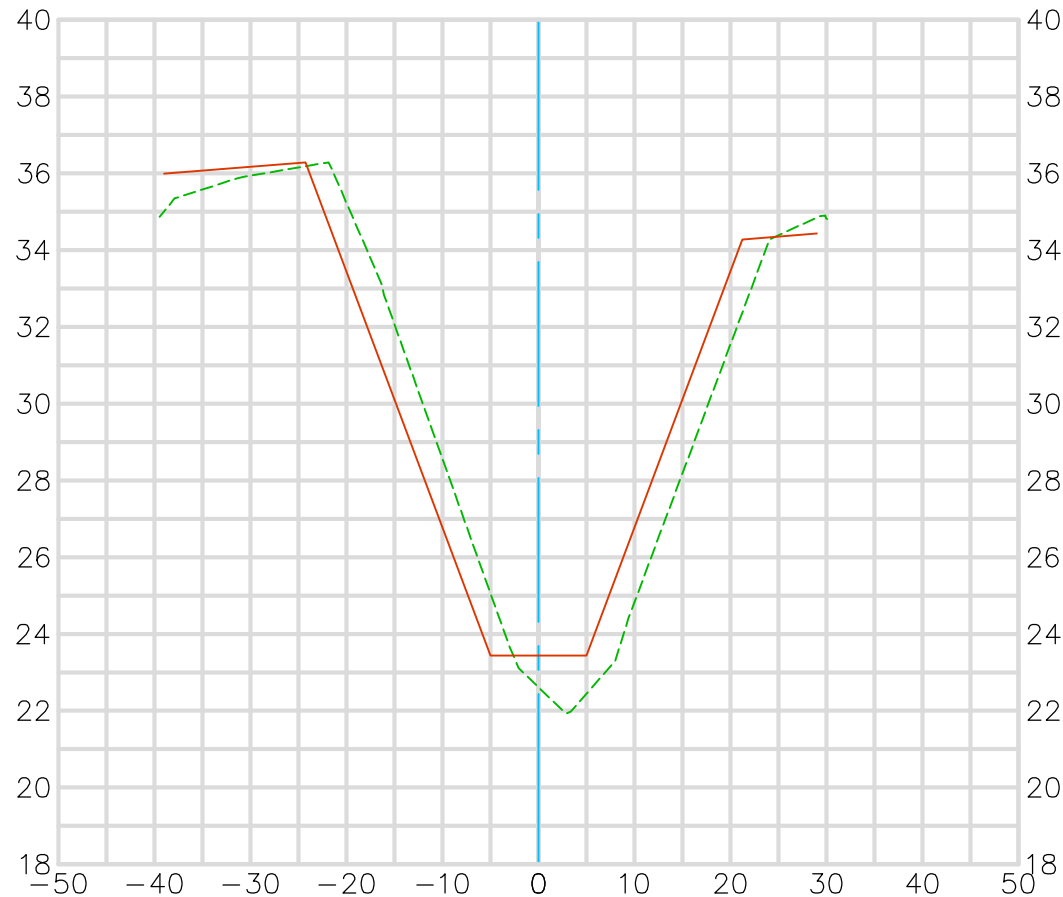

Existing Condition 2018 ---
Record Plan 1960-1966 ---
CO6-101-2-A 1960, CO6-101-4-A 1963, CO6-103-1-M 1966
Modified Per Engineer's Directive
Prepared 8/21/19

Horizontal Scale 1" = 20'
Vertical Scale 1" = 5'

**U.S. Survey
Foot**


OC Public Works/Engineering Services
OC Survey/Field Services
Boundary Analysis & Mapping



OCEAN VIEW CHANNEL (C06)

125+00.00

CL CONSTRUCTION

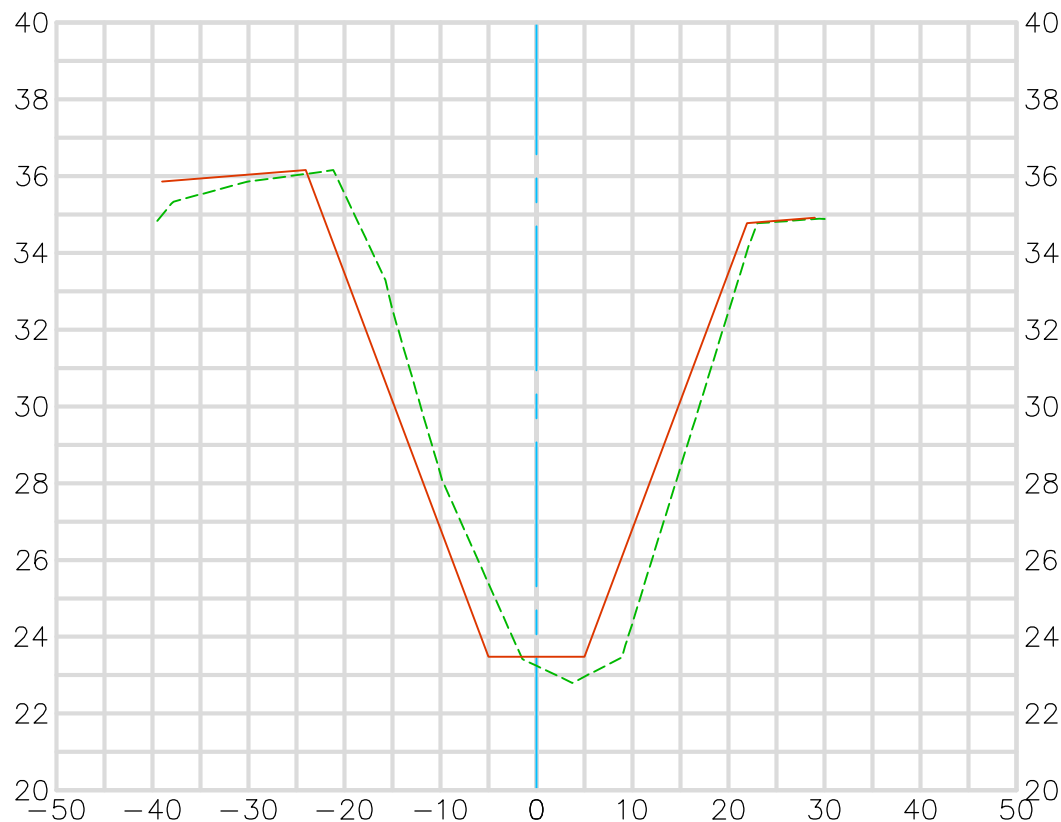

Existing Condition 2018 ---
Record Plan 1960-1966 ---
CO6-101-2-A 1960, CO6-101-4-A 1963, CO6-103-1-M 1966
Modified Per Engineer's Directive
Prepared 8/21/19

Horizontal Scale 1" = 20'
Vertical Scale 1" = 5'

U.S. Survey Foot


OC Public Works/Engineering Services
OC Survey/Field Services
Boundary Analysis & Mapping



OCEAN VIEW CHANNEL (C06)

125+50.00

CL CONSTRUCTION

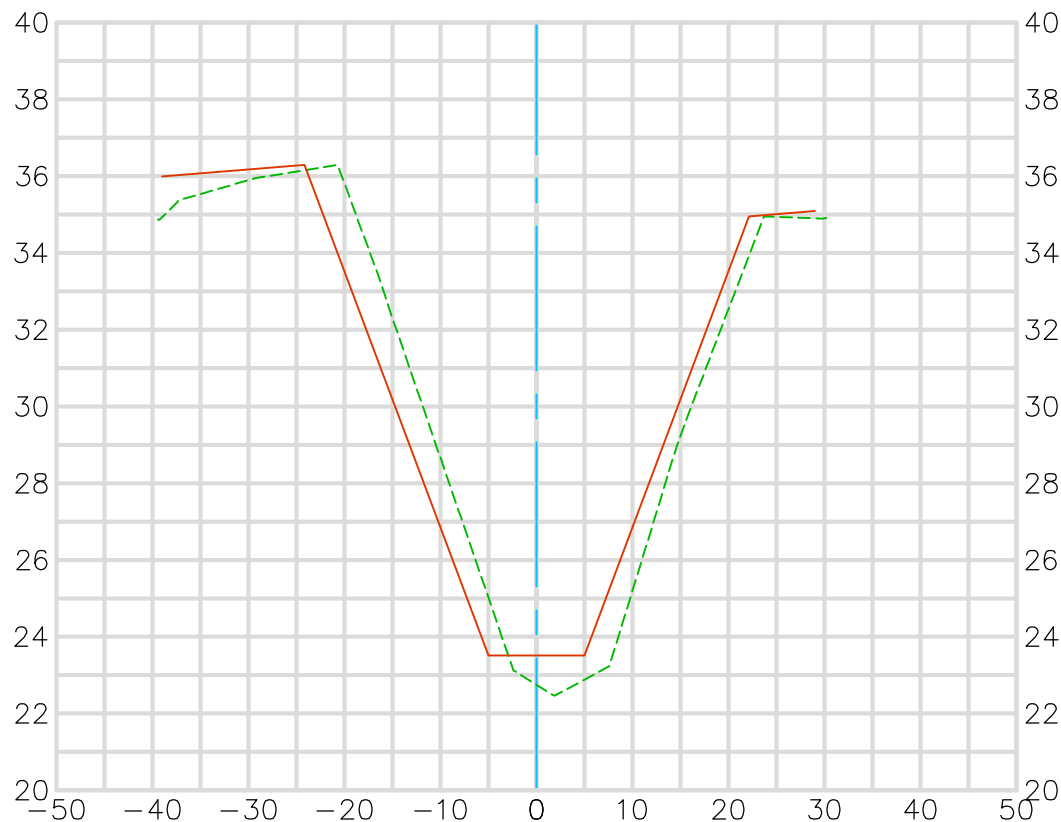

Existing Condition 2018 
Record Plan 1960-1966 
CO6-101-2-A 1960, CO6-101-4-A 1963, CO6-103-1-M 1966
Modified Per Engineer's Directive
Prepared 8/21/19

Horizontal Scale 1" = 20'
Vertical Scale 1" = 5'

U.S. Survey Foot


OC Public Works/Engineering Services
OC Survey/Field Services
Boundary Analysis & Mapping



OCEAN VIEW CHANNEL (C06)

126+00.00

CL CONSTRUCTION

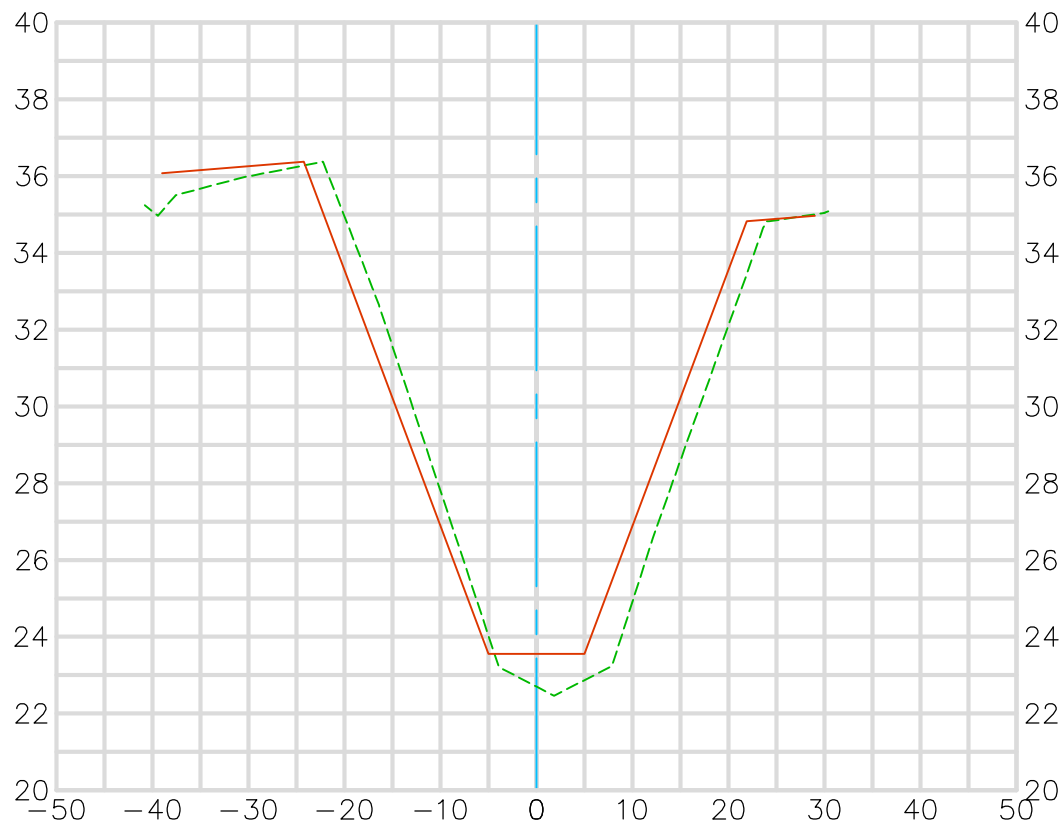

Existing Condition 2018 ---
Record Plan 1960-1966 ---
CO6-101-2-A 1960, CO6-101-4-A 1963, CO6-103-1-M 1966
Modified Per Engineer's Directive
Prepared 8/21/19

Horizontal Scale 1" = 20'
Vertical Scale 1" = 5'

**U.S. Survey
Foot**


OC Public Works/Engineering Services
OC Survey/Field Services
Boundary Analysis & Mapping



OCEAN VIEW CHANNEL (C06)

126+50.00

CL CONSTRUCTION

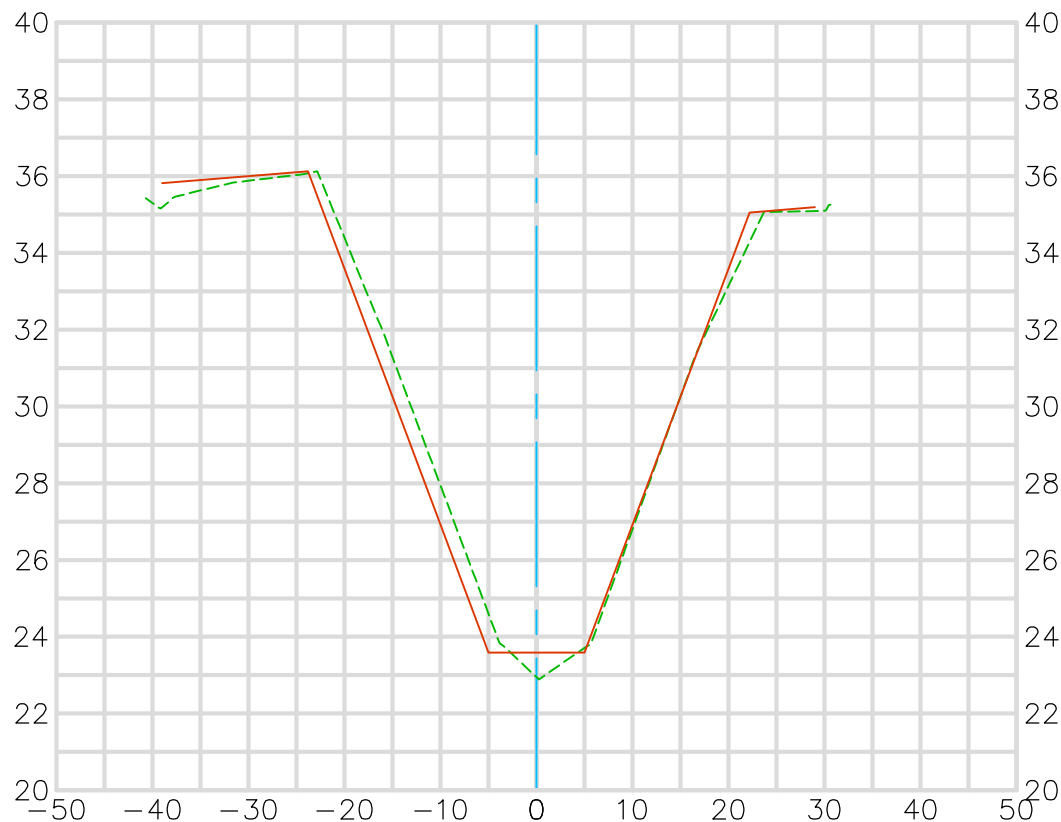

Existing Condition 2018 
Record Plan 1960-1966 
CO6-101-2-A 1960, CO6-101-4-A 1963, CO6-103-1-M 1966
Modified Per Engineer's Directive
Prepared 8/21/19


Horizontal Scale 1" = 20'
Vertical Scale 1" = 5'

U.S. Survey Foot

OC Public Works/Engineering Services
OC Survey/Field Services
Boundary Analysis & Mapping



OCEAN VIEW CHANNEL (C06) 127+50.00 CL CONSTRUCTION

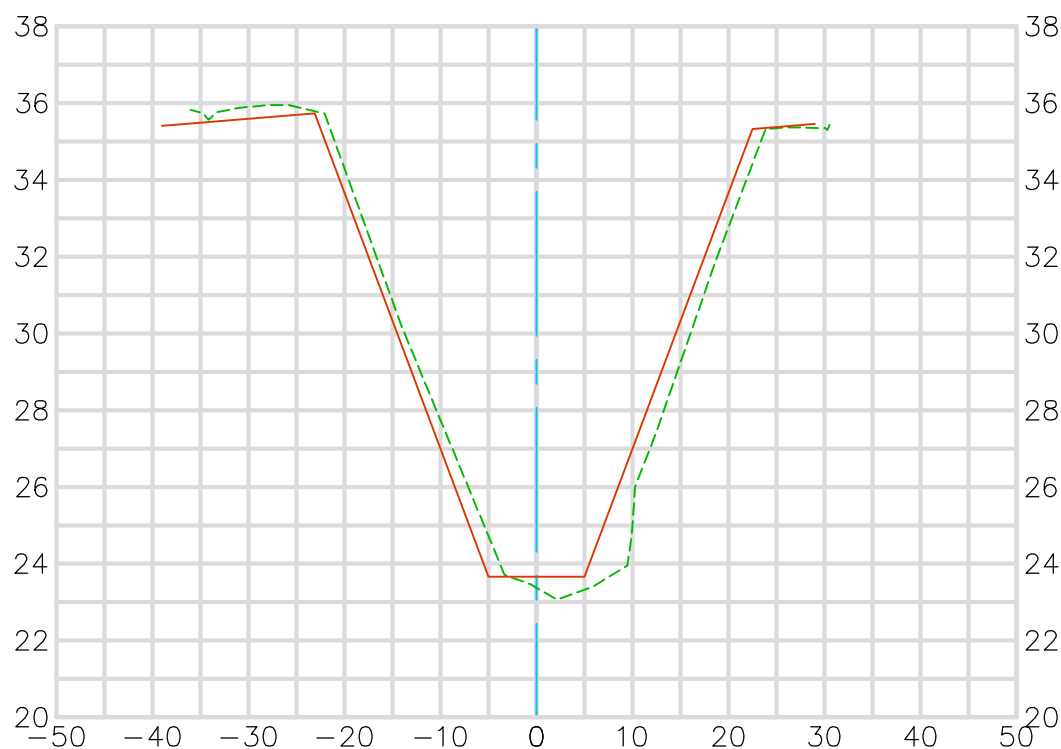

Existing Condition 2018 ---
Record Plan 1960-1966 ---
CO6-101-2-A 1960, CO6-101-4-A 1963, CO6-103-1-M 1966
Modified Per Engineer's Directive
Prepared 8/21/19


Horizontal Scale 1" = 20'
Vertical Scale 1" = 5'

U.S. Survey Foot

OC Public Works/Engineering Services
OC Survey/Field Services
Boundary Analysis & Mapping




OCEAN VIEW CHANNEL (C06) 128+00.00 CL CONSTRUCTION

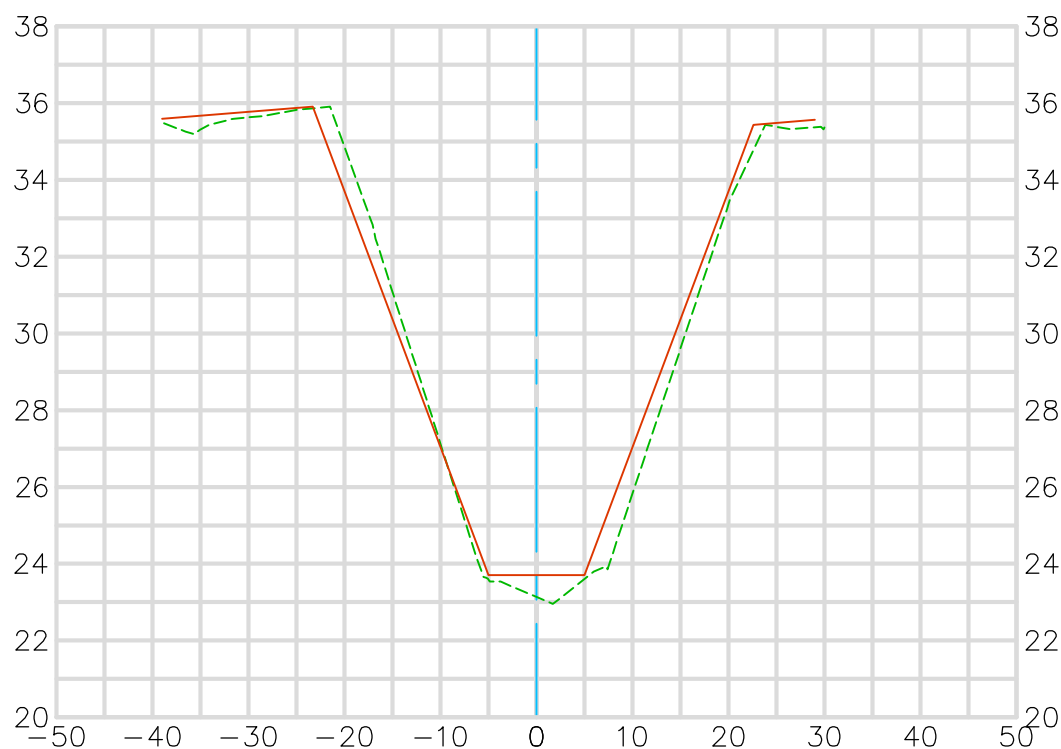

Existing Condition 2018 ---
Record Plan 1960-1966 ---
CO6-101-2-A 1960, CO6-101-4-A 1963, CO6-103-1-M 1966
Modified Per Engineer's Directive
Prepared 8/21/19


Horizontal Scale 1" = 20'
Vertical Scale 1" = 5'

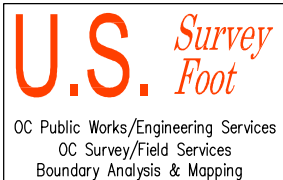

OCEAN VIEW CHANNEL (C06)

128+50.00

CL CONSTRUCTION

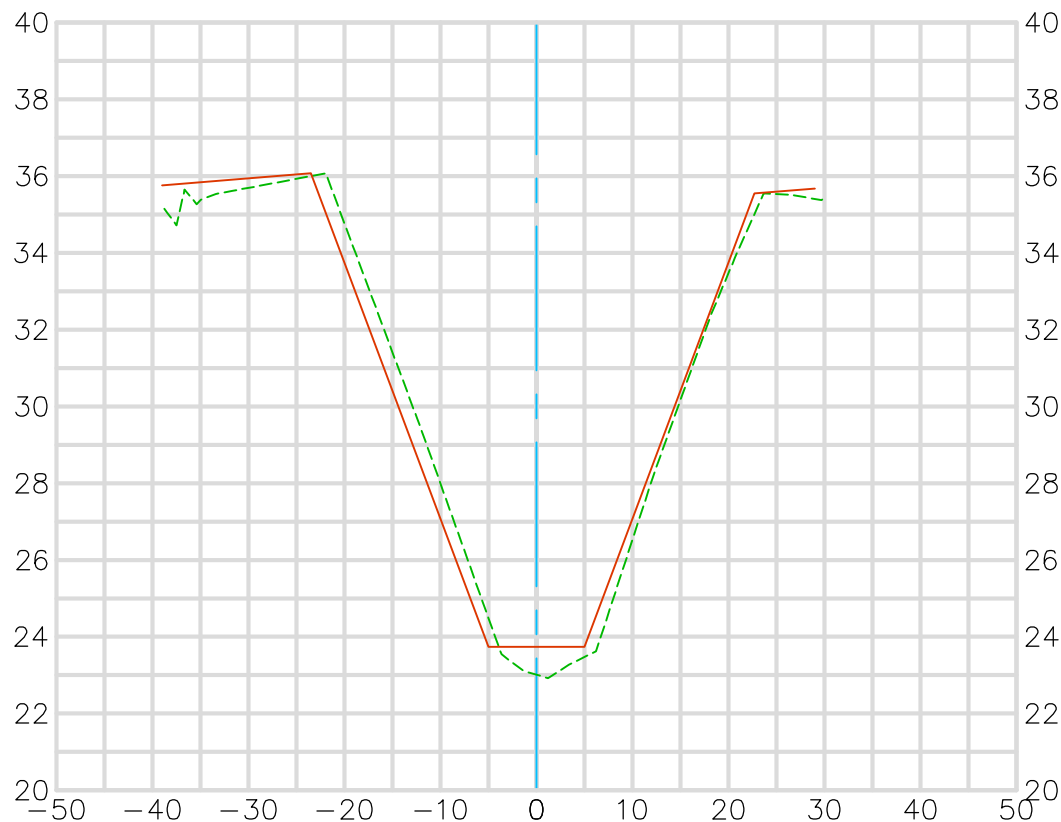

Existing Condition 2018 
Record Plan 1960-1966 
CO6-101-2-A 1960, CO6-101-4-A 1963, CO6-103-1-M 1966
Modified Per Engineer's Directive
Prepared 8/21/19

Horizontal Scale 1" = 20'
Vertical Scale 1" = 5'

OCEAN VIEW CHANNEL (C06)

129+00.00

CL CONSTRUCTION



Existing Condition 2018 ---
 Record Plan 1960-1966 ---
 CO6-101-2-A 1960, CO6-101-4-A 1963, CO6-103-1-M 1966
 Modified Per Engineer's Directive
 Prepared 8/21/19

Horizontal Scale 1" = 20'
 Vertical Scale 1" = 5'

**U.S. Survey
Foot**

OC Public Works/Engineering Services
OC Survey/Field Services
Boundary Analysis & Mapping



OCEAN VIEW CHANNEL (C06)

129+50.00

CL CONSTRUCTION



Existing Condition 2018 ---
Record Plan 1960-1966 ---
CO6-101-2-A 1960, CO6-101-4-A 1963, CO6-103-1-M 1966
Modified Per Engineer's Directive
Prepared 8/21/19

Horizontal Scale 1" = 20'
Vertical Scale 1" = 5'

**U.S. Survey
Foot**


OC Public Works/Engineering Services
OC Survey/Field Services
Boundary Analysis & Mapping



OCEAN VIEW CHANNEL (C06)

130+00.00

CL CONSTRUCTION

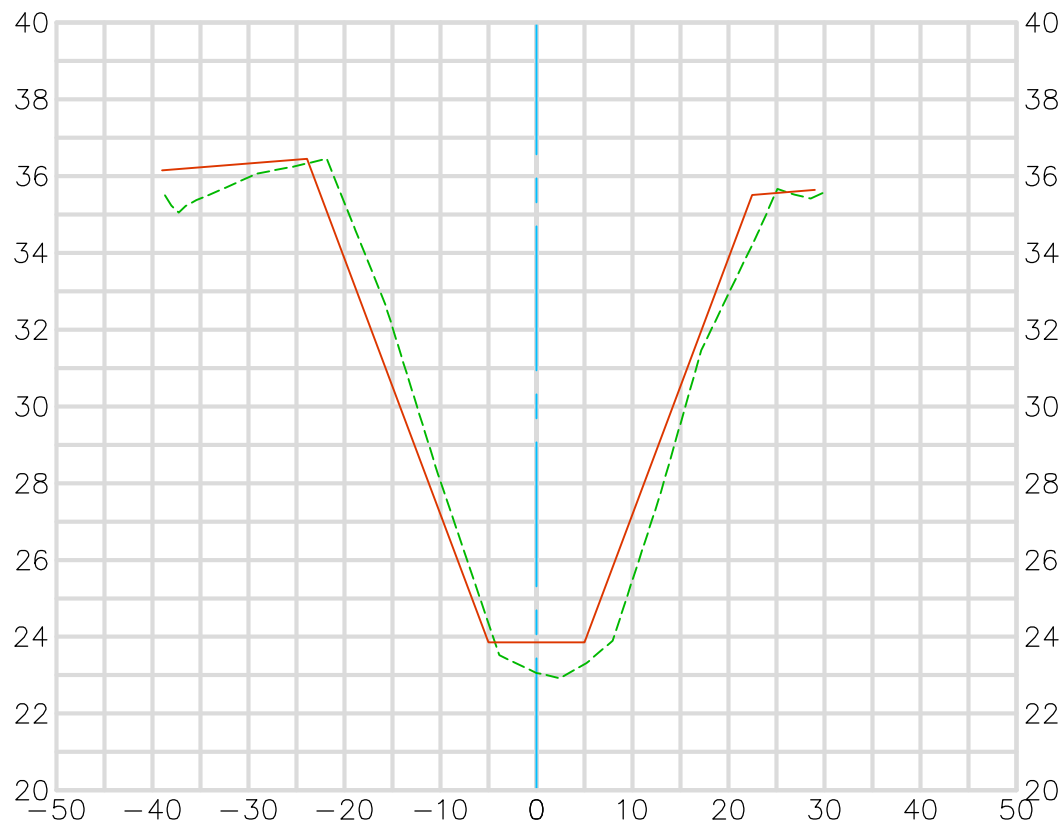

Existing Condition 2018 ---
Record Plan 1960-1966 ---
CO6-101-2-A 1960, CO6-101-4-A 1963, CO6-103-1-M 1966
Modified Per Engineer's Directive
Prepared 8/21/19

Horizontal Scale 1" = 20'
Vertical Scale 1" = 5'

**U.S. Survey
Foot**


OC Public Works/Engineering Services
OC Survey/Field Services
Boundary Analysis & Mapping



OCEAN VIEW CHANNEL (C06)

130+50.00

CL CONSTRUCTION

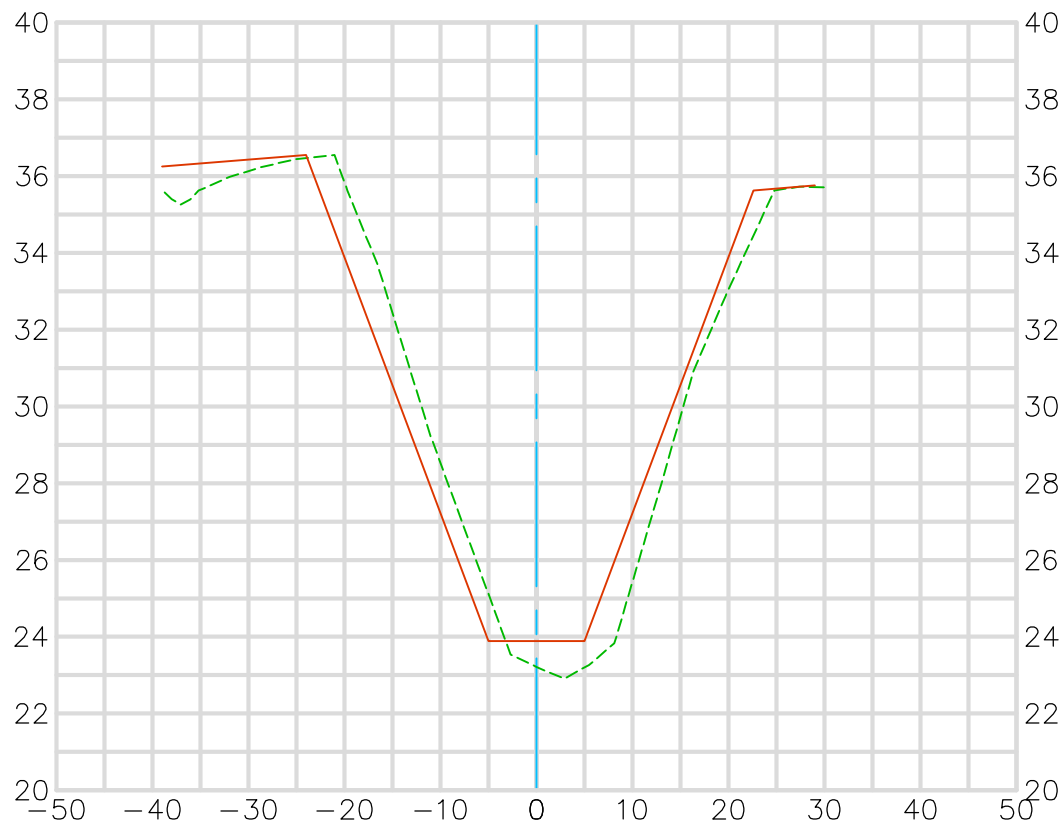


Existing Condition 2018 ---
Record Plan 1960-1966 ---
CO6-101-2-A 1960, CO6-101-4-A 1963, CO6-103-1-M 1966
Modified Per Engineer's Directive
Prepared 8/21/19

Horizontal Scale 1" = 20'
Vertical Scale 1" = 5'

OCEAN VIEW CHANNEL (C06)

131+00.00

CL CONSTRUCTION

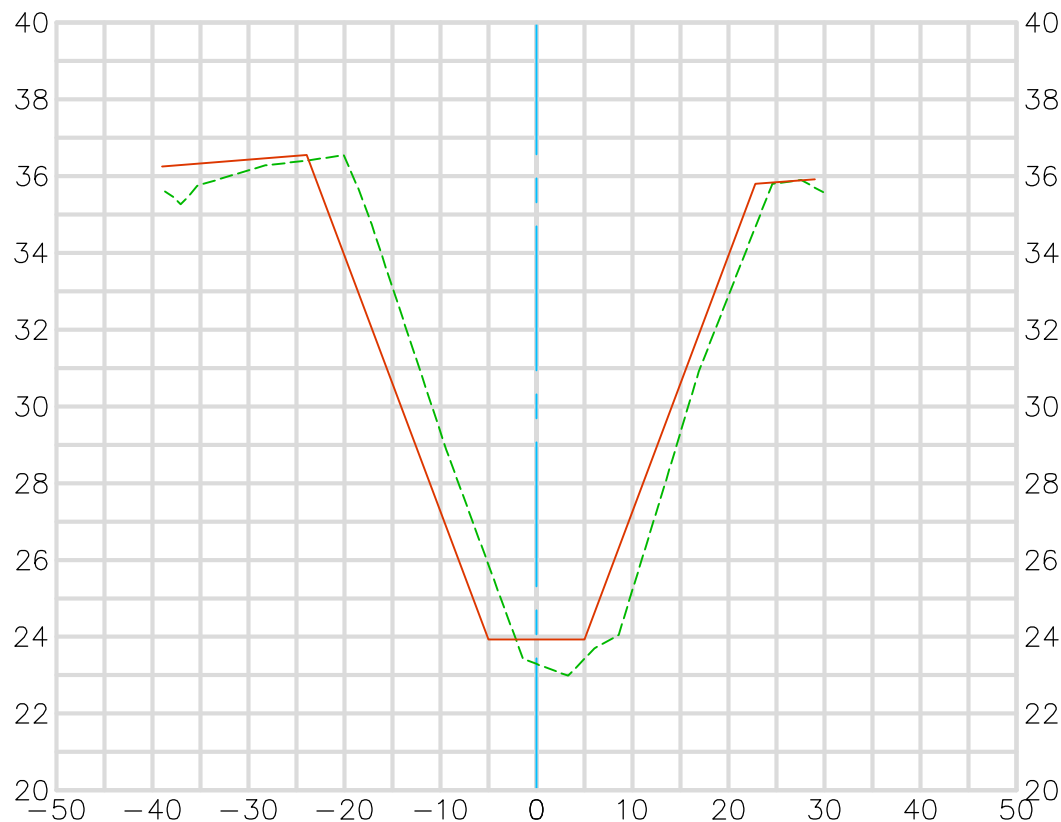

Existing Condition 2018 ---
Record Plan 1960-1966 ---
CO6-101-2-A 1960, CO6-101-4-A 1963, CO6-103-1-M 1966
Modified Per Engineer's Directive
Prepared 8/21/19

Horizontal Scale 1" = 20'
Vertical Scale 1" = 5'

U.S. Survey Foot


OC Public Works/Engineering Services
OC Survey/Field Services
Boundary Analysis & Mapping



OCEAN VIEW CHANNEL (C06)

131+50.00

CL CONSTRUCTION

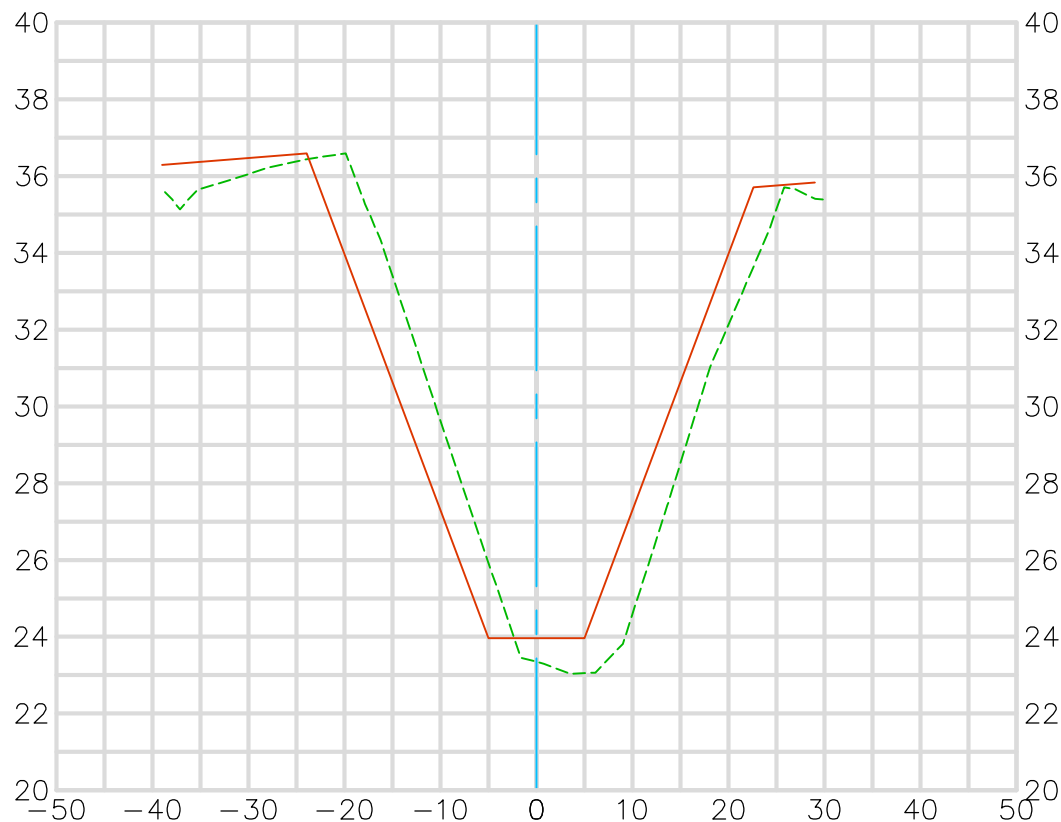

Existing Condition 2018 ---
Record Plan 1960-1966 ---
CO6-101-2-A 1960, CO6-101-4-A 1963, CO6-103-1-M 1966
Modified Per Engineer's Directive
Prepared 8/21/19

Horizontal Scale 1" = 20'
Vertical Scale 1" = 5'

**U.S. Survey
Foot**

OC Public Works/Engineering Services
OC Survey/Field Services
Boundary Analysis & Mapping



OCEAN VIEW CHANNEL (C06)

132+00.00

CL CONSTRUCTION




Existing Condition 2018 
Record Plan 1960-1966 
CO6-101-2-A 1960, CO6-101-4-A 1963, CO6-103-1-M 1966
Modified Per Engineer's Directive
Prepared 8/21/19

Horizontal Scale 1" = 20'
Vertical Scale 1" = 5'

OCEAN VIEW CHANNEL (C06)

132+50.00

CL CONSTRUCTION

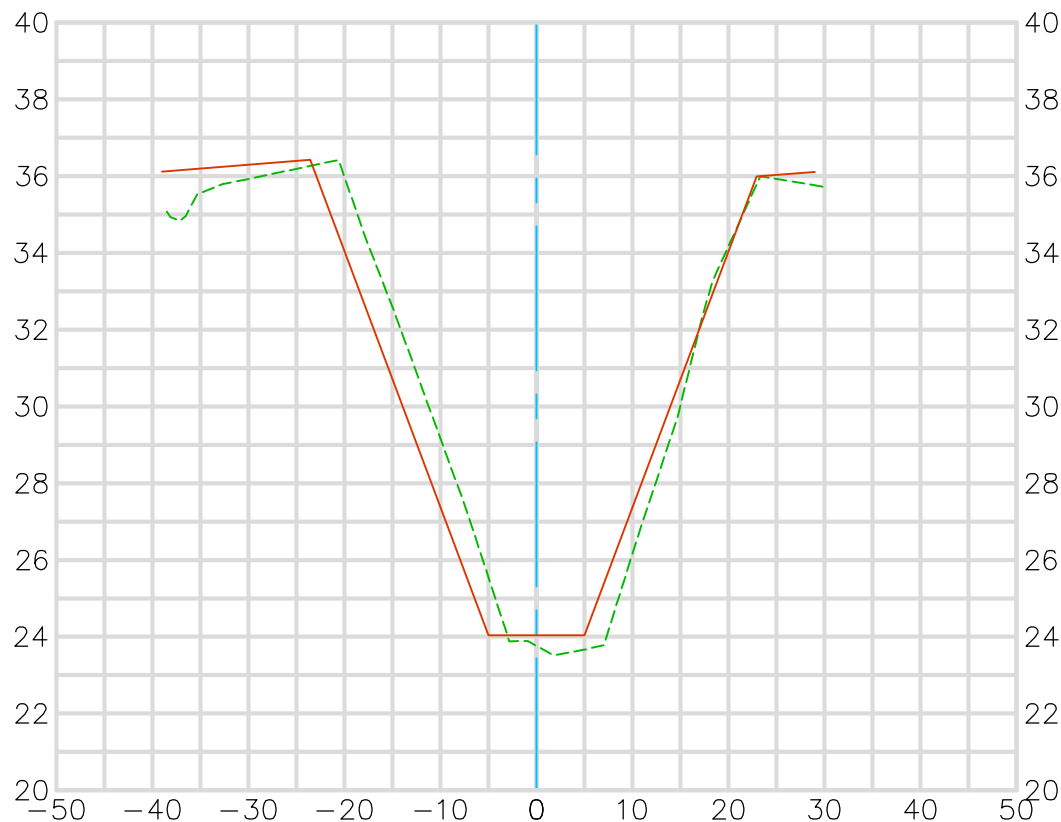

Existing Condition 2018 ---
 Record Plan 1960-1966 ---
 CO6-101-2-A 1960, CO6-101-4-A 1963, CO6-103-1-M 1966
 Modified Per Engineer's Directive
 Prepared 8/21/19

Horizontal Scale 1" = 20'
 Vertical Scale 1" = 5'

**U.S. Survey
Foot**


OC Public Works/Engineering Services
OC Survey/Field Services
Boundary Analysis & Mapping



OCEAN VIEW CHANNEL (C06)


133+00.00

CL CONSTRUCTION

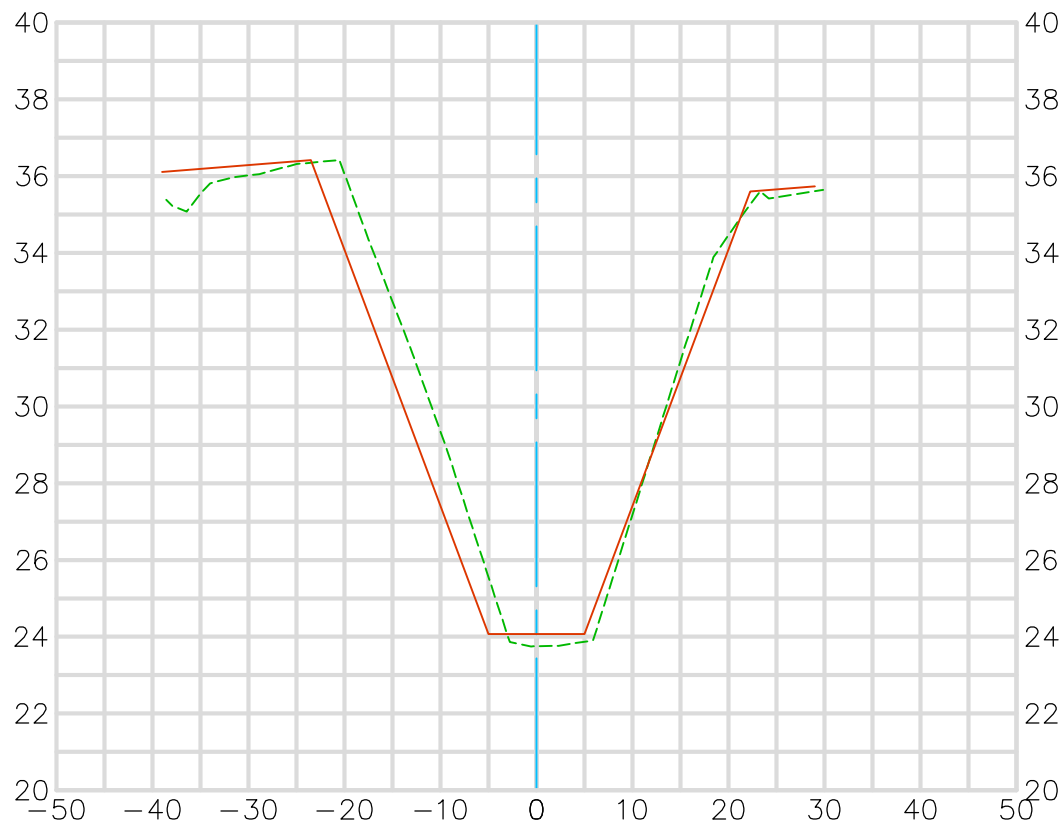

Existing Condition 2018 
Record Plan 1960-1966 
CO6-101-2-A 1960, CO6-101-4-A 1963, CO6-103-1-M 1966
Modified Per Engineer's Directive
Prepared 8/21/19


Horizontal Scale 1" = 20'
Vertical Scale 1" = 5'

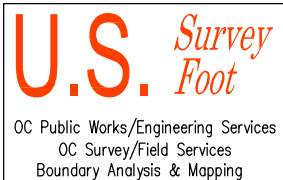

OCEAN VIEW CHANNEL (C06)

133+50.00

CL CONSTRUCTION

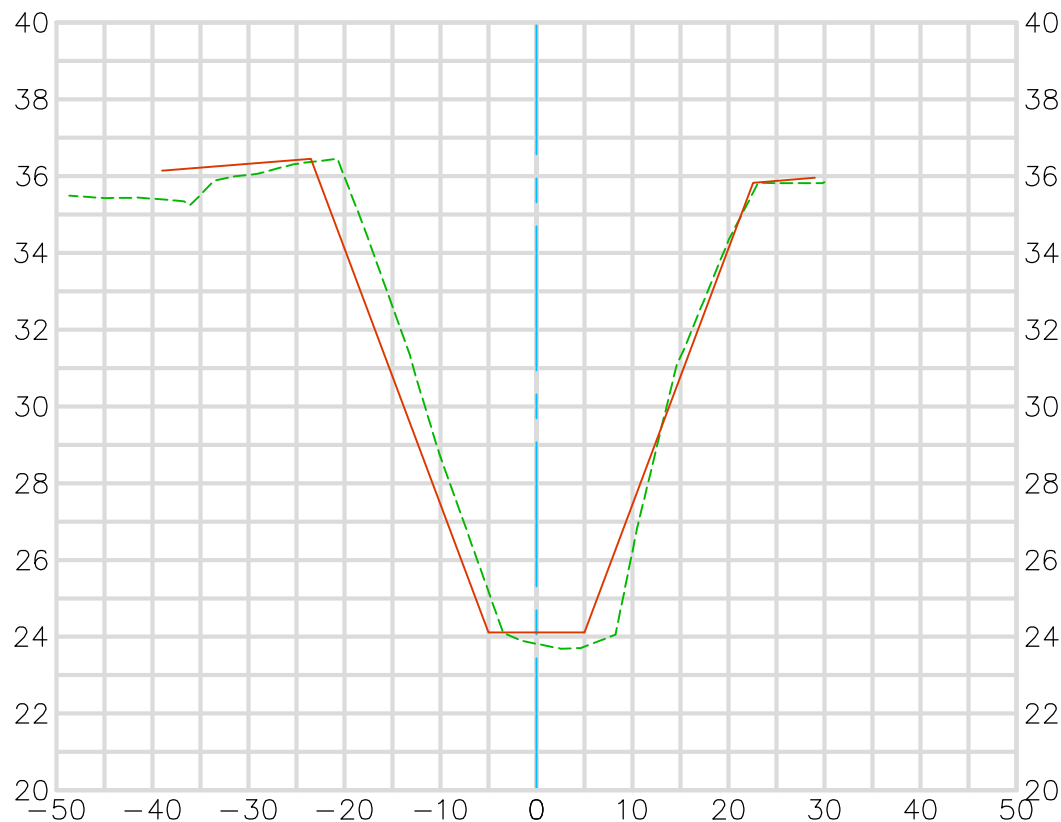

Existing Condition 2018 
Record Plan 1960-1966 
CO6-101-2-A 1960, CO6-101-4-A 1963, CO6-103-1-M 1966
Modified Per Engineer's Directive
Prepared 8/21/19

Horizontal Scale 1" = 20'
Vertical Scale 1" = 5'

**U.S. Survey
Foot**


OC Public Works/Engineering Services
OC Survey/Field Services
Boundary Analysis & Mapping



OCEAN VIEW CHANNEL (C06)

134+00.00

CL CONSTRUCTION

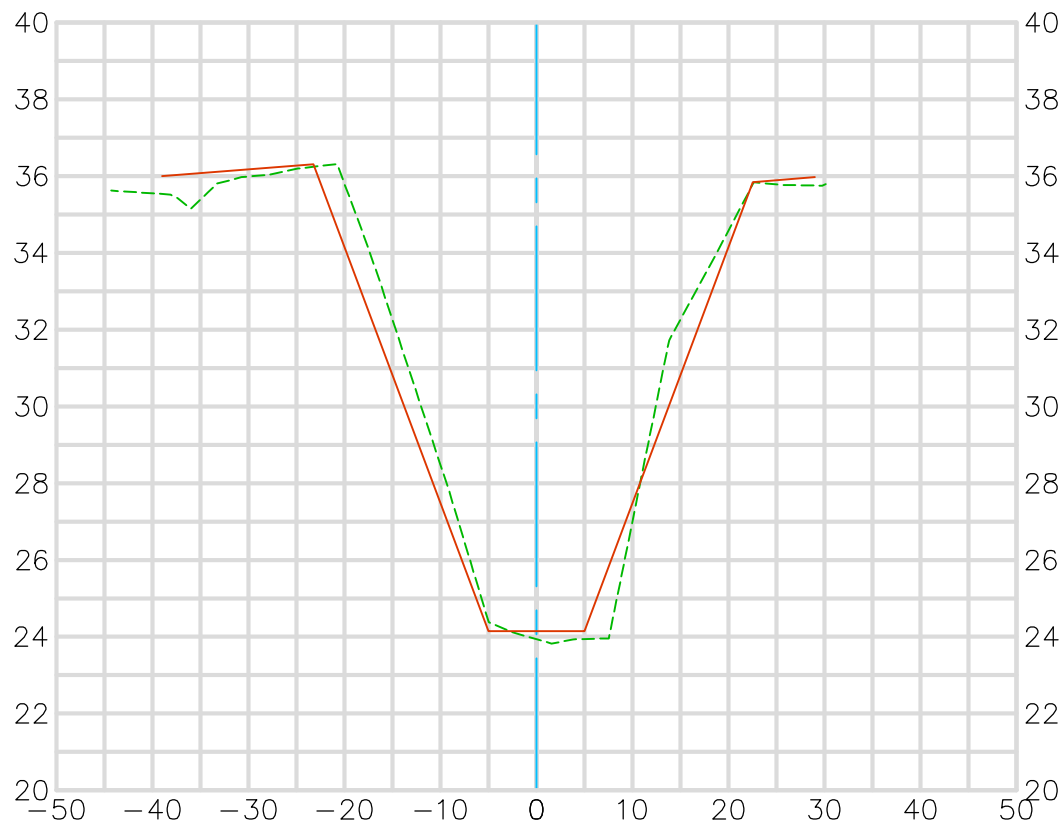

Existing Condition 2018 ---
Record Plan 1960-1966 ---
CO6-101-2-A 1960, CO6-101-4-A 1963, CO6-103-1-M 1966
Modified Per Engineer's Directive
Prepared 8/21/19

Horizontal Scale 1" = 20'
Vertical Scale 1" = 5'

U.S. Survey Foot


OC Public Works/Engineering Services
OC Survey/Field Services
Boundary Analysis & Mapping



OCEAN VIEW CHANNEL (C06)

134+50.00

CL CONSTRUCTION

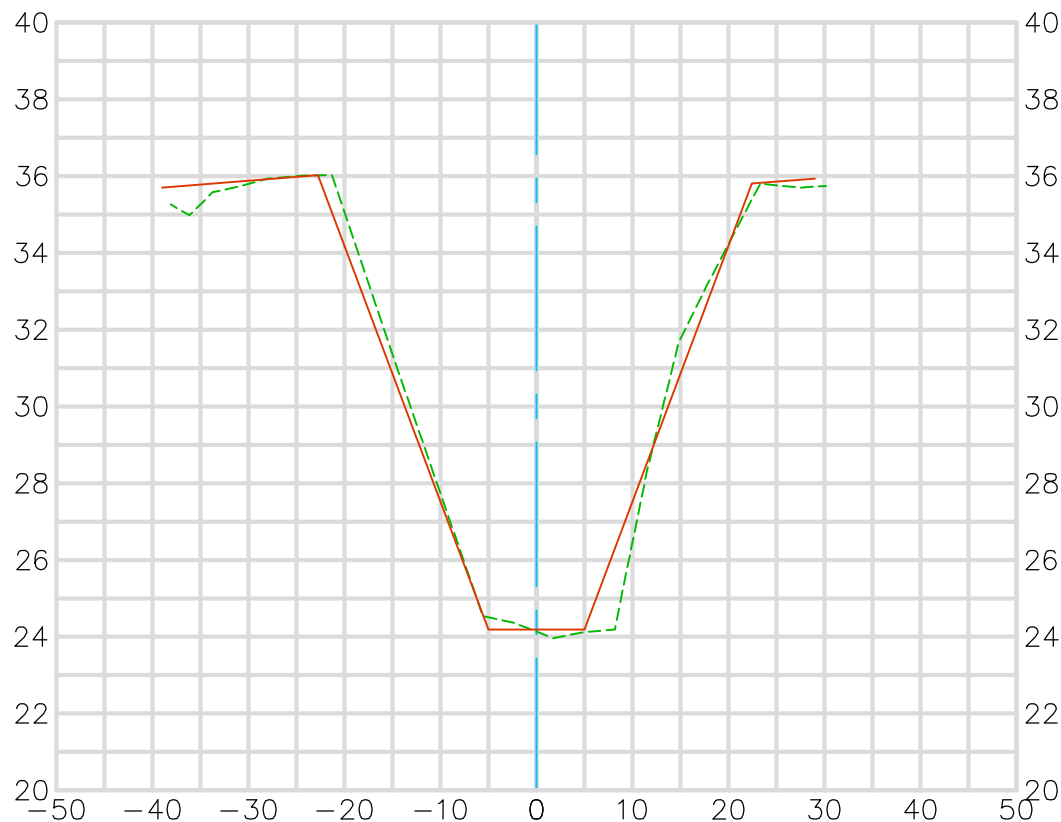

Existing Condition 2018 ---
Record Plan 1960-1966 ---
CO6-101-2-A 1960, CO6-101-4-A 1963, CO6-103-1-M 1966
Modified Per Engineer's Directive
Prepared 8/21/19


Horizontal Scale 1" = 20'
Vertical Scale 1" = 5'

U.S. Survey Foot

OC Public Works/Engineering Services
OC Survey/Field Services
Boundary Analysis & Mapping



OCEAN VIEW CHANNEL (C06) 135+00.00 CL CONSTRUCTION

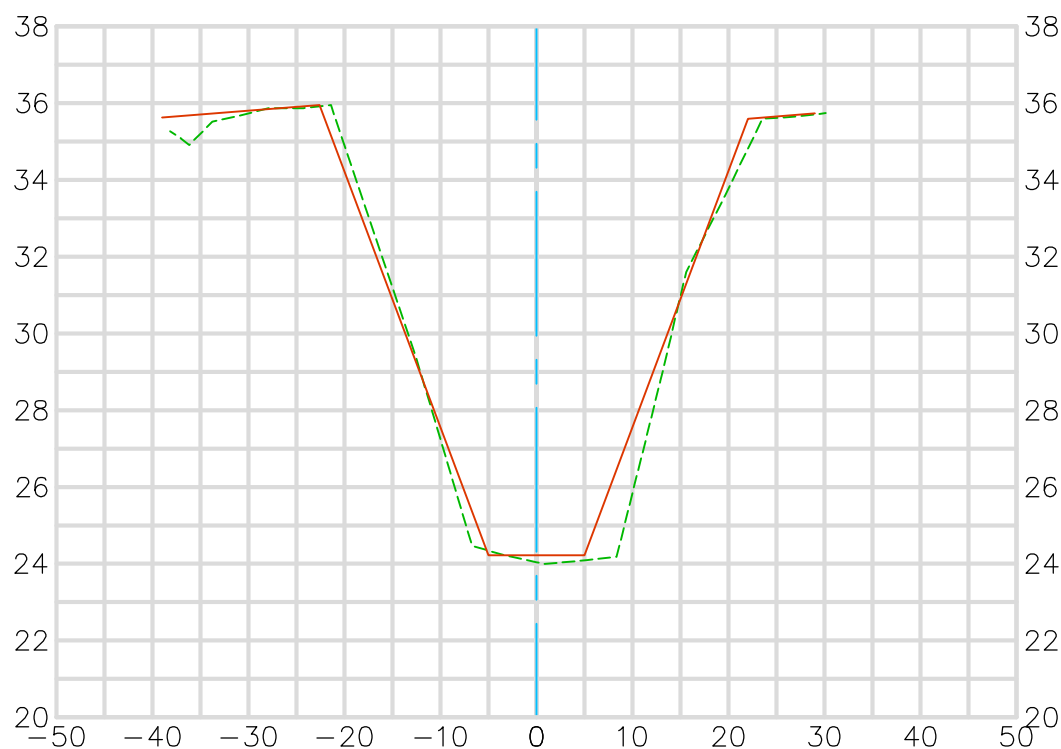

Existing Condition 2018 ---
Record Plan 1960-1966 ---
CO6-101-2-A 1960, CO6-101-4-A 1963, CO6-103-1-M 1966
Modified Per Engineer's Directive
Prepared 8/21/19

Horizontal Scale 1" = 20'
Vertical Scale 1" = 5'

**U.S. Survey
Foot**


OC Public Works/Engineering Services
OC Survey/Field Services
Boundary Analysis & Mapping



OCEAN VIEW CHANNEL (C06)

135+50.00

CL CONSTRUCTION

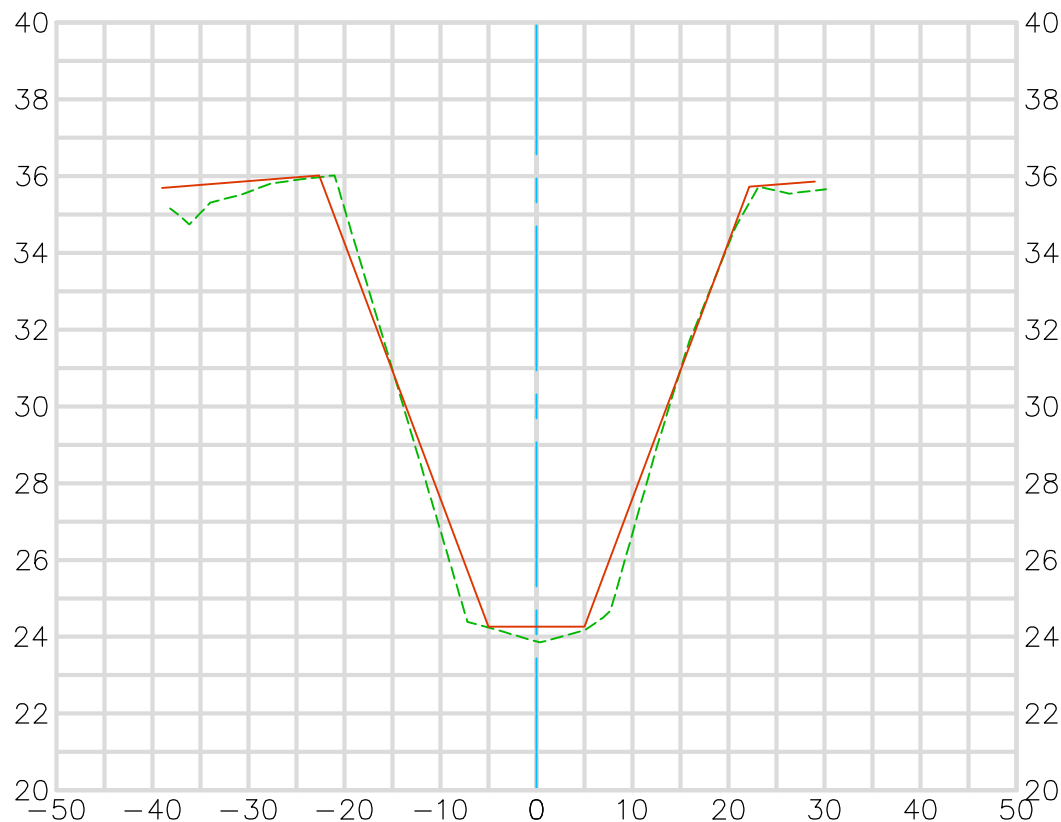

Existing Condition 2018 ---
Record Plan 1960-1966 ---
CO6-101-2-A 1960, CO6-101-4-A 1963, CO6-103-1-M 1966
Modified Per Engineer's Directive
Prepared 8/21/19


Horizontal Scale 1" = 20'
Vertical Scale 1" = 5'

**U.S. Survey
Foot**

OC Public Works/Engineering Services
OC Survey/Field Services
Boundary Analysis & Mapping



OCEAN VIEW CHANNEL (C06) 136+00.00 CL CONSTRUCTION

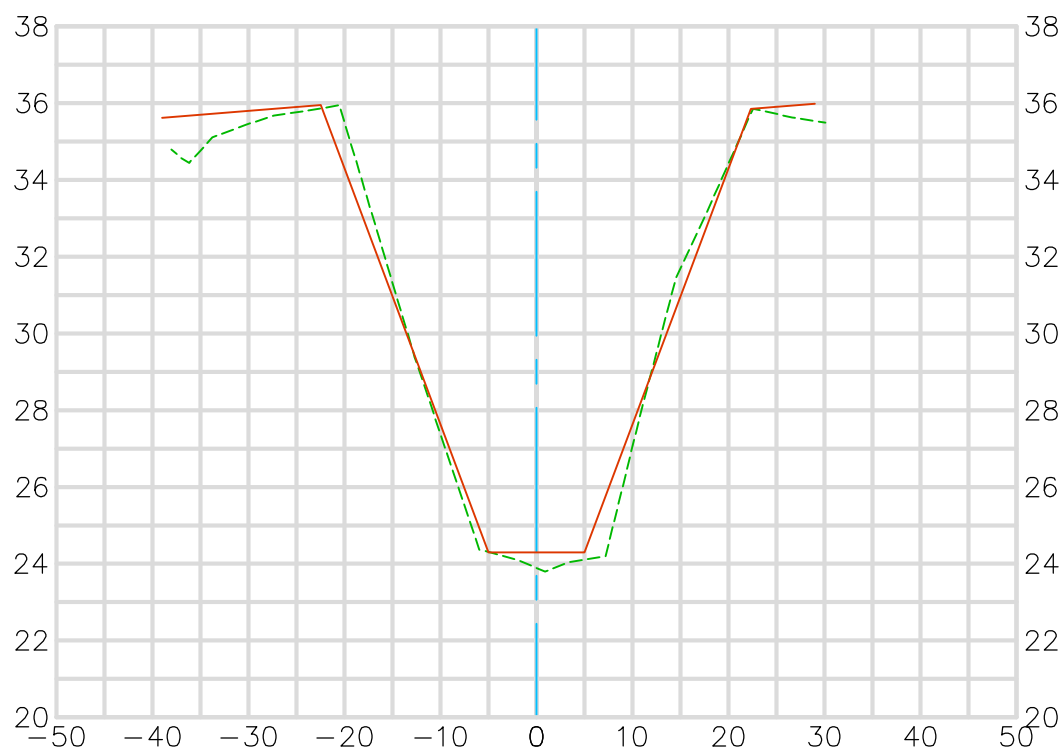

Existing Condition 2018 ---
Record Plan 1960-1966 ---
CO6-101-2-A 1960, CO6-101-4-A 1963, CO6-103-1-M 1966
Modified Per Engineer's Directive
Prepared 8/21/19


Horizontal Scale 1" = 20'
Vertical Scale 1" = 5'

U.S. Survey Foot

OC Public Works/Engineering Services
OC Survey/Field Services
Boundary Analysis & Mapping



OCEAN VIEW CHANNEL (C06) 136+50.00 CL CONSTRUCTION

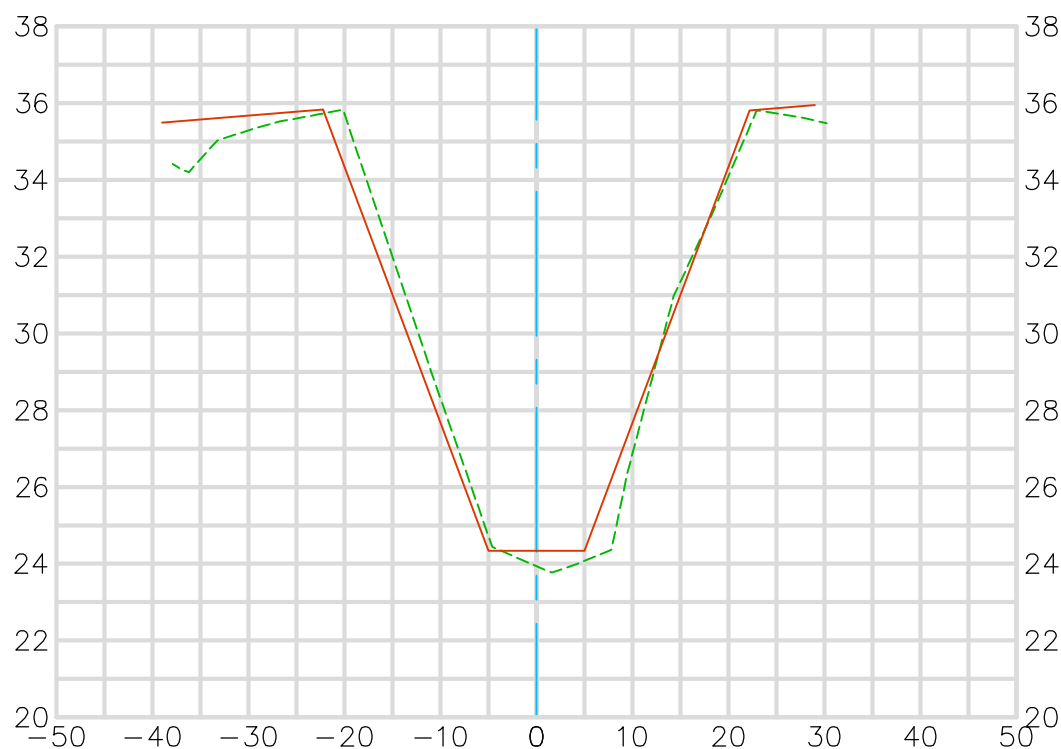

Existing Condition 2018 ---
Record Plan 1960-1966 ---
CO6-101-2-A 1960, CO6-101-4-A 1963, CO6-103-1-M 1966
Modified Per Engineer's Directive
Prepared 8/21/19


Horizontal Scale 1" = 20'
Vertical Scale 1" = 5'

**U.S. Survey
Foot**

OC Public Works/Engineering Services
OC Survey/Field Services
Boundary Analysis & Mapping



OCEAN VIEW CHANNEL (C06) 137+00.00 CL CONSTRUCTION

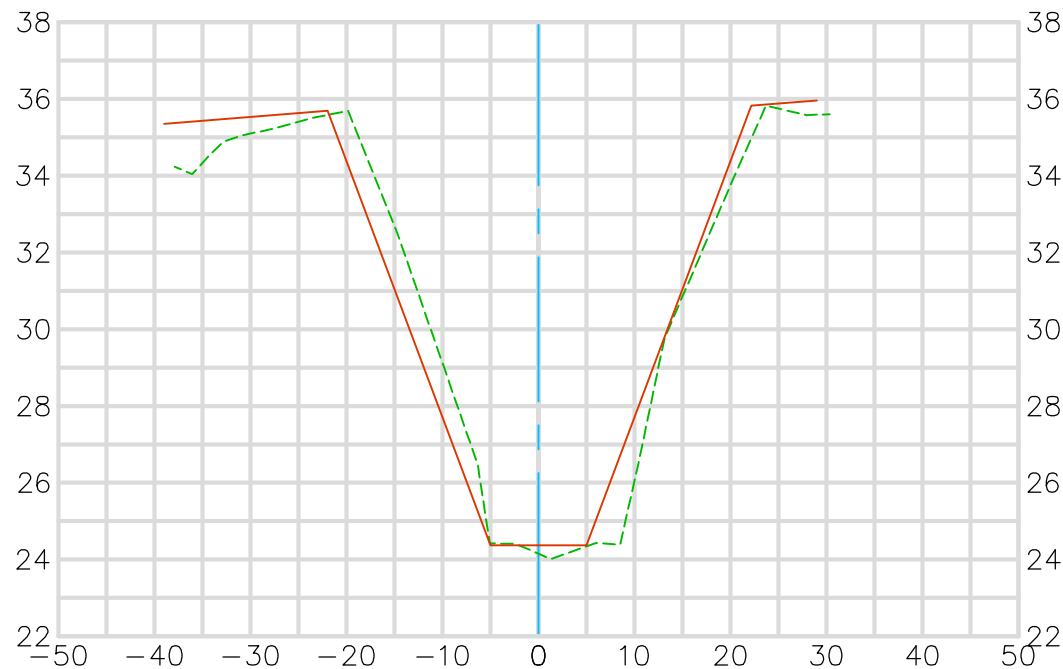

Existing Condition 2018 
Record Plan 1960-1966 
CO6-101-2-A 1960, CO6-101-4-A 1963, CO6-103-1-M 1966
Modified Per Engineer's Directive
Prepared 8/21/19


Horizontal Scale 1" = 20'
Vertical Scale 1" = 5'

**U.S. Survey
Foot**

OC Public Works/Engineering Services
OC Survey/Field Services
Boundary Analysis & Mapping



OCEAN VIEW CHANNEL (C06) 137+50.00 CL CONSTRUCTION

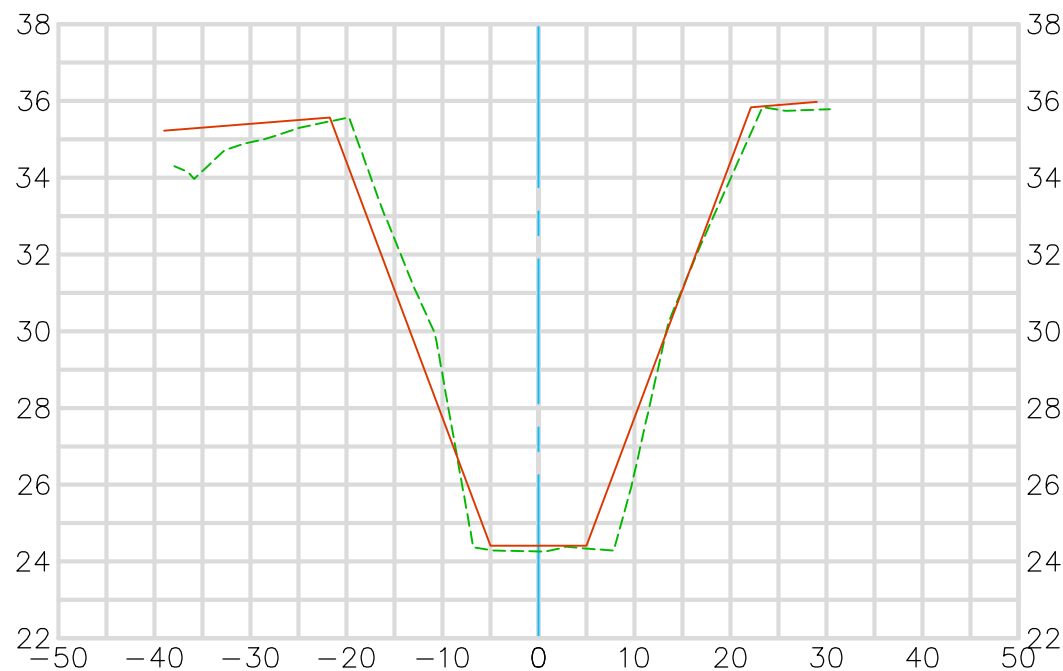

Existing Condition 2018 ---
Record Plan 1960-1966 ---
CO6-101-2-A 1960, CO6-101-4-A 1963, CO6-103-1-M 1966
Modified Per Engineer's Directive
Prepared 8/21/19


Horizontal Scale 1" = 20'
Vertical Scale 1" = 5'

U.S. Survey Foot

OC Public Works/Engineering Services
OC Survey/Field Services
Boundary Analysis & Mapping



OCEAN VIEW CHANNEL (C06) 138+00.00 CL CONSTRUCTION

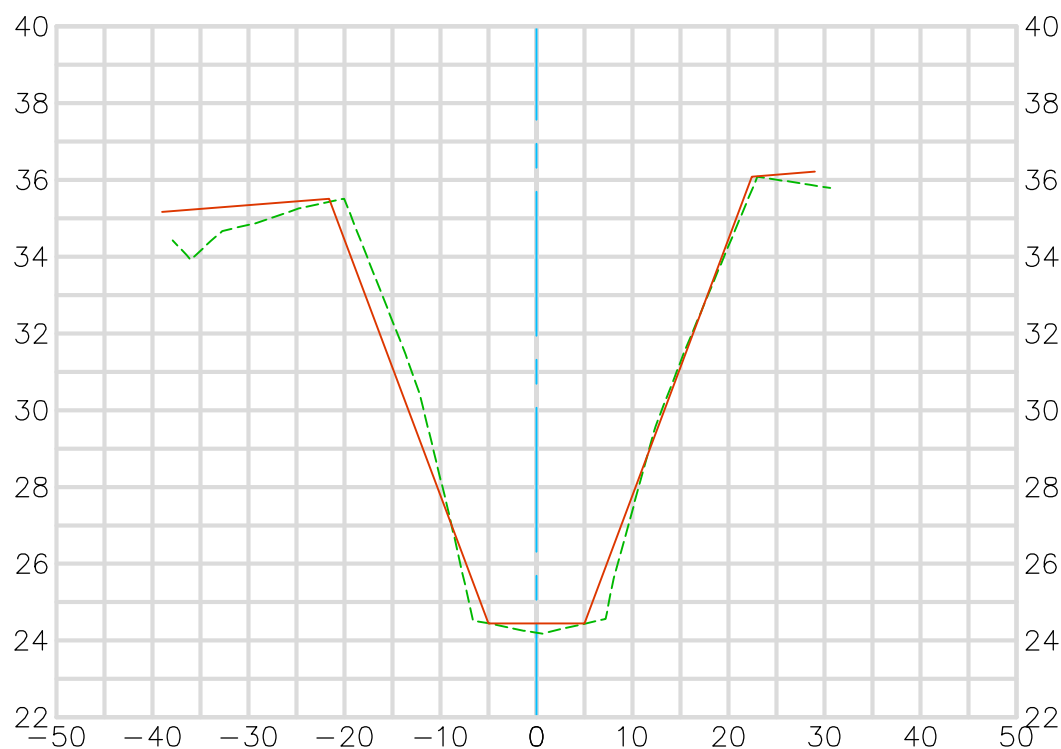

Existing Condition 2018 ---
Record Plan 1960-1966 ---
CO6-101-2-A 1960, CO6-101-4-A 1963, CO6-103-1-M 1966
Modified Per Engineer's Directive
Prepared 8/21/19


Horizontal Scale 1" = 20'
Vertical Scale 1" = 5'

U.S. Survey Foot

OC Public Works/Engineering Services
OC Survey/Field Services
Boundary Analysis & Mapping



OCEAN VIEW CHANNEL (C06) 138+50.00 CL CONSTRUCTION

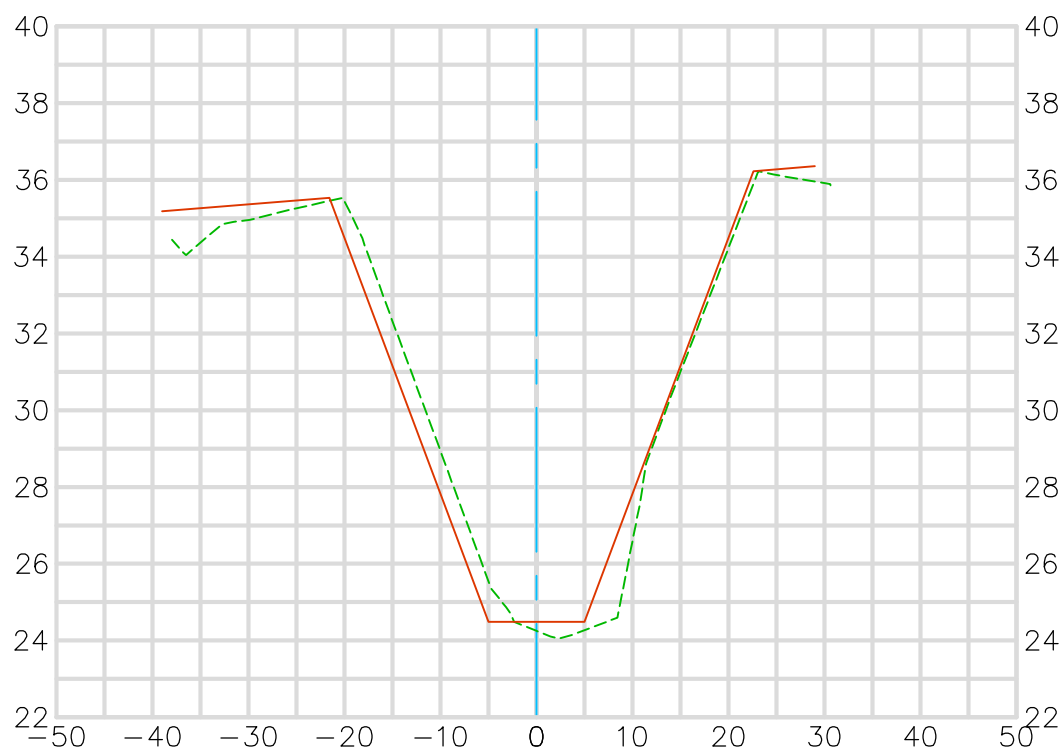

Existing Condition 2018 ---
Record Plan 1960-1966 ---
CO6-101-2-A 1960, CO6-101-4-A 1963, CO6-103-1-M 1966
Modified Per Engineer's Directive
Prepared 8/21/19


Horizontal Scale 1" = 20'
Vertical Scale 1" = 5'

**U.S. Survey
Foot**

OC Public Works/Engineering Services
OC Survey/Field Services
Boundary Analysis & Mapping



OCEAN VIEW CHANNEL (C06) 139+00.00 CL CONSTRUCTION

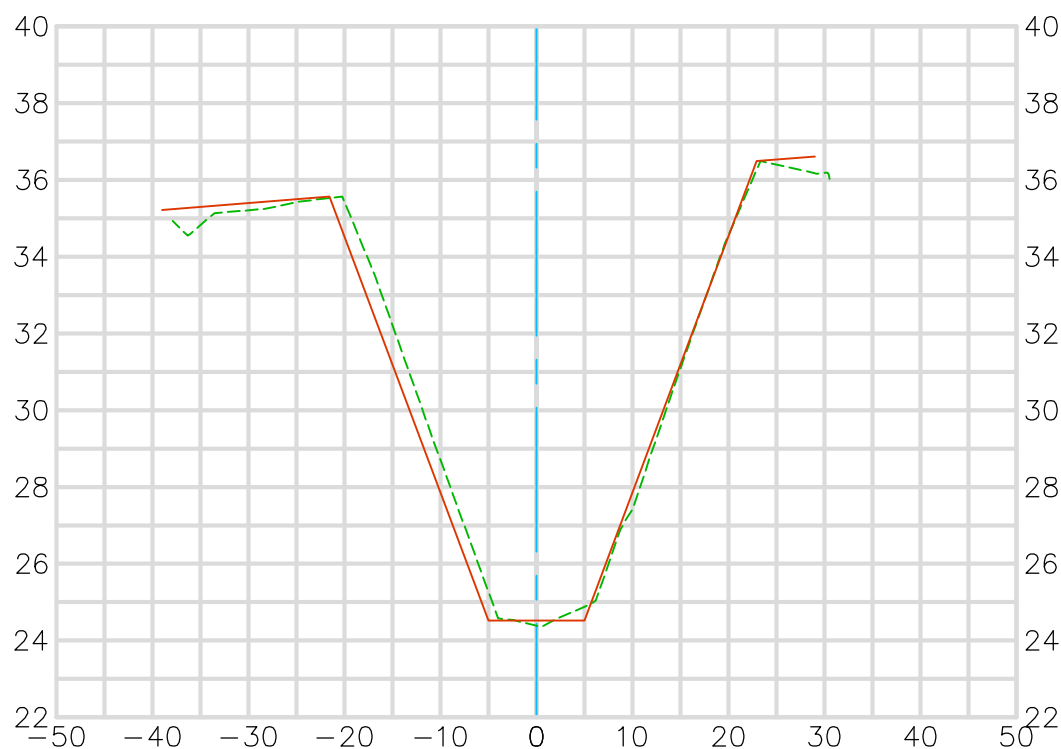

Existing Condition 2018 
Record Plan 1960-1966 
CO6-101-2-A 1960, CO6-101-4-A 1963, CO6-103-1-M 1966
Modified Per Engineer's Directive
Prepared 8/21/19

Horizontal Scale 1" = 20'
Vertical Scale 1" = 5'

U.S. Survey Foot


OC Public Works/Engineering Services
OC Survey/Field Services
Boundary Analysis & Mapping



OCEAN VIEW CHANNEL (C06)

139+48.32

CL CONSTRUCTION

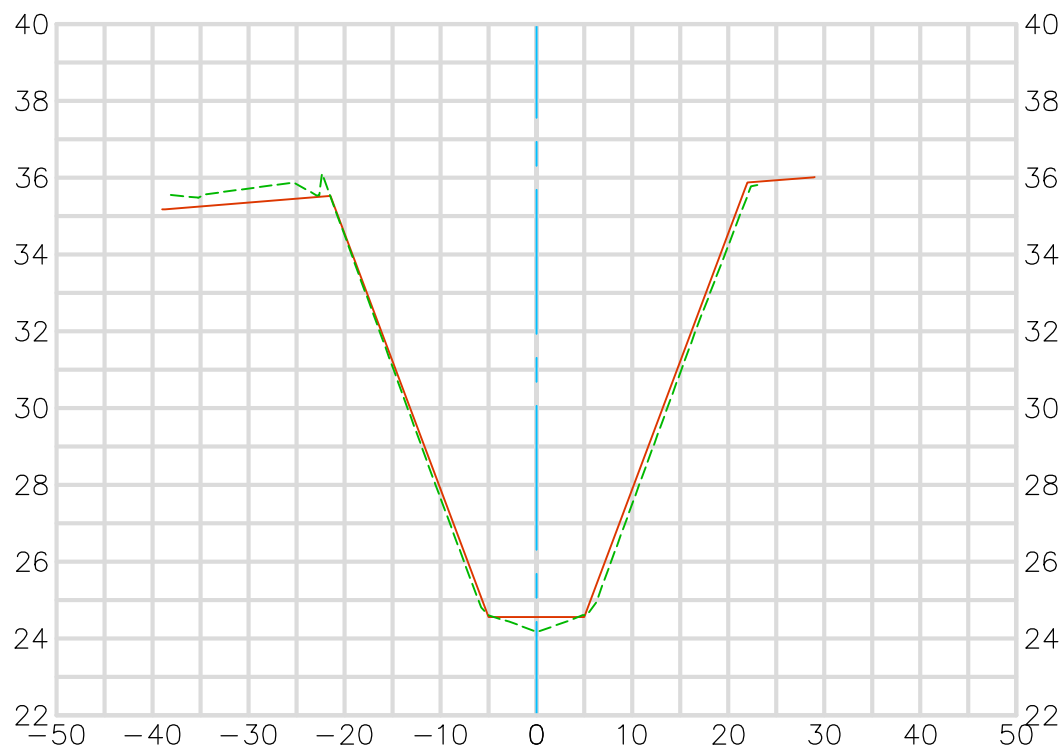

Existing Condition 2018 ---
Record Plan 1960-1966 ---
CO6-101-2-A 1960, CO6-101-4-A 1963, CO6-103-1-M 1966
Modified Per Engineer's Directive
Prepared 8/21/19

Horizontal Scale 1" = 20'
Vertical Scale 1" = 5'