


**U.S. Survey
Foot**

OC Public Works/Engineering Services
OC Survey/Field Services
Boundary Analysis & Mapping



OCEAN VIEW CHANNEL (C06) 194+56.81 CL CONSTRUCTION

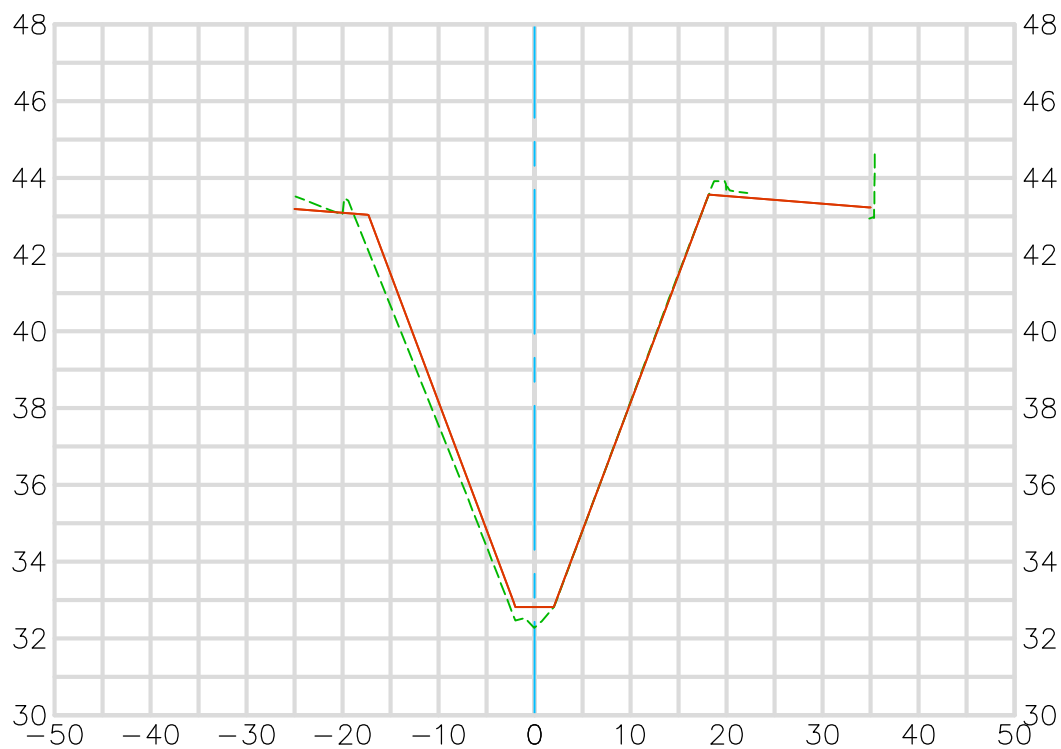

Existing Condition 2018
Record Plan 1960-1966
C06-101-2-A 1960, C06-101-4-A 1963, C06-103-1-M 1966
Modified Per Engineer's Directive
Prepared 8/21/19


Horizontal Scale 1" = 20'
Vertical Scale 1" = 5'

U.S. Survey Foot

OC Public Works/Engineering Services
OC Survey/Field Services
Boundary Analysis & Mapping



OCEAN VIEW CHANNEL (C06) 195+00.00 CL CONSTRUCTION

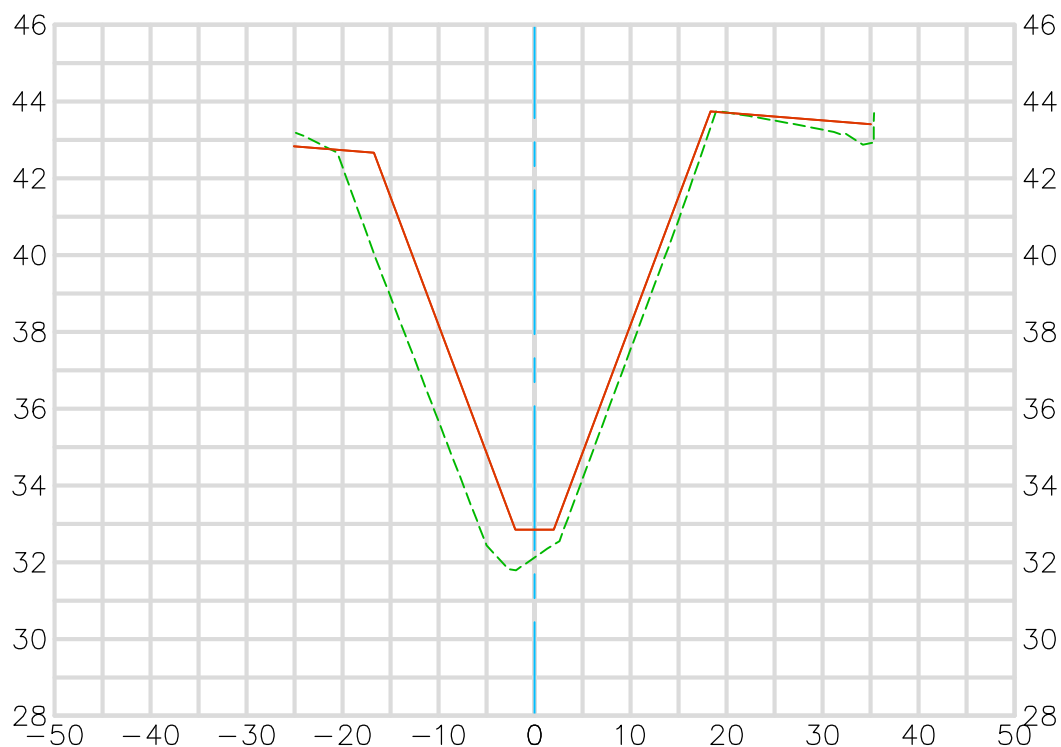

Existing Condition 2018

Record Plan 1960-1966


C06-101-2-A 1960, C06-101-4-A 1963, C06-103-1-M 1966

Modified Per Engineer's Directive

Prepared 8/21/19

Horizontal Scale 1" = 20'


Vertical Scale 1" = 5'

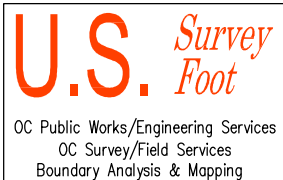

OCEAN VIEW CHANNEL (C06)

195+50.00

CL CONSTRUCTION

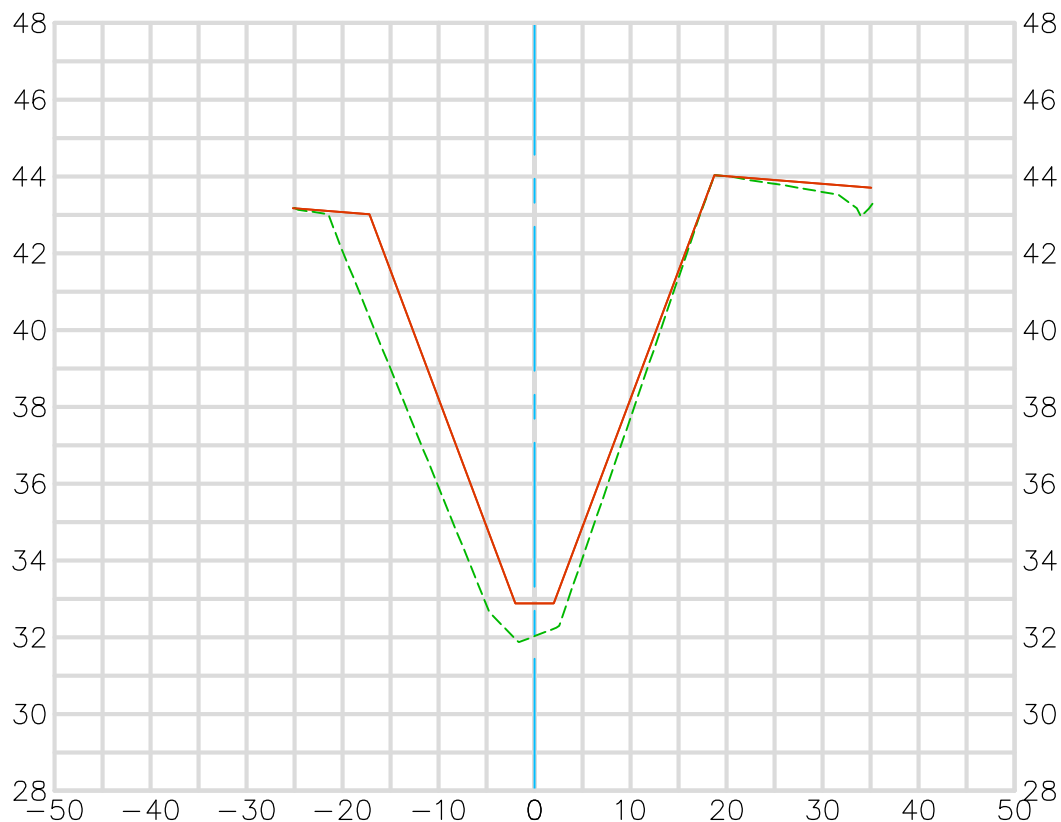

Existing Condition 2018
Record Plan 1960-1966
C06-101-2-A 1960, C06-101-4-A 1963, C06-103-1-M 1966
Modified Per Engineer's Directive
Prepared 8/21/19

Horizontal Scale 1" = 20'
Vertical Scale 1" = 5'

**U.S. Survey
Foot**


OC Public Works/Engineering Services
OC Survey/Field Services
Boundary Analysis & Mapping



OCEAN VIEW CHANNEL (C06)


196+00.00

CL CONSTRUCTION

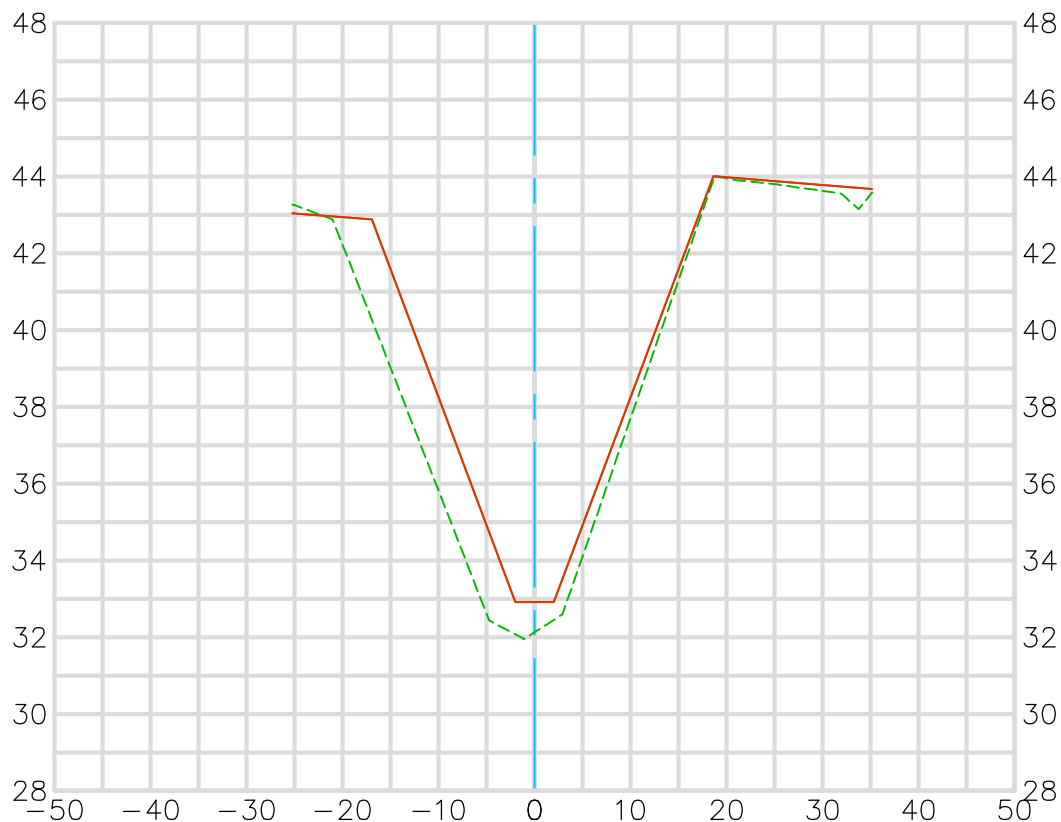

Existing Condition 2018
Record Plan 1960-1966
C06-101-2-A 1960, C06-101-4-A 1963, C06-103-1-M 1966
Modified Per Engineer's Directive
Prepared 8/21/19


Horizontal Scale 1" = 20'
Vertical Scale 1" = 5'

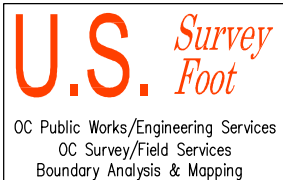

OCEAN VIEW CHANNEL (C06)

196+50.00

CL CONSTRUCTION

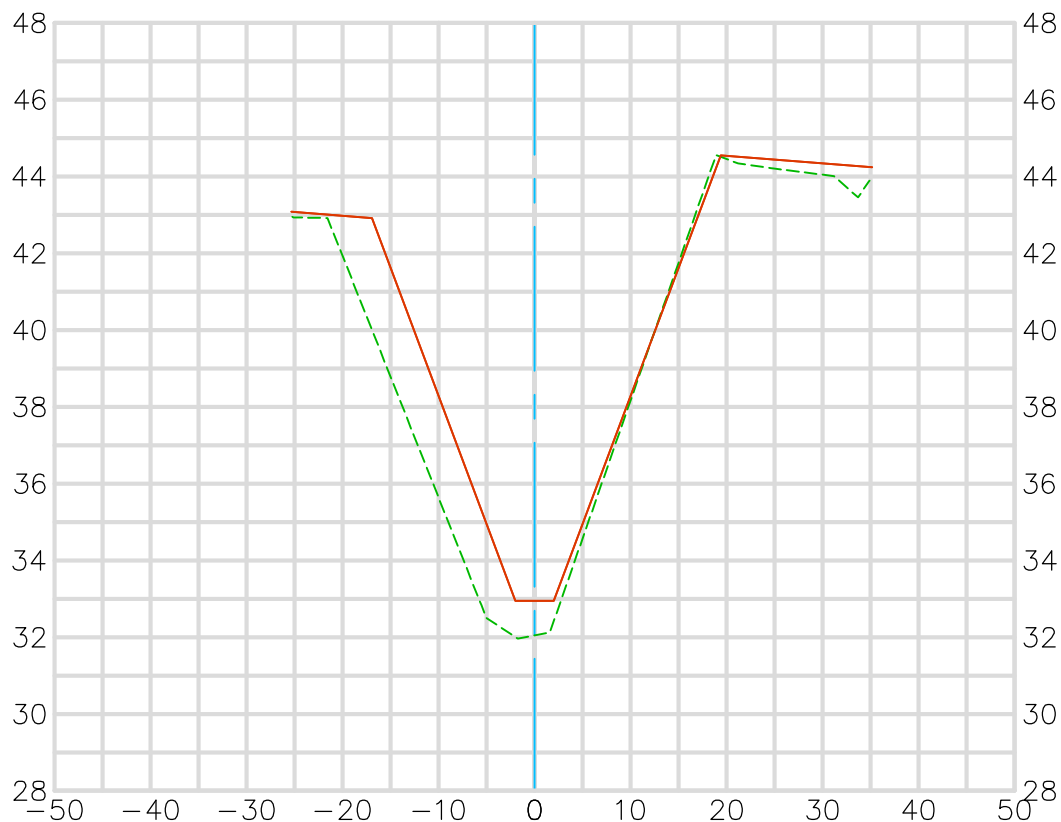

Existing Condition 2018
Record Plan 1960-1966
C06-101-2-A 1960, C06-101-4-A 1963, C06-103-1-M 1966
Modified Per Engineer's Directive
Prepared 8/21/19

Horizontal Scale 1" = 20'
Vertical Scale 1" = 5'

**U.S. Survey
Foot**

OC Public Works/Engineering Services
OC Survey/Field Services
Boundary Analysis & Mapping



OCEAN VIEW CHANNEL (C06)

197+00.00

CL CONSTRUCTION



Existing Condition 2018
Record Plan 1960-1966
C06-101-2-A 1960, C06-101-4-A 1963, C06-103-1-M 1966
Modified Per Engineer's Directive
Prepared 8/21/19


Horizontal Scale 1" = 20'
Vertical Scale 1" = 5'

U.S. Survey Foot

OC Public Works/Engineering Services
OC Survey/Field Services
Boundary Analysis & Mapping



OCEAN VIEW CHANNEL (C06) 197+50.00 CL CONSTRUCTION

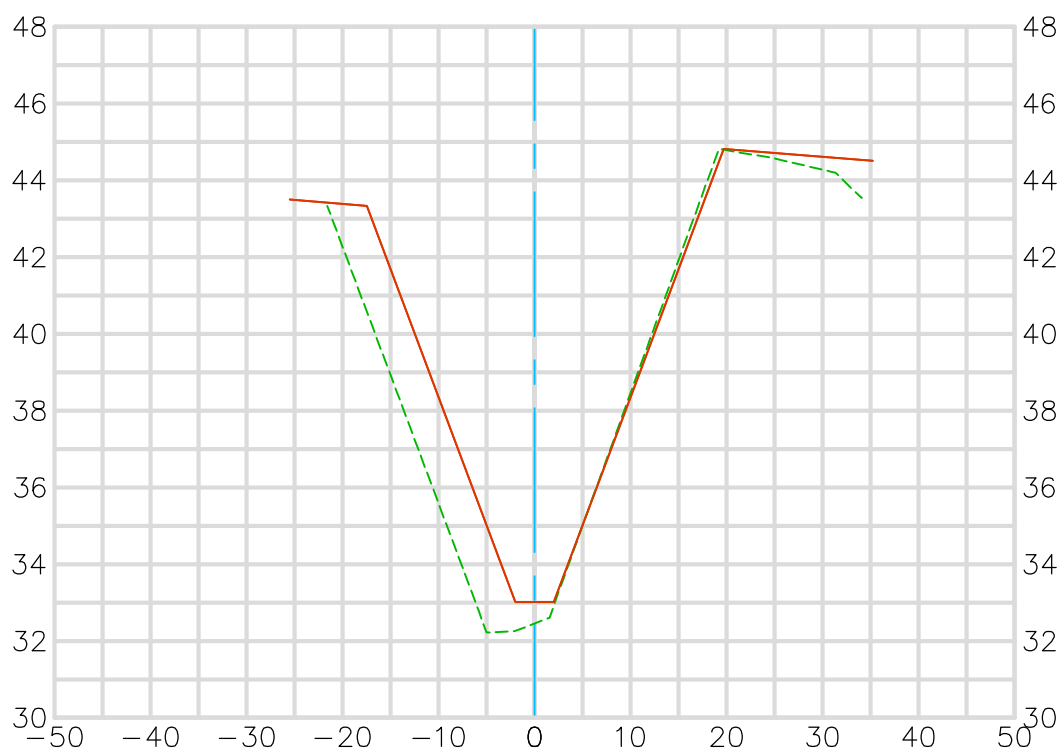

Existing Condition 2018
Record Plan 1960-1966
C06-101-2-A 1960, C06-101-4-A 1963, C06-103-1-M 1966
Modified Per Engineer's Directive
Prepared 8/21/19


Horizontal Scale 1" = 20'
Vertical Scale 1" = 5'

**U.S. Survey
Foot**

OC Public Works/Engineering Services
OC Survey/Field Services
Boundary Analysis & Mapping



OCEAN VIEW CHANNEL (C06) 198+00.00 CL CONSTRUCTION

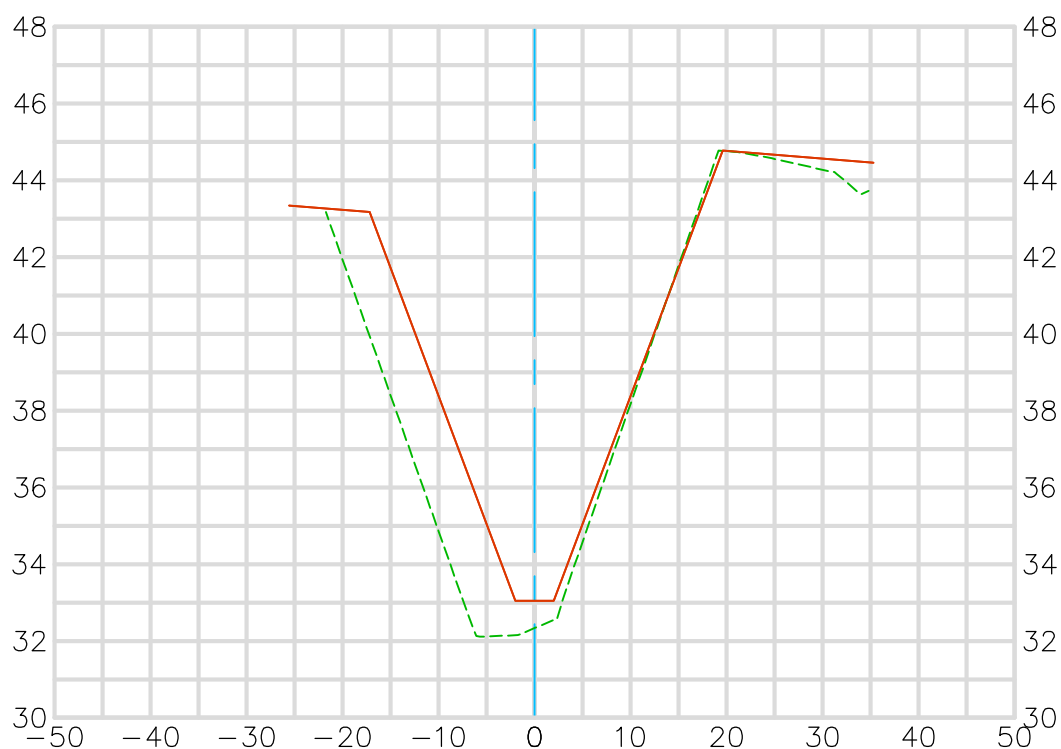

Existing Condition 2018

Record Plan 1960-1966

C06-101-2-A 1960, C06-101-4-A 1963, C06-103-1-M 1966

Modified Per Engineer's Directive

Prepared 8/21/19

Horizontal Scale 1" = 20'


Vertical Scale 1" = 5'

U.S. Survey Foot

OC Public Works/Engineering Services
OC Survey/Field Services
Boundary Analysis & Mapping



OCEAN VIEW CHANNEL (C06) 198+50.00 CL CONSTRUCTION

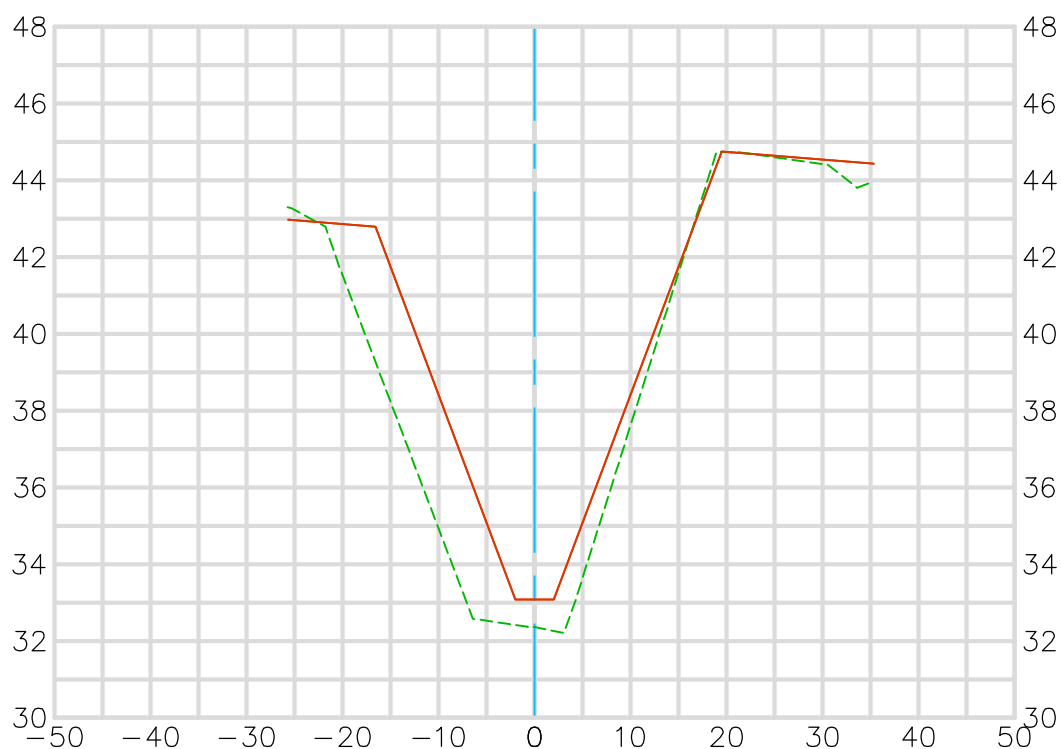

Existing Condition 2018
Record Plan 1960-1966
C06-101-2-A 1960, C06-101-4-A 1963, C06-103-1-M 1966
Modified Per Engineer's Directive
Prepared 8/21/19

Horizontal Scale 1" = 20'
Vertical Scale 1" = 5'

U.S. Survey Foot

OC Public Works/Engineering Services
OC Survey/Field Services
Boundary Analysis & Mapping




OCEAN VIEW CHANNEL (C06) 199+00.00 CL CONSTRUCTION



Existing Condition 2018
Record Plan 1960-1966
C06-101-2-A 1960, C06-101-4-A 1963, C06-103-1-M 1966
Modified Per Engineer's Directive
Prepared 8/21/19

Horizontal Scale 1" = 20'
Vertical Scale 1" = 5'

OCEAN VIEW CHANNEL (C06) 199+50.00 CL CONSTRUCTION

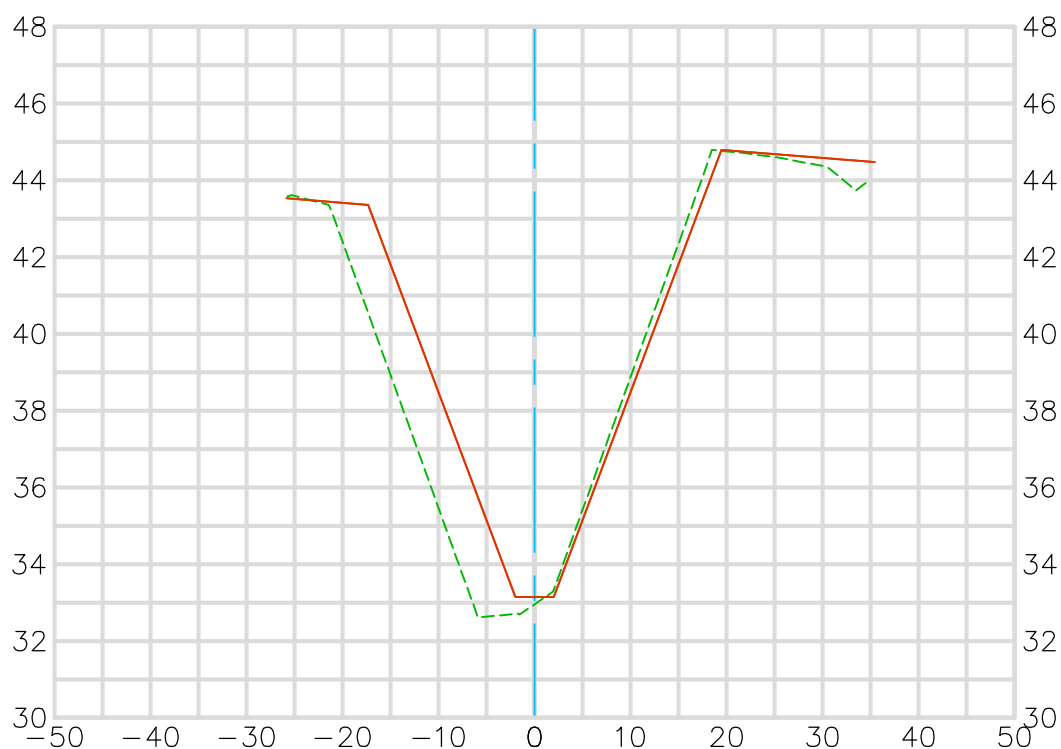

Existing Condition 2018
 Record Plan 1960-1966
 C06-101-2-A 1960, C06-101-4-A 1963, C06-103-1-M 1966
 Modified Per Engineer's Directive
 Prepared 8/21/19


Horizontal Scale 1" = 20'
 Vertical Scale 1" = 5'

U.S. Survey Foot

OC Public Works/Engineering Services
OC Survey/Field Services
Boundary Analysis & Mapping



OCEAN VIEW CHANNEL (C06) 200+00.00 CL CONSTRUCTION

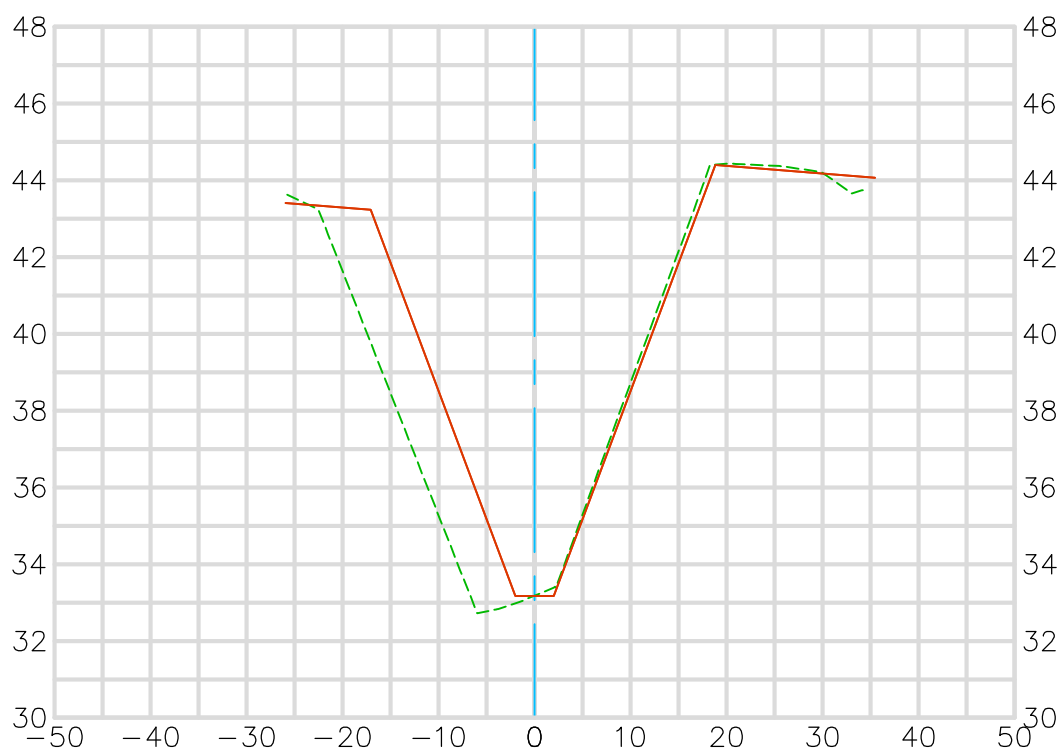

Existing Condition 2018
Record Plan 1960-1966
C06-101-2-A 1960, C06-101-4-A 1963, C06-103-1-M 1966
Modified Per Engineer's Directive
Prepared 8/21/19


Horizontal Scale 1" = 20'
Vertical Scale 1" = 5'

U.S. Survey Foot

OC Public Works/Engineering Services
OC Survey/Field Services
Boundary Analysis & Mapping



OCEAN VIEW CHANNEL (C06) 200+50.00 CL CONSTRUCTION

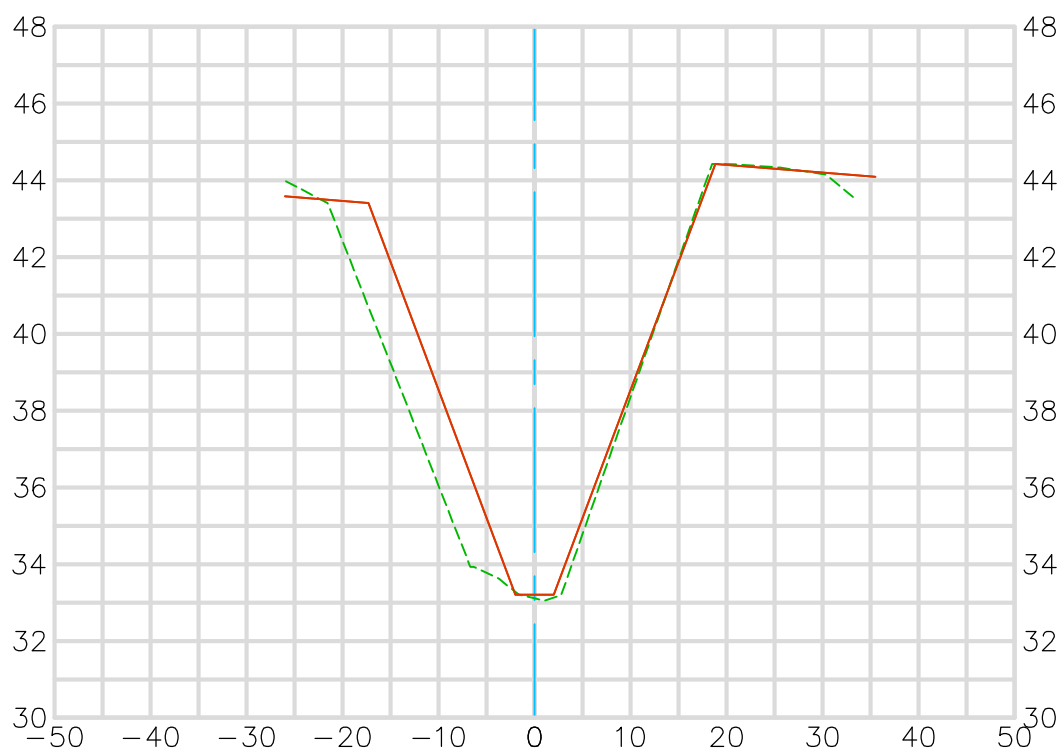

Existing Condition 2018
Record Plan 1960-1966
C06-101-2-A 1960, C06-101-4-A 1963, C06-103-1-M 1966
Modified Per Engineer's Directive
Prepared 8/21/19


Horizontal Scale 1" = 20'
Vertical Scale 1" = 5'

U.S. Survey Foot

OC Public Works/Engineering Services
OC Survey/Field Services
Boundary Analysis & Mapping



OCEAN VIEW CHANNEL (C06) 201+00.00 CL CONSTRUCTION

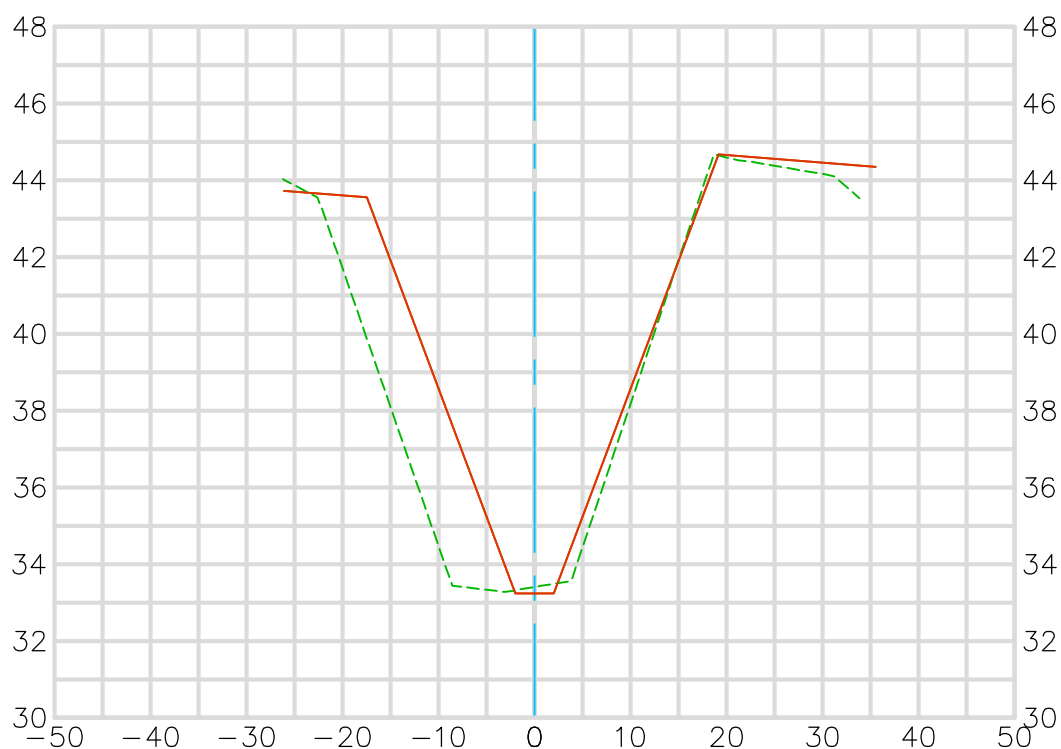

Existing Condition 2018
Record Plan 1960-1966
C06-101-2-A 1960, C06-101-4-A 1963, C06-103-1-M 1966
Modified Per Engineer's Directive
Prepared 8/21/19


Horizontal Scale 1" = 20'
Vertical Scale 1" = 5'

U.S. Survey Foot

OC Public Works/Engineering Services
OC Survey/Field Services
Boundary Analysis & Mapping



OCEAN VIEW CHANNEL (C06) 201+50.00 CL CONSTRUCTION

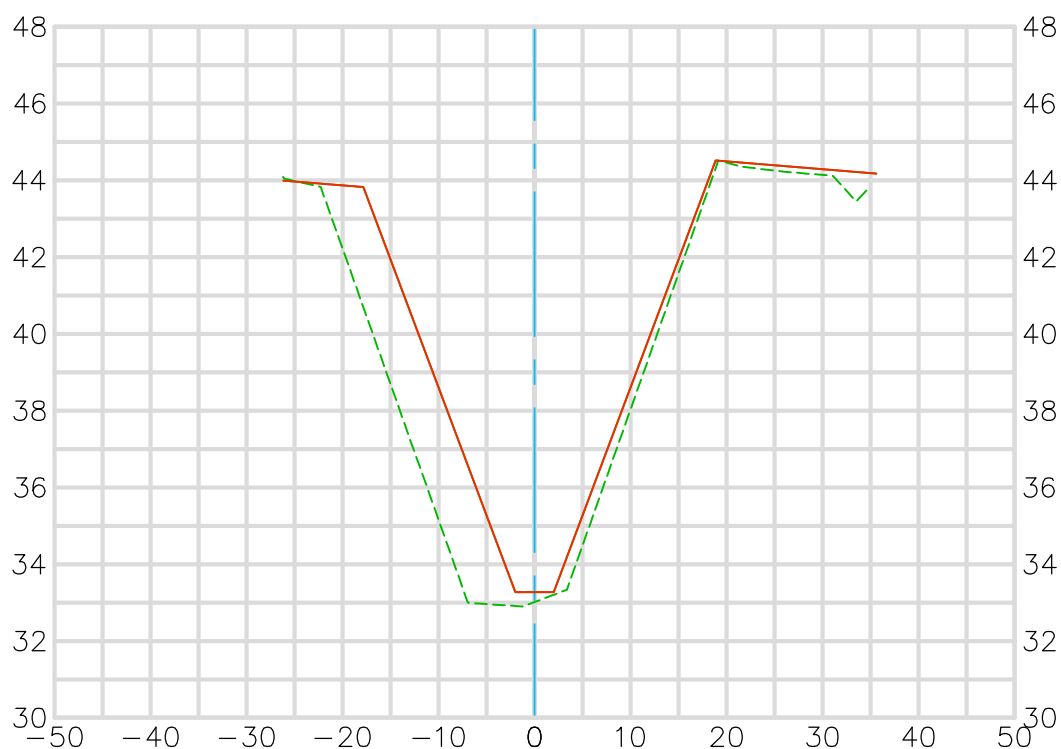

Existing Condition 2018
Record Plan 1960-1966
C06-101-2-A 1960, C06-101-4-A 1963, C06-103-1-M 1966
Modified Per Engineer's Directive
Prepared 8/21/19


Horizontal Scale 1" = 20'
Vertical Scale 1" = 5'

U.S. Survey Foot

OC Public Works/Engineering Services
OC Survey/Field Services
Boundary Analysis & Mapping



OCEAN VIEW CHANNEL (C06) 202+00.00 CL CONSTRUCTION

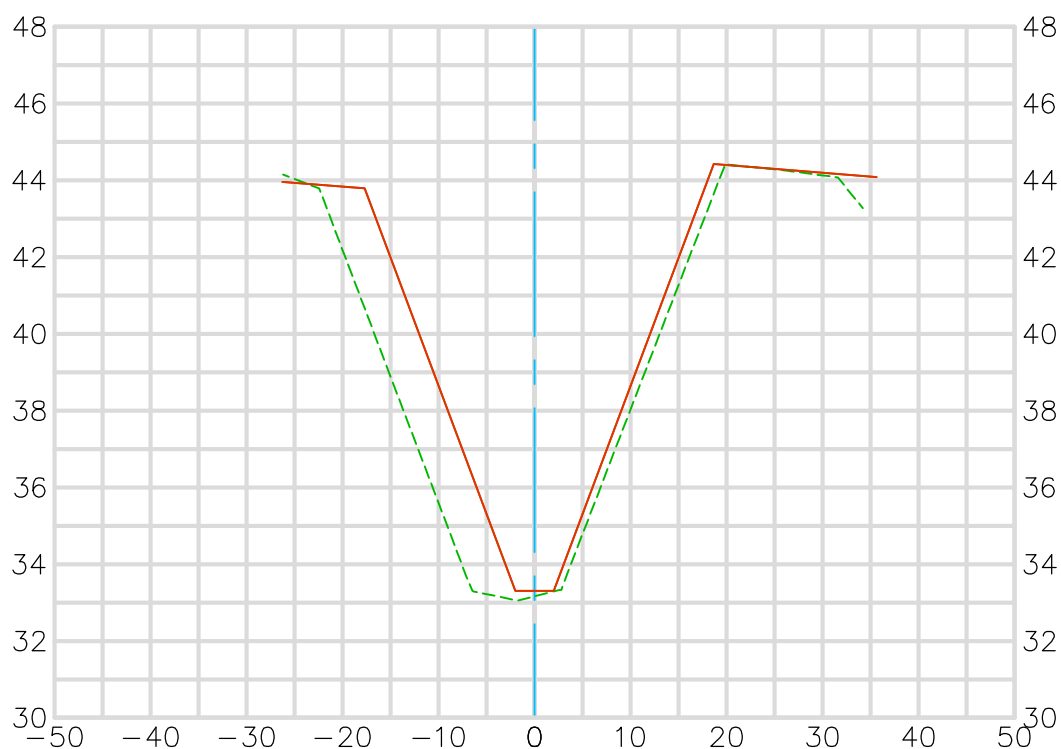

Existing Condition 2018
Record Plan 1960-1966
C06-101-2-A 1960, C06-101-4-A 1963, C06-103-1-M 1966
Modified Per Engineer's Directive
Prepared 8/21/19


Horizontal Scale 1" = 20'
Vertical Scale 1" = 5'

U.S. Survey Foot

OC Public Works/Engineering Services
OC Survey/Field Services
Boundary Analysis & Mapping



OCEAN VIEW CHANNEL (C06) 202+50.00 CL CONSTRUCTION

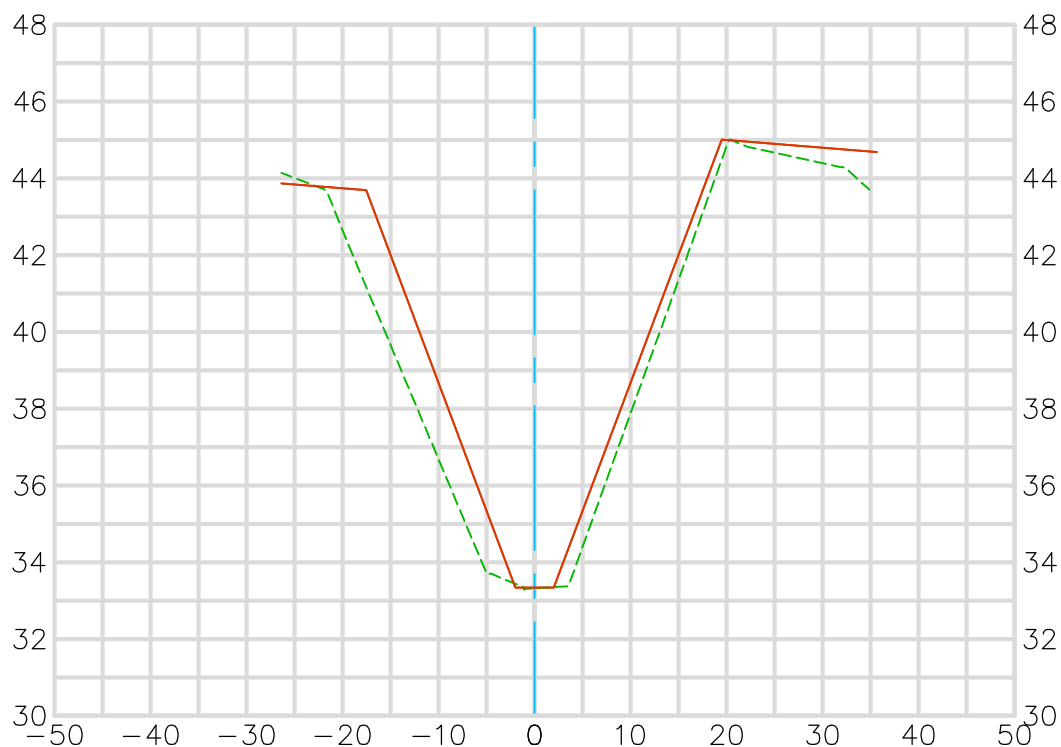

Existing Condition 2018
Record Plan 1960-1966
C06-101-2-A 1960, C06-101-4-A 1963, C06-103-1-M 1966
Modified Per Engineer's Directive
Prepared 8/21/19


Horizontal Scale 1" = 20'
Vertical Scale 1" = 5'

U.S. Survey Foot

OC Public Works/Engineering Services
OC Survey/Field Services
Boundary Analysis & Mapping



OCEAN VIEW CHANNEL (C06) 203+00.00 CL CONSTRUCTION

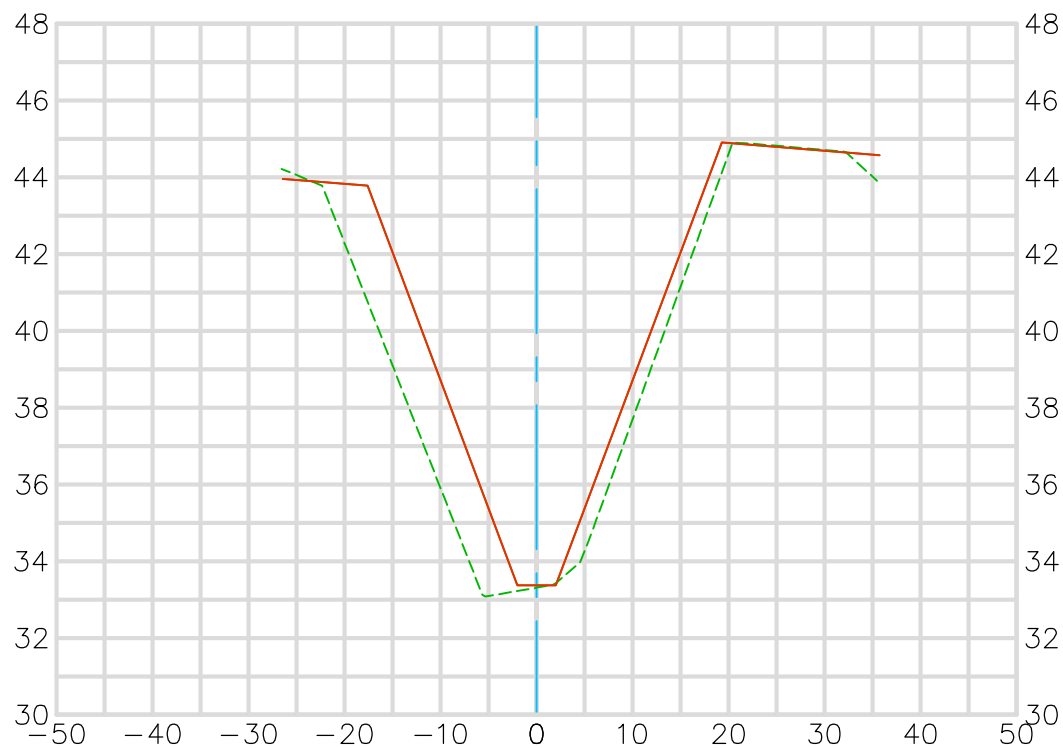

Existing Condition 2018
Record Plan 1960-1966
C06-101-2-A 1960, C06-101-4-A 1963, C06-103-1-M 1966
Modified Per Engineer's Directive
Prepared 8/21/19


Horizontal Scale 1" = 20'
Vertical Scale 1" = 5'

U.S. Survey Foot

OC Public Works/Engineering Services
OC Survey/Field Services
Boundary Analysis & Mapping




OCEAN VIEW CHANNEL (C06) 203+50.00 CL CONSTRUCTION

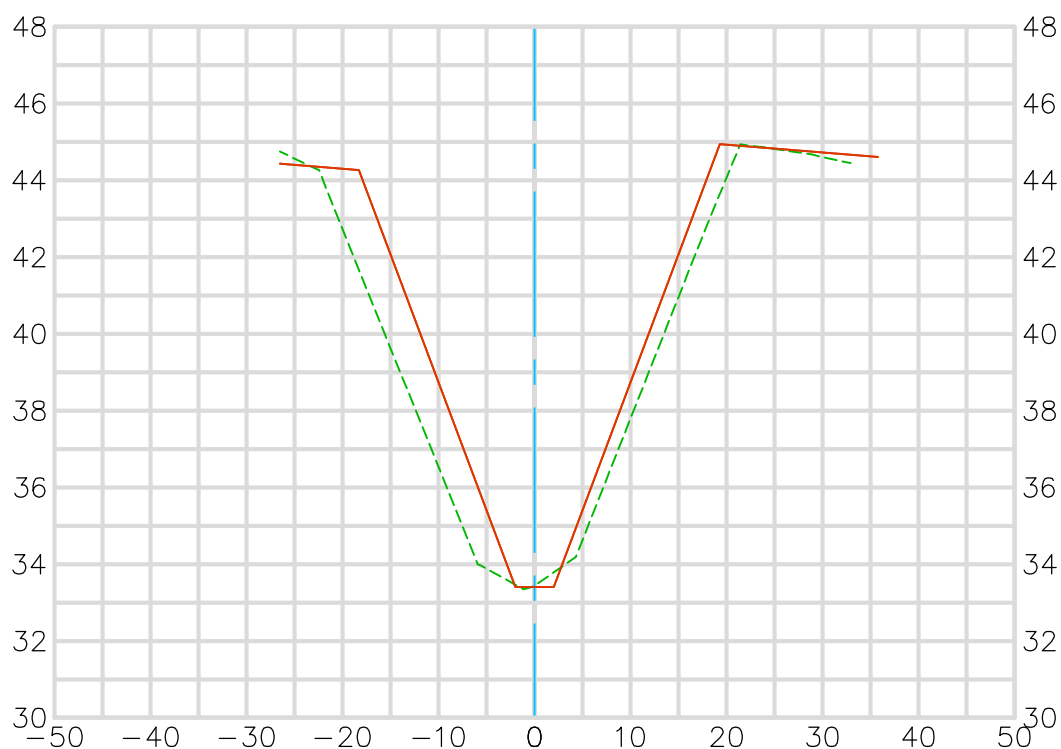

Existing Condition 2018
Record Plan 1960-1966
C06-101-2-A 1960, C06-101-4-A 1963, C06-103-1-M 1966
Modified Per Engineer's Directive
Prepared 8/21/19

Horizontal Scale 1" = 20'
Vertical Scale 1" = 5'

OCEAN VIEW CHANNEL (C06) 204+00.00 CL CONSTRUCTION

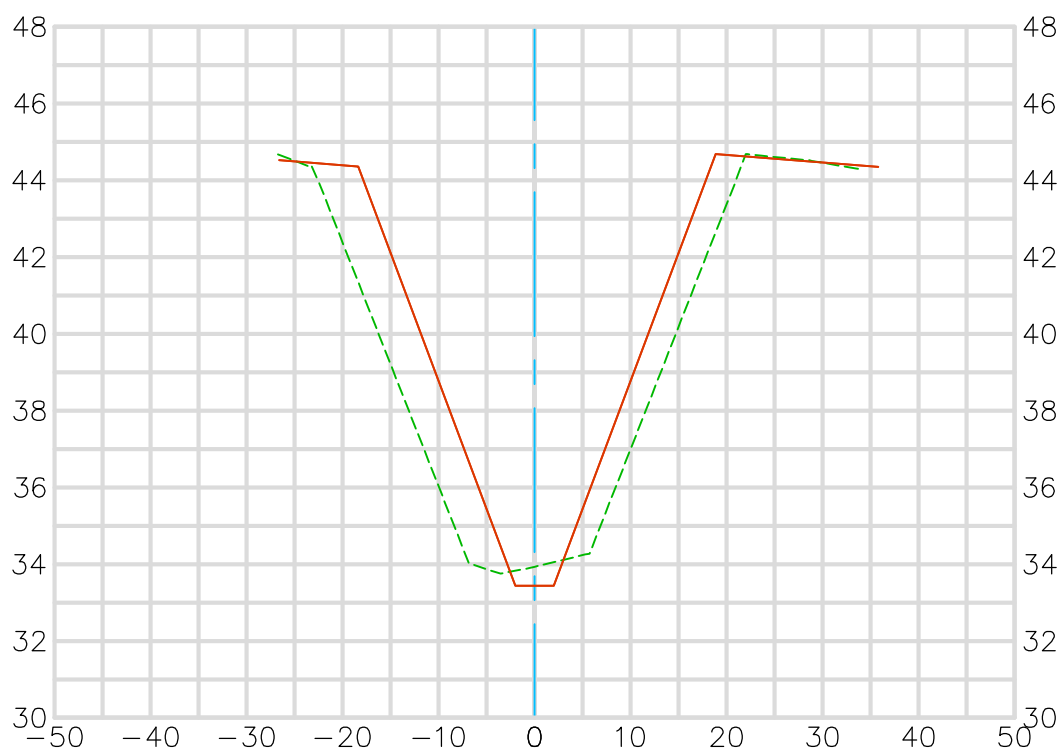

Existing Condition 2018
 Record Plan 1960-1966
 C06-101-2-A 1960, C06-101-4-A 1963, C06-103-1-M 1966
 Modified Per Engineer's Directive
 Prepared 8/21/19


Horizontal Scale 1" = 20'
 Vertical Scale 1" = 5'

U.S. Survey Foot

OC Public Works/Engineering Services
OC Survey/Field Services
Boundary Analysis & Mapping



OCEAN VIEW CHANNEL (C06) 204+50.00 CL CONSTRUCTION

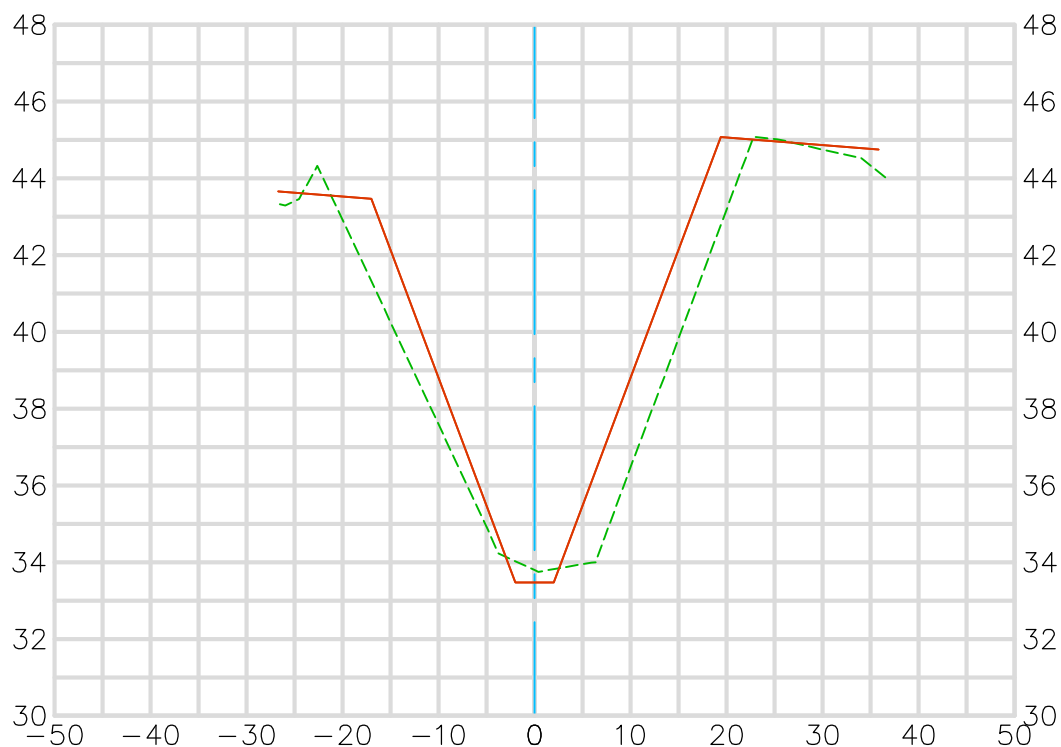

Existing Condition 2018
Record Plan 1960-1966
C06-101-2-A 1960, C06-101-4-A 1963, C06-103-1-M 1966
Modified Per Engineer's Directive
Prepared 8/21/19


Horizontal Scale 1" = 20'
Vertical Scale 1" = 5'

U.S. Survey Foot

OC Public Works/Engineering Services
OC Survey/Field Services
Boundary Analysis & Mapping



OCEAN VIEW CHANNEL (C06) 205+00.00 CL CONSTRUCTION

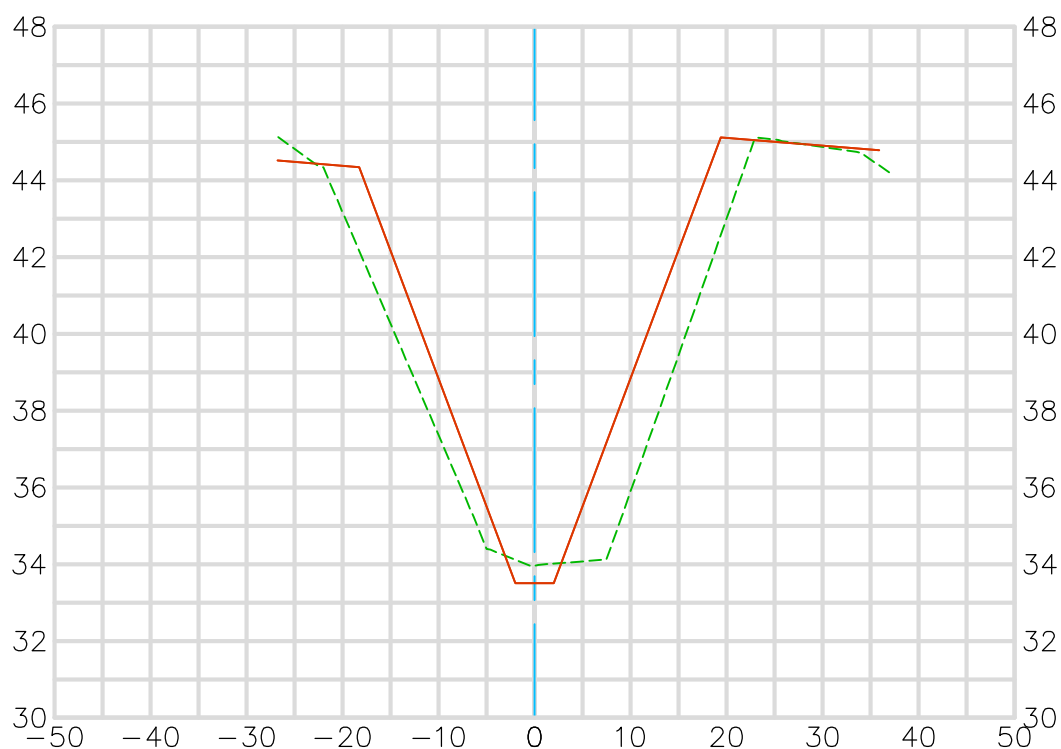

Existing Condition 2018
Record Plan 1960-1966
C06-101-2-A 1960, C06-101-4-A 1963, C06-103-1-M 1966
Modified Per Engineer's Directive
Prepared 8/21/19


Horizontal Scale 1" = 20'
Vertical Scale 1" = 5'

U.S. Survey Foot

OC Public Works/Engineering Services
OC Survey/Field Services
Boundary Analysis & Mapping



OCEAN VIEW CHANNEL (C06) 205+50.00 CL CONSTRUCTION

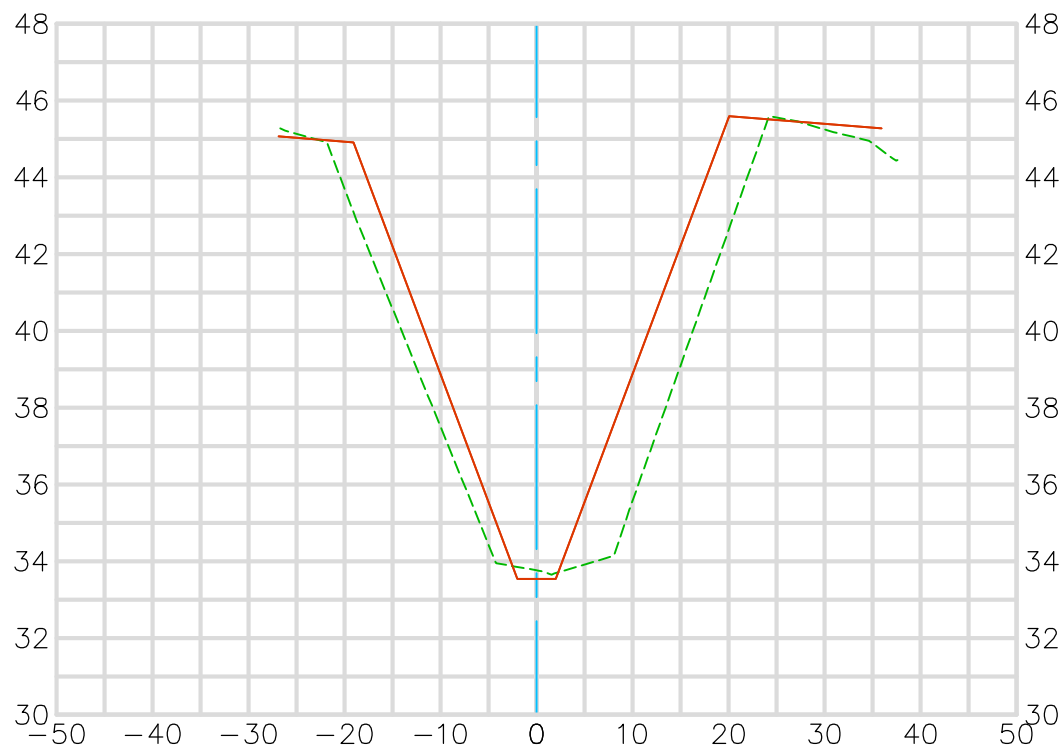

Existing Condition 2018
Record Plan 1960-1966
C06-101-2-A 1960, C06-101-4-A 1963, C06-103-1-M 1966
Modified Per Engineer's Directive
Prepared 8/21/19


Horizontal Scale 1" = 20'
Vertical Scale 1" = 5'

**U.S. Survey
Foot**

OC Public Works/Engineering Services
OC Survey/Field Services
Boundary Analysis & Mapping



OCEAN VIEW CHANNEL (C06) 206+00.00 CL CONSTRUCTION

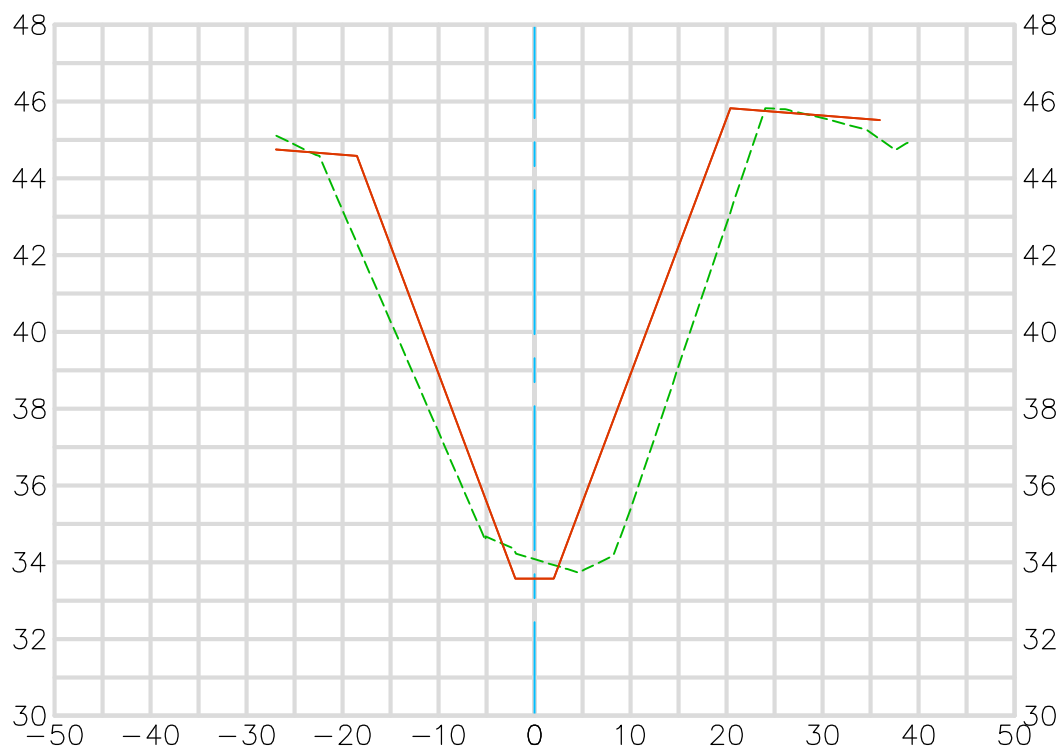

Existing Condition 2018
Record Plan 1960-1966
C06-101-2-A 1960, C06-101-4-A 1963, C06-103-1-M 1966
Modified Per Engineer's Directive
Prepared 8/21/19


Horizontal Scale 1" = 20'
Vertical Scale 1" = 5'

**U.S. Survey
Foot**

OC Public Works/Engineering Services
OC Survey/Field Services
Boundary Analysis & Mapping



OCEAN VIEW CHANNEL (C06) 206+50.00 CL CONSTRUCTION

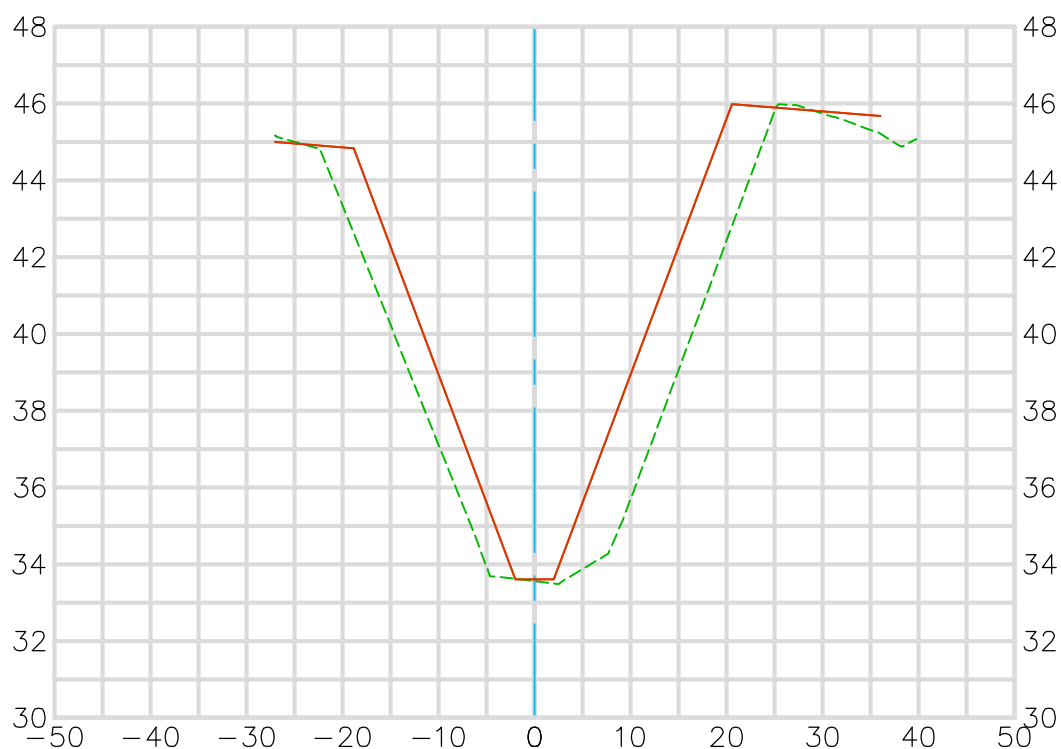

Existing Condition 2018
Record Plan 1960-1966
C06-101-2-A 1960, C06-101-4-A 1963, C06-103-1-M 1966
Modified Per Engineer's Directive
Prepared 8/21/19

Horizontal Scale 1" = 20'
Vertical Scale 1" = 5'

**U.S. Survey
Foot**

OC Public Works/Engineering Services
OC Survey/Field Services
Boundary Analysis & Mapping



OCEAN VIEW CHANNEL (C06) 207+00.00 CL CONSTRUCTION




Existing Condition 2018
Record Plan 1960-1966
C06-101-2-A 1960, C06-101-4-A 1963, C06-103-1-M 1966
Modified Per Engineer's Directive
Prepared 8/21/19

Horizontal Scale 1" = 20'
Vertical Scale 1" = 5'

OCEAN VIEW CHANNEL (C06)

207+50.00


CL CONSTRUCTION

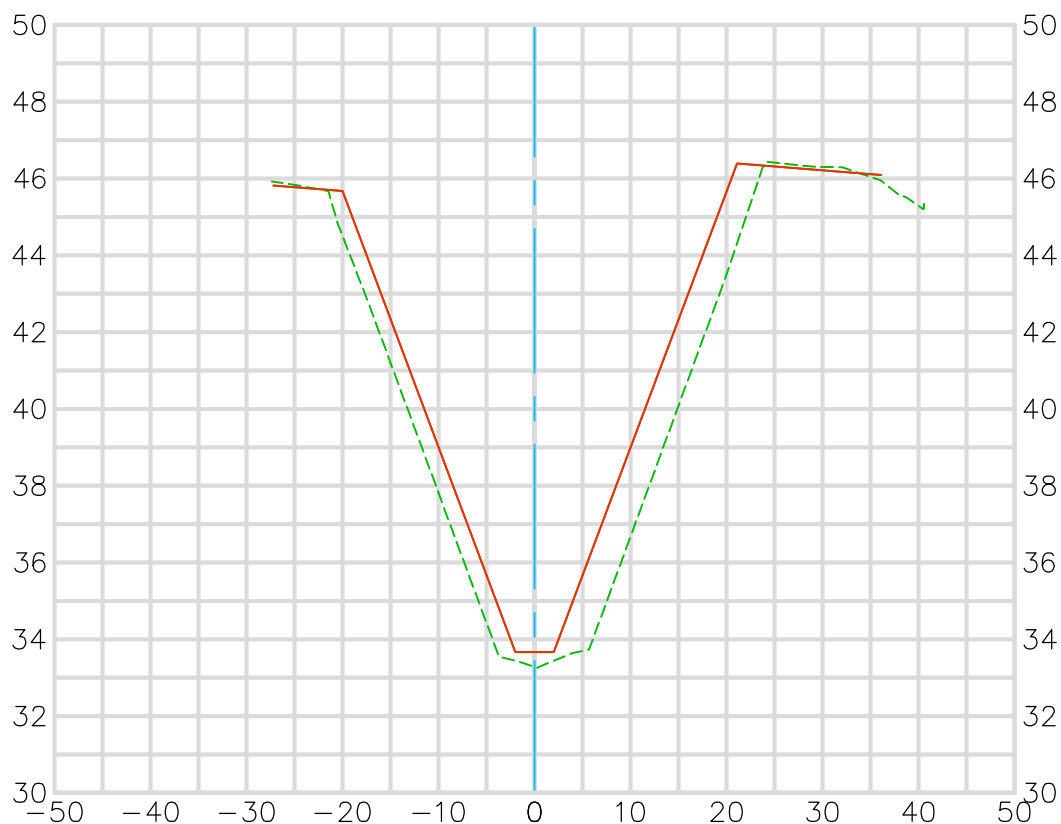

Existing Condition 2018
 Record Plan 1960-1966
 C06-101-2-A 1960, C06-101-4-A 1963, C06-103-1-M 1966
 Modified Per Engineer's Directive
 Prepared 8/21/19

Horizontal Scale 1" = 20'
 Vertical Scale 1" = 5'

OCEAN VIEW CHANNEL (C06) 208+00.00 CL CONSTRUCTION

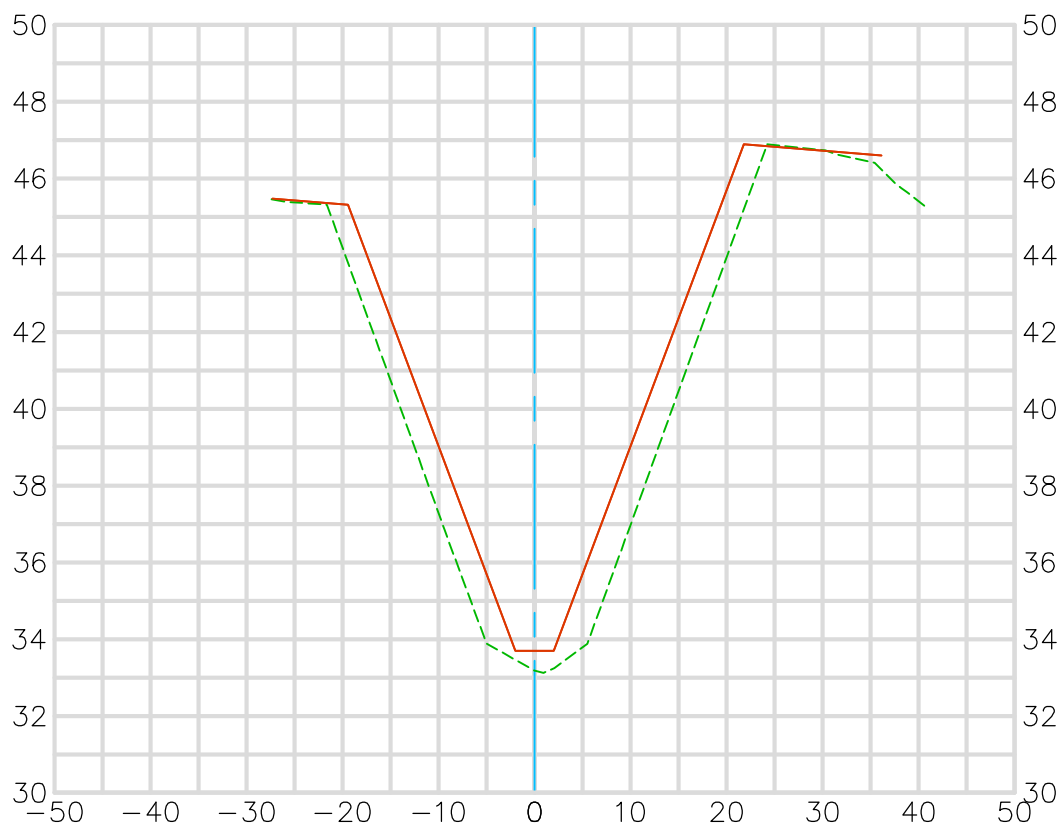

Existing Condition 2018
Record Plan 1960-1966
C06-101-2-A 1960, C06-101-4-A 1963, C06-103-1-M 1966
Modified Per Engineer's Directive
Prepared 8/21/19

Horizontal Scale 1" = 20'
Vertical Scale 1" = 5'

**U.S. Survey
Foot**


OC Public Works/Engineering Services
OC Survey/Field Services
Boundary Analysis & Mapping



OCEAN VIEW CHANNEL (C06)

208+50.00

CL CONSTRUCTION

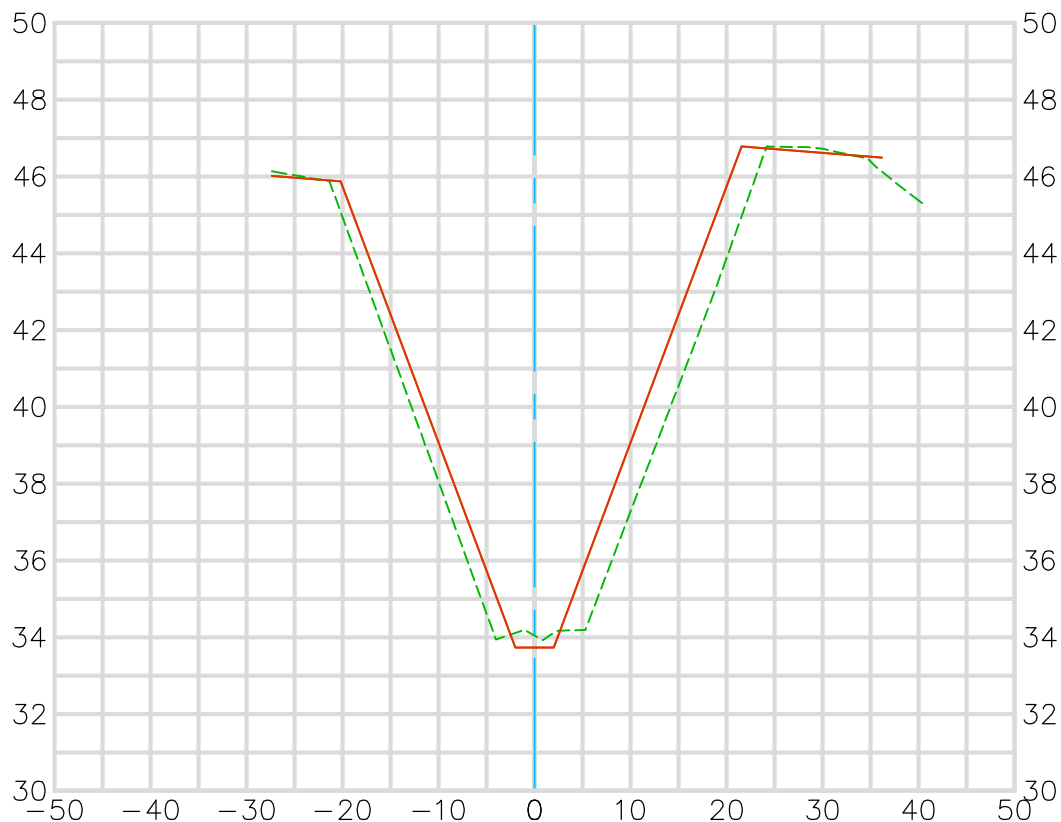

Existing Condition 2018
Record Plan 1960-1966
C06-101-2-A 1960, C06-101-4-A 1963, C06-103-1-M 1966
Modified Per Engineer's Directive
Prepared 8/21/19

Horizontal Scale 1" = 20'
Vertical Scale 1" = 5'

**U.S. Survey
Foot**


OC Public Works/Engineering Services
OC Survey/Field Services
Boundary Analysis & Mapping



OCEAN VIEW CHANNEL (C06)

209+00.00

CL CONSTRUCTION

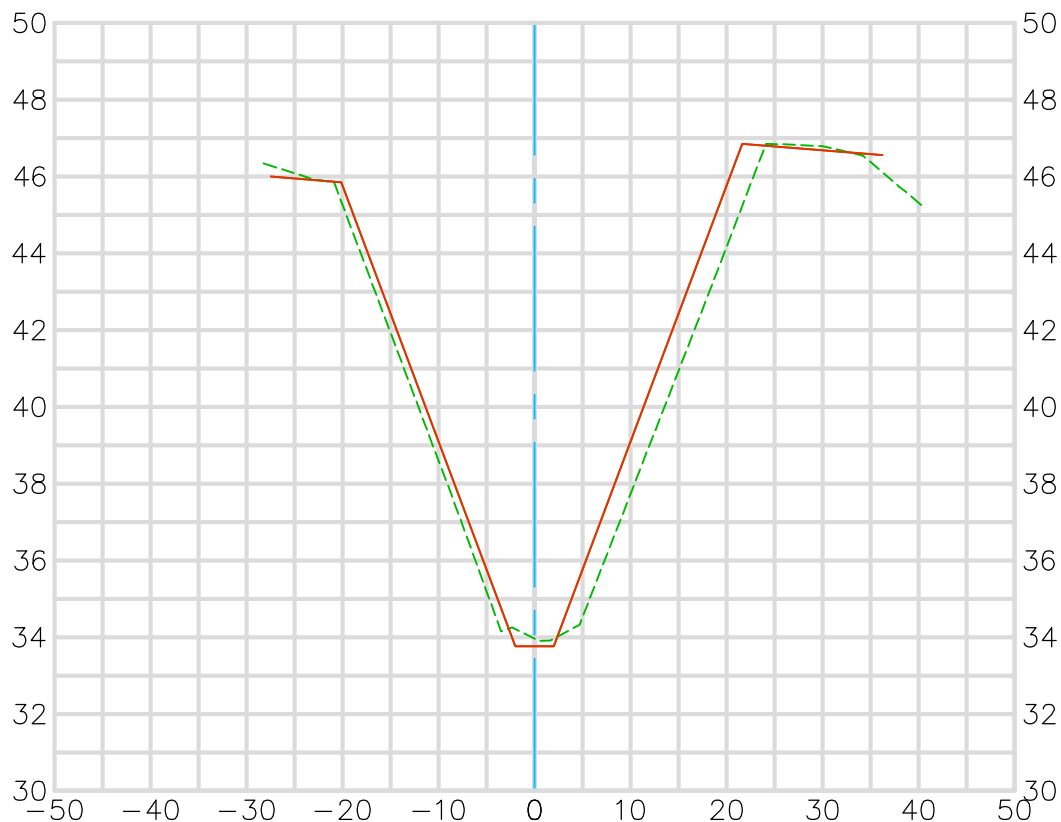

Existing Condition 2018
Record Plan 1960-1966
C06-101-2-A 1960, C06-101-4-A 1963, C06-103-1-M 1966
Modified Per Engineer's Directive
Prepared 8/21/19

Horizontal Scale 1" = 20'
Vertical Scale 1" = 5'

**U.S. Survey
Foot**

OC Public Works/Engineering Services
OC Survey/Field Services
Boundary Analysis & Mapping



OCEAN VIEW CHANNEL (C06) 209+50.00 CL CONSTRUCTION



Existing Condition 2018
Record Plan 1960-1966
C06-101-2-A 1960, C06-101-4-A 1963, C06-103-1-M 1966
Modified Per Engineer's Directive
Prepared 8/21/19

Horizontal Scale 1" = 20'
Vertical Scale 1" = 5'

OCEAN VIEW CHANNEL (C06) 210+00.00 CL CONSTRUCTION



Existing Condition 2018
 Record Plan 1960-1966
 C06-101-2-A 1960, C06-101-4-A 1963, C06-103-1-M 1966
 Modified Per Engineer's Directive
 Prepared 8/21/19

Horizontal Scale 1" = 20'
 Vertical Scale 1" = 5'

**U.S. Survey
Foot**

OC Public Works/Engineering Services
OC Survey/Field Services
Boundary Analysis & Mapping



OCEAN VIEW CHANNEL (C06)

210+50.00

CL CONSTRUCTION



Existing Condition 2018

Record Plan 1960-1966

C06-101-2-A 1960, C06-101-4-A 1963, C06-103-1-M 1966

Modified Per Engineer's Directive

Prepared 8/21/19

Horizontal Scale 1" = 20'

Vertical Scale 1" = 5'

**U.S. Survey
Foot**

OC Public Works/Engineering Services
OC Survey/Field Services
Boundary Analysis & Mapping



OCEAN VIEW CHANNEL (C06) 211+00.00 CL CONSTRUCTION



Existing Condition 2018
Record Plan 1960-1966
C06-101-2-A 1960, C06-101-4-A 1963, C06-103-1-M 1966
Modified Per Engineer's Directive
Prepared 8/21/19

Horizontal Scale 1" = 20'
Vertical Scale 1" = 5'

U.S. Survey Foot

OC Public Works/Engineering Services
OC Survey/Field Services
Boundary Analysis & Mapping




OCEAN VIEW CHANNEL (C06) 211+50.00 CL CONSTRUCTION



Existing Condition 2018
Record Plan 1960-1966
C06-101-2-A 1960, C06-101-4-A 1963, C06-103-1-M 1966
Modified Per Engineer's Directive
Prepared 8/21/19

Horizontal Scale 1" = 20'
Vertical Scale 1" = 5'


OCEAN VIEW CHANNEL (C06) 212+00.00 CL CONSTRUCTION

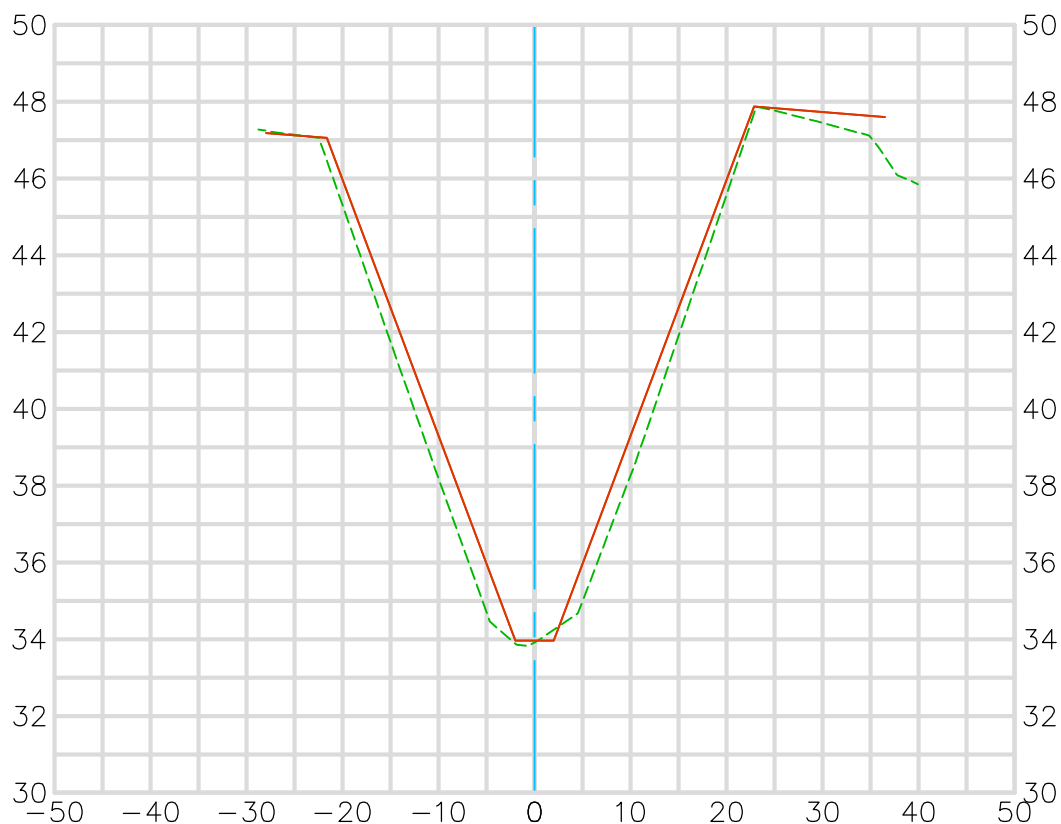

Existing Condition 2018
 Record Plan 1960-1966
 C06-101-2-A 1960, C06-101-4-A 1963, C06-103-1-M 1966
 Modified Per Engineer's Directive
 Prepared 8/21/19

Horizontal Scale 1" = 20'
 Vertical Scale 1" = 5'

OCEAN VIEW CHANNEL (C06) 212+50.00 CL CONSTRUCTION

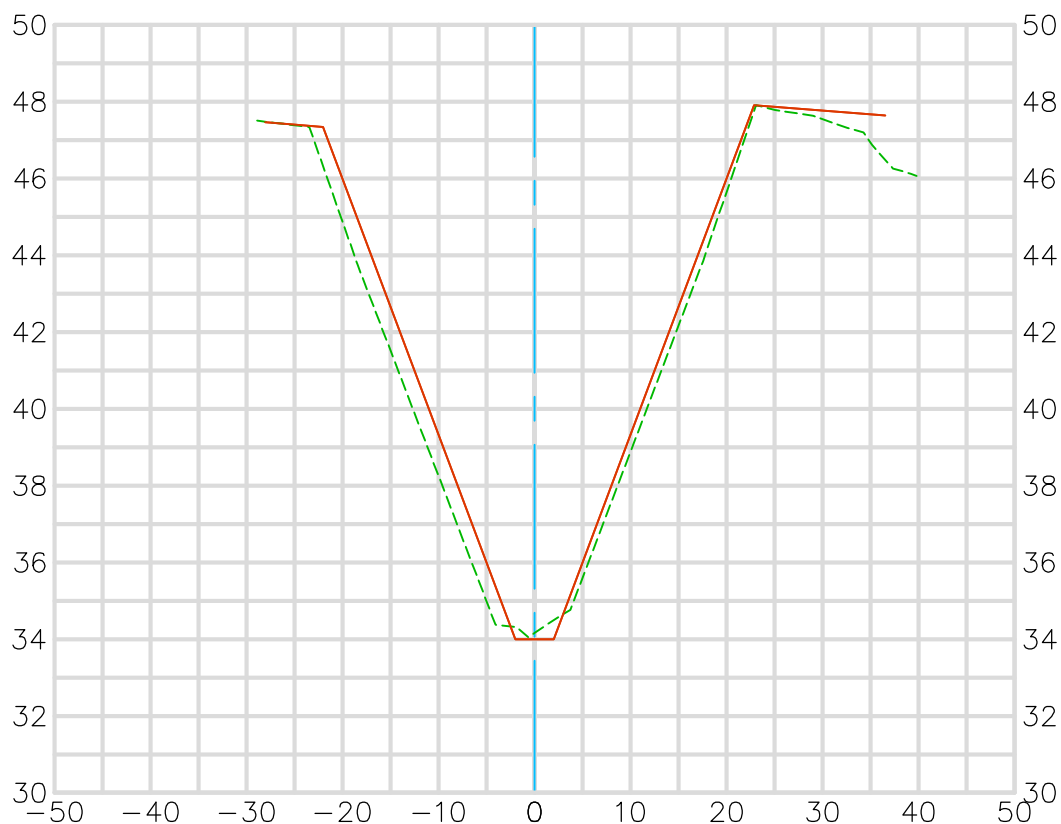

Existing Condition 2018
 Record Plan 1960-1966
 C06-101-2-A 1960, C06-101-4-A 1963, C06-103-1-M 1966
 Modified Per Engineer's Directive
 Prepared 8/21/19

Horizontal Scale 1" = 20'
 Vertical Scale 1" = 5'

**U.S. Survey
Foot**

OC Public Works/Engineering Services
OC Survey/Field Services
Boundary Analysis & Mapping



OCEAN VIEW CHANNEL (C06)

213+00.00

CL CONSTRUCTION



Existing Condition 2018
Record Plan 1960-1966
C06-101-2-A 1960, C06-101-4-A 1963, C06-103-1-M 1966
Modified Per Engineer's Directive
Prepared 8/21/19

Horizontal Scale 1" = 20'
Vertical Scale 1" = 5'

**U.S. Survey
Foot**


OC Public Works/Engineering Services
OC Survey/Field Services
Boundary Analysis & Mapping



OCEAN VIEW CHANNEL (C06)

213+50.00

CL CONSTRUCTION

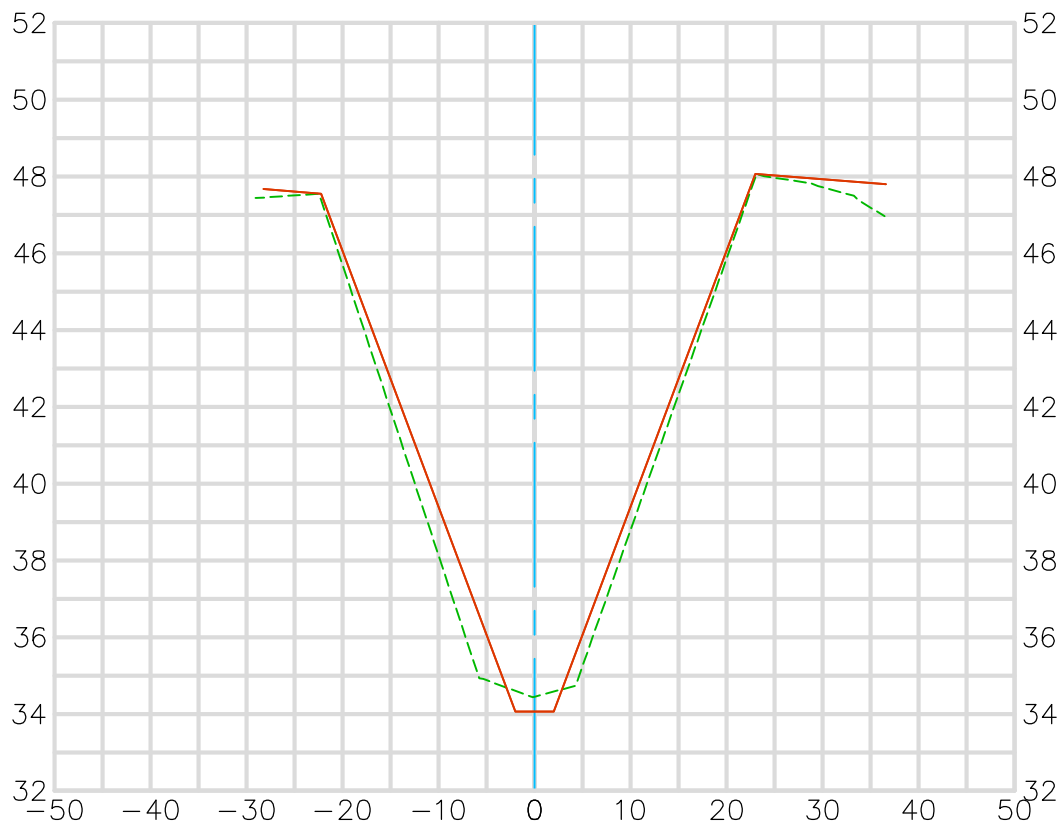

Existing Condition 2018

Record Plan 1960-1966

C06-101-2-A 1960, C06-101-4-A 1963, C06-103-1-M 1966

Modified Per Engineer's Directive

Prepared 8/21/19

Horizontal Scale 1" = 20'


Vertical Scale 1" = 5'

**U.S. Survey
Foot**

OC Public Works/Engineering Services
OC Survey/Field Services
Boundary Analysis & Mapping



OCEAN VIEW CHANNEL (C06) 214+00.00 CL CONSTRUCTION

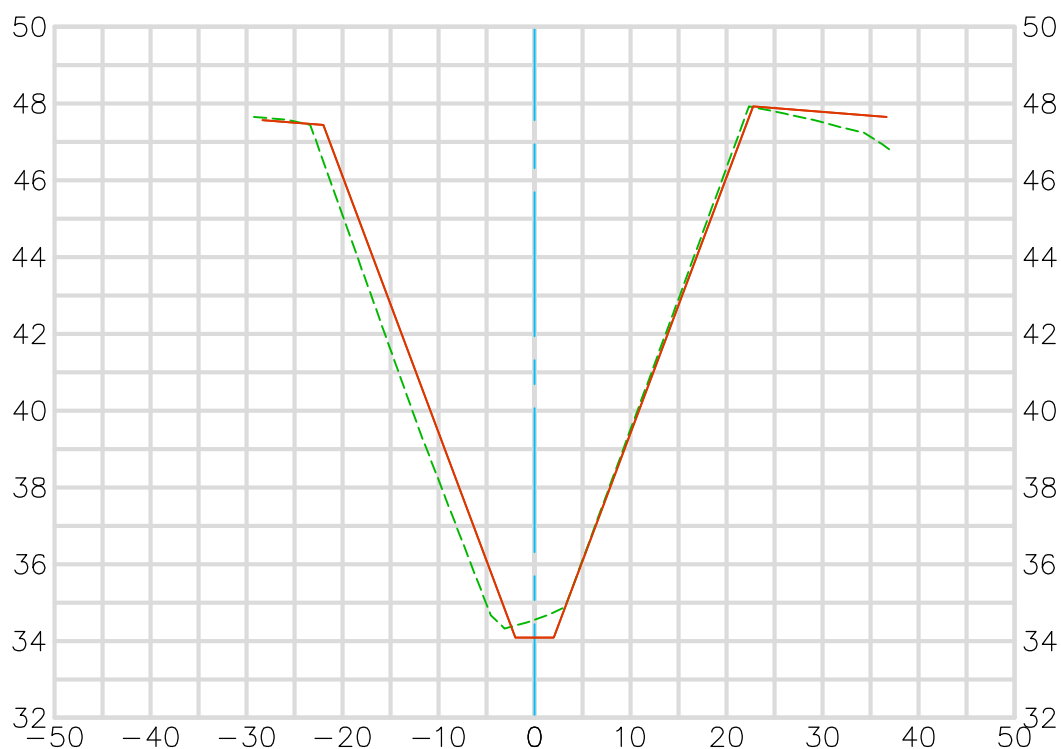

Existing Condition 2018
Record Plan 1960-1966
C06-101-2-A 1960, C06-101-4-A 1963, C06-103-1-M 1966
Modified Per Engineer's Directive
Prepared 8/21/19


Horizontal Scale 1" = 20'
Vertical Scale 1" = 5'

U.S. Survey Foot

OC Public Works/Engineering Services
OC Survey/Field Services
Boundary Analysis & Mapping



OCEAN VIEW CHANNEL (C06) 214+50.00 CL CONSTRUCTION

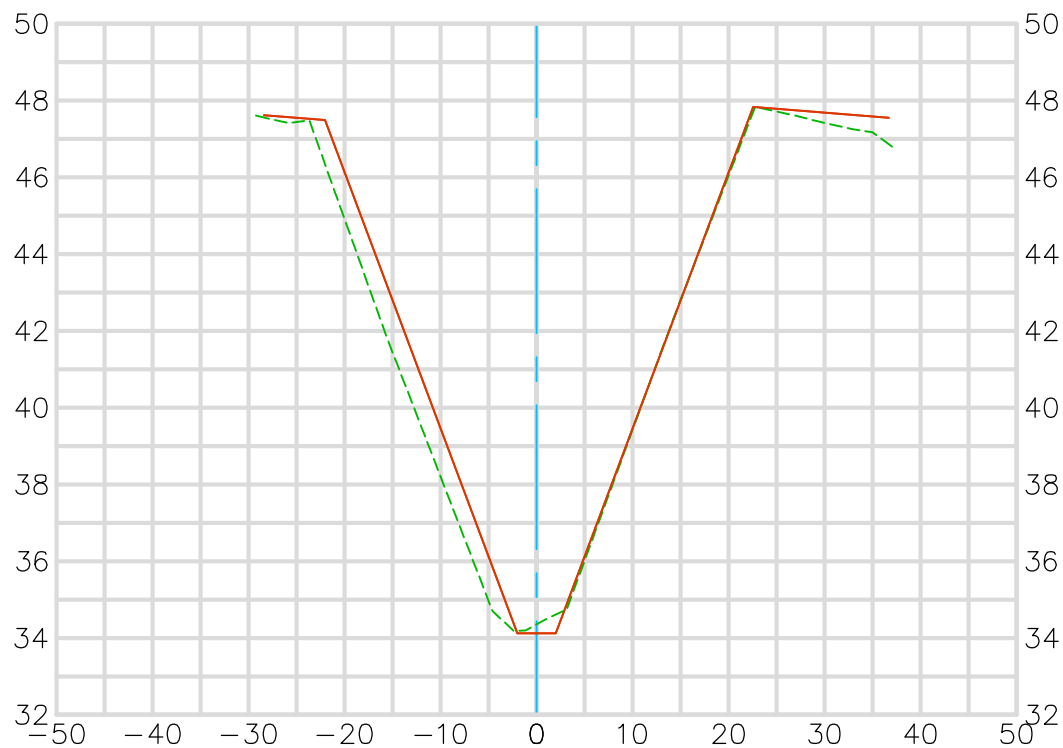

Existing Condition 2018
Record Plan 1960-1966
C06-101-2-A 1960, C06-101-4-A 1963, C06-103-1-M 1966
Modified Per Engineer's Directive
Prepared 8/21/19


Horizontal Scale 1" = 20'
Vertical Scale 1" = 5'

**U.S. Survey
Foot**

OC Public Works/Engineering Services
OC Survey/Field Services
Boundary Analysis & Mapping



OCEAN VIEW CHANNEL (C06) 215+00.00 CL CONSTRUCTION

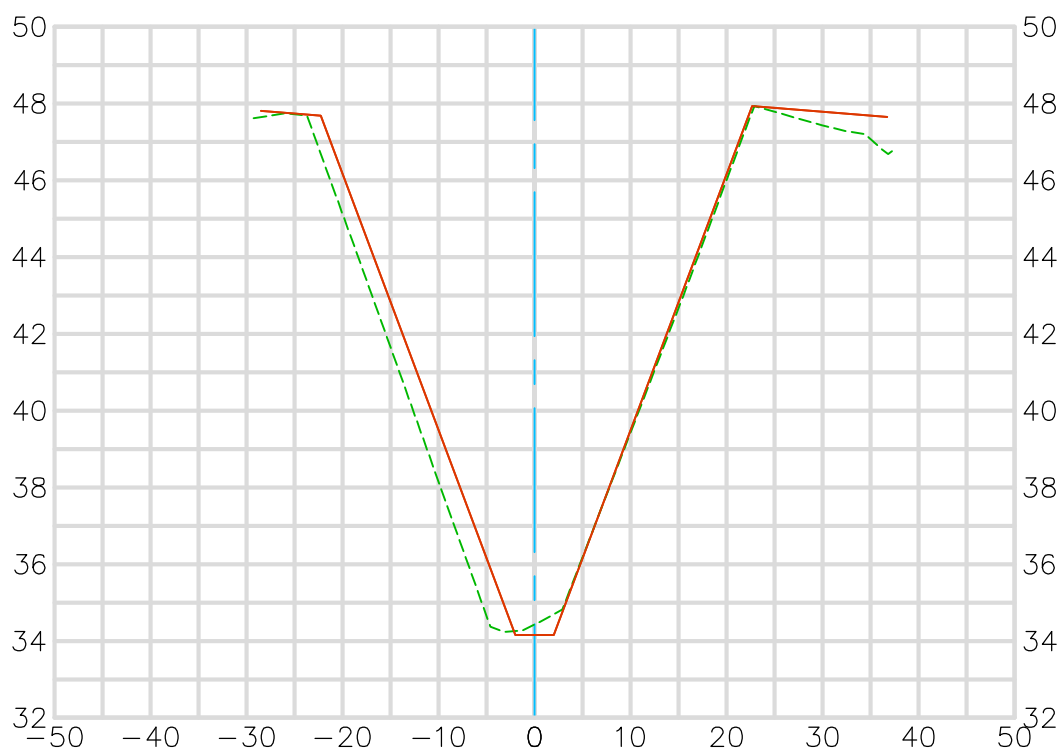


Existing Condition 2018
Record Plan 1960-1966
C06-101-2-A 1960, C06-101-4-A 1963, C06-103-1-M 1966
Modified Per Engineer's Directive
Prepared 8/21/19

Horizontal Scale 1" = 20'
Vertical Scale 1" = 5'

OCEAN VIEW CHANNEL (C06)

215+50.00

CL CONSTRUCTION

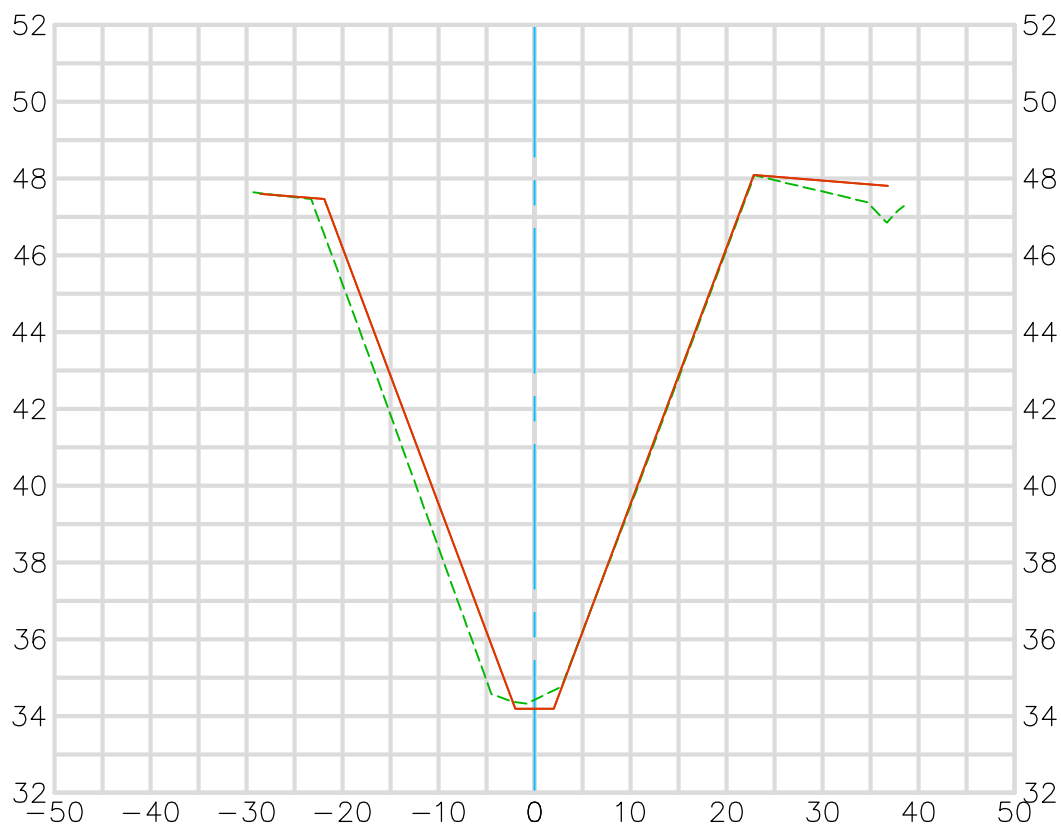

Existing Condition 2018
 Record Plan 1960-1966
 C06-101-2-A 1960, C06-101-4-A 1963, C06-103-1-M 1966
 Modified Per Engineer's Directive
 Prepared 8/21/19

Horizontal Scale 1" = 20'
 Vertical Scale 1" = 5'

**U.S. Survey
Foot**

OC Public Works/Engineering Services
OC Survey/Field Services
Boundary Analysis & Mapping



OCEAN VIEW CHANNEL (C06) 216+00.00 CL CONSTRUCTION



Existing Condition 2018

Record Plan 1960-1966

C06-101-2-A 1960, C06-101-4-A 1963, C06-103-1-M 1966

Modified Per Engineer's Directive

Prepared 8/21/19

Horizontal Scale 1" = 20'

Vertical Scale 1" = 5'

U.S. Survey Foot


OC Public Works/Engineering Services
OC Survey/Field Services
Boundary Analysis & Mapping



OCEAN VIEW CHANNEL (C06)

216+50.00

CL CONSTRUCTION

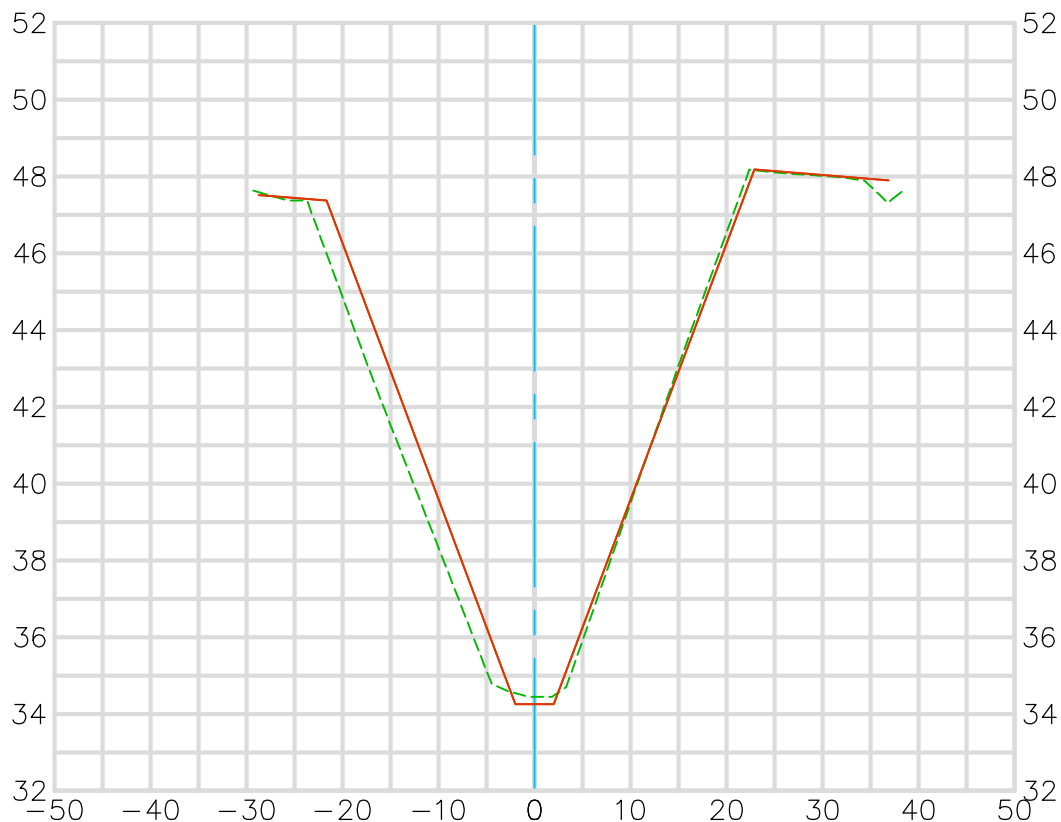

Existing Condition 2018
Record Plan 1960-1966
C06-101-2-A 1960, C06-101-4-A 1963, C06-103-1-M 1966
Modified Per Engineer's Directive
Prepared 8/21/19

Horizontal Scale 1" = 20'
Vertical Scale 1" = 5'

**U.S. Survey
Foot**


OC Public Works/Engineering Services
OC Survey/Field Services
Boundary Analysis & Mapping



OCEAN VIEW CHANNEL (C06)

217+00.00

CL CONSTRUCTION

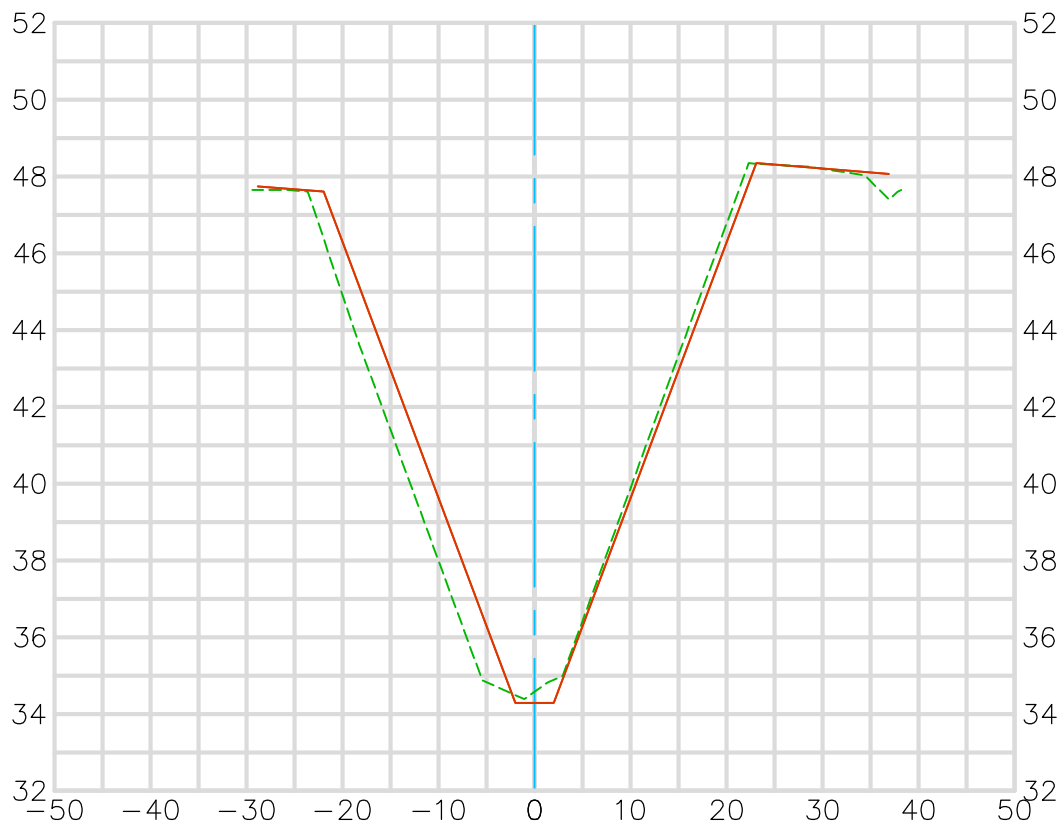

Existing Condition 2018

Record Plan 1960-1966

C06-101-2-A 1960, C06-101-4-A 1963, C06-103-1-M 1966

Modified Per Engineer's Directive

Prepared 8/21/19


Horizontal Scale 1" = 20'

Vertical Scale 1" = 5'

**U.S. Survey
Foot**

OC Public Works/Engineering Services
OC Survey/Field Services
Boundary Analysis & Mapping

OCEAN VIEW CHANNEL (C06) 217+50.00 CL CONSTRUCTION

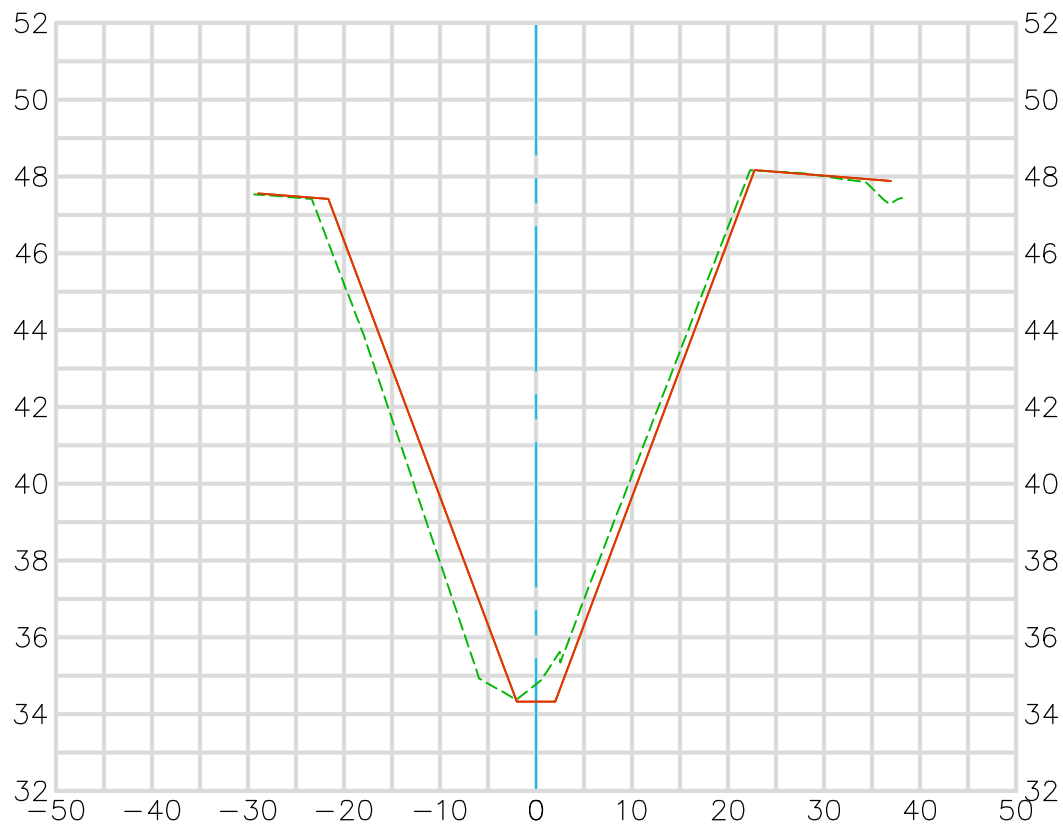

Existing Condition 2018

Record Plan 1960-1966

C06-101-2-A 1960, C06-101-4-A 1963, C06-103-1-M 1966

Modified Per Engineer's Directive

Prepared 8/21/19

Horizontal Scale 1" = 20'

Vertical Scale 1" = 5'

**U.S. Survey
Foot**

OC Public Works/Engineering Services
OC Survey/Field Services
Boundary Analysis & Mapping



OCEAN VIEW CHANNEL (C06) 217+94.93 CL CONSTRUCTION



Existing Condition 2018
Record Plan 1960-1966
C06-101-2-A 1960, C06-101-4-A 1963, C06-103-1-M 1966
Modified Per Engineer's Directive
Prepared 8/21/19

Horizontal Scale 1" = 20'
Vertical Scale 1" = 5'