



ROSSMOOR RETARDING BASIN 165+17

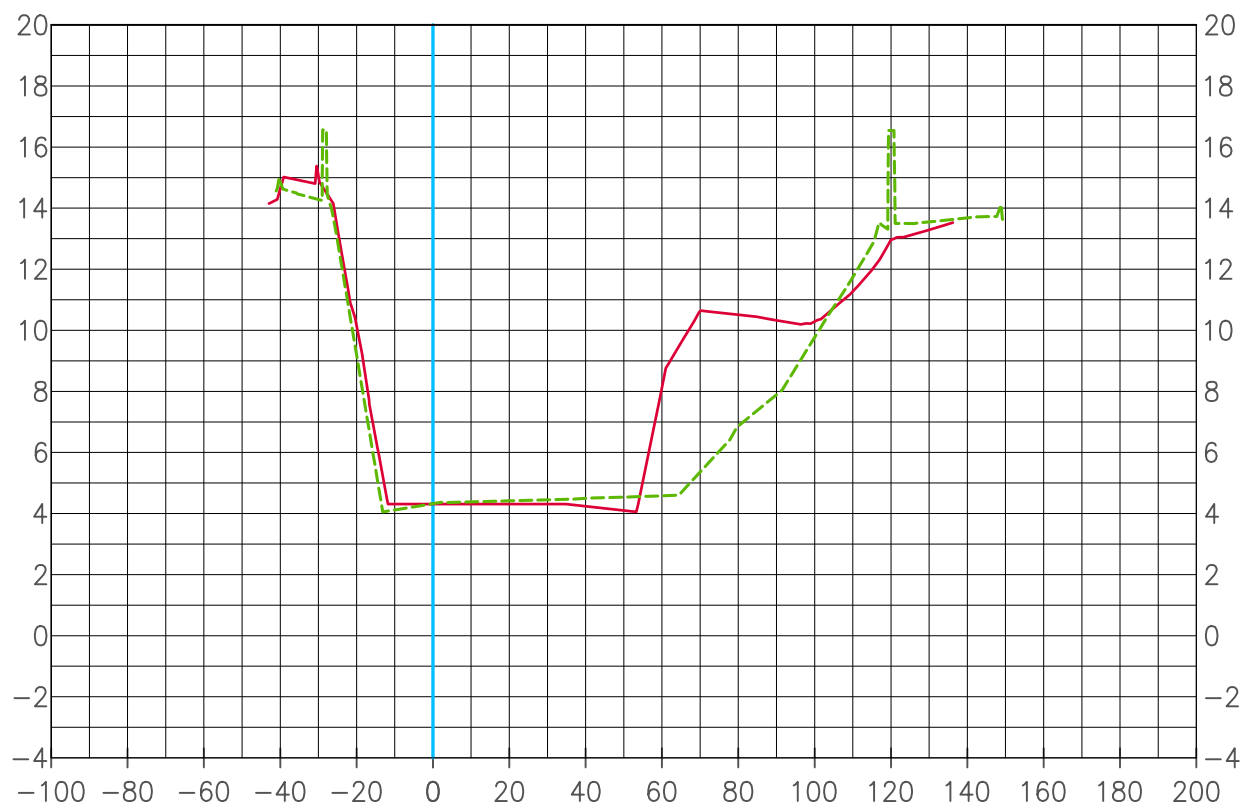

Topography Survey (2019) - - - - -
Record Plan C01B02-101-2 (2000) _____
Construction Centerline _____


Horizontal Scale 1" = 50'
Vertical Scale 1" = 8'

Date Prepared: 04/16/2019

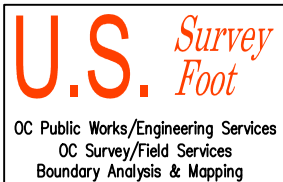

ROSSMOOR RETARDING BASIN


167+50

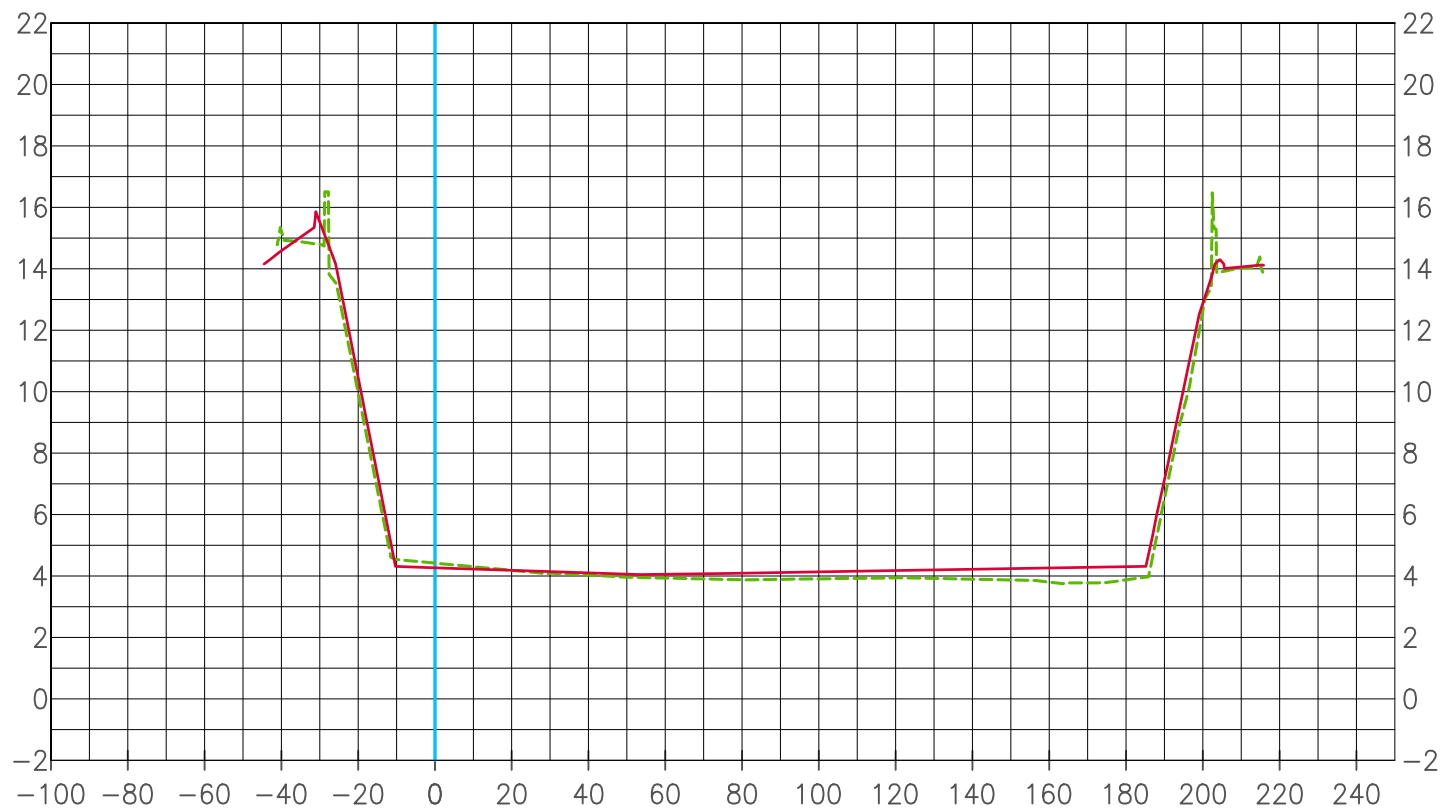

Topography Survey (2019) - - - - -
Record Plan C01B02-101-2 (2000) _____
Construction Centerline _____


Horizontal Scale 1" = 50'
Vertical Scale 1" = 8'

Date Prepared: 04/16/2019

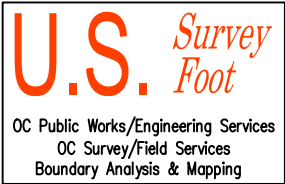

ROSSMOOR RETARDING BASIN

170+00

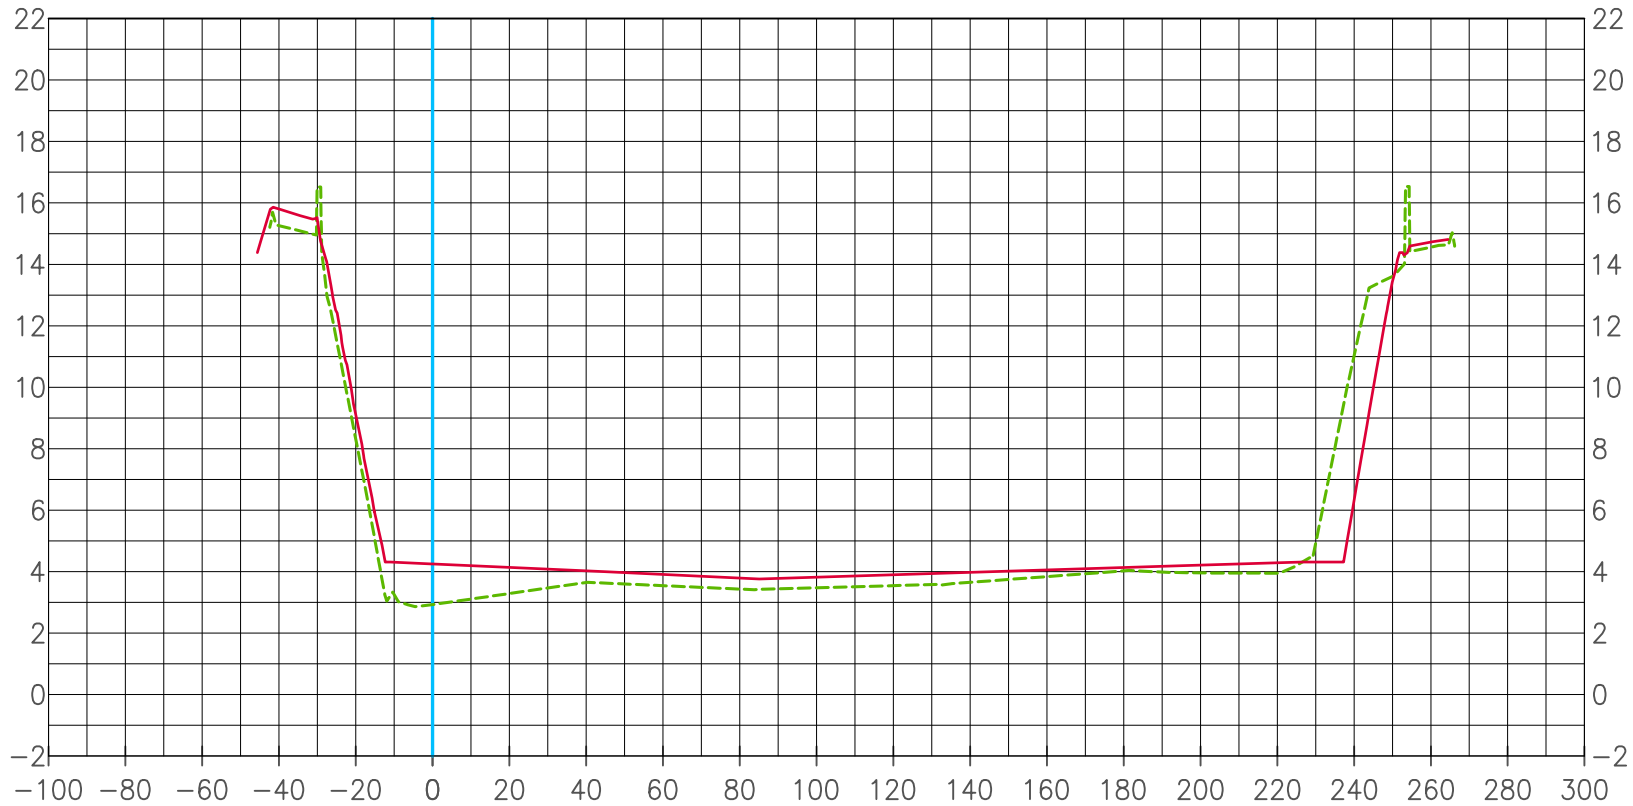


Topography Survey (2019) - - - - -
Record Plan C01B02-101-2 (2000) _____
Construction Centerline _____

Horizontal Scale 1" = 50'
Vertical Scale 1" = 8'

Date Prepared: 04/16/2019

ROSSMOOR RETARDING BASIN

172+50

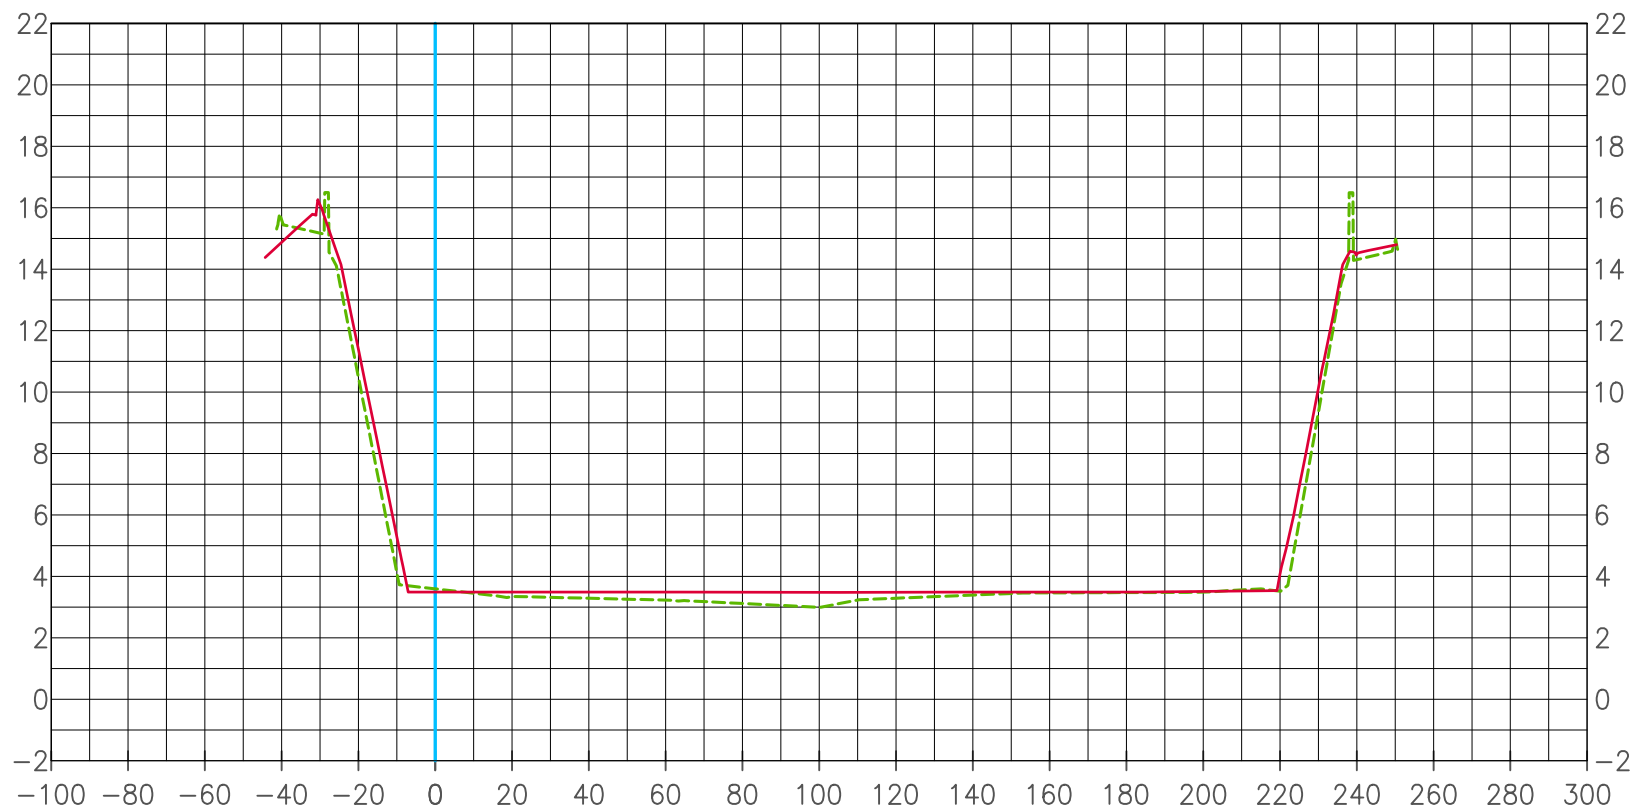

Topography Survey (2019) ---
 Record Plan C01B02-101-2 (2000) —
 Construction Centerline —

Horizontal Scale 1" = 50'
 Vertical Scale 1" = 8'


Date Prepared: 04/16/2019

**U.S. Survey
Foot**

OC Public Works/Engineering Services
OC Survey/Field Services
Boundary Analysis & Mapping

ROSSMOOR RETARDING BASIN

175+00

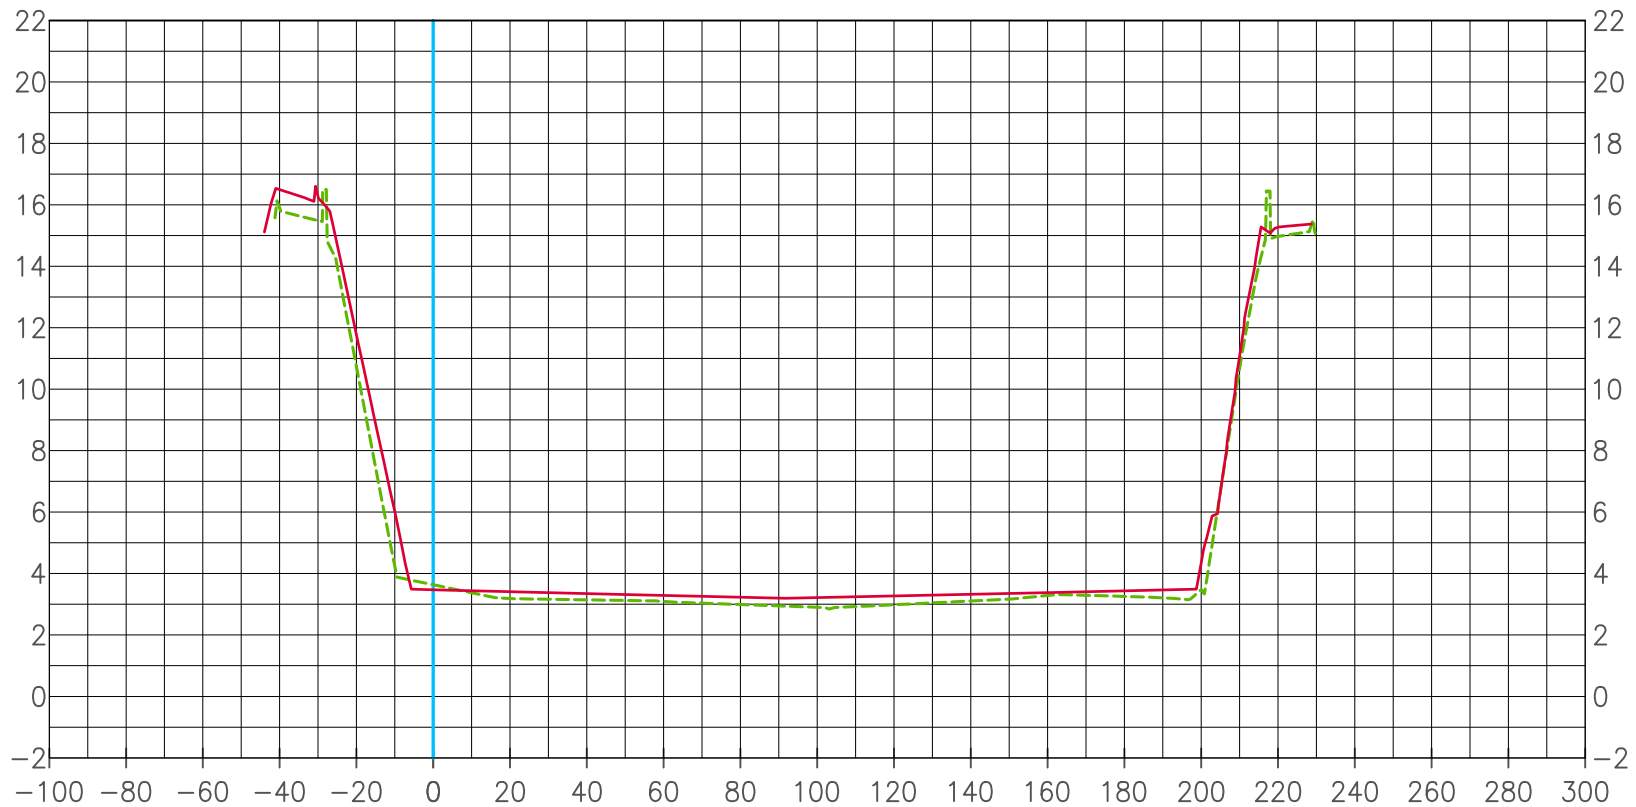

Topography Survey (2019)

Record Plan C01B02-101-2 (2000)

Construction Centerline




Horizontal Scale 1" = 50'

Vertical Scale 1" = 8'

Date Prepared: 04/16/2019

ROSSMOOR RETARDING BASIN


177+50

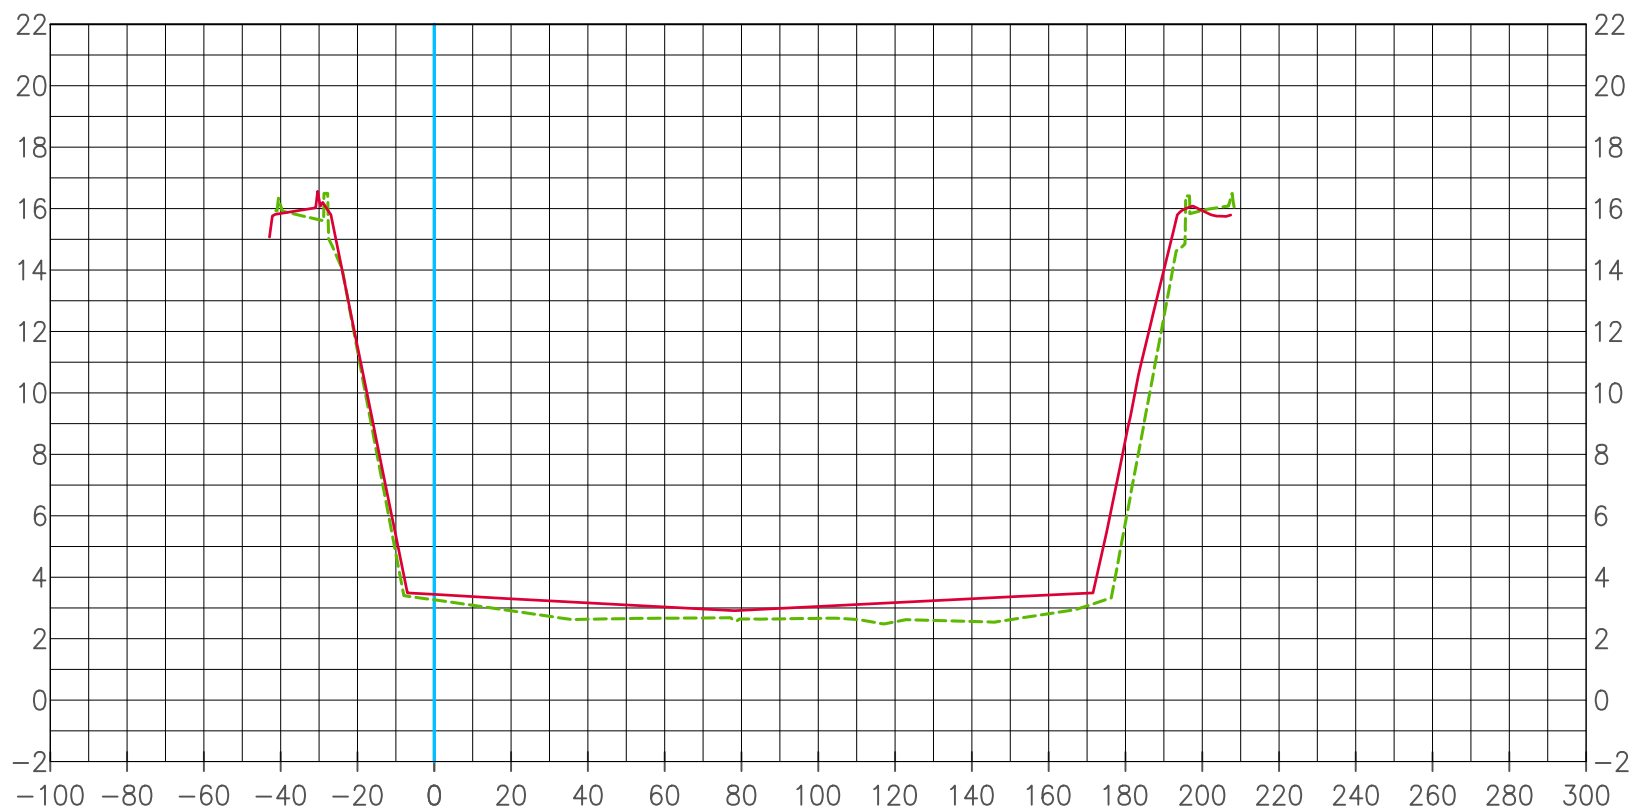

Topography Survey (2019) ---
 Record Plan C01B02-101-2 (2000) —
 Construction Centerline —


Horizontal Scale 1" = 50'
 Vertical Scale 1" = 8'

Date Prepared: 04/16/2019

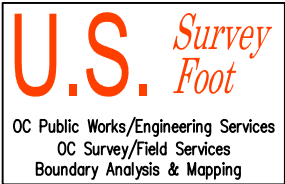

ROSSMOOR RETARDING BASIN


180+00

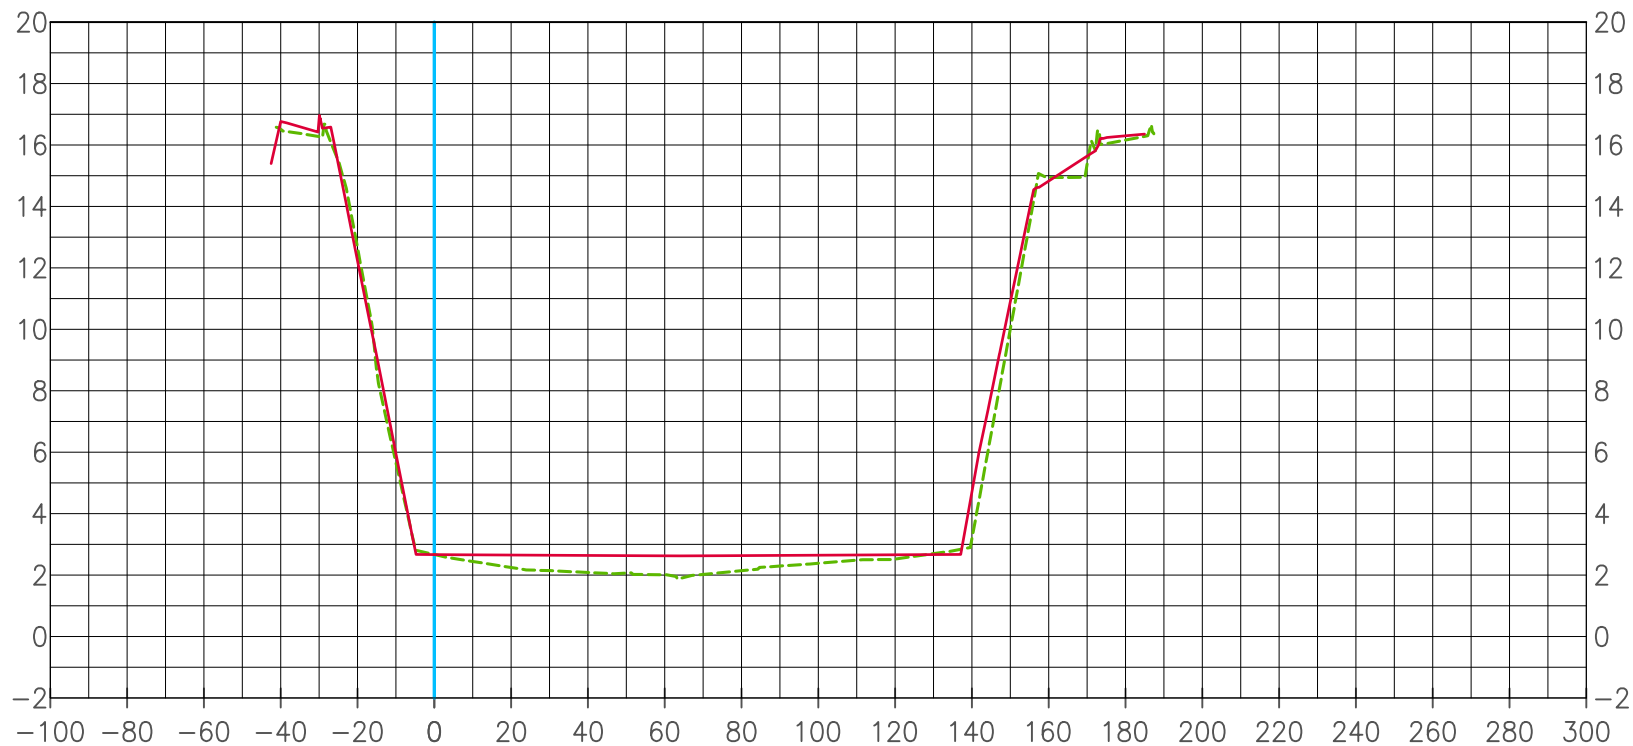

Topography Survey (2019) - - - - -
Record Plan C01B02-101-2 (2000) ———
Construction Centerline ———


Horizontal Scale 1" = 50'
Vertical Scale 1" = 8'

Date Prepared: 04/16/2019

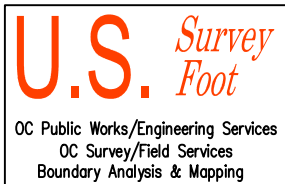

ROSSMOOR RETARDING BASIN

182+50

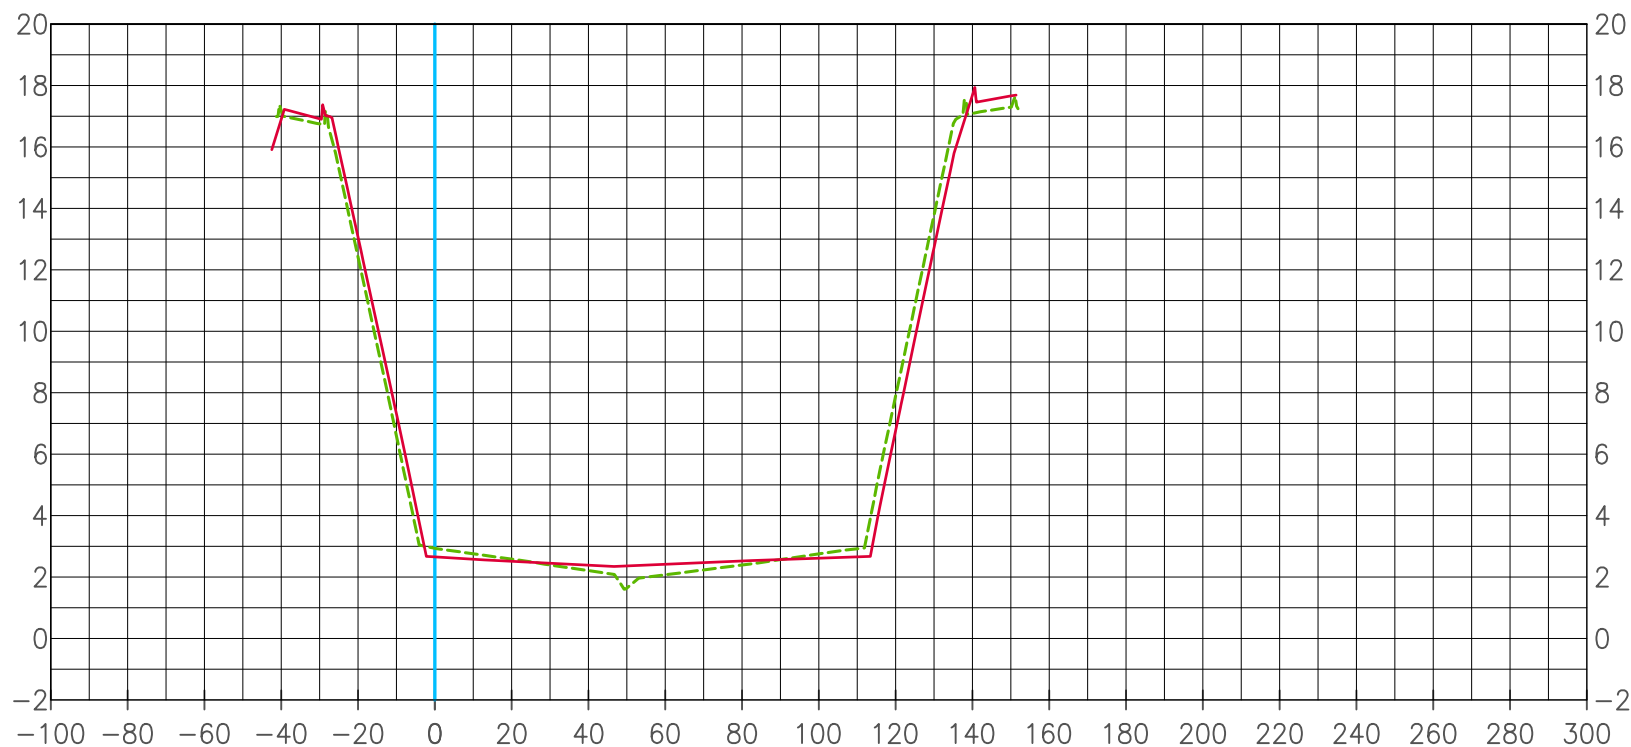

Topography Survey (2019) - - - - -
Record Plan C01B02-101-2 (2000) _____
Construction Centerline _____

Horizontal Scale 1" = 50'
Vertical Scale 1" = 8'


Date Prepared: 04/16/2019

**U.S. Survey
Foot**

OC Public Works/Engineering Services
OC Survey/Field Services
Boundary Analysis & Mapping

ROSSMOOR RETARDING BASIN

185+00

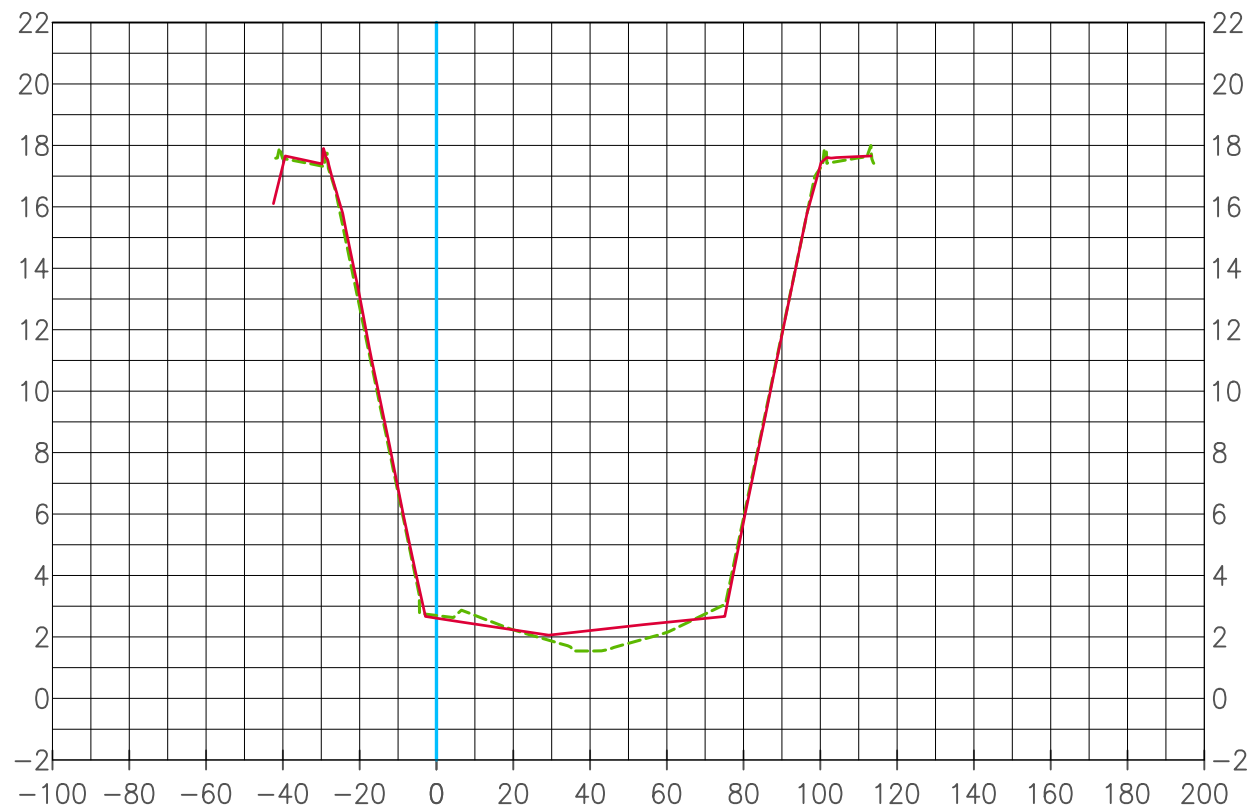

Topography Survey (2019)

Record Plan C01B02-101-2 (2000)

Construction Centerline



Horizontal Scale 1" = 50'

Vertical Scale 1" = 8'


Date Prepared: 04/16/2019

**U.S. Survey
Foot**

OC Public Works/Engineering Services
OC Survey/Field Services
Boundary Analysis & Mapping

ROSSMOOR RETARDING BASIN

187+50

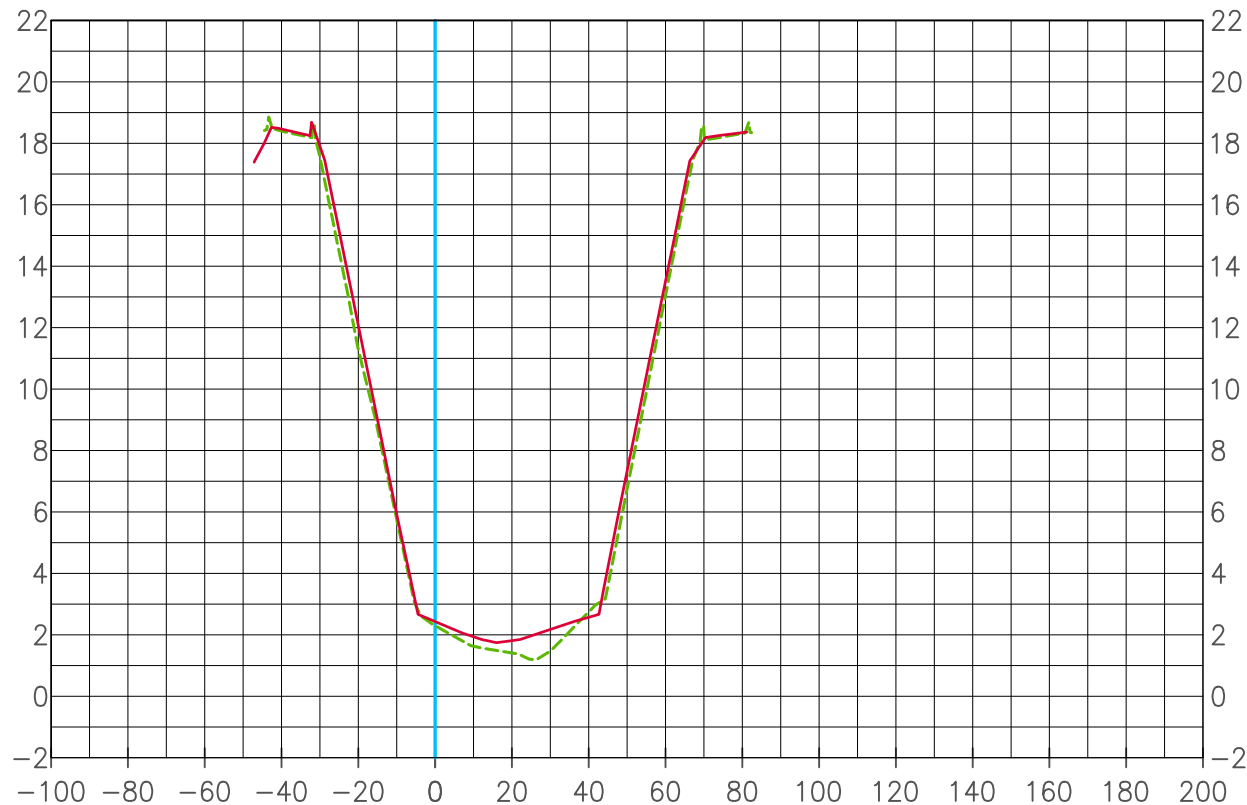

Topography Survey (2019)

Record Plan C01B02-101-2 (2000)


Construction Centerline



Horizontal Scale 1" = 50'


Vertical Scale 1" = 8'

Date Prepared: 04/16/2019

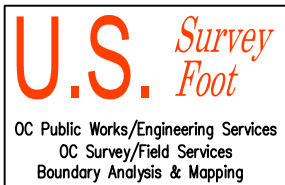

ROSSMOOR RETARDING BASIN

190+00

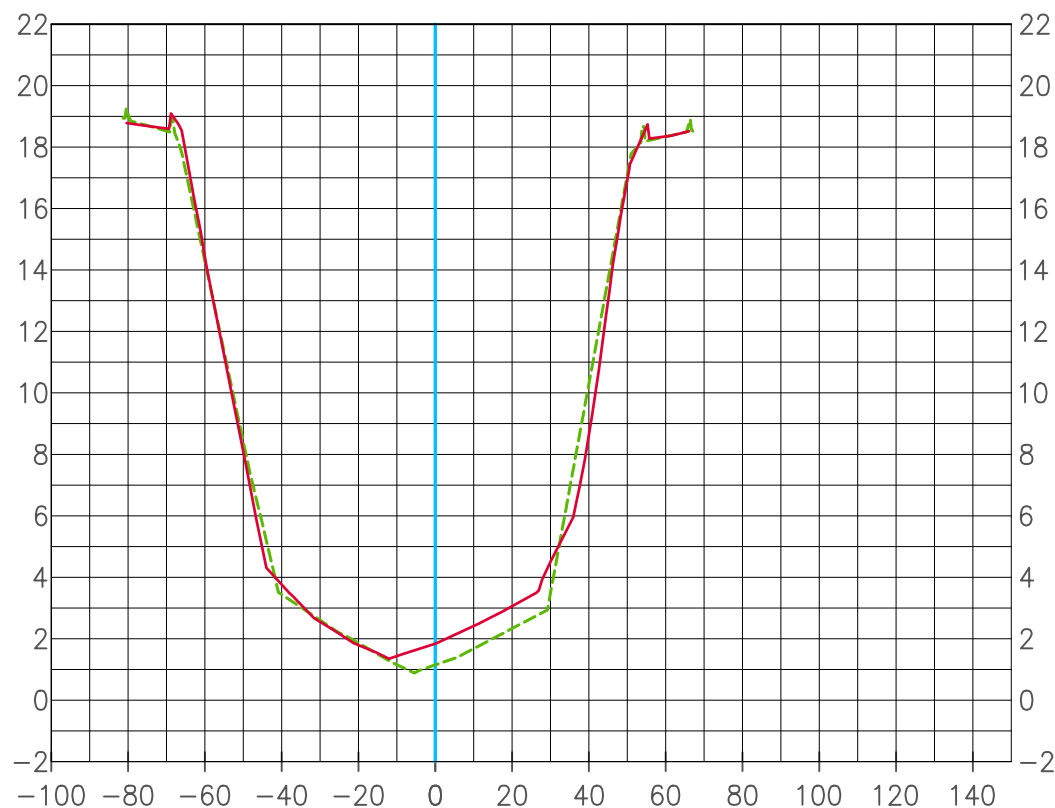

Topography Survey (2019) 
Record Plan C01B02-101-2 (2000) 
Construction Centerline 

Horizontal Scale 1" = 50'
Vertical Scale 1" = 8'


Date Prepared: 04/16/2019

U.S. Survey Foot

OC Public Works/Engineering Services
OC Survey/Field Services
Boundary Analysis & Mapping

ROSSMOOR RETARDING BASIN

192+50

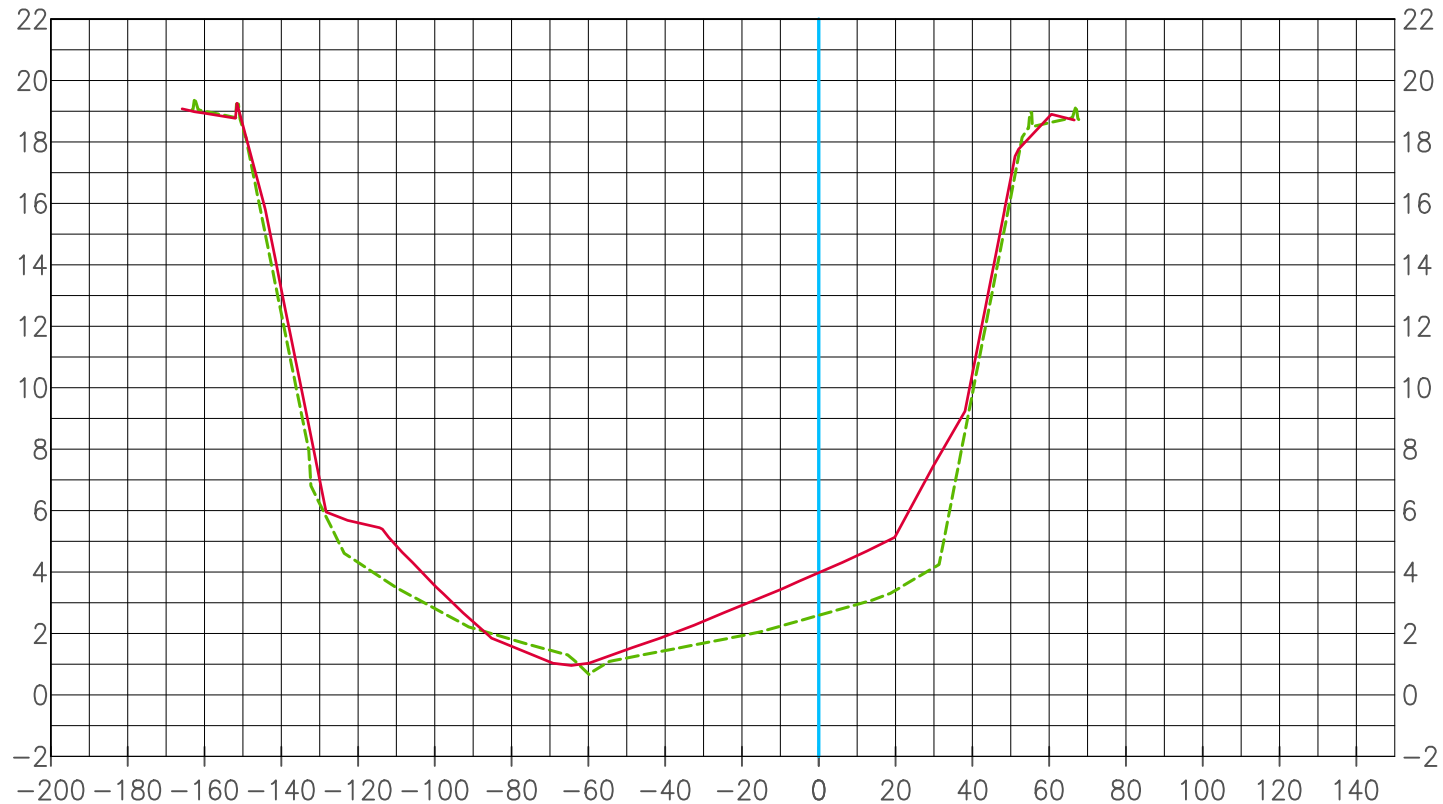

Topography Survey (2019)

Record Plan C01B02-101-2 (2000)

Construction Centerline



Horizontal Scale 1" = 50'

Vertical Scale 1" = 8'


Date Prepared: 04/16/2019

**U.S. Survey
Foot**

OC Public Works/Engineering Services
OC Survey/Field Services
Boundary Analysis & Mapping

ROSSMOOR RETARDING BASIN

195+00

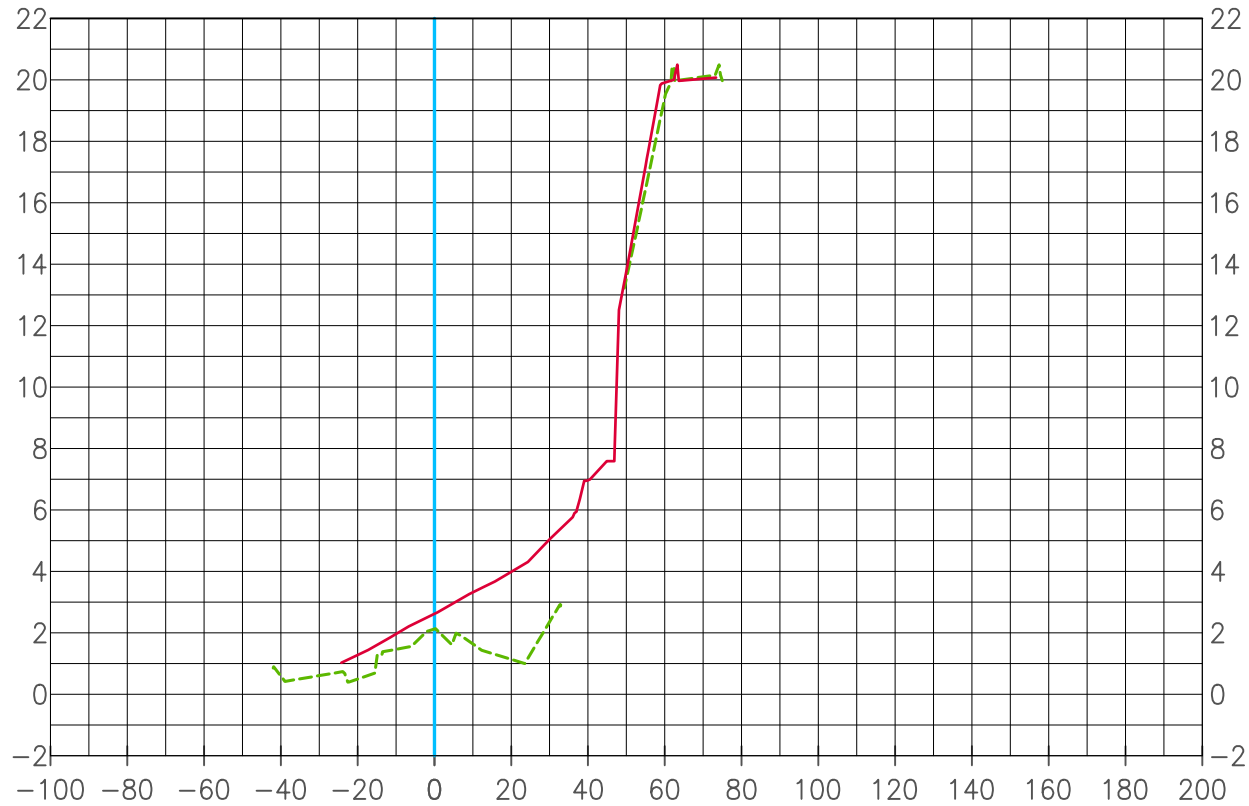

Topography Survey (2019)

Record Plan C01B02-101-2 (2000)

Construction Centerline



Horizontal Scale 1" = 50'

Vertical Scale 1" = 8'

Date Prepared: 04/16/2019

U.S. Survey Foot

OC Public Works/Engineering Services
OC Survey/Field Services
Boundary Analysis & Mapping

ROSSMOOR RETARDING BASIN

197+50



Topography Survey (2019)

Record Plan C01B02-101-2 (2000)

Construction Centerline



Horizontal Scale 1" = 50'


Vertical Scale 1" = 8'

Date Prepared: 04/16/2019



ROSSMOOR RETARDING BASIN

200+00

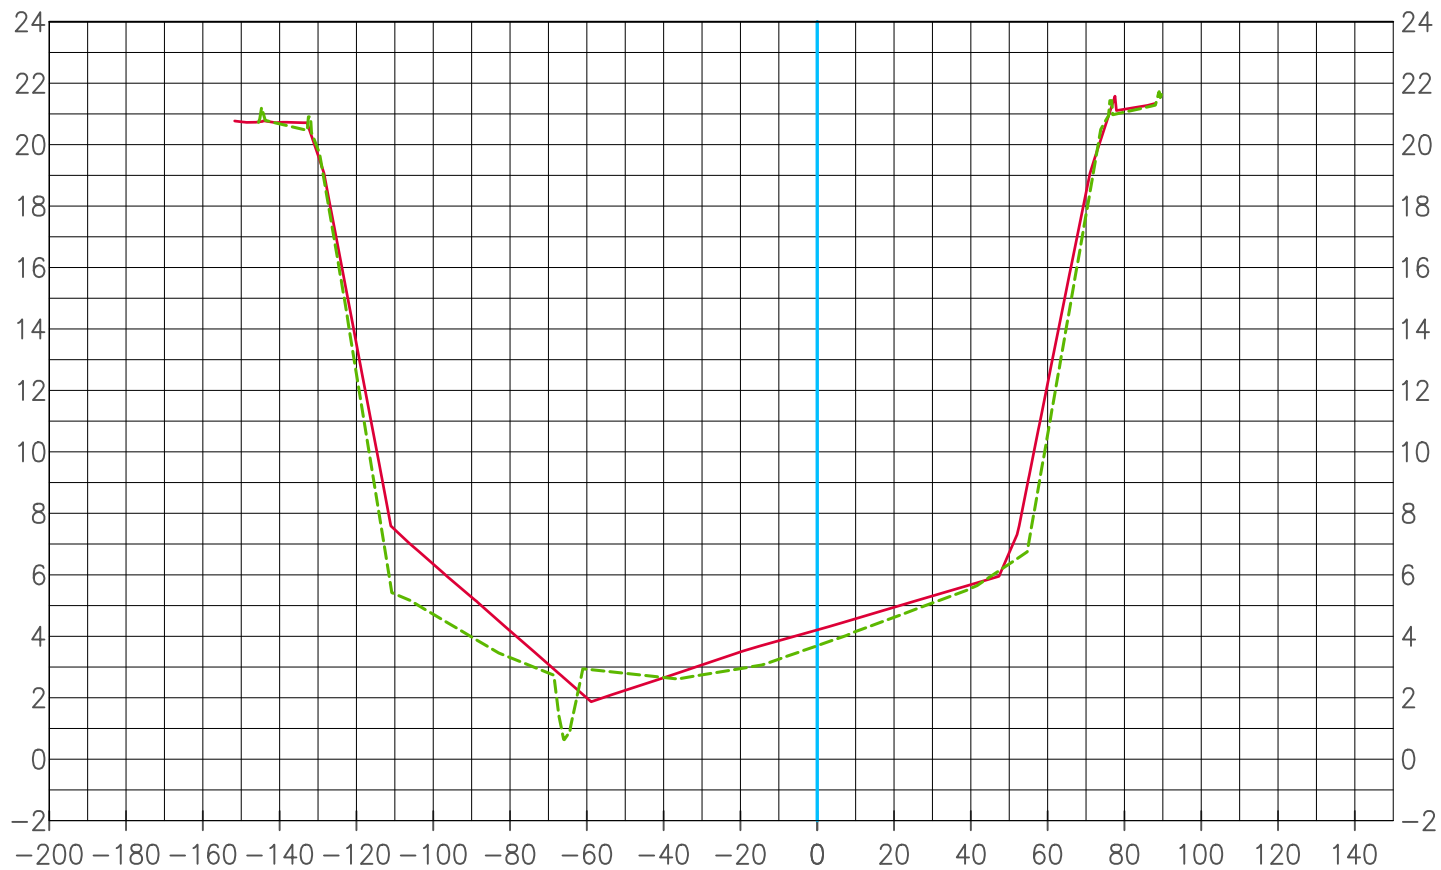


Topography Survey (2019) ---
Record Plan C01B02-101-2 (2000) —
Construction Centerline —

Horizontal Scale 1" = 50'
Vertical Scale 1" = 8'

Date Prepared: 04/16/2019

ROSSMOOR RETARDING BASIN

202+50

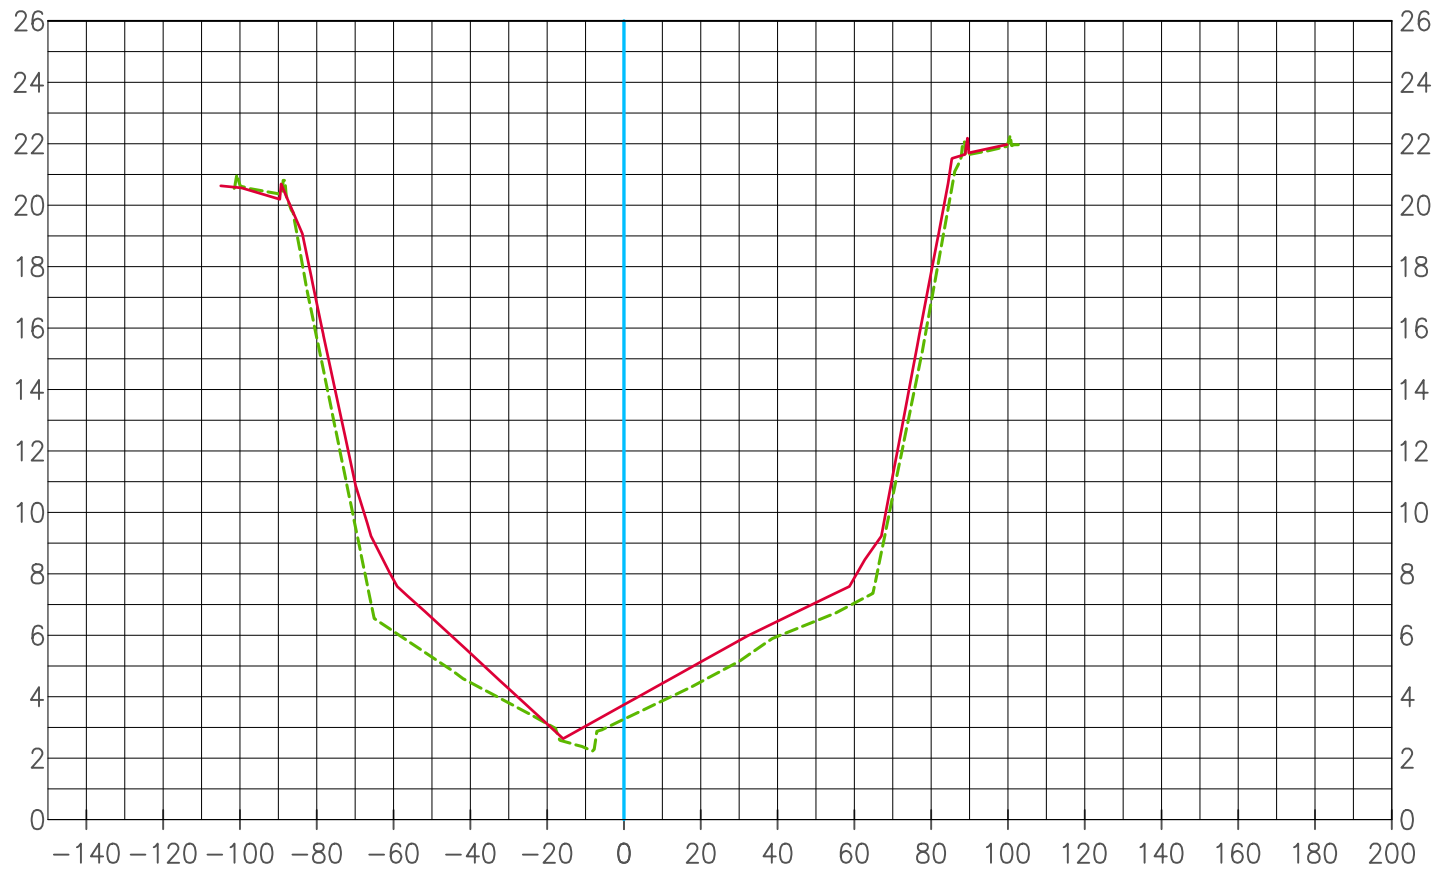

Topography Survey (2019) ---
 Record Plan C01B02-101-2 (2000) —
 Construction Centerline —

Horizontal Scale 1" = 50'
 Vertical Scale 1" = 8'

Date Prepared: 04/16/2019


**U.S. Survey
Foot**

OC Public Works/Engineering Services
OC Survey/Field Services
Boundary Analysis & Mapping



ROSSMOOR RETARDING BASIN

205+00

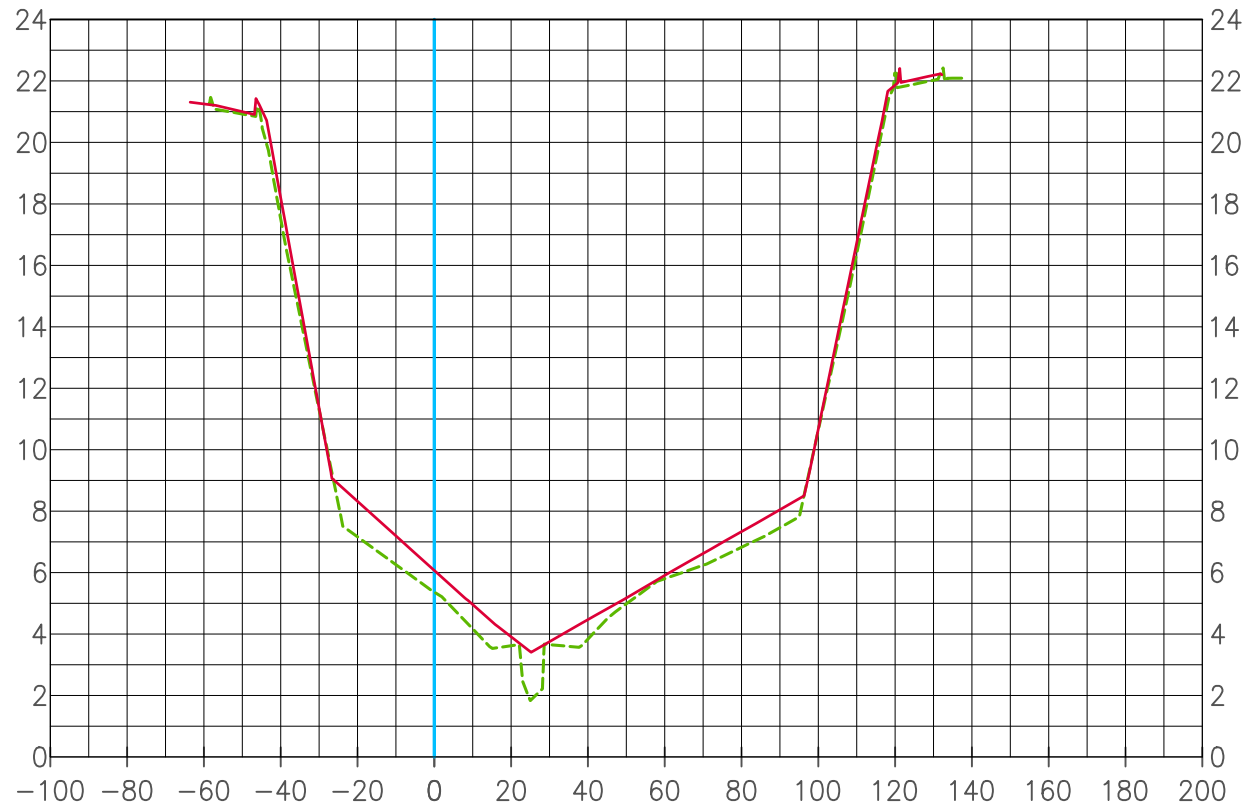

Topography Survey (2019)

Record Plan C01B02-101-2 (2000)

Construction Centerline



Horizontal Scale 1" = 50'

Vertical Scale 1" = 8'

Date Prepared: 04/16/2019


U.S. Survey Foot

OC Public Works/Engineering Services
OC Survey/Field Services
Boundary Analysis & Mapping



ROSSMOOR RETARDING BASIN

207+50

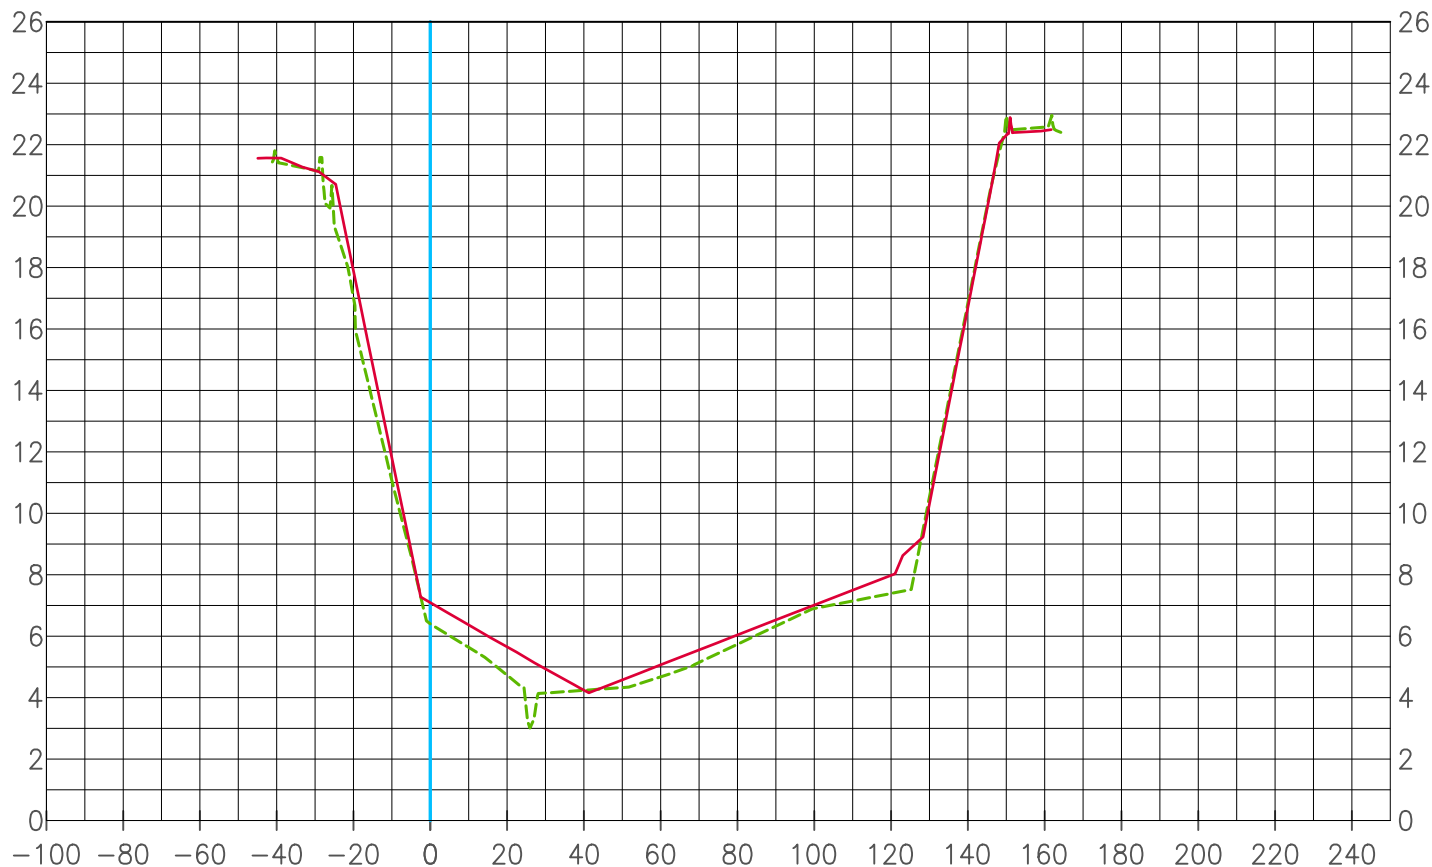

Topography Survey (2019)

Record Plan C01B02-101-2 (2000)

Construction Centerline



Horizontal Scale 1" = 50'

Vertical Scale 1" = 8'

Date Prepared: 04/16/2019

ROSSMOOR RETARDING BASIN

210+00



Topography Survey (2019) ---
 Record Plan C01B02-101-2 (2000) —
 Construction Centerline |

Horizontal Scale 1" = 50'
 Vertical Scale 1" = 8'

Date Prepared: 04/16/2019

**U.S. Survey
Foot**

OC Public Works/Engineering Services
OC Survey/Field Services
Boundary Analysis & Mapping

ROSSMOOR RETARDING BASIN

212+50



Topography Survey (2019)

Record Plan C01B02-101-2 (2000)

Construction Centerline



Horizontal Scale 1" = 50'

Vertical Scale 1" = 8'


Date Prepared: 04/16/2019

**U.S. Survey
Foot**

OC Public Works/Engineering Services
OC Survey/Field Services
Boundary Analysis & Mapping

ROSSMOOR RETARDING BASIN

215+00

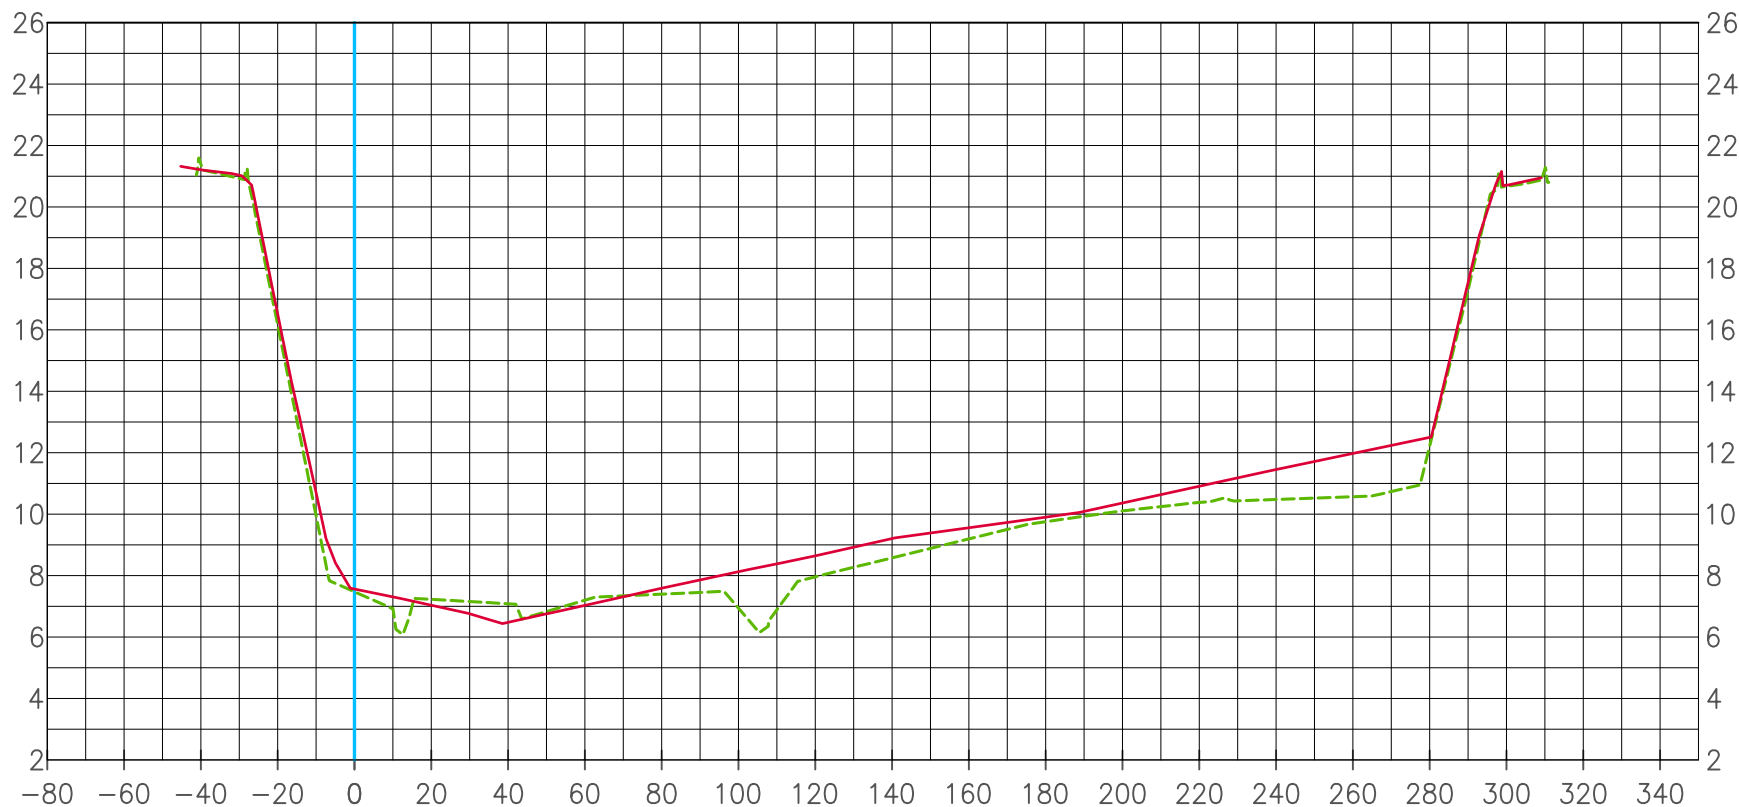

Topography Survey (2019)

Record Plan C01B02-101-2 (2000)

Construction Centerline




Horizontal Scale 1" = 50'

Vertical Scale 1" = 8'

Date Prepared: 04/16/2019

ROSSMOOR RETARDING BASIN

217+50

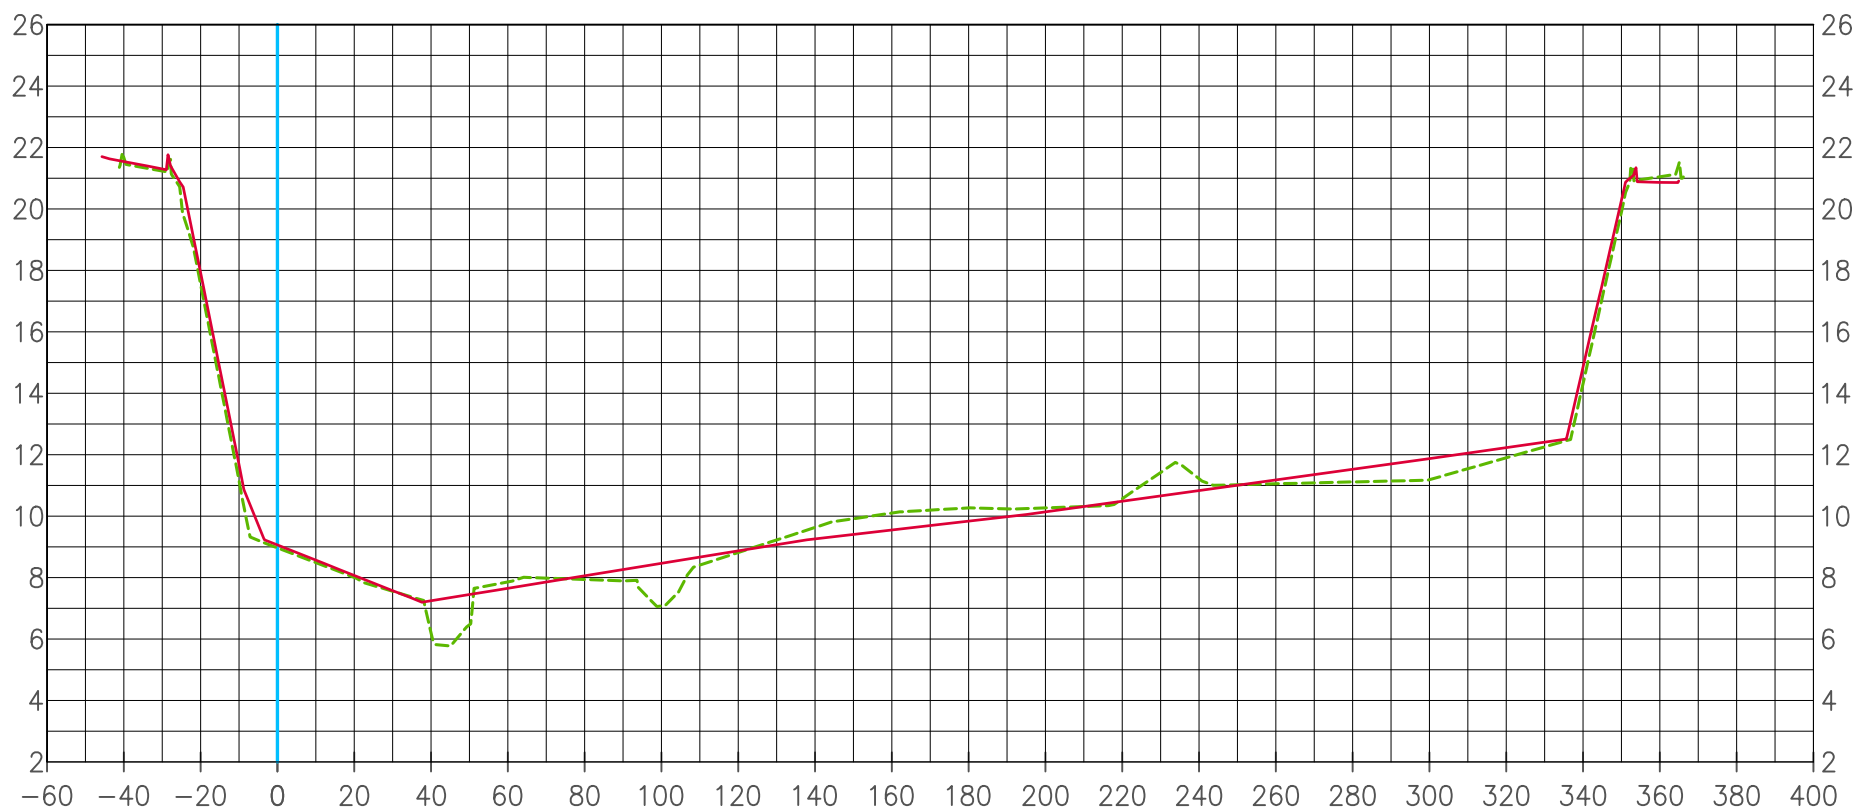

Topography Survey (2019) ---
 Record Plan C01B02-101-2 (2000) —
 Construction Centerline |


Date Prepared: 04/16/2019

Horizontal Scale 1" = 50'
 Vertical Scale 1" = 8'

**U.S. Survey
Foot**

OC Public Works/Engineering Services
OC Survey/Field Services
Boundary Analysis & Mapping

ROSSMOOR RETARDING BASIN 220+00

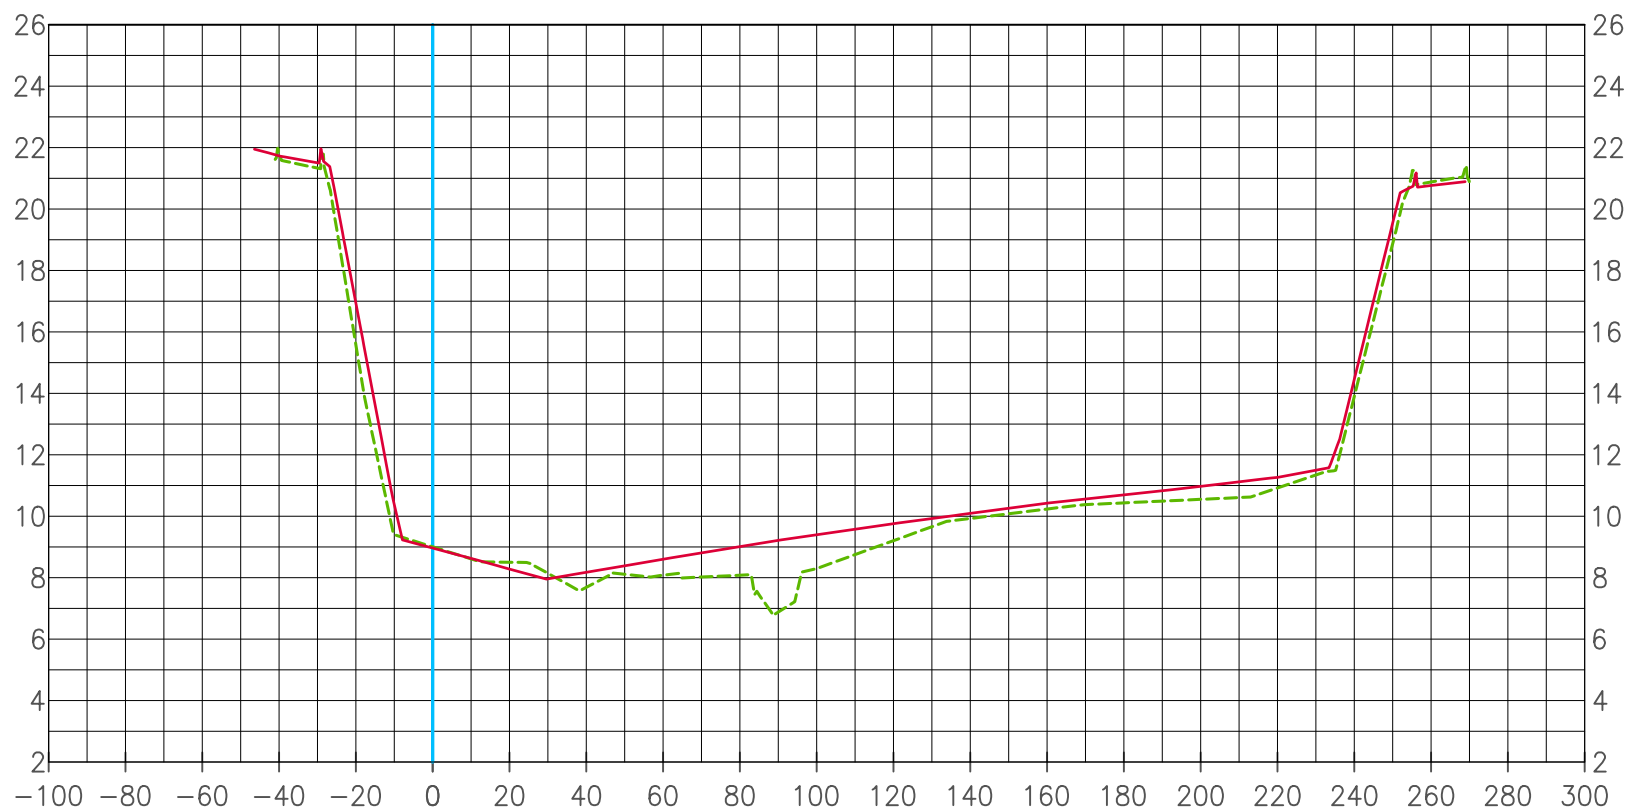

Topography Survey (2019)

Record Plan C01B02-101-2 (2000)


Construction Centerline



Horizontal Scale 1" = 50'

Vertical Scale 1" = 8'

Date Prepared: 04/16/2019

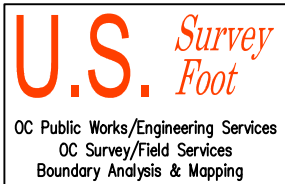

ROSSMOOR RETARDING BASIN


222+50




Topography Survey (2019) - - - - -
Record Plan C01B02-101-2 (2000) _____
Construction Centerline _____

Horizontal Scale 1" = 50'
Vertical Scale 1" = 8'

Date Prepared: 04/16/2019

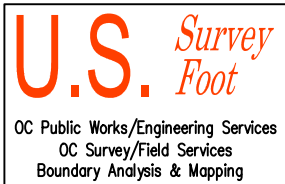

ROSSMOOR RETARDING BASIN 223+20

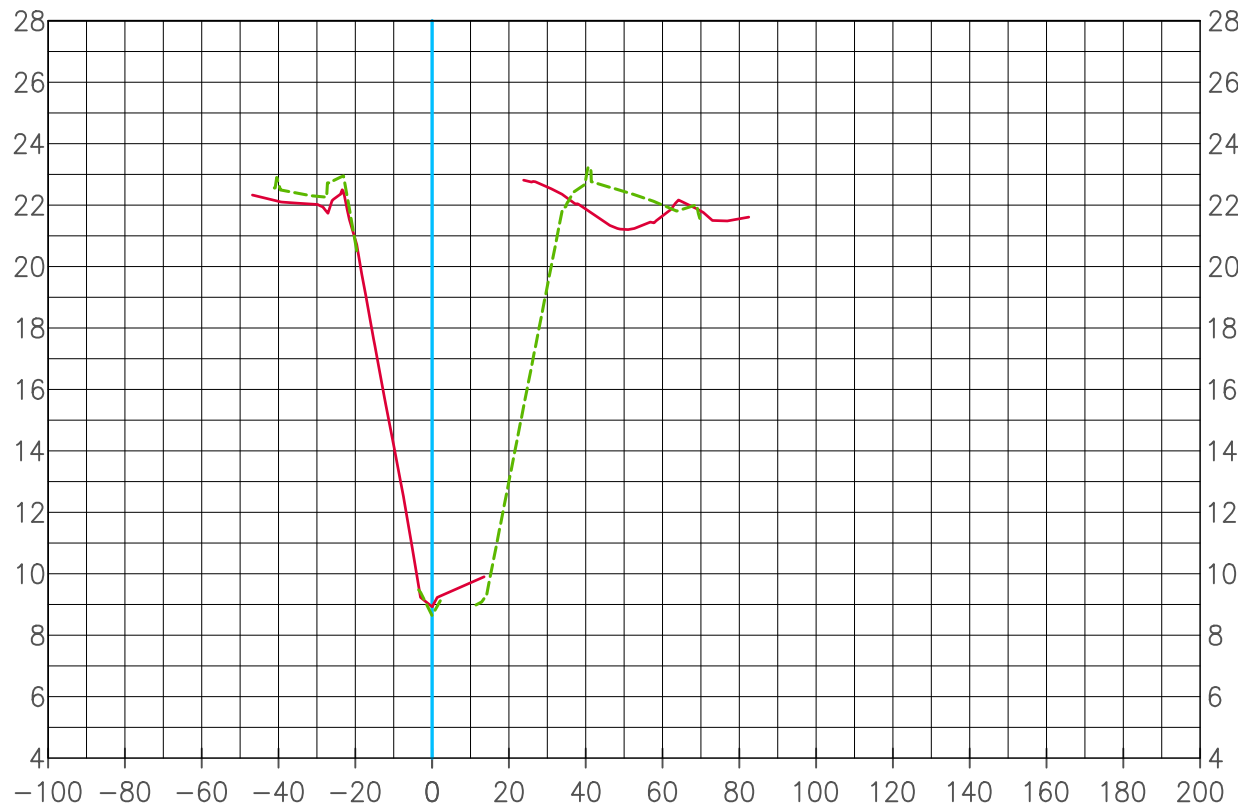

Topography Survey (2019) ---
Record Plan C01B02-101-2 (2000) ---
Construction Centerline ---

Horizontal Scale 1" = 50'
Vertical Scale 1" = 8'

Date Prepared: 04/16/2019