


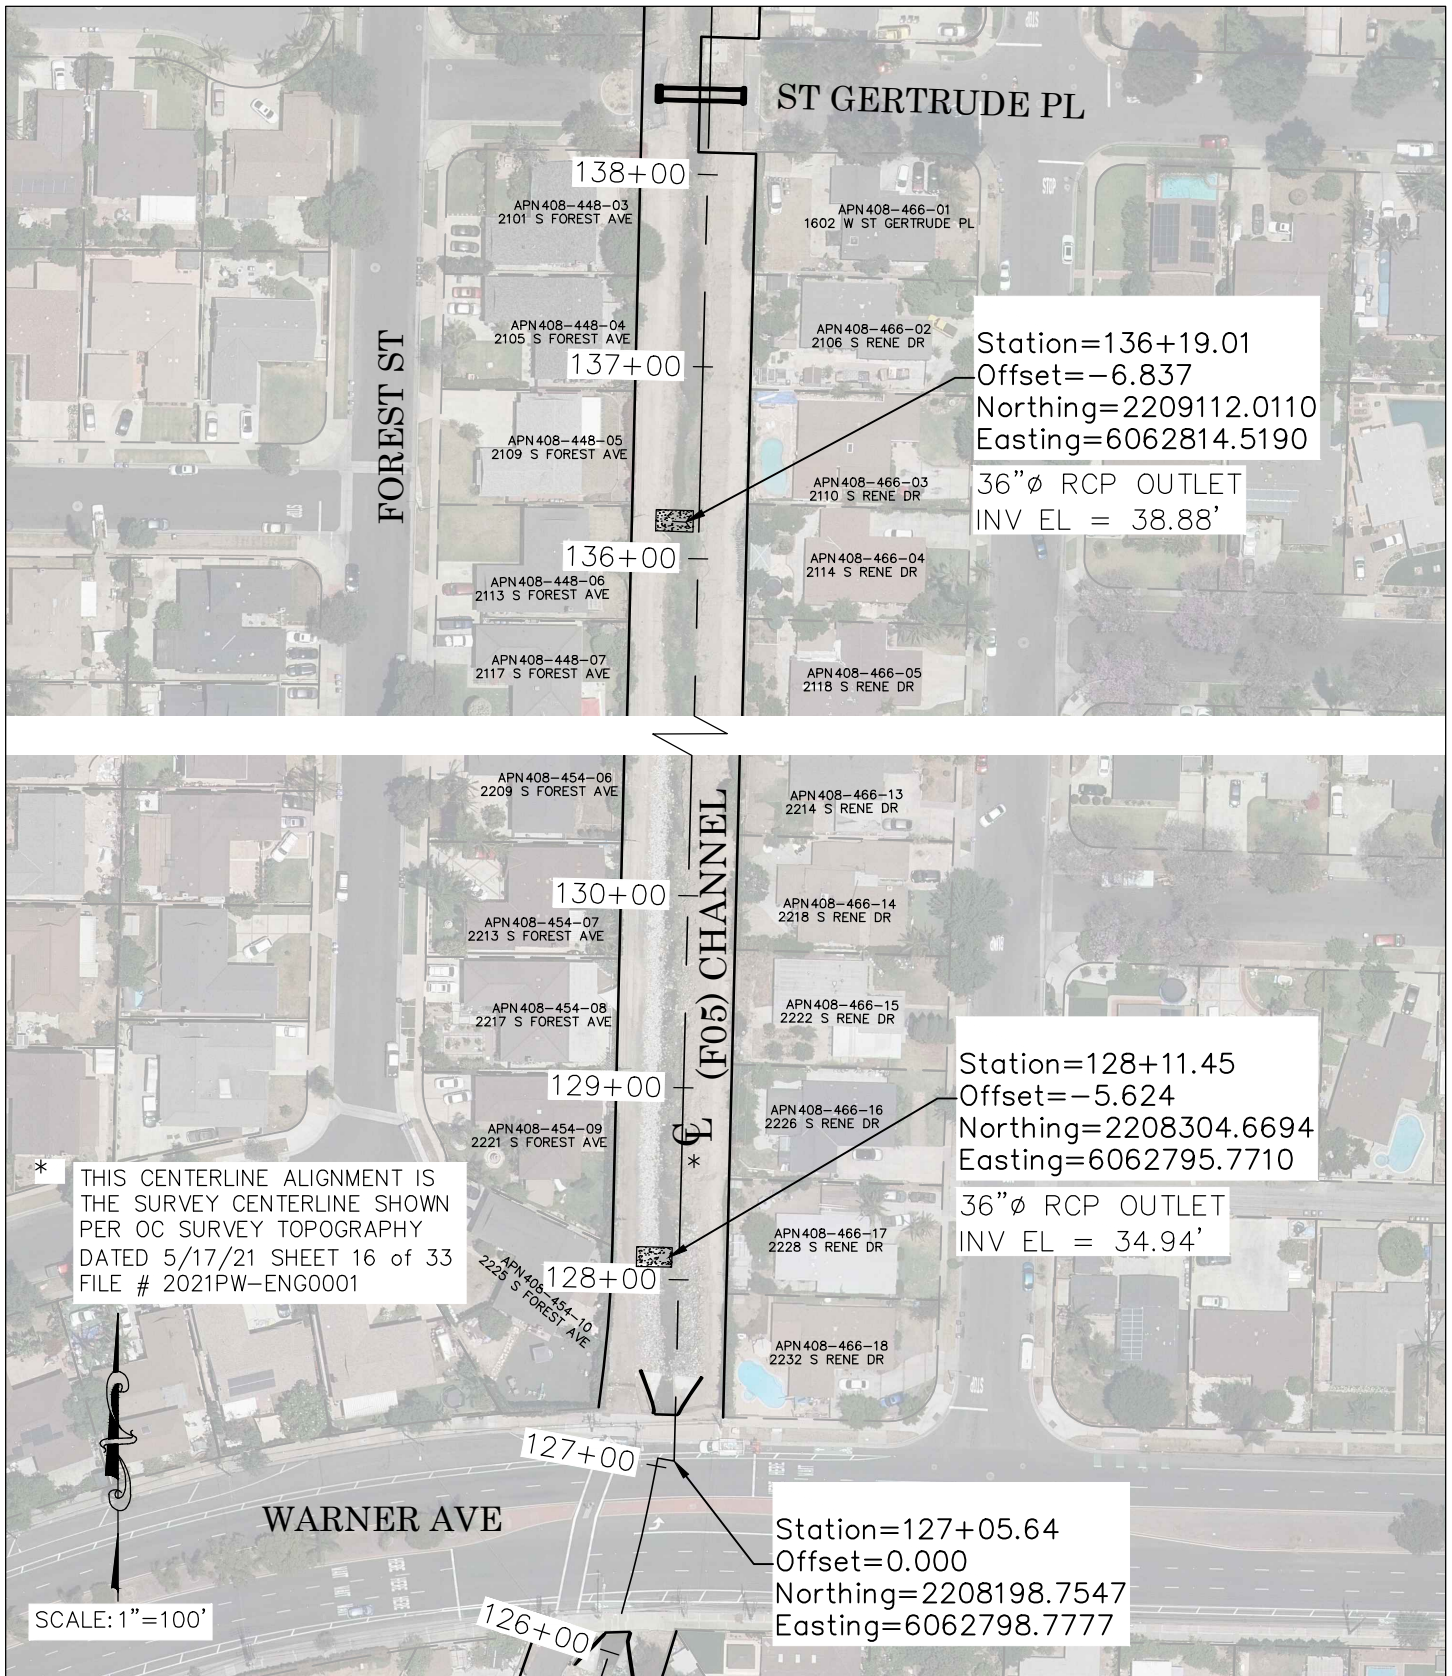

|                                                                                    |                                                              |                 |                                                                                       |
|------------------------------------------------------------------------------------|--------------------------------------------------------------|-----------------|---------------------------------------------------------------------------------------|
| ASBUILT                                                                            | COUNTY OF ORANGE<br>OC PUBLIC WORKS/OC SURVEY/FIELD SERVICES |                 |  |
| PURPOSE:<br>ASBUILT FOR 2 NEW CONCRETE PIPE<br>STRUCTURES INSTALLED PER THIS PHASE | SANTA ANA GARDENS (F02) CHANNEL<br>PHASE 1A ASBUILT          |                 |                                                                                       |
|                                                                                    | DATE                                                         | 5/29/24         |                                                                                       |
|                                                                                    | DRAWN BY:                                                    | M.KUBISTY, PLS  |                                                                                       |
|                                                                                    | CHECKED BY:                                                  | T LOFGREEN, PLS |                                                                                       |
|                                                                                    | W.O. # EF21473                      FILE NO. 2021PW-ENG0001  |                 |                                                                                       |
|                                                                                    |                                                              | SHEET 1 OF 1    |                                                                                       |