



OC PUBLIC WORKS DEPARTMENT

JAMES TREADAWAY, DIRECTOR OF PUBLIC WORKS
KEVIN HILLS, COUNTY SURVEYOR



SILVERADO CANYON DEBRIS REMOVAL


THE CONSTRUCTION ALIGNMENTS SHOWN HEREON ARE DERIVED BY HOLDING THE APPROXIMATED FLOWLINE FROM THE BASE SURFACE AND ARE TO BE USED FOR THIS PROJECT ONLY.

ANDERSON CREEK = 10+00-29+17
SILVERADO CREEK AREA 1 = 40+00-53+47
WILDCAT CREEK = 60+00-73+17
SILVERADO CREEK AREA 2 = 80+00-84+98


THE PRE CONSTRUCTION SURFACE (03/2022) AND THE POST CONSTRUCTION SURFACE (11/2022) WERE BOTH DERIVED BY USING TERRESTRIAL AND AERIAL LIDAR SCANNING. THE FOOTPRINT OF THE HOUSES WHICH ARE SURROUNDING THE CREEK BEDS ARE EXCLUDED FROM THE EXISTING SURFACE AND VOLUME REPORT.

THIS DATA SET WAS PRODUCED TO MEET ASPRS POSITIONAL ACCURACY STANDARDS FOR DIGITAL GEOSPATIAL DATA (2014) FOR 20 CM RMSE VERTICAL ACCURACY CLASS EQUATING TO NVA = ± 39.2 CM AT 95% CONFIDENCE LEVEL AND VVA = ± 60 CM AT THE 95% PERCENTILE.

PROJECT CROSS SECTIONS

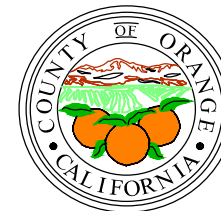

Anderson Creek 10+00 CL

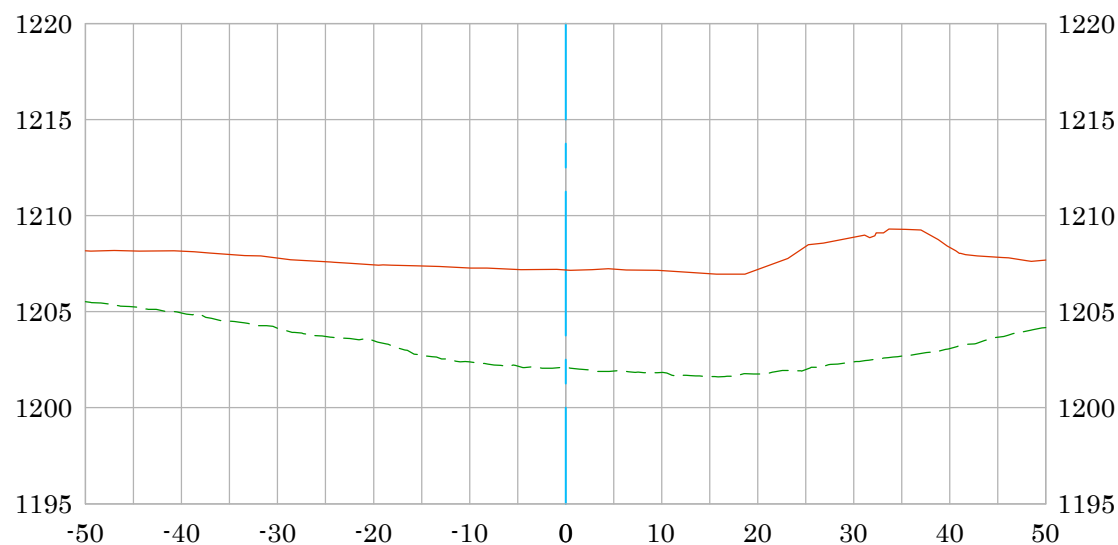


PRE-CONSTRUCTION SURFACE (03/22)

ASBUILT SURFACE POST CONSTRUCTION (11/22)


DATE PREPARED: 12/14/2022

Vert. Scale: 1"=10'

Hor. Scale: 1"=20'

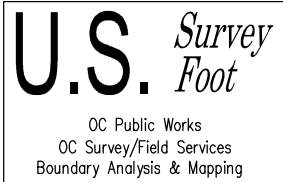

Anderson Creek 10+05 CL

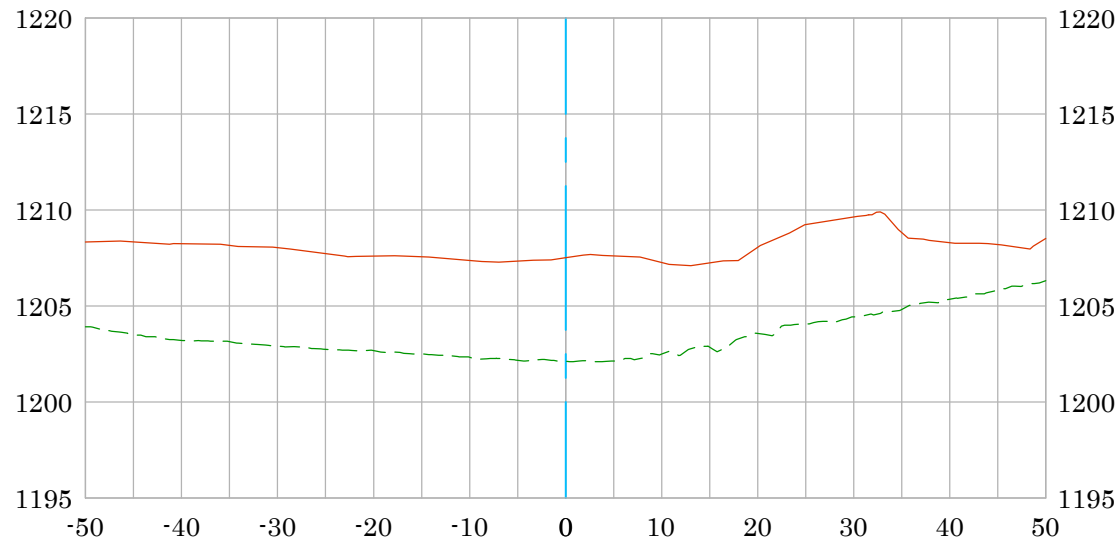

PRE-CONSTRUCTION SURFACE (03/22)

ASBUILT SURFACE POST CONSTRUCTION (11/22)

DATE PREPARED: 12/14/2022

Vert. Scale: 1"=10'


Hor. Scale: 1"=20'

U.S. *Survey*
Foot

OC Public Works
OC Survey/Field Services
Boundary Analysis & Mapping



Anderson Creek 10+13 CL

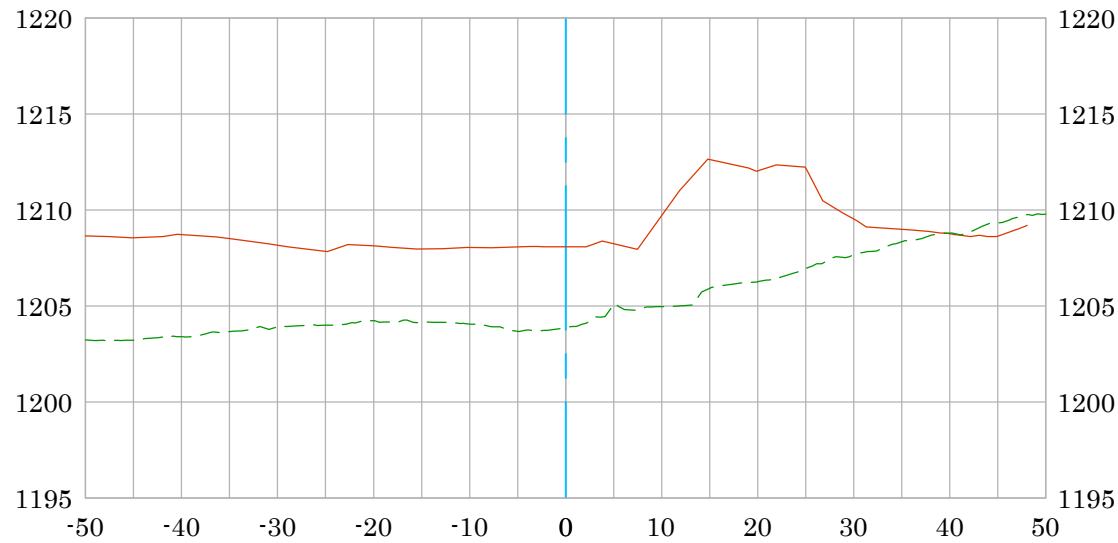


PRE-CONSTRUCTION SURFACE (03/22)

ASBUILT SURFACE POST CONSTRUCTION (11/22)


DATE PREPARED: 12/14/2022

Vert. Scale: 1"=10'

Hor. Scale: 1"=20'

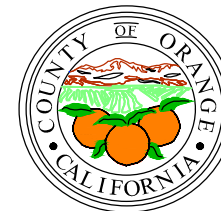

Anderson Creek Outlet 10+20 CL

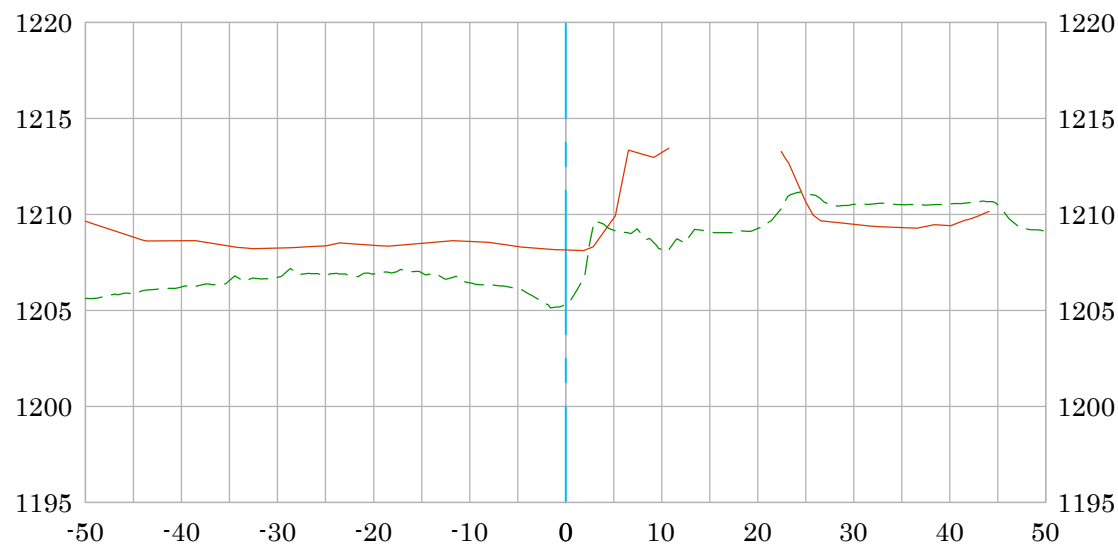

PRE-CONSTRUCTION SURFACE (03/22)

ASBUILT SURFACE POST CONSTRUCTION (11/22)

DATE PREPARED: 12/14/2022

Vert. Scale: 1"=10'


Hor. Scale: 1"=20'

U.S. *Survey*
Foot

OC Public Works
OC Survey/Field Services
Boundary Analysis & Mapping



Anderson Creek 10+27 CL

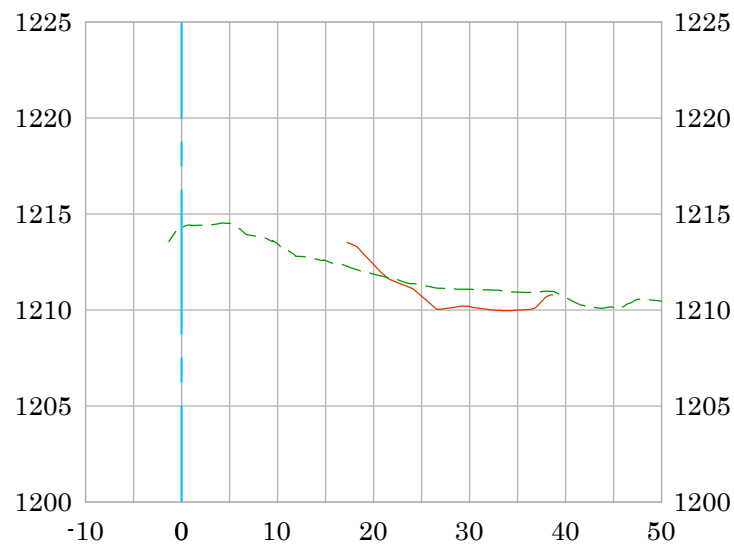


PRE-CONSTRUCTION SURFACE (03/22)

ASBUILT SURFACE POST CONSTRUCTION (11/22)


DATE PREPARED: 12/14/2022

Vert. Scale: 1"=10'

Hor. Scale: 1"=20'

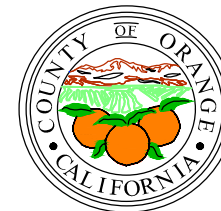

Anderson Creek 10+35 CL

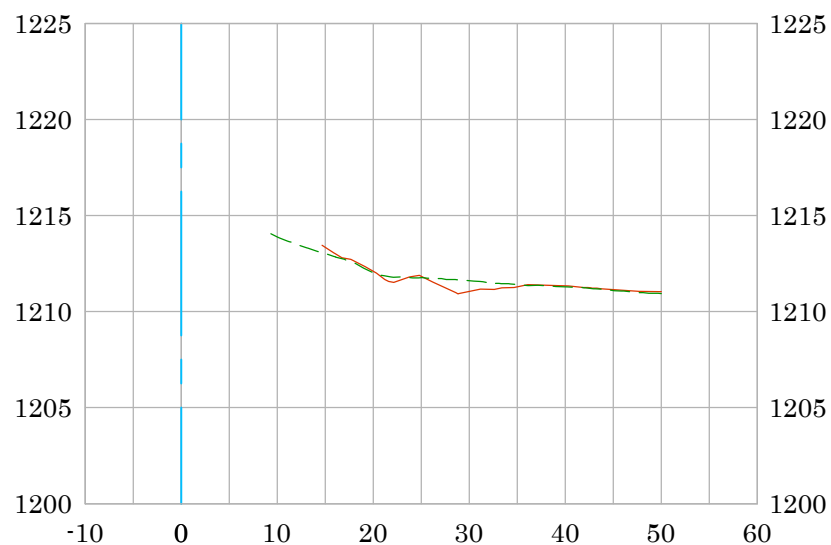

PRE-CONSTRUCTION SURFACE (03/22)

ASBUILT SURFACE POST CONSTRUCTION (11/22)


DATE PREPARED: 12/14/2022

—————


- - - - -

Vert. Scale: 1"=10'

Hor. Scale: 1"=20'

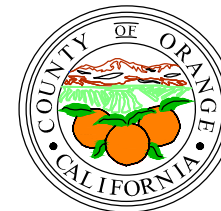

Anderson Creek 10+50 CL

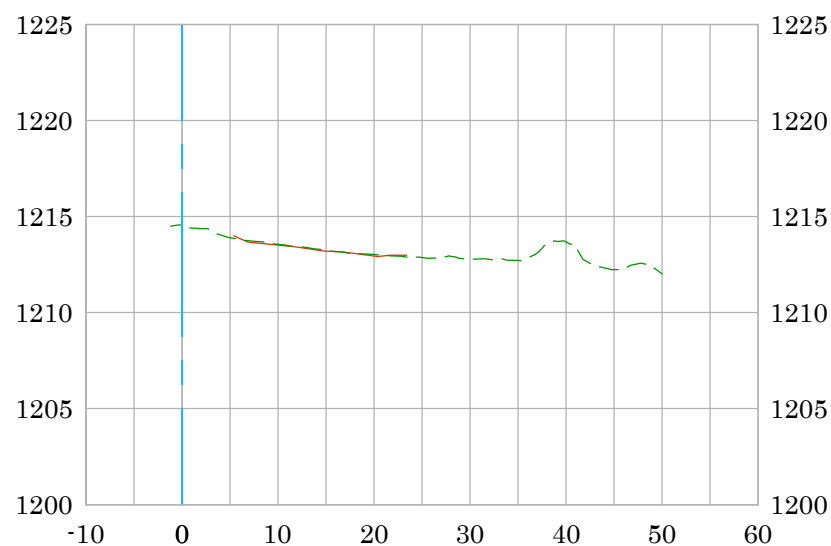

PRE-CONSTRUCTION SURFACE (03/22)

ASBUILT SURFACE POST CONSTRUCTION (11/22)


DATE PREPARED: 12/14/2022

—————


- - - - -

Vert. Scale: 1"=10'

Hor. Scale: 1"=20'

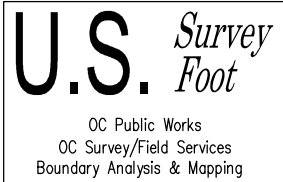

Anderson Creek 11+00 CL

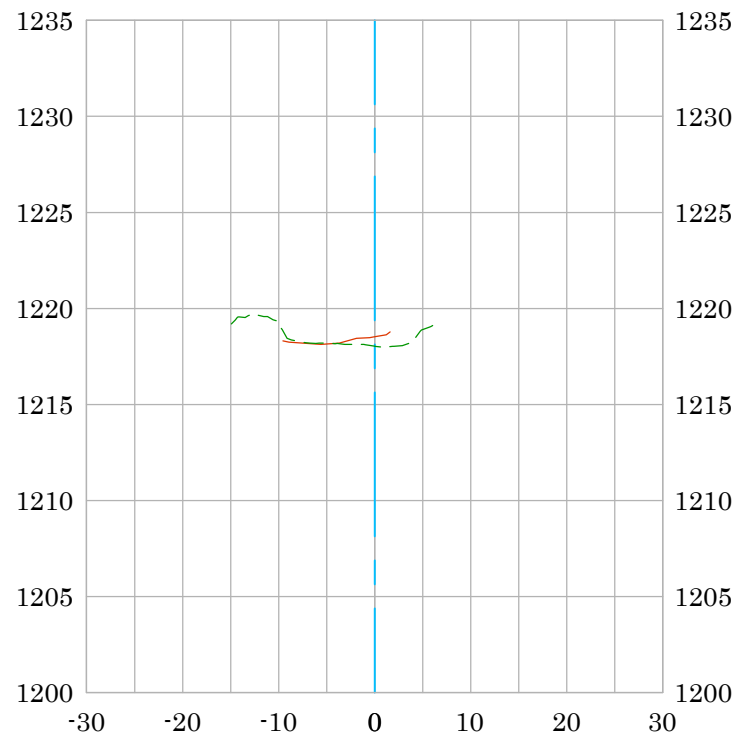

PRE-CONSTRUCTION SURFACE (03/22)

ASBUILT SURFACE POST CONSTRUCTION (11/22)

DATE PREPARED: 12/14/2022

Vert. Scale: 1"=10'


Hor. Scale: 1"=20'

U.S. *Survey*
Foot

OC Public Works
OC Survey/Field Services
Boundary Analysis & Mapping



Anderson Creek 11+15 CL

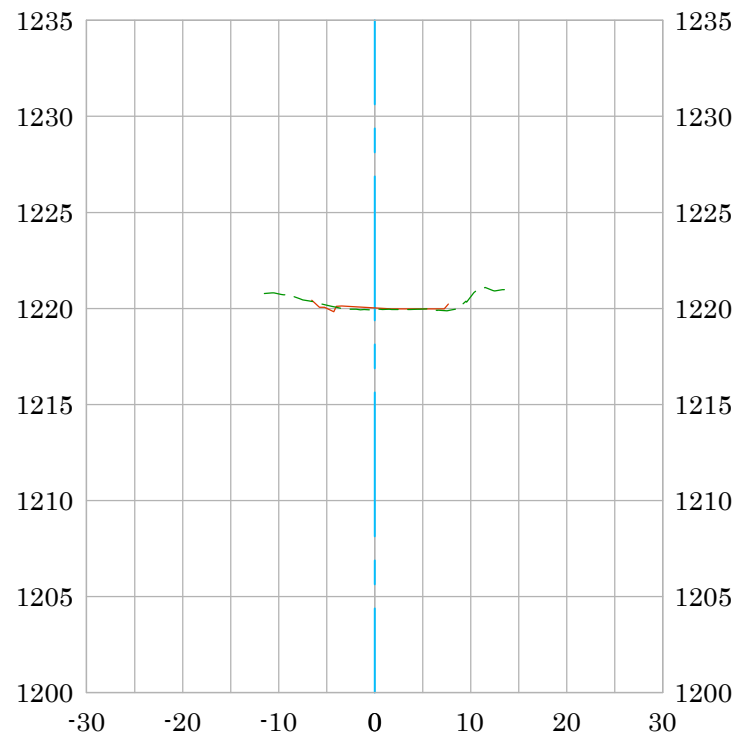


PRE-CONSTRUCTION SURFACE (03/22)

ASBUILT SURFACE POST CONSTRUCTION (11/22)


DATE PREPARED: 12/14/2022

Vert. Scale: 1"=10'

Hor. Scale: 1"=20'

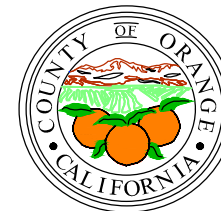

Anderson Creek 11+23 CL

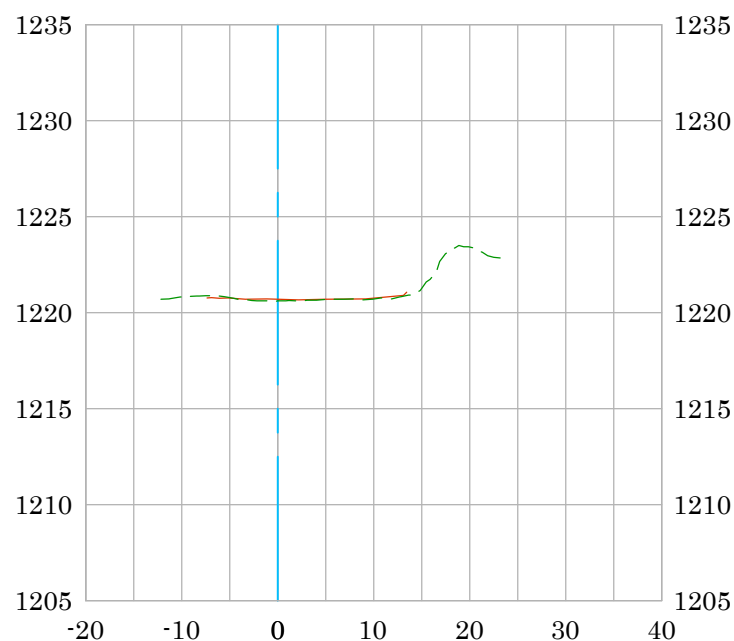

PRE-CONSTRUCTION SURFACE (03/22)

ASBUILT SURFACE POST CONSTRUCTION (11/22)


DATE PREPARED: 12/14/2022

—————


- - - - -

Vert. Scale: 1"=10'

Hor. Scale: 1"=20'

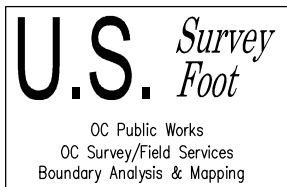

Anderson Creek Inlet 11+30 CL

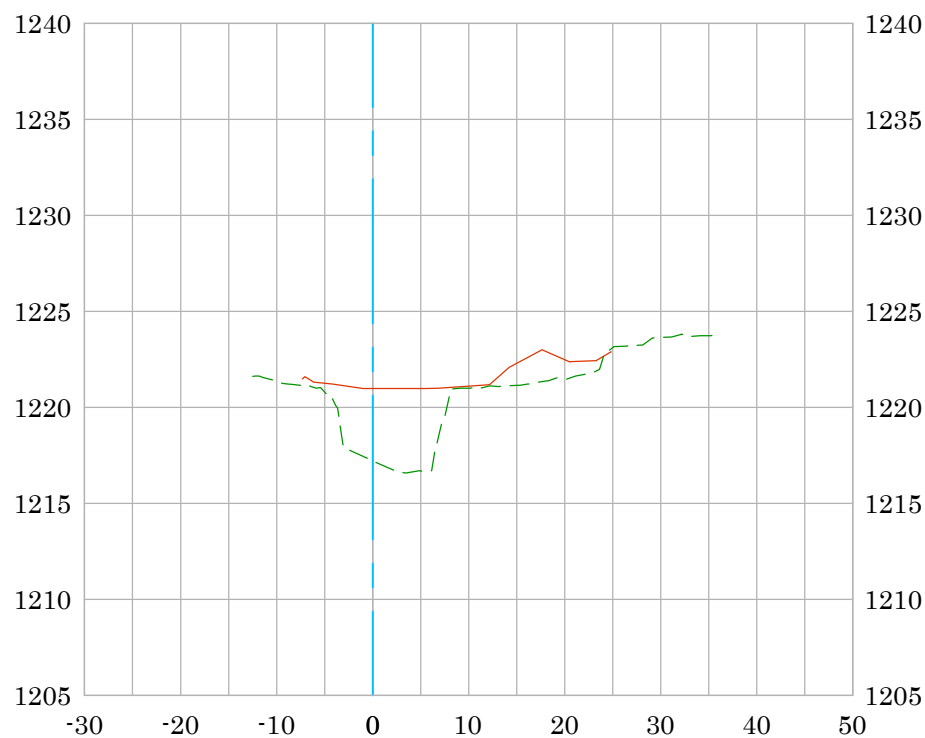

PRE-CONSTRUCTION SURFACE (03/22)

ASBUILT SURFACE POST CONSTRUCTION (11/22)

DATE PREPARED: 12/14/2022

Vert. Scale: 1"=10'


Hor. Scale: 1"=20'

U.S. *Survey*
Foot

OC Public Works
OC Survey/Field Services
Boundary Analysis & Mapping



Anderson Creek 11+37 CL

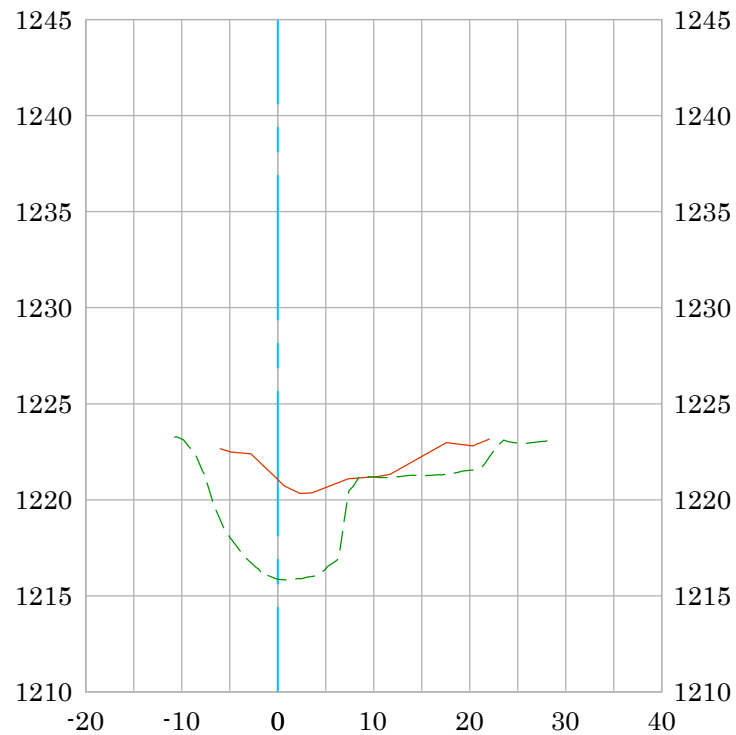

PRE-CONSTRUCTION SURFACE (03/22)


ASBUILT SURFACE POST CONSTRUCTION (11/22)

DATE PREPARED: 12/14/2022

Vert. Scale: 1"=10'

Hor. Scale: 1"=20'

Anderson Creek 11+45 CL

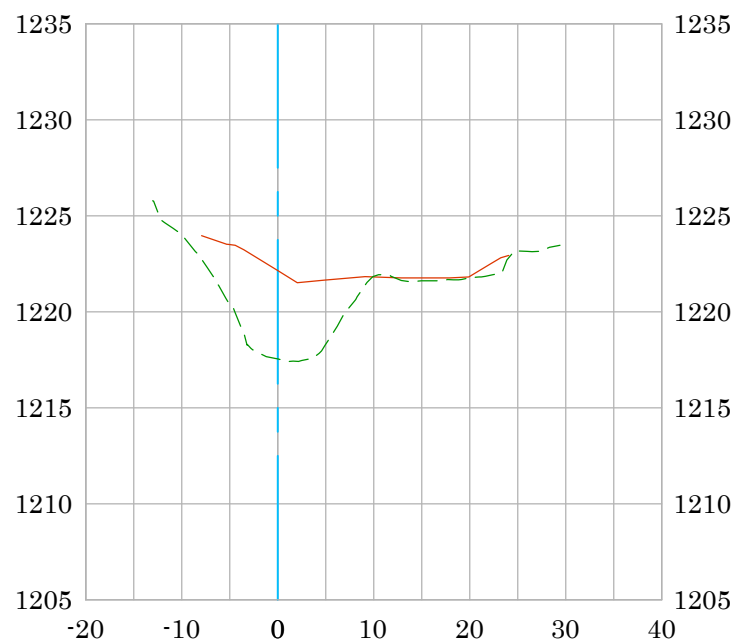

PRE-CONSTRUCTION SURFACE (03/22)

ASBUILT SURFACE POST CONSTRUCTION (11/22)

DATE PREPARED: 12/14/2022



Vert. Scale: 1"=10'


Hor. Scale: 1"=20'

U.S. *Survey
Foot*

OC Public Works
OC Survey/Field Services
Boundary Analysis & Mapping



Anderson Creek 11+50 CL

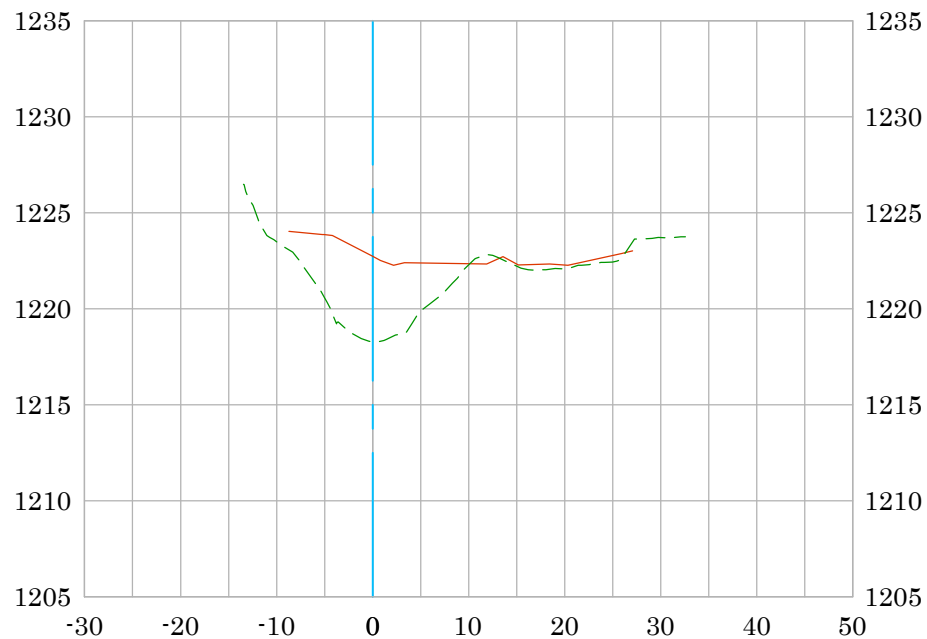

PRE-CONSTRUCTION SURFACE (03/22)

ASBUILT SURFACE POST CONSTRUCTION (11/22)

DATE PREPARED: 12/14/2022

Vert. Scale: 1"=10'


Hor. Scale: 1"=20'

U.S. *Survey*
Foot

OC Public Works
OC Survey/Field Services
Boundary Analysis & Mapping



Anderson Creek 11+94 CL

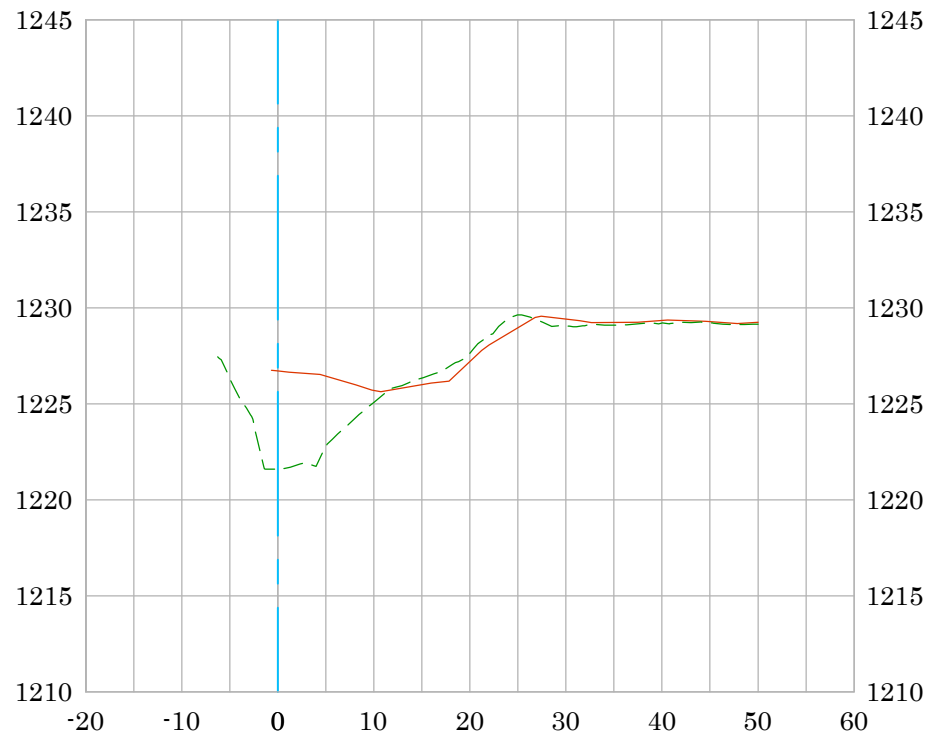


PRE-CONSTRUCTION SURFACE (03/22)

ASBUILT SURFACE POST CONSTRUCTION (11/22)


DATE PREPARED: 12/14/2022

Vert. Scale: 1"=10'

Hor. Scale: 1"=20'

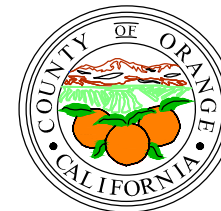

Anderson Creek 12+00 CL

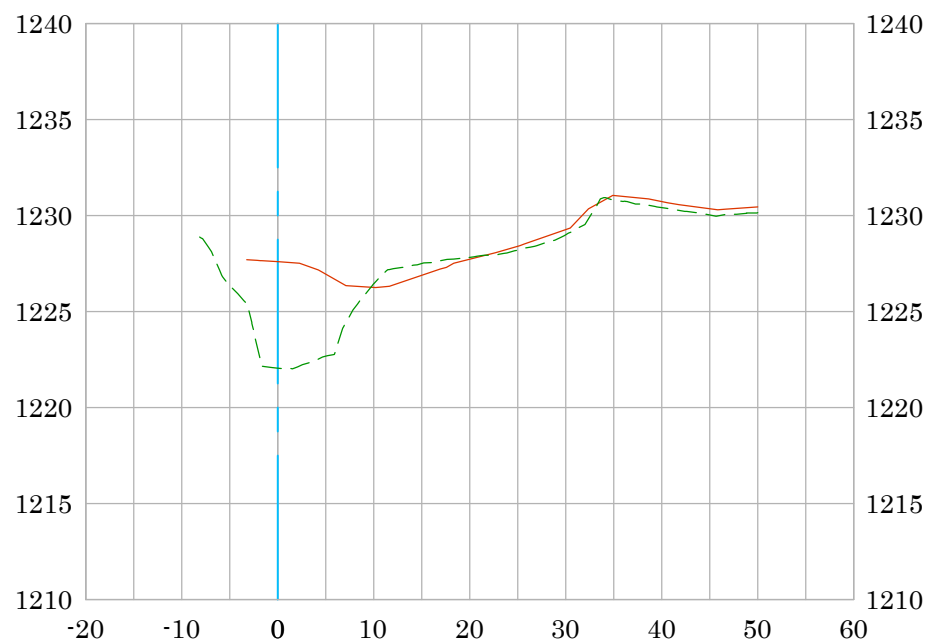

PRE-CONSTRUCTION SURFACE (03/22)

ASBUILT SURFACE POST CONSTRUCTION (11/22)

DATE PREPARED: 12/14/2022

—————

- - - - -

Vert. Scale: 1"=10'


Hor. Scale: 1"=20'

U.S. *Survey*
Foot

OC Public Works
OC Survey/Field Services
Boundary Analysis & Mapping



Anderson Creek 12+02 CL

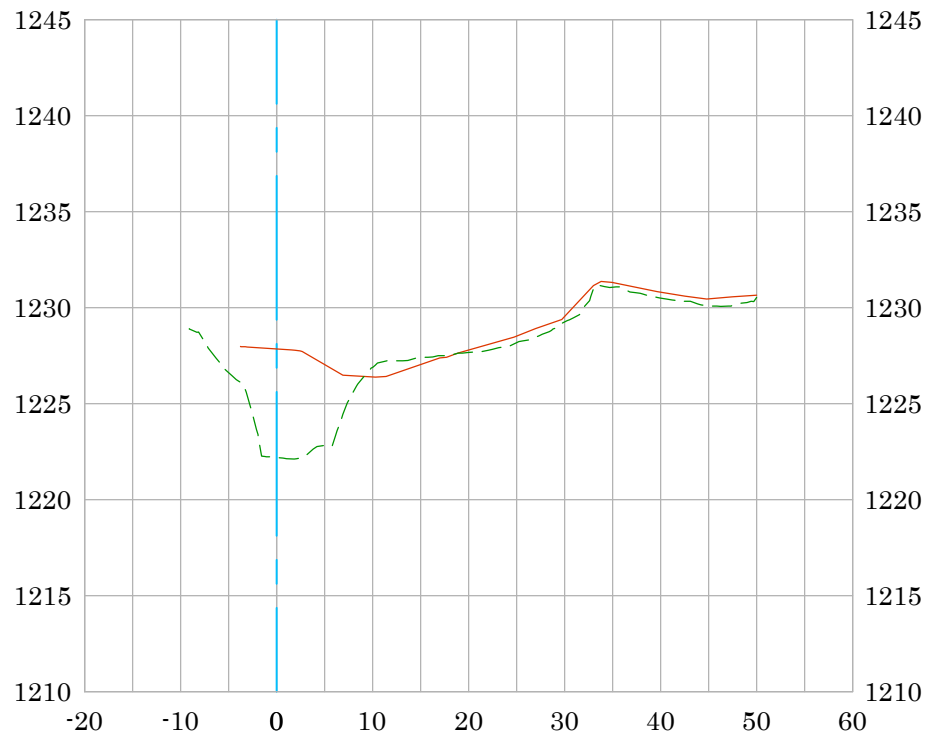

PRE-CONSTRUCTION SURFACE (03/22)

ASBUILT SURFACE POST CONSTRUCTION (11/22)

DATE PREPARED: 12/14/2022

Vert. Scale: 1"=10'


Hor. Scale: 1"=20'

U.S. *Survey*
Foot

OC Public Works
OC Survey/Field Services
Boundary Analysis & Mapping



Anderson Creek Bridge Crossing 12+09 CL

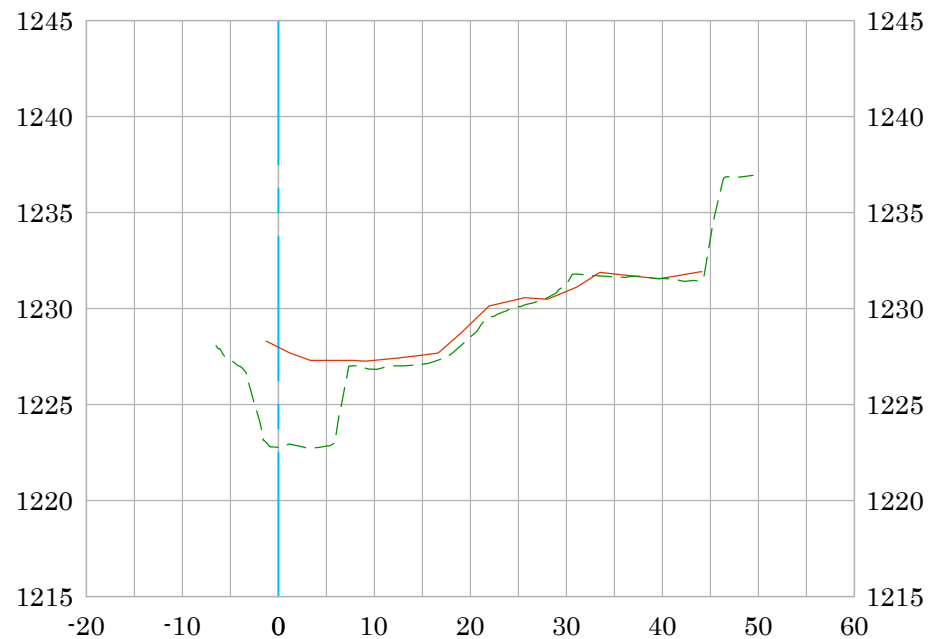

PRE-CONSTRUCTION SURFACE (03/22)

ASBUILT SURFACE POST CONSTRUCTION (11/22)

DATE PREPARED: 12/14/2022

Vert. Scale: 1"=10'


Hor. Scale: 1"=20'

U.S. *Survey*
Foot

OC Public Works
OC Survey/Field Services
Boundary Analysis & Mapping



Anderson Creek 12+16 CL

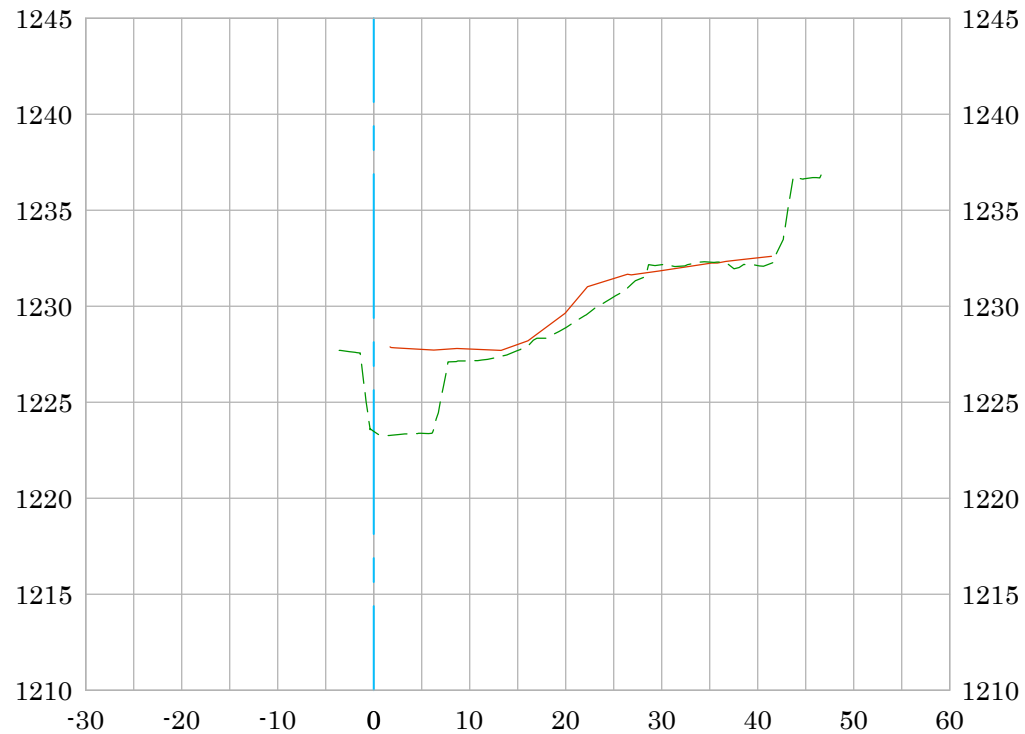

PRE-CONSTRUCTION SURFACE (03/22)

ASBUILT SURFACE POST CONSTRUCTION (11/22)


DATE PREPARED: 12/14/2022

Vert. Scale: 1"=10'

Hor. Scale: 1"=20'



Anderson Creek 12+24 CL

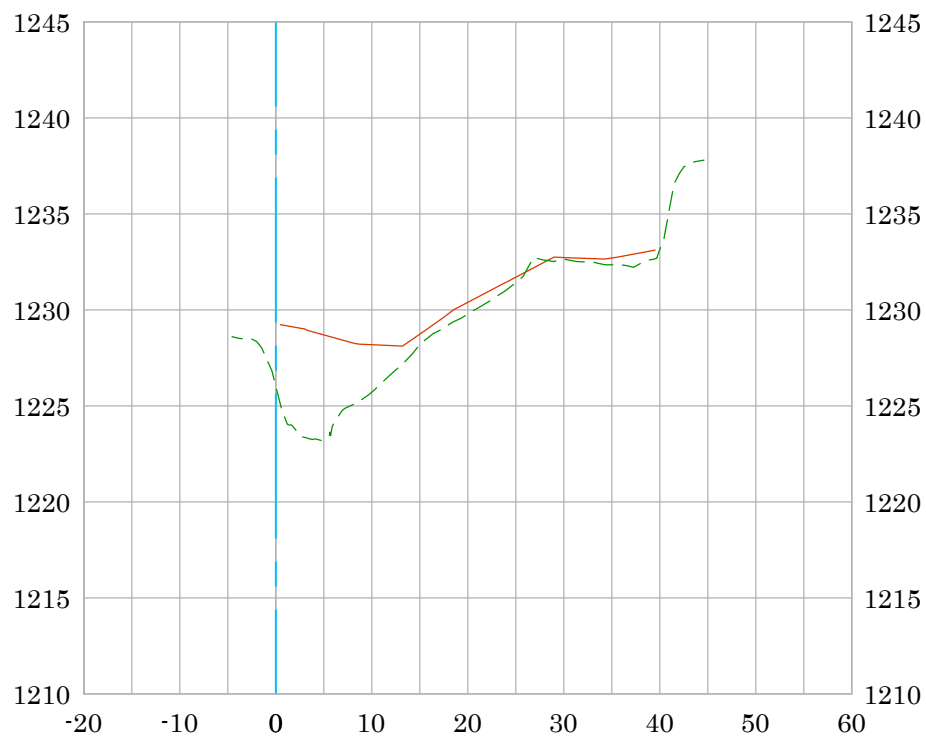


PRE-CONSTRUCTION SURFACE (03/22)

ASBUILT SURFACE POST CONSTRUCTION (11/22)


DATE PREPARED: 12/14/2022

Vert. Scale: 1"=10'

Hor. Scale: 1"=20'

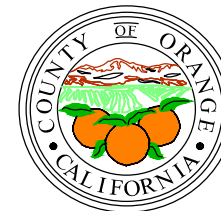

Anderson Creek 12+50 CL

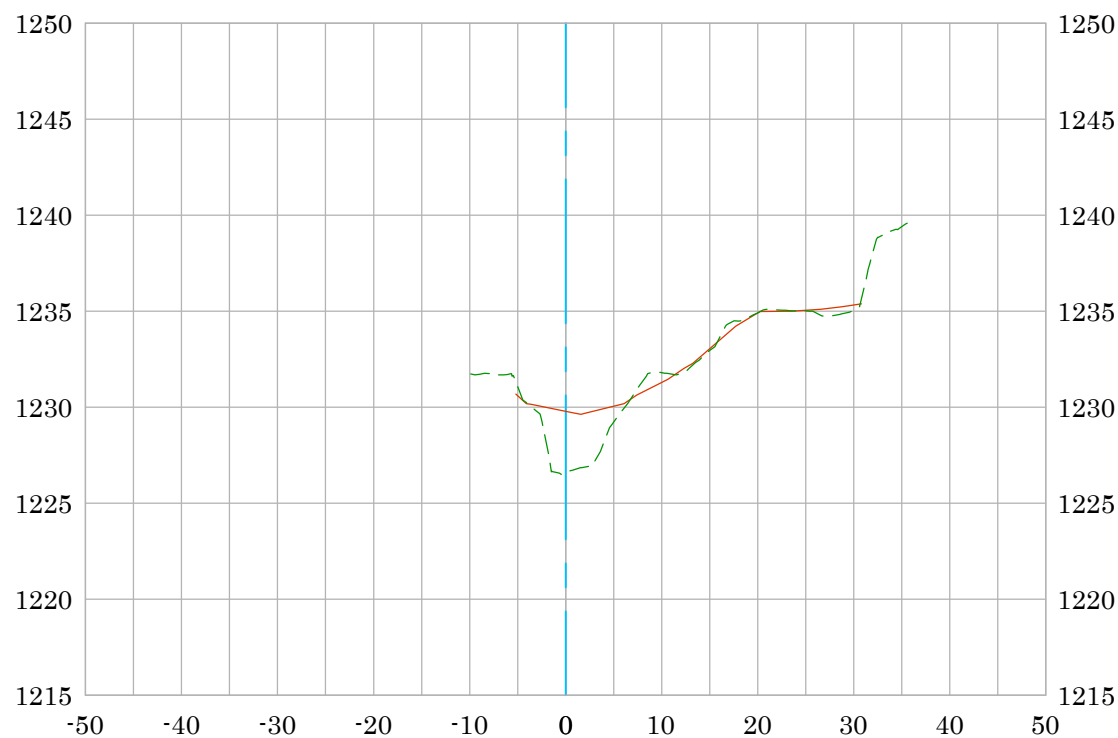

PRE-CONSTRUCTION SURFACE (03/22)

ASBUILT SURFACE POST CONSTRUCTION (11/22)

DATE PREPARED: 12/14/2022

Vert. Scale: 1"=10'


Hor. Scale: 1"=20'

U.S. *Survey*
Foot

OC Public Works
OC Survey/Field Services
Boundary Analysis & Mapping



Anderson Creek 13+00 CL

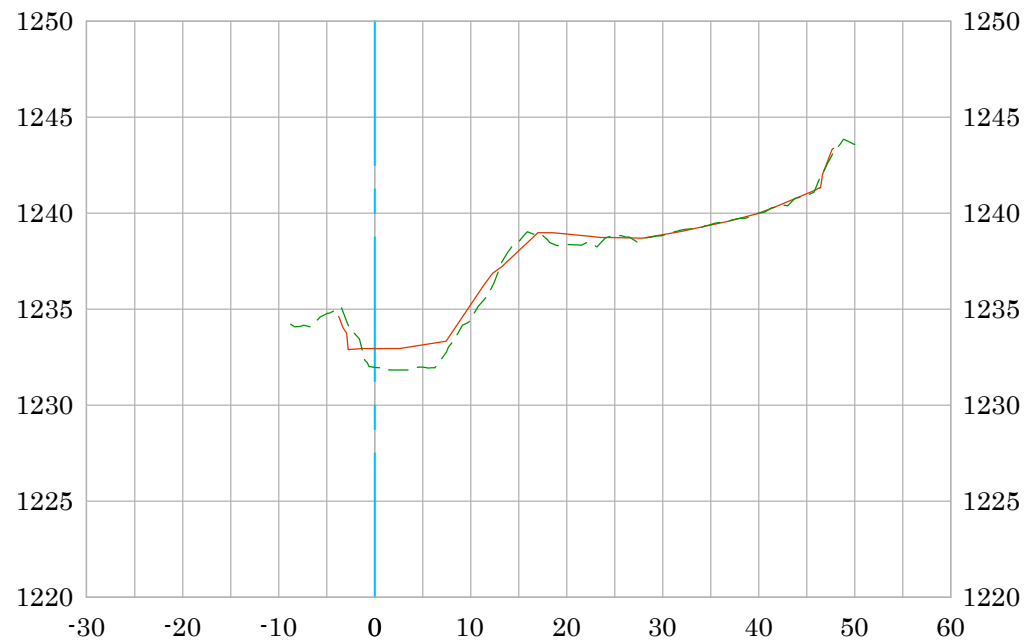

PRE-CONSTRUCTION SURFACE (03/22)

ASBUILT SURFACE POST CONSTRUCTION (11/22)

DATE PREPARED: 12/14/2022

Vert. Scale: 1"=10'


Hor. Scale: 1"=20'

U.S. *Survey*
Foot

OC Public Works
OC Survey/Field Services
Boundary Analysis & Mapping



Anderson Creek 13+11 CL

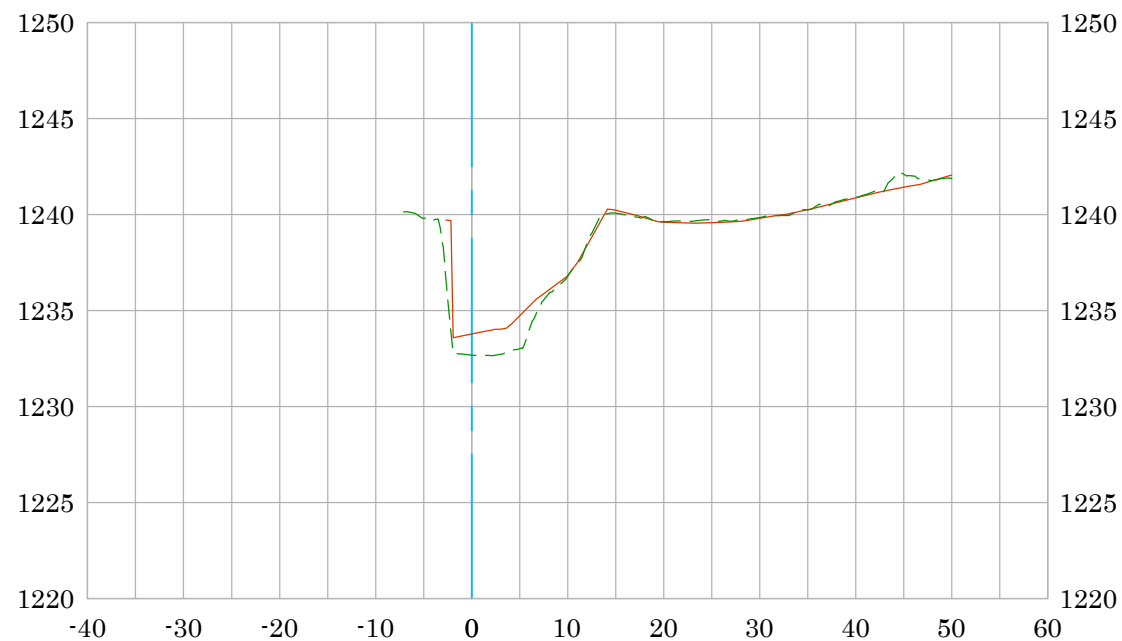

PRE-CONSTRUCTION SURFACE (03/22)

ASBUILT SURFACE POST CONSTRUCTION (11/22)

DATE PREPARED: 12/14/2022

Vert. Scale: 1"=10'


Hor. Scale: 1"=20'

U.S. *Survey*
Foot

OC Public Works
OC Survey/Field Services
Boundary Analysis & Mapping



Anderson Creek 13+19 CL

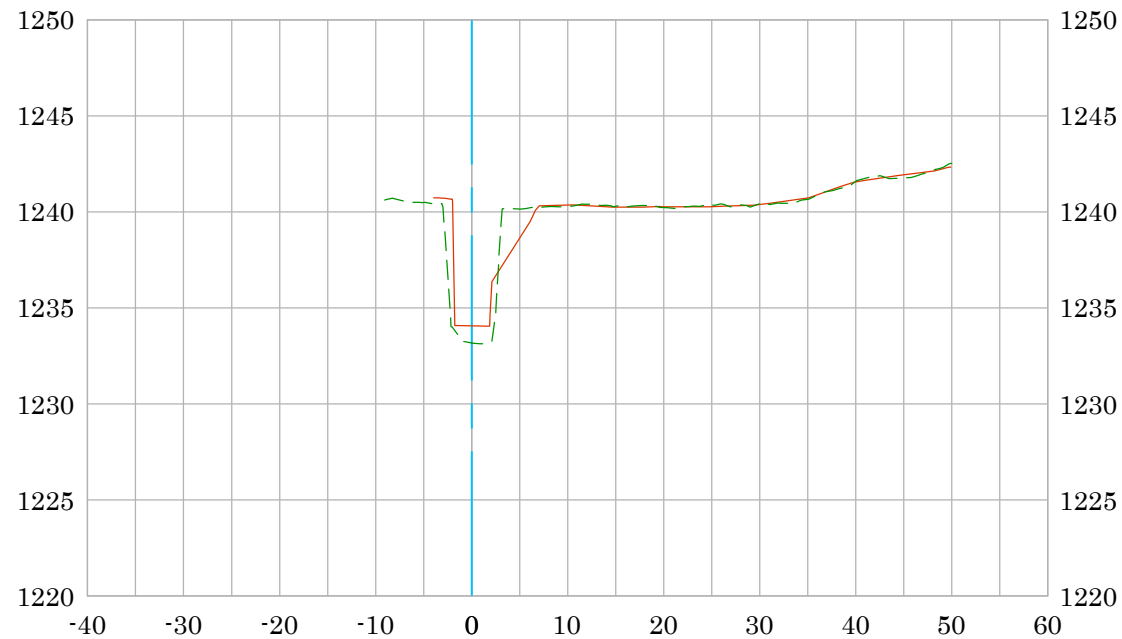

PRE-CONSTRUCTION SURFACE (03/22)

ASBUILT SURFACE POST CONSTRUCTION (11/22)

DATE PREPARED: 12/14/2022

Vert. Scale: 1"=10'


Hor. Scale: 1"=20'

**U.S. Survey
Foot**

OC Public Works
OC Survey/Field Services
Boundary Analysis & Mapping



Anderson Creek Bridge Crossing 13+26 CL

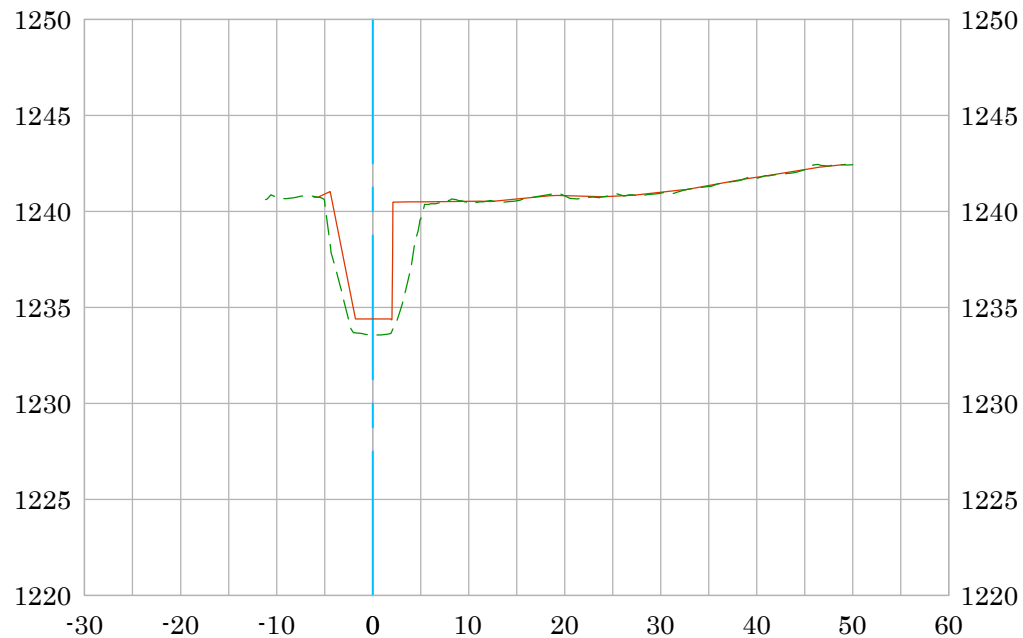

PRE-CONSTRUCTION SURFACE (03/22)

ASBUILT SURFACE POST CONSTRUCTION (11/22)

DATE PREPARED: 12/14/2022

Vert. Scale: 1"=10'


Hor. Scale: 1"=20'

U.S. *Survey*
Foot

OC Public Works
OC Survey/Field Services
Boundary Analysis & Mapping



Anderson Creek 13+33 CL

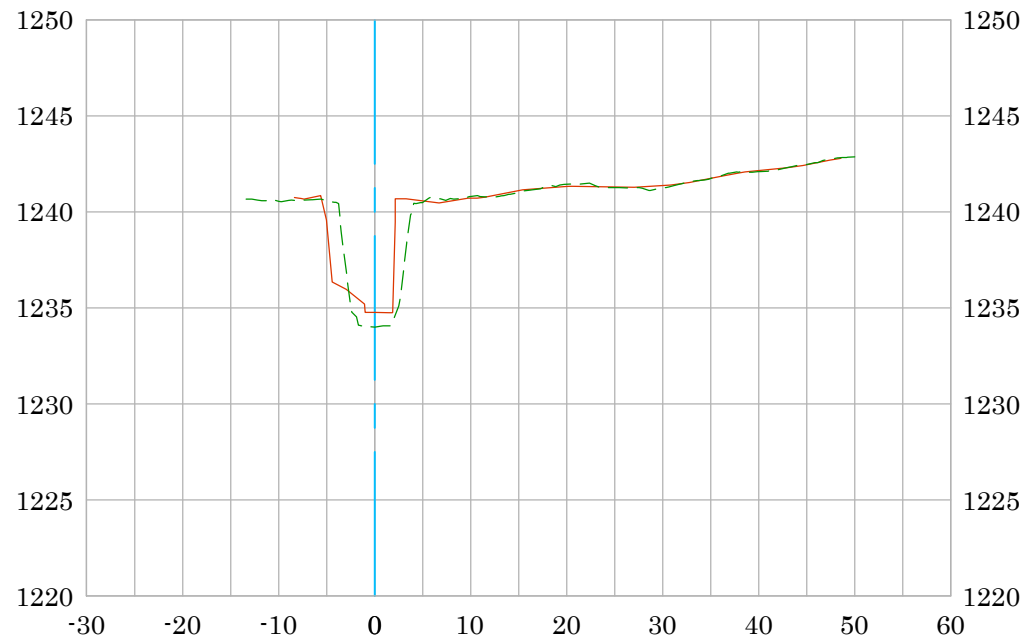

PRE-CONSTRUCTION SURFACE (03/22)

ASBUILT SURFACE POST CONSTRUCTION (11/22)

DATE PREPARED: 12/14/2022

Vert. Scale: 1"=10'


Hor. Scale: 1"=20'

U.S. *Survey*
Foot

OC Public Works
OC Survey/Field Services
Boundary Analysis & Mapping



Anderson Creek 13+50 CL

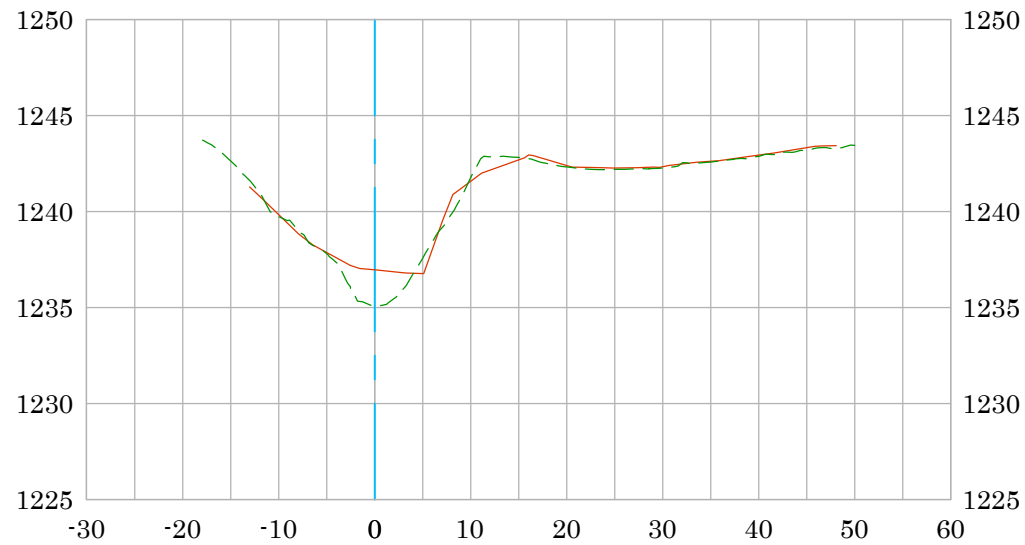

PRE-CONSTRUCTION SURFACE (03/22)

ASBUILT SURFACE POST CONSTRUCTION (11/22)

DATE PREPARED: 12/14/2022

Vert. Scale: 1"=10'


Hor. Scale: 1"=20'

U.S. *Survey*
Foot

OC Public Works
OC Survey/Field Services
Boundary Analysis & Mapping



Anderson Creek 13+41 CL

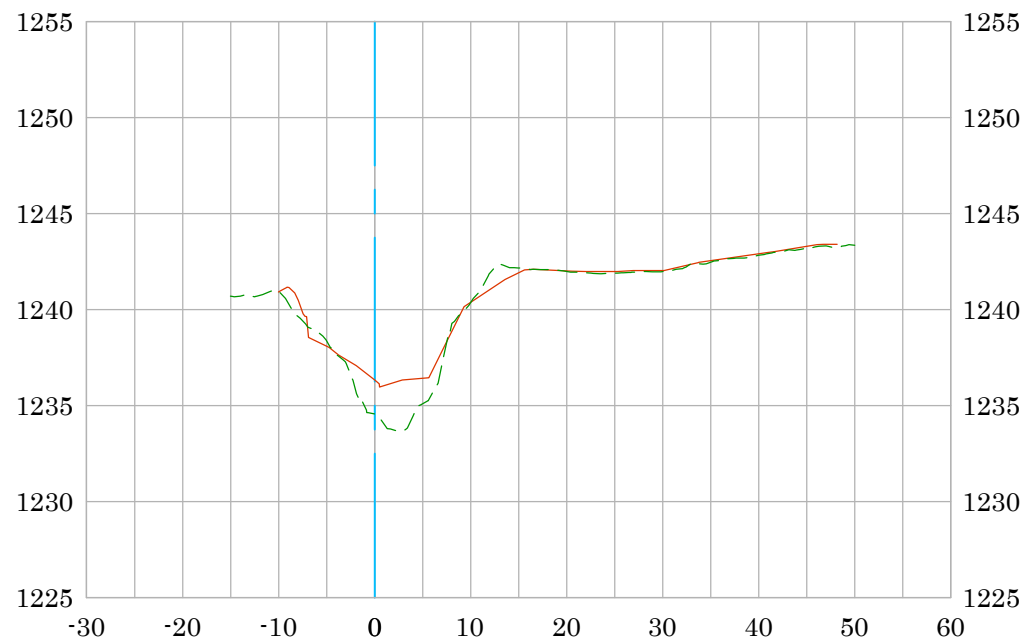


PRE-CONSTRUCTION SURFACE (03/22)

ASBUILT SURFACE POST CONSTRUCTION (11/22)


DATE PREPARED: 12/14/2022

Vert. Scale: 1"=10'

Hor. Scale: 1"=20'

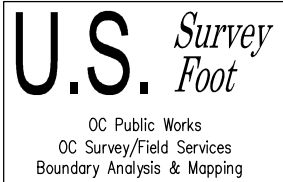

Anderson Creek 14+00 CL

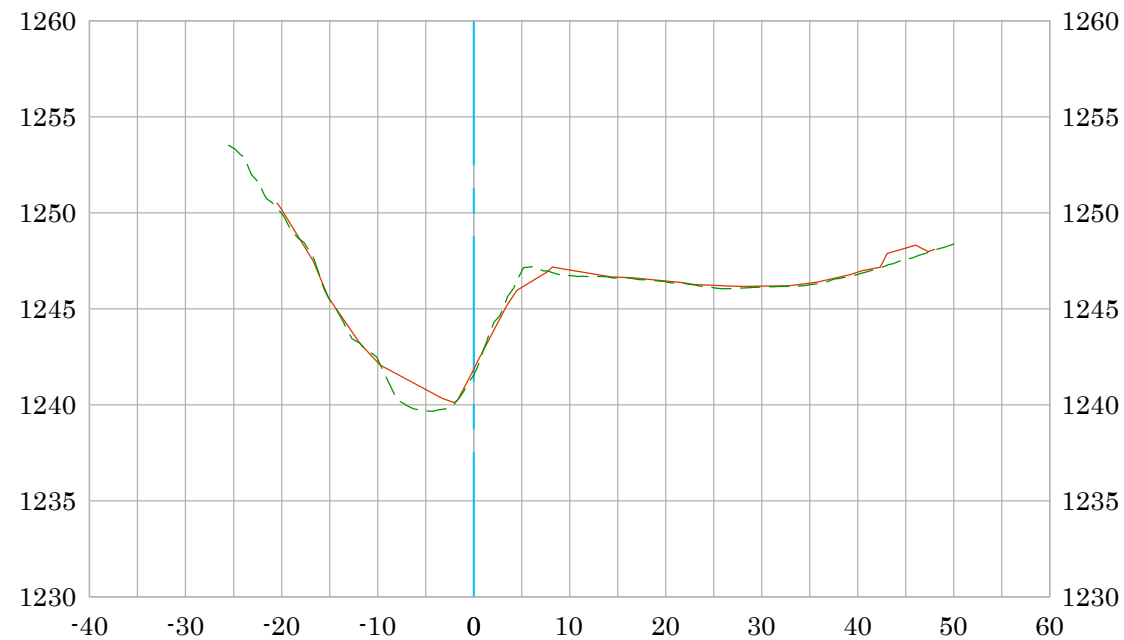

PRE-CONSTRUCTION SURFACE (03/22)

ASBUILT SURFACE POST CONSTRUCTION (11/22)

DATE PREPARED: 12/14/2022

Vert. Scale: 1"=10'


Hor. Scale: 1"=20'

U.S. *Survey*
Foot

OC Public Works
OC Survey/Field Services
Boundary Analysis & Mapping



Anderson Creek 14+50 CL

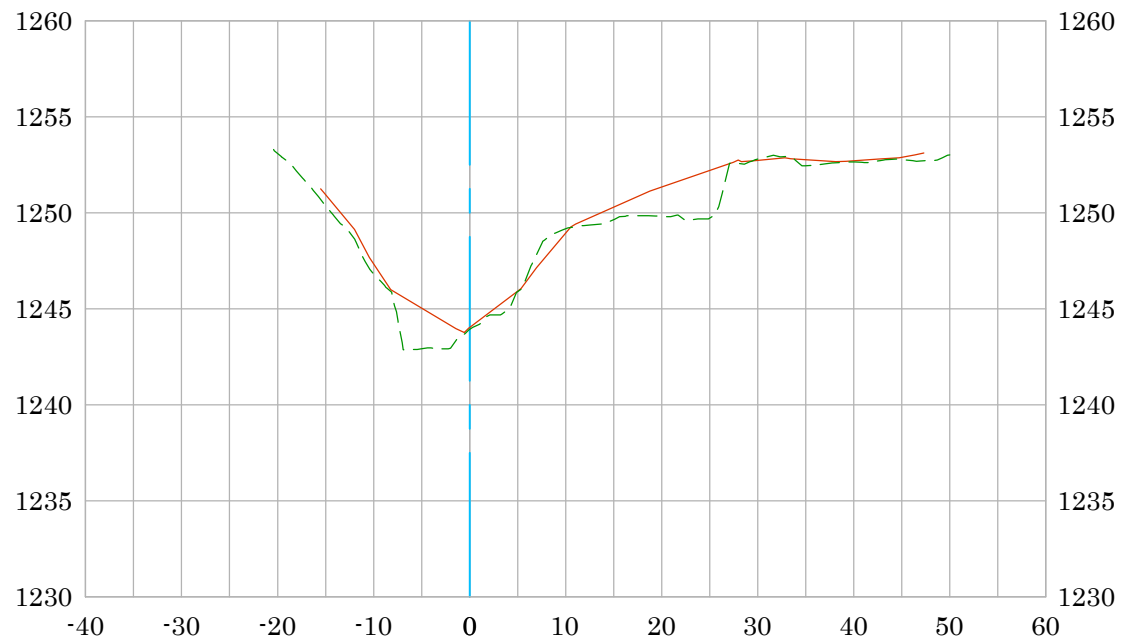


PRE-CONSTRUCTION SURFACE (03/22)

ASBUILT SURFACE POST CONSTRUCTION (11/22)


DATE PREPARED: 12/14/2022

Vert. Scale: 1"=10'

Hor. Scale: 1"=20'

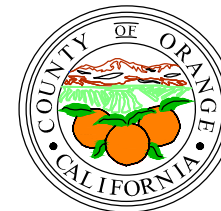

Anderson Creek 14+97 CL

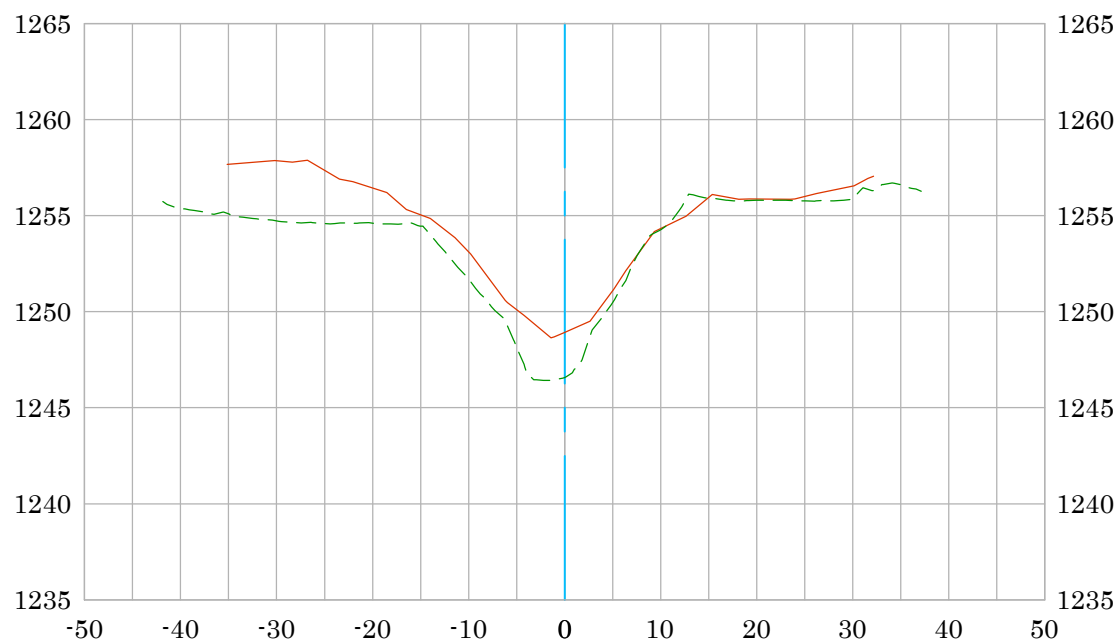

PRE-CONSTRUCTION SURFACE (03/22)

ASBUILT SURFACE POST CONSTRUCTION (11/22)

DATE PREPARED: 12/14/2022

—————

- - - - -

Vert. Scale: 1"=10'


Hor. Scale: 1"=20'

U.S. *Survey
Foot*

OC Public Works
OC Survey/Field Services
Boundary Analysis & Mapping



Anderson Creek 15+00 CL

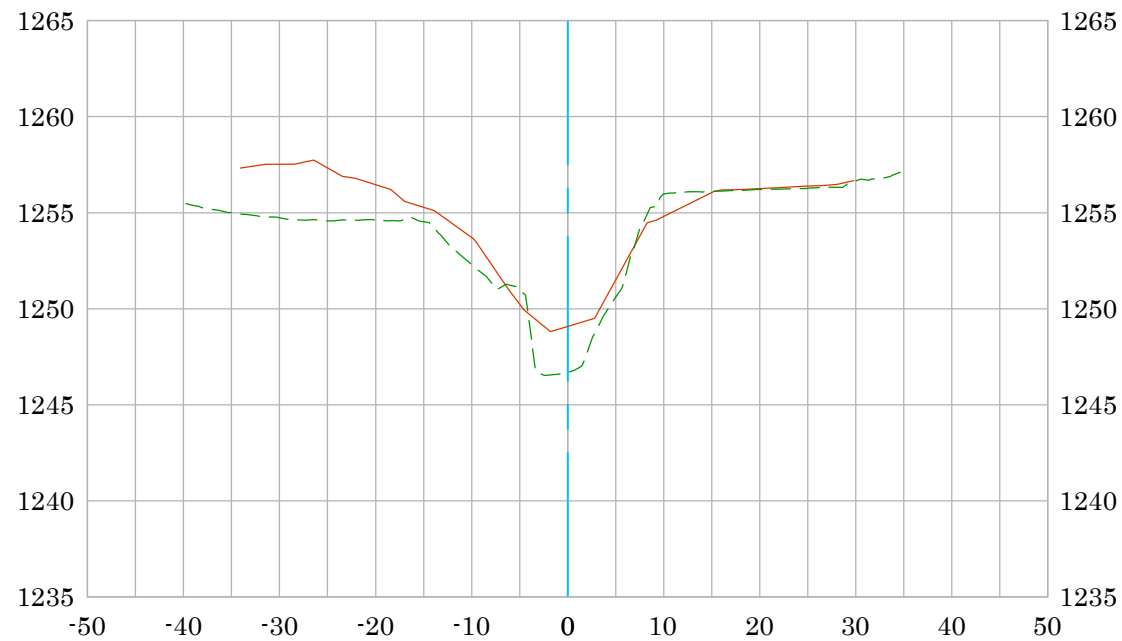


PRE-CONSTRUCTION SURFACE (03/22)

ASBUILT SURFACE POST CONSTRUCTION (11/22)


DATE PREPARED: 12/14/2022

Vert. Scale: 1"=10'

Hor. Scale: 1"=20'

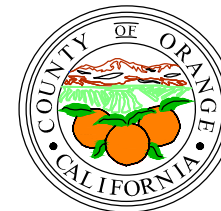

Anderson Creek 15+05 CL

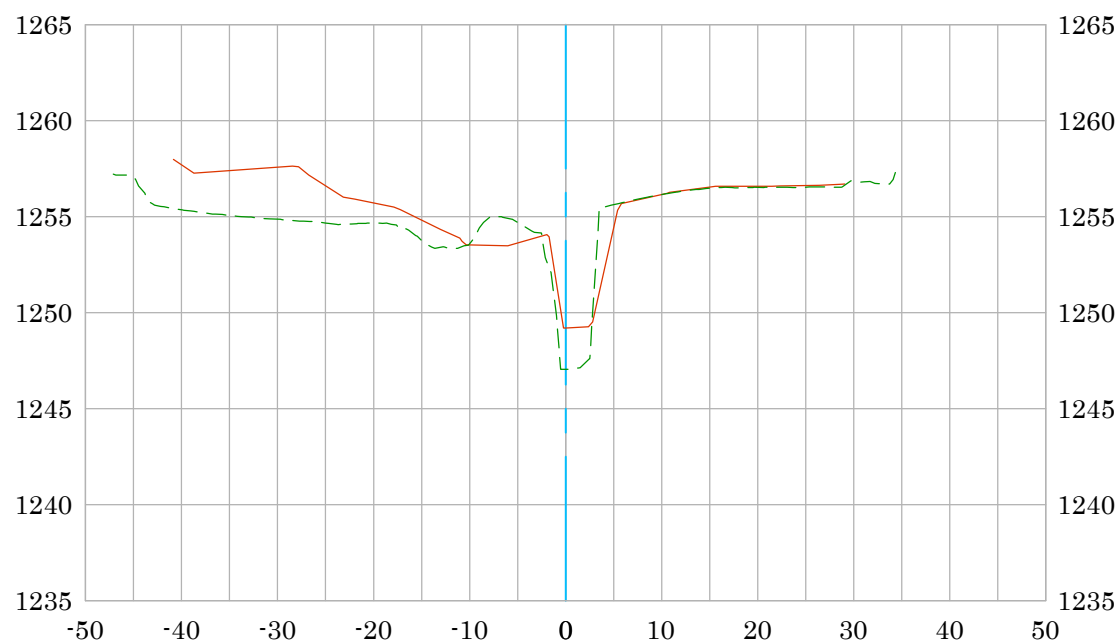

PRE-CONSTRUCTION SURFACE (03/22)

ASBUILT SURFACE POST CONSTRUCTION (11/22)

DATE PREPARED: 12/14/2022

Vert. Scale: 1"=10'


Hor. Scale: 1"=20'

U.S. Survey
Foot

OC Public Works
OC Survey/Field Services
Boundary Analysis & Mapping



Anderson Creek Bridge Crossing 15+12 CL

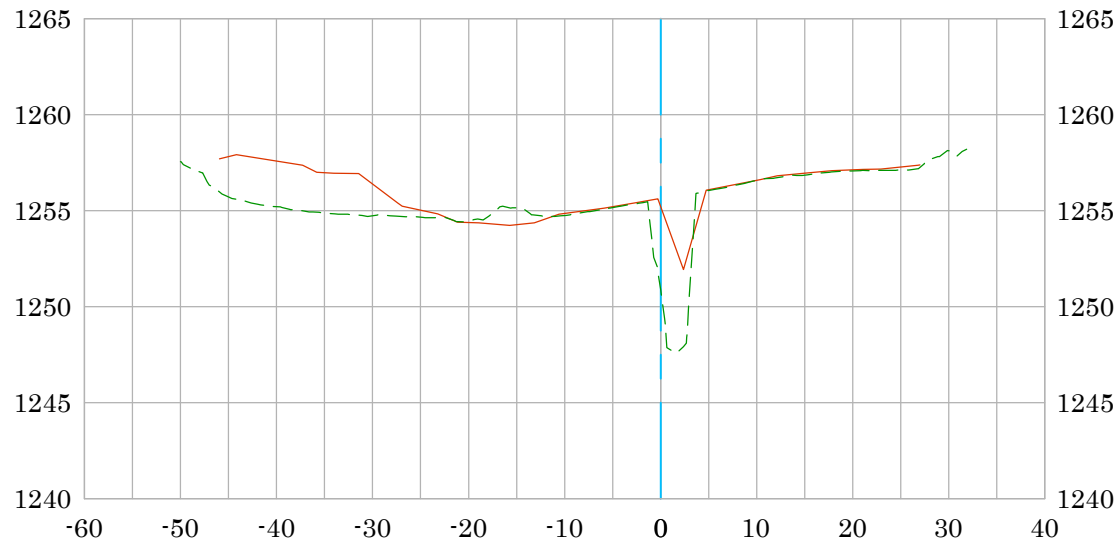


PRE-CONSTRUCTION SURFACE (03/22)

ASBUILT SURFACE POST CONSTRUCTION (11/22)


DATE PREPARED: 12/14/2022

Vert. Scale: 1"=10'

Hor. Scale: 1"=20'

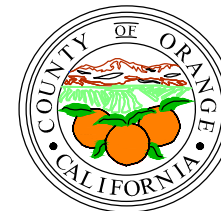

Anderson Creek 15+19 CL

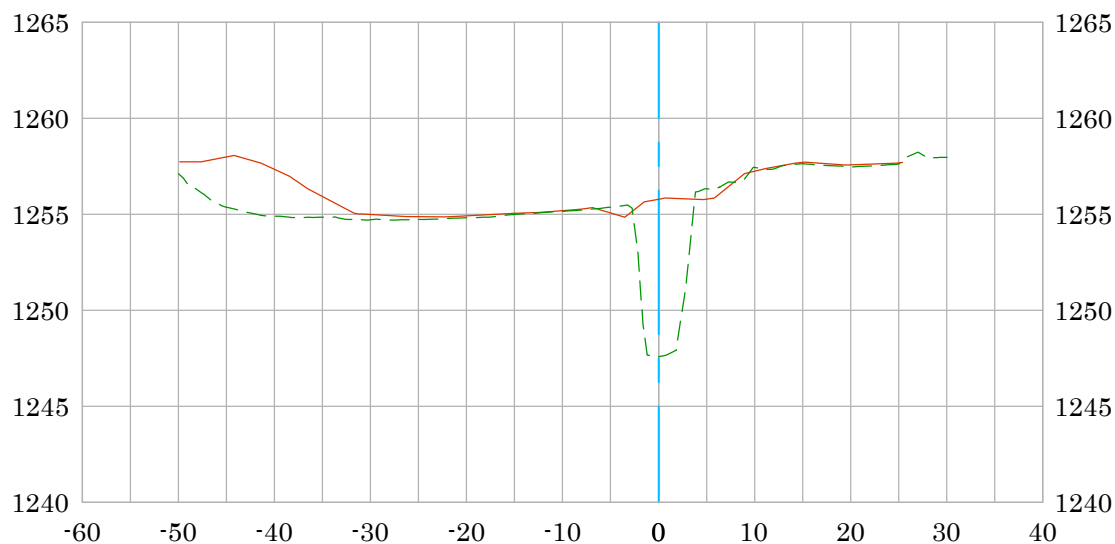


PRE-CONSTRUCTION SURFACE (03/22)

ASBUILT SURFACE POST CONSTRUCTION (11/22)


DATE PREPARED: 12/14/2022

Vert. Scale: 1"=10'

Hor. Scale: 1"=20'

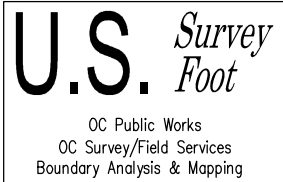

Anderson Creek 15+27 CL

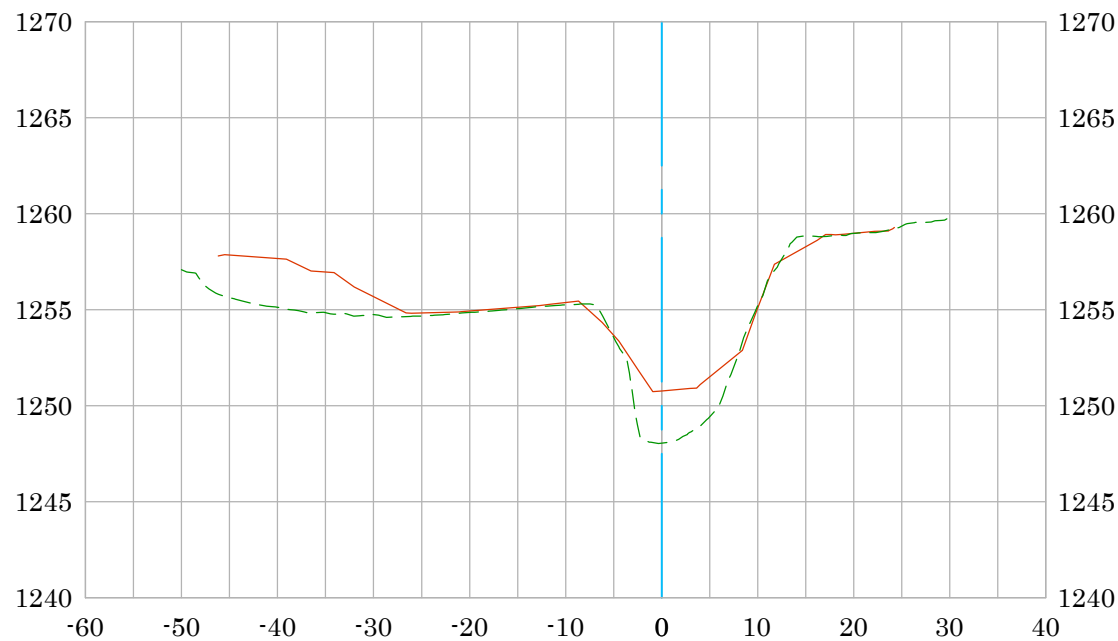

PRE-CONSTRUCTION SURFACE (03/22)

ASBUILT SURFACE POST CONSTRUCTION (11/22)

DATE PREPARED: 12/14/2022

—————

- - - - -

Vert. Scale: 1"=10'


Hor. Scale: 1"=20'

U.S. *Survey*
Foot

OC Public Works
OC Survey/Field Services
Boundary Analysis & Mapping



Anderson Creek 15+50 CL

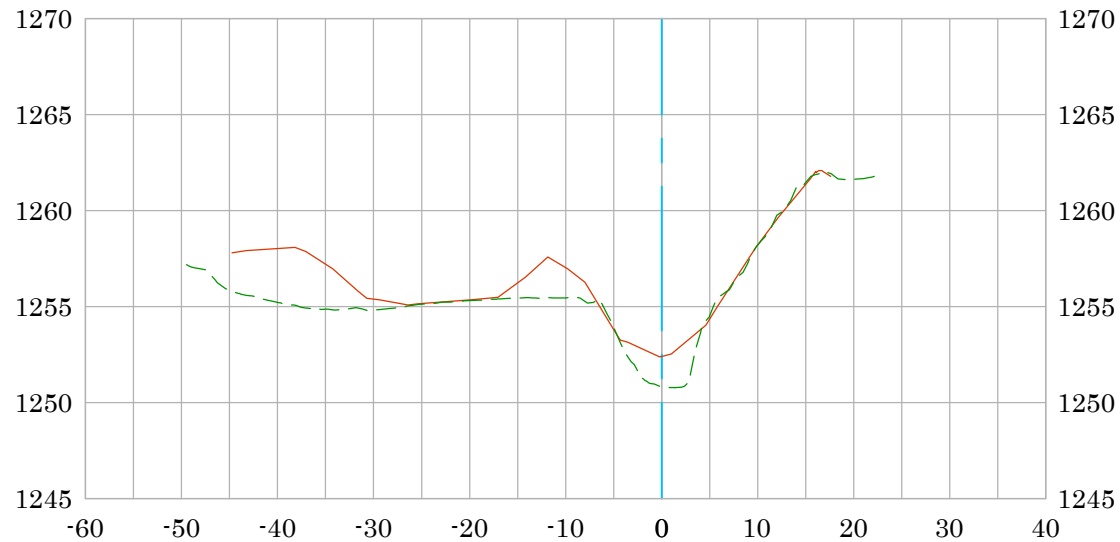

PRE-CONSTRUCTION SURFACE (03/22)

ASBUILT SURFACE POST CONSTRUCTION (11/22)

DATE PREPARED: 12/14/2022

Vert. Scale: 1"=10'


Hor. Scale: 1"=20'

U.S. *Survey*
Foot

OC Public Works
OC Survey/Field Services
Boundary Analysis & Mapping



Anderson Creek 16+00 CL

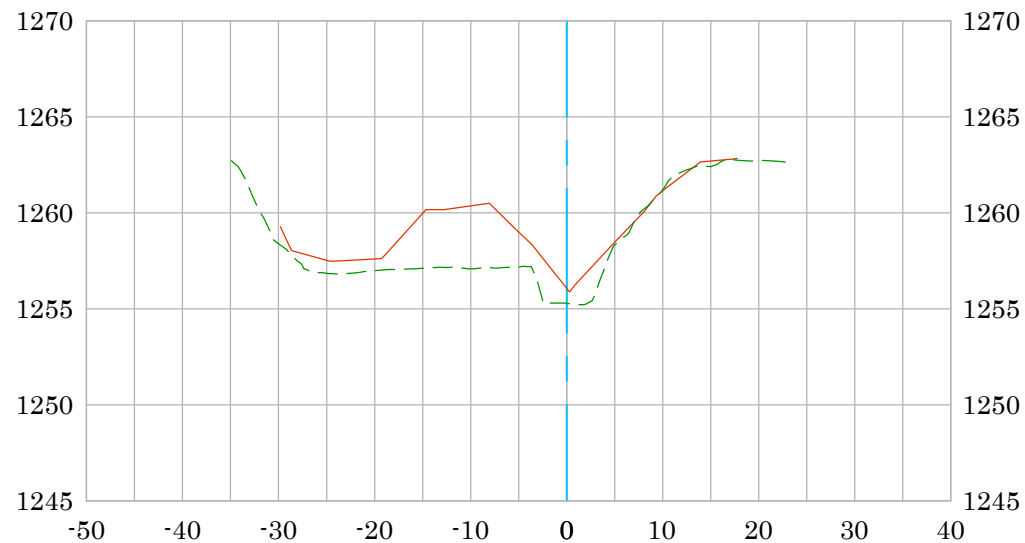


PRE-CONSTRUCTION SURFACE (03/22)

ASBUILT SURFACE POST CONSTRUCTION (11/22)


DATE PREPARED: 12/14/2022

Vert. Scale: 1"=10'

Hor. Scale: 1"=20'

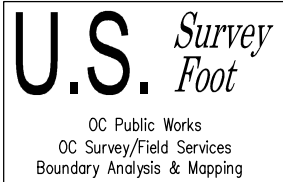

Anderson Creek 16+50 CL

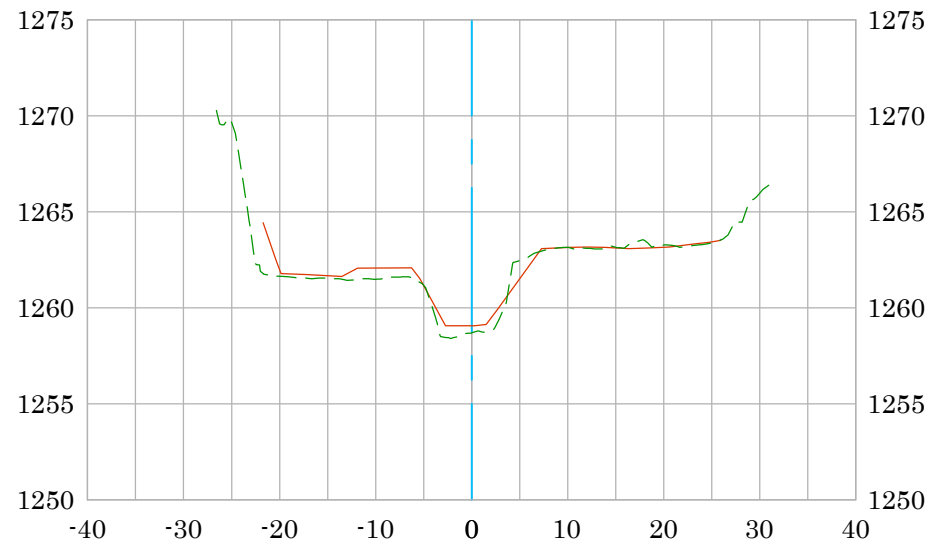

PRE-CONSTRUCTION SURFACE (03/22)

ASBUILT SURFACE POST CONSTRUCTION (11/22)

DATE PREPARED: 12/14/2022

Vert. Scale: 1"=10'


Hor. Scale: 1"=20'

U.S. *Survey*
Foot

OC Public Works
OC Survey/Field Services
Boundary Analysis & Mapping



Anderson Creek 16+58 CL

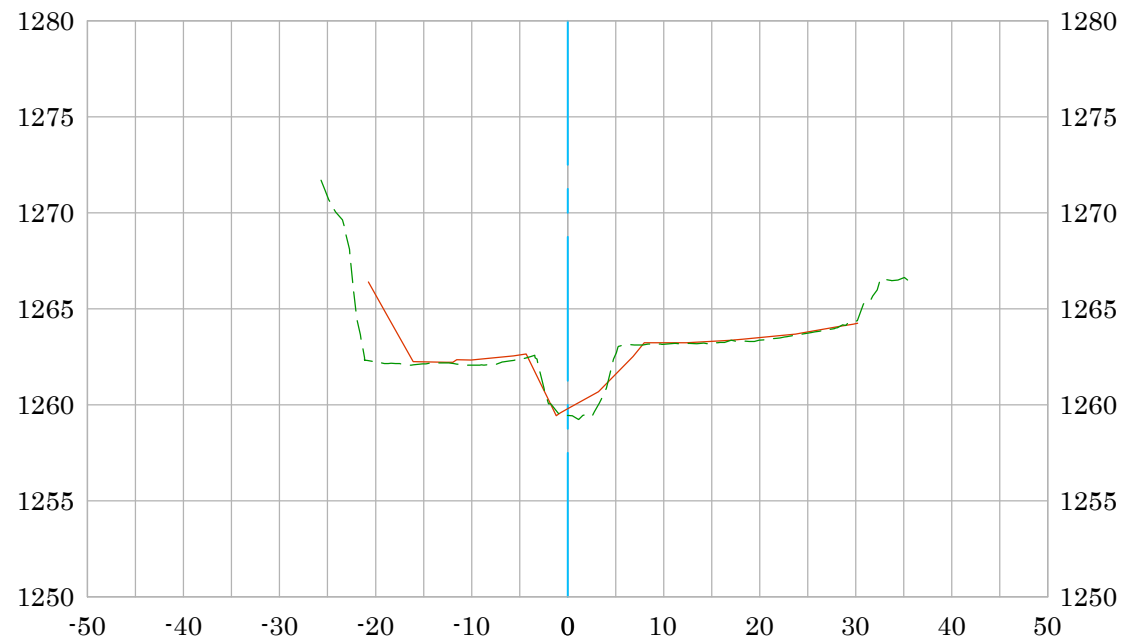



PRE-CONSTRUCTION SURFACE (03/22)

ASBUILT SURFACE POST CONSTRUCTION (11/22)


DATE PREPARED: 12/14/2022

Vert. Scale: 1"=10'

Hor. Scale: 1"=20'

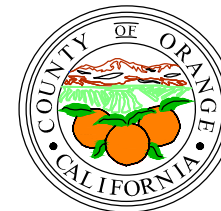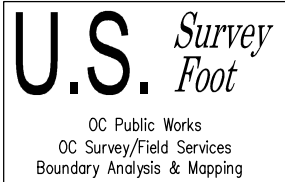

Anderson Creek 16+50 CL

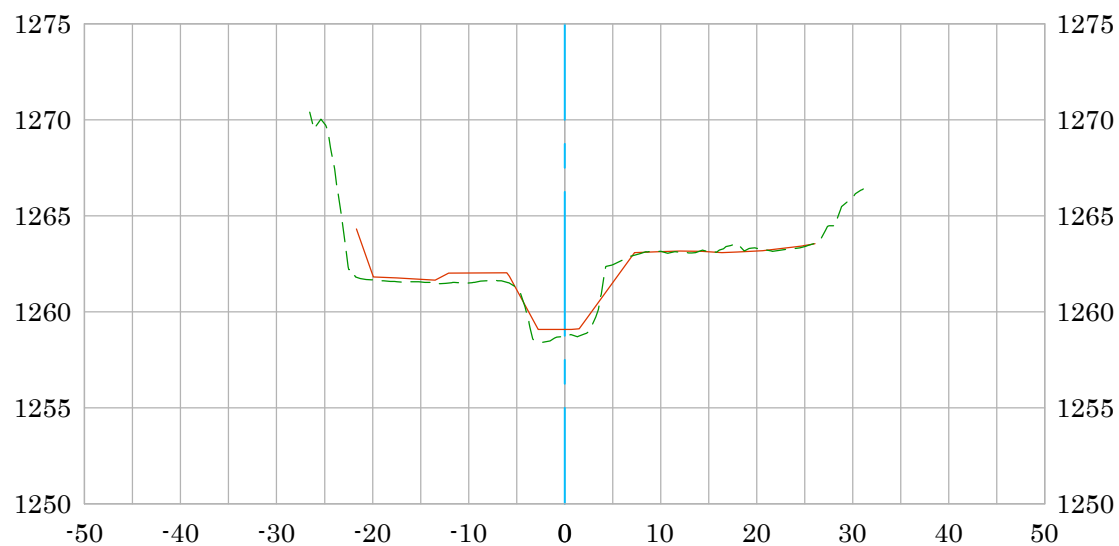

PRE-CONSTRUCTION SURFACE (03/22)

ASBUILT SURFACE POST CONSTRUCTION (11/22)

DATE PREPARED: 12/14/2022

Vert. Scale: 1"=10'


Hor. Scale: 1"=20'

U.S. *Survey*
Foot

OC Public Works
OC Survey/Field Services
Boundary Analysis & Mapping



Anderson Creek Bridge Crossing 16+65 CL

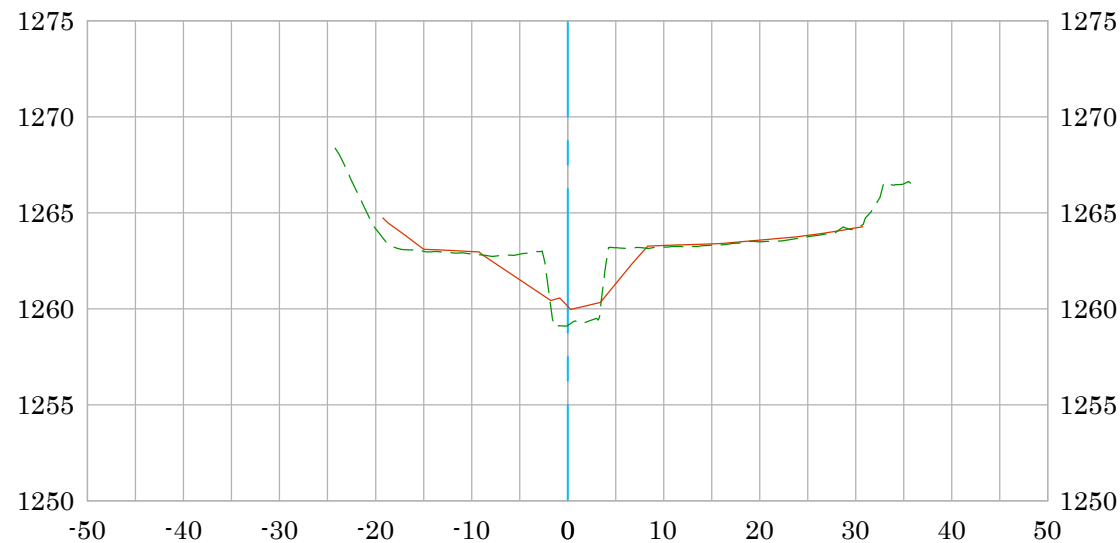


PRE-CONSTRUCTION SURFACE (03/22)

ASBUILT SURFACE POST CONSTRUCTION (11/22)


DATE PREPARED: 12/14/2022

Vert. Scale: 1"=10'

Hor. Scale: 1"=20'

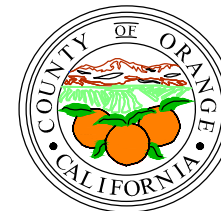

Anderson Creek 16+72 CL

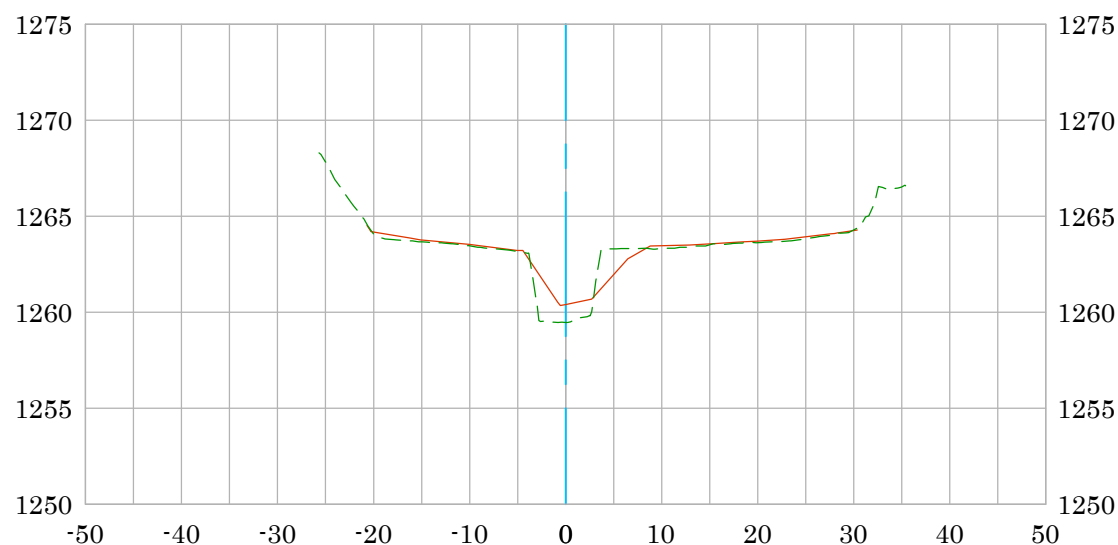

PRE-CONSTRUCTION SURFACE (03/22)

ASBUILT SURFACE POST CONSTRUCTION (11/22)


DATE PREPARED: 12/14/2022

—————


- - - - -

Vert. Scale: 1"=10'

Hor. Scale: 1"=20'

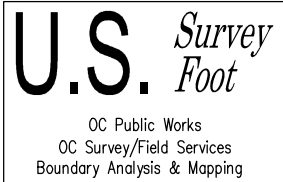

Anderson Creek 16+80 CL

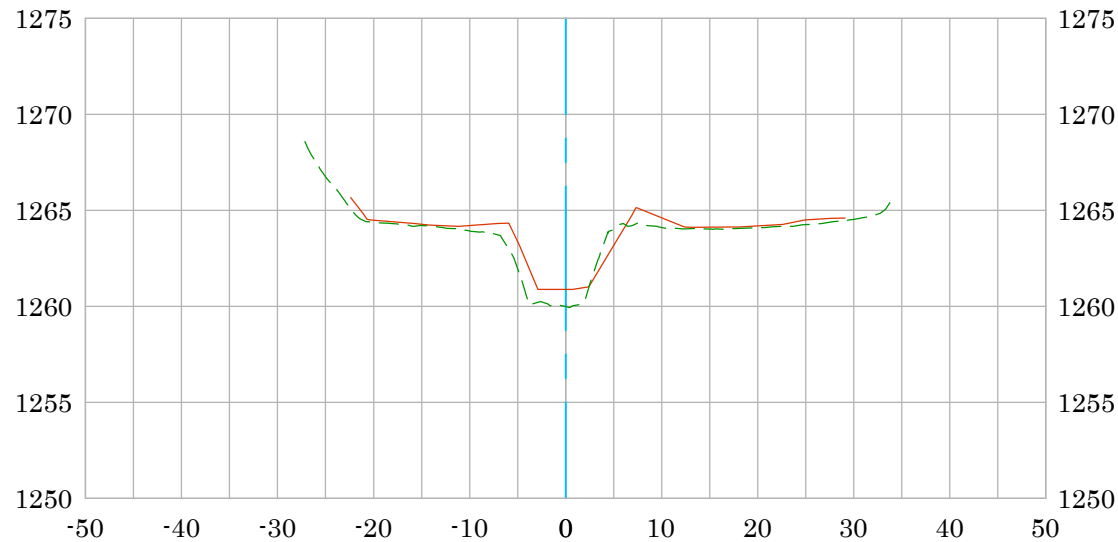

PRE-CONSTRUCTION SURFACE (03/22)

ASBUILT SURFACE POST CONSTRUCTION (11/22)

DATE PREPARED: 12/14/2022



Vert. Scale: 1"=10'


Hor. Scale: 1"=20'

U.S. *Survey
Foot*

OC Public Works
OC Survey/Field Services
Boundary Analysis & Mapping



Anderson Creek 17+00 CL

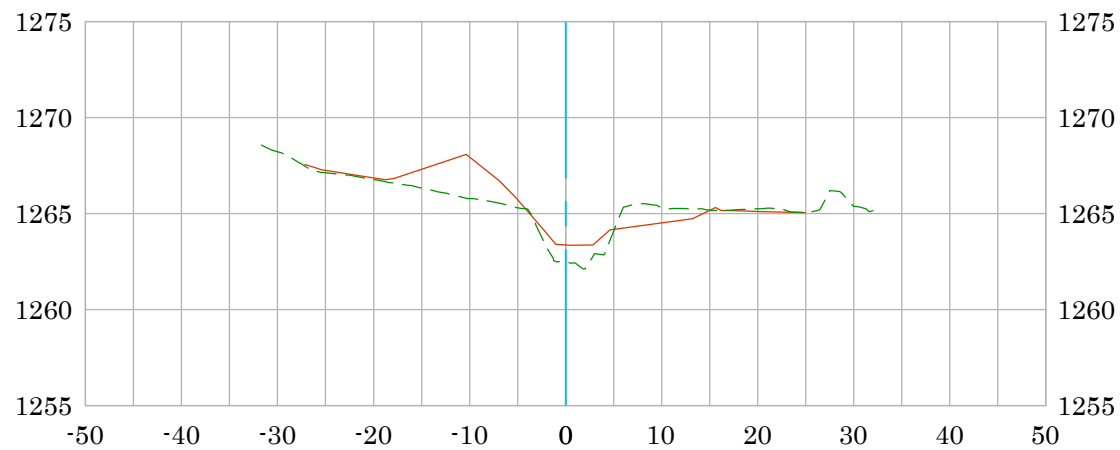

PRE-CONSTRUCTION SURFACE (03/22)

ASBUILT SURFACE POST CONSTRUCTION (11/22)

DATE PREPARED: 12/14/2022

Vert. Scale: 1"=10'


Hor. Scale: 1"=20'

U.S. *Survey*
Foot

OC Public Works
OC Survey/Field Services
Boundary Analysis & Mapping



Anderson Creek 17+50 CL

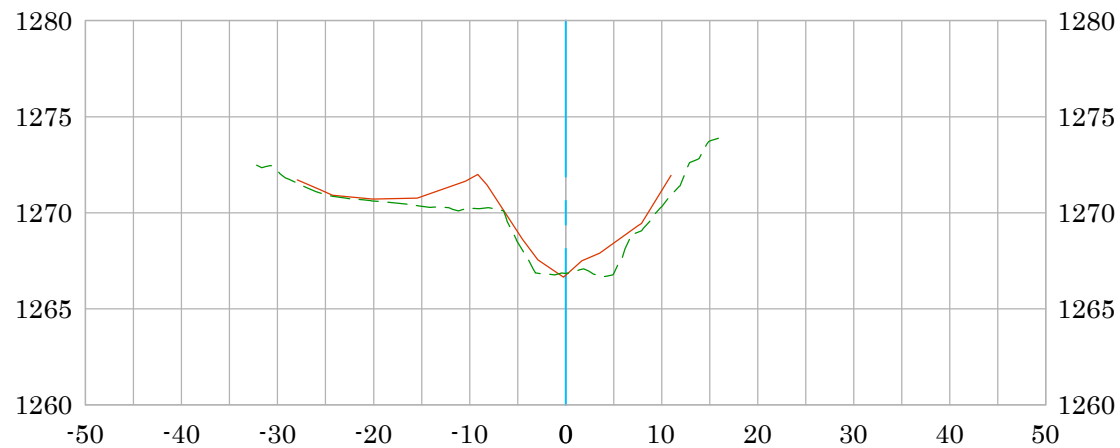

PRE-CONSTRUCTION SURFACE (03/22)

ASBUILT SURFACE POST CONSTRUCTION (11/22)

DATE PREPARED: 12/14/2022

Vert. Scale: 1"=10'


Hor. Scale: 1"=20'

U.S. *Survey
Foot*

OC Public Works
OC Survey/Field Services
Boundary Analysis & Mapping



Anderson Creek 18+00 CL

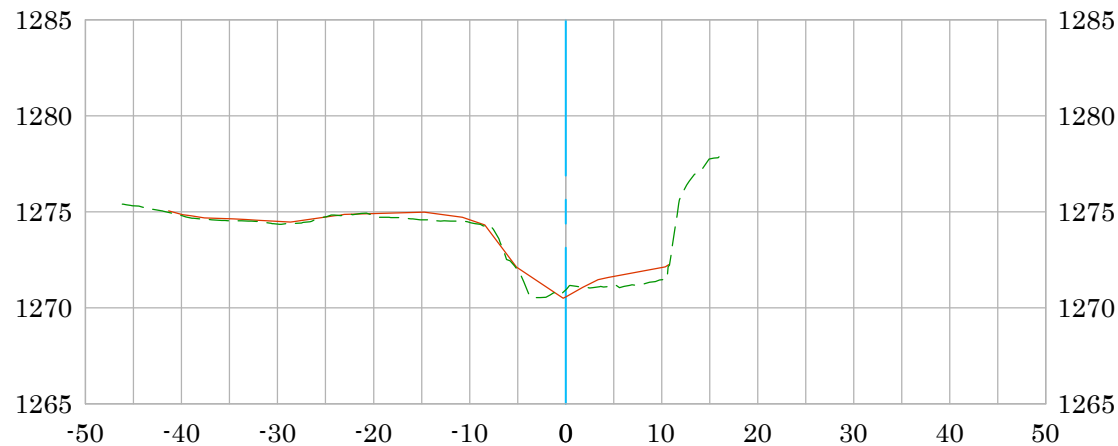


PRE-CONSTRUCTION SURFACE (03/22)

ASBUILT SURFACE POST CONSTRUCTION (11/22)


DATE PREPARED: 12/14/2022

Vert. Scale: 1"=10'

Hor. Scale: 1"=20'

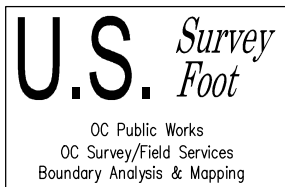

Anderson Creek 18+50 CL

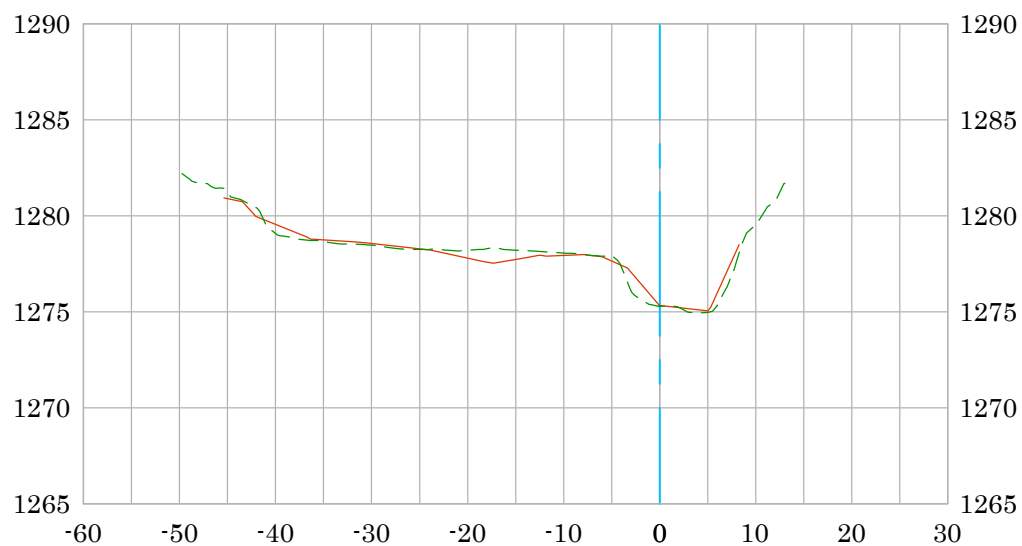


PRE-CONSTRUCTION SURFACE (03/22)

ASBUILT SURFACE POST CONSTRUCTION (11/22)


DATE PREPARED: 12/14/2022

Vert. Scale: 1"=10'

Hor. Scale: 1"=20'

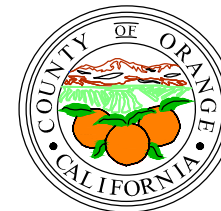

Anderson Creek 19+00 CL

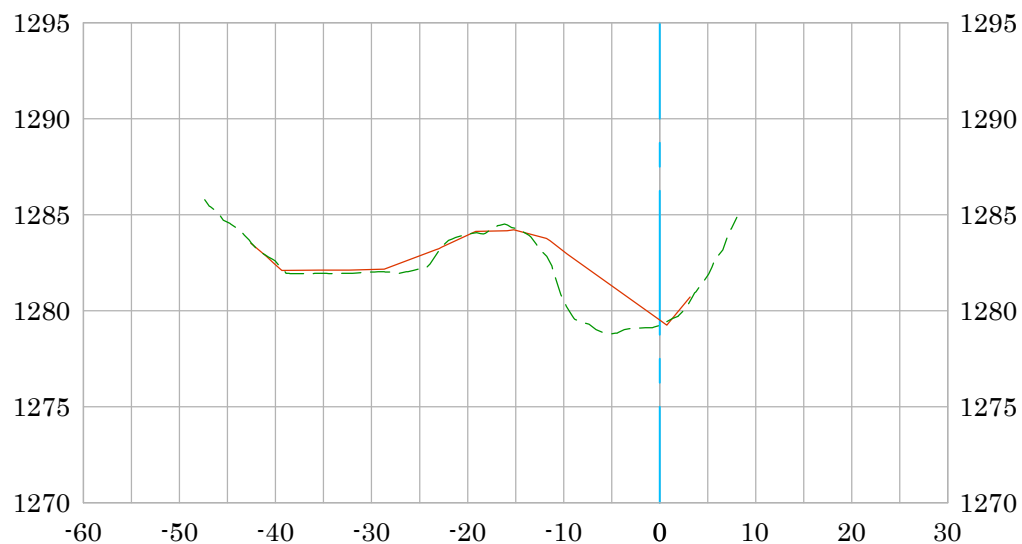

PRE-CONSTRUCTION SURFACE (03/22)

ASBUILT SURFACE POST CONSTRUCTION (11/22)

DATE PREPARED: 12/14/2022

Vert. Scale: 1"=10'


Hor. Scale: 1"=20'

U.S. *Survey*
Foot

OC Public Works
OC Survey/Field Services
Boundary Analysis & Mapping



Anderson Creek 19+50 CL

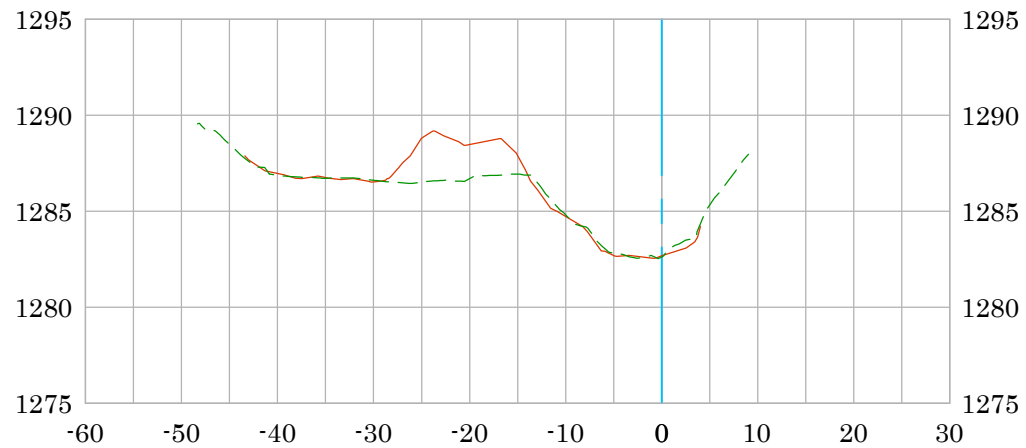

PRE-CONSTRUCTION SURFACE (03/22)

ASBUILT SURFACE POST CONSTRUCTION (11/22)

DATE PREPARED: 12/14/2022

Vert. Scale: 1"=10'


Hor. Scale: 1"=20'

U.S. *Survey*
Foot

OC Public Works
OC Survey/Field Services
Boundary Analysis & Mapping



Anderson Creek 20+00 CL

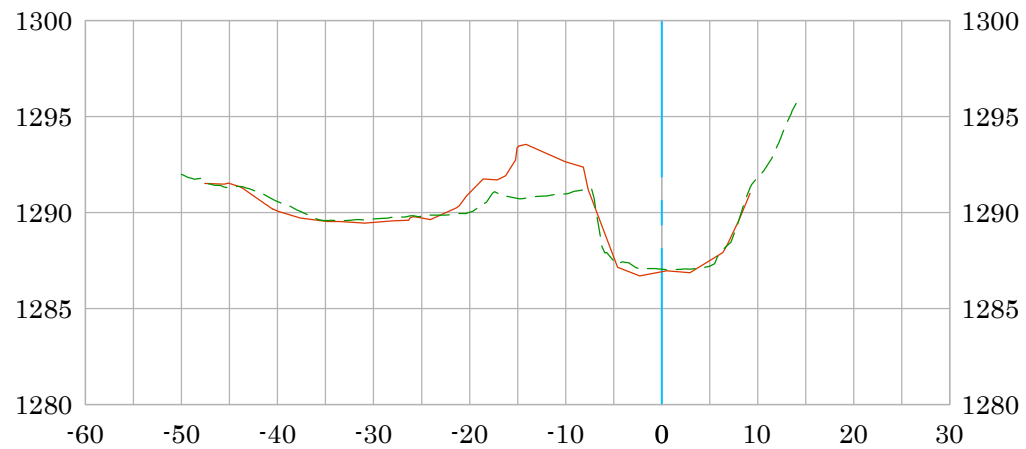

PRE-CONSTRUCTION SURFACE (03/22)

ASBUILT SURFACE POST CONSTRUCTION (11/22)


DATE PREPARED: 12/14/2022

Vert. Scale: 1"=10'

Hor. Scale: 1"=20'



Anderson Creek 20+37 CL

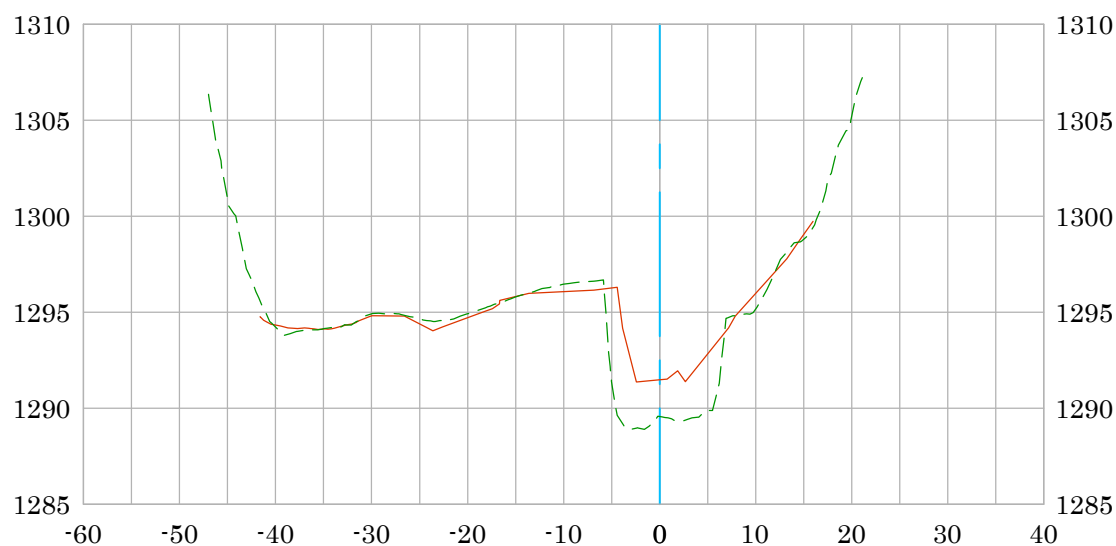

PRE-CONSTRUCTION SURFACE (03/22)

ASBUILT SURFACE POST CONSTRUCTION (11/22)

DATE PREPARED: 12/14/2022

Vert. Scale: 1"=10'


Hor. Scale: 1"=20'

U.S. *Survey*
Foot

OC Public Works
OC Survey/Field Services
Boundary Analysis & Mapping



Anderson Creek 20+50 CL

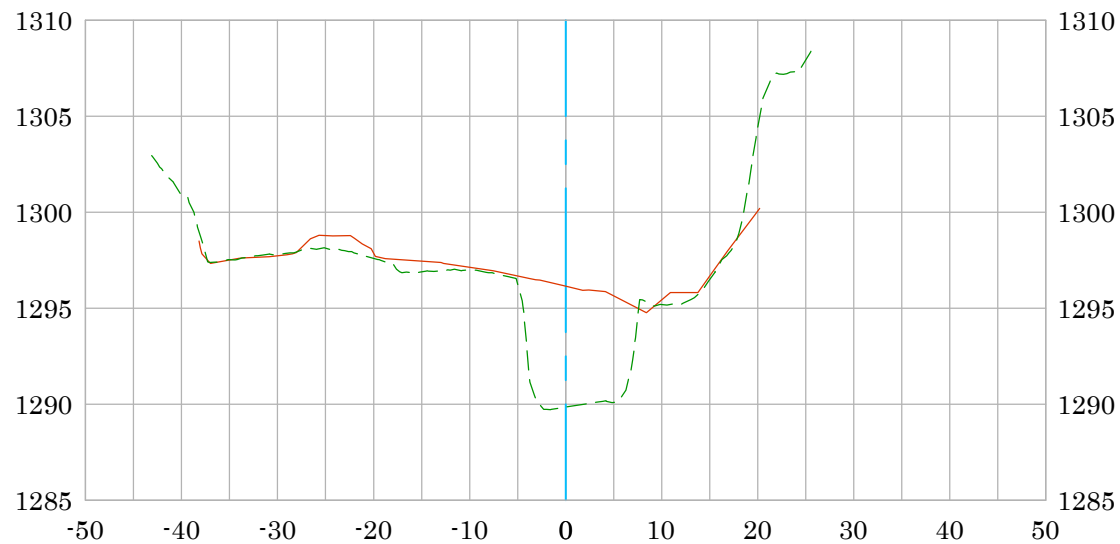

PRE-CONSTRUCTION SURFACE (03/22)

ASBUILT SURFACE POST CONSTRUCTION (11/22)

DATE PREPARED: 12/14/2022

Vert. Scale: 1"=10'


Hor. Scale: 1"=20'

U.S. *Survey Foot*

OC Public Works
OC Survey/Field Services
Boundary Analysis & Mapping



Anderson Creek 20+45 CL

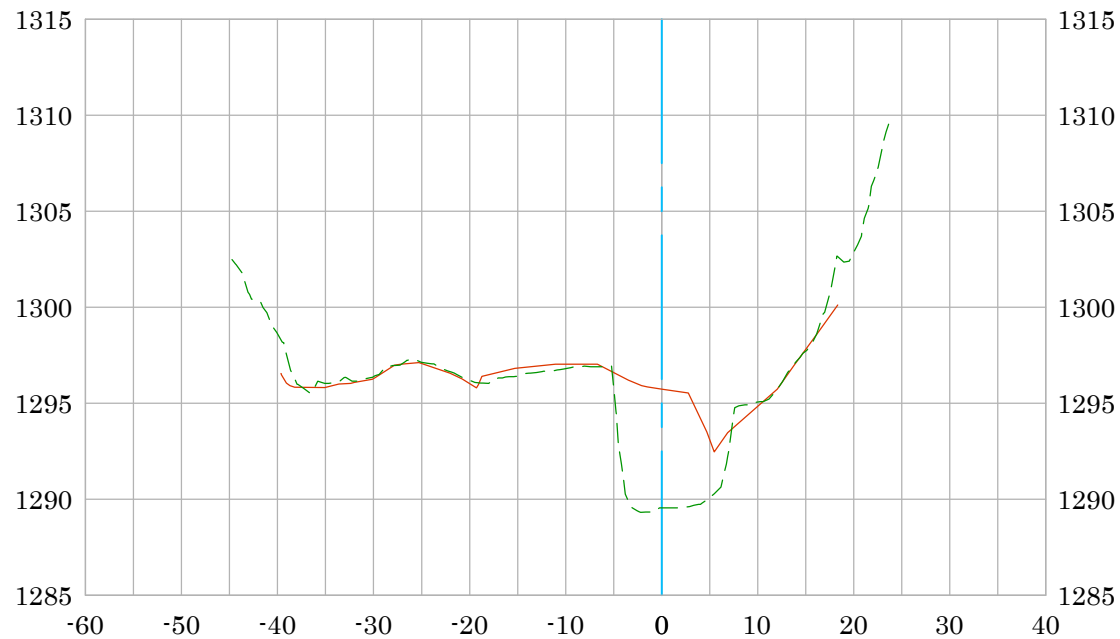


PRE-CONSTRUCTION SURFACE (03/22)

ASBUILT SURFACE POST CONSTRUCTION (11/22)


DATE PREPARED: 12/14/2022

Vert. Scale: 1"=10'

Hor. Scale: 1"=20'

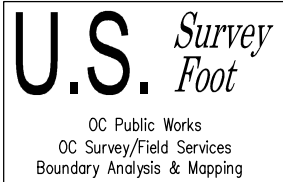

Anderson Creek Bridge Crossing 20+52 CL

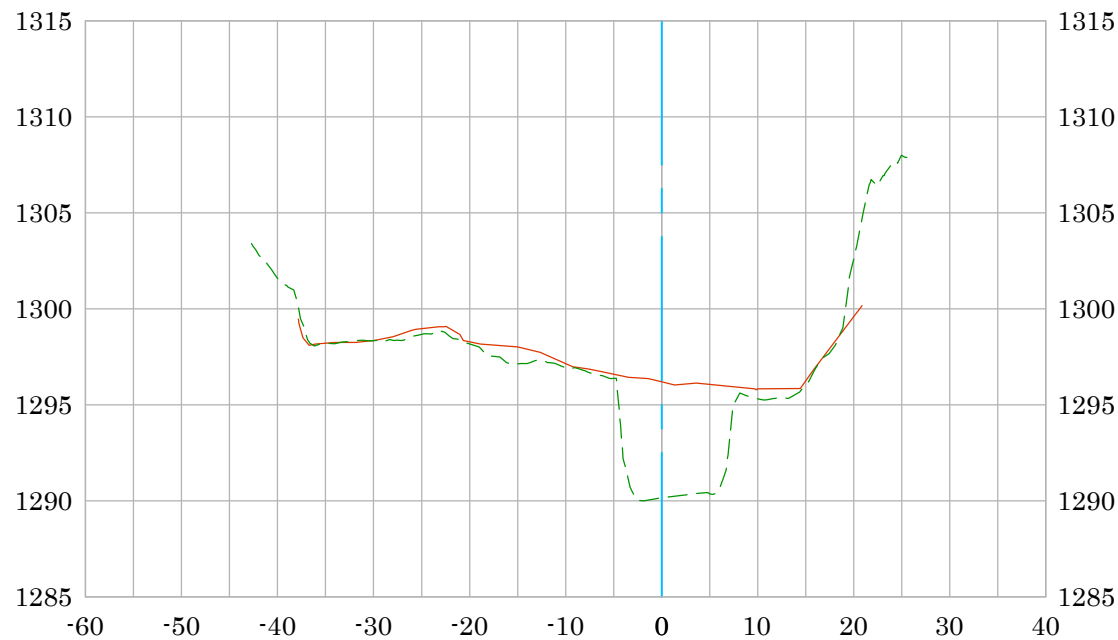


PRE-CONSTRUCTION SURFACE (03/22)

ASBUILT SURFACE POST CONSTRUCTION (11/22)


DATE PREPARED: 12/14/2022

Vert. Scale: 1"=10'

Hor. Scale: 1"=20'

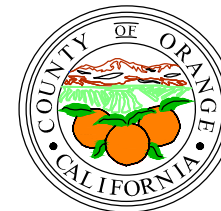

Anderson Creek 20+59 CL

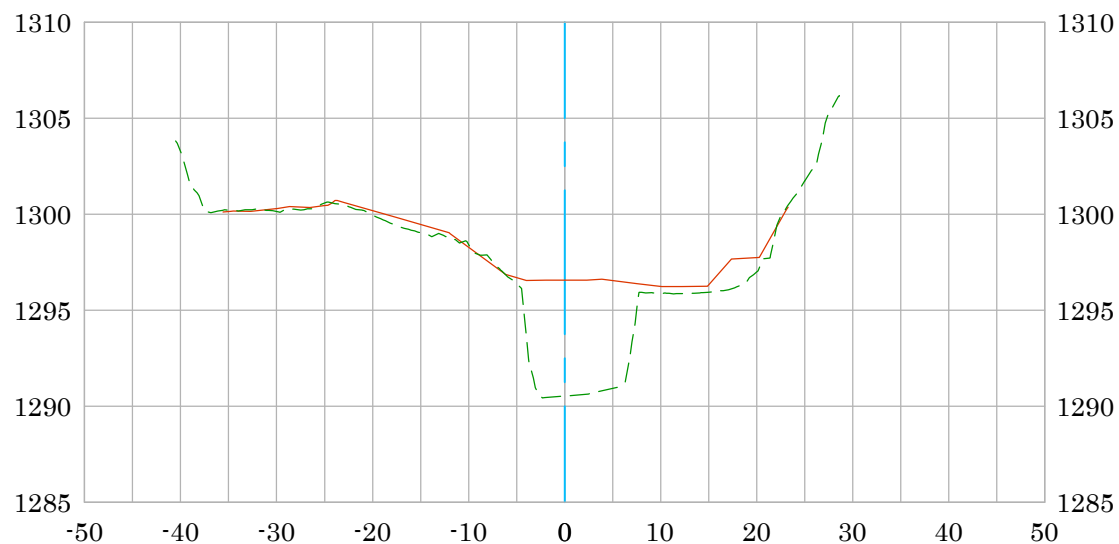

PRE-CONSTRUCTION SURFACE (03/22)

ASBUILT SURFACE POST CONSTRUCTION (11/22)

DATE PREPARED: 12/14/2022

Vert. Scale: 1"=10'


Hor. Scale: 1"=20'

U.S. *Survey*
Foot

OC Public Works
OC Survey/Field Services
Boundary Analysis & Mapping



Anderson Creek 20+67 CL

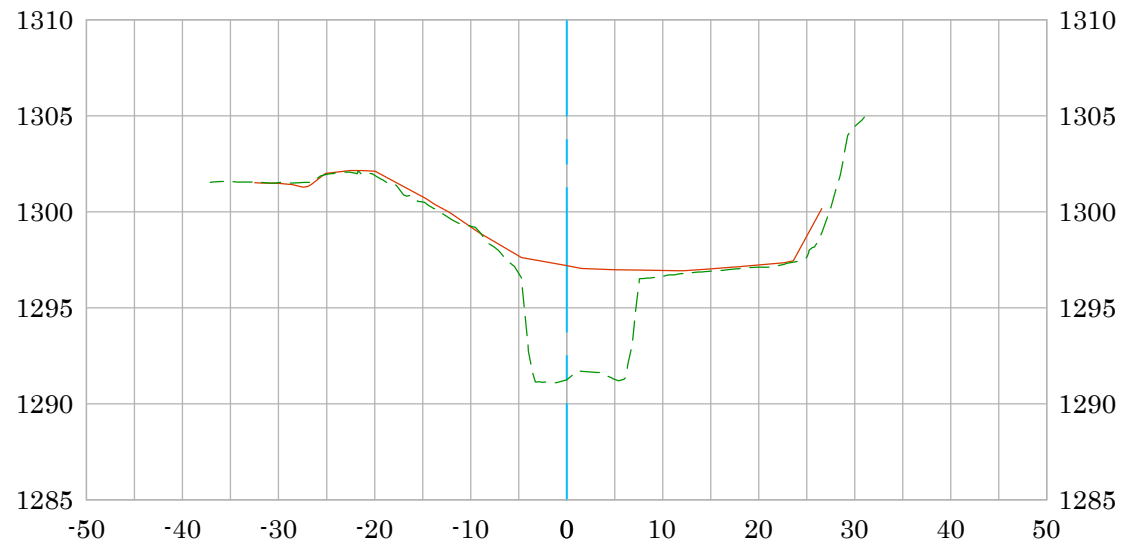


PRE-CONSTRUCTION SURFACE (03/22)

ASBUILT SURFACE POST CONSTRUCTION (11/22)


DATE PREPARED: 12/14/2022

Vert. Scale: 1"=10'

Hor. Scale: 1"=20'

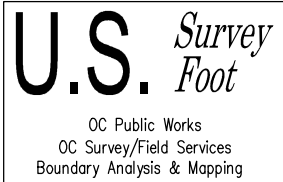

Anderson Creek 21+00 CL

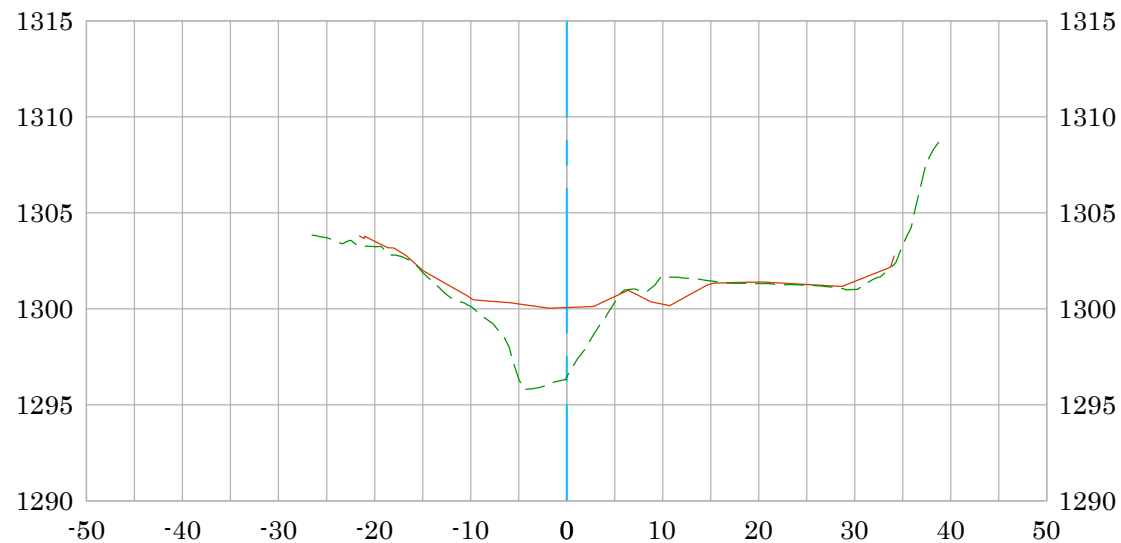

PRE-CONSTRUCTION SURFACE (03/22)

ASBUILT SURFACE POST CONSTRUCTION (11/22)

DATE PREPARED: 12/14/2022

Vert. Scale: 1"=10'


Hor. Scale: 1"=20'

U.S. *Survey*
Foot

OC Public Works
OC Survey/Field Services
Boundary Analysis & Mapping



Anderson Creek 21+50 CL

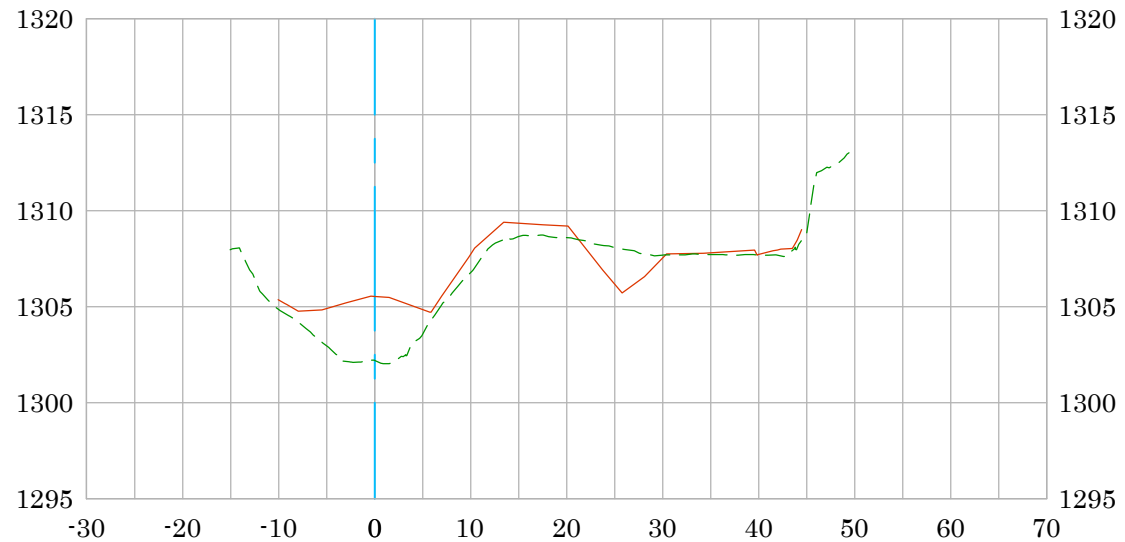

PRE-CONSTRUCTION SURFACE (03/22)


ASBUILT SURFACE POST CONSTRUCTION (11/22)

DATE PREPARED: 12/14/2022

Vert. Scale: 1"=10'

Hor. Scale: 1"=20'

Anderson Creek 22+00 CL

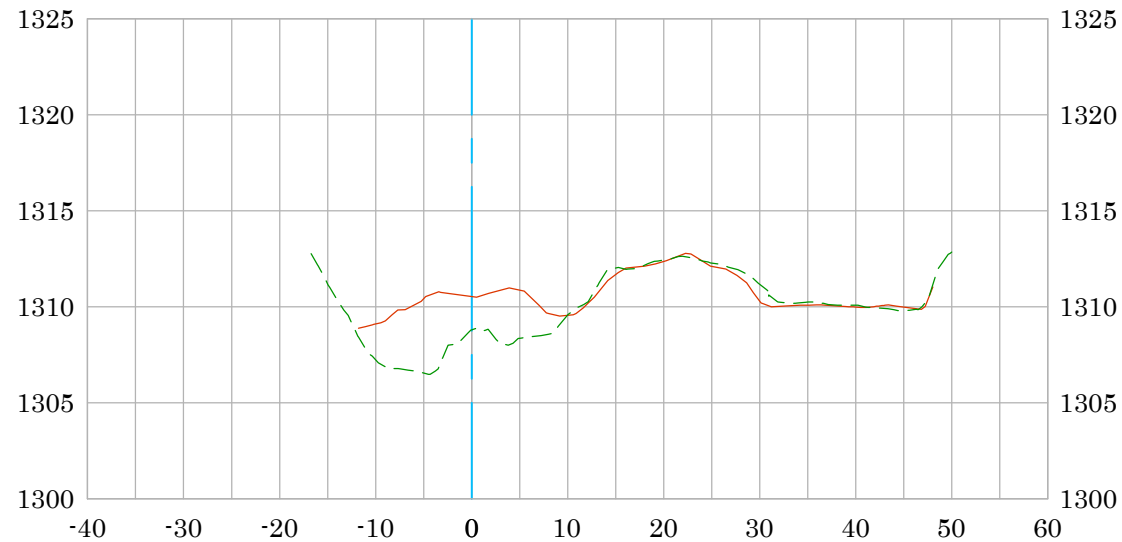

PRE-CONSTRUCTION SURFACE (03/22)

ASBUILT SURFACE POST CONSTRUCTION (11/22)

DATE PREPARED: 12/14/2022

—————

- - - - -

Vert. Scale: 1"=10'


Hor. Scale: 1"=20'

U.S. *Survey
Foot*

OC Public Works
OC Survey/Field Services
Boundary Analysis & Mapping



Anderson Creek 22+50 CL

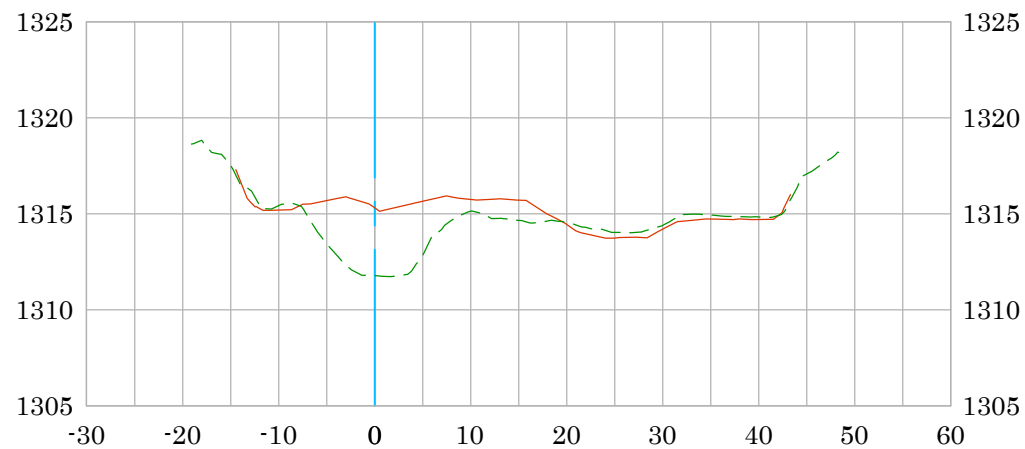


PRE-CONSTRUCTION SURFACE (03/22)

ASBUILT SURFACE POST CONSTRUCTION (11/22)


DATE PREPARED: 12/14/2022

Vert. Scale: 1"=10'

Hor. Scale: 1"=20'

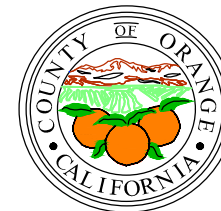

Anderson Creek 23+00 CL

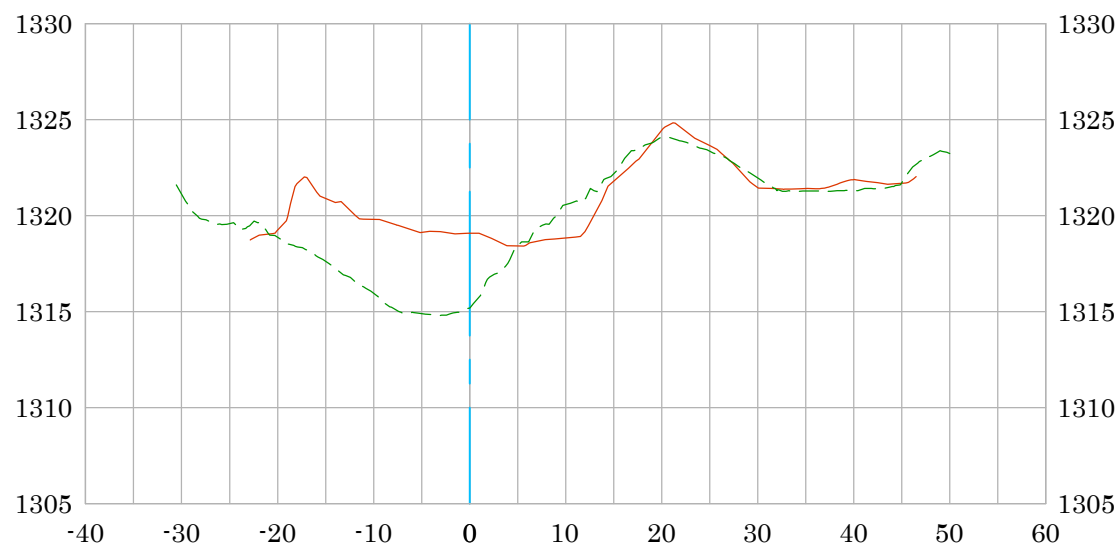


PRE-CONSTRUCTION SURFACE (03/22)

ASBUILT SURFACE POST CONSTRUCTION (11/22)


DATE PREPARED: 12/14/2022

Vert. Scale: 1"=10'

Hor. Scale: 1"=20'

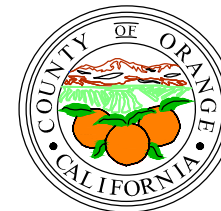

Anderson Creek 23+50 CL

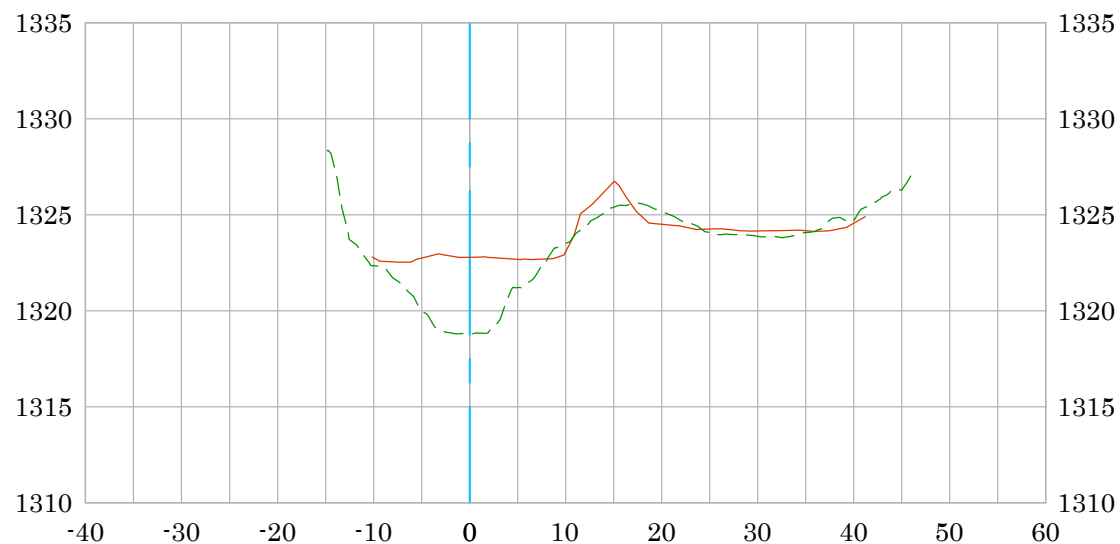

PRE-CONSTRUCTION SURFACE (03/22)

ASBUILT SURFACE POST CONSTRUCTION (11/22)


DATE PREPARED: 12/14/2022

—————


- - - - -

Vert. Scale: 1"=10'

Hor. Scale: 1"=20'

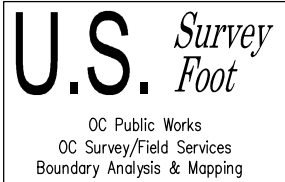

Anderson Creek 24+00 CL

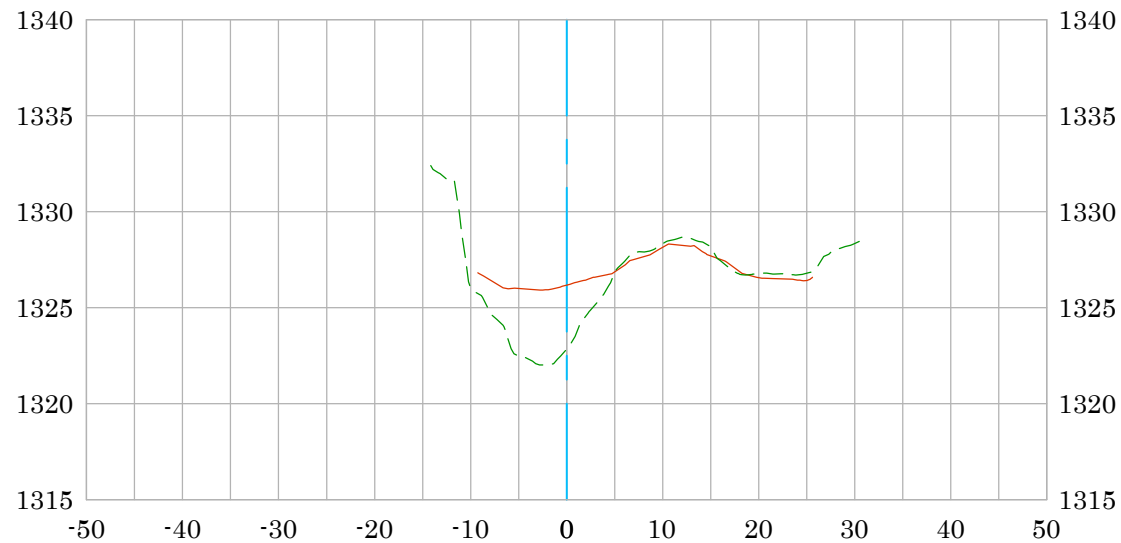

PRE-CONSTRUCTION SURFACE (03/22)

ASBUILT SURFACE POST CONSTRUCTION (11/22)

DATE PREPARED: 12/14/2022

—————

- - - - -

Vert. Scale: 1"=10'


Hor. Scale: 1"=20'

U.S. *Survey*
Foot

OC Public Works
OC Survey/Field Services
Boundary Analysis & Mapping



Anderson Creek 24+50 CL

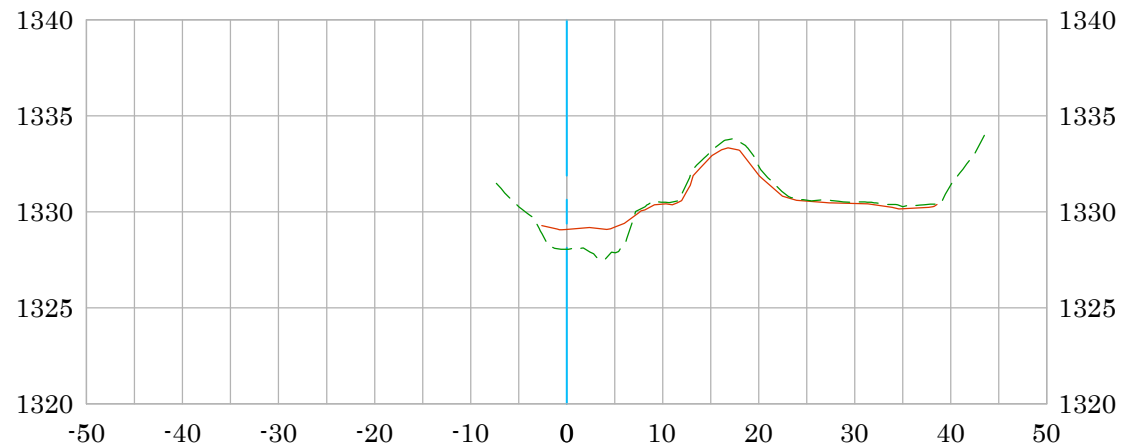


PRE-CONSTRUCTION SURFACE (03/22)

ASBUILT SURFACE POST CONSTRUCTION (11/22)


DATE PREPARED: 12/14/2022

Vert. Scale: 1"=10'

Hor. Scale: 1"=20'

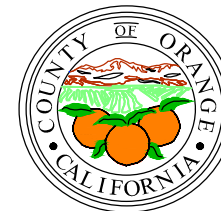

Anderson Creek 25+00 CL

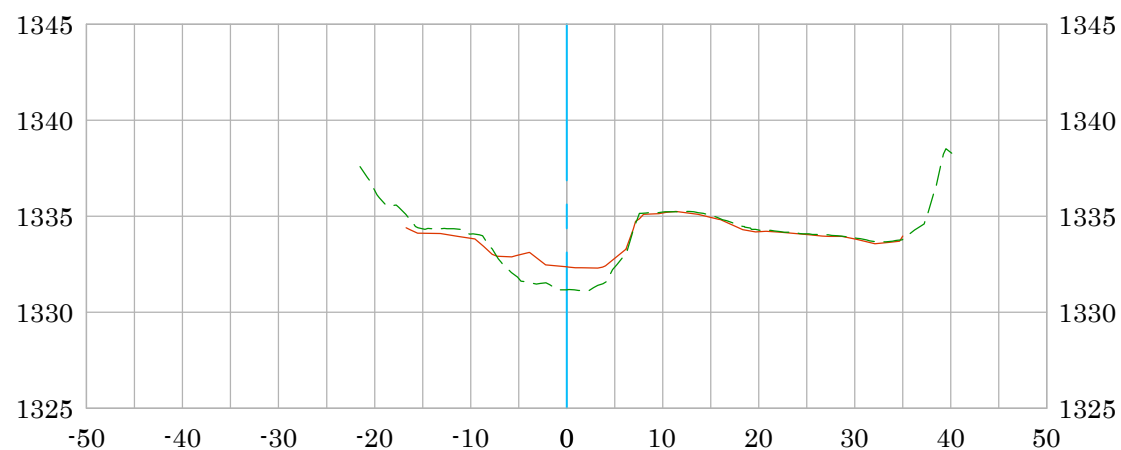


PRE-CONSTRUCTION SURFACE (03/22)

ASBUILT SURFACE POST CONSTRUCTION (11/22)


DATE PREPARED: 12/14/2022

Vert. Scale: 1"=10'

Hor. Scale: 1"=20'

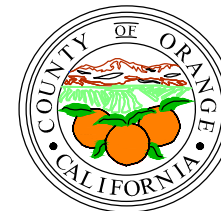

Anderson Creek 25+50 CL

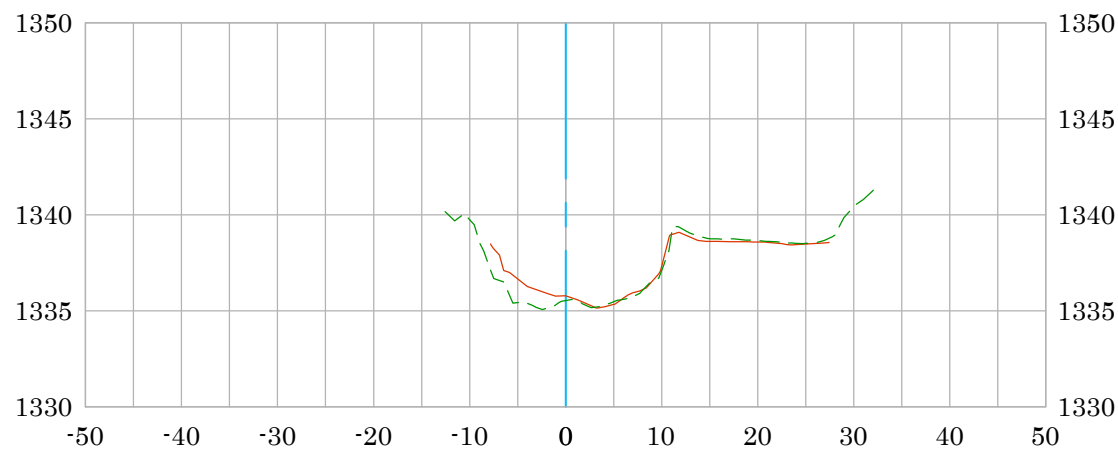

PRE-CONSTRUCTION SURFACE (03/22)

ASBUILT SURFACE POST CONSTRUCTION (11/22)


DATE PREPARED: 12/14/2022

—————


- - - - -

Vert. Scale: 1"=10'

Hor. Scale: 1"=20'

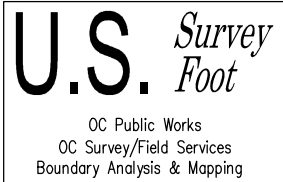

Anderson Creek 26+00 CL

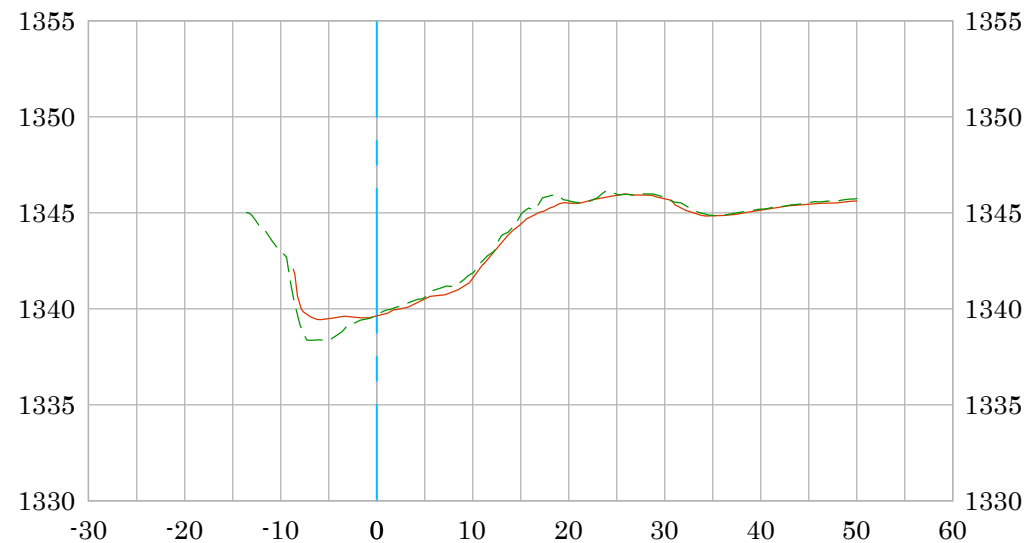

PRE-CONSTRUCTION SURFACE (03/22)

ASBUILT SURFACE POST CONSTRUCTION (11/22)

DATE PREPARED: 12/14/2022

Vert. Scale: 1"=10'


Hor. Scale: 1"=20'

U.S. *Survey*
Foot

OC Public Works
OC Survey/Field Services
Boundary Analysis & Mapping



Anderson Creek 26+50 CL

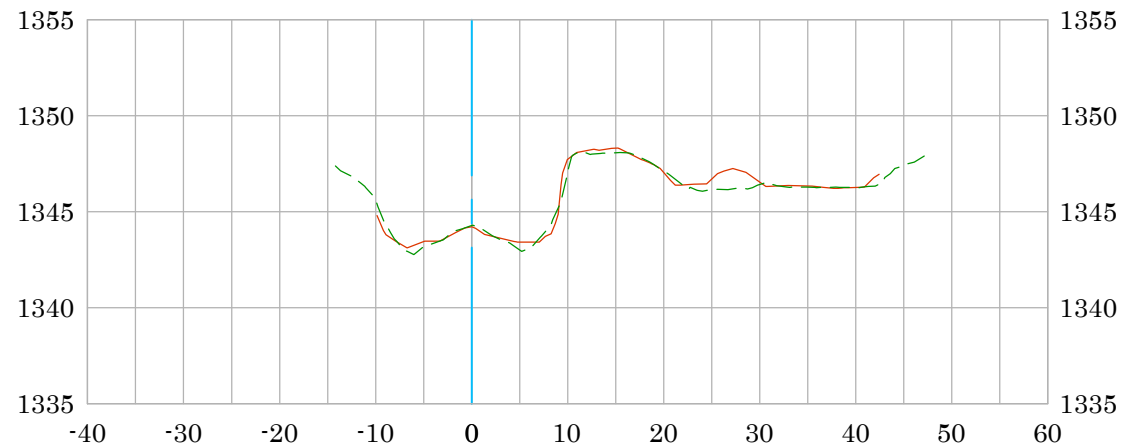


PRE-CONSTRUCTION SURFACE (03/22)

ASBUILT SURFACE POST CONSTRUCTION (11/22)


DATE PREPARED: 12/14/2022

Vert. Scale: 1"=10'

Hor. Scale: 1"=20'

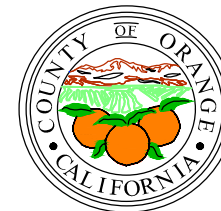

Anderson Creek 26+88 CL

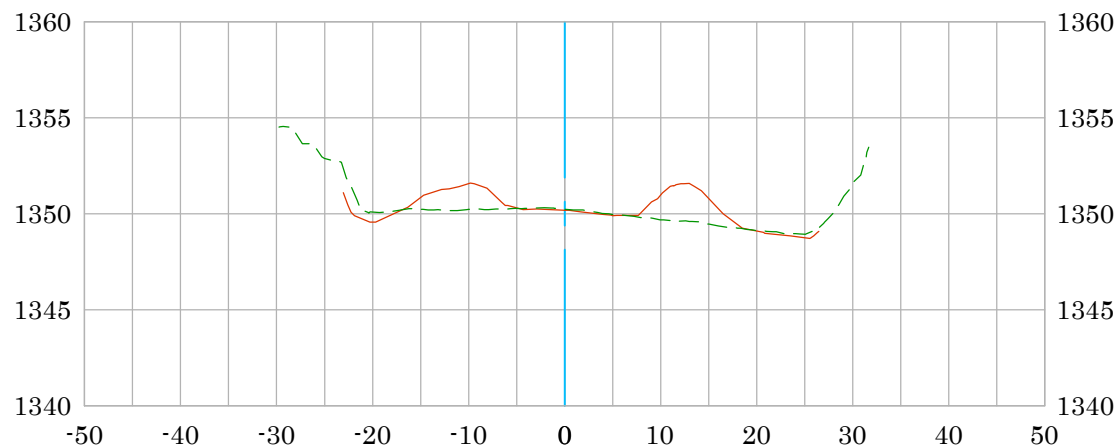

PRE-CONSTRUCTION SURFACE (03/22)

ASBUILT SURFACE POST CONSTRUCTION (11/22)

DATE PREPARED: 12/14/2022

—————

- - - - -

Vert. Scale: 1"=10'


Hor. Scale: 1"=20'

U.S. *Survey*
Foot

OC Public Works
OC Survey/Field Services
Boundary Analysis & Mapping



Anderson Creek 26+96 CL

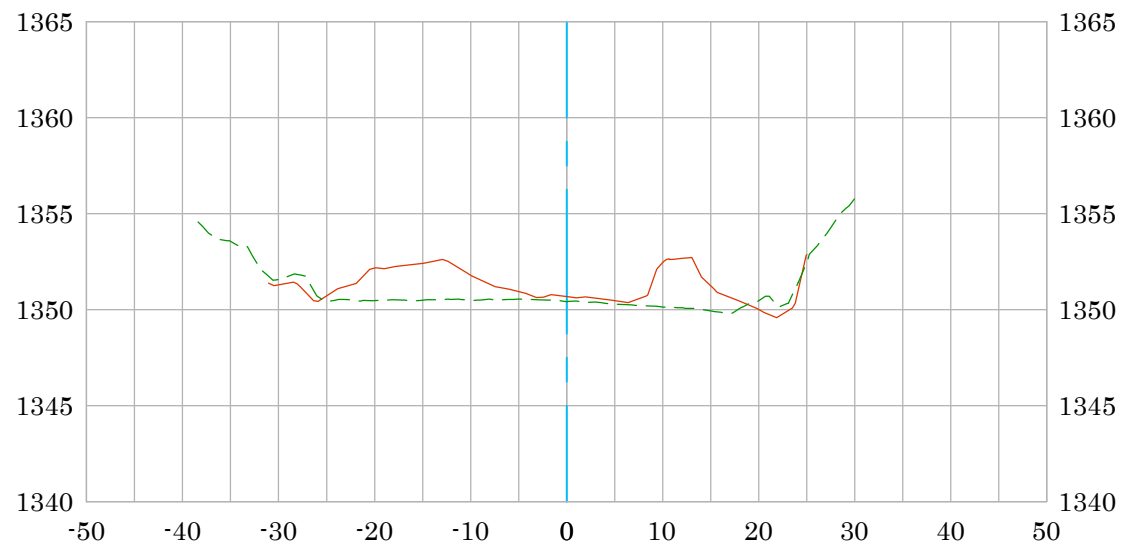

PRE-CONSTRUCTION SURFACE (03/22)

ASBUILT SURFACE POST CONSTRUCTION (11/22)

DATE PREPARED: 12/14/2022

Vert. Scale: 1"=10'


Hor. Scale: 1"=20'

U.S. *Survey Foot*

OC Public Works
OC Survey/Field Services
Boundary Analysis & Mapping



Anderson Creek
Bridge Crossing
27+03
CL

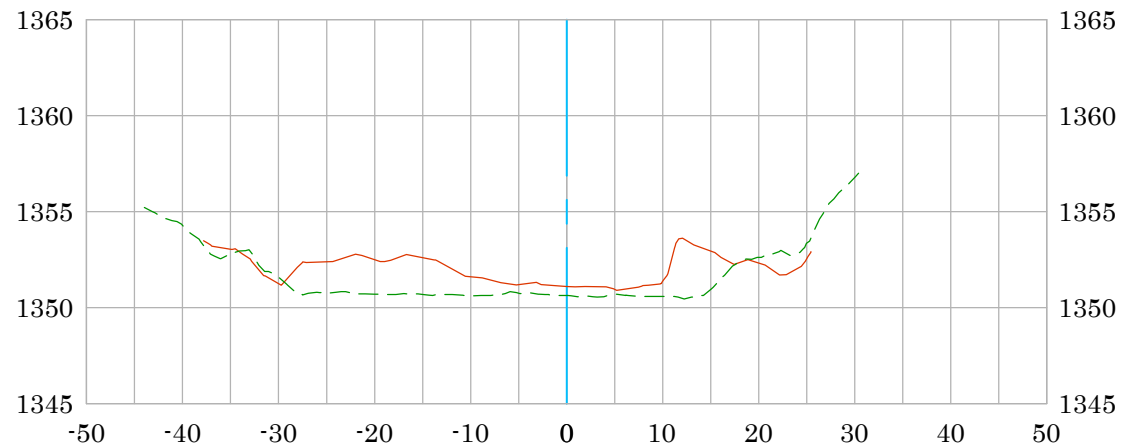

PRE-CONSTRUCTION SURFACE (03/22)

ASBUILT SURFACE POST CONSTRUCTION (11/22)

DATE PREPARED: 12/14/2022

Vert. Scale: 1"=10'


Hor. Scale: 1"=20'

U.S. *Survey*
Foot

OC Public Works
OC Survey/Field Services
Boundary Analysis & Mapping



Anderson Creek 27+10 CL

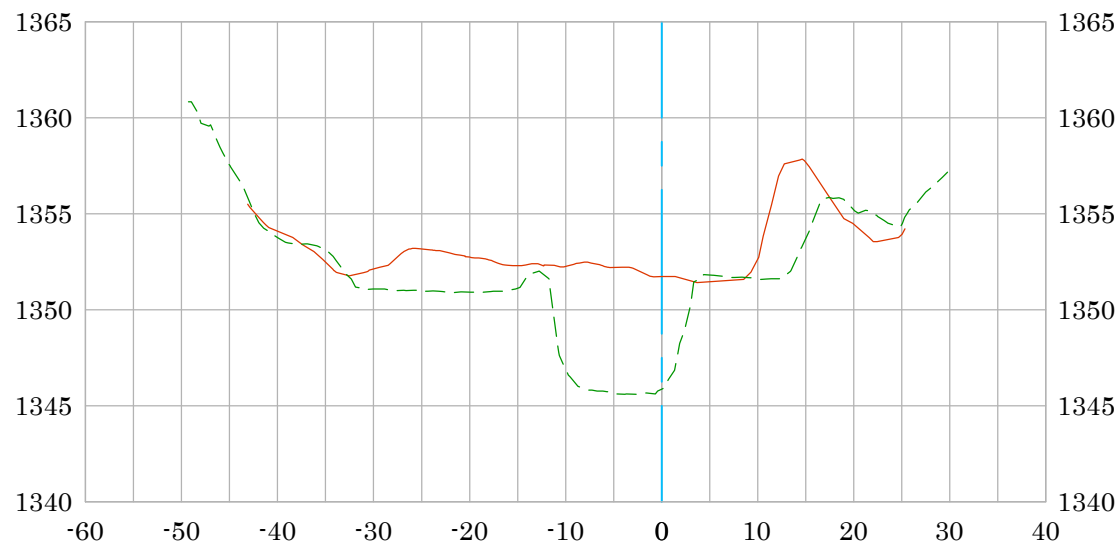


PRE-CONSTRUCTION SURFACE (03/22)

ASBUILT SURFACE POST CONSTRUCTION (11/22)


DATE PREPARED: 12/14/2022

Vert. Scale: 1"=10'

Hor. Scale: 1"=20'

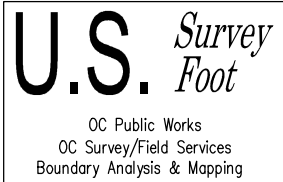

Anderson Creek 27+18 CL

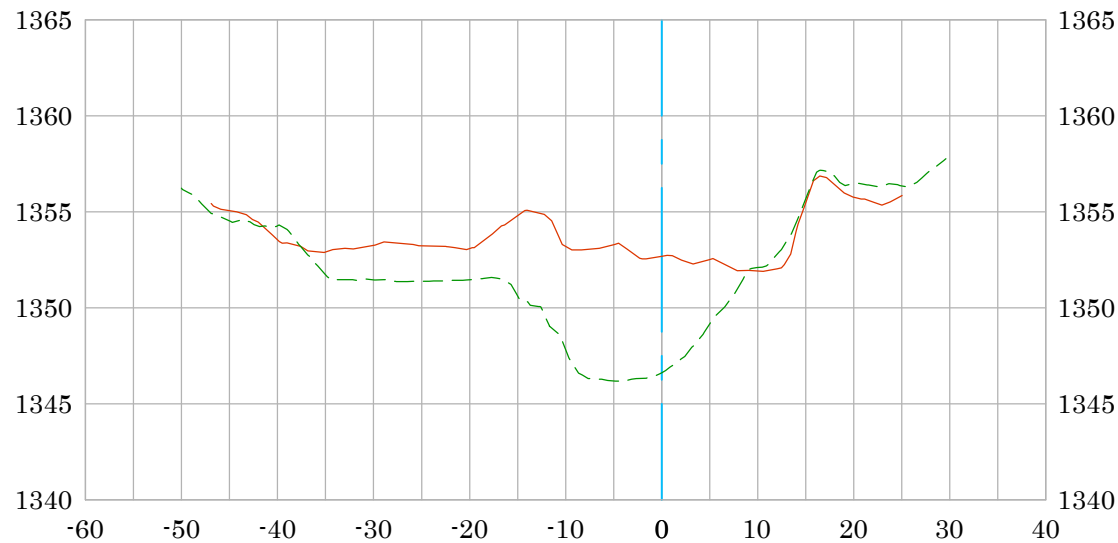


PRE-CONSTRUCTION SURFACE (03/22)

ASBUILT SURFACE POST CONSTRUCTION (11/22)


DATE PREPARED: 12/14/2022

Vert. Scale: 1"=10'

Hor. Scale: 1"=20'

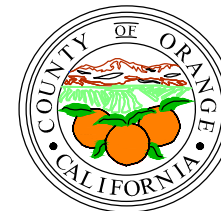

Anderson Creek 27+00 CL

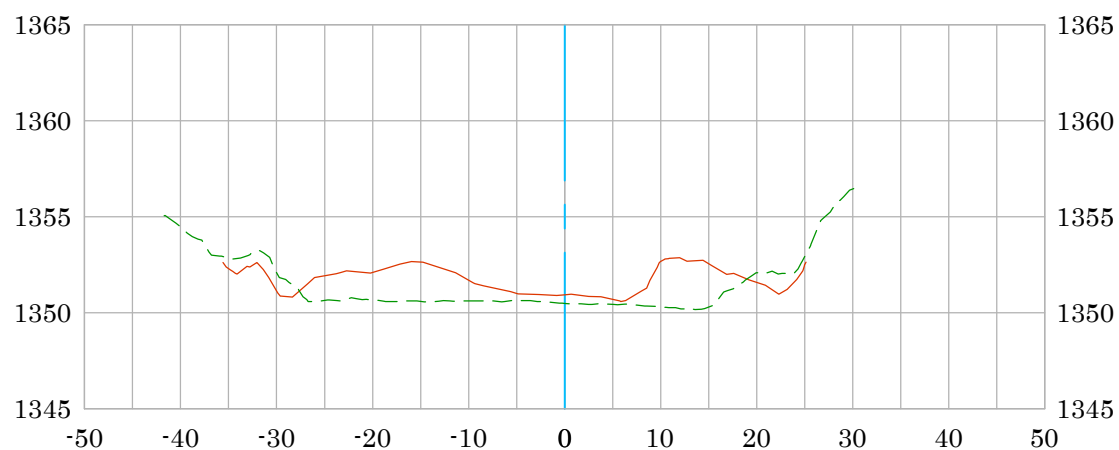

PRE-CONSTRUCTION SURFACE (03/22)

ASBUILT SURFACE POST CONSTRUCTION (11/22)


DATE PREPARED: 12/14/2022

—————


- - - - -

Vert. Scale: 1"=10'

Hor. Scale: 1"=20'

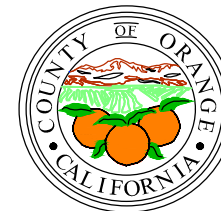

Anderson Creek 27+50 CL

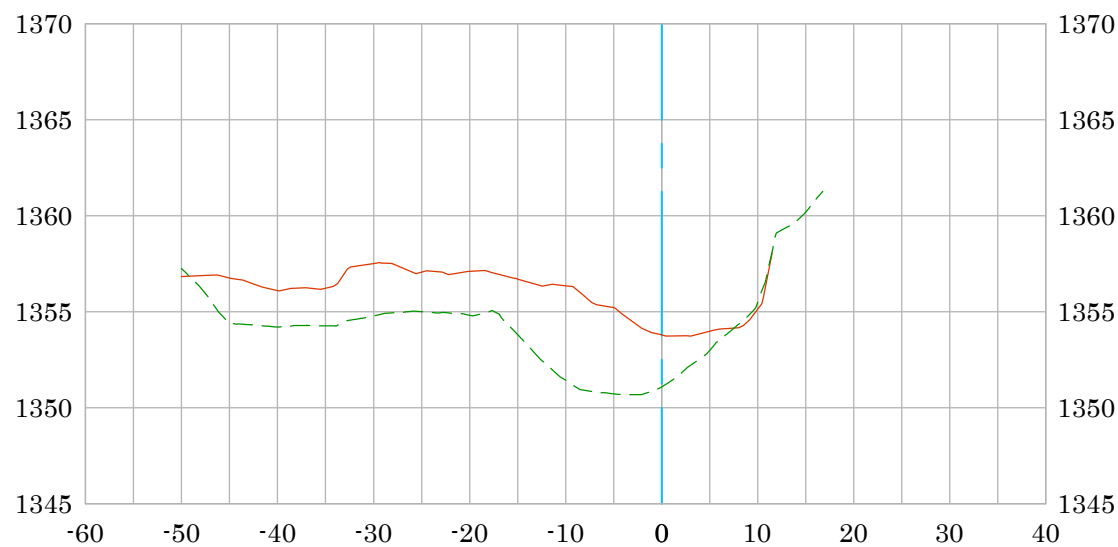

PRE-CONSTRUCTION SURFACE (03/22)

ASBUILT SURFACE POST CONSTRUCTION (11/22)

DATE PREPARED: 12/14/2022

Vert. Scale: 1"=10'


Hor. Scale: 1"=20'

U.S. *Survey
Foot*

OC Public Works
OC Survey/Field Services
Boundary Analysis & Mapping



Anderson Creek 28+00 CL

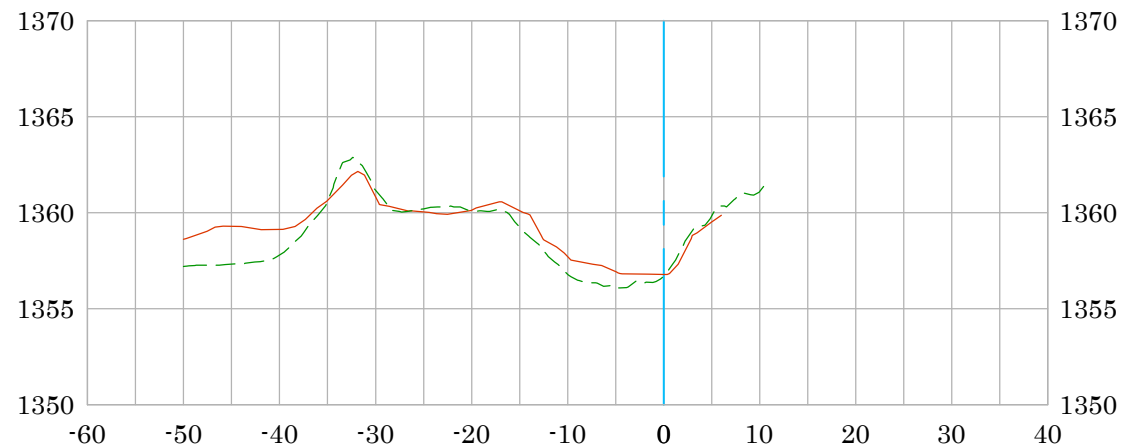


PRE-CONSTRUCTION SURFACE (03/22)

ASBUILT SURFACE POST CONSTRUCTION (11/22)


DATE PREPARED: 12/14/2022

Vert. Scale: 1"=10'

Hor. Scale: 1"=20'

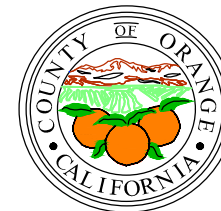

Anderson Creek 28+50 CL

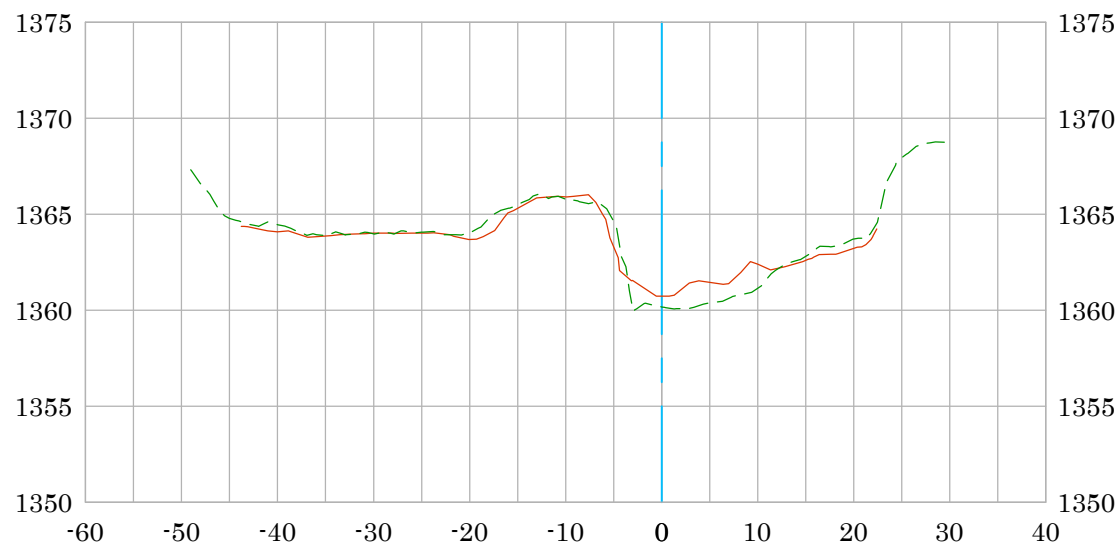


PRE-CONSTRUCTION SURFACE (03/22)

ASBUILT SURFACE POST CONSTRUCTION (11/22)

DATE PREPARED: 12/14/2022


Vert. Scale: 1"=10'

Hor. Scale: 1"=20'

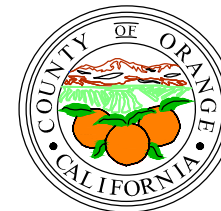

Silverado Creek Area 1 Bridge Crossing

46+00
CL

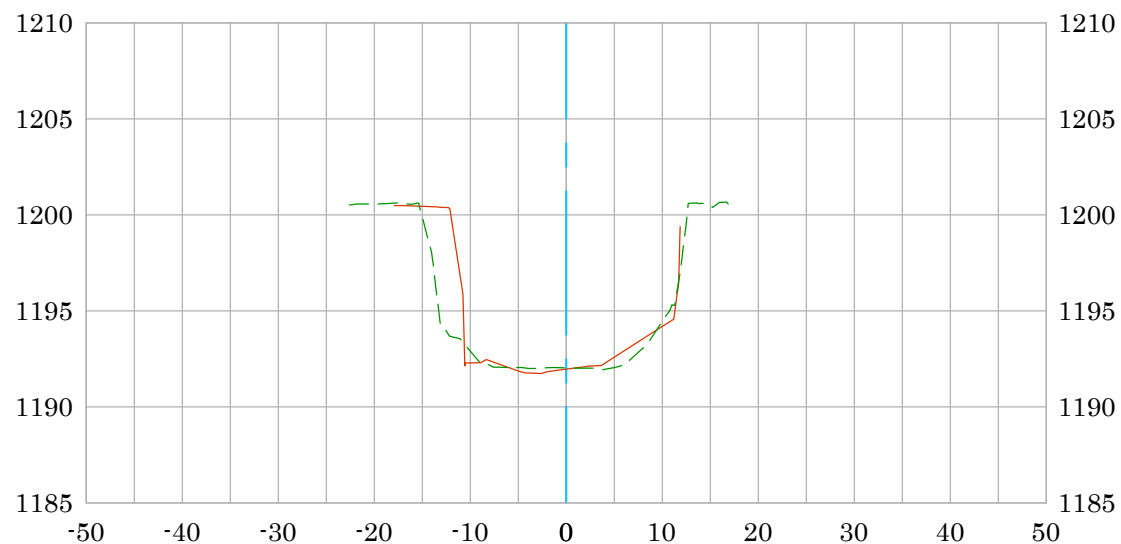


PRE-CONSTRUCTION SURFACE (03/22)

ASBUILT SURFACE POST CONSTRUCTION (11/22)


DATE PREPARED: 12/14/2022

Vert. Scale: 1"=10'

Hor. Scale: 1"=20'

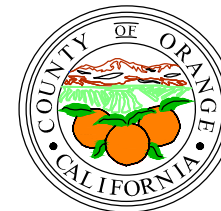

Silverado Creek Area 1 46+50 CL

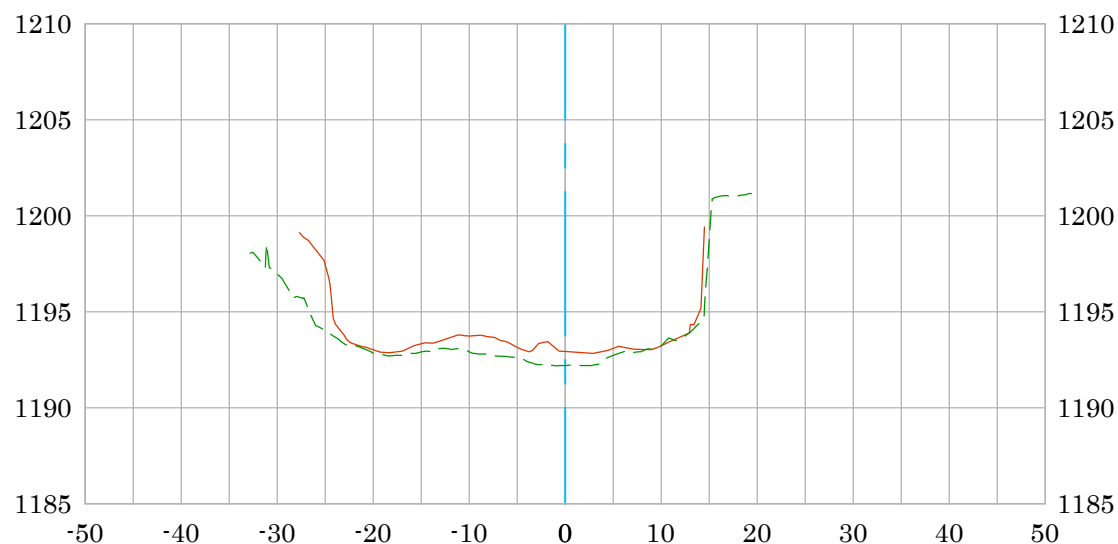


PRE-CONSTRUCTION SURFACE (03/22)

ASBUILT SURFACE POST CONSTRUCTION (11/22)

DATE PREPARED: 12/14/2022

Vert. Scale: 1"=10'


Hor. Scale: 1"=20'

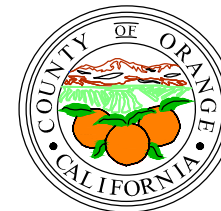

Silverado Creek Area 1

47+00

CL

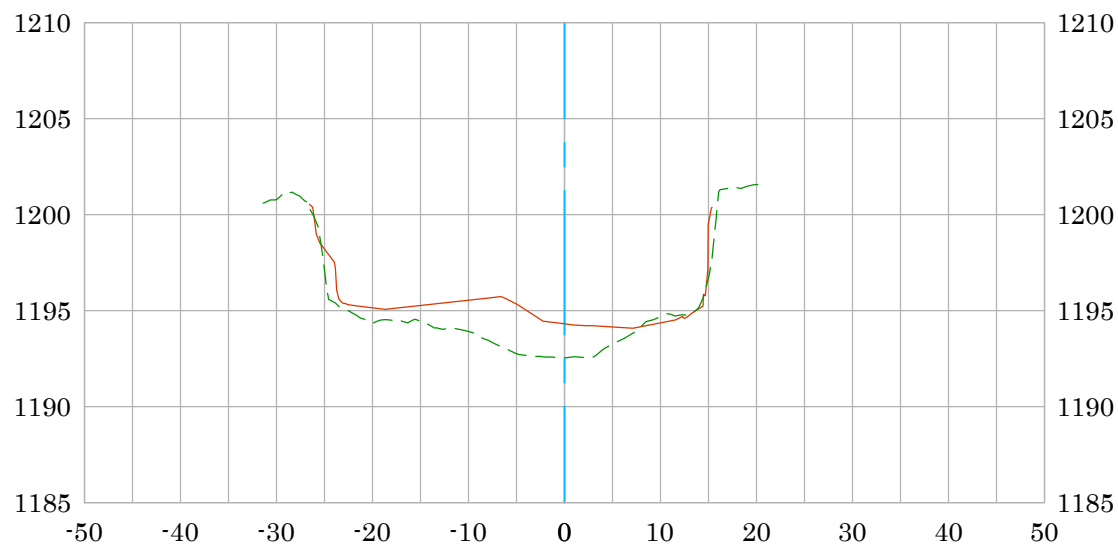

PRE-CONSTRUCTION SURFACE (03/22)

ASBUILT SURFACE POST CONSTRUCTION (11/22)

DATE PREPARED: 12/14/2022

Vert. Scale: 1"=10'

Hor. Scale: 1"=20'

U.S. *Survey*
Foot


OC Public Works
OC Survey/Field Services
Boundary Analysis & Mapping



Silverado Creek Area 1

47+50

CL

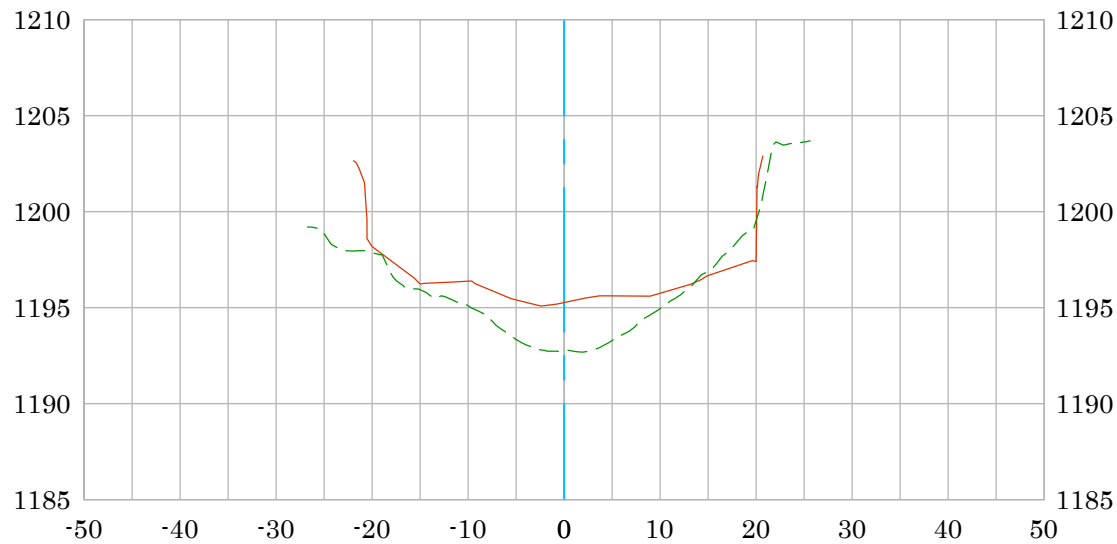

PRE-CONSTRUCTION SURFACE (03/22)

ASBUILT SURFACE POST CONSTRUCTION (11/22)

DATE PREPARED: 12/14/2022

Vert. Scale: 1"=10'

Hor. Scale: 1"=20'

U.S. *Survey*
Foot


OC Public Works
OC Survey/Field Services
Boundary Analysis & Mapping



Silverado Creek Area 1

48+00

CL

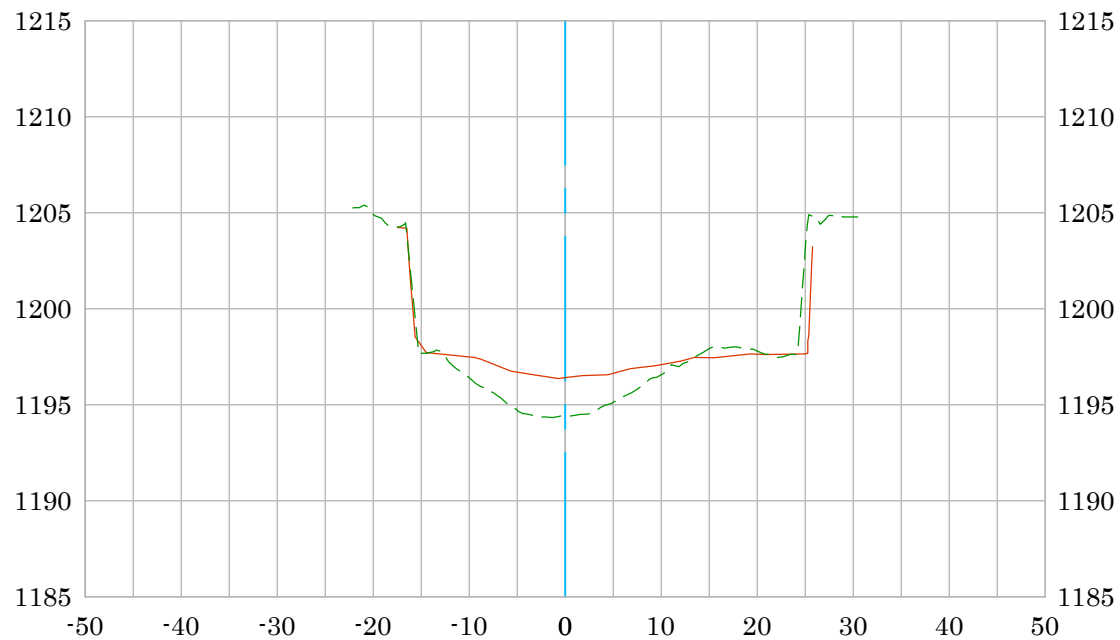

PRE-CONSTRUCTION SURFACE (03/22)

ASBUILT SURFACE POST CONSTRUCTION (11/22)

DATE PREPARED: 12/14/2022

Vert. Scale: 1"=10'


Hor. Scale: 1"=20'

U.S. *Survey*
Foot

OC Public Works
OC Survey/Field Services
Boundary Analysis & Mapping



Silverado Creek Area 1 48+50 CL

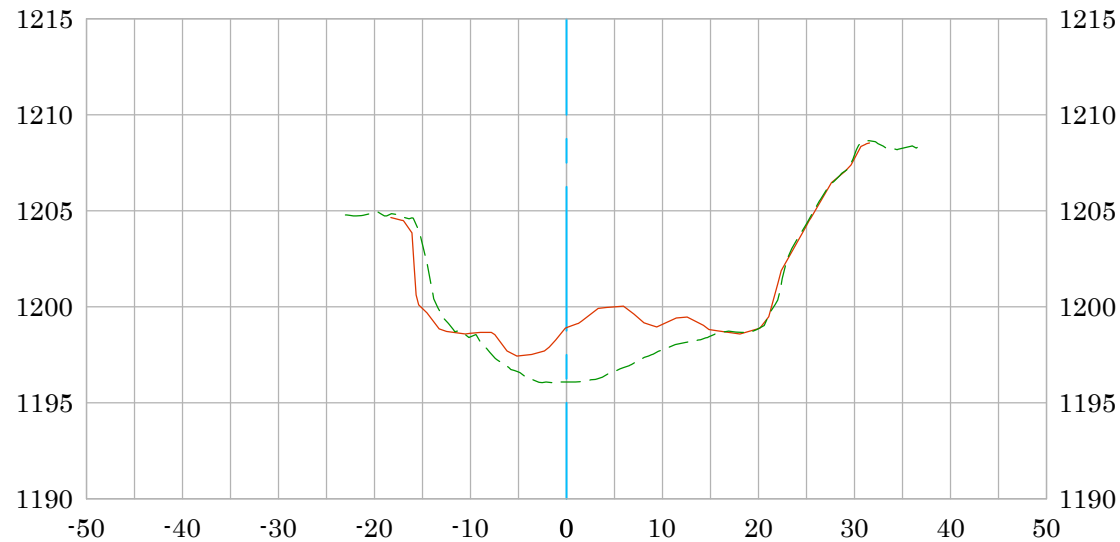

PRE-CONSTRUCTION SURFACE (03/22)

ASBUILT SURFACE POST CONSTRUCTION (11/22)

DATE PREPARED: 12/14/2022

Vert. Scale: 1"=10'


Hor. Scale: 1"=20'

U.S. *Survey*
Foot

OC Public Works
OC Survey/Field Services
Boundary Analysis & Mapping



Silverado Creek Area 1 49+00 CL

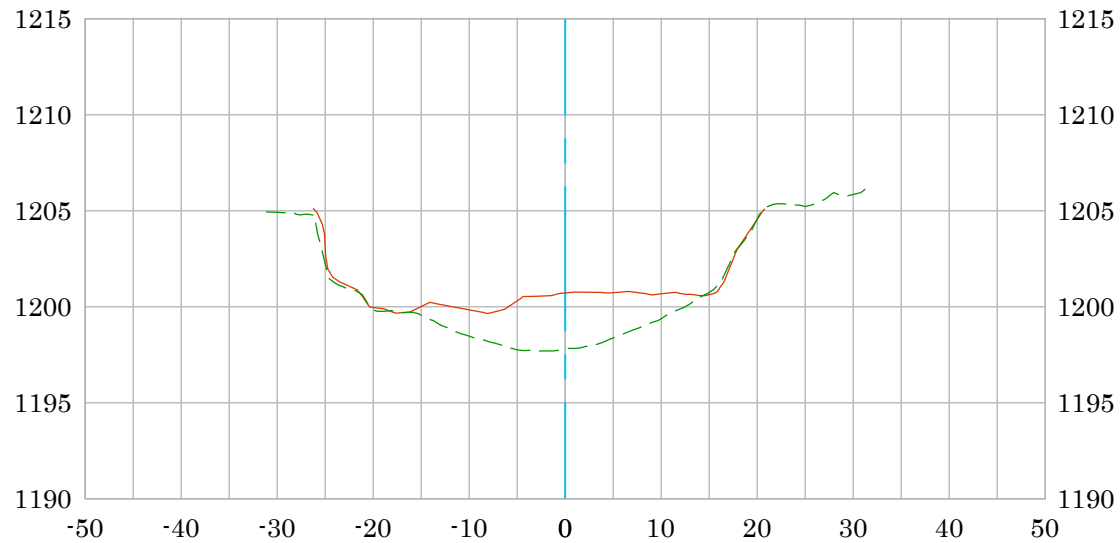

PRE-CONSTRUCTION SURFACE (03/22)

ASBUILT SURFACE POST CONSTRUCTION (11/22)

DATE PREPARED: 12/14/2022


Vert. Scale: 1"=10'

Hor. Scale: 1"=20'

Silverado Creek Area 1

49+50

CL

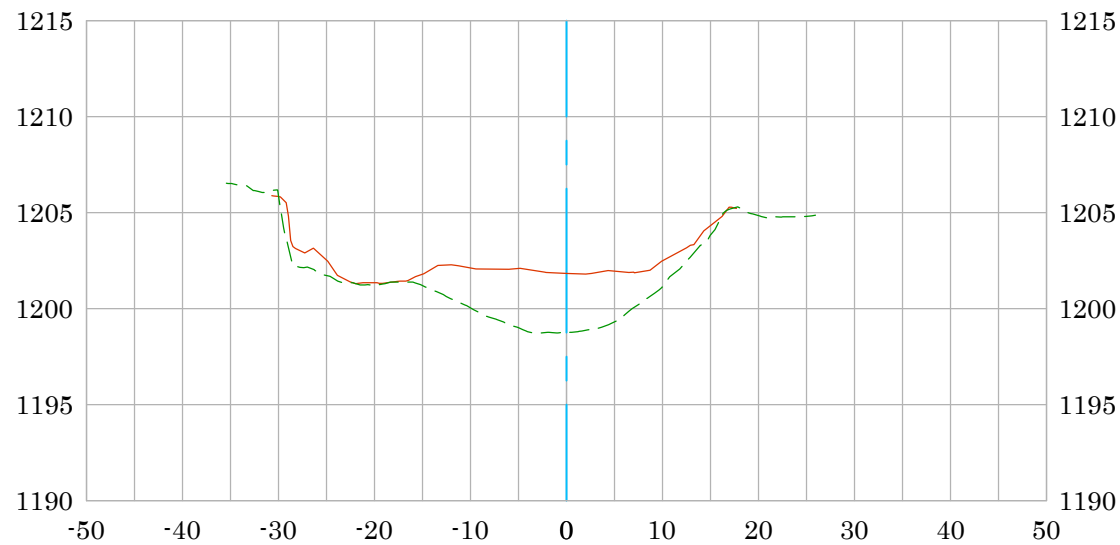


PRE-CONSTRUCTION SURFACE (03/22)

ASBUILT SURFACE POST CONSTRUCTION (11/22)

DATE PREPARED: 12/14/2022

Vert. Scale: 1"=10'


Hor. Scale: 1"=20'

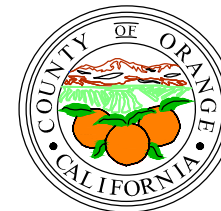

Silverado Creek Area 1

50+00

CL

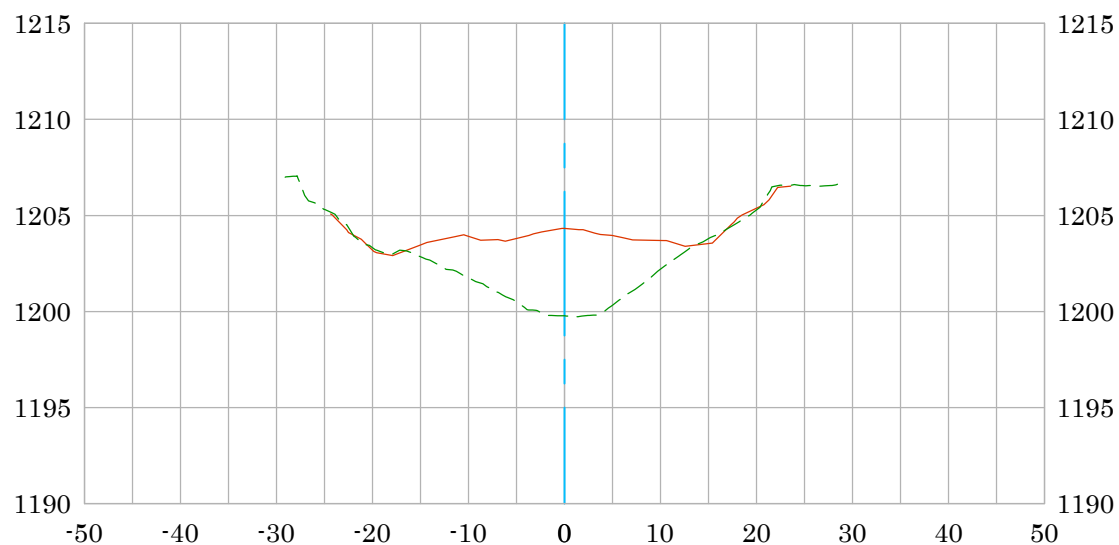


PRE-CONSTRUCTION SURFACE (03/22)

ASBUILT SURFACE POST CONSTRUCTION (11/22)


DATE PREPARED: 12/14/2022

Vert. Scale: 1"=10'

Hor. Scale: 1"=20'

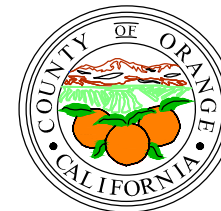

Silverado Creek Area 1 50+50 CL

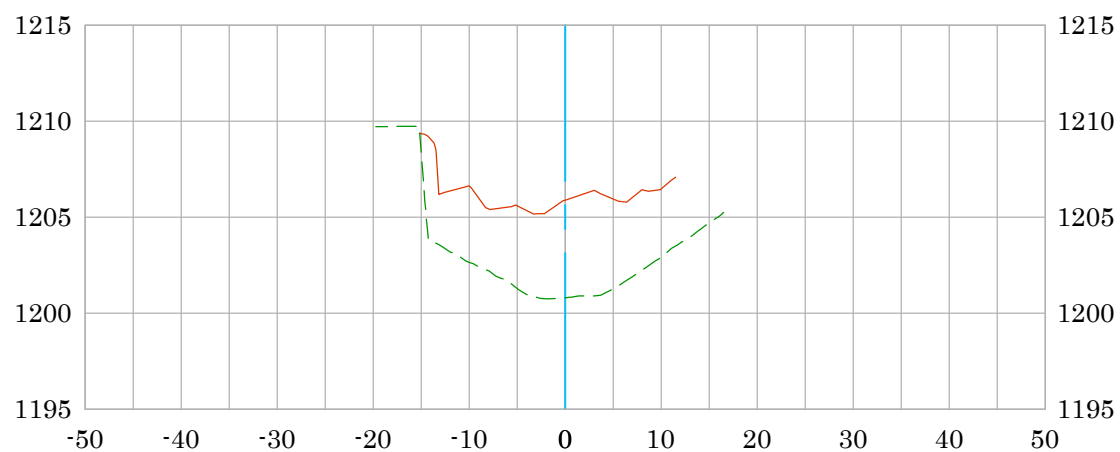

PRE-CONSTRUCTION SURFACE (03/22)

ASBUILT SURFACE POST CONSTRUCTION (11/22)

DATE PREPARED: 12/14/2022

Vert. Scale: 1"=10'


Hor. Scale: 1"=20'

U.S. *Survey*
Foot

OC Public Works
OC Survey/Field Services
Boundary Analysis & Mapping



Silverado Creek Area 1 51+00 CL

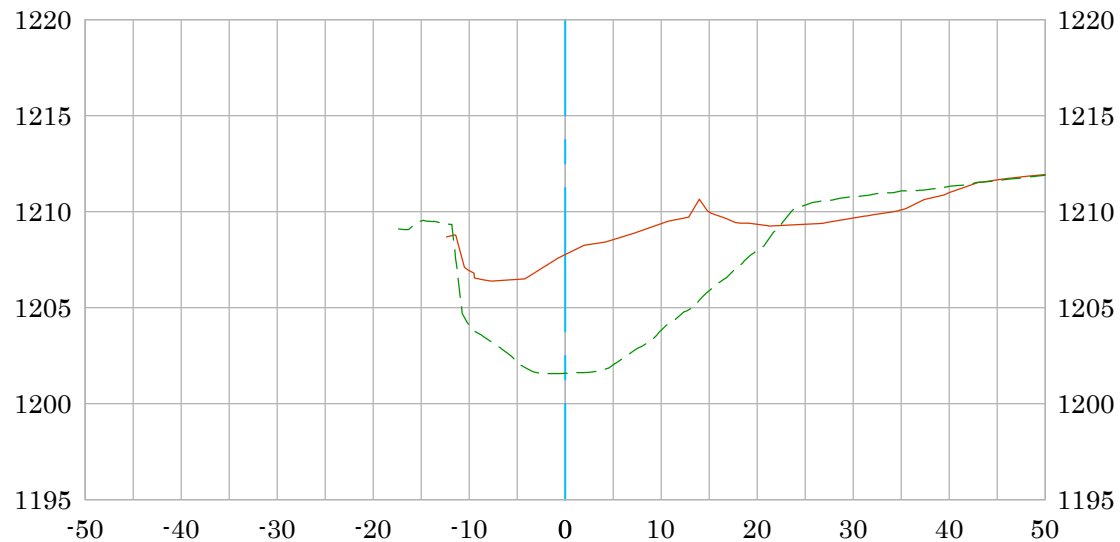


PRE-CONSTRUCTION SURFACE (03/22)

ASBUILT SURFACE POST CONSTRUCTION (11/22)

DATE PREPARED: 12/14/2022

Vert. Scale: 1"=10'


Hor. Scale: 1"=20'

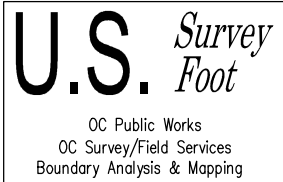

Silverado Creek Area 1

51+50

CL

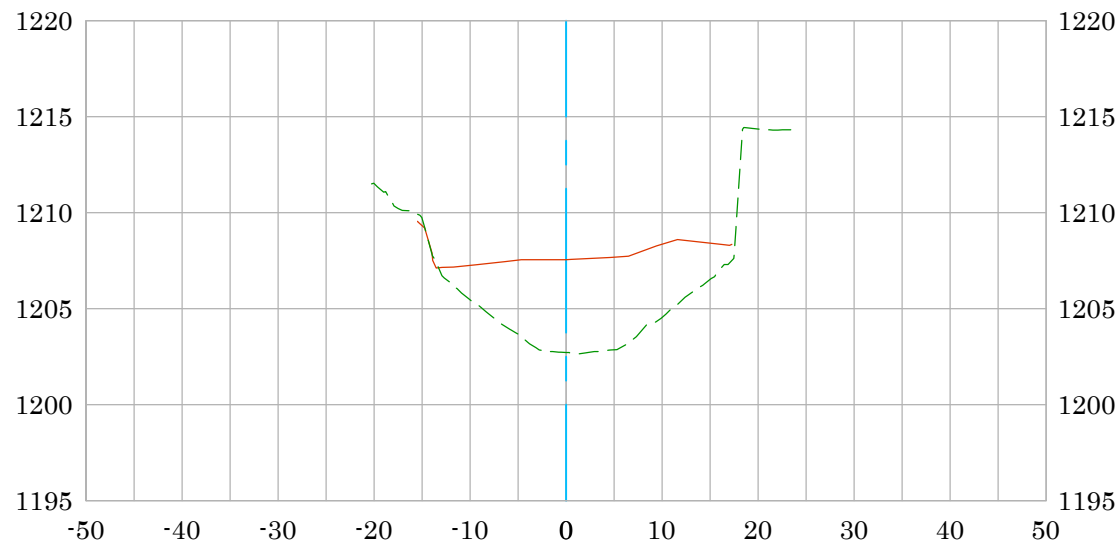

PRE-CONSTRUCTION SURFACE (03/22)

ASBUILT SURFACE POST CONSTRUCTION (11/22)

DATE PREPARED: 12/14/2022



Vert. Scale: 1"=10'

Hor. Scale: 1"=20'

U.S. *Survey*
Foot


OC Public Works
OC Survey/Field Services
Boundary Analysis & Mapping



Silverado Creek Area 1

52+00

CL

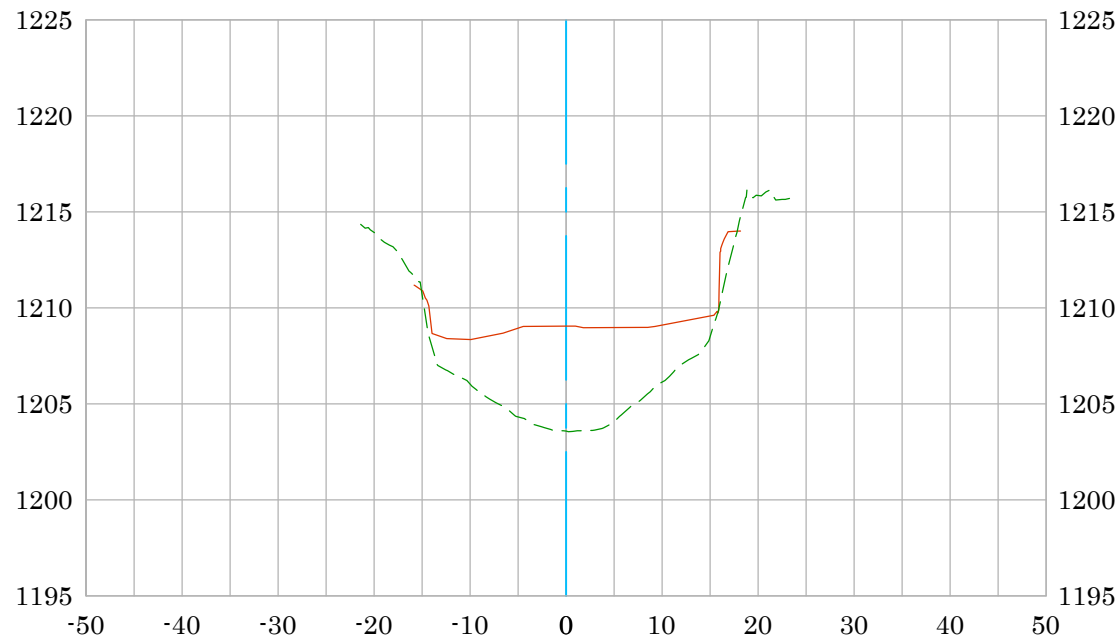

PRE-CONSTRUCTION SURFACE (03/22)

ASBUILT SURFACE POST CONSTRUCTION (11/22)

DATE PREPARED: 12/14/2022

Vert. Scale: 1"=10'

Hor. Scale: 1"=20'

U.S. *Survey
Foot*


OC Public Works
OC Survey/Field Services
Boundary Analysis & Mapping



Silverado Creek Area 1

52+50

CL

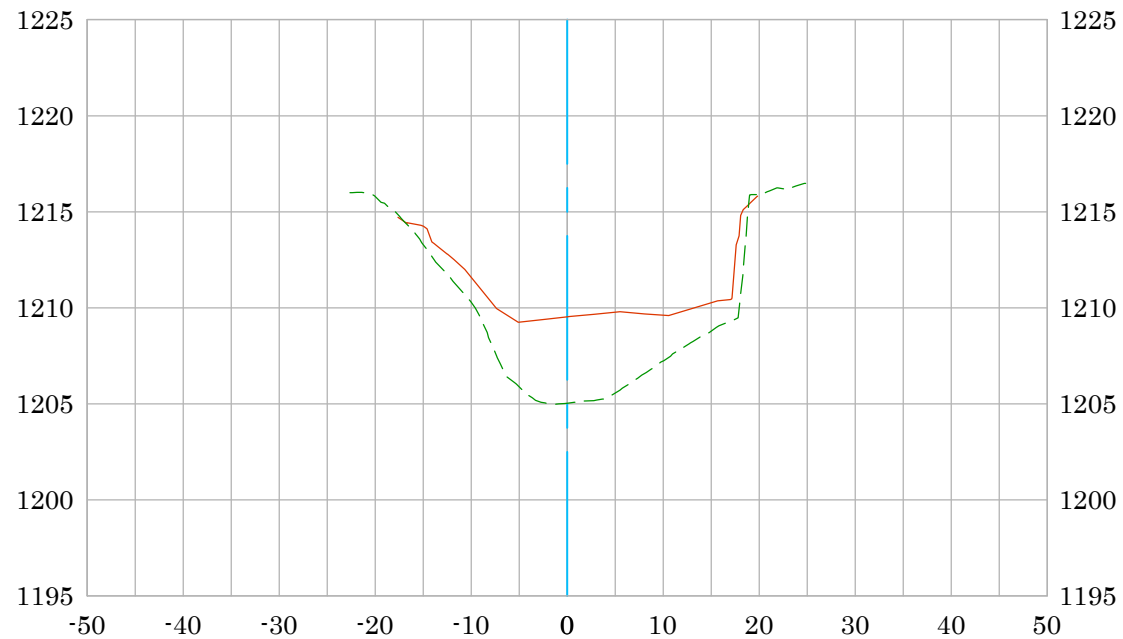


PRE-CONSTRUCTION SURFACE (03/22)

ASBUILT SURFACE POST CONSTRUCTION (11/22)

DATE PREPARED: 12/14/2022

Vert. Scale: 1"=10'


Hor. Scale: 1"=20'

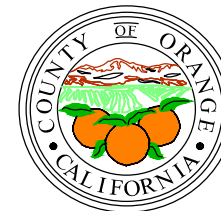

Silverado Creek Area 1

53+00

CL

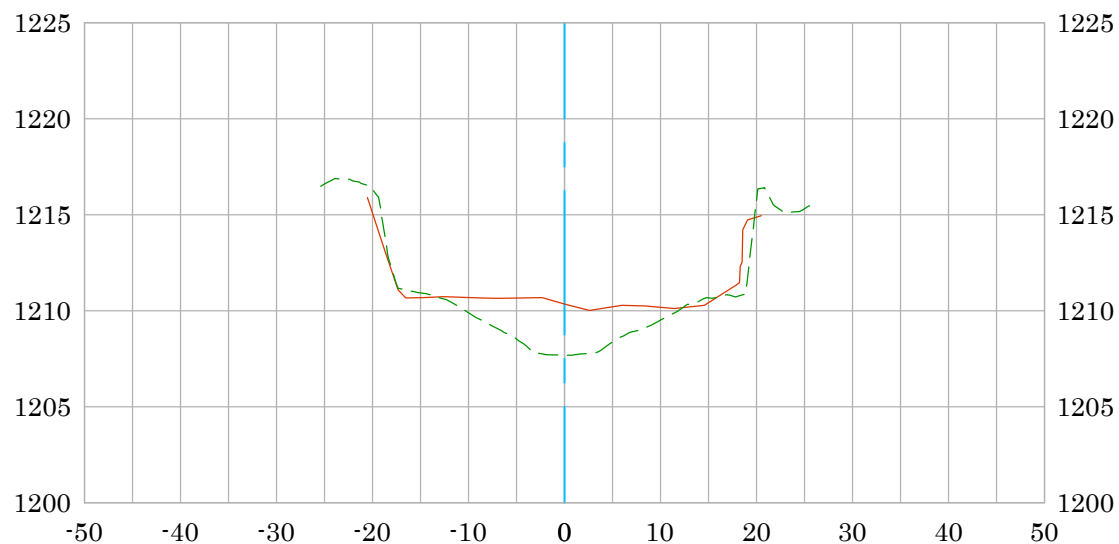

PRE-CONSTRUCTION SURFACE (03/22)

ASBUILT SURFACE POST CONSTRUCTION (11/22)

DATE PREPARED: 12/14/2022

Vert. Scale: 1"=10'

Hor. Scale: 1"=20'

U.S. *Survey*
Foot


OC Public Works
OC Survey/Field Services
Boundary Analysis & Mapping



Silverado Creek Area 1

53+47

CL

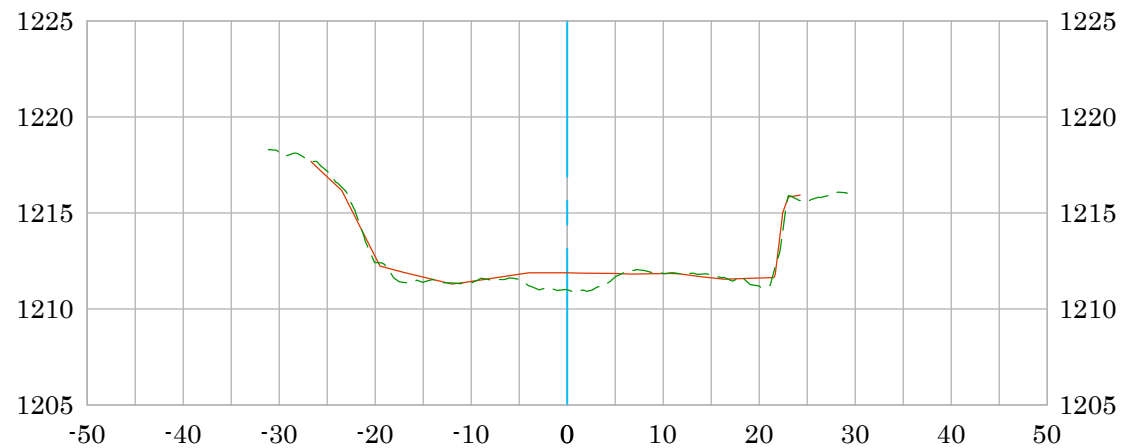


PRE-CONSTRUCTION SURFACE (03/22)

ASBUILT SURFACE POST CONSTRUCTION (11/22)


DATE PREPARED: 12/14/2022

Vert. Scale: 1"=10'

Hor. Scale: 1"=20'

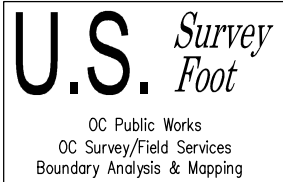

Wildcat Creek 60+00 CL

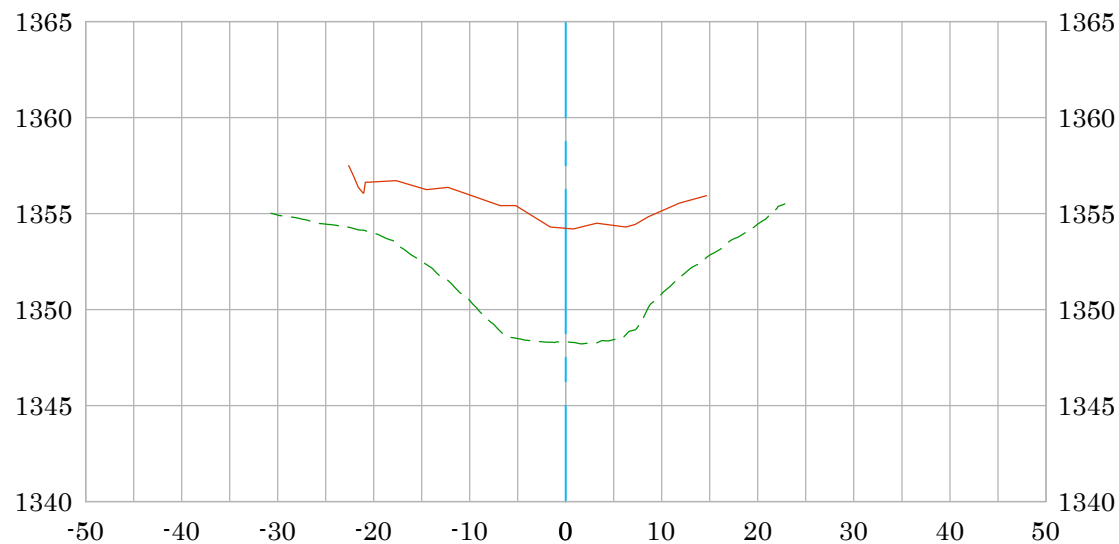


PRE-CONSTRUCTION SURFACE (03/22)

ASBUILT SURFACE POST CONSTRUCTION (11/22)


DATE PREPARED: 12/14/2022

Vert. Scale: 1"=10'

Hor. Scale: 1"=20'

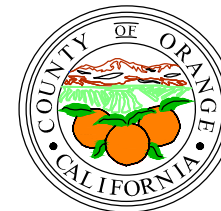

Wildcat Creek 60+50 CL

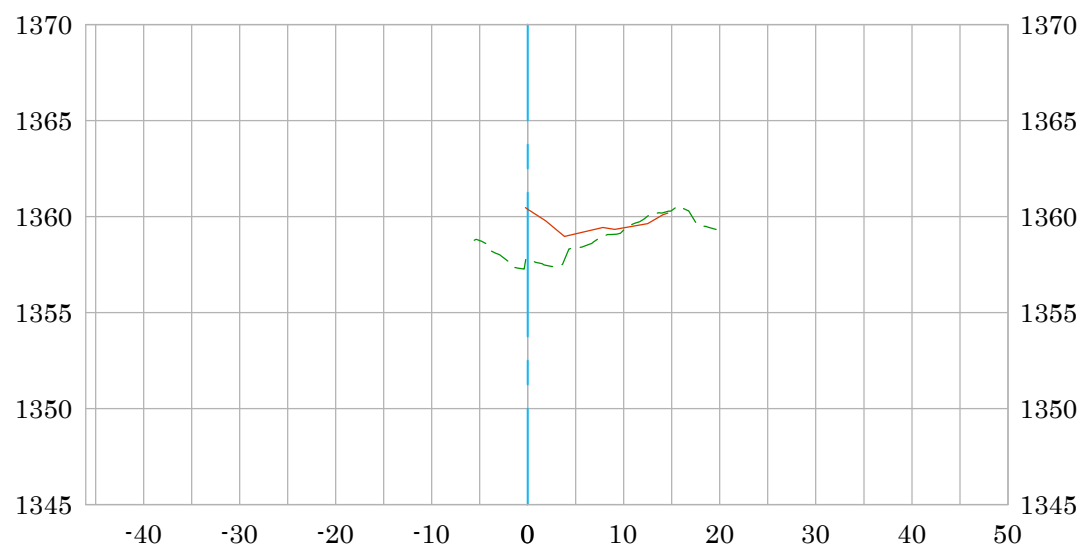

PRE-CONSTRUCTION SURFACE (03/22)

ASBUILT SURFACE POST CONSTRUCTION (11/22)

DATE PREPARED: 12/14/2022

—————

- - - - -

Vert. Scale: 1"=10'


Hor. Scale: 1"=20'

U.S. *Survey Foot*

OC Public Works
OC Survey/Field Services
Boundary Analysis & Mapping



Wildcat Creek 61+00 CL

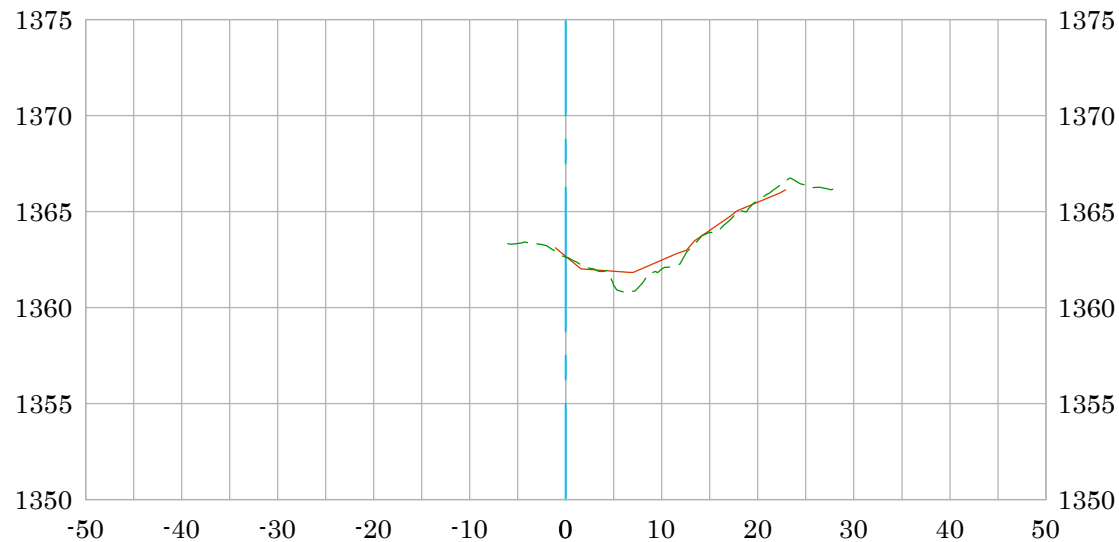


PRE-CONSTRUCTION SURFACE (03/22)

ASBUILT SURFACE POST CONSTRUCTION (11/22)


DATE PREPARED: 12/14/2022

Vert. Scale: 1"=10'

Hor. Scale: 1"=20'

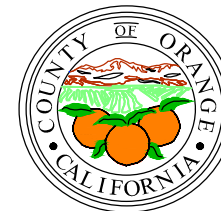

Wildcat Creek 61+35 CL

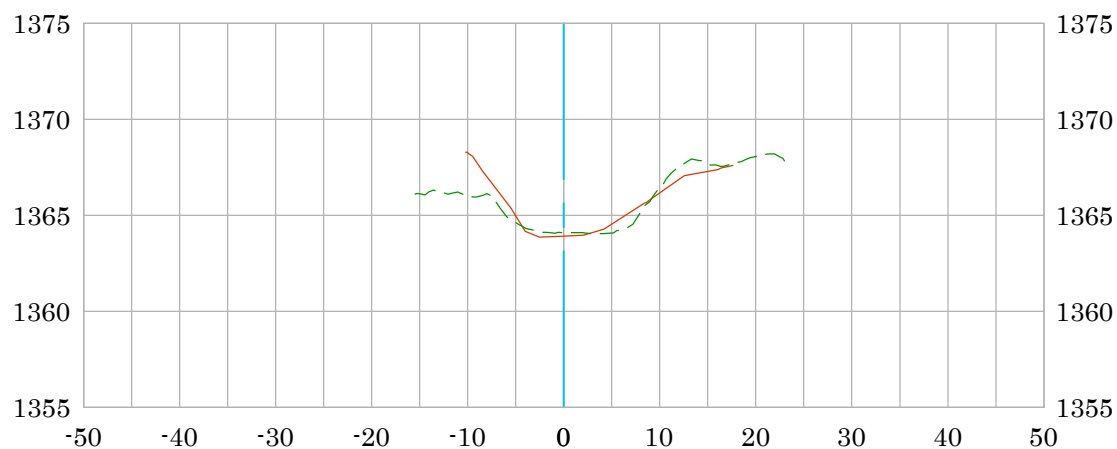

PRE-CONSTRUCTION SURFACE (03/22)

ASBUILT SURFACE POST CONSTRUCTION (11/22)

DATE PREPARED: 12/14/2022



Vert. Scale: 1"=10'


Hor. Scale: 1"=20'

U.S. *Survey*
Foot

OC Public Works
OC Survey/Field Services
Boundary Analysis & Mapping



Wildcat Creek 61+43 CL

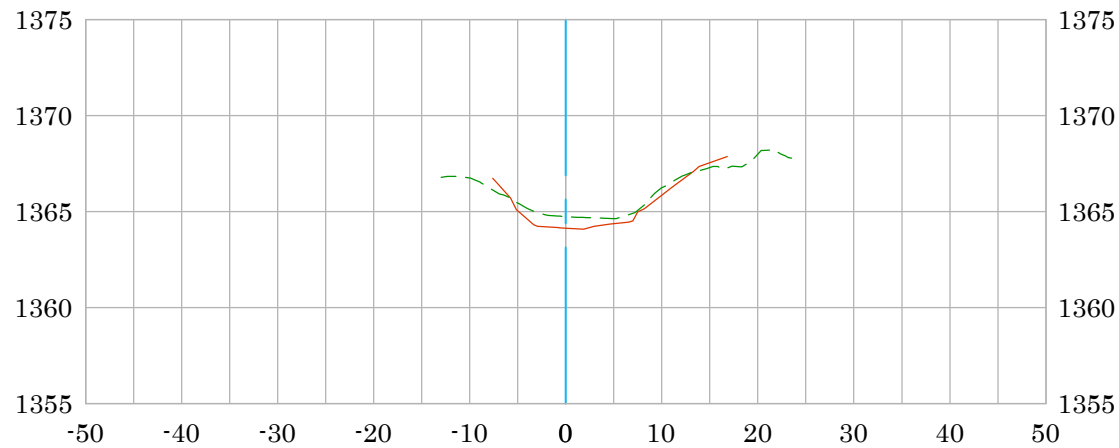


PRE-CONSTRUCTION SURFACE (03/22)

ASBUILT SURFACE POST CONSTRUCTION (11/22)


DATE PREPARED: 12/14/2022

Vert. Scale: 1"=10'

Hor. Scale: 1"=20'

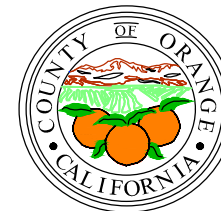

Wildcat Creek Bridge Crossing 61+50 CL

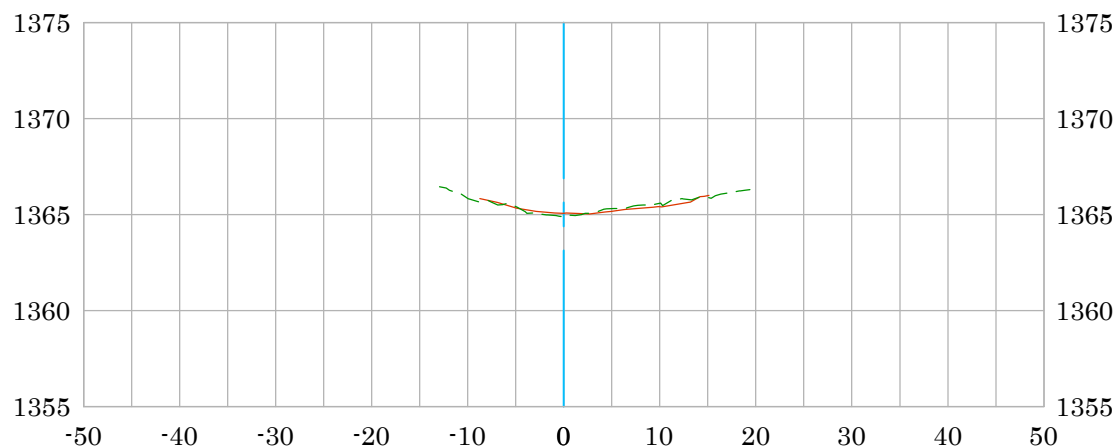

PRE-CONSTRUCTION SURFACE (03/22)

ASBUILT SURFACE POST CONSTRUCTION (11/22)


DATE PREPARED: 12/14/2022

—————


- - - - -

Vert. Scale: 1"=10'

Hor. Scale: 1"=20'

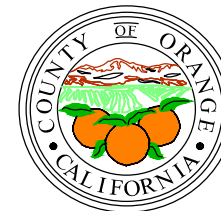

Wildcat Creek 61+57 CL

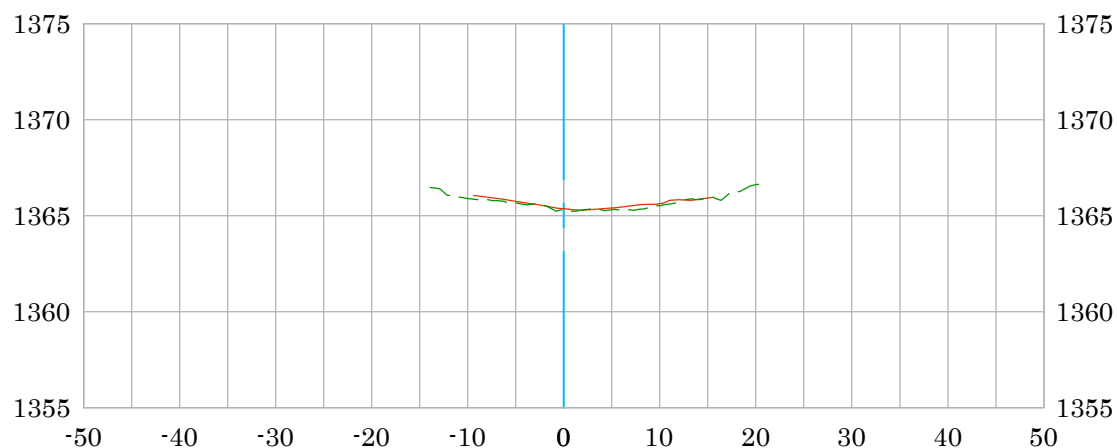

PRE-CONSTRUCTION SURFACE (03/22)

ASBUILT SURFACE POST CONSTRUCTION (11/22)

DATE PREPARED: 12/14/2022



Vert. Scale: 1"=10'


Hor. Scale: 1"=20'

U.S. *Survey
Foot*

OC Public Works
OC Survey/Field Services
Boundary Analysis & Mapping



Wildcat Creek 61+65 CL

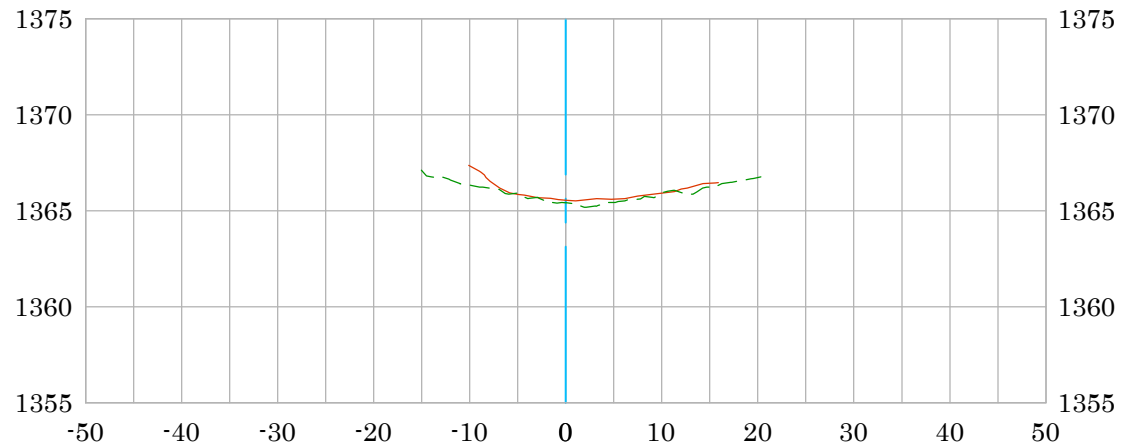

PRE-CONSTRUCTION SURFACE (03/22)

ASBUILT SURFACE POST CONSTRUCTION (11/22)

DATE PREPARED: 12/14/2022

—————

- - - - -

Vert. Scale: 1"=10'


Hor. Scale: 1"=20'

U.S. *Survey*
Foot

OC Public Works
OC Survey/Field Services
Boundary Analysis & Mapping



Wildcat Creek 62+00 CL

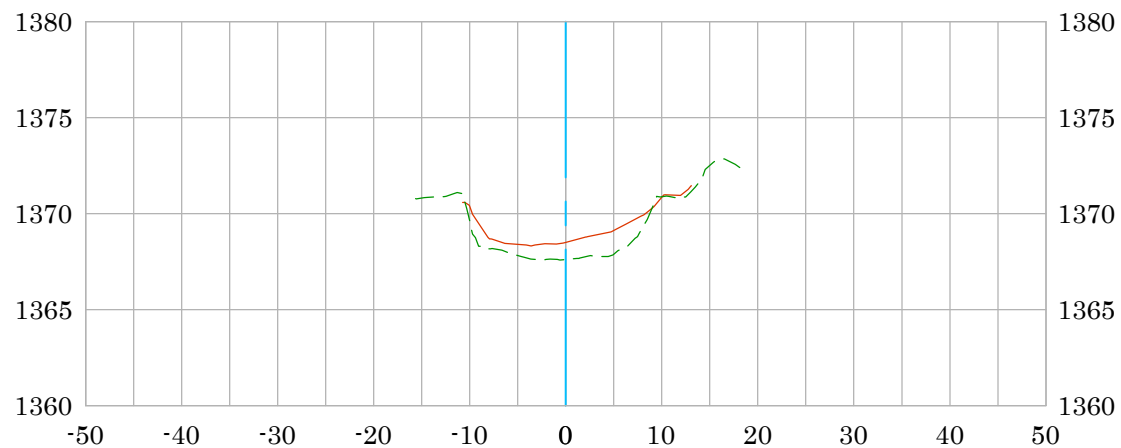


PRE-CONSTRUCTION SURFACE (03/22)

ASBUILT SURFACE POST CONSTRUCTION (11/22)


DATE PREPARED: 12/14/2022

Vert. Scale: 1"=10'

Hor. Scale: 1"=20'

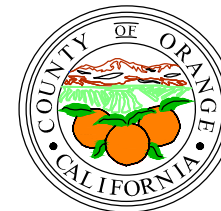

Wildcat Creek 62+50 CL

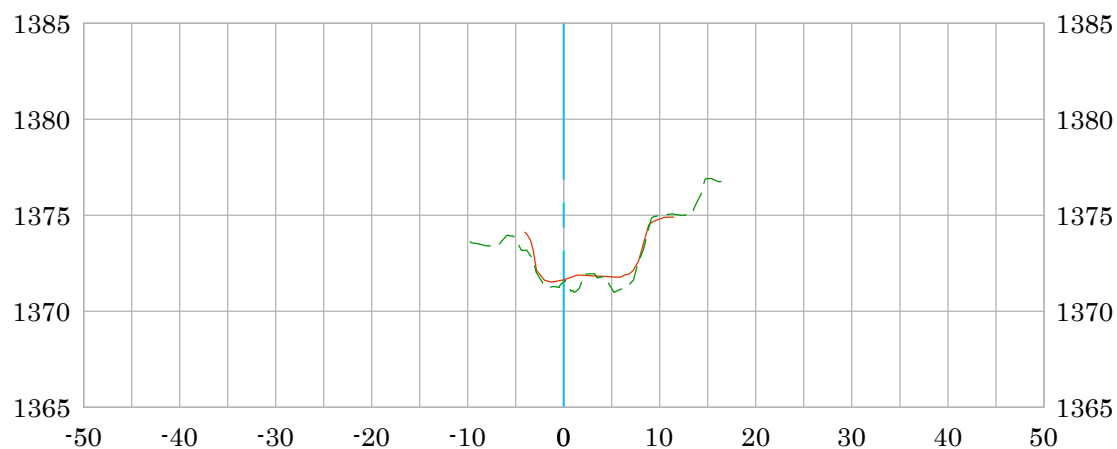

PRE-CONSTRUCTION SURFACE (03/22)

ASBUILT SURFACE POST CONSTRUCTION (11/22)


DATE PREPARED: 12/14/2022

—————


- - - - -

Vert. Scale: 1"=10'

Hor. Scale: 1"=20'

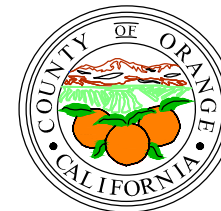

Wildcat Creek 63+00 CL

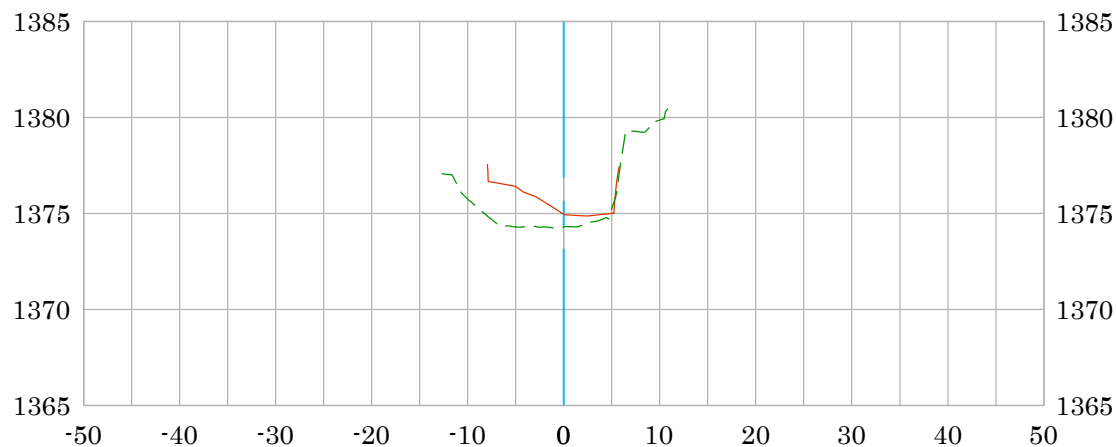

PRE-CONSTRUCTION SURFACE (03/22)

ASBUILT SURFACE POST CONSTRUCTION (11/22)


DATE PREPARED: 12/14/2022

—————


- - - - -

Vert. Scale: 1"=10'

Hor. Scale: 1"=20'

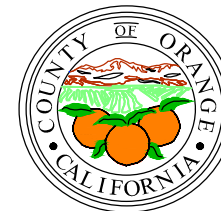

Wildcat Creek 63+50 CL

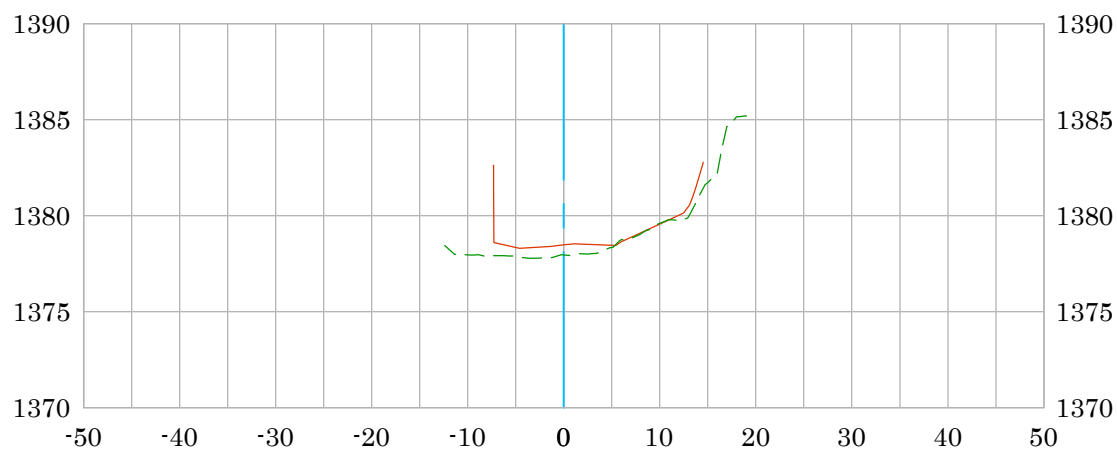

PRE-CONSTRUCTION SURFACE (03/22)

ASBUILT SURFACE POST CONSTRUCTION (11/22)

DATE PREPARED: 12/14/2022

—————

- - - - -

Vert. Scale: 1"=10'


Hor. Scale: 1"=20'

U.S. *Survey*
Foot

OC Public Works
OC Survey/Field Services
Boundary Analysis & Mapping



Wildcat Creek 64+00 CL

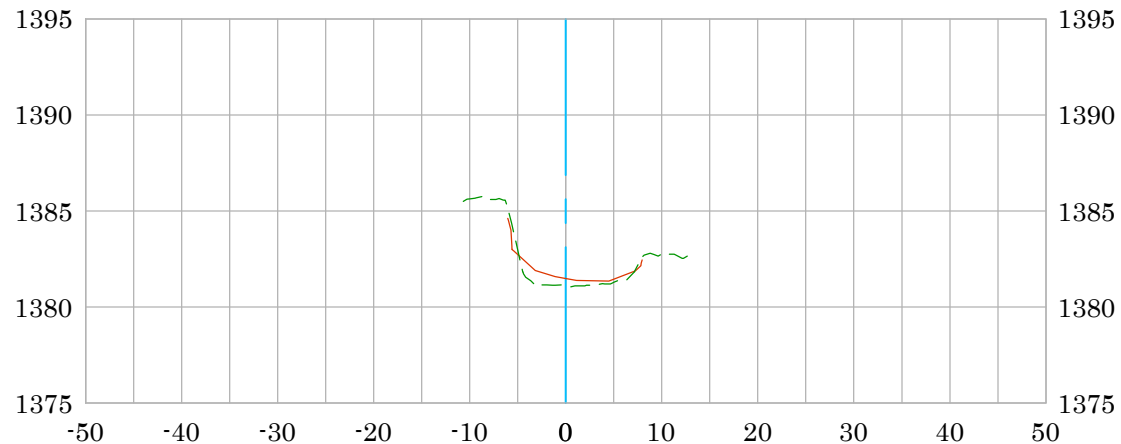

PRE-CONSTRUCTION SURFACE (03/22)

ASBUILT SURFACE POST CONSTRUCTION (11/22)

DATE PREPARED: 12/14/2022

Vert. Scale: 1"=10'


Hor. Scale: 1"=20'

U.S. *Survey*
Foot

OC Public Works
OC Survey/Field Services
Boundary Analysis & Mapping



Wildcat Creek 64+50 CL

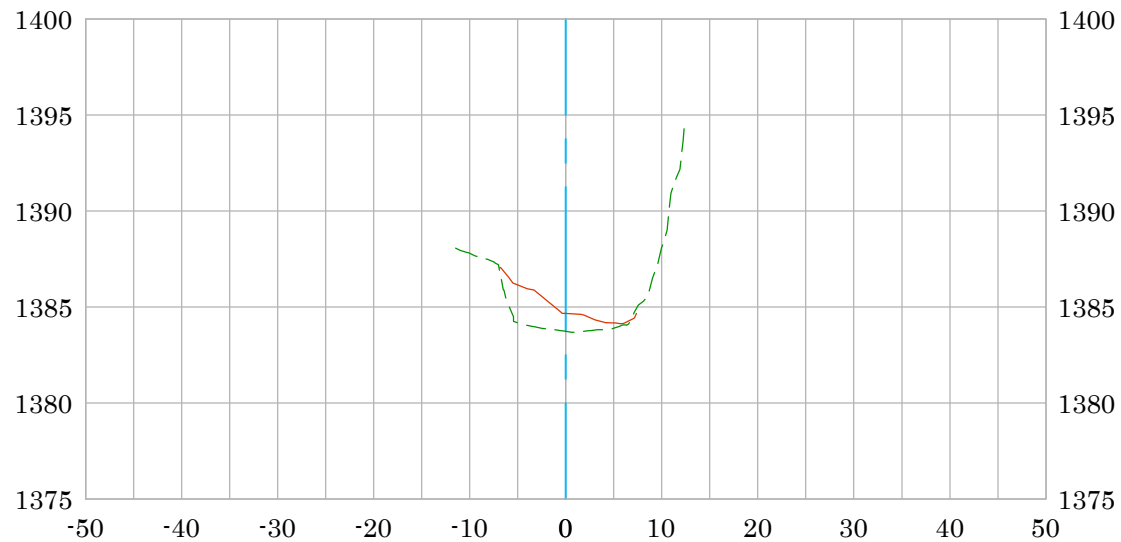

PRE-CONSTRUCTION SURFACE (03/22)

ASBUILT SURFACE POST CONSTRUCTION (11/22)


DATE PREPARED: 12/14/2022

—————


- - - - -

Vert. Scale: 1"=10'

Hor. Scale: 1"=20'

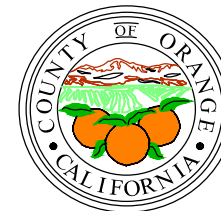

Wildcat Creek 65+00 CL

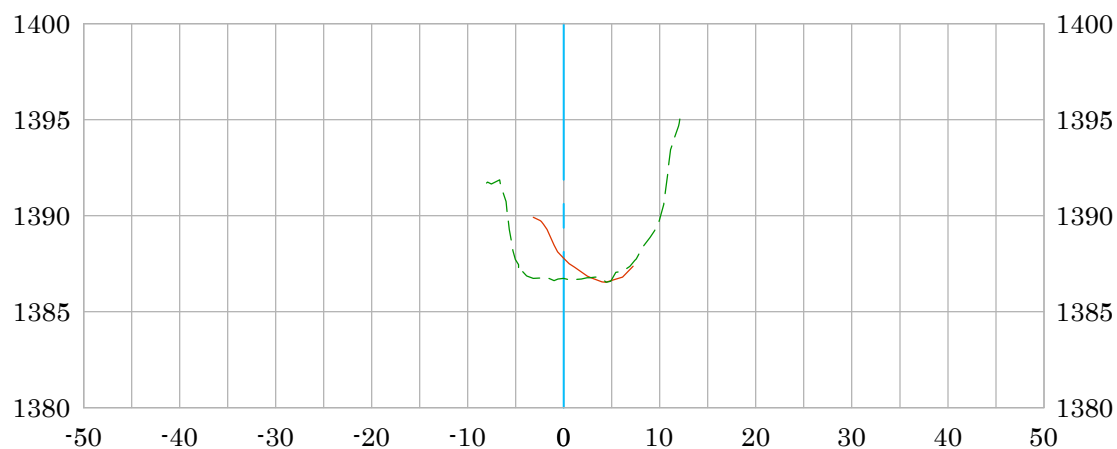

PRE-CONSTRUCTION SURFACE (03/22)


ASBUILT SURFACE POST CONSTRUCTION (11/22)

DATE PREPARED: 12/14/2022




Vert. Scale: 1"=10'

Hor. Scale: 1"=20'

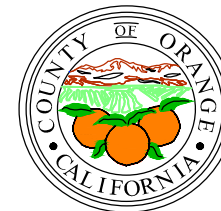

Wildcat Creek 65+50 CL

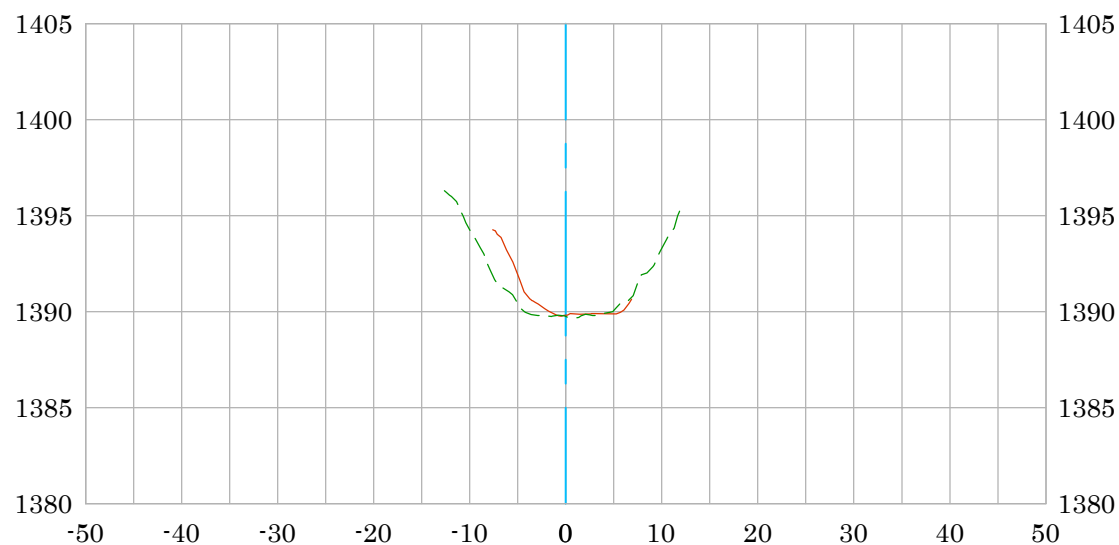

PRE-CONSTRUCTION SURFACE (03/22)

ASBUILT SURFACE POST CONSTRUCTION (11/22)


DATE PREPARED: 12/14/2022

—————


- - - - -

Vert. Scale: 1"=10'

Hor. Scale: 1"=20'

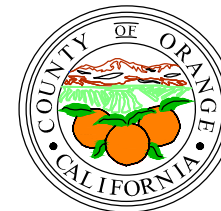

Wildcat Creek 66+00 CL

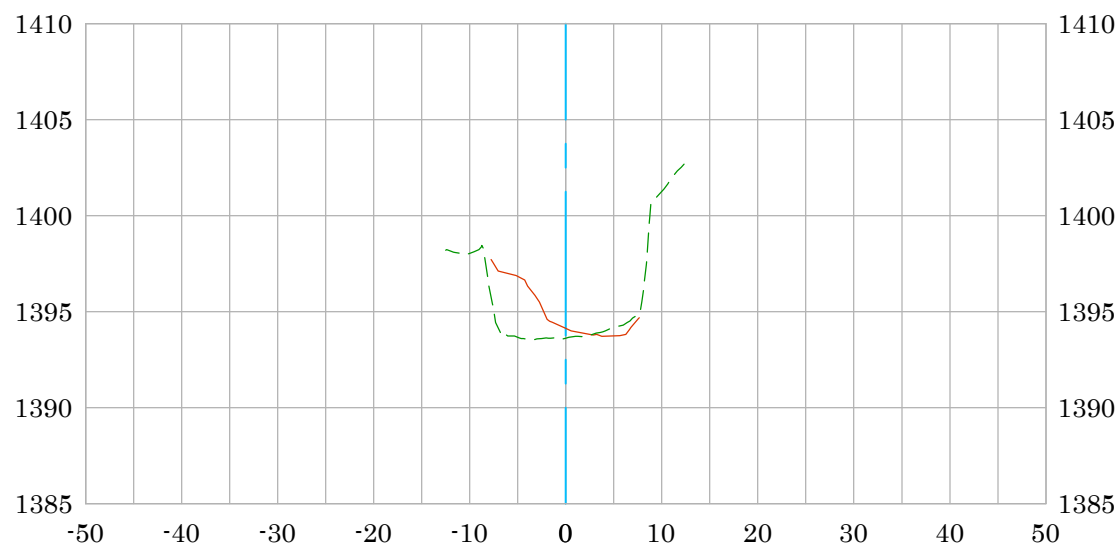

PRE-CONSTRUCTION SURFACE (03/22)

ASBUILT SURFACE POST CONSTRUCTION (11/22)


DATE PREPARED: 12/14/2022

—————


- - - - -

Vert. Scale: 1"=10'

Hor. Scale: 1"=20'

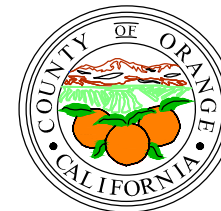

Wildcat Creek 66+50 CL

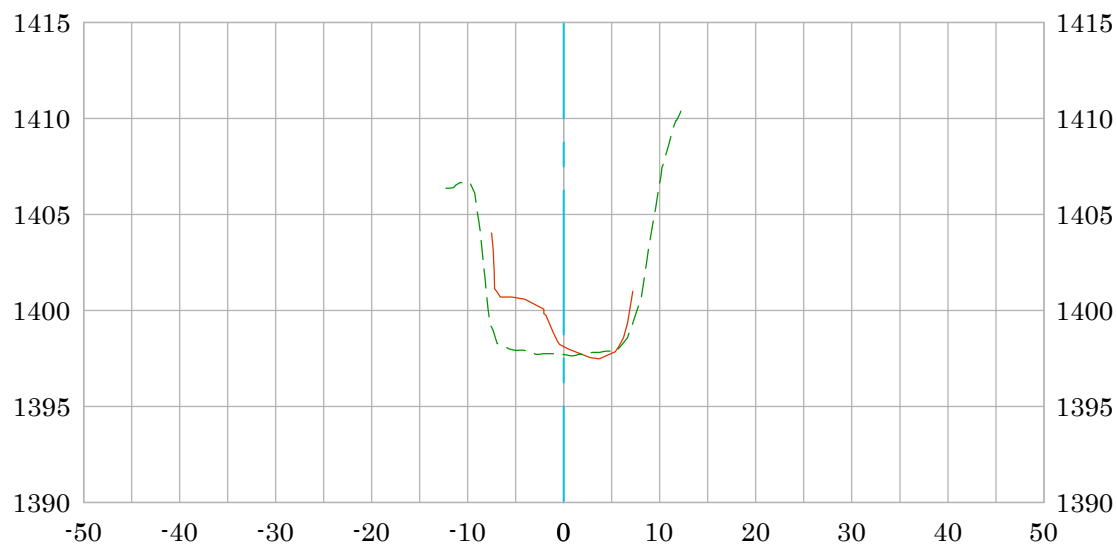

PRE-CONSTRUCTION SURFACE (03/22)


ASBUILT SURFACE POST CONSTRUCTION (11/22)

DATE PREPARED: 12/14/2022




Vert. Scale: 1"=10'

Hor. Scale: 1"=20'

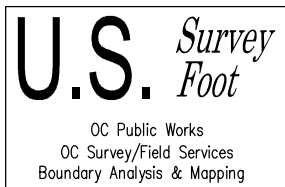

Wildcat Creek 67+00 CL

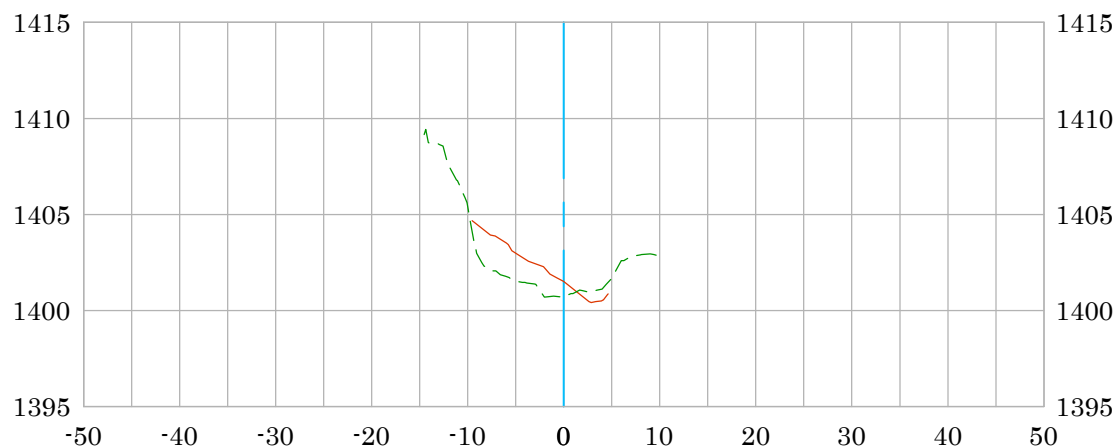

PRE-CONSTRUCTION SURFACE (03/22)

ASBUILT SURFACE POST CONSTRUCTION (11/22)


DATE PREPARED: 12/14/2022

—————


- - - - -

Vert. Scale: 1"=10'

Hor. Scale: 1"=20'

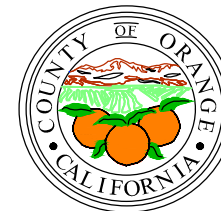

Wildcat Creek 67+50 CL

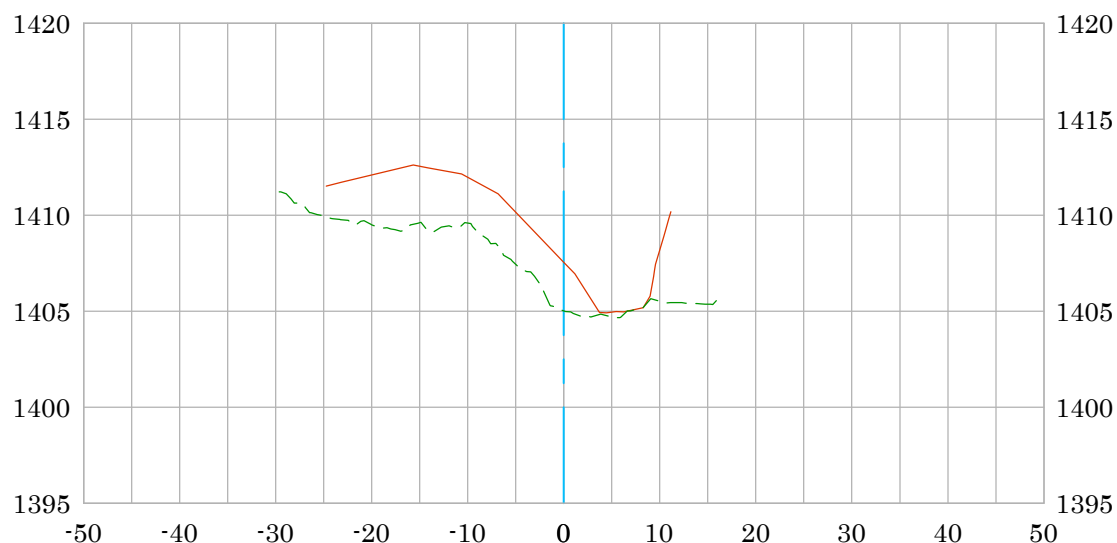

PRE-CONSTRUCTION SURFACE (03/22)

ASBUILT SURFACE POST CONSTRUCTION (11/22)

DATE PREPARED: 12/14/2022

—————

- - - - -

Vert. Scale: 1"=10'


Hor. Scale: 1"=20'

U.S. *Survey*
Foot

OC Public Works
OC Survey/Field Services
Boundary Analysis & Mapping



Wildcat Creek 68+00 CL

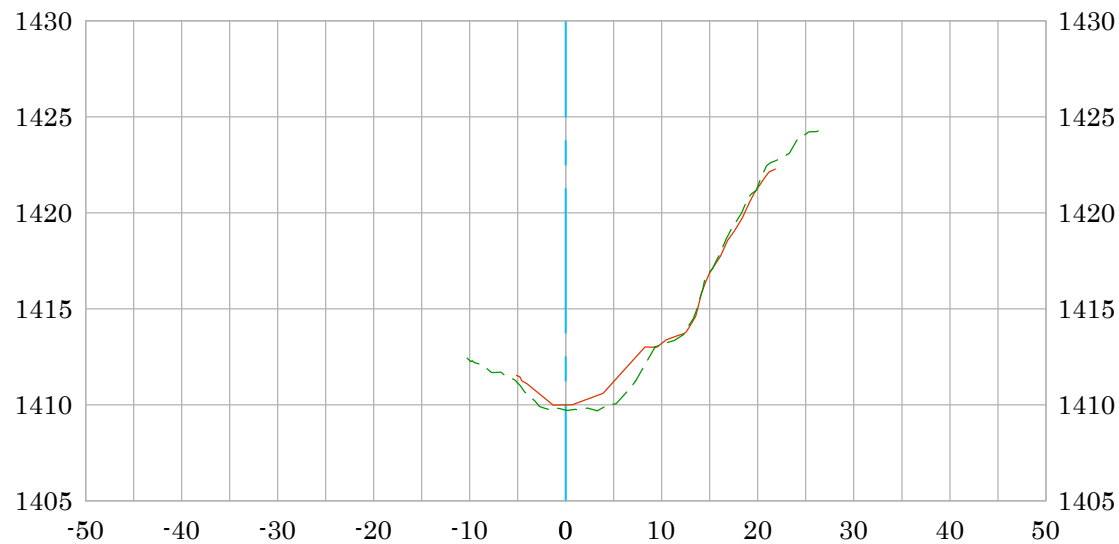

PRE-CONSTRUCTION SURFACE (03/22)


ASBUILT SURFACE POST CONSTRUCTION (11/22)

DATE PREPARED: 12/14/2022

Vert. Scale: 1"=10'

Hor. Scale: 1"=20'

Wildcat Creek 68+50 CL

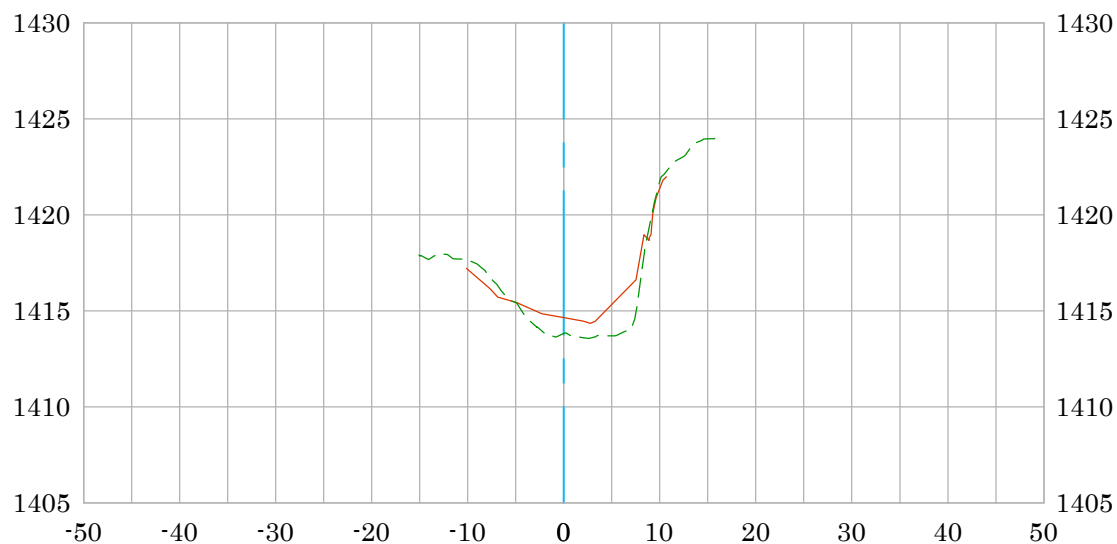

PRE-CONSTRUCTION SURFACE (03/22)

ASBUILT SURFACE POST CONSTRUCTION (11/22)

DATE PREPARED: 12/14/2022

Vert. Scale: 1"=10'


Hor. Scale: 1"=20'

U.S. *Survey*
Foot

OC Public Works
OC Survey/Field Services
Boundary Analysis & Mapping



Wildcat Creek 68+82 CL

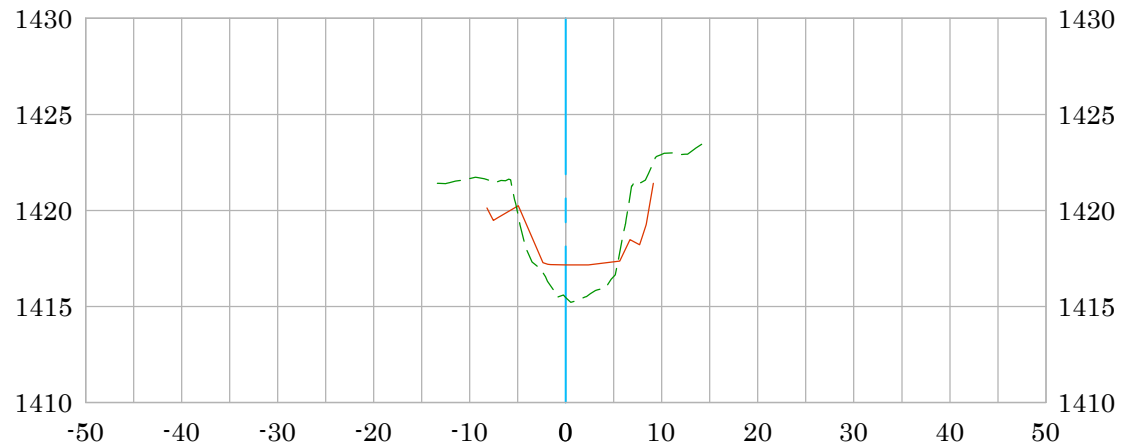

PRE-CONSTRUCTION SURFACE (03/22)


ASBUILT SURFACE POST CONSTRUCTION (11/22)

DATE PREPARED: 12/14/2022




Vert. Scale: 1"=10'

Hor. Scale: 1"=20'

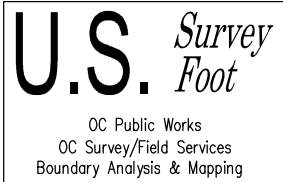

Wildcat Creek 68+90 CL

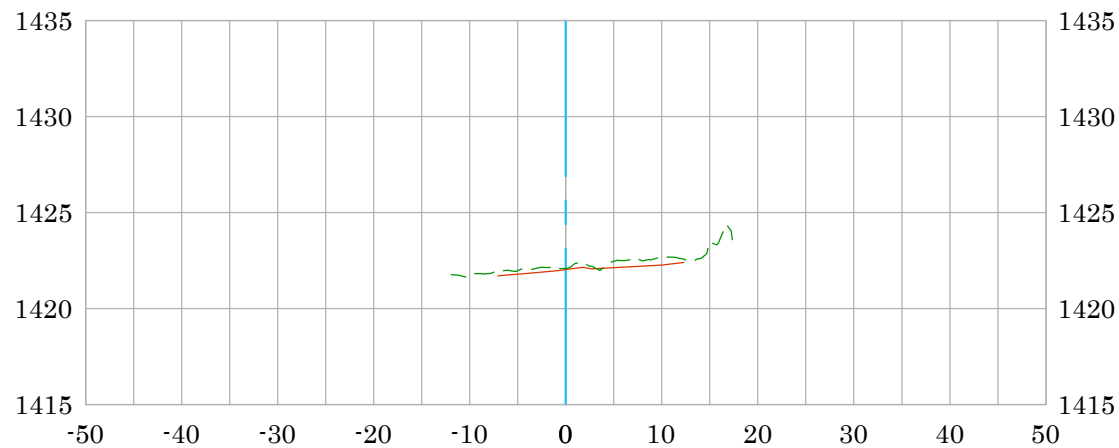

PRE-CONSTRUCTION SURFACE (03/22)

ASBUILT SURFACE POST CONSTRUCTION (11/22)


DATE PREPARED: 12/14/2022

—————


- - - - -

Vert. Scale: 1"=10'

Hor. Scale: 1"=20'

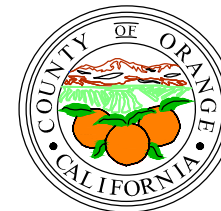

Wildcat Creek Bridge Crossing 68+97 CL

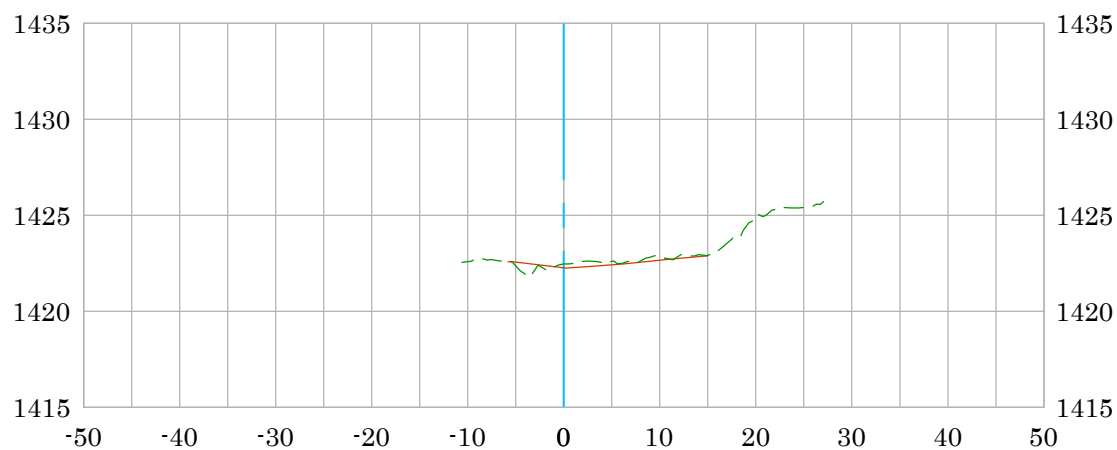

PRE-CONSTRUCTION SURFACE (03/22)

ASBUILT SURFACE POST CONSTRUCTION (11/22)


DATE PREPARED: 12/14/2022

—————


- - - - -

Vert. Scale: 1"=10'

Hor. Scale: 1"=20'

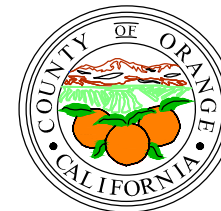

Wildcat Creek 69+04 CL

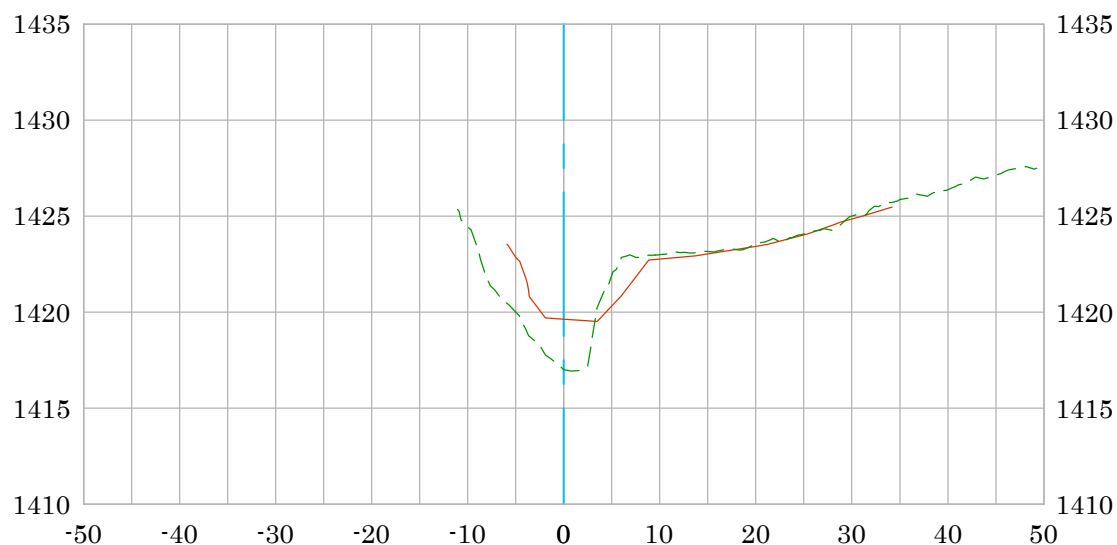

PRE-CONSTRUCTION SURFACE (03/22)

ASBUILT SURFACE POST CONSTRUCTION (11/22)

DATE PREPARED: 12/14/2022

—————

- - - - -

Vert. Scale: 1"=10'


Hor. Scale: 1"=20'

U.S. *Survey*
Foot

OC Public Works
OC Survey/Field Services
Boundary Analysis & Mapping



Wildcat Creek 69+12 CL

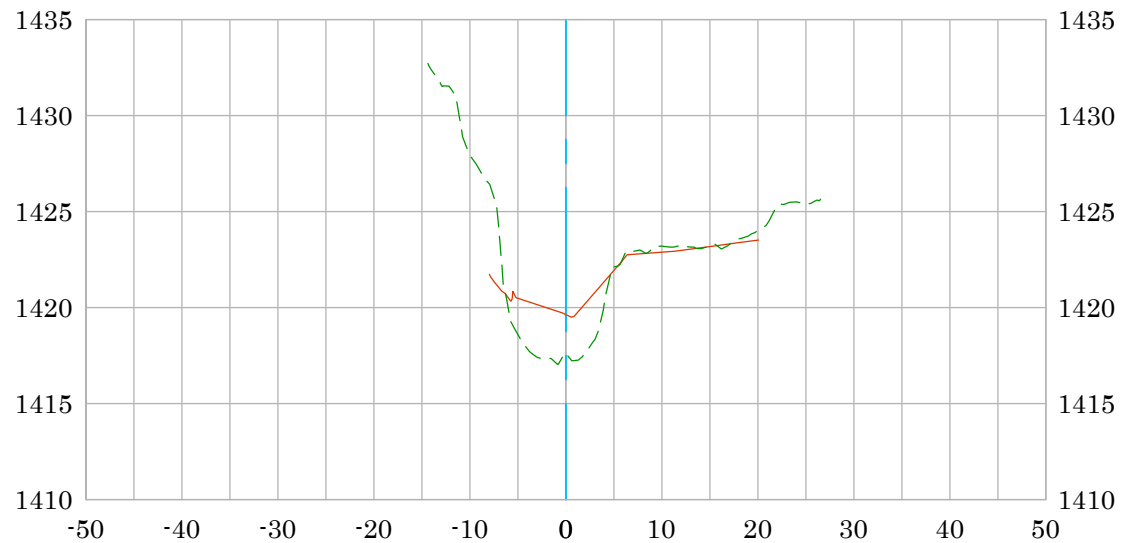


PRE-CONSTRUCTION SURFACE (03/22)

ASBUILT SURFACE POST CONSTRUCTION (11/22)


DATE PREPARED: 12/14/2022

Vert. Scale: 1"=10'

Hor. Scale: 1"=20'

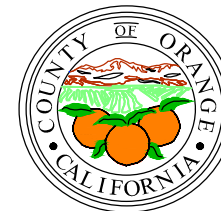

Wildcat Creek 69+00 CL

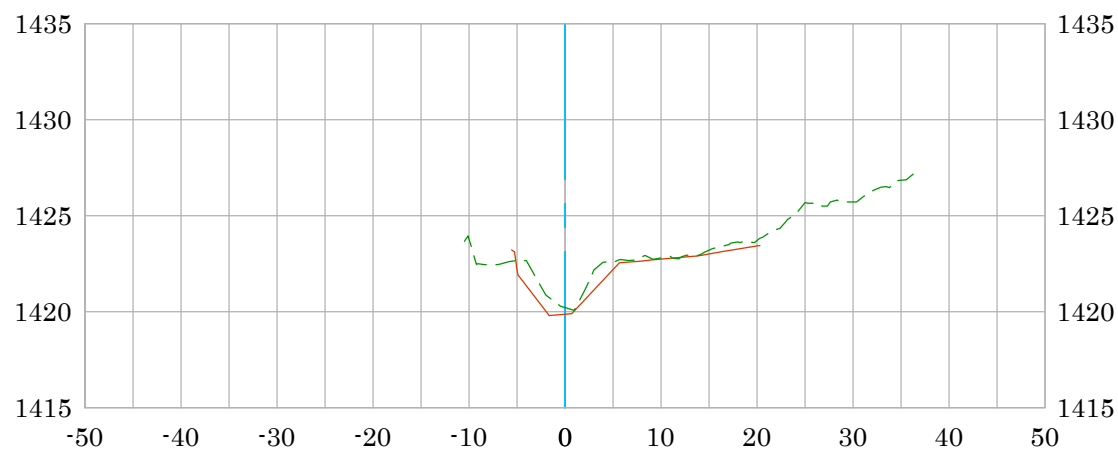

PRE-CONSTRUCTION SURFACE (03/22)

ASBUILT SURFACE POST CONSTRUCTION (11/22)

DATE PREPARED: 12/14/2022

—————

- - - - -

Vert. Scale: 1"=10'


Hor. Scale: 1"=20'

U.S. *Survey*
Foot

OC Public Works
OC Survey/Field Services
Boundary Analysis & Mapping



Wildcat Creek 69+50 CL

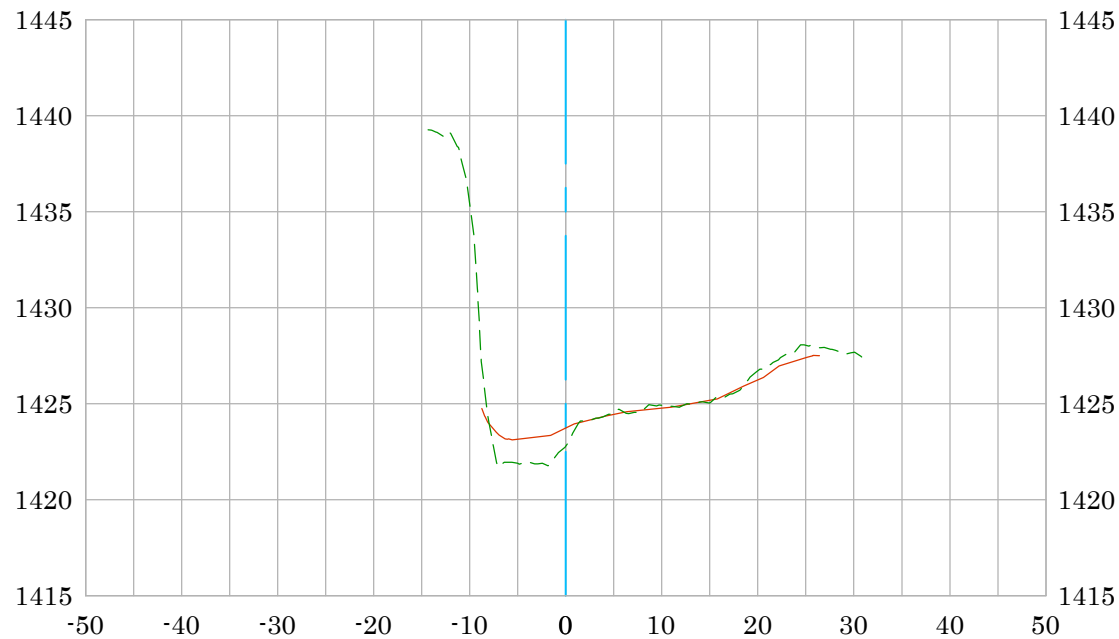

PRE-CONSTRUCTION SURFACE (03/22)

ASBUILT SURFACE POST CONSTRUCTION (11/22)

DATE PREPARED: 12/14/2022

Vert. Scale: 1"=10'


Hor. Scale: 1"=20'

U.S. *Survey*
Foot

OC Public Works
OC Survey/Field Services
Boundary Analysis & Mapping



Wildcat Creek 70+00 CL

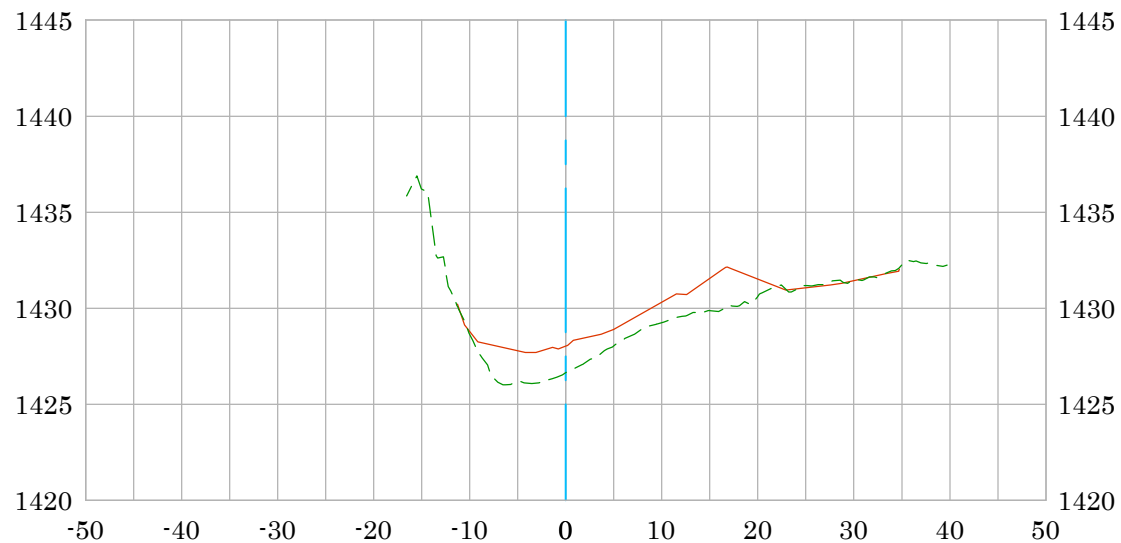


PRE-CONSTRUCTION SURFACE (03/22)

ASBUILT SURFACE POST CONSTRUCTION (11/22)


DATE PREPARED: 12/14/2022

Vert. Scale: 1"=10'

Hor. Scale: 1"=20'

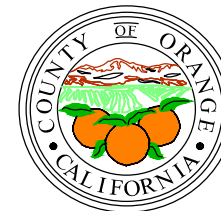

Wildcat Creek 70+51 CL

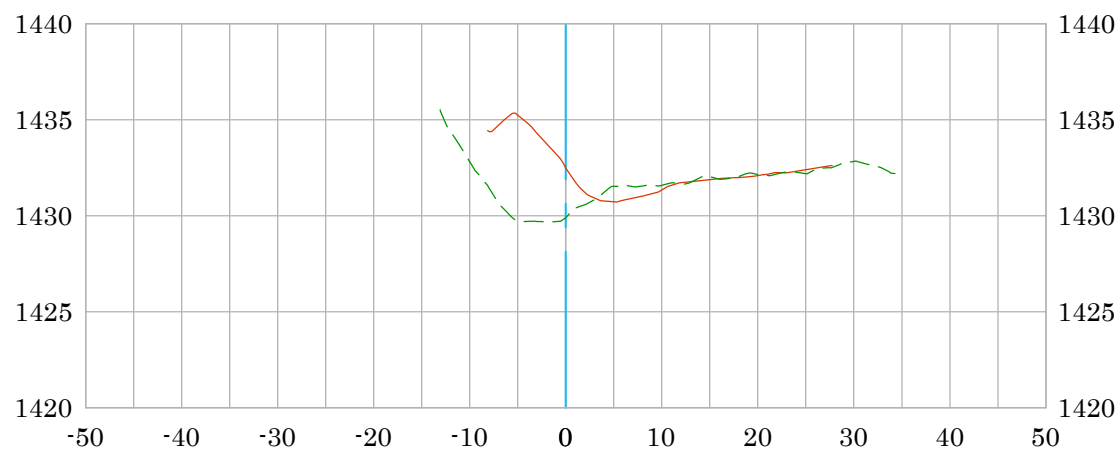

PRE-CONSTRUCTION SURFACE (03/22)

ASBUILT SURFACE POST CONSTRUCTION (11/22)

DATE PREPARED: 12/14/2022

—————

- - - - -

Vert. Scale: 1"=10'


Hor. Scale: 1"=20'

U.S. *Survey*
Foot

OC Public Works
OC Survey/Field Services
Boundary Analysis & Mapping



Wildcat Creek 70+59 CL

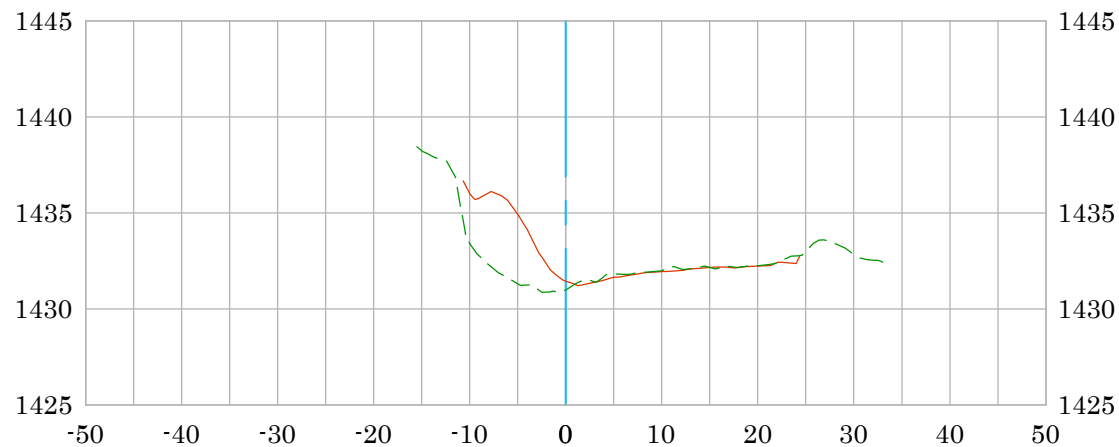

PRE-CONSTRUCTION SURFACE (03/22)

ASBUILT SURFACE POST CONSTRUCTION (11/22)


DATE PREPARED: 12/14/2022

—————


- - - - -

Vert. Scale: 1"=10'

Hor. Scale: 1"=20'

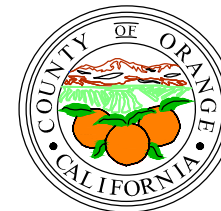

Wildcat Creek Bridge Crossing 70+66 CL

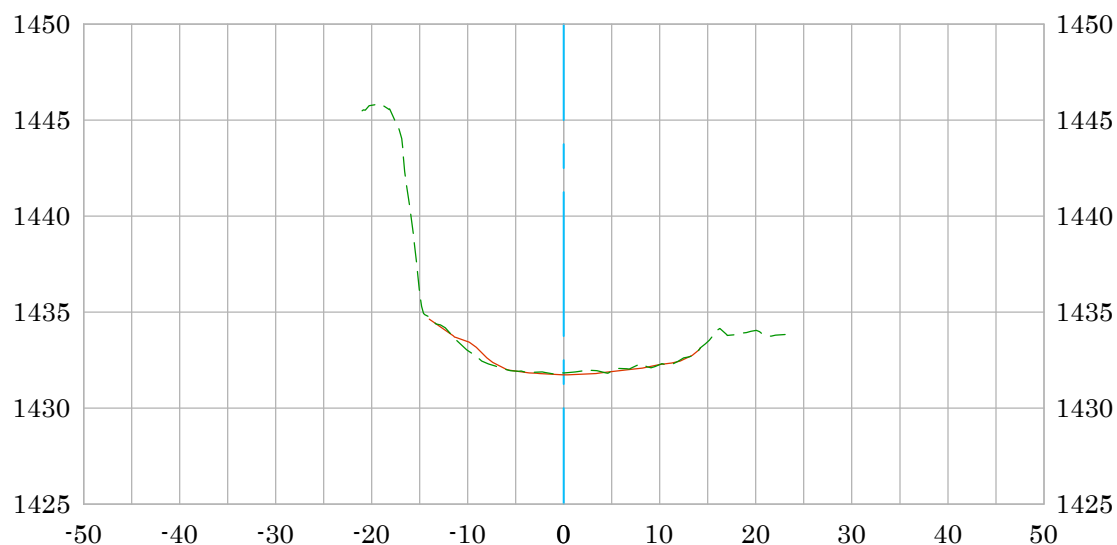

PRE-CONSTRUCTION SURFACE (03/22)

ASBUILT SURFACE POST CONSTRUCTION (11/22)

DATE PREPARED: 12/14/2022

Vert. Scale: 1"=10'


Hor. Scale: 1"=20'

U.S. *Survey*
Foot

OC Public Works
OC Survey/Field Services
Boundary Analysis & Mapping



Wildcat Creek 70+73 CL

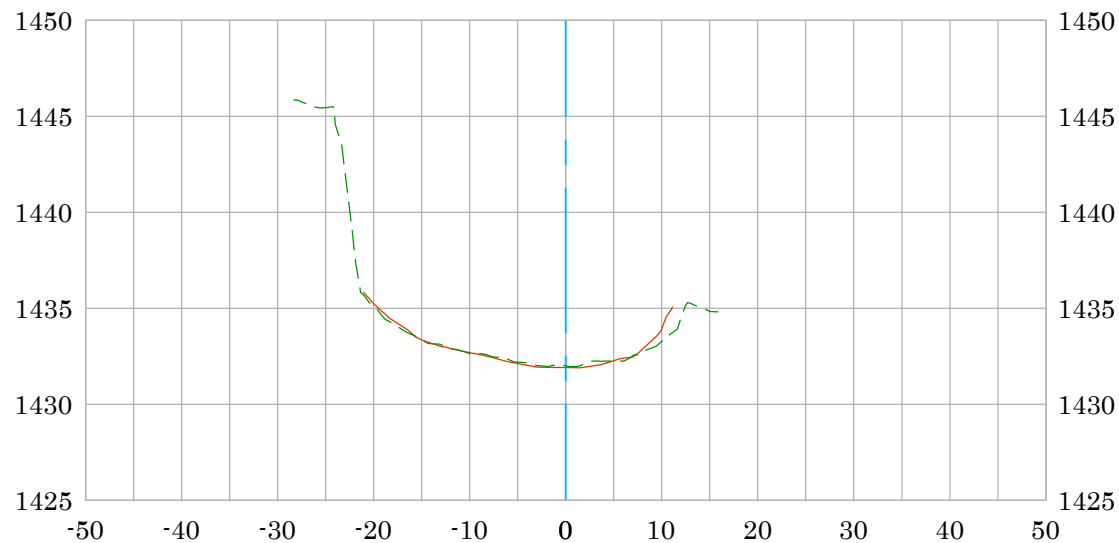

PRE-CONSTRUCTION SURFACE (03/22)

ASBUILT SURFACE POST CONSTRUCTION (11/22)

DATE PREPARED: 12/14/2022

Vert. Scale: 1"=10'


Hor. Scale: 1"=20'

U.S. *Survey*
Foot

OC Public Works
OC Survey/Field Services
Boundary Analysis & Mapping



Wildcat Creek 70+81 CL

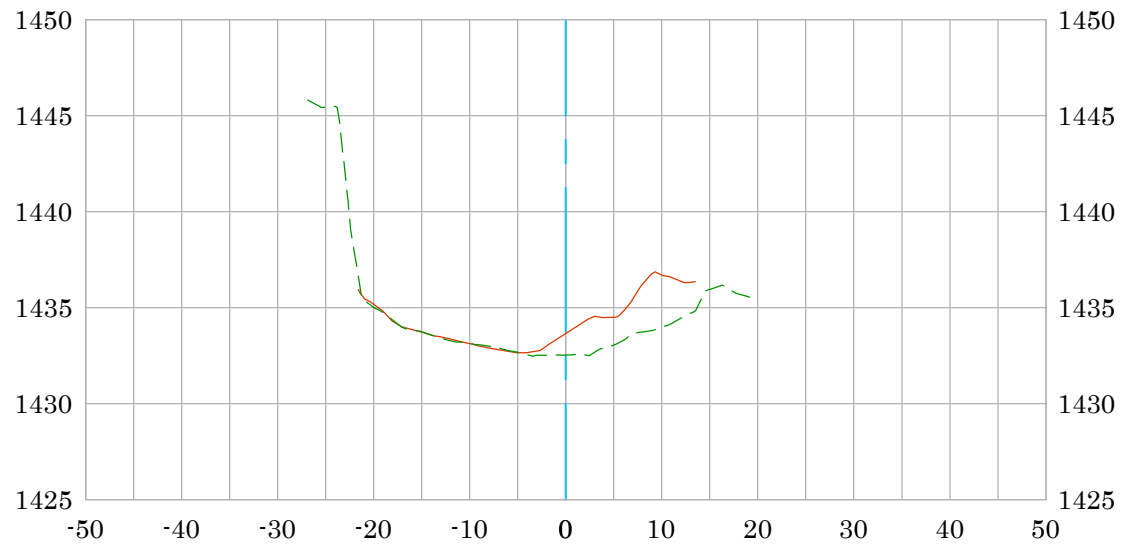

PRE-CONSTRUCTION SURFACE (03/22)

ASBUILT SURFACE POST CONSTRUCTION (11/22)

DATE PREPARED: 12/14/2022

Vert. Scale: 1"=10'


Hor. Scale: 1"=20'

U.S. *Survey*
Foot

OC Public Works
OC Survey/Field Services
Boundary Analysis & Mapping



Wildcat Creek 71+00 CL

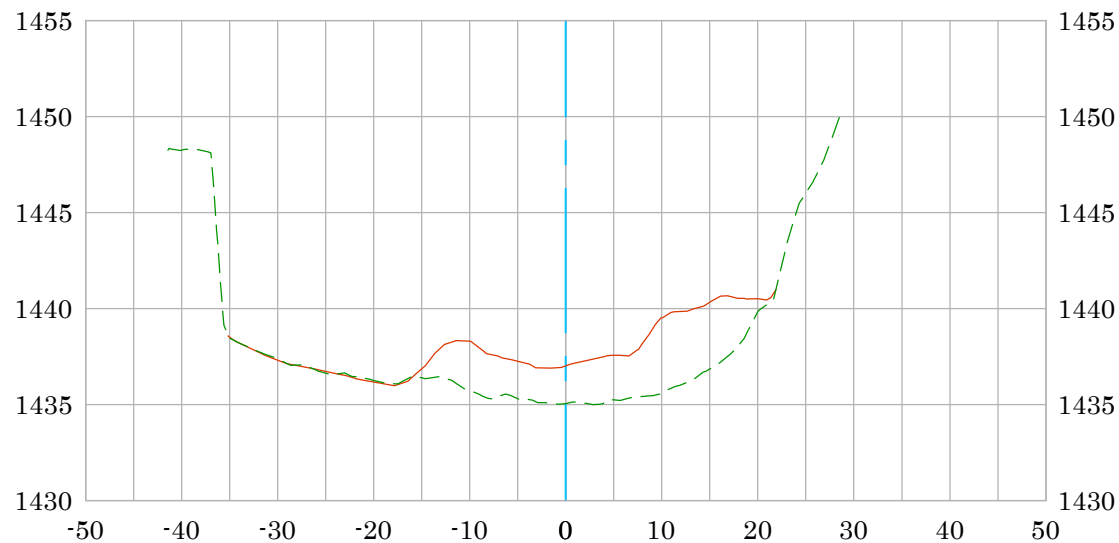


PRE-CONSTRUCTION SURFACE (03/22)

ASBUILT SURFACE POST CONSTRUCTION (11/22)


DATE PREPARED: 12/14/2022

Vert. Scale: 1"=10'

Hor. Scale: 1"=20'

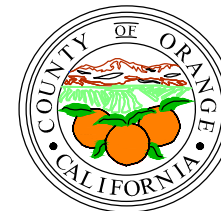

Wildcat Creek 71+50 CL

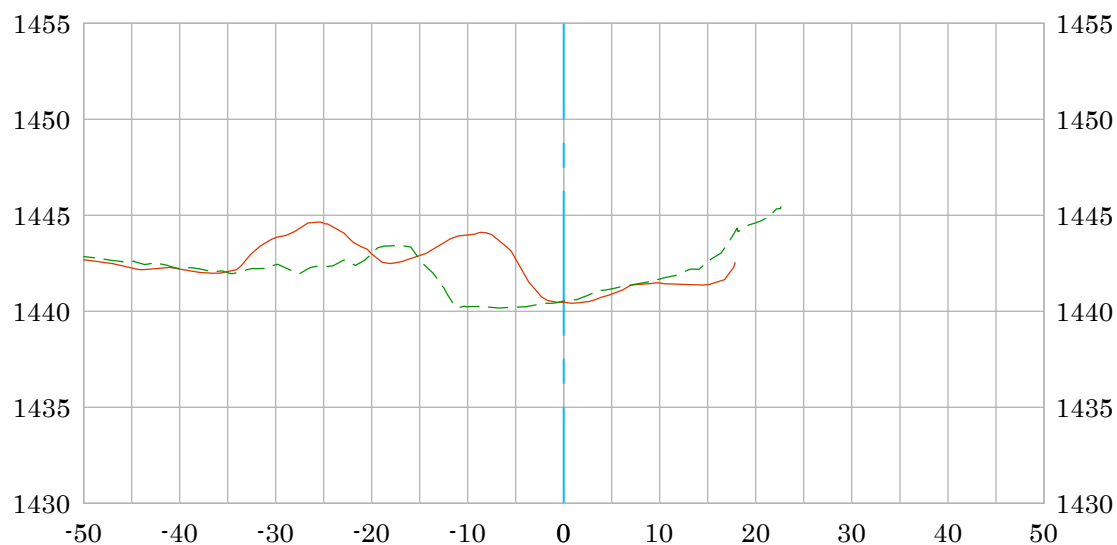

PRE-CONSTRUCTION SURFACE (03/22)

ASBUILT SURFACE POST CONSTRUCTION (11/22)


DATE PREPARED: 12/14/2022

—————

- - - - -

Vert. Scale: 1"=10'


Hor. Scale: 1"=20'

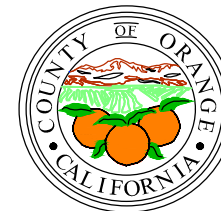

Silverado Creek Area 2

80+00

CL

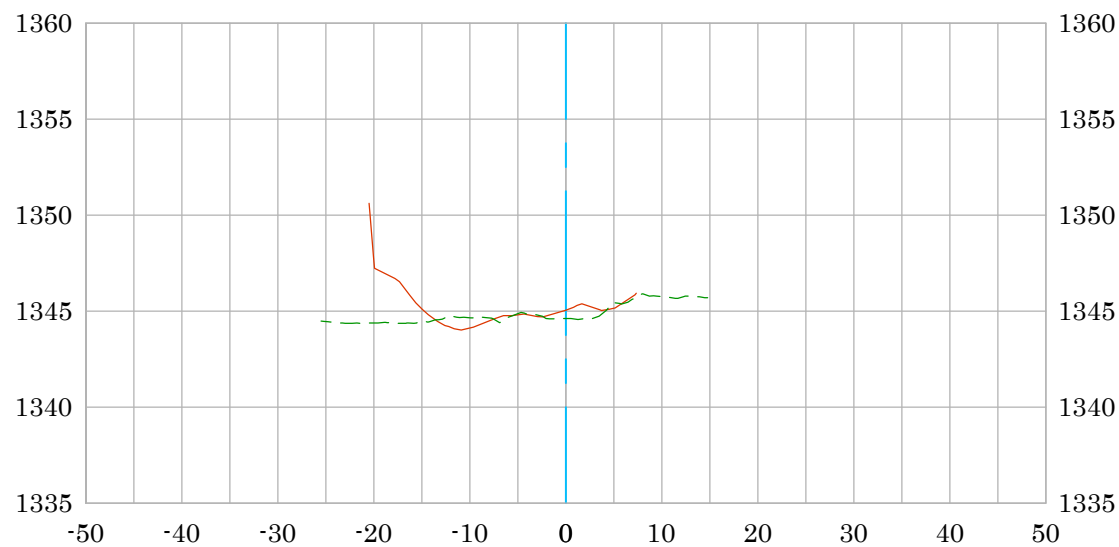

PRE-CONSTRUCTION SURFACE (03/22)

ASBUILT SURFACE POST CONSTRUCTION (11/22)

DATE PREPARED: 12/14/2022

Vert. Scale: 1"=10'


Hor. Scale: 1"=20'



Silverado Creek Area 2

80+50

CL

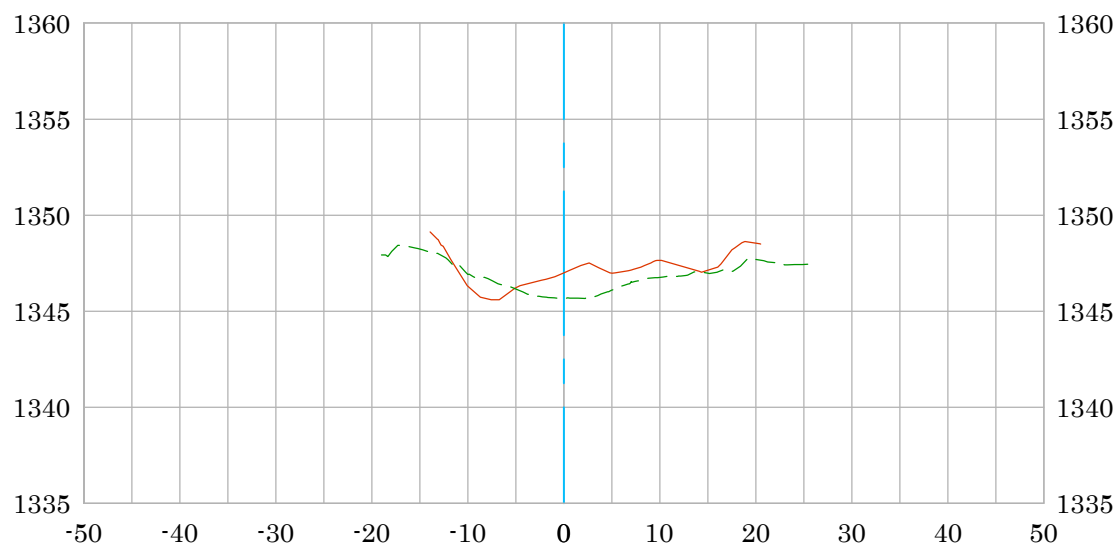


PRE-CONSTRUCTION SURFACE (03/22)

ASBUILT SURFACE POST CONSTRUCTION (11/22)

DATE PREPARED: 12/14/2022

Vert. Scale: 1"=10'


Hor. Scale: 1"=20'

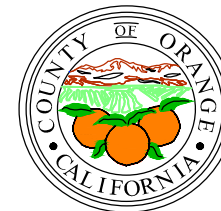

Silverado Creek Area 2

81+00

CL

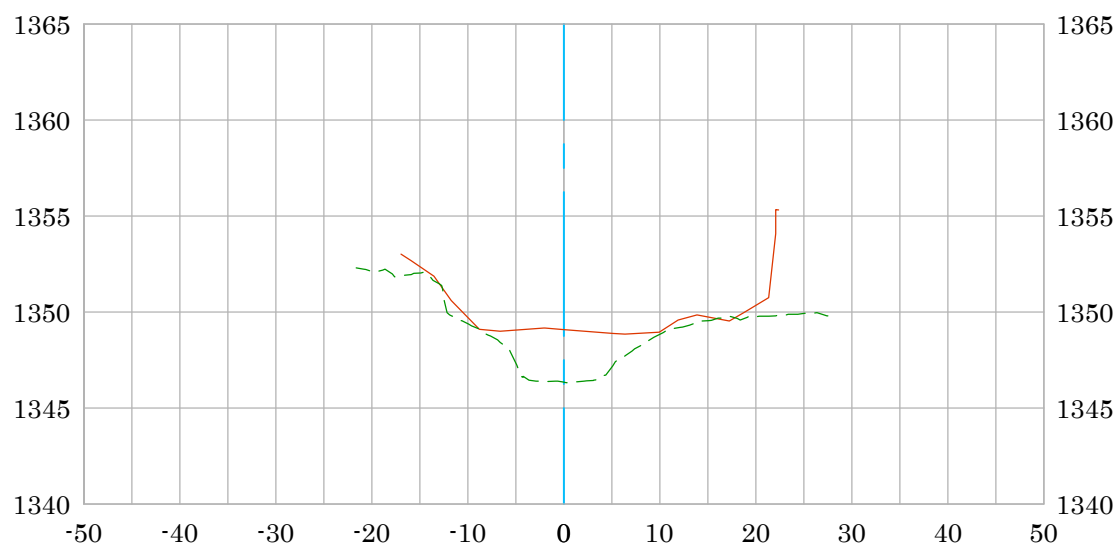


PRE-CONSTRUCTION SURFACE (03/22)

ASBUILT SURFACE POST CONSTRUCTION (11/22)

DATE PREPARED: 12/14/2022

Vert. Scale: 1"=10'


Hor. Scale: 1"=20'

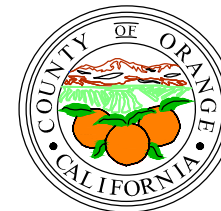

Silverado Creek Area 2

81+50

CL

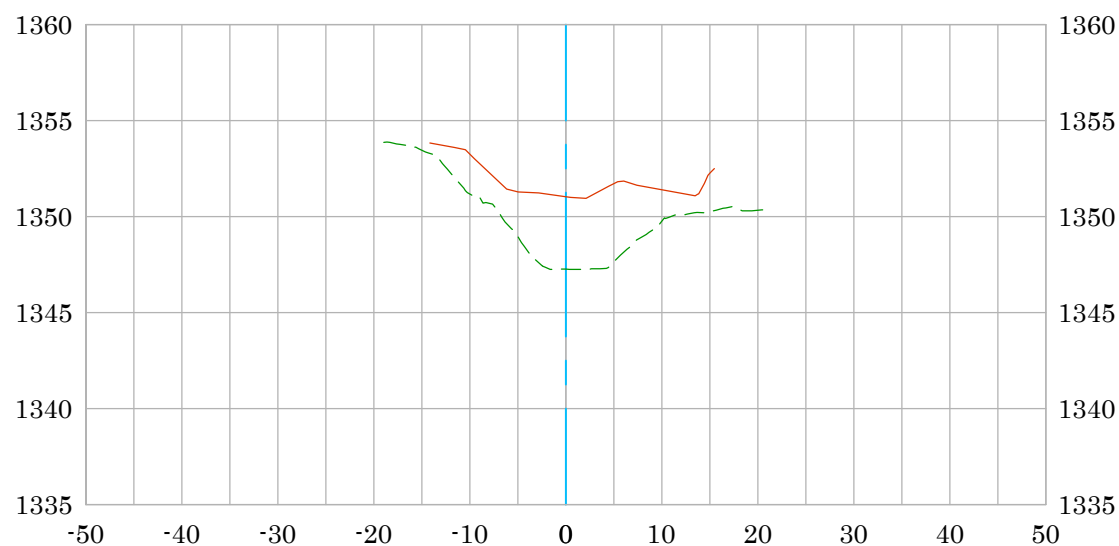

PRE-CONSTRUCTION SURFACE (03/22)

ASBUILT SURFACE POST CONSTRUCTION (11/22)

DATE PREPARED: 12/14/2022



Vert. Scale: 1"=10'


Hor. Scale: 1"=20'

U.S. *Survey
Foot*

OC Public Works
OC Survey/Field Services
Boundary Analysis & Mapping



Silverado Creek Area 2 82+00 CL

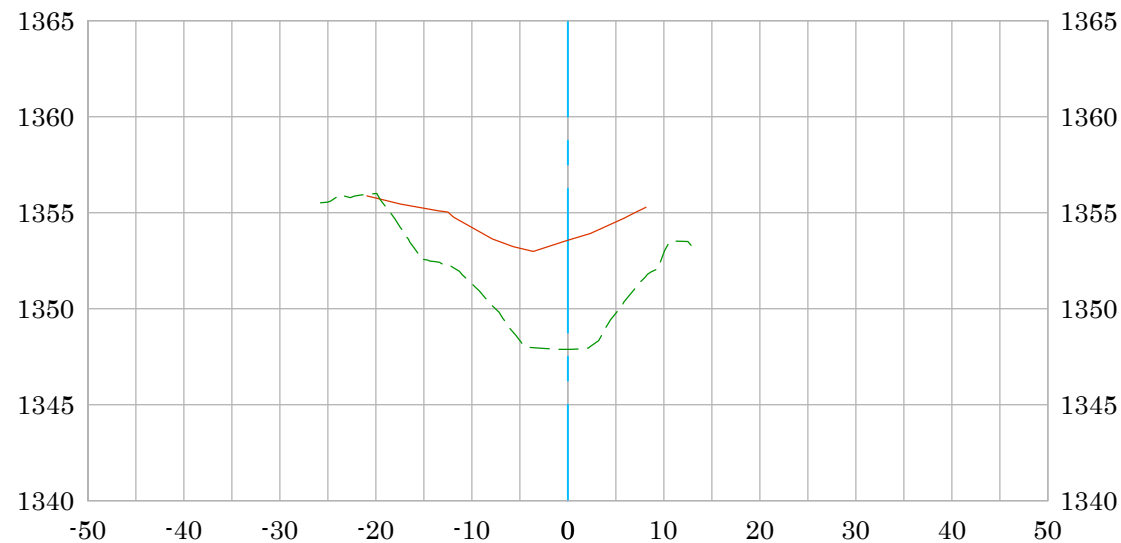

PRE-CONSTRUCTION SURFACE (03/22)

ASBUILT SURFACE POST CONSTRUCTION (11/22)

DATE PREPARED: 12/14/2022

Vert. Scale: 1"=10'


Hor. Scale: 1"=20'

U.S. *Survey*
Foot

OC Public Works
OC Survey/Field Services
Boundary Analysis & Mapping



Silverado Creek Area 2 82+50 CL

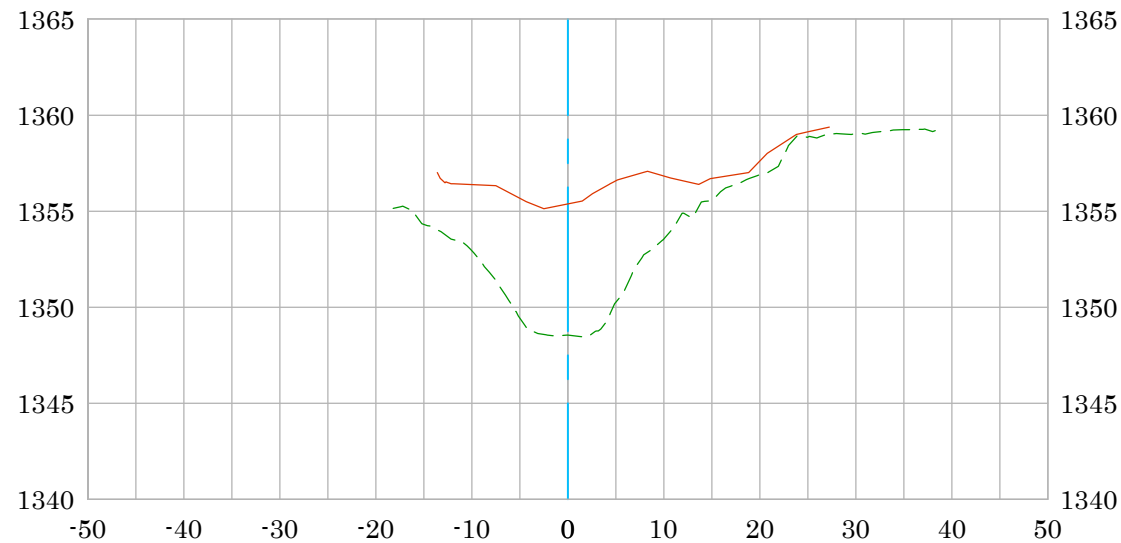

PRE-CONSTRUCTION SURFACE (03/22)

ASBUILT SURFACE POST CONSTRUCTION (11/22)

DATE PREPARED: 12/14/2022

Vert. Scale: 1"=10'

Hor. Scale: 1"=20'

U.S. *Survey
Foot*


OC Public Works
OC Survey/Field Services
Boundary Analysis & Mapping



Silverado Creek Area 2

83+00

CL

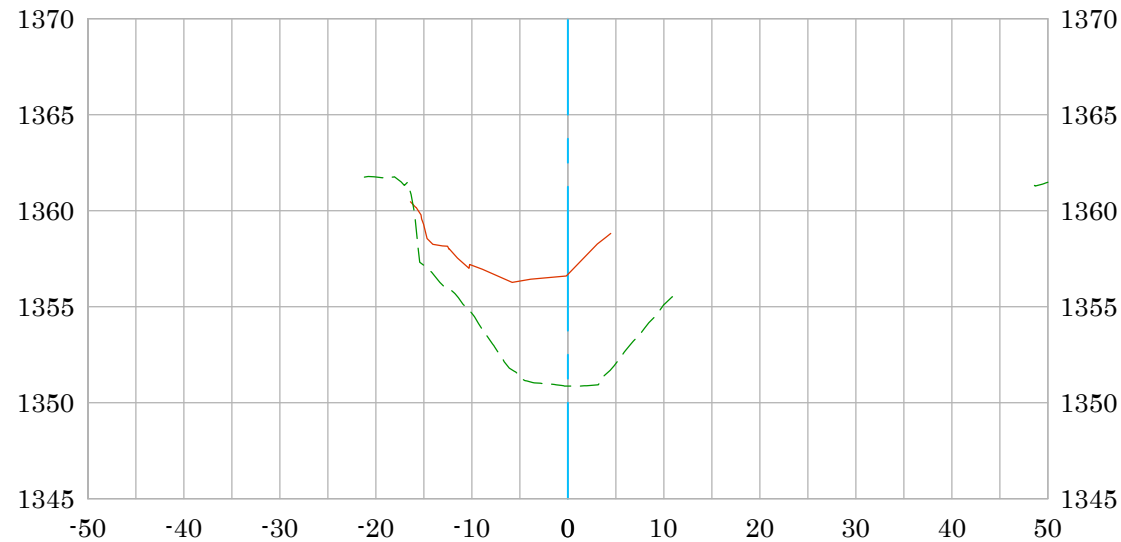

PRE-CONSTRUCTION SURFACE (03/22)

ASBUILT SURFACE POST CONSTRUCTION (11/22)

DATE PREPARED: 12/14/2022

Vert. Scale: 1"=10'


Hor. Scale: 1"=20'

U.S. *Survey*
Foot

OC Public Works
OC Survey/Field Services
Boundary Analysis & Mapping



Silverado Creek Area 2 83+50 CL

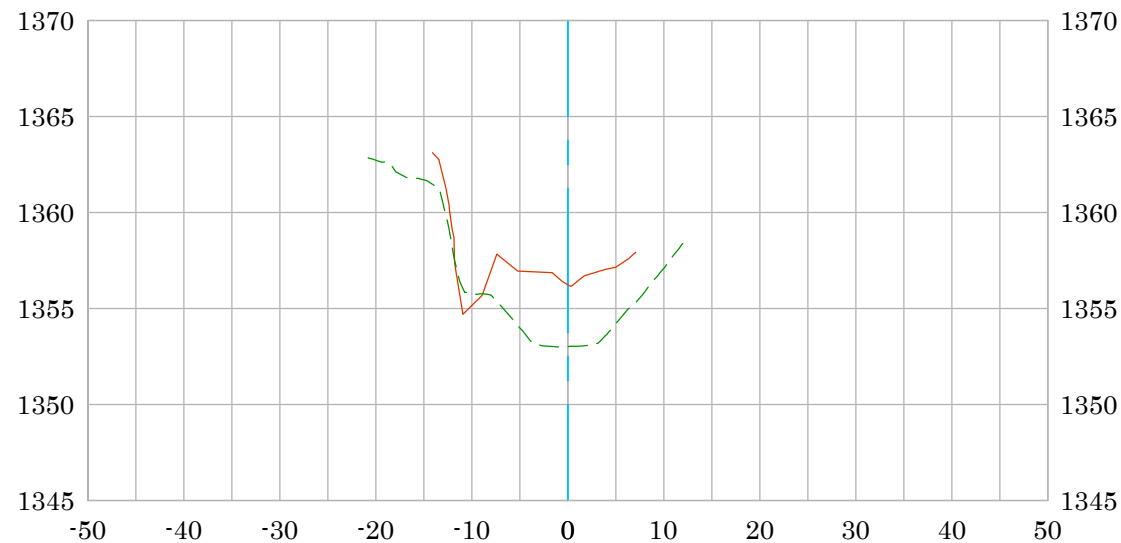

PRE-CONSTRUCTION SURFACE (03/22)

ASBUILT SURFACE POST CONSTRUCTION (11/22)

DATE PREPARED: 12/14/2022

Vert. Scale: 1"=10'

Hor. Scale: 1"=20'

U.S. *Survey*
Foot


OC Public Works
OC Survey/Field Services
Boundary Analysis & Mapping



Silverado Creek Area 2

84+00

CL

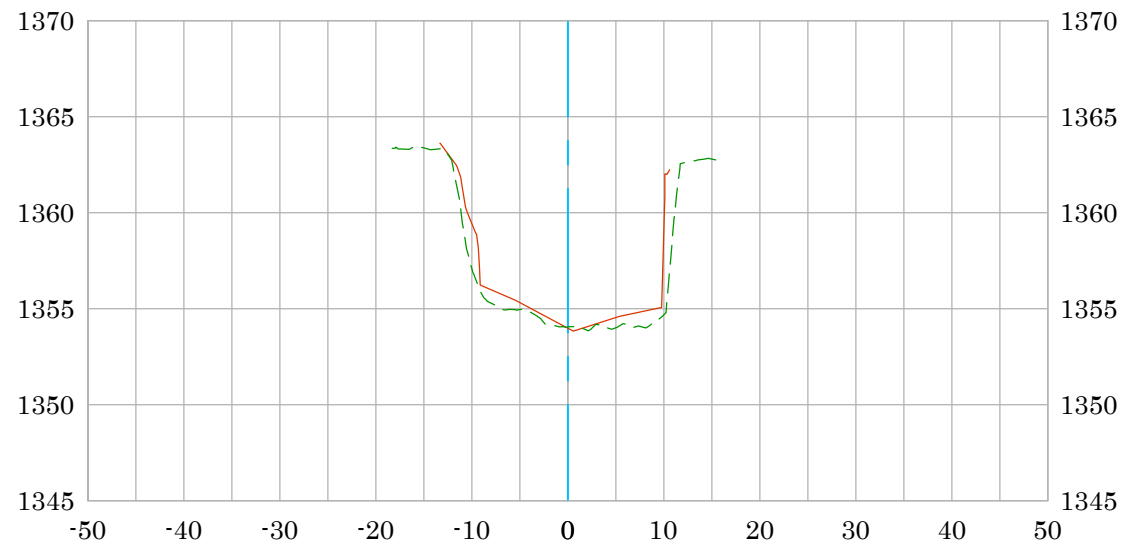

PRE-CONSTRUCTION SURFACE (03/22)

ASBUILT SURFACE POST CONSTRUCTION (11/22)

DATE PREPARED: 12/14/2022

Vert. Scale: 1"=10'

Hor. Scale: 1"=20'