




OC PUBLIC WORKS DEPARTMENT
JAMES TREADAWAY, DIRECTOR OF PUBLIC WORKS
WORKFORCE REENTRY CENTER
(COUNTY OF ORANGE ANIMAL SHELTER)
ALTA/NSPS/TOPOGRAPHIC SURVEY

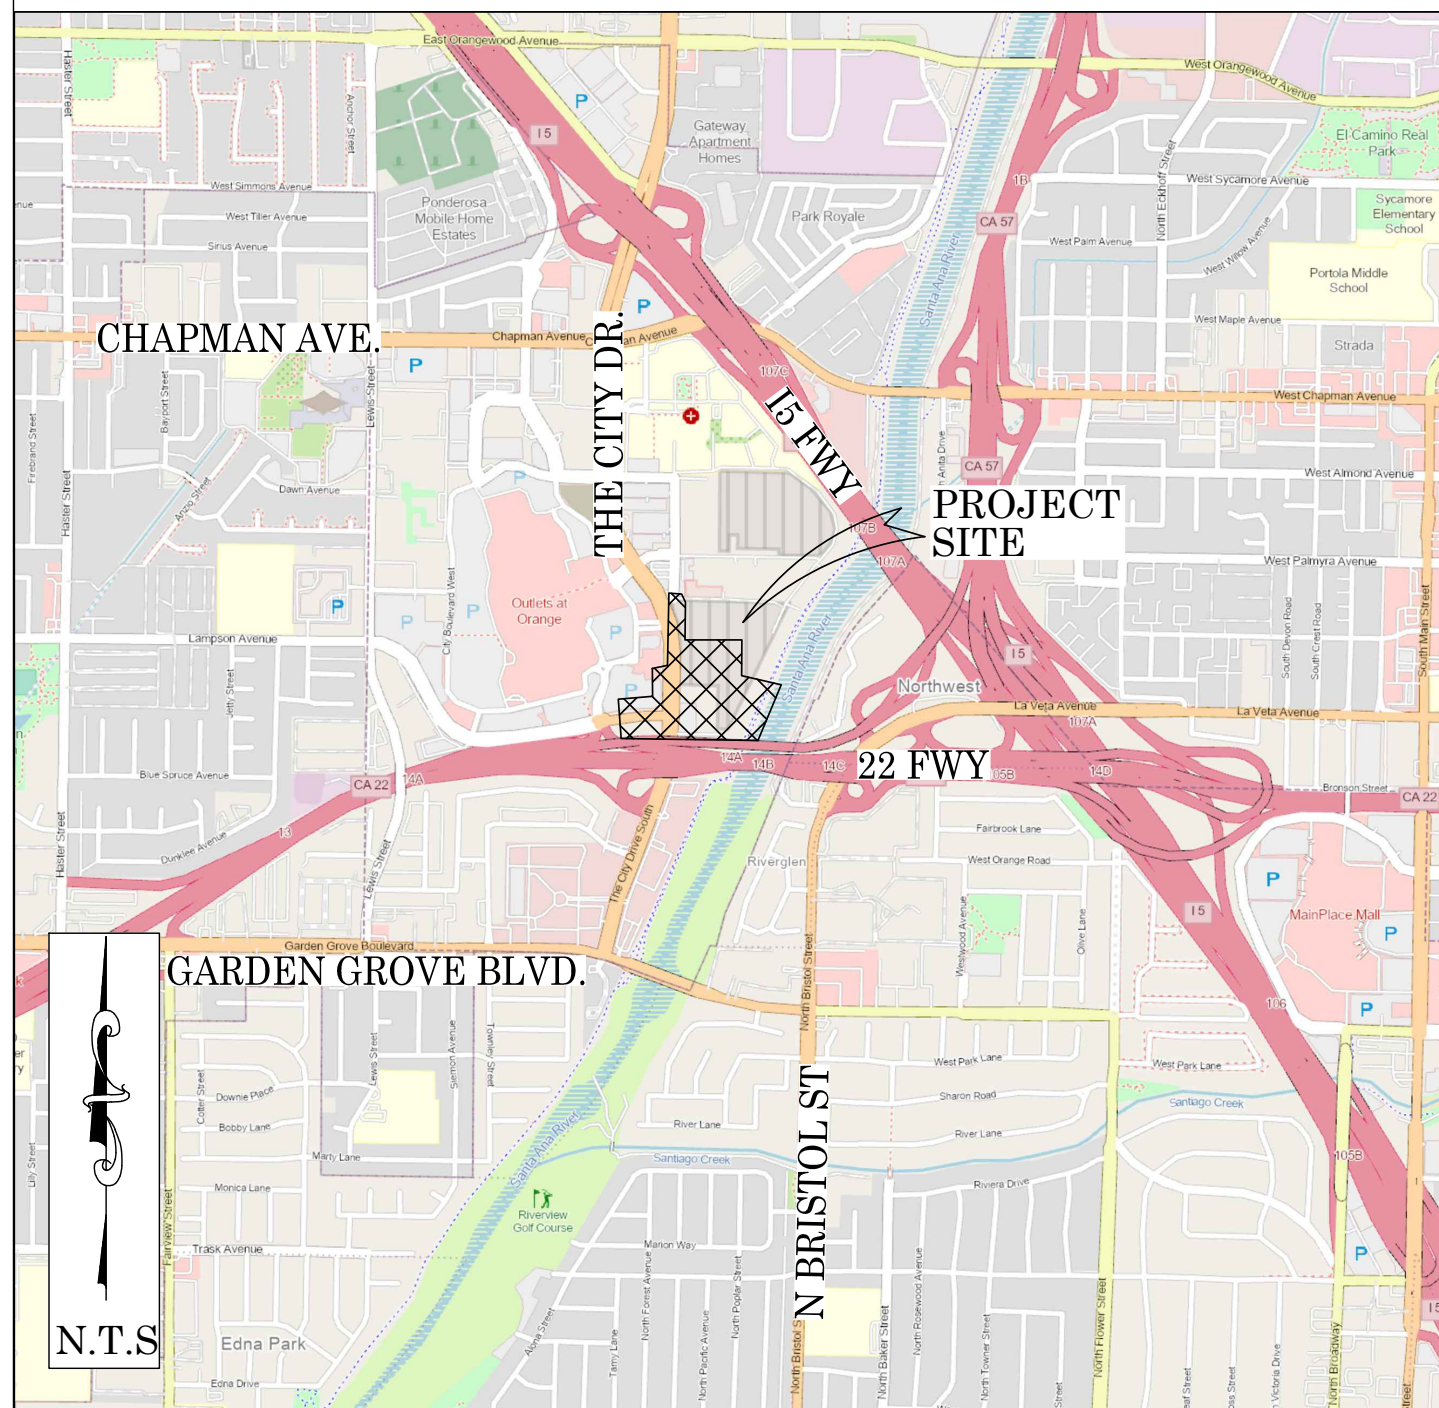


LOCATION MAP



SENIOR LAND SURVEYOR'S CERTIFICATE:

THIS MAP CORRECTLY REPRESENTS A SURVEY MADE BY ME OR UNDER MY DIRECTION IN CONFORMANCE WITH REQUIREMENTS OF THE PROFESSIONAL LAND SURVEYOR'S ACT; THIS 24 DAY OF JULY, 2024.


MICHAEL KUBISTY, PLS. SENIOR LAND SURVEYOR

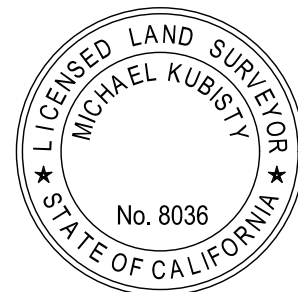

SENIOR LAND SURVEYOR'S CERTIFICATE:

THIS MAP HAS BEEN EXAMINED IN ACCORDANCE WITH THE PROFESSIONAL LAND SURVEYORS' ACT; THIS 24 DAY OF JULY, 2024.

ELLIOTT MEDINA, PLS. SENIOR LAND SURVEYOR

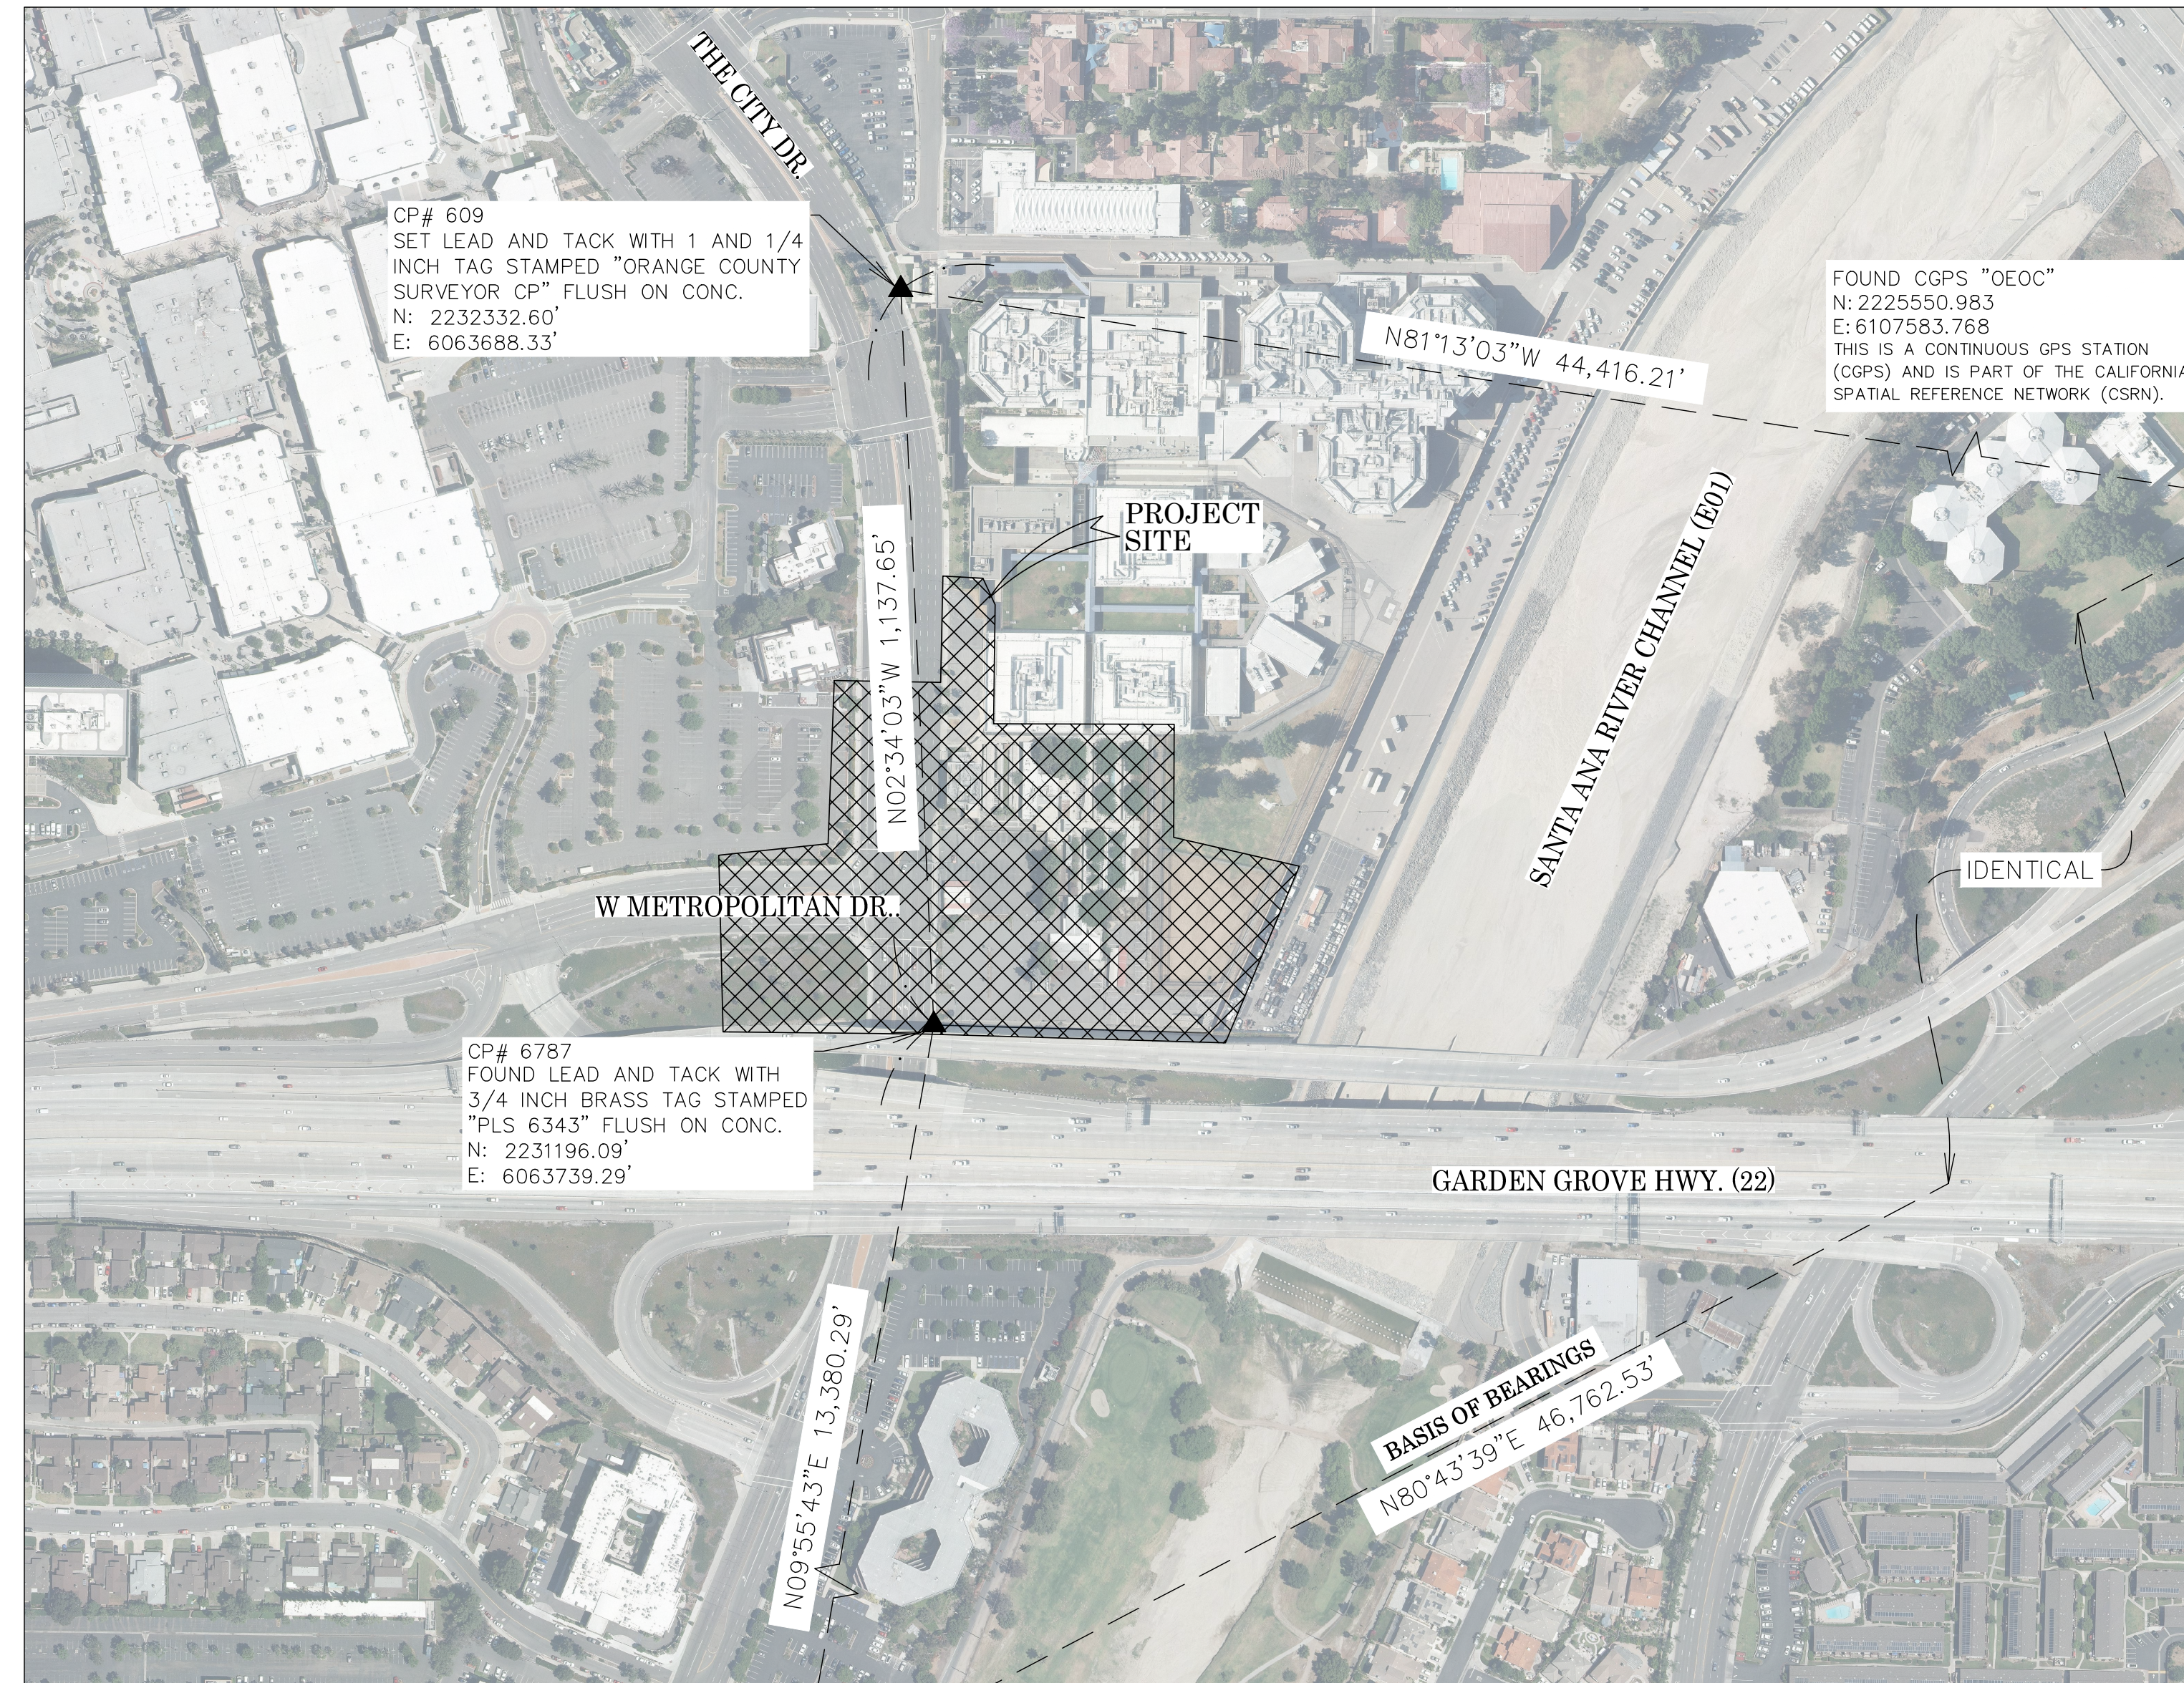

FOUND CGPS "SACY"
N: 2218016.191
E: 6061432.265
THIS IS A CONTINUOUS GPS STATION
(CGPS) AND IS PART OF THE CALIFORNIA
SPATIAL REFERENCE NETWORK (CSRN).

ALTA/NSPS/TOPOGRAPHIC MAPPING PROJECT

BASIS OF BEARINGS

THE BASIS OF BEARINGS FOR THIS SURVEY IS BASED ON THE CALIFORNIA COORDINATE SYSTEM (CCS83), ZONE VI, NAD 83, OCS (2017.50) EPOCH ADJUSTMENT, AS DETERMINED LOCALLY BY A LINE BETWEEN CONTINUOUS GLOBAL POSITIONING STATIONS CGPS STATIONS (SACY) AND (OEOC) BEING NORTH 80°43'39" EAST AS DERIVED FROM THE COORDINATES PUBLISHED BY THE CALIFORNIA SPATIAL REFERENCE CENTER (CSRN) ALONG WITH DATA SHEETS ON FILE IN THE OFFICE OF THE ORANGE COUNTY SURVEYOR.

HORIZONTAL DATUM

COORDINATES SHOWN ARE BASED ON THE CALIFORNIA COORDINATE SYSTEM (CCS83), ZONE VI, NAD 83, OCS (2017.50) EPOCH ADJUSTMENT.
ALL DISTANCES SHOWN ARE GRID, UNLESS OTHERWISE NOTED. TO OBTAIN GROUND DISTANCES MULTIPLY GRID BY A COMBINED FACTOR OF 1.00001605.
THIS COMBINATION FACTOR WAS HELD AT: CP# 6787
N: 2231196.09 E: 6063739.29 EL: 124.04'
ALL DISTANCES ARE BASED ON THE U.S. SURVEY FOOT.

VERTICAL DATUM

O.C.S. BM. SA-341-09 ELEV. = 135.077' YEAR LEVELED: 2010
NAVD 1988 (O.C.S. 1995 ADJUSTMENT)
DESCRIPTION: FOUND 4" OCS ALUMINUM BENCHMARK DISK STAMPED "SA-341-09" SET IN THE NORTHWESTERLY CORNER OF A 4 FT. BY 12 FT. CONCRETE CATCH BASIN. MONUMENT IS LOCATED IN THE NORTHWESTERLY CORNER OF THE INTERSECTION OF CHAPMAN AVENUE AND STATE COLLEGE/THE CITY DR. 69 FT. WESTERLY OF THE CENTERLINE OF STATE COLLEGE/THE CITY DR. AND 147 FT. NORTHERLY OF THE CENTERLINE OF CHAPMAN AVE. MONUMENT IS SET LEVEL WITH THE SIDEWALK.

CERTIFICATION

TO: COUNTY OF ORANGE, CEO REAL ESTATE, AND FIDELITY NATIONAL TITLE COMPANY.
THIS IS TO CERTIFY THAT THIS MAP OR PLAT AND THE SURVEY ON WHICH IT IS BASED WERE MADE IN ACCORDANCE WITH THE 2021 MINIMUM STANDARD DETAIL REQUIREMENTS FOR ALTA/NSPS LAND TITLE SURVEYS, JOINTLY ESTABLISHED AND ADOPTED BY ALTA AND NSPS, AND INCLUDES ITEMS, 1-10, 13-14, 16-18 AND 20 OF TABLE A THEREOF. THE FIELD WORK WAS COMPLETED ON 03/20/2024.
DATE OF PLAT OR MAP: 05/02/2024
NOTE: SECTION 8770.6 OF THE CALIFORNIA BUSINESS AND PROFESSIONS CODE STATES THAT THE USE OF THE WORD CERTIFY OR CERTIFICATION BY A LICENSED LAND SURVEYOR IN THE PRACTICE OF LAND SURVEYING OR THE PREPARATION OF MAPS, PLATS, REPORTS, DESCRIPTIONS OR OTHER SURVEYING DOCUMENTS ONLY CONSTITUTES AN EXPRESSION OF PROFESSIONAL OPINION REGARDING THOSE FACTS OR FINDINGS WHICH ARE THE SUBJECT OF THE CERTIFICATION AND DOES NOT CONSTITUTE A WARRANTY OR GUARANTEE, EITHER EXPRESSED OR IMPLIED.

SHEET INDEX

| SHEET | NO. | DESCRIPTION |
|--------|-------|-----------------------------|
| SHEET | 1 | TITLE SHEET |
| SHEETS | 2-10 | BOUNDARY SHEETS |
| SHEET | 11 | EASEMENT MAP |
| SHEETS | 12-13 | ALTA/NSPS LAND TITLE SURVEY |

| | | | |
|-----------|---|---|------------------------|
| | | COUNTY OF ORANGE OC PUBLIC WORKS OC SURVEY/FIELD SERVICES/BOUNDARY ANALYSIS & MAPPING | |
| | | WORKFORCE REENTRY CENTER ALTA/NSPS/TOPOGRAPHIC SURVEY | |
| | | TITLE SHEET | |
| | | PROJECT LIMITS: BETWEEN THE 22 FREEWAY AND THEO LACY FACILITY | |
| 7/23/2024 | ADDITIONAL TOPO OF THE ADJACENT INTERSECTION OF METROPOLITAN DRIVE AND THE CITY DRIVE, SEE SHEET 14 | DATE OF SURVEY: MARCH 2024 | BY: J. RUSSO & PARTY |
| | | MAPPING | BY: J. PEDRETTI |
| | | OFFICE CHECK | BY: E. MEDINA, PLS. |
| | | FIELD CHECK | BY: T. LOFGREEN & CREW |
| MARK | DATE | ITEM | |
| | | REVISIONS | |
| | | SCALE: N.T.S. | W.O. #EC29962 |
| | | FILE: WFRG_ALTA_2024_ADD.DWG | FILE: #2324PW-RE0003 |
| | | SHEET NO. 1 of 14 | |

LEGAL DESCRIPTION PROPOSED PARCEL GA-1118-152

THAT CERTAIN PORTION OF LAND IN THE CITY OF ORANGE, COUNTY OF ORANGE, STATE OF CALIFORNIA, OVER LAND DESCRIBED IN DEED RECORDED NOVEMBER 21, 1912, IN BOOK 150, PAGE 177 OF DEEDS, DESCRIBED IN GRANT DEED RECORDED JULY 9, 1965, IN BOOK 7587, PAGE 794, DESCRIBED IN GRANT DEED RECORDED OCTOBER 28, 1965, IN BOOK 7719, PAGE 964, AND DESCRIBED IN GRANT DEED RECORDED APRIL 3, 2003 AS INSTRUMENT NO. 2003000369248, ALL TO THE COUNTY OF ORANGE, ALL OF OFFICIAL RECORDS IN THE OFFICE OF THE COUNTY RECORDER OF SAID COUNTY, LYING SOUTHERLY AND WESTERLY OF THE FOLLOWING DESCRIBED LINE:

COMMENCING AT THE NORTHERLY TERMINUS OF THAT CERTAIN COURSE ON THE CENTERLINE OF THE CITY DRIVE SHOWN AS "N00°41'08"E 149.545M" ON RECORD OF SURVEY 2003-1006 PER MAP FILED IN BOOK 199, PAGES 1 THROUGH 16 OF RECORDS OF SURVEY IN THE OFFICE OF THE COUNTY RECORDER OF SAID ORANGE COUNTY;

THENCE LEAVING SAID CENTERLINE, PERPENDICULAR THERETO, SOUTH 89°18'52" EAST, 60.00 FEET TO THE EASTERLY BOUNDARY LINE OF THE CITY DRIVE;

THENCE ALONG SAID EASTERLY LINE NORTH 00°41'08" EAST, 45.00 FEET TO THE BEGINNING OF A NON-TANGENT CURVE, CONCAVE SOUTHERLY AND HAVING A RADIUS OF 48.70 FEET, A RADIAL LINE TO SAID BEGINNING BEARS NORTH 00°12'42" WEST, SAID BEGINNING ALSO BEING THE TRUE POINT OF BEGINNING;

THENCE LEAVING SAID EASTERLY LINE, EASTERLY 8.99 FEET ALONG SAID CURVE THROUGH A CENTRAL ANGLE OF 10°34'48";

THENCE NON-TANGENT TO SAID CURVE NORTH 06°51'07" EAST, 2.54 FEET;

THENCE SOUTH 89°14'05" EAST, 41.26 FEET;

THENCE SOUTH 00°50'13" WEST, 23.03 FEET; THENCE SOUTH 88°04'51" EAST, 11.82 FEET;

THENCE SOUTH 00°41'08" WEST, 24.62 FEET; THENCE NORTH 89°12'35" WEST, 6.32 FEET; THENCE SOUTH 00°40'46" WEST, 138.89 FEET; THENCE SOUTH 67°30'54" WEST, 1.16 FEET TO THE BEGINNING OF A NON-TANGENT CURVE, CONCAVE WESTERLY AND HAVING A RADIUS OF 46.00 FEET, A RADIAL LINE TO SAID BEGINNING BEARS NORTH 69°09'24" EAST;

THENCE SOUTHERLY 38.88 FEET ALONG SAID CURVE THROUGH A CENTRAL ANGLE OF 48°25'44";

THENCE NON-TANGENT TO SAID CURVE SOUTH 89°16'48" EAST, 260.26 FEET;

THENCE SOUTH 00°44'28" WEST, 170.65 FEET;

THENCE SOUTH 78°06'57" EAST, 214.62 FEET; THENCE SOUTH 24°25'19" WEST, 269.28 FEET TO ITS INTERSECTION WITH THE NORTHERLY BOUNDARY LINE OF PARCEL 102321-1, AS DESCRIBED IN THE GRANT DEED TO THE ORANGE COUNTY TRANSPORTATION AUTHORITY RECORDED NOVEMBER 30, 2004 AS DOCUMENT NO. 2004001062820 OF OFFICIAL RECORDS IN THE OFFICE OF THE COUNTY RECORDER OF SAID ORANGE COUNTY.

TOGETHER WITH LAND DESCRIBED AS PARCEL G.A. 1118-10.01 IN FINAL ORDER OF CONDEMNATION, RECORDED JANUARY 25, 1966, IN BOOK 7820, PAGE 506, DESCRIBED IN GRANT DEED TO THE COUNTY OF ORANGE, RECORDED DECEMBER 8, 1998, AS INSTRUMENT NO. 19980842737, AND DESCRIBED IN GRANT DEED TO THE COUNTY OF ORANGE RECORDED SEPTEMBER 23, 2005, AS INSTRUMENT NO. 2005000755202, ALL OF OFFICIAL RECORDS IN SAID COUNTY RECORDER'S OFFICE.

EXCEPT THAT PORTION OF LAND DESCRIBED IN THE EASEMENT DEED TO THE CITY OF ORANGE, RECORDED MAY 21, 1998 AS INSTRUMENT NO. 19980314756 OF OFFICIAL RECORDS IN SAID COUNTY RECORDER'S OFFICE.

ALSO EXCEPT THAT PORTION OF LAND DESCRIBED IN THE EASEMENT DEED TO THE CITY OF ORANGE, RECORDED MAY 21, 1998 AS INSTRUMENT NO. 19980314757 OF OFFICIAL RECORDS IN SAID COUNTY RECORDER'S OFFICE.

CONTAINING 4.604 ACRES, MORE OR LESS.

ZONING AND SETBACK REQUIREMENTS

THE PROPERTY IS WITHIN THE "LIMITED BUSINESS C1" AND "PUBLIC INFRASTRUCTURE" ZONE OF THE CITY OF TUSTIN. SETBACK REQUIREMENTS OF SAID ZONE ARE DEFINED IN CITY OF TUSTIN PLANNED COMMUNITY DISTRICT REGULATIONS PROPOSED MODIFICATIONS TO PLANNED COMMUNITY DISTRICT REGULATIONS ZONE

ORDINANCE NO. 1347 DATE JANUARY 15, 2008

ZONING INFORMATION FOR LIMITED BUSINESS C1

ALL SETBACKS SHALL BE MEASURED FROM THE PROPERTY LINE. FOR THE PURPOSE OF THIS ORDINANCE, A STREET SIDE PROPERTY LINE IS THAT LINE CREATED BY THE ULTIMATE RIGHT-OF-WAY LINE OF THE FRONTAGE STREET.

DEVELOPMENT STANDARDS:

- FRONT YARD SETBACK – 10 FT.
- REAR YARD SETBACK – NOT REQUIRED.
- SIDE YARD SETBACK, EACH – 10 FT.
- MINIMUM LOT SIZE – 7,000 SQUARE FEET AND MINIMUM LOT WIDTH OF 70 FEET

ZONING INFORMATION FOR PUBLIC INFRASTRUCTURE

ALL SETBACKS SHALL BE MEASURED FROM THE PROPERTY LINE. FOR THE PURPOSE OF THIS ORDINANCE, A STREET SIDE PROPERTY LINE IS THAT LINE CREATED BY THE ULTIMATE RIGHT-OF-WAY LINE OF THE FRONTAGE STREET.

DEVELOPMENT STANDARDS:

- FRONT YARD SETBACK – 10 FT.
- REAR YARD SETBACK – NOT REQUIRED.
- SIDE YARD SETBACK, EACH – 10 FT.
- MINIMUM LOT SIZE – 6,000 SQUARE FEET

FLOOD ZONE

SUBJECT PROPERTY LIES WITHIN "ZONE X" BEING AREAS OF 0.2% ANNUAL CHANCE FLOOD PLAIN; AREAS OF 1% ANNUAL CHANCE FLOOD WITH AVERAGE DEPTHS OF LESS THAN 1 FOOT OR WITH DRAINAGE AREAS LESS THAN 1 SQUARE MILE, AND AREAS PROTECTED BY LEVEES FROM 1% ANNUAL CHANCE FLOOD.

INSURANCE PROGRAM (NFIP) & FLOOD INSURANCE RATE MAP INFORMATION LOCATED AT ORANGE COUNTY, CALIFORNIA AND UNINCORPORATED AREAS, CITY OF TUSTIN; PANEL 06059C 0144J WITH AN EFFECTIVE DATE OF DECEMBER 3, 2009.

FLOOD AREA LINE WORK WAS DERIVED FROM FEMA GIS WEBSITE: [HTTPS://MSC.FEMA.GOV/](https://MSC.FEMA.GOV/)

PARKING COUNT

STANDARD PARKING: 207
ADA ACCESSIBLE PARKING: 5

TOTAL PARKING: 212

NOTES

ALL BOUNDARY LINES NOT SHOWN IN BOLD ARE FOR GRAPHICAL REPRESENTATION ONLY.

RECORD DISTANCES SHOWN HEREON ARE AS THEY APPEAR ON THE DOCUMENT OF RECORD. DISTANCES MAY BE EITHER GRID OR GROUND, AS PER SAID RECORD.

REFERENCE DOCUMENTS IN THE REFERENCE LEGEND ARE LIVE HYPERLINKS TO SAID DOCUMENT.

EASEMENT NOTES 40 THROUGH 45 INCLUSIVE ARE SHOWN AND REFERENCED FROM PTR #00197617-994-LTR-ITW DATED 8-10-23

BASIS OF BEARINGS

THE BASIS OF BEARINGS FOR THIS SURVEY IS BASED ON THE CALIFORNIA COORDINATE SYSTEM (CCS83), ZONE VI, NAD 83, OCS (2017.50) EPOCH ADJUSTMENT, AS DETERMINED LOCALLY BY A LINE BETWEEN CONTINUOUS GLOBAL POSITIONING STATIONS CGPS STATIONS (SACY) AND (OEOC) BEING NORTH 80°43'39" EAST AS DERIVED FROM THE COORDINATES PUBLISHED BY THE CALIFORNIA SPATIAL REFERENCE CENTER (CSRC) ALONG WITH DATA SHEETS ON FILE IN THE OFFICE OF THE ORANGE COUNTY SURVEYOR.

HORIZONTAL DATUM

COORDINATES SHOWN ARE BASED ON THE CALIFORNIA COORDINATE SYSTEM (CCS83), ZONE VI, NAD 83, OCS (2017.50) EPOCH ADJUSTMENT.

ALL DISTANCES SHOWN ARE GRID, UNLESS OTHERWISE NOTED. TO OBTAIN GROUND DISTANCES MULTIPLY GRID BY A COMBINED FACTOR OF 1.00001605.

THIS COMBINATION FACTOR WAS HELD AT: CP# 6787
N:2231196.09 E:6063739.29 EL: 124.04'

ALL DISTANCES ARE BASED ON THE U.S. SURVEY FOOT.

VERTICAL DATUM

O.C.S. BM. SA-341-09 ELEV. = 135.077' YEAR LEVELED: 12010

NAVD 1988 (O.C.S. 1995 ADJUSTMENT)

DESCRIPTION: FOUND 4" OCS ALUMINUM BENCHMARK DISK STAMPED "SA-341-09" SET IN THE NORTHWESTERLY CORNER OF A 4 FT. BY 12 FT. CONCRETE CATCH BASIN. MONUMENT IS LOCATED IN THE NORTHWESTERLY CORNER OF THE INTERSECTION OF CHAPMAN AVENUE AND STATE COLLEGE/THE CITY DR. 69 FT. WESTERLY OF THE CENTERLINE OF STATE COLLEGE/THE CITY DR. AND 147 FT. NORTHERLY OF THE CENTERLINE OF CHAPMAN AVE. MONUMENT IS SET LEVEL WITH THE SIDEWALK.

EASEMENT NOTES:

PER AMENDED TITLE REPORT ORDER NO. 955-30109939-A-2AA AMENDMENT NO. A DATED JANUARY 31, 2024 PREPARED BY FIDELITY NATIONAL TITLE COMPANY 555 S. FLOWER STREET, SUITE 4420, LOS ANGELES, CA 90071

- ② EASEMENT FOR ROADS, RAILROADS, AND DITCHES DESCRIBED PER DOCUMENT NO. 13/347, O.R. ILLEGIBLE.
- ④ EASEMENT GRANTED TO THE COUNTY OF ORANGE FOR CONSTRUCTING AND MAINTAINING A SEWER OUTFALL PIPE DESCRIBED PER DOCUMENT NO. 528/ 319, O.R.
- ⑥ EASEMENT GRANTED TO SOUTHERN CALIFORNIA EDISON COMPANY FOR CONSTRUCTING AND MAINTAINING ELECTRIC LINES WITHIN PARCEL DESCRIBED PER DOCUMENT NO. 4351/ 313, O.R. AND DOCUMENT NO. 5408/ 415, O.R.
- ⑦ EASEMENT GRANTED TO SOUTHERN CALIFORNIA EDISON COMPANY FOR CONSTRUCTING AND MAINTAINING ELECTRIC LINES WITHIN PARCEL DESCRIBED PER DOCUMENT NO. 4662/ 186, O.R.
- ⑧ EASEMENT GRANTED TO THE COUNTY SANITATION DISTRICT NO. 2 OF ORANGE COUNTY FOR PURPOSES OF SANITARY SEWER WITHIN LOT 35, DOCUMENT NO. 5218/184 O.R. AND DOCUMENT 502/266 O.R.
- ⑨ PROPERTY GRANTED TO THE STATE OF CALIFORNIA FOR PURPOSES OF PUBLIC HIGHWAY AND ITS MAINTENANCE, DOCUMENT NO. 5923/1 O.R. UPON RESEARCHING THE CHAIN OF TITLE ASSOCIATED WITH THIS PARCEL IT HAS BEEN CONFIRMED THAT OWNERSHIP IS NOW IN THE COUNTY OF ORANGE PER DOCUMENT NO. 2005000755202 O.R.
- ⑩ EASEMENTS AND PROPERTY GRANTED TO THE STATE OF CALIFORNIA FOR PURPOSES OF A FREEWAY, SLOPE EASEMENT, AND LANDSCAPE MAINTENANCE, DOCUMENT NO. 6311/631 O.R.
- ⑫ EASEMENT RESERVATION OF 25' STRIP FOR INGRESS AND EGRESS OVER THAT PORTION OF LOT 28 DESCRIBED PER DOCUMENT NO. 7170/25 O.R. NOT PLOTTABLE FROM RECORD.
- ⑭ EASEMENTS GRANTED TO THE STATE OF CALIFORNIA FOR PURPOSES OF INGRESS AND EGRESS, DOCUMENT NO. 8069/84 O.R.
- ⑮ EASEMENTS GRANTED FOR PURPOSES OF SANITARY SEWER OVER PARCEL 1 P.M.B. 25/ 32, DOCUMENT NO. 9140/887 O.R.
- ⑰ EASEMENTS GRANTED TO SOUTHERN CALIFORNIA EDISON FOR PURPOSES OF INSTALLING AND MAINTAINING ELECTRICAL AND COMMUNICATION SYSTEMS, DOCUMENT NO. 13123/1124 O.R.
- ⑲ EASEMENTS GRANTED TO SOUTHERN CALIFORNIA EDISON FOR PURPOSES OF INSTALLING AND MAINTAINING ELECTRICAL AND COMMUNICATION SYSTEMS, DOCUMENT NO. 87-012516 O.R.
- ⑳ EASEMENT GRANTED TO SOUTHERN CALIFORNIA EDISON FOR PURPOSES OF INSTALLING AND MAINTAINING ELECTRICAL LINES, DOCUMENT NO. 92-802868 O.R. NOT PLOTTABLE FROM RECORD.
- ㉑ EASEMENTS GRANTED TO THE CITY OF ORANGE FOR PURPOSES OF INSTALLING AND MAINTAINING TRAFFIC SIGNAL DEVICES, DOCUMENT NO. 92-898030 O.R.
- ㉒ EASEMENTS GRANTED TO THE CITY OF ORANGE FOR PURPOSES OF RIGHT OF WAY OF STREET AND PUBLIC UTILITY, DOCUMENT NO. 19980314756 O.R.
- ㉓ EASEMENTS GRANTED TO THE CITY OF ORANGE FOR PURPOSES OF RIGHT OF WAY OF STREET AND PUBLIC UTILITY, DOCUMENT NO. 19980314757 O.R.
- ㉔ EASEMENTS GRANTED TO THE COUNTY OF ORANGE AND GLOBAL SIGNAL ACQUISITIONS III LLC FOR PURPOSES OF COMMUNICATION SYSTEMS INSTALLATION AND MAINTENANCE, DOCUMENT NO. 2012000297925 O.R.
- ㉖ EASEMENTS GRANTED TO THE COUNTY OF ORANGE FLOOD CONTROL DISTRICT FOR PURPOSES OF STORM DRAIN INSTALLATION AND MAINTENANCE, DOCUMENT NO. 2009000571573 O.R.
- ㉘ EASEMENT GRANTED TO NEW CINGULAR WIRELESS PCS, LLC FOR PURPOSES OF INSTALLING AND MAINTAINING A CELL TOWER PER DOCUMENT NO. 2011000595364 O.R. NOT LOCATABLE.
- ㉙ EASEMENTS GRANTED TO SOUTHERN CALIFORNIA EDISON FOR PURPOSES OF INSTALLING AND MAINTAINING ELECTRICAL AND COMMUNICATION SYSTEMS, DOCUMENT NO. 2012000162275 O.R.
- ④0 EASEMENT GRANTED TO THE ORANGE COUNTY WATER DISTRICT, DOCUMENT NO. 2005000196259 O.R. NOT FOUND IN PTR.
- ④1 EASEMENT GRANTED TO DEPT. OF CORRECTION AND REHABILITATION OF THE STATE OF CALIFORNIA. FOR ACCESS AND UTILITY, WITHIN PARCEL A, SITE AND AREAS 1-5, DOCUMENT NO. 2019000033731, O.R. NOT FOUND IN PTR

NOTE


SEE SHEET 11 FOR EASEMENT MAP

COMPLETED TABLE A ITEMS:

2. ADDRESS(ES) OF THE SURVEYED PROPERTY IF DISCLOSED IN DOCUMENTS PROVIDED TO OR OBTAINED BY THE SURVEYOR, OR OBSERVED WHILE CONDUCTING THE FIELDWORK.
3. FLOOD ZONE CLASSIFICATION (WITH PROPER ANNOTATION BASED ON FEDERAL FLOOD INSURANCE RATE MAPS OR THE STATE OR LOCAL EQUIVALENT) DEPICTED BY SCALED MAP LOCATION AND GRAPHIC PLOTTING ONLY.
4. GROSS LAND AREA (AND OTHER AREAS IF SPECIFIED BY THE CLIENT).
5. VERTICAL RELIEF WITH THE SOURCE OF INFORMATION.
6. (a) IF THE CURRENT ZONING CLASSIFICATION, SETBACK REQUIREMENTS, THE HEIGHT AND FLOOR SPACE AREA RESTRICTIONS, AND PARKING REQUIREMENTS SPECIFIC TO THE SURVEYED PROPERTY ARE SET FORTH IN A ZONING REPORT OR LETTER PROVIDED TO THE SURVEYOR BY THE CLIENT OR THE CLIENT'S DESIGNATED REPRESENTATIVE, LIST THE ABOVE ITEMS ON THE PLAT OR MAP AND IDENTIFY THE DATE AND SOURCE OF THE REPORT OR LETTER.

(b) SQUARE FOOTAGE OF:
(1) EXTERIOR FOOTPRINT OF ALL BUILDINGS AT GROUND LEVEL.

(c) MEASURED HEIGHT OF ALL BUILDINGS ABOVE GRADE AT A LOCATION SPECIFIED BY THE CLIENT. IF NO LOCATION IS SPECIFIED, THE POINT OF MEASUREMENT SHALL BE IDENTIFIED.
8. SUBSTANTIAL FEATURES OBSERVED IN THE PROCESS OF CONDUCTING THE FIELDWORK (IN ADDITION TO THE IMPROVEMENTS AND FEATURES REQUIRED PURSUANT TO SECTION 5 ABOVE) (E.G., PARKING LOTS, BILLBOARDS, SIGNS, SWIMMING POOLS, LANDSCAPED AREAS, SUBSTANTIAL AREAS OF REFUSE).
9. NUMBER AND TYPE (E.G., DISABLED, MOTORCYCLE, REGULAR AND OTHER MARKED SPECIALIZED TYPES) OF CLEARLY IDENTIFIABLE PARKING SPACES ON SURFACE PARKING AREAS, LOTS AND IN PARKING STRUCTURES. STRIPING OF CLEARLY IDENTIFIABLE PARKING SPACES ON SURFACE PARKING AREAS AND LOTS.
10. AS DESIGNATED BY THE CLIENT, A DETERMINATION OF THE RELATIONSHIP AND LOCATION OF CERTAIN DIVISION OR PARTY WALLS WITH RESPECT TO ADJOINING PROPERTIES.
13. NAMES OF ADJOINING OWNERS ACCORDING TO CURRENT TAX RECORDS. IF MORE THAN ONE OWNER, IDENTIFY THE FIRST OWNER'S NAME LISTED IN THE TAX RECORDS FOLLOWED BY "ET AL."
14. AS SPECIFIED BY THE CLIENT, DISTANCE TO THE NEAREST INTERSECTING STREET.
15. RECTIFIED ORTHOPHOTOGRAPHY, PHOTOGRAMMETRIC MAPPING, REMOTE SENSING, AIRBORNE/MOBILE LASER SCANNING AND OTHER SIMILAR PRODUCTS, TOOLS OR TECHNOLOGIES AS THE BASIS FOR SHOWING THE LOCATION OF CERTAIN FEATURES (EXCLUDING BOUNDARIES) WHERE GROUND MEASUREMENTS ARE NOT OTHERWISE NECESSARY TO LOCATE THOSE FEATURES TO AN APPROPRIATE AND ACCEPTABLE ACCURACY RELATIVE TO A NEARBY BOUNDARY. THE SURVEYOR MUST (A) DISCUSS THE RAMIFICATIONS OF SUCH METHODOLOGIES (E.G., THE POTENTIAL PRECISION AND COMPLETENESS OF THE DATA GATHERED THEREBY) WITH THE INSURER, LENDER, AND CLIENT PRIOR TO THE PERFORMANCE OF THE SURVEY, AND (B) PLACE A NOTE ON THE FACE OF THE SURVEY EXPLAINING THE SOURCE, DATE, PRECISION, AND OTHER RELEVANT QUALIFICATIONS OF ANY SUCH DATA.
16. EVIDENCE OF RECENT EARTH MOVING WORK, BUILDING CONSTRUCTION, OR BUILDING ADDITIONS OBSERVED IN THE PROCESS OF CONDUCTING THE FIELDWORK. N/A
17. PROPOSED CHANGES IN STREET RIGHT OF WAY LINES, IF SUCH INFORMATION IS MADE AVAILABLE TO THE SURVEYOR BY THE CONTROLLING JURISDICTION. EVIDENCE OF RECENT STREET OR SIDEWALK CONSTRUCTION OR REPAIRS OBSERVED IN THE PROCESS OF CONDUCTING THE FIELDWORK. N/A
18. PURSUANT TO SECTIONS 5 AND 6 (AND APPLICABLE SELECTED TABLE A ITEMS, EXCLUDING TABLE A ITEM 1), INCLUDE AS PART OF THE SURVEY ANY PLOTTABLE OFFSITE (I.E. APPURTENANT) EASEMENTS DISCLOSED IN DOCUMENTS PROVIDED TO OR OBTAINED BY THE SURVEYOR.

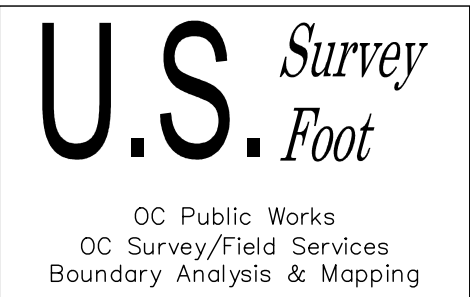

| | | | | | | |
|------|------|------|---|--|-------------------------|--|
| | | | COUNTY OF ORANGE OC PUBLIC WORKS OC SURVEY/FIELD SERVICES/BOUNDARY ANALYSIS & MAPPING | | | |
| | | | COUNTY OF ORANGE ANIMAL SHELTER ALTANSPS SURVEY | | | |
| | | | BOUNDARY MAP | | | |
| | | | PROJECT LIMITS: BETWEEN THE 22 FREEWAY AND THEO LACY FACILITY | | | |
| | | | DATE OF SURVEY:MARCH 2024 | | BY:T. LOFGREEN AND CREW | SHEET NO. 2 of 14 |
| | | | MAPPING | | BY:T. LOFGREEN | |
| | | | OFFICE CHECK | | BY:E. MEDINA, PLS | |
| | | | FIELD CHECK | | BY:T. LOFGREEN | |
| | | | SCALE:N.T.S. | | W.O. #EC29962 | |
| MARK | DATE | ITEM | REVISIONS | | FILE #2324PW-RE0003 | |
| | | | FILE:Animal Shelter Boundary_2024.DWG | | | |

MONUMENT NOTES

- 1

FOUND NAIL AND TAG STAMPED "LS 5411" PER R26, FLUSH IN A.C., ACCEPTED AS CENTERLINE INTERSECTION OF ECKHOFF ST. AND CHAPMAN AVE.
- 2

FOUND GEAR SPIKE AND 1 1/2 INCH WASHER STAMPED LS 5411 PER R14, FLUSH IN A.C. ACCEPTED AS CENTERLINE INTERSECTION OF ANITA DR. AND CHAPMAN AVE.
- 3

FOUND GEAR SPIKE AND 1 1/2 INCH WASHER STAMPED LS 5411 PER R14, FLUSH IN ACCEPTED AS INTERSECTION OF THE EASTERLY LINE OF O.C.F.C.D. R/W AND CENTERLINE CHAPMAN AVE.
- 4

FOUND GEAR SPIKE AND 1 1/2 INCH WASHER STAMPED LS 5411 PER R14, FLUSH IN A.C. ACCEPTED AS POINT ON CENTERLINE CHAPMAN AVE.
- 5

FOUND LEAD, BRASS PIN WITH 1 1/2 INCH OCS BRASS TAG NO REF, FLUSH IN CONCRETE. ACCEPTED AS INTERSECTION OF THE CORPS OF ENGINEER'S CONSTRUCTION CENTERLINE AND CHAPMAN AVE. PER R1.
- 6

FOUND LEAD BRASS PIN WITH 3/4 INCH BRASS TAG STAMPED "DIV HWYS" PER CAL TRANS NOTES SR73-070-329 AND SHOWN ON R1, FLUSH IN CONCRETE. ACCEPTED AS POINT ON CENTERLINE CHAPMAN AVE., ALSO ACCEPTED AS ENGINEER'S STATION 99+61.55 DESCRIBED IN R8.
- 7

FOUND 1 INCH IP WITH TAG "ILLEGIBLE" PER R15, DOWN 0.70' IN DIRT. ACCEPTED AS 1 INCH IP TAGGED R.C.E. 9070 HELD AS THE NORTHEAST CORNER OF PARCEL 3.
- 8

FOUND 2 INCH IP WITH 1 1/2 INCH OCS TAG PER R1, FLUSH IN DIRT. ACCEPTED AS POINT IN THE EASTERLY LINE OF O.C.F.C.D. R/W PER R1.
- 9

FOUND LEAD, BRASS NAIL AND 1 1/2 INCH OCS WASHER IN CONCRETE CYLINDER PER R1, DOWN 0.30' IN GRASS. ACCEPTED AS POINT IN EASTERLY LINE OF O.C.F.C.D. R/W PER R1.
- 10

FOUND LEAD, BRASS NAIL AND 1 1/2 INCH OCS WASHER IN CONCRETE CYLINDER PER R1, DOWN 0.30' IN GRASS ACCEPTED AS POINT IN EASTERLY LINE OF O.C.F.C.D. R/W PER R1.
- 11

FOUND 2 INCH IP TAGGED "LS 5134" PER R15, FLUSH IN DIRT. PER R10 ACCEPTED AS POINT IN THE EASTERLY LINE OF PARCEL 2 PER R15.
- 12

FOUND 2 INCH IP WITH NO TAG ACCEPTED AS 2 INCH IP WITH OCS TAG, PER R1, DOWN 0.60' IN DIRT. ALSO HELD AS POINT IN EASTERLY O.C.F.C.D. R/W PER R1.
- 13

FOUND 2 INCH IP WITH TAG STAMPED "R.C.E. 18752" NO REF, DOWN 0.50' IN DIRT. N87°38'12"E 0.32' FROM POINT IN EASTERLY LINE OF O.C.F.D.C. R/W, NOT ACCEPTED.
- 14

FOUND 2 INCH IP WITH TAG STAMPED "R.C.E. 18752" NO REF, DOWN 0.50' IN DIRT. S89°01'19"E 0.15' FROM INTERSECTION OF NORTHERLY O.C.F.D.C R/W AND WESTERLY ANITA DR. R/W, NOT ACCEPTED.
- 15

FOUND GEAR SPIKE AND 1 1/2 INCH WASHER STAMPED "LS 5411" PER R17, FLUSH IN A.C. ACCEPTED AS POINT ON CENTERLINE ANITA DR.
- 16

FOUND 2 INCH IP WITH TAG STAMPED "R.C.E. 14456" PER R18, DOWN 0.25' IN DIRT. ACCEPTED AS INTERSECTION OF SOUTHEASTERLY O.C.F.D.C R/W AND WESTERLY ANITA DR. R/W PER R18.
- 17

FOUND 2 INCH IP WITH TAG STAMPED "R.C.E. 14456" PER R18, DOWN 0.20' IN DIRT. ACCEPTED AS EC SOUTHEASTERLY O.C.F.D.C R/W PER R18.
- 18

FOUND 2 INCH IP WITH 1 1/2 INCH OCS TAG PER R1, DOWN 0.45' IN DIRT. ACCEPTED AS BC OF EASTERLY O.C.F.C.D. R/W PER R1.
- 19

FOUND 1 INCH IRON PIPE WITH 3/4 INCH BRASS TAG STAMPED "PLS 7566" PER R2, DOWN 0.30' IN DIRT. DISTURBED N44°59'38"W 0.24", NOT ACCEPTED.
- 20

FOUND 2 INCH IRON PIPE WITH 1 1/4 INCH BRASS TAG STAMPED "ORANGE COUNTY SURVEYOR RCE 6978" PER R11, DOWN 0.60' IN DIRT. ACCEPTED AS THE SOUTHEAST CORNER OF PARCEL 1 OF R11.
- 21

FD 1 INCH IP WITH PLASTIC CAP STAMPED "CAL TRANS" PER R10, DOWN 0.50' IN DIRT. N50°01'15"E 0.05', NOT ACCEPTED.
- 22

FOUND LEAD WITH BRASS PIN WITH 3/4 INCH BRASS TAG STAMPED "CALTRANS LS 5134" PER R10, FLUSH IN CONCRETE. ACCEPTED AS INTERSECTION OF WESTERLY O.C.F.C.D. R/W AND SOUTH LINE OF PARCEL 200497-1 PER INST. NO. 19980593748 O.R.
- 23

FOUND 2 INCH IRON PIPE WITH 3/4 INCH BRASS TAG STAMPED "CALTRANS LS 5134" PER R10, DOWN 0.3' IN DIRT. ACCEPTED AS INTERSECTION OF WESTERLY O.C.F.C.D. R/W AND SOUTH LINE OF PARCEL 200875-4 PER INST. NO. 19980593748 O.R.
- 24

FOUND LEAD WITH PIN HOLE FLUSH IN CONCRETE RIP RAP. ACCEPTED AS LEAD AND TACK WITH 1 1/2 INCH OCS TAG PER R1 ACCEPTED AS THE SOUTHWESTERLY CORNER PARCEL 200875-4 PER INST. NO. 19980593748 O.R.
- 25

FOUND 1 1/4 INCH OCS TAG WITH BRASS PIN IN HEADWALL PER R1, FLUSH IN CONCRETE. ACCEPTED AS SOUTHWESTERLY CORNER ENTRY PARCEL R1601 AS SHOWN ON R1.
- 26

FOUND 2 INCH IRON PIPE WITH 3/4 INCH BRASS TAG STAMPED "ORANGE COUNTY SURVEYOR" PER R1, DOWN 1.6' IN DIRT. ACCEPTED AS SOUTHEASTERLY CORNER ENTRY PARCEL R1601 AS SHOWN ON R1.
- 27

FOUND 2 INCH IRON PIPE WITH 1 1/4 INCH BRASS TAG STAMPED "ORANGE COUNTY SURVEYOR RCE 7872" PER R19, DOWN 2.0' IN DIRT. ACCEPTED AS BC IN EASTERLY O.C.F.C.D. R/W PER 965/226 O.R.
- 28

FOUND 2 INCH IRON PIPE WITH 1 1/4 INCH BRASS TAG STAMPED "ORANGE COUNTY SURVEYOR" PER R1, FLUSH IN DIRT. ACCEPTED AS THE INTERSECTION OF THE EASTERLY O.C.F.C.D. R/W AND THE WESTERLY LINE OF PARCEL DESCRIBED BY 98/418 O.R.
- 29

FOUND 2 INCH IRON PIPE WITH 1 1/4 INCH BRASS TAG STAMPED "ORANGE COUNTY SURVEYOR" PER R1, DOWN 0.6' IN DIRT. S5°33'28"W 0.15' HELD FOR EASTERLY LINE OF O.C.F.C.D. R/W PER R1.
- 30

FOUND 2 INCH IRON PIPE WITH 1 1/4 INCH BRASS TAG STAMPED "ORANGE COUNTY SURVEYOR" PER R1, DOWN 1.0' IN DIRT. ACCEPTED AS INTERSECTION OF EASTERLY O.C.F.C.D. R/W AND WESTERLY LINE OF LOT 29 PER R20.
- 31

FOUND 2 INCH IRON PIPE WITH 1 1/4 INCH BRASS TAG STAMPED "ORANGE COUNTY SURVEYOR" PER R1, FLUSH IN DIRT. S27°57'25"E 5.18' FROM A POINT IN THE E'LY O.C.F.D.C. R/W, NOT ACCEPTED.
- 32

FOUND 2 INCH IRON PIPE WITH STEEL NAIL PER R1, DOWN 1.3' IN DIRT. ACCEPTED AS THE SOUTH CORNER OF LOT 29 OF R20, ALSO ACCEPTED AS PROLONGATION OF THE SOUTH LINE OF R3.
- 33

FOUND 2 INCH IRON PIPE WITH A SCREW AND 1 1/4 INCH BRASS WASHER NOT STAMPED, NO REF, DOWN 1.00' IN DIRT. ACCEPTED AS POINT IN THE S'LY LINE OF R3 AS SHOWN ON R1.
- 34

FOUND LEAD AND BRASS NAIL WITH 3/4 INCH BRASS TAG STAMPED "TIE POINT PLS 6343" PER R12, FLUSH IN CONCRETE.
- 35

FOUND LEAD AND BRASS NAIL WITH 3/4 INCH BRASS TAG STAMPED "TIE POINT PLS 6343" PER R12, FLUSH IN CONCRETE.
- 36

FOUND LEAD AND BRASS NAIL WITH 3/4 INCH BRASS TAG STAMPED "TIE POINT PLS 6343" PER R12, FLUSH IN CONCRETE.
- 37

FOUND LEAD AND BRASS NAIL WITH 3/4 INCH BRASS TAG STAMPED "TIE POINT PLS 6343" PER R12, FLUSH IN CONCRETE.
- 39

FOUND 1 INCH IRON PIPE WITH STEEL NAIL ACCEPTED AS 1 INCH IP & TAG "RCE 3795", PER R6, DOWN 0.5' IN CONCRETE. N89°08'33"W 0.12' HELD FOR THE W'LY PROLONGATION OF THE S'LY LINE OF R3.
- 40

FOUND 3/4 INCH HEX BAR WITH 3/4 INCH BRASS TAG STAMPED "RCE 16556" PER R22, DOWN 1.70' IN WELL MONUMENT ACCEPTED AS CENTERLINE BC THE CITY DRIVE.
- 41

FOUND 3/4 INCH IRON PIPE WITH BRASS NAIL AND NO TAG PER R3, DOWN 1.60' IN DIRT. BENT S4°07'46"E 0.43' NOT ACCEPTED AS NORTHWEST CORNER LOT 35 PER R3.
- 42

FOUND 3/4 INCH HEX BAR WITH 3/4 INCH BRASS TAG STAMPED "RCE 16556" PER R23, DOWN 1.90' IN WELL MONUMENT ACCEPTED AS BC CENTERLINE OF THE CITY DRIVE.
- 43

FOUND PUNCHED SPIKE, NO REF, DOWN 0.25' IN ASPHALT. ACCEPTED AS POINT ON CENTERLINE OF THE CITY DRIVE.
- 44

FOUND SPIKE AND WASHER STAMPED "RCE 6978", PER R11, DOWN 0.30' IN A.C. ACCEPTED AS THE INTERSECTION OF THE CENTERLINE OF THE CITY DRIVE AND THE W'LY PROLONGATION OF THE S'LY LINE OF R11.
- 45

FOUND LEAD AND BRASS PIN ACCEPTED AS LEAD & TAG LS 7566 PER R2, FLUSH IN CONCRETE. HELD AS THE SOUTHWEST CORNER PARCEL 1 OF R2.
- 46

FOUND LEAD WITH PIN HOLE ACCEPTED AS LEAD & TAG 7566 PER R2, FLUSH IN CONCRETE. HELD AS PRC IN W'LY LINE OF PARCEL 1 OF R2.
- 47

FOUND 3/4 INCH BRASS TAG STAMPED "PLS 7566" PER R2, FLUSH WITH THE TOP OF CURB ACCEPTED AS WITNESS CORNER 18.00' N00°40'36"E.
- 48

FOUND 1 INCH IRON PIPE WITH 3/4 INCH BRASS TAG STAMPED "PLS 7566" PER R2, UP 0.35' IN DIRT. ACCEPTED AS POINT IN S'LY LINE OF PARCEL 1 OF R2.
- 49

FOUND LEAD AND BRASS PIN WITH 3/4 INCH BRASS TAG STAMPED PLS 7566 PER R2, FLUSH IN ROCK. ACCEPTED AS POINT IN S'LY LINE OF PARCEL 1 OF R2.
- 50

FOUND 1 INCH IRON PIPE WITH 3/4 INCH BRASS TAG STAMPED "PLS 7566" PER R2, UP 0.20' IN DIRT. ACCEPTED AS POINT IN S'LY LINE OF PARCEL 1 OF R2.
- 51

FOUND PUNCHED BOAT SPIKE WITH 1 1/2 INCH STEEL WASHER STAMPED "CAL TRANS" PER R2, DOWN 0.1' IN A.C. N89°28'37"E 0.05', NOT ACCEPTED.
- 52

FOUND GEAR SPIKE WITH 1 1/2 INCH STAINLESS STEEL WASHER STAMPED "LS 5411" PER R24, FLUSH IN A.C. ACCEPTED AS THE CENTERLINE INTERSECTION OF THE CITY DRIVE WITH THE N'LY LINE OF LOT 14 OF R3.
- 53

FOUND LEAD BRASS PIN WITH 3/4 INCH BRASS TAG STAMPED "CAL TRANS" NO REF, FLUSH IN CONCRETE. ACCEPTED AS CENTERLINE EC CHAPMAN AVE. AS SHOWN ON R10.
- 54

FOUND 1 INCH IRON PIPE WITH 3/4 INCH BRASS TAG STAMPED "PLS 7566" PER R25, FLUSH IN DIRT. ACCEPTED AS N'LY CORNER OF DEED 2003000294173 O.R. AS SHOWN ON R25.
- 55

FOUND BOAT SPIKE WITH 1 1/2" STEEL WASHER STAMPED "PLS 6343" NO REF, FLUSH IN A.C. ACCEPTED AS THE NE CORNER OF PARCEL 102303-1 PER R85.
- 56

FOUND LEAD AND TACK WITH 3/4" BRASS TAG STAMPED "PLS 6343" FLUSH IN CONCRETE. NO REF. ACCEPTED AS THE NORTHWEST CORNER PARCEL 102303-1 PER R85.
- 57

FOUND 1" IRON PIPE WITH 3/4" BRASS TAG STAMPED "RCE 3795" PER R6, DOWN 0.20' IN DIRT. ACCEPTED AS POINT IN SE'LY CORNER OF PARCEL 1 OF R6.
- 58

FOUND 2" OPEN IRON PIPE. DOWN 0.40' IN DIRT. ACCEPTED AS 2" IRON PIPE WITH TAG STAMPED "LS 3246" PER R31, ALSO ACCEPTED AS SE'LY CORNER OF PARCEL 1 OF R81.
- 59

FOUND 2" IRON PIPE WITH 1-1/4" BRASS TAG STAMPED "OCS", DOWN 1.20' IN DIRT. NO REF. ACCEPTED AS A POINT ALONG THE E'LY BOUNDARY OF PARCEL 1 PER R41
- 60

FOUND 2" IRON PIPE WITH TACK AND ILLEGIBLE 3/4" BRASS TAG, DOWN 0.30' IN DIRT. ACCEPTED AS POINT ON RADIAL LINE, N68°05'08"E 0.23' FROM THE E'LY BC RIGHT OF WAY ALONG THE CITY DRIVE AS SHOWN ON R31.

ESTABLISHMENT NOTES

- A

ESTABLISHED THE CENTERLINE OF THE O.C.F.C.D. R/W BY HOLDING RECORD ANGLE PER R8 SW'LY FROM THE CENTERLINE OF CHAPMAN AVENUE ALONG MONUMENT NOTE **[6]**.
- B

ESTABLISHED THE CENTERLINE BC OF THE O.C.F.D.C R/W ALONG LINE ESTABLISHMENT **[4]** HOLDING 875.81' PER R8 FROM MONUMENT NOTE **[6]**.
- C

ESTABLISHED THE CENTERLINE OF O.C.F.C.D. R/W HOLDING A RECORD RADIUS OF 1000.00' PER R8, TANGENT TO LINE ESTABLISHMENT **[4]**.
- D

ESTABLISHED THE SOUTHERLY LINE OF THE DAWN TRACT OF R3 AND THE N'LY LINE OF LOT 28 OF R20 BETWEEN MONUMENT NOTES **[32]** AND **[39]**.
- E

SFN, ESTABLISHED THE SE'LY CORNER OF LOT 35 OF R3 ALONG LINE ESTABLISHMENT NOTE **[4]** HOLDING RECORD DISTANCE OF 845.12' PER R1 W'LY FROM MONUMENT NOTE **[32]**
- F

ESTABLISHED THE CENTERLINE OF THE O.C.F.C.D. R/W ON LINE ESTABLISHMENT **[4]** HOLDING A RECORD DISTANCE OF 343.57' PER R8 E'LY FROM CORNER ESTABLISHMENT NOTE **[4]**.
- G

ESTABLISHED THE CENTERLINE OF THE O.C.F.C.D. R/W TANGENT TO CURVE ESTABLISHMENT **[4]**.
- H

ESTABLISHED THE CENTERLINE OF THE O.C.F.C.D. R/W HOLDING A RECORD RADIUS OF 2000.00' PER R8, TANGENT TO LINE ESTABLISHMENT **[4]**.
- I

ESTABLISHED THE CENTERLINE O.C.F.C.D. R/W FROM ESTABLISHMENT NOTE **[4]** AND TANGENT TO CURVE ESTABLISHMENT **[4]**.
- J

ESTABLISHED THE O.C.F.C.D. R/W 300.00' W'LY OF CENTERLINE PER R8.
- K

ESTABLISHED THE O.C.F.C.D. R/W 315.00' W'LY OF CENTERLINE PER R8.
- L

ESTABLISHED THE O.C.F.C.D. R/W 300.00' E'LY OF CENTERLINE PER R8.
- M

ESTABLISHED THE O.C.F.C.D. R/W 315.00' E'LY OF CENTERLINE PER R8.
- N

SFN, ESTABLISHED POINT ON THE SW'LY LINE OF THE S.P.R.R. RAILROAD R/W BY HOLDING A RECORD DISTANCE OF 1419.66' E'LY FROM MONUMENT NOTE **[32]** AND RECORD ANGLE 49°04'02" PER R1 PASSING THROUGH MONUMENT NOTE **[20]**.
- O

ESTABLISHED THE SW'LY S.P.R.R. R/W BETWEEN MONUMENT NOTE **[20]** AND ESTABLISHMENT NOTE **[4]**.
- P

SFN, ESTABLISHED POINT IN S'LY LINE OF PCL. 200875-4 BY HOLDING RECORD ANGLE AND DISTANCE PER R10.
- Q

SFN, ESTABLISHED THE INTERSECTION OF S'LY LINE OF PCL. 200875-4 OF INST. NO. 1998059374 O.R. WITH THE S'LY LINE OF **[23]** HOLDING RECORD 62.40' PER INST. NO. 1998059374 O.R. FROM MONUMENT NOTE **[24]** ALONG A LINE BETWEEN MONUMENT NOTE **[24]** AND ESTABLISHMENT NOTE **[4]**.
- R

SFN, ESTABLISHED THE MOST E'LY CORNER OF LOT 27 OF R3 21.35' NW'LY ALONG LINE ESTABLISHMENT **[4]** FROM ESTABLISHMENT NOTE **[4]**.
- S

ESTABLISHED THE NE'LY LINE OF R3 ALSO THE SW'LY S.P.R.R. RAILROAD R/W BETWEEN ESTABLISHMENT NOTE **[4]** AND MONUMENT NOTE **[20]**.
- T

ESTABLISHED THE CENTERLINE S.P.R.R. RAILROAD R/W BY HOLDING A LINE PARRELELL WITH & A RECORD DISTANCE OF 50.00' PER R3 NE'LY OF LINE ESTABLISHMENTS **[4]** AND **[5]**.
- U

ESTABLISHED INTERSECTION OF NON-TANGENT CURVE CONCAVE NORTH RECORD RADIUS 5161.75', AND RECORD DELTA 3°38'57" PER R28 BETWEEN MONUMENT NOTE **[22]** AND LINE ESTABLISHMENT **[5]**.
- V

ESTABLISHED THE NE'LY LINE LOT 13 OF R3 BETWEEN ESTABLISHMENT NOTE **[4]** AND MONUMENT NOTE **[20]**.
- W

ESTABLISHED BY INTERSECTION OF LINE ESTABLISHMENT **[4]** AND THE W'LY PROLONGATION OF A LINE BETWEEN MONUMENT **[1]** & **[6]**.
- X

SFN, ESTABLISHED BY TIES PER R12.
- Y

ESTABLISHED THE CENTERLINE OF THE CITY DRIVE BETWEEN ESTABLISHMENT NOTE **[4]** AND MONUMENT NOTE **[40]**.
- Z

ESTABLISHED CL OLD PLACENTIA AVE. ALSO BEING THE W'LY LINE LOTS 35, 29, 26, 14 AND 12 PER R3 10.00' EAST PARALLEL WITH LINE ESTABLISHMENT **[4]**.
- AA

ESTABLISHED THE INTERSECTION OF CL OLD PLACENTIA DR. AND CL OLD CHAPMAN AVE ALSO BEING THE NE'LY CORNER LOT 12 OF R3 HOLDING RECORD ANGLE 89°52' PER R3 FROM LINE ESTABLISHMENT **[4]** PASSING THROUGH MONUMENT NOTE **[52]**.
- AB

ESTABLISHED THE NORTHEAST CORNER OF LOT 12 OF R3 BY INTERSECTION OF LINE ESTABLISHMENT **[4]** AND NW'LY PROLONGATION LINE ESTABLISHMENT **[5]**.
- AC

ESTABLISHED THE CENTERLINE OF THE CITY DRIVE BETWEEN MONUMENT NOTES **[52]** AND **[43]**.
- AD

ESTABLISHED THE CENTERLINE OF THE CITY DRIVE TANGENT TO LINE ESTABLISHMENT **[4]** HOLDING RECORD RADIUS 1000.00' PER R27 TO MONUMENT **[42]**.
- AE

ESTABLISHED THE SOUTHWEST CORNER OF LOT 35 OF R3 BY INTERSECTION OF ESTABLISHMENT **[4]** WITH THE W'LY PROLONGATION OF ESTABLISHMENT **[4]**.
- AF

ESTABLISHED BY PROPORTION ALONG LINE ESTABLISHMENT NOTE **[4]** PER R3 BETWEEN LINE ESTABLISHMENTS **[4]** AND **[4]**.
- AG

ESTABLISHED THE E'LY R/W OF THE CITY DRIVE RECORD 60.00' CONCENTRIC WITH CURVE ESTABLISHMENT **[4]** PER INST. NO. 98-314755 O.R.
- AH

ESTABLISHED THE S'LY LINE OF LOT 29 AND A PORTION OF LOT 28 OF R3 BY PROPORTION BETWEEN LINE ESTABLISHMENTS **[4]** AND **[4]** AND HOLDING RECORD ANGLE PER R3 FROM ESTABLISHMENT NOTE **[4]**.
- AI

ESTABLISHED A POINT IN THE S'LY LINE OF PARCEL 1 PER R2 BY HOLDING OFFSET MONUMENT **[47]** PER R2.
- AJ

ESTABLISHED THE INTERSECTION OF LINE ESTABLISHMENT **[4]** WITH THE S'LY LINE OF R11.
- AK

ESTABLISHED A POINT IN THE S'LY LINE OF PARCEL 1 OF R11 BY GRANT BOUNDARY ADJUSTMENT BETWEEN CORNER ESTABLISHMENT NOTE **[4]** AND MONUMENT NOTE **[48]**.
- AL

ESTABLISHED POINT IN THE S'LY LINE OF PARCEL 1 OF R11 BY GRANT BOUNDARY ADJUSTMENT BETWEEN MONUMENT NOTES **[50]** AND **[20]**.
- AM

ESTABLISHED POINT IN THE S'LY LINE OF PARCEL 1 OF R11 BY GRANT BOUNDARY ADJUSTMENT BETWEEN MONUMENT NOTES **[50]** AND **[20]**.
- AN

ESTABLISHED PI OF CENTERLINE CHAPMAN AVE. BY HOLDING 891.07' PER R10 W'LY FROM MONUMENT NOTE **[2]** ALONG A LINE BETWEEN MONUMENT NOTE **[2]** AND ESTABLISHMENT NOTE **[4]**.
- AO

ESTABLISHED THE CENTERLINE OF CHAPMAN AVE HOLDING RECORD DELTA 54°39'55" AND RECORD RADIUS 1000.00' PER R10 FROM MONUMENT NOTE **[53]** AND TANGENT TO A LINE PASSING THROUGH ESTABLISHMENT NOTE **[4]**.
- AP

ESTABLISHED THE NORTH LINE OF LOT 11 OF R3 BETWEEN MONUMENT NOTE **[52]** AND ESTABLISHMENT NOTE **[4]**.
- AQ


ESTABLISHED THE CL OF THE CITY DRIVE TANGENT TO LINE ESTABLISHMENT **[4]**.
- AR

ESTABLISHED THE CL OF THE CITY DRIVE BY HOLDING RECORD RADIUS 1000.00' PER R27 TANGENT BETWEEN LINE ESTABLISHMENTS **[4]** AND **[4]**.
- AS

ESTABLISHED THE NE'LY LINE OF PARCEL DD200537-01-01 PER INST. NO. 2003000425637 O.R., RECORD OF SURVEY RSB 2003-1051 BY LEAST SQUARES ADJUSTMENT BETWEEN MONUMENT NOTES **[20]** AND **[54]**.
- AT

ESTABLISHED THE CENTERLINE OF CHAPMAN AVE HOLDING RECORD RADIUS 1000.00' PER R10 TANGENT TO ESTABLISHMENT **[4]** AND TANGENT TO A LINE BETWEEN MONUMENT NOTES **[1]** AND **[6]**.
- AU

ESTABLISHED THE INTERSECTION OF THE E'LY O.C.F.C.D. R/W WITH THE S'LY U.P.R.R. R/W BY HOLDING A LINE TANGENT TO A CURVE ESTABLISHED BETWEEN MONUMENT NOTES **[27]** AND **[28]**.

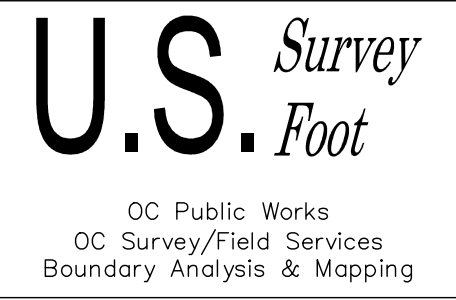

| | | | | |
|-----------|------|---|--------------------------|--------------------------------|
| | | COUNTY OF ORANGE OC PUBLIC WORKS OC SURVEY/FIELD SERVICES/BOUNDARY ANALYSIS & MAPPING | | |
| | | COUNTY OF ORANGE ANIMAL SHELTER ALTANSPS SURVEY | | |
| | | BOUNDARY MAP | | |
| | | PROJECT LIMITS: BETWEEN THE 22 FREEWAY AND THEO LACY FACILITY | | |
| MARK | DATE | DATE OF SURVEY: MARCH 2024 | BY: T. LOFGREEN AND CREW | SHEET NO. 3 of 14 |
| | | MAPPING | BY: T. LOFGREEN | |
| | | OFFICE CHECK | BY: E. MEDINA, PLS | |
| | | FIELD CHECK | BY: T. LOFGREEN | |
| | | SCALE: N.T.S. | W.O. #EC29962 | |
| REVISIONS | | FILE # 2324PW-RE0003 | | |
| | | FILE: Animal Shelter Boundary_2024.DWG | | |

ESTABLISHMENT NOTES

- 

ESTABLISHED THE E'LY LINE OF PARCEL 2 OF R6 BY PROLONGATION OF ESTABLISHMENT [E2](#) SOUTHERLY FROM MONUMENT [57](#) AT RECORD DISTANCE OF 117.46' PER R6
- 

ESTABLISHED THE S'LY LINE OF R63 BY HOLDING A LINE PARALLEL WITH ESTABLISHMENT [C1](#) SOUTHERLY 248.00' FROM ESTABLISHMENT [E2](#)
- 

ESTABLISHED THE W'LY O.C.F.C.D. R/W BY HOLDING A LINE BETWEEN ESTABLISHMENT [C1](#) AND MONUMENT [58](#)
- 

ESTABLISHED THE SE'LY LINE OF PARCEL 102303-1 OF R85 HOLDING A RECORD DISTANCE OF 61.04' PER R85 ALONG THE SW'LY PROLONGATION OF LINE [E2](#) ESTABLISHMENT [58](#) FROM MONUMENT
- 

ESTABLISHED THE N'LY LINE OF PARCEL 1 OF R81 BY HOLDING A LINE PARALLEL WITH AND DISTANT 295.00' PER R81 N'LY OF ESTABLISHMENT [E2](#)
- 

ESTABLISHED THE E'LY LINE OF PARCEL 1118-10.01 OF R63 BY HOLDING RECORD ANGLE AND DISTANCE PER R63 SOUTHERLY FROM ESTABLISHMENT [E2](#)
- 

ESTABLISHED THE SE'LY LINE OF PARCEL 102303-1 OF R85 BY HOLDING RECORD A DISTANCE OF 0.64' PER R85 ALONG ESTABLISHMENT [E2](#)
- 

ESTABLISHED THE NE'LY CORNER OF PARCEL 1118-10.01 OF R63 BY HOLDING RECORD DISTANCE OF 283.00' PER R63 EASTERLY FROM ESTABLISHMENT [E2](#) ALONG ESTABLISHMENT [C1](#)
- 

ESTABLISHED THE E'LY LINE OF PARCEL 1 PER R81 BY HOLDING A LINE BETWEEN THE S'LY TERMINUS OF ESTABLISHMENT [E2](#) AND MONUMENT [58](#)
- 

ESTABLISHED THE E'LY LINE OF PARCEL 1 PER R6 BY PROLONGATION OF ESTABLISHMENT NOTE [E2](#) SE'LY TO THE INTERSECTION OF ESTABLISHMENT NOTE [E2](#)
- 

ESTABLISHED THE TIE LINE FOR THE SW'LY CORNER OF PARCEL 3 OF R81 BY HOLDING RECORD DELTA AND RADIUS PER R5 SOUTHERLY ALONG ESTABLISHMENT [E2](#)
- 

ESTABLISHED A PORTION OF THE NORTHERLY LINE OF THE SE 1/4 OF THE SE 1/4 OF SECTION 35 T4S R10W BY HOLDING A LINE BETWEEN ESTABLISHMENT [E2](#) AND MONUMENT [59](#)
- 

ESTABLISHED THE N'LY LINE OF PARCEL 102303-1 PER R85 BY HOLDING A LINE BETWEEN MONUMENTS [58](#) AND [58](#)
- 

ESTABLISHED THE S'LY LINE OF PARCEL 1 PER R81 BY HOLDING A LINE BETWEEN ESTABLISHMENT [E2](#) AND MONUMENT [58](#)
- 

ESTABLISHED THE TIE LINE FOR THE SW'LY CORNER OF PARCEL 1 OF R81 BY HOLDING RECORD DELTA AND RADIUS PER R81 S'LY ALONG ESTABLISHMENT [E2](#)
- 

ESTABLISHED THE NE'LY LINE OF PARCEL 1 OF R87 HOLDING RECORD ANGLES AND DISTANCES PER R87
- 

ESTABLISHED THE NE'LY LINE OF PARCEL 1 OF R87 HOLDING RECORD ANGLES AND DISTANCES PER R87
- 

ESTABLISHED THE N'LY LINE OF R92 HOLDING A LINE PARALLEL WITH ESTABLISHMENT [C1](#) W'LY FROM MONUMENT [57](#)
- 

ESTABLISHED THE E'LY LINE OF R91 BY HOLDING A LINE PARALLEL WITH ESTABLISHMENT [E2](#)
- 

ESTABLISHED THE W'LY LINE OF R91 BY HOLDING RECORD DISTANCE OF 130.58' PER R6 ALONG THE E'LY R/W OF CITY DRIVE S'LY FROM MONUMENT [39](#)
- 

ESTABLISHED THE W'LY LINE OF PARCEL DESCRIBED 1 PER R87 BY HOLDING A LINE BETWEEN THE S'LY TERMINUS OF ESTABLISHMENT [E2](#) AND THE W'LY TERMINUS OF ESTABLISHMENT [E2](#)
- 

ESTABLISHED PORTIONS OF PROPOSED PARCEL GA-1118-152 BY HOLDING COURSES PARALLEL AND CONCENTRIC WITH TOPOGRAPHIC FEATURES AS SHOWN ON SHEET 7 BETWEEN ESTABLISHMENT NOTE [E2](#) AND MONUMENT [57](#)
- 

ESTABLISHED THE CENTERLINE BC OF THE CITY DRIVE AT RECORD DISTANCE OF 374.91' PER R41 N'LY FROM ESTABLISHMENT [C1](#) ALONG ESTABLISHMENT NOTE [C1](#)
- 

ESTABLISHED THE CENTERLINE OF THE CITY DRIVE HOLDING A RECORD RADIUS OF 2000.00' PER R79 TANGENT TO LINE ESTABLISHMENT [C1](#)
- 

ESTABLISHED THE POINT OF COMMENCEMENT FOR PROPOSED PARCEL GA-1118-152 AT A POINT PERPENDICULAR TO LINE ESTABLISHMENT [C1](#) FROM MONUMENT [40](#) AT THE E'LY R/W OF THE CITY DRIVE PER R27
- 

ESTABLISHED THE SW CORNER OF THE PROPOSED R/W OF THE CITY DRIVE AS SHOWN BY R98 HOLDING A RECORD DISTANCE OF 106.57' PER R98 W'LY FROM MONUMENT NOTE [58](#)
- 

ESTABLISHED THE PROPOSED R/W OF THE CITY DRIVE AS SHOWN BY R98 HOLDING A RECORD DISTANCE OF 106.57' PER R98 N'LY FROM ESTABLISHMENT [E2](#)
- 

ESTABLISHED THE SW'LY, AND S'LY LINES OF PROPOSED R/W OF METROPOLITAN AVENUE AS SHOWN ON R98 BY RECORD ANGLES AND DISTANCES PER R98 FROM ESTABLISHMENT [E2](#)
- 

ESTABLISHED THE NE CORNER OF PARCEL 12302-1 OF R93 BY PROLONGATION OF LINE ESTABLISHMENT [C1](#) A DISTANCE OF 77.01' PER R93 FROM ESTABLISHMENT [E2](#)
- 

ESTABLISHED THE N'LY LINES OF PARCEL 102302-1 OF R93 BY HOLDING RECORD ANGLES AND DISTANCES PER R93 FROM ESTABLISHMENT [E2](#)
- 

ESTABLISHED THE W'LY R/W OF CITY DRIVE BY HOLDING A LINE PARALLEL AND RECORD A DISTANCE OF 82.00' W'LY PER R97 FROM LINE ESTABLISHMENT [C1](#)

NOTES

ALL BOUNDARY LINES NOT SHOWN IN BOLD ARE FOR GRAPHICAL REPRESENTATION ONLY.

RECORD DISTANCES SHOWN HEREON ARE AS THEY APPEAR ON THE DOCUMENT OF RECORD. DISTANCES MAY BE EITHER GRID OR GROUND, AS PER SAID RECORD.

REFERENCE DOCUMENTS IN THE REFERENCE LEGEND ARE LIVE HYPERLINKS TO SAID DOCUMENT.

EASEMENT NOTES 40 THROUGH 44 INCLUSIVE ARE SHOWN AND REFERENCED FROM PTR #00197617-994-LTR-ITW DATED 8-10-23

| LINE TABLE | | | |
|------------|-------------|-------------------|-----------------|
| LINE # | BEARING | MEASURED DISTANCE | RECORD DISTANCE |
| L1 | N48°08'34"E | 42.19' | 42.19' R11 |
| L2 | N48°08'35"E | 20.03' | 20.01' R10 |
| L3 | N39°58'46"W | 35.82' | 35.83' R1 |
| L4 | N39°58'46"W | 105.93' | 105.93' R1 |
| L5 | N89°04'48"W | 142.52' | 142.52' C R10 |
| L6 | N89°04'48"W | 157.48' | N/A |
| L7 | N89°04'48"W | 39.14' | 39.13' R1 |
| L8 | N89°04'48"W | 294.43' | NO REF |
| L9 | N89°04'48"W | 17.58' | 17.60' R13 |
| L10 | N89°04'48"W | 80.52' | 80.48' R1 |
| L11 | N89°03'23"W | 92.99' | 93.02' R1 |
| L12 | N01°22'48"E | 6.51' | 6.48' R1 |
| L13 | N47°00'14"W | 106.02' | 105.99' R10 |
| L14 | N46°57'52"E | 27.09' | 26.96' R1 |
| L15 | N37°34'24"W | 63.33' | 63.32' R10 |
| L16 | N89°13'09"W | 134.95' | 135.00' R10 |
| L17 | N89°13'09"W | 62.40' | 62.40' R10 |
| L18 | N29°01'05"E | 147.61' | 147.60' R10 |
| L19 | N39°59'27"W | 23.74' | 23.76' R1 |
| L20 | N39°59'27"W | 94.86' | 95.00' R1 |
| L21 | N52°45'24"E | 240.28' | 240.28' R1 |
| L22 | N40°57'14"E | 307.50' | 304.47' R1 |
| L23 | N39°58'46"W | 32.63' | 32.49' R1 |
| L24 | N39°58'47"W | 21.35' | 21.35' R1 |
| L25 | N05°33'26"E | 4.72' | 4.87' R1 |
| L26 | N65°36'43"W | 15.00' | N/A |
| L27 | N34°13'38"E | 30.90' | 30.87' R1 |
| L28 | N39°58'46"W | 72.75' | 72.75' R1 |
| L29 | N34°13'38"E | 50.70' | 50.67' R1 |
| L30 | N39°58'46"W | 17.99' | 18.00' R1 |
| L31 | N40°57'14"E | 64.46' | 64.44' R1 |
| L32 | N46°57'52"E | 27.22' | 29.19' R8 |
| L33 | N65°36'42"W | 15.00' | N/A |
| L34 | N89°08'33"W | 60.00' | N/A |
| L39 | N00°40'36"E | 70.73' | 70.53' R4 |
| L40 | N00°40'36"E | 105.51' | 105.44' R4 |
| L41 | N89°19'26"W | 62.01' | 61.99' R2 |
| L42 | N66°58'04"E | 35.12' | 35.14' R11 |
| L43 | N53°12'22"E | 49.87' | 49.90' R11 |
| L44 | N89°24'08"W | 48.12' | 48.25' R11 |
| L45 | N60°04'25"W | 25.99' | 26.00' R11 |
| L46 | N44°11'35"W | 31.48' | 31.45' R11 |
| L47 | N50°13'36"W | 57.10' | 57.07' R11 |
| L48 | N50°12'44"W | 36.52' | 36.49' R11 |
| L49 | N43°16'33"W | 45.99' | 45.96' R11 |
| L50 | N70°05'08"W | 18.63' | 18.70' R11 |
| L51 | N16°04'48"W | 79.96' | 77.05' R11 |
| L52 | N89°04'57"W | 198.52' | 198.52' C R10 |
| L53 | N78°07'12"W | 214.62' | ----- |
| L54 | N00°44'13"E | 18.03' | ----- |
| L55 | N11°57'39"W | 18.57' | 18.47' R6 |
| L56 | N05°03'29"W | 100.00' | 100.00' R6 |
| L57 | N24°24'34"E | 61.04' | 61.04' R85 |
| L58 | N89°08'33"W | 11.26' | ----- |
| L60 | N89°08'33"W | 1.25' | ----- |
| L61 | N89°08'33"W | 15.92' | 15.85' R6 |
| L62 | N89°08'33"W | 80.50' | ----- |
| L63 | N88°51'34"W | 10.04' | 10.04' R87 |
| L64 | N06°50'52"E | 2.54' | ----- |
| L65 | N89°14'20"W | 41.26' | ----- |
| L66 | N00°49'58"E | 23.03' | ----- |
| L67 | N88°05'06"W | 11.82' | ----- |
| L68 | N00°40'53"E | 24.62' | ----- |
| L69 | N89°12'50"W | 6.32' | ----- |
| L70 | N67°30'39"E | 1.16' | ----- |
| L71 | N00°40'53"E | 45.00' | ----- |
| L72 | N89°19'07"W | 60.00' | ----- |
| L73 | N00°44'13"E | 152.62' | ----- |
| L76 | N68°05'05"W | 49.79' | ----- |
| L78 | N75°22'22"W | 50.00' | 50.00' R5 |
| L79 | N21°54'56"E | 374.90' | 374.91' R41 |
| L80 | N00°40'53"E | 374.90' | 374.91' R41 |
| L81 | N70°36'40"W | 50.00' | 50.00' R5 |
| L84 | N89°23'11"W | 13.20' | 13.05' R41 |
| L85 | N88°51'34"W | 143.69' | 143.64' R84 |
| L86 | N24°23'18"E | 57.48' | ----- |
| L87 | N89°08'33"W | 143.97' | ----- |
| L88 | N24°24'34"E | 62.84' | ----- |
| L89 | N88°19'38"W | 126.00' | ----- |
| L90 | N87°22'20"W | 17.01' | ----- |
| L91 | N24°24'34"E | 58.93' | 59.99' R85 |
| L92 | N88°19'38"W | 8.04' | ----- |
| L93 | N88°19'38"W | 106.14' | 106.14' R98 |
| L94 | N88°19'38"W | 50.07' | 50.07' R98 |
| L95 | N88°19'38"W | 56.07' | 56.08' R98 |
| L96 | N01°20'06"E | 106.57' | 106.57' R98 |
| L97 | N45°57'19"W | 41.91' | 41.91' R98 |
| L98 | N89°33'20"E | 177.73' | 177.73' R98 |
| L99 | N89°33'21"E | 147.56' | 147.56' R93 |
| L100 | N36°06'46"E | 66.31' | 66.31' R93 |
| L101 | N89°08'33"W | 2.01' | 2.37' R96 |
| L102 | N89°08'37"W | 77.01' | 77.01' R100 |
| L103 | N89°08'33"W | 17.00' | 17.00' R93 |

| CURVE TABLE | | | | | | |
|-------------|-----------|----------|---------|--------------------|-------------------|------------------|
| CURVE # | DELTA | RADIUS | LENGTH | RECORD DELTA | RECORD RADIUS | RECORD LENGTH |
| C1 | 1°46'48" | 699.99' | 21.75' | 01°47'00" R1 | 700.00' R1 | 21.79' R1 |
| C2 | 8°18'36" | 764.99' | 110.95' | 08°18'44" R1 | 765.00' R1 | 110.98' R1 |
| C3 | 5°33'06" | 764.99' | 74.12' | 05°33'20" R1 | 765.00' R1 | 74.14' R18 |
| C4 | 28°28'12" | 1145.98' | 569.43' | 28°28'04" R1 | 1146.00' R1 | 569.40' R1 |
| C5 | 4°26'01" | 699.99' | 54.17' | 4°26'02" R1 | 700.00' R1 | 54.17' R1 |
| C6 | 1°05'31" | 699.99' | 13.34' | 1°05'09" R10 | 700.00' R10 | 13.27' R10 |
| C7 | 12°50'21" | 700.00' | 156.86' | 12°50'53" R10 | 700.00' R10 | 135.96' R10 |
| C8 | 3°23'35" | 699.99' | 41.45' | 3°23'32" R10 | 700.00' R10 | 41.44' R10 |
| C9 | 3°58'37" | 5161.77' | 358.27' | 3°58'37" R28 | 5161.75' R28 | 358.27' R28 |
| C10 | 5°45'01" | 1075.98' | 107.99' | 5°45'07" R1 | 1076.00' R1 | 108.02' R1 |
| C11 | 9°10'05" | 1299.98' | 208.02' | 9°10'05" R1 | 1300.00' R1 | 208.02' R1 |
| C12 | 12°19'38" | 1299.98' | 279.69' | 12°19'36" R1 | 1300.00' R1 | 279.70' R1 |
| C13 | 2°50'52" | 1699.97' | 84.49' | 2°50'35" R11 | 1700.00' R11 | 84.35' R11 |
| C14 | 1°18'07" | 1699.97' | 38.63' | N/A | N/A | N/A |
| C15 | 2°45'37" | 919.99' | 44.32' | 2°45'45" R11 | 920.00' R11 | 44.36' R11 |
| C16 | 2°55'15" | 2001.97' | 102.06' | 2°55'13" R2 | 2002.00' R2 | 102.04' R2 |
| C22 | 2°31'35" | 2049.97' | 90.39' | 2°31'46" R41 | 2050.00' R41 | 90.50' R41 |
| C23 | 4°45'42" | 2049.97' | 170.37' | 4°45'42" R41 | 2050.00' R41 | 170.37' R41 |
| C24 | 8°21'44" | 2049.97' | 299.19' | 8°21'43" R5 | 2050.00' R5 | 299.18' R5 |
| C25 | 15°39'01" | 2049.97' | 559.95' | 15°39'11" C R5/R41 | 2050.00' C R5/R41 | 560.05' C R5/R41 |
| C26 | 3°09'27" | 2049.97' | 112.97' | 3°10'22" R87 | 2050.00' R87 | 112.97' R87 |
| C27 | 3°07'51" | 2059.97' | 112.56' | 3°07'46" R82 | 2060.00' R82 | 112.52' R82 |
| C28 | 10°34'48" | 48.70' | 8.99' | ----- | ----- | ----- |
| C29 | 48°25'44" | 46.00' | 38.88' | ----- | ----- | ----- |
| C30 | 1°41'04" | 2059.97' | 60.56' | ----- | ----- | ----- |
| C31 | 1°26'46" | 2059.97' | 52.00' | ----- | ----- | ----- |
| C32 | 21°14'02" | 2009.97' | 744.90' | ----- | ----- | ----- |
| C33 | 16°23'37" | 1999.97' | 572.24' | 21°13'46" R79 | 2000.00' R79 | 741.05' R79 |

REFERENCES

- (R1) = RECORD OF SURVEY 94-1026, RSB 153/10-24
- (R2) = RECORD OF SURVEY 2002-1062, RSB 193/16-18
- (R3) = DAWN TRACT, MM 8-21
- (R4) = PARCEL MAP 81-769, PMB 172 40-42
- (R5) = RECORD OF SURVEY 2003-1006, RSB 199/1-16
- (R6) = PARCEL MAP, PMB 25-32
- (R7) = RECORD OF SURVEY, RSB 85-1
- (R8) = 562/74 O.R. RECORDS OF ORANGE COUNTY
- (R9) = RECORD OF SURVEY 2012-1051, RSB 260/33
- (R10) = RECORD OF SURVEY 2006-1204, RSB 220/1-9
- (R11) = PARCEL MAP, PMB 62-43
- (R12) = CORNER RECORD, CR 2009-3281
- (R13) = CORNER RECORD, CR-2012-1482
- (R14) = CORNER RECORD, CR 2012-2202
- (R15) = PARCEL MAP, PMB 75 3-4
- (R16) = CORNER RECORD, CR-2014-1695
- (R17) = CORNER RECORD, CR-2015-1241
- (R18) = PARCEL MAP, PMB 141 30-31
- (R19) = RECORD OF SURVEY, RSB 86/12
- (R20) = POTTS, BORDEN, & SIDWELL TRACT, L/A 1/63, M.R.L.A. 4-624
- (R21) = RECORD OF SURVEY, RSB 29/24
- (R22) = CITY OF ORANGE TIES 1504, CL INTERSECTION TIES NO. SP 1599
- (R23) = CITY OF ORANGE TIES 1506, CL INTERSECTION TIES NO. SP 1599
- (R24) = CORNER RECORD, CR-2015-1233
- (R25) = RECORD OF SURVEY 2003-1051, R.S.B. 195/39-40
- (R26) = CORNER RECORD, CR-2004-1312
- (R27) = 10567/358-368 O.R. RECORDS OF ORANGE COUNTY
- (R28) = 19950440367 O.R. RECORDS OF ORANGE COUNTY
- (R41) = PARCEL MAP, PMB 211 34-37
- (R50) = RECORD OF SURVEY, RSB 152/7-20
- (R51) = RECORD OF SURVEY, RSB 105/7
- (R60) = 150/ 177 O.R. RECORDS OF ORANGE COUNTY
- (R61) = 7587/ 794 O.R. RECORDS OF ORANGE COUNTY
- (R62) = 7719/ 964 O.R. RECORDS OF ORANGE COUNTY
- (R63) = 7820/ 506 O.R. RECORDS OF ORANGE COUNTY
- (R64) = 5923/ 1 O.R. RECORDS OF ORANGE COUNTY
- (R65) = 528/ 319 O.R. RECORDS OF ORANGE COUNTY
- (R66) = 4351/ 313 O.R. RECORDS OF ORANGE COUNTY
- (R67 = 5408/ 415 O.R. RECORDS OF ORANGE COUNTY
- (R68) = 4662/ 186 O.R. RECORDS OF ORANGE COUNTY
- (R69) = 5218/ 184 O.R. RECORDS OF ORANGE COUNTY
- (R70) = 7170/ 26 O.R. RECORDS OF ORANGE COUNTY
- (R71) = 8069/ 64 O.R. RECORDS OF ORANGE COUNTY
- (R72) = 9140/ 887 O.R. RECORDS OF ORANGE COUNTY
- (R73) = 13123/ 1124 O.R. RECORDS OF ORANGE COUNTY
- (R74) = 1987/ 12516 O.R. RECORDS OF ORANGE COUNTY
- (R75) = 1992000898030 O.R. RECORDS OF ORANGE COUNTY
- (R76) = 1998000314756 O.R. RECORDS OF ORANGE COUNTY
- (R77) = 1998000728962 O.R. RECORDS OF ORANGE COUNTY
- (R78) = 2012000162275 O.R. RECORDS OF ORANGE COUNTY
- (R79) = 2212/ 183 O.R. RECORDS OF ORANGE COUNTY
- (R80) = 2012000297925 O.R. RECORDS OF ORANGE COUNTY
- (R81) = 6311/ 631 O.R. RECORDS OF ORANGE COUNTY
- (R82) = 1998000314757 O.R. RECORDS OF ORANGE COUNTY
- (R83) = 2009000571573 O.R. RECORDS OF ORANGE COUNTY
- (R84) = 2003000369248 O.R. RECORDS OF ORANGE COUNTY
- (R85) = 2004000106282 O.R. RECORDS OF ORANGE COUNTY
- (R86) = 2011000595364 O.R. RECORDS OF ORANGE COUNTY
- (R87) = 1987000339973 O.R. RECORDS OF ORANGE COUNTY
- (R88) = 1998000842737 O.R. RECORDS OF ORANGE COUNTY
- (R89) = 2005000755202 O.R. RECORDS OF ORANGE COUNTY
- (R90) = PROPOSED PARCEL GA1118-152
- (R91) = 9219/ 338 O.R. RECORDS OF ORANGE COUNTY
- (R92) = 19980357067 O.R. RECORDS OF ORANGE COUNTY
- (R93) = 2006000871508 O.R. RECORDS OF ORANGE COUNTY
- (R94) = 199700165656 O.R. RECORDS OF ORANGE COUNTY
- (R95) = 201100273502 O.R. RECORDS OF ORANGE COUNTY
- (R96) = 201300112702 O.R. RECORDS OF ORANGE COUNTY
- (R97) = 2010000609044 O.R. RECORDS OF ORANGE COUNTY
- (R98) = CALTRANS APPRAISAL MAP E120077-01 COMPLETE6000DPI.
- (R99) = TRACT NO. 3414, MM 249-11-19
- (R100) = RECORD OF SURVEY 2003-10

OVERALL BOUNDARY ESTABLISHMENT & SHEET INDEX MAP

NOTES

SEE SHEET 2 & 3 FOR MONUMENT AND ESTABLISHMENT NOTES.


SEE SHEET 3 FOR REFERENCES, LINE & CURVE TABLES , AND EASEMENT NOTES.

ALL BOUNDARY LINES NOT SHOWN IN BOLD ARE FOR GRAPHICAL REPRESENTATION ONLY.

RECORD DISTANCES SHOWN HEREON ARE AS THEY APPEAR ON THE DOCUMENT OF RECORD. DISTANCES MAY BE EITHER GRID OR GROUND, AS PER SAID RECORD.

REFERENCE DOCUMENTS IN THE REFERENCE LEGEND ARE LIVE HYPERLINKS TO SAID DOCUMENT.

MONUMENT SYMBOLS CONTAIN LIVE HYPERLINKS TO IMAGES, IF THEY EXIST, OF RESPECTIVE MONUMENT.

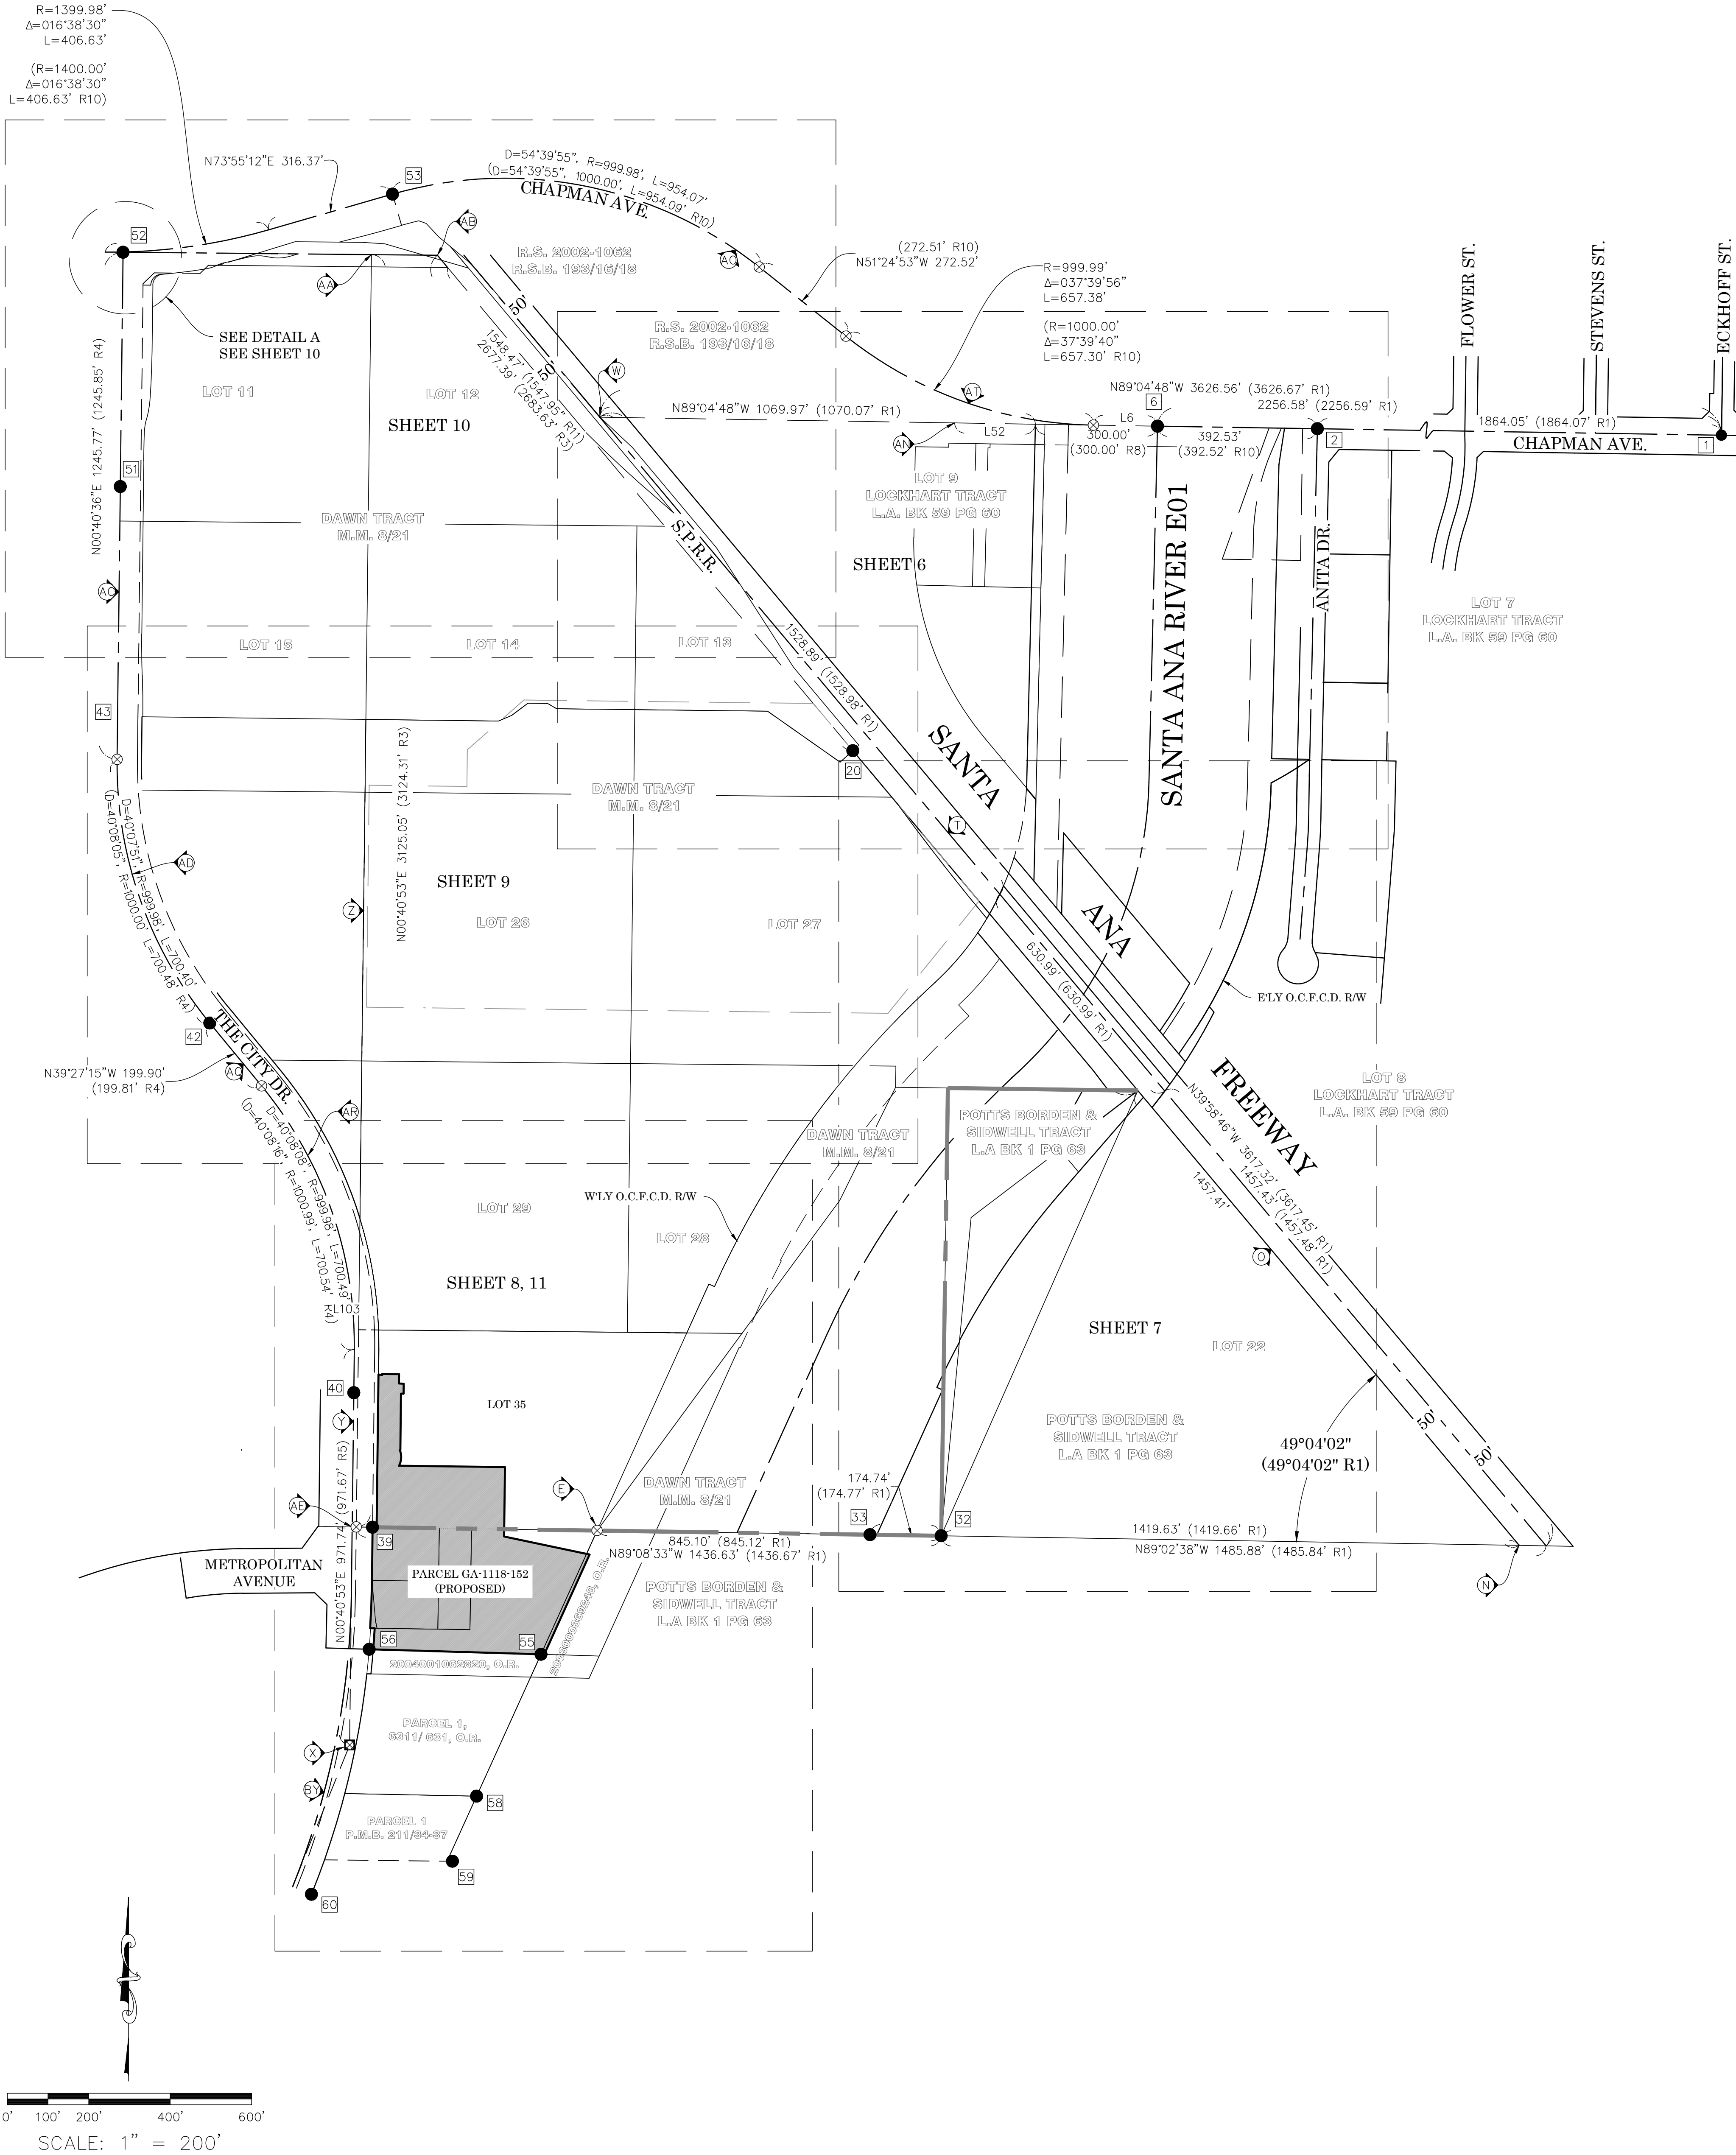


- LEGEND**
- FOUND MONUMENT AS NOTED
 - ⊗ S.F.N. - SEARCHED, FOUND NOTHING
 - ⊠ S.F.N., ESTABLISHED BY TIES
 - C CALC FROM RECORD MAP
 - () RECORD MAP

U.S. Survey


Foot

OC Public Works
OC Survey/Field Services
Boundary Analysis & Mapping

| | | | |
|-----------|------|---|------------------------------------|
| | | COUNTY OF ORANGE OC PUBLIC WORKS OC SURVEY/FIELD SERVICES/BOUNDARY ANALYSIS & MAPPING | |
| | | COUNTY OF ORANGE ANIMAL SHELTER ALTANSPS SURVEY | |
| | | BOUNDARY MAP | |
| | | PROJECT LIMITS: BETWEEN THE 22 FREEWAY AND THEO LACY FACILITY | |
| | | DATE OF SURVEY: MARCH 2024 | SHEET NO. 5 of 14 |
| | | MAPPING | |
| | | OFFICE CHECK | |
| | | FIELD CHECK | |
| | | SCALE: 1" = 200' | |
| | | FILE: Animal Shelter Boundary_2024.DWG | |
| MARK | DATE | ITEM | |
| REVISIONS | | | |
| | | W.O. #EC29962 | FILE # 2324PW-RE0003 |

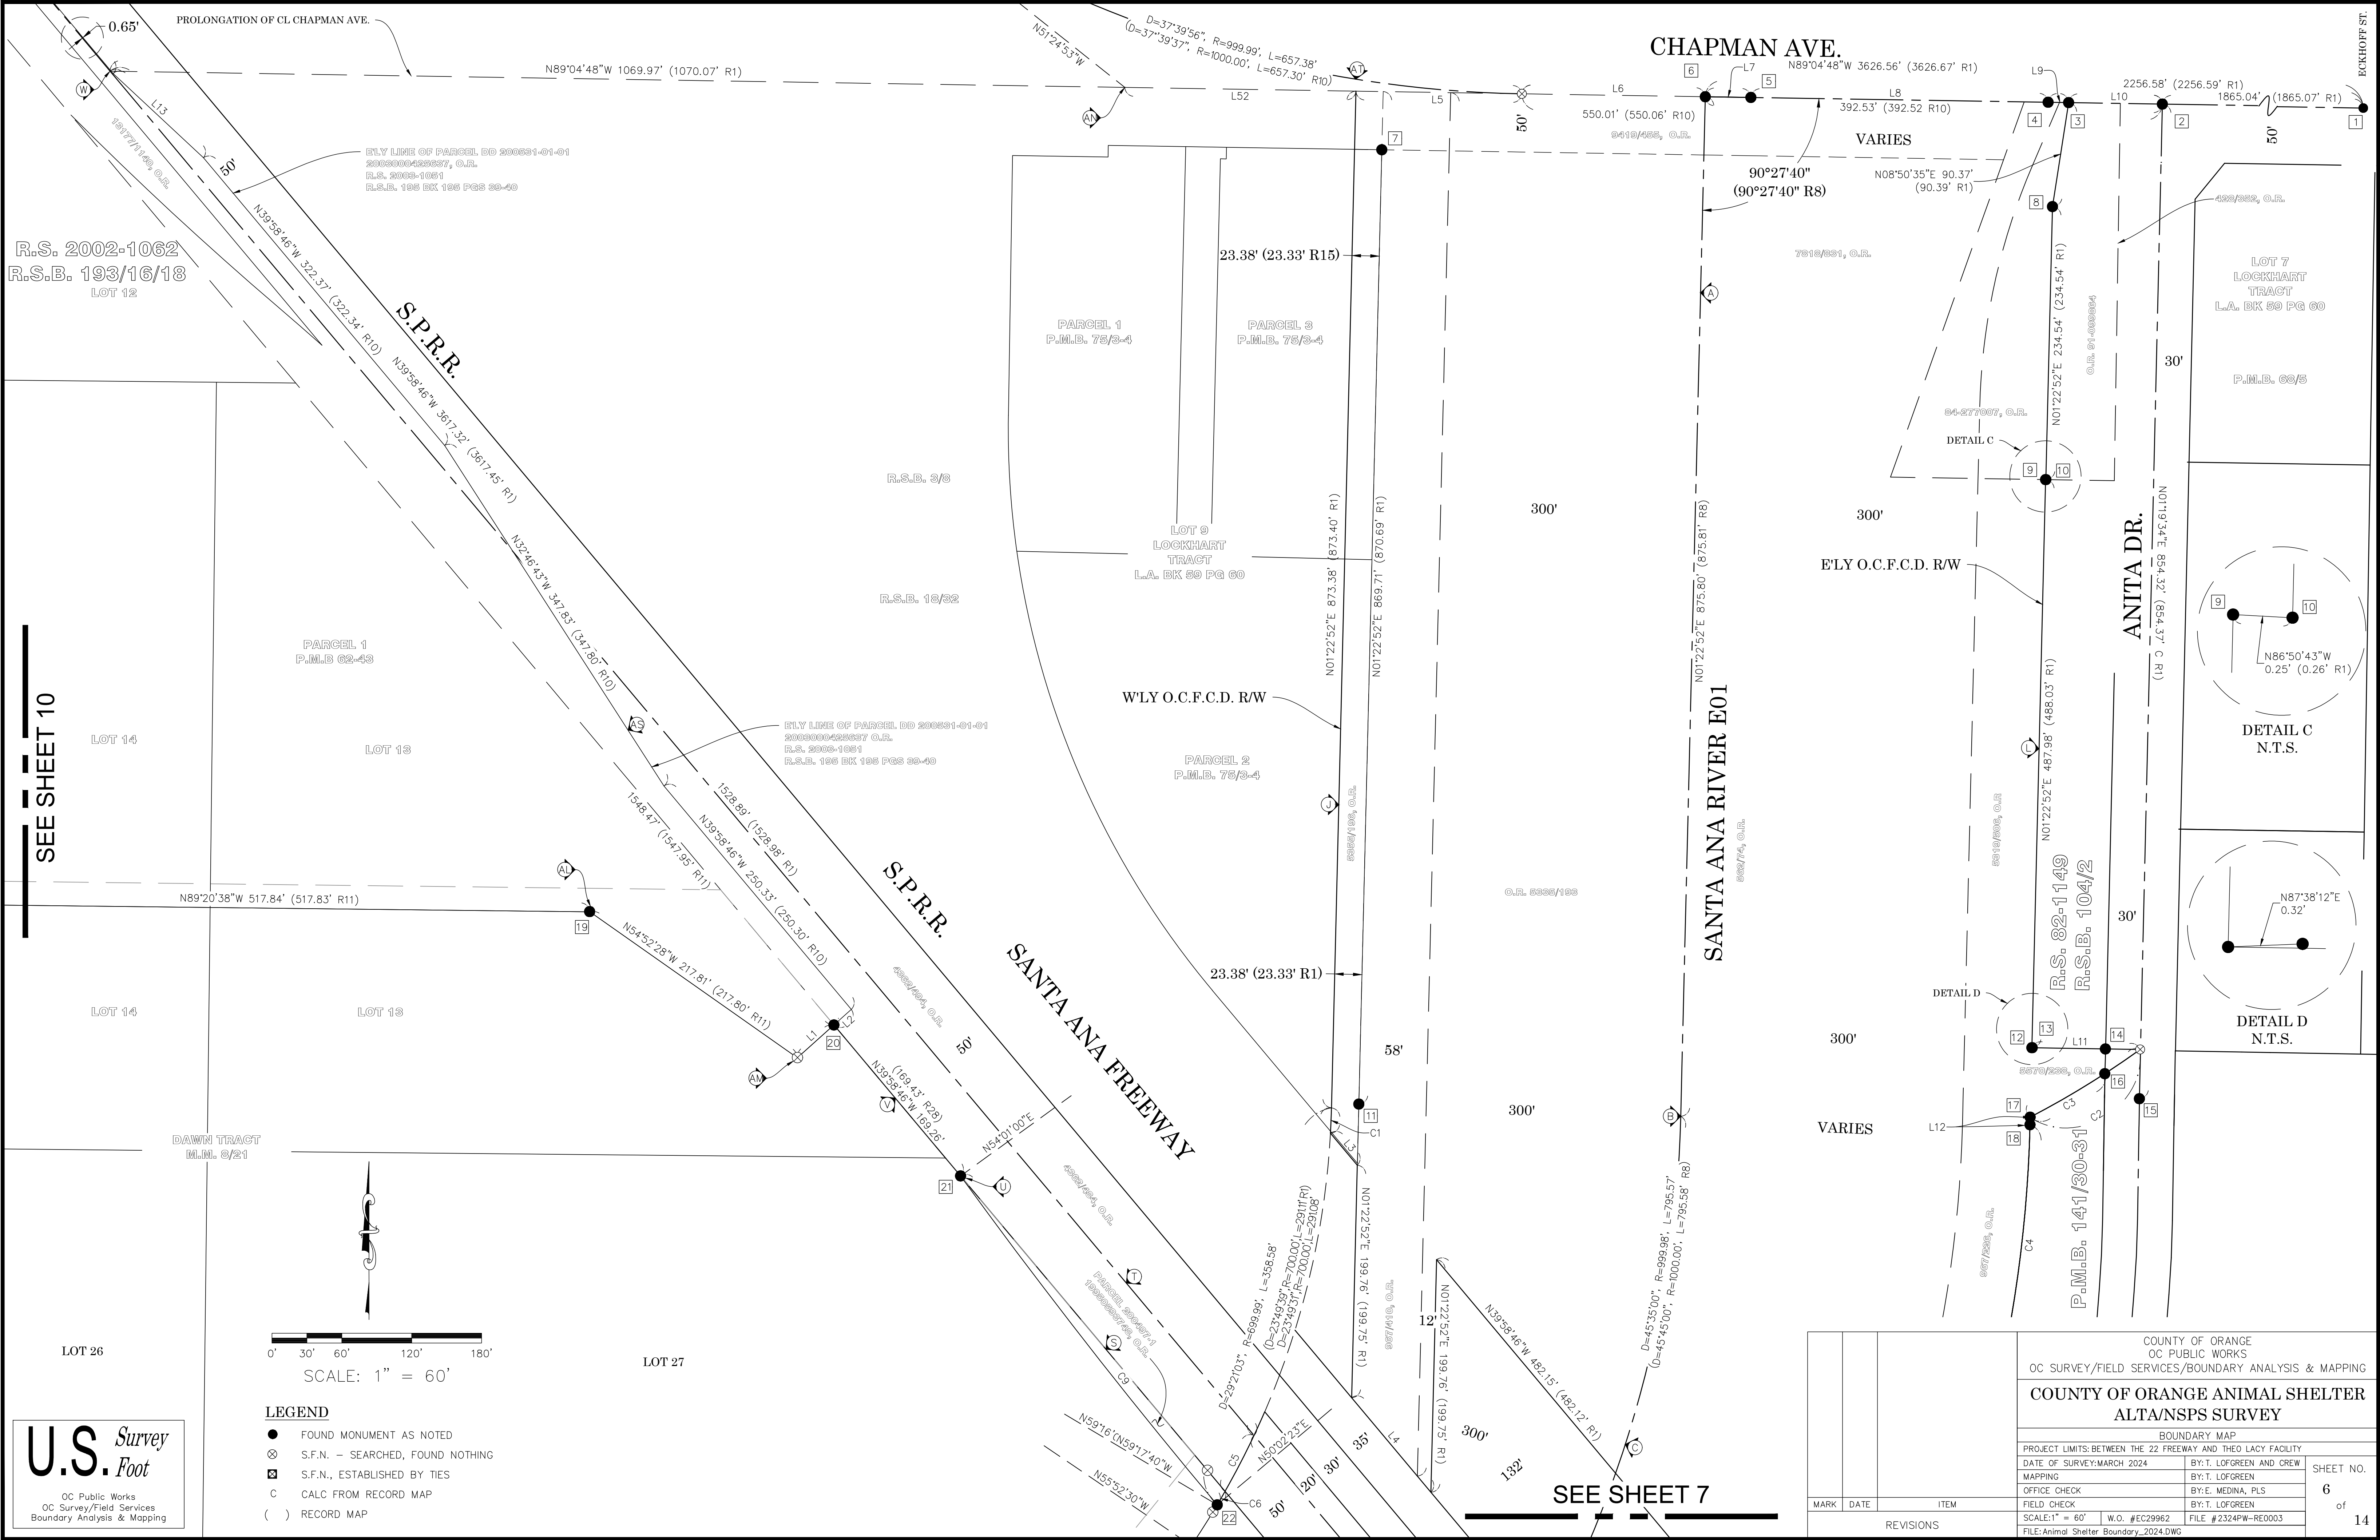

| | | | | | |
|------|------|------|---|--------------------------|--------------------------------|
| | | | COUNTY OF ORANGE OC PUBLIC WORKS OC SURVEY/FIELD SERVICES/BOUNDARY ANALYSIS & MAPPING | | |
| | | | COUNTY OF ORANGE ANIMAL SHELTER ALTA/NSPS SURVEY | | |
| | | | BOUNDARY MAP | | |
| | | | PROJECT LIMITS: BETWEEN THE 22 FREEWAY AND THEO LACY FACILITY | | |
| | | | DATE OF SURVEY: MARCH 2024 | BY: T. LOFGREEN AND CREW | SHEET NO. 6 of 14 |
| | | | MAPPING | BY: T. LOFGREEN | |
| | | | OFFICE CHECK | BY: E. MEDINA, PLS | |
| | | | FIELD CHECK | BY: T. LOFGREEN | |
| | | | SCALE: 1" = 60' | W.O. #EC29962 | |
| | | | FILE: Animal Shelter Boundary_2024.DWG | FILE #2324FW-RE0003 | |
| MARK | DATE | ITEM | REVISIONS | | |

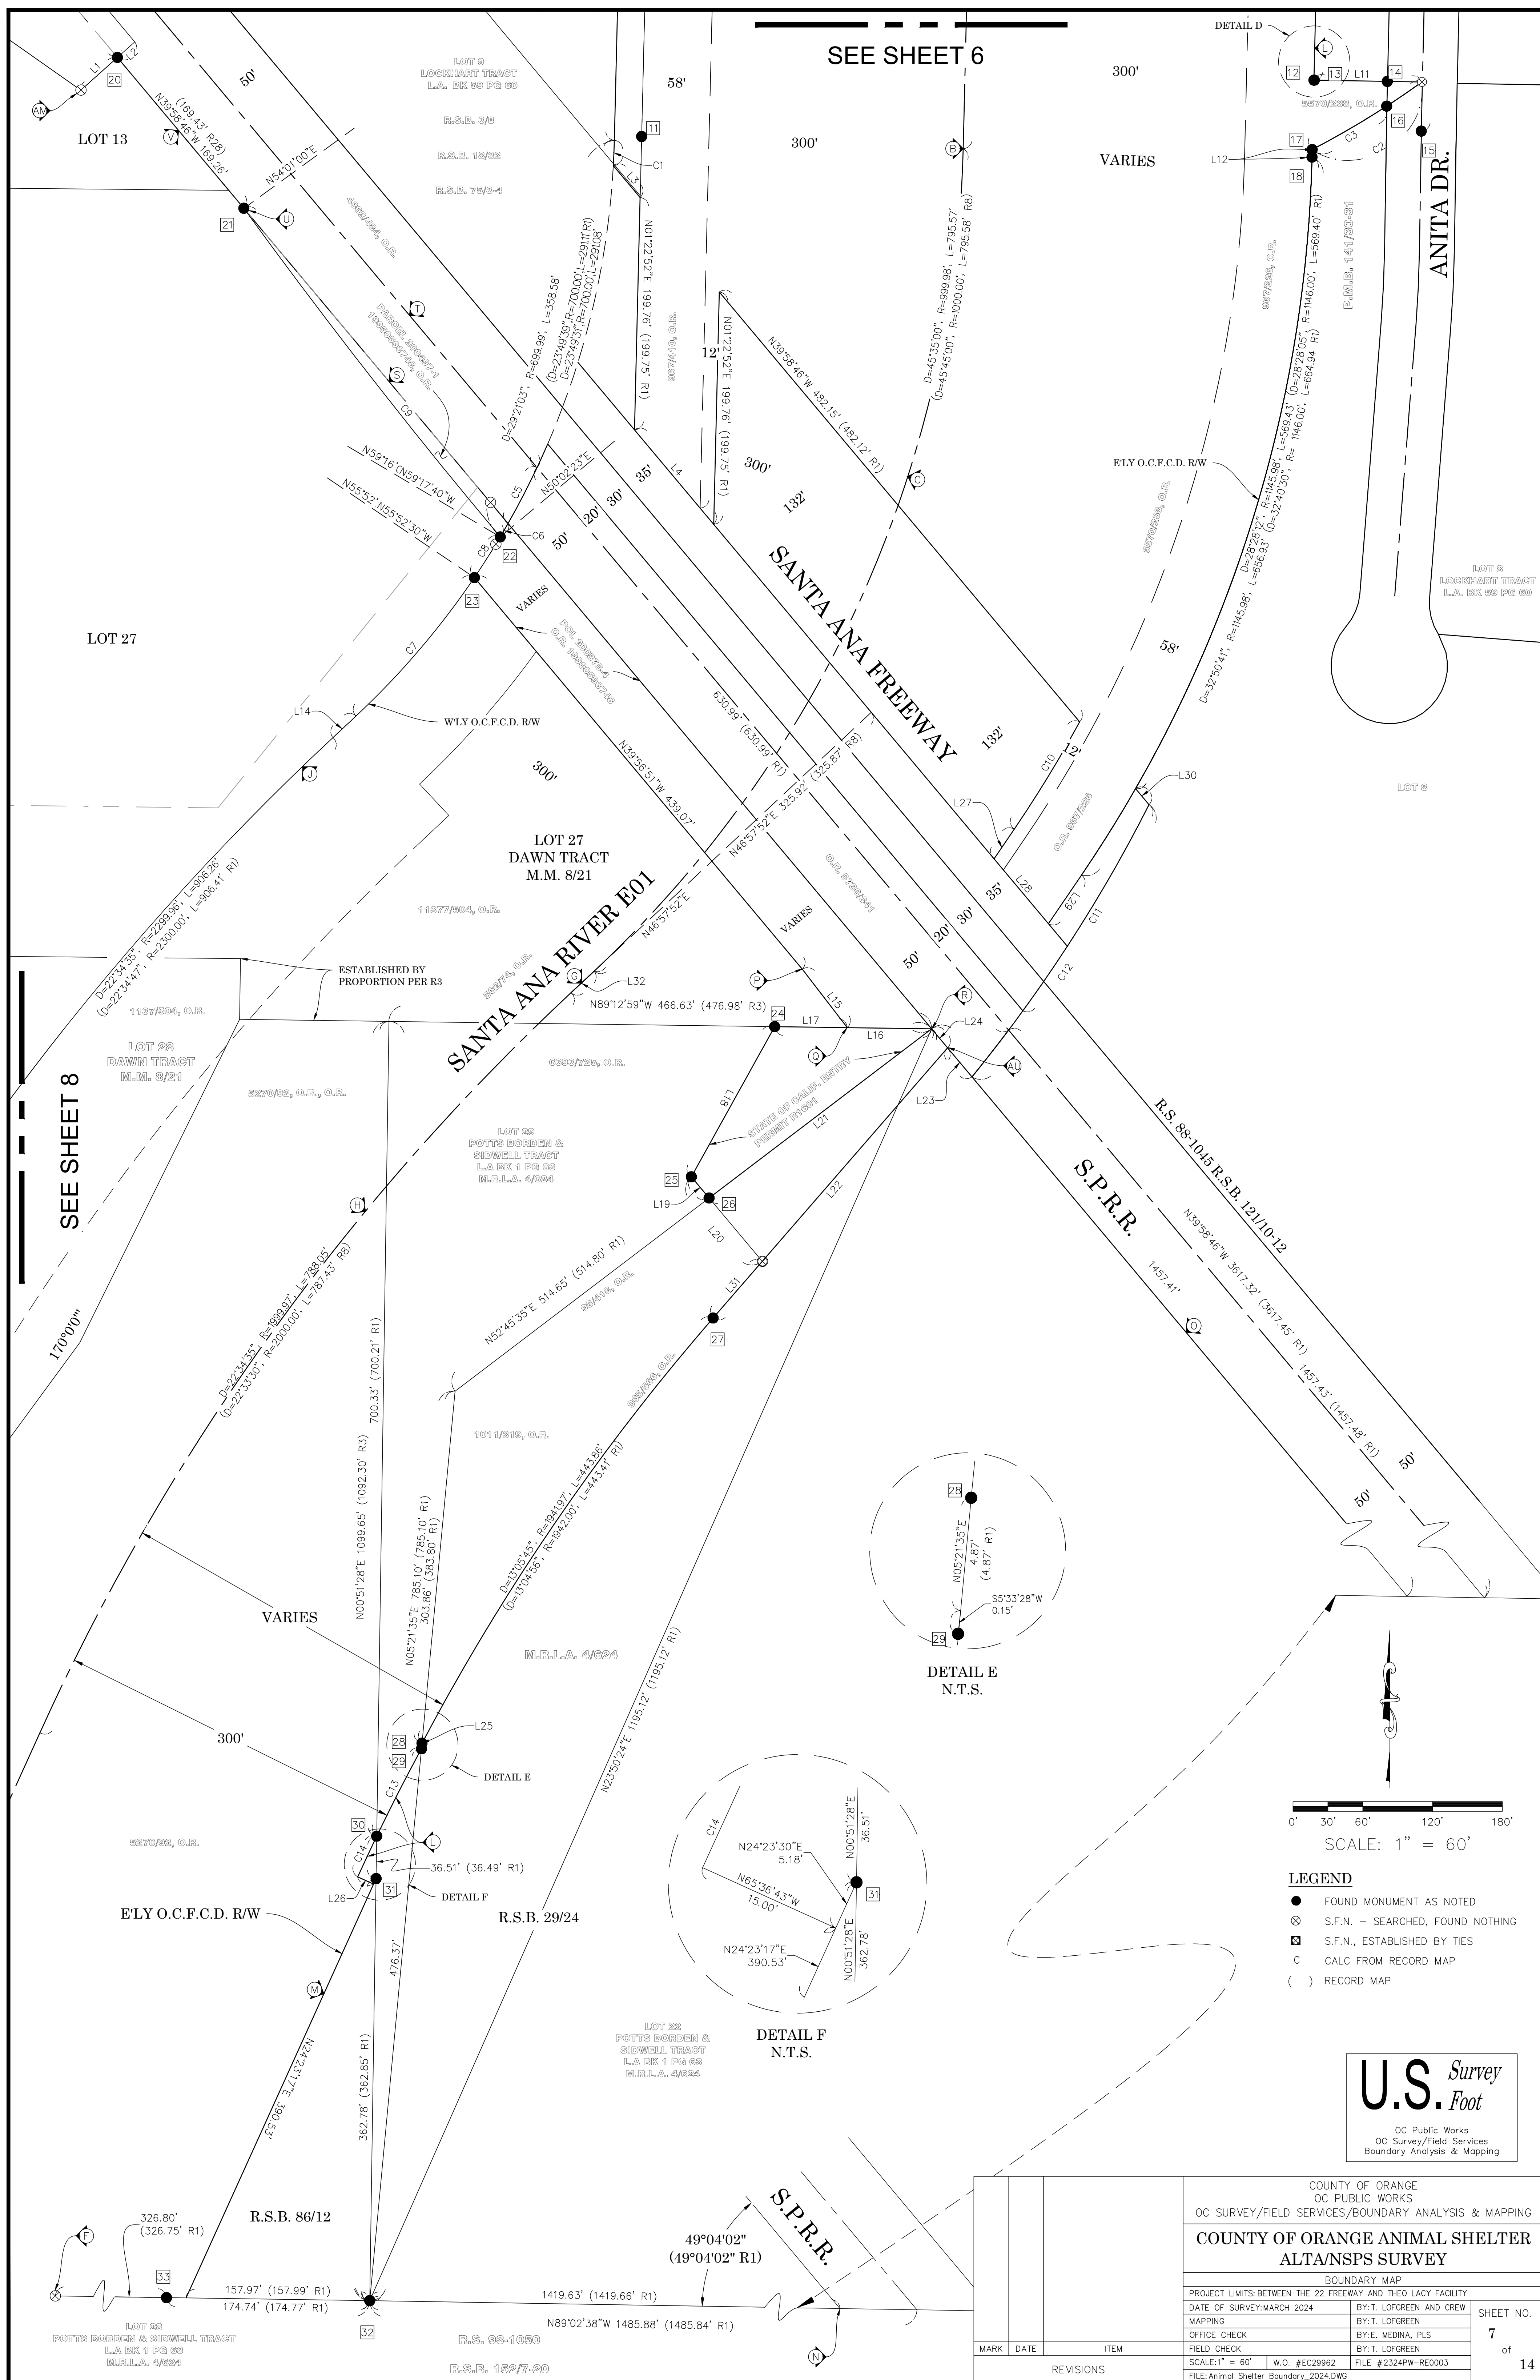


SEE SHEET 9

SEE SHEET 7

SEE SHEET 7

SEE SHEET 7

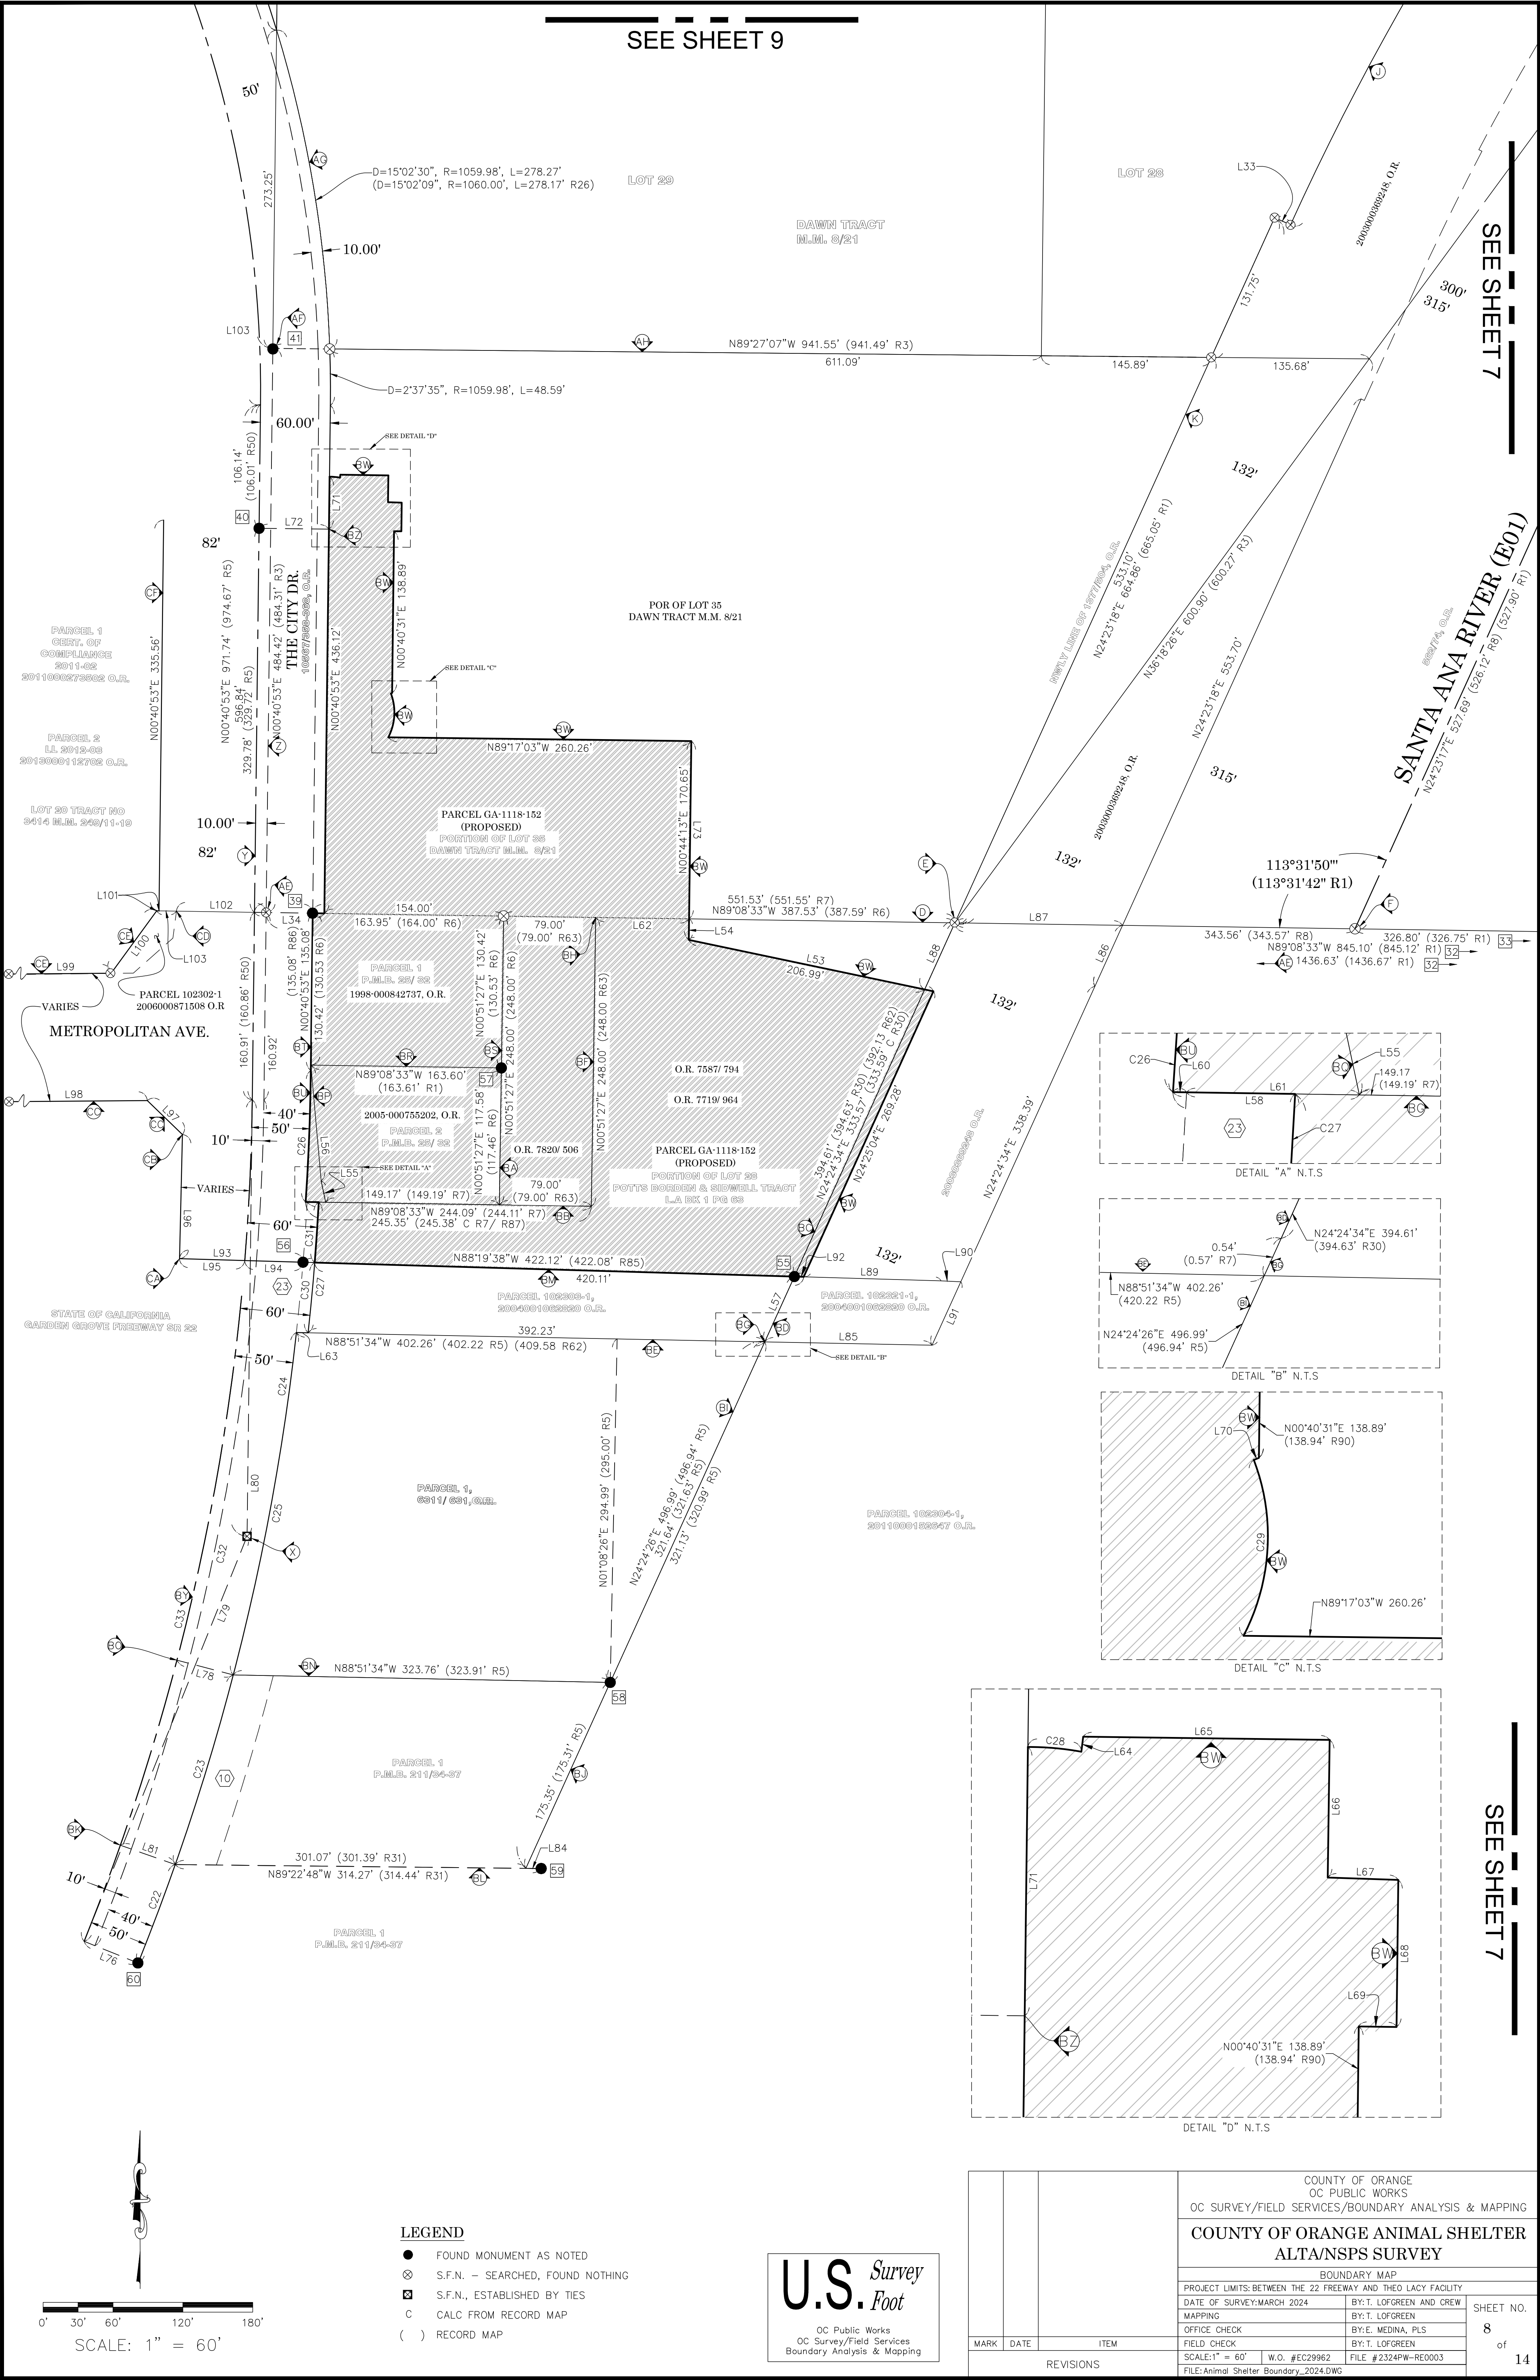

LEGEND

- FOUND MONUMENT AS NOTED
- ⊗ S.F.N. - SEARCHED, FOUND NOTHING
- ⊠ S.F.N., ESTABLISHED BY TIES
- C CALC FROM RECORD MAP
- () RECORD MAP

U.S. Survey
Foot

OC Public Works
OC Survey/Field Services
Boundary Analysis & Mapping

COUNTY OF ORANGE
OC PUBLIC WORKS
OC SURVEY/FIELD SERVICES/BOUNDARY ANALYSIS & MAPPING

COUNTY OF ORANGE ANIMAL SHELTER
ALTA/NSPS SURVEY

BOUNDARY MAP

PROJECT LIMITS: BETWEEN THE 22 FREEWAY AND THEO LACY FACILITY

DATE OF SURVEY: MARCH 2024 BY: T. LOFGREEN AND CREW

MAPPING BY: T. LOFGREEN

OFFICE CHECK BY: E. MEDINA, PLS


FIELD CHECK BY: T. LOFGREEN

SCALE: 1" = 60' W.O. #EC29962 FILE #2324PW-RE0003

FILE: Animal Shelter Boundary_2024.DWG

| MARK | DATE | ITEM |
|-----------|------|------|
| REVISIONS | | |


SHEET NO.
8 of 14

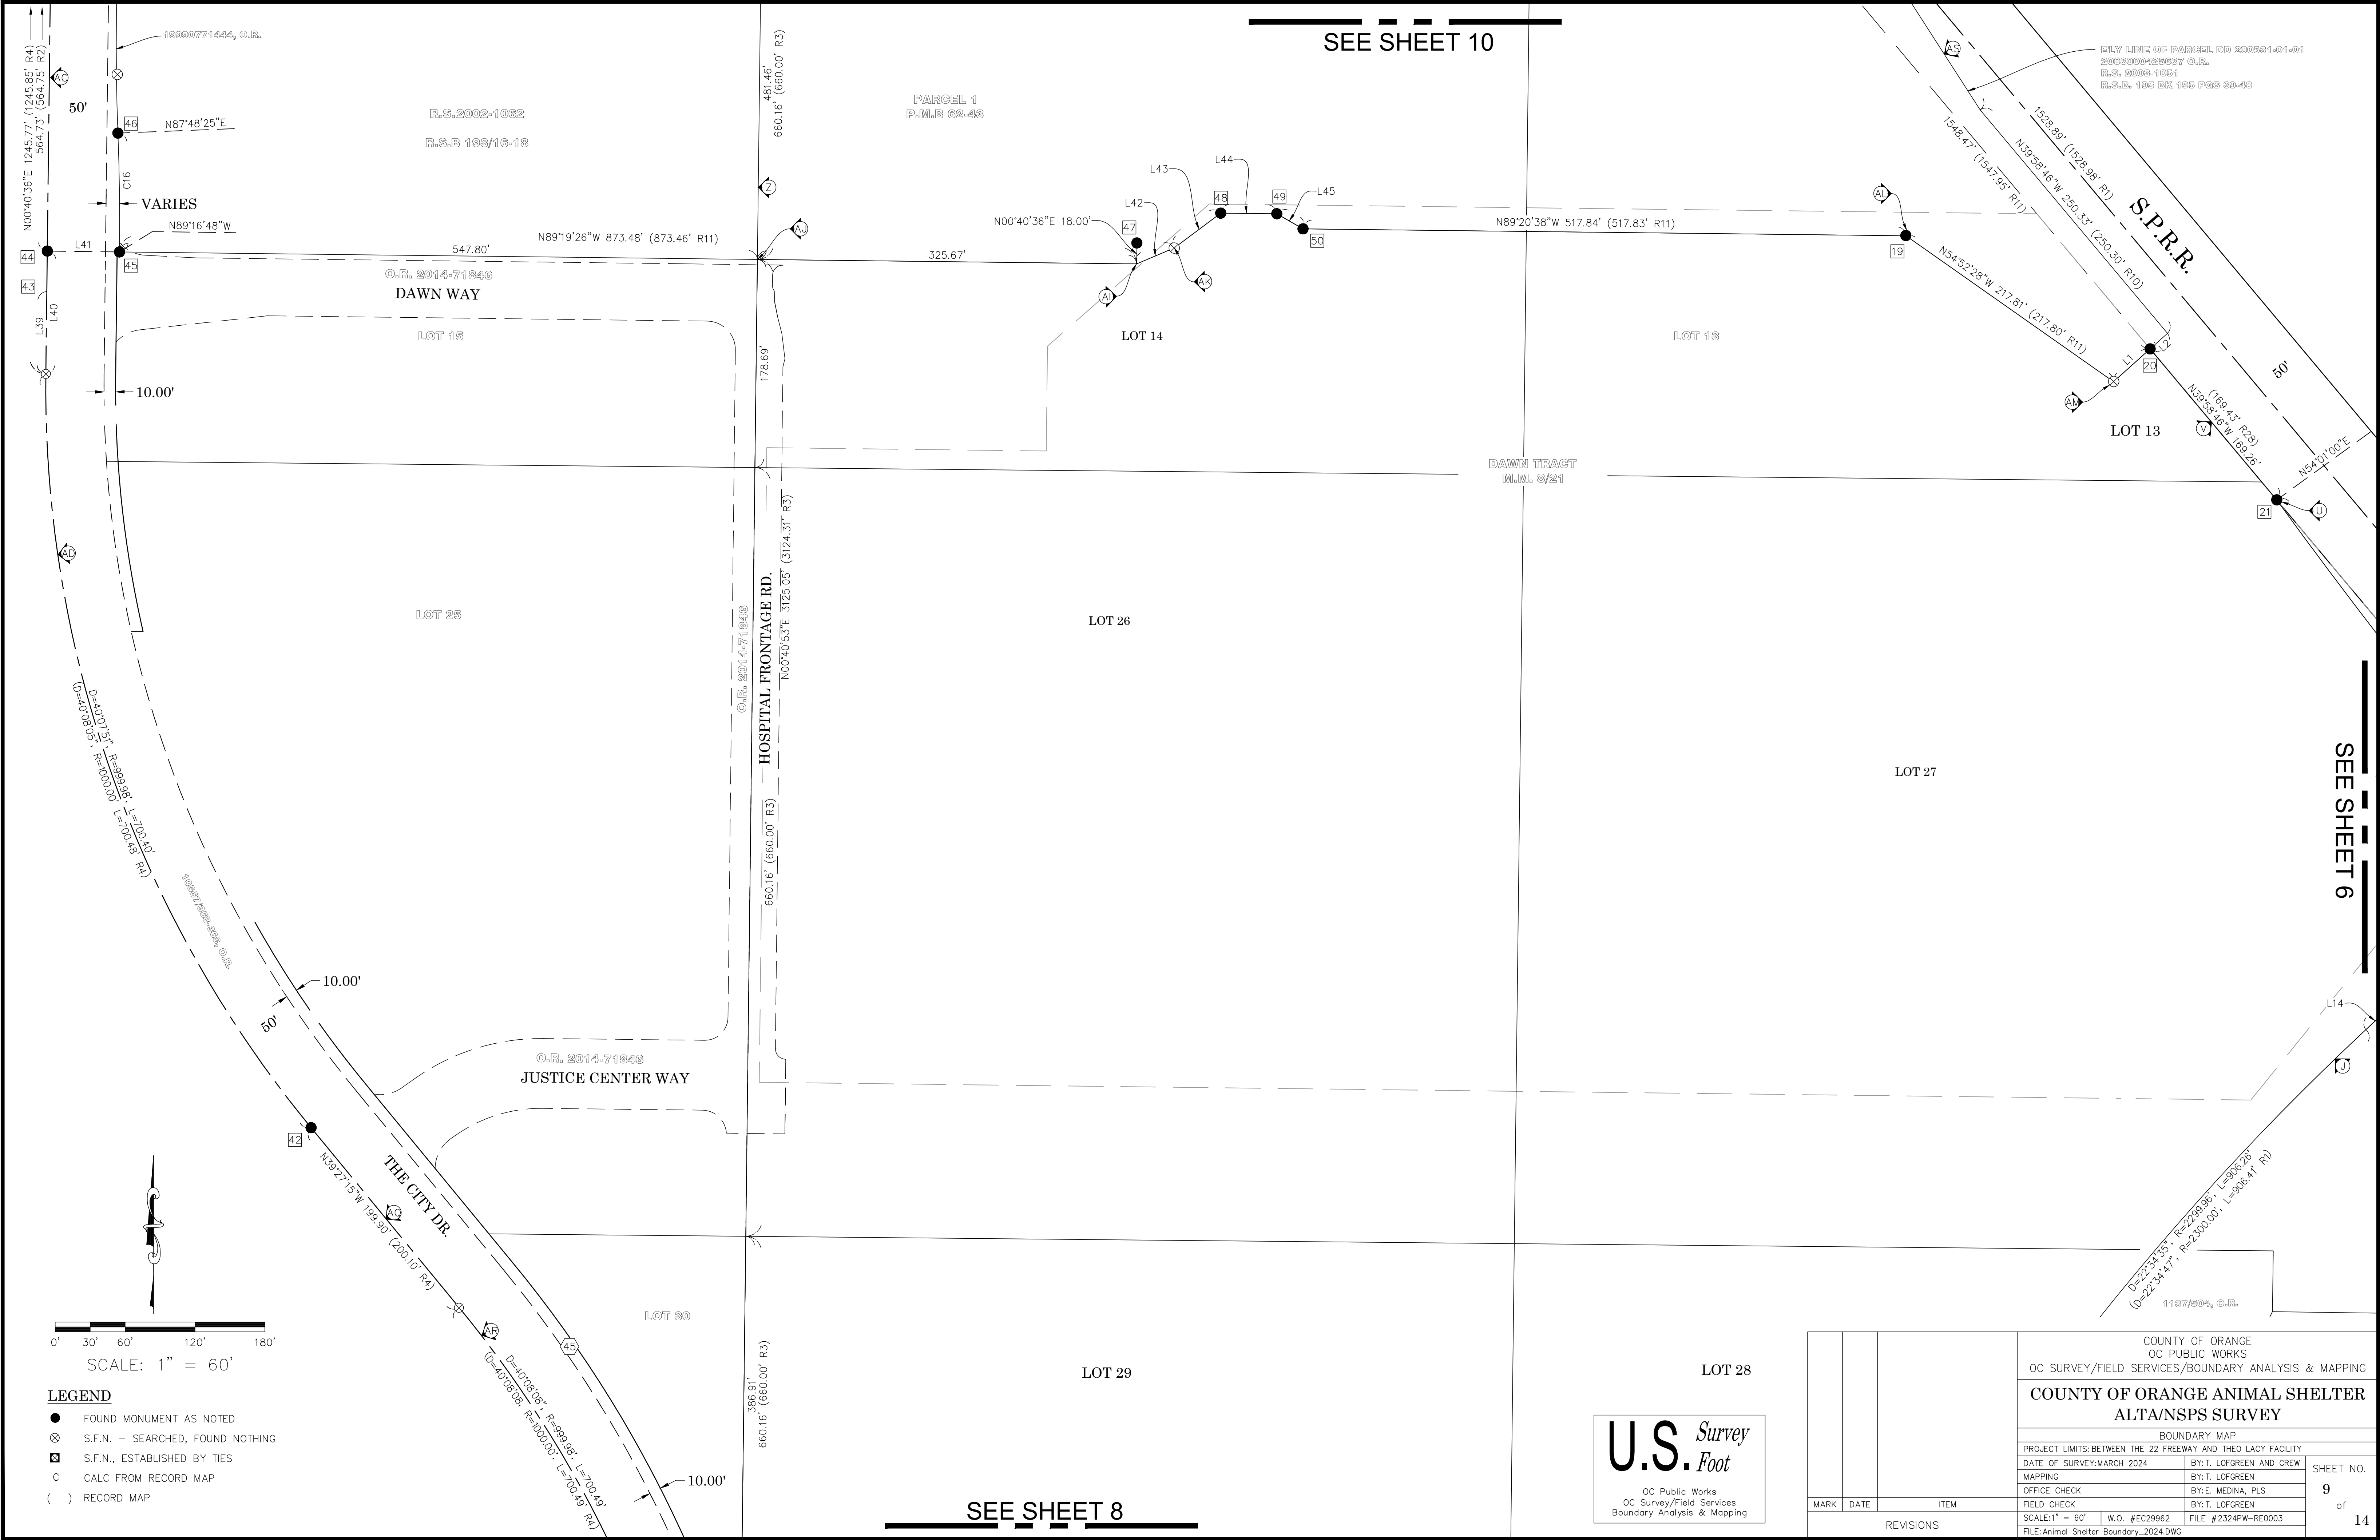

- LEGEND**
- FOUND MONUMENT AS NOTED
 - ⊗ S.F.N. - SEARCHED, FOUND NOTHING
 - ⊠ S.F.N., ESTABLISHED BY TIES
 - C CALC FROM RECORD MAP
 - () RECORD MAP

0' 30' 60' 120' 180'



SCALE: 1" = 60'

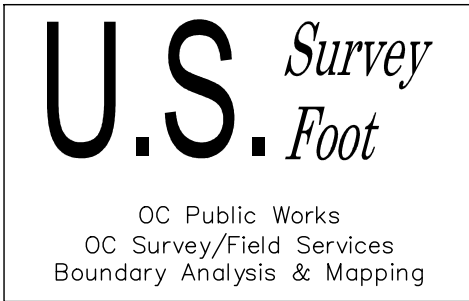

| | | | | | | | |
|--------------|------|--------------------|---|--|--------------------------|--|------------------------------------|
| | | | COUNTY OF ORANGE OC PUBLIC WORKS OC SURVEY/FIELD SERVICES/BOUNDARY ANALYSIS & MAPPING | | | | |
| | | | COUNTY OF ORANGE ANIMAL SHELTER ALTANSPTS SURVEY | | | | |
| | | | BOUNDARY MAP | | | | |
| | | | PROJECT LIMITS: BETWEEN THE 22 FREEWAY AND THEO LACY FACILITY | | | | |
| | | | DATE OF SURVEY: MARCH 2024 | | BY: T. LOFGREEN AND CREW | | SHEET NO. 9 of 14 |
| | | | MAPPING | | BY: T. LOFGREEN | | |
| OFFICE CHECK | | BY: E. MEDINA, PLS | | | | | |
| FIELD CHECK | | BY: T. LOFGREEN | | | | | |
| MARK | DATE | ITEM | SCALE: 1" = 60' W.O. #EC29962 | | FILE #2324FW-RE0003 | | |
| REVISIONS | | | FILE: Animal Shelter Boundary_2024.DWG | | | | |





EASEMENT MAP

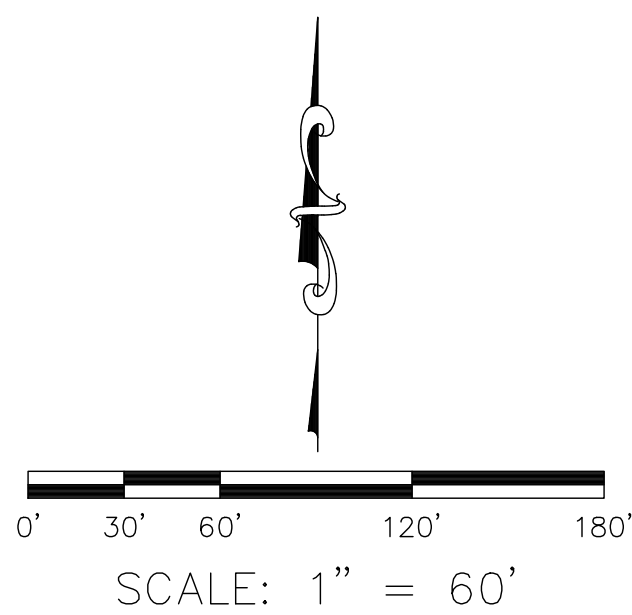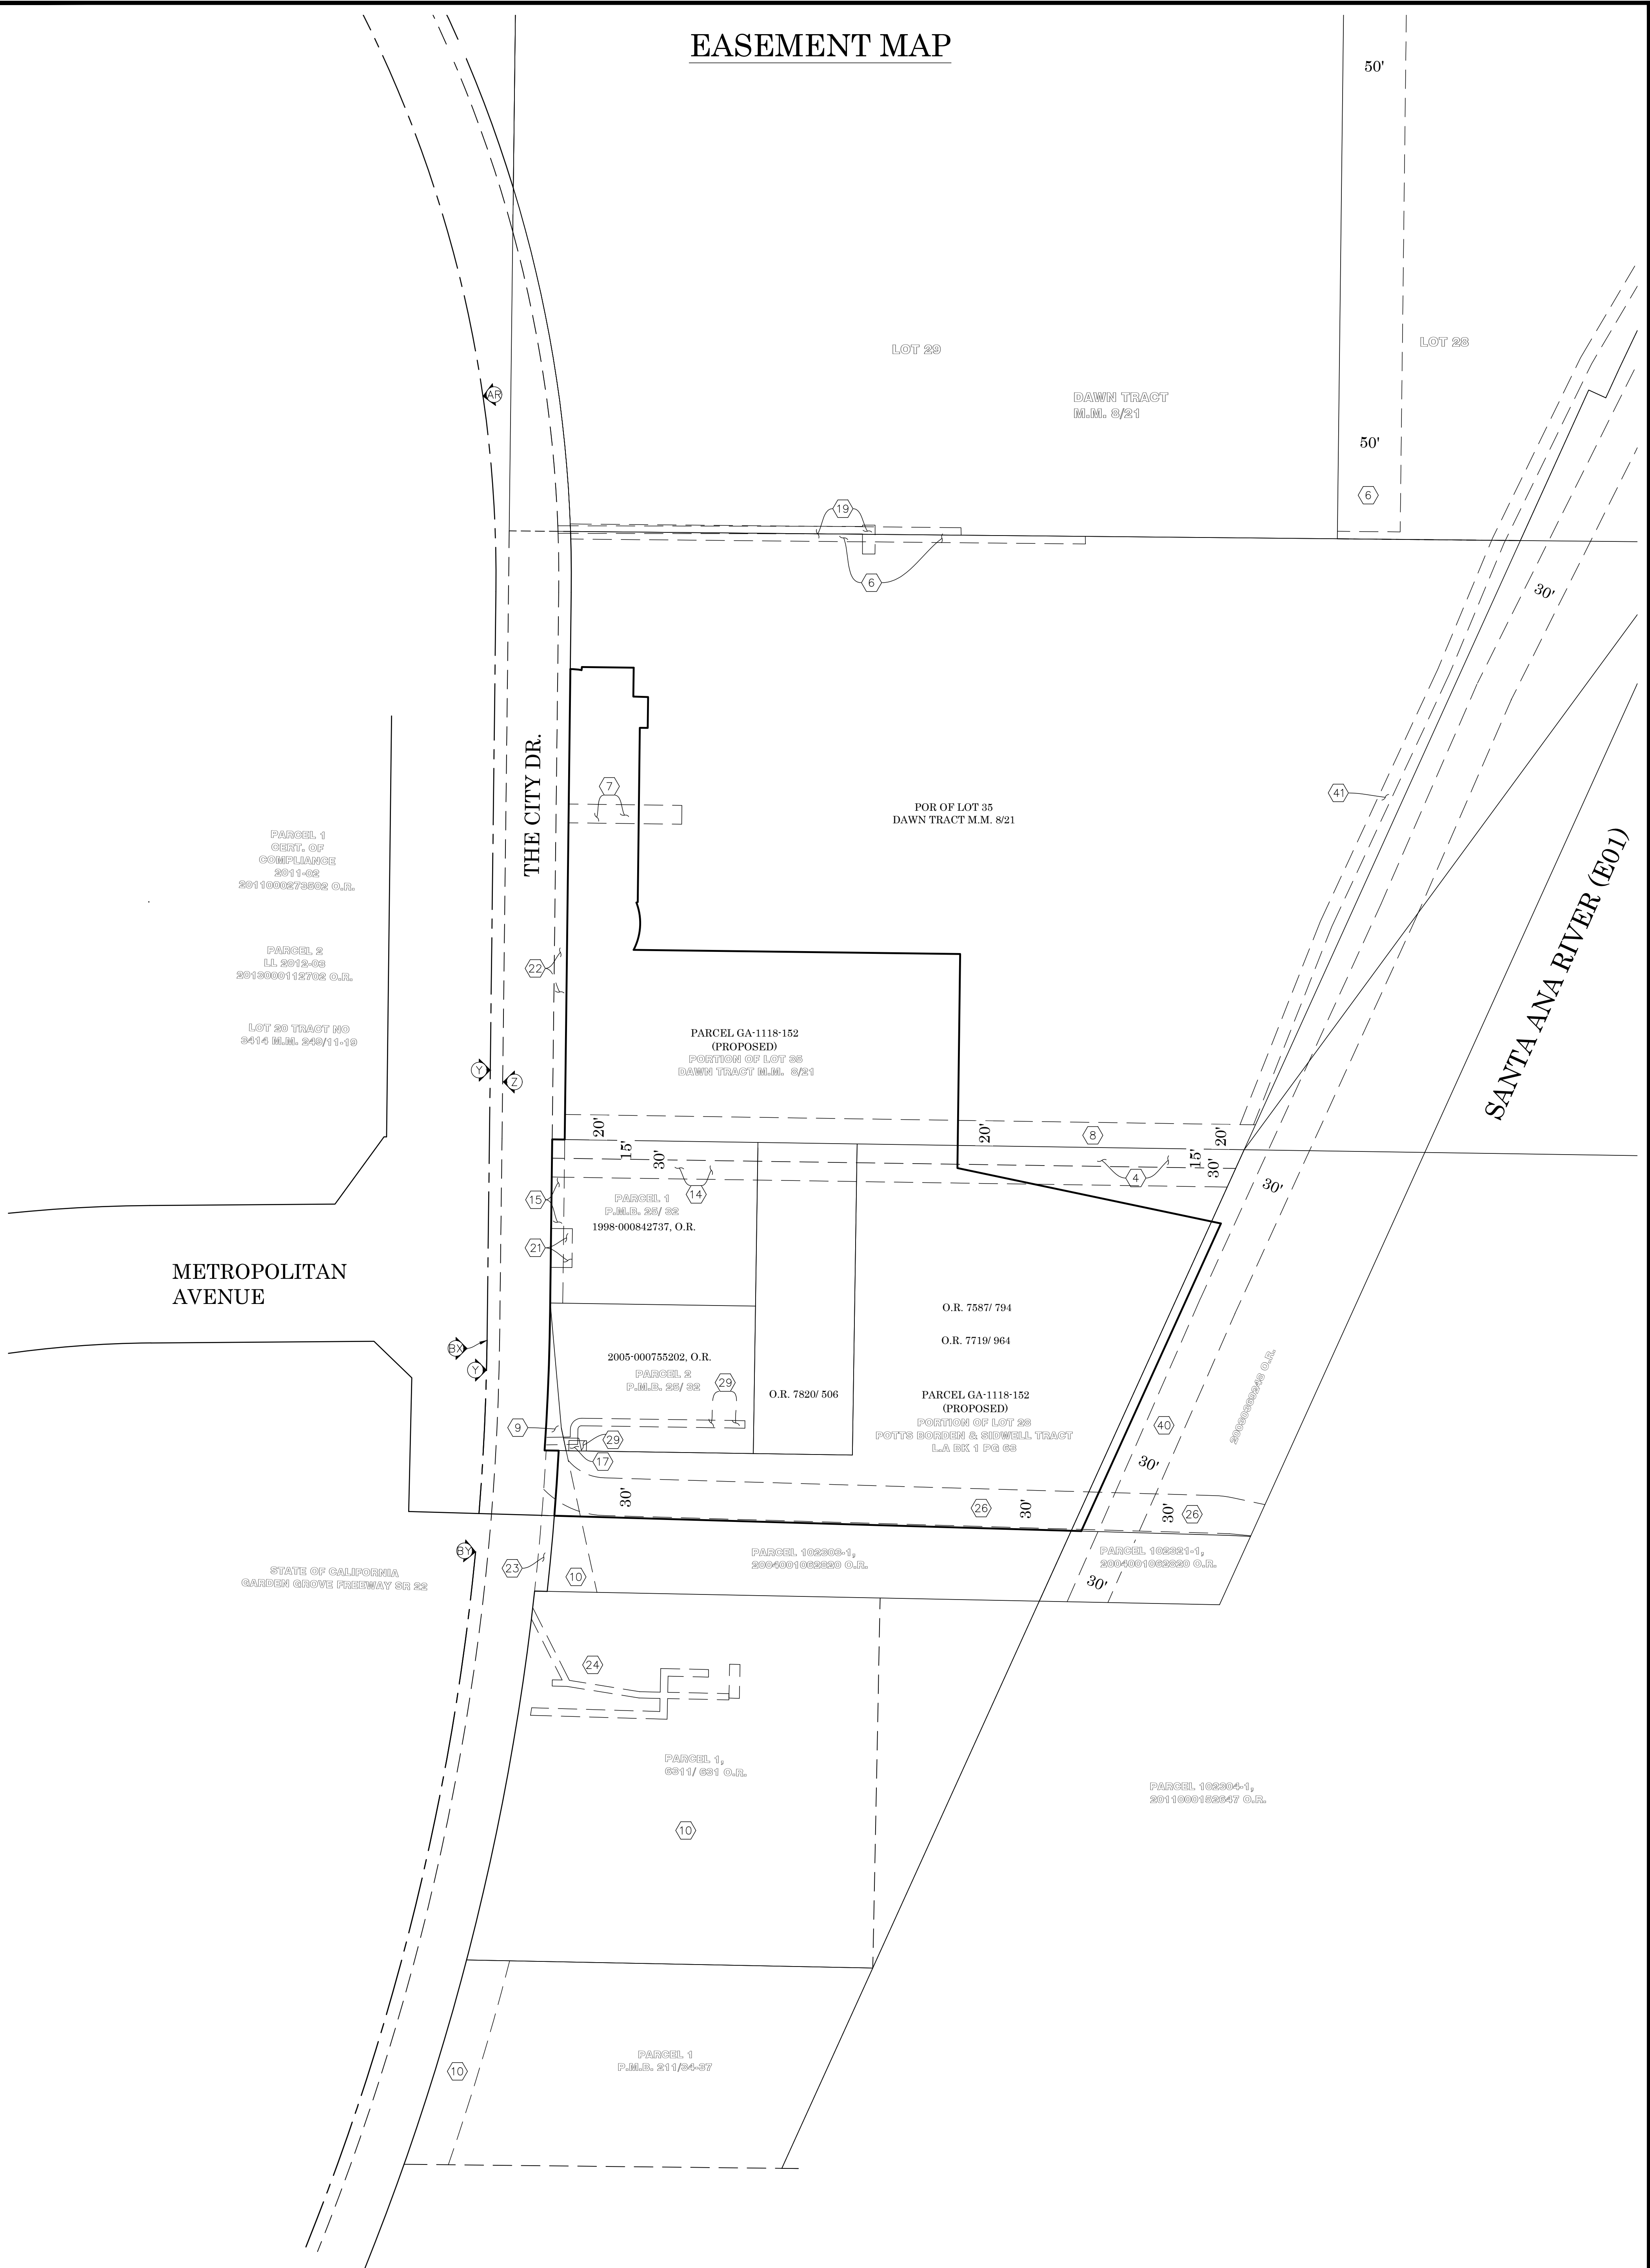

U.S. Survey Foot
OC Public Works
OC Survey/Field Services
Boundary Analysis & Mapping



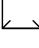

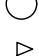


 
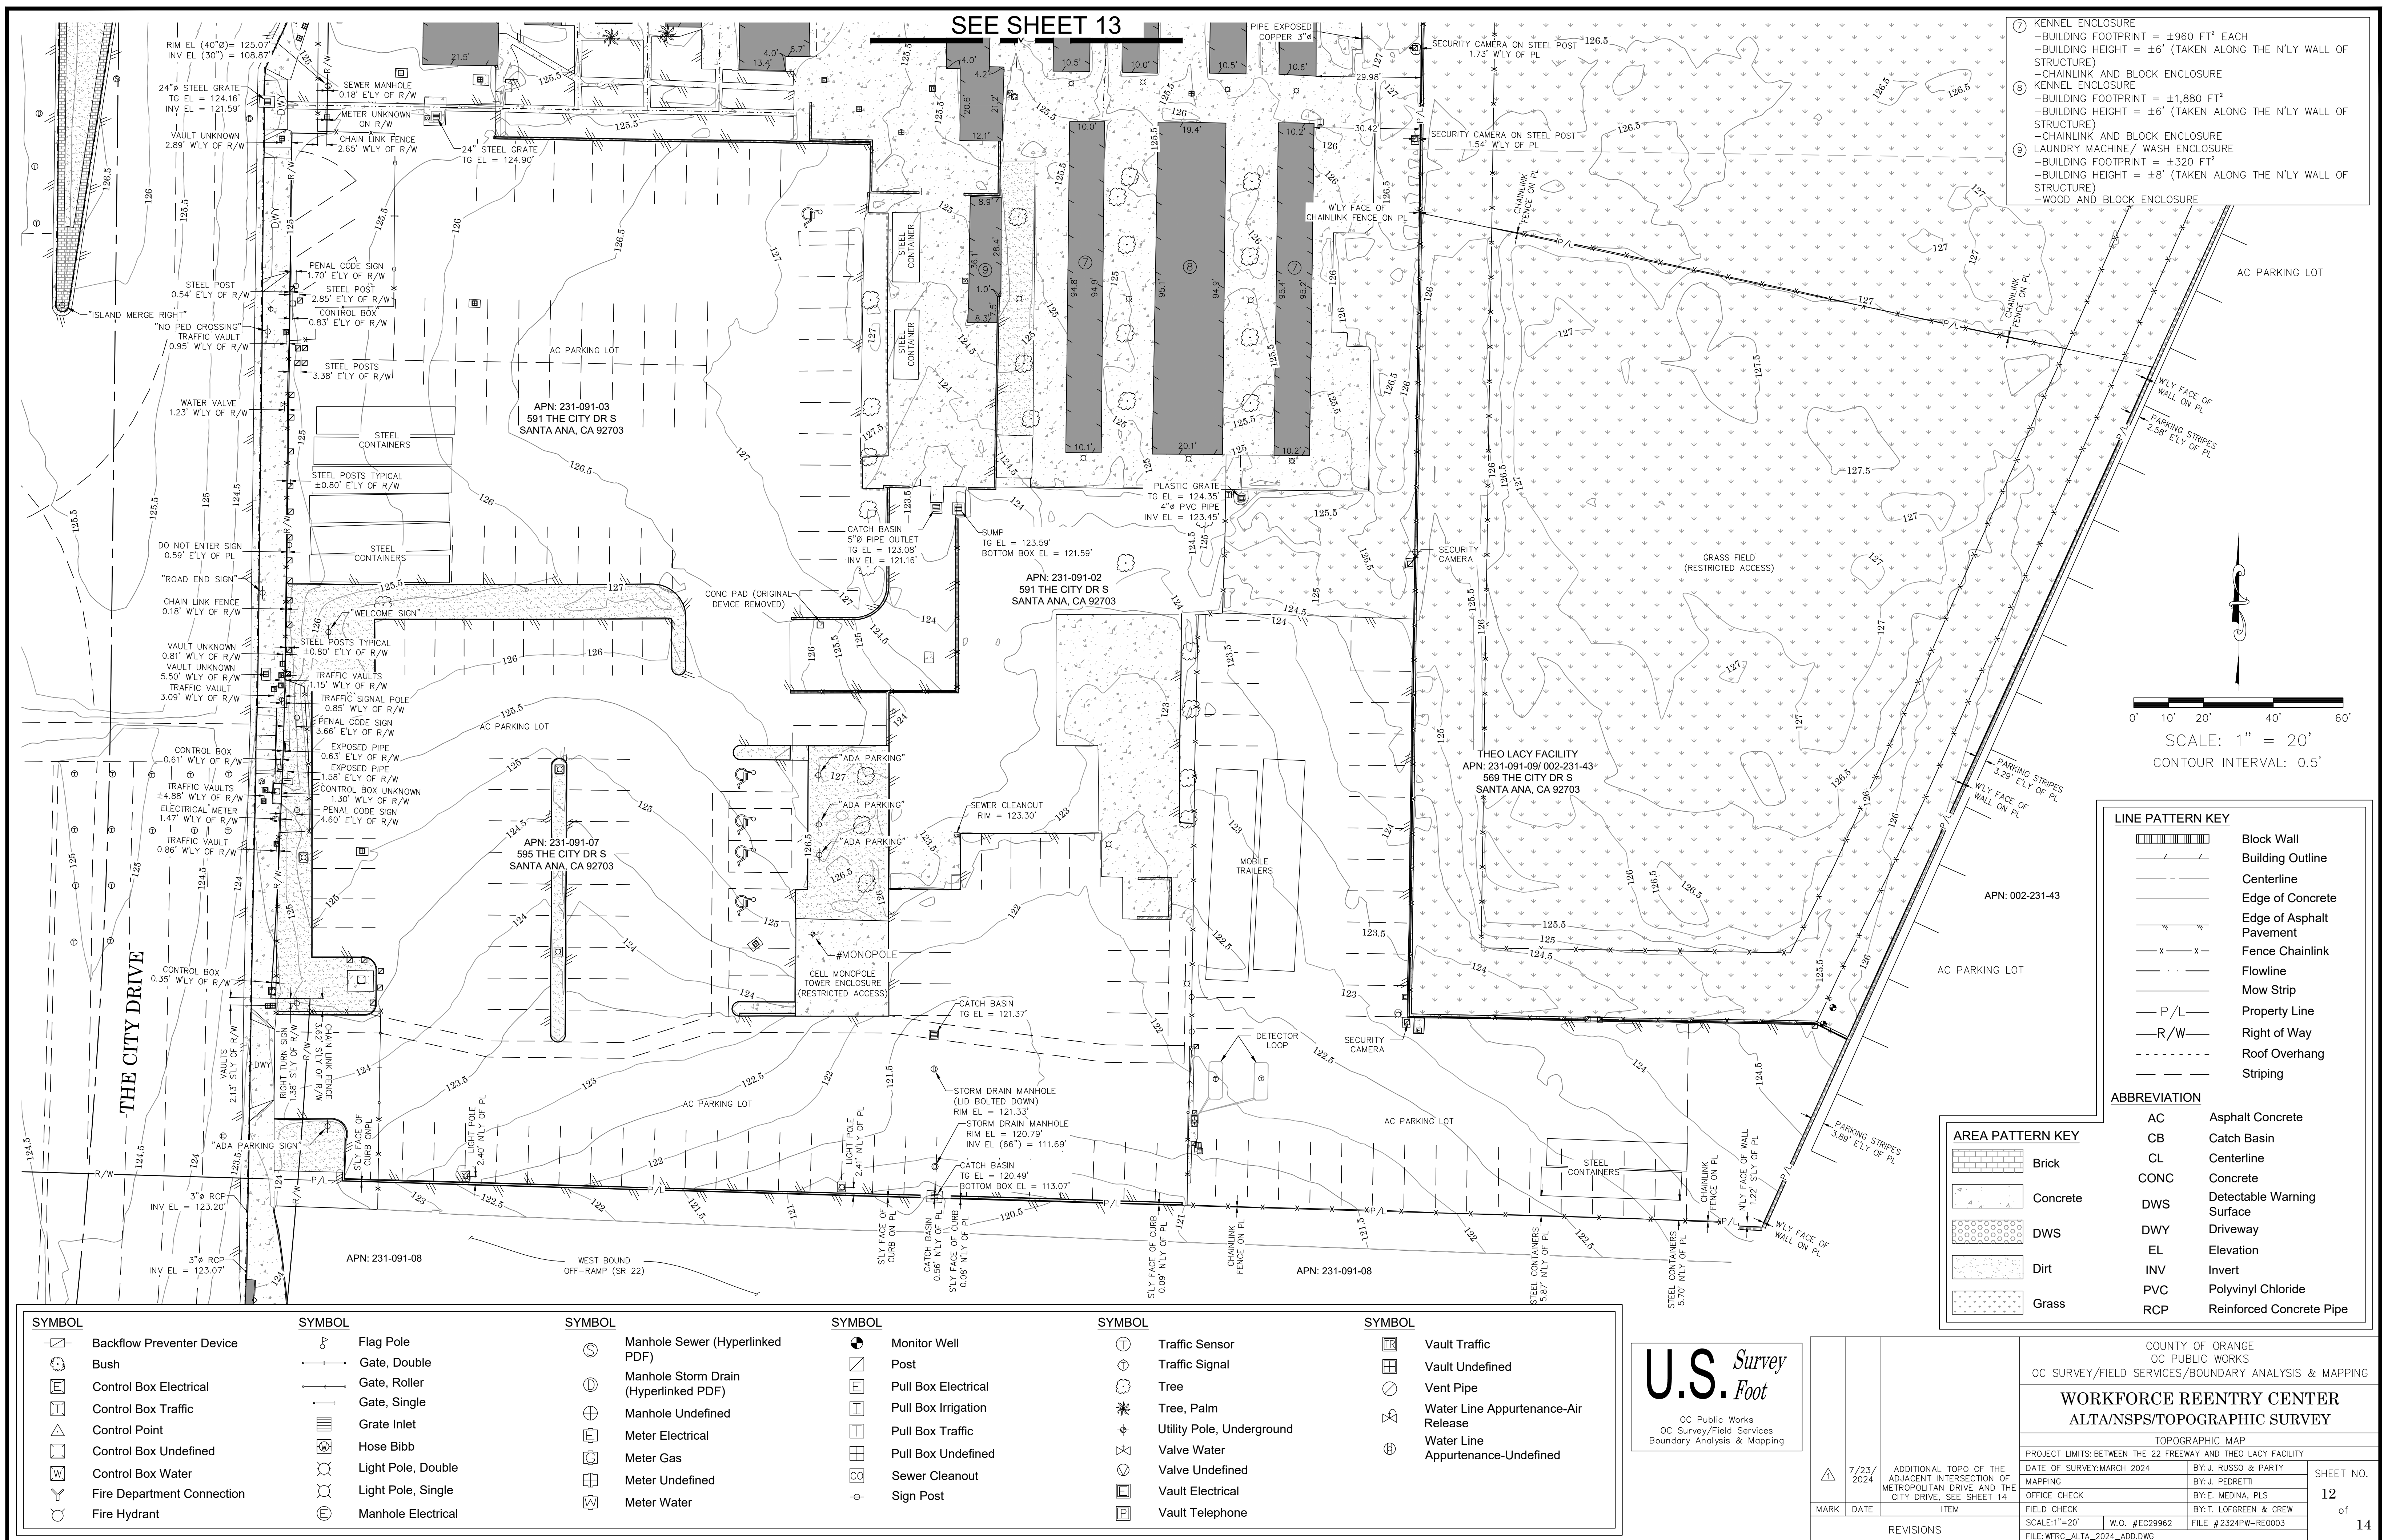


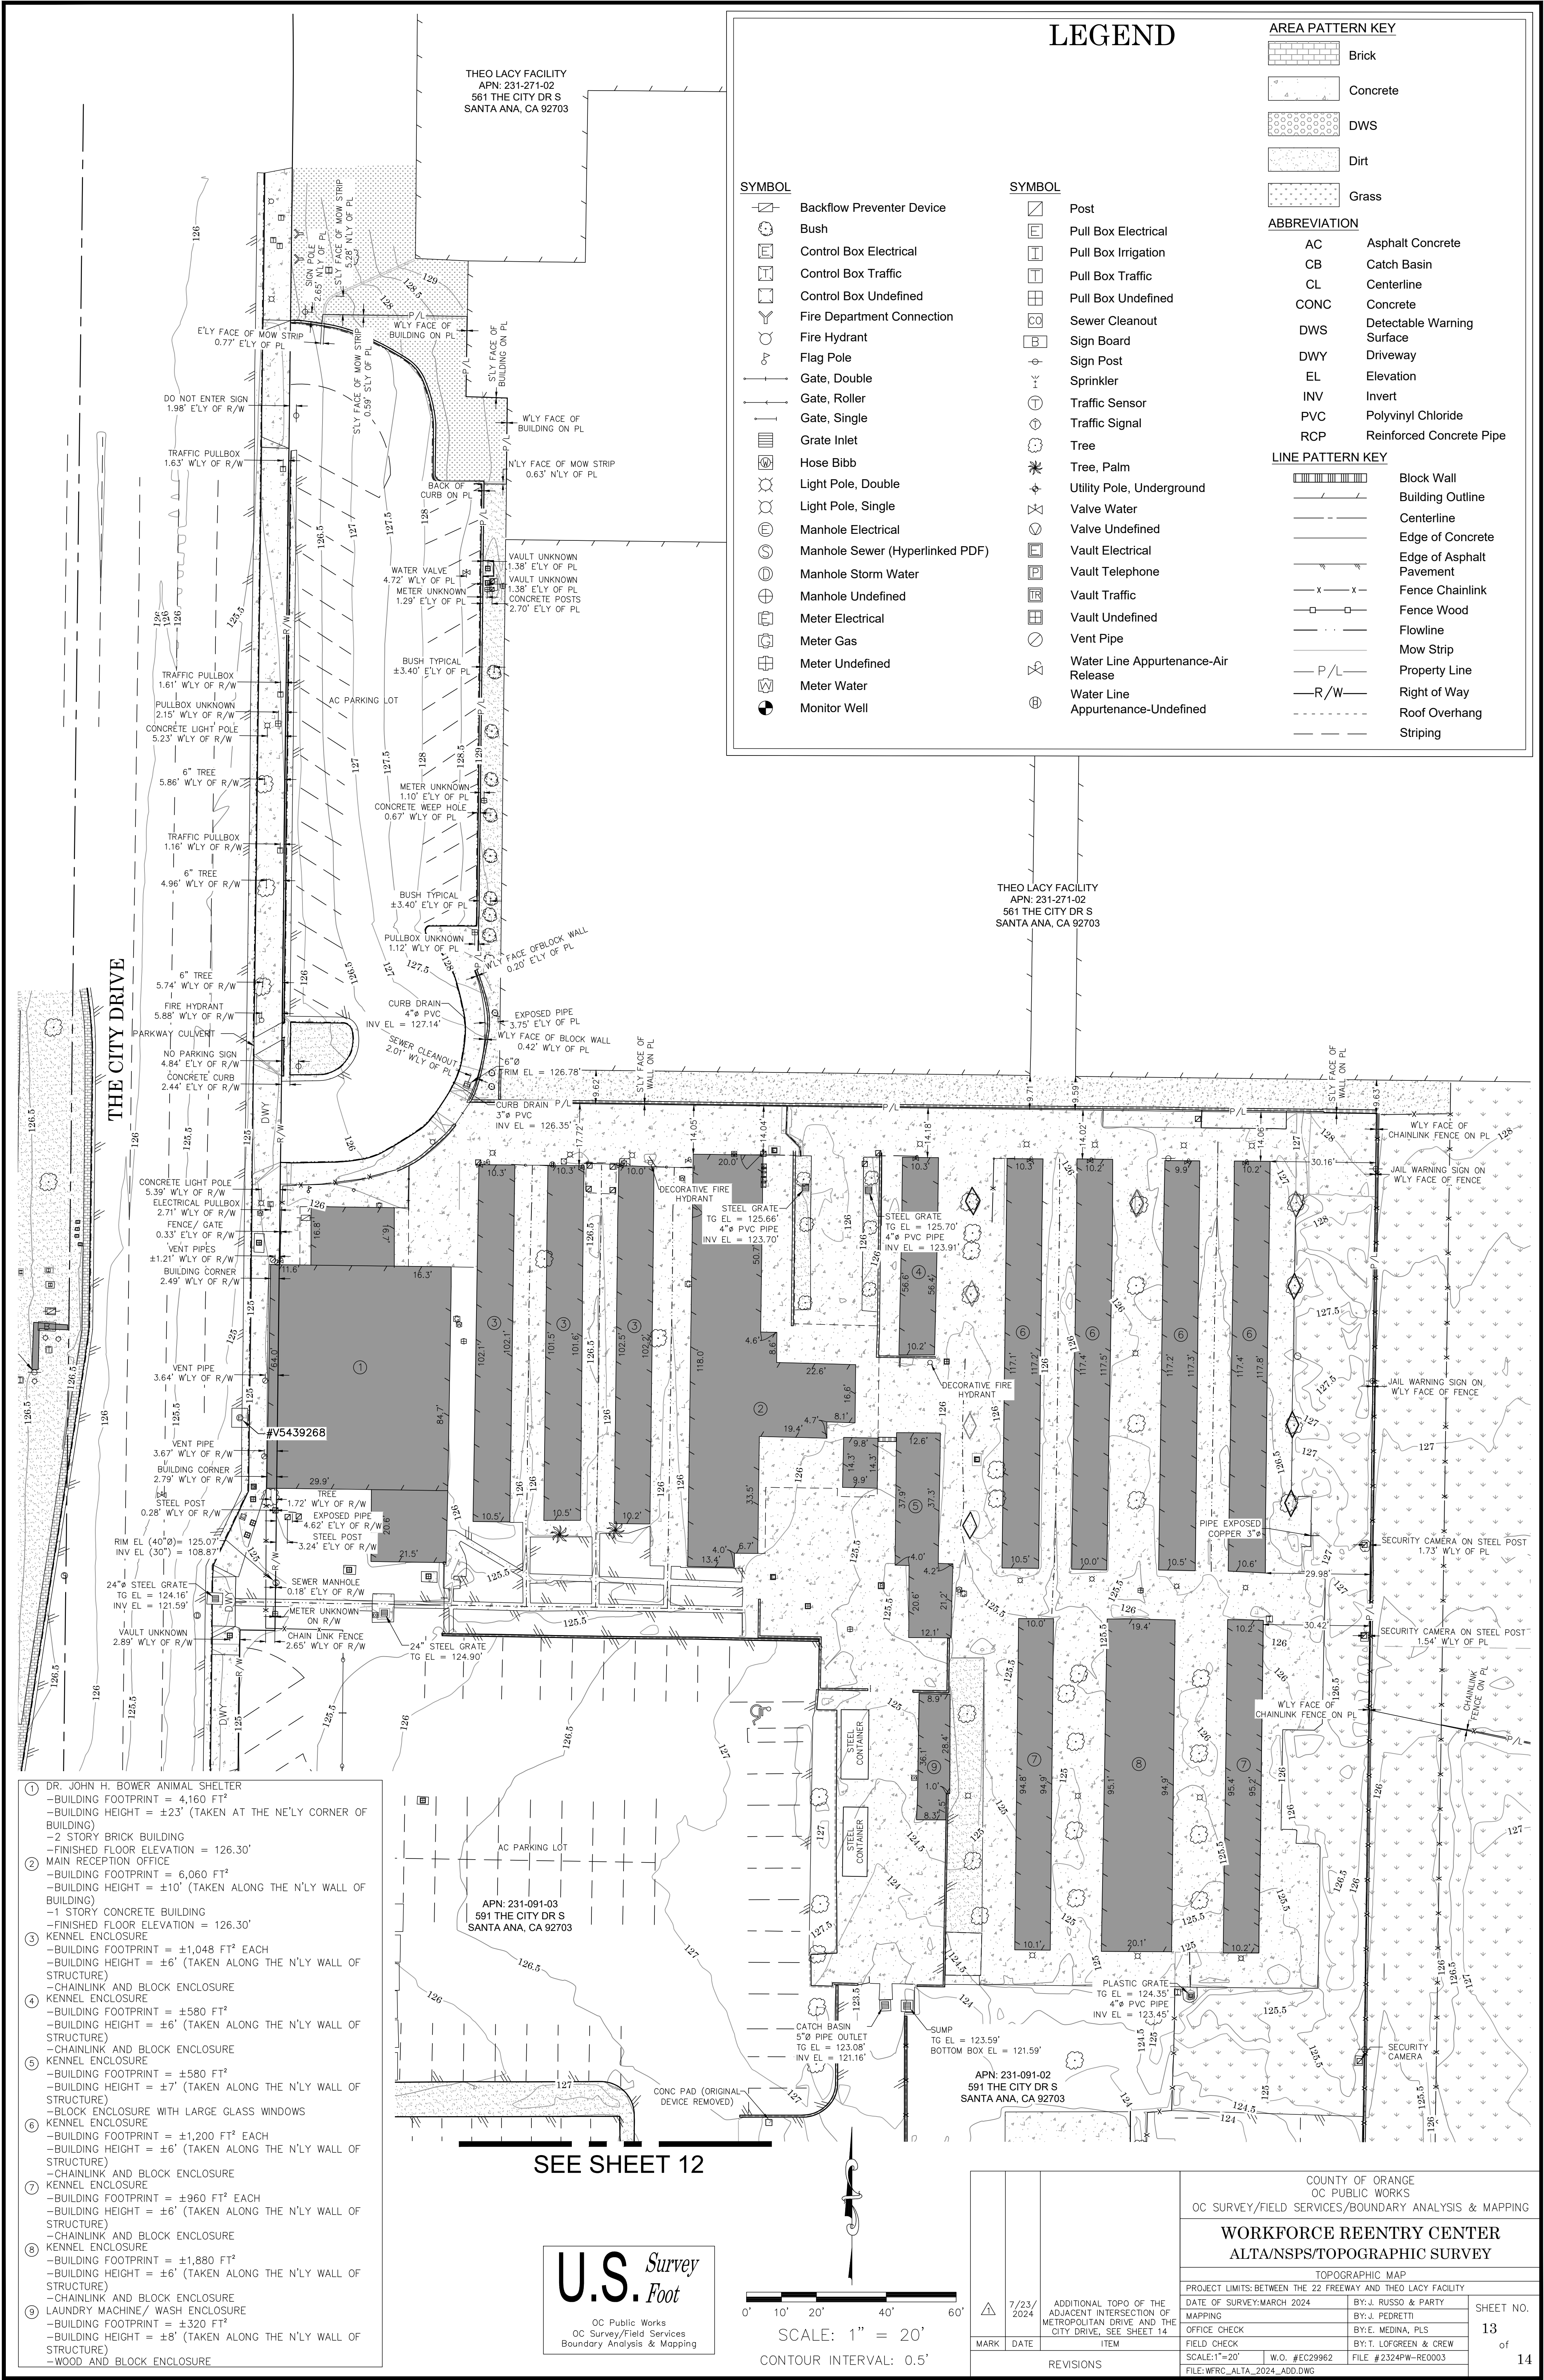





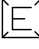

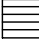




| | | | | | |
|--------------------------------------|-----------|------|--|--------------------------|--|
| <div> <div></div> <div></div> </div> | | | COUNTY OF ORANGE OC PUBLIC WORKS OC SURVEY/FIELD SERVICES/BOUNDARY ANALYSIS & MAPPING | | <div> <div>11</div> <div>of</div> <div>14</div> </div> |
| | | | COUNTY OF ORANGE ANIMAL SHELTER ALTA/NSPS SURVEY | | |
| | | | EASEMENT MAP | | |
| | | | PROJECT LIMITS: BETWEEN THE 22 FREEWAY AND THEO LACY FACILITY | | |
| | | | DATE OF SURVEY: MARCH 2024 | BY: T. LOFGREEN AND CREW | |
| | | | MAPPING | BY: T. LOFGREEN | |
| | | | OFFICE CHECK | BY: E. MEDINA, PLS | |
| | | | FIELD CHECK | BY: T. LOFGREEN | |
| | MARK | DATE | ITEM | | |
| | REVISIONS | | SCALE: 1" = 60' W.O. #EC29962 FILE #2324P-RE0003 FILE: Animal Shelter Boundary_2024.DWG | | |







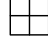
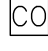
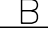
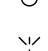

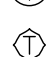


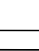







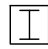


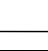


LEGEND






SYMBOL

- | | |
|---|---|
|  | Backflow Preventer Device |
|  | Bush |
|  | Control Box Electrical |
|  | Control Box Traffic |
|  | Control Box Undefined |
|  | Fire Department Connection |
|  | Fire Hydrant |
|  | Flag Pole |
|  | Gate, Double |
|  | Gate, Roller |
|  | Gate, Single |
|  | Grate Inlet |
|  | Hose Bibb |
|  | Light Pole, Double |
|  | Light Pole, Single |
|  | Manhole Electrical |
|  | Manhole Sewer (Hyperlinked PDF) |
|  | Manhole Storm Water |
|  | Manhole Undefined |
|  | Meter Electrical |
|  | Meter Gas |
|  | Meter Undefined |
|  | Meter Water |
|  | Monitor Well |

SYMBOL


- | | |
|--|-------------------------------------|
|  | Post |
|  | Pull Box Electrical |
|  | Pull Box Irrigation |
|  | Pull Box Traffic |
|  | Pull Box Undefined |
|  | Sewer Cleanout |
|  | Sign Board |
|  | Sign Post |
|  | Sprinkler |
|  | Traffic Sensor |
|  | Traffic Signal |
|  | Tree |
|  | Tree, Palm |
|  | Utility Pole, Underground |
|  | Valve Water |
|  | Valve Undefined |
|  | Vault Electrical |
|  | Vault Telephone |
|  | Vault Traffic |
|  | Vault Undefined |
|  | Vent Pipe |
|  | Water Line Appurtenance-Air Release |
|  | Water Line |
|  | Appurtenance-Undefined |

AREA PATTERN KEY

- | | |
|---|----------|
|  | Brick |
|  | Concrete |
|  | DWS |
|  | Dirt |
|  | Grass |
-
- | <u>ABBREVIATION</u> | |
|---------------------|----------------------------|
| AC | Asphalt Concrete |
| CB | Catch Basin |
| CL | Centerline |
| CONC | Concrete |
| DWS | Detectable Warning Surface |
| DWY | Driveway |
| EL | Elevation |
| INV | Invert |
| PVC | Polyvinyl Chloride |
| RCP | Reinforced Concrete Pipe |


LINE PATTERN KEY


- | | |
|--|--------------------------|
| | Block Wall |
| | Building Outline |
| | Centerline |
| | Edge of Concrete |
| | Edge of Asphalt Pavement |
| | Fence Chainlink |
| | Fence Wood |
| | Flowline |
| | Mow Strip |
| | Property Line |
| | Right of Way |
| | Roof Overhang |
| | Striping |

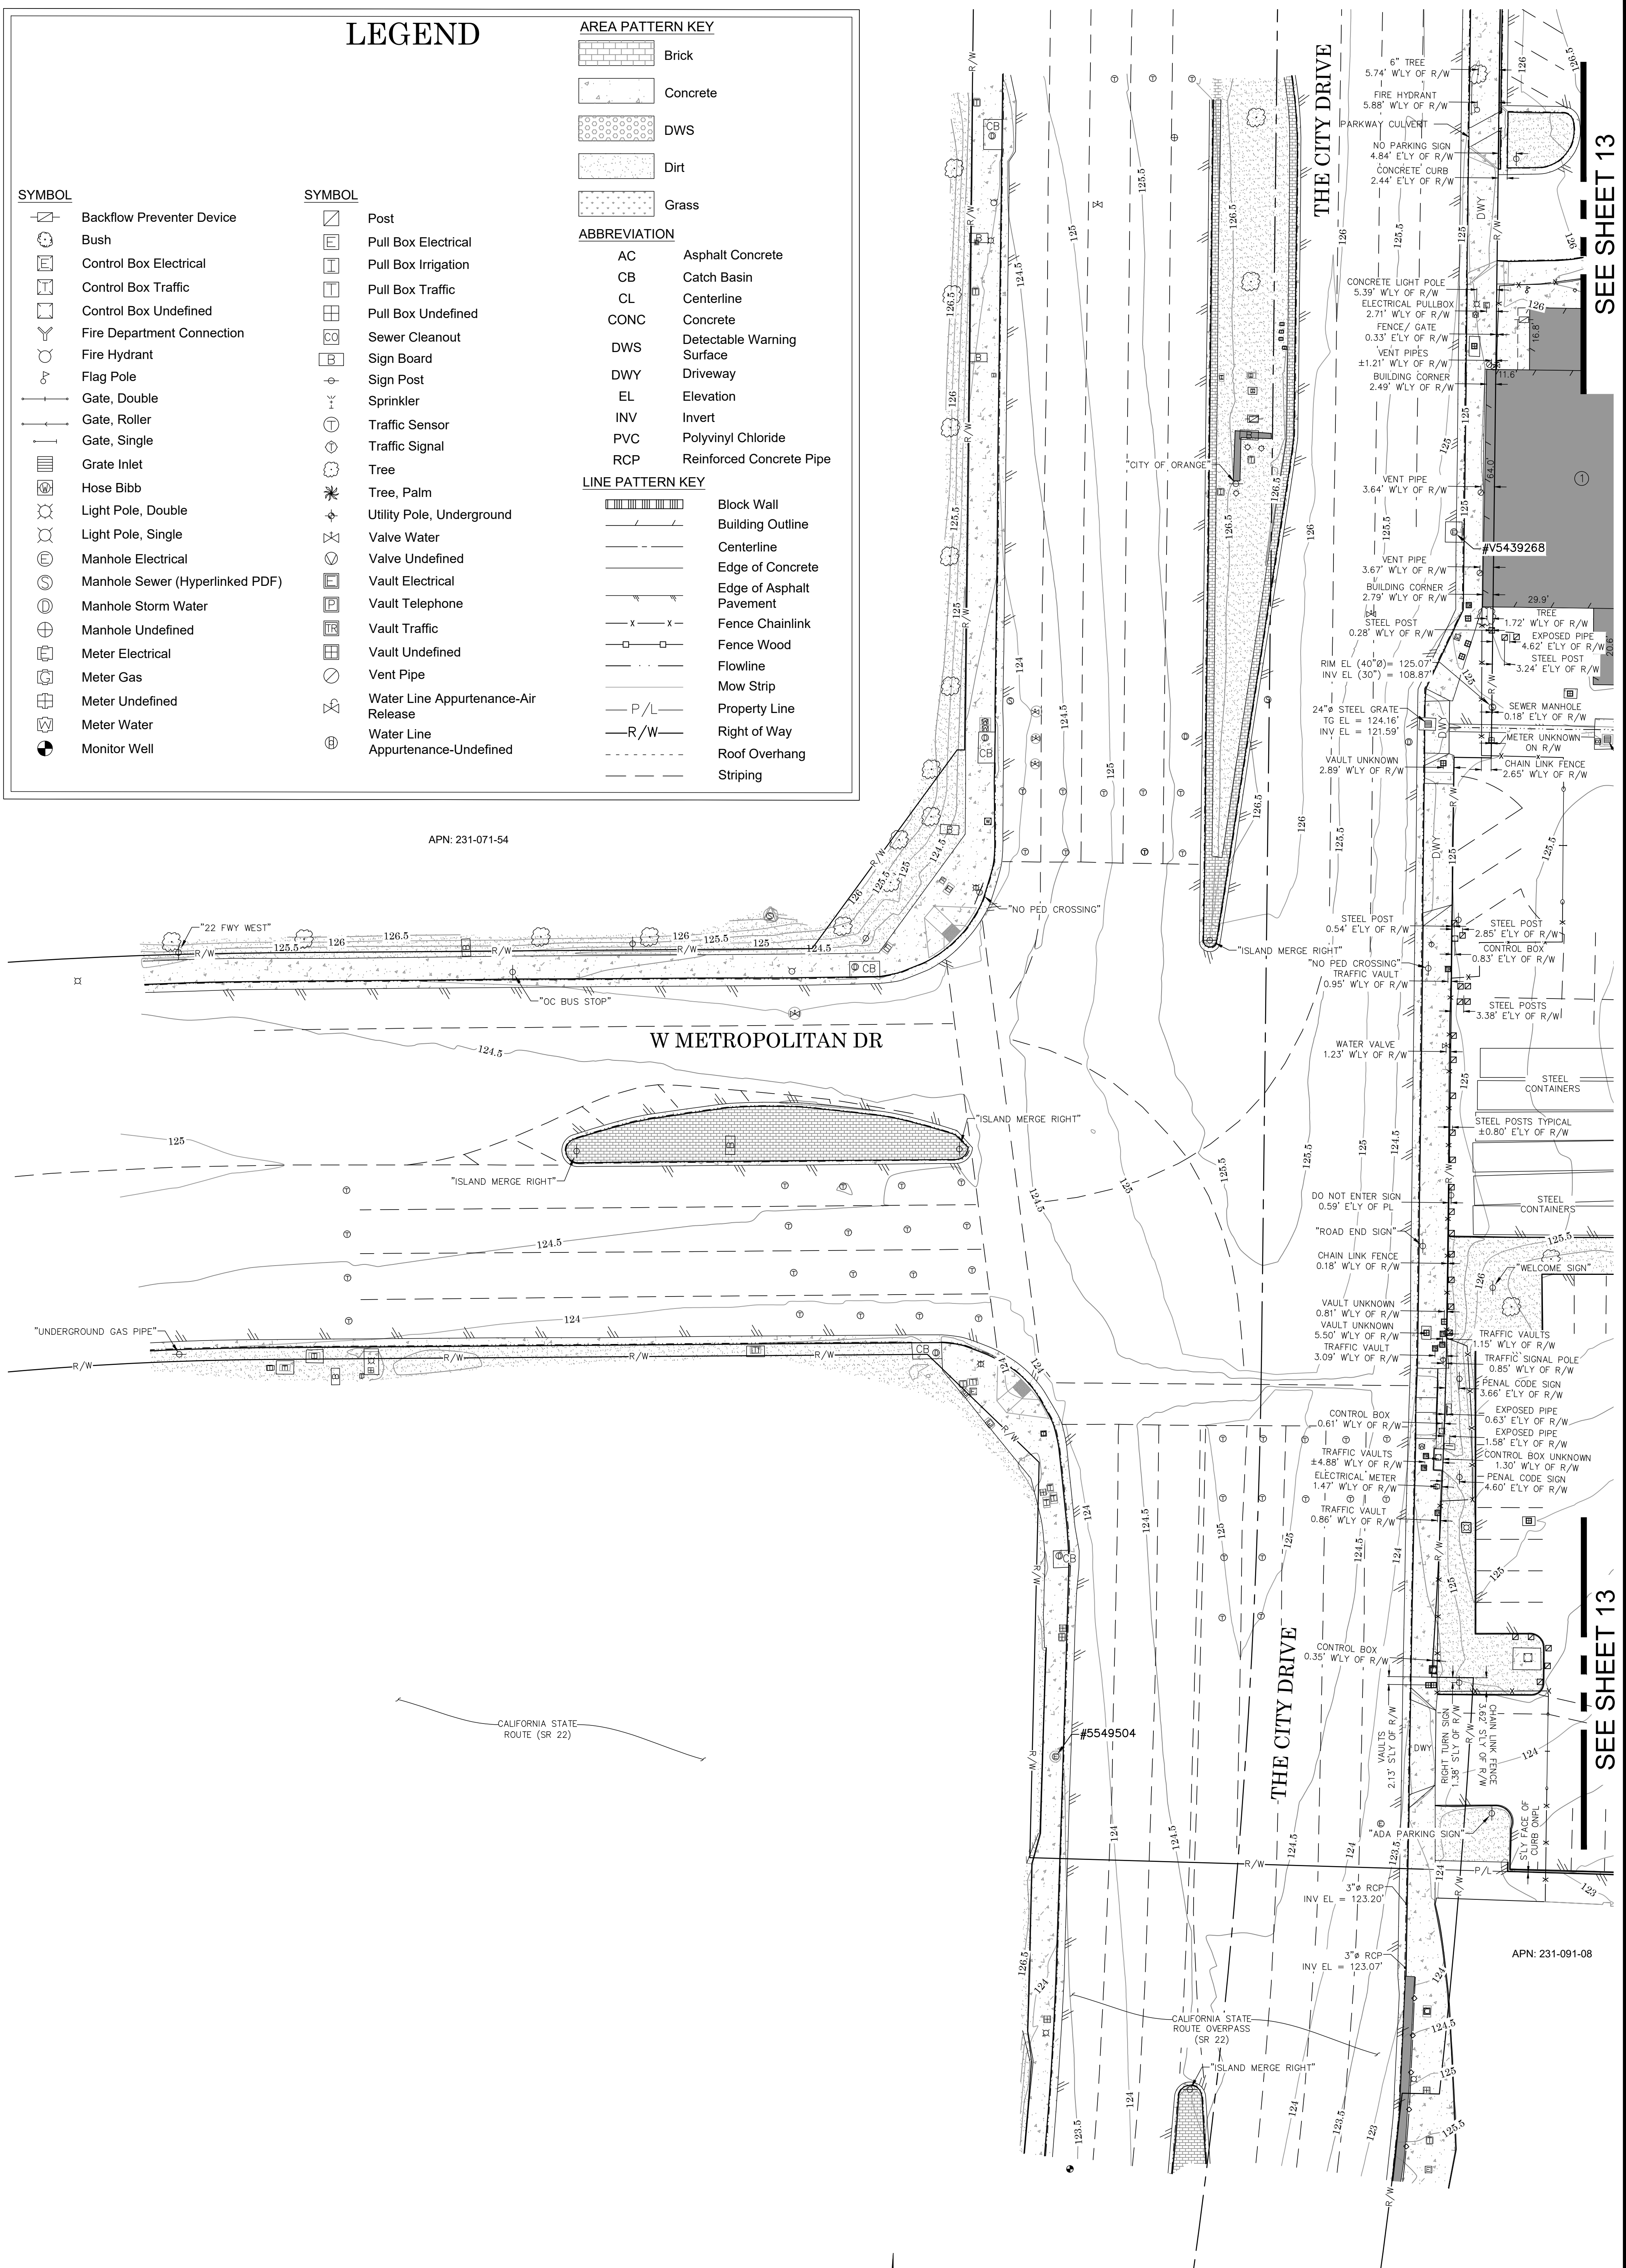

SEE SHEET 13

SEE SHEET 13

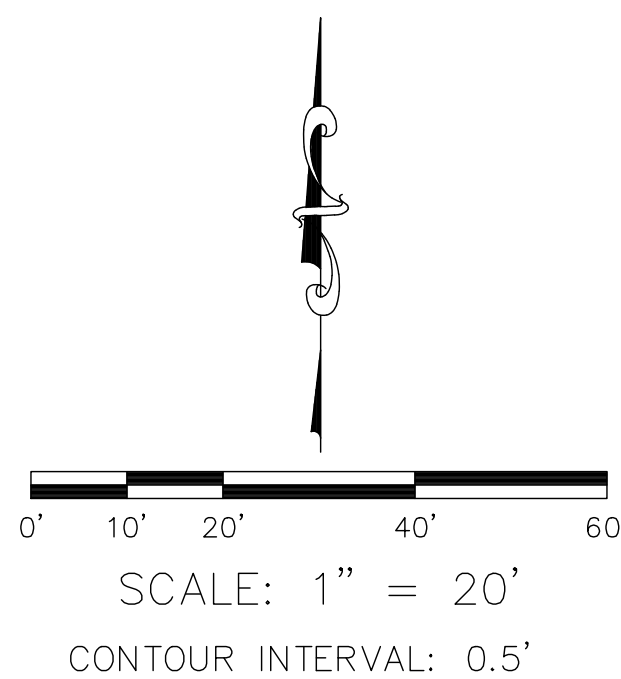

| | | | | | | | |
|---|-----------|--|---|---|--|---------------------------------|--|
|  | 7/23/2024 | ADDITIONAL TOPO OF THE ADJACENT INTERSECTION OF METROPOLITAN DRIVE AND THE CITY DRIVE, SEE SHEET 14 | | COUNTY OF ORANGE OC PUBLIC WORKS OC SURVEY/FIELD SERVICES/BOUNDARY ANALYSIS & MAPPING | | SHEET NO. 14 of 14 | |
| | MARK | | DATE | | WORKFORCE REENTRY CENTER ALTA/NSPS/TOPOGRAPHIC SURVEY | | |
| | ITEM | | TOPOGRAPHIC MAP | | | | |
| | REVISIONS | | PROJECT LIMITS: BETWEEN THE 22 FREEWAY AND THEO LACY FACILITY | | | | |
| | | | DATE OF SURVEY: MARCH 2024 | | BY: J. RUSSO & PARTY | | |
| | | MAPPING | | BY: J. PEDRETTI | | | |
| | | OFFICE CHECK | | BY: E. MEDINA, PLS | | | |
| | | FIELD CHECK | | BY: T. LOFGREEN & CREW | | | |
| | | SCALE: 1"=20' | | W.O. #EC29962 | | | |
| | | FILE: WRCR_ALTA_2024_ADD.DWG | | FILE #2324PW-RE0003 | | | |