



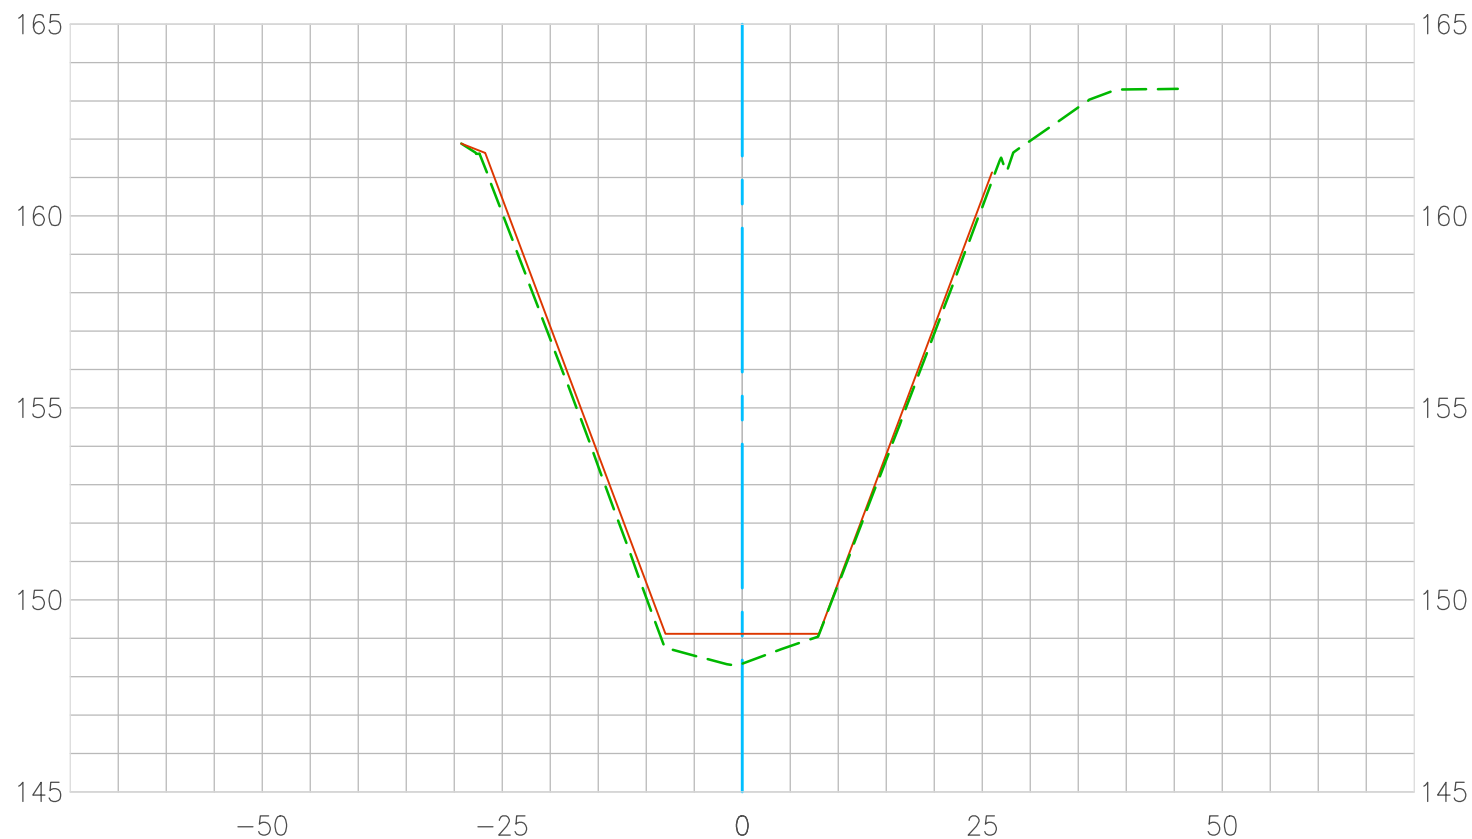

# COLLINS CHANNEL (E07)

## 5+37.66

### CL

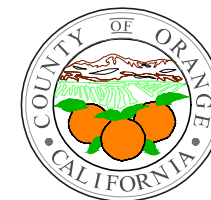

Existing Condition 2018  
Record Plan  
E07-101-2 (1959)



DATE PREPARED: 06/12/2019

Horizontal Scale 1" = 20'  
Vertical Scale 1" = 5'