


CONDUCTOR SCHEDULE									
AWG	CIRCUIT	1	2	3	4	5	6	7	8
#14	Ø1	—	—	—	—	—	3	3	3
	Ø2	3	3	—	—	—	3	3	3
	Ø4	—	3	—	—	—	3	6	6
	Ø6	—	—	—	3	3	3	3	3
	Ø2PB	2	2	2	—	—	—	2	2
	Ø2PPB	—	1	1	—	—	—	1	1
#10	PPB COMMON	—	1	1	—	—	—	1	1
	SPARES	3	3	3	3	3	3	6	6
#10	TOTAL	8	13	7	6	6	12	25	25
	LUMINAIRE	2	2	2	2	2	2	2	2
#10	ILLUM. ST. NAME SIGN	2	2	2	2	2	2	2	2
	TOTAL	4	4	4	4	4	4	4	4
TYPE "B" DLC	Ø1	—	—	—	—	1	1	1	1
	Ø2	—	—	—	—	—	—	—	2
	Ø4	—	2	2	—	—	—	—	2
	TOTAL	—	2	2	—	1	1	3	5
EVP		—	—	—	—	—	2	2	2
SIC		—	—	—	—	—	—	—	—
CONDUIT SIZES (INCHES)		2"	2"	2"	2"	2"	2"	2"	2-3"

ALL CONDUCTORS AND CONDUITS ARE EXISTING.
PPB = PED PUSH BUTTON

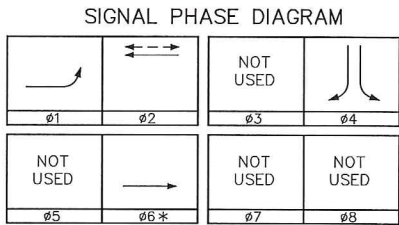


MONARCH BAY PLAZA ENTRANCE

POLE SCHEDULE													
POLE LOCATION	SIGNAL STANDARD			LUMINAIRE SIZE/TYPE	MOUNTINGS			PEDESTRIAN PUSH BUTTON			POLE LOCATION		I.I.S.N.S.
	TYPE	MAST ARM			VEHICLE		PEDESTRIAN	PHASE	TYPE	QUAD	A	B	
		SIG.	LUM.		POLE	MAST ARM							
(A)	19-2-70	25'	12'	250W	SV-1-T	MAS	SP-1-T	-	-	-	EXISTING	EXISTING	Monarch Bay Plaza
(B)	1-A	-	-	-	TV-1-T	-	-	Ø2	A	W	EXISTING	EXISTING	-
(C)	PPB POST	-	-	-	-	-	-	Ø2	B	E	EXISTING	EXISTING	-
(D)	1-A	-	-	-	TV-2-T	-	SP-1-T	-	-	-	EXISTING	EXISTING	-
(E)	19-2-70	25'	12'	250W	SV-1-T	MAS	-	-	-	-	EXISTING	EXISTING	Monarch Bay Plaza
(F)	19-2-70	15'	-	-	SV-2-TA	MAS	-	-	-	-	EXISTING	EXISTING	-

ALL EQUIPMENT IS EXISTING.
(A) = ANADODE PUSH BUTTON, (B) = BULL DOG PUSH BUTTON.

EXISTING SIGNS ON THIS SHEET

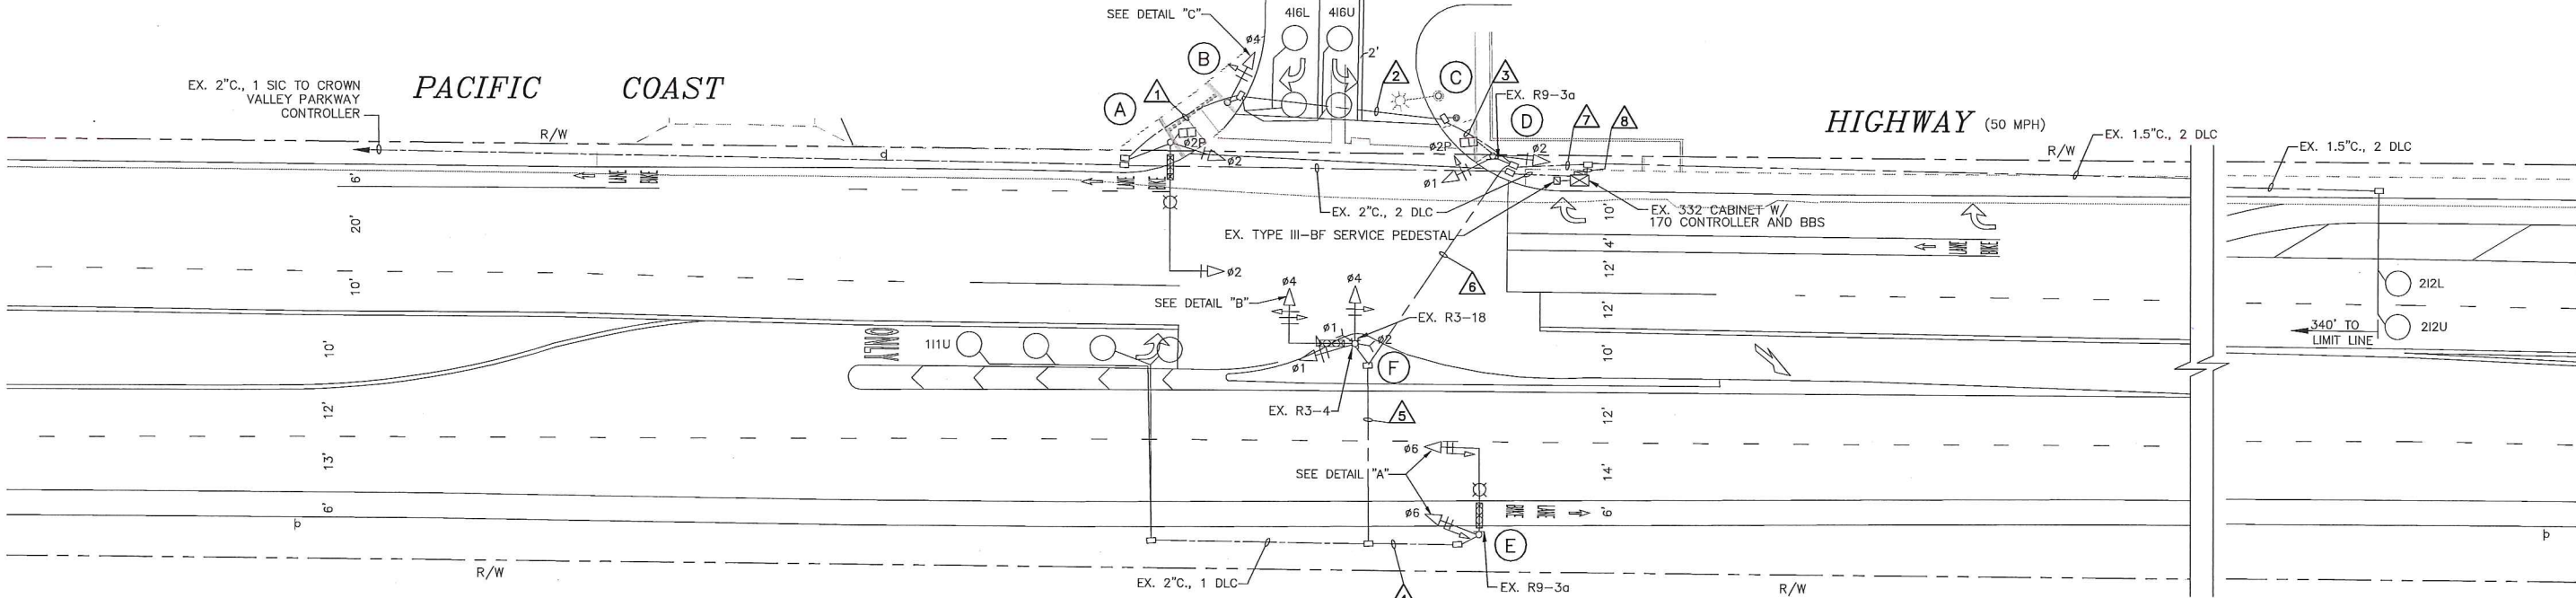

GENERAL NOTES:

- THIS PLAN IS BEING GENERATED TO DOCUMENT AS-BUILT CONDITIONS, AND TO REVIEW THE IN PLACE TRAFFIC SIGNAL INSTALLATION TO VERIFY COMPLIANCE WITH CURRENT APPLICABLE REGULATIONS. UNDERGROUND UTILITY CONSTRUCTION IS NOT A PART OF THE ENGINEER'S REVIEW, BUT IS SHOWN FOR INFORMATIONAL PURPOSES ONLY PER PREVIOUS AS-BUILT PLANS.
- TRAFFIC SIGNAL AND HIGHWAY LIGHTING CONSTRUCTION SHOWN HEREON CONFORMED TO THE VERSION OF THE STATE OF CALIFORNIA DEPARTMENT OF TRANSPORTATION STANDARD PLANS AND SPECIFICATIONS AND THE CALIFORNIA MANUAL OF UNIFORM TRAFFIC CONTROL DEVICES THAT WAS CURRENT AT THE TIME THE TRAFFIC SIGNAL WAS INSTALLED.
- TRAFFIC SIGNAL PHASING AND SIGNAL TIMING IN PLACE AT THE INTERSECTION SHALL BE AS DIRECTED BY THE CITY ENGINEER OR HIS DESIGNATED REPRESENTATIVE.

RECORD DRAWING

THIS SET OF RECORD DRAWINGS HAS BEEN PREPARED BASED ON VERIFICATION OF ACTUAL FIELD CONDITIONS. THE ENGINEER CERTIFIES THAT ON STREET CONDITIONS ARE ACCEPTABLE PER APPLICABLE TRAFFIC DESIGN GUIDELINES (I.E. CALIFORNIA MUTCD/CALTRANS STANDARD PLANS, ETC.) AND ARE ACCEPTABLE IN MY PROFESSIONAL OPINION AS A REGISTERED TRAFFIC ENGINEER IN THE STATE OF CALIFORNIA.

Name: *[Signature]* Date: *6/19/17*

CALIFORNIA REGISTRATION TR




12", 3-SECTION VEHICLE HEAD
NO SCALE



12", 4-SECTION VEHICLE HEAD
NO SCALE



12", 5-SECTION VEHICLE HEAD
NO SCALE

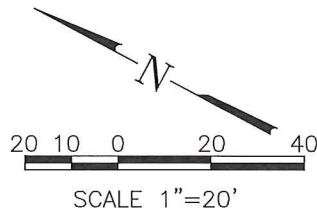

--	--	
n:\3200\2113225-1 - city of dana point on-call services 2011 fye 2012, dana point\2017 traffic signal record drawings\sch at monarch bay plaza\3225 sch - monarch bay record drawing 2017.dwg LDP 11:55:05 06-16-2017 milano