




- 1 INSTALL "TYPE B" TELEPHONE DEMARCATION CABINET (TDM) PER CALTRANS STD PLAN NO. ES-3E.
- 2 INSTALL 2" CONDUIT FROM TDM TO TRAFFIC SIGNAL PULLBOX.
PULL 2 PAIR #22 TELEPHONE CABLE FROM TDM TO CONTROLLER CABINET.
- 6 INSTALL 2" PVC CONDUIT AND 10' RISER TO POWERPOLE. COORDINATE
WITH PAC BELL REPRESENTATIVE, MR. STEVEN WIGGS, AT (714) 237-6950.
- 7 INSTALL 30A BREAKER IN EXISTING "TYPE III" SERVICE CABINET FOR
TDM POWER. PULL 2 #12 CONDUCTORS FROM SERVICE CABINET TO TDM TO PROVIDE
120V SERVICE.

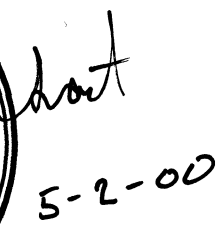

APPROVED: _____

DATE _____

[illegible]

SCALE: 1"=40'		DATE
DRAWN BY	C. VIANA	4/00
CHECKED BY	S. BARNHART	4/00
APPROVED	PRINCIPAL TRAFFIC ENGINEER	
APPROVED	SEE FILE SHEET NO. 6150 FOR APPROVALS	

SHEET 4 OF 5

PLAN
NUMBER
23153