

DRAWING NUMBER
PORT AVE @
MA DR

DRAWING NUMBER
170.7

DRAWING NUMBER

DRAWING NUMBER

POLE SCHEDULE												
POLE DATA			SIGNAL	H.P.S.V. LUMINAIRE	SIGNAL MOUNTING			PED. PUSH BUTTON	FOUNDATION		ISNS TYPE 'A'	
NO.	TYPE	HEIGHT	M.A.	M.A. WATTS	VEH.	M.A.	PED.	PHASE	POLE QUAD	TYPE	SIZE	(DOUBLE FACE)
1	1A	10'			TV-1-T (5 SECT)					S	2'-0"x3'-0"	
2	26-4-70	30'	40'	15'	250	SV-1-T	2 MAS (M) SP-1-CS (R) SP-1-CS			C	3'-0"x3'-0"	La Loma
3	1A	10'				TV-1-T		2	SE	S	2'-0"x3'-0"	
4	TYPE 15	30'		12'	200	SV-1-T			SE	C	2'-6"x5'-0"	
5	1A	10'				TV-1-T		8	NW	S	2'-0"x3'-0"	
6	26-4-70	30'	40'	15'	250	SV-1-T	2 MAS SP-1-CS	8	SW	S	3'-0"x3'-0"	La Loma
7	1A	10'				TV-1-T		6	NW	S	2'-0"x3'-0"	
8	TYPE 15	30'		12'	200	SV-1-T		6	NW	C	2'-6"x5'-0"	

EXACT POLE LOCATIONS BY ENGINEER IN THE FIELD.
POTHOLE MAST ARM POLE FOUNDATION LOCATIONS
PRIOR TO ORDERING POLES.

C = C.I.D.H.
S = SQUARE.

PHASE		DIAGRAM							
VEHICULAR & PEDESTRIAN MOVEMENTS									
NEMA PHASE	Ø1	Ø2	Ø3	Ø4	Ø5	Ø6	Ø7	Ø8	
COORDINATION FUNCTION	*	*	*	*	*	*	*	*	*
* DETERMINED BY MASTER COMPUTER DURING COORDINATED OPERATION.									
SEQUENCE WITH CALLS ON ALL PHASES.									

(NEW)		
INDUCTIVE LOOP DETECTOR SCHEDULE		
SENSOR UNIT	CHANNEL	DETECTOR
# 1	1	1-Ø5 (1)
	2	1-Ø2 (2)
# 2	1	3-Ø2 (3)
	2	3-Ø2
# 3	1	4-Ø1 (4)
	2	5-Ø6 (5)
# 4	1	6-Ø6 (6)
	2	3-Ø6
# 5	1	7-Ø4
	2	SPARE
# 6	1	8-Ø8
	2	2-Ø8

☒ - DETECTOR LOOP LOCATIONS SHALL BE APPROVED BY ENGINEER IN FIELD PRIOR TO INSTALLATION. ALL DETECTOR UNITS SHALL BE SHELF MOUNTED, DUAL CHANNEL, DUAL OUTPUT PER CHANNEL WITH INTEGRAL COLORGATED EXTENSION AND DELAY CAPABILITY. OUTPUT 'A' SHALL BE TIMED. OUTPUT 'B' SHALL BE PRESENCE MODE FOR SYSTEM SAMPLING ONLY. NO EXTENSIONS ON RED.

(##) - SYSTEM SAMPLER NUMBER
** - VEHICLE COUNTING SYSTEM NUMBER
* - 10-30 SEC DELAY

(EXISTING)		
INDUCTIVE LOOP DETECTOR SCHEDULE		
SENSOR UNIT	CHANNEL	DETECTOR
# 1	1	1EØ6 ▲
	2	1EØ6 ☒
# 2	1	1WØ2 ▲
	2	1WØ2 ☒
# 3	1	
	2	
# 4	1	1NØ4
	2	
# 5	1	4EØ6
	2	

▲ = CALL HOLD CAPABILITY (Ø-7 SEC)
☒ = SYSTEM SAMPLING


CONSTRUCTION NOTES:

- RELOCATE EXISTING SIGNAL PULL BOX OUT OF WHEEL CHAIR RAMP AREA.
- INSTALL DETECTOR LOOPS AS INDICATED.
- INSTALL 3/2" P.B.
- INSTALL 2" CONDUIT.
- REMOVE EXISTING PEDESTRIAN BARRICADES.
- PROVIDE AND INSTALL PEDESTRIAN BARRICADES AND SIGNS ON BOTH SIDES OF POST PER CALTRAN STANDARD PLAN ES-5F TYPE I.
- CONSTRUCT WHEEL CHAIR RAMP PER OCEMA STD. PLAN 102-0-OC.
- PROVIDE AND INSTALL 2 ADDITIONAL CONDUCTORS FOR FUTURE PROTECTED/PERMISSIVE PHASING.
- REWIRE CONTROLLER CABINET FOR DETECTION AND OPERATION INDICATED.
- REMOVE EXISTING CONDUCTORS AND REWIRE INTERSECTION PER SCHEDULES AND SPECIAL PROVISIONS.
- PROVIDE AND INSTALL VEHICLE COUNTING SYSTEM.
- REMOVE EXISTING SIGNAL FOUNDATION.
- REMOVE AND SALVAGE EXISTING SHELF MOUNT DETECTORS AND HARNESS.
- REMOVE TOP 18" OF EXISTING SIGNAL FOUNDATION AND CAP WITH CONCRETE.
- PROVIDE AND INSTALL 2 CHANNEL SHELF MOUNT VEHICLE COUNTING DETECTOR AMPLIFIERS WITH EXTEND AND DELAY CAPABILITIES AND NEW HARNESS PER DETECTOR SCHEDULE AND SPECIAL PROVISIONS.
- REMOVE AND SALVAGE EXISTING 820 CONTROLLER.
- PROVIDE AND INSTALL VCS PANEL WITH VCS HARNESS (MULTISONICS PART No. 016050 OR EQUAL).
- PROVIDE AND INSTALL A NEW MULTISONICS 820A CONTROLLER FOR OPERATION INDICATED.
- REMOVE EXISTING STREET NAME SIGN AND POST.

- INSTALL 3" CONDUIT PER SCHEDULE.
- INSTALL EVP CABLE FROM END OF MASTARM TO CABINET AND COIL 15 FEET OF LEAD CABLE IN SIDE CABINET.
- REMOVE EXISTING AND CONSTRUCT NEW P.C. CONCRETE CONTROLLER CABINET FOUNDATION FOR EXISTING TYPE 'P' CABINET AND SCHEDULE.
- RELOCATE EXISTING CABINET AND ASSEMBLY ONTO NEW FOUNDATION.

CONDUCTOR SCHEDULE						CONDUCTOR SCHEDULE							
AWG	CIRCUIT	RUN					AWG	CIRCUIT	RUN				
		1	2	3	4	5			1	2	3	4	5
# 14	Ø1		3	3	3	3	# 14	ISNS	2	2	2	2	4
	Ø2	3				3		SPARES	3	3	3	3	6
								TOTAL	23	21	27	27	49
	Ø4			3	3	3	# 10	SIGNAL COMMON	1	1	1	1	2
	Ø5	5				5		LUMINAIRE	2	2	2	2	4
	Ø6	3	3	3	3	3		TOTAL	3	3	3	3	6
	Ø8	3	3	3	3	6	# 20	EVP	1		1	1	2
	Ø2P	2	2	2	2	4		TOTAL	1		1	1	2
	Ø6P			2	2	4	DLC	Ø2		4	4	4	4
	Ø8P		2	2	2	2		Ø4	1				1
	Ø2PPB	1	1	1	1	2		Ø6					4
								Ø8				2	2
Ø6PPB			1	1	1	TOTAL		1	4	4	6	11	
Ø8PPB		1	1	1	1								
PPB COMMON	1	1	1	1	2								
() = EXISTING BOLD NO. = NEW						CONDUIT SIZE		(2")	(2")	(2")	(2")	(2-2")	
										3"	3"	2-2"	

() = EXISTING
BOLD No. = NEW

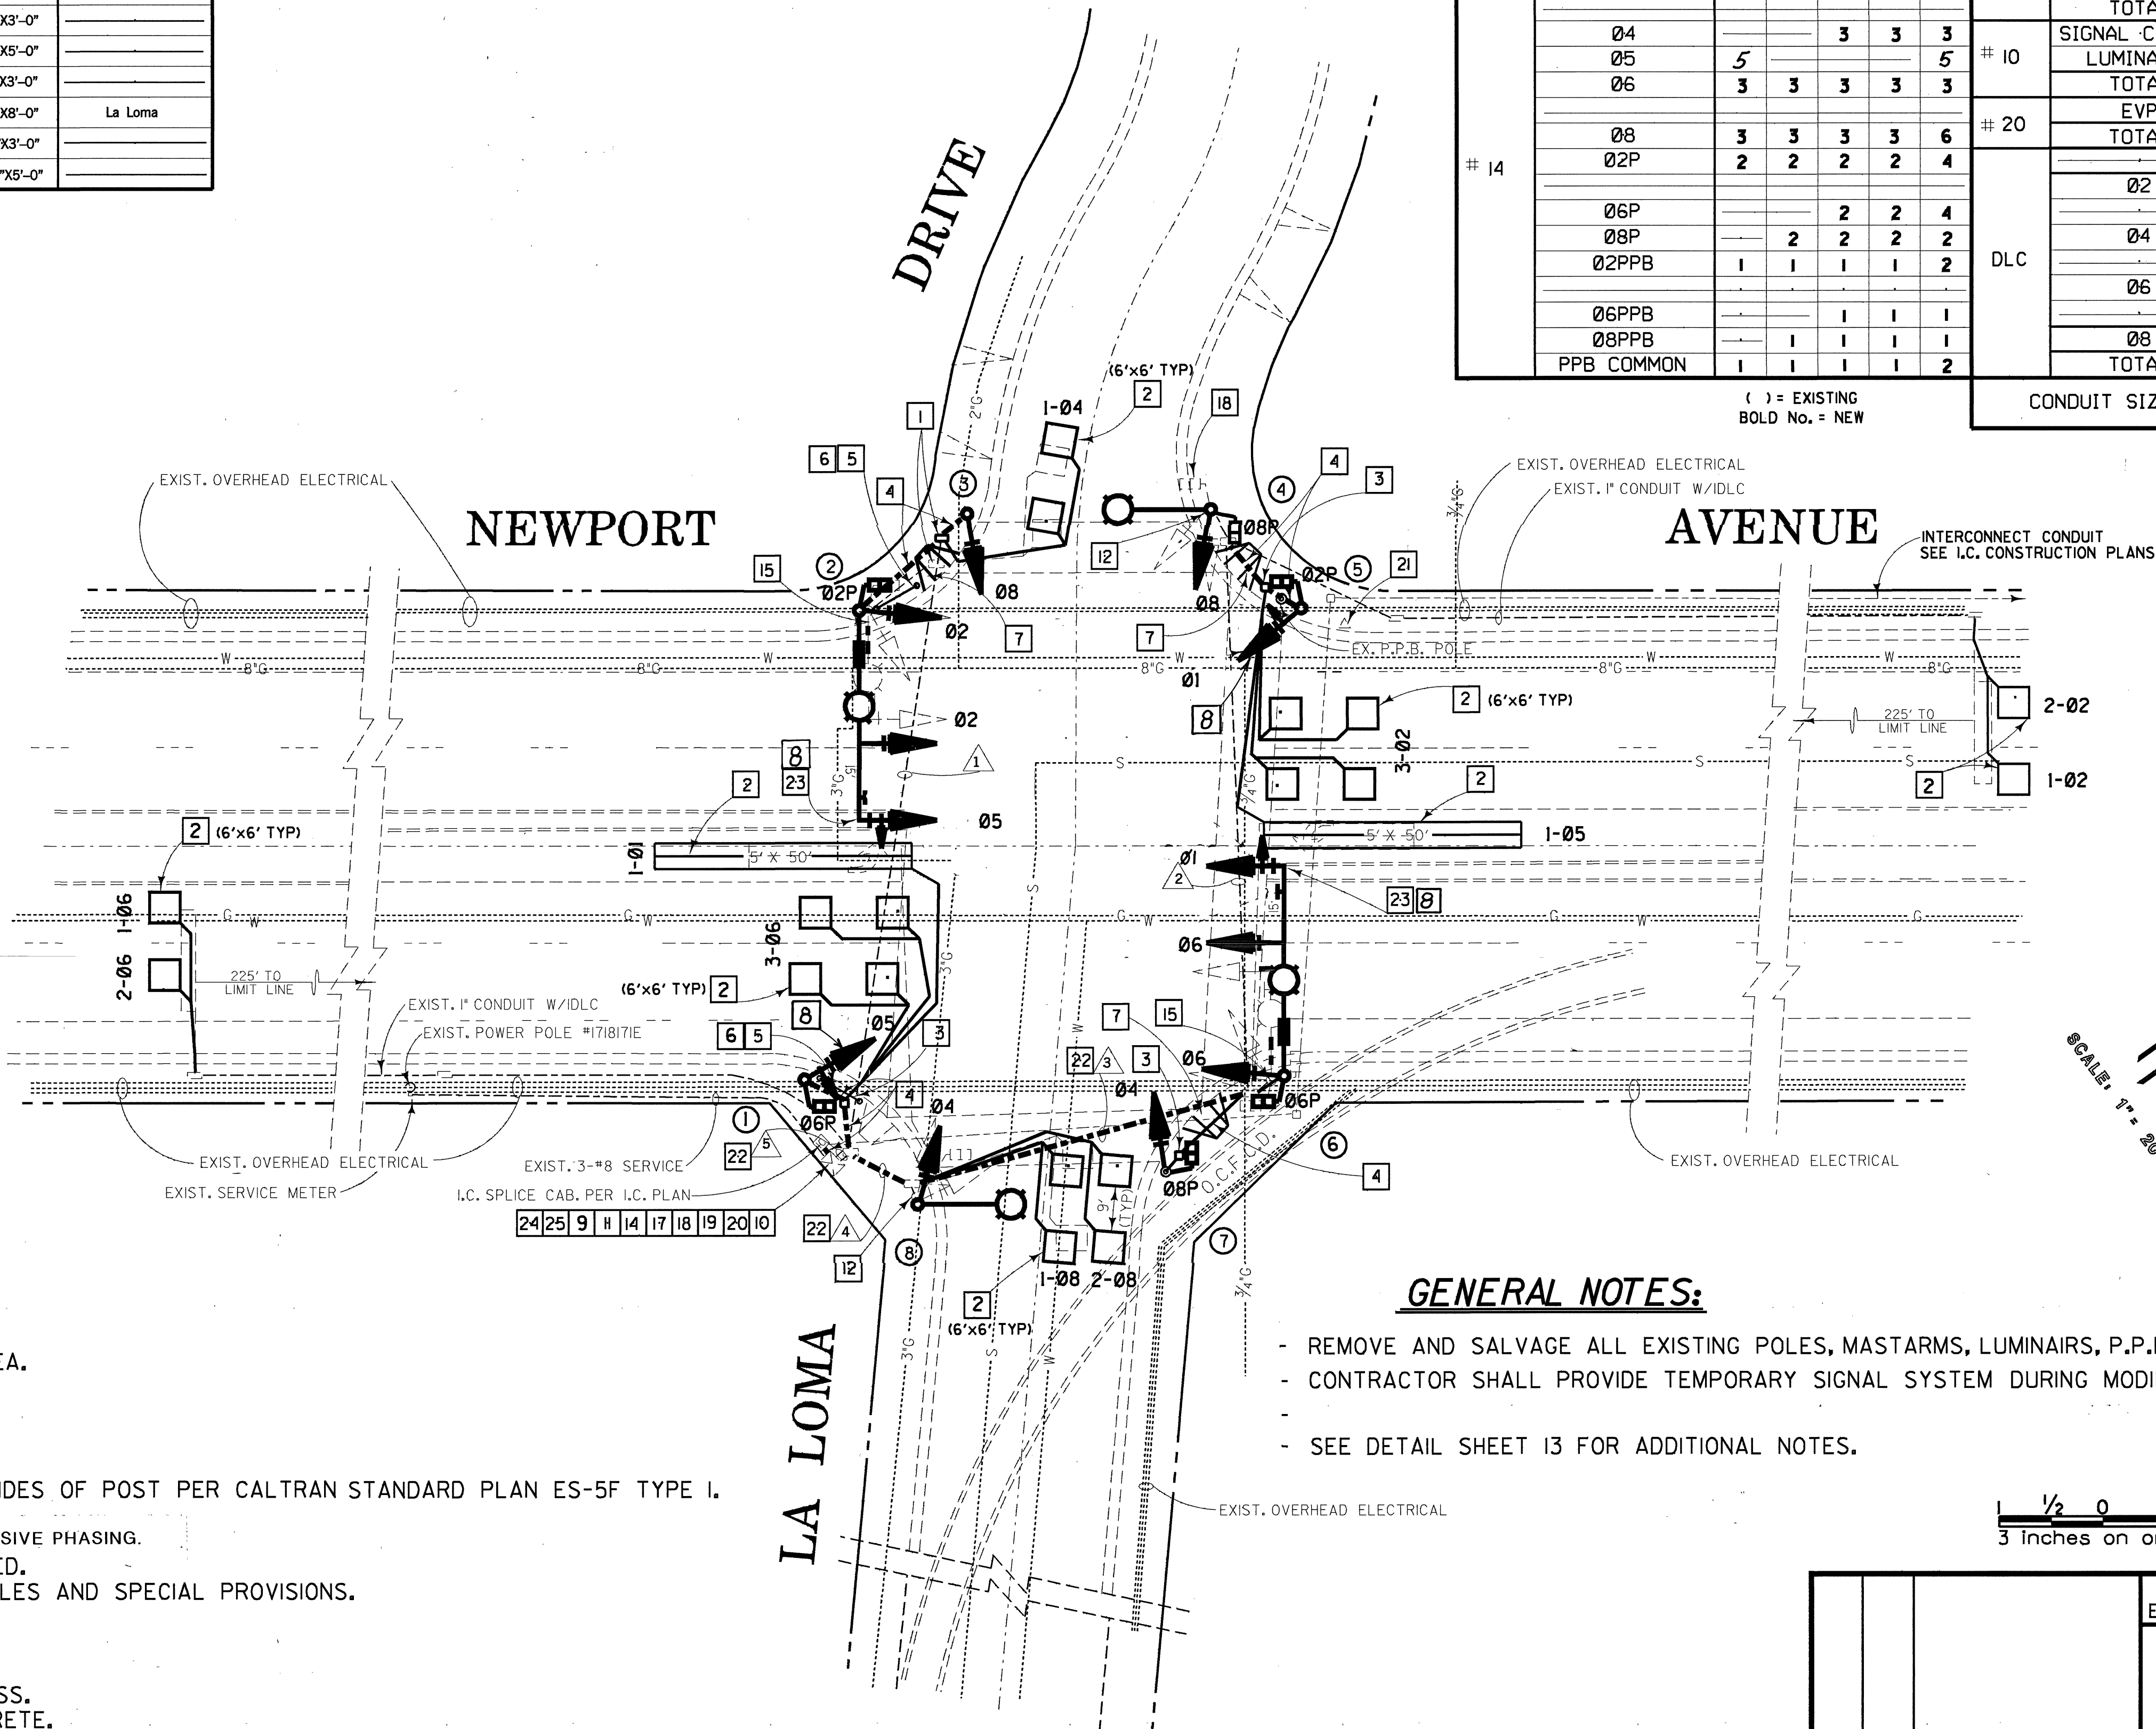

GENERAL NOTES:

- REMOVE AND SALVAGE ALL EXISTING POLES, MASTARMS, LUMINAIRS, P.P.B.P.'S AND SIGNAL HEADS.
- CONTRACTOR SHALL PROVIDE TEMPORARY SIGNAL SYSTEM DURING MODIFICATION.
- SEE DETAIL SHEET I3 FOR ADDITIONAL NOTES.

1/2 0 2
3 inches on original drawing

ORANGE COUNTY ENVIRONMENTAL MANAGEMENT AGENCY			
NEWPORT AVENUE AT LA LOMA DRIVE			
SIGNAL MODIFICATION PLAN			
MARK	DATE	DESCRIPTION	PREPARED UNDER
REVISIONS			SUPERVISION OF
DESIGNED	L. ABAD	DATE	RCE 4/25/92
DRAWN	T. PHAM	CHECKED	L. NATSUHARA
SCALE	DATE	W. O. NO.	OF 13
AS SHOWN	JUNE 92	R09753	