


ORANGE COUNTY TRANSPORTATION AUTHORITY

NEWPORT AVENUE/BOULEVARD (NORTH) CORRIDOR

TRAFFIC SIGNAL SYNCHRONIZATION PROJECT

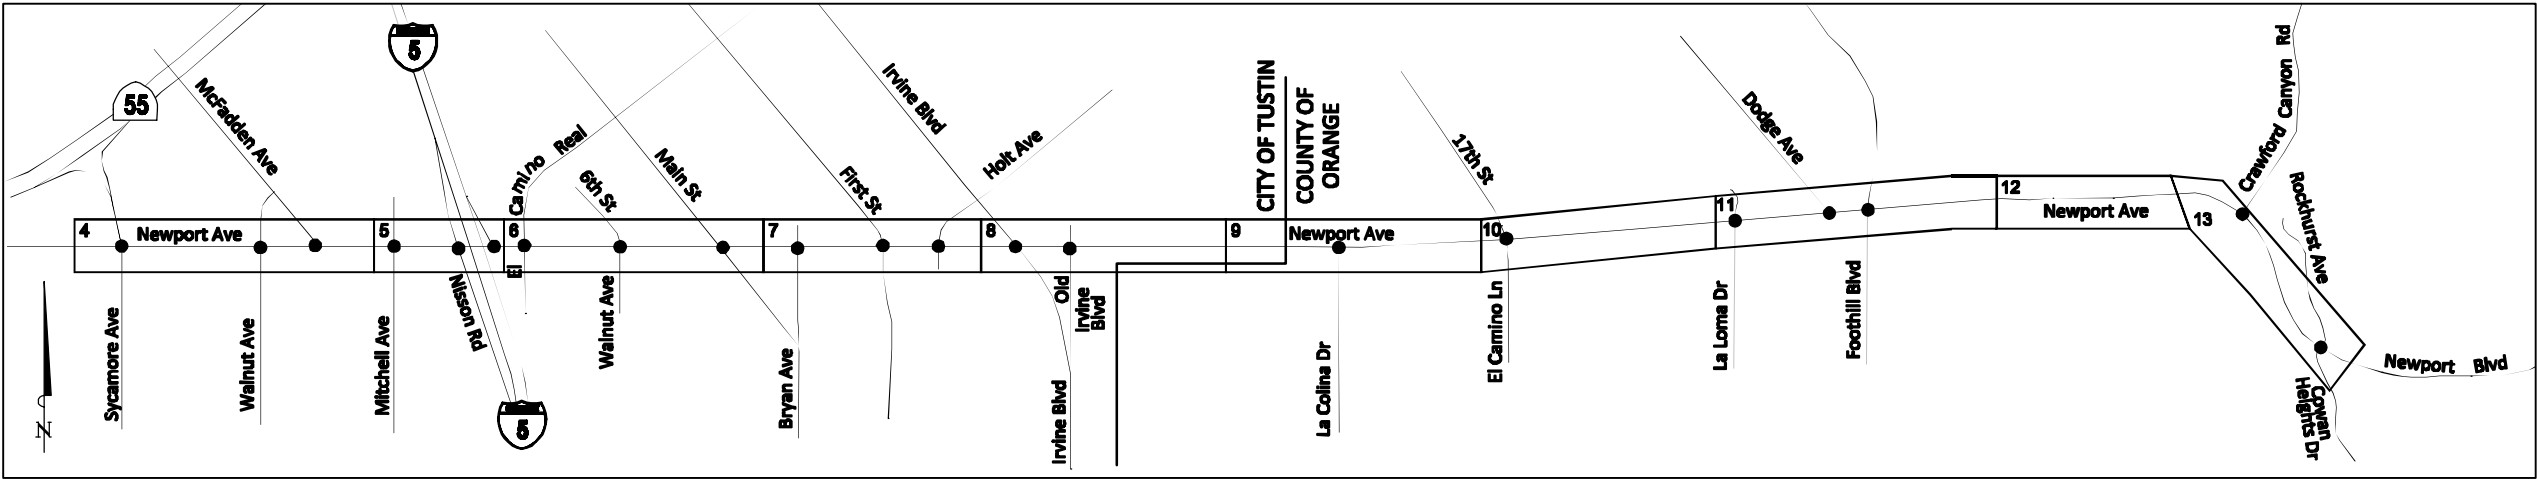

SHEET INDEX

NOT TO SCALE

GENERAL NOTES:

- ALL WORK, UNLESS OTHERWISE SPECIFIED, SHALL CONFORM TO THE LATEST EDITION AND SUPPLEMENTS OF THE STANDARD SPECIFICATIONS FOR PUBLIC WORKS CONSTRUCTION PER APWA STANDARD PLANS, UNLESS OTHERWISE SHOWN. ALL TRAFFIC SIGNAL WORK SHALL CONFORM TO THE PROVISIONS OF THE STANDARD SPECIFICATIONS AND STANDARD PLANS OF THE STATE OF CALIFORNIA, DEPARTMENT OF TRANSPORTATION, DATED MAY 2016, UNLESS OTHERWISE NOTED.
- ALL STRIPING AND TRAFFIC SIGNS SHALL BE ACCORDING TO THE LATEST EDITION OF THE CALIFORNIA MANUAL ON UNIFORM TRAFFIC CONTROL DEVICES (MUTCD), DATED NOVEMBER 7TH, 2014. ALL SIGNING AND STRIPING SHALL BE NEW INSTALLATIONS EXCEPT AS OTHERWISE NOTED.
- LOCATE ALL SUBSTRUCTURES PRIOR TO CONSTRUCTION. HAND DIG FOUNDATIONS UNTIL CLEAR OF OBSTRUCTIONS. PHONE UNDERGROUND SERVICE ALERT AT 811 48 HOURS PRIOR TO CONSTRUCTION.
- ALL DETECTOR LOOPS SHALL BE PROTECTED IN PLACE. ANY DAMAGED LOOPS SHALL BE REPAIRED WITHIN 3 WORKING DAYS.
- INTERCONNECT CABLE SHALL BE CONTINUOUS FROM SPICE VAULT TO SPICE VAULT. NO SPICES WILL BE ALLOWED.
- UNLESS OTHERWISE INDICATED, PULL BOXES SHALL BE FOR SIGNAL INTERCONNECT. PULL BOXES SHALL BE INSTALLED AT A MAXIMUM OF 800' INTERVALS. PULL BOXES SHALL NOT BE LOCATED WITHIN DRIVEWAYS OR WITHIN 1' OF WHEELCHAIR RAMPS.
- EXISTING SIGNALS SHALL REMAIN OPERATIONAL AT ALL TIMES UNLESS OTHERWISE NOTED.
- CONDUIT SHALL BE PVC SCHEDULE 40 AS SHOWN ON THE PLANS. CONDUIT CROSSING ROADWAYS AND UNDER CONCRETE SIDEWALKS AND DRIVEWAYS SHALL BE BORED UNLESS OTHERWISE APPROVED BY THE CITY. CONDUIT SHALL BE INSTALLED BY THE TRENCHING METHOD ONLY WHERE NOTED ON THE PLANS OR AS ALLOWED BY THE PROJECT ENGINEER. NO ADDITIONAL MEASUREMENT OR PAYMENT WILL BE MADE FOR INSTALLATION OF CONDUIT BY TRENCHING METHOD.
- WORK IN PUBLIC STREETS, ONCE BEGUN, SHALL BE PROSECUTED TO COMPLETION WITHOUT DELAY SO AS TO PROVIDE MINIMUM INCONVENIENCE TO ADJACENT PROPERTY OWNERS AND TO THE TRAVELING PUBLIC.
- PVC CONDUIT INSTALLED BY TRENCHING IN PAVEMENT METHOD SHALL HAVE 18" COVER AND BACK FILLED WITH 2 SACK CEMENT SLURRY AND 2" A.C. CAP WHERE APPROVED BY THE CITY.
- CONTRACTOR SHALL USE COMPRESSED AIR TO CLEAN OUT EXISTING CONDUITS PRIOR TO INTERCONNECT CABLE INSTALLATION OR SIGNAL INTERCONNECT RELOCATION.
- ALL DAMAGED OR REMOVED CONCRETE, SIDEWALK, LANDSCAPE, AND PAVEMENT SHALL BE REPLACED IN KIND.
- CONTRACTOR IS RESPONSIBLE FOR UPDATING THE CLOCK AT LEAST ONCE A WEEK ON ALL CONTROLLERS DISCONNECTED FROM THE INTERCONNECT NETWORK DUE TO WORK ON THIS PROJECT.
- CONTRACTOR SHALL BE RESPONSIBLE FOR FURNISHING AND INSTALLING TOTAL NUMBER OF CONDUCTORS INDICATED ON THE PLANS IN PARENTHESIS.
- THE CONTRACTOR SHALL OBTAIN A PERMIT FROM CALTRANS DISTRICT 12 ENCROACHMENT PERMIT OFFICE, 3347 MICHELSON DRIVE, SUITE 100, IRVINE, CA 92612, TELEPHONE: (949) 724-2445, PRIOR TO CONSTRUCTION ON CALTRANS RIGHT-OF-WAY.
- CONTRACTOR SHALL CLEAR ALL EXISTING PULL BOX INTERIORS FROM DEBRIS AND DIRT PRIOR TO THE INTERCONNECT CABLE(S) INSTALLATION.
- ALL NEW AND EXISTING PULL BOXES SHALL BE GROUTED PRIOR TO INSTALLATION OF INTERCONNECT CABLE(S).
- ALL NEW AND EXISTING CONDUITS SHALL BE DUCT SEALED.

CONSTRUCTION NOTES:

- FURNISH AND INSTALL NEW PVC SCHEDULE 80 3" CONDUIT.
- FURNISH AND INSTALL 24 SMFO CABLE IN CONDUIT.
- FURNISH AND INSTALL 6 SMFO CABLE IN CONDUIT.
- FURNISH AND INSTALL 12PAIR#19 SIC PER AGENCY SPECIAL PROVISIONS.
- FURNISH AND INSTALL 24 INCH PVC BUSHINGS.
- FURNISH AND INSTALL NEW #6 PULL BOX ADJACENT TO EXISTING PULL BOX. PROVIDE 40 FEET OF SLACK FOR THE FIBER OPTIC CABLE IN PULL BOX AND CONTROLLER CABINET.
- FURNISH AND INSTALL NEW #6 PULL BOX. REMOVE EXISTING PULL BOX.
- FURNISH AND INSTALL FIBER SWITCH PER AGENCY SPECIAL PROVISIONS.
- FURNISH AND INSTALL AGENCY APPROVED FIBER OPTIC SPICE ENCLOSURE IN PULL BOX PER AGENCY SPECIAL PROVISIONS. FUSION SPICE 6-STRAND SMFO CABLE(S) TO 24 SMFO CABLE(S) IN SPICE ENCLOSURE.
- FURNISH AND INSTALL FIBER DISTRIBUTION UNIT WITH SPICE TRAY. FURNISH AND INSTALL 6 SC DUPLEX CABLES INSIDE THE FIBER DISTRIBUTION UNIT. TERMINATE SC CABLES ON THE BACK OF THE PANELS. FUSION SPICE 6 SMFO CABLE(S) TO DUPLEX CABLE IN SPICE TRAY. FURNISH AND INSTALL 2 FIBER OPTIC DUPLEX JUMPER CABLES WITH SC OR LC CONNECTORS PER AGENCY STANDARD. CONNECT THESE CABLES TO FIBER SWITCH.
- FURNISH AND INSTALL WIRELESS RADIO ANTENNA. CONFIGURATION, TESTING, AND ASSOCIATED WIRING.
- FURNISH AND INSTALL AGENCY APPROVED FIBER OPTIC SPICE ENCLOSURE IN SPICE VAULT PER AGENCY SPECIAL PROVISIONS. FUSION SPICE 6-STRAND SMFO CABLE(S) TO CALTRANS 72 SMFO CABLE(S) IN SPICE ENCLOSURE.
- FURNISH AND INSTALL NEW #6 PULL BOX.
- FURNISH AND INSTALL NEW PULL BOX LID.
- FURNISH AND INSTALL ACTELIS ETHERNET OVER COPPER SWITCH.
- FURNISH AND INSTALL NEW 2" PVC SCHEDULE 80 CONDUIT.
- FURNISH AND INSTALL 24 SMFO IN NEW CONDUIT.
- FURNISH AND INSTALL CISCO ETHERNET OVER COPPER SWITCH.
- FURNISH AND INSTALL 12 SMFO CABLE IN EXISTING CONDUIT.
- FURNISH AND INSTALL OUTDOOR-RATED (POE) CAT5E CABLE.
- PUNCH DOWN INTERCONNECT AS DIRECTED BY THE ENGINEER.

LEGEND:

- EXISTING TRAFFIC SIGNAL CONTROLLER CABINET
- EXISTING PULL BOX
- PROPOSED PULL BOX
- EXISTING SPICE VAULT
- EXISTING MYERS HUB
- EXISTING CONDUIT
- PROPOSED CONDUIT
- APPROXIMATE RIGHT OF WAY (RW)
- PROPOSED WIRELESS RADIO ANTENNA
- EXISTING TRAFFIC SIGNAL

SHEET INDEX

SHEET TITLE	SHEET NUMBER
TITLE SHEET	1
PROPOSED COMMUNICATION SCHEMATIC	2
COMMUNICATIONS BLOCK DIAGRAM	3
COMMUNICATIONS DESIGN	4-13

ABBREVIATION LIST

APWA	AMERICAN PUBLIC WORKS ASSOCIATION
DLC	LOOP DETECTOR LEAD-IN CABLE
EX	EXISTING
GRC	GALVANIZED RIGID CONDUIT
MUTCD	MANUAL ON UNIFORM TRAFFIC CONTROL DEVICES
IC	INTERCONNECT
PAIR	PAIR
PR	PROPOSED
PVC	POLYVINYL CHLORIDE
SIC	SIGNAL INTERCONNECT CABLE
SMFO	SINGLE MODE FIBER OPTIC

NEWPORT AVENUE/BOULEVARD (NORTH) RTSSP

TITLE SHEET COMMUNICATION PLANS

DATE: 08/07/15	SUBMITTED: _____ NAME/SIGNATURE	SHEET NO. 1 OF 13
SCALE: NTS	DATE: _____	PROJECT NO. 068371004
DESIGN: CC	APPROVED: _____ NAME/SIGNATURE	
DRAWN: RP	DATE: _____	
CHECKED: SC		



Kimley»Horn

© 2016 KIMLEY-HORN AND ASSOCIATES, INC.
660 South Figueroa Street, Suite 2050, Los Angeles, CA 90017
Tel (213) 261-4040

As-Built Drawings
Gilbert Rodarte
CROSSTOWN ELECTRICAL & DATA, INC.




K:\DT_TPTD\099371004 - Newport Ave North TSSP\Design\Currents\Communications\099371004-SH42-CS.dwg 5/6/2014 9:45 AM




Kimley»Horn

© 2016 KIMLEY-HORN AND ASSOCIATES, INC.
660 South Figueroa Street, Suite 2050, Los Angeles, CA 90017
Tel (213) 261-4040

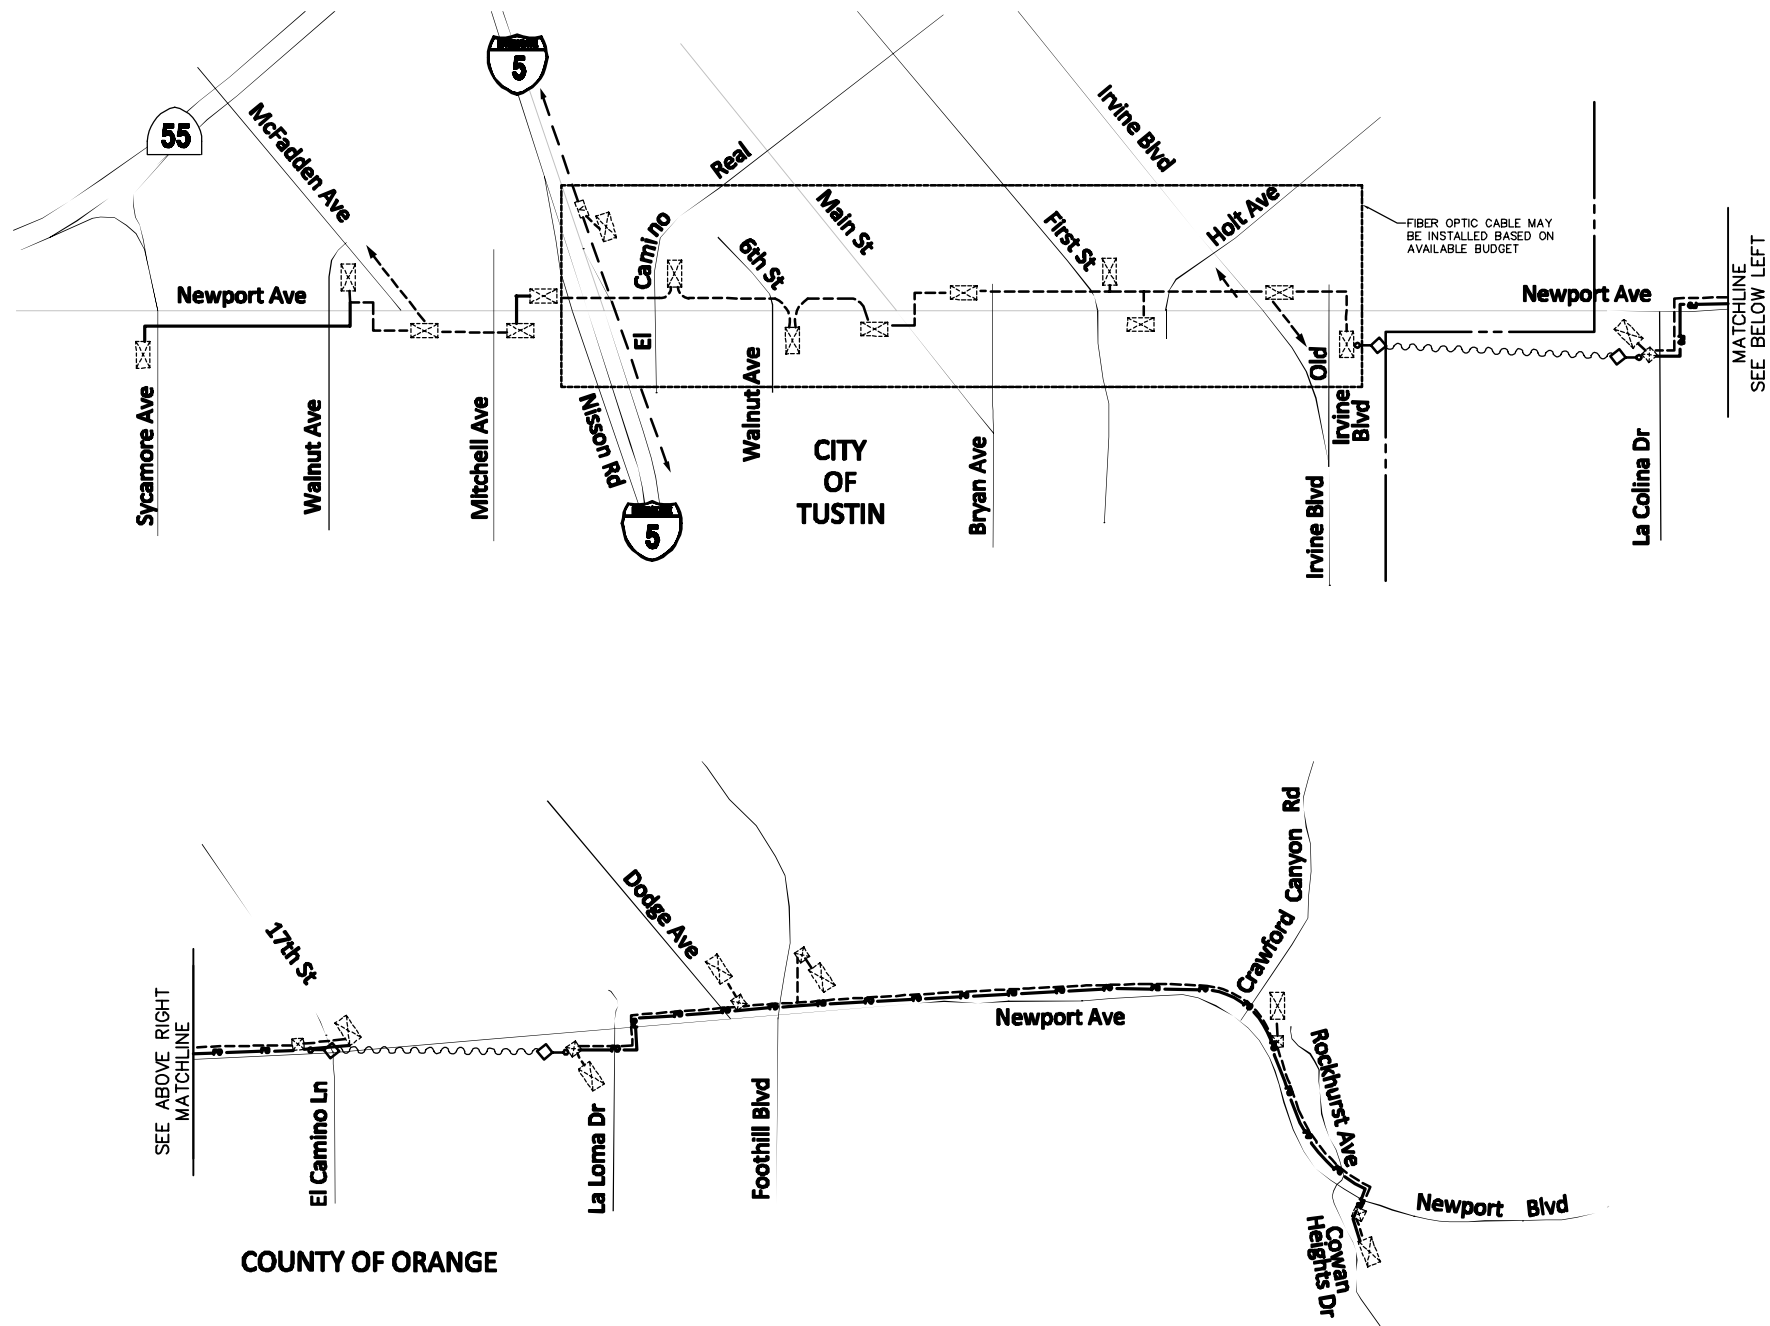

LEGEND

- EXISTING CONTROLLER CABINET
- EXISTING COPPER SIC SPLICER CABINET
- EXISTING SPLICER VAULT
- EXISTING CONDUIT ALIGNMENT WITH COPPER SIC
- EXISTING CONDUIT ALIGNMENT WITH FIBER SIC
- PROPOSED FIBER SIC IN EXISTING CONDUIT
- CITY/COUNTY LIMITS
- PROPOSED WIRELESS ANTENNA (POLE MOUNTED)
- PROPOSED CONDUIT ALIGNMENT WITH COPPER SIC
- PROPOSED WIRELESS COMMUNICATION

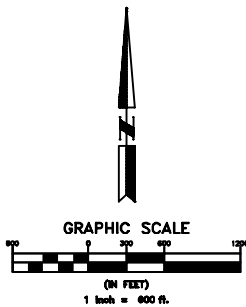

**NEWPORT AVENUE/BOULEVARD (NORTH)
RTSSP**

**PROPOSED COMMUNICATION SCHEMATIC
COMMUNICATION PLANS**



DATE: 08/07/15	SUBMITTED: _____ NAME/SIGNATURE _____	SHEET NO. 2 OF 13
SCALE: 1"=40'	DATE: _____	PROJECT NO. 068371004
DESIGN: CC	APPROVED: _____ NAME/SIGNATURE _____	
DRAWN: RP	DATE: _____	
CHECKED: SC		




As-Built Drawings
Gilbert Rodarte
CROSSTOWN ELECTRICAL & DATA, INC.

COMMUNICATIONS BLOCK DIAGRAM - LEGEND


- FIBER SPLICES
 CX: RG59 COAX CABLE
 CAT 5E: CAT5E (10 BASE T) CABLE
 PR.: PROPOSED
 EX.: EXISTING

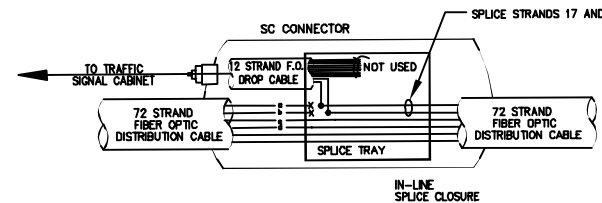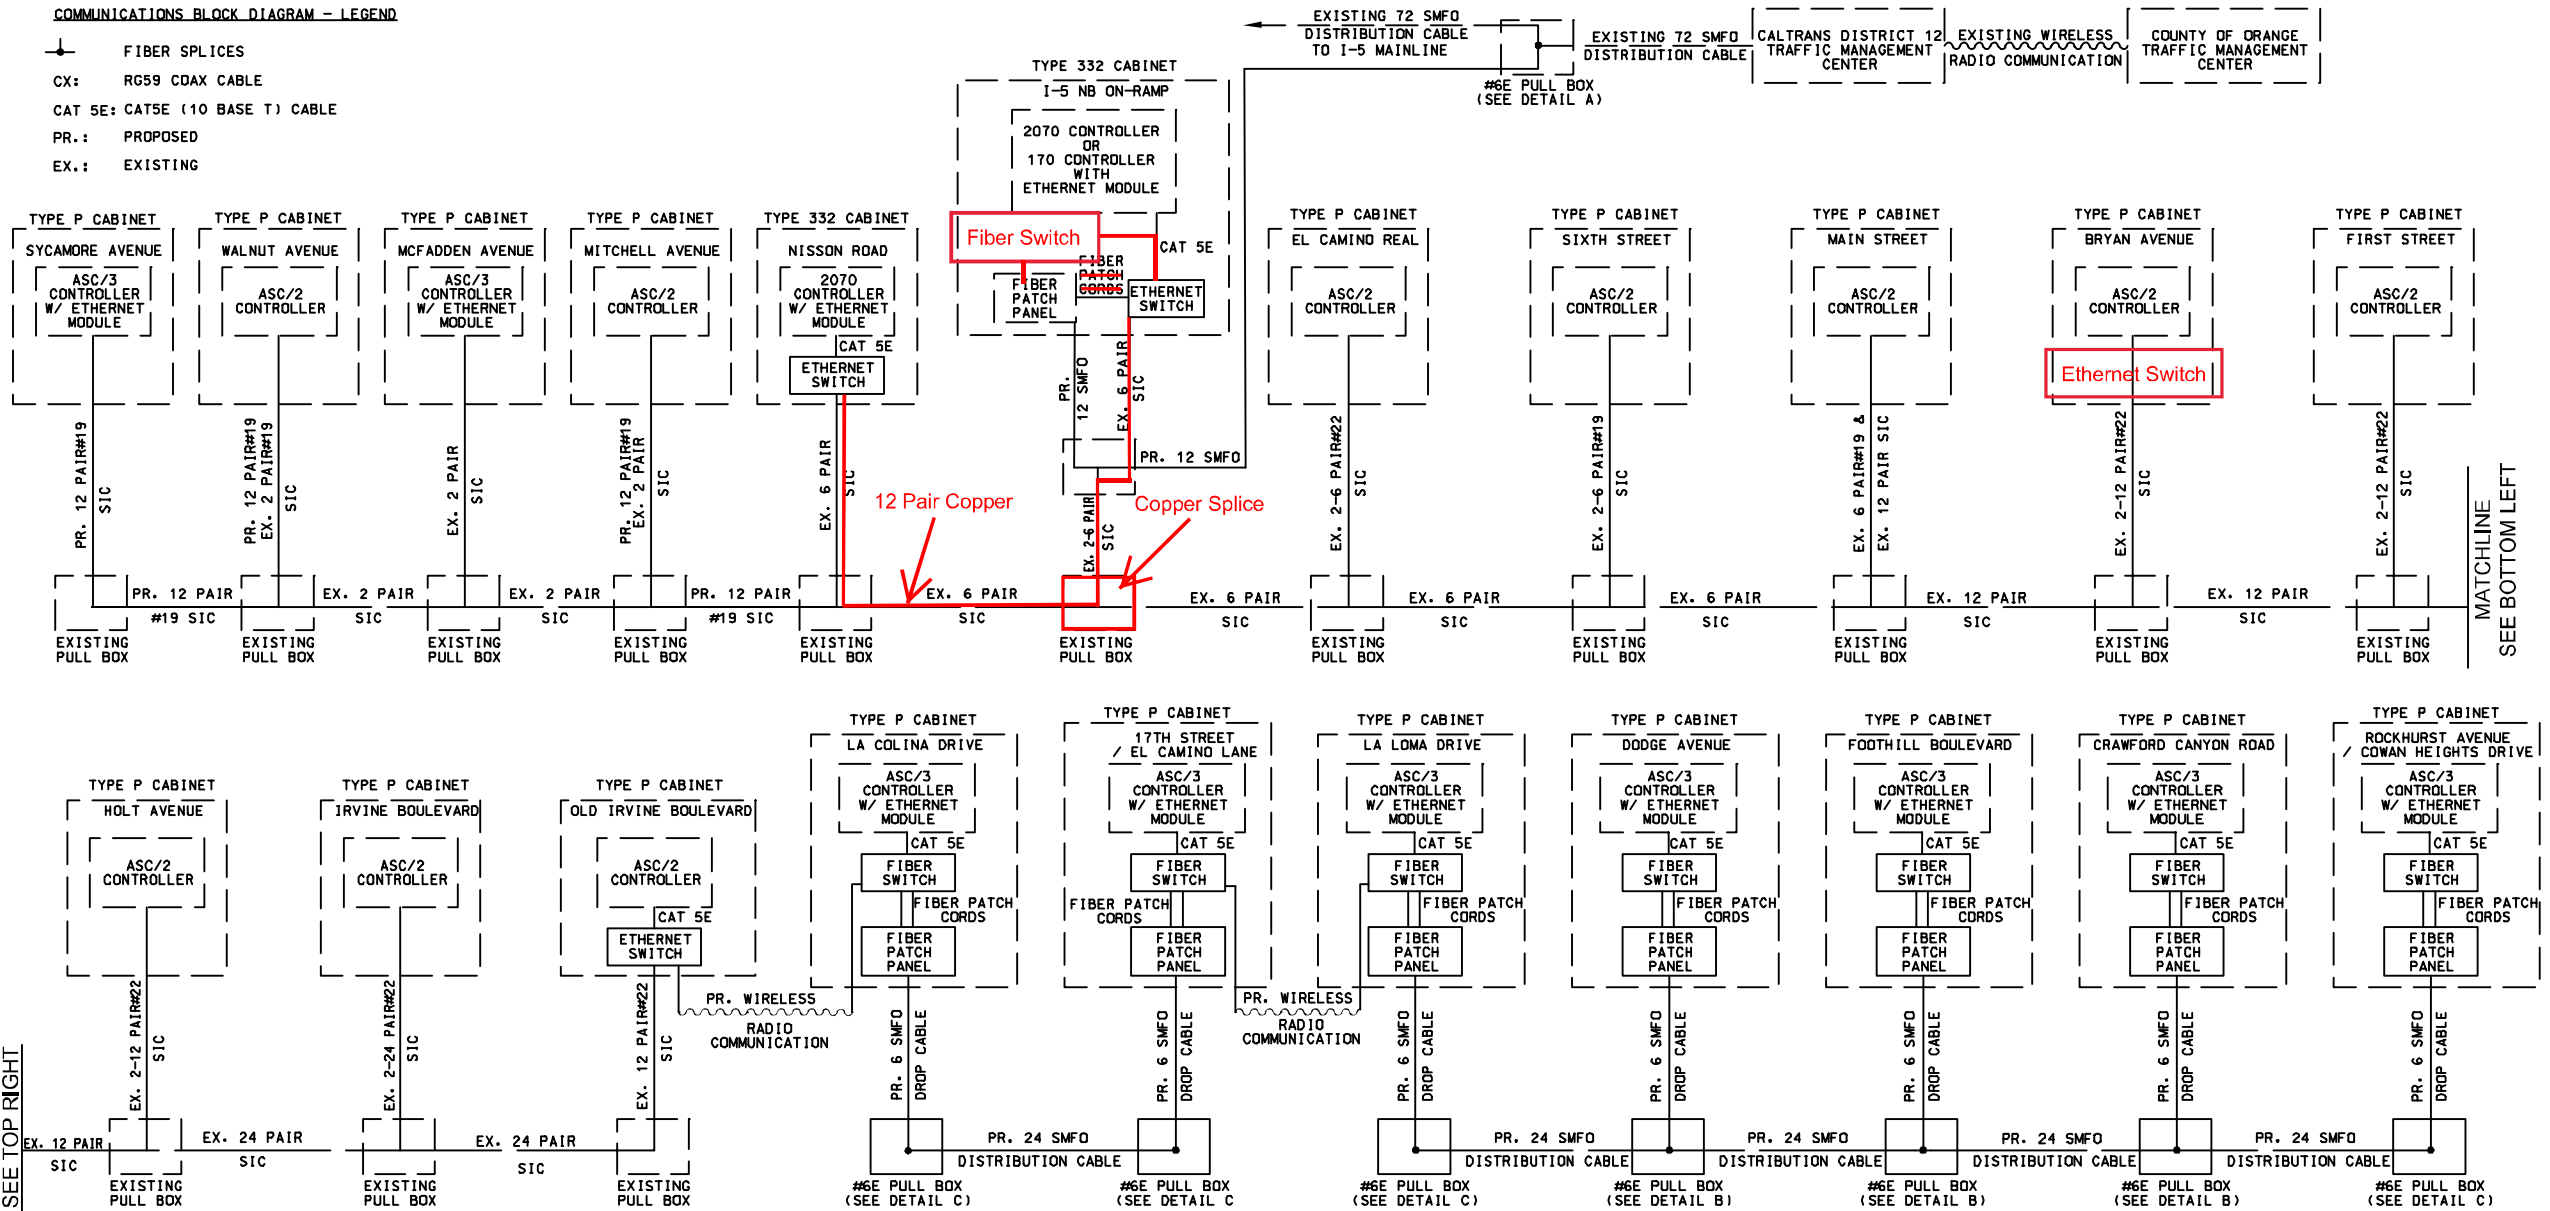

DETAIL A

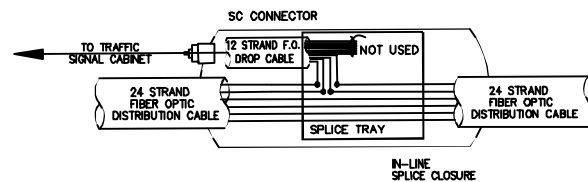

DETAIL B

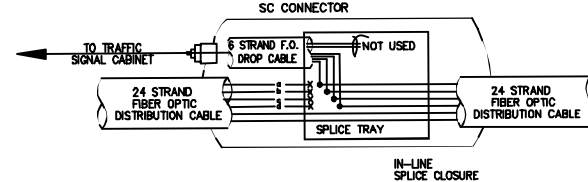

DETAIL C

LEGEND

- DENOTES SPLICE
 x CUT END OF FIBER (Not Spliced)
 CAT 5E: CAT 5E (10 BASE T) CABLE

As-Built Drawings
 Gilbert Rodarte
 CROSSTOWN ELECTRICAL & DATA, INC.



NEWPORT AVENUE/BOULEVARD (NORTH)
RTSSP


COMMUNICATION BLOCK DIAGRAM

DATE: 08/07/15	SUBMITTED: _____	SHEET NO. 3 OF 13
SCALE: NTS	DATE: _____	
DESIGN: CC	APPROVED: _____	PROJECT NO. 099371004
DRAWN: RP	NAME/SIGNATURE: _____	
CHECKED: SC	DATE: _____	





Kimley»Horn

© 2016 KIMLEY-HORN AND ASSOCIATES, INC.
 660 South Figueroa Street, Suite 2050, Los Angeles, CA 90017
 Tel (213) 261-4040

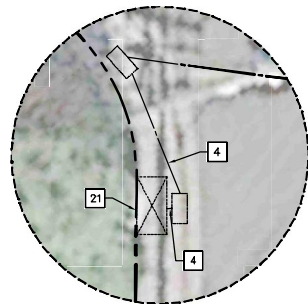

DETAIL A
1"=10'

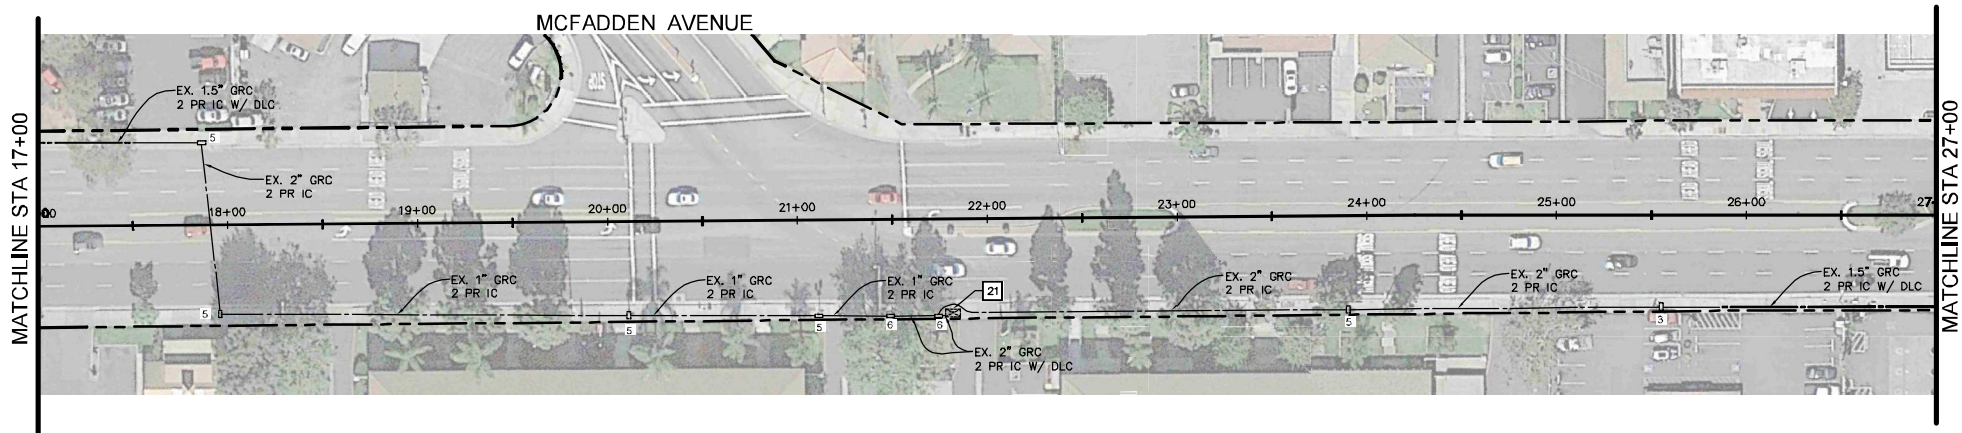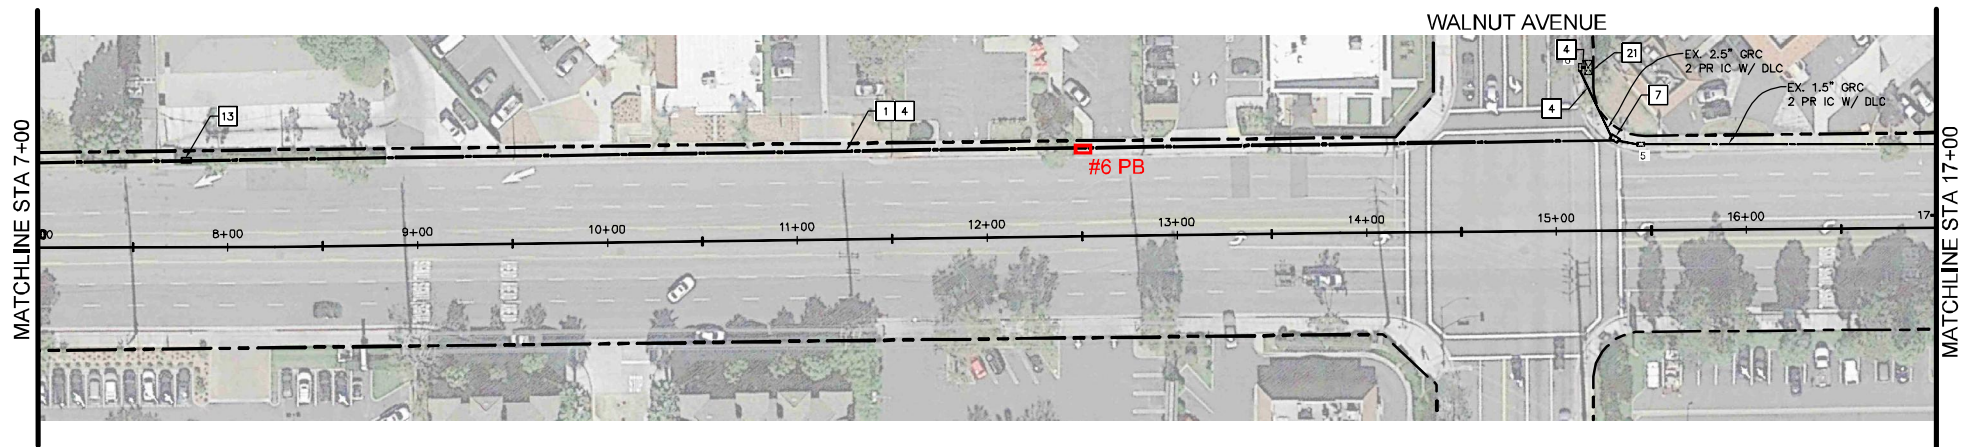


GENERAL NOTES:

1. CONTRACTOR SHALL CONTACT THE CITY OF TUSTIN ENGINEERING DEPARTMENT AT 714-573-3150 AT LEAST 48 HOURS PRIOR TO BEGINNING CONSTRUCTION.

CONSTRUCTION NOTES:

- 1 FURNISH AND INSTALL NEW PVC SCHEDULE 80 3" CONDUIT.
- 4 FURNISH AND INSTALL 12PAIR#19 GIC PER AGENCY SPECIAL PROVISIONS.
- 7 FURNISH AND INSTALL NEW #6E PULL BOX. REMOVE EXISTING PULL BOX.
- 13 FURNISH AND INSTALL NEW #6 PULL BOX.
- 21 PUNCH DOWN INTERCONNECT AS DIRECTED BY THE ENGINEER.

As-Built Drawings
Gilbert Rodarte
CROSSTOWN ELECTRICAL & DATA, INC.

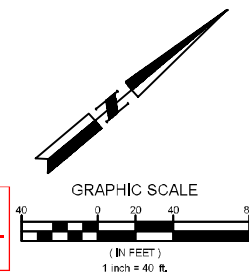

**NEWPORT AVENUE/BOULEVARD (NORTH)
RTSSP**

**NEWPORT AVENUE FROM SYCAMORE AVENUE MCFADDEN AVENUE
COMMUNICATION PLANS**

DATE: 08/07/15	SUBMITTED: _____ NAME/SIGNATURE	SHEET NO. 4 OF 13
SCALE: 1"=40'	DATE: _____	PROJECT NO. 068371004
DESIGN: CC	APPROVED: _____ NAME/SIGNATURE	
DRAWN: RP	DATE: _____	
CHECKED: SC		





Kimley»Horn

© 2016 KIMLEY-HORN AND ASSOCIATES, INC.
660 South Figueroa Street, Suite 2050, Los Angeles, CA 90017
Tel (213) 261-4040



1	FURNISH AND INSTALL NEW PVC SCHEDULE 80 3" CONDUIT.
2	FURNISH AND INSTALL 24 SMFO IN NEW CONDUIT.
4	FURNISH AND INSTALL 12P4R#19 SBC PER AGENCY SPECIAL PROVISIONS.
7	FURNISH AND INSTALL NEW#6 PULL BOX, REMOVE EXISTING PULL BOX.
12	FURNISH AND INSTALL AGENCY APPROVED FIBER OPTIC SPLICER ENCLOSURE IN SPLICER VAULT PER AGENCY SPECIAL PROVISIONS. FUSION SPLICER 3-STRAND SMFO CABLE(S) TO CALTRANS 72 SMFO CABLE(S) IN SPLICER ENCLOSURE.
13	FURNISH AND INSTALL NEW#6 PULL BOX.
15	FURNISH AND INSTALL ACTELIS ETHERNET OVER COPPER SWITCH.
16	FURNISH AND INSTALL NEW 2" PVC SCHEDULE 80 CONDUIT.
17	FURNISH AND INSTALL 24 SMFO IN NEW CONDUIT.
18	FURNISH AND INSTALL CISCO ETHERNET OVER COPPER SWITCH.
19	FURNISH AND INSTALL 12 SMFO CABLE IN EXISTING CONDUIT.
21	PUNCH DOWN INTERCONNECT AS DIRECTED BY THE ENGINEER.

1. CONTRACTOR SHALL CONTACT THE CITY OF TUSTIN ENGINEERING DEPARTMENT AT 714-573-3150 AT LEAST 48 HOURS PRIOR TO BEGINNING CONSTRUCTION.

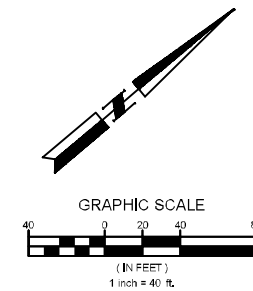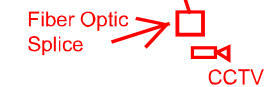

NEWPORT AVENUE/BOULEVARD (NORTH) RTSSP		
NEWPORT AVENUE FROM MITCHELL AVENUE TO I-5 FREEWAY COMMUNICATION PLANS		
DATE: 08/07/15	SUBMITTED _____ NAME/SIGNATURE	SHEET NO. 5 OF 13
SCALE: 1"=40'	DATE _____	PROJECT NO. 086921004
DESIGN: CC	APPROVED _____ NAME/SIGNATURE	
DRAWN: RP	DATE _____	
CHECKED: SC		

K:\DT_TPT\099371004 - Newport Ave North RTSSP\Design\Currents\Communications\099371004-SH16.dwg 5/6/2014 9:45 AM



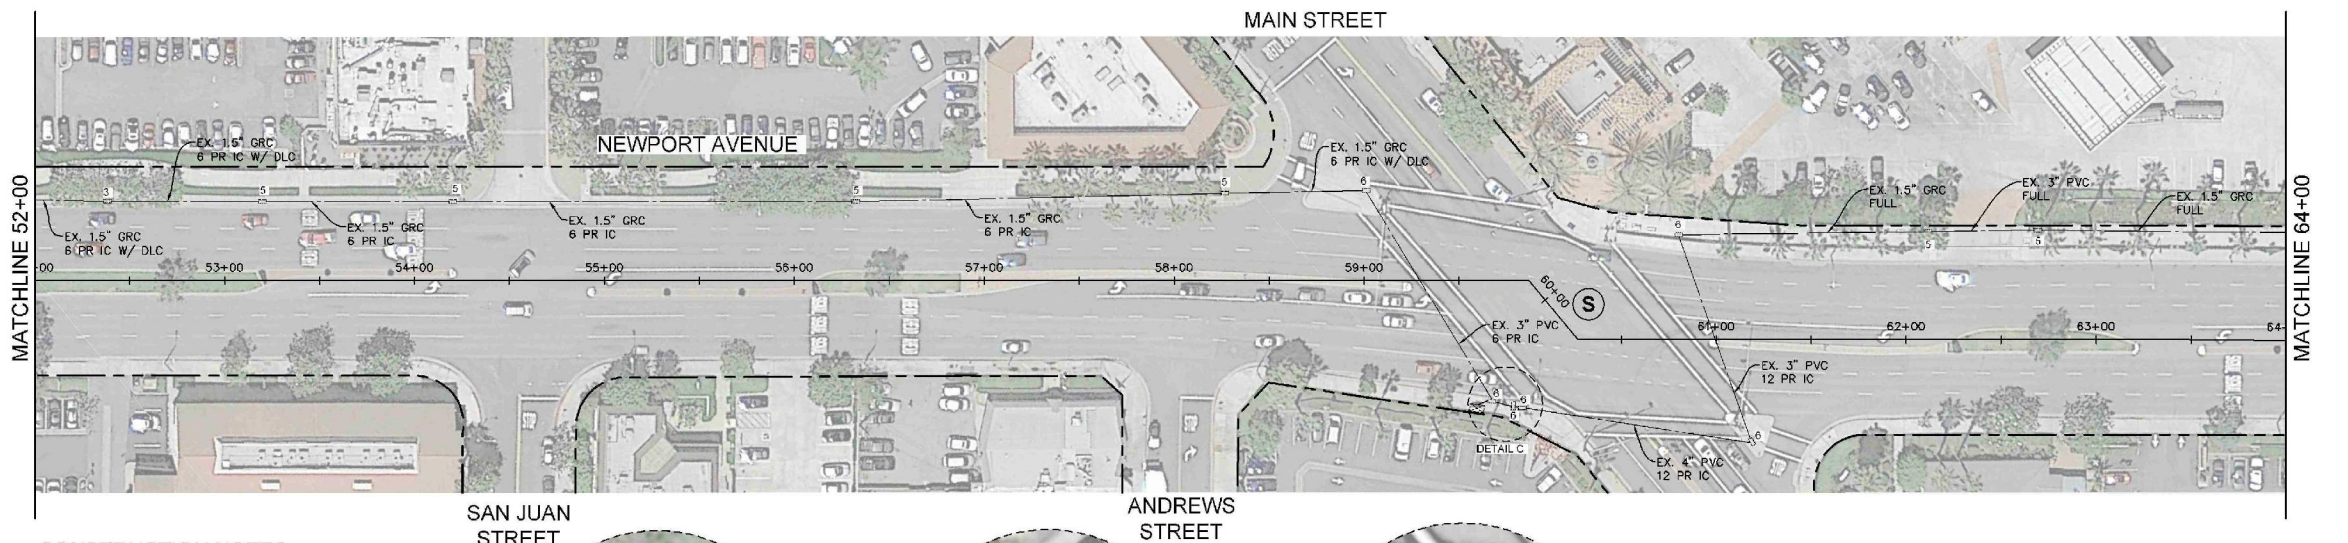
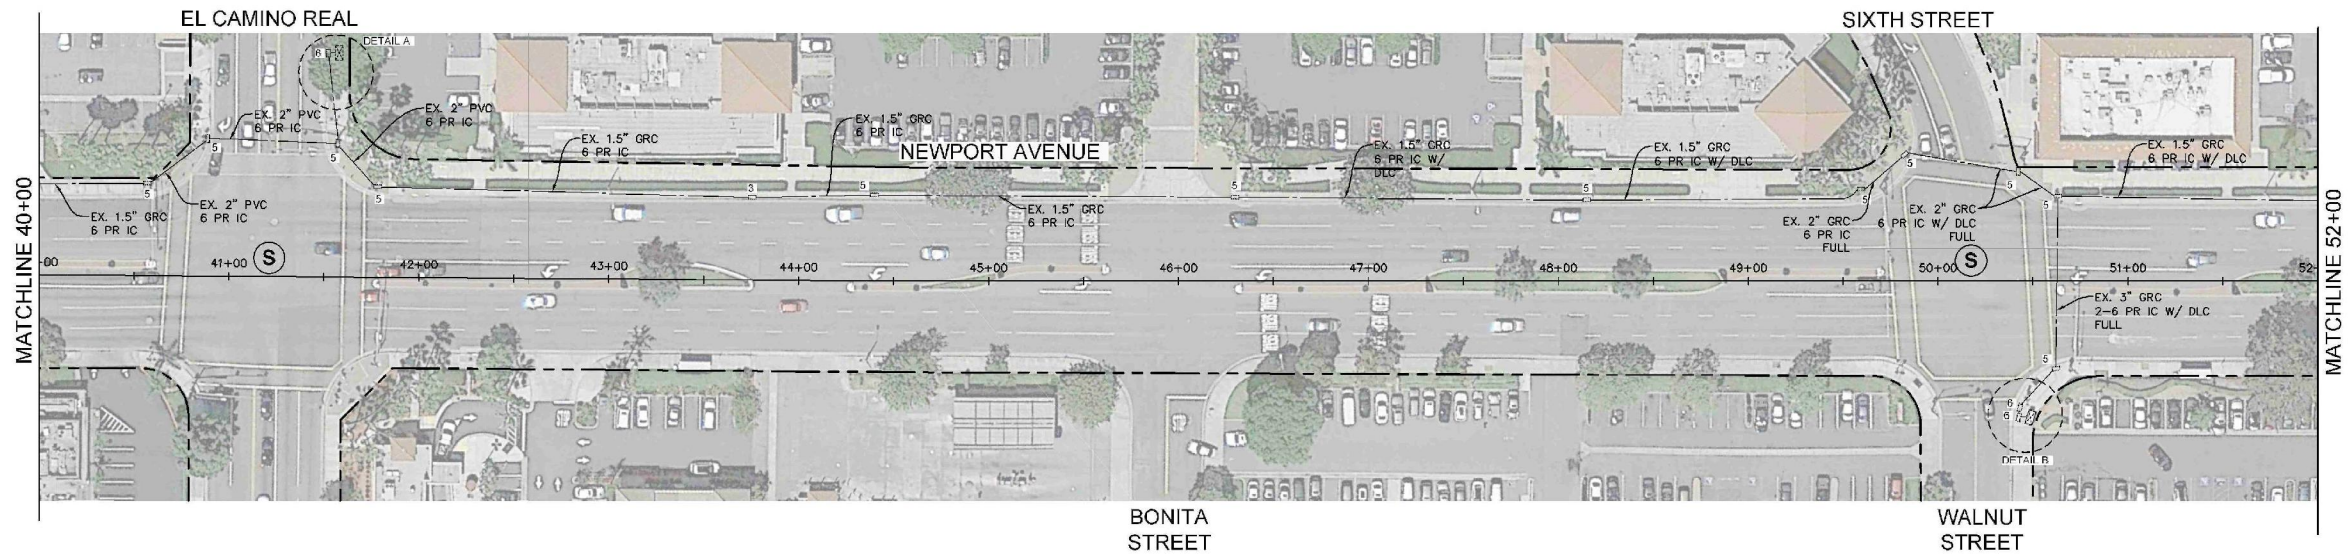


CONSTRUCTION NOTES:

- [21] PUNCH DOWN INTERCONNECT AS DIRECTED BY THE ENGINEER.

GENERAL NOTES:

1. CONTRACTOR SHALL CONTACT THE CITY OF TUSTIN ENGINEERING DEPARTMENT AT 714-573-3159 AT LEAST 48 HOURS PRIOR TO BEGINNING CONSTRUCTION.

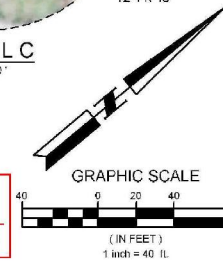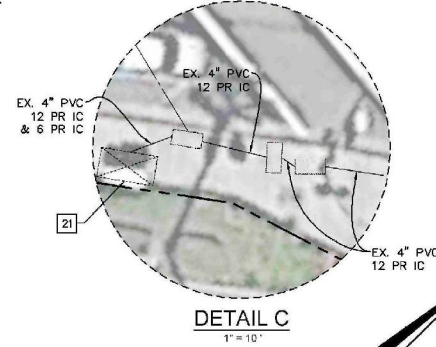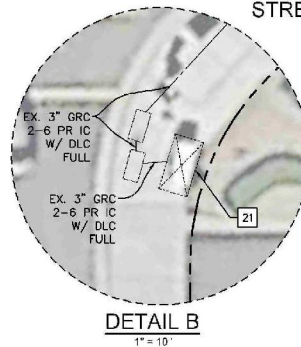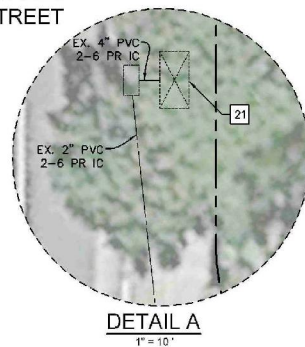

NEWPORT AVENUE/BOULEVARD (NORTH) RTSSP			
NEWPORT AVENUE FROM EL CAMINO REAL TO MAIN STREET COMMUNICATION PLANS			
DATE: 08/07/15	SUBMITTED: _____ NAME/SIGNATURE	SHEET NO. 6 OF 13	
SCALE: 1"=40'	DATE: _____	PROJECT NO. 099371004	
DESIGN: CC	APPROVED: _____ NAME/SIGNATURE		
DRAWN: RP	DATE: _____		
CHECKED: SC			



Kimley»Horn

© 2015 KIMLEY-HORN AND ASSOCIATES, INC.
660 South Figueroa Street, Suite 2050, Los Angeles, CA 90017
Tel: (213) 261-4040



As-Built Drawings
Gilbert Rodarte
CROSSTOWN ELECTRICAL & DATA, INC.

K:\DT_TPT\099371004 - Newport Ave North RTSSP\Currents\Communications\099371004-SH47.dwg 5/6/2014 9:45 AM




Kimley»Horn

© 2016 KIMLEY-HORN AND ASSOCIATES, INC.
660 South Figueroa Street, Suite 2050, Los Angeles, CA 90017
Tel: (213) 261-4040

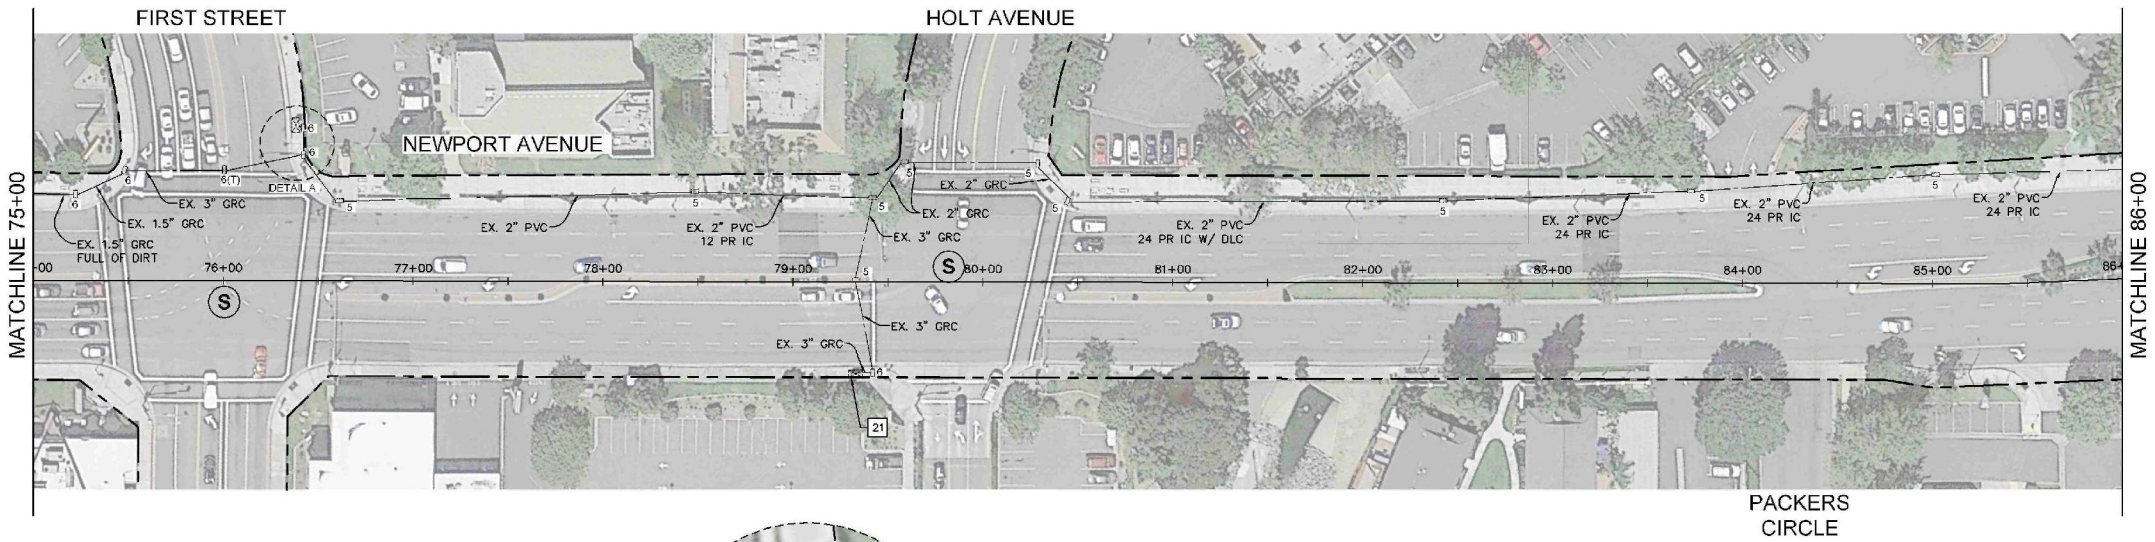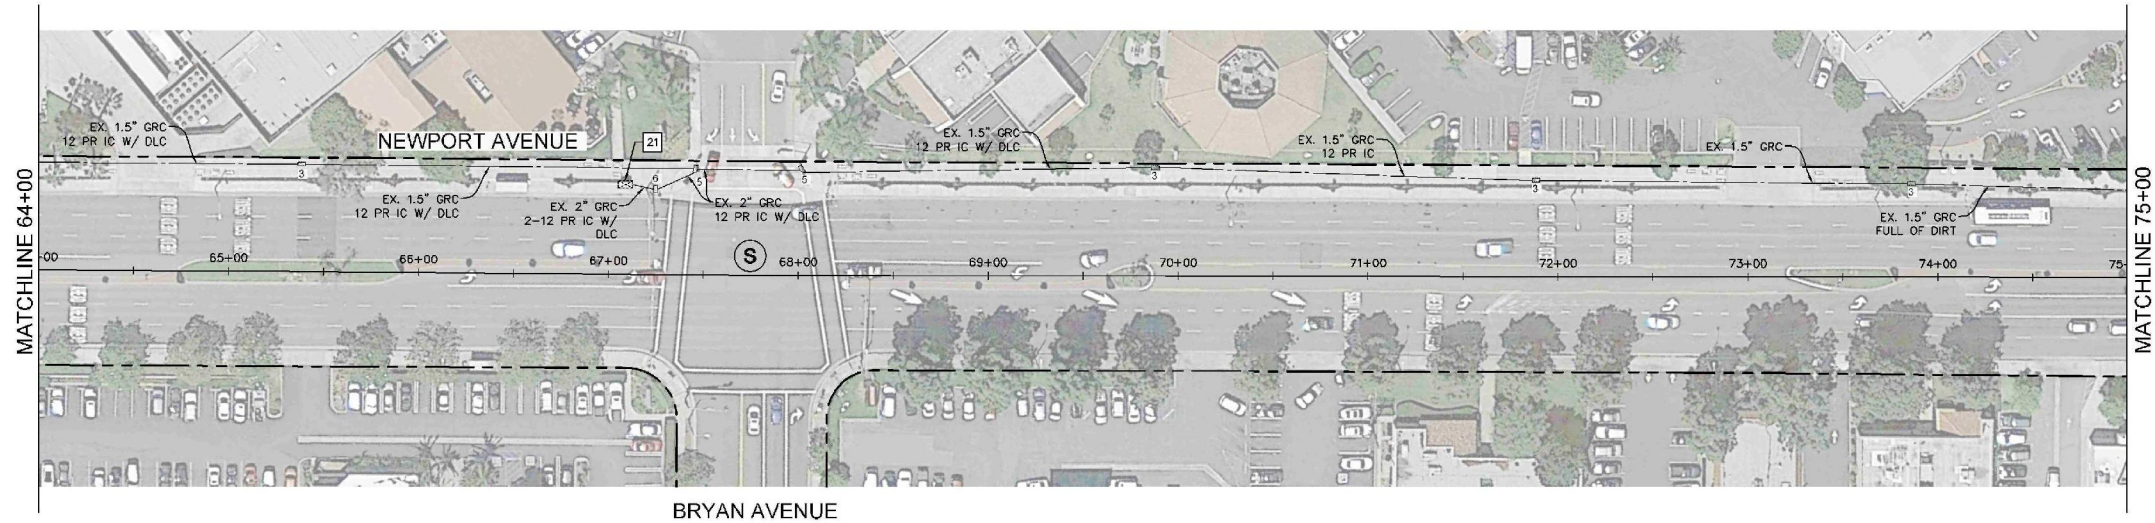

CONSTRUCTION NOTES:


- 21 PUNCH DOWN INTERCONNECT AS DIRECTED BY THE ENGINEER.

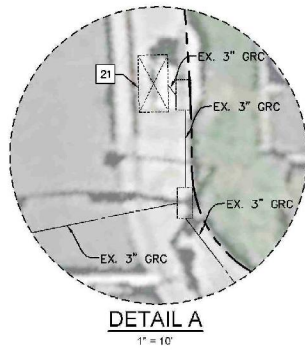


GENERAL NOTES:

1. CONTRACTOR SHALL CONTACT THE CITY OF TUSTIN ENGINEERING DEPARTMENT AT 714-573-3150 AT LEAST 48 HOURS PRIOR TO BEGINNING CONSTRUCTION.

As-Built Drawings
Gilbert Rodarte
CROSSTOWN ELECTRICAL & DATA, INC.

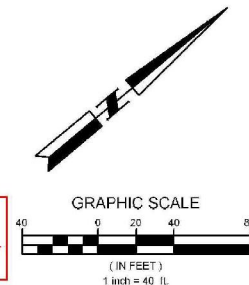

NEWPORT AVENUE/BOULEVARD (NORTH) RTSSP		
NEWPORT AVENUE FROM BRYAN AVENUE TO PACKERS CIRCLE COMMUNICATION PLANS		
DATE: 08/07/15	SUBMITTED: _____ NAME/SIGNATURE	SHEET NO. 7 OF 13
SCALE: 1"=40'	DATE: _____	PROJECT NO. 099371004
DESIGN: CC	APPROVED: _____ NAME/SIGNATURE	
DRAWN: RP	DATE: _____	
CHECKED: SC		

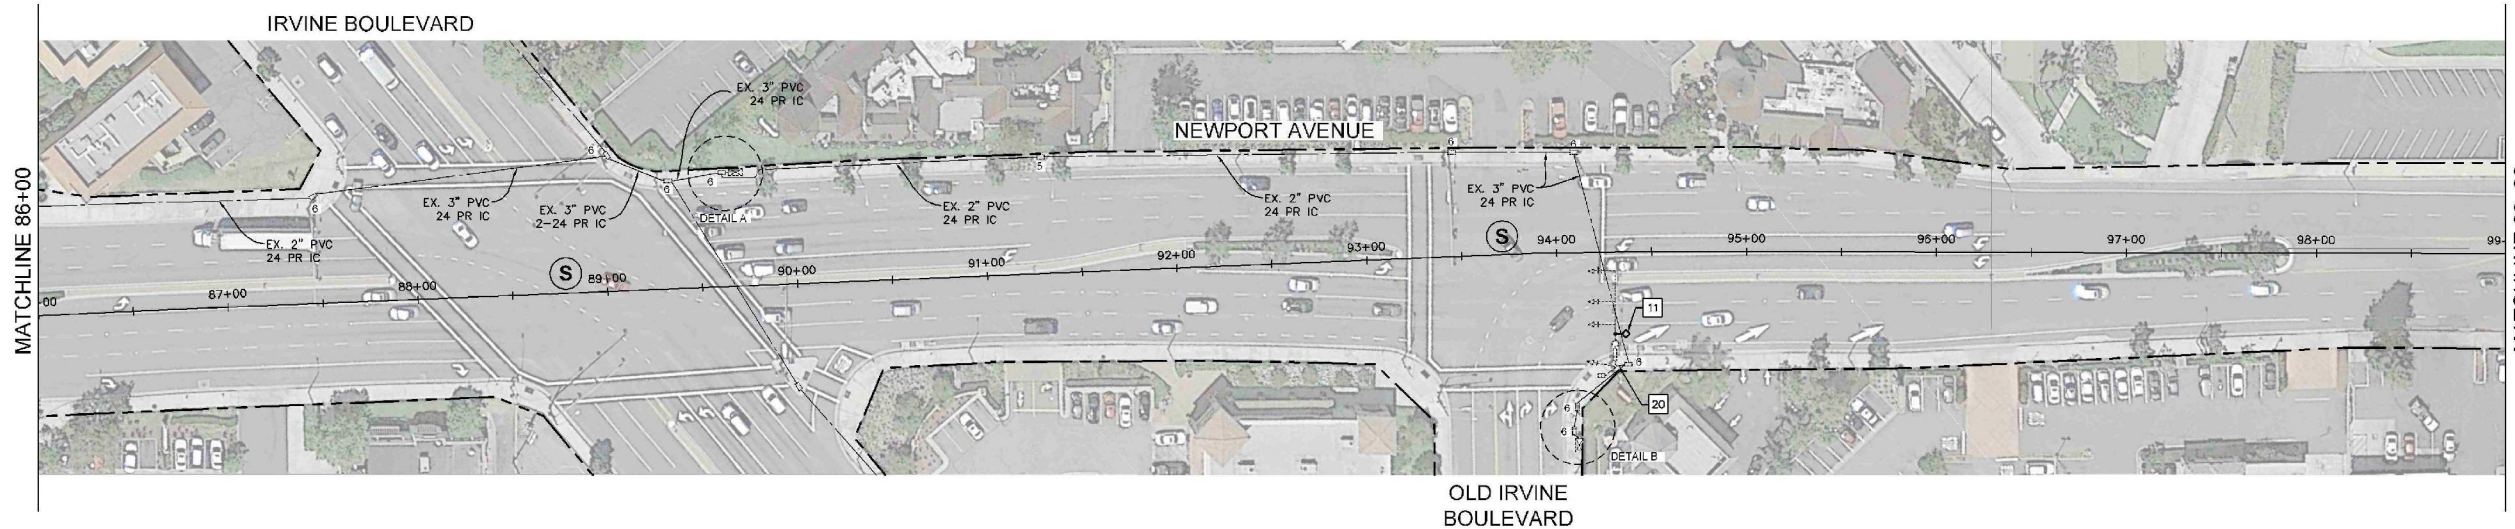


CONSTRUCTION NOTES:


- 11 FURNISH AND INSTALL WIRELESS RADIO ANTENNA, CONFIGURATION, TESTING, AND ASSOCIATED WIRING.
- 15 FURNISH AND INSTALL A/C/E/S ETHERNET OVER COPPER SWITCH.
- 20 FURNISH AND INSTALL OUTDOOR-RATED (PCE) CAT5E CABLE.
- 21 PUNCH DOWN INTERCONNECT AS DIRECTED BY THE ENGINEER.

GENERAL NOTES:


1. CONTRACTOR SHALL CONTACT THE CITY OF TUSTIN ENGINEERING DEPARTMENT AT 714-573-3150 AT LEAST 48 HOURS IN ADVANCE PRIOR TO BEGINNING CONSTRUCTION.

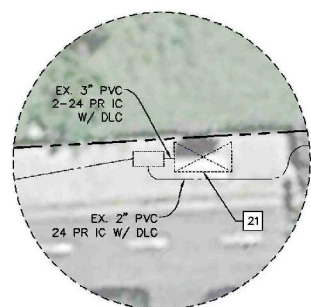

DETAIL A
1" = 10'

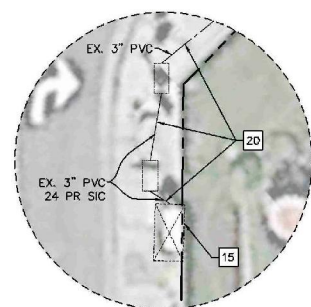

DETAIL B
1" = 10'

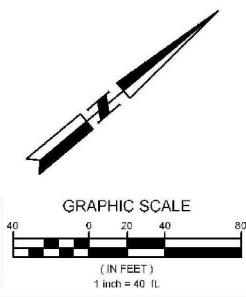


NEWPORT AVENUE/BOULEVARD (NORTH) RTSSP			
NEWPORT AVENUE FROM IRVINE BOULEVARD TO WARREN AVENUE COMMUNICATION PLANS			
DATE: 08/07/15	SUBMITTED: _____	SHEET NO. 8 OF 13	
SCALE: 1"=40'	DATE: _____	PROJECT NO. 099371004	
DESIGN: CC	APPROVED: _____		
DRAWN: RP	DATE: _____		
CHECKED: SC			



© 2015 KIMLEY-HORN AND ASSOCIATES, INC.
660 South Figueroa Street, Suite 2050, Los Angeles, CA 90017
Tel: (213) 261-4040

K:\DT_TPT\099371004 - Newport Ave North RTSSP\Design\Currents\Communications\099371004-SH4.dwg 5/6/2014 9:45 AM

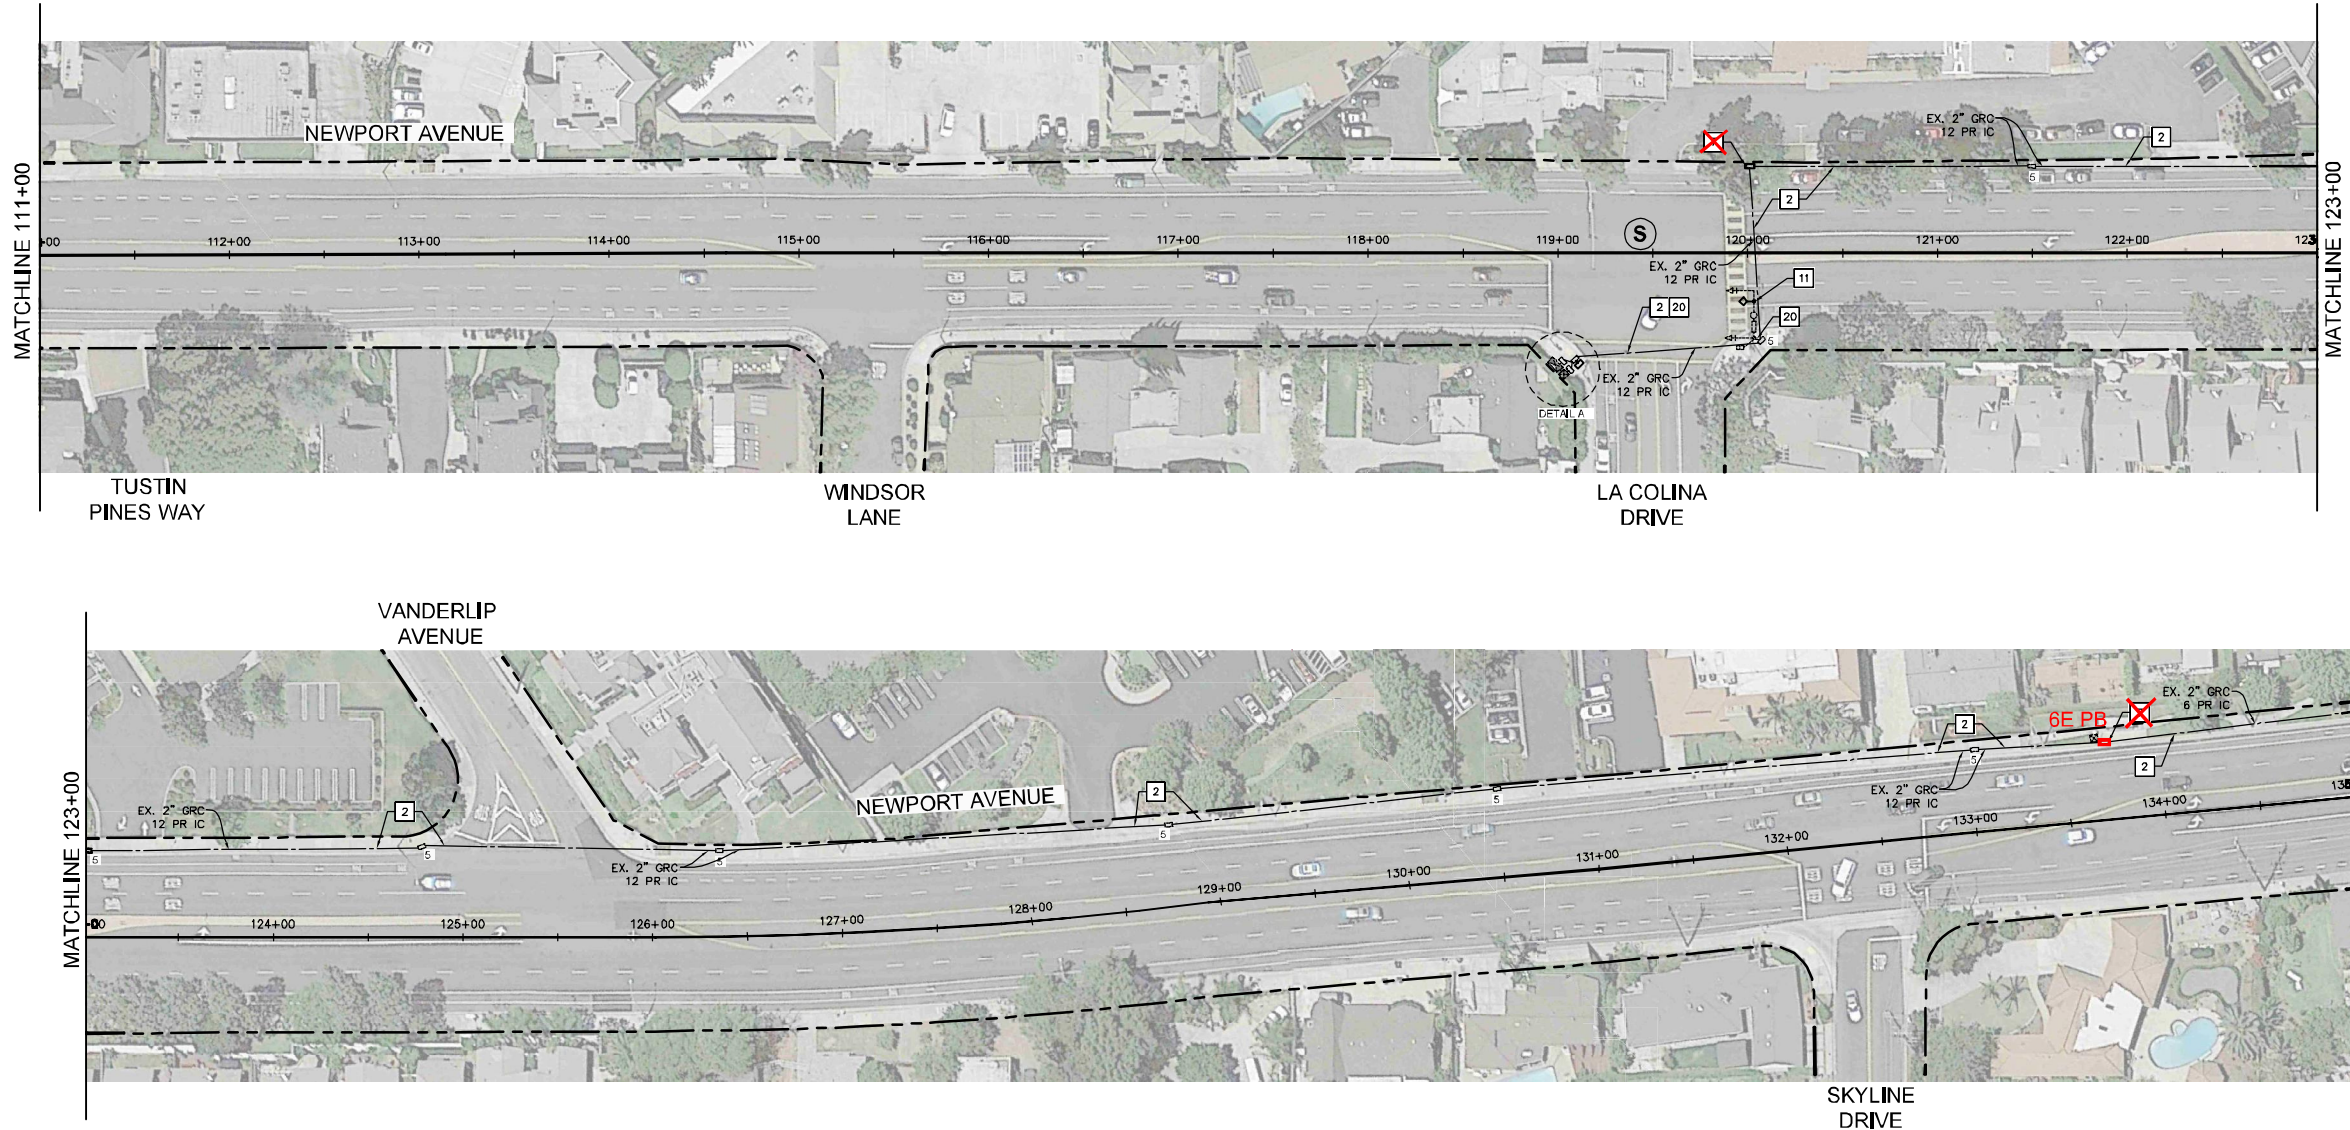


GENERAL NOTES:

1. CONTRACTOR SHALL CONTACT THE ORANGE COUNTY ROAD DEPARTMENT AT 714-245-4570 AT LEAST 48 HOURS PRIOR TO BEGINNING CONSTRUCTION.

CONSTRUCTION NOTES:


1. FURNISH AND INSTALL NEW PVC SCHEDULE 80 3" CONDUIT.
2. FURNISH AND INSTALL 24 SMFO CABLE IN CONDUIT.
3. FURNISH AND INSTALL 6 SMFO CABLE IN CONDUIT.
6. FURNISH AND INSTALL NEW 6E PULL BOX ADJACENT TO EXISTING PULL BOX. PROVIDE 40 FEET OF SLACK FOR THE FIBER OPTIC CABLE IN PULL BOX AND CONTROLLER CABINET.
7. FURNISH AND INSTALL NEW 6E PULL BOX, REMOVE EXISTING PULL BOX.
8. FURNISH AND INSTALL FIBER SWITCH PER AGENCY SPECIAL PROVISIONS.
9. FURNISH AND INSTALL AGENCY APPROVED FIBER OPTIC SPLICE ENCLOSURE IN PULL BOX PER AGENCY SPECIAL PROVISIONS. FUSION SPLICE 6-STRAND SMFO CABLE(S) TO 24 SMFO CABLE(S) IN SPLICE ENCLOSURE.
10. FURNISH AND INSTALL FIBER DISTRIBUTION UNIT WITH SPLICE TRAY. FURNISH AND INSTALL 6 SC DUPLEX CABLES INSIDE THE FIBER DISTRIBUTION UNIT. TERMINATE SC CABLES ON THE BACK OF THE PANELS. FUSION SPLICE 6 SMFO CABLE(S) TO DUPLEX CABLE IN SPLICE TRAY. FURNISH AND INSTALL 2 FIBER OPTIC DUPLEX JUMPER CABLES WITH SC (OR) SL CONNECTORS PER AGENCY STANDARD. CONNECT THESE CABLES TO FIBER SWITCH.
11. FURNISH AND INSTALL WIRELESS RADIO ANTENNA, CONFIGURATION, TESTING, AND ASSOCIATED WIRING.
20. FURNISH AND INSTALL OUTDOOR/RATED (POE) CAT5E CABLE.

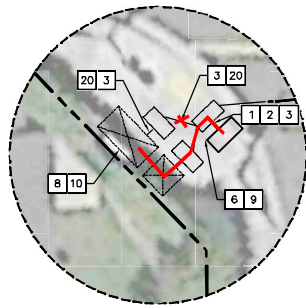

DETAIL A

1" = 1'

As-Built Drawings
Gilbert Rodarte
CROSSTOWN ELECTRICAL & DATA, INC.

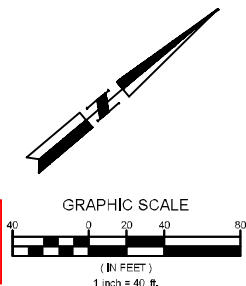

NEWPORT AVENUE/BOULEVARD (NORTH) RTSSP			
NEWPORT AVENUE FROM TUSTIN PINES WAY TO SKYLINE DRIVE COMMUNICATION PLANS			
DATE: 08/07/15	SUBMITTED: _____	SHEET NO. 9 OF 13	
SCALE: 1"=40'	DATE: _____	PROJECT NO. 06837/1004	
DESIGN: CC	APPROVED: _____		
DRAWN: RP	DATE: _____		
CHECKED: SC			

K:\DT_TPTD\068371004 - newport ave north tssp\Design\Curren\communications\068371004-Sht9.dwg 5/6/2014 9:45 AM




Kimley»Horn
© 2016 KIMLEY-HORN AND ASSOCIATES, INC.
660 South Figueroa Street, Suite 2050, Los Angeles, CA 90017
Tel (213) 261-4040

K:_DT_TPTD\099371004 - newport ave north tsep\Design\Currents\communications\099371004-Sht10.dwg 5/6/2014 9:45 AM



Kimley»Horn

© 2016 KIMLEY-HORN AND ASSOCIATES, INC.
660 South Figueroa Street, Suite 2050, Los Angeles, CA 90017
Tel (213) 261-4040

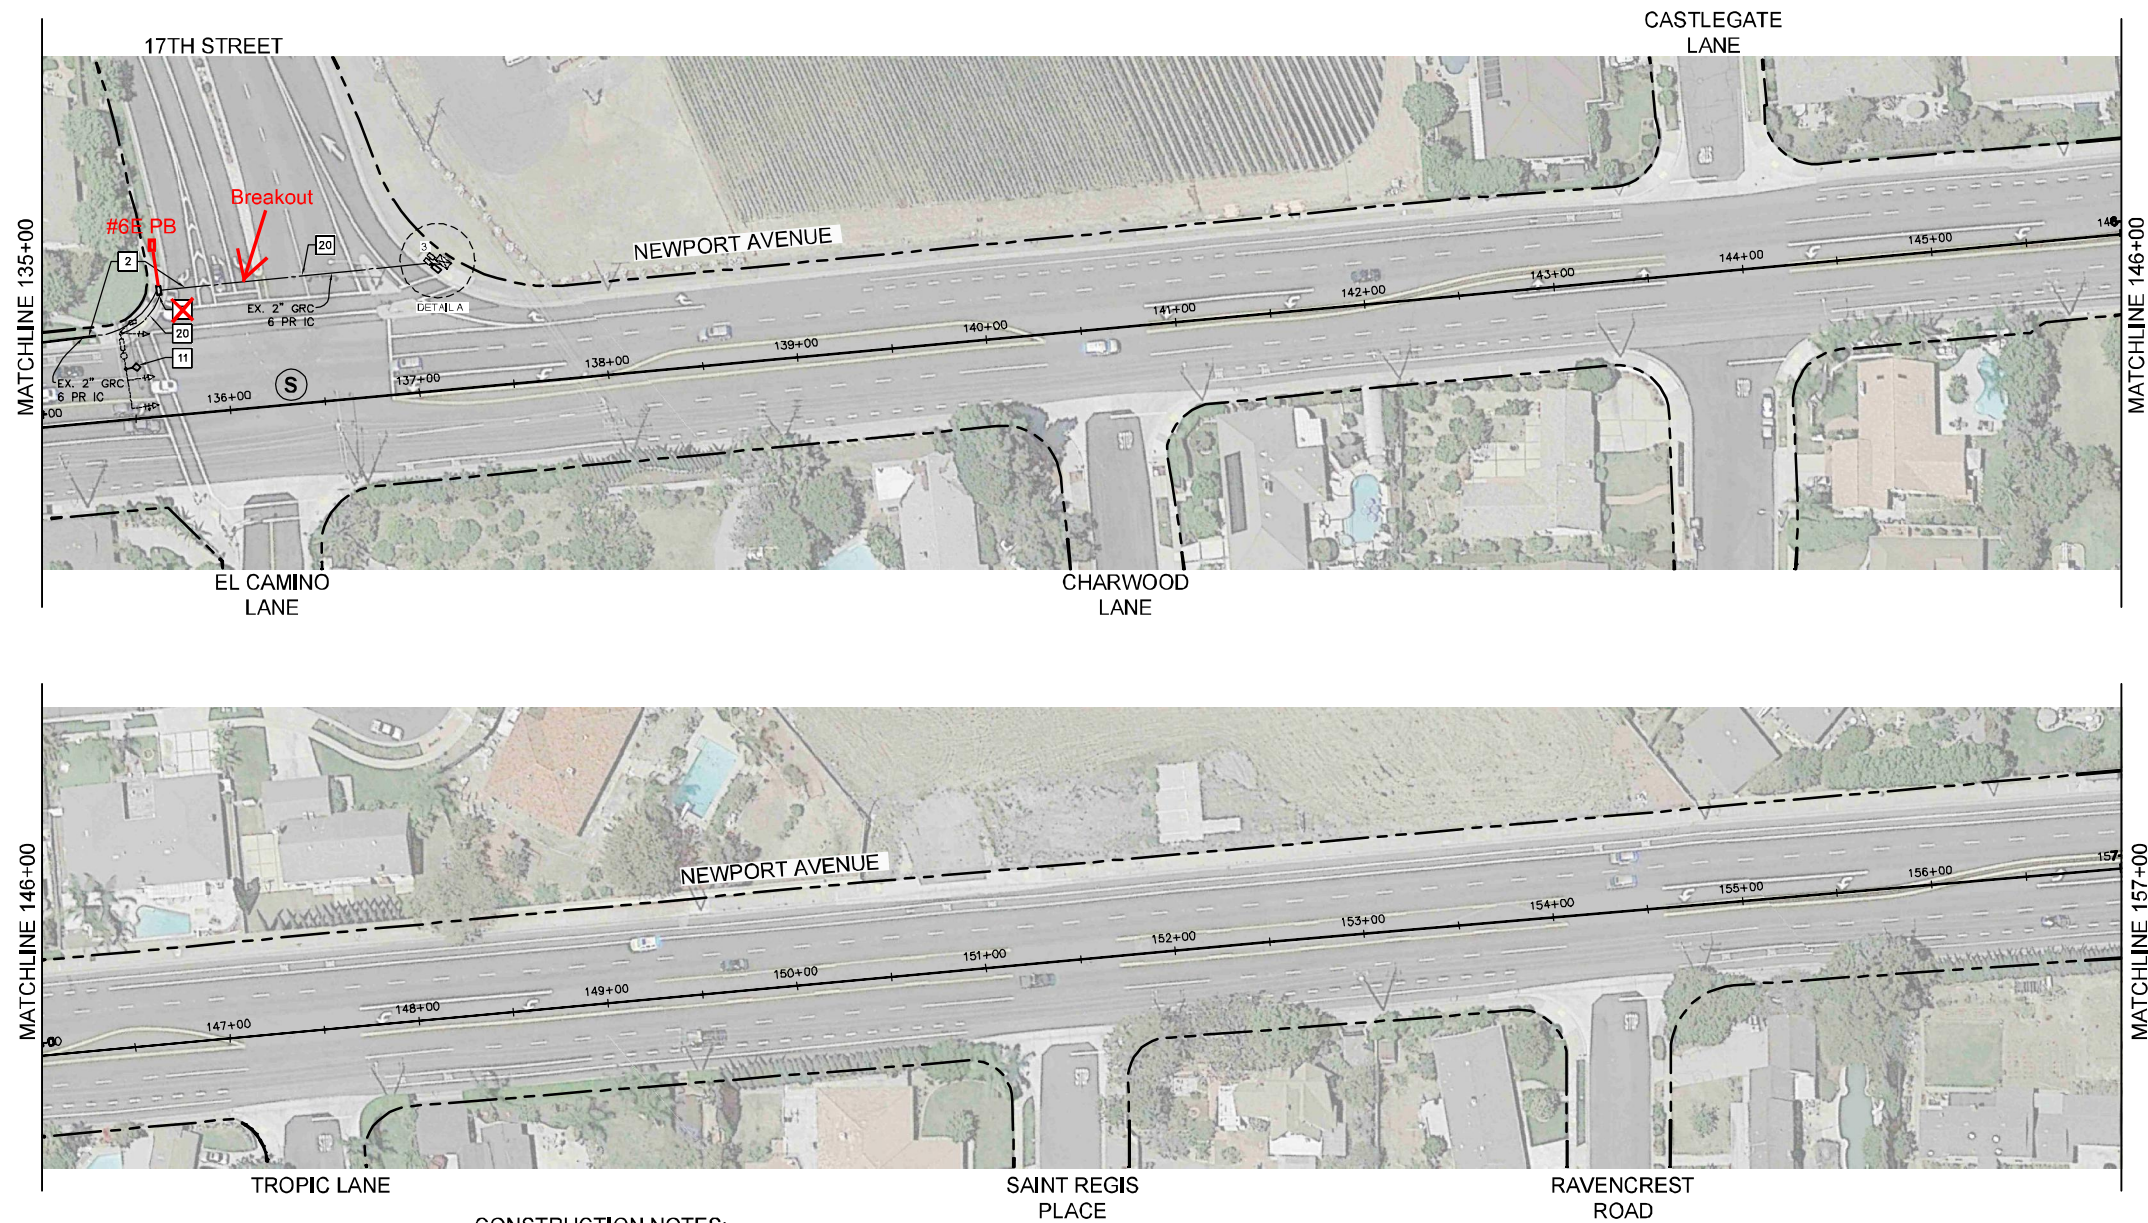


GENERAL NOTES:

1. CONTRACTOR SHALL CONTACT THE ORANGE COUNTY ROAD DEPARTMENT AT 714-245-4670 AT LEAST 48 HOURS PRIOR TO BEGINNING CONSTRUCTION.


CONSTRUCTION NOTES:

1. FURNISH AND INSTALL NEW PVC SCHEDULE 80 3" CONDUIT.
2. FURNISH AND INSTALL 24 SMFO CABLE IN CONDUIT.
3. FURNISH AND INSTALL 6 SMFO CABLE IN CONDUIT.
6. FURNISH AND INSTALL NEW #RE PULL BOX ADJACENT TO EXISTING PULL BOX. PROVIDE 40 FEET OF SLACK FOR THE FIBER OPTIC CABLE IN PULL BOX AND CONTROLLER CABINET.
7. FURNISH AND INSTALL NEW #RE PULL BOX. REMOVE EXISTING PULL BOX.
8. FURNISH AND INSTALL FIBER SWITCH PER AGENCY SPECIAL PROVISIONS.
9. FURNISH AND INSTALL AGENCY APPROVED FIBER OPTIC SPLICING ENCLOSURE IN PULL BOX PER AGENCY SPECIAL PROVISIONS. FUSION SPLICING (6-STRAND SMFO CABLE(S) TO 24 SMFO CABLE(S) IN SPLICING ENCLOSURE.
10. FURNISH AND INSTALL FIBER DISTRIBUTION UNIT WITH SPLICING TRAY. FURNISH AND INSTALL 6 SC DUPLEX CABLES INSIDE THE FIBER DISTRIBUTION UNIT. TERMINATE SC CABLES ON THE BACK OF THE PANELS. FUSION SPLICING 6 SMFO CABLE(S) TO DUPLEX CABLE IN SPLICING TRAY. FURNISH AND INSTALL 2 FIBER OPTIC DUPLEX JUMPER CABLES WITH SC (OR) SC CONNECTORS PER AGENCY STANDARD. CONNECT THESE CABLES TO FIBER SWITCH.
11. FURNISH AND INSTALL WIRELESS RADIO ANTENNA. CONFIGURATION, TESTING, AND ASSOCIATED WIRING.
20. FURNISH AND INSTALL OUTDOOR-RATED (POE) CAT5E CABLE.




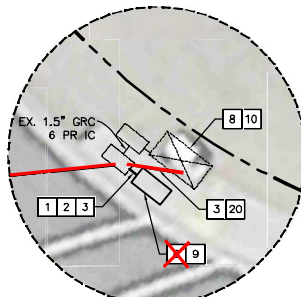



DETAIL A
1" = 10'

As-Built Drawings
Gilbert Rodarte
CROSSTOWN ELECTRICAL & DATA, INC.

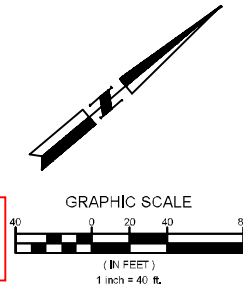

NEWPORT AVENUE/BOULEVARD (NORTH) RTSSP			
NEWPORT AVENUE FROM 17 STREET TO RAVENCREST ROAD COMMUNICATION PLANS			
DATE: 08/07/15	SUBMITTED: _____	SHEET NO. 10 OF 13	
SCALE: 1"=40'	DATE: _____	PROJECT NO. 099371004	
DESIGN: CC	APPROVED: _____		
DRAWN: RP	DATE: _____		
CHECKED: SC			

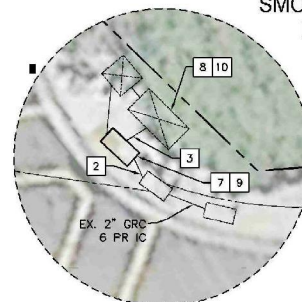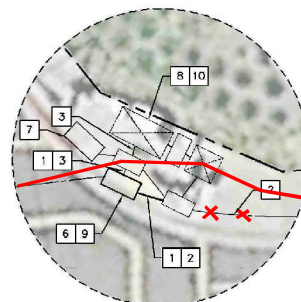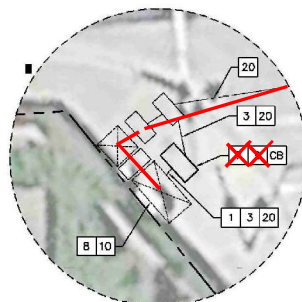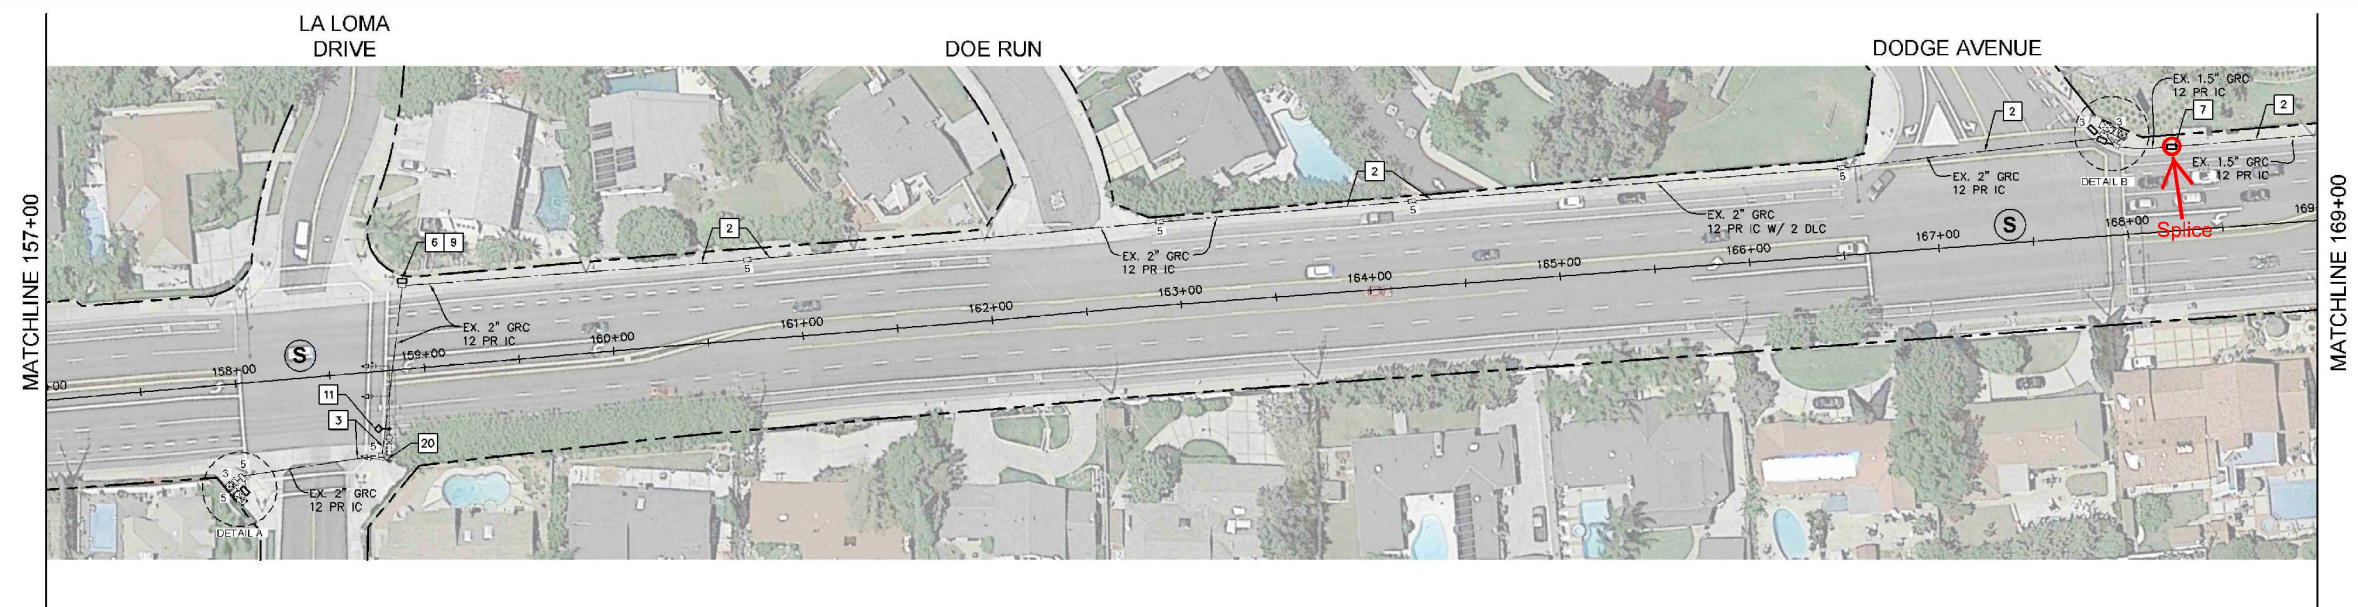

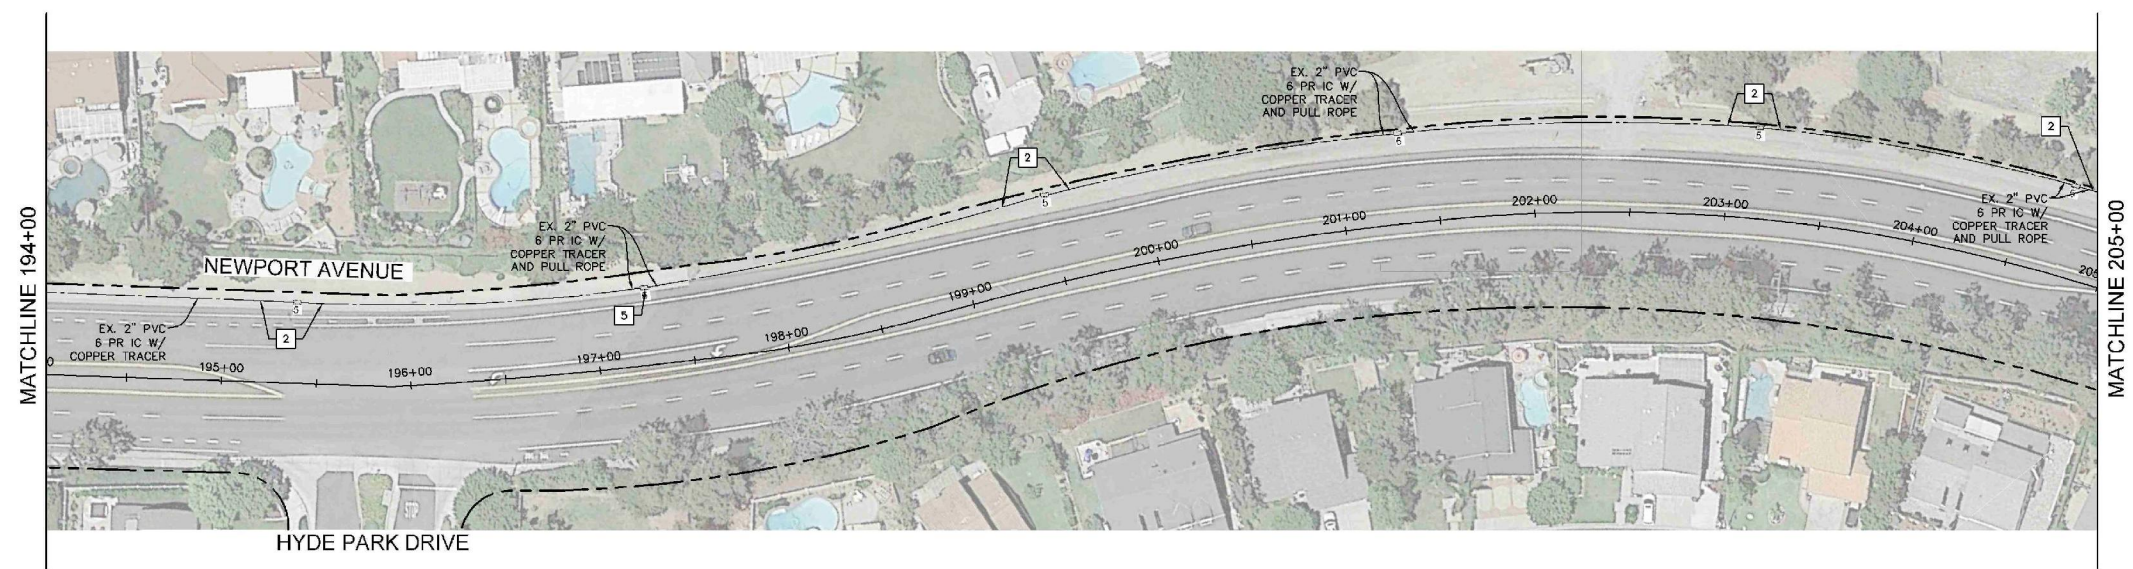

CONSTRUCTION NOTES:

- 2 FURNISH AND INSTALL 24 BMFO CABLE IN CONDUIT
- 5 FURNISH AND INSTALL 2-2 INCH PVC BUSHINGS
- 14 FURNISH AND INSTALL NEW PULL BOX LID

GENERAL NOTES:


1. CONTRACTOR SHALL CONTACT THE ORANGE COUNTY ROAD DEPARTMENT AT 714-245-4570 AT LEAST 48 HOURS PRIOR TO BEGINNING CONSTRUCTION.



Kimley»Horn

© 2019 KIMLEY-HORN AND ASSOCIATES, INC.
660 South Figueroa Street, Suite 2050, Los Angeles, CA 90017
Tel: (213) 261-4040

As-Built Drawings
Gilbert Rodarte
CROSSTOWN ELECTRICAL & DATA, INC.

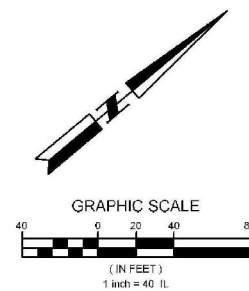

NEWPORT AVENUE/BOULEVARD (NORTH) RTSSP			
NEWPORT AVENUE FROM LEMON HILL DRIVE TO HYDE PARK DRIVE COMMUNICATION PLANS			
DATE: 08/07/15	SUBMITTED: _____	SHEET NO. 12 OF 13	
SCALE: 1"=40'	DATE: _____	PROJECT NO. 099371004	
DESIGN: CC	APPROVED: _____		
DRAWN: RP	NAME/SIGNATURE: _____		
CHECKED: SC	DATE: _____		

K:\LD_TPTD\099371004 - Newport ave north tsep\Design\Currents\communications\099371004-Sht13.dwg 5/6/2014 9:45 AM



Kimley»Horn


© 2016 KIMLEY-HORN AND ASSOCIATES, INC.
660 South Figueroa Street, Suite 2050, Los Angeles, CA 90017
Tel (213) 261-4040

CONSTRUCTION NOTES:


1. FURNISH AND INSTALL NEW PVC SCHEDULE 80 3" CONDUIT.
2. FURNISH AND INSTALL 24 SMFO CABLE IN CONDUIT.
3. FURNISH AND INSTALL 6 SMFO CABLE IN CONDUIT.
6. FURNISH AND INSTALL NEW WIRE PULL BOX ADJACENT TO EXISTING PULL BOX. PROVIDE 40 FEET OF SLACK FOR THE FIBER OPTIC CABLE IN PULL BOX AND CONTROLLER CABINET.
8. FURNISH AND INSTALL FIBER SWITCH PER AGENCY SPECIAL PROVISIONS.
9. FURNISH AND INSTALL AGENCY APPROVED FIBER OPTIC SPLICE ENCLOSURE IN PULL BOX PER AGENCY SPECIAL PROVISIONS. FUSION SPLICE 6-STRAND SMFO CABLE(S) TO 24 SMFO CABLE(S) IN SPLICE ENCLOSURE.
10. FURNISH AND INSTALL FIBER DISTRIBUTION UNIT WITH SPLICE TRAY. FURNISH AND INSTALL 8 SC DUPLEX CABLES INSIDE THE FIBER DISTRIBUTION UNIT. TERMINATE SC CABLES ON THE BACK OF THE PANELS. FUSION SPLICE 6 SMFO CABLE(S) TO DUPLEX CABLE IN SPLICE TRAY. FURNISH AND INSTALL 2 FIBER OPTIC DUPLEX JUMPER CABLES WITH SC (OR) SC CONNECTORS PER AGENCY STANDARD. CONNECT THESE CABLES TO FIBER SWITCH.

GENERAL NOTES:


1. CONTRACTOR SHALL CONTACT THE ORANGE COUNTY ROAD DEPARTMENT AT 714-245-4570 AT LEAST 48 HOURS PRIOR TO BEGINNING CONSTRUCTION.

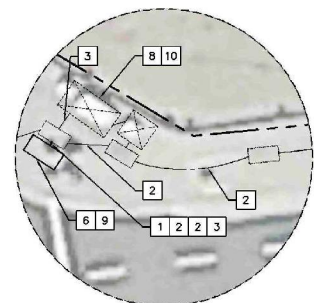

DETAIL A
1" = 10'

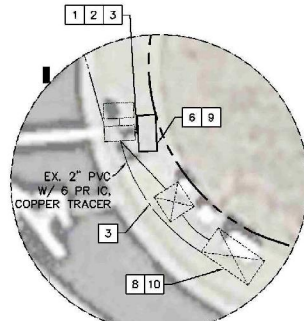

DETAIL B
1" = 10'

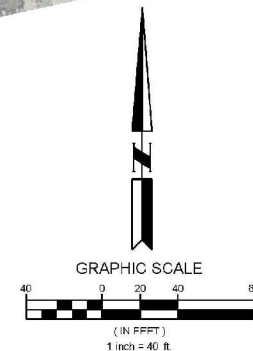

NEWPORT AVENUE/BOULEVARD (NORTH) RTSSP		
NEWPORT AVENUE FROM CRAWFORD CANYON BOULEVARD TO ROCKHURST AVENUE COMMUNICATION PLANS		
DATE: 08/07/15	SUBMITTED: _____ NAME/SIGNATURE	SHEET NO. 13 OF 13
SCALE: 1"=40'	DATE: _____	PROJECT NO. 088371004
DESIGN: CC	APPROVED: _____ NAME/SIGNATURE	
DRAWN: RP	DATE: _____	
CHECKED: SC		

As-Built Drawings
Gilbert Rodarte
CROSSTOWN ELECTRICAL & DATA, INC.