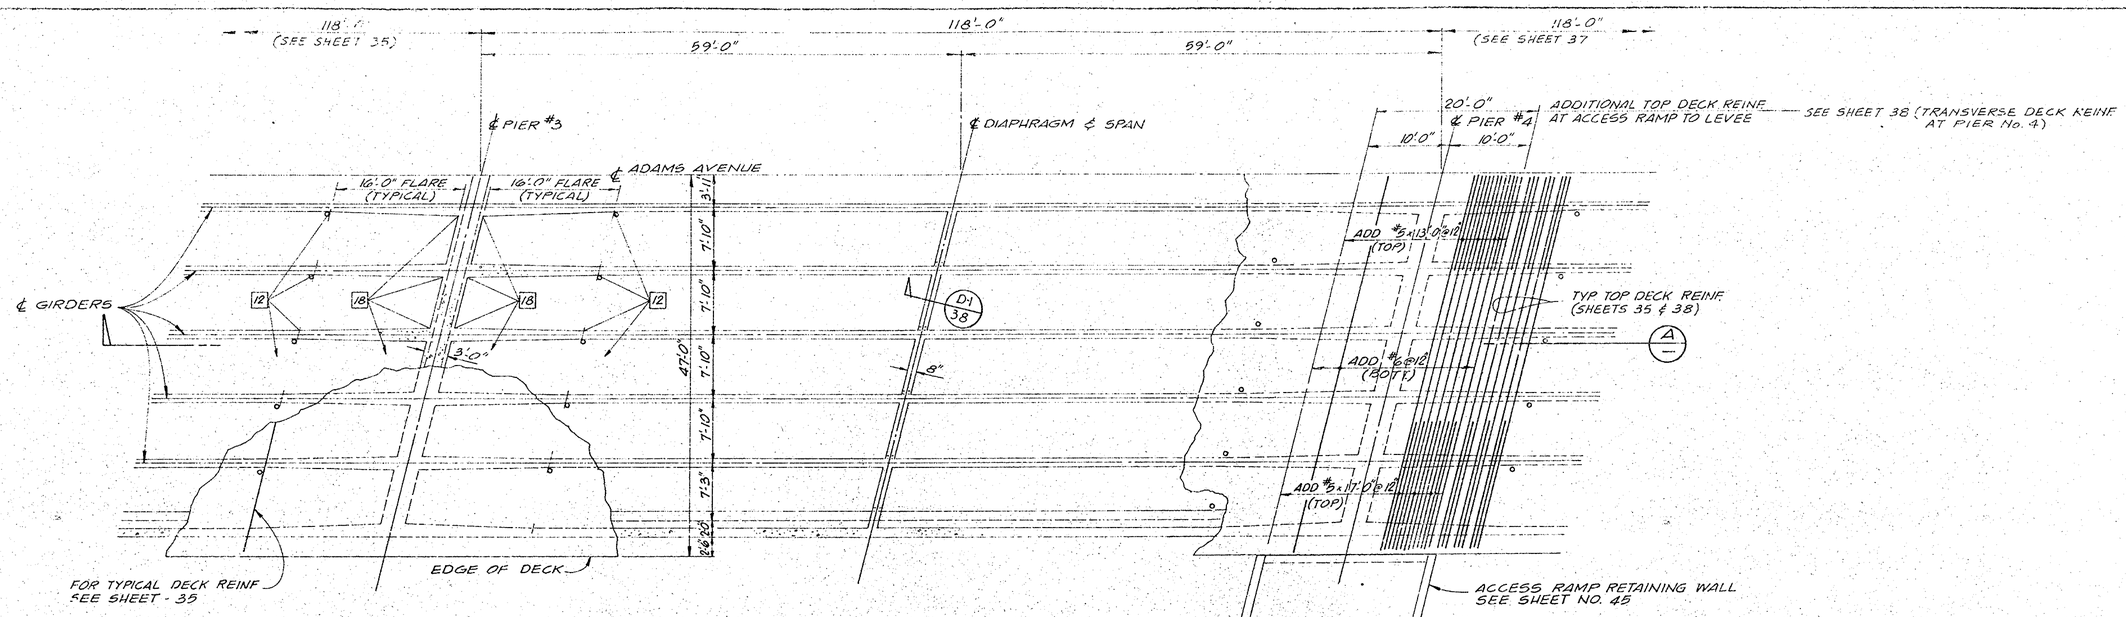

PLAN - GIRDER LAYOUT

SCALE: 1/8" = 1'-0"
(RIGHT BRIDGE SHOWN)

NOTE:
5"ϕ VENTS IN BOTTOM SLAB & 6" SQUARE DRAINS THROUGH DIAPHAGM SHALL BE SAME AS INDICATED ON SHEET 35. (SEE PLAN ABOVE FOR LOCATION OF VENTS.)

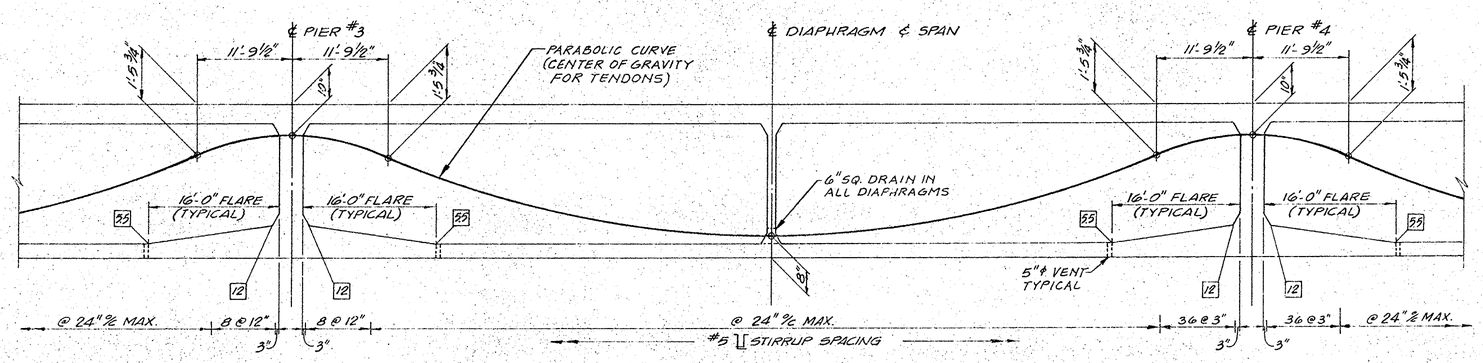

LONGITUDINAL SECTION (A) TYPICAL ALL GIRDERS

SCALE: HORIZ: 1/8" = 1'-0"
VERT: 1/2" = 1'-0"

AS BUILT

WHILE THE INFORMATION SHOWN IS BELIEVED TO BE ACCURATE, THE ORANGE COUNTY ENVIRONMENTAL MANAGEMENT AGENCY WILL NOT BE RESPONSIBLE FOR OMMISSIONS, ERRORS, OR INACCURACIES.

1 1/2 0 1 2
3 inches on original drawing

Bridge Plans
Dr. #7 13329
Dwg. No. 34.1
Sheet No. 36

ORANGE COUNTY
ENVIRONMENTAL MANAGEMENT AGENCY

ADAMS AVENUE BRIDGE
OVER
SANTA ANA RIVER

GIRDER LAYOUT - 2

MARK	DATE	DESCRIPTION	PREPARED UNDER SUPERVISION OF		SHEET
REVISIONS			RCE 6654	DATE	36
DESIGNED J.S.			SCALE	DATE	DWG. NO.
DRAWN R.R.R.	CHECKED J.W.B.		AS SHOWN	APRIL 1977	S.A. 35

OF 53

DR# 7 13329