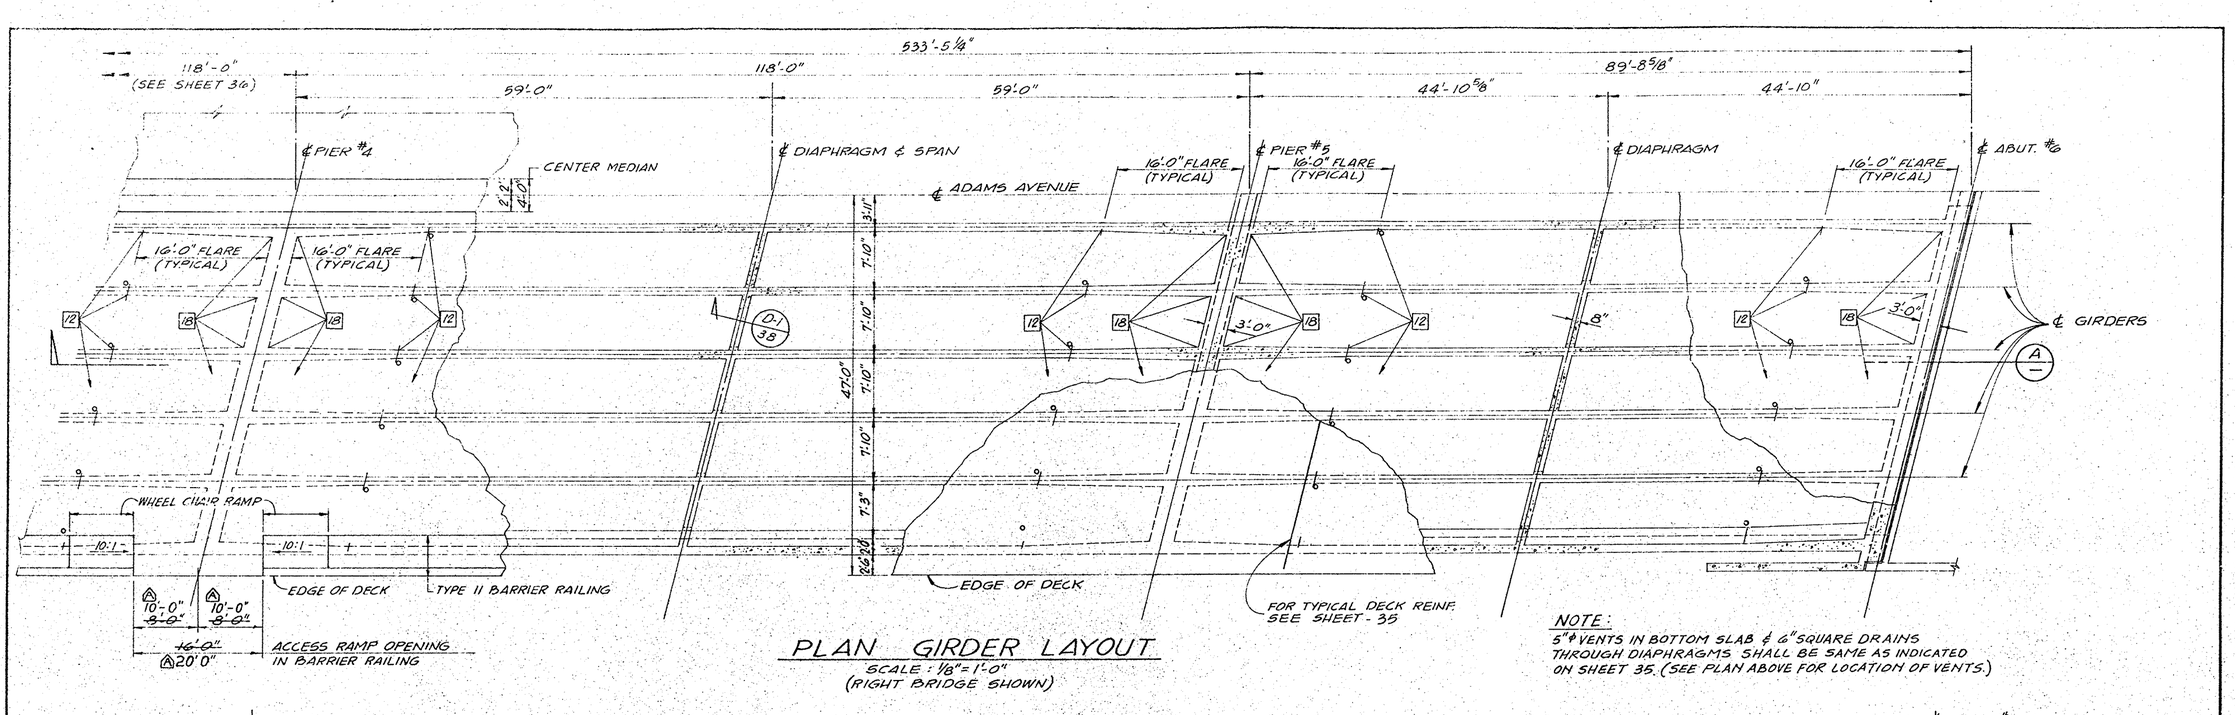

PLAN GIRDER LAYOUT

SCALE : 1/8" = 1'-0"
(RIGHT BRIDGE SHOWN)

NOTE:
5" ϕ VENTS IN BOTTOM SLAB & 6" SQUARE DRAINS THROUGH DIAPHRAGMS SHALL BE SAME AS INDICATED ON SHEET 35. (SEE PLAN ABOVE FOR LOCATION OF VENTS.)

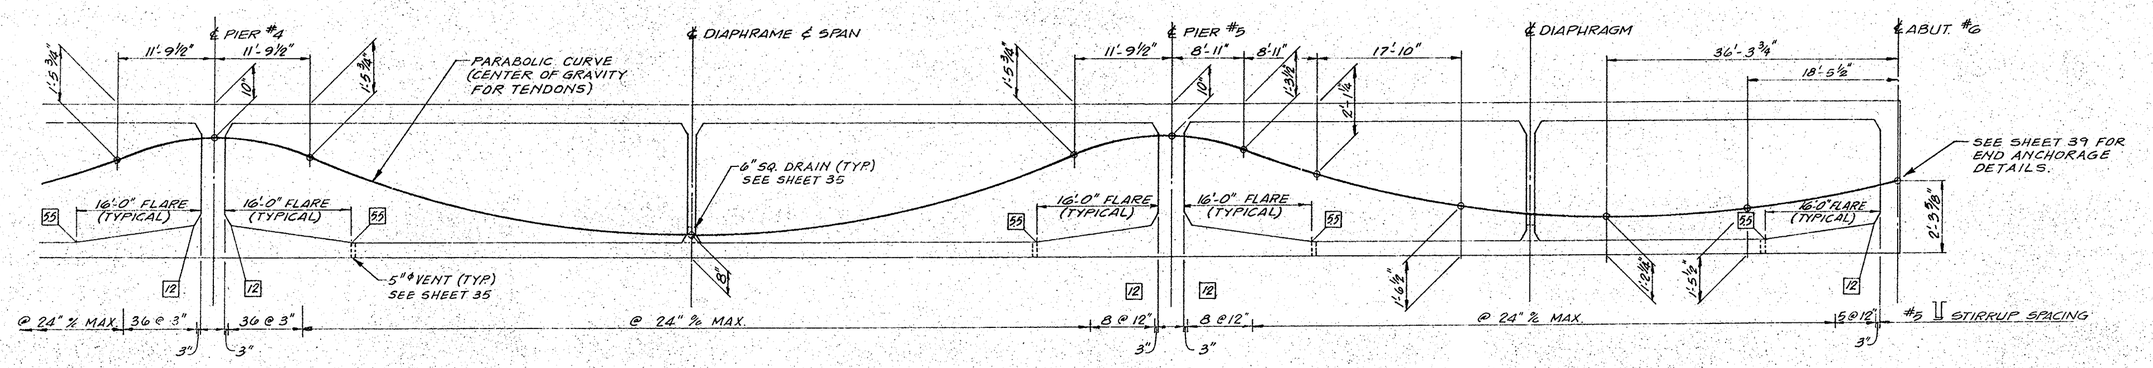

LONGITUDINAL SECTION (A) TYPICAL ALL GIRDERS

SCALE : HORIZ. 1/8" = 1'-0"
VERT. 1/2" = 1'-0"

AS BUILT
WHILE THE INFORMATION SHOWN IS BELIEVED TO BE ACCURATE, THE ORANGE COUNTY ENVIRONMENTAL MANAGEMENT AGENCY WILL NOT BE RESPONSIBLE FOR OMISSIONS, ERRORS, OR INACCURACIES.

1 1/2 0 1 2
3 inches on original drawing

Bridge Plans
Dr. 87 13329
Sheet 37 of 53
Red:* 24.1
Type:** Linen

MARK	DATE	DESCRIPTION
A	3-83	AS BUILT.

REVISIONS

DESIGNED J.S. DRAWN R.R.R. CHECKED J.W.B.

ORANGE COUNTY ENVIRONMENTAL MANAGEMENT AGENCY

ADAMS AVENUE BRIDGE OVER SANTA ANA RIVER

GIRDER LAYOUT - 3

PREPARED UNDER SUPERVISION OF Carl O. Carlson 4/21/77
RCE 6654 DATE

SCALE AS SHOWN | DATE APRIL 1977 | DWG. NO. S.A. 35

SHEET 37 OF 53

DA# 7 13329