ORANGE COUNTY ROAD DEPARTMENT		
PROJECT	BALL ROAD WIDENING	
LIMITS	AT SANTA ANA RIVER	
SCALE	HORIZ. 1"=20' VERT. 1"=5'	SHEET 9 OF 31

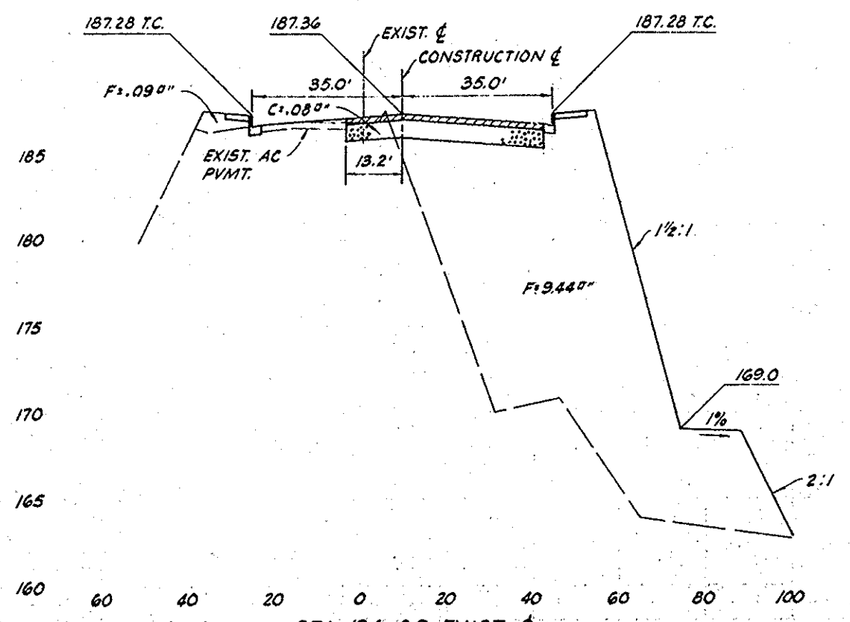

STA. 124+00 EXIST. ℄ =
STA. 123+96 CONSTRUCTION ℄

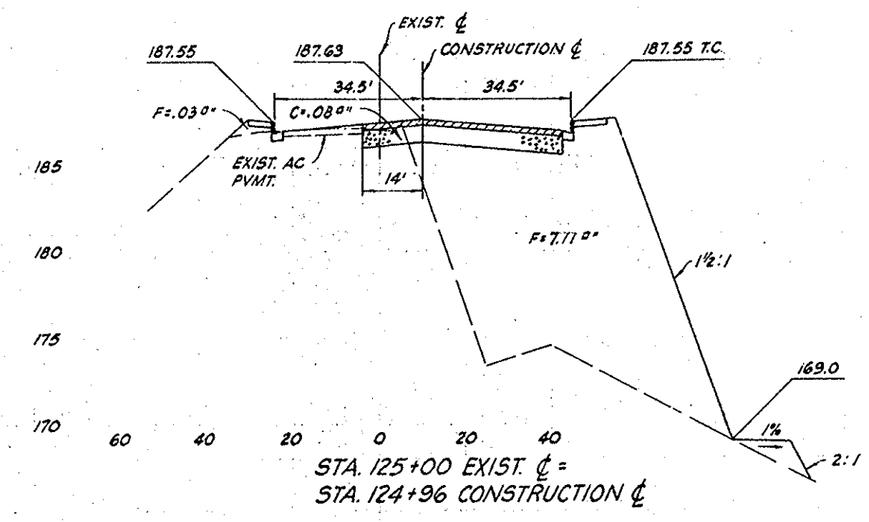

STA. 125+00 EXIST. ℄ =
STA. 124+96 CONSTRUCTION ℄

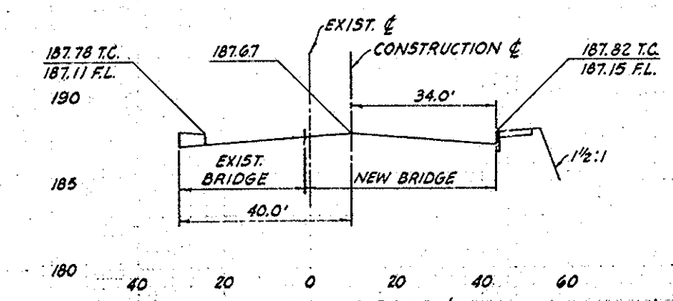

STA. 125+70.5 EXIST. ℄ =
STA. 125+67 CONSTRUCTION ℄

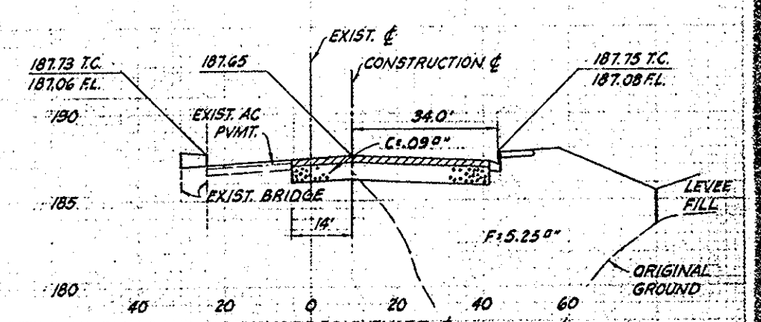

STA. 125+53.5 EXIST. ℄ =
STA. 125+50 CONSTRUCTION ℄

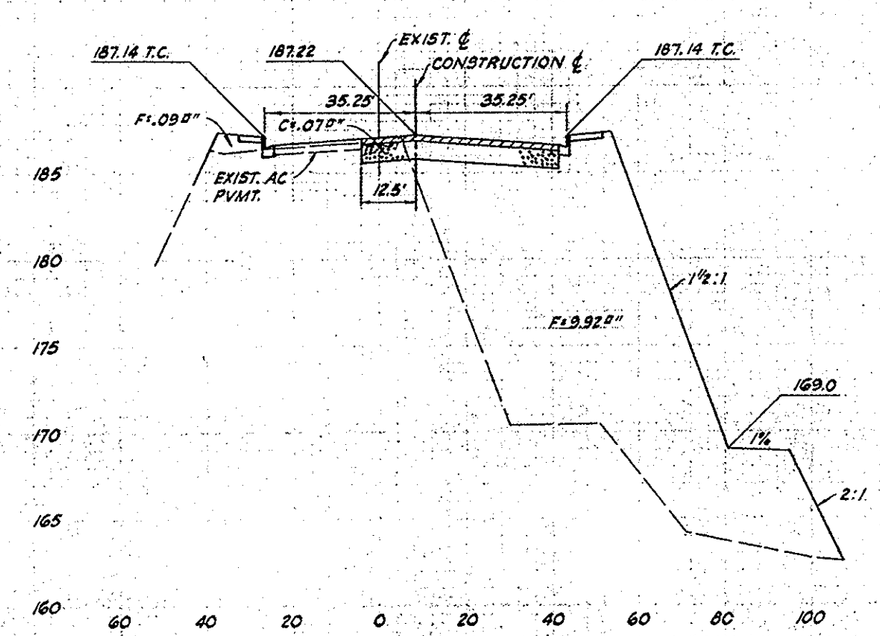

STA. 123+50 EXIST. ℄ =
STA. 123+46.25 CONSTRUCTION ℄

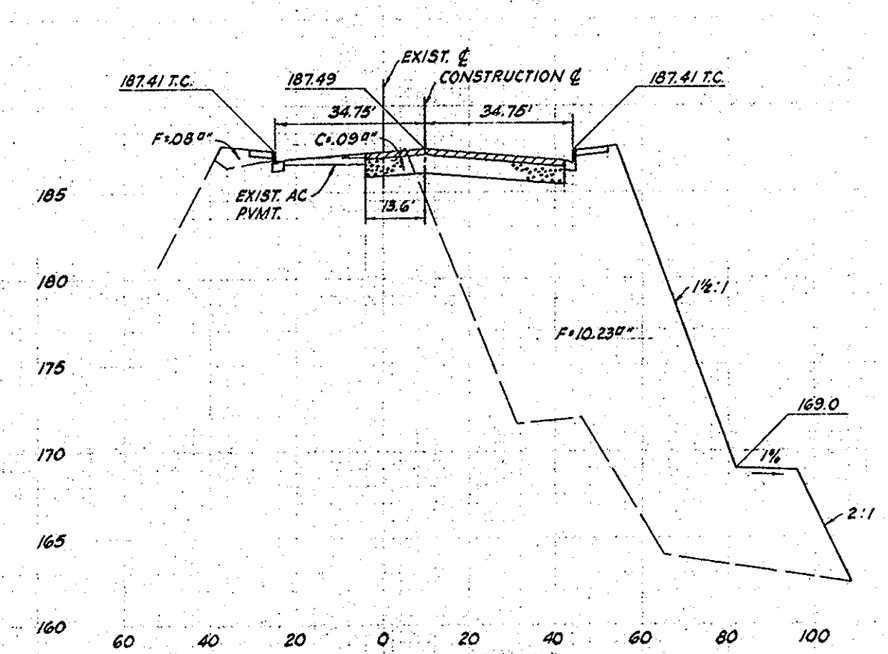

STA. 124+50 EXIST. ℄ =
STA. 124+46 CONSTRUCTION ℄

AS BUILT

f12241
BALL ROAD WIDENING
SHEET 9 of 31
CROSS SECTION
REDUCED 2&:1

DR. #2 (12241)