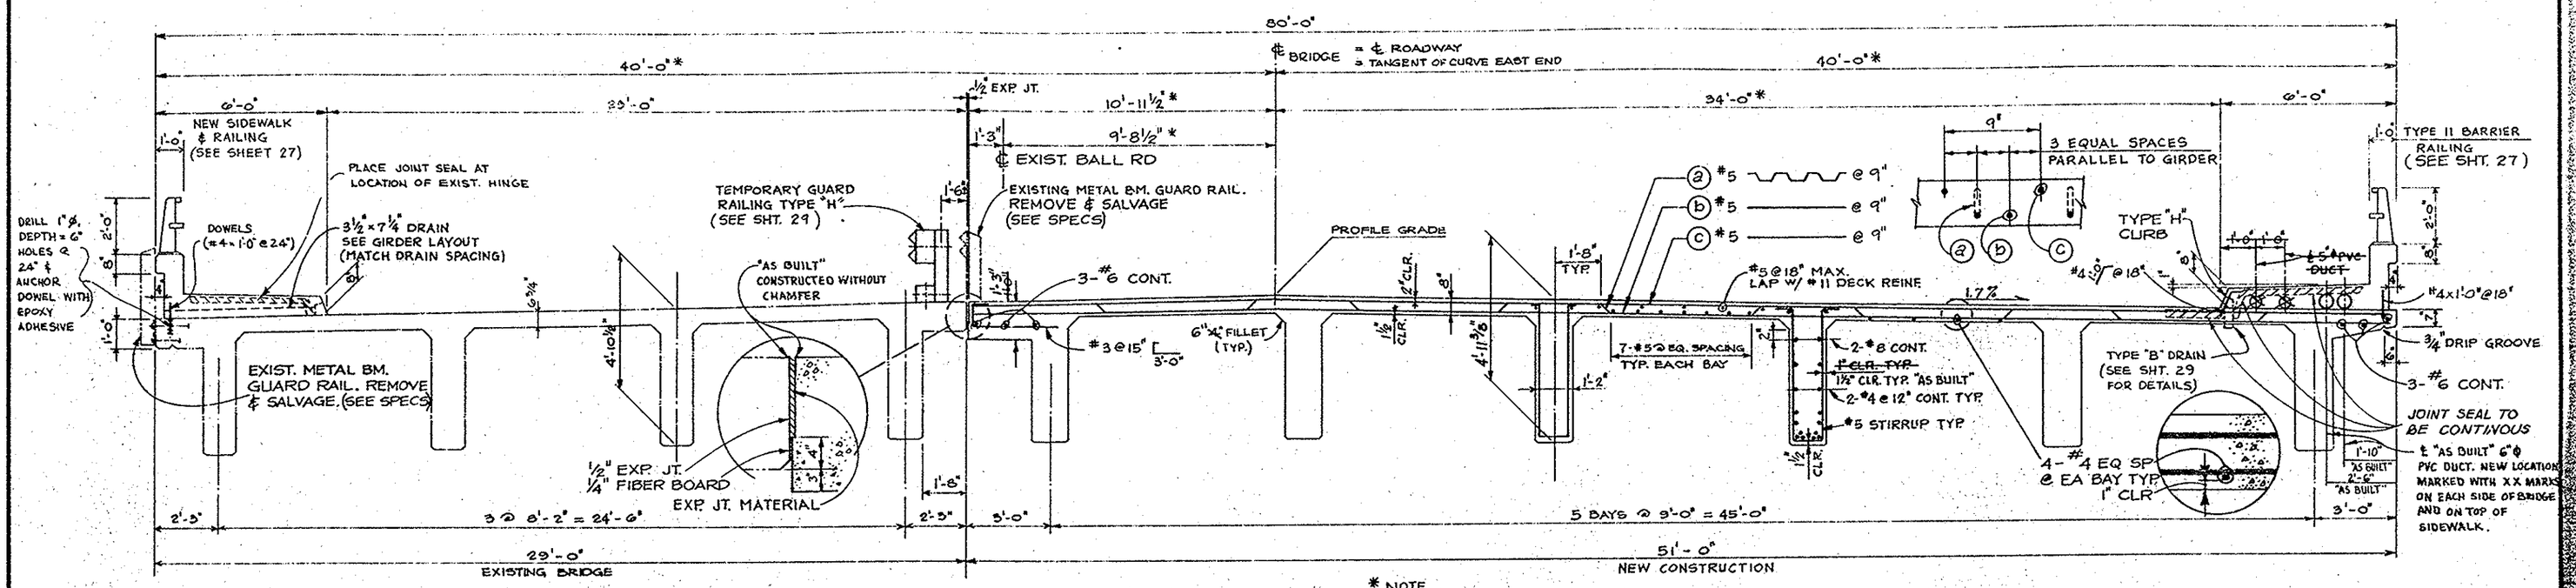

TYPICAL SECTION

SCALE: 3/8" = 1'-0"

* NOTE
EAST ABUTMENT & GIRDER DIMENSIONS ARE DIMENSIONED FROM TANGENT OF CURVE. (SEE GENERAL PLAN FOR CURVE DATA.)

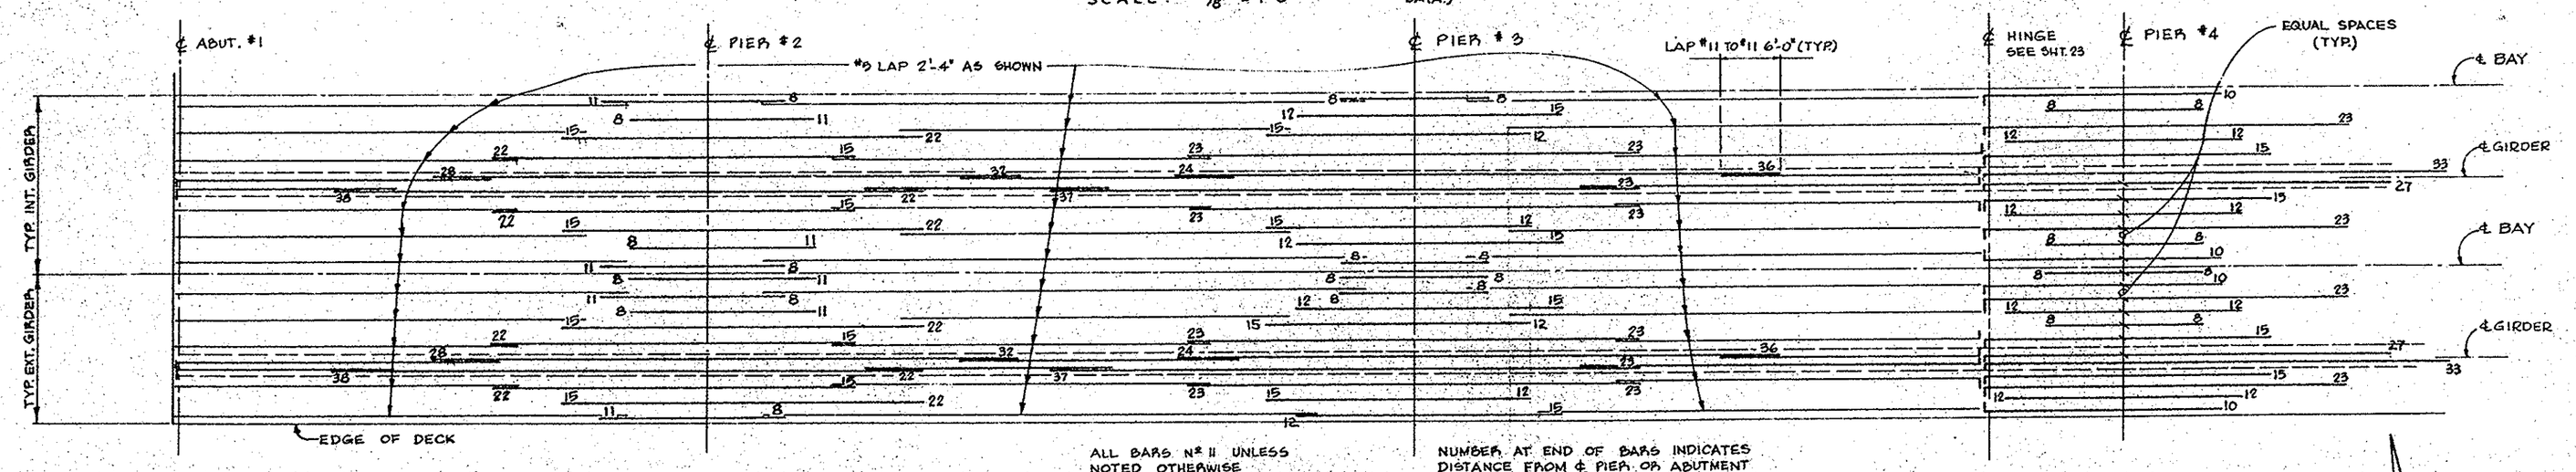

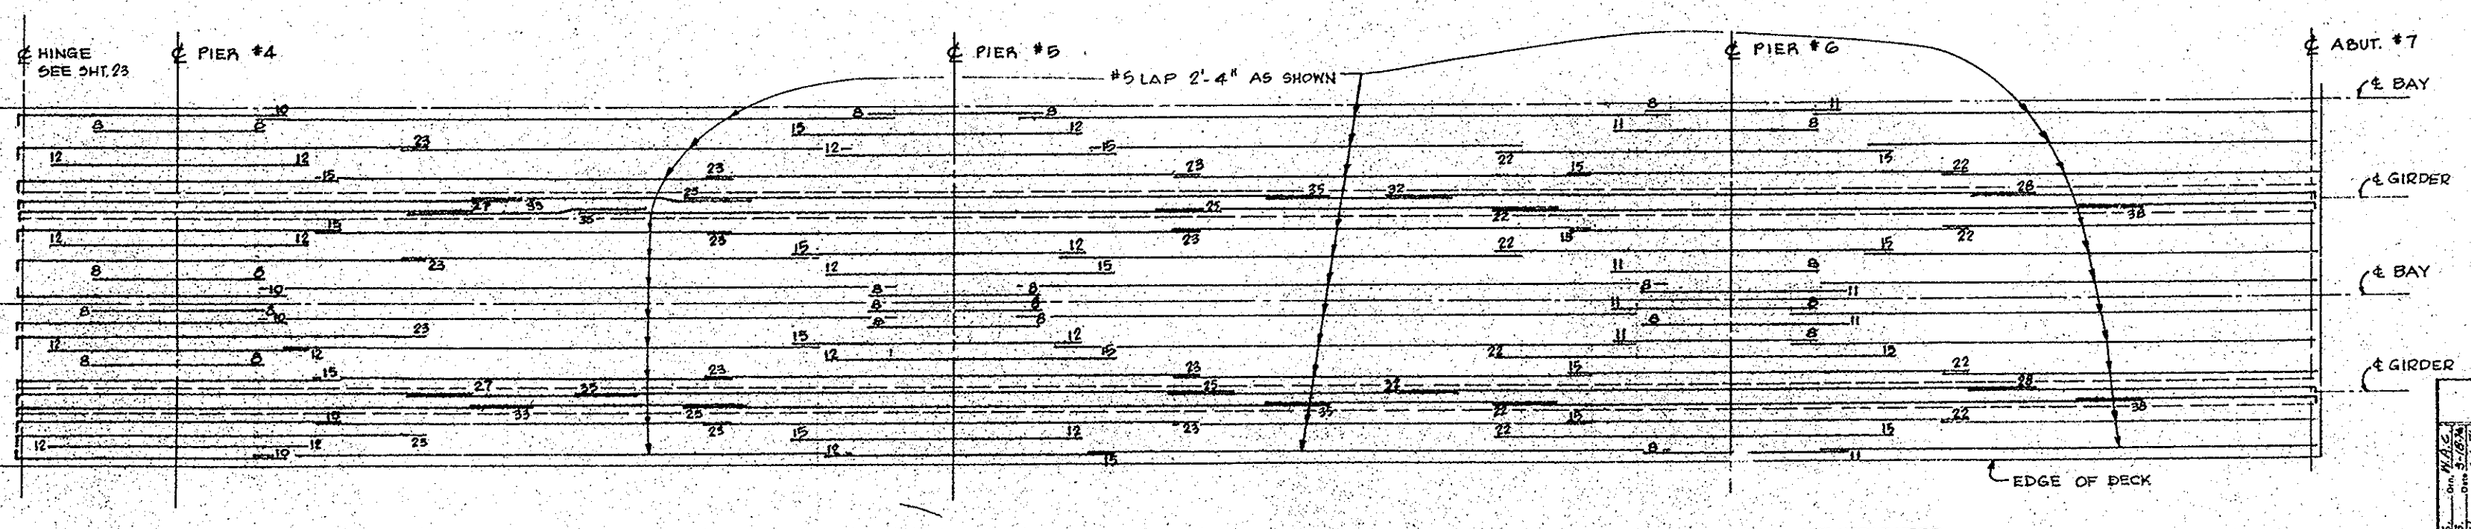

TOP DECK GIRDER REINFORCING LAYOUT

SCALE: LONG. @ 1/8" = 1'-0" ; TRANS. @ 1/4" = 1'-0"

NOTE: SKEW NOT INDICATED

#12241
BALL ROAD WIDENING
REDUCED 24x1
SHEET 19 of 31
LINEN

AS BUILT

ORANGE COUNTY ROAD DEPARTMENT

BALL ROAD BRIDGE WIDENING SA-12
OVER
SANTA ANA RIVER

TYPICAL SECTION

SCALE: AS NOTED | SHEET 19 OF 31

DR. 2 (12241)