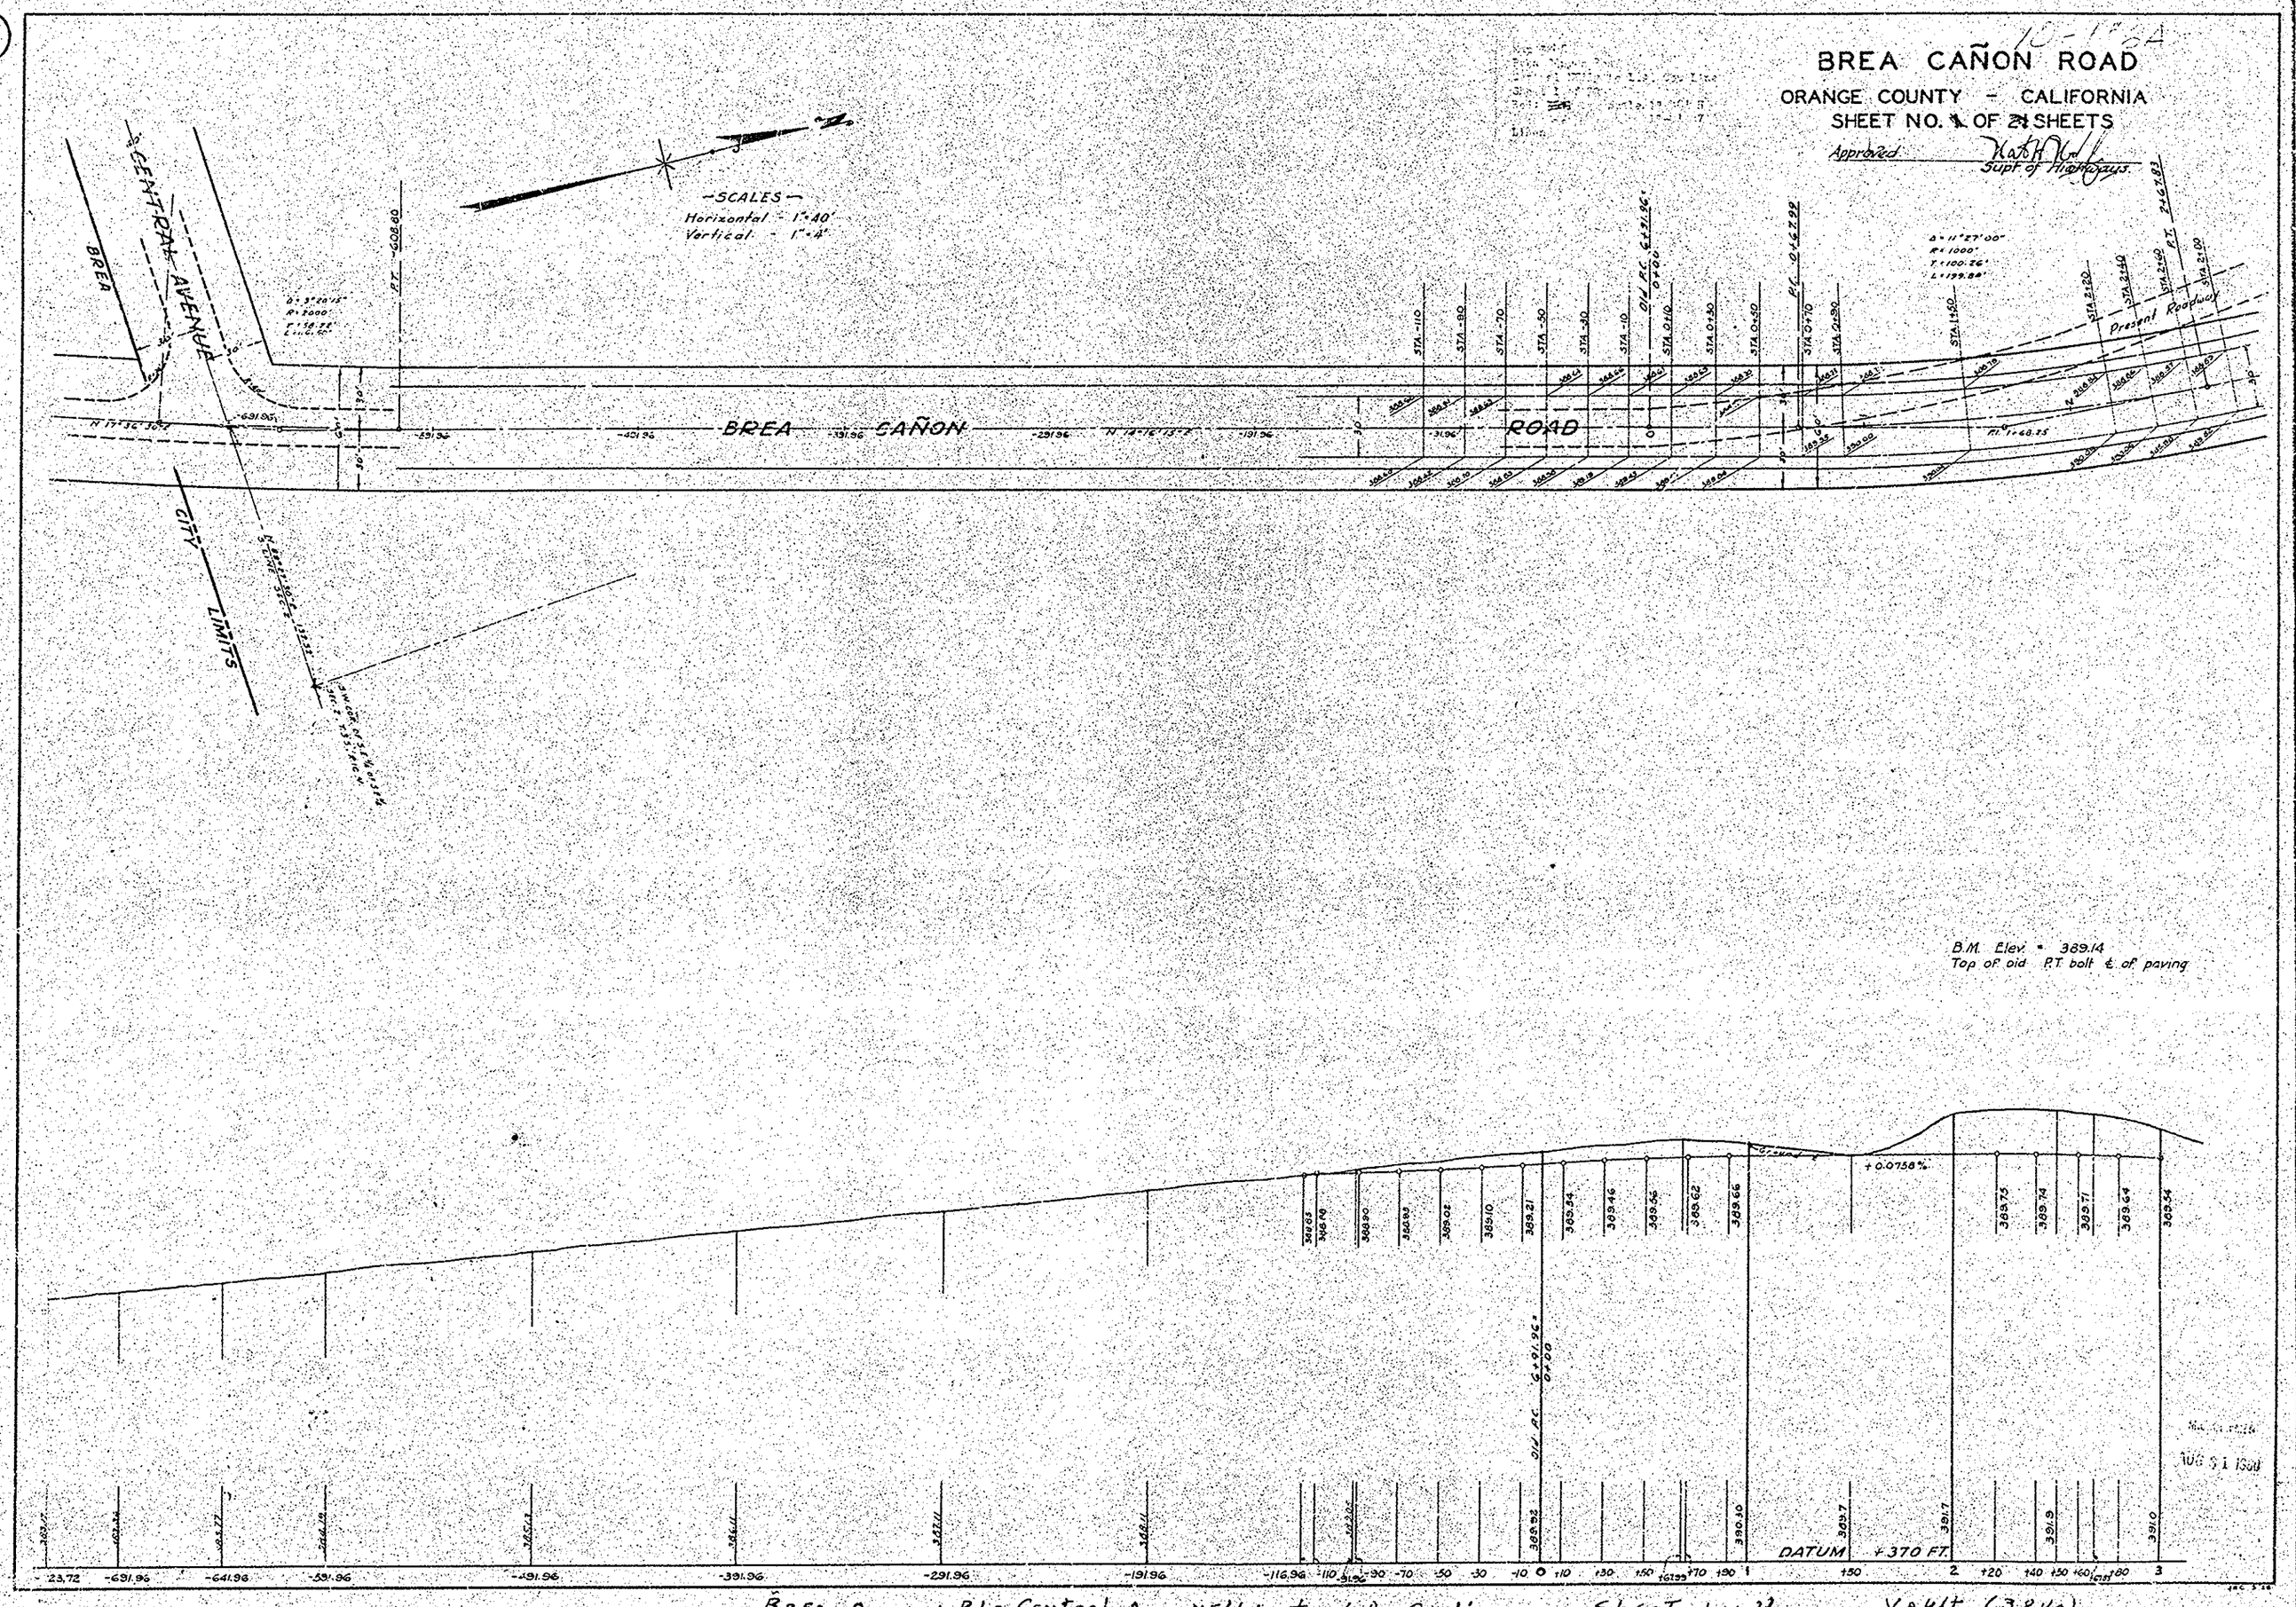

BREA CANYON Rd - CENTRAL Ave NE'ly to L.A. Co. Line

Sheet 1 of 22

VAULT (3840)

1928

BREA CANYON ROAD

& BRIDGES 55C-0122, 55C-0123 OVER BREA CAN. CHANNEL (A02)

55C-122 0.6 mi N/o Central Ave.

55C-123 0.8 mi N/o Central Avenue

55C-121 0.41 mi N/O Central Avenue

L.A. COUNTY LINE = 93+84.97

BREA CITY LIMITS = -691.96

100+76.93 = 1.91 miles

52.80

* 55C-121 (BR-
@ BREA BLVD
THOMAS: 709-B5
* 55C-122 (BR-2)
@ BREA BLVD.
Thomas: 709-B4
* 55C-123 (BR-1)
@ Brea Blvd.
Thomas: 709-C4