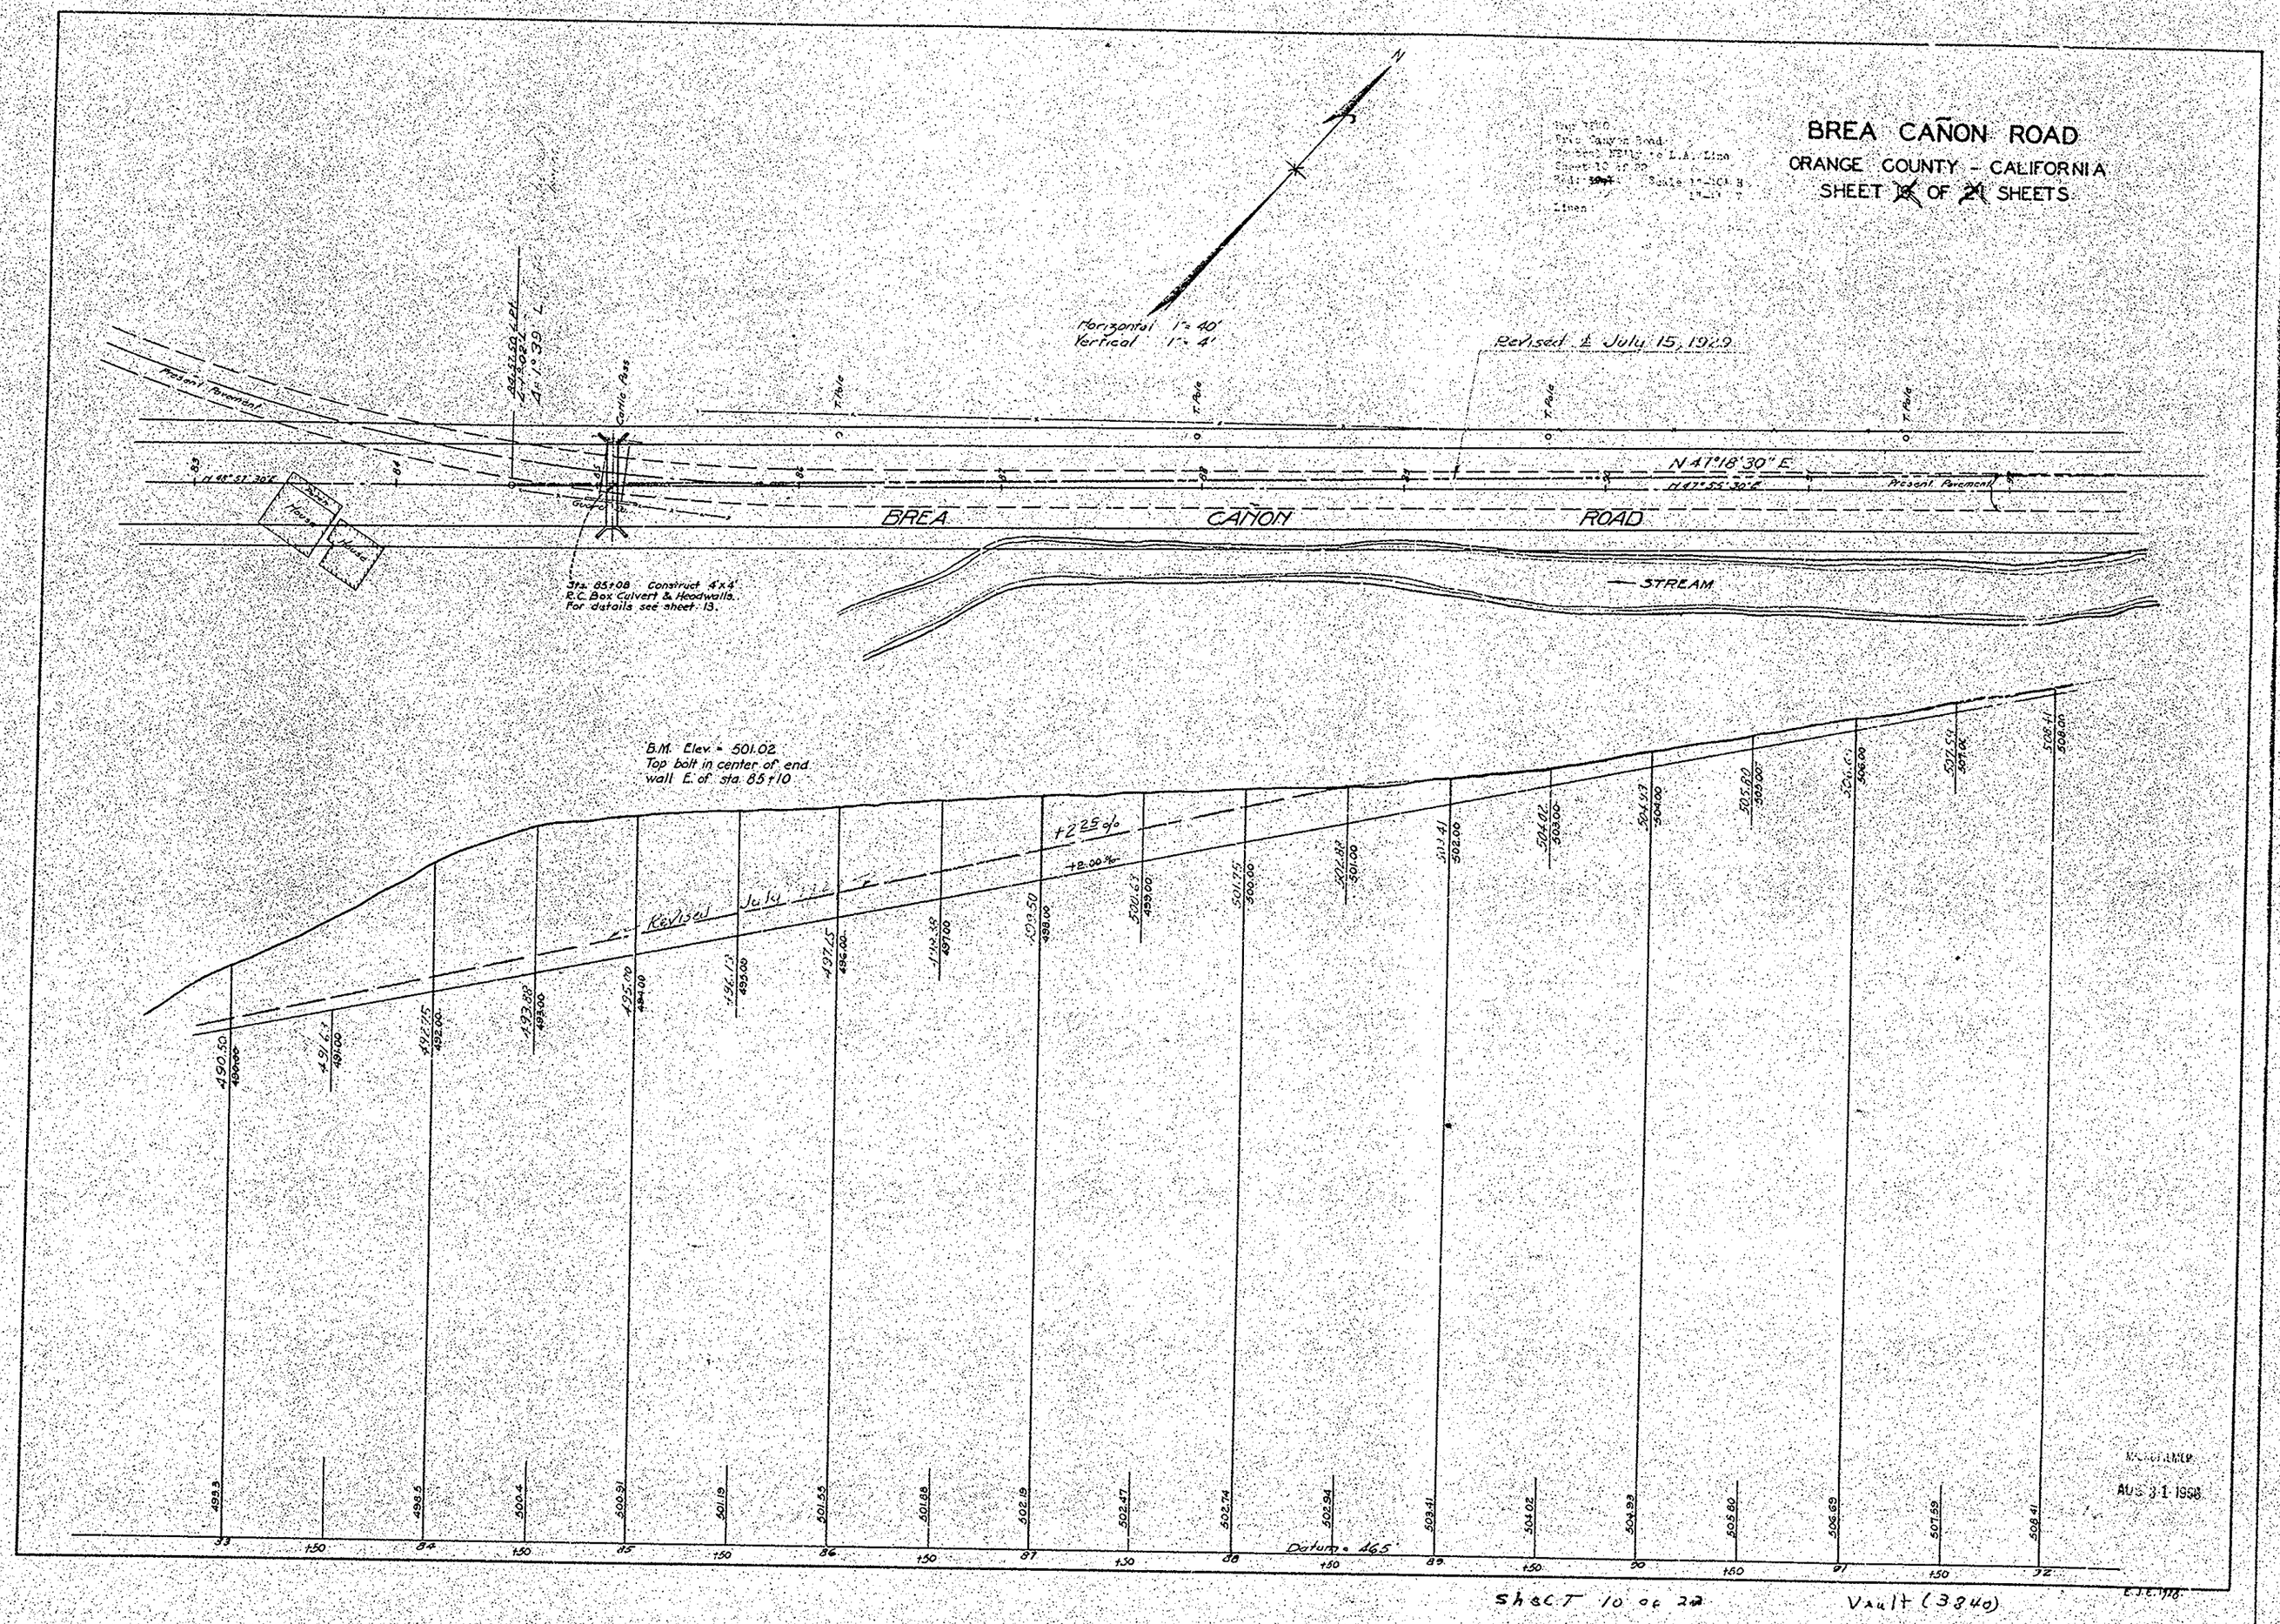
BREA CAÑON ROAD
ORANGE COUNTY - CALIFORNIA
SHEET 10 OF 21 SHEETS
Horizontal 1" = 40'
Vertical 1" = 4'
Revised 1 July 15, 1929
N 47°18' 30" E
Present Pavement
BREA CAÑON ROAD
STREAM
Sta. 85+08 Construct 4'x4' R.C. Box Culvert & Headwalls. For details see sheet 13.
B.M. Elev. = 501.02
Top bolt in center of end wall E. of sta. 85+10
+2.25%
+8.00%
Revised July
Datum = 465'
Sheet 10 of 22
Vault (3340)
AUG 31 1958