


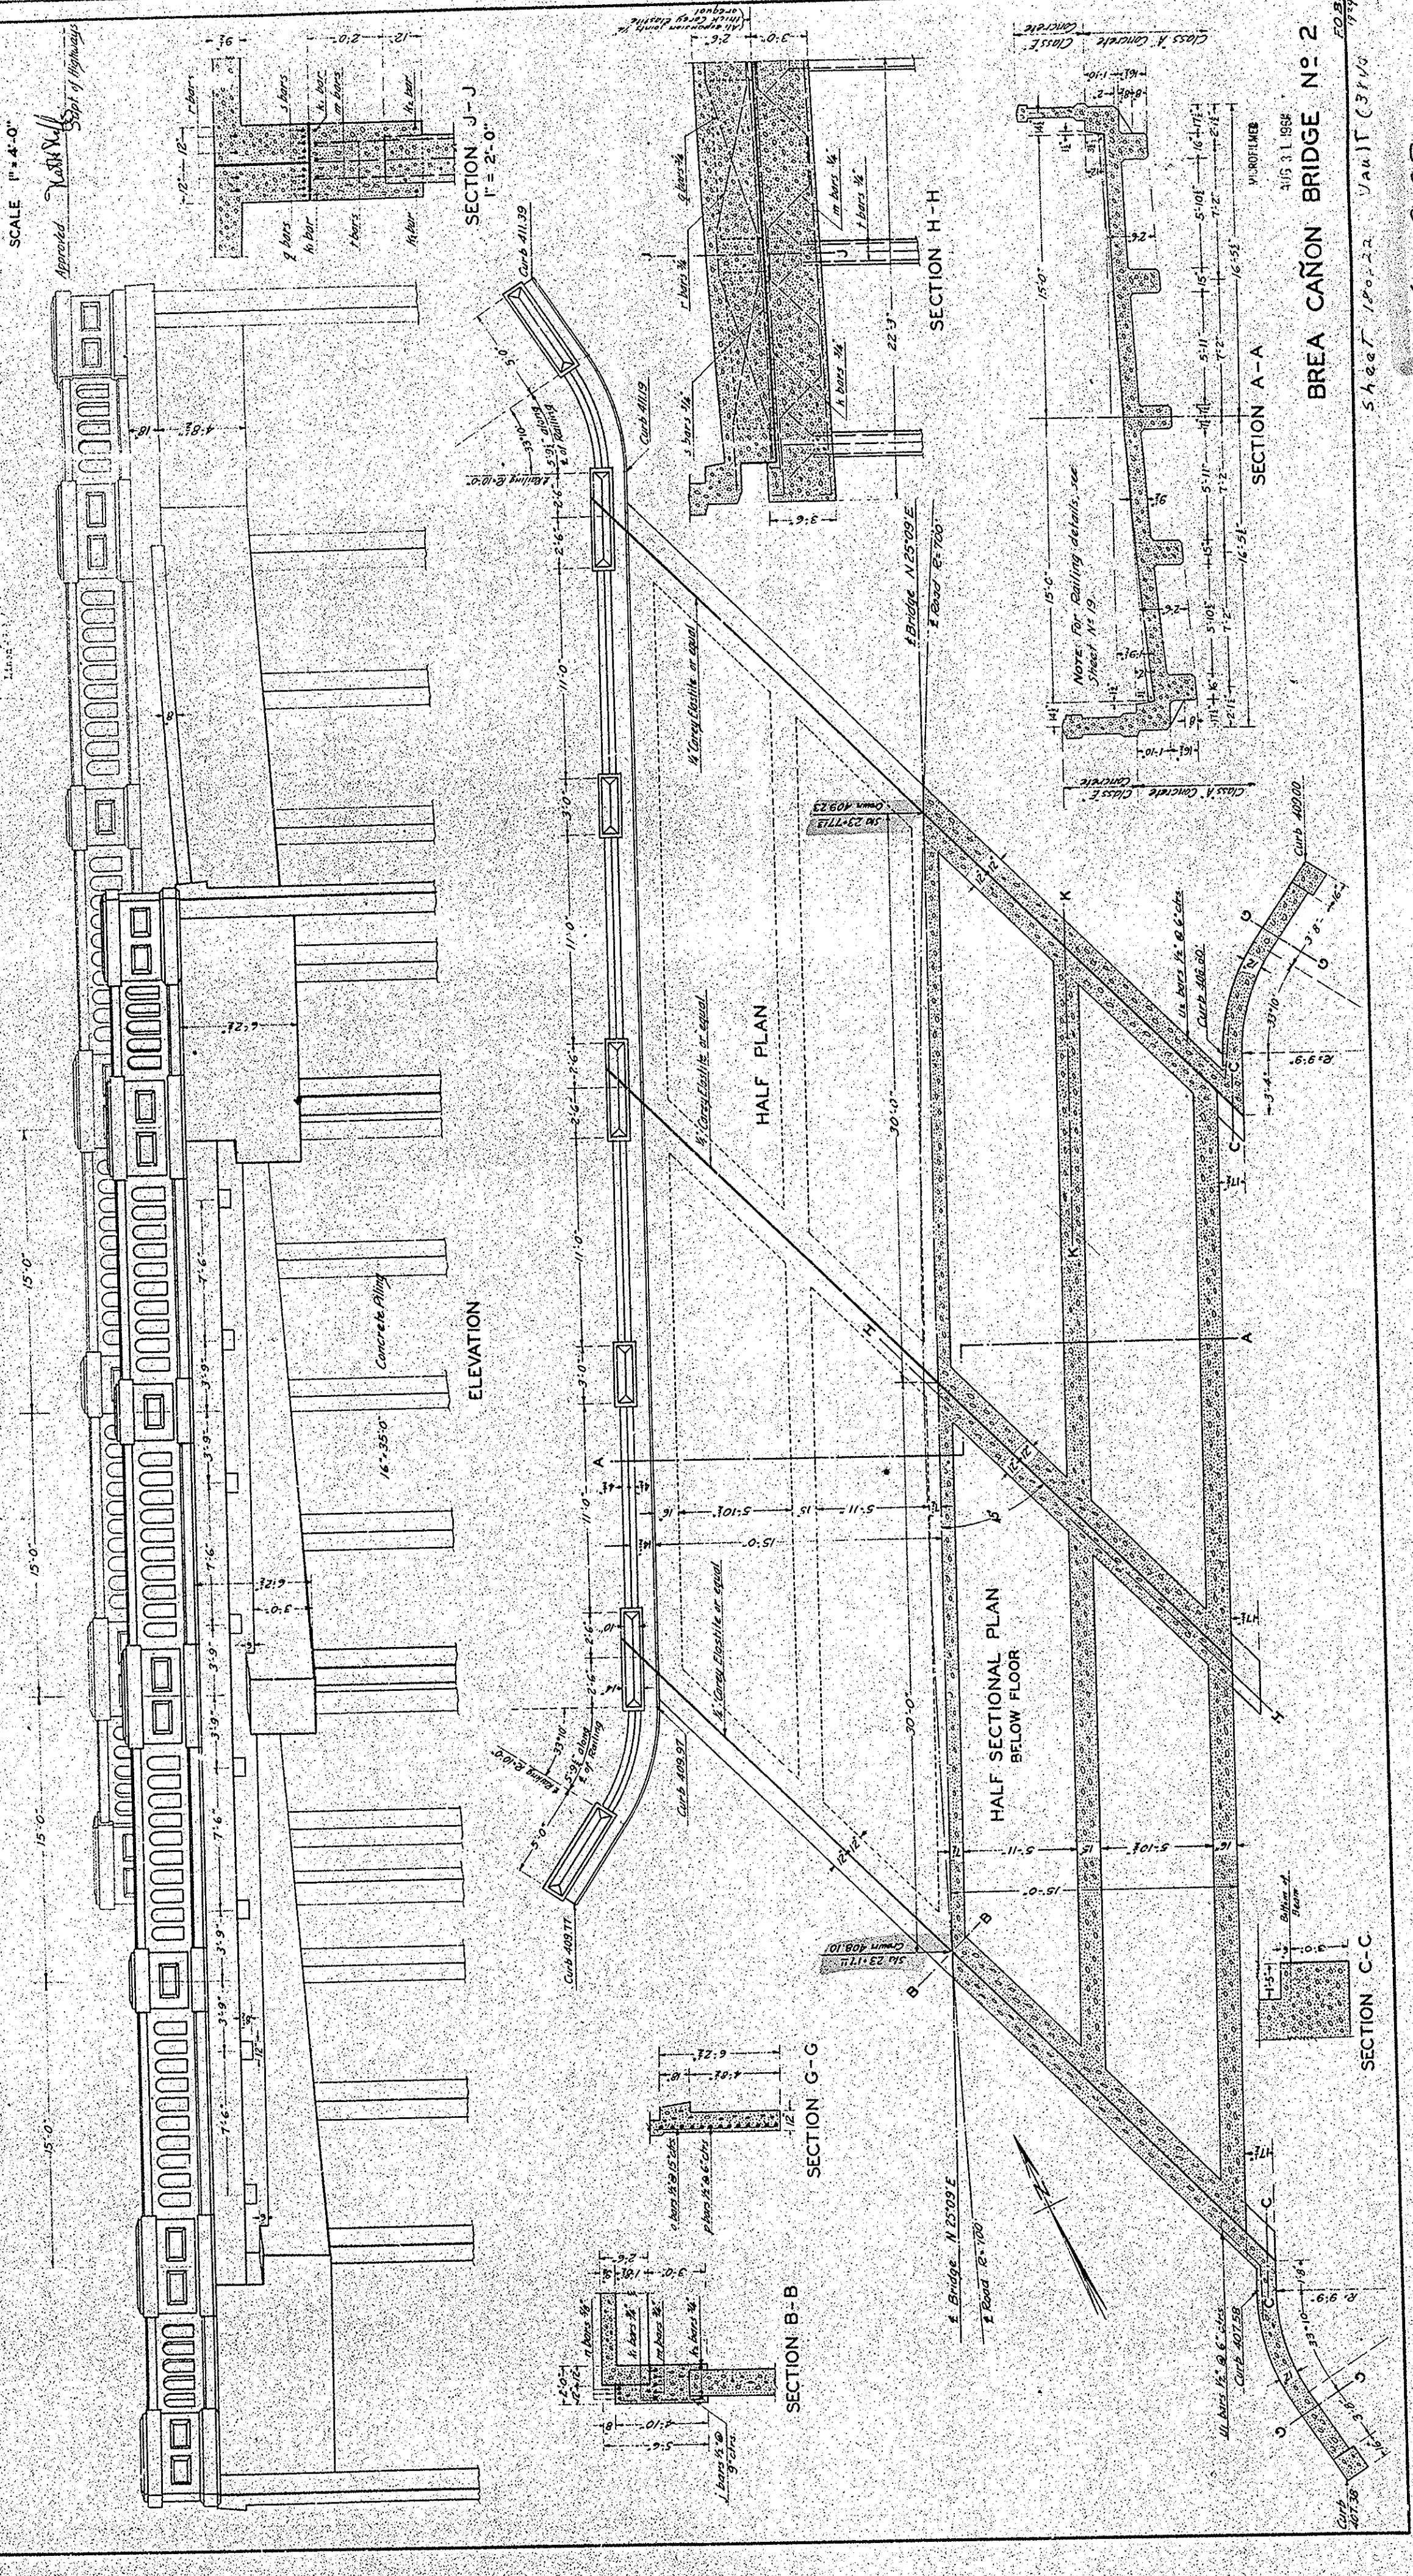

BBREA CAÑON BRIDGE N° 2