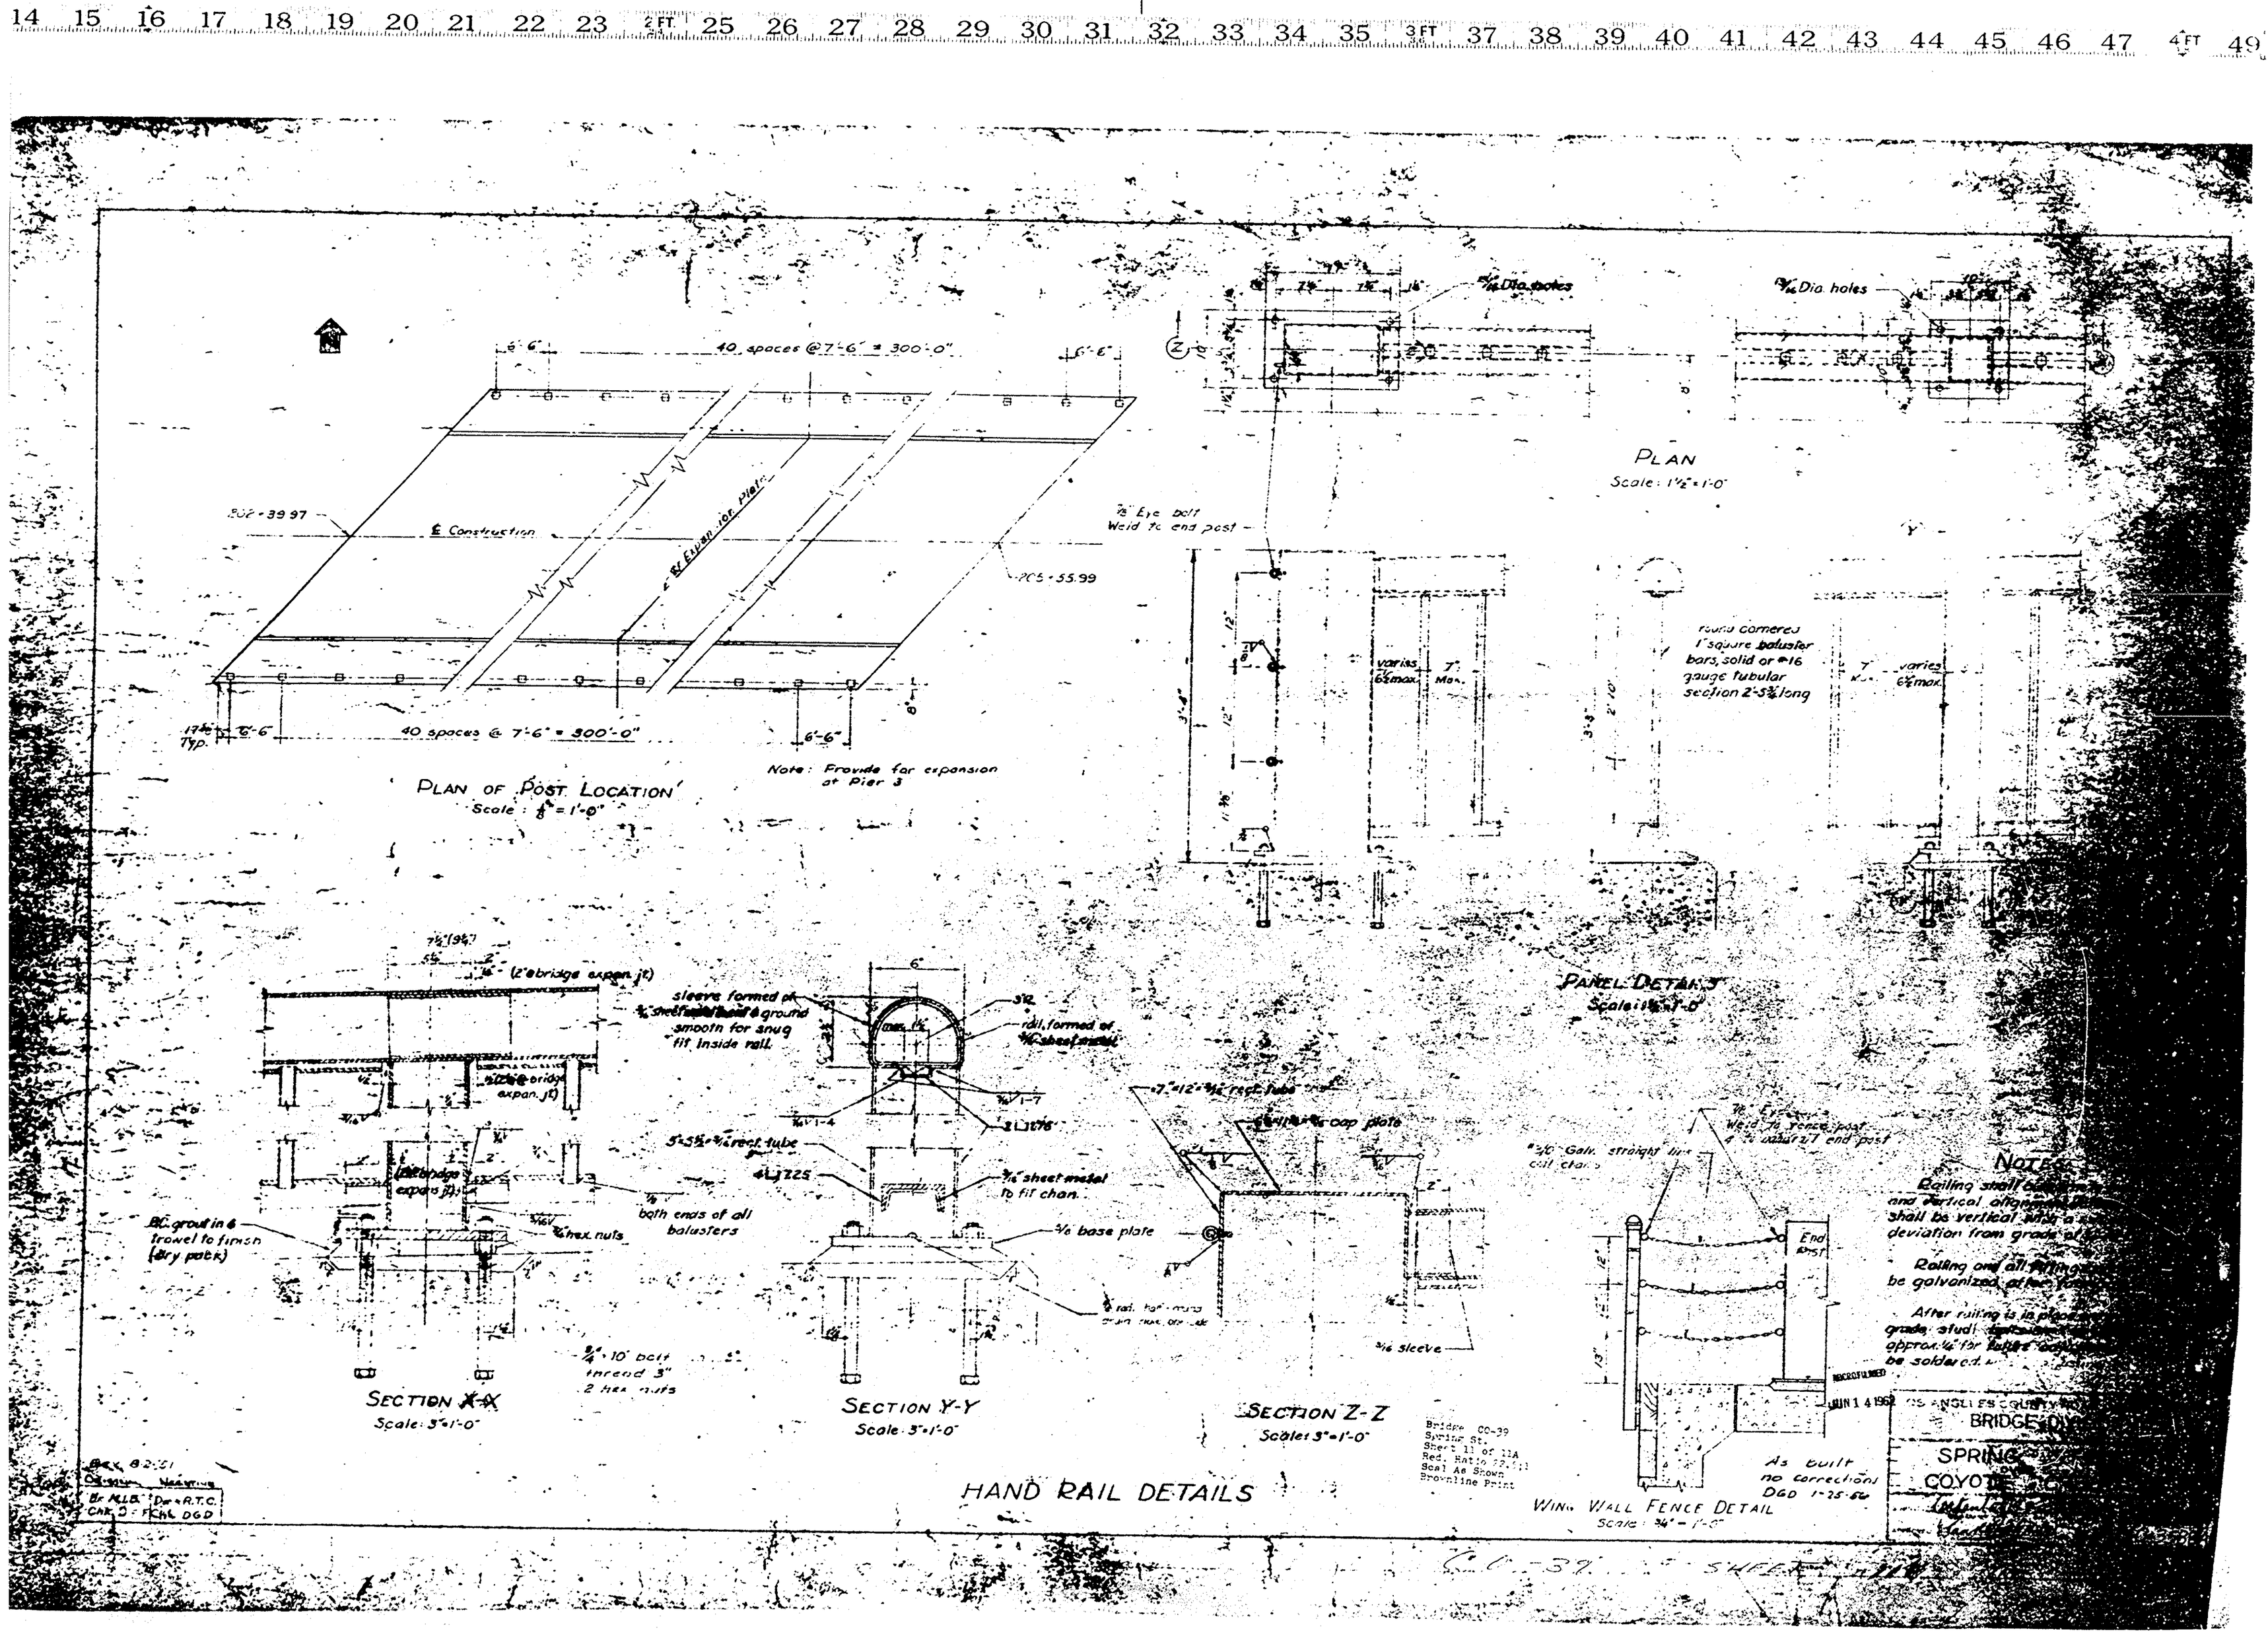
PLAN OF POST LOCATION
Scale: 1/8" = 1'-0"
40 spaces @ 7'-6" = 300'-0"
℄ Construction
℄ Expansion Plate
Note: Provide for expansion at Pier 3
PLAN
Scale: 1 1/2" = 1'-0"
Round cornered 1" square baluster bars, solid or #16 gauge tubular section 2'-5 3/8" long
PANEL DETAIL
Scale: 1 1/2" = 1'-0"
SECTION X-X
Scale: 3" = 1'-0"
SECTION Y-Y
Scale: 3" = 1'-0"
SECTION Z-Z
Scale: 3" = 1'-0"
HAND RAIL DETAILS
WING WALL FENCE DETAIL
Scale: 3/4" = 1'-0"
NOTES
As built no corrections DGD 1-25-62
BRIDGE DIV.
SPRING ST.
COYOTE
Bridge CO-39
Spring St.
Sheet 11 of 11A
Scal As Shown
Brownline Print
CO-39 SHEET 11A