DIST.	COUNTY	ROUTE	POST MILES—TOTAL PROJECT	SHEET NO.	TOTAL SHEETS
07	ora.	57	10.7/12.5	167	243

DESIGN SECTION SUPERVISOR A.E. Backer REGISTERED CIVIL ENGINEER NO. 8558

DATE APPROVED April 16, 1973

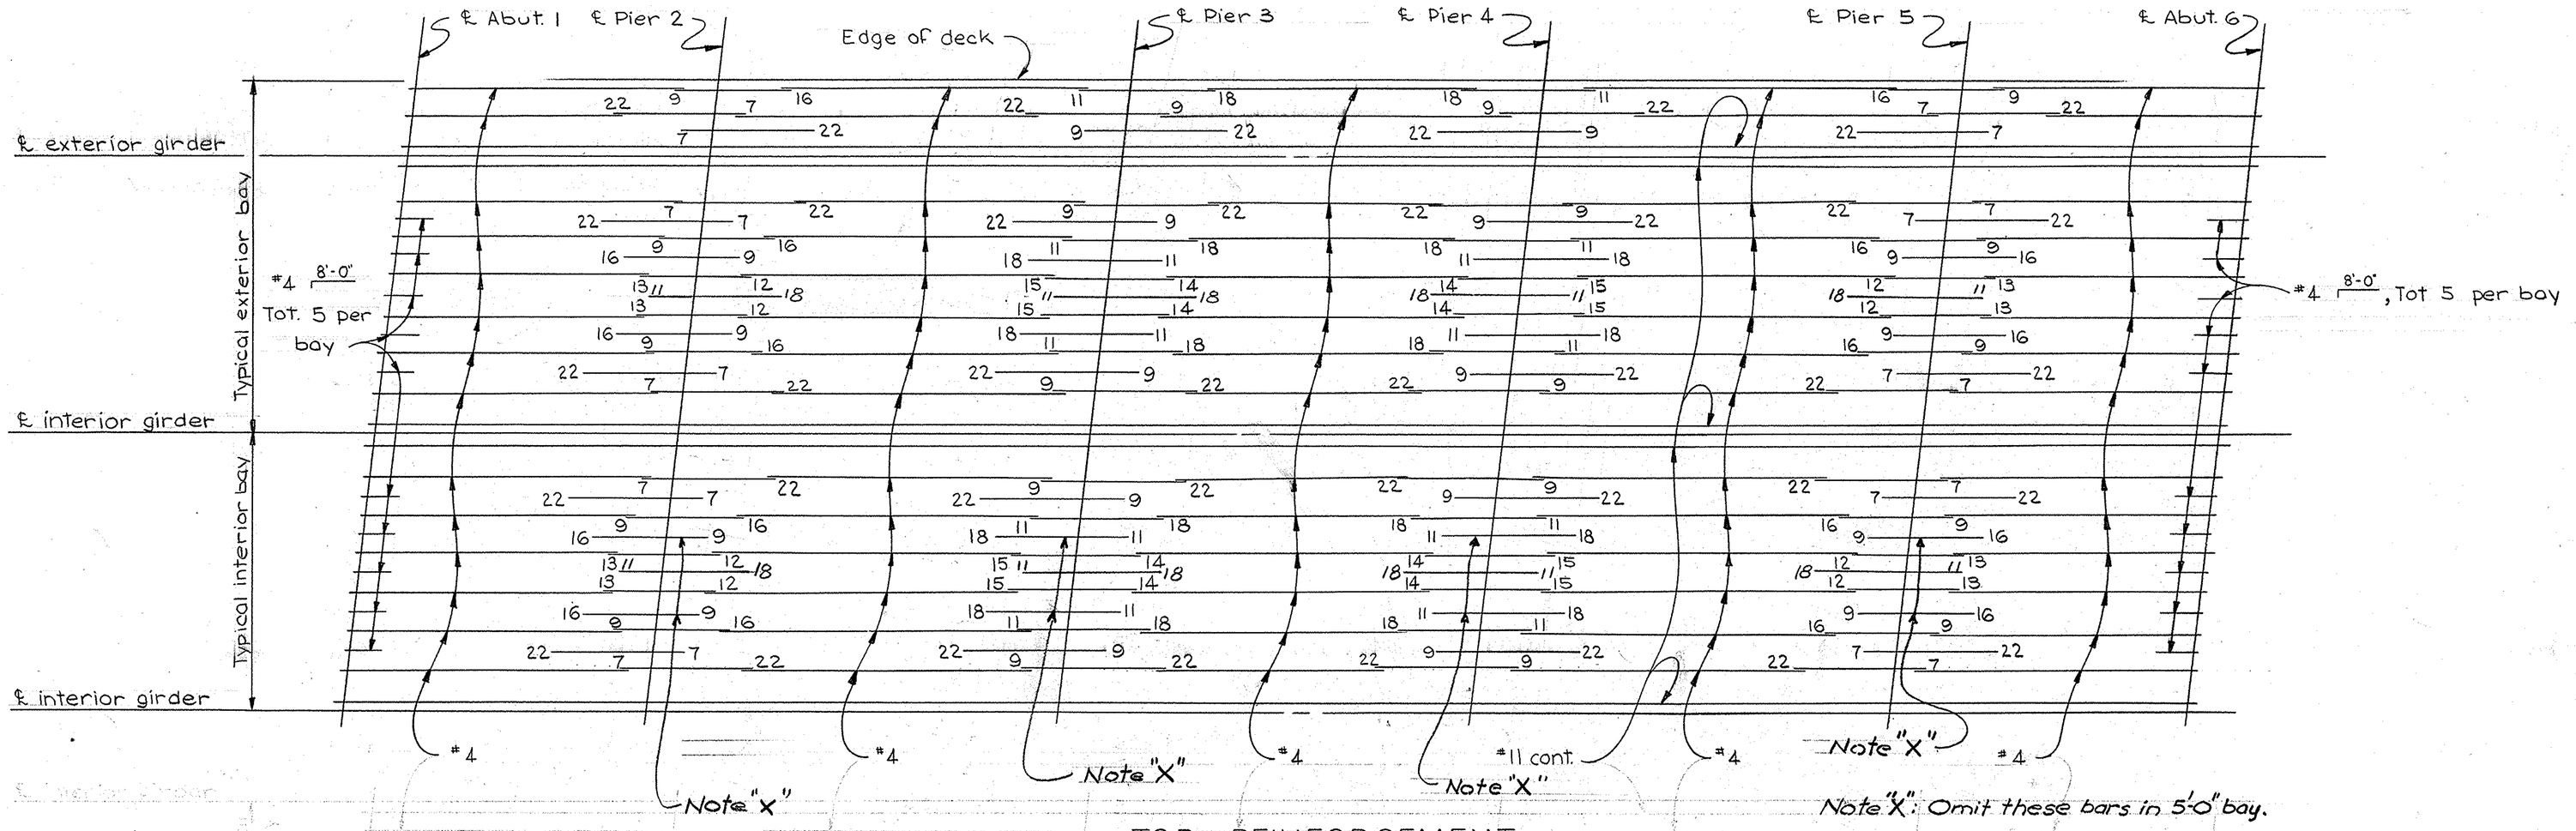

TOP REINFORCEMENT
No Scale

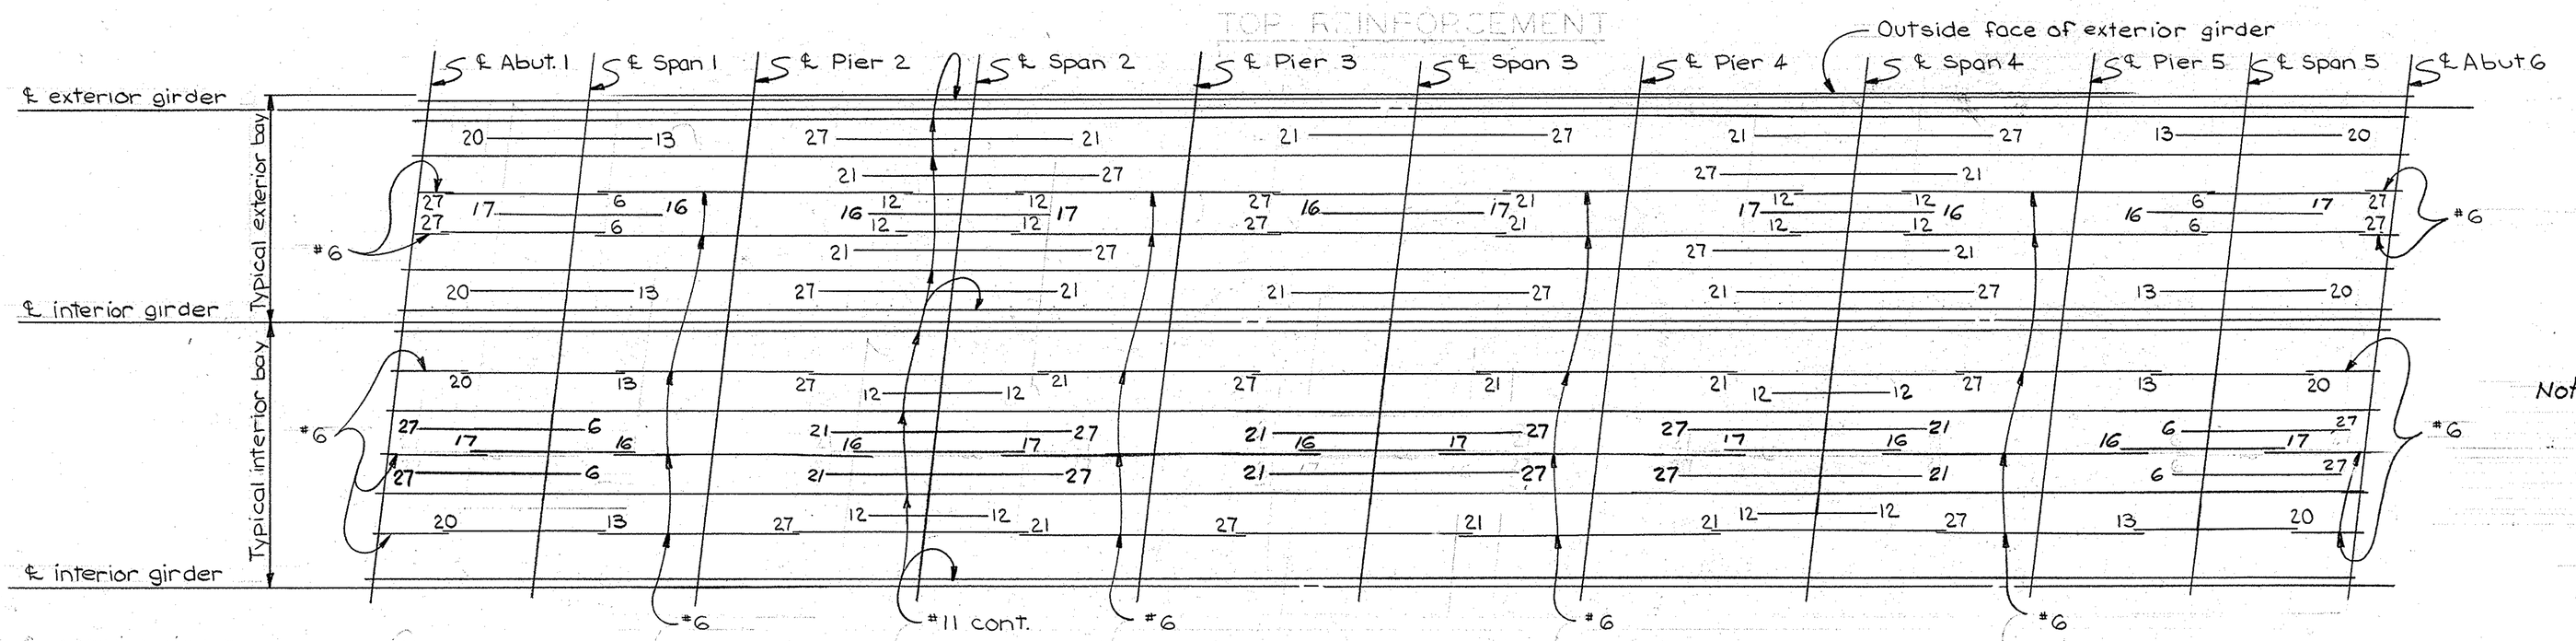

BOTTOM REINFORCEMENT
No Scale

AS BUILT Rev. 5/28/76
NO CORRECTIONS BY W. HANSEN
CONTRACT NO. 07-032014
DATE 4-13-76

Note: All bars No. 11 except as noted.

Numbers at ends of bars indicate length in feet from ℄ between piers for bottom reinforcement and ℄ piers for top reinforcement.

Denote bundled bars.

MICROFILMED
JUL 2 2 1976

167

BRIDGE DEPARTMENT
DESIGN SECTION 9
Project Engineer P. Nelsen
DESIGN By Albert Backer
Checked
DETAILS By DON SCHROEDER 10-69
Checked
QUANTITIES By P. Nelsen
Checked

STATE OF CALIFORNIA
DEPARTMENT OF TRANSPORTATION

SANTA ANA RIVER BRIDGE
REMOVE & REPLACE

GIRDER REINFORCEMENT

BRIDGE NO.	POST MILE	DRAWING NO.	SHEET	OF
55 C-54	11.1	55C54-	8	12

WO
CU

Disregard prints bearing earlier revision dates

REVISION DATES (PRELIMINARY STAGE ONLY)