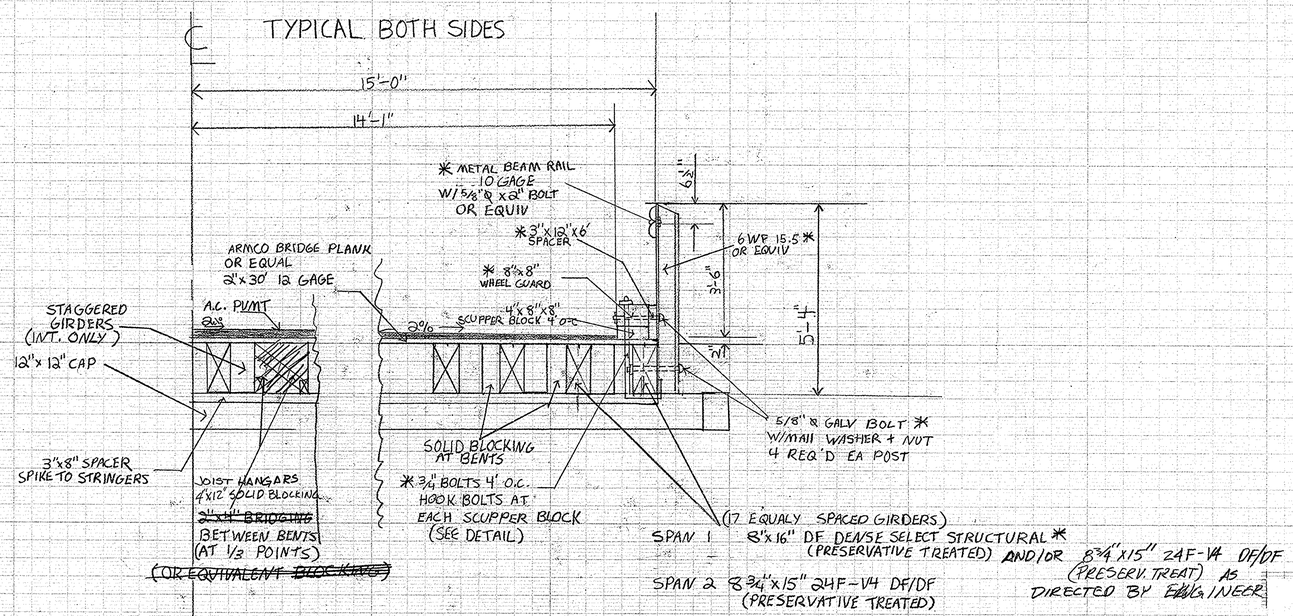

TYPICAL SECTION

1/2" = 1'-0"

* NOTE: THESE MATERIALS MAY BE SALVAGED TO THE GREATEST EXTENT POSSIBLE BY CONTRACTOR AND AS APPROVED BY ENGINEER.

1 1/2 0 1 2
3 inches on original drawing

MARK	DATE	DESCRIPTION

REVISIONS

DESIGNED ____ DRAWN ____ CHECKED ____

ORANGE COUNTY
ENVIRONMENTAL MANAGEMENT AGENCY

PREPARED UNDER SUPERVISION OF ____ DATE ____

SCALE AS SHOWN | DATE | DWG. NO.

SHEET 4/4

EDINGER AV. BR. @ SUNSET AQUATIC PARK
(EMERGENCY REPAIRS)