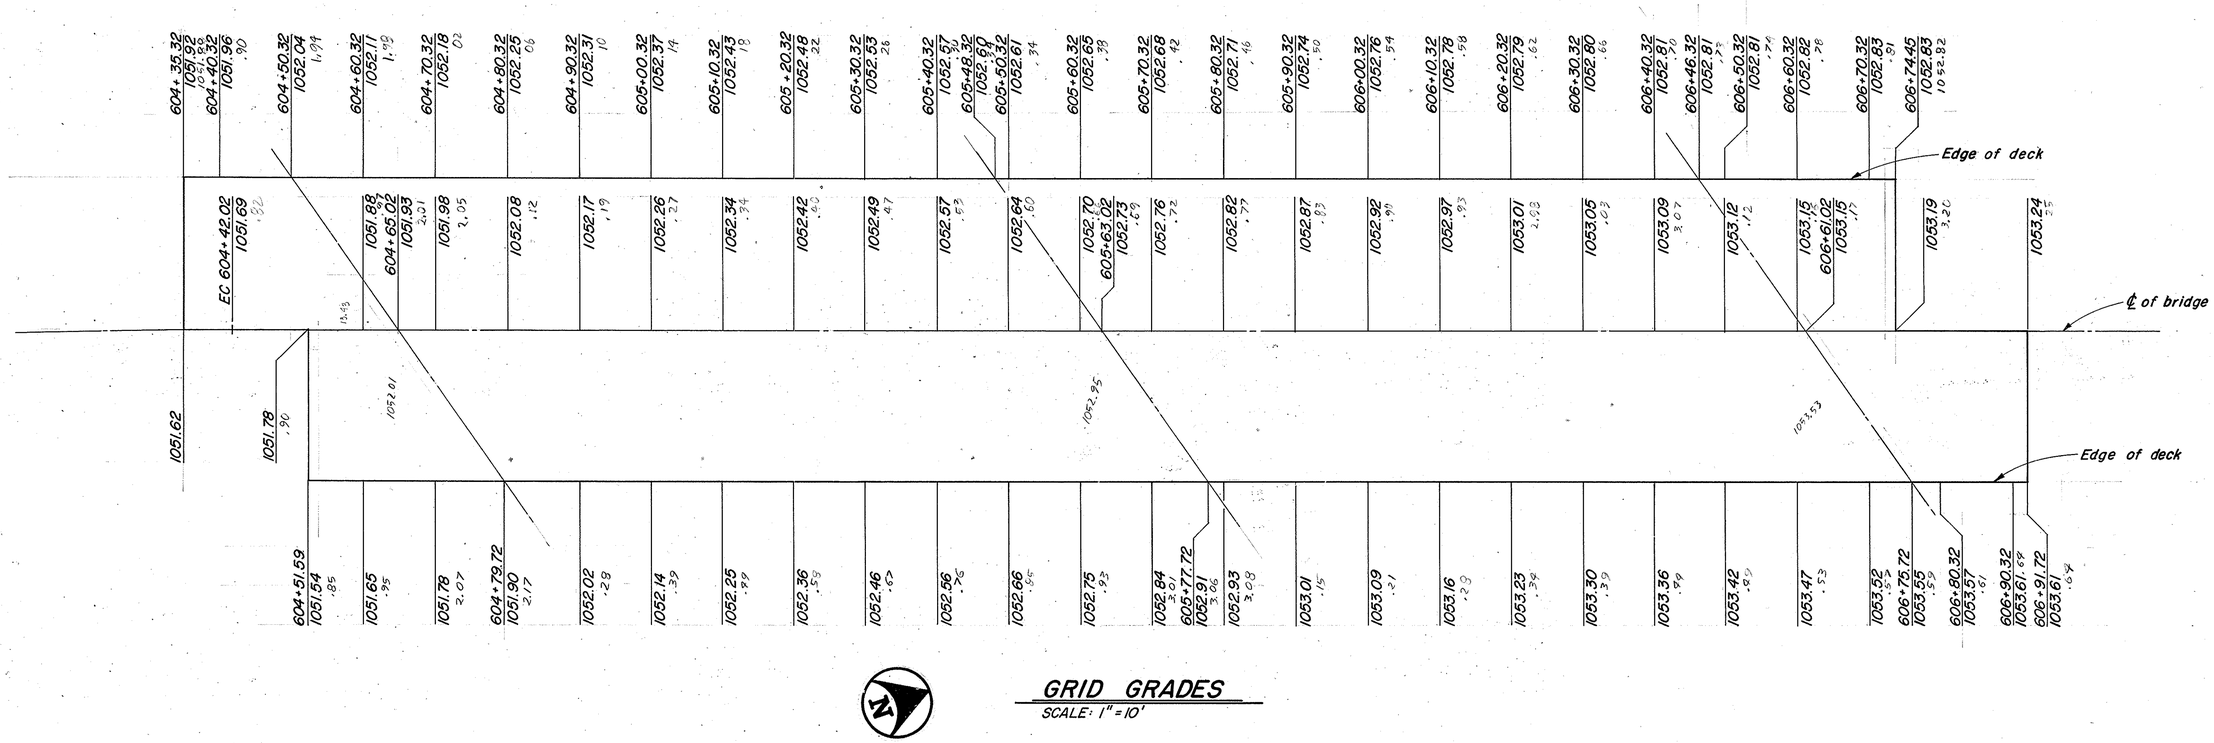

GRID GRADES

SCALE: 1" = 10'

1 1/2 0 1 2

3 inches on original drawing

ORANGE COUNTY
ENVIRONMENTAL MANAGEMENT AGENCY

EL TORO ROAD BRIDGE
NO. AL 0.5 AT
ALISO CREEK

GRID GRADES

MARK	DATE	DESCRIPTION

REVISIONS

PREPARED UNDER SUPERVISION OF Danny T. Liao
RCE 21594 7/30/79 DATE

DESIGNED DTL
DRAWN JM CHECKED
SCALE AS SHOWN
DATE
DWG. NO.
SHEET 45