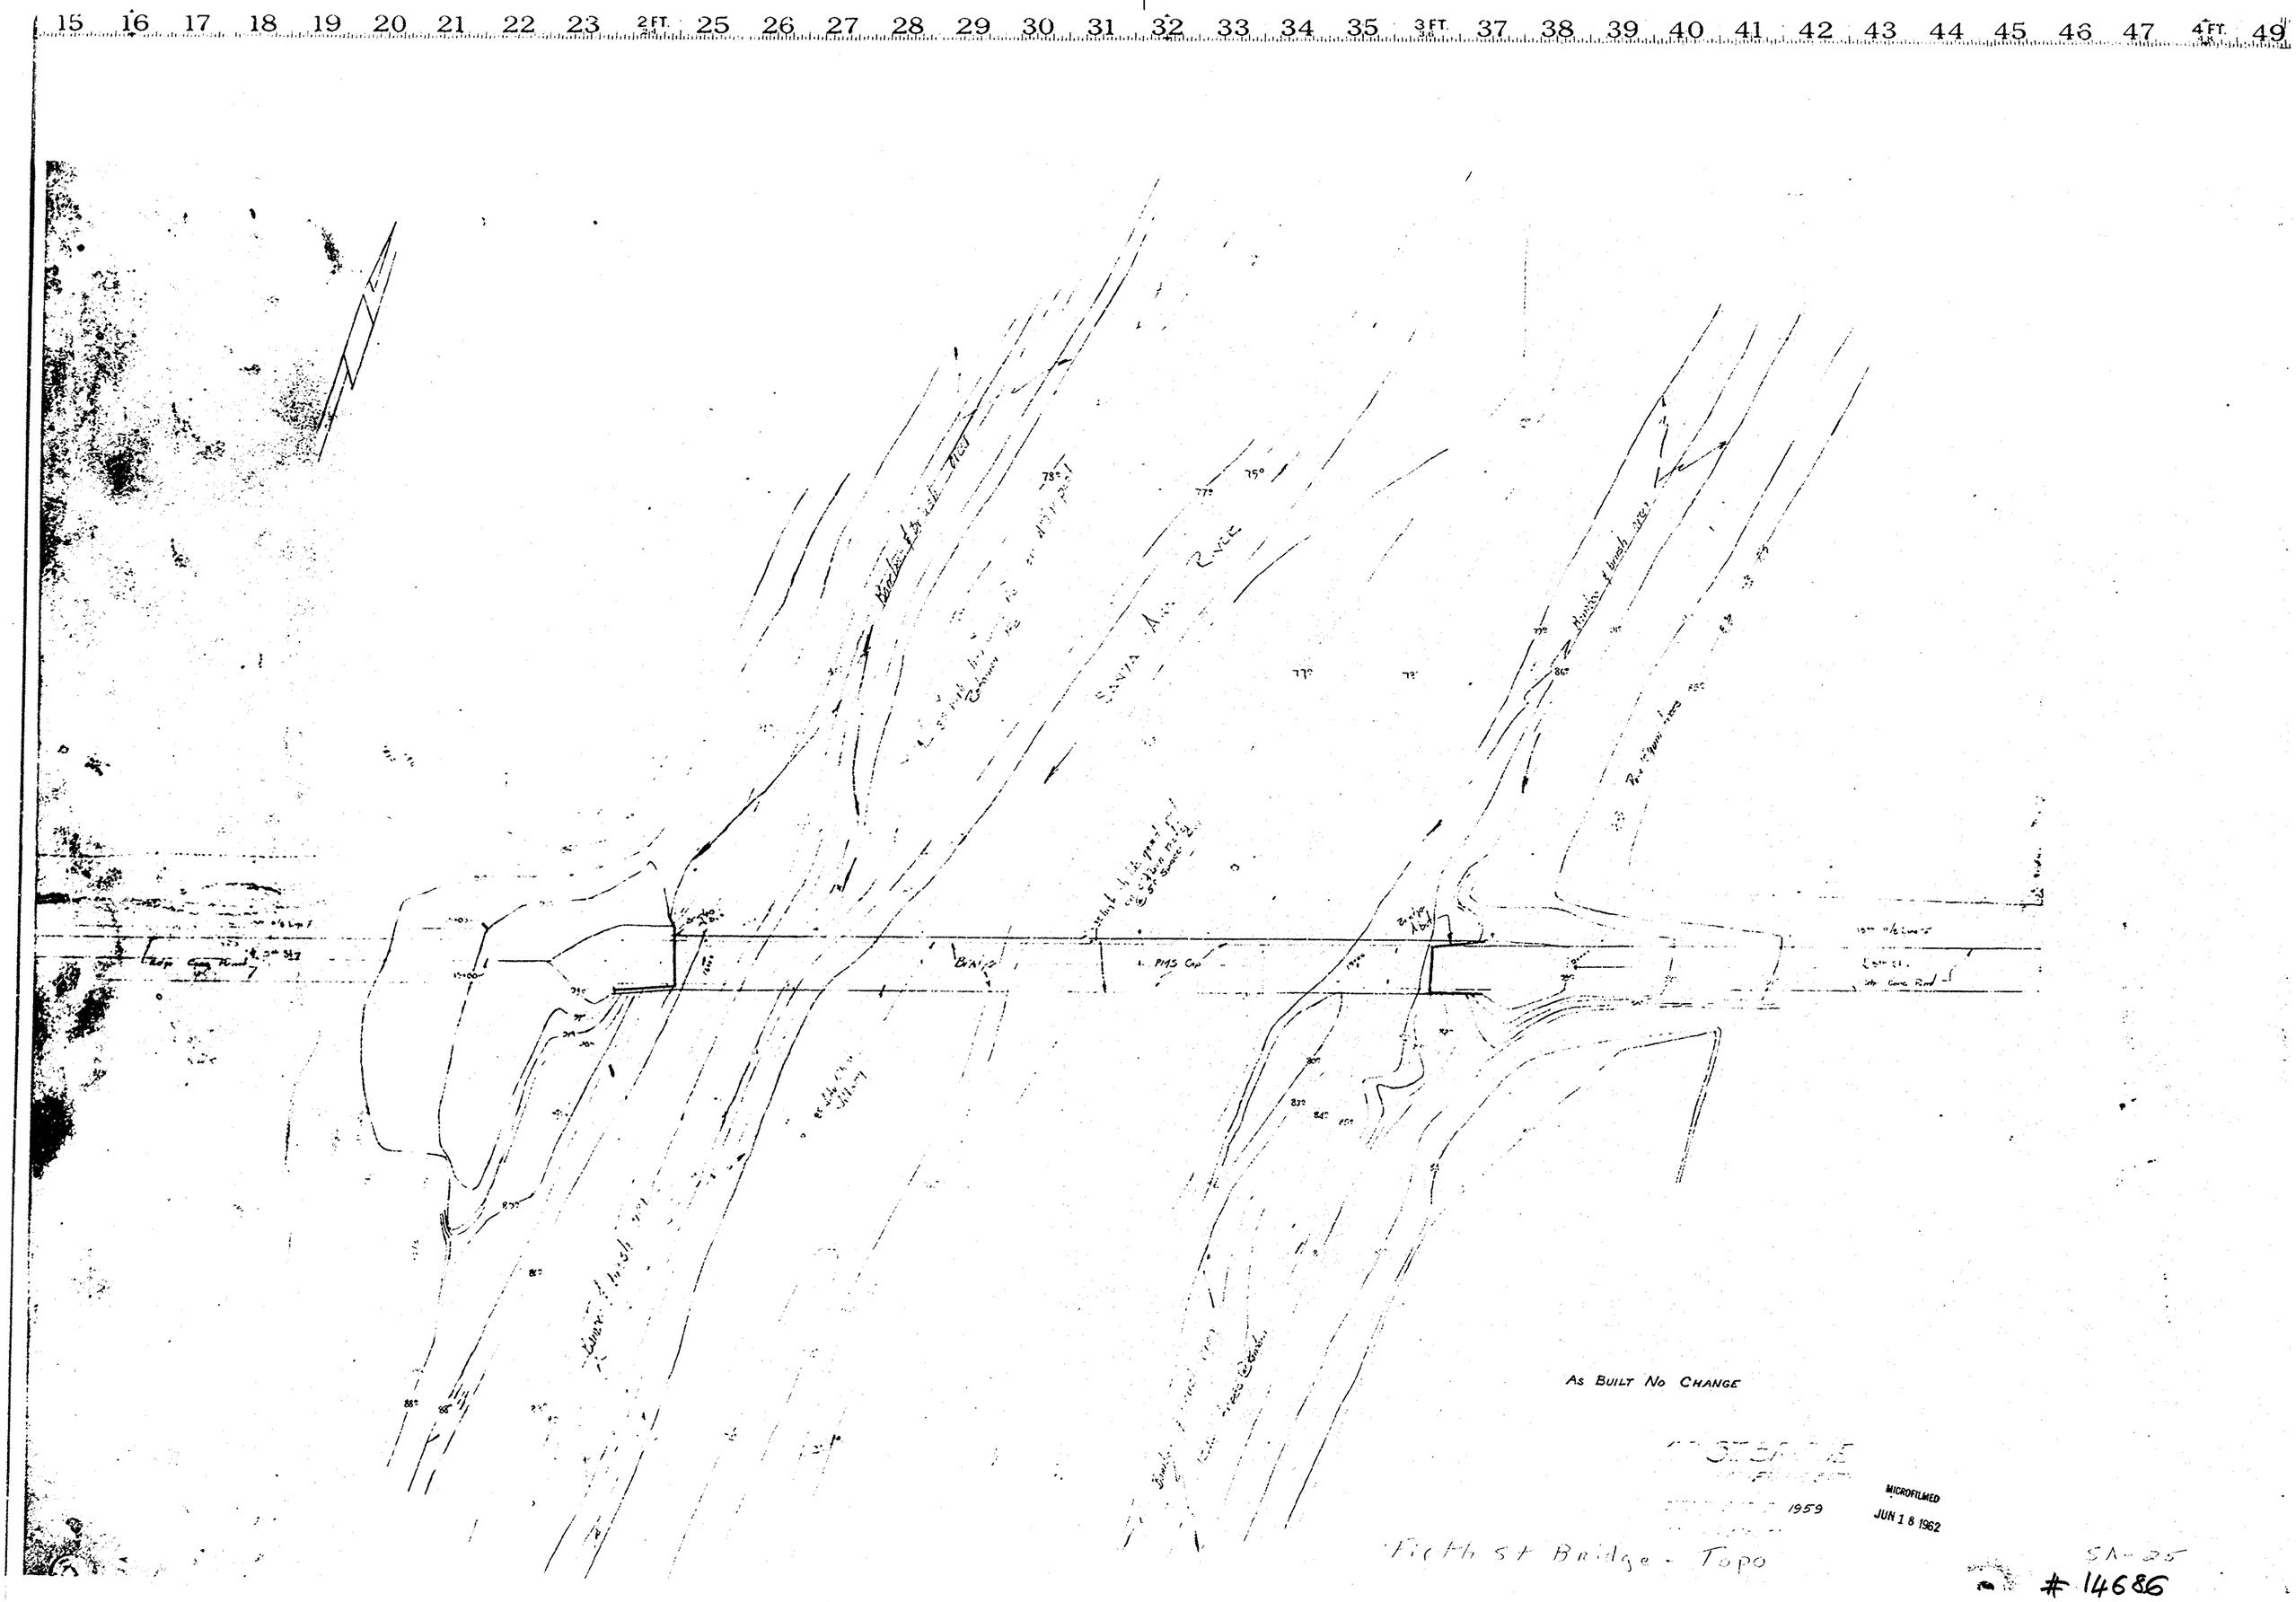

SA-25
14686
SA-25
Topo