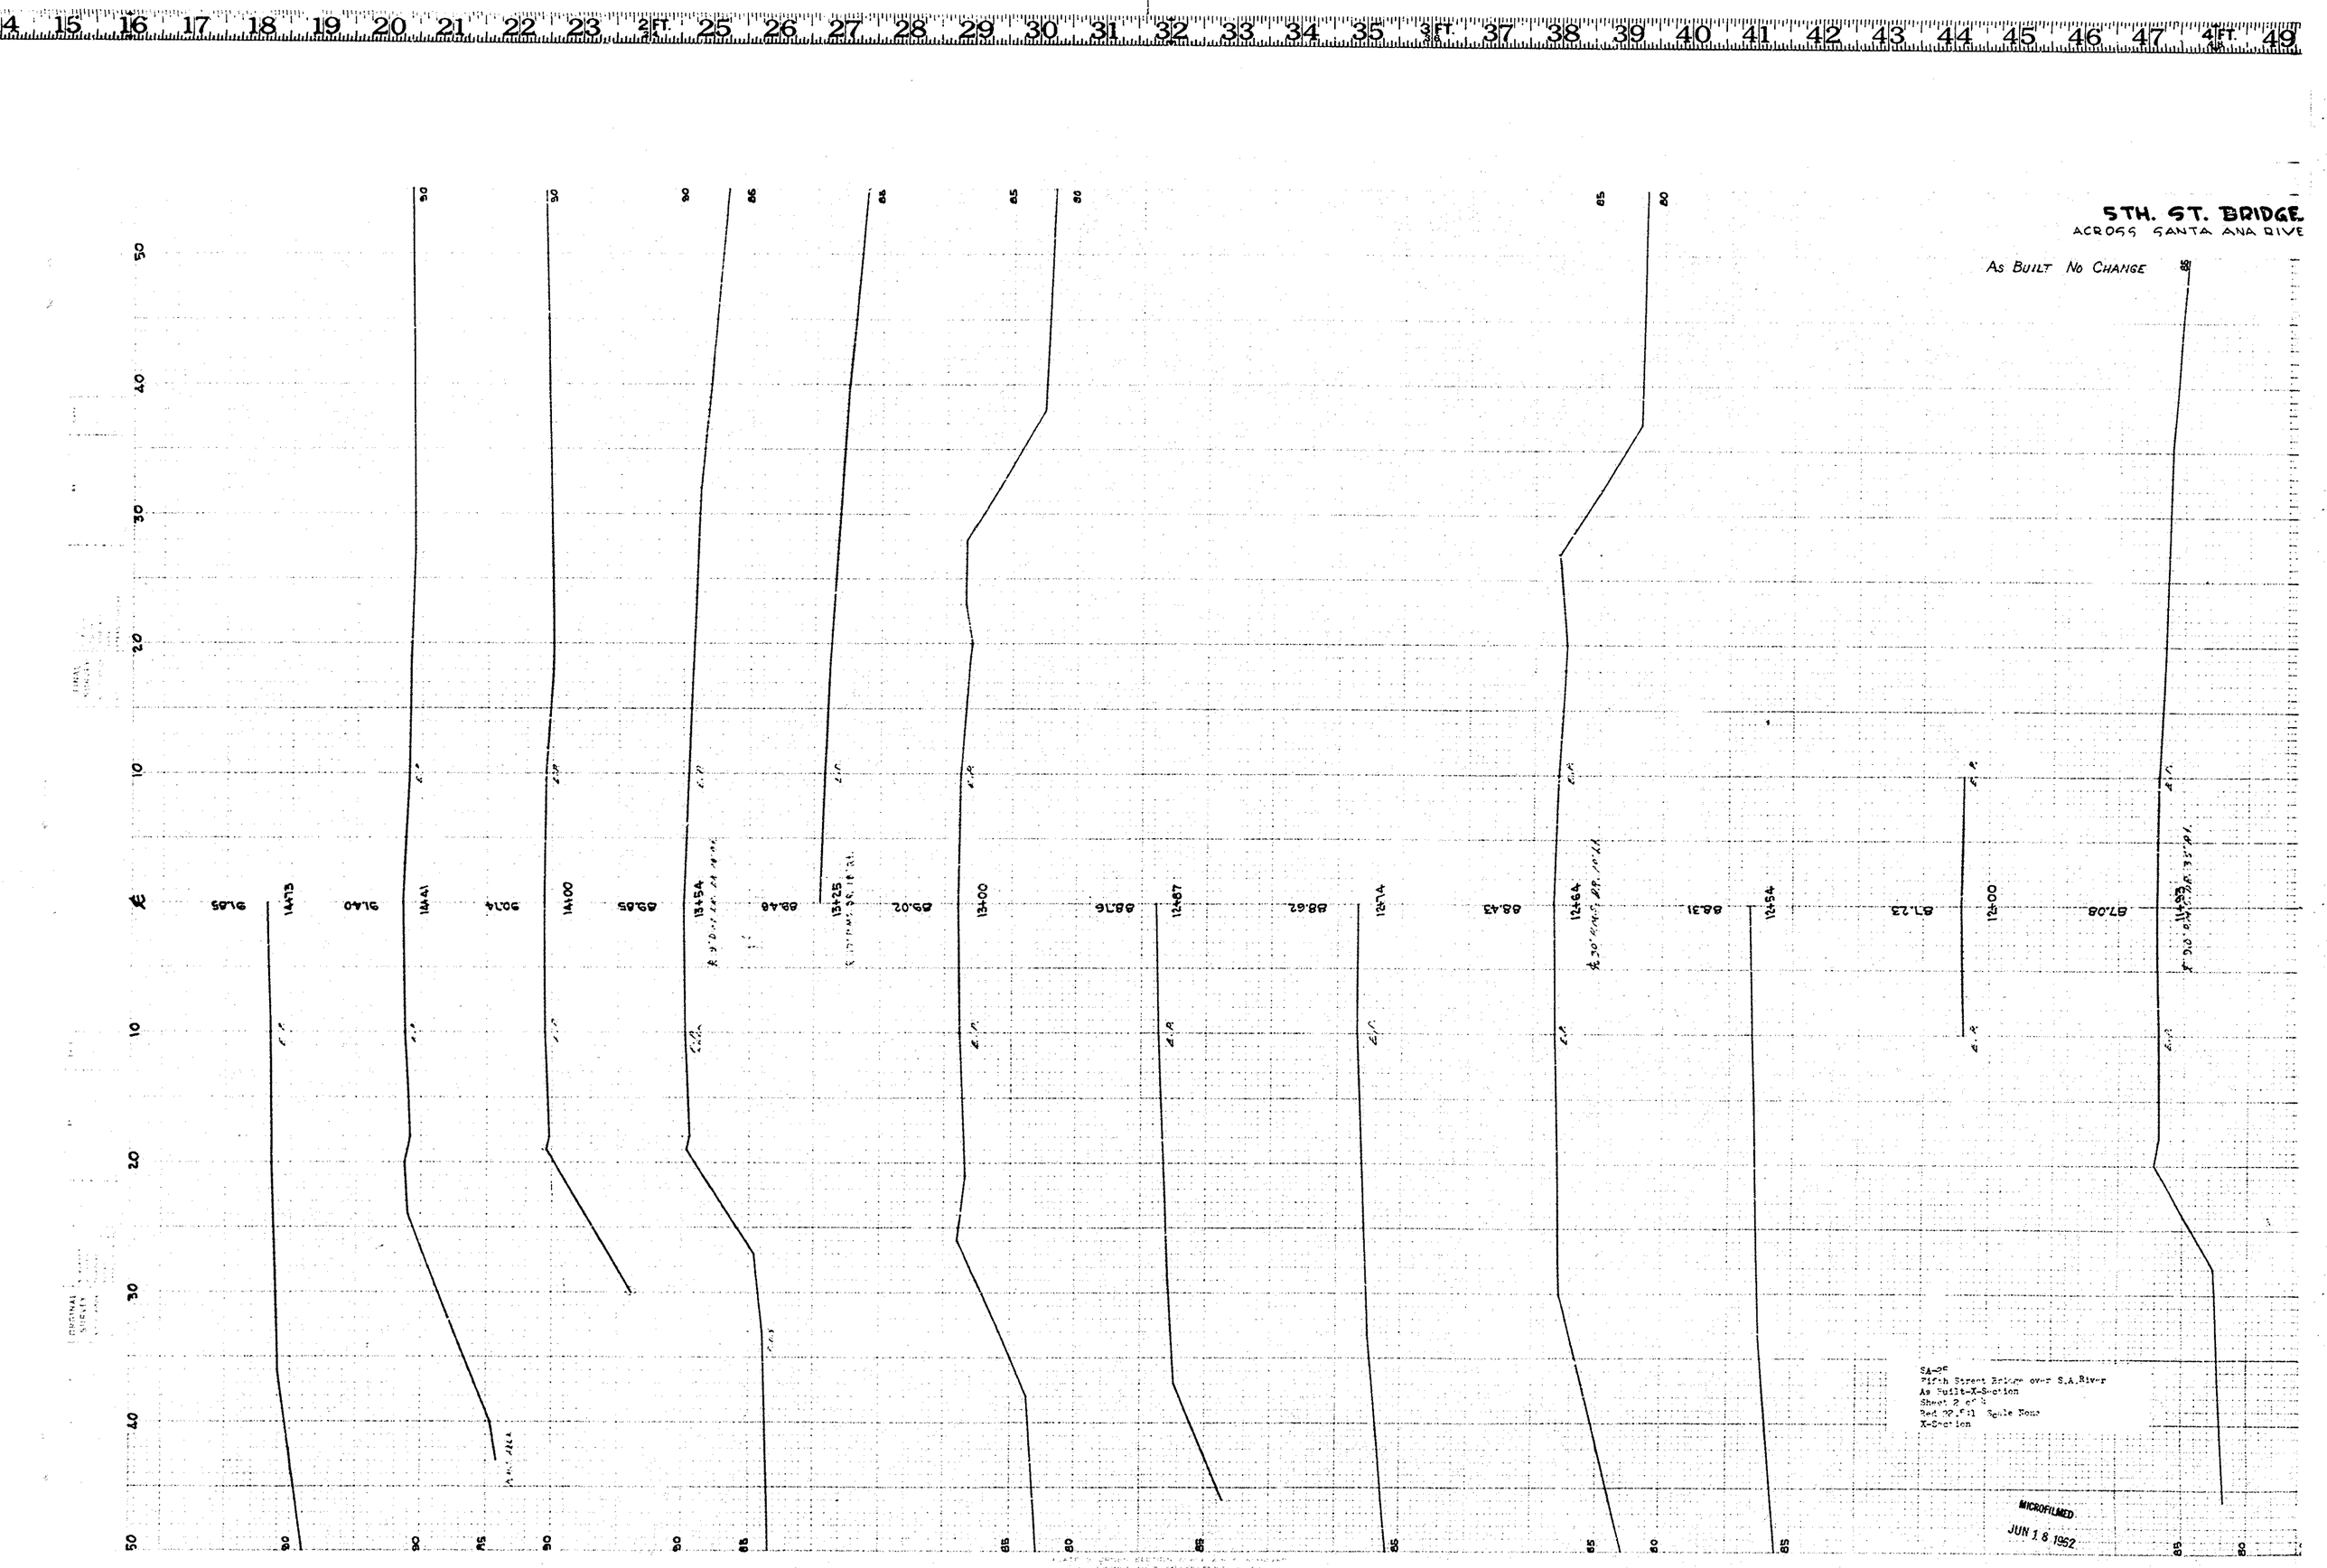
5TH. ST. BRIDGE
ACROSS SANTA ANA RIVE
AS BUILT NO CHANGE
SA-25
Fifth Street Bridge over S.A.River
As Built-X-Section
Sheet 2 of 4
Red 22.0 fl Scale None
X-Section
MICROFILMED
JUN 18 1952